


PLANS FOR CONSTRUCTION OF
PAVING, DRAINAGE AND UTILITIES ON
BAYOU BEND ESTATES
FOR THE
CITY OF ANGLETON
BRAZORIA COUNTY
B&L JOB No. 13454

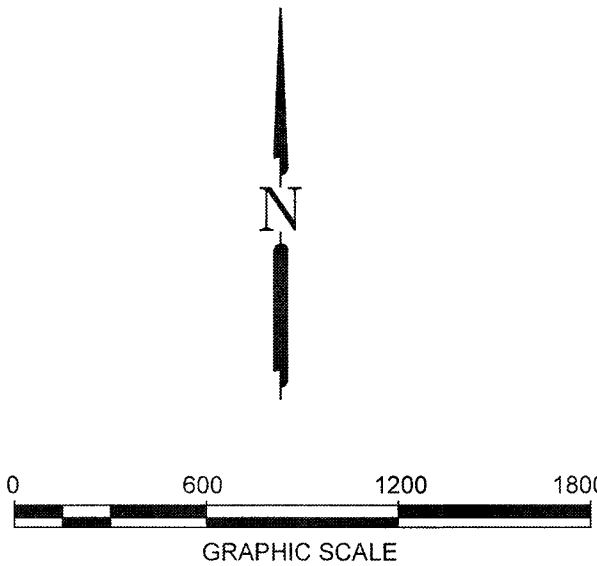

CITY OF ANGLETON


MAYOR
JASON PEREZ

CITY COUNCIL
MIKEY SVOBODA
CECIL BOOTH
JOHN WRIGHT
TRAVIS TOWNSEND
MARK GONGORA

CITY MANAGER
CHRIS WHITTAKER

"Release of this application does not constitute a verification of all data, information and calculations supplied by the applicant. The engineer of record is solely responsible for the completeness, accuracy and adequacy of their submittal, whether or not the application is reviewed for Code compliance by the City Engineer."

"All responsibility for the adequacy of these plans remains with the Engineer who prepared them. In approving these plans, the City of Angleton must rely on the adequacy of the work of the Design Engineer."

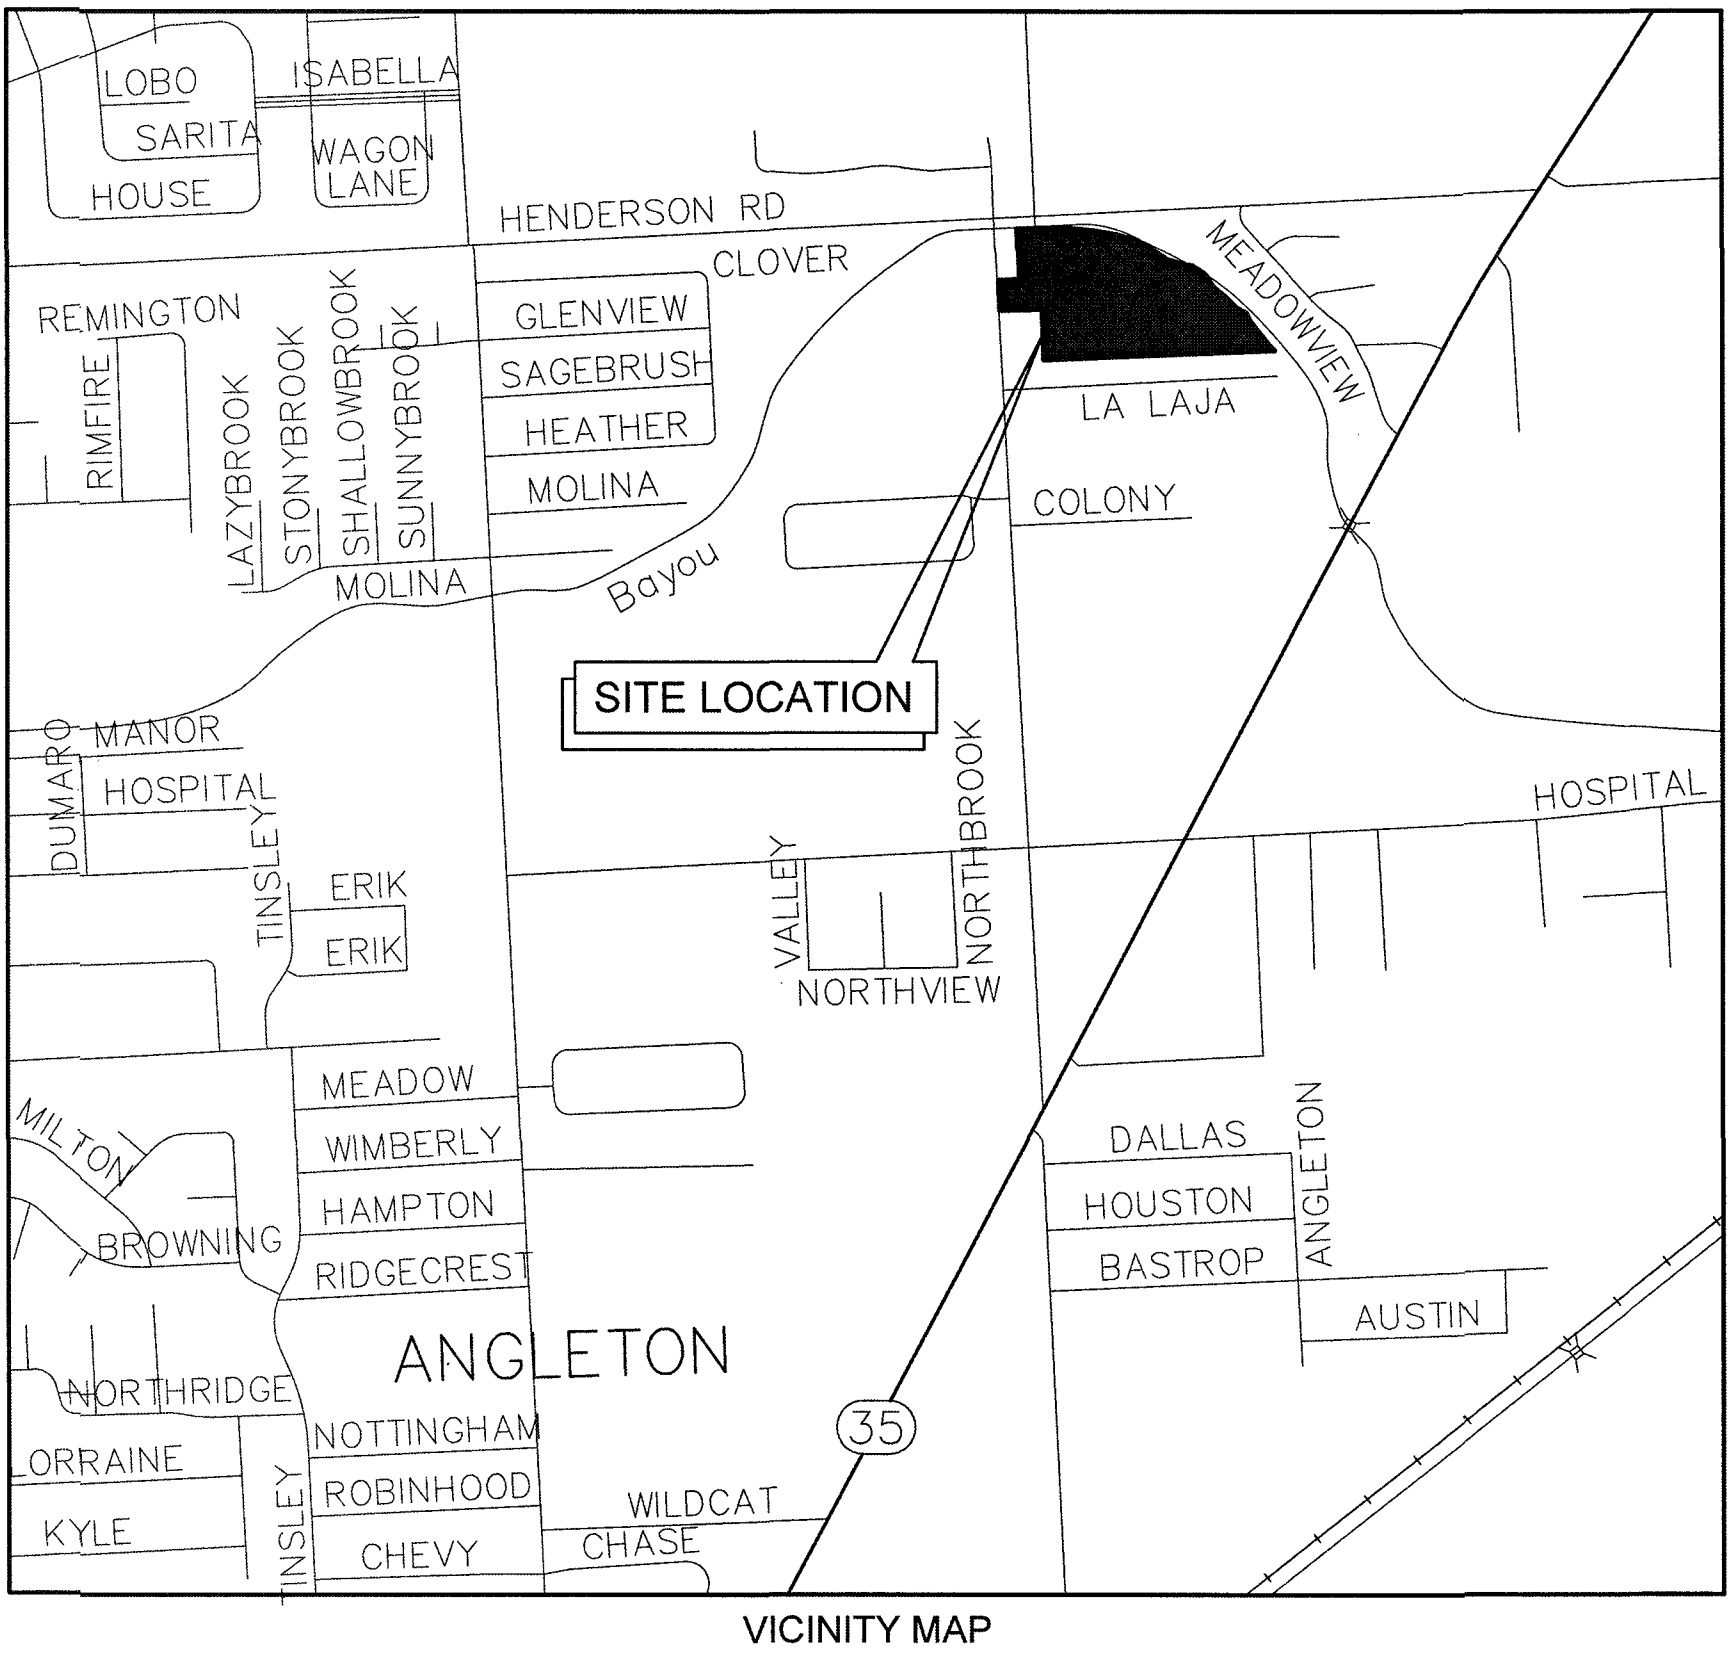

INDEX OF DRAWINGS

SHEET NO.	SHEET NAME
1	TITLE SHEET
--	PRELIMINARY REPLAT
2	CONSTRUCTION NOTES
3	EXISTING CONDITIONS
4	PLAN & PROFILE - BAYOU BEND BLVD. STA 0+00 TO 5+60
5	PLAN & PROFILE - BAYOU BEND BLVD. STA 5+60 TO 10+80
6	PLAN & PROFILE - BAYOU BEND BLVD. STA 10+80 TO 13+00
7	PLAN & PROFILE - BAYOU BEND COURT STA 0+00 TO 2+81
7A	PLAN & PROFILE - OUTFALL 1
8	UTILITY LAYOUT
9	DETENTION POND LAYOUT AND CROSS SECTIONS
10	DRAINAGE AREA MAP
11	GRADING PLAN
12	CUT AND FILL PLAN
13	SWPPP LAYOUT
14	SWPPP NARRATIVE
15	HYDROLOGICAL CALCULATIONS
16	WINDSTORM DATA 1-1 TO 1-5, 1-6 TO 1-9
17	TRAFFIC CONTROL PLAN - TCP (2-5) - 18
18	PAVEMENT MARKING, STREET SIGN, MAILBOX, AND ROADWAY LIGHTING LAYOUT
18A	HERITAGE TREE SURVEY AND TREE PRESERVATION PLAN

DETAIL SHEETS

19	MISCELLANEOUS DETAILS
20 (SL-03)	STORM SEWER MANHOLE CONSTR. DETAILS
21 (SL-07)	STORM SEWER MANHOLE CONSTR. DETAILS
22 (SL-08)	STORM SEWER INLET CONSTR. DETAILS II
23 (SL-09)	STORM SEWER INLET CONSTR. DETAILS III
24 (SL-10)	STORM SEWER CONSTR. DETAILS
25 (SL-11)	JUNCTION BOX MANHOLES
26 (SL-14)	SANITARY SEWER CONSTR. DETAILS
27 (SL-15)	WATER LINE CONSTR. DETAILS
28 (SL-16)	WATER LINE CROSSING DETAILS
29 (SL-19)	WATER LINE, SAN. SEW. F.M. BEDDING DETAILS
30 (SL-20)	STORM SEW. BEDDING AND BACKFILL DETAILS
31 (SL-21)	CONCRETE PAVEMENT CONSTR. DETAILS
32 (SL-22)	CONCRETE PAVEMENT CONSTR. DETAILS
33 (SL-23)	RESIDENTIAL CURB CONSTR. DETAILS
34 (SL-25)	WHEEL CHAIR RAMP & SIDEWALK DETAILS I
35 (SL-26)	WHEEL CHAIR RAMP & SIDEWALK DETAILS II
36 (SL-27)	DRIVEWAY CONSTR. DETAILS
37 (SL-33)	GENERAL EROSION CONTROL NOTES
38 (SL-34)	EROSION CONTROL DETAILS - 1
39 (SL-35)	EROSION CONTROL DETAILS - 2

RECORD DRAWING

DESIGNED MS				OWNER: Clint Peltier Clint Peltier Custom Homes 979-481-4840	PLAN: _____ PROFILE: _____ HORIZONTAL: _____ VERTICAL: _____	BAYOU BEND ESTATES ANGLETON, TEXAS PLANS FOR GRADING, PAVING, UTILITIES AND DETENTION	TITLE SHEET PROJECT NO. 13454
DRAWN							
CHECKED							
DATE							
NO. DATE DESCRIPTION APPROVED							
REVISIONS							

GENERAL CONSTRUCTION NOTES

1. CONTRACTOR SHALL NOTIFY THE "UNDERGROUND UTILITY COORDINATING COMMITTEE" TELEPHONE NO. (979) 849-4364 AND THE CITY OF ANGLETON TELEPHONE NO. (979) 849-4364 48 HOURS BEFORE STARTING WORK IN STREET RIGHT-OF-WAYS OR EASEMENTS.
2. ALL EXISTING UNDERGROUND UTILITIES ARE NOT GUARANTEED TO BE COMPLETE OR DEFINITE, BUT WERE OBTAINED FROM INFORMATION AVAILABLE. CONTRACTOR HAS SOLE RESPONSIBILITY FOR FIELD VERIFICATION OF ALL EXISTING FACILITIES SHOWN ON DRAWINGS. CONTRACTOR SHALL COORDINATE ALL CONFLICTS WITH THE APPROPRIATE GOVERNING AGENCY, NO SEPARATE PAY.
3. CONTRACTOR SHALL PROVIDE A TRENCH SAFETY SYSTEM TO MEET, AS A MINIMUM, THE REQUIREMENTS OF OSHA SAFETY AND HEALTH REGULATION, PART 1926, SUBPART P AS PUBLISHED IN THE FEDERAL REGISTER, VOLUME 54, NO. 209, DATED OCTOBER 31, 1989.
4. CONTRACTOR SHALL PROVIDE AND INSTALL TRAFFIC CONTROL DEVICES IN CONFORMANCE WITH PART VI OF THE TEXAS MANUAL ON UNIFORM TRAFFIC CONTROL DEVICES (TEXAS MUTCD MOST RECENT EDITION AS REVISED) DURING CONSTRUCTION.
5. CONTRACTOR SHALL COVER OPEN EXCAVATIONS IN PUBLIC STREETS WITH ANCHORED STEEL PLATES DURING NON-WORKING HOURS.
6. ADEQUATE DRAINAGE SHALL BE MAINTAINED AT ALL TIMES DURING CONSTRUCTION, AND IF DRAINAGE DITCH OR STRUCTURE DISTURBED DURING CONSTRUCTION SHALL BE RESTORED TO THE SATISFACTION OF THE OWNING AUTHORITY. ALL CONSTRUCTION STORM RUNOFF SHALL COMPLY WITH THE NATIONAL POLLUTANT DISCHARGE ELIMINATION SYSTEM (NPDES) REQUIREMENTS.
7. EXISTING PAVEMENTS, CURBS, SIDEWALKS, CULVERTS AND DRIVEWAYS (ADJACENT TO THE WORK) DAMAGED OR REMOVED DURING CONSTRUCTION SHALL BE REPLACED TO EQUAL OR BETTER THAN THEIR ORIGINAL CONDITION AT CONTRACTOR EXPENSE.
8. CONDITION OF THE ROAD AND/OR RIGHT-OF-WAY, UPON COMPLETION OF JOB, SHALL BE AS GOOD AS OR BETTER THAN THE CONDITION PRIOR TO STARTING WORK. CONTRACTOR SHALL TAKE NECESSARY ACTIONS TO PROTECT THE EXISTING SURFACES OUTSIDE THE WORK AREA FROM THE EQUIPMENT USED. ALL TRACKED MACHINERY (STREET PADS INCLUDED) SHALL NOT BE OPERATED DIRECTLY ATOP THE PAVEMENT WITHOUT APPROPRIATE PADDING AND PROTECTION OF THE SURFACES. ANY MARKED OR DISTRESSED AREAS SHALL BE REMOVED AND RESTORED WITH NEW MATERIALS TO THE SATISFACTION OF THE ENGINEER. ANY EXISTING DISTRESSED AREAS SHALL BE MADE KNOWN TO THE ENGINEER PRIOR TO OPERATIONS IN THE WORK AREA.
9. ALIGNMENT, CENTERLINE CURVE DATA AND STATIONING TO BE VERIFIED BY ON-THE-GROUND SURVEY FROM APPROVED SUBDIVISION PLAT (OR APPROVED PLOT FOR OFF SITE EASEMENTS), AND ELEVATIONS OF ALL CONNECTIONS TO EXISTING FACILITIES TO BE CONFIRMED PRIOR TO WORK START. CONTRACTOR TO NOTIFY OWNER'S REPRESENTATIVE OF ANY DISCREPANCIES PRIOR TO CONSTRUCTION.
10. CONTRACTOR SHALL GIVE NOTICE TO ALL AUTHORIZED INSPECTORS, SUPERINTENDENTS, OR PERSONS IN CHARGE OF PRIVATE AND PUBLIC UTILITIES AFFECTED BY HIS OPERATIONS PRIOR TO COMMENCEMENT OF WORK.
11. CONTRACTOR SHALL ASSURE HIMSELF THAT ALL CONSTRUCTION PERMITS HAVE BEEN OBTAINED PRIOR TO COMMENCEMENT OF WORK.
12. ALL UTILITY TRENCHES TO BE BACK FILLED TO 90 PERCENT (90%) STANDARD PROCTOR DENSITY UNLESS OTHERWISE NOTED.
13. ALL SURVEY, LAYOUT, MEASUREMENT, AND GRADE STAKE WORK SHALL BE PERFORMED BY BAKER & LAWSON, INC. AS PART OF THE WORK UNDER THIS CONTACT.
14. BAKER & LAWSON, INC. WILL PROVIDE EXPERIENCED INSTRUMENT PERSONNEL, COMPETENT ASSISTANTS, AND SUCH INSTRUMENTS, TOOLS, STAKES, AND OTHER MATERIALS REQUIRED TO COMPLETE THE SURVEY, LAYOUT AND MEASUREMENT WORK.
15. CONSTRUCTION DEBRIS AND OTHER UNCLASSIFIED UNSUITABLE EXCESS MATERIAL SHALL BE HAULED TO A STATE APPROVED DISPOSAL SITE OR AS DIRECTED BY THE ENGINEER. AN EXISTING LANDFILL APPROXIMATELY 10 MILES FROM THE PROJECT SITE IS THE NEAREST STATE APPROVED FEE FACILITY. ALL REFUSE MATERIALS (BROKEN CONCRETE, TREES, ASPHALT, ETC.) SHALL BE DISPOSED OF BY THE CONTRACTOR AT HIS EXPENSE.
16. PLAN QUANTITIES WILL BE USED FOR FINAL PAYMENT UNLESS DESIGN CHANGES ARE MADE DURING CONSTRUCTION.

CONSTRUCTION NOTES FOR PAVING & DRAINAGE

1. GUIDELINES SET FORTH IN THE MANUAL ON UNIFORM CONTROL DEVICES SHALL BE OBSERVED.
2. FILL SHALL BE PLACED IN MAXIMUM 8" LOOSE LIFTS AND COMPACTED TO 95% OF OPTIMUM DENSITY AS DETERMINED USING TESTING METHOD ASTM D698.
3. CONTRACTOR RESPONSIBLE FOR MAINTAINING BARRICADES TO PREVENT TRAFFIC FROM USING NEW PAVEMENT UNTIL PROJECT IS COMPLETED AND ACCEPTED BY PROPER AUTHORITY OR AS AUTHORIZED BY ENGINEER.
4. B-B INDICATES ROAD WIDTH TO BACK OF CURB. CURB RADI ARE TO BACK OF CURB. T.C. INDICATES TOP OF CURB ELEVATIONS (BASED ON 4" CURB UNLESS OTHERWISE NOTED) T.P. INDICATES TOP OF PAVEMENT ELEVATION.
5. TRANSVERSE EXPANSION JOINTS SHALL BE INSTALLED AT MAXIMUM SPACING OF 40-FOOT INTERVALS (SAWCUTS @ 20'(2 1/2"DEEP), LONGITUDINAL JOINTS SHALL BE AT MAXIMUM OF 14-FOOT SPACING. WOOD JOINT SHALL BE SOUND HEART REDWOOD.
6. 6-INCH CONCRETE PAVEMENT TO BE 5.5 SACK MIX MIN. (3,500 PSI) REINFORCING STEEL TO CONFORM TO ASTM A-615, GRADE 60. PROVIDE MINIMUM 18-INCH LAPS. (36 BAR DIA)
7. SAW CUT TO EXPOSE EXISTING LONGITUDINAL STEEL REQUIRED TO CREATE A MINIMUM TWELVE-INCH (12") OVERLAP OF PROPOSED AND EXISTING LONGITUDINAL REINFORCING STEEL WHEN MAKING A CONNECTION TO EXISTING CONCRETE PAVEMENT. WHERE SPACING OF EXISTING LONGITUDINAL STEEL DIFFERS FROM PROPOSED STEEL SPACING, NOTIFY THE ENGINEER.
8. USE PLASTIC CHAIRS TO SUPPORT REINFORCEMENT AT 24-INCH SPACING EACH WAY.
9. SUBGRADE TO BE STABILIZED 2-FOOT BACK OF PROPOSED CURB OR EDGE OF PAVEMENT. EXCESS LIME STABILIZED SOIL SHALL BE UTILIZED IN THE PREPARATION OF SUBGRADE FOR DRIVEWAYS. THIS WORK SHALL BE CONSIDERED INCIDENTAL TO THE ASSOCIATED CONCRETE PAVEMENTS. SUBGRADE PREPARATION FOR DRIVEWAYS AND PAVING SHALL INCLUDE PROOF ROLLING. SOFT AREAS TO BE EXCAVATED AND RECOMPACTED TO ADJACENT SOIL DENSITY.
10. USE CONTINUOUS LONGITUDINAL REINFORCING BAR IN CURB.
11. BACK FILL AND BEDDING FOR HEADWALL STRUCTURES, TYPE "C" INLETS, R.C.P. LEADS, SANITARY SEWER LEADS, AND STORM SEWERS SHALL BE WITH 1.5 SACK CEMENT STABILIZED SAND SHALL BE COMPACTED TO A DENSITY OF AT LEAST 90% OF DENSITY DETERMINED BY STANDARD MOISTURE-DENSITY RELATION (ASTM D-698) AT OPTIMUM MOISTURE AND SHALL BE PLACED AND FINISHED WITHIN 3 HRS. OF MIXING. TEMPORARY TRAVEL WAY SURFACE SHALL BE WITH CEMENT STABILIZED LIMESTONE. PAYMENT FOR THESE ITEMS SHALL BE SUBSIDIARY TO THE VARIOUS STRUCTURAL BID ITEMS. VERIFICATION OF CEMENT STABILIZED SAND MIXTURE SHALL BE FURNISHED UPON REQUEST OF ENGINEER.
12. THE SUBGRADE SHALL BE BROUGHT TO THE REQUIRED GRADE BY THE USE OF GRADE STAKES (BLUE TOPS AND AT 50 FT MAX SPACING O.C.) AND APPROVED BY THE ENGINEER BEFORE LIME IS APPLIED.

13. RATE OF APPLICATION FOR LIME SHALL BE SEVEN PERCENT (7%) OF THE DRY WEIGHT OF SOIL (QUALITY BASE ON 100 #/ C.F.) OR THIRTY ONE AND ONE HALF (31.5) POUNDS PER SQUARE YARD FOR SIX (6) INCH STABILIZED SUBGRADE. LIME STABILIZED SUBGRADE SHALL NOT BE MIXED MORE THAN ONE INCH IN EXCESS OF THE REQUIRED DEPTH. WATER SHALL BE ADDED TO THE LIME STABILIZED SUBGRADE AND SHALL BE BROUGHT TO THE OPTIMUM MOISTURE CONTENT DURING THE FIRST MIXING OPERATIONS. LIME STABILIZED SHALL BE KEPT MOIST AND LEFT TO CURE FOR TWO CURING DAYS BEFORE FINAL MIXING CAN BEGIN. AFTER FINAL MIXING IS COMPLETE AND BEFORE SOIL DENSITY TESTS ARE TAKEN, LIME STABILIZED SUBGRADE SHALL BE BROUGHT TO THE REQUIRED GRADE BY THE USE OF GRADE STAKES (BLUE TOPS) AND APPROVED BY THE ENGINEER. DENSITY SHALL BE NINETY-FIVE PERCENT (95%) OF THE STANDARD PROCTOR DENSITY AT OPTIMUM MOISTURE. TESTED AND COMPLETED SECTIONS SHALL BE KEPT MOIST CURED ON A DAILY BASIS WITH WATER TRUCKS OR SUBSTANTIAL SUPPLY HOSES FOR THE ENTIRE PERIOD THE SURFACE REMAINS UNCOVERED WITH ADDITIONAL COURSES. AFTER FINAL TESTING AND APPROVAL IS COMPLETE, TRACK EQUIPMENT, SCRAPERS AND OTHER HEAVY EQUIPMENT WILL NOT BE PERMITTED ON THE COMPLETED LIME STABILIZED AREA. LIGHT MOTOR GRADERS, RUBBER Tired TRACTORS, WATER TRUCKS AND ROLLERS USED IN THE FINISHING OPERATIONS SHALL BE PERMITTED WITH THE APPROVAL OF THE ENGINEER. CONCRETE AND LOADED HAUL TRUCKS ARE STRICTLY PROHIBITED ON COMPLETED AREAS UNLESS THE TRAVELED AREA REGARDLESS OF CONDITION IS REMIXED COMPACTED AND TESTED FOR APPROVAL A SECOND TIME.
14. FORMS SHALL BE EITHER WOOD OR STEEL, OF GOOD QUALITY, FREE OF WARP AND SUFFICIENTLY STAKED TO AVOID SHIFTING WHEN LOAD IS APPLIED. ALL REDWOOD EXPANSION BOARDS SHALL BE STAKED WITH 1X2 REDWOOD STAKES AND ALLOWED TO REMAIN WITHIN THE POUR. METAL STAKES ARE APPROVED FOR USE TO STAKE METAL KEYS.
15. REINFORCING SHALL BE SECURELY TIED AT ALL INTERSECTIONS AND SPLICES. ALL DOWELS SHALL BE SECURELY TIED. REINFORCEMENT SHALL BE CLEAN AND FREE OF RUST AT TIME OF USE. PLASTIC CHAIR OF THE CORRECT HEIGHT SHALL BE USED. SPACING SHALL BE SUFFICIENT TO SUPPORT REINFORCEMENT.
16. PRIOR TO CONCRETE PLACEMENT, CONTRACTOR SHALL PRESENT A CERTIFIED COPY OF TOP OF FORM GRADES TO THE ENGINEER FOR REVIEW AND APPROVAL. ELEVATIONS OF FORMS SHALL BE RECORDED AT 10' INTERVALS. ADJUSTMENTS TO FORMS SHALL BE COMPLETE 4 HRS. PRIOR TO CONCRETE PLACEMENT.
17. CONCRETE FOR STREET PAVEMENTS SHALL BE "CLASS A" CONCRETE, SHALL NOT HAVE LESS THAN FIVE AND ONE HALF (5 1/2) SACKS OF CEMENT PER CUBIC YARD, AND SHALL NOT HAVE MORE THAN SIX AND ONE HALF (6 1/2) GALLONS OF WATER PER SACK OF CEMENT. SLUMP SHALL NOT EXCEED FIVE (5) INCHES AND SHALL DEVELOP A MODULUS OF RUPTURE STRENGTH OF THREE THOUSAND FIVE HUNDRED (3500) P.S.I. AT TWENTY EIGHT (28) DAYS. CONCRETE SHALL BE PLACED IN SUCH A MANNER AS TO REQUIRE AS LITTLE HANDLING POSSIBLE. USE OF AN APPROVED VIBRATING SCREED WILL BE REQUIRED. AT INTERSECTIONS AND SMALL AREAS WHERE A VIBRATORY SCREED CAN NOT BE USED, A HAND VIBRATOR OR "JITTERBUG" SHALL BE USED. USE OF A TEN FOOT (10') CONCRETE PAVEMENT STRAIGHT EDGE WILL ALSO BE REQUIRED. ALL EXPOSED JOINTS SHALL BE EDGED AS NOTED ON DETAILS. SURFACE SHALL BE TYPICALLY A BELT FINISH OR BROOM FINISH (COARSE, MEDIUM OR LIGHT) AS REQUIRED BY THE APPLICATION AND DIRECTED BY THE ENGINEER.
18. FLY ASH SHALL MAKE UP FROM 20-25% BY VOLUME OF THE SPECIFIED CEMENT VOLUME AND SHALL CONFORM TO ASTM C 618, CLASS C.
19. CURING COMPOUND SHALL BE TYPE II WITH WHITE PIGMENT. APPLIED AT THE UNDLUTED RATE OF ONE GALLON PER TWO HUNDRED (200) SQUARE FEET.
20. EXPANSION JOINTS SHALL BE BLAST CLEANED, WIRE BRUSHED, BLOWN OR FLAME DRIED SEALED WITH AN APPROVED LIST RUBBERIZED HOT LAID ASPHALT JOINT AND CRACK SEALANT OR A TWO (2) COMPONENT POLYMERIC SELF LEVELING COLD APPLIED SEALANT.

21. CONTRACTOR WILL NOT PERMIT TRAFFIC ON NEW CONCRETE PAVEMENT UNTIL BOTH A MINIMUM OF SEVEN (7) CURING DAYS AND MODULUS OF RUPTURE STRENGTH OF THREE THOUSAND FIVE HUNDRED (3500) P.S.I. TAKES PLACE OR AS APPROVED BY THE ENGINEER/PUBLIC WORKS DEPARTMENT.
22. CONCRETE FOR CURB SHALL BE A 3000 P.S.I. PERFORMANCE STRENGTH CONCRETE WITH A MINIMUM FIVE (5) SACK CEMENT PER CUBIC YARD CONTENT. CURB CONCRETE MIX MAY BE A SMALL AGGREGATE BATCH DESIGN.
23. A CONCRETE MIX DESIGN OF CONCRETE PLUS FLY ASH MAY BE SUBSTITUTED IN LIEU OF THE STANDARD CONCRETE BATCH DESIGN. THE FLY ASH SHALL CONFORM TO THE REQUIREMENTS OF TxDOT MATERIAL SPECIFICATION D-9-8900, AND SHALL NOT EXCEED 25% BY ABSOLUTE VOLUME OF THE SPECIFIED CEMENT CONTENT. THE MODULUS OF RUPTURE STRENGTHS MINIMUMS AND DEVELOPMENT PERIOD OF THE STANDARD CONCRETE MIX DESIGN SHALL REMAIN IN EFFECT AND SHALL BE VERIFIED. CONCRETE BATCH MIX DESIGN PREPARED AND TESTED BY A GEOTECHNICAL LAB AND SUBMITTED FOR REVIEW AND APPROVAL BY THE CITY ENGINEERING/PUBLIC WORKS DEPARTMENT PRIOR TO PAVING OPERATIONS.
24. ALL PAVEMENT SAW CUT REQUIRED IN THE PLANS SHALL BE CONSIDERED SUBSIDIARY TO THE PAVING REMOVAL PAY ITEM REQUIRING IT.
25. BLOCK SOD SHALL BE PLACED 16" (ONE BLOCK WIDTH) WIDE ALONG THE EDGE OF ALL NEWLY CONSTRUCTED CURBS AND TO DRIVEWAY REPLACEMENT LIMITS. SILT FENCING MAY BE PLACED DIRECTLY BEHIND CURBS IN LIEU OF SOD.
26. THE CONTRACTOR WILL BE RESPONSIBLE FOR ANALYZING WEATHER CONDITIONS AND TO SUSPEND OPERATIONS DURING PERIODS WHEN ADVERSE WEATHER CONDITIONS APPEAR LIKELY. NO CONCRETE SHALL BE PLACED WHEN THE TEMPERATURE IS 35°F AND RISING, HOWEVER, NO CONCRETE SHALL BE PLACED WHEN THE CONCRETE TEMPERATURE IS ABOVE 100°F. THE CONTRACTOR SHALL KEEP SUFFICIENT LENGTH OF COVERING MATERIAL ON THE JOB SITE TO PLACE OVER AND PROTECT THE SURFACE OF "FRESH" CONCRETE DURING PERIODS OF UNPREDICTED RAINS.

WASTEWATER CONSTRUCTION NOTES

1. CONTRACTOR SHALL PROVIDE RECORD OF LOCATION OF ALL STACKS, STUBS, LEADS, ETC. TO CITY OF ANGLETON.
2. SEPARATION DISTANCES FOR ALL SANITARY SEWER AND WATER MAIN CONSTRUCTION SHALL BE GOVERNED BY THE "TEXAS NATURAL RESOURCE CONSERVATION COMMISSION RULES AND REGULATIONS FOR DESIGN CRITERIA FOR SEWAGE SYSTEMS," SECTION 317.20," LATEST PRINTING.
3. MAINTAIN 12-INCH MINIMUM VERTICAL CLEARANCE AT CROSSINGS BETWEEN SANITARY SEWERS AND CULVERTS, UNLESS OTHERWISE NOTED.
4. WHERE SANITARY SEWER LINE CROSSES A WATER LINE WITH LESS THAN 9- FEET BUT MORE THAN 6-INCHES VERTICAL SEPARATION, PROVIDE ONE MINIMUM 18-FOOT JOINT OF PRESSURE RATED P.V.C. SANITARY SEWER (ASTM D2241, CLASS 150, SDR 26) CENTERED ON WATER LINE. INCLUDE COST OF WATER LINE CROSSING IN UNIT PRICE BID PER LINEAR FOOT FOR SANITARY SEWER IN APPROPRIATE SIZES.
5. CONTRACTOR TO NOTIFY OWNER'S REPRESENTATIVE UPON ENCOUNTERING ANY UNSUITABLE TRENCH CONDITIONS.
6. SANITARY SEWER LEADS UNDER OR WITHIN 1' OF EXISTING OR FUTURE PAVEMENT SHALL BE BACK FILLED WITH CEMENT STABILIZED SAND UP TO WITHIN 1' OF TOP OF PAVING SUBGRADE. CEMENT STABILIZED SAND BACK FILL FOR LEADS SHALL BE INCLUDED IN THE BID UNIT PRICE FOR LEADS. SANITARY SEWER LEADS LESS THAN 2 FT BELOW PAVING TO BE INSTALLED AFTER LIME STABILIZATION IS COMPLETE. SANITARY SEWER LEADS TO BE BEDDED AND BACKFILLED TO TOP OF SUBGRADE WITH COMPACTED CEMENT STABILIZED SAND.
- 7.

LOW PRESSURE AIR TEST SHALL BE CONDUCTED PER TNRCC TAC 317.2. HOLDING TIMES SHALL BE AS ESTABLISHED BY TNRCC. CONTRACTOR TO PROVIDE TEST PLUGS AND RISERS. NO SEPARATE PAY.

8. CONTRACTOR TO OPEN CUT ALL SANITARY SEWER CONSTRUCTION UNLESS NOTE OTHER WISE, SEWER SERVICES TO BE INSTALLED FULL WIDTH OF ROADWAY.-NO HALF STREET INSTALLATIONS.
9. CONTRACTOR SHALL AT ALL TIMES PROVIDE MAXIMUM UNINTERRUPTED SERVICE AND SHALL AVAIL OF ANY ROUTING METHOD AND EQUIPMENT TO ACCOMPLISH THIS.
10. ALL SINGLE AND DOUBLE SERVICE LEAD SHALL BE A MINIMUM SIX INCH (6") UNLESS OTHERWISE DIRECTED BY THE ENGINEER/PUBLIC WORKS AND/OR FIELD ADJUSTED BY THE UTILITY DEPARTMENT IN THE FUTURE.
- WATER CONSTRUCTION NOTES**
1. CONTRACTOR SHALL PROVIDE ADEQUATE THRUST BLOCKING TO WITHSTAND TEST PRESSURE AS SPECIFIED IN CONTRACT DOCUMENTS. THRUST BLOCKING SHALL BE CLASS "B" CONCRETE 2500 P.S.I. AND SHALL BE SUBSIDIARY TO THE BID ITEM PERTINENT TO ITS USE. ALL CEMENT STABILIZED SAND BACKFILL SHALL BE 1.5 SK/CY CEMENT CONTENT. ALL M.J. D.I. FITTINGS WILL HAVE M.J. RESTRAINTS (STARGRIP OR EQUAL) WRAP FITTINGS & RESTRAINTS WITH 10 MIL POLY.
2. SEPARATION DISTANCES OF ALL WATER MAIN AND SANITARY SEWER MAIN CONSTRUCTION SHALL BE GOVERNED BY THE "TEXAS NATURAL RESOURCE CONSERVATION COMMISSION RULES AND REGULATIONS FOR DESIGN CRITERIA FOR SEWAGE SYSTEMS," SECTION 317.20, LATEST PRINTING.
3. ALL 4" THROUGH 12" WATER MAINS TO BE P.V.C. PIPE, AWWA C-900, CLASS 150, SDR 18, MEETING THE REQUIREMENTS OF ANS/NSF 61 UNLESS OTHERWISE NOTED.
4. WATER LINES UNDER OR WITHIN 1 FEET OF NEW OR EXISTING PAVEMENTS (STREETS AND DRIVEWAYS) SHALL BE BACK FILLED WITH CEMENT STABILIZED SAND AS SPECIFIED IN THE CONSTRUCTION DETAIL. TYPICAL BEDDING AND BACKFILL TO BE 6" MECHANICALLY COMPACTED BANK SAND. PROVIDE UNIFORM GRADE FOR BEDDING TO PROVIDE FULL BEDDING OF WATER LINE.
5. PROVIDE A MINIMUM SIX-INCHES (6") OF CLEARANCE AT STORM SEWER AND WATER LINE CROSSINGS.
6. 4-INCH THROUGH 12-INCH LINES TO HAVE A MINIMUM OF 4"-0" COVER BELOW TOP OF CURB. UNLESS OTHERWISE NOTED, VARY FLOW LINE UNIFORMLY FROM DEPTH SHOWN ON PLANS.
7. CENTERLINE OF FIRE HYDRANT TO BE LOCATED AT 3' FROM BACK OF CURB WITH CENTERLINE OF STEAMER NOZZLE 22 INCHES ABOVE FINISHED GRADE. TURN STEAMER OUTLET TO FACE STREET. PROVIDE 4" X 16" X 16" PRECAST CONC PAD BLOCK UNDER FIRE HYDRANT. INSTALL 2 C.F. PEA GRAVEL AROUND WEEP HOLES OF FIRE HYDRANT
8. WHERE WATER LINE CROSSES SANITARY SEWER LINE OR LEAD WITH LESS THAN NINE FEET (9') VERTICAL SEPARATION, PROVIDE ONE MINIMUM 18-FOOT STEEL CASING OVER THE WATER LINE CENTERED ON SANITARY MAIN. BID STEEL CASINGS AS A SEPARATE LINE LINE PER CROSSING.
9. THE CONTRACTOR AT ALL TIMES PROVIDE MAXIMUM UNINTERRUPTED FLOW TO ALL SERVICES AND MAINS AND SHALL AVAIL OF ANY ROUTING METHOD AND EQUIPMENT TO ACCOMPLISH THIS.

CENTERPOINT ENERGY / ENTEX NOTES

CAUTION: UNDERGROUND GAS FACILITIES

LOCATIONS OF CENTERPOINT ENERGY MAIN LINES (TO INCLUDE CENTERPOINT ENERGY, INTRASTATE PIPELINE, L.C. WHERE APPLICABLE) ARE SHOWN IN AN APPROXIMATE LOCATION ONLY. SERVICE LINES ARE NOT USUALLY SHOWN. OUR SIGNATURE ON THESE PLANS ONLY INDICATES THAT OUR FACILITIES ARE SHOWN IN APPROXIMATE LOCATION. IT DOES NOT IMPLY THAT A CONFLICT ANALYSIS HAS BEEN MADE. THE CONTRACTOR SHALL CONTACT THE UTILITY COORDINATING COMMITTEE AT (979) 849-4364 OR 811, A MINIMUM OF 48 HOURS PRIOR TO CONSTRUCTION TO HAVE MAIN AND SERVICE LINES FIELD LOCATED.

- * WHEN CENTERPOINT ENERGY PIPE LINE MARKINGS ARE NOT VISIBLE, CALL (800) 752-8036 OR (713) 659-2111 (7:00 A.M. TO 4:30 P.M.) FOR STATUS OF LINE LOCATION REQUEST BEFORE EXCAVATION BEGINS.
- * WHEN EXCAVATING WITHIN EIGHTEEN INCHES (18") OF THE INDICATED LOCATION OF CENTERPOINT ENERGY FACILITIES, ALL EXCAVATION MUST BE ACCOMPLISHED USING NON-MECHANIZED EXCAVATION PROCEDURES.
- * WHEN CENTERPOINT ENERGY FACILITIES ARE EXPOSED, SUFFICIENT SUPPORT MUST BE PROVIDED TO THE FACILITIES TO PREVENT EXCESSIVE STRESS ON THE PIPING.
- * FOR EMERGENCIES REGARDING GAS LINES CALL (800) 659-2111 OR (713) 659-2111.

THE CONTRACTOR IS FULLY RESPONSIBLE FOR ANY DAMAGES CAUSED BY HIS FAILURE TO EXACTLY LOCATE AND PRESERVE THESE UNDERGROUND FACILITIES.

ACTIVITIES ON OR ACROSS CENTERPOINT ENERGY FEE OR EASEMENT PROPERTY NO APPROVAL TO USE, CROSS OR OCCUPY CENTERPOINT FEE OR EASEMENT PROPERTY IS GIVEN, IF YOU NEED TO USE CENTERPOINT PROPERTY, PLEASE CONTACT OUR SURVEYING & RIGHT OF WAY DIVISION AT (713) 207-5769.

WARNING: OVERHEAD ELECTRICAL FACILITIES

OVERHEAD LINES MAY EXIST ON THE PROPERTY. WE HAVE NOT ATTEMPTED TO MARK THOSE LINES SINCE THEY ARE CLEARLY VISIBLE, BUT YOU SHOULD LOCATE THEM PRIOR TO BEGINNING ANY CONSTRUCTION. TEXAS LAW, SECTION 752, HEALTH & SAFETY CODE, FORBIDS ALL ACTIVITIES IN WHICH PERSONS OR THINGS MAY COME WITHIN SIX (6) FEET OF LIVE OVERHEAD HIGH VOLTAGE LINES. PARTIES RESPONSIBLE FOR THE WORK, INCLUDING CONTRACTORS, ARE LEGALLY RESPONSIBLE FOR THE SAFETY OF CONSTRUCTION WORKERS UNDER THIS LAW. THIS LAW CARRIES BOTH CRIMINAL AND CIVIL LIABILITY. TO ARRANGE FOR LINES TO BE TURNED OFF OR REMOVED CALL TEXAS NEW MEXICO POWER AT (979) 345-5667.

SBC NOTES

THE LOCATIONS OF SOUTHWESTERN BELL TELEPHONE CO. UTILITIES ARE SHOWN IN AN APPROXIMATE WAY ONLY. THE CONTRACTOR SHALL DETERMINE THE EXACT LOCATION BEFORE COMMENCING WORK. HE AGREES TO BE FULLY RESPONSIBLE FOR ANY AND ALL DAMAGES WHICH MIGHT BE OCCASIONED BY HIS FAILURE TO EXACTLY LOCATE AND PRESERVE THESE UNDERGROUND UTILITIES.

TEXAS NEW MEXICO POWER NOTES

OVERHEAD LINES MAY EXIST ON THE PROPERTY. WE HAVE NOT ATTEMPTED TO MARK THOSE LINES SINCE THEY ARE CLEARLY VISIBLE, BUT YOU SHOULD LOCATE THEM PRIOR TO BEGINNING ANY CONSTRUCTION. TEXAS LAW, SECTION 752, HEALTH & SAFETY CODE FORBIDS ALL ACTIVITIES IN WHICH PERSONS OR THINGS MAY COME WITHIN SIX (6) FEET OF LIVE OVERHEAD HIGH VOLTAGE LINES. PARTIES RESPONSIBLE FOR THE WORK, INCLUDING CONTRACTORS, ARE LEGALLY RESPONSIBLE FOR THE SAFETY OF CONSTRUCTION WORKERS UNDER THIS LAW. THIS LAW CARRIES BOTH CRIMINAL AND CIVIL LIABILITY. TO ARRANGE FOR LINES TO BE TURNED OFF OR REMOVED CALL TEXAS NEW MEXICO POWER AT (979) 345-5667.

GENERAL CONSTRUCTION NOTES

1. ALL CONSTRUCTION SHALL BE IN ACCORDANCE WITH THE ANGLETON CONSTRUCTION MANUAL (ACM) AND LAND DEVELOPMENT CODE, HEREAFTER REFERRED TO THE ACM AND THE LDC.
2. APPROVAL OF THESE CONSTRUCTION PLANS DOES NOT CONSTITUTE A VERIFICATION OF ALL DATA, INFORMATION AND CALCULATIONS SUPPLIED BY THE APPLICANT. THE ENGINEER OF RECORD IS SOLELY RESPONSIBLE FOR THE COMPLETENESS, ACCURACY, ADEQUACY, AND COMPLIANCE OF THE SUBMITTED PLANS.
3. ALL RESPONSIBILITY FOR DESIGN RESTS ON ENGINEER WHO PREPARED THEM, IN APPROVING THESE PLANS, THE CITY MUST RELY ON THE ADEQUACY AND ACCURACY OF THE DESIGN ENGINEER.
4. DESIGNS SHALL BE IN COMPLETE COMPLIANCE WITH THE LDC AND THE ACM. ANY WAIVER, DEVIATION, VARIANCE, OR EXCEPTION FROM ANY SPECIFIC REQUIREMENT(S) OF THE LDC OR ACM THAT WERE NOT EXPRESSLY REQUESTED WHEN PLANS ARE SUBMITTED, SHALL NOT BE CONSTRUED TO HAVE BEEN GRANTED IF PLANS ARE APPROVED. IT IS THE RESPONSIBILITY OF THE ENGINEER TO MAKE SUCH A WAIVER PROACTIVELY WHEN PLANS ARE SUBMITTED.
5. A MINIMUM OF TWO EXISTING BENCHMARKS SHOULD BE SHOWN ON THE PLANS. IN ADDITION, TWO PERMANENT BENCHMARKS PER SUBDIVISION SHALL BE INSTALLED IN EACH NEW SUBDIVISION TO INCLUDE DESCRIPTION, LOCATION, AND ELEVATION AND TIE TO CITY STANDARDS.
6. CAST BRONZE SURVEY MARKERS SHALL BE PLACED IN CONCRETE IN PERMANENT, ACCESSIBLE LOCATIONS AT THE TIME OF CONSTRUCTION. THE LOCATIONS OF THE MARKERS SHALL BE INDICATED ON THE CONSTRUCTION PLANS. A MINIMUM OF ONE MARKER SHALL BE PLACED FOR EACH 20 ACRES OF THE PROJECT.
7. PRIOR TO BEGINNING CONSTRUCTION, THE OWNER OR HIS AUTHORIZED REPRESENTATIVE SHALL CONVEY A PRE-CONSTRUCTION CONFERENCE WITH THE CITY, THE DEVELOPER'S CONSULTING ENGINEER, CONTRACTOR, AND ANY OTHER AFFECTED PARTIES. THE CITY SHALL BE NOTIFIED AT LEAST 48 HOURS PRIOR TO THE TIME OF THE CONFERENCE AND 48 HOURS PRIOR TO THE BEGINNING OF CONSTRUCTION.
8. THE CONTRACTOR SHALL PROVIDE THE CITY A MINIMUM OF 48 HOURS NOTICE BEFORE BEGINNING EACH PHASE OF CONSTRUCTION.
9. BARRICADES, BUILT TO CITY SPECIFICATIONS, SHALL BE CONSTRUCTED ON ALL DEAD-END STREETS AND AS NECESSARY DURING CONSTRUCTION TO MAINTAIN JOB SAFETY.
10. IF BLASTING IS PLANNED, A BLASTING PERMIT MUST BE SECURED PRIOR TO COMMENCEMENT OF ANY BLASTING.
11. ANY EXISTING PAVEMENT, CURBS, AND/OR SIDEWALKS DAMAGED OR REMOVED WILL BE REPAIRED BY THE CONTRACTOR AT HIS EXPENSE BEFORE ACCEPTANCE OF THE SUBDIVISION.
12. THE LOCATION OF ANY WATER OR WASTEWATER LINES SHOWN ON THE PLANS MUST BE VERIFIED BY THE PUBLIC WORKS DEPARTMENT.
13. USE ONE CALL UTILITY SYSTEM: DIAL 1-800-344-8377, 48 HOURS BEFORE YOU DIG.
14. ALL STORM SEWER PIPES TO BE CLASS III RCP UNLESS NOTED OTHERWISE. SPECIAL NOTES FOR PLANS, WHEN APPLICABLE.
15. CONSTRUCTED STREET SECTIONS SHALL SHOW THE FOLLOWING:
- a. PROVIDE STREET NAMES, WIDTH OF R.O.W., OR OTHER METHODS TO IDENTIFY PROPOSED DESIGN OF DIFFERENT PAVEMENT THICKNESS. IN WRITING OR GRAPHICALLY, DESCRIBE THE STREET SECTION(S) TO BE CONSTRUCTED.
 - b. MANHOLE FRAMES, COVERS, AND WATER VALVE COVERS WILL BE RAISED TO FINISHED PAVEMENT GRADE AT THE OWNER'S EXPENSE BY A QUALIFIED CONTRACTOR WITH CITY INSPECTION. ALL UTILITY ADJUSTMENTS SHALL BE COMPLETED PRIOR TO FINAL PAVING CONSTRUCTION.
 - c. CROWNS OF INTERSECTING STREETS WILL CULMINATE IN A DISTANCE OF 40 FEET FROM THE INTERSECTING CURB LINE UNLESS OTHERWISE NOTED. INLETS ON THE INTERSECTING STREET SHALL NOT BE CONSTRUCTED WITHIN 40 FEET OF THE VALLEY GUTTER, UNLESS OTHERWISE NOTED.
 - d. PRIOR TO FINAL ACCEPTANCE OF A STREET OUTSIDE THE CITY LIMITS, STREET NAME SIGNS CONFORMING TO COUNTY STANDARDS SHALL BE INSTALLED BY DEVELOPER.
 - e. SIDEWALK REQUIREMENTS (GIVE STREET NAME AND LOCATION OF REQUIRED SIDEWALK, I.E., NORTH, SOUTH, EAST, OR WEST SIDE).
 - f. A CURB LAY DOWN WHERE REQUIRED WHEN ALL POINTS OF SIDEWALKS INTERSECTS CURBS.
 - g. INSIDE THE CITY LIMITS, SIDEWALKS SHALL BE COMPLETED PRIOR TO ACCEPTANCE OF ANY DRIVEWAY APPROACHES AND/OR ISSUANCE OF A CERTIFICATE OF OCCUPANCY. WHEN OUTSIDE THE CITY LIMITS, A LETTER OF CREDIT MAY BE POSTED OR OTHER SUITABLE FINANCIAL ARRANGEMENTS MAY BE MADE TO ENSURE CONSTRUCTION OF THE SIDEWALKS. IN EITHER CASE, SIDEWALKS ADJACENT TO "COMMON AREAS", PARKWAYS, OR OTHER LOCATIONS ON WHICH NO BUILDING CONSTRUCTION WILL TAKE PLACE, MUST BE CONSTRUCTED PRIOR TO FINAL ACCEPTANCE OF THE SUBDIVISION.
 - h. A LICENSE AGREEMENT FOR LANDSCAPING MAINTENANCE AND IRRIGATION IN STREET R.O.W. SHALL BE EXECUTED BY THE DEVELOPER IN PARTY WITH THE CITY PRIOR TO FINAL ACCEPTANCE.
17. CALL THE CITY 48 HOURS PRIOR TO BEGINNING ANY WORK AND SCHEDULE A PRE-CONSTRUCTION MEETING WITH THE CITY AND ALL AFFECTED UTILITY PROVIDERS, THE GENERAL CONTRACTOR, THE DEVELOPER AND THE DEVELOPER'S ENGINEER.

CONSTRUCTION SEQUENCING

CALL THE CITY 48 HOURS PRIOR TO BEGINNING ANY WORK AND SCHEDULE A PRE-CONSTRUCTION MEETING WITH THE CITY AND ALL AFFECTED UTILITY PROVIDERS, THE GENERAL CONTRACTOR, THE DEVELOPER AND THE DEVELOPER'S ENGINEER.

OBTAIN A DEVELOPMENT PERMIT FROM THE CITY.

PROVIDE THE CITY WITH EVIDENCE ALL TCEQ LICENSES AND REQUIREMENTS ARE UP TO DATE.

INSTALL TEMPORARY EROSION CONTROLS AND TREE PROTECTION FENCING PRIOR TO ANY CLEARING AND GRUBBING. NOTIFY THE CITY WHEN INSTALLED.

ROUGH-CUT ALL REQUIRED OR NECESSARY PONDS. EITHER THE PERMANENT OUTLET STRUCTURE OR EXCAVATION THAT LEADS TO PONDING CONDITIONS. THE OUTLET SYSTEM MUST CONSIST OF A LOW-LEVEL OUTLET AND AN EMERGENCY OVERFLOW MEETING THE REQUIREMENTS OF THE LDC. THE OUTLET SYSTEM SHALL BE PROTECTED FROM EROSION AND SHALL BE MAINTAINED THROUGHOUT THE COURSE OF CONSTRUCTION UNTIL FINAL RESTORATION IS ACHIEVED.

DELIVER APPROVED ROUGH-CUT SHEETS TO THE CITY ENGINEER PRIOR TO CLEARING AND GRUBBING.

ROUGH GRADE STREETS. NO DEVELOPMENT OF EMBANKMENT WILL BE PERMITTED AT THIS TIME.

INSTALL ALL UTILITIES TO BE LOCATED UNDER THE PROPOSED PAVEMENT OR WITHIN THE ROAD RIGHT-OF-WAY.

DELIVER STORM SEWER CUT SHEETS TO THE CITY ENGINEER.

BEGIN INSTALLATION OF STORM SEWER LINES. UPON COMPLETION, RESTORE AS MUCH DISTURBED AREAS AS POSSIBLE, PARTICULARLY CHANNELS AND LARGE OPEN AREAS.

DELIVER FINAL GRADE CUT SHEETS TO THE CITY ENGINEER.

RE-GRADE STREETS TO SUB-GRADE.

ENSURE THAT UNDERGROUND UTILITY CROSSINGS ARE COMPLETED. LAY 1ST/ COURSE BASE MATERIAL ON STREETS.

INSTALL CURB AND GUTTER

LAY FINAL BASE COURSE ON ALL STREETS.

PLACE CONCRETE.

COMPLETE FINAL GRADING AND RESTORATION OF DETENTION, SEDIMENTATION/FILTRATION PONDS.

COMPLETE PERMANENT EROSION CONTROL AND RESTORATION OF SITE VEGETATION.



REMOVE AND DISPOSE OF TEMPORARY EROSION CONTROLS.

COMPLETE ANY NECESSARY FINAL DRESS UP OF AREAS DISTURBED.

RECORD DRAWING

NO.	DATE	DESCRIPTION	APPROVED
REVISIONS			

DESIGNED MS
DRAWN
CHECKED
DATE

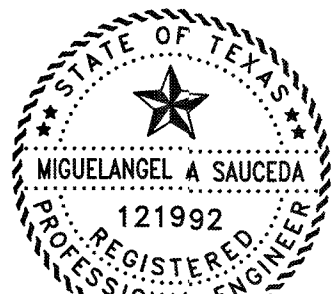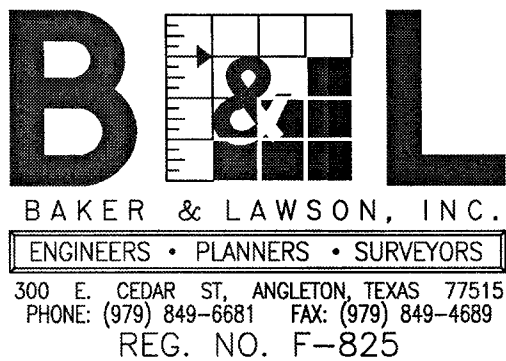




The seal appearing on this document was authorized by Miguel Saucedo P.E. 121992
Date: 1/11/22

OWNER:
Clint Peltier
Clint Peltier Custom Homes
979-481-4840

PLAN:
PROFILE:
HORIZONTAL:
VERTICAL:

BAYOU BEND ESTATES
ANGLETON, TEXAS
PLANS FOR
GRADING, PAVING, UTILITIES
AND DETENTION

CONSTRUCTION NOTES

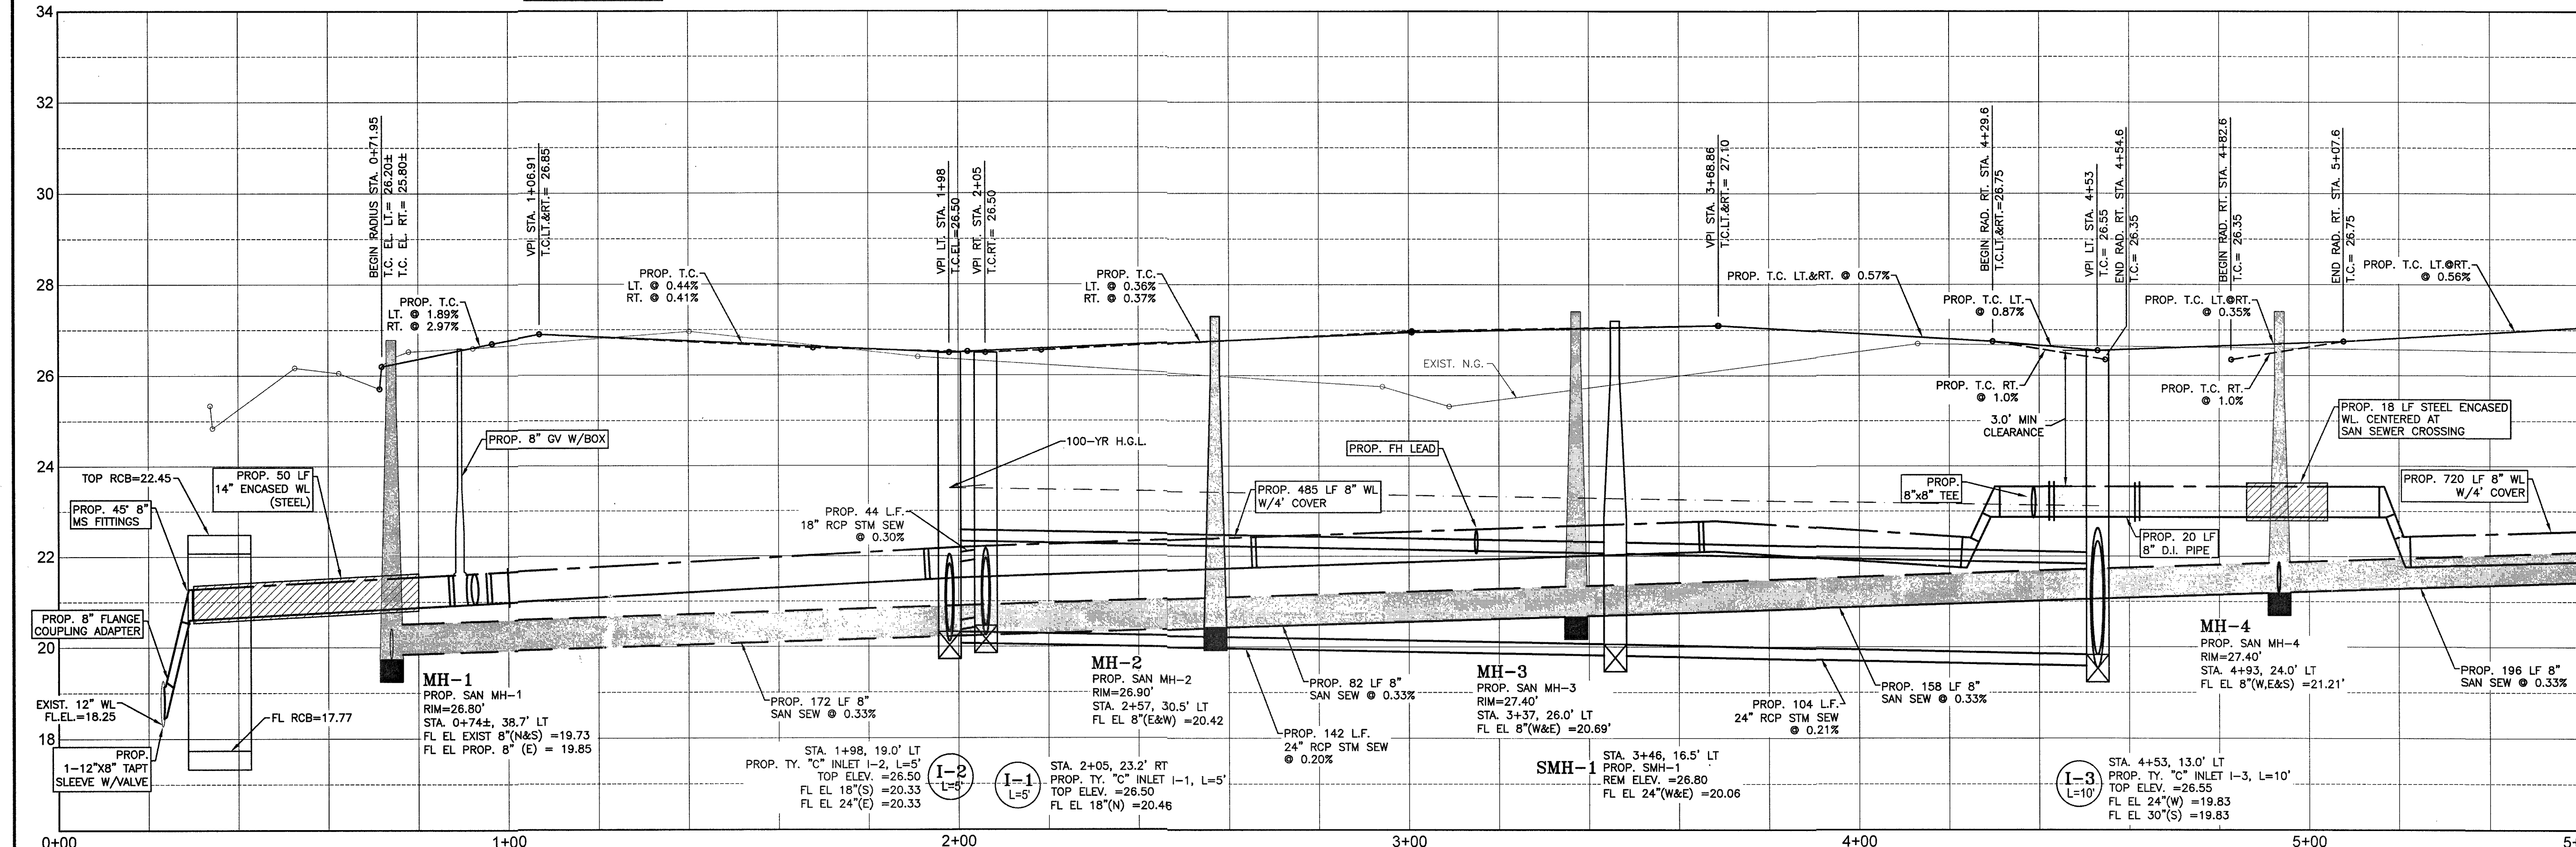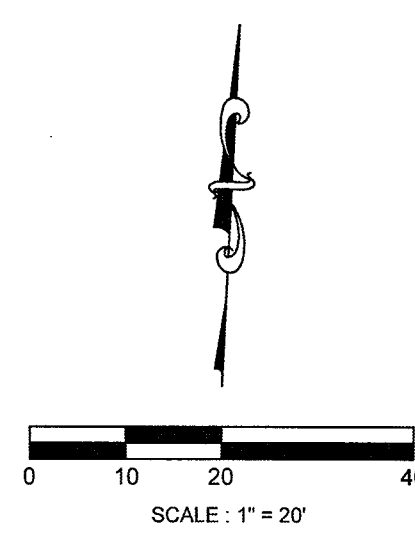
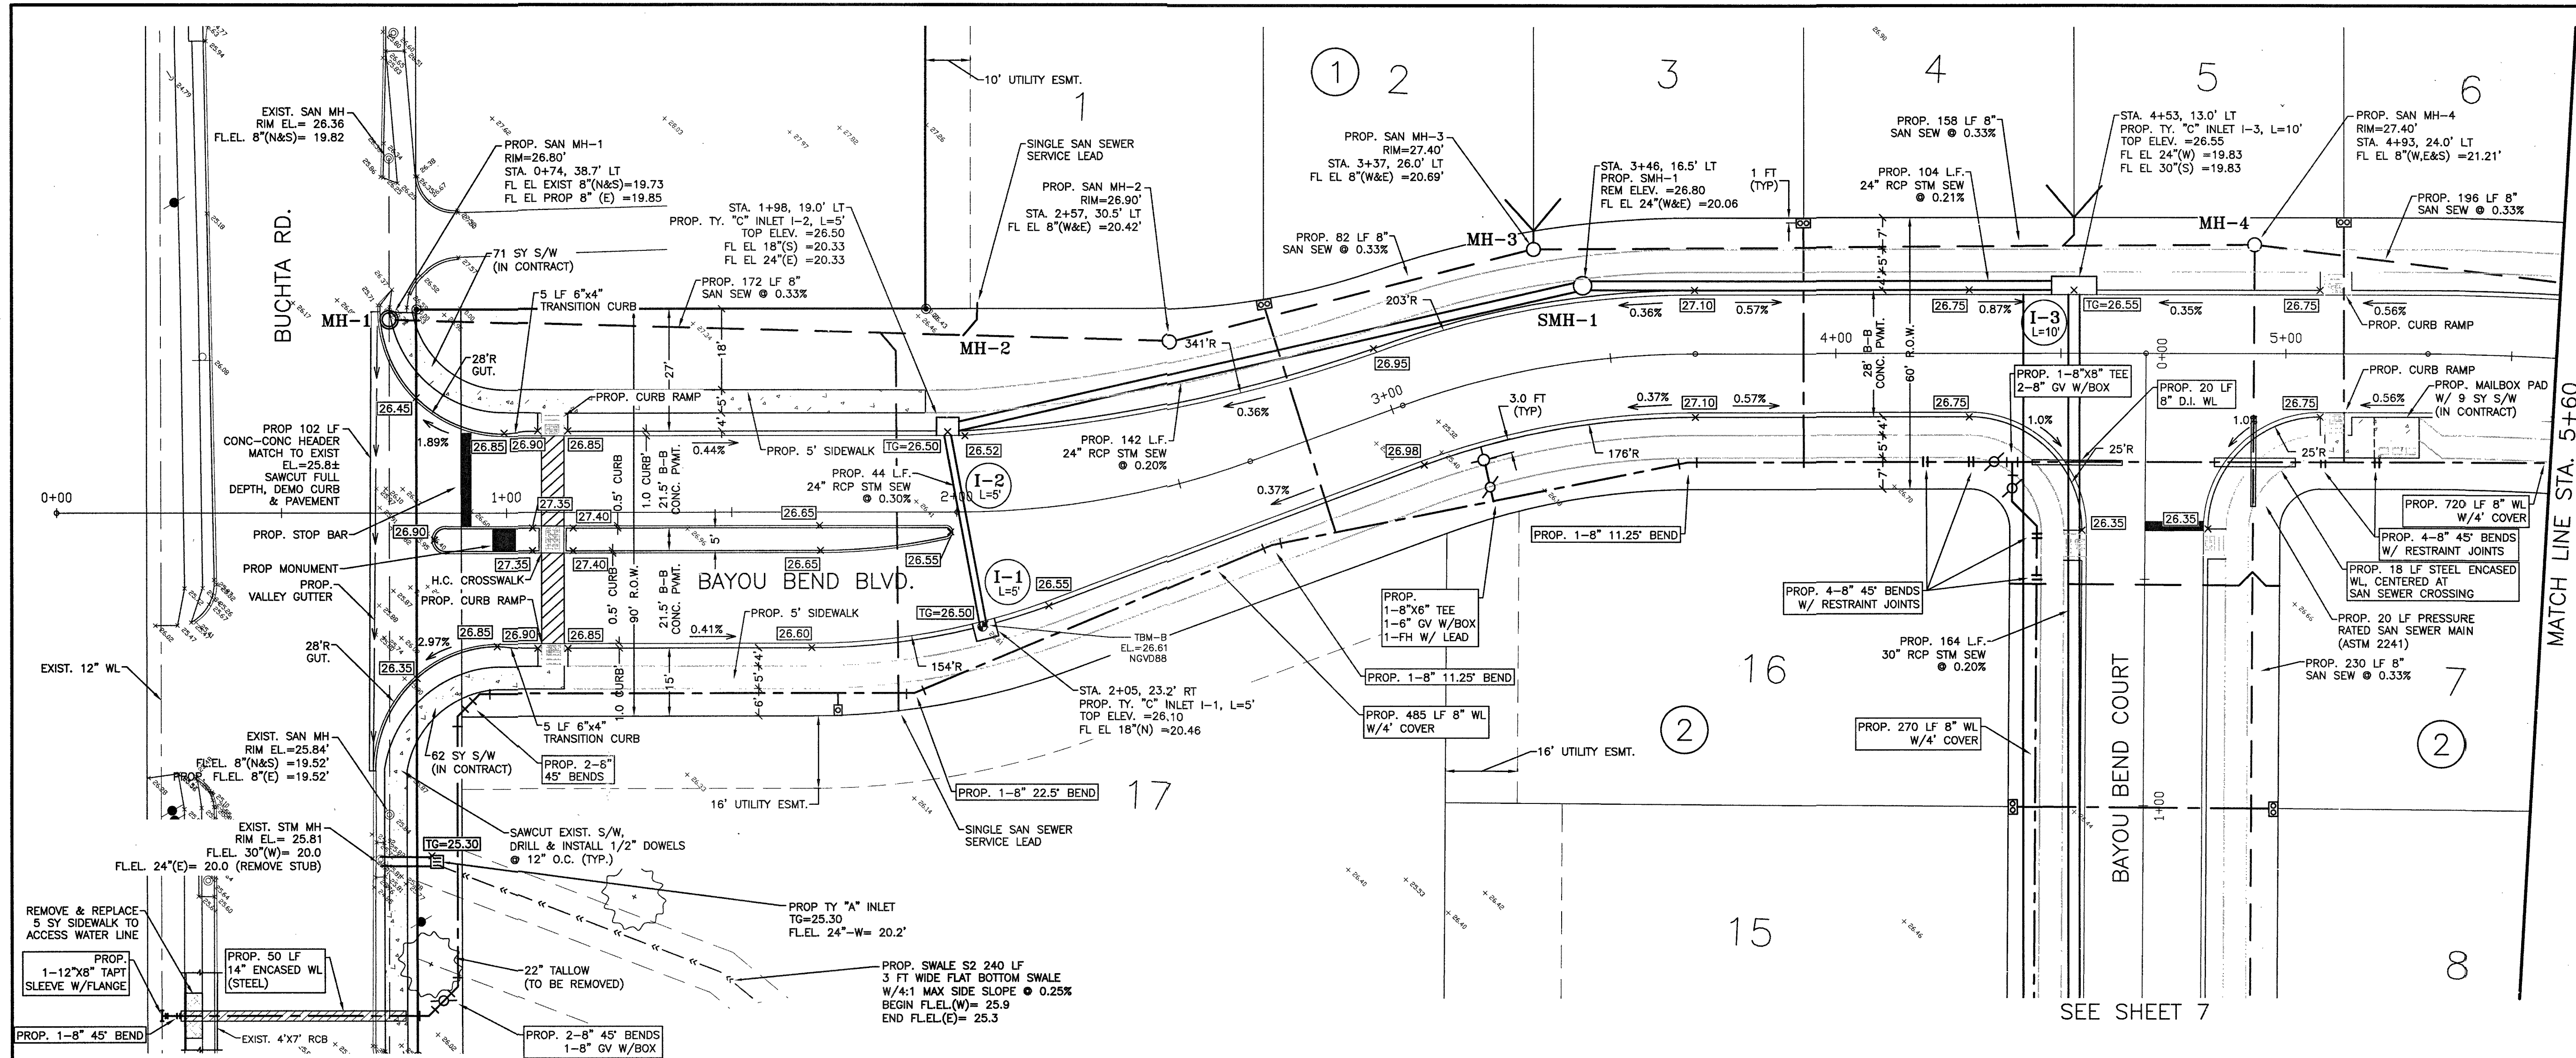


- SYMBOLS LEGEND**
- [Symbol] SINGLE WATER METER
 - [Symbol] DOUBLE WATER METER
 - [Symbol] FIRE HYDRANT
 - [Symbol] WATER VALVE
 - [Symbol] TAPPING SLEEVE AND VALVE
 - [Symbol] REDUCER
 - [Symbol] STORM SEWER MANHOLE (SMH-1)
 - [Symbol] SANITARY SEWER MANHOLE (MH-1)
 - [Symbol] TOP BANK
 - [Symbol] STORM SEWER LINE (REINFORCED CONCRETE PIPE, ASTM C76)
 - [Symbol] SANITARY SEWER LINE (D3034, SDR 26, 160 PR)
 - [Symbol] WATERLINE (AWWA C900, CLASS 150, DR18)

RECORD DRAWING

NO.	DATE	DESCRIPTION	APPROVED
REVISIONS			

DESIGNED MS
DRAWN
CHECKED
DATE

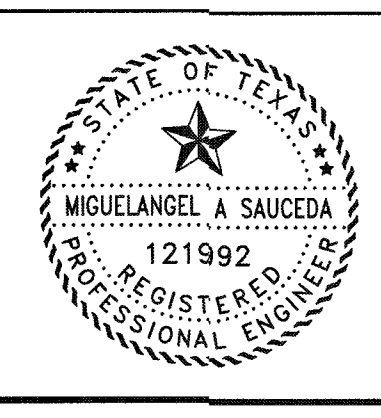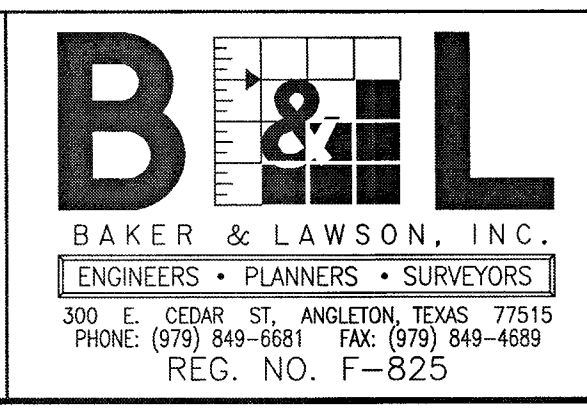

The seal appearing on this document was authorized by Miguel Saucedo P.E. 121992
Date: 1/11/22




OWNER:
Clint Peltier
Clint Peltier Custom Homes
979-481-4840







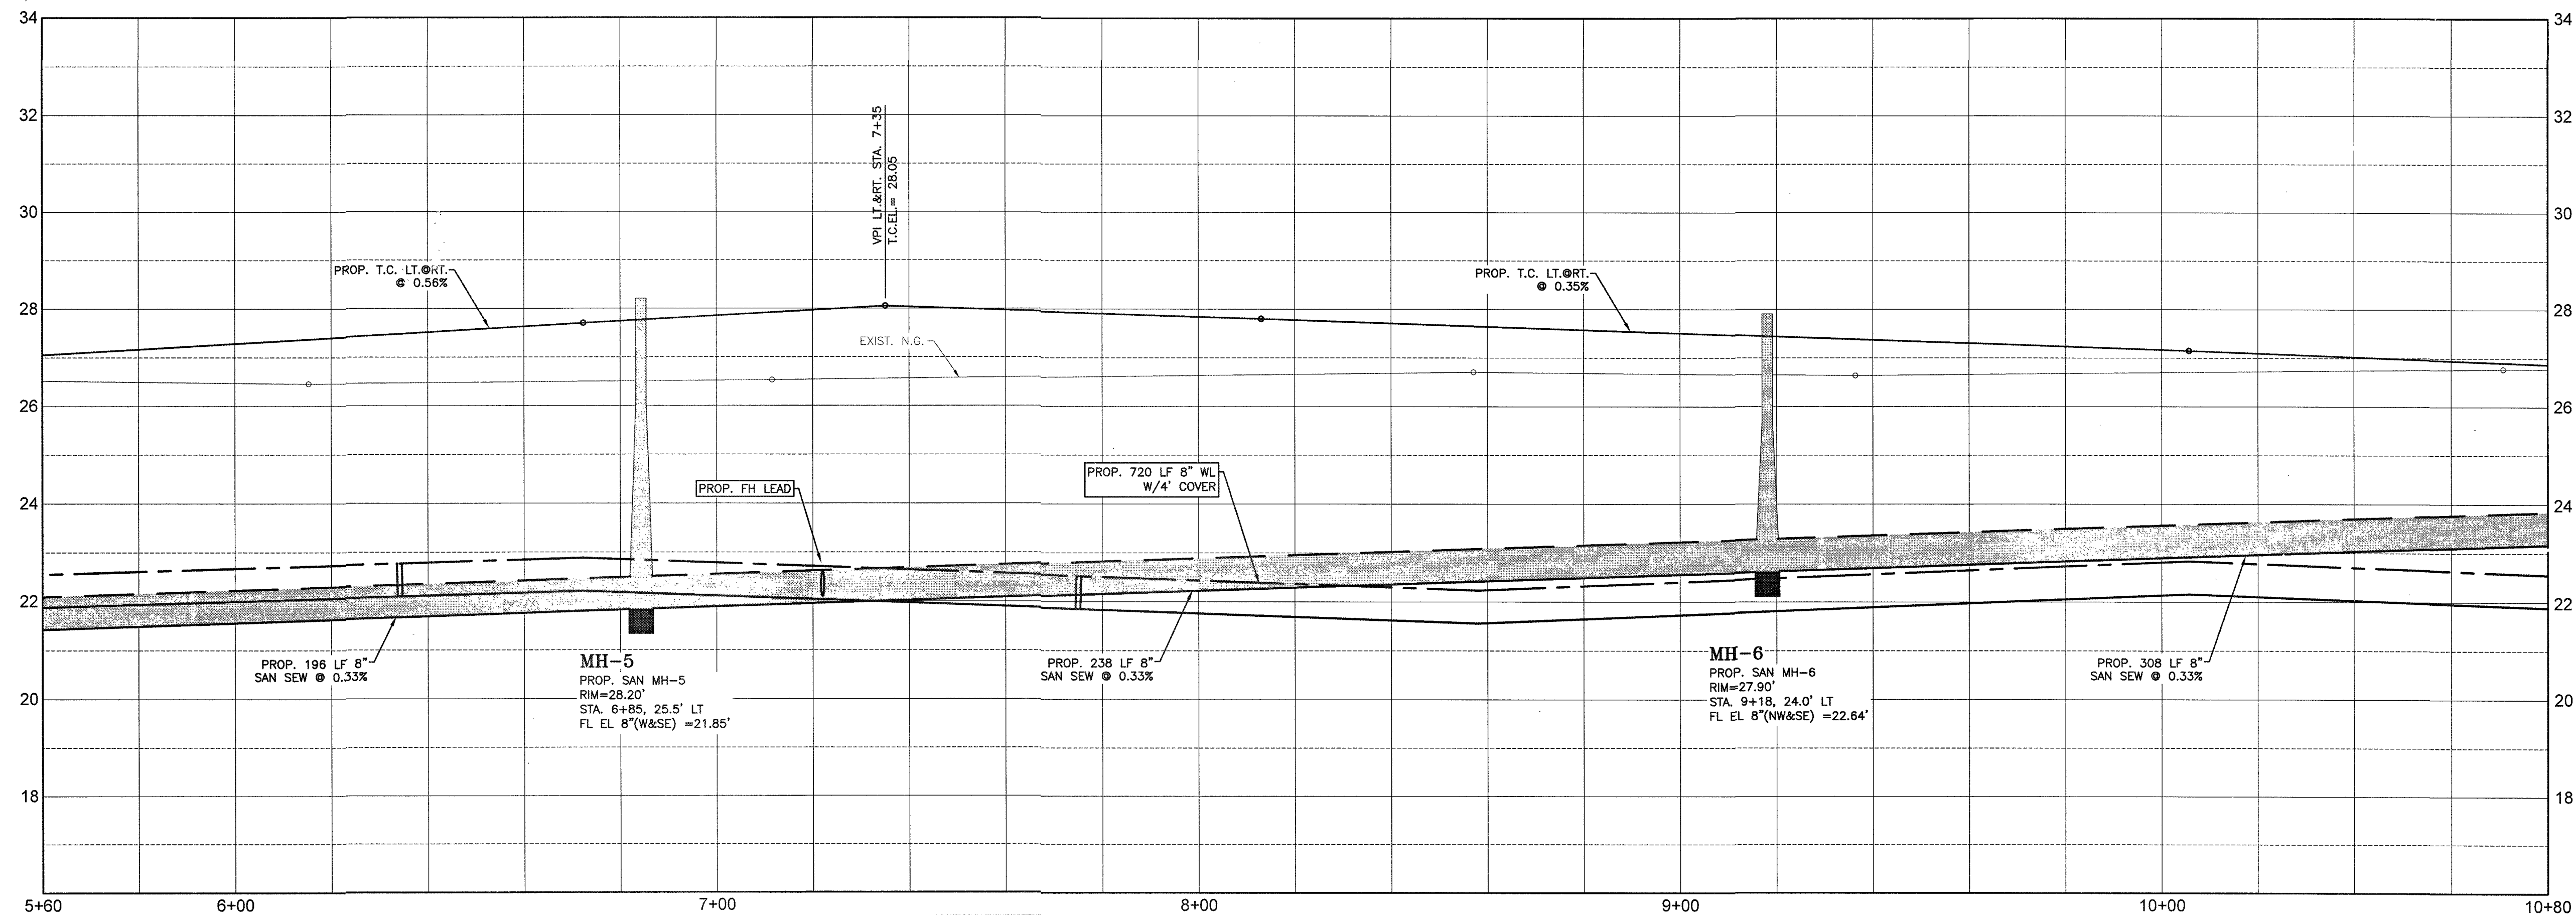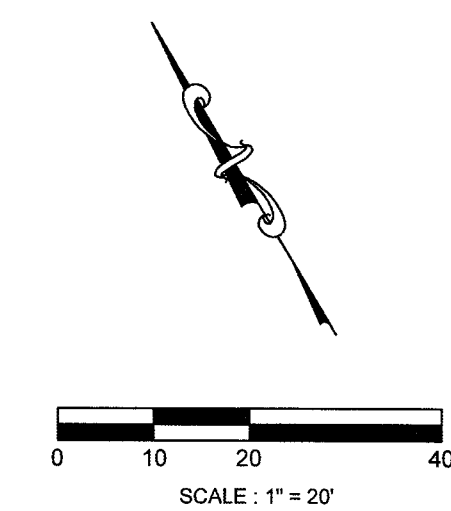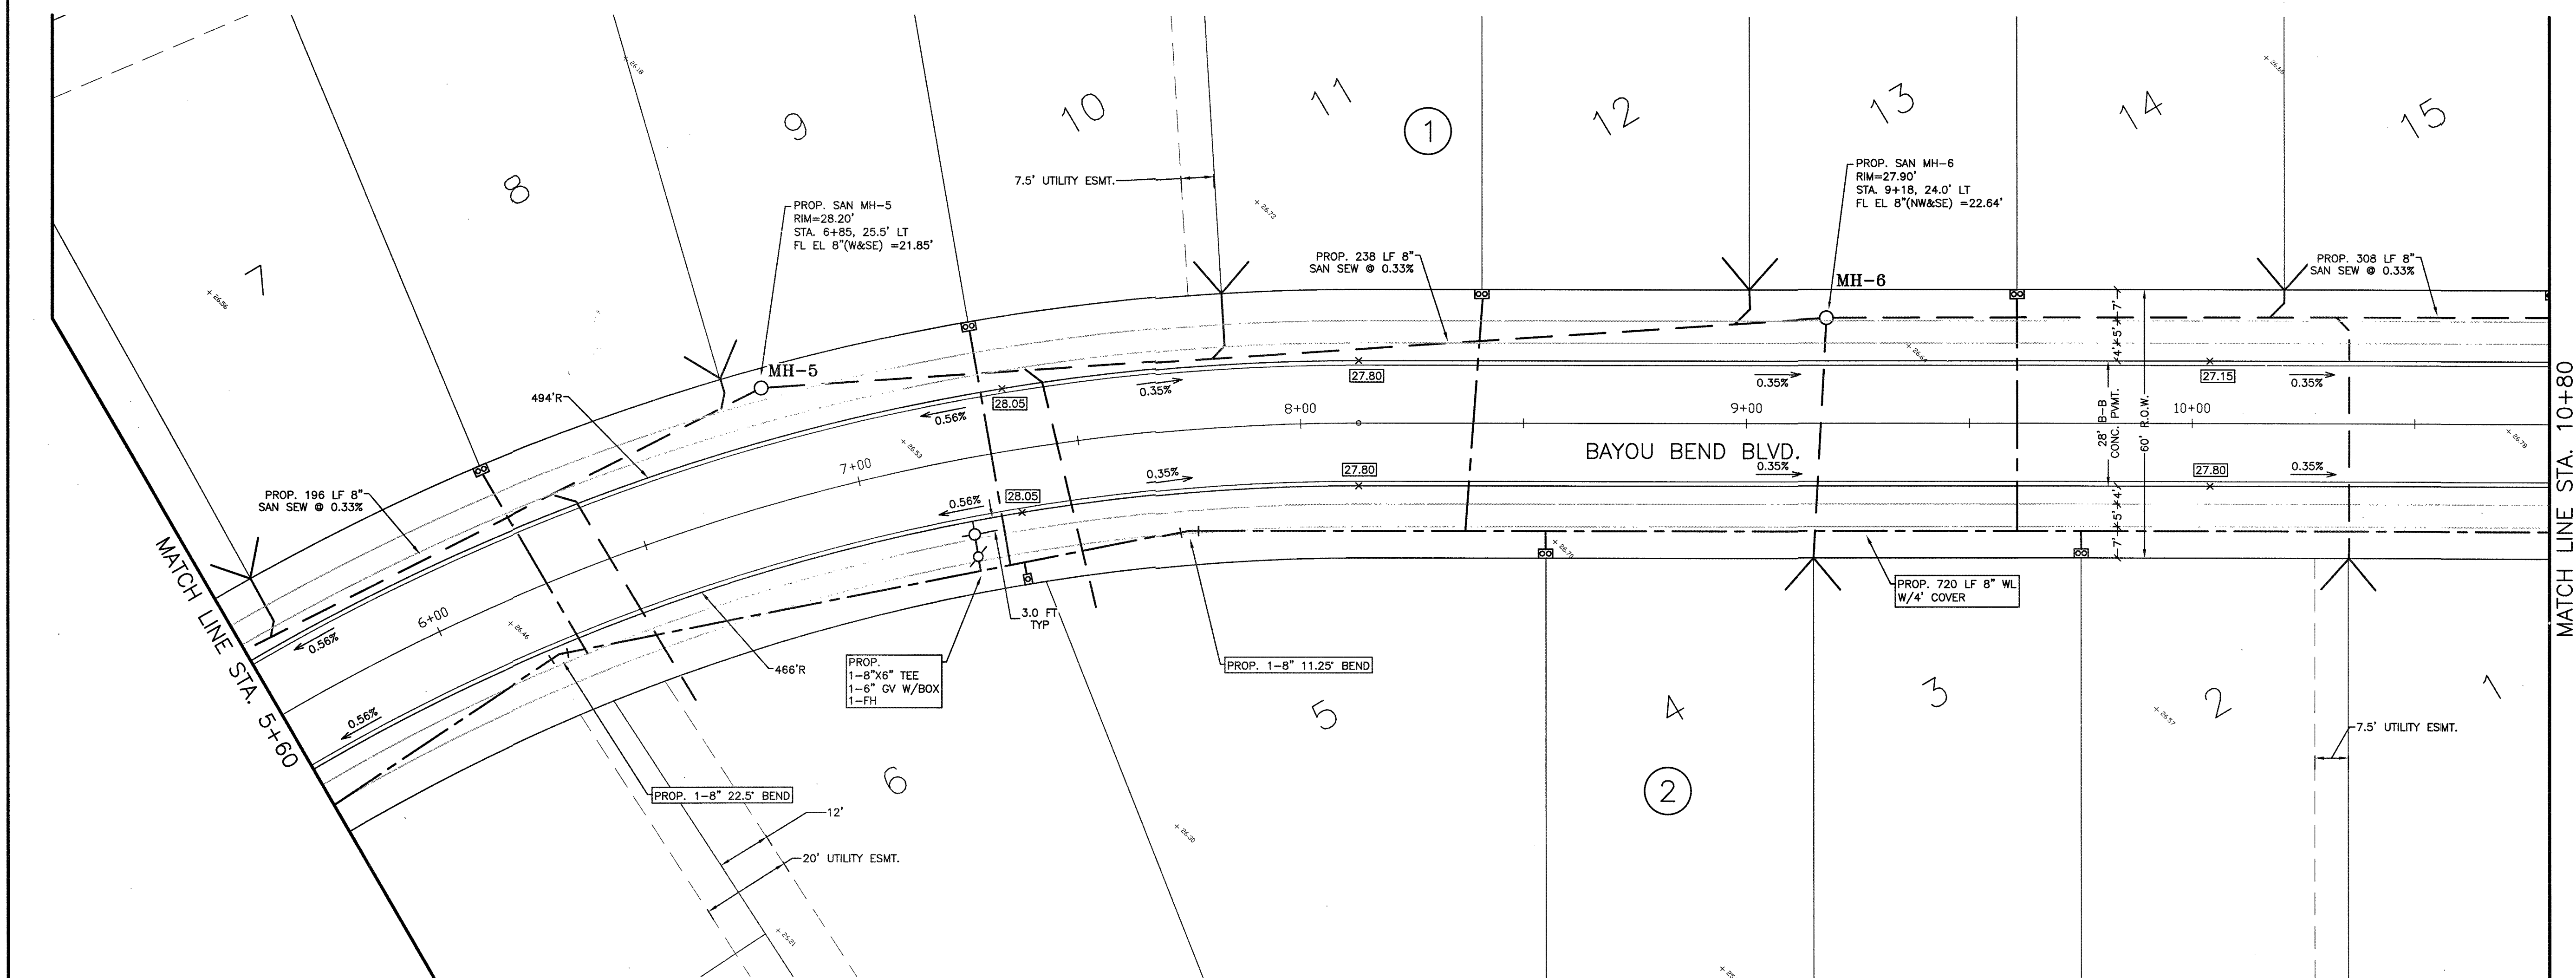


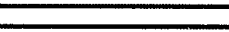


PLAN: 1" = 20'
PROFILE:
HORIZONTAL: 1" = 2'
VERTICAL: 1" = 20'

BAYOU BEND ESTATES
ANGLETON, TEXAS
PLANS FOR
GRADING, PAVING, UTILITIES
AND DETENTION

PLAN & PROFILE
BAYOU BEND BOULEVARD
STA. 0+00 TO 5+60

PROJECT NO. 13454





- ## SYMBOLS LEGEND
- | | |
|---|--|
|  | SINGLE WATER METER |
|  | DOUBLE WATER METER |
|  | FIRE HYDRANT |
|  | WATER VALVE |
|  | TAPPING SLEEVE AND VALVE |
|  | REDUCER |
|  | STORM SEWER MANHOLE (SMH-1) |
|  | SANITARY SEWER MANHOLE (MH-1) |
|  | TOP BANK |
|  | STORM SEWER LINE
(REINFORCED CONCRETE PIPE
ASTM C76) |
|  | SANITARY SEWER LINE
(D3034, SDR 26, 160 PR) |
|  | WATERLINE (AWWA C900,
CLASS 150, DR18) |

RECORD DRAWING

NO.	DATE	DESCRIPTION	APPROVE
REVISIONS			

DESIGNED _____ MS
DRAWN _____
CHECKED _____
DATE _____

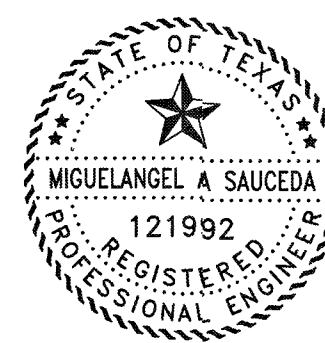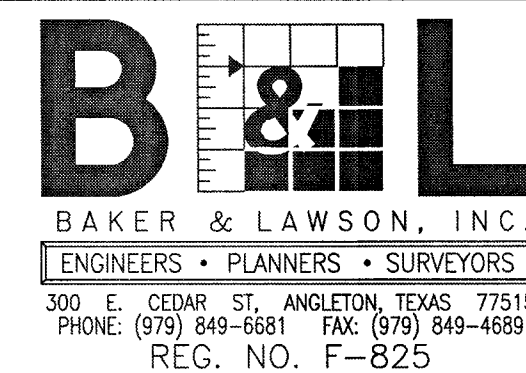

The seal appearing on
this document was
authorized by
Miguel Saucedo
P.E. 121992

Miguel Saucedo

Date: 1/11/22




OWNER:
Clint Peltier
Clint Peltier Custom Homes
979-481-4840

PLAN: 1" = 20'
 PROFILE:
 HORIZONTAL: 1" = 2'
 VERTICAL: 1" = 20'

BAYOU BEND ESTATES
ANGLETON, TEXAS
PLANS FOR
GRADING, PAVING, UTILITIES
AND DETENTION

PLAN & PROFILE
BAYOU BEND BOULEVARD
STA. 5+60 TO 10+80

PROJECT NO. 13454

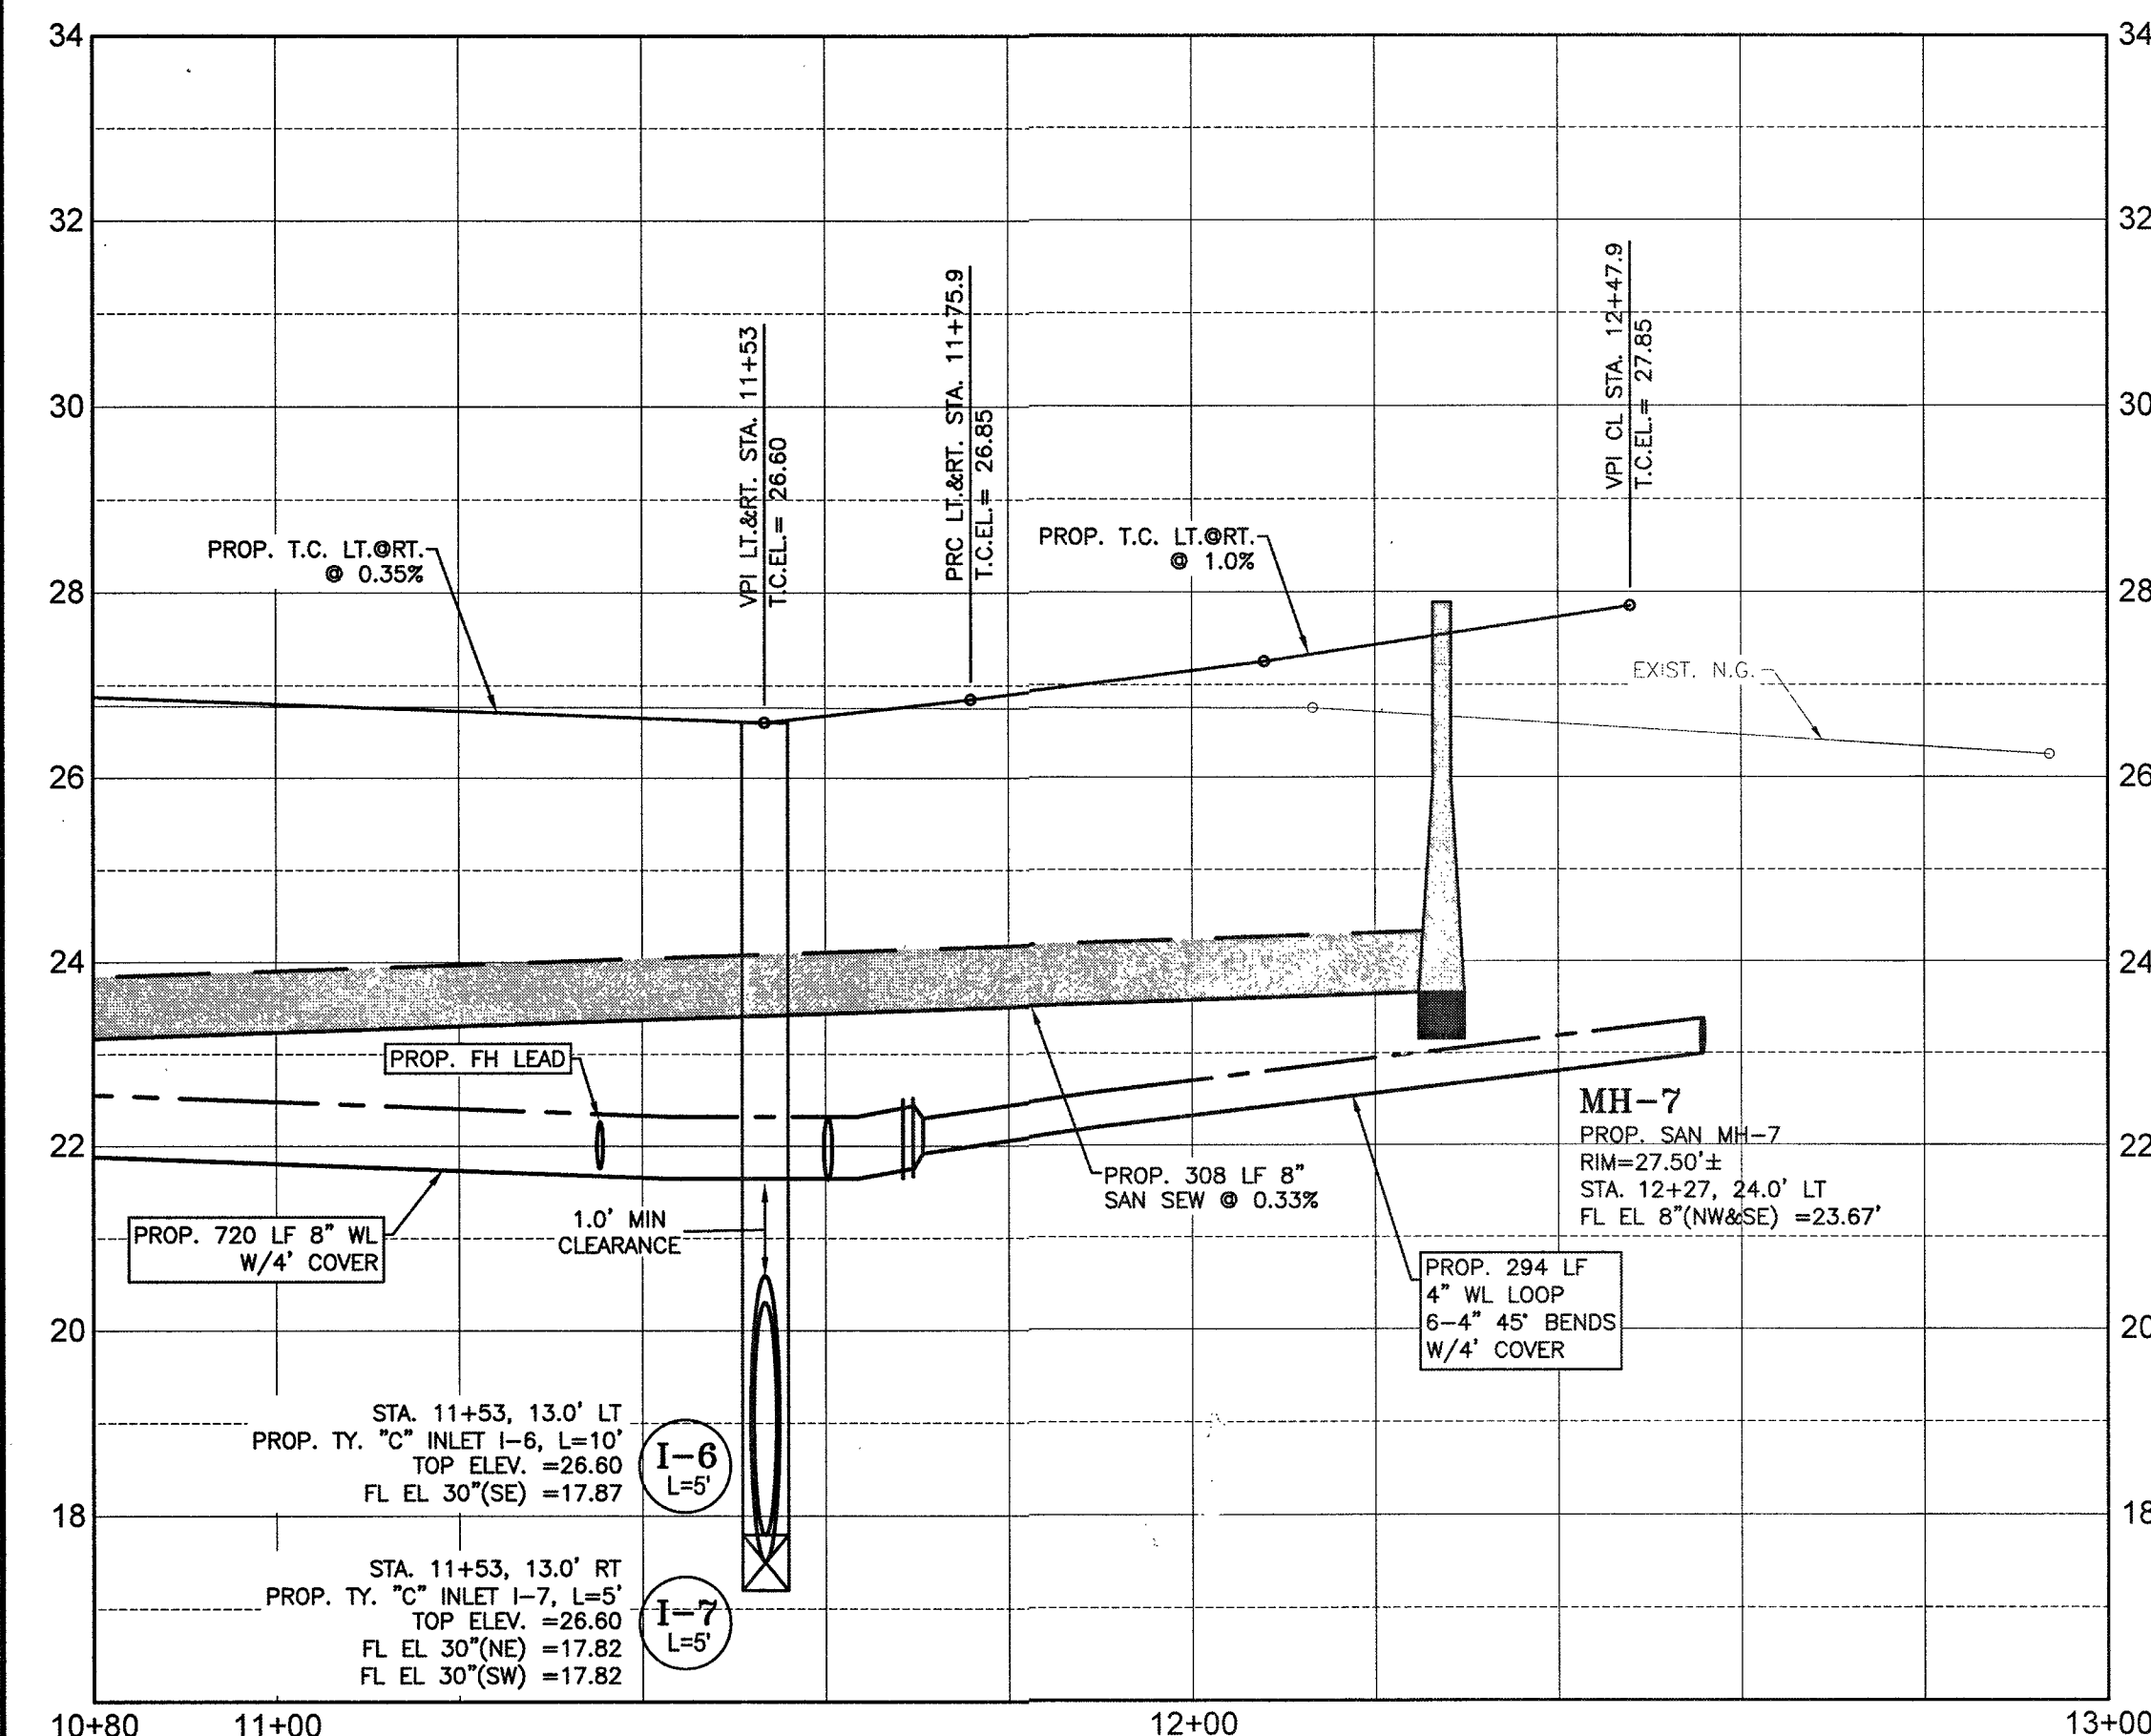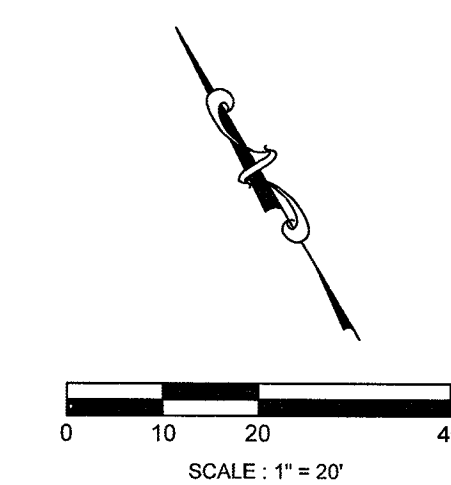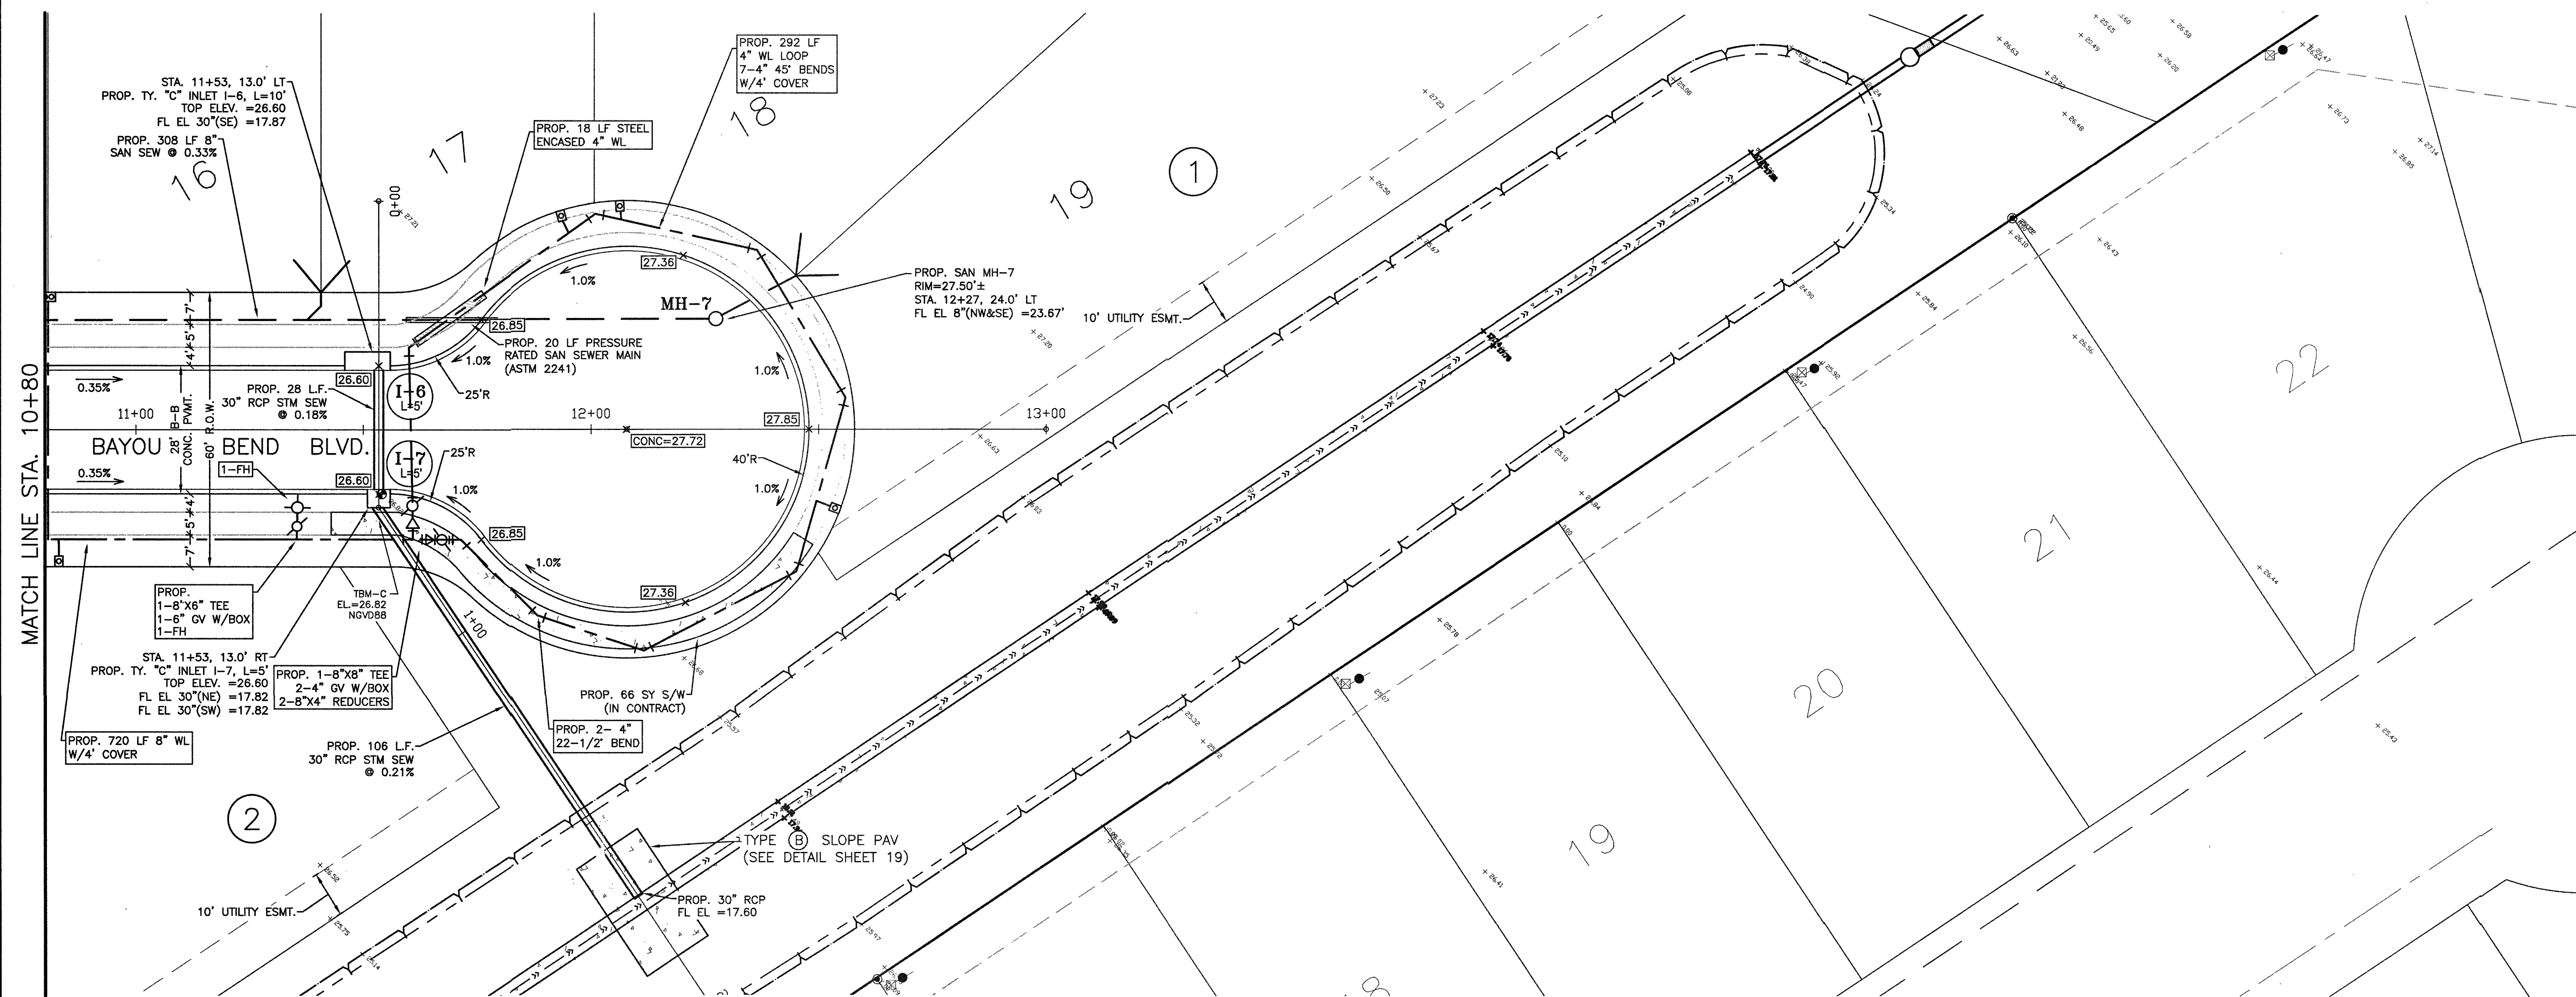

SYMBOLS LEGEND


- SINGLE WATER METER
- DOUBLE WATER METER
- FIRE HYDRANT
- WATER VALVE
- TAPPING SLEEVE AND VALVE
- REDUCER
- STORM SEWER MANHOLE (SMH-1)
- SANITARY SEWER MANHOLE (MH-1)
- TOP BANK
- STORM SEWER LINE (REINFORCED CONCRETE PIPE, ASTM C76)
- SANITARY SEWER LINE (D3034, SDR 26, 160 PR)
- WATERLINE (AWWA C900, CLASS 150, DR18)

RECORD DRAWING

NO.	DATE	DESCRIPTION	APPROVED
1	10.4.21	MOVE REDUCER, DIM WL LOOP.	
REVISIONS			

DESIGNED	MS
DRAWN	BT/BB
CHECKED	
DATE	

B & L
BAKER & LAWSON, INC.
ENGINEERS • PLANNERS • SURVEYORS
300 E. CEDAR ST. ANGLETON, TEXAS 77515
PHONE: (979) 849-6681 FAX: (979) 849-4639
REG. NO. F-825

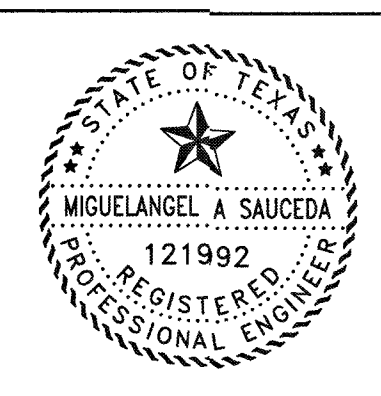




The seal appearing on this document was authorized by Miguel Saucedo P.E. 121992
Date: 11/11/22

OWNER:
Clint Peltier
Clint Peltier Custom Homes
979-481-4840

PLAN: 1" = 20'
PROFILE:
HORIZONTAL: 1" = 2'
VERTICAL: 1" = 20'

BAYOU BEND ESTATES
ANGLETON, TEXAS
PLANS FOR
GRADING, PAVING, UTILITIES
AND DETENTION

PLAN & PROFILE
BAYOU BEND BOULEVARD
STA. 10+80 TO 13+00
PROJECT NO. 13454

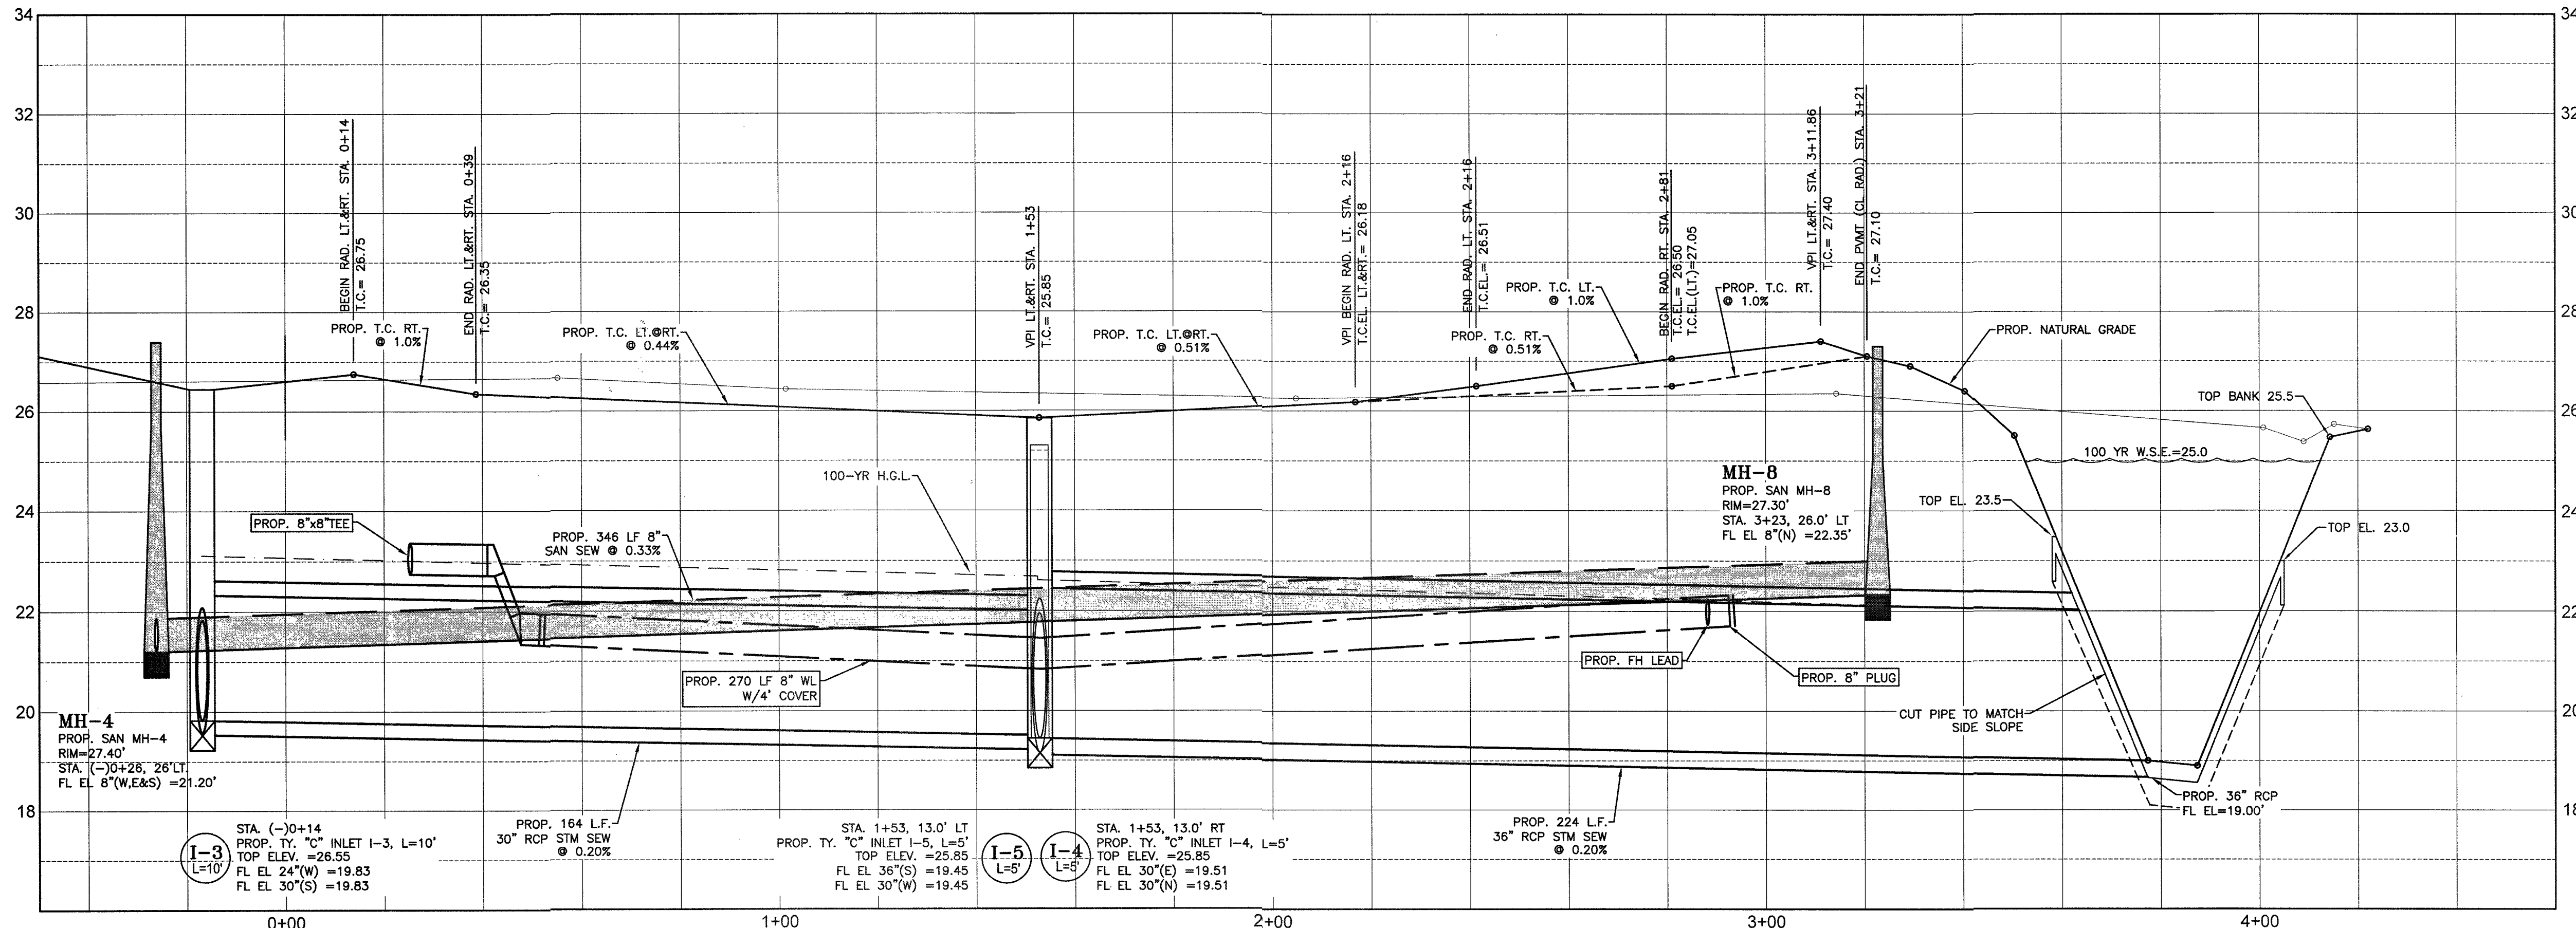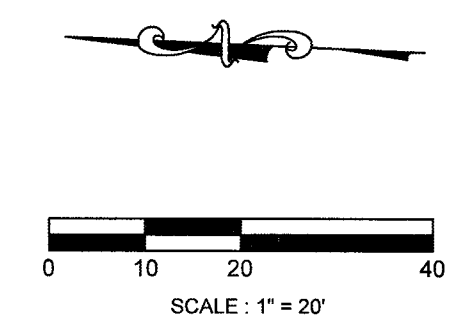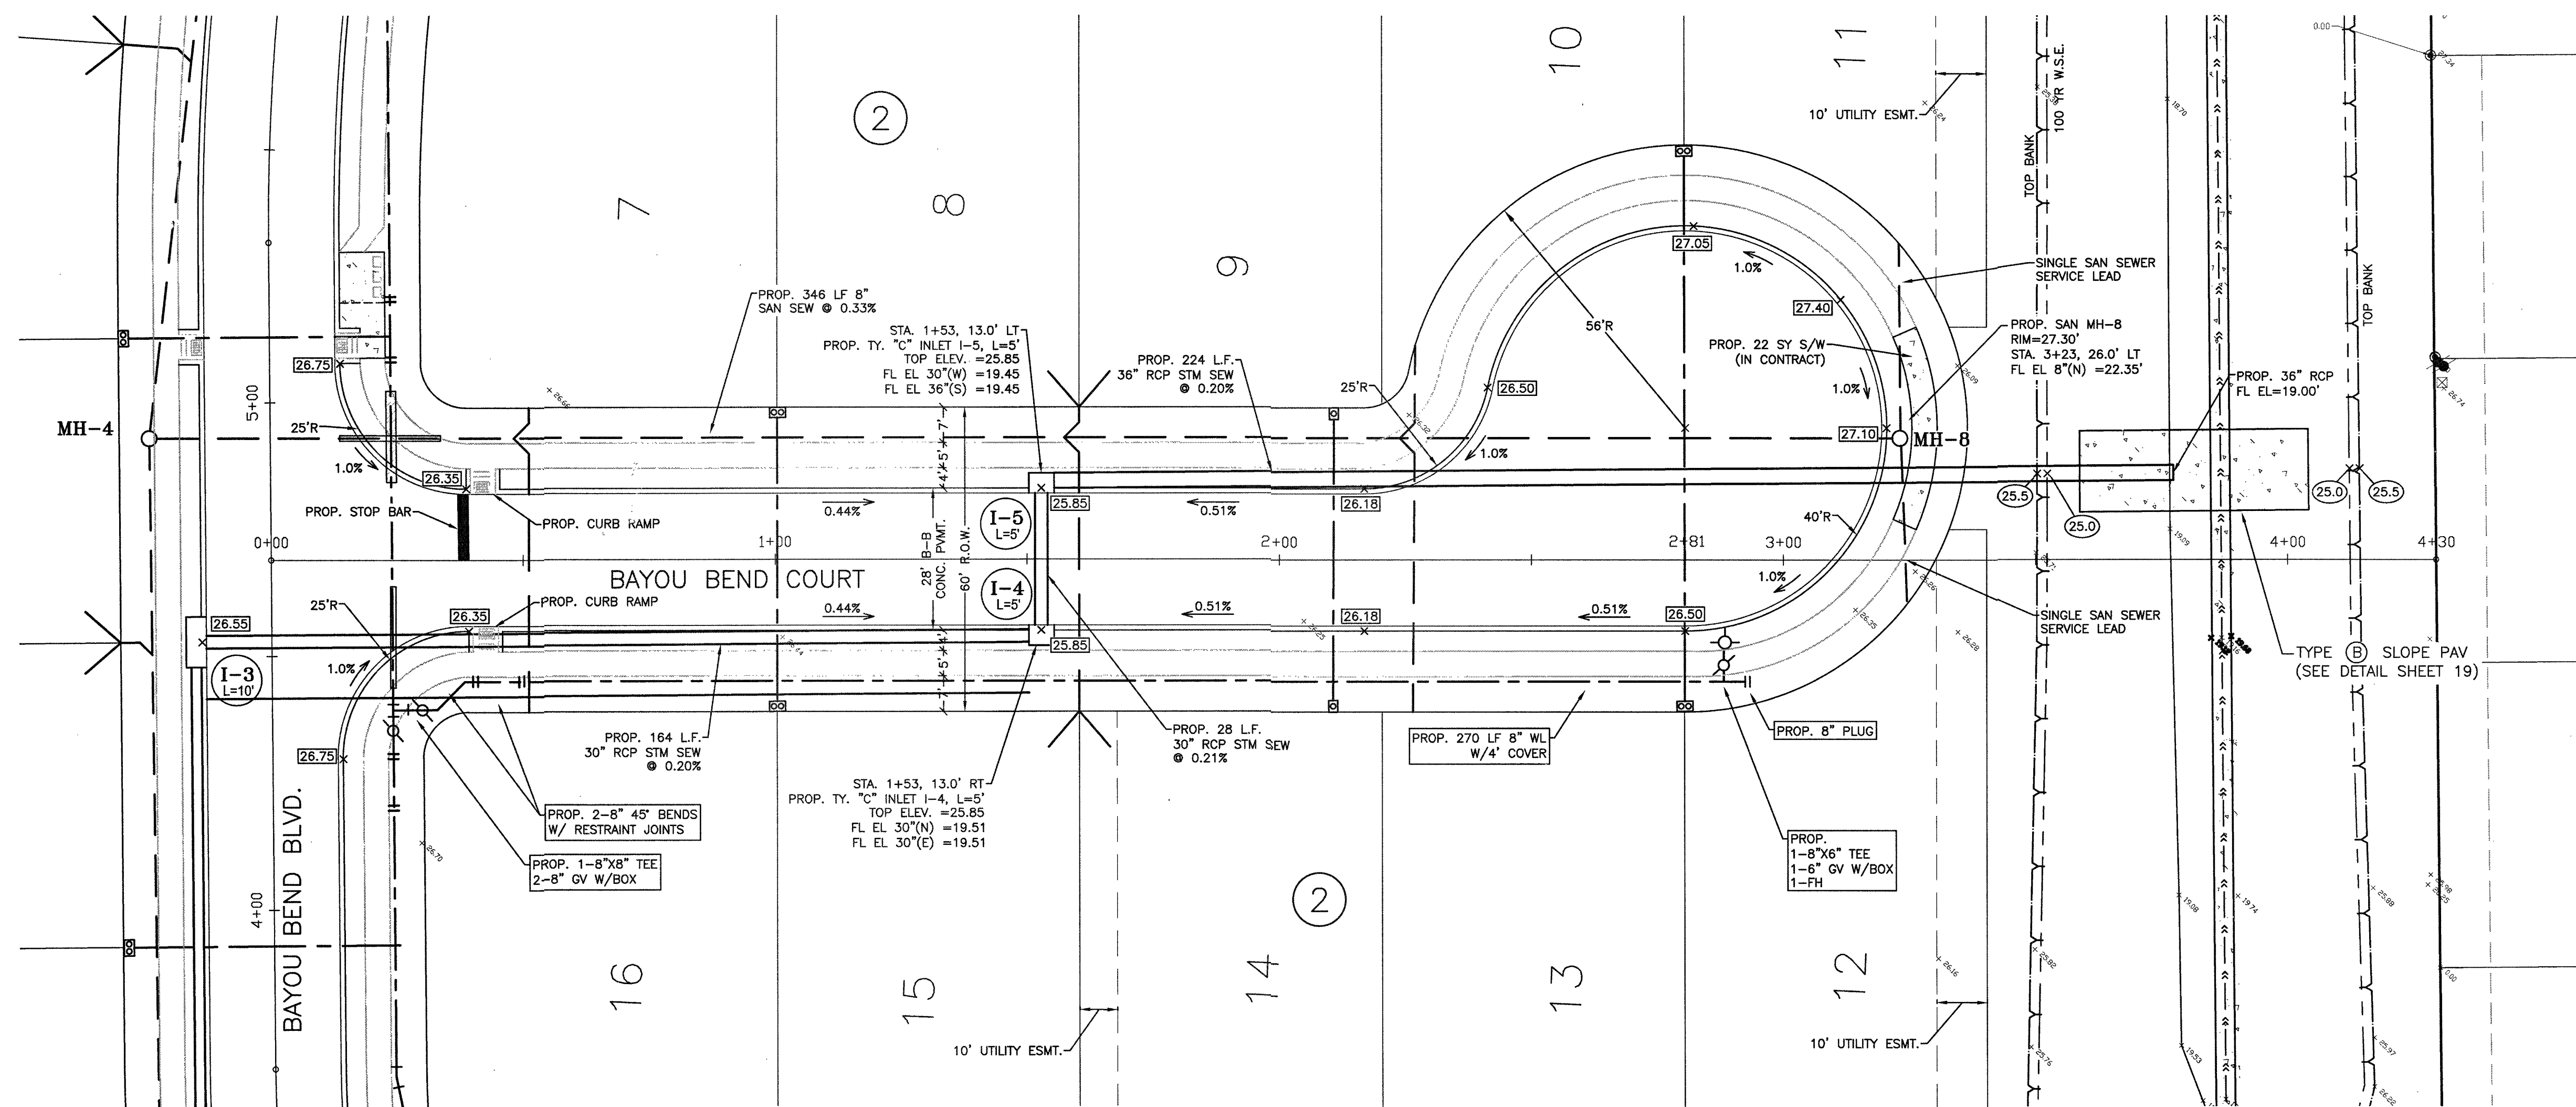


- SYMBOLS LEGEND**
- SINGLE WATER METER
 - DOUBLE WATER METER
 - FIRE HYDRANT
 - WATER VALVE
 - TAPPING SLEEVE AND VALVE
 - REDUCER
 - STORM SEWER MANHOLE (SMH-1)
 - SANITARY SEWER MANHOLE (MH-1)
 - TOP BANK
 - STORM SEWER LINE (REINFORCED CONCRETE PIPE, ASTM C76)
 - SANITARY SEWER LINE (D3034, SDR 26, 160 PR)
 - WATERLINE (AWWA C900, CLASS 150, DR18)

RECORD DRAWING

NO.	DATE	DESCRIPTION	APPROVED
REVISIONS			

DESIGNED MS
 DRAWN
 CHECKED
 DATE

B & L
 BAKER & LAWSON, INC.
 ENGINEERS • PLANNERS • SURVEYORS
 300 E. CEDAR ST. ANGLETON, TEXAS 77515
 PHONE: (979) 849-6681 FAX: (979) 849-6689
 REG. NO. F-825

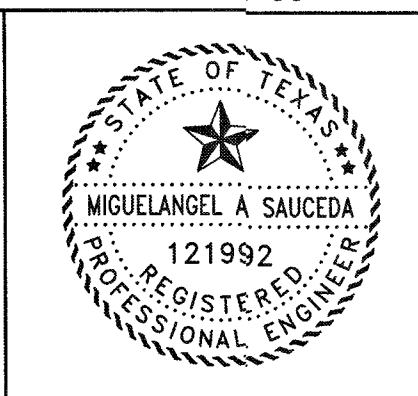




The seal appearing on this document was authorized by Miguel Saucedo P.E. 121992
 Date: 11/1/22

OWNER:
Clint Peltier
Clint Peltier Custom Homes
979-481-4840

PLAN: 1" = 20'
 PROFILE:
 HORIZONTAL: 1" = 2'
 VERTICAL: 1" = 20'

BAYOU BEND ESTATES
ANGLETON, TEXAS
PLANS FOR
GRADING, PAVING, UTILITIES
AND DETENTION

PLAN & PROFILE
BAYOU BEND COURT
STA. 0+00 TO 2+81
 PROJECT NO. 13454

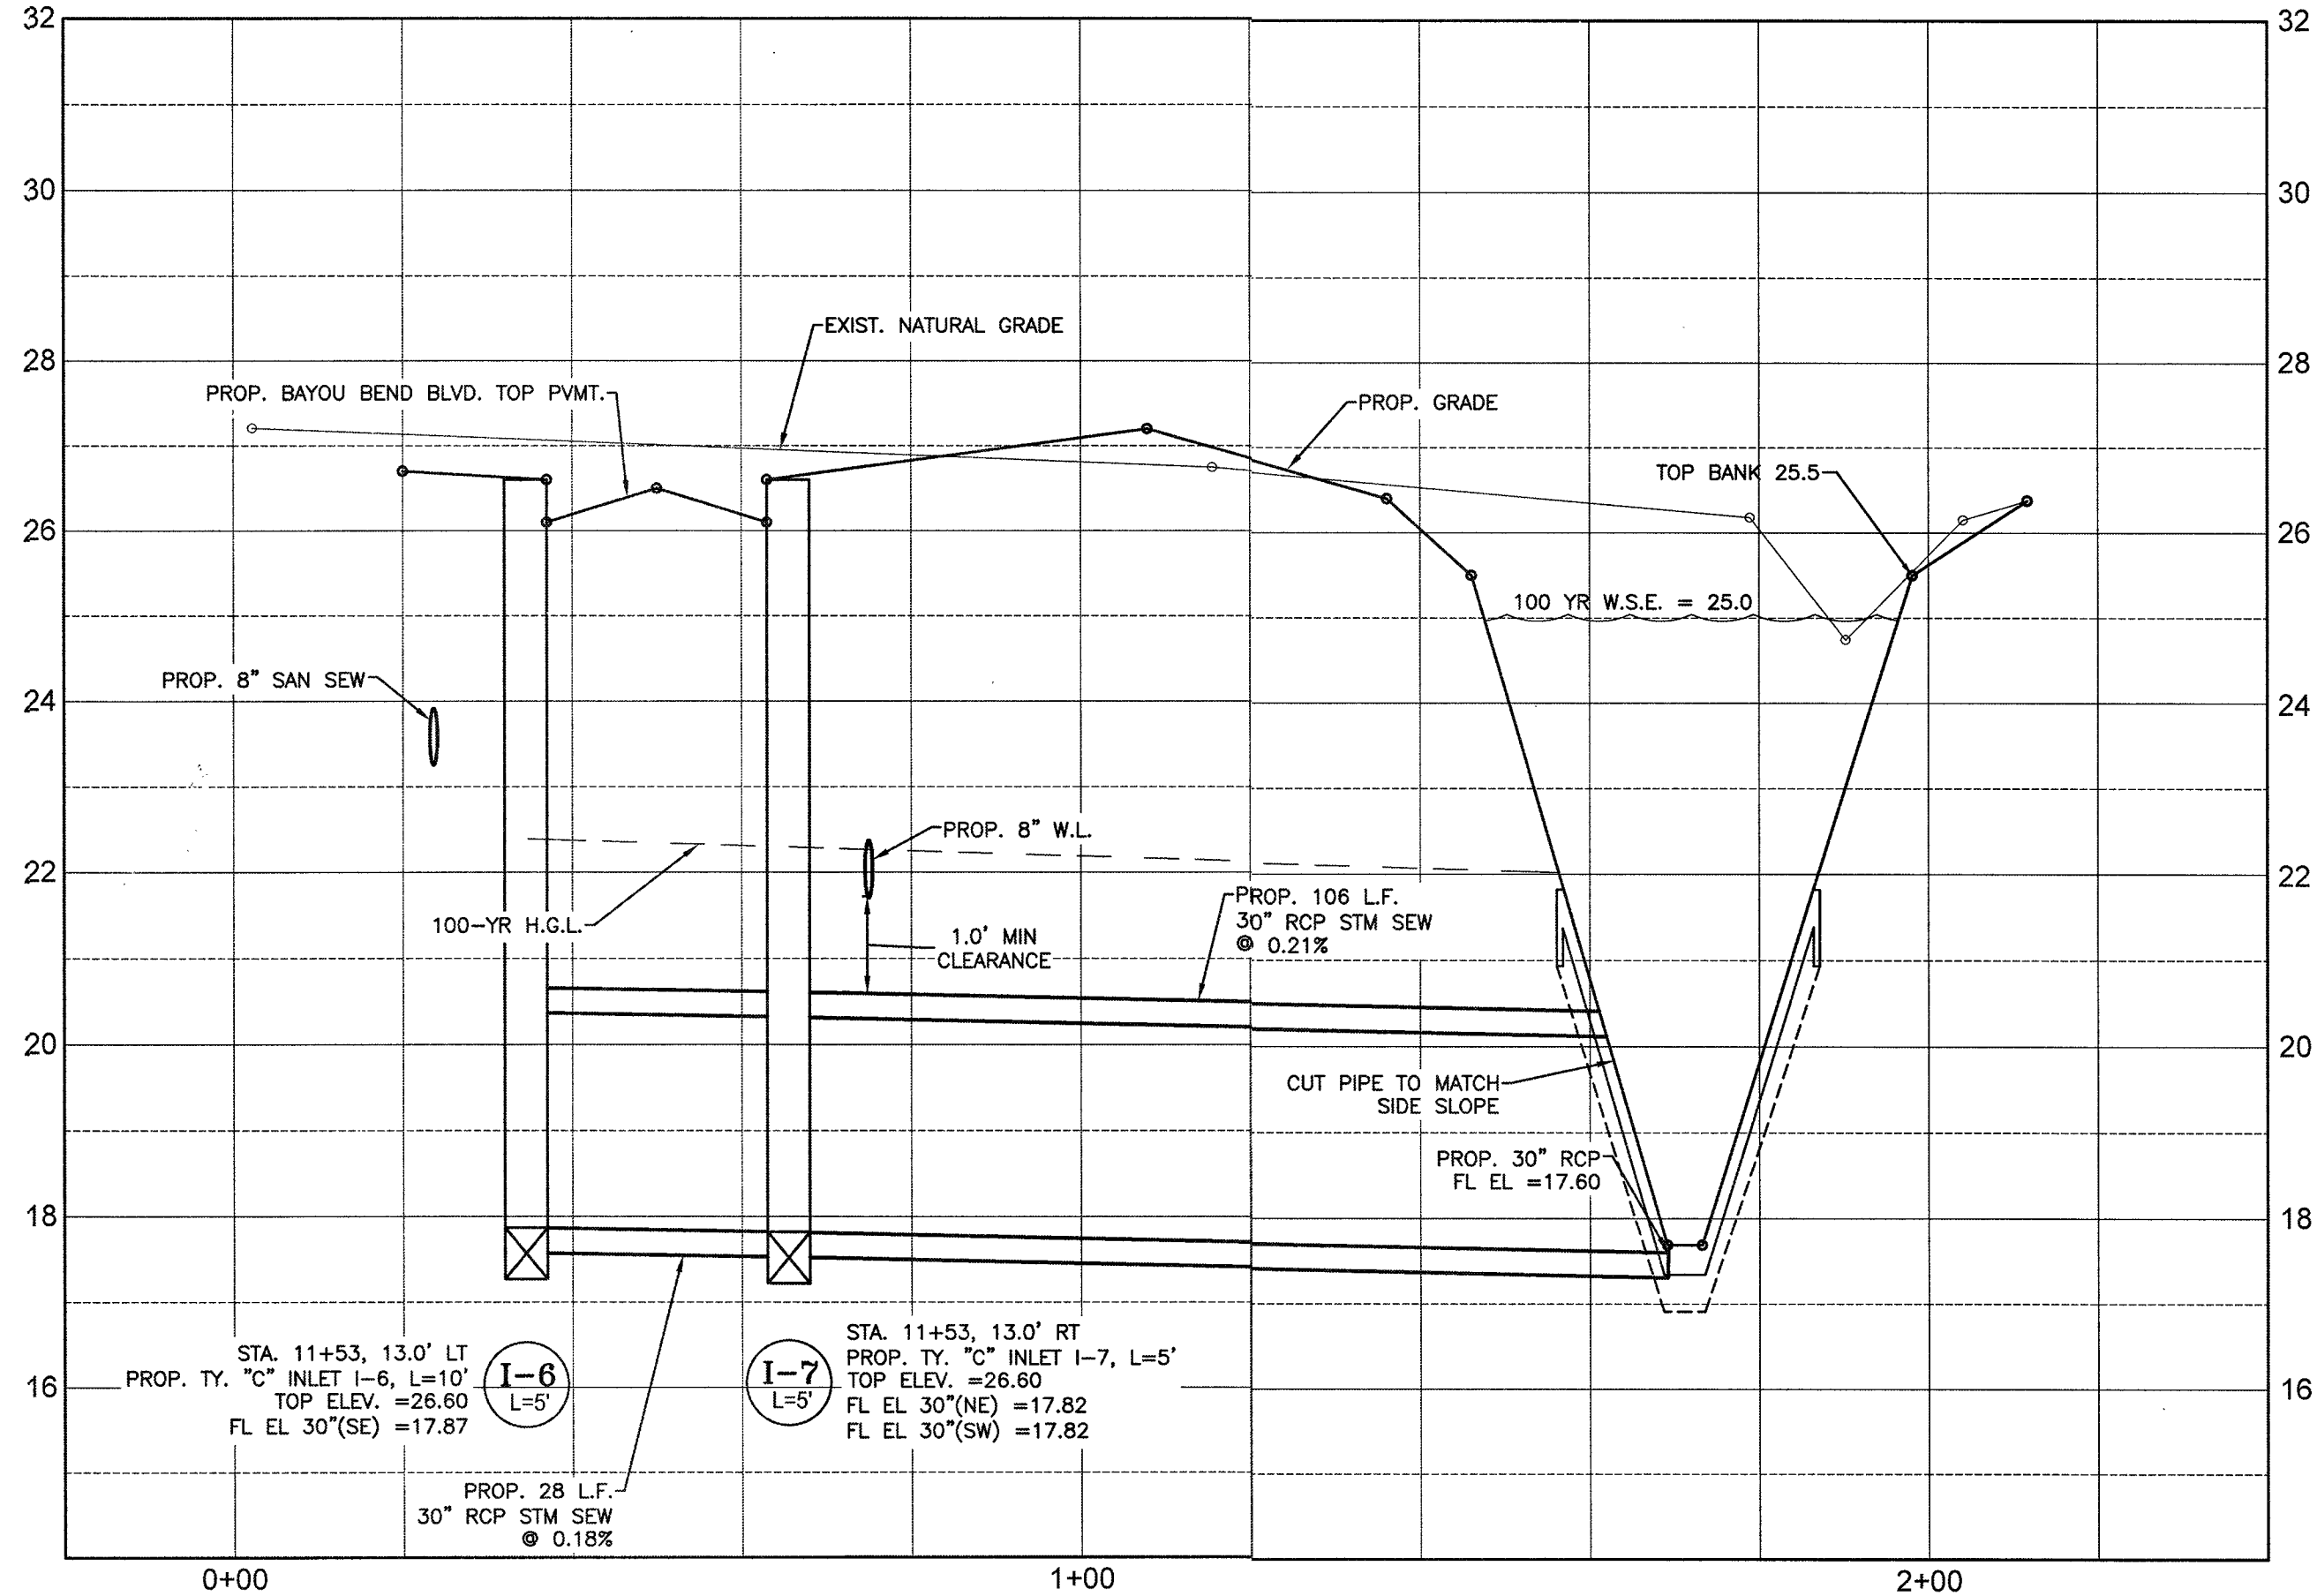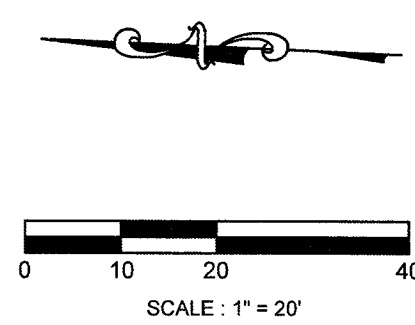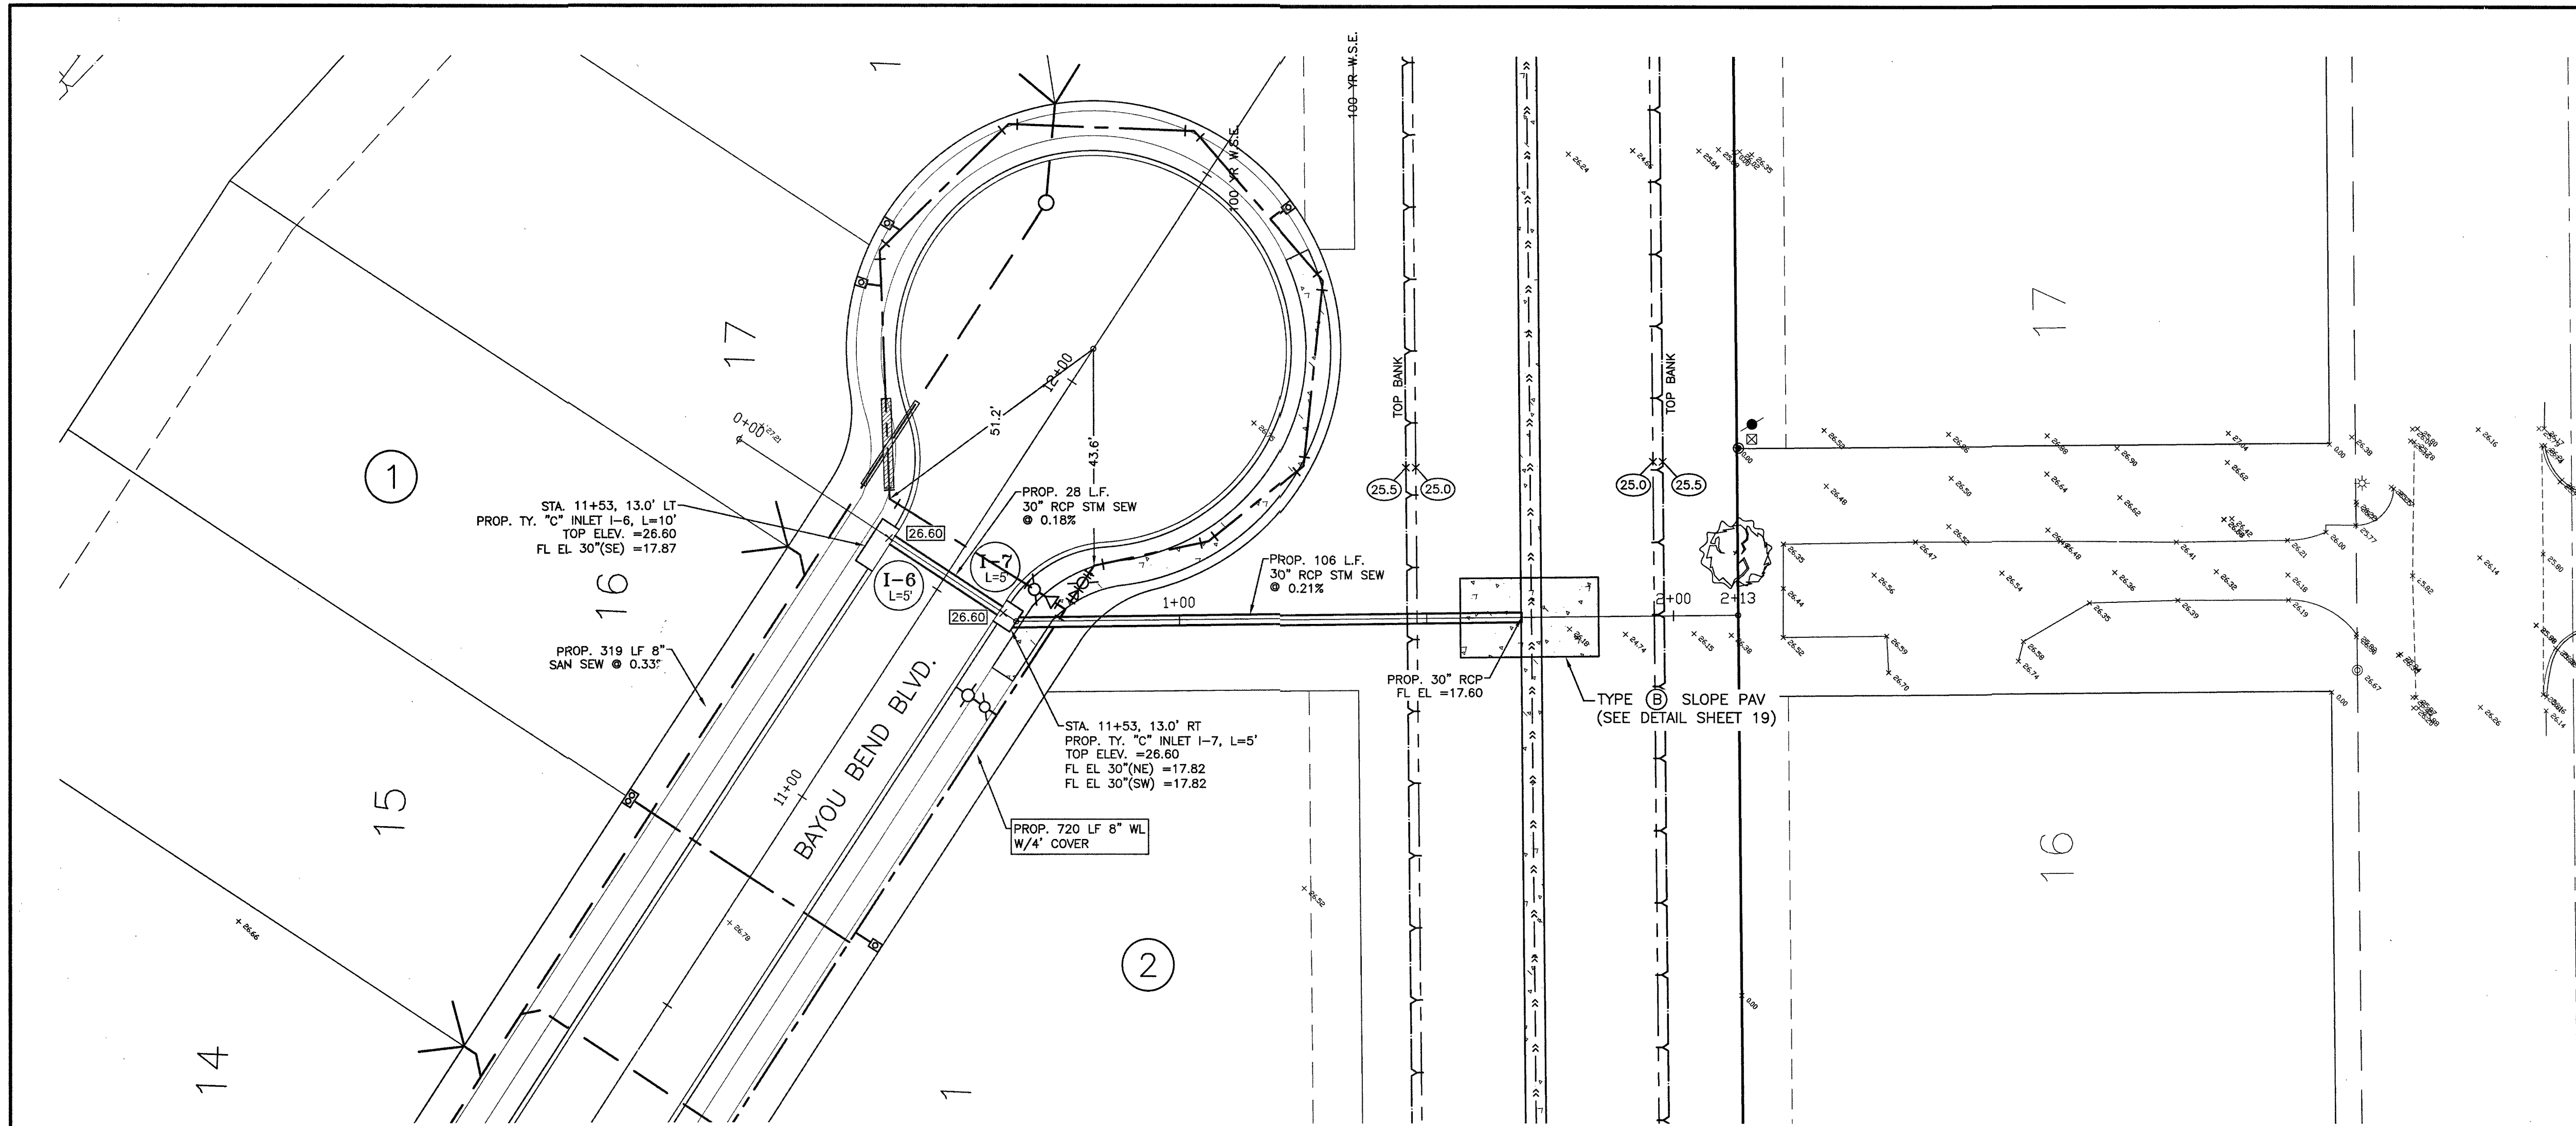

SYMBOLS LEGEND


- SINGLE WATER METER
- DOUBLE WATER METER
- FIRE HYDRANT
- WATER VALVE
- TAPPING SLEEVE AND VALVE
- REDUCER
- STORM SEWER MANHOLE (SMH-1)
- SANITARY SEWER MANHOLE (MH-1)
- TOP BANK
- STORM SEWER LINE (REINFORCED CONCRETE PIPE, ASTM C76)
- SANITARY SEWER LINE (D3034, SDR 26, 160 PR)
- WATERLINE (AWWA C900, CLASS 150, DR18)

RECORD DRAWING

NO.	DATE	DESCRIPTION	APPROVED

DESIGNED MS
 DRAWN
 CHECKED
 DATE

B & L
 BAKER & LAWSON, INC.
 ENGINEERS • PLANNERS • SURVEYORS
 300 E. CEDAR ST. ANGLETON, TEXAS 77515
 PHONE: (979) 849-6681 FAX: (979) 849-4689
 REG. NO. F-825

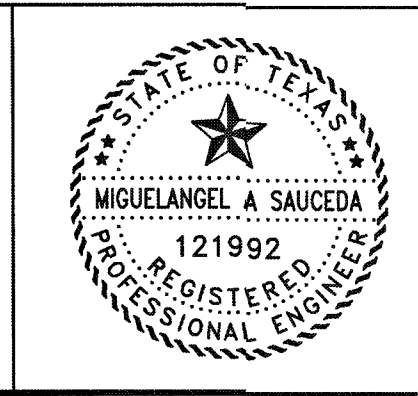


The seal appearing on this document was authorized by Miguel Saucedo P.E. 121992
 Date: 1/11/22

OWNER:
Clint Peltier
Clint Peltier Custom Homes
979-481-4840


PLAN: 1" = 20'
 PROFILE:
 HORIZONTAL: 1" = 2'
 VERTICAL: 1" = 20'

BAYOU BEND ESTATES
ANGLETON, TEXAS
PLANS FOR
GRADING, PAVING, UTILITIES
AND DETENTION

PLAN & PROFILE
 OUTFALL 1
 PROJECT NO. 13454

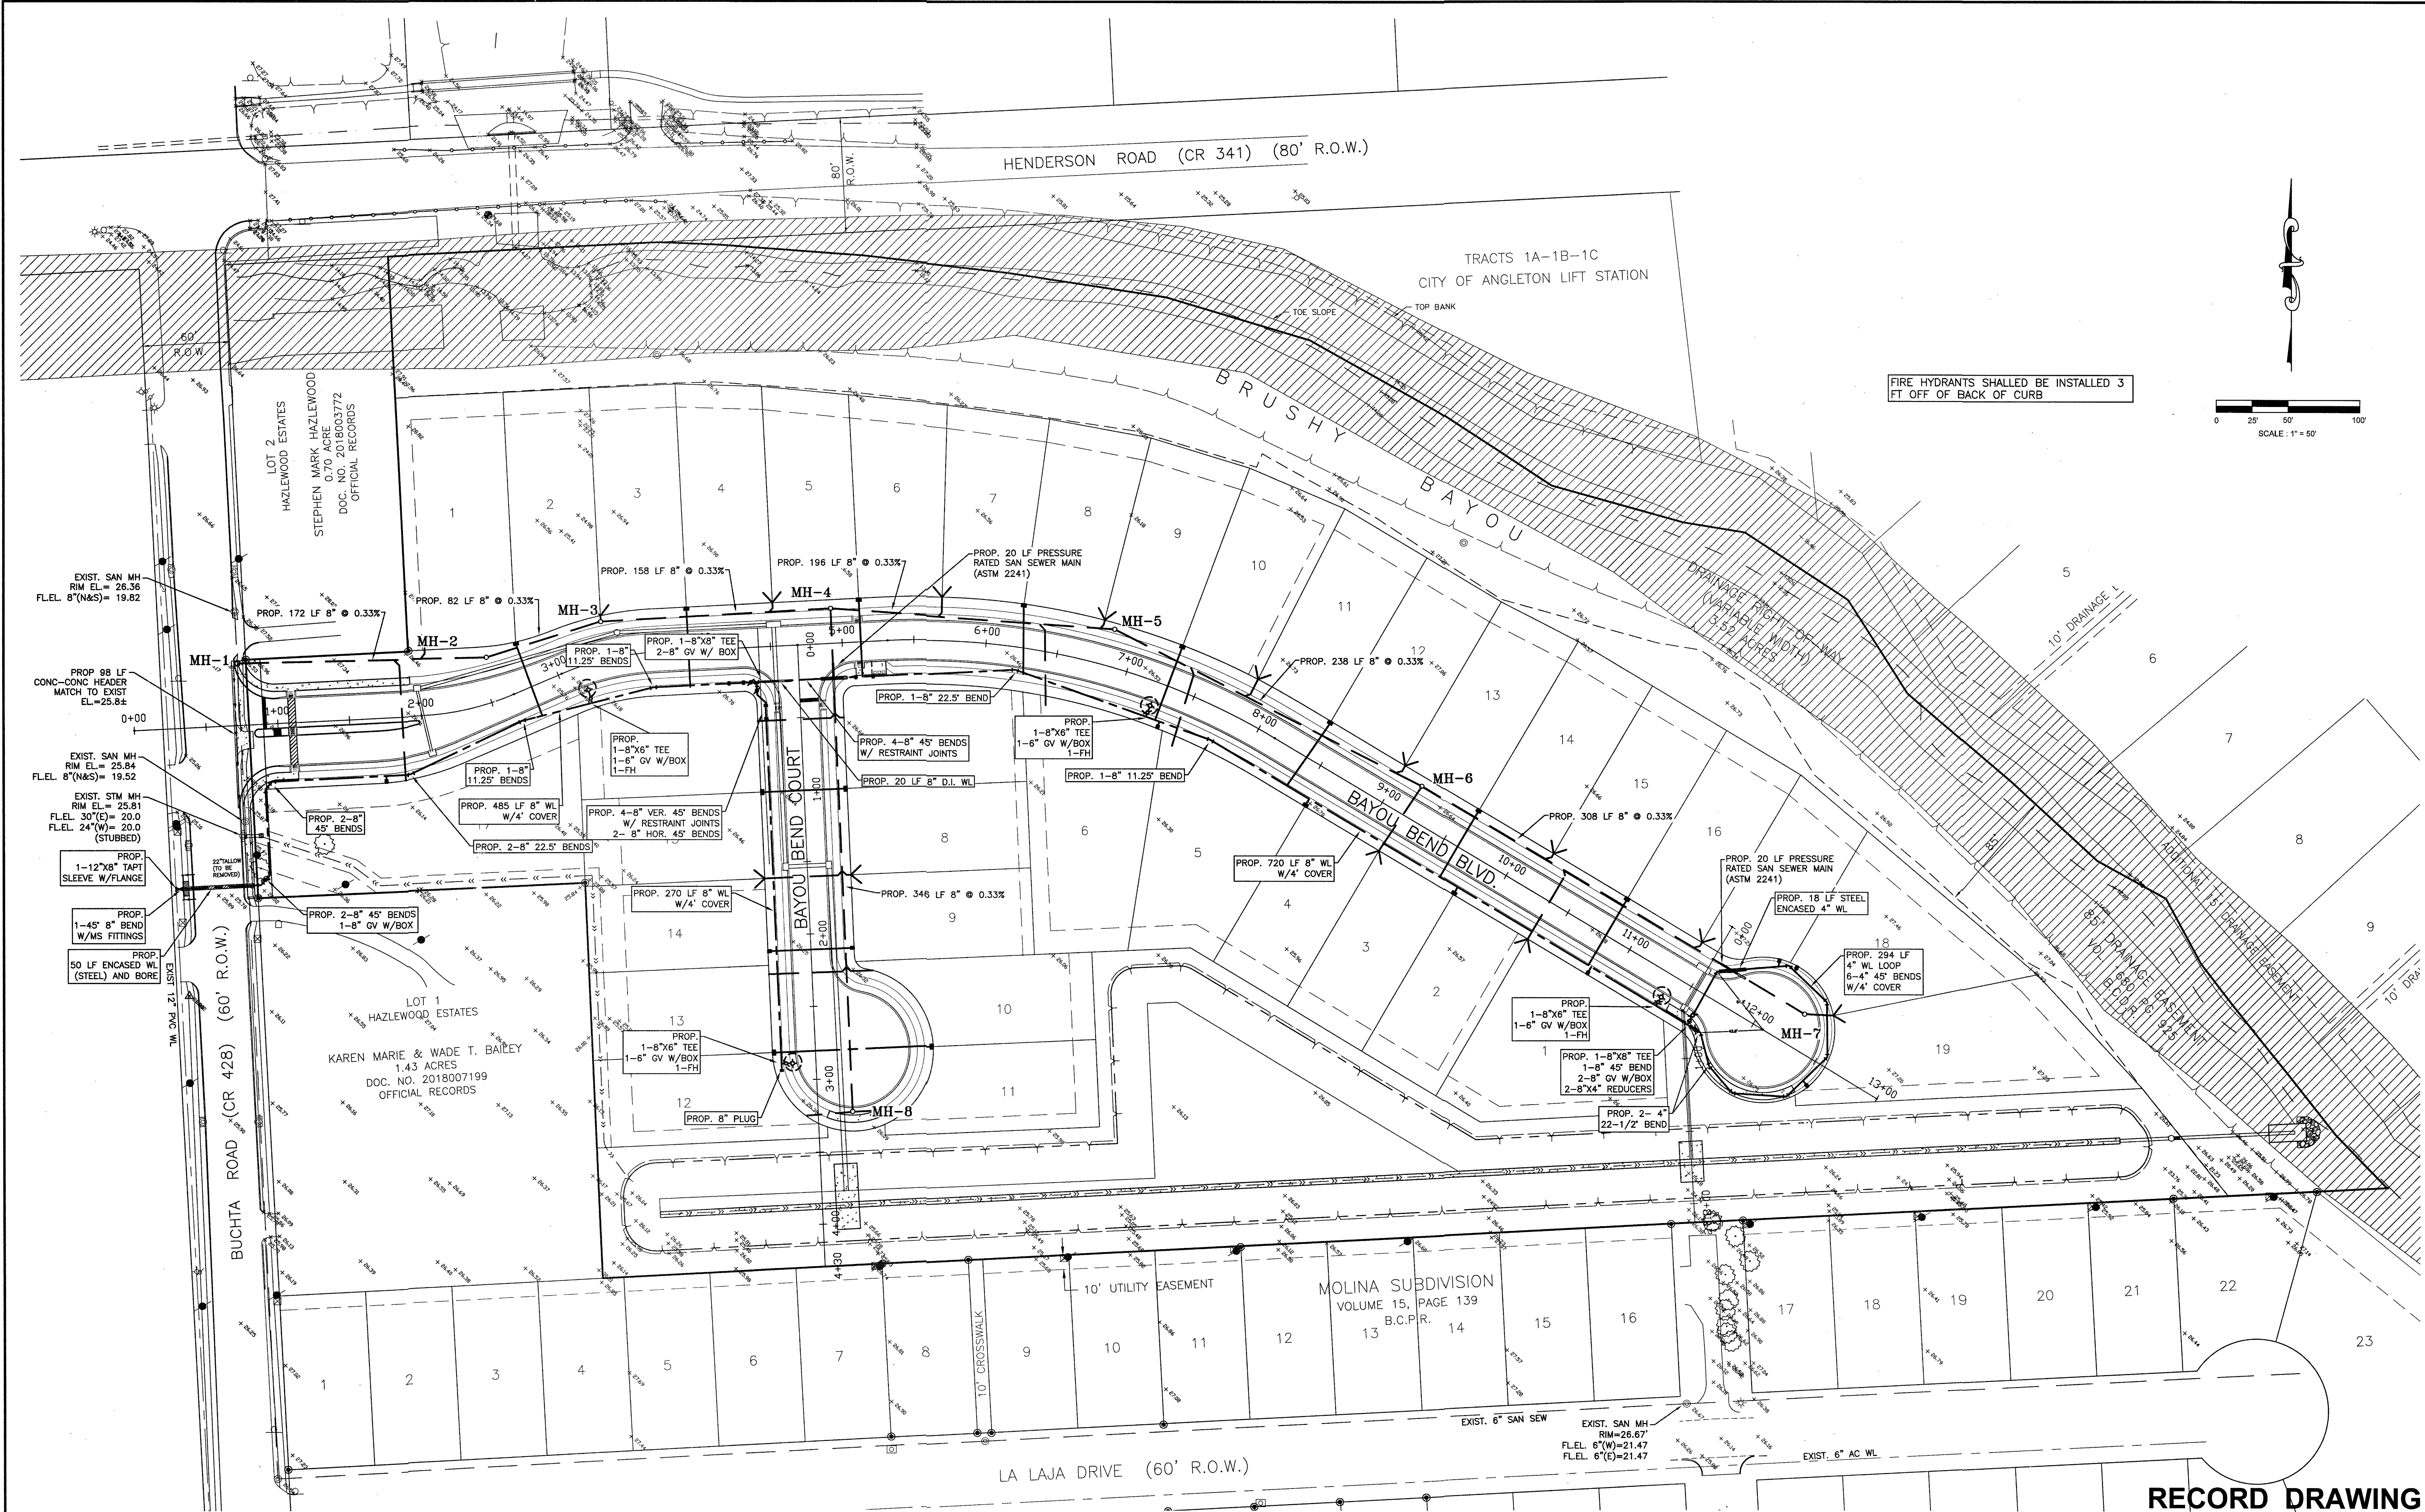

FIRE HYDRANTS SHALL BE INSTALLED 3 FT OFF OF BACK OF CURB

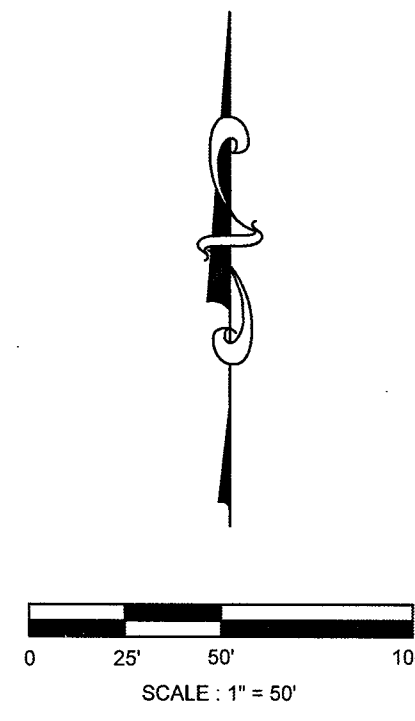

RECORD DRAWING

REVISIONS			
NO.	DATE	DESCRIPTION	APPROVED

DESIGNED	MS
DRAWN	
CHEKED	
DATE	

B & L
BAKER & LAWSON, INC.
ENGINEERS • PLANNERS • SURVEYORS
300 E CEDAR ST. ANGLETON, TEXAS 77515
PHONE: (979) 849-6681 FAX: (979) 849-6689
REG. NO. F-825



The seal appearing on this document was authorized by Miguel Saucedo P.E. 121992
Date: 11/11/22

OWNER:
Clint Peltier
Clint Peltier Custom Homes
979-481-4840



PLAN: 1" = 50'
PROFILE:
HORIZONTAL:
VERTICAL:

BAYOU BEND ESTATES
ANGLETON, TEXAS
PLANS FOR
GRADING, PAVING, UTILITIES
AND DETENTION

UTILITY PLAN

PROJECT NO. 13454

13454-SHEET SET.DWG

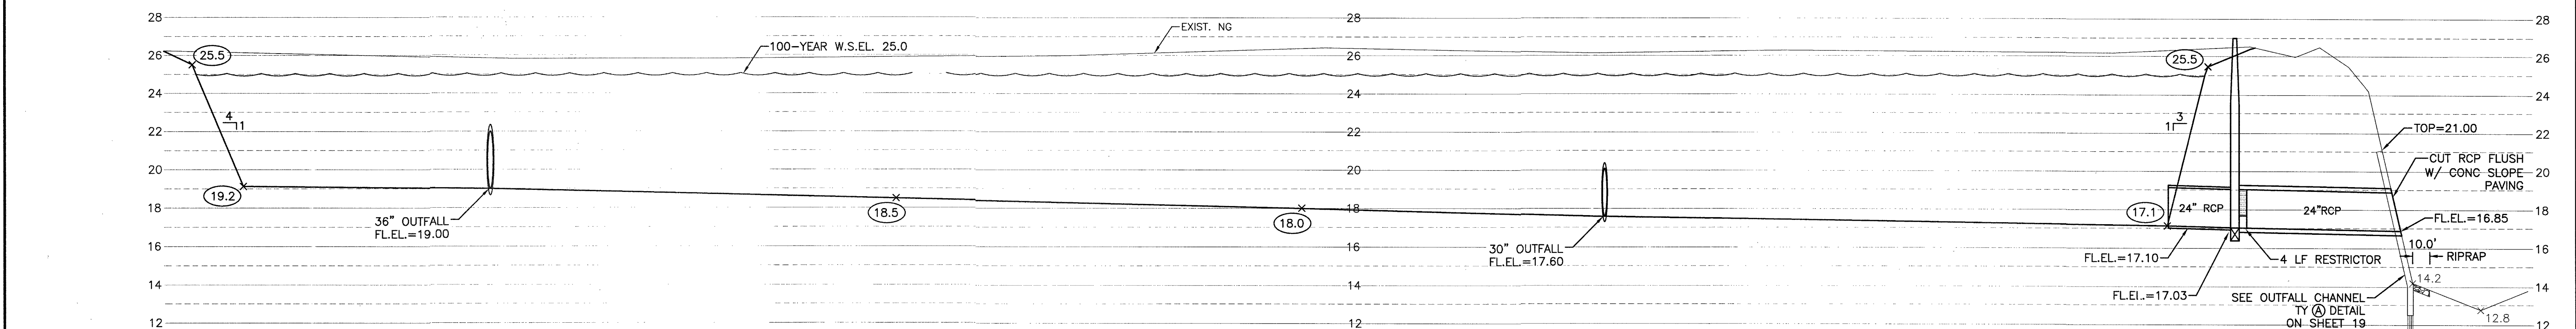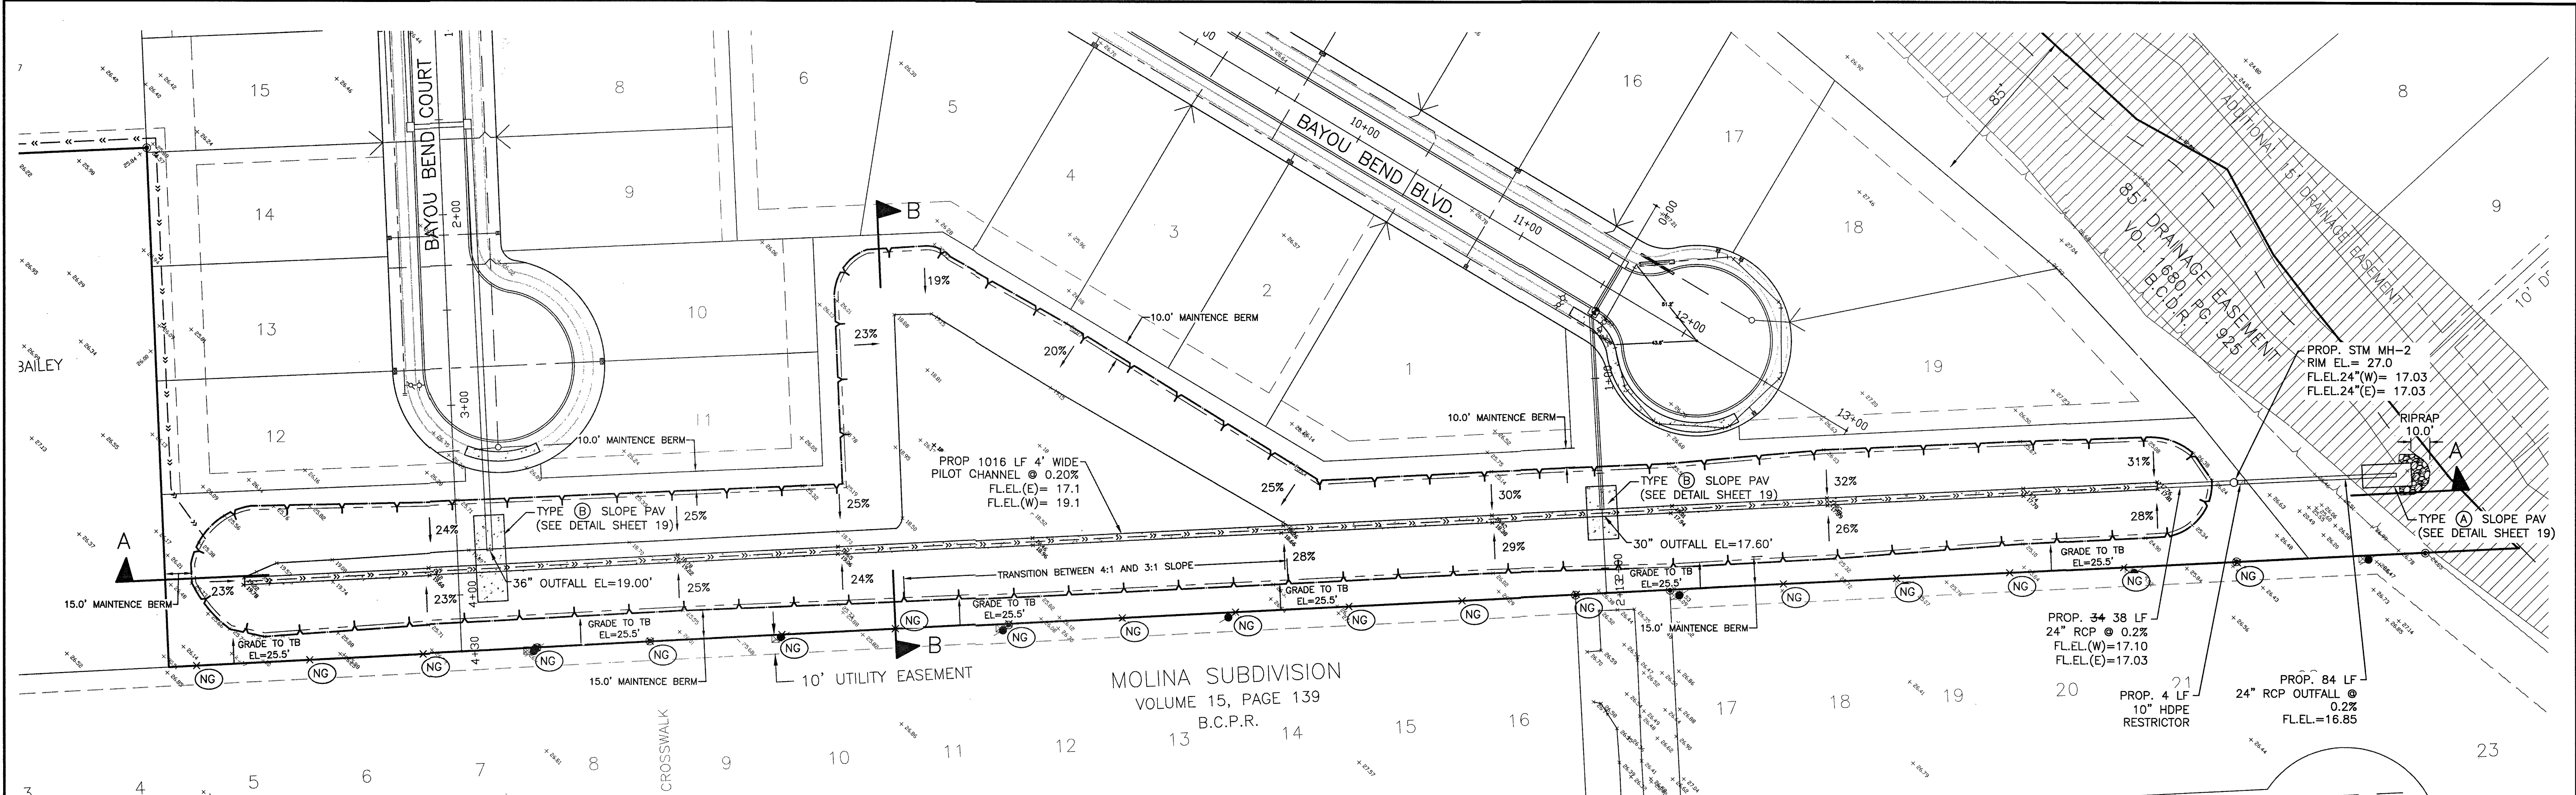

DETENTION CALCULATIONS

PRE-DEVELOPMENT FLOW RATE CALCULATION (100-YEAR STORM)

TC = 15.0 MIN. + 350 LF GRASS @ 0.5 FPS
 + 840 LF DITCH @ 1.5 FPS

1,400 = 6.583 IN/HR

$Q_{100} = 0.80 \text{ CFS/AC} \times 15.0 \text{ ACRES} = 12.0 \text{ CFS}$

MAXIMUM ALLOWABLE OUTFALL RATE IN 0.80 CFS PER ACRE
 ACCORDING TO BRAZORIA COUNTY MASTER DRAINAGE STUDY.

PROPOSED CONDITION (100-YEAR STORM)

$Q = CIA \times 1.25 \text{ PK}$

A = 15.0 ACRES



C = 0.55

TC = 15 MIN. + 100 LF GRASS @ 0.5 FPS
 + 750 LF STM SEW @ 3.0 FPS
 + 890 LF POND @ 1.5 FPS = 32.3 MIN.

I = 6.289 IN/HR

$Q = 0.55 \times 6.289 \times 15.0 > 1.25 = 64.857 \text{ CFS}$

DETENTION = 6.774 AC-FT = 295,075 CF

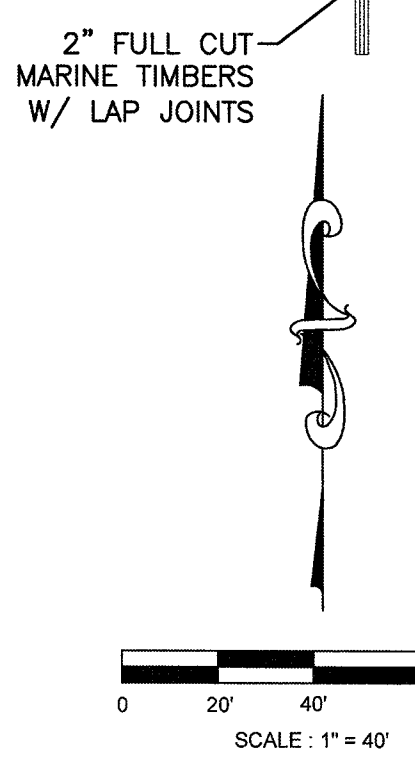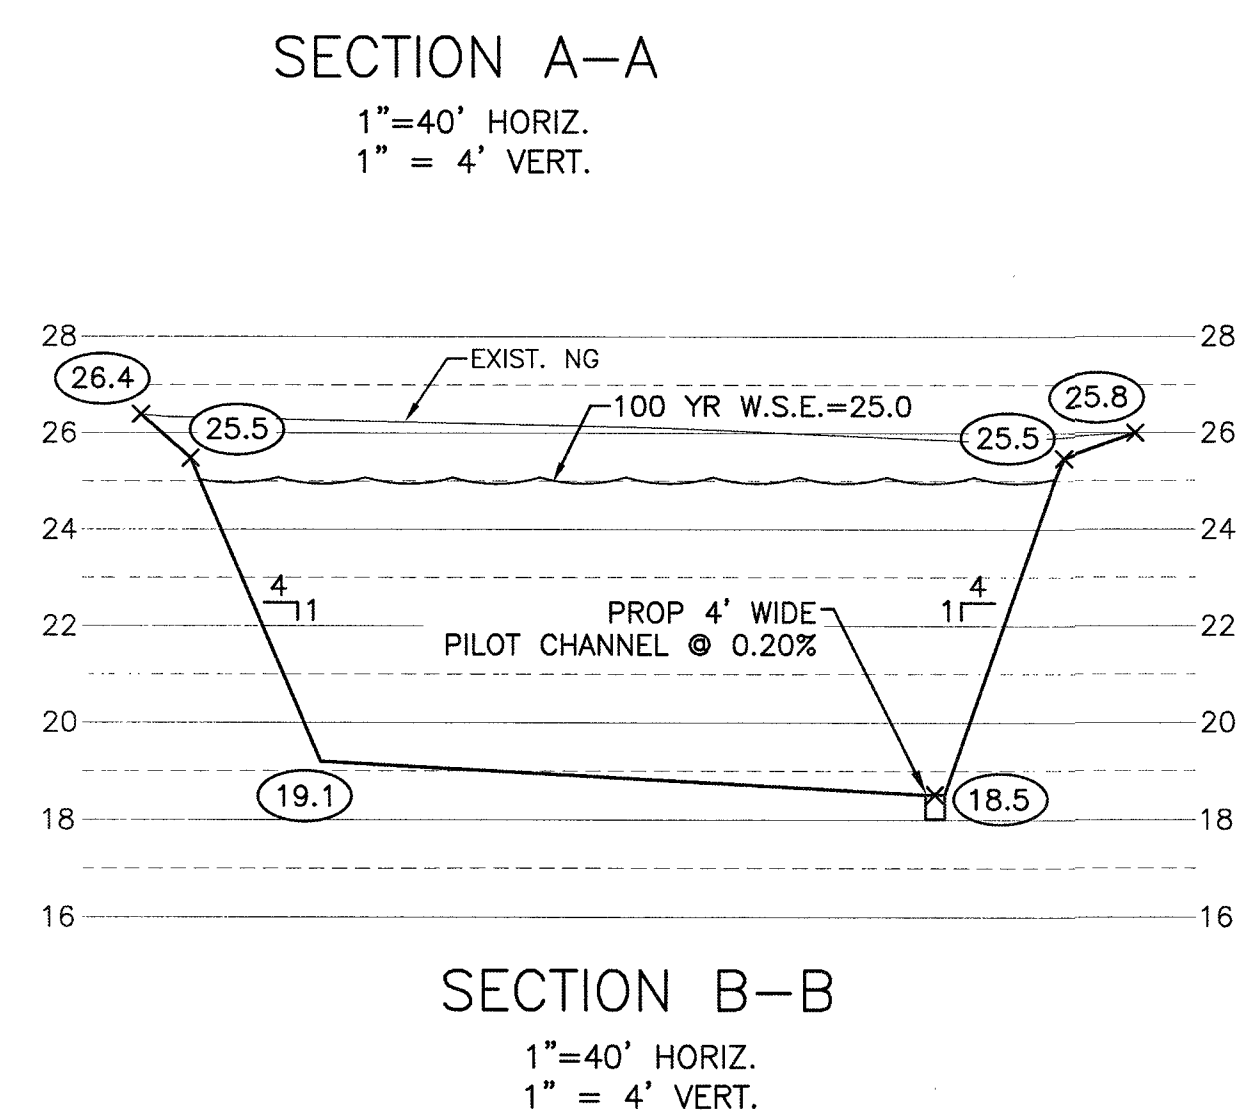

RECORD DRAWING



NO.	DATE	DESCRIPTION	APPROVED

DESIGNED MS

DRAWN

CHECKED

DATE

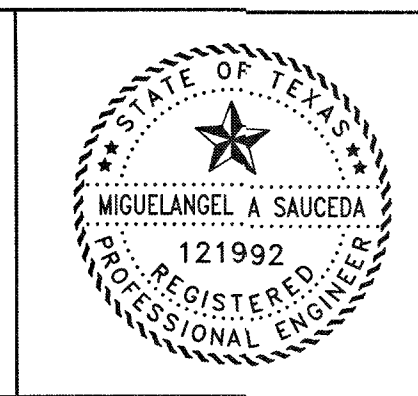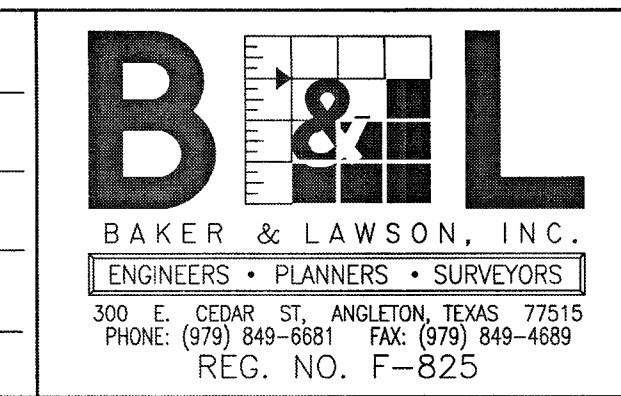

The seal appearing on this document was authorized by Miguel Saucedo P.E. 121992

Date: 1/11/22

OWNER:

Clint Peltier

Clint Peltier Custom Homes

979-481-4840

PLAN: 1" = 40'

PROFILE:

HORIZONTAL:

VERTICAL:

BAYOU BEND ESTATES

ANGLETON, TEXAS

PLANS FOR

GRADING, PAVING, UTILITIES


AND DETENTION

DETENTION POND

LAYOUT AND CROSS

SECTIONS

PROJECT NO. 13454

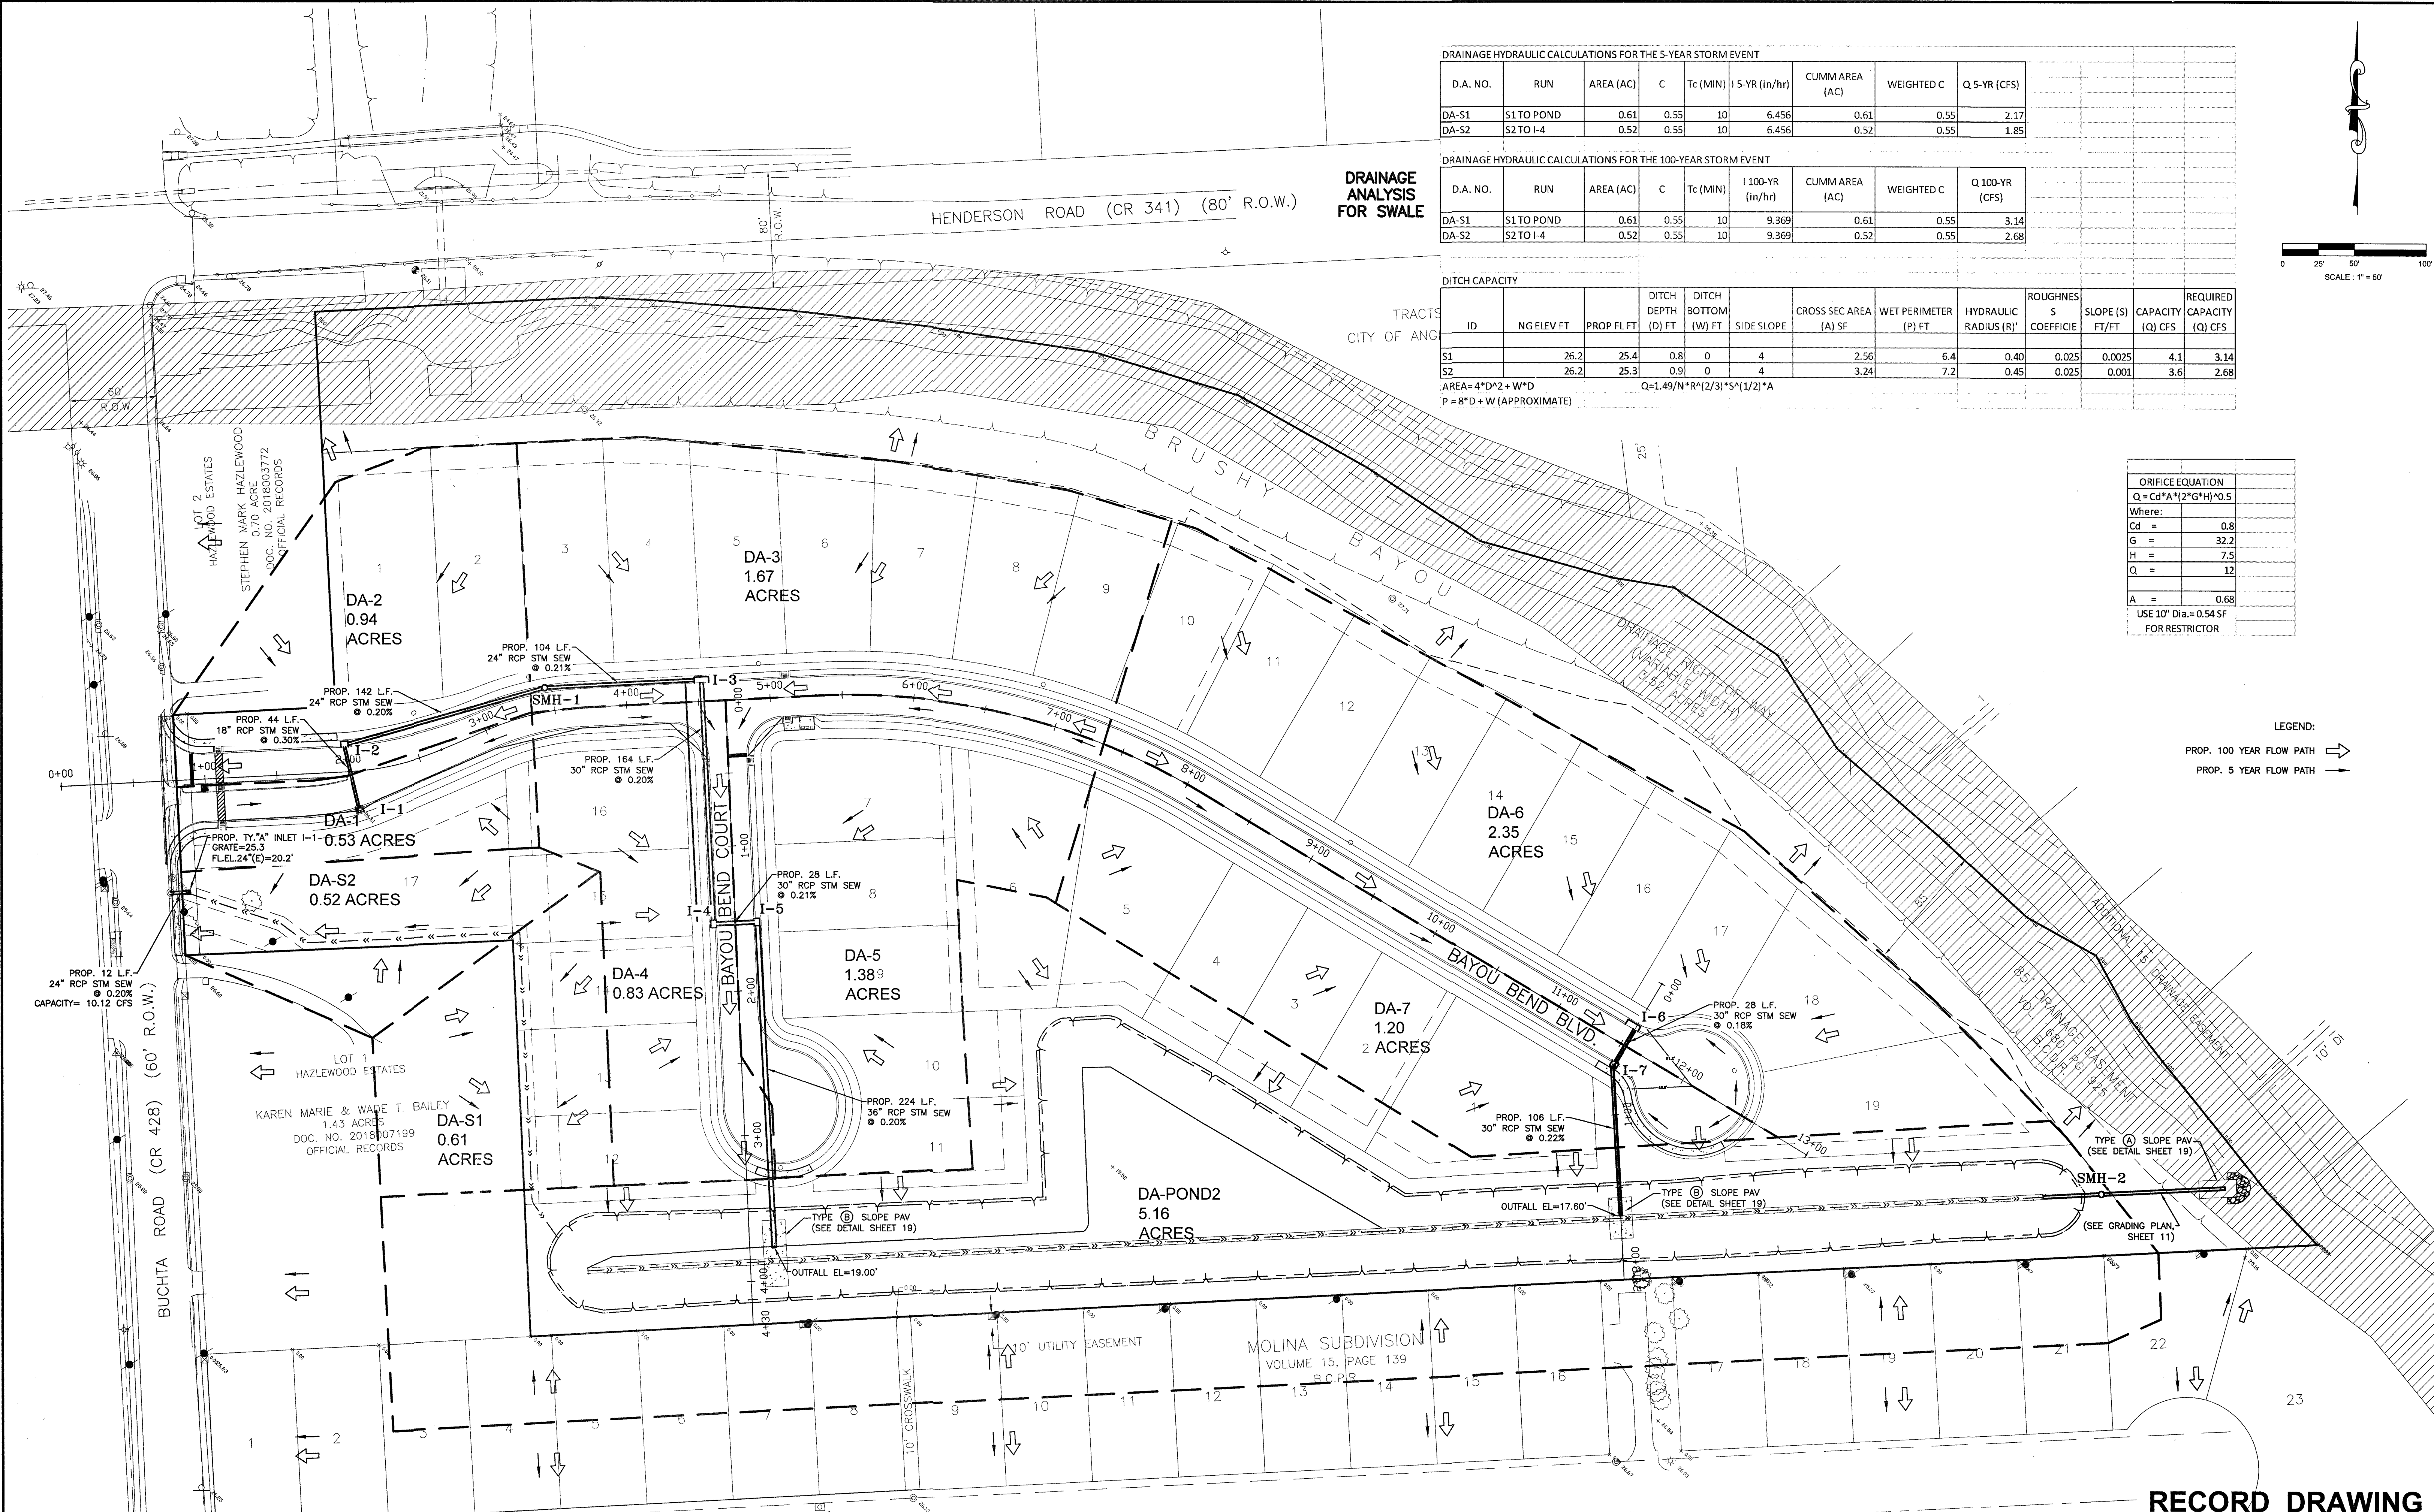

DRAINAGE ANALYSIS FOR SWALE

DRAINAGE HYDRAULIC CALCULATIONS FOR THE 5-YEAR STORM EVENT

D.A. NO.	RUN	AREA (AC)	C	Tc (MIN)	15-YR (in/hr)	CUMM AREA (AC)	WEIGHTED C	Q 5-YR (CFS)
DA-S1	S1 TO POND	0.61	0.55	10	6.456	0.61	0.55	2.17
DA-S2	S2 TO I-4	0.52	0.55	10	6.456	0.52	0.55	1.85

DRAINAGE HYDRAULIC CALCULATIONS FOR THE 100-YEAR STORM EVENT

D.A. NO.	RUN	AREA (AC)	C	Tc (MIN)	100-YR (in/hr)	CUMM AREA (AC)	WEIGHTED C	Q 100-YR (CFS)
DA-S1	S1 TO POND	0.61	0.55	10	9.369	0.61	0.55	3.14
DA-S2	S2 TO I-4	0.52	0.55	10	9.369	0.52	0.55	2.68

DITCH CAPACITY

ID	NGELEV FT	PROP FL FT	DITCH DEPTH (D) FT	DITCH BOTTOM (W) FT	SIDE SLOPE	CROSS SEC AREA (A) SF	WET PERIMETER (P) FT	HYDRAULIC RADIUS (R)'	ROUGHNESS COEFFICIE	SLOPE (S) FT/FT	CAPACITY (Q) CFS	REQUIRED CAPACITY (Q) CFS
S1	26.2	25.4	0.8	0	4	2.56	6.4	0.40	0.025	0.0025	4.1	3.14
S2	26.2	25.3	0.9	0	4	3.24	7.2	0.45	0.025	0.001	3.6	2.68

AREA=4*D*D/2 + W*D
P=8*D + W (APPROXIMATE)
Q=1.49/N*R^(2/3)*S^(1/2)*A


ORIFICE EQUATION

$Q = C_d A \sqrt{2gH}$

Where:

Cd	=	0.8
G	=	32.2
H	=	7.5
Q	=	12
A	=	0.68

USE 10" Dia. = 0.54 SF FOR RESTRICTOR

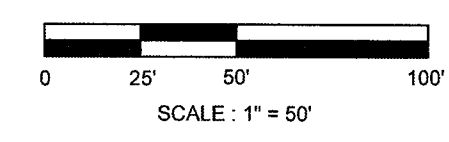

- LEGEND:
- PROP. 100 YEAR FLOW PATH (thick dashed line with arrow)
 - PROP. 5 YEAR FLOW PATH (thin dashed line with arrow)

RECORD DRAWING

DESIGNED	MS
DRAWN	
CHECKED	
DATE	

NO.	DATE	DESCRIPTION	APPROVED
REVISIONS			

The seal appearing on this document was authorized by Miguel Saucedo P.E. 121992

Date: 1/11/22

OWNER:

Clint Peltier

Clint Peltier Custom Homes

979-481-4840

PLAN: 1" = 50'

PROFILE:

HORIZONTAL:

VERTICAL:

BAYOU BEND ESTATES

ANGLETON, TEXAS

PLANS FOR

GRADING, PAVING, UTILITIES

AND DETENTION



DRAINAGE AREA MAP

AND STORM SEWER

LAYOUT

PROJECT NO. 13454

10

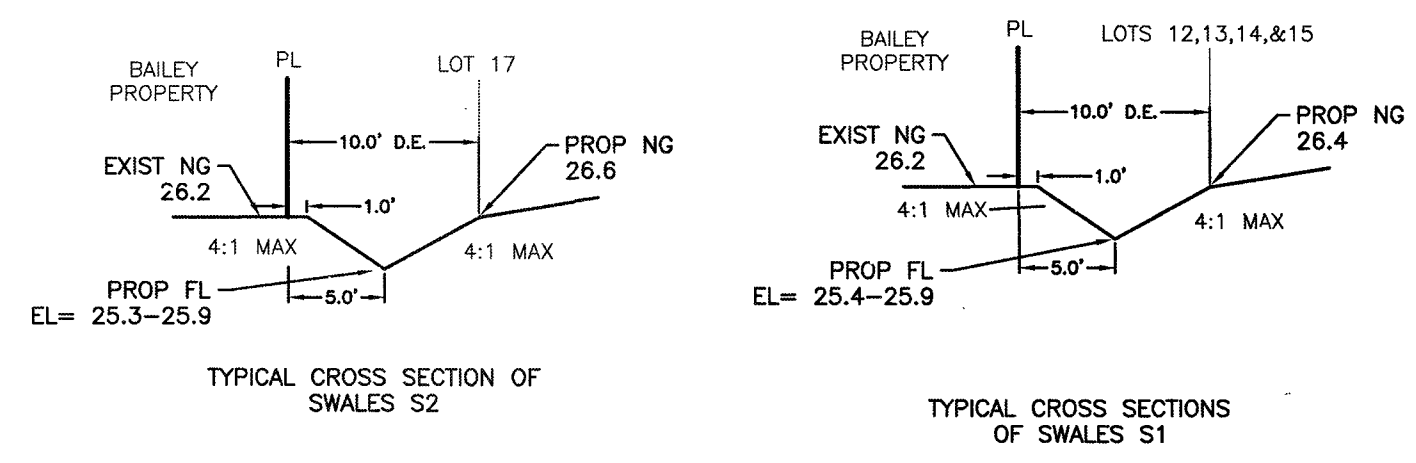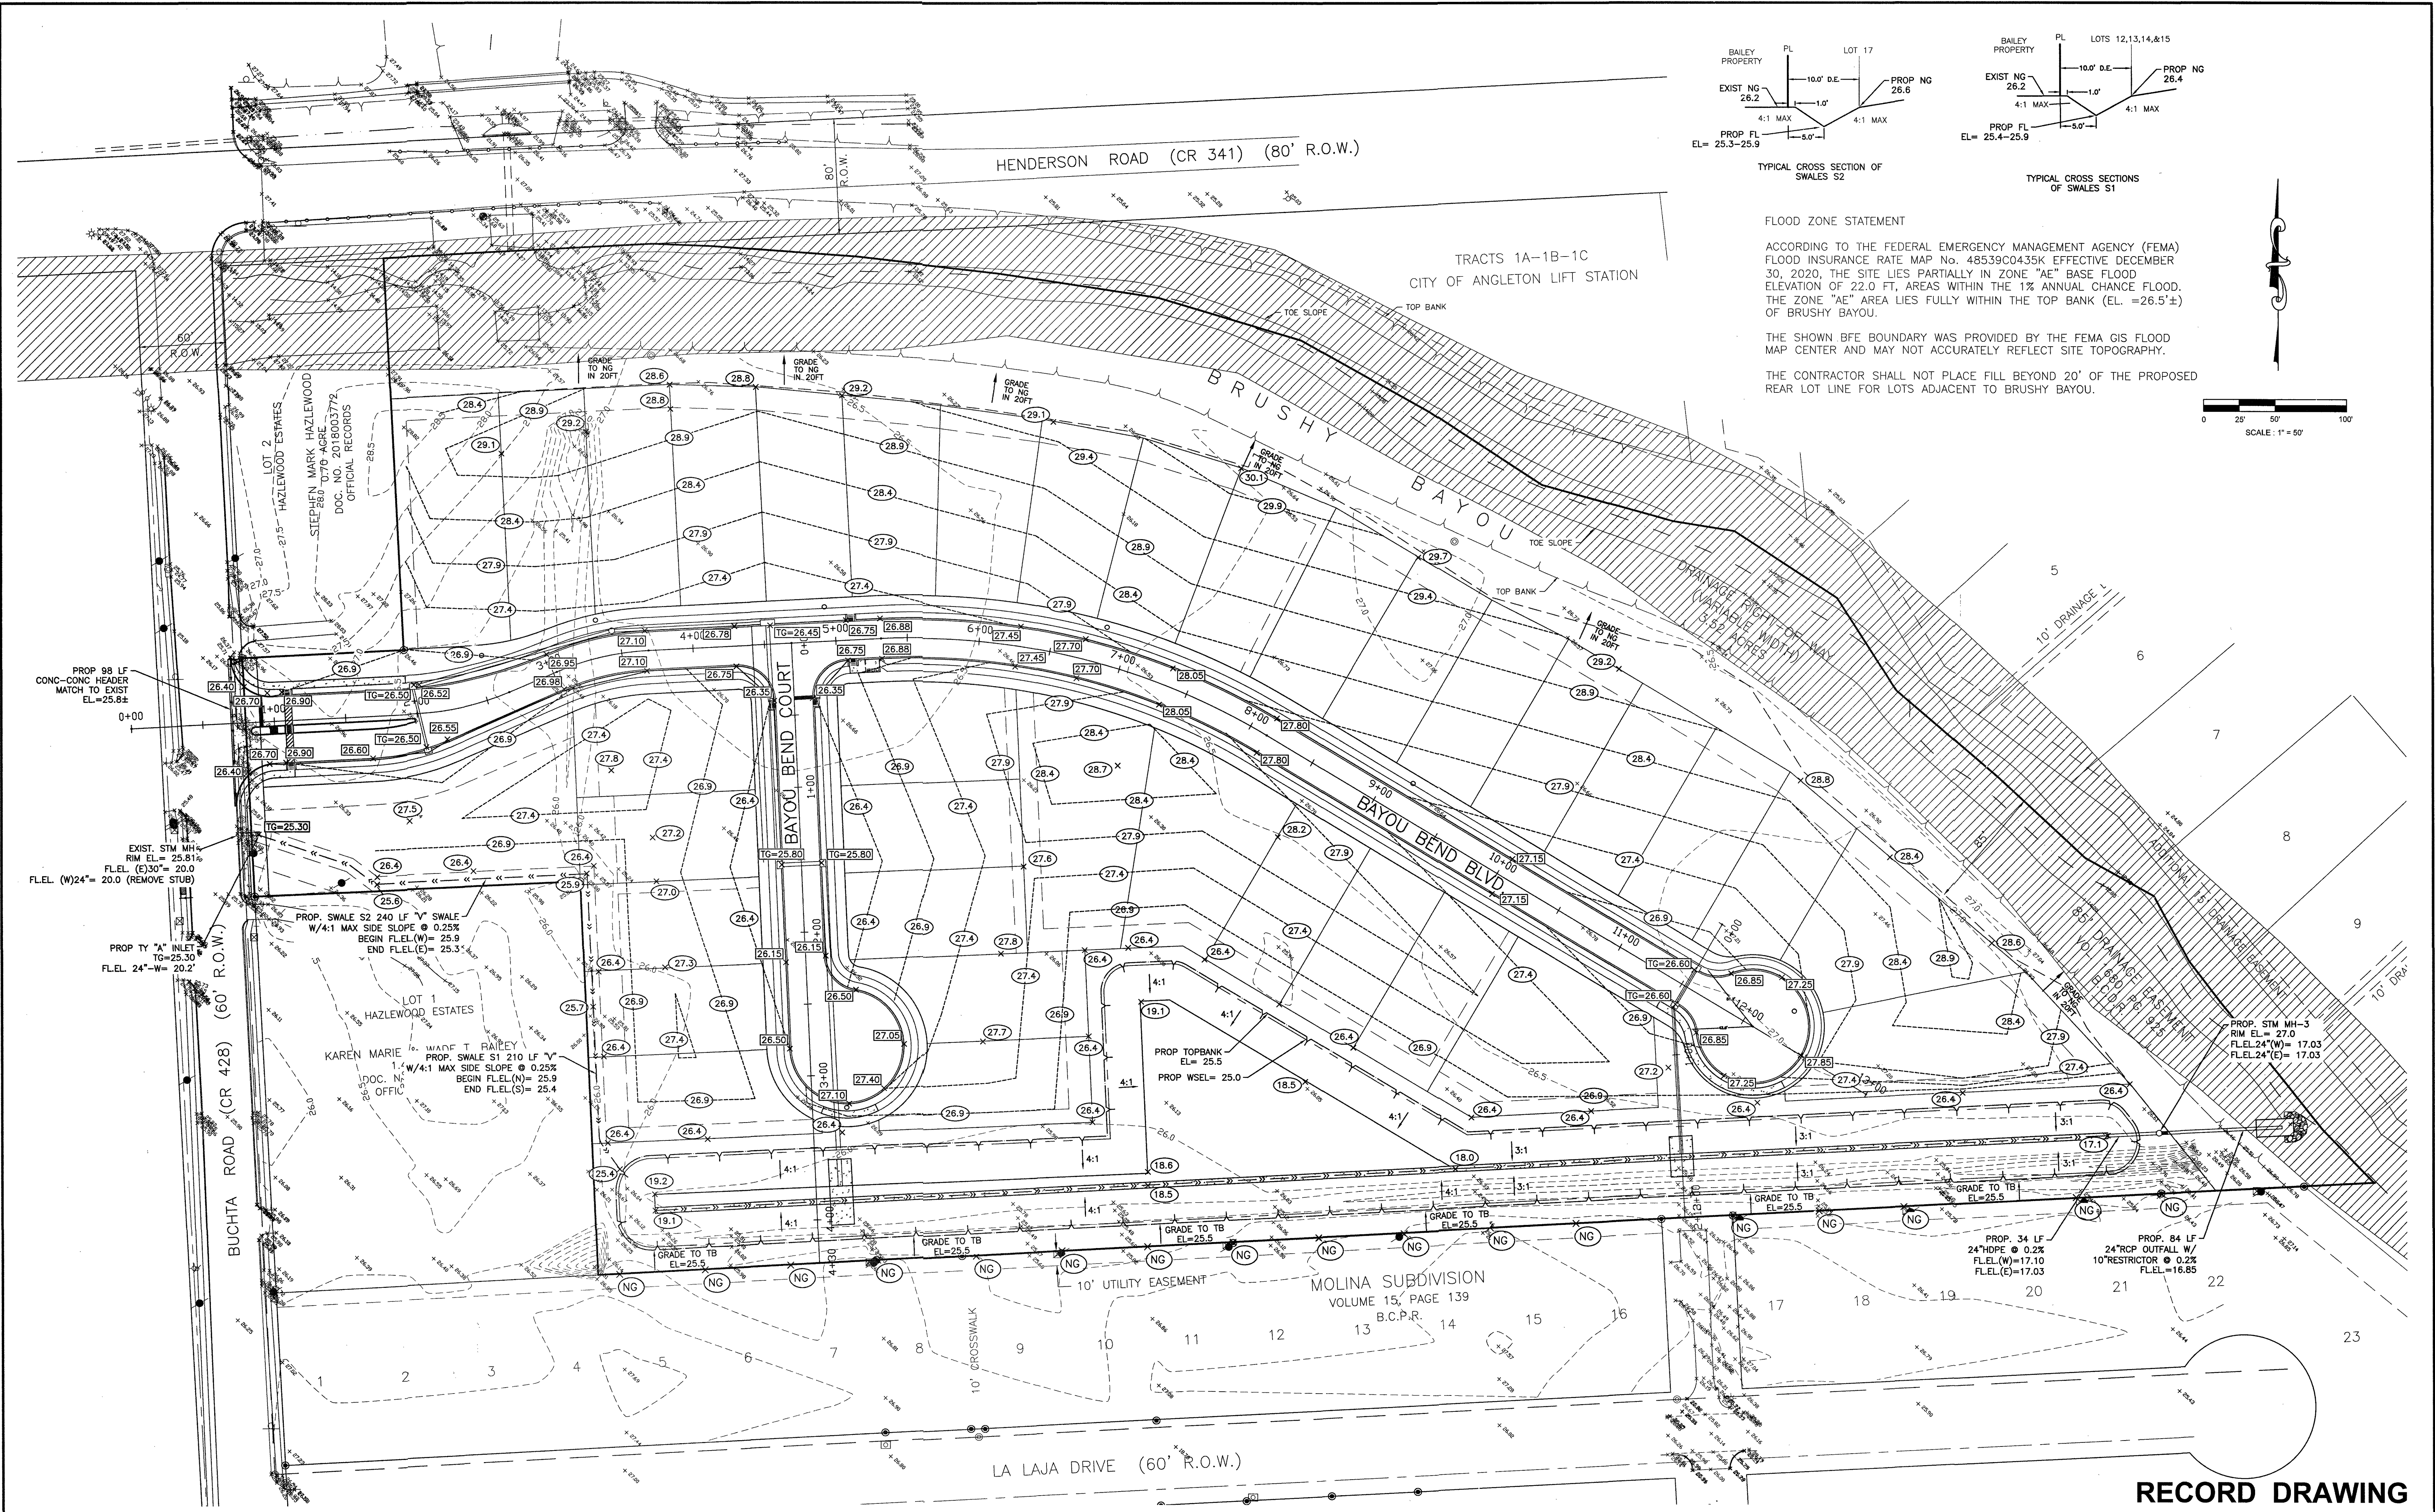


FLOOD ZONE STATEMENT

ACCORDING TO THE FEDERAL EMERGENCY MANAGEMENT AGENCY (FEMA) FLOOD INSURANCE RATE MAP No. 48539C0435K EFFECTIVE DECEMBER 30, 2020, THE SITE LIES PARTIALLY IN ZONE "AE" BASE FLOOD ELEVATION OF 22.0 FT, AREAS WITHIN THE 1% ANNUAL CHANCE FLOOD. THE ZONE "AE" AREA LIES FULLY WITHIN THE TOP BANK (EL. =26.5'±) OF BRUSHY BAYOU.

THE SHOWN BFE BOUNDARY WAS PROVIDED BY THE FEMA GIS FLOOD MAP CENTER AND MAY NOT ACCURATELY REFLECT SITE TOPOGRAPHY.


THE CONTRACTOR SHALL NOT PLACE FILL BEYOND 20' OF THE PROPOSED REAR LOT LINE FOR LOTS ADJACENT TO BRUSHY BAYOU.

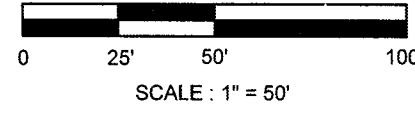

NO.	DATE	DESCRIPTION	APPROVED

DESIGNED MS
DRAWN
CHECKED
DATE

B & L
BAKER & LAWSON, INC.
ENGINEERS • PLANNERS • SURVEYORS
300 E CEDAR ST. ANGLETON, TEXAS 77515
PHONE: (979) 849-6681 FAX: (979) 849-6689
REG. NO. F-825

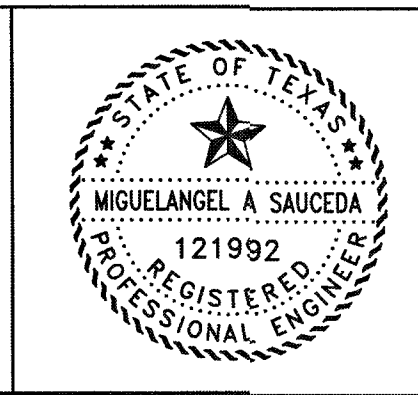

The seal appearing on this document was authorized by Miguel Saucedo P.E. 121992
Date: 1/11/24

OWNER:
Clint Peltier
Clint Peltier Custom Homes
979-481-4840

PLAN: 1" = 50'
PROFILE:
HORIZONTAL:
VERTICAL:



RECORD DRAWING

BAYOU BEND ESTATES
ANGLETON, TEXAS
PLANS FOR
GRADING, PAVING, UTILITIES
AND DETENTION

GRADING PLAN

PROJECT NO. 13454

11

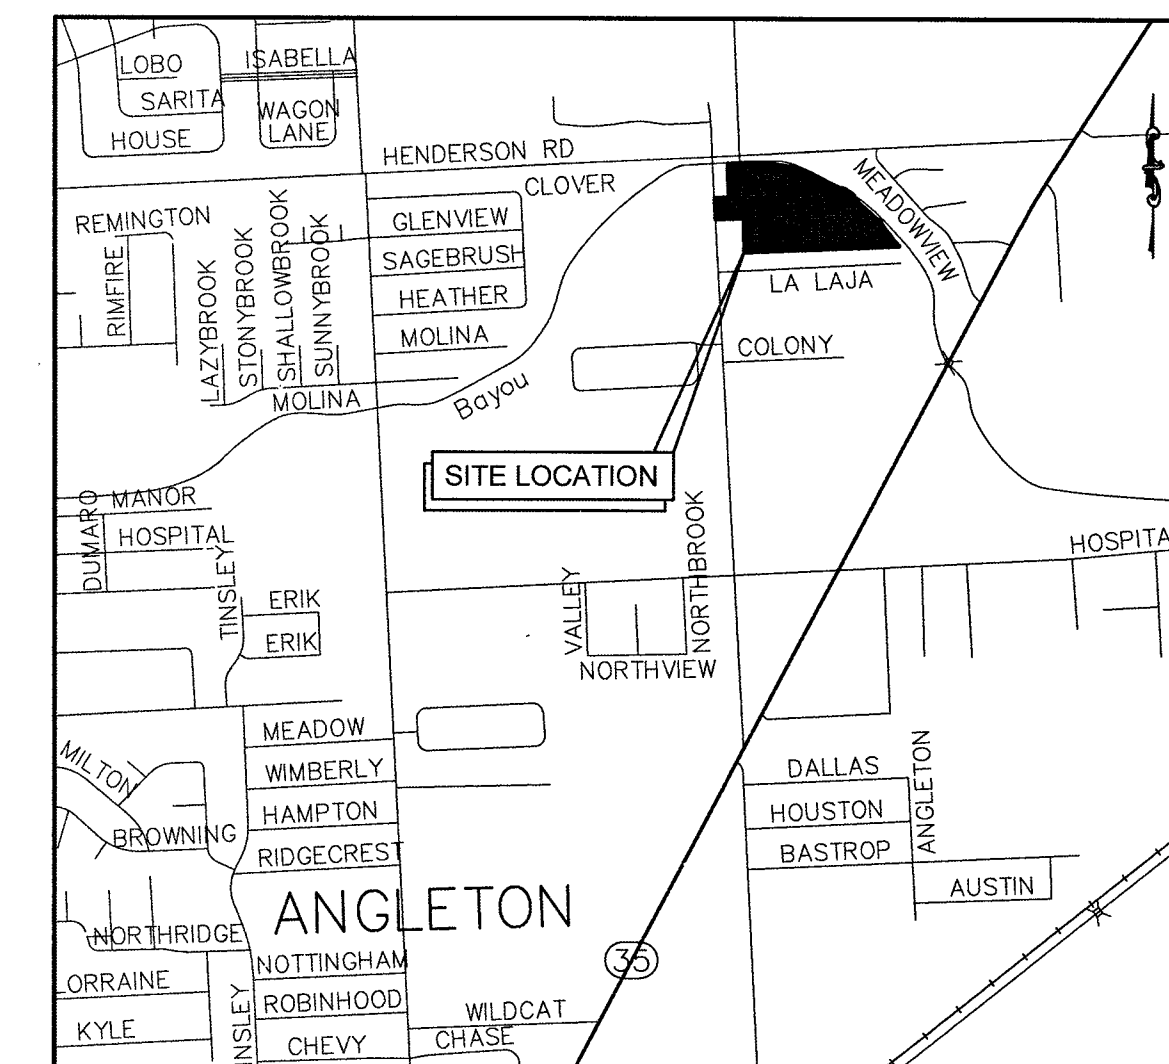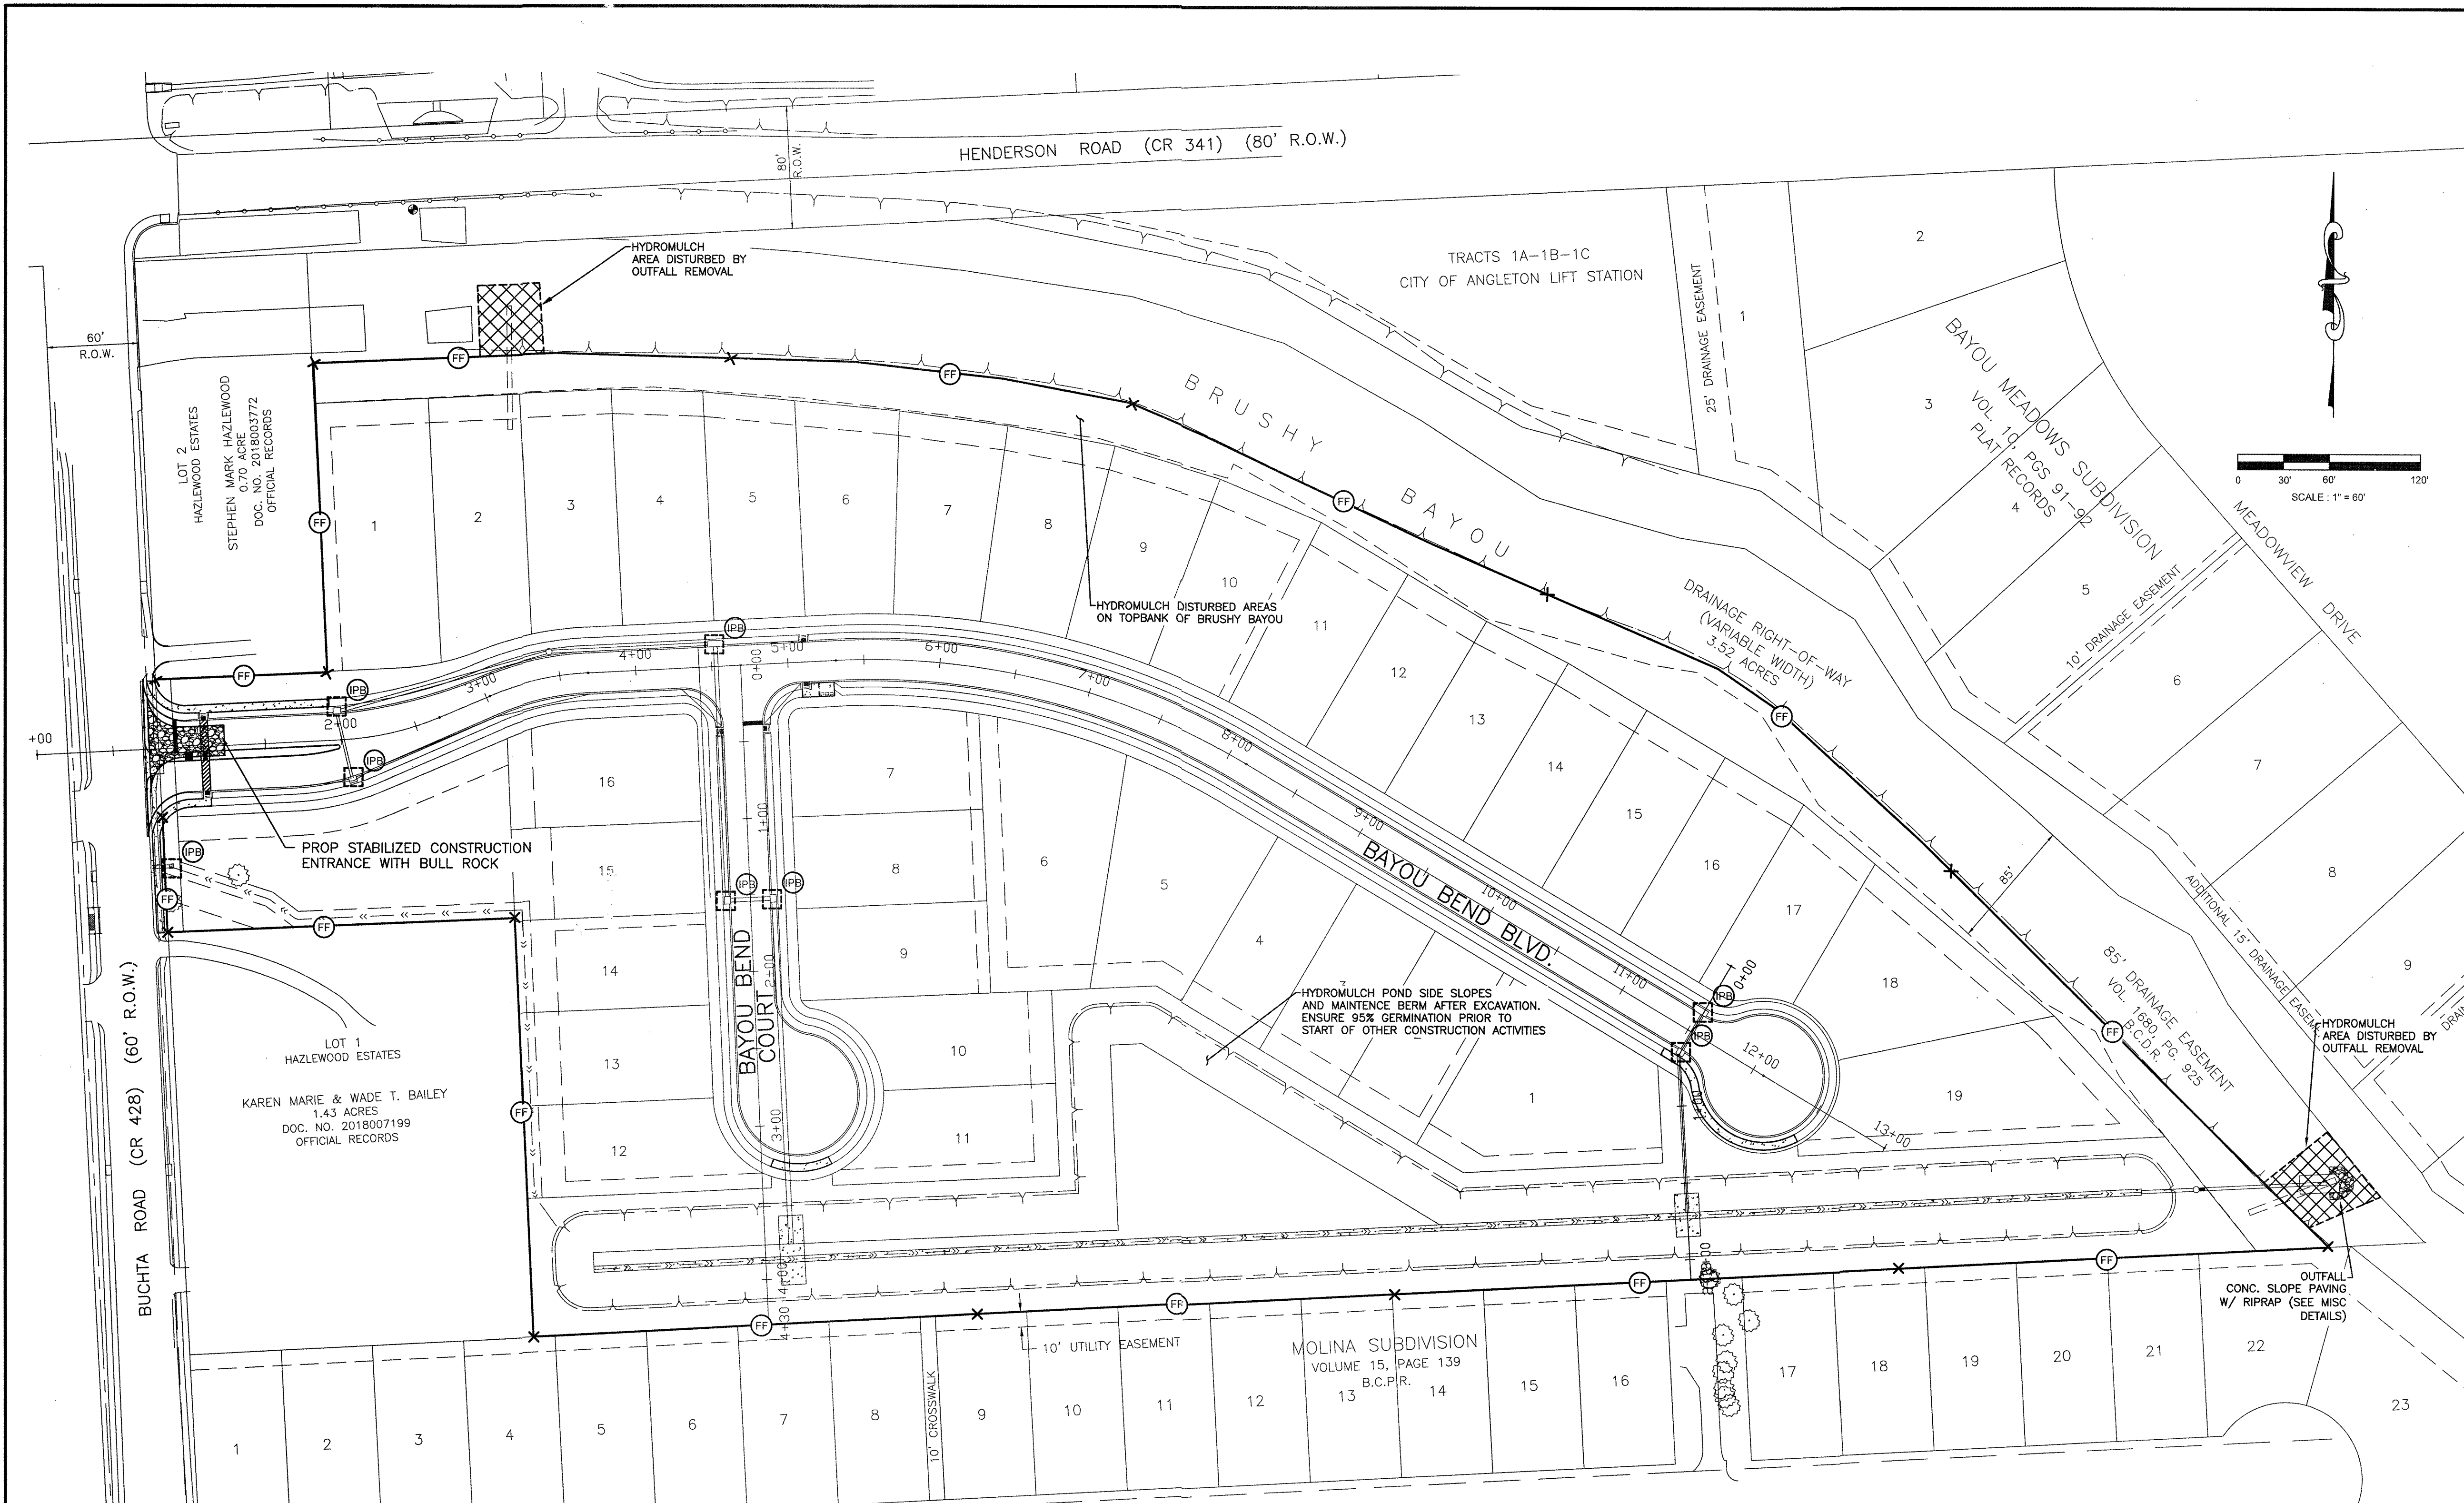

VICINITY MAP

PROJECT/SITE INFORMATION

PROJECT NAME: BAYOU BEND ESTATES SUBDIVISION
PROJECT ADDRESS/LOCATION: SE CORNER OF HENDERSON RD AND BUCHTA RD
CITY: ANGLETON STATE: TX ZIP CODE: 77515
LATITUDE: 29°07'22.4" LONGITUDE: 95°25'54.8" COUNTY: BRAZORIA
NAME OF RECEIVING WATERS: GULF OF MEXICO

08/01/2021 02/01/2022
MONTH/DAY/YEAR MONTH/DAY/YEAR
ESTIMATED CONSTRUCTION START DATE ESTIMATED COMPLETION DATE
ESTIMATE OF AREA TO BE DISTURBED: 13.5 ACRES
ESTIMATE OF LIKELIHOOD OF DISCHARGE:


☐ UNLIKELY ☐ ONCE PER WEEK ☐ CONTINUAL
☒ ONCE PER MONTH ☐ ONCE PER DAY

ARE THERE ANY LISTED ENDANGERED OR THREATENED SPECIES, OR DESIGNATED CRITICAL HABITAT IN THE PROJECT AREA?

☐ YES ☒ NO

ELIGIBILITY WITH REGARD TO PROTECTION OF ENDANGERED SPECIES HAS BEEN SATISFIED THROUGH THE INDICATED SECTION OF PART 1.B.3.e.(2) OF THE PERMIT.

(a) ☒ (b) ☐ (c) ☐ (d) ☐

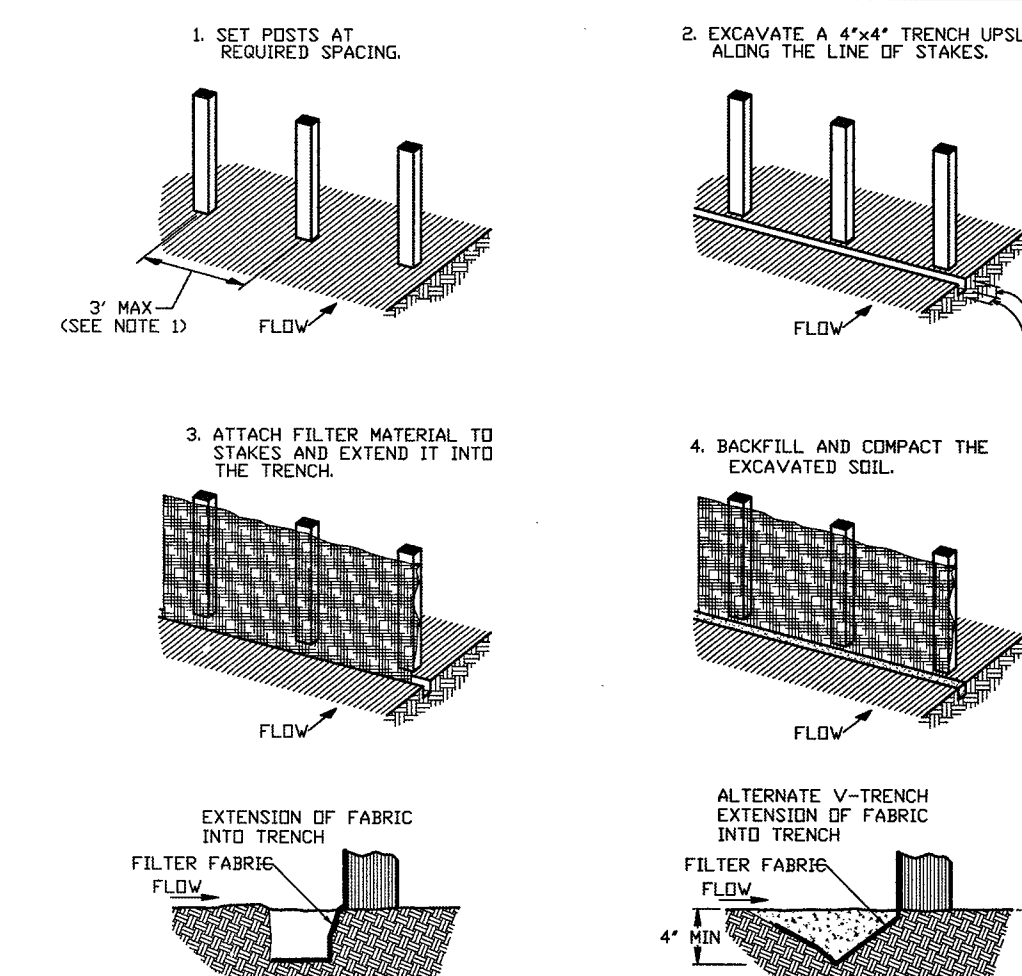

CONSTRUCTION NOTES:



1. 1 INCH THICK BY 2 INCH WOODEN STAKES TO BE SET AT MAX SPACING OF 3 FEET AND EMBEDDED A MIN OF 8 INCHES. IF PREASSEMBLED FENCE WITH SUPPORT NETTING IS USED, SPACING OF POST MAY BE INCREASED TO 8 FEET MAX.
2. ATTACH FILTER FABRIC TO WOODEN STAKES. FILTER FABRIC FENCE SHALL HAVE A MIN HEIGHT OF 18 INCHES AND MAX HEIGHT OF 36 INCHES ABOVE NATURAL GROUND.
3. WHEN TWO SECTIONS OF FILTER CLOTH ADJOIN EACH OTHER THEY SHOULD BE OVERLAPPED 6 INCHES AT THE POSTS, AND FOLDED.

FILTER FABRIC FENCE

RECORD DRAWING

NO.	DATE	DESCRIPTION	APPROVED
REVISIONS			

DESIGNED MS
DRAWN
CHECKED
DATE

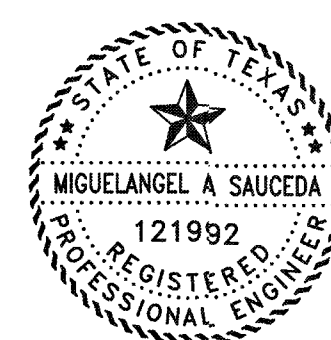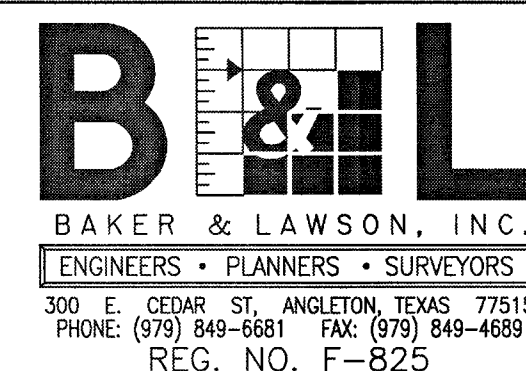

The seal appearing on this document was authorized by Miguel Saucedo P.E. 121992
Date: 1/11/22

OWNER:
Clint Peltier
Clint Peltier Custom Homes
979-481-4840

PLAN: 1" = 60'
PROFILE:
HORIZONTAL:
VERTICAL:

BAYOU BEND ESTATES
ANGLETON, TEXAS
PLANS FOR
GRADING, PAVING, UTILITIES
AND DETENTION

SWPPP LAYOUT
AND DETAILS

PROJECT NO. 13454

1. SITE DESCRIPTION

A. NATURE OF THE CONSTRUCTION ACTIVITY: BAYOU BEND ESTATES SUBDIVISION ANGLETON, BRAZORIA COUNTY, TEXAS, BEING 13.5 ACRE DEVELOPED AREA WHICH WILL BE A RESIDENTIAL SUBDIVISION OF 36 LOTS (60 FT WIDE MINIMUM). CONSTRUCTION WILL INCLUDE UNDERGROUND UTILITIES, STORM SEWER, CONCRETE ROADWAYS WITH 4" CURB, AND DETENTION POND.

B. INTENDED SEQUENCE OF MAJOR SOIL DISTURBING ACTIVITIES: STREET RIGHT OF WAY AND LOT AREAS WILL BE STRIPPED OF ALL VEGETATIVE MATTER. THIS MATERIAL WILL BE STOCKPILED AT THE SITE TO BE SPREAD OVER THE LOTS AFTER FINAL GRADING. THE DETENTION POND WILL BE EXCAVATED AND MATERIAL WILL BE SPREAD ON THE SITE. UTILITY AND STORMSEWER WILL REQUIRE TRENCHING WITH SPOILS TO BE SPREAD ON THE LOTS. RAINFALL RUNOFF WILL BE DIRECTED TO THE STREET GUTTERS AND THE CONSTRUCTED STORM SEWER. TRUCKS WILL BE USED TO DELIVER MATERIALS TO THE SITE AND INCLUDE LIME, CONCRETE, AND PIPE. TRUCKS WILL ALSO BE USED TO HAUL MATERIAL AWAY FROM THE SITE. THE TRUCKS WILL BE ROUTED ALONG BUCHTA ROAD FOR INGRESS AND EGRESS. RUTTING ON SITE DURING WET WEATHER WILL PROVIDE POTENTIAL FOR TRACKING MUD ALONG BUCHTA ROAD. THE CONTRACTOR IS RESPONSIBLE FOR CLEANING MUD TRACTED ONTO BUCHTA ROAD DAILY.

C. TOTAL PROJECT AREA: 15.87 ACRES

D. TOTAL AREA TO BE DISTURBED: 13.5 ACRES

WEIGHTED RUNOFF COEFFICIENT (BEFORE CONSTRUCTION): 0.30 (AFTER CONSTRUCTION): 0.55

E. REFER TO GENERAL LOCATION MAP AND SITE MAP FOR DRAINAGE PATTERNS AND APPROXIMATE SLOPES ANTICIPATED AFTER MAJOR GRADING ACTIVITIES; AREAS OF SOIL DISTURBANCE; AREAS WHICH WILL NOT BE DISTURBED; LOCTIONS OF MAJOR STRUCTURAL AND NON-STRUCTURAL CONTROLS; LOCATIONS WHERE STABILIZATION PRACTICES ARE EXPECTED TO OCCUR; LOCATION OF OFF-SITE MATERIAL, WASTE, BORROW OR EQUIPMENT STORAGE AREAS; SURFACE WATERS (INCLUDING WETLANDS); AND LOCATIONS WHERE STORM WATER DISCHARGES TO A SURFACE WATER.

F. LOCATION AND DESCRIPTION OF ANY DISCHARGE ASSOCIATED WITH INDUSTRIAL ACTIVITY OTHER THAN CONSTRUCTION:

G. NAME OF RECEIVING WATERS: DRAINAGE WILL BE COLLECTED IN THE PROPOSED DETENTION POND WHICH WILL DRAIN THRU A RESTRICTIVE OUTLET INTO BRUSHY BAYOU.

AREAL EXTENT AND DESCRIPTION OF WETLAND OR SPECIAL AQUATIC SITE AT OR NEAR THE SITE WHICH WILL BE DISTURBED OR WHICH WILL RECEIVE DISCHARGES FROM DISTURBED AREAS OF THE PROJECT.

NONE

H. REFER TO FEDERAL REGISTER, VOLUME 63, NO.128, MONDAY JULY 6, 1998, PAGES 36497 TO 36515 FOR REQUIREMENTS OF NPDES GENERAL PERMITS FOR STORM WATER DISCHARGES FROM CONSTRUCTION ACTIVITIES IN REGION 6.

I. LISTED ENDANGERED OR THREATENED SPECIES OR CRITICAL HABITAT FOUND IN PROXIMITY TO THE CONSTRUCTION ACTIVITY:

NONE

J. PROPERTY LISTED OR ELIGIBLE FOR LISTING ON THE NATIONAL REGISTER OF HISTORIC PLACES:

NONE

2. CONTROLS

NARRATIVE - SEQUENCE OF CONSTRUCTION ACTIVITIES AND APPROPRIATE CONTROL MEASURES DURING CONSTRUCTION

1. INSTALL SILT FENCE ALONG THE PERIMETER OF THE WORK AREA. CONSTUCT THE STABILIZED CONSTRUCTION ENTRANCE.
2. STRIPPING OF ALL VEGETATION MAY BEGIN. REMOVED VEGETATION WILL BE STOCKPILED AT THE SITE.
2. CUT ALL PERIMETER SWALES SHOWN ON THE LOT GRADING PLAN. THE DETENTION POND WILL BE EXCAVATED AND SPOILS WILL BE SPREAD ON SITE. INSTALL THE RESTRICTIVE OUTLET TO THE POND. COVER THE OUTLET WITH A ROCK BERM. HYDROMULCH THE POND SIDE SLOPES.
3. INSTALL WATERLINE, SANITARY SEWER, SERVICE LEAD, STORM SEWER, INLETS, AND MANHOLES. PROVIDE INLET PROTECTION ON ALL INLETS. ALL SPOILS FROM TRENCHING WILL BE SPREAD ON THE ADJACENT LOTS.
4. BEGIN ROADWAY EXCAVATION, LIME STABILIZATION, AND CONCRETE PAVING.
5. INSTALL CONCRETE CURB. PLACE AN 16" WIDE STRIP OF SOD BEHIND THE CURB. FILTER FABRIC FENCE INSTALLED FLUSH WITH BACK OF CURB MAY BE USED IN LIEU OF SOD.
6. PERFORM FINAL GRADE ON LOTS. SPREAD STOCKPILED VEGETATIVE MATERIAL OVER LOTS. SEED AND FERTILIZED ALL AREAS TO ENSURE GROWTH.

A. EROSION AND SEDIMENT CONTROLS: EROSION AND SEDIMENT CONTROLS SHALL RETAIN SEDIMENT ON SITE TO THE EXTENT PRACTICABLE. CONTROL MEASURES SHALL BE INSTALLED AND MAINTAINED IN ACCORDANCE WITH MANUFACTURER'S SPECIFICATIONS (WHERE APPLICABLE) AND GOOD ENGINEERING PRACTICES. OFFSITE SEDIMENT ACCUMULATIONS MUST BE REMOVED AT A FREQUENCY SUFFICIENT TO MINIMIZE OFFSITE IMPACTS. SEDIMENT MUST BE REMOVED FROM SEDIMENT TRAPS OR SEDIMENTATION PONDS WHEN CAPACITY HAS BEEN REDUCED BY 50%. LITTER, CONSTRUCTION DEBRIS, AND CONSTRUCTION CHEMICALS EXPOSED TO STORM WALL SHALL BE PREVENTED FROM BECOMING A POLLUTANT SOURCE FOR STORM WATER DISCHARGES.

SOIL STABILIZATION PRACTICES:	OWNER/ DEVELOPER	GENERAL CNTRTR.	BUILDER	OTHER
TEMPORARY SEEDING				
PERMANENT PLANTING, SODDING, OR SEEDING		X		
MULCHING- WHERE INDICATED		X		
SOIL RETENTION BLANKET				
VEGETATIVE BUFFER STRIPS				
PRESERVATION OF NATURAL RESOURCES				
OTHER: (RIP RAP)		X		

THE FOLLOWING RECORDS SHALL BE MAINTAINED AND ATTACHED TO THIS SWPPP: DATES WHEN MAJOR GRADING ACTIVITIES OCCUR, DATES WHEN CONSTRUCTION ACTIVITIES TEMPORARILY OR PERMANENTLY CEASE ON A PORTION OF THE SITE, DATES WHEN STABILIZATION MEASURES ARE INITIATED.

STRUCTURAL PRACTICES:	OWNER/ DEVELOPER	GENERAL CNTRTR.	BUILDER	OTHER
SILT FENCES		X		
HAY BALES				
ROCK BERMS		X		
DIVERSION, INTERCEPTOR, OR PERIMETER DIKES				
DIVERSION, INTERCEPTOR, OR PERIMETER SWALES		X		
DIVERSION DIKE AND SWALE COMBINATIONS				
PIPE SLOPE DRAINS				
ROCK BEDDING AT CONSTRUCTION EXIT		X		
TIMBER MATTING AT CONSTRUCTION EXIT				
SEDIMENT TRAPS (AT INLETS)		X		
SEDIMENT BASINS				
STORM INLET PROTECTION		X		
STONE OUTLET STRUCTURES				
OTHER:				

B. STORM WATER MANAGEMENT MEASURES INSTALLED DURING CONSTRUCTION TO CONTROL POLLUTANTS IN STORM WATER DISCHARGES THAT WILL OCCUR AFTER CONSTRUCTION:

CURBS & GUTTERS STORM SEWERS

C. OTHER CONTROLS

NO SOLID MATERIALS, INCLUDING BUILDING MATERIALS, SHALL BE DISCHARGED TO WATERS OF THE UNITED STATES, EXCEPT AS AUTHORIZED BY A PERMIT ISSUED UNDER SECTION 404 OF THE CLEAN WATER ACT.

WASTE MATERIALS: ALL WASTE MATERIALS WILL BE COLLECTED AND STORED IN A SECURELY LIDDED METAL CONTAINER. THE CONTAINER SHALL MEET ALL STATE AND CITY SOLID WASTE MANAGEMENT REGULATIONS. THE CONTAINER SHALL BE EMPTIED AS NECESSARY AND THE TRASH HAULED TO AN APPROPRIATE DUMP SITE. NO CONSTRUCTION MATERIALS WILL BE BURIED ON SITE.

HAZARDOUS WASTE (INCLUDING SPILL REPORTING): AT A MINIMUM, ANY PRODUCTS IN THE FOLLOWING CATEGORIES ARE CONSIDERED TO BE HAZARDOUS: PAINT, CLEANING SOLVENTS, ASPHALT PRODUCTS, PETROLEUM PRODUCTS, CHEMICAL ADDITIVES FOR SOIL STABILIZATION, AND CONCRETE CURING COMPOUNDS AND ADDITIVES. IN THE EVENT OF A SPILL WHICH MAY BE HAZARDOUS, THE SPILL COORDINATOR SHOULD BE CONTACTED IMMEDIATELY.

SANITARY WASTE: PORTABLE SANITARY FACILITIES WILL BE PROVIDED BY THE CONTRACTOR. ALL SANITARY WASTES WILL BE COLLECTED FROM PORTABLE UNITS AND SERVICED BY A LICENSED SANITARY WASTE MANAGEMENT CONTRACTOR.

OFFSITE VEHICLE TRACKING SHALL BE MINIMIZED BY:

- HAUL ROADS DAMPENED FOR DUST CONTROL LOADED
- X HAUL TRUCKS TO BE COVERED WITH TARPULIN
- X EXCESS DIRT ON ROAD REMOVED DAILY STABILIZED
- CONSTRUCTION ENTRANCE

OTHER: TRUCKS HAULING VEGETATION AND DEBRIS WILL BE MONITORED AND SHALL BE COVERED WITH TARPULINS IF REQUIRED TO PREVENT DUST OR OTHER PARTICLES FROM BLOWING OR FALLING FROM TRUCK.

REMARKS: ALL OPERATIONS WILL BE CONDUCTED IN A MANNER THAT WILL MINIMIZE AND CONTROL THE AMOUNTS OF SEDIMENT THAT MAY ENTER THE RECEIVING WATERS. DISPOSAL AREAS SHALL NOT BE LOCATED IN ANY WETLAND, WATERBODY, OR STREAMBED. CONSTRUCTION STAGING AREAS AND VEHICLE MAINTENANCE AREAS SHALL BE CONSTRUCTED BY THE CONTRACTOR IN A MANNER TO MINIMIZE THE RUNOFF OF POLLUTANTS.

3. MAINTENANCE

ALL EROSION AND SEDIMENT CONTROLS WILL BE MAINTAINED IN EFFECTIVE OPERATING CONDITION. IF A REPAIR IS NECESSARY IT SHALL BE DONE AT THE EARLIEST TIME POSSIBLE, BUT NO LATER THAN SEVEN CALENDAR DAYS AFTER THE GROUND HAS DRIED SUFFICIENTLY TO PREVENT FURTHER DAMAGE FROM HEAVY EQUIPMENT. THE AREAS ADJACENT TO DRAINAGE WAYS SHALL HAVE PRIORITY, FOLLOWED BY DEVICES PROTECTING STORM SEWER INLETS. MAINTENANCE SHALL BE PERFORMED BEFORE THE NEXT ANTICIPATED STORM EVENT OR AS SOON AS PRACTICABLE.

4. INSPECTION

AN INSPECTION WILL BE PERFORMED BY THE PERMITEE EVERY FOURTEEN DAYS AS WELL AS AFTER EVERY ONE-HALF INCH OR GREATER RAINFALL EVENT. AN INSPECTION AND RAINFALL REPORT WILL BE MADE AFTER EACH INSPECTION. ANY DEFICIENCIES WILL BE NOTED AND APPROPRIATE CHANGES SHALL BE MADE TO THE SYSTEM TO COMPLY WITH REQUIREMENTS.

5. NON-STORMWATER DISCHARGES

- FIRE HYDRANT FLUSHING
- X BUILDING WASHDOWN WITHOUT DETERGENTS
- X PAVEMENT WASHDOWN WITHOUT DETERGENTS
- X CONDENSATE
- UNCONTAMINATED GROUNDWATER
- UNCONTAMINATED FOUNDATION DRAINS

RECORD DRAWING

NO.	DATE	DESCRIPTION	APPROVED
REVISIONS			

DESIGNED	MS
DRAWN	
CHECKED	
DATE	


BAKER & LAWSON, INC.

ENGINEERS • PLANNERS • SURVEYORS

300 E. CEDAR ST., ANGLETON, TEXAS 77515

PHONE: (979) 849-6681 FAX: (979) 849-4689

REG. NO. F-825

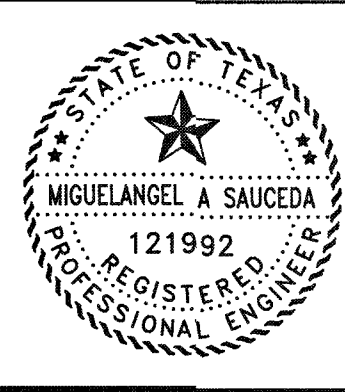

The seal appearing on this document was authorized by Miguel Saucedo P.E. 121992 Date: 1/11/22

OWNER:
Clint Peltier
Clint Peltier Custom Homes
979-481-4840

PLAN:
PROFILE:
HORIZONTAL:
VERTICAL:

BAYOU BEND ESTATES
ANGLETON, TEXAS
PLANS FOR
GRADING, PAVING, UTILITIES
AND DETENTION

SWPPP NARRATIVE

PROJECT NO. 13454

Drainage Analysis

Job # 13454 - Hazelwood, Buchta Rd, Angleton TX

Rainfall intensity calculations for Brazoria County

i = intensity (in/hr)
b = coefficient
t = time of concentration
d = coefficient
e = coefficient

subscript i=1 = 2year storm
i=2 = 5 year storm
i=3 = 10 year storm
i=4 = 25 year storm
i=5 = 50 year storm
i=6 = 100 year storm

i = 1..6

$b_i :=$	$b_b :=$	$d_i :=$
75.5	0.807	14.7
82.8	0.775	16.9
88.1	0.756	18.4
100.8	0.753	19.1
107.3	0.742	19.8
120.2	0.741	21.3

$T_{c0} := 32.1$

ENTER PREDEVELOPMENT
TIME OF CONCENTRATION

$$I_i := \frac{b_i}{(d_i + T_{c0})^{e_i}}$$

$I_6 = 6.307$ Predevelopment
Intensity of interest

$C_w := .1269$

ENTER PREDEVELOPMENT C VALUE

$A_w := 15.1$

ENTER AREA

$C_F := 1.00$

$$Q := C \cdot C_F \cdot I_6 \cdot A$$
$$Q = 12.085$$

Must Insert correct subscript for I to obtain the relevant Q

$$V_w := (C) \cdot A \cdot 43560 \cdot 1.08$$

$$V = 9.015 \times 10^4$$

For these calculations, total volume storage is assumed to
equal (C)*A with A converted to square feet multiplied
by 13" (1.08')

DEVELOPMENT OF RUNOFF HYDROGRAPH
MALCOM'S METHOD AS DESCRIBED IN THE
BRAZORIA COUNTY DRAINAGE CRITERIA
MANUAL

$$T := \frac{V}{1.39 \cdot Q}$$
$$T = 5.367 \times 10^3$$

T = Time to peak, presented as a function
of volume and peak flow and therefore
indirectly related to time of concentration

t := 0, 1000 .. 84000

$$f(t) := \left(\frac{Q}{2}\right) \cdot \left(1 - \cos\left(\frac{t \cdot \pi}{T}\right)\right)$$

f(t) describes rising limb of hydrograph

$$g(t) := 4.34 \cdot Q \cdot \exp\left[-1.30 \cdot \left(\frac{t}{T}\right)\right]$$


g(t) describes descending limb of hydrograph

$$q(t) := \text{if}(t \leq 1.25 \cdot T, f(t), g(t))$$

$$\text{Volume}_{\text{pre}} := \int_0^{86400} q(t) dt$$

$$\text{Volume}_{\text{pre}} = 9.047 \times 10^4$$

Predevelopment hydrograph

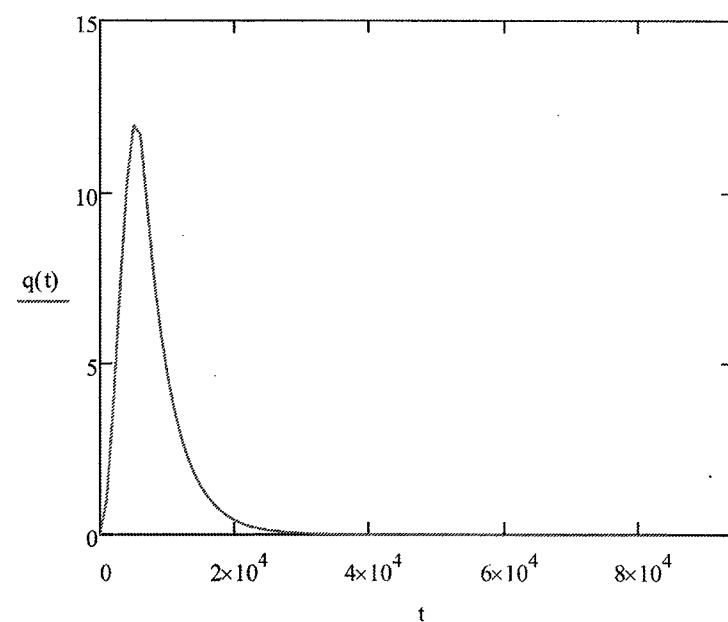

$T_{c0} := 29.1$

ENTER POST DEVELOPMENT TIME OF
CONCENTRATION

$$I_i := \frac{b_i}{(d_i + T_{c0})^{e_i}}$$

$I_6 = 6.583$ Post development I of interest

$C_w := 0.55$

ENTER POST DEVELOPMENT C FACTOR
REVISE C1 AND AREA IF NECESSARY

$C_{w1} := 1.25$

$$Q_w := C \cdot I_6 \cdot A \cdot C_F$$

$$Q = 68.337$$

$$V_w := (C) \cdot A \cdot 43560 \cdot 1.08$$

$$V = 3.907 \times 10^5$$

$$T := \frac{V}{1.39 \cdot Q}$$
$$T = 4.113 \times 10^3$$

t := 0, 1000 .. 25000

$$f(t) := \left(\frac{Q}{2}\right) \cdot \left(1 - \cos\left(\frac{t \cdot \pi}{T}\right)\right)$$


$$g(t) := 4.34 \cdot Q \cdot \exp\left[-1.30 \cdot \left(\frac{t}{T}\right)\right]$$

$$r(t) := \text{if}(t \leq 1.25 \cdot T, f(t), g(t))$$


$$\text{Volume}_{\text{post}} := \int_0^{86400} r(t) dt$$

$$\text{Volume}_{\text{post}} = 3.921 \times 10^5$$

Post development
hydrograph

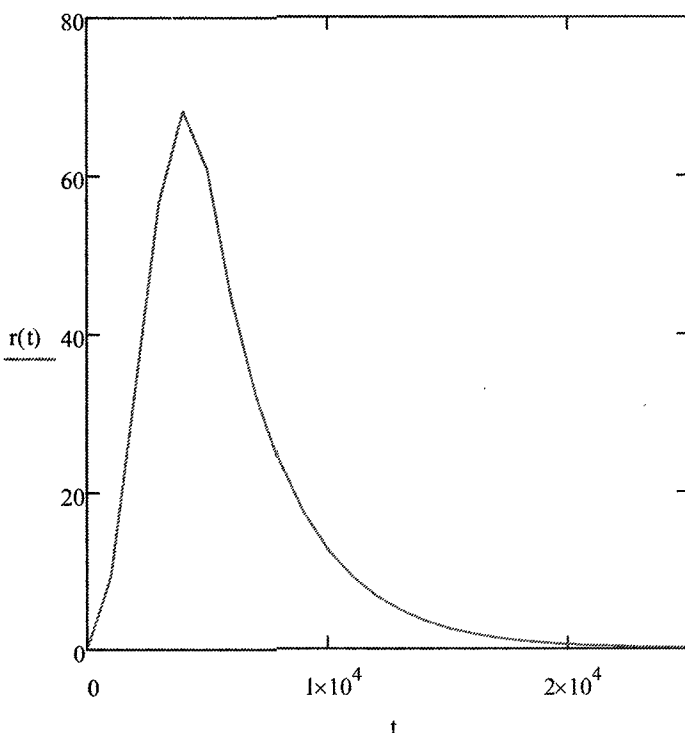

Combined pre and post development
hydrographs

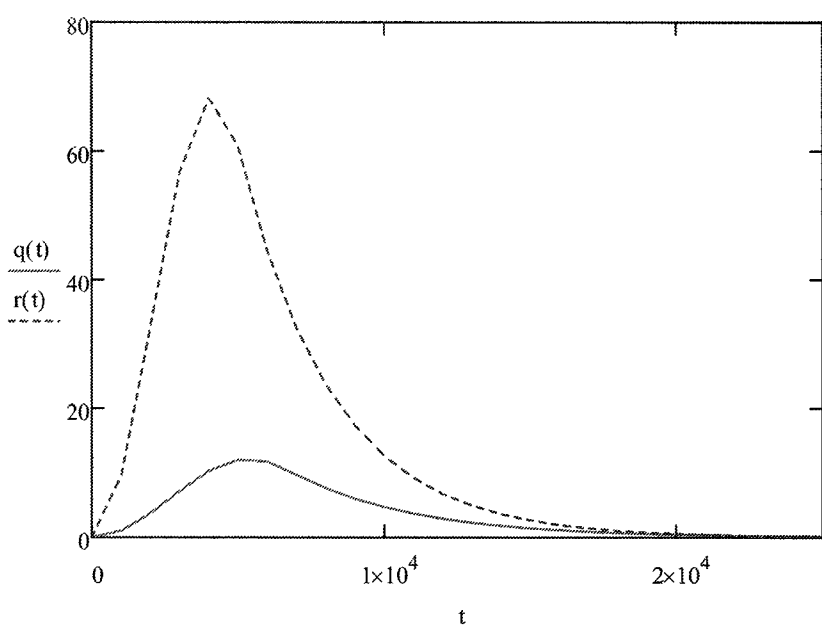

$$ff(t) := ((r(t) - q(t))) \cdot 1$$

$$v(t) := \text{if}(ff(t) > 0, f(t), 0)$$

THE REQUIRED STORAGE COMPUTED
AS THAT PART OF THE POST DEVELOPMENT
HYDROGRAPH THAT FALLS ABOVE THE
PREDEVELOPMENT HYDROGRAPH

ACRE- FEET

$$\int_0^{86400} v(t) dt$$
$$\frac{121992}{43560} = 6.928$$

Hydrological and Hydraulic Impacts
Hazelwood - Buchta Road, Angleton TX
Job # 13454

Brazoria County, Texas

A = 15.1 Acre Development :

Pre Development:

C = 0.1269
TC = 32.1 Minutes, I = 6.307 in/hr
Q = 100 Year Storm = 12.085 cfs

Post Development

C = 0.55
T/C = 29.1 Minutes, I = 6.583 in/hr
Q = 100 Year Storm = 68.337 cfs

Required Detention:

6.928 acre - feet (301,784 c.f.)

Maximum allowable outfall rate is 0.80 cfs/acre
as according to Bra Co Master Study for
Drainage Areas BB35 & BB36 of Bastrop Bayou

Pre Q100= 0.80 x 15.1 = 12.08 CFS

Miguel Saucedo, P.E. December 18, 2020



RECORD DRAWING

DESIGNED MS

DRAWN

CHECKED

DATE

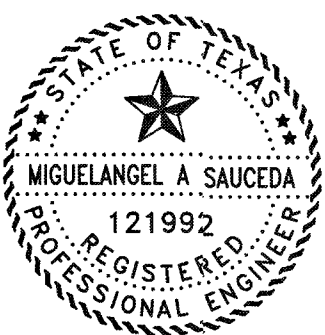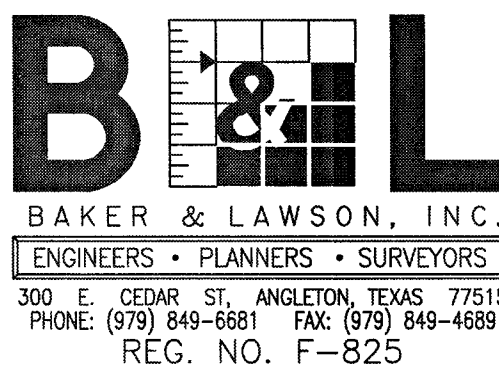

The seal appearing on
this document was
authorized by
Miguel Saucedo
P.E. 121992
Date: 11/11/22

OWNER:
Clint Peltier
Clint Peltier Custom Homes
979-481-4840

PLAN: _____
PROFILE: _____
HORIZONTAL: _____
VERTICAL: _____

BAYOU BEND ESTATES
ANGLETON, TEXAS
PLANS FOR
GRADING, PAVING, UTILITIES
AND DETENTION

HYDROLOGICAL
CALCULATIONS

PROJECT NO. 13454

Winstorm (STORM DRAIN DESIGN) Version 3.05, Jan. 25, 2002
Run @ 6/17/2021 9:36:27 AM

PROJECT NAME : BAYOU BEND
JOB NUMBER : 13454
PROJECT DESCRIPTION :
DESIGN FREQUENCY : 5 Years
ANALYSIS FREQUENCY : 100 Years
MEASUREMENT UNITS: ENGLISH

OUTPUT FOR DESIGN FREQUENCY OF: 5 Years

Runoff Computation for Design Frequency.

ID (acre)	C Value (min)	Area (min)	Tc (in/hr)	Tc Used (cfs)	Intensity (cfs)	Supply Q (cfs)	Total Q
A-3	0.55	1.67	10.00	10.00	7.99	0.000	7.336
A-4	0.55	0.83	10.00	10.00	7.99	0.000	3.646
A-5	0.55	1.38	10.00	10.00	7.99	0.000	6.062
A-1	0.55	0.38	10.00	10.00	7.99	0.000	1.669
A-2	0.55	0.94	10.00	10.00	7.99	0.000	4.129

Sag Inlets Configuration Data.

Inlet ID (ft)	Inlet Type	Length/Perim. (sf)	Grate Area (%)	Left-Slope Long Trans (%)	Right-Slope Long Trans (%)	Gutter n	Depth Depwr (ft)	Critic Allowed (ft)	Elev.
A-3	Curb	10.00	n/a	0.50	2.00	0.014	1.50	0.50	26.70
A-4	Curb	5.00	n/a	0.50	2.00	0.014	1.50	0.50	26.00
A-5	Curb	5.00	n/a	0.50	2.00	0.014	1.50	0.50	26.00
A-1	Curb	5.00	n/a	0.50	2.00	0.014	1.50	0.50	26.60
A-2	Curb	5.00	n/a	0.50	2.00	0.014	1.50	0.50	26.60

Sag Inlets Computation Data.

Inlet ID (ft)	Inlet Type	Length (ft)	Grate Perim. Area (cfs)	Total Q (ft)	Inlet Capacity (ft)	Total Head (ft)	Ponded Width Left Right	Critic Elev.
A-3	Curb	10.00	n/a	7.336	10.327	0.398	12.70	12.70
A-4	Curb	5.00	n/a	3.646	6.261	0.349	9.80	9.80
A-5	Curb	5.00	n/a	6.062	6.261	0.489	11.85	11.85
A-1	Curb	5.00	n/a	1.669	6.261	0.207	7.30	7.30
A-2	Curb	5.00	n/a	4.129	6.261	0.379	10.25	10.25

Cumulative Junction Discharge Computations

Node I.D. (acres)	Node Type	Weighted C-Value (min)	Cumulat. Dr. Area (in/hr)	Cumulat. Tc (cfs)	Intens. (cfs)	User Supply Q (cfs)	Additional Q in Node	Total Disch.
A-3	Curb	0.550	2.99	11.36	11.40	0.000	0.00	18.746
A-4	Curb	0.550	3.82	12.02	11.13	0.000	0.00	23.389
A-5	Curb	0.550	5.20	12.12	11.09	0.000	0.00	31.729
A-1	Curb	0.550	0.38	10.00	12.00	0.000	0.00	2.508
A-2	Curb	0.550	1.32	10.23	11.89	0.000	0.00	8.632
MH-1	CircMh	0.550	5.20	12.12	11.09	0.000	0.00	31.729
OUT	outlt	0.550	5.20	12.29	7.30	0.000	0.00	20.880

Conveyance Configuration Data

Run#	Node I.D.	Flowline Elev.	US DS	US DS	Shape #	Span	Rise	Length	Slope	n_value
1	A-1	A-2	20.46	20.33	Circ 1	0.00	1.50	44.00	0.30	0.013
2	A-2	MH-1	20.33	20.06	Circ 1	0.00	2.00	142.00	0.19	0.013
3	MH-1	A-3	20.06	19.83	Circ 1	0.00	2.00	104.00	0.22	0.013
4	A-3	A-4	19.83	19.51	Circ 1	0.00	2.50	164.00	0.20	0.013
5	A-4	A-5	19.51	19.45	Circ 1	0.00	2.50	28.00	0.21	0.013
6	A-5	OUT	19.45	19.00	Circ 1	0.00	3.00	224.00	0.20	0.013

Conveyance Hydraulic Computations. Tailwater = 22.000 (ft)

Run#	US Elev (ft)	DS Elev (ft)	Fr. Slope (%)	Unif. (ft)	Actual (ft)	Velocity (f/s)	Q (cfs)	Cap (cfs)	Junc Loss
1	22.54	22.53	0.025	0.55	1.50	2.84	0.94	1.67	5.71 0.000
2	22.53	22.44	0.064	1.09	2.00	3.26	1.83	5.74	9.87 0.000
3	22.44	22.37	0.064	1.05	2.00	3.45	1.83	5.74	10.64 0.000
4	22.37	22.22	0.091	1.52	2.50	3.95	2.52	12.37	18.12 0.000
5	22.22	22.18	0.141	1.72	2.50	4.28	3.14	15.40	18.99 0.000
6	22.18	22.00	0.098	1.88	3.00	4.49	2.95	20.88	29.90 0.000

OUTPUT FOR ANALYSIS FREQUENCY OF: 100 Years

Runoff Computation for Analysis Frequency.

ID (acre)	C Value (min)	Area (min)	Tc (in/hr)	Tc Used (cfs)	Intensity (cfs)	Supply Q (cfs)	Total Q
A-3	0.55	1.67	10.00	10.00	12.00	0.000	11.020
A-4	0.55	0.83	10.00	10.00	12.00	0.000	5.477
A-5	0.55	1.38	10.00	10.00	12.00	0.000	9.106
A-1	0.55	0.38	10.00	10.00	12.00	0.000	2.508
A-2	0.55	0.94	10.00	10.00	12.00	0.000	6.203

Sag Inlets Configuration Data.

Inlet ID (ft)	Inlet Type	Length/Perim. (sf)	Grate Area (%)	Left-Slope Long Trans (%)	Right-Slope Long Trans (%)	Gutter n	Depth Depwr (ft)	Critic Allowed (ft)	Elev.
A-3	Curb	10.00	n/a	0.50	2.00	0.014	1.50	0.50	26.70
A-4	Curb	5.00	n/a	0.50	2.00	0.014	1.50	0.50	26.00
A-5	Curb	5.00	n/a	0.50	2.00	0.014	1.50	0.50	26.00
A-1	Curb	5.00	n/a	0.50	2.00	0.014	1.50	0.50	26.60
A-2	Curb	5.00	n/a	0.50	2.00	0.014	1.50	0.50	26.60

Sag Inlets Computation Data.

Inlet ID (ft)	Inlet Type	Length (ft)	Grate Perim. Area (cfs)	Total Q (ft)	Inlet Capacity (ft)	Total Head (ft)	Ponded Width Left Right	Critic Elev.
A-3	Curb	10.00	n/a	11.020	13.436	0.418	14.80	14.80
A-4	Curb	5.00	n/a	5.477	6.261	0.457	11.40	11.40
A-5	Curb	5.00	n/a	9.106	6.718	0.709	13.80	13.80
A-1	Curb	5.00	n/a	2.508	6.261	0.272	8.50	8.50
A-2	Curb	5.00	n/a	6.203	6.261	0.497	11.95	11.95

Cumulative Junction Discharge Computations

Node I.D. (acres)	Node Type	Weighted C-Value (min)	Cumulat. Dr. Area (in/hr)	Cumulat. Tc (cfs)	Intens. (cfs)	User Supply Q (cfs)	Additional Q in Node	Total Disch.
A-3	Curb	0.550	2.99	11.36	11.40	0.000	0.00	18.746
A-4	Curb	0.550	3.82	12.02	11.13	0.000	0.00	23.389
A-5	Curb	0.550	5.20	12.12	11.09	0.000	0.00	31.729
A-1	Curb	0.550	0.38	10.00	12.00	0.000	0.00	2.508
A-2	Curb	0.550	1.32	10.23	11.89	0.000	0.00	8.632
MH-1	CircMh	0.550	5.20	12.12	11.09	0.000	0.00	31.729
OUT	outlt	0.550	5.20	12.12	11.09	0.000	0.00	31.729

Conveyance Configuration Data

Run#	Node I.D.	Flowline Elev.	US DS	US DS	Shape #	Span	Rise	Length	Slope	n_value
1	A-1	A-2	20.46	20.33	Circ 1	0.00	1.50	44.00	0.30	0.013
2	A-2	MH-1	20.33	20.06	Circ 1	0.00	2.00	142.00	0.19	0.013
3	MH-1	A-3	20.06	19.83	Circ 1	0.00	2.00	104.00	0.22	0.013
4	A-3	A-4	19.83	19.51	Circ 1	0.00	2.50	164.00	0.20	0.013
5	A-4	A-5	19.51	19.45	Circ 1	0.00	2.50	28.00	0.21	0.013
6	A-5	OUT	19.45	19.00	Circ 1	0.00	3.00	224.00	0.20	0.013

Conveyance Hydraulic Computations. Tailwater = 22.000 (ft)

Run#	US Elev (ft)	DS Elev (ft)	Fr. Slope (%)	Unif. (ft)	Actual (ft)	Velocity (f/s)	Q (cfs)	Cap (cfs)	Junc Loss
1	23.32	23.30	0.057	0.69	1.50	3.15	1.42	2.51	5.71 0.000
2	23.30	23.09	0.146	1.44	2.00	3.57	2.75	8.63	9.87 0.000
3	23.09	22.94	0.146	1.38	2.00	3.75	2.75	8.63	10.64 0.000
4	22.94	22.60	0.209	2.19	2.50	4.12	3.82	18.75	18.12 0.000
5	22.60	22.51	0.325	2.50	2.50	4.76	4.76	23.39	18.99 0.000
6	22.51	22.00	0.226	2.63	3.00	4.84	4.49	31.73	29.90 0.000

NORMAL TERMINATION OF WINSTORM.

Winstorm (STORM DRAIN DESIGN) Version 3.05, Jan. 25, 2002
Run @ 4/28/2021 3:58:12 PM

PROJECT NAME : BAYOU BEND
JOB NUMBER : 13454
PROJECT DESCRIPTION :
DESIGN FREQUENCY : 5 Years
ANALYSIS FREQUENCY : 100 Years
MEASUREMENT UNITS: ENGLISH

OUTPUT FOR DESIGN FREQUENCY OF: 5 Years

Runoff Computation for Design Frequency.

ID (acre)	C Value (min)	Area (min)	Tc (in/hr)	Tc Used (cfs)	Intensity (cfs)	Supply Q (cfs)	Total Q
A-6	0.55	2.35	10.00	10.00	7.99	0.000	10.323
A-7	0.55	1.20	10.00	10.00	7.99	0.000	5.271

Sag Inlets Configuration Data.

Inlet ID (ft)	Inlet Type	Length/Perim. (sf)	Grate Area (%)	Left-Slope Long Trans (%)	Right-Slope Long Trans (%)	Gutter n	Depth Depwr (ft)	Critic Allowed (ft)	Elev.
A-6	Curb	10.00	n/a	0.50	2.00	0.014	1.50	0.50	26.70
A-7	Curb	5.00	n/a	0.50	2.00	0.014	1.50	0.50	26.70

Sag Inlets Computation Data.

Inlet ID (ft)	Inlet Type	Length (ft)	Grate Perim. Area (cfs)	Total Q (ft)	Inlet Capacity (ft)	Total Head (ft)	Ponded Width Left Right	Critic Elev.
A-6	Curb	10.00	n/a	10.323	10.327	0.500	14.45	14.45
A-7	Curb	5.00	n/a	5.271	6.261	0.446	11.25	11.25

Cumulative Junction Discharge Computations

Node I.D. (acres)	Node Type	Weighted C-Value (min)	Cumulat. Dr. Area (in/hr)	Cumulat. Tc (cfs)	Intens. (cfs)	User Supply Q (cfs)	Additional Q in Node	Total Disch.
A-6	Curb	0.550	2.35	10.00	12.00	0.000	0.00	15.507
A-7	Curb	0.550	3.55	10.12	11.94	0.000	0.00	23.317
OUT	outlt	0.550	3.55	10.12	11.94	0.000	0.00	23.317

Conveyance Configuration Data

Run#	Node I.D.	Flowline Elev.	US DS	US DS	Shape #	Span	Rise	Length	Slope	n_value
3	A-6	A-7	17.87	17.82	Circ 1	0.00	2.50	28.00	0.18	0.013
4	A-7	OUT	17.82	17.60	Circ 1	0.00	2.50	104.00	0.21	0.013

Conveyance Hydraulic Computations. Tailwater = 22.000 (ft)

Run#	US Elev (ft)	DS Elev (ft)	Fr. Slope (%)	Unif. (ft)	Actual (ft)	Velocity (f/s)	Q (cfs)	Cap (cfs)	Junc Loss
3	22.17	22.15	0.063	1.41	2.50	3.63	2.10	10.32	17.34 0.000
4	22.15	22.00	0.143	1.72	2.50	4.31	3.16	15.51	18.87 0.000

OUTPUT FOR ANALYSIS FREQUENCY OF: 100 Years

Runoff Computation for Analysis Frequency.

ID (acre)	C Value (min)	Area (min)	Tc (in/hr)	Tc Used (cfs)	Intensity (cfs)	Supply Q (cfs)	Total Q
A-6	0.55	2.35	10.00	10.00	12.00	0.000	15.507
A-7	0.55	1.20	10.00	10.00	12.00	0.000	7.918

Sag Inlets Configuration Data.

Inlet ID (ft)	Inlet Type	Length/Perim. (sf)	Grate Area (%)	Left-Slope Long Trans (%)	Right-Slope Long Trans (%)	Gutter n	Depth Depwr (ft)	Critic Allowed (ft)	Elev.
A-6	Curb	10.00	n/a	0.50	2.00	0.014	1.50	0.50	26.70
A-7	Curb	5.00	n/a	0.50	2.00	0.014	1.50	0.50	26.70

Sag Inlets Computation Data.

Inlet ID (ft)	Inlet Type	Length (ft)	Grate Perim. Area (cfs)	Total Q (ft)	Inlet Capacity (ft)	Total Head (ft)	Ponded Width Left Right	Critic Elev.
A-6	Curb	10.00	n/a	15.507	13.436	0.583	16.85	16.85
A-7	Curb	5.00	n/a	7.918	6.718	0.597	13.10	13.10

Cumulative Junction Discharge Computations

Node I.D. (acres)	Node Type	Weighted C-Value (min)	Cumulat. Dr. Area (in/hr)	Cumulat. Tc (cfs)	Intens. (cfs)	User Supply Q (cfs)	Additional Q in Node	Total Disch.
A-6	Curb	0.550	2.35	10.00	12.00	0.000	0.00	15.507
A-7	Curb	0.550	3.55	10.12	11.94	0.000	0.00	23.317
OUT	outlt	0.550	3.55	10.12	11.94	0.000	0.00	23.317

Conveyance Configuration Data

Run#	Node I.D.	Flowline Elev.	US DS	US DS	Shape #	Span	Rise	Length	Slope	n_value
3	A-6	A-7	17.87	17.82	Circ 1	0.00	2.50	28.00	0.18	0.013
4	A-7	OUT	17.82	17.60	Circ 1	0.00	2.50	104.00	0.21	0.013

Conveyance Hydraulic Computations. Tailwater = 22.000 (ft)

Run#	US Elev (ft)	DS Elev (ft)	Fr. Slope (%)	Unif. (ft)	Actual (ft)	Velocity (f/s)	Q (cfs)	Cap (cfs)	Junc Loss
3	22.38	22.34	0.143	1.88	2.50	3.93	3.16	15.51	17.34 0.000
4	22.34	22.00	0.323	2.50	2.50	4.75	4.75	23.32	18.87 0.000

NORMAL TERMINATION OF WINSTORM.

NO.	DATE	DESCRIPTION	APPROVED
REVISIONS			


DESIGNED MS
DRAWN
CHECKED
DATE

B & L
BAKER & LAWSON, INC.
ENGINEERS • PLANNERS • SURVEYORS
300 E CEDAR ST. ANGLETON, TEXAS 77515
PHONE: (979) 849-6681 FAX: (979) 849-6689
REG. NO. F-825



STATE OF TEXAS
MIGUEL A. SAUCEDA
121992
REGISTERED PROFESSIONAL ENGINEER

DISCLAIMER: The use of this standard is governed by the "Texas Engineering Practice Act". No warranty of any kind is made by TxDOT for any purpose whatsoever. TxDOT assumes no responsibility for the conversion of this standard to other formats or for incorrect results or damages resulting from its use.

DATE: FILE:

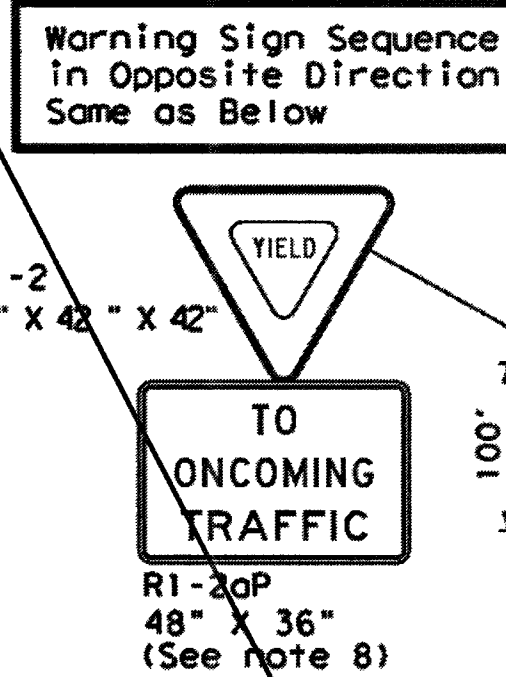

Channelizing devices separate work space from traveled way

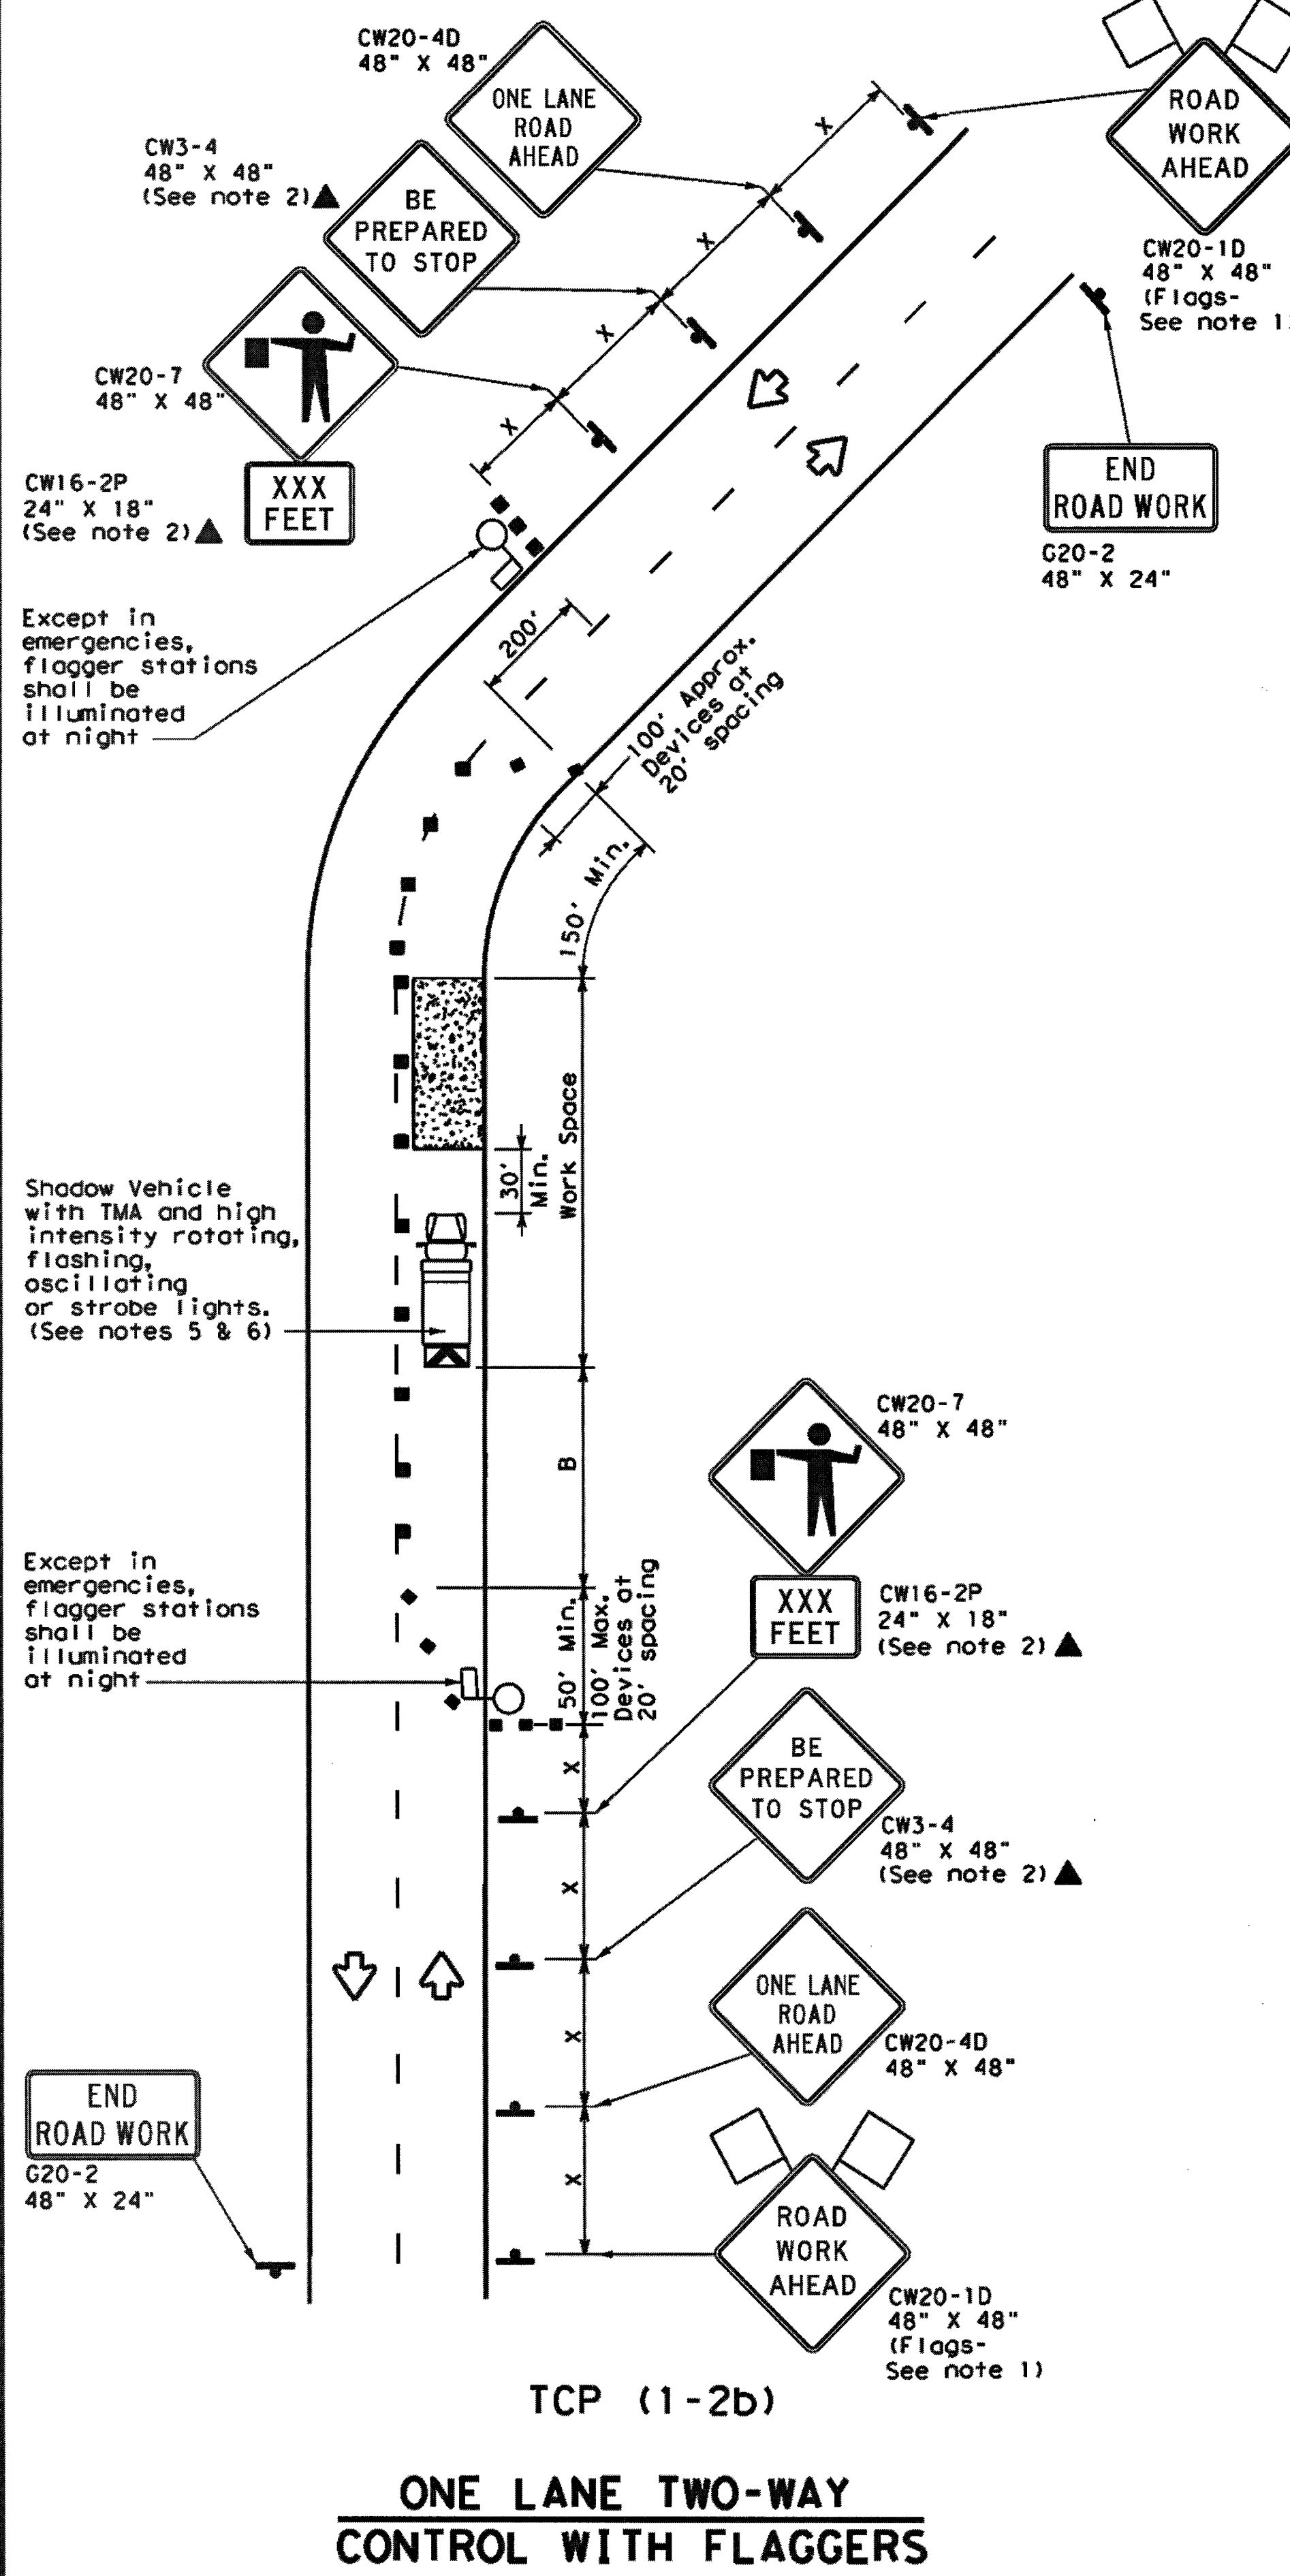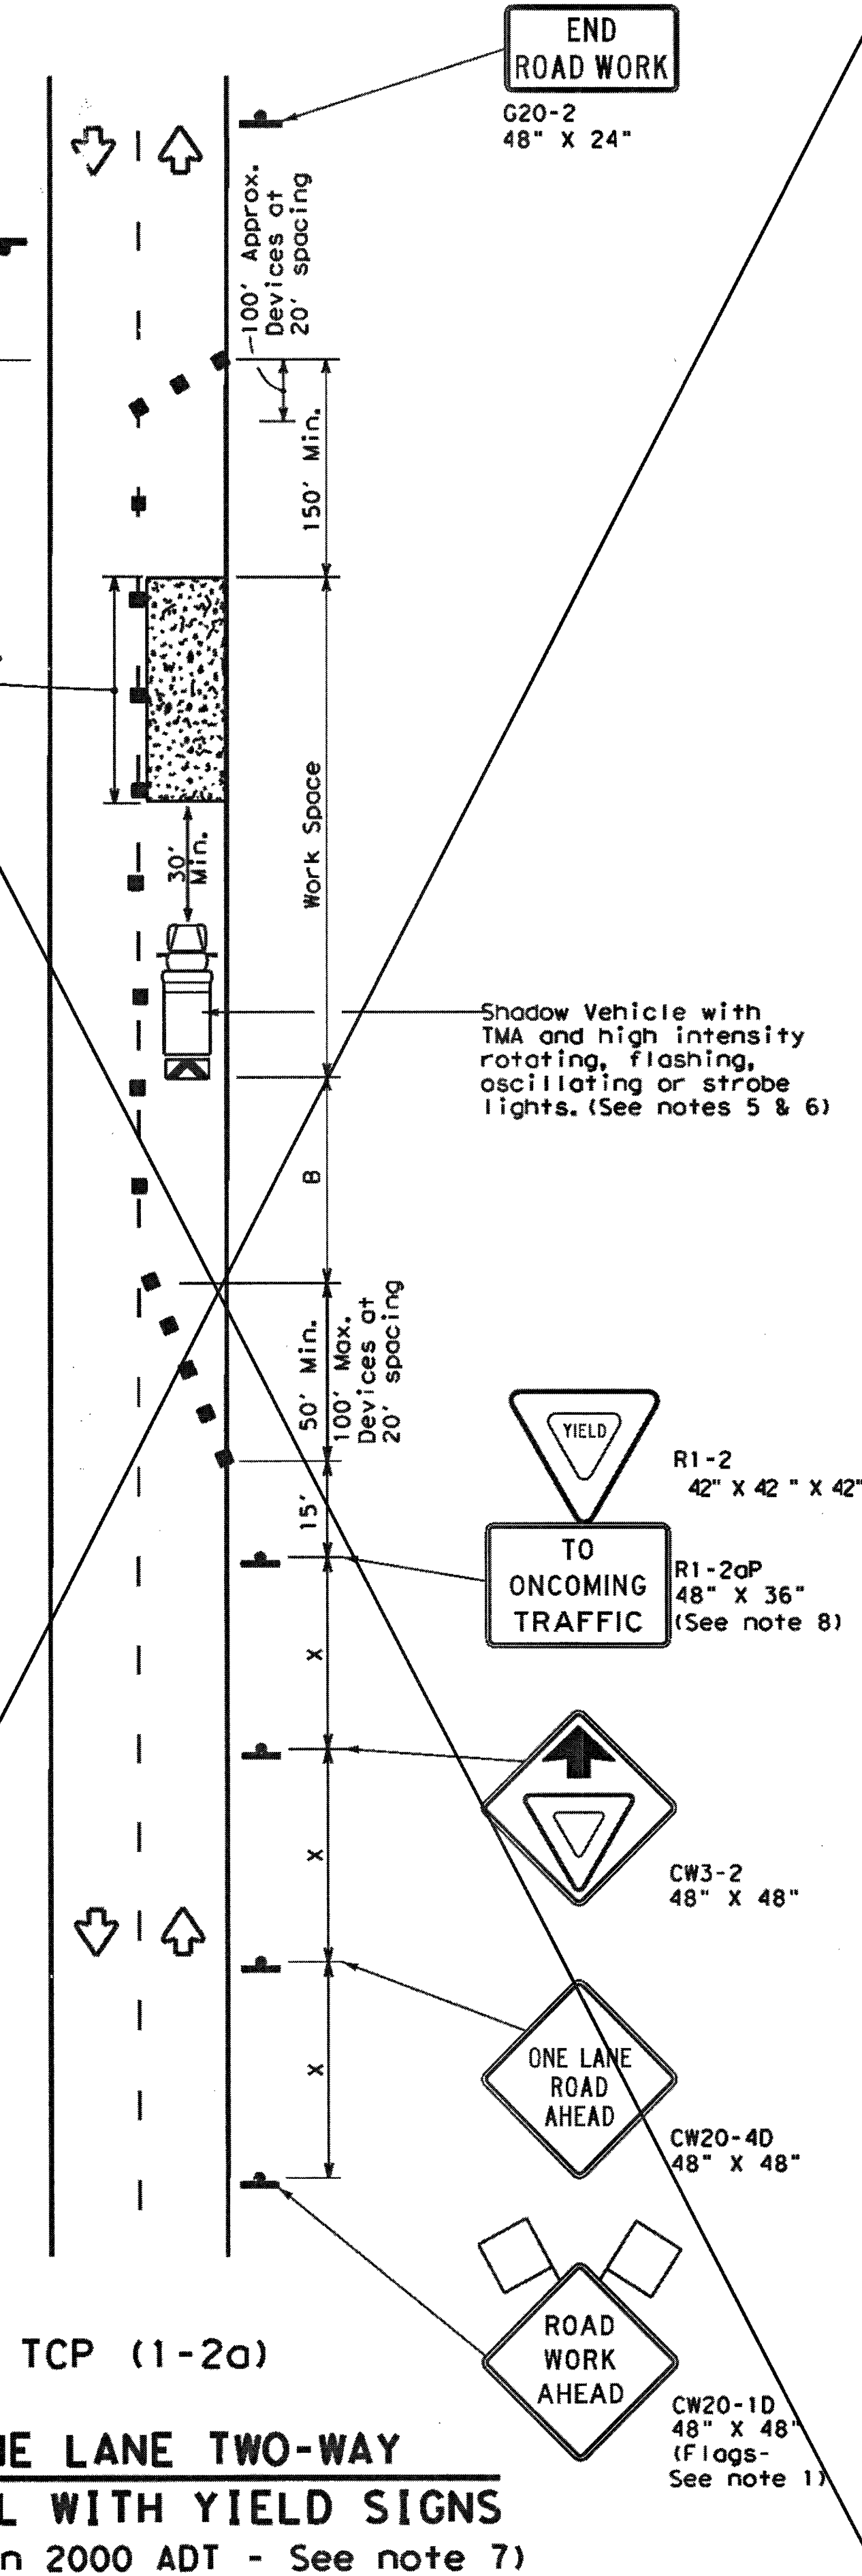

LEGEND			
	Type 3 Barricade		Channelizing Devices
	Heavy Work Vehicle		Truck Mounted Attenuator (TMA)
	Trailer Mounted Flashing Arrow Board		Portable Changeable Message Sign (PCMS)
	Sign		Traffic Flow
	Flag		Flagger

Posted Speed * %	Formula	Minimum Desirable Taper Lengths **			Suggested Maximum Spacing of Channelizing Devices		Minimum Sign Spacing "x" Distance	Suggested Longitudinal Buffer Space "b"	Stopping Sight Distance
		10' Offset	11' Offset	12' Offset	On a Taper	On a Tangent			
30	$L = \frac{WS^2}{60}$	150'	165'	180'	30'	60'	120'	90'	200'
35		205'	225'	245'	35'	70'	160'	120'	250'
40		265'	295'	320'	40'	80'	240'	155'	305'
45	L = WS	450'	495'	540'	45'	90'	320'	195'	360'
50		500'	550'	600'	50'	100'	400'	240'	425'
55		550'	605'	660'	55'	110'	500'	295'	495'
60		600'	660'	720'	60'	120'	600'	350'	570'
65		650'	715'	780'	65'	130'	700'	410'	645'
70		700'	770'	840'	70'	140'	800'	475'	730'
75		750'	825'	900'	75'	150'	900'	540'	820'

* Conventional Roads Only

** Taper lengths have been rounded off.

L=Length of Taper (FT) W=Width of Offset (FT) S=Posted Speed (MPH)

TYPICAL USAGE				
MOBILE	SHORT DURATION	SHORT TERM STATIONARY	INTERMEDIATE TERM STATIONARY	LONG TERM STATIONARY
	✓	✓		

GENERAL NOTES

- Flags attached to signs where shown are REQUIRED.
- All traffic control devices illustrated are REQUIRED, except those denoted with the triangle symbol may be omitted when stated elsewhere in the plans, or for routine maintenance work, when approved by the Engineer.
- The CW3-4 "BE PREPARED TO STOP" sign may be installed after the CW20-4D "ONE LANE ROAD AHEAD" sign, but proper sign spacing shall be maintained.
- Sign spacing may be increased or an additional CW20-1D "ROAD WORK AHEAD" sign may be used if advance warning ahead of the flagger or R1-2 "YIELD" sign is less than 1500 feet.
- A Shadow Vehicle with a TMA should be used anytime it can be positioned 30 to 100 feet in advance of the area of crew exposure without adversely affecting the performance or quality of the work. If workers are no longer present but road or work conditions require the traffic control to remain in place, Type 3 Barricades or other channelizing devices may be substituted for the Shadow Vehicle and TMA.
- Additional Shadow Vehicles with TMAs may be positioned off the paved surface, next to those shown in order to protect wider work spaces.

TCP (1-2a)

- R1-2 "YIELD" sign traffic control may be used on projects with approaches that have adequate sight distance. For projects in urban areas, work spaces should be no longer than one half city block. In rural areas on roadways with less than 2000 ADT, work spaces should be no longer than 400 feet.
- R1-2 "YIELD" sign with R1-2aP "TO ONCOMING TRAFFIC" plaque shall be placed on a support at a 7 foot minimum mounting height.

TCP (1-2b)

- Flaggers should use two-way radios or other methods of communication to control traffic.
- Length of work space should be based on the ability of flaggers to communicate.
- If the work space is located near a horizontal or vertical curve, the buffer distances should be increased in order to maintain adequate stopping sight distance to the flagger and a queue of stopped vehicles (see table above).
- Channelizing devices on the center-line may be omitted when a pilot car is leading traffic and approved by the Engineer.
- Flaggers should use 24" STOP/SLOW paddles to control traffic. Flags should be limited to emergency situations.


		Traffic Operations Division Standard			
TRAFFIC CONTROL PLAN					
ONE-LANE TWO-WAY TRAFFIC CONTROL					
TCP (1-2) - 18					
FILE: tcp1-2-18.dgn	DW: CK1	DW: CK1	CK1		
© TxDOT December 1985	CONT	SECT	JOB HIGHWAY		
REVISIONS					
4-90 4-98					
2-94 2-12					
1-97 2-18					
	DIST	COUNTY	SHEET NO.		

RECORD DRAWING

NO.	DATE	DESCRIPTION	APPROVED
REVISIONS			

DESIGNED	MS
DRAWN	N
CHECKED	
DATE	

B & L
BAKER & LAWSON, INC.
ENGINEERS • PLANNERS • SURVEYORS
300 E. CEDAR ST. ANGLETON, TEXAS 77515
PHONE: (979) 849-6881 FAX: (979) 849-6883
REG. NO. F-825

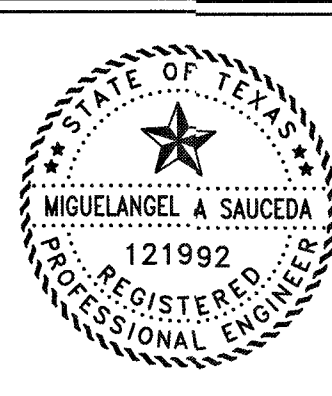

The seal appearing on this document was authorized by Miguel Saucedo P.E. 121992
Date: 1/11/24





OWNER:
Clint Peltier
Clint Peltier Custom Homes
979-481-4840

PLAN: _____
PROFILE: _____
HORIZONTAL: _____
VERTICAL: _____





BAYOU BEND ESTATES
ANGLETON, TEXAS
PLANS FOR
GRADING, PAVING, UTILITIES
AND DETENTION

TRAFFIC CONTROL PLAN



PROJECT NO. 13454

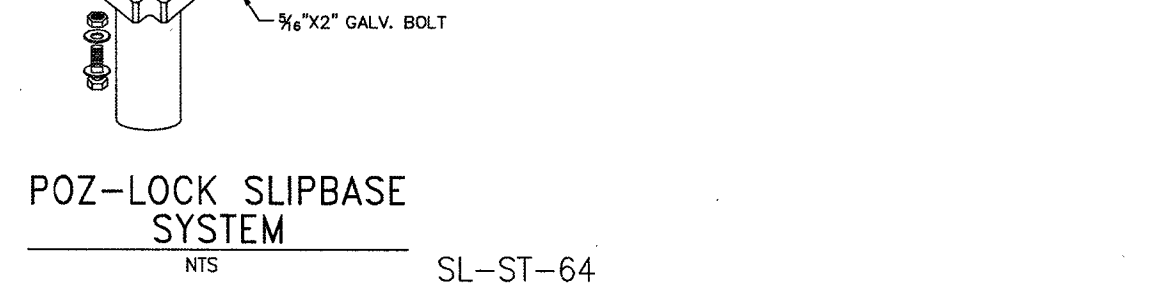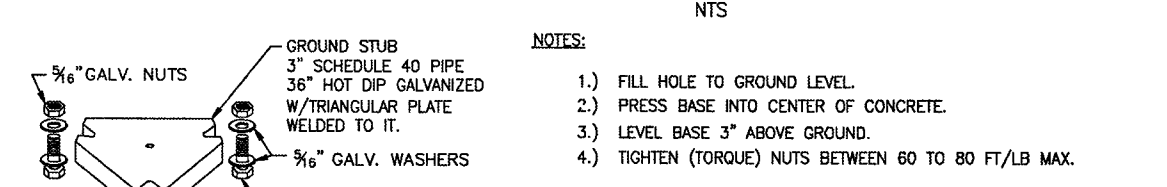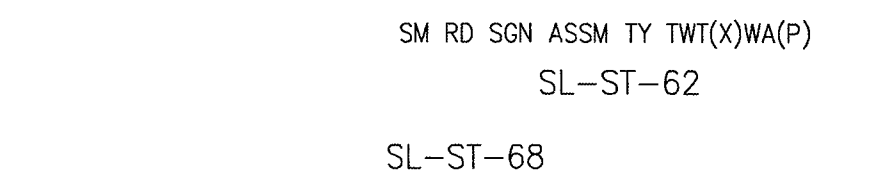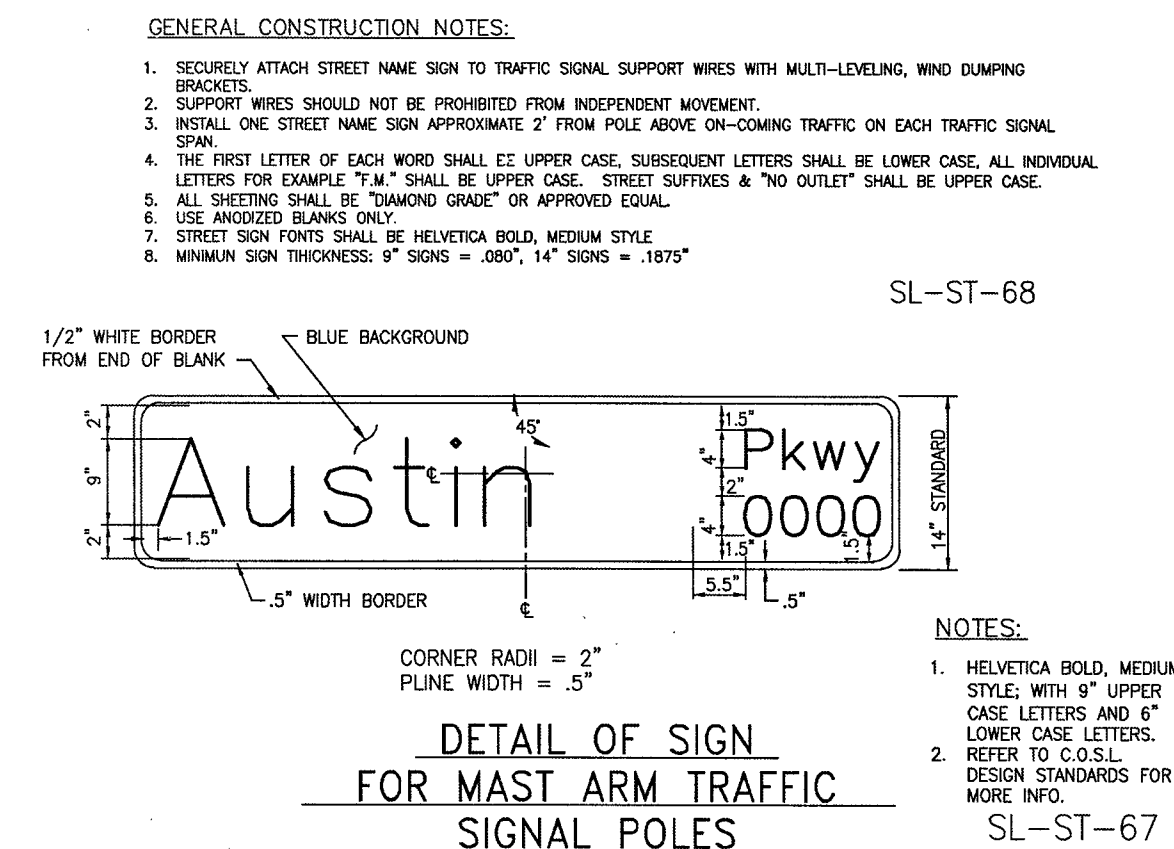

ND
UT
18

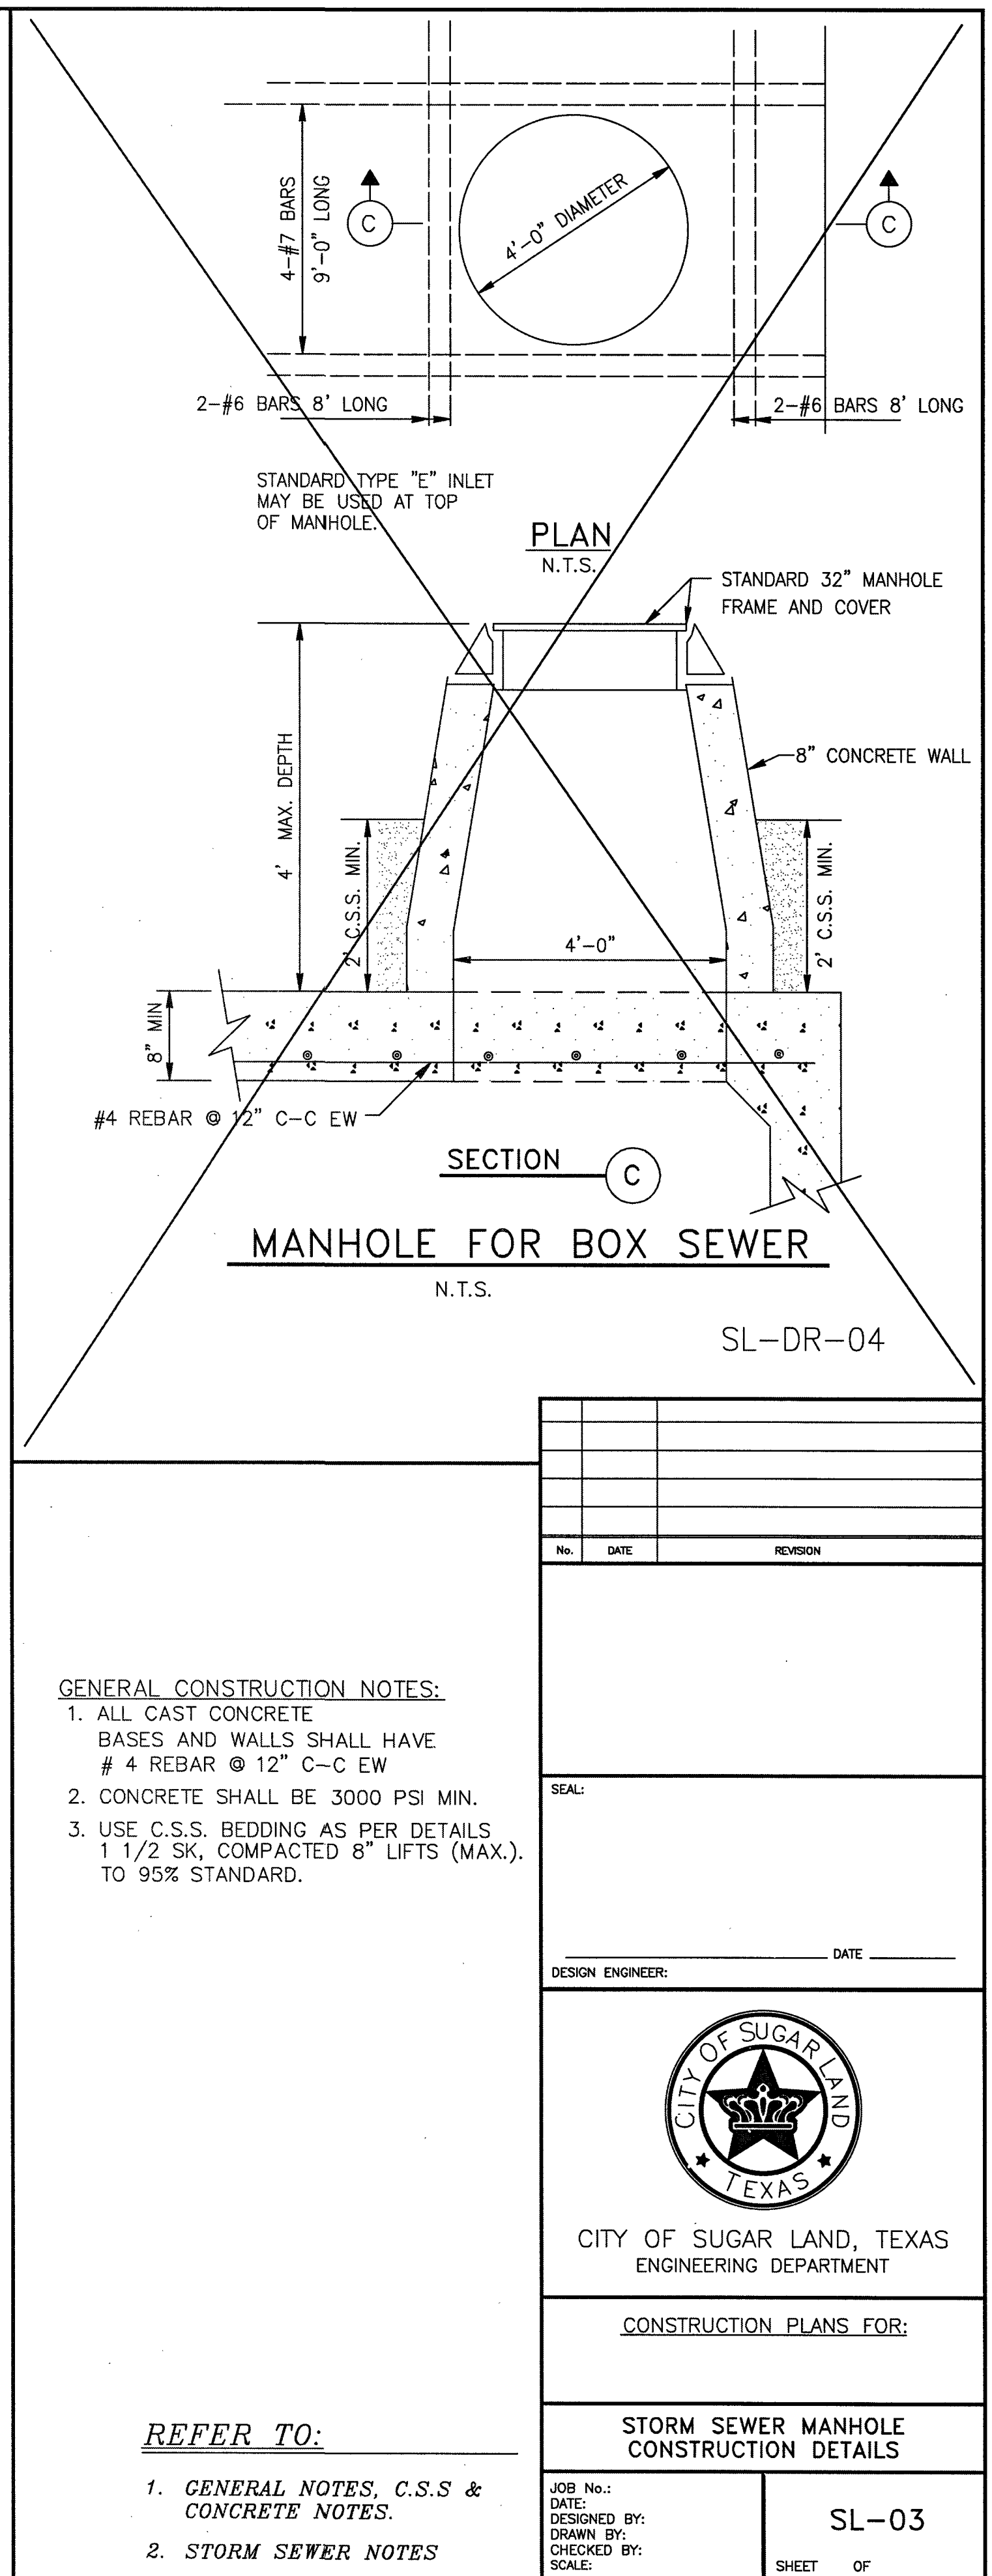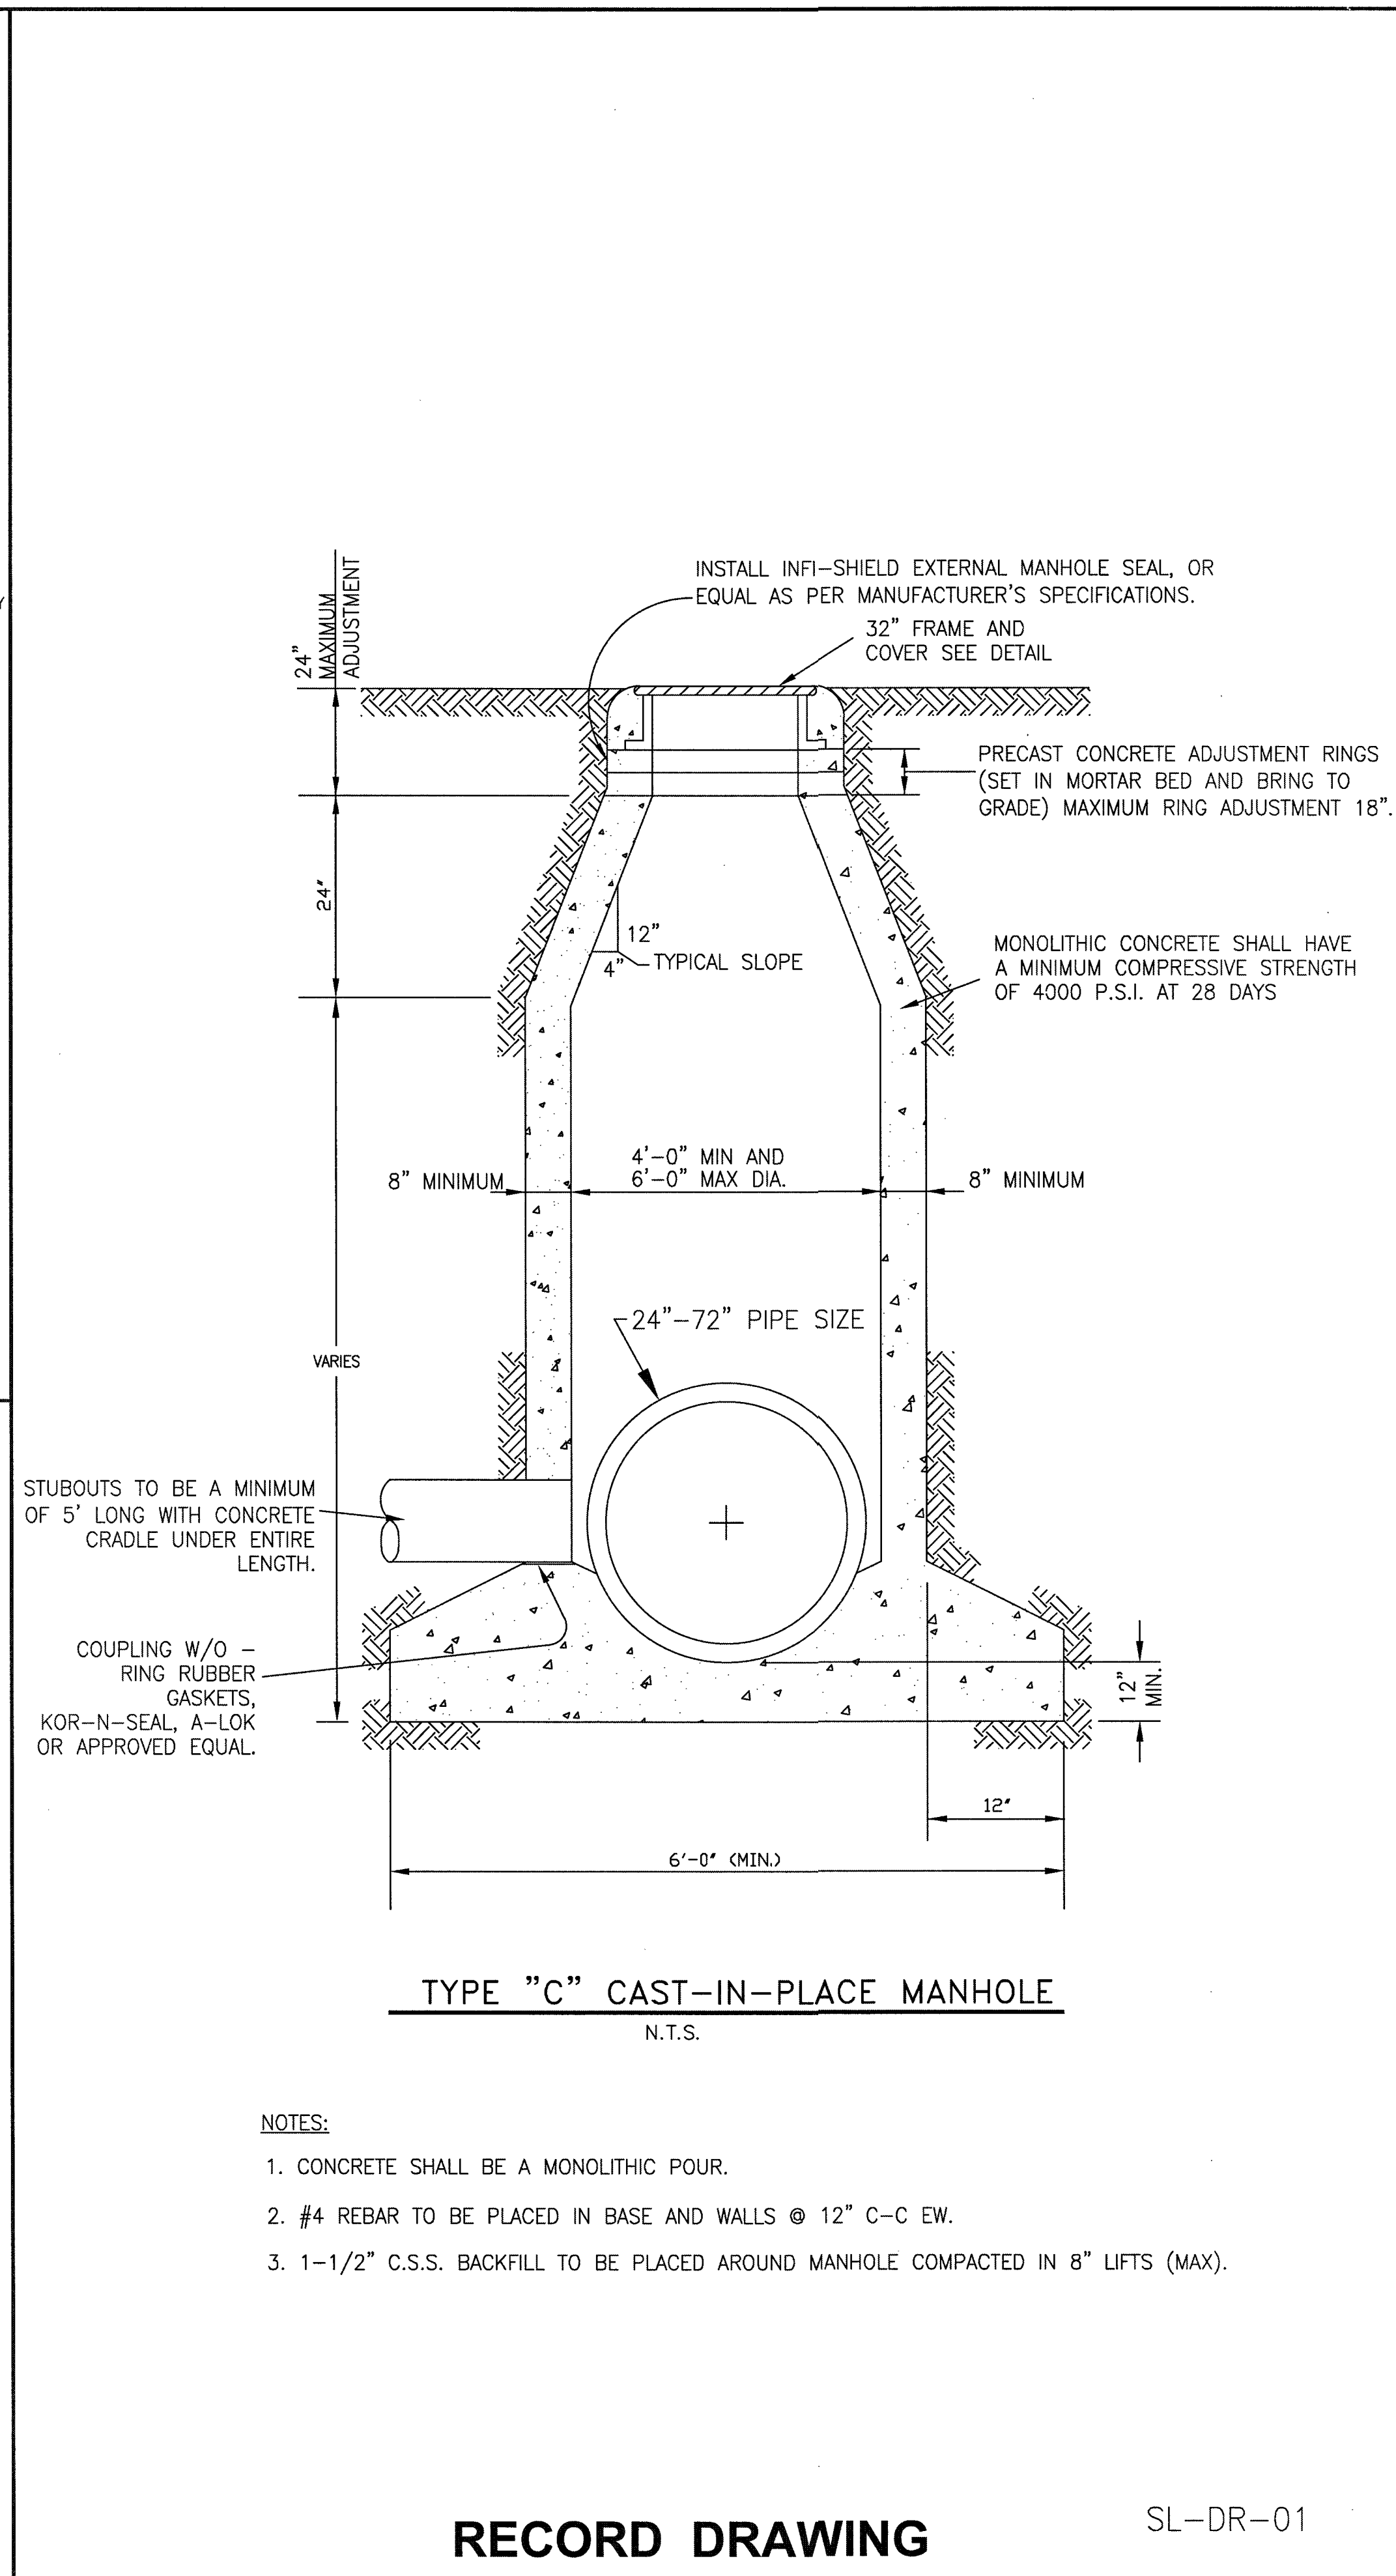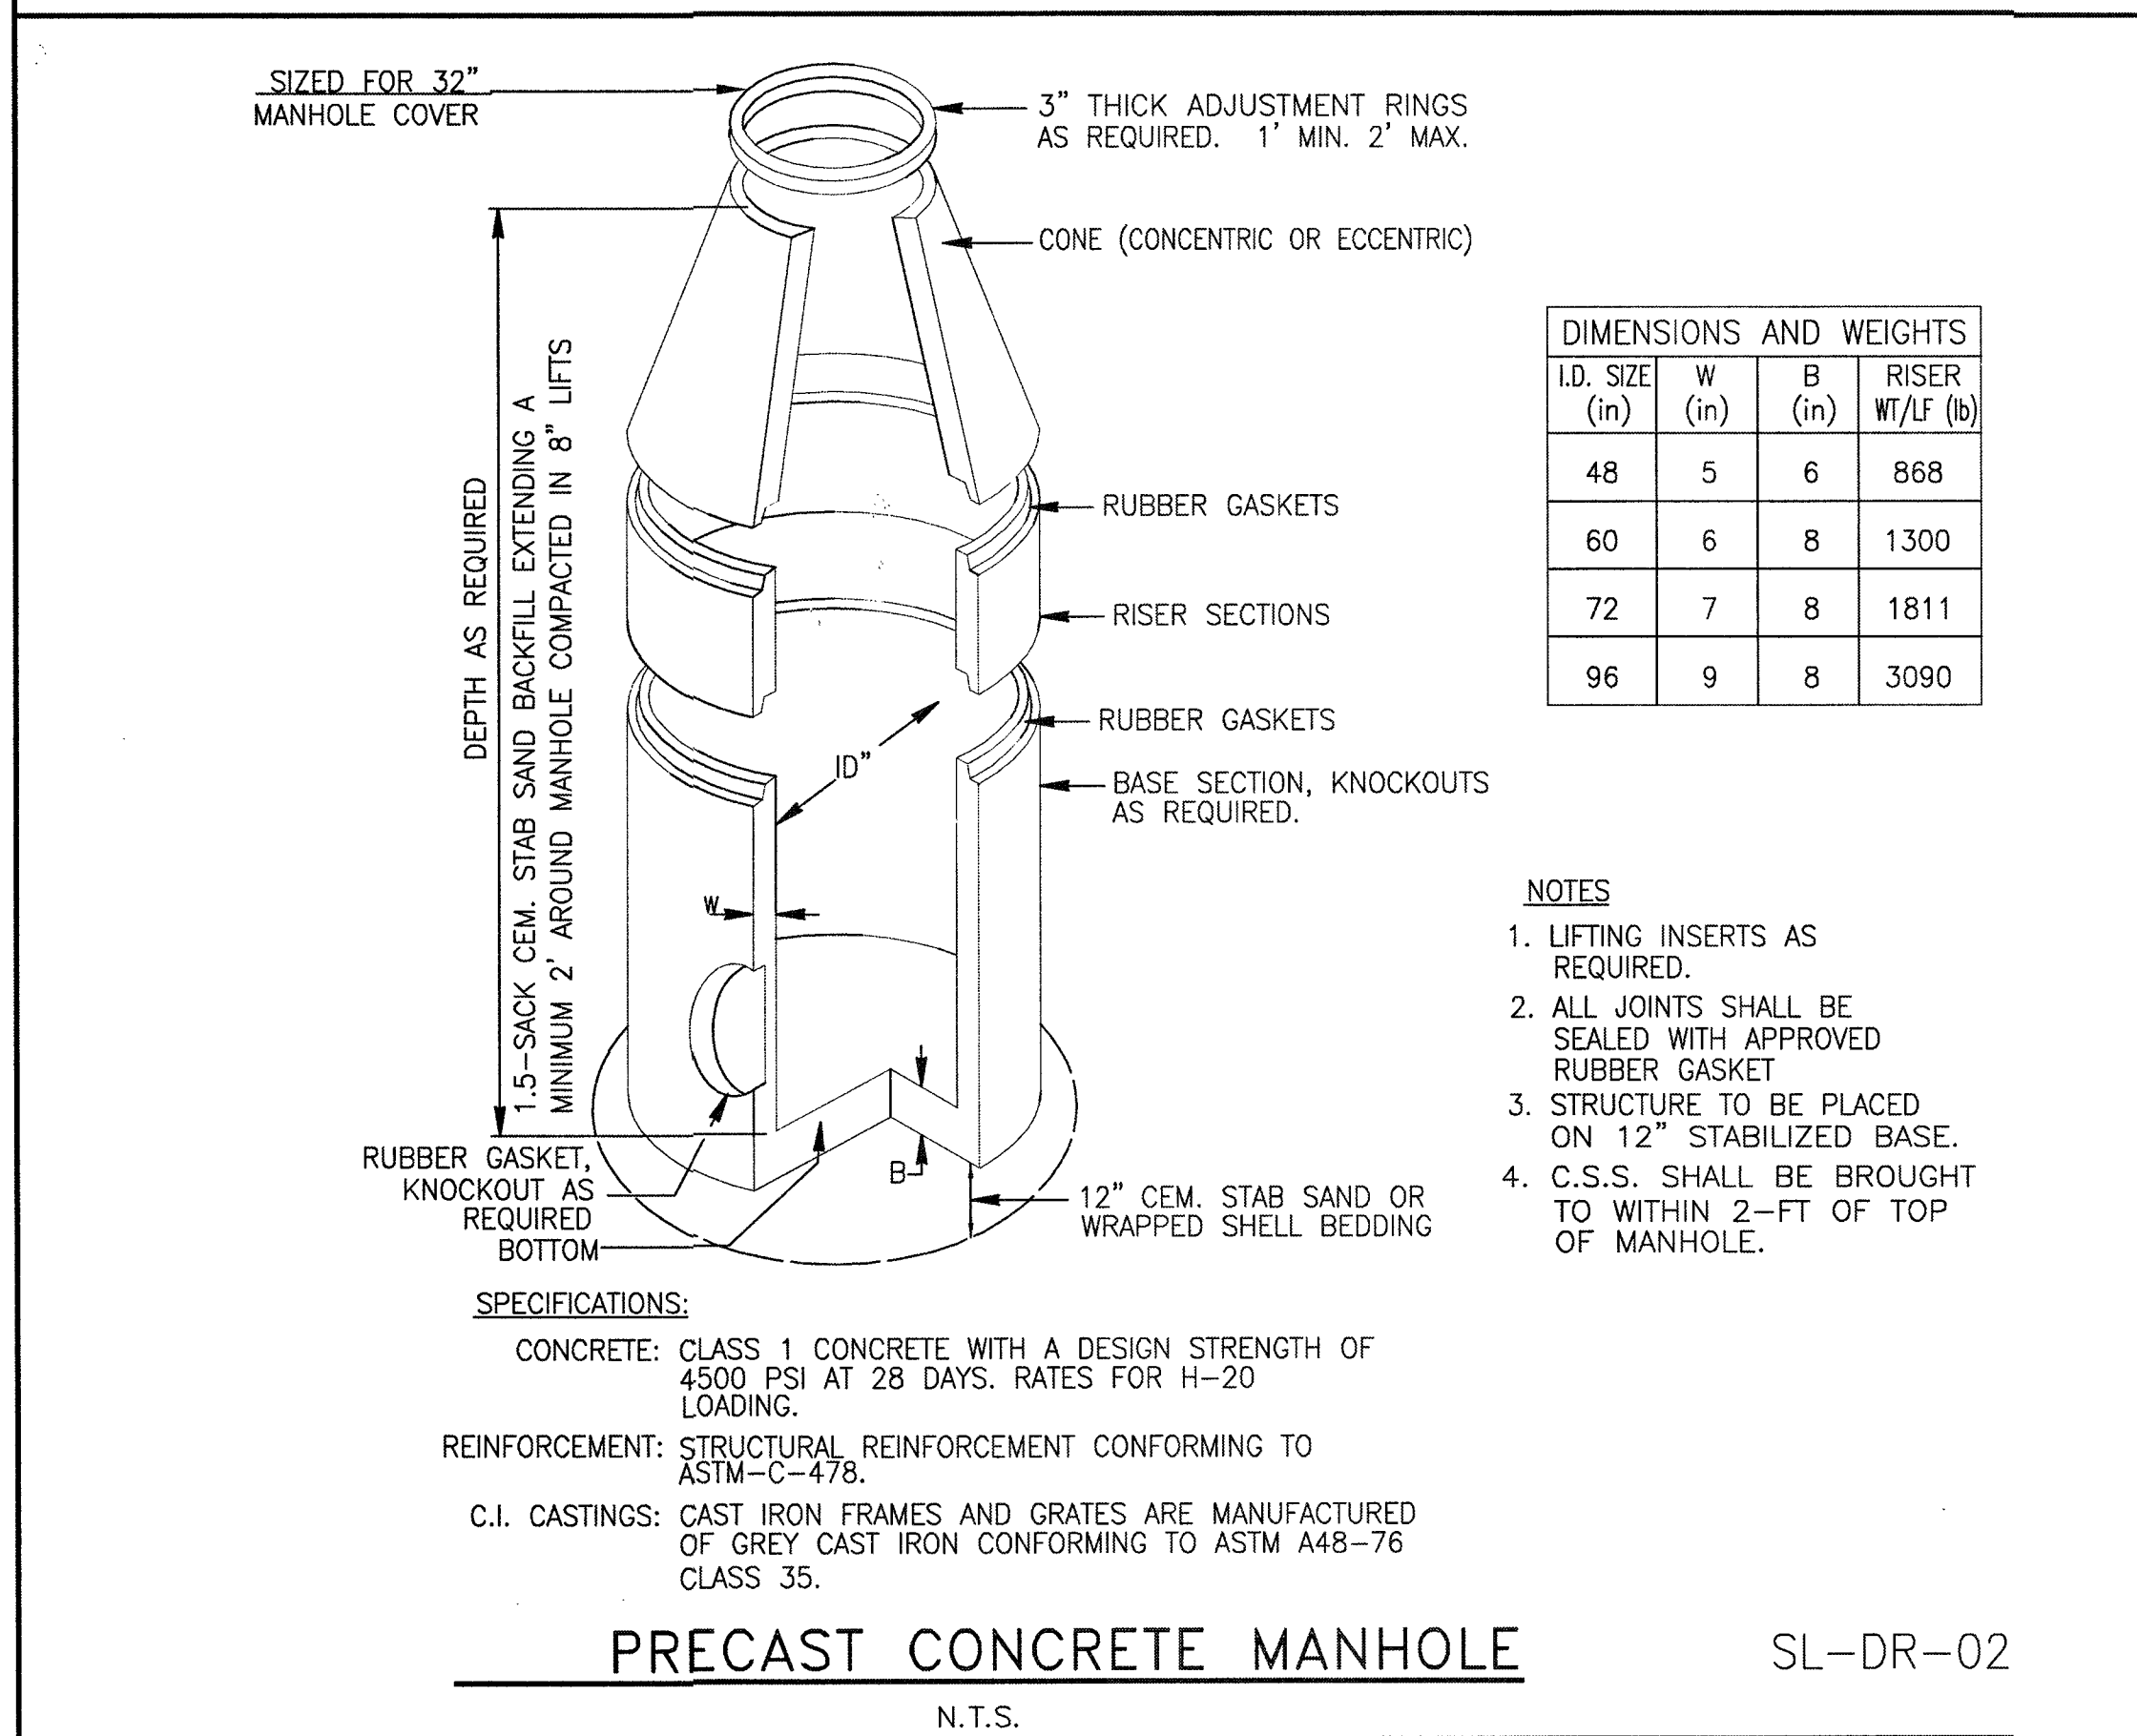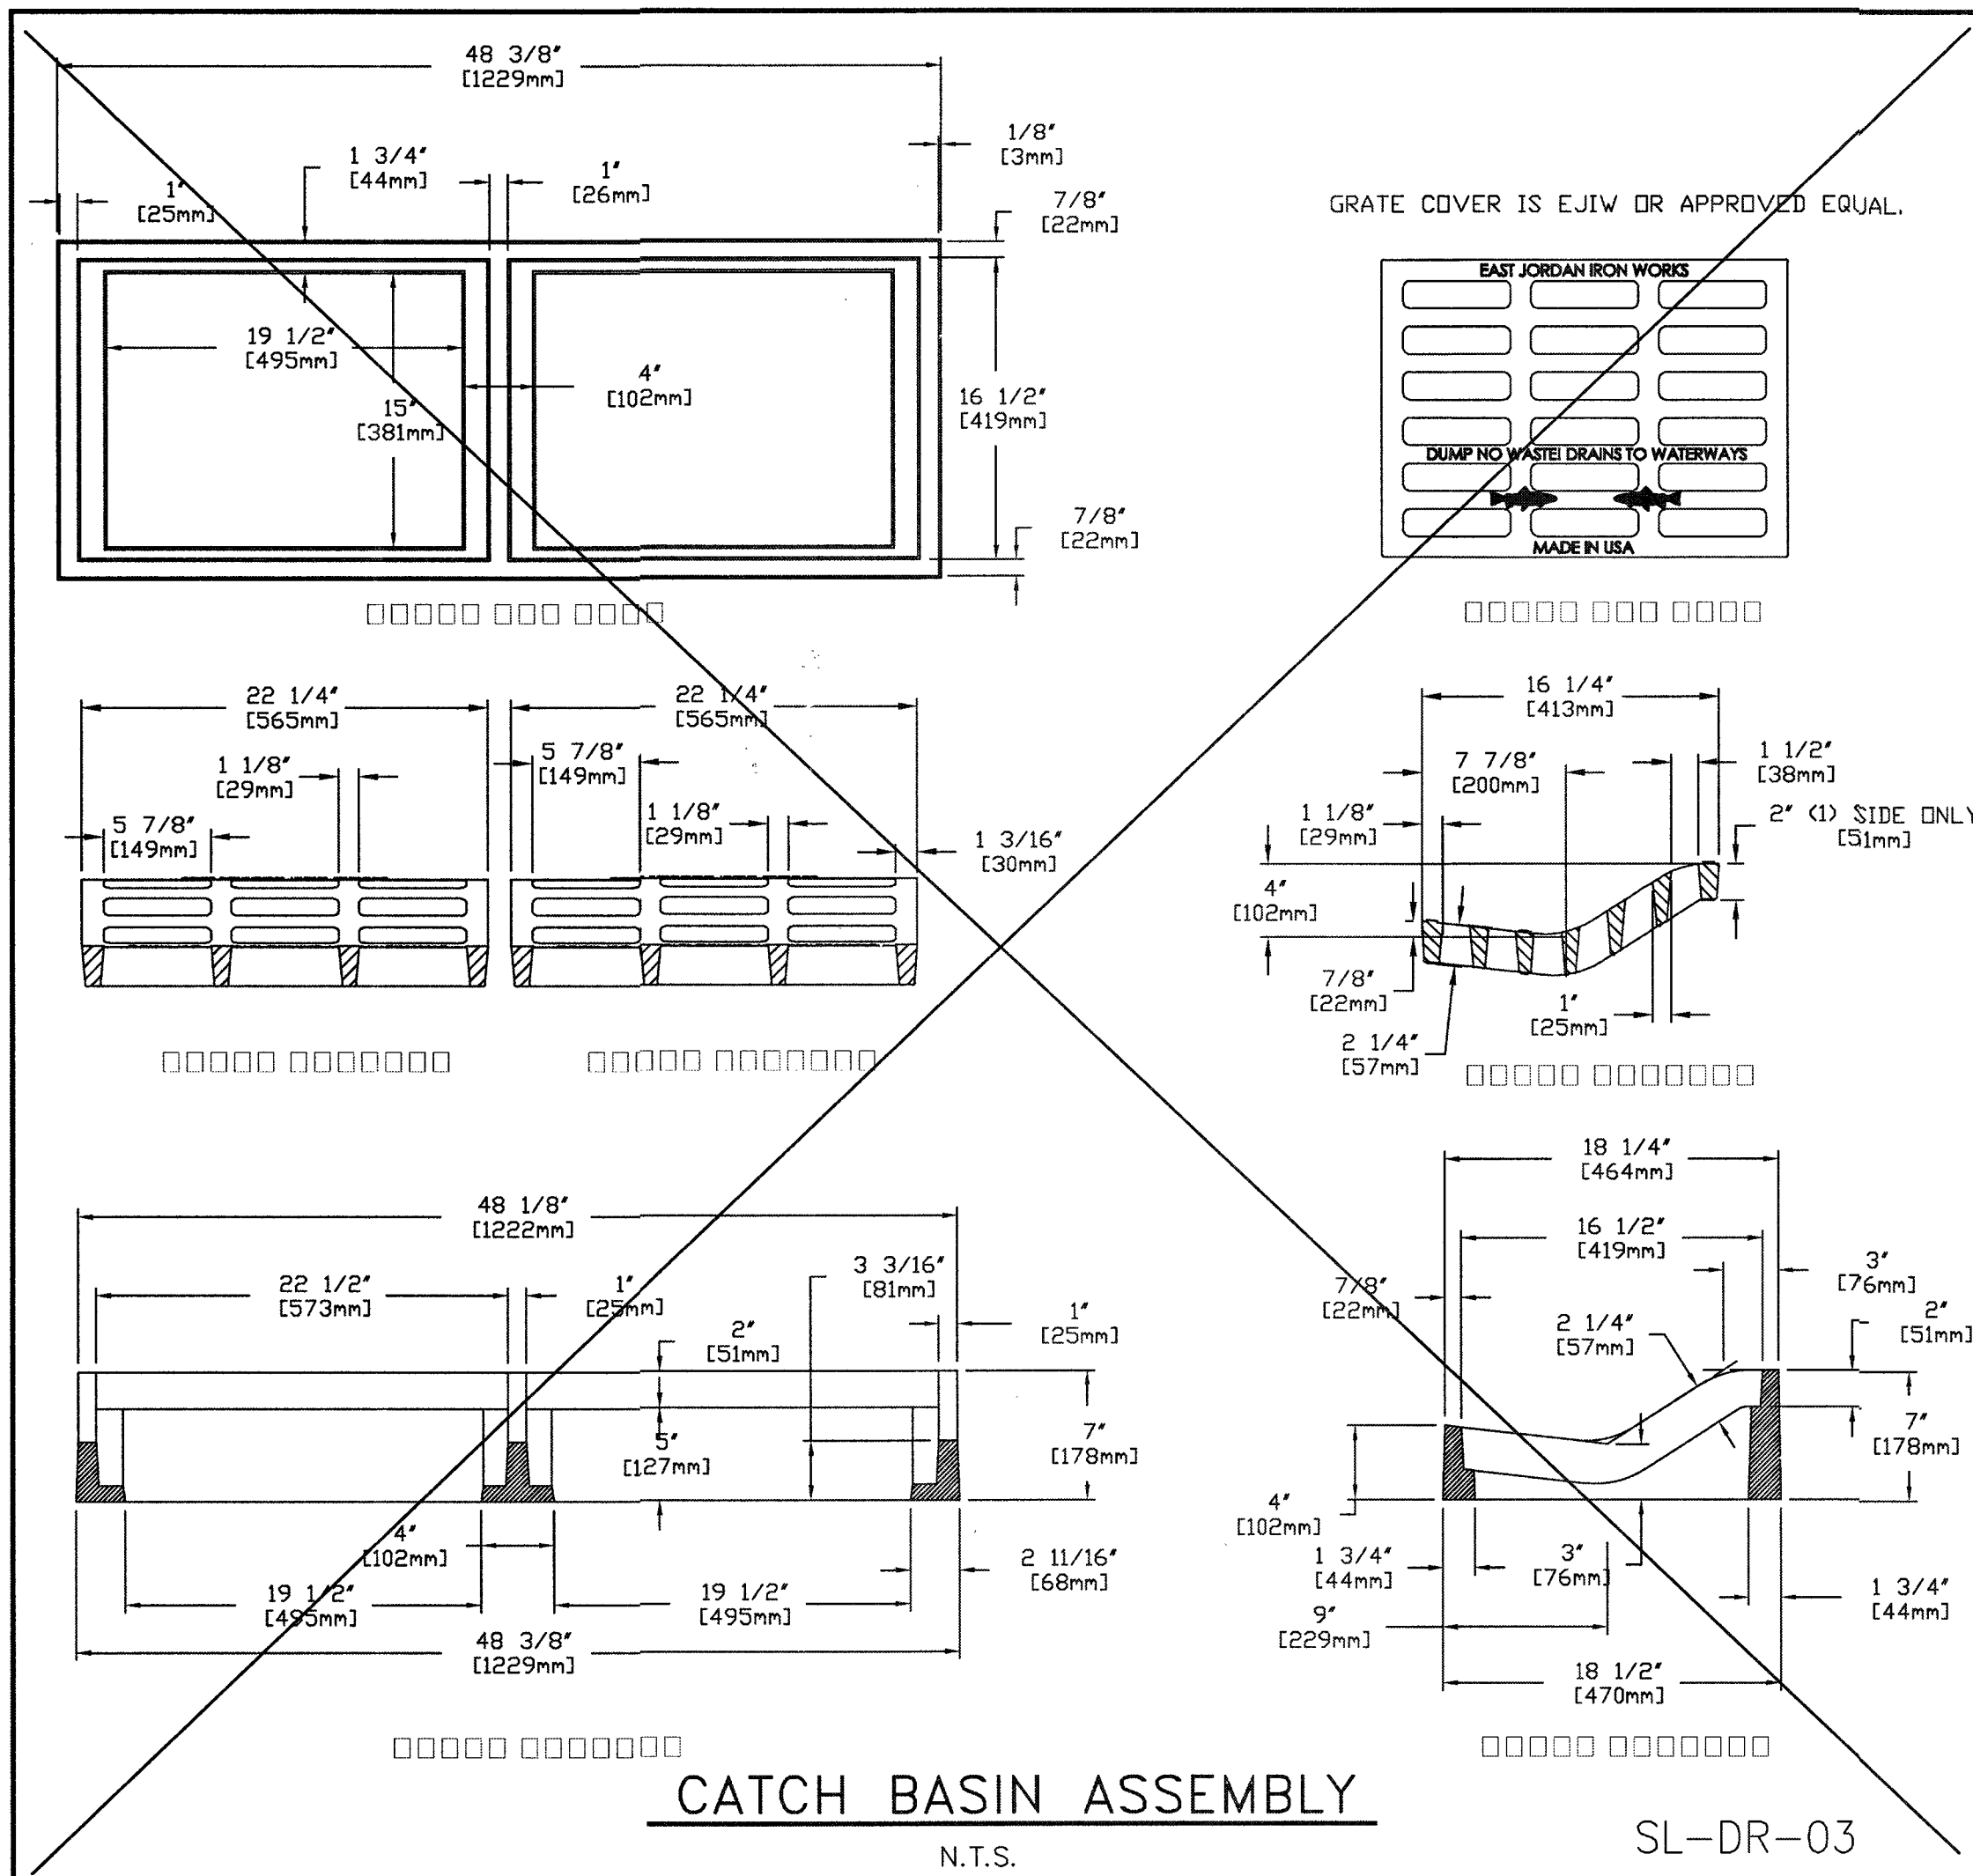

					DESIGNED	MS
					DRAWN	BT
					CHECKED	
NO.	DATE	DESCRIPTION			APPROVED	DATE
REVISIONS						

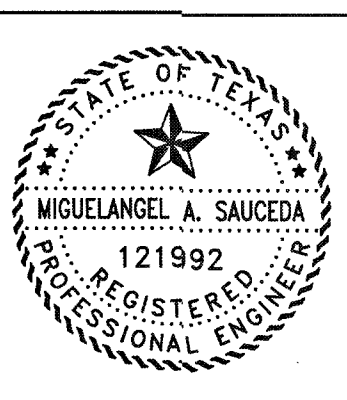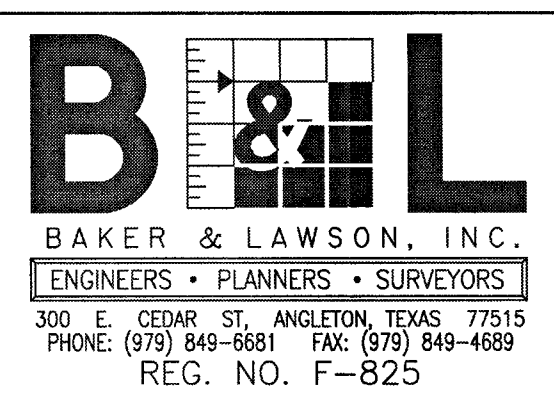

The seal appearing on this document was authorized by Miguelangel A. Saucedo P.E. 121992

Date: 1/11/22

OWNER:

Clint Peltier
Clint Peltier Custom Homes
979-481-4840





PLAN: _____
PROFILE: _____
HORIZONTAL: _____
VERTICAL: _____

BAYOU BEND ESTATES
ANGLETON, TEXAS

PLANS FOR
GRADING, PAVING, UTILITIES
AND DETENTION

STORM SEWER MANHOLE
CONSTRUCTION DETAILS
SL-03

PROJECT NO. 13454

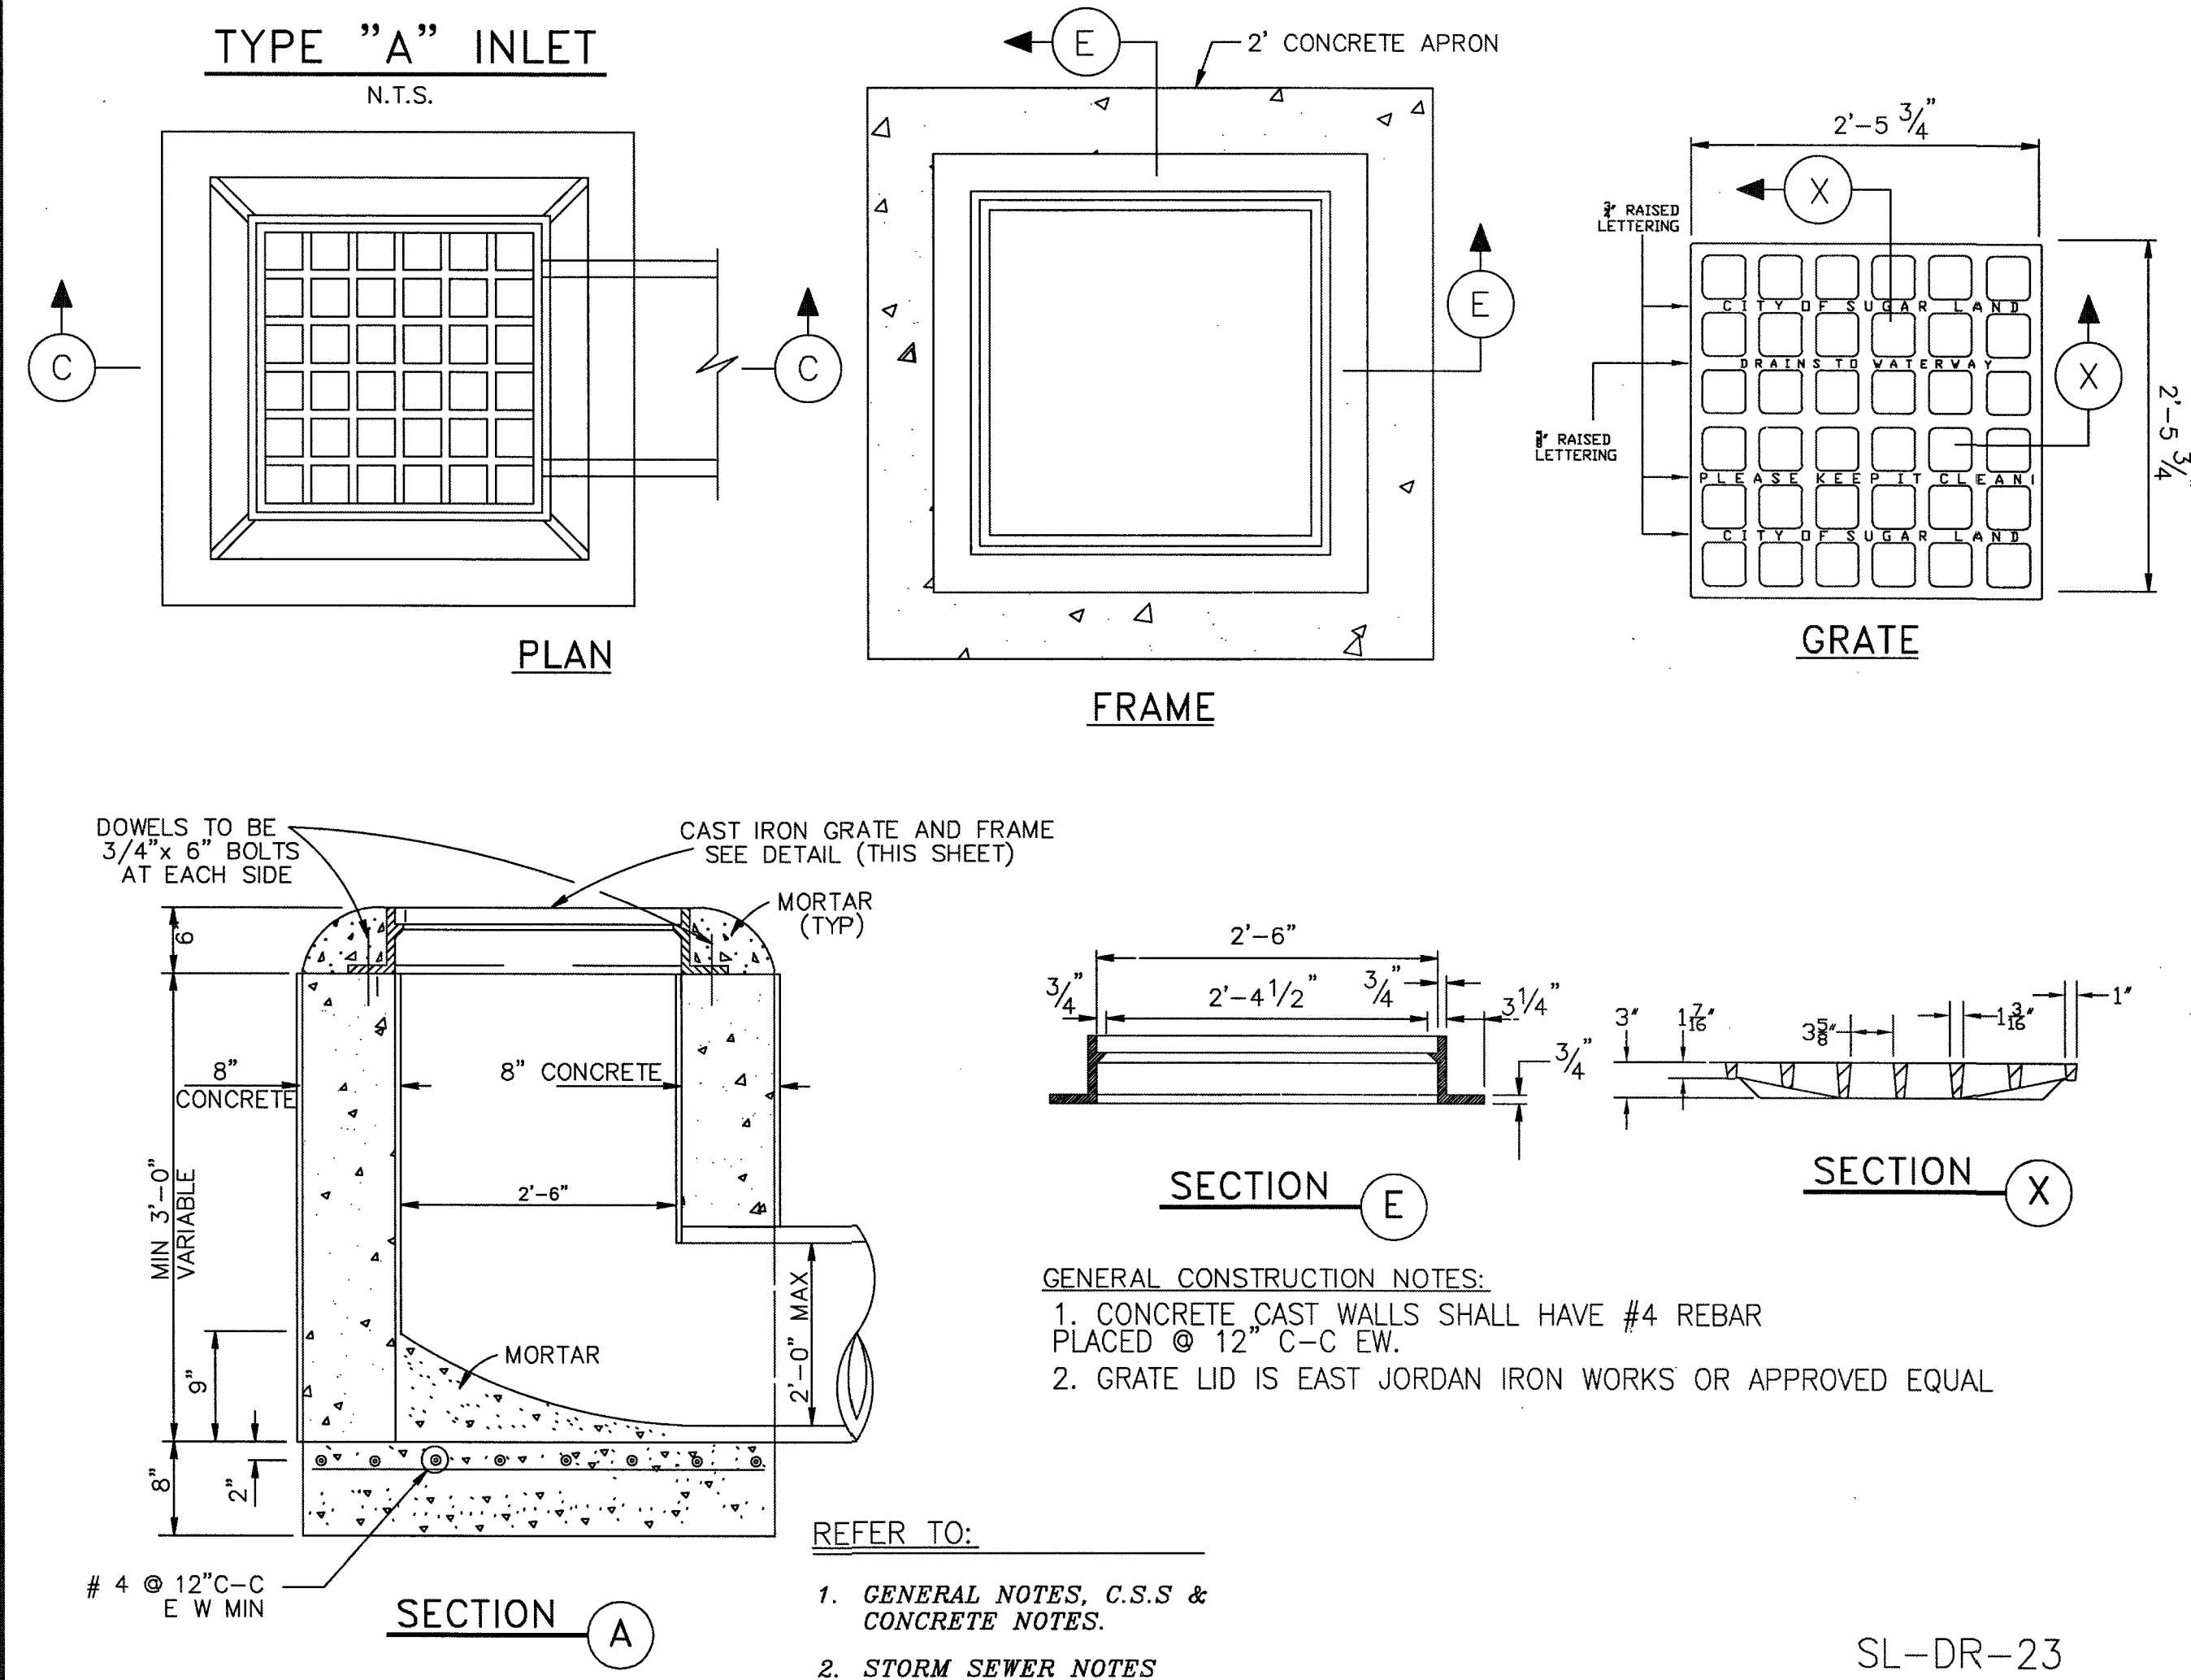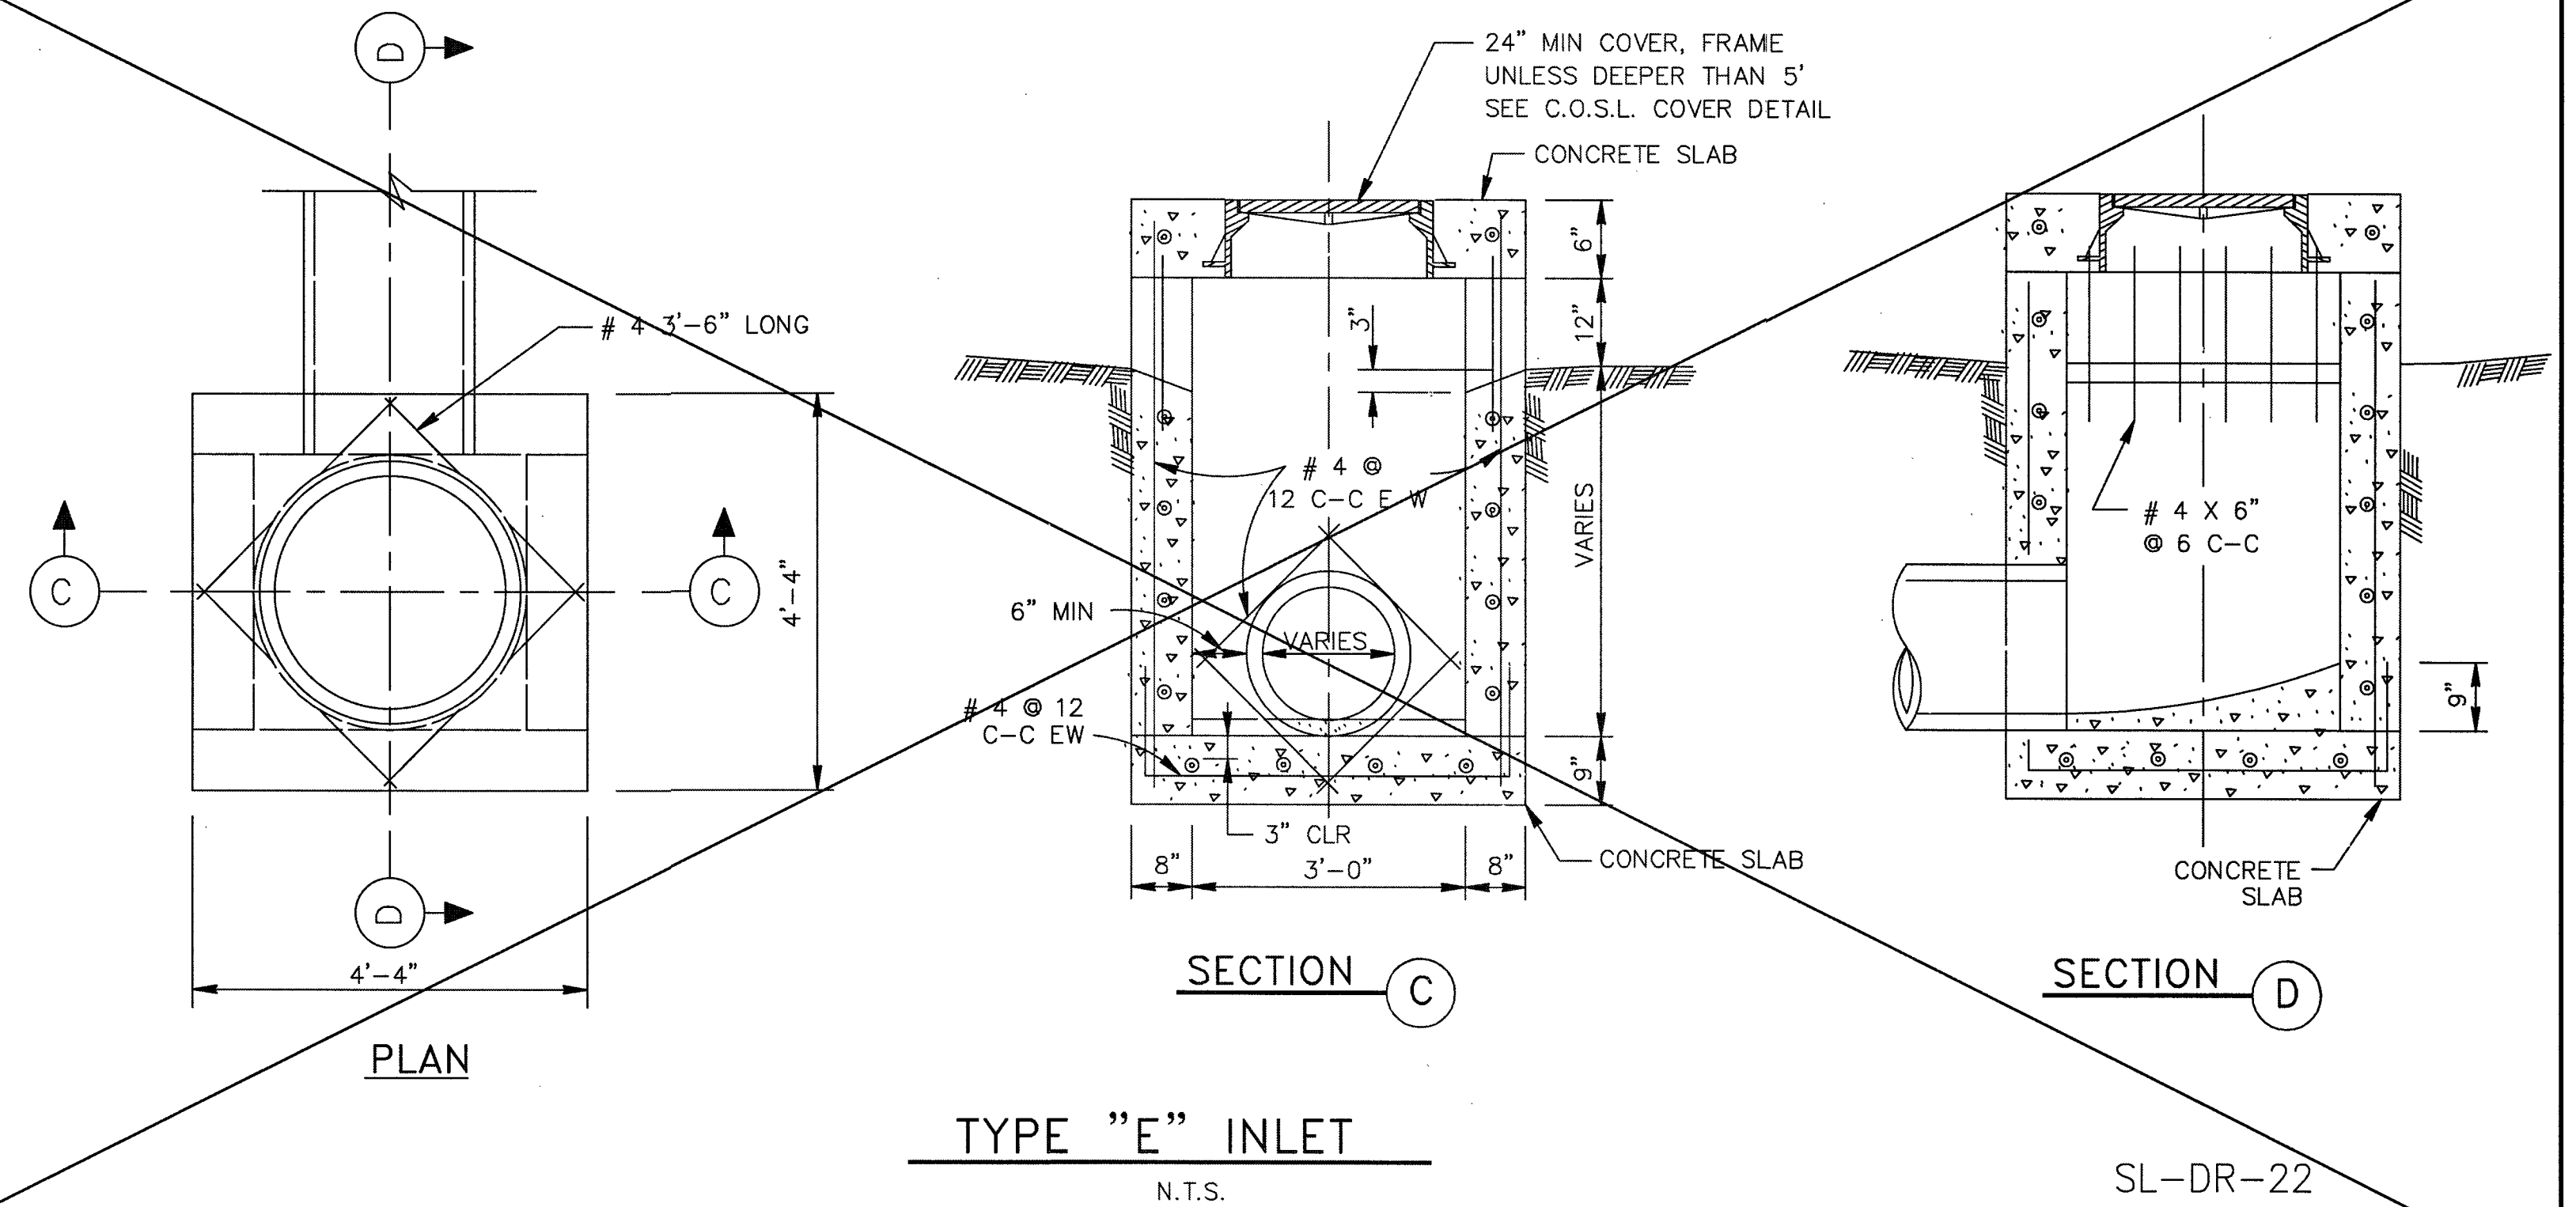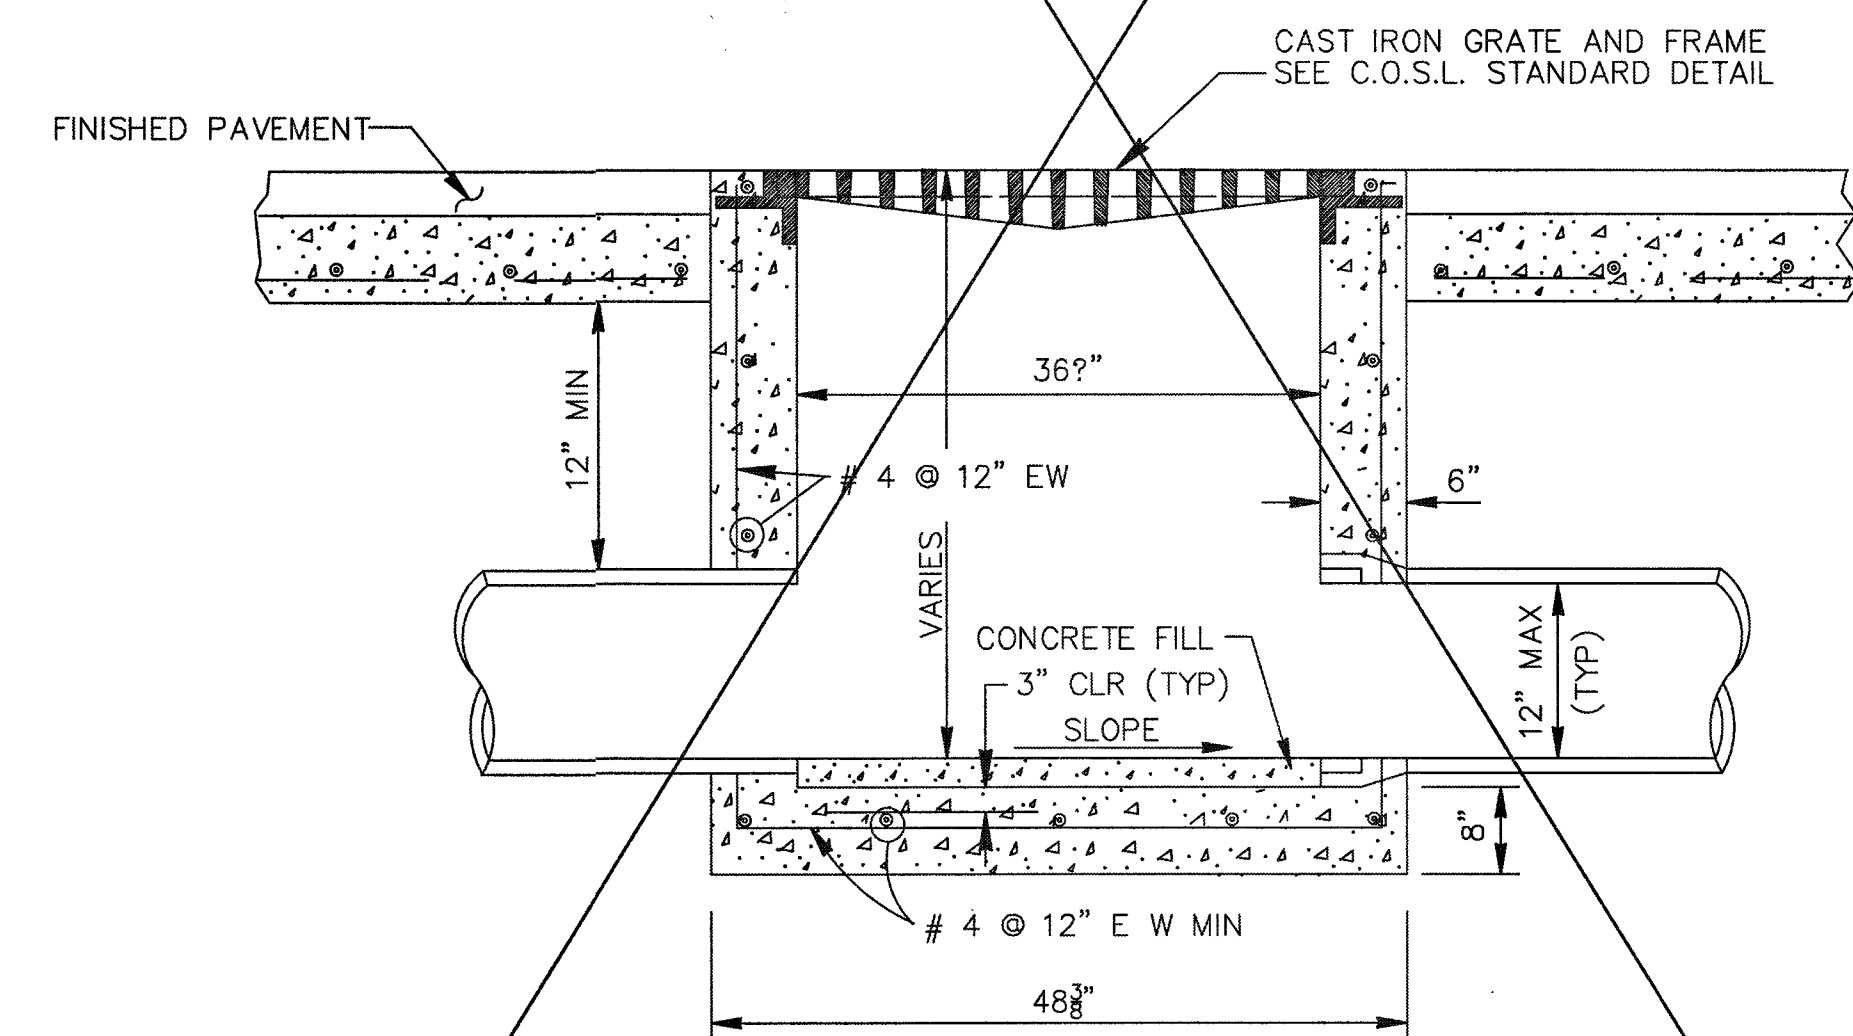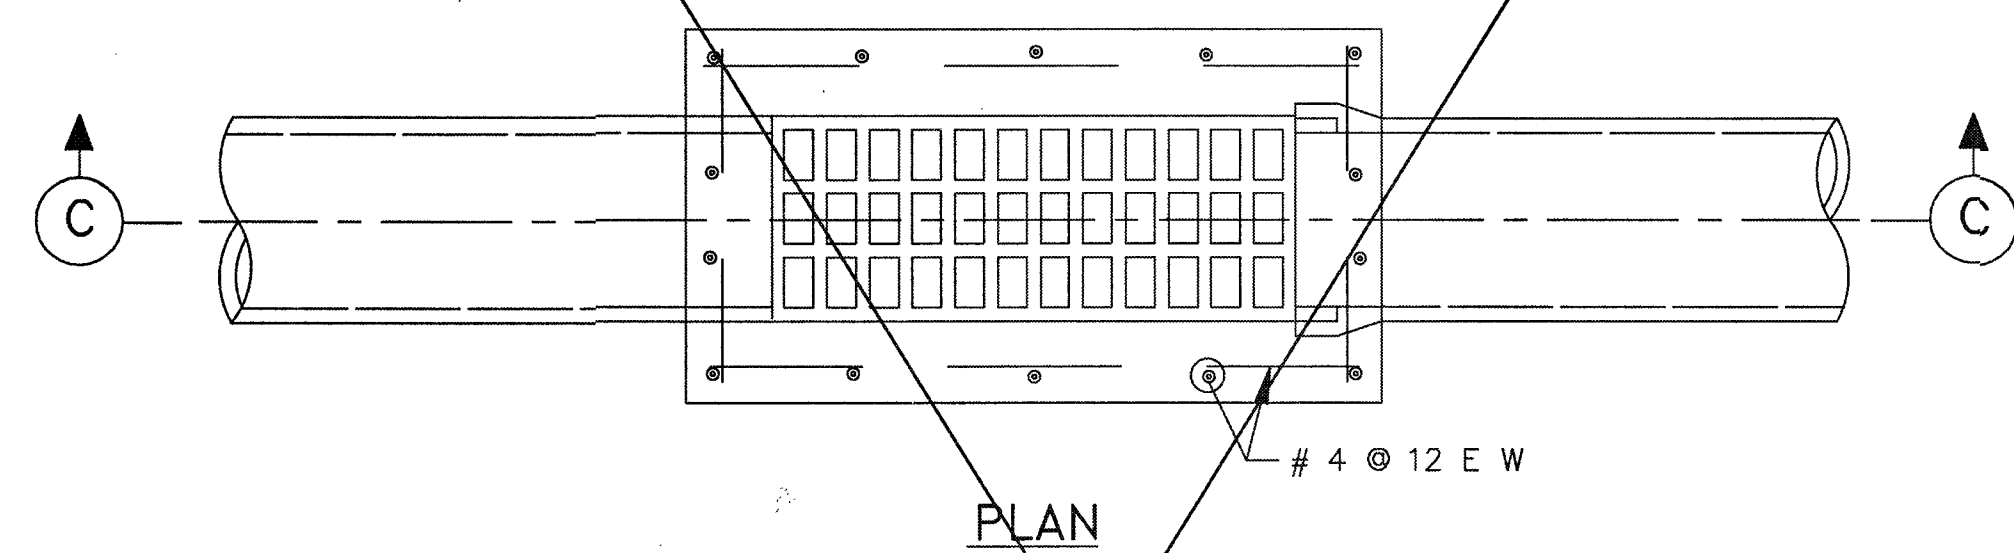

No.	DATE	REVISION

SEAL:

DESIGN ENGINEER: _____ DATE: _____

CITY OF SUGAR LAND, TEXAS
ENGINEERING DEPARTMENT

CONSTRUCTION PLANS FOR:

STORM SEWER INLET
CONSTRUCTION DETAILS I

JOB No.: _____
DATE: _____
DESIGNED BY: _____
DRAWN BY: _____
CHECKED BY: _____
SCALE: _____

SL-07

SHEET OF

SL-DR-23

RECORD DRAWING

NO.	DATE	DESCRIPTION	APPROVED

REVISIONS


DESIGNED MS

DRAWN BT

CHECKED _____

DATE _____

B & L
BAKER & LAWSON, INC.
ENGINEERS • PLANNERS • SURVEYORS
300 E. CEDAR ST., ANGLETON, TEXAS 77515
PHONE: (979) 849-6681 FAX: (979) 849-4689
REG. NO. F-825

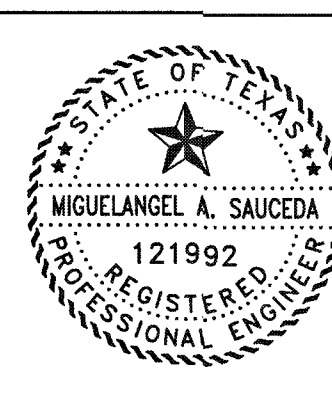

The seal appearing on this document was authorized by Miguelangel A. Saucedo P.E. 121992

Date: 11/1/22

OWNER:

Clint Peltier

Clint Peltier Custom Homes

979-481-4840

PLAN: _____

PROFILE: _____

HORIZONTAL: _____

VERTICAL: _____

BAYOU BEND ESTATES
ANGLETON, TEXAS

PLANS FOR
GRADING, PAVING, UTILITIES
AND DETENTION

STORM SEWER MANHOLE
CONSTRUCTION DETAILS
SL-07

PROJECT NO. 13454



SL-DR-25

1. INLET WALLS MAY BE EXTENDED USING PRECAST RISER SECTION.
2. INLET TOPS MUST BE SECURED TO THE INLET WALL USING #6 DOWELS DRILLED AND GROUTED A MINIMUM DEPTH OF 5" INTO THE INLET WALL. A PLAN PREPARED BY THE MANUFACTURER MUST BE SUBMITTED FOR APPROVAL PRIOR TO INSTALLATION. THE PLAN SHOULD DETAIL CONNECTIONS AND SEALING OF JOINTS.
3. PRECAST INLET TOPS SHALL NOT UTILIZE MULTIPLE ONE-FOOT SECTIONS TO ACHIEVE GRADE.
4. INLET BACKFILL SHALL BE CEMENT STABILIZED SAND TO THE TOP OF THE INLET FIRST STAGE.
5. GRADE 60 REINFORCEMENT. #4 STEEL REBAR TO CONFORM TO ASTM A615 ON REQUIRED CENTERS OR EQUAL.
6. PRECAST INLET MUST BE CONSTRUCTED TO SPECIFICATIONS REQUIRED BY APPROVED DRAWINGS. (SEE GENERAL NOTES).
7. TOPS POURED-IN-PLACE REQUIRE #4 REBAR @ 12" C-C EACH WAY, 4,500 PSI CONCRETE MINIMUM AND 3" THICK MINIMUM.
8. PAVEMENT DEPTH AT INLET SHALL BE EQUAL TO OR GREATER THAN REQUIRED PAVEMENT DEPTH.
9. DEPRESS GUTTER TO INLET.
10. ALL SIDES OF ALL INLETS MUST BE COMPACTED.
11. REFER TO GEOTECHNICAL REPORTS FOR RECOMMENDED TRENCH SIDE SLOPES.



SCALE: N.T.S.

SL-DR-40





N.T.S.

SL-DR-26

1. GENERAL NOTES
2. SEE C.S.S., PAVEMENT NOTES

RECORD DRAWING

DESIGNED _____ MS
DRAWN _____ BT
CHECKED _____
DATE _____

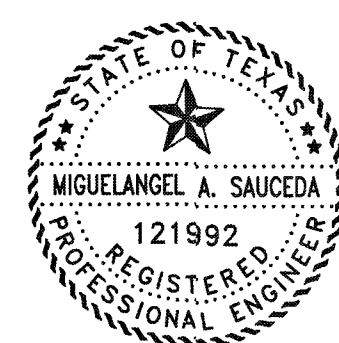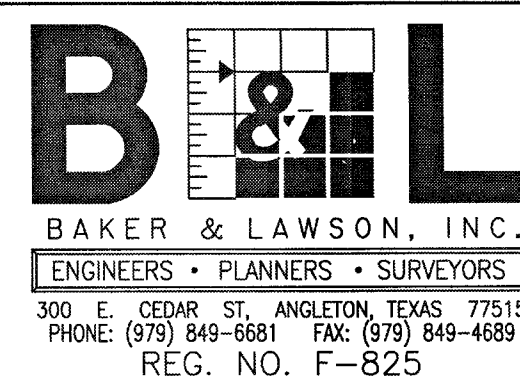

The seal appearing on
this document was
authorized by
Miguelangel A. Saucedo
P.E. 121992

Date: 1/11/22

OWNER:
Clint Peltier
Clint Peltier Custom Homes
979-481-4840


PLAN: _____
 PROFILE: _____
 HORIZONTAL: _____
 VERTICAL: _____

**BAYOU BEND ESTATES
ANGLETON, TEXAS
PLANS FOR
GRADING, PAVING, UTILITIES
AND DETENTION**


STORM SEWER INLET
CONSTRUCTION DETAILS II
SL-08

PROJECT NO. 13454

22

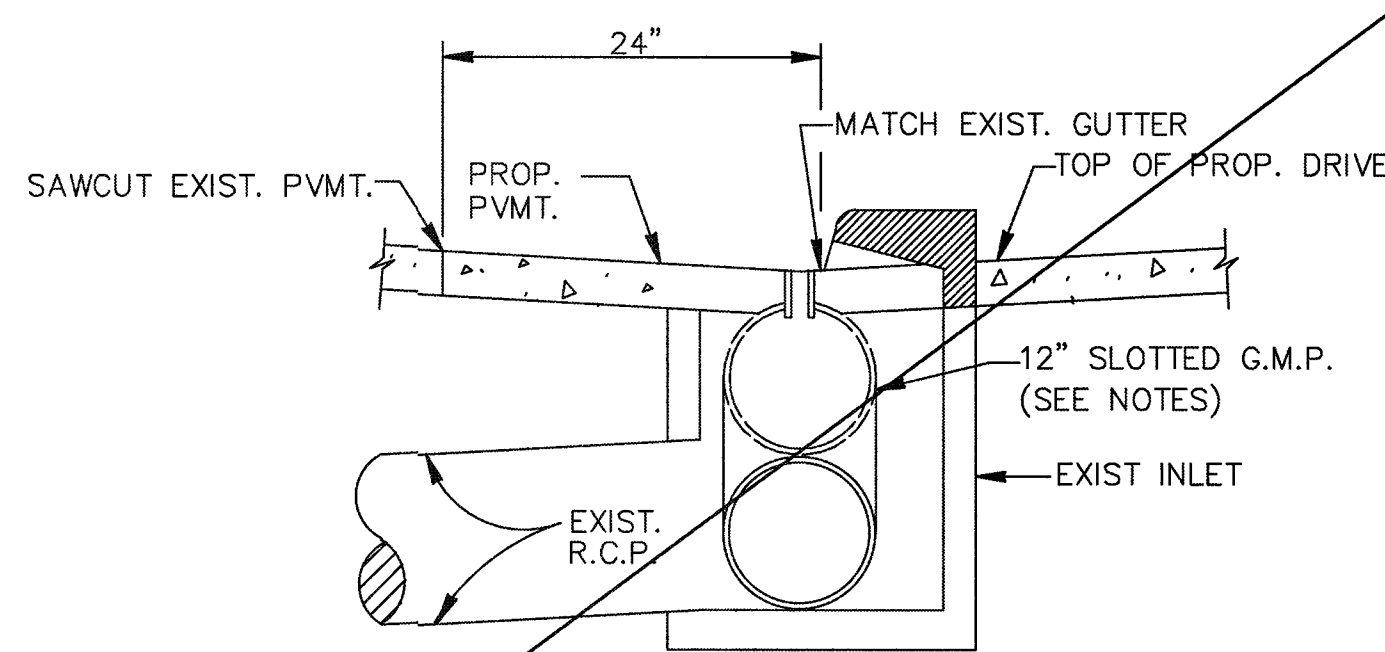

SLOTTED PIPE INSTALLATION
FOR DRIVEWAY CONSTRUCTION

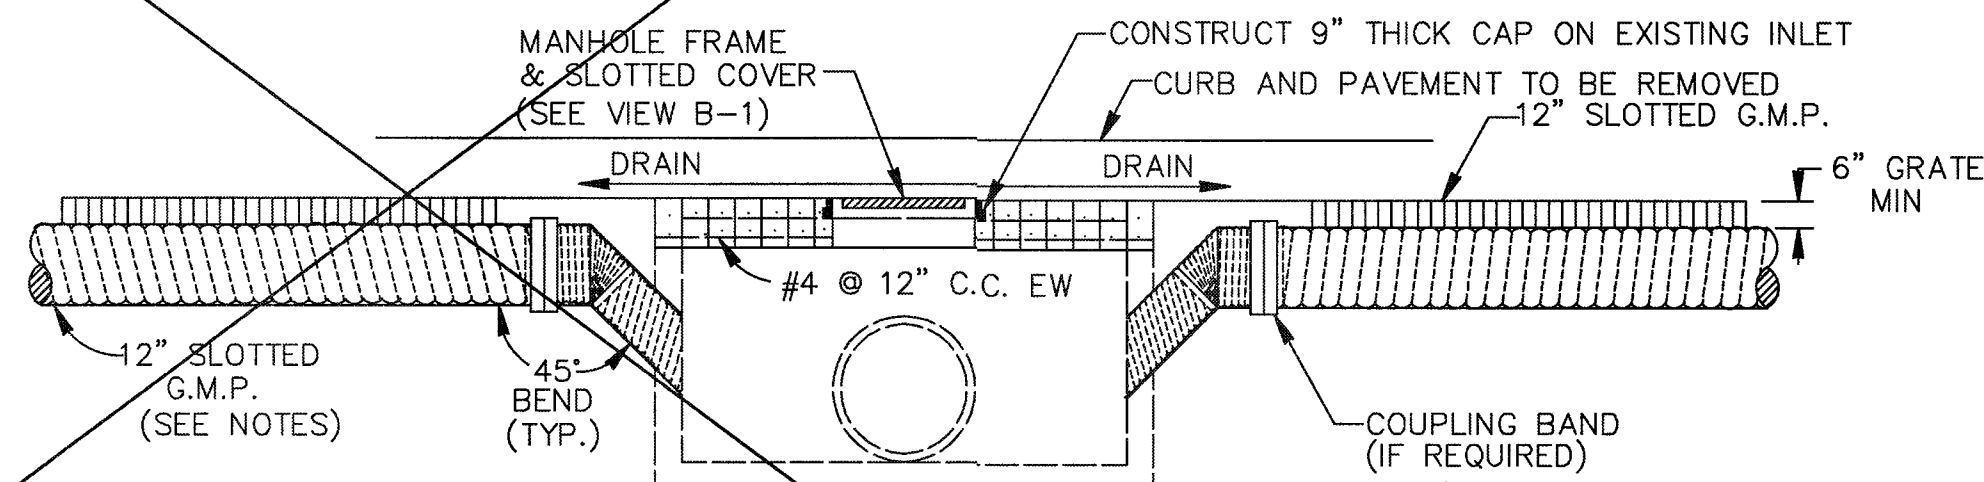


SECTION C-C



- ## NOTES
- 1.) 30 FEET OF SLOT IS THE MINIMUM REQUIREMENT TO REPLACE A TYPE B-B INLET.
 - 2.) CONCRETE MIN. 3000 P.S.I.
 - 3.) PIPE TO BE GALVANIZED TYPE II WITH GALVANIZED SLOT
 - 4.) CONDITIONS MAY VARY. CONTRACTOR TO ROLL FITTING AND ENTER BOX BELOW 9" CAP.
 - 5.) SEE C.S.S. NOTES.

SLOTTED DRAIN DETAIL

N.T.S.

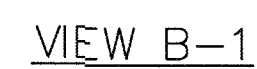

~~SL-DR-29~~

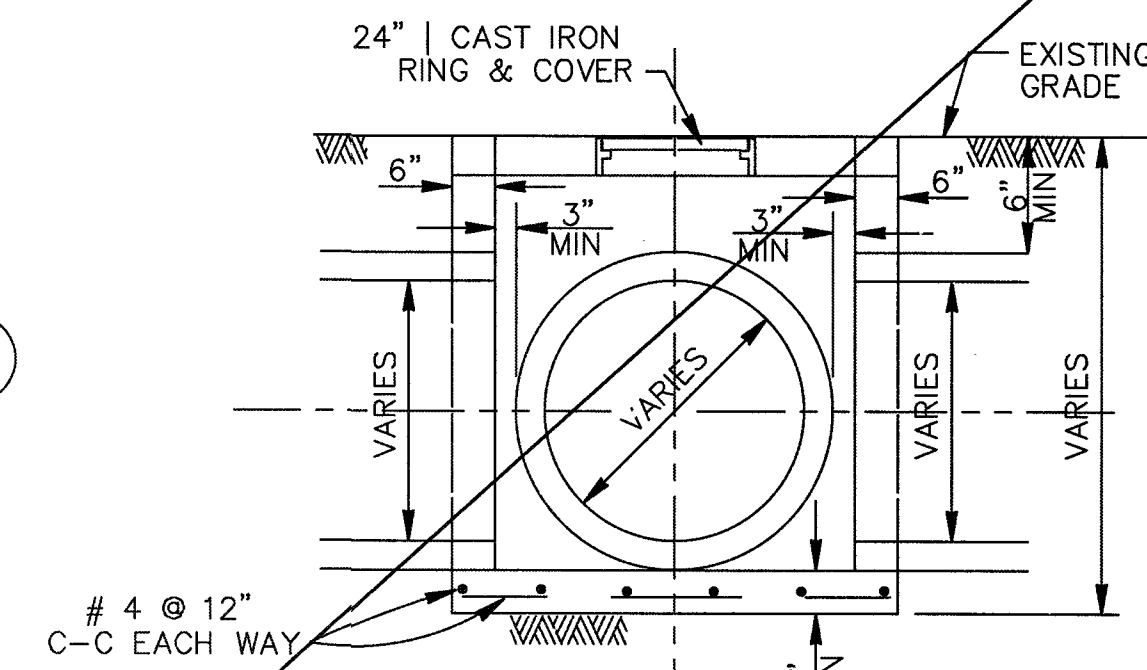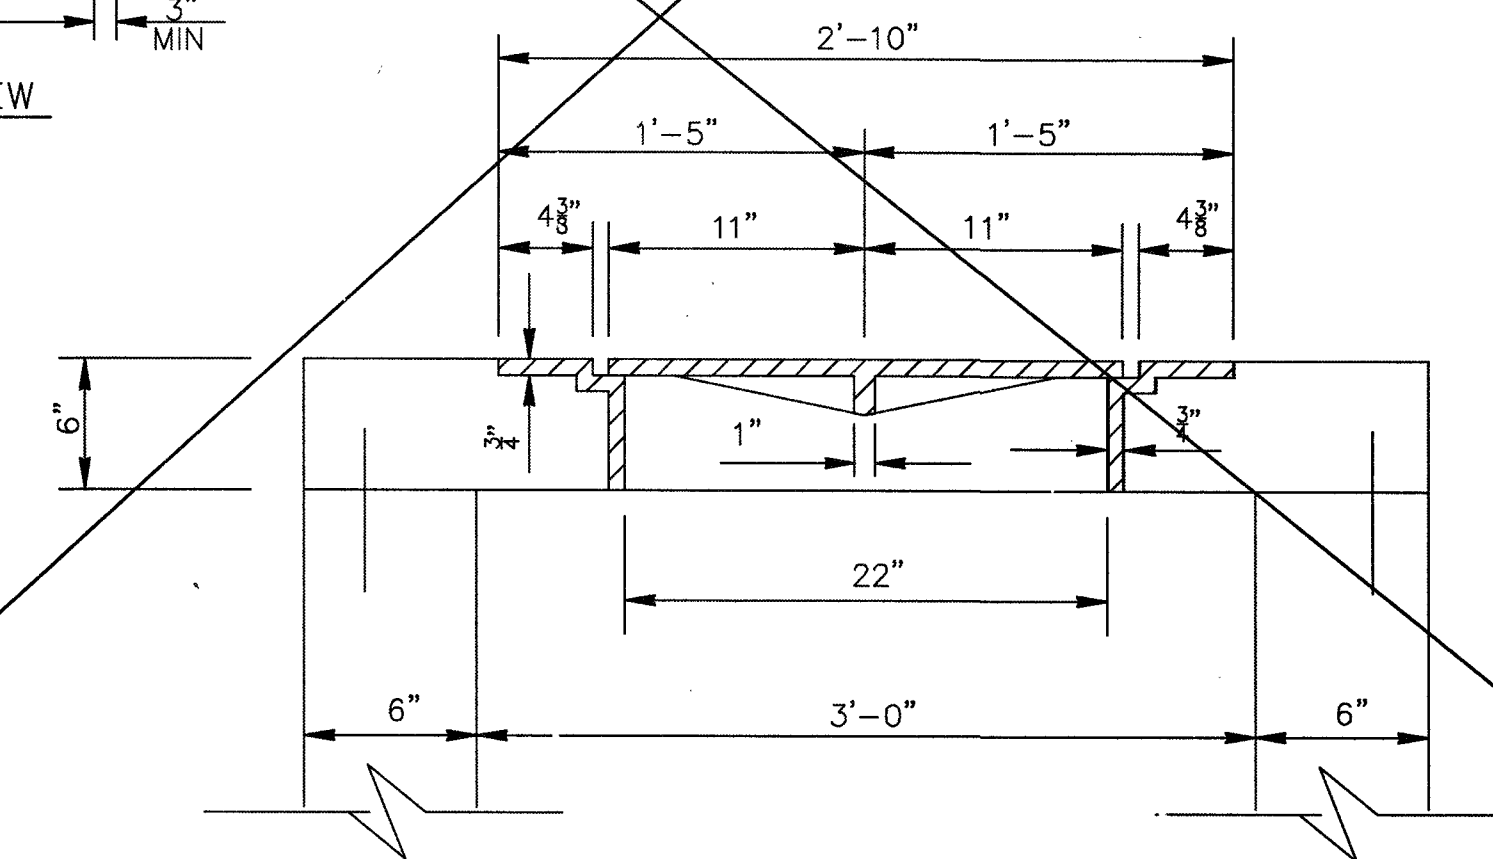SECTION 

FRAME AND COVER SECTION

JUNCTION BOX

N.T.S.

SL-DR-30



STORM SEWER CHOKE RESTRICTOR

N.T.S.

SL-DR-31

REFER TO:

1. GENERAL NOTES
2. STORM SEWER NOTES



N.T.S.

SL-DR-32

Clint Peltier
Clint Peltier Custom Homes
979-481-4840



N.T.S.

RECORD DRAWING

SL-DR-33



CONSTRUCTION PLANS FOR:



STORM SEWER CONSTRUCTION DETAILS

JOB No.:
DATE:
DESIGNED BY:
DRAWN BY:
CHECKED BY:
SCALE:

SL-10

SHEET OF

DESIGNED	MS
DRAWN	BT
CHECKED	
DATE	

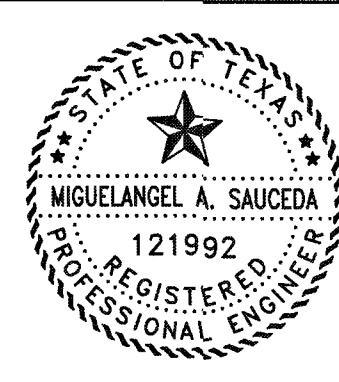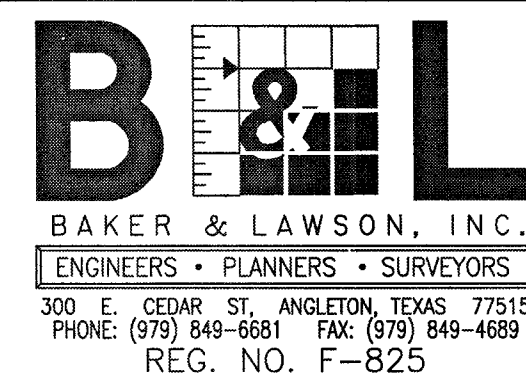

The seal appearing on
this document was
authorized by
Miguelangel A. Saucedo
P.E. 121992

Date: 1/11/22

OWNER:



PLAN: _____
 PROFILE: _____
 HORIZONTAL: _____
 VERTICAL: _____

**BAYOU BEND ESTATES
ANGLETON, TEXAS
PLANS FOR
GRADING, PAVING, UTILITIES
AND DETENTION**


STORM SEWER
CONSTRUCTION DETAILS
SL-10

PROJECT NO. 13454



24

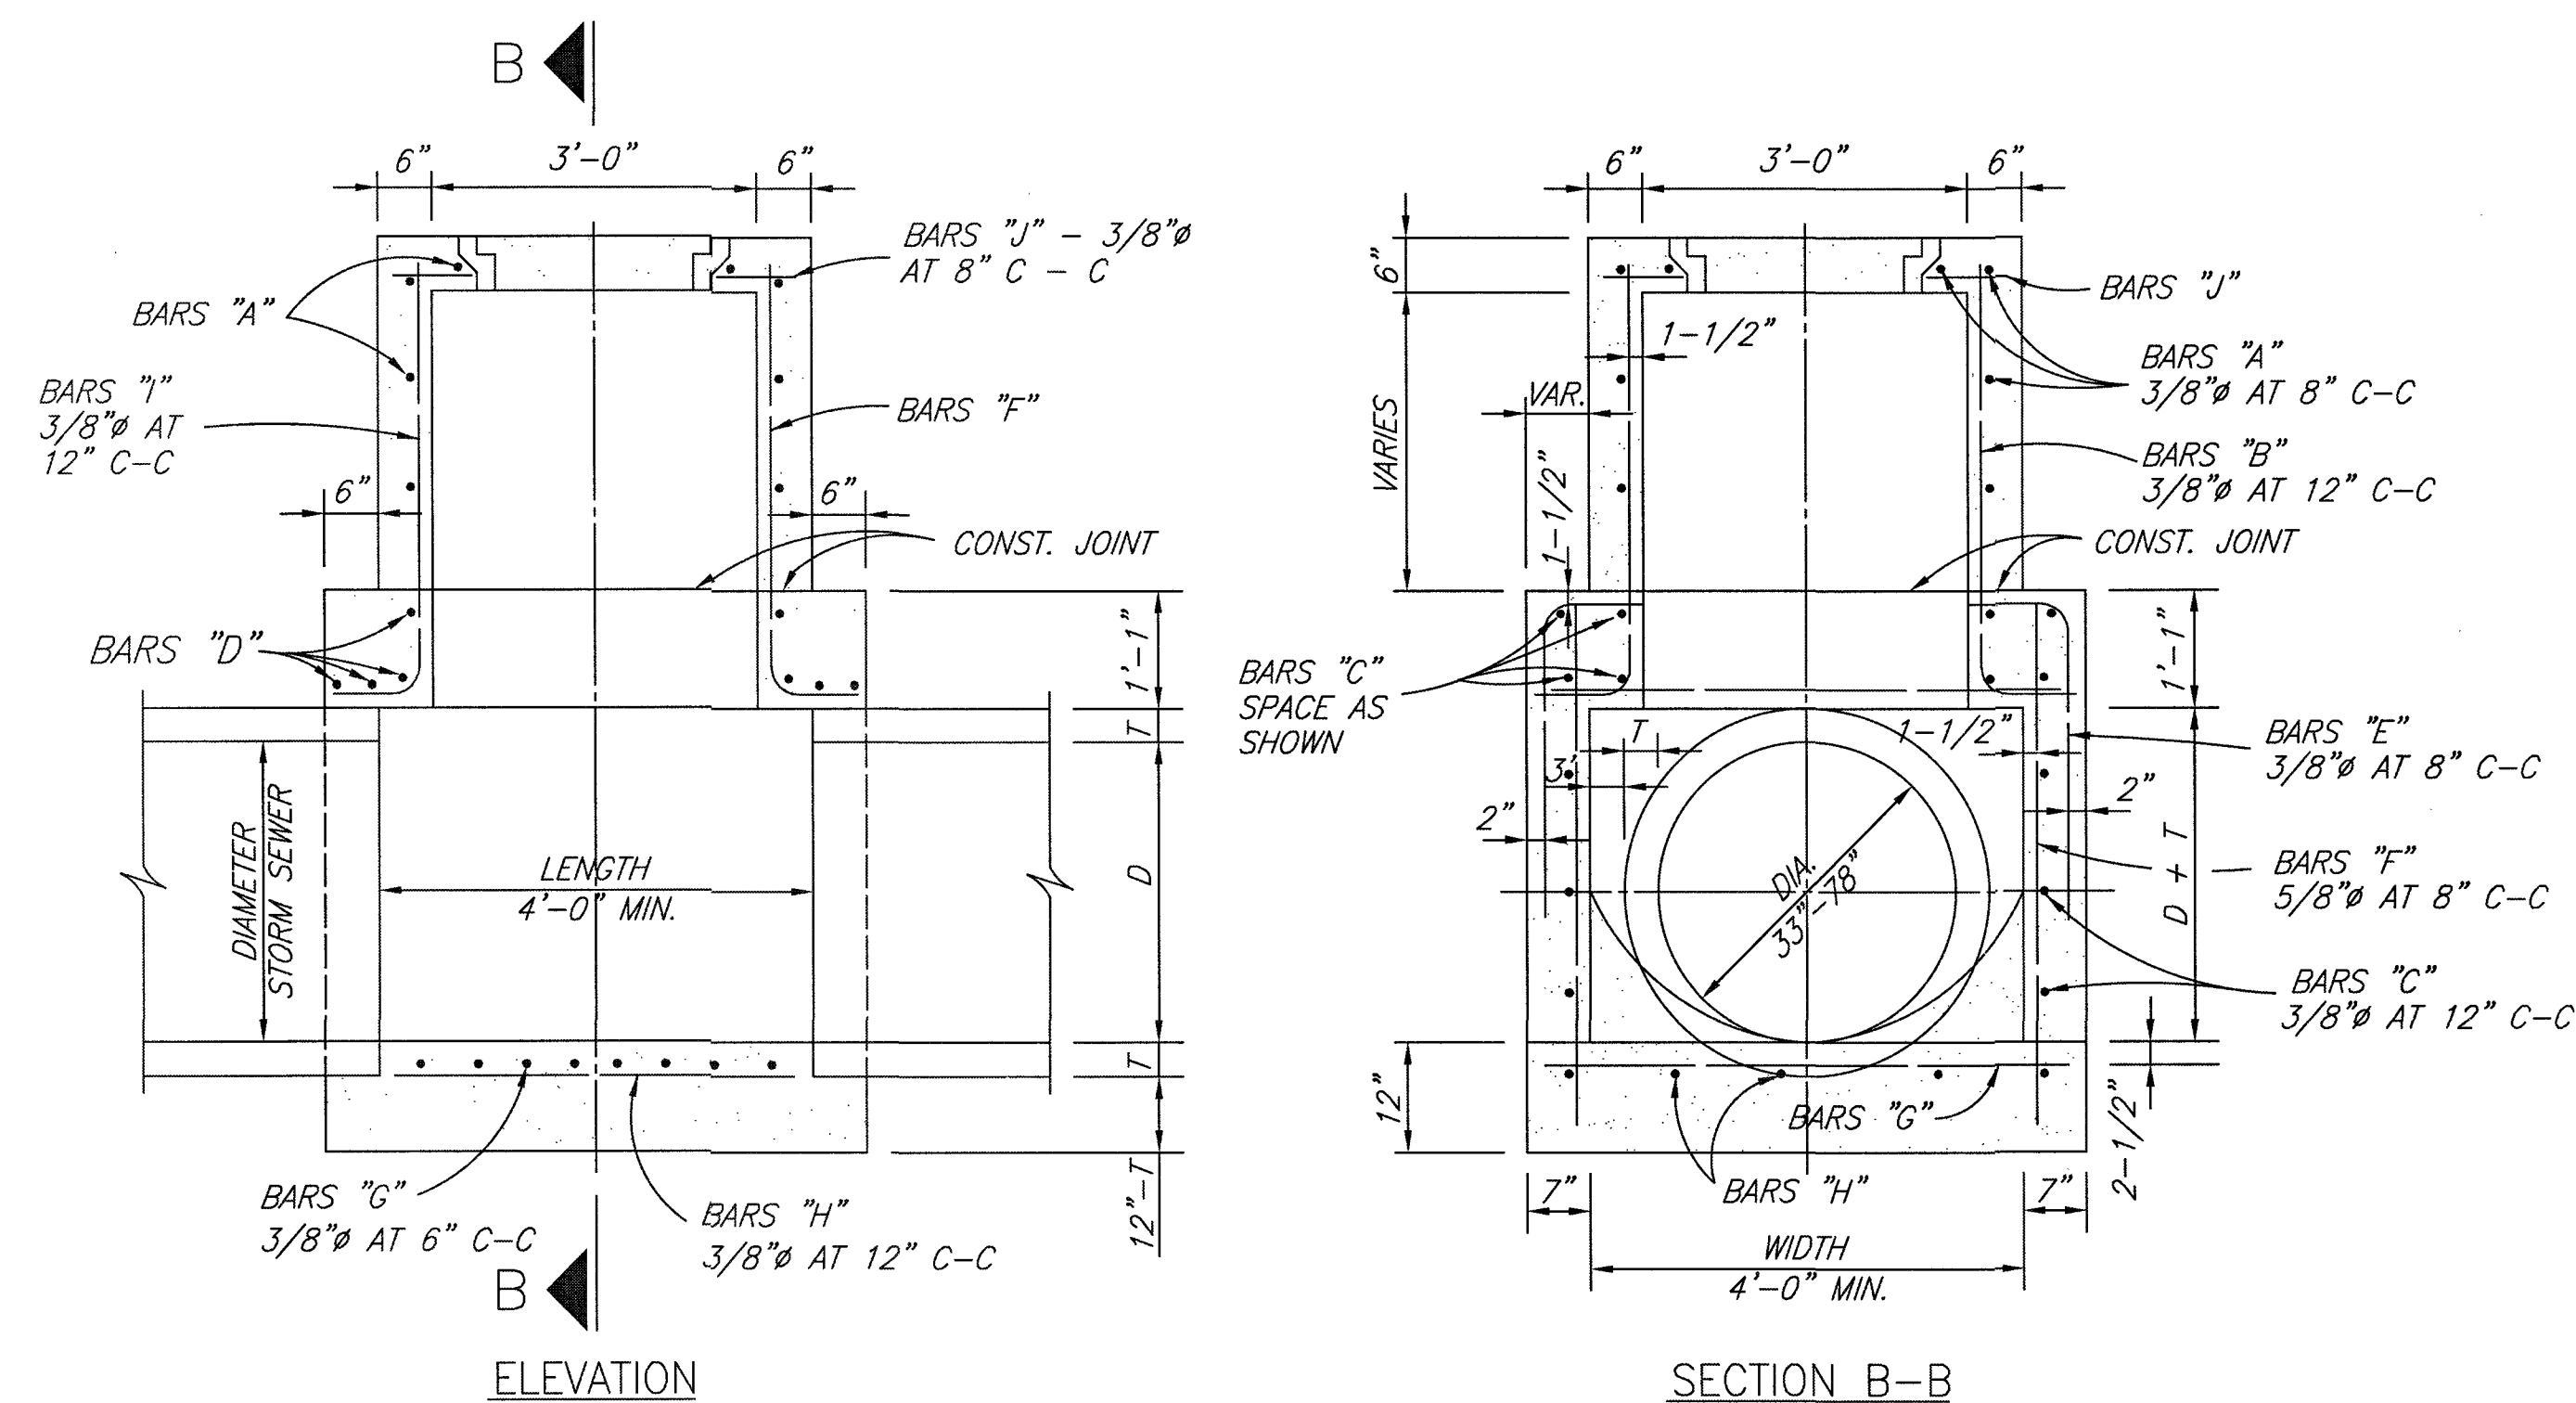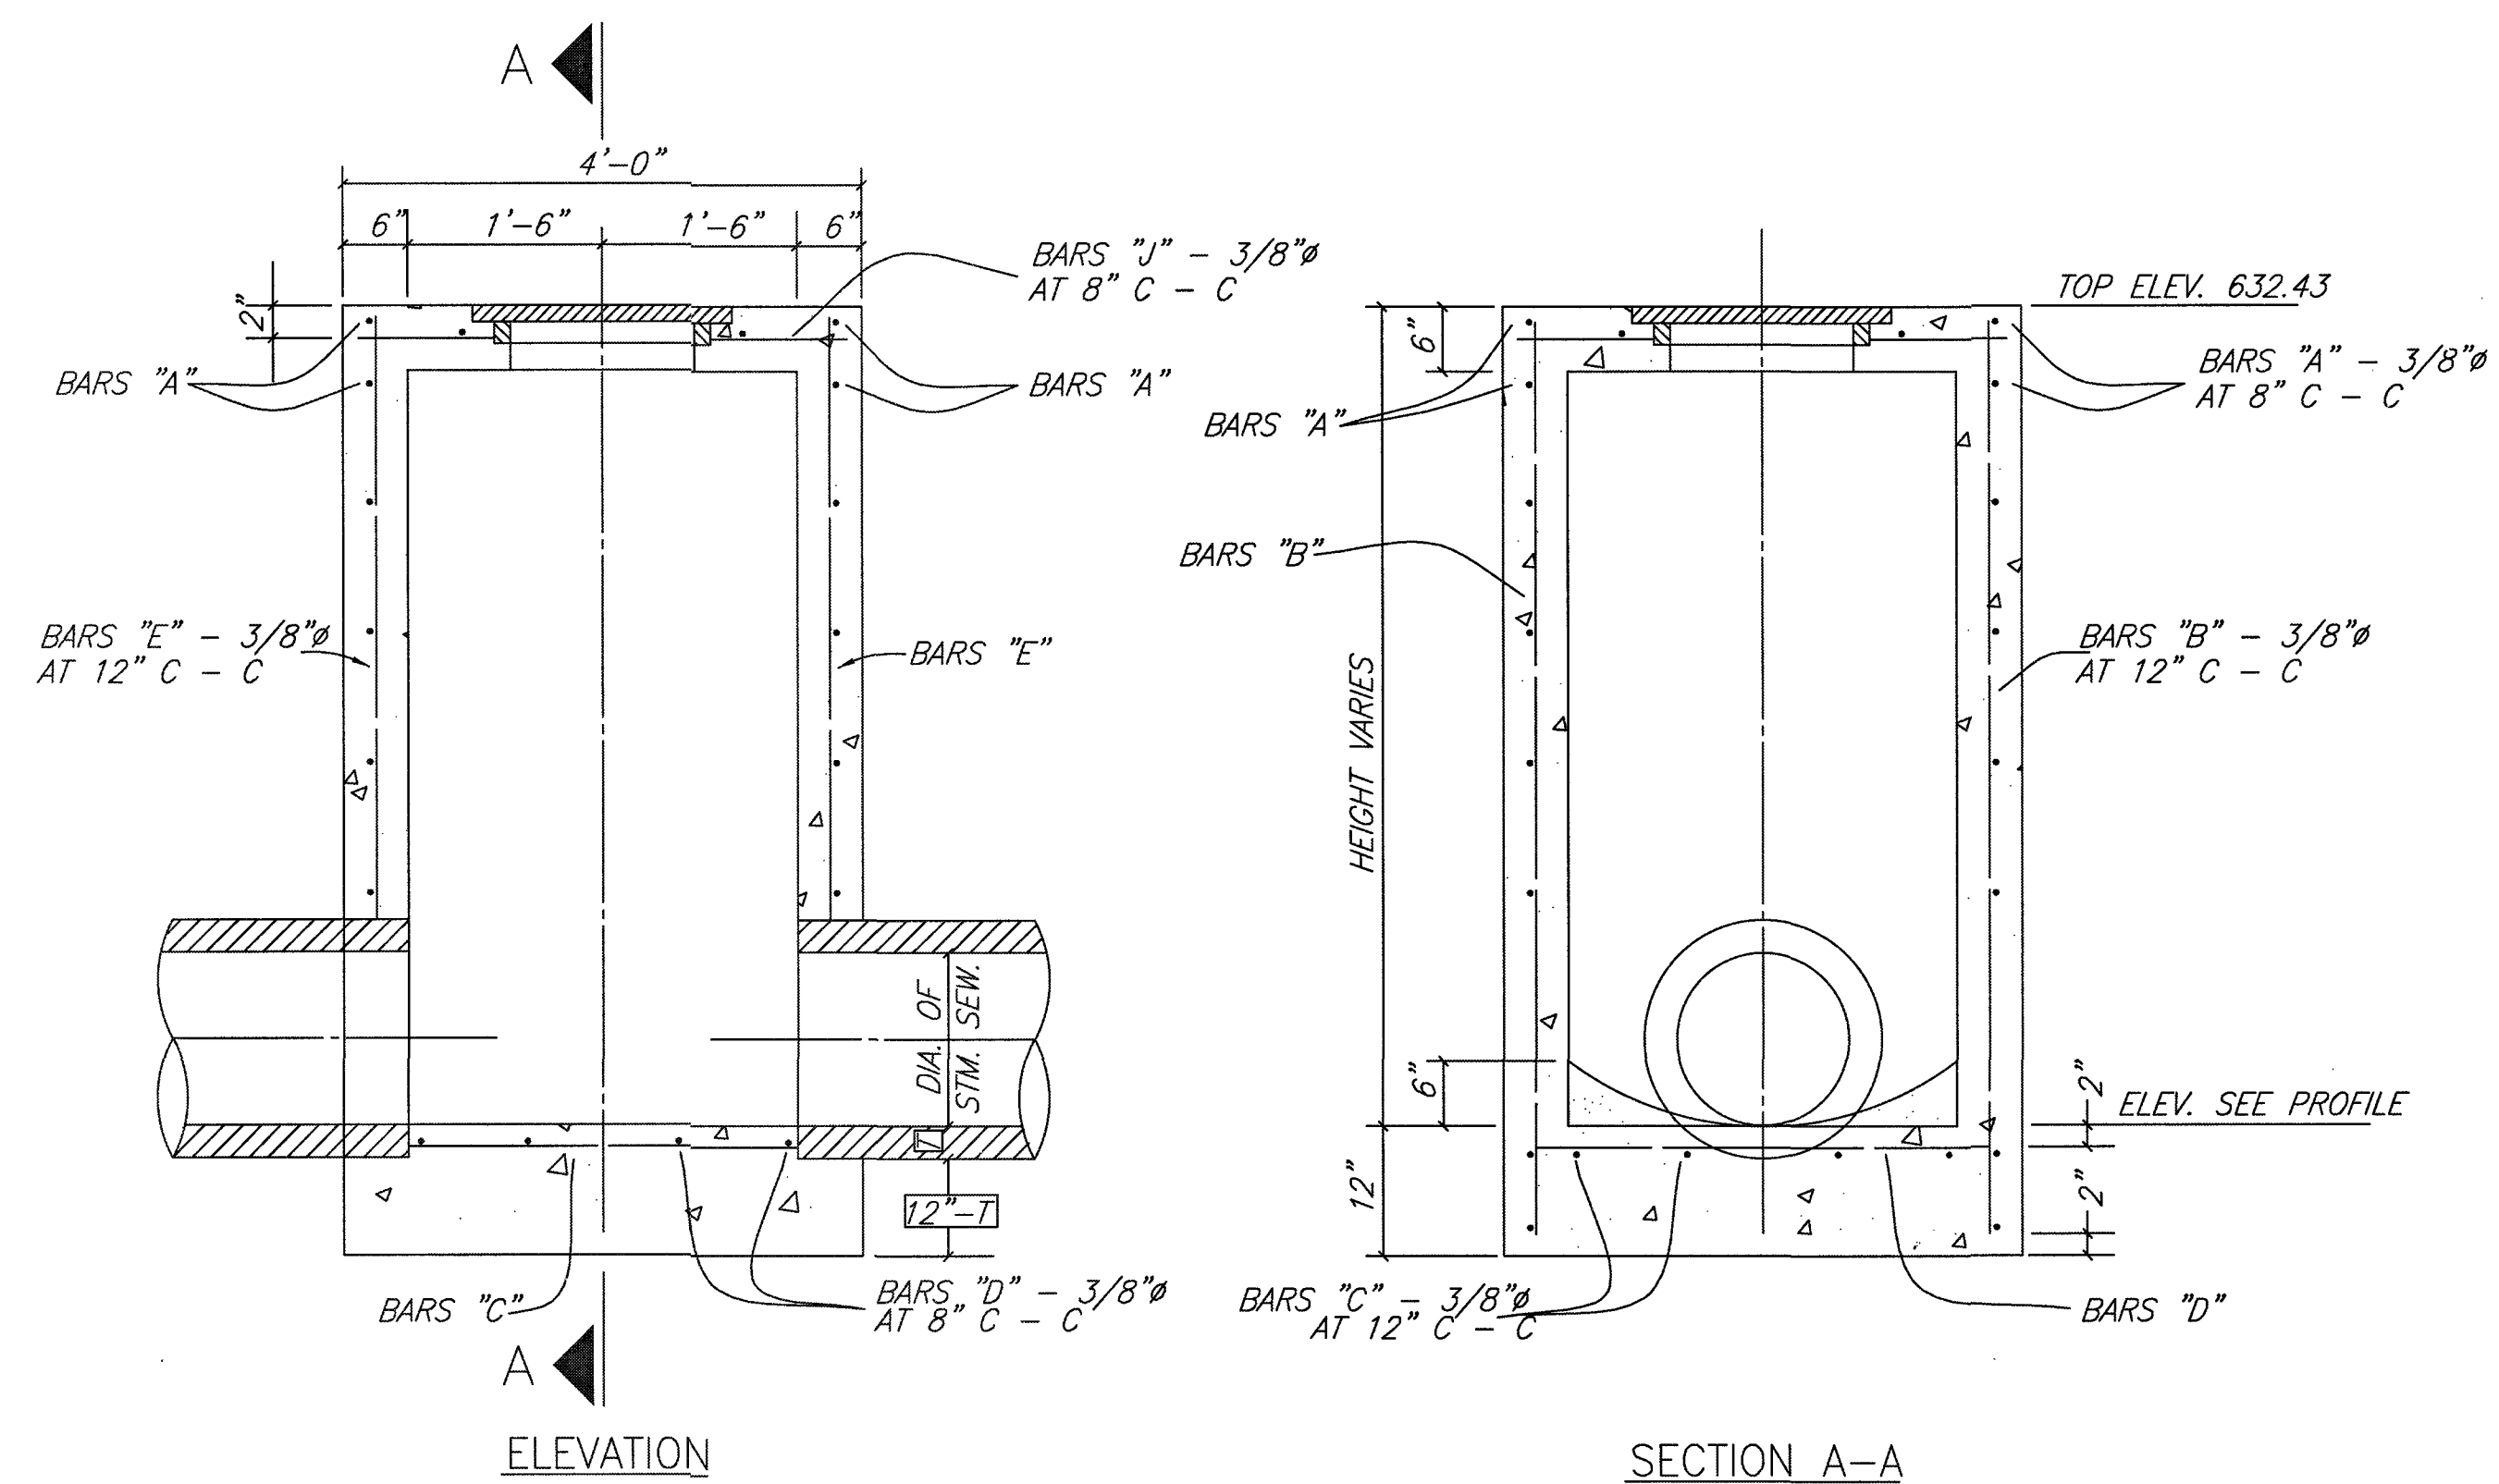


RECORD DRAWING

No.	DATE	REVISION			
SEAL:					
_____ DATE _____ DESIGN ENGINEER:					
<div style="text-align: center;"><p>CITY OF SUGAR LAND, TEXAS ENGINEERING DEPARTMENT</p></div>					
<u>CONSTRUCTION PLANS FOR:</u>					
JUNCTION BOX MANHOLES					
JOB No.: DATE: DESIGNED BY: DRAWN BY: CHECKED BY: SCALE:			SL-11 SHEET OF		

				DESIGNED	MS
				DRAWN	BT
NO.	DATE	DESCRIPTION	APPROVED	CHECKED	
REVISIONS				DATE	

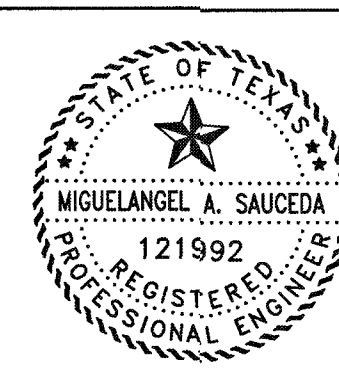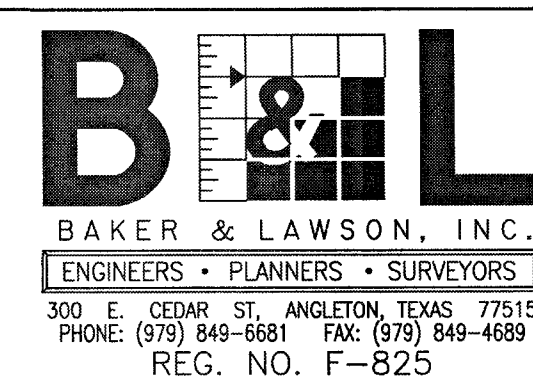

The seal appearing on
this document was
authorized by
Miguelangel A. Saucedo
P.E. 121992

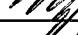
Date: 1/11/27









OWNER:
Clint Peltier
Clint Peltier Custom Homes
979-481-4840

PLAN: _____
 PROFILE: _____
 HORIZONTAL: _____
 VERTICAL: _____

**BAYOU BEND ESTATES
ANGLETON, TEXAS
PLANS FOR
GRADING, PAVING, UTILITIES
AND DETENTION**

JUNCTION BOX
MANHOLES
SL-11

PROJECT NO. 13454

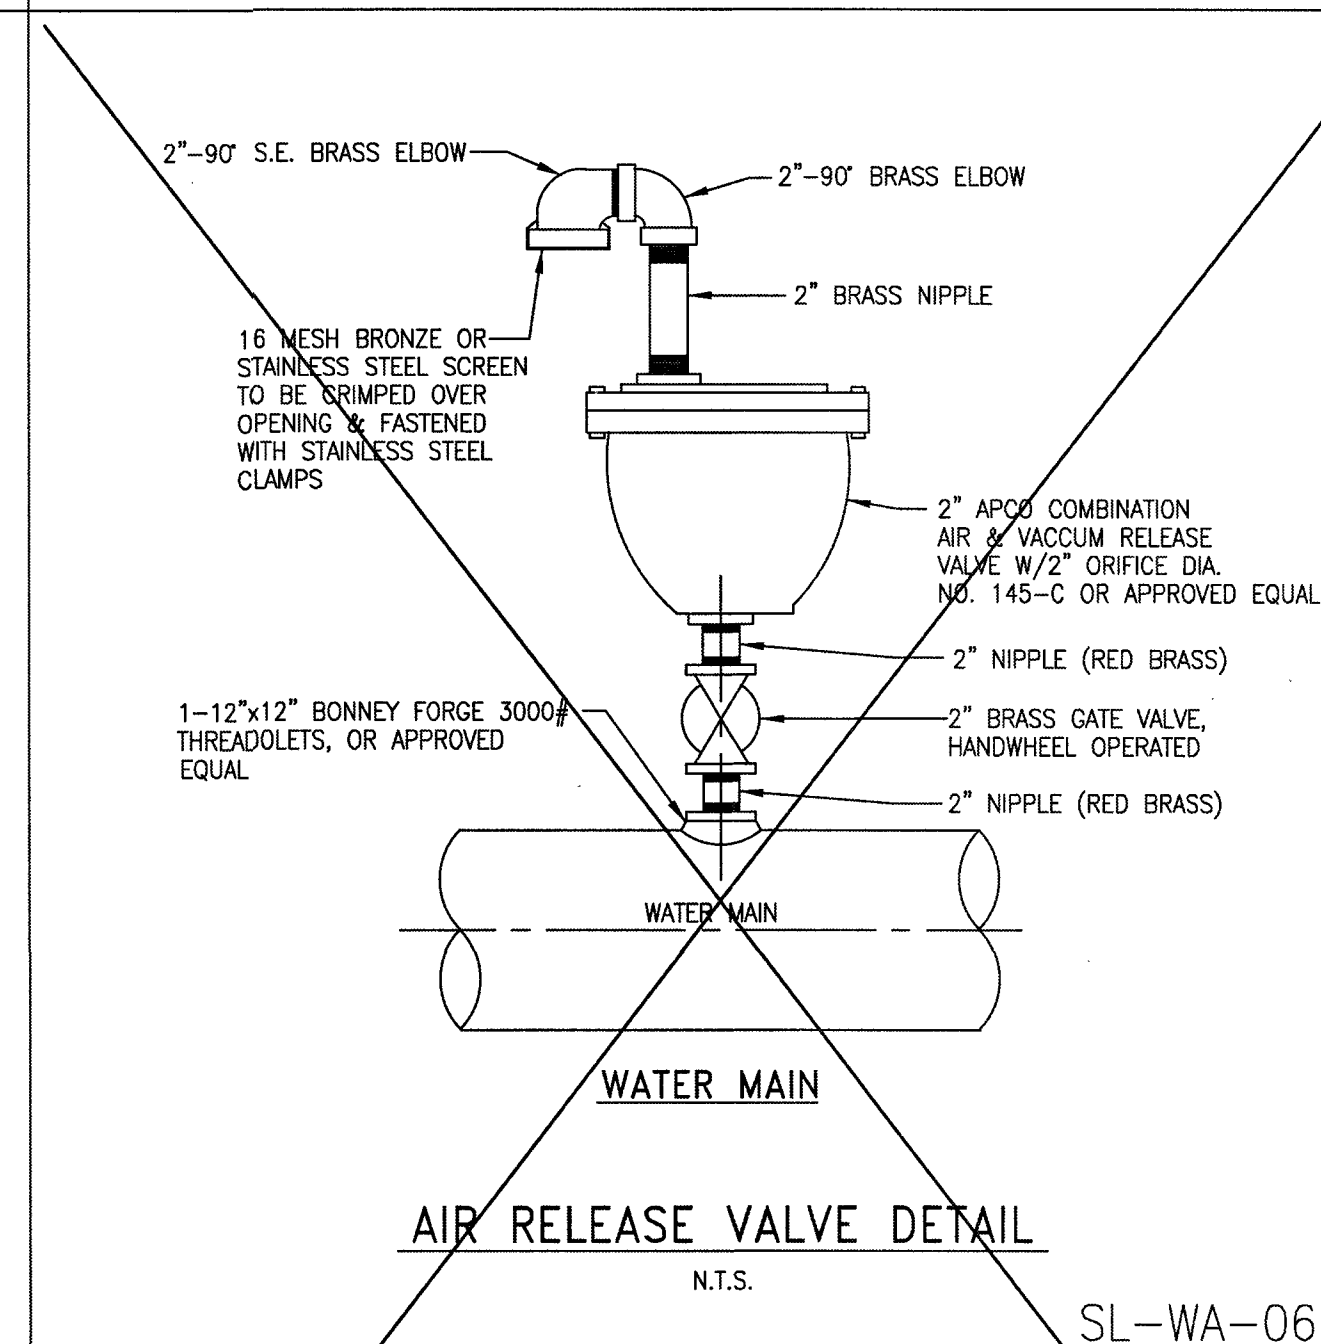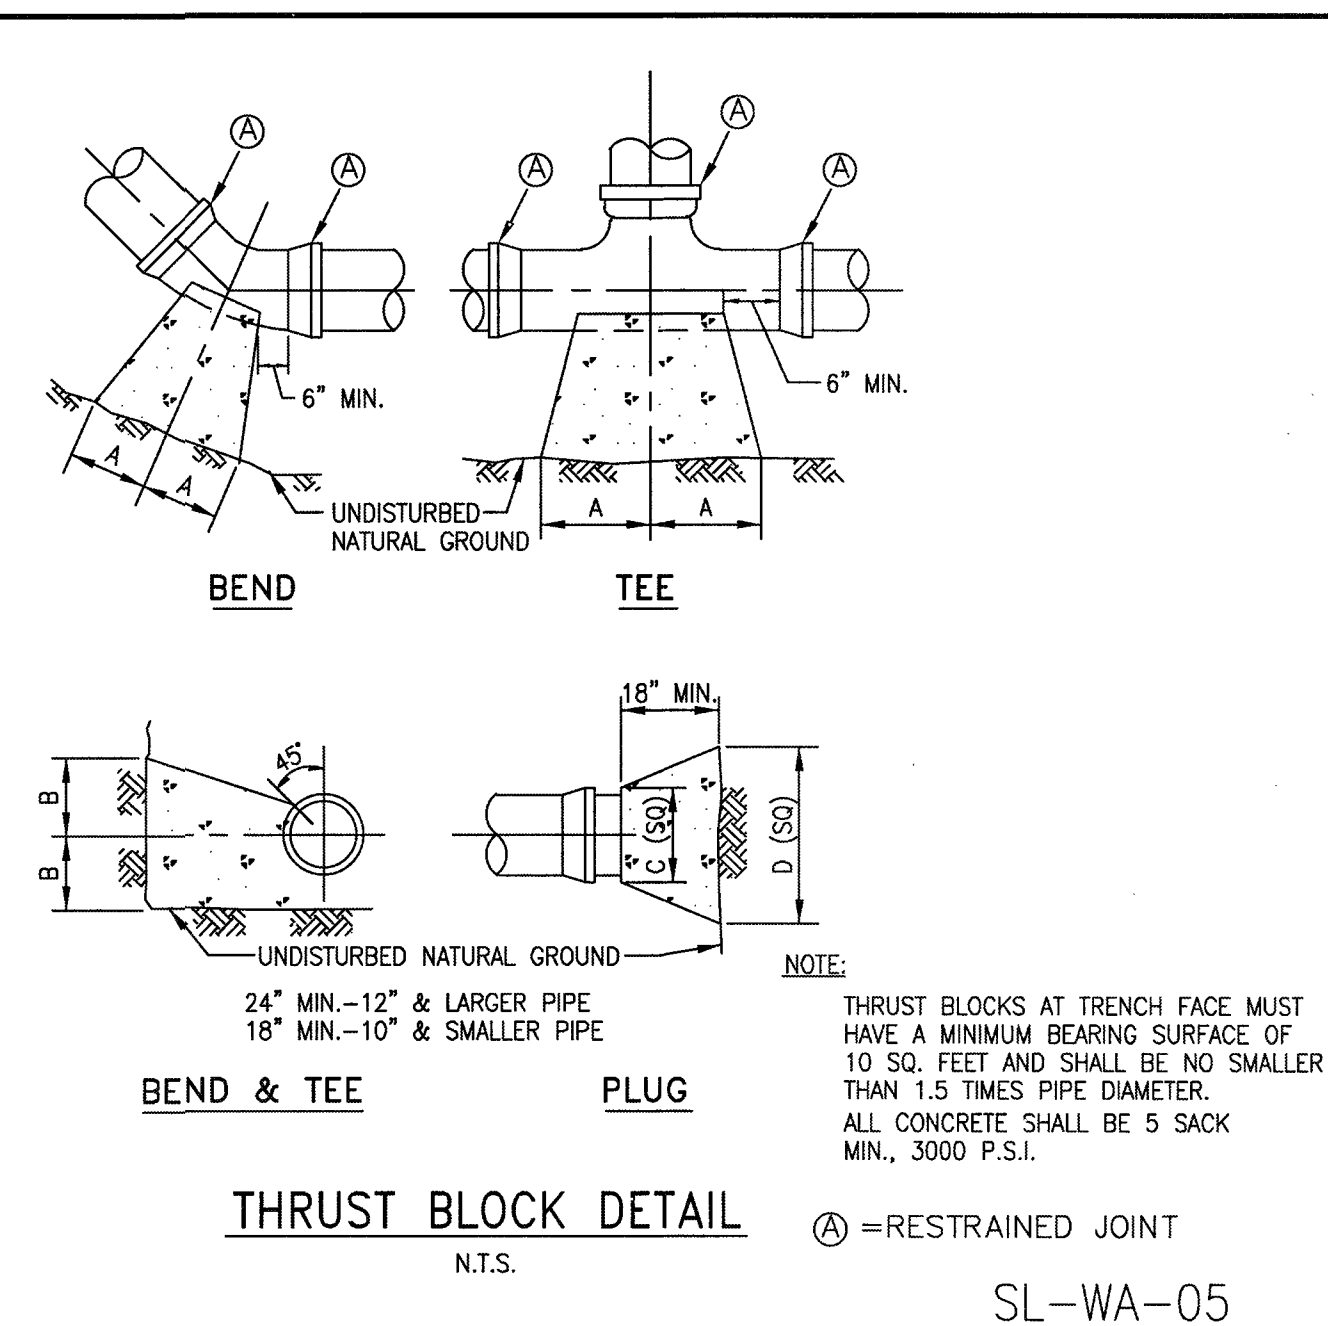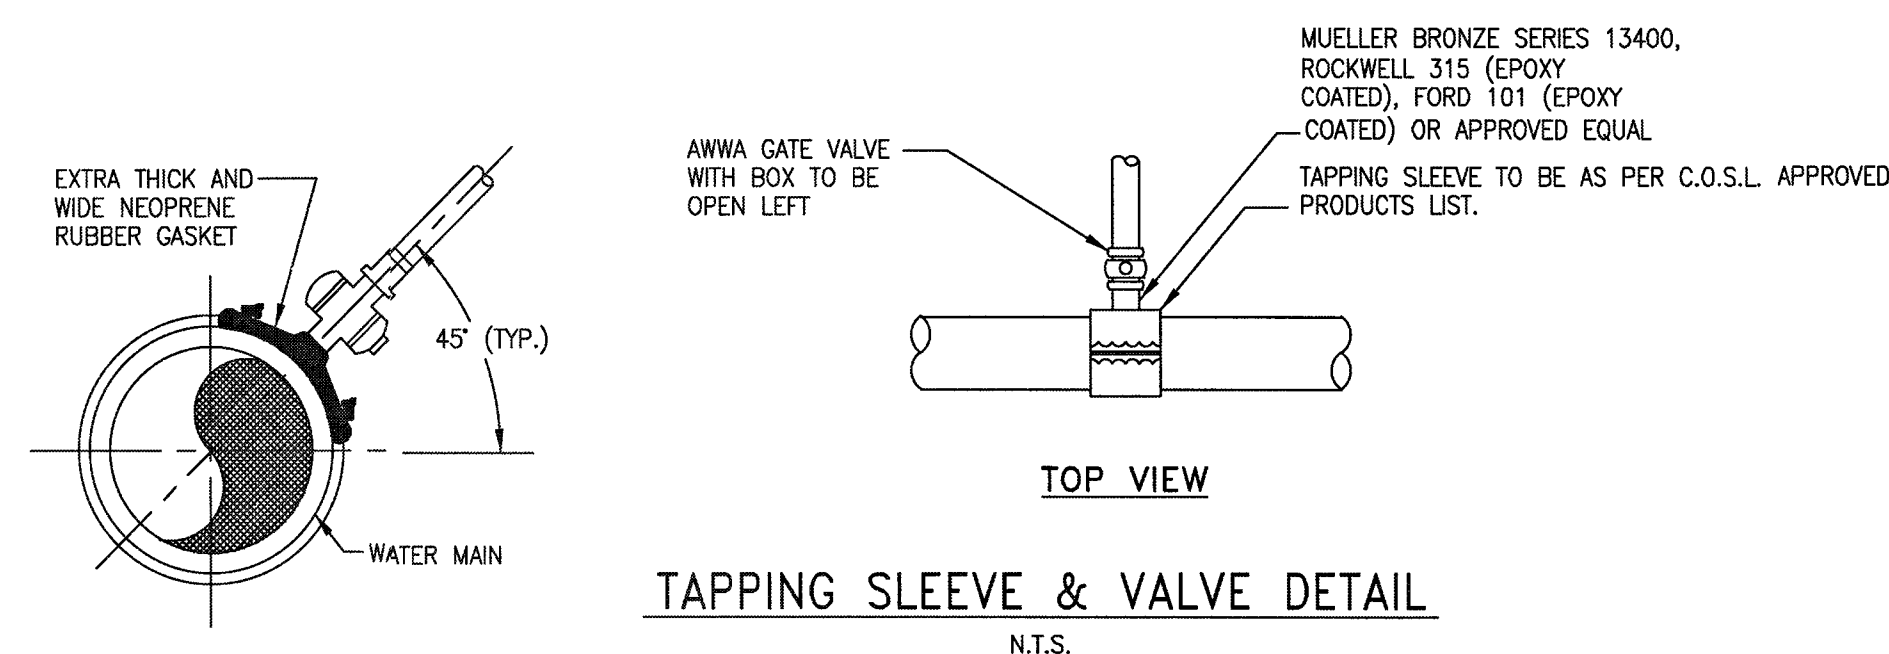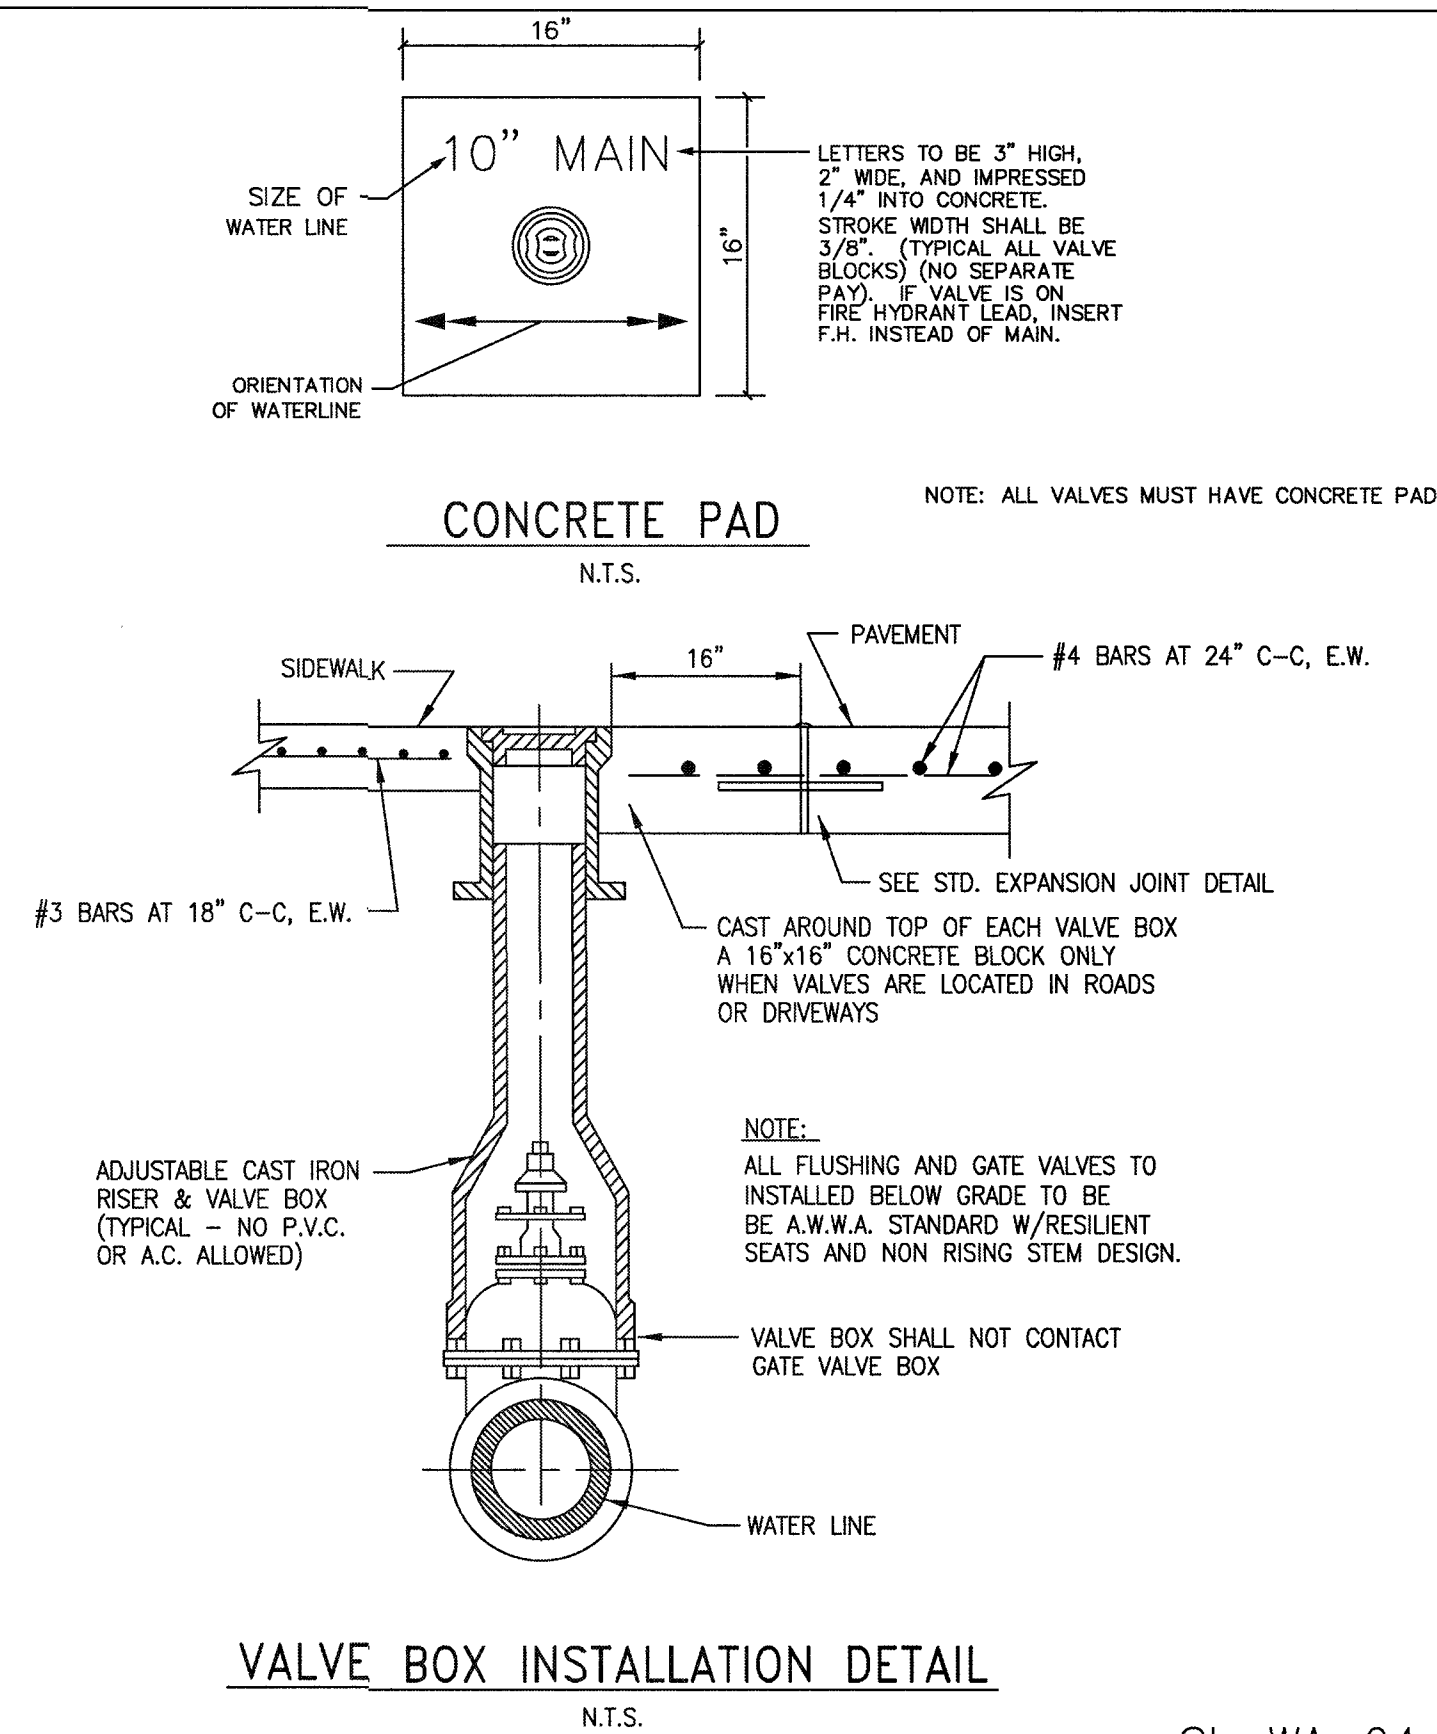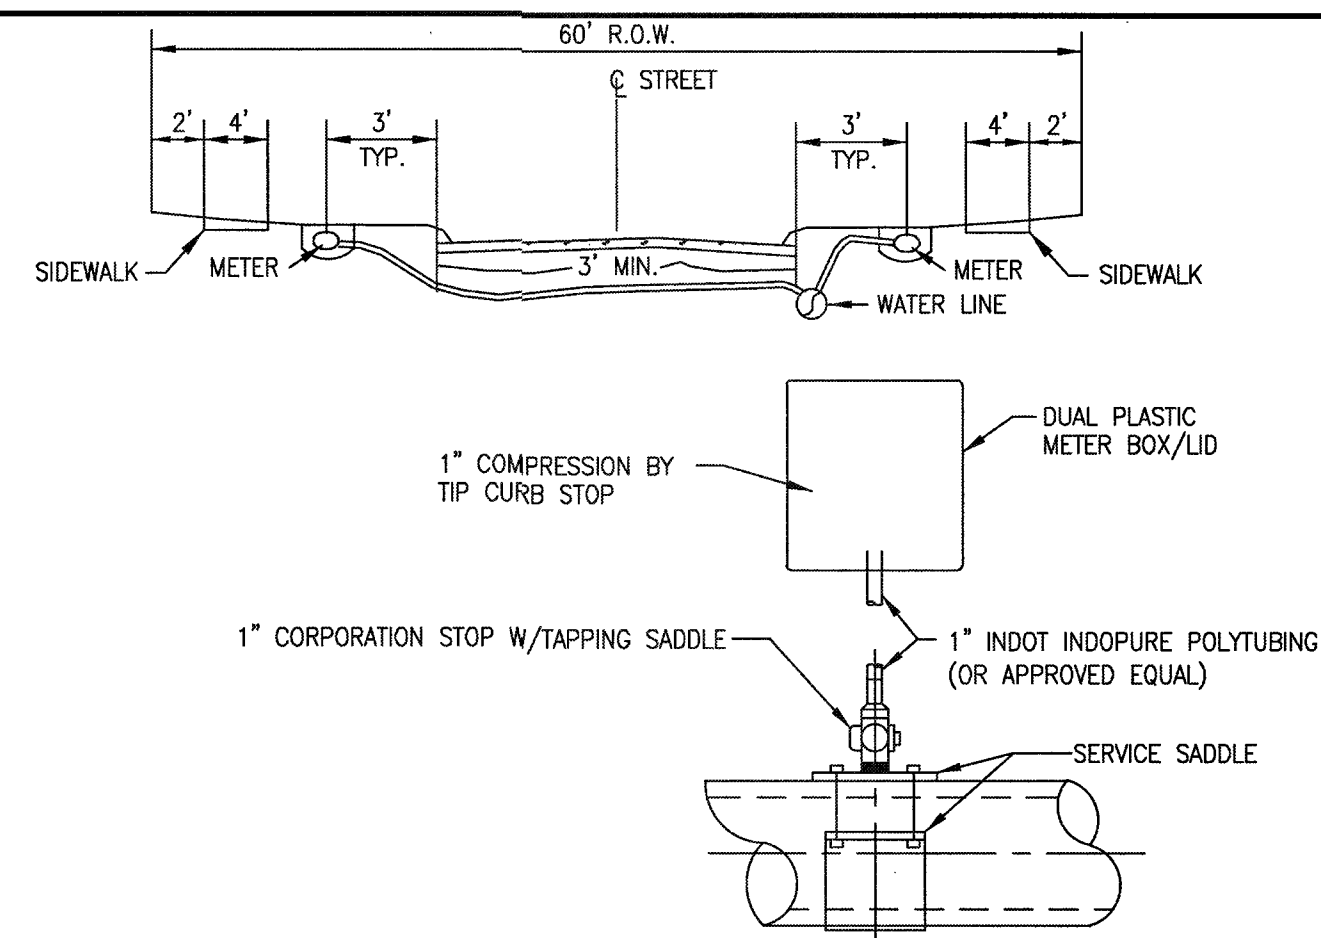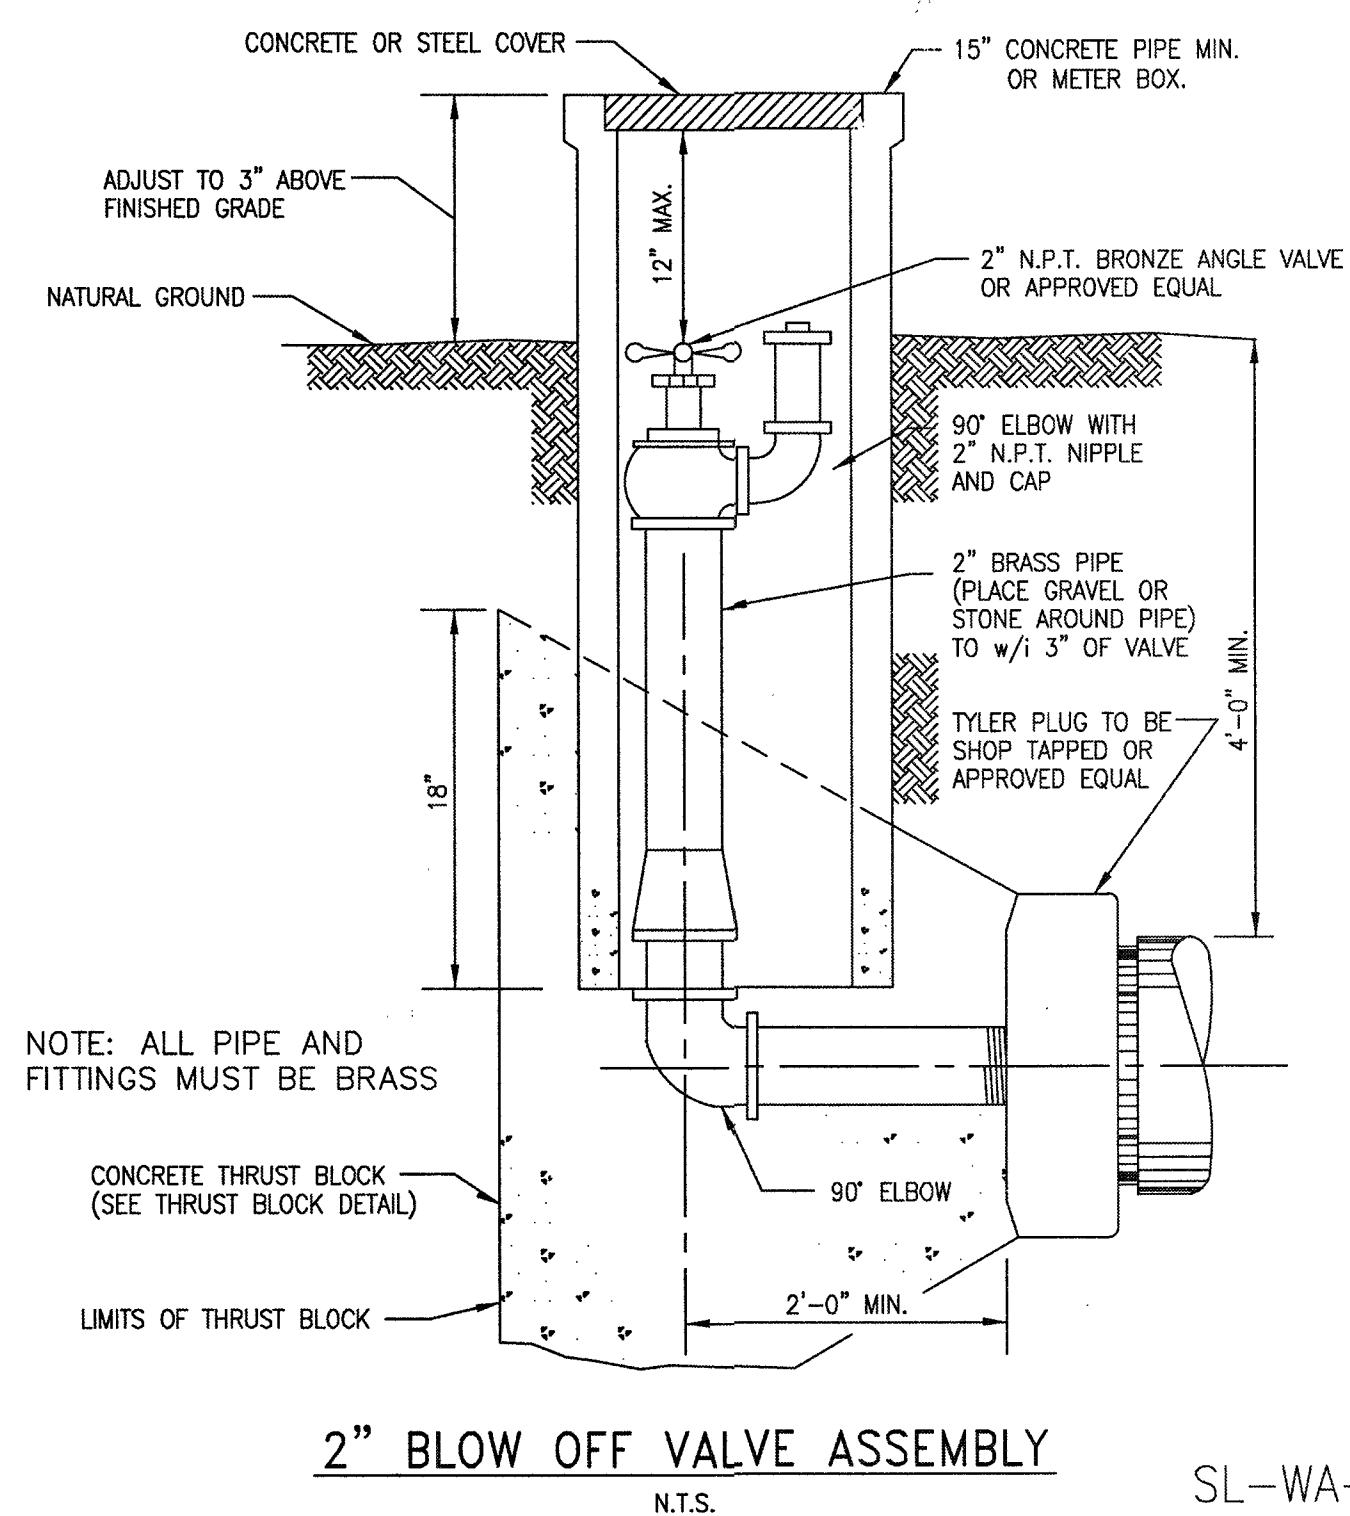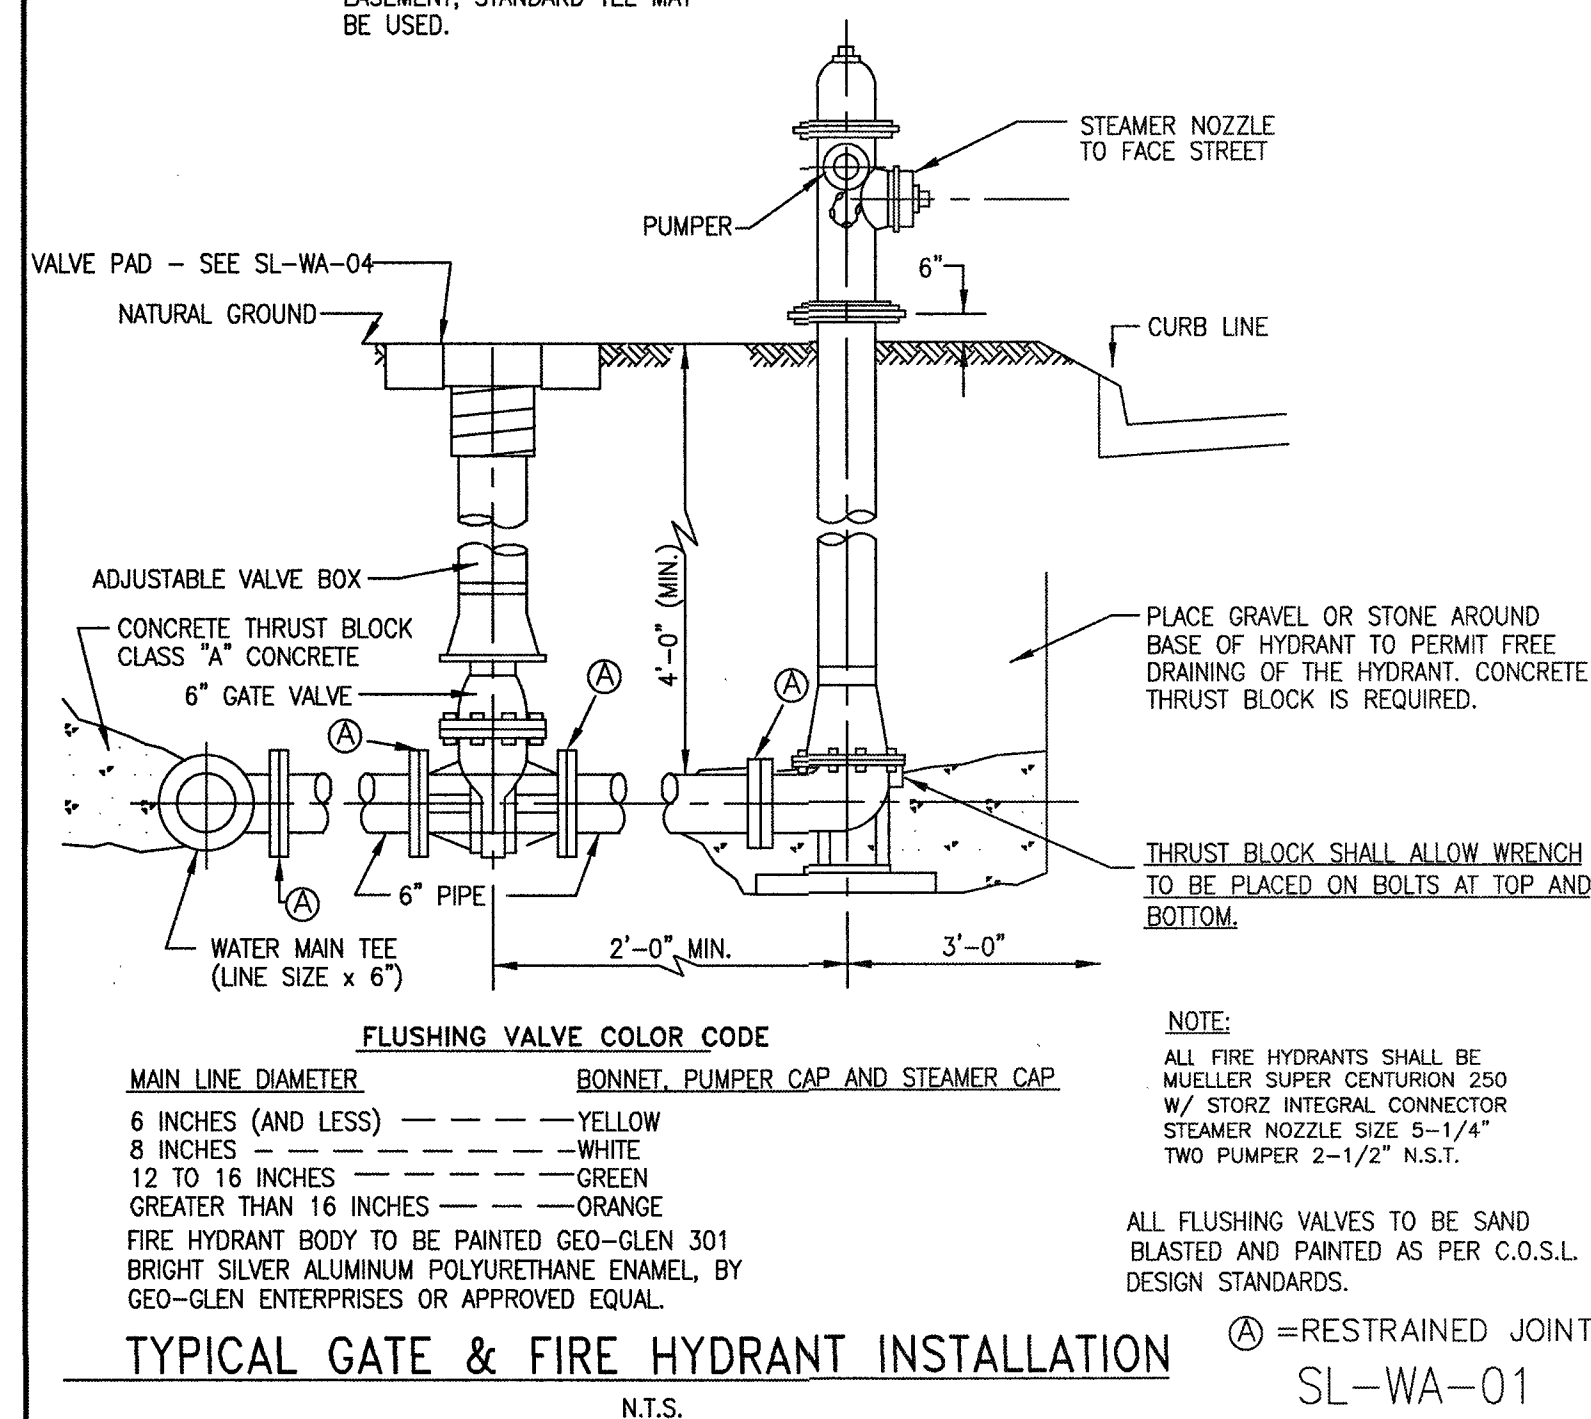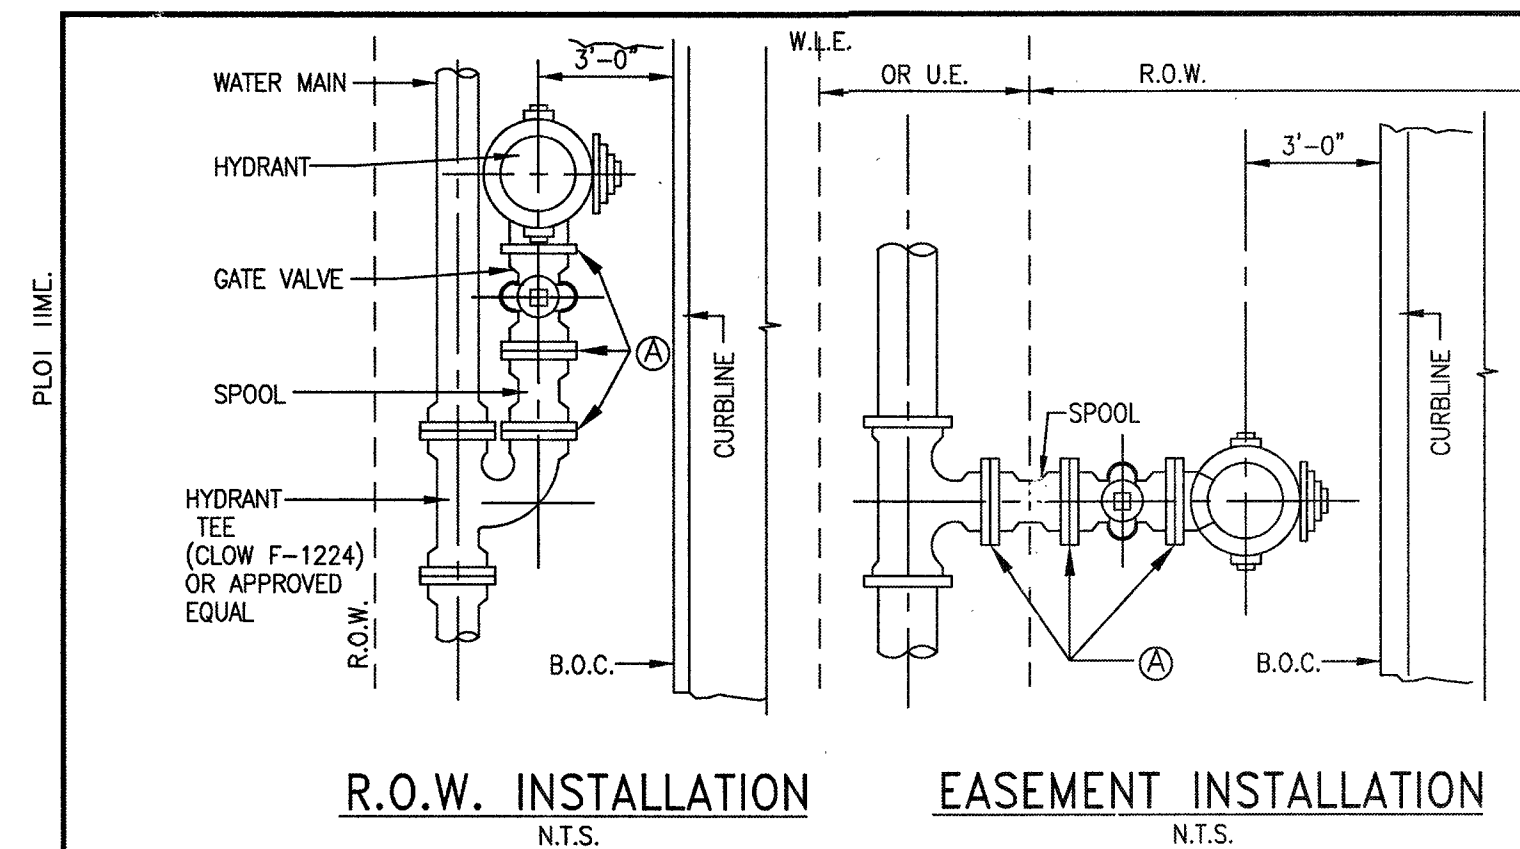

SIZE	90° BEND		45° BEND		22 1/2° BEND		TEES		PLUGS	
	A	B	A	B	A	B	A	B	A	B
2 1/2"	12"	7"	6"	7"	6"	6"	7"	8"	8"	14"
6"	16"	10"	9"	10"	6"	12"	10"	12"	10"	21"
8"	22"	13"	12"	13"	8"	10"	13"	16"	12"	29"
10"	26"	17"	14"	17"	10"	13"	16"	20"	14"	36"
12"	29"	21"	16"	21"	11"	16"	18"	24"	16"	41"
14"	35"	24"	19"	24"	12"	20"	22"	27"	18"	48"
16"	38"	27"	21"	27"	12"	24"	24"	30"	20"	54"
20"	50"	40"	30"	40"	18"	30"	30"	30"	30"	*78"
24"	50"	40"	30"	40"	18"	30"	30"	40"	30"	*78"
30"	60"	48"	36"	48"	20"	36"	36"	48"	36"	*96"

No.	DATE	REVISION

SEAL

DESIGN ENGINEER:

CITY OF SUGAR LAND, TEXAS
ENGINEERING DEPARTMENT

CONSTRUCTION PLANS FOR:



WATER LINE CONSTRUCTION DETAILS

JOB No.:
DATE:
DESIGNED BY:
DRAWN BY:
CHECKED BY:
SCALE:


SL-15

NO.	DATE	DESCRIPTION	APPROVED
REVISIONS			

DESIGNED _____ MS
DRAWN _____ BT
CHECKED _____
DATE _____

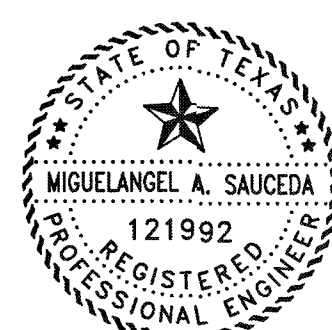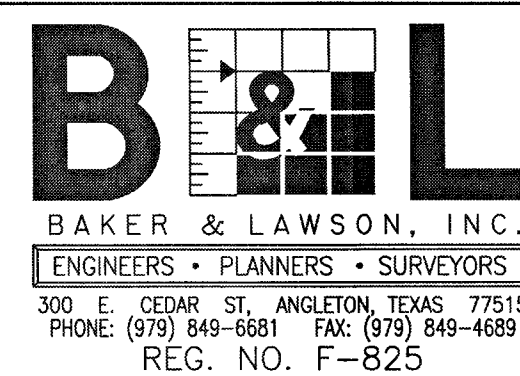

The seal appearing on
this document was
authorized by
Miguelangel A. Saucedo
P.E. 121992


Date: 1/11/27

OWNER:
Clint Peltier
Clint Peltier Custom Homes
979-481-4840

PLAN: _____
 PROFILE: _____
 HORIZONTAL: _____
 VERTICAL: _____

**BAYOU BEND ESTATES
ANGLETON, TEXAS
PLANS FOR
GRADING, PAVING, UTILITIES
AND DETENTION**


WATER LINE
CONSTRUCTION DETAILS
SI-15

PROJECT NO. 13454



SANITARY FORCE MAIN & WATER LINE BEDDING AND BACKFILL

SL-BB-01

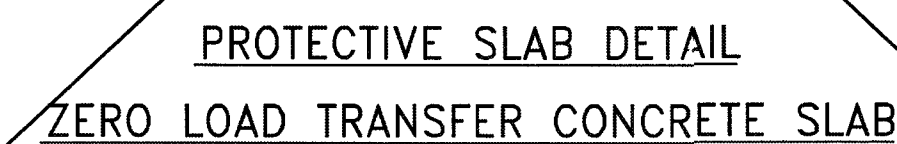

SL-BB-04

1. CONTRACTOR SHALL CONTACT SUGAR LAND ENGINEERING DEPARTMENT IMMEDIATELY IF WET SAND CONDITIONS ARE ENCOUNTERED.
2. LIMESTONE AND RECYCLED CONCRETE DIMENSIONS SHOWN ARE TYPICAL BUT MAY BE VARIED BY ORDER OF CITY ENGINEER.
3. LIMESTONE OR RECYCLED CONCRETE SHALL BE IN ACCORDANCE WITH TxDOT SPECIFICATION No. 248 FLEXIBLE BASE, TYPE A, GRADE 2 AGGREGATE.
4. NO BEDDING SHALL BE INSTALLED IN WET CONDITIONS. WHEN WELL POINTING OR IN WET SAND CONDITIONS, MAINTAIN GROUND WATER 1 (FT) BELOW BOTTOM OF TRENCH FOR A MINIMUM OF 24-HRS AFTER BEDDING AND BACKFILL IS IN PLACE.
5. ALL MATERIALS SHALL BE FROM THE APPROVED PRODUCTS LIST UNLESS SPECIFICALLY APPROVED BY THE CITY ENGINEER.
6. SANITARY SEWER BEDDING FOR WET SAND CONDITIONS SHALL BE AS PER MODIFIED "A".
7. ALL SAND BEDDING FOR WATER LINES SHALL BE CLEAN, MECHANICALLY COMPACTED BANK SAND.
8. REFER TO: MANHOLE DETAILS, SANITARY, C.S.S., GENERAL, WATER CROSSING, WATER DISTRIBUTION DETAILS AND NOTES.
9. ALL BEDDING WILL BE COMPACTED TO 95% STANDARD PROCTOR DENSITY.
10. A GEOTECHNICAL REPORT MAY BE REQUIRED TO ANALYZE THE BEARING CAPACITY OF EXISTING SOILS AND MAKE A DETERMINATION IF ADDITIONAL BEDDING AND BACKFILL IS APPROPRIATE.

SL-BB-05



NOTE: C.S.S. SHALL BE INSTALLED A MIN. 1' ABOVE
TOP OF PIPE.



SANITARY SEWER
BEDDING AND BACKFILL
RECORD DRAWING

SL-BB-03


1. GENERAL NOTES
2. C.S.S. NOTES

NO.	DATE	DESCRIPTION	APPROVE
REVISIONS			

DESIGNED MS
DRAWN BT
CHECKED _____
DATE _____

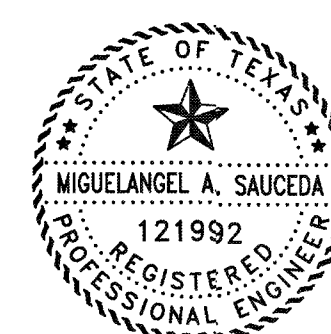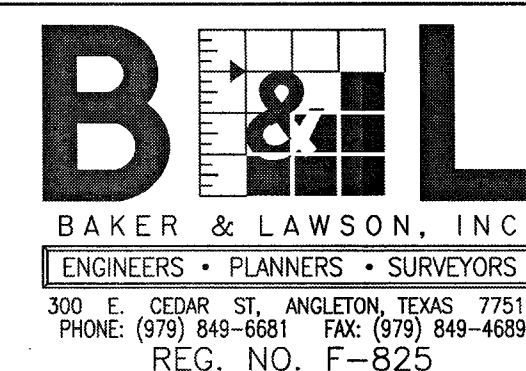

The seal appearing on
this document was
authorized by
Miguelangel A. Saucedo
P.E. 121992



Date: 11/11/22












OWNER:
Clint Peltier
Clint Peltier Custom Homes
979-481-4840

PLAN: _____
 PROFILE: _____
 HORIZONTAL: _____
 VERTICAL: _____

**BAYOU BEND ESTATES
ANGLETON, TEXAS
PLANS FOR
GRADING, PAVING, UTILITIES
AND DETENTION**

WATER LINE, SANITARY
SEWER FORCE MAIN
BEDDING DETAILS
SL-19

PROJECT NO. 13454

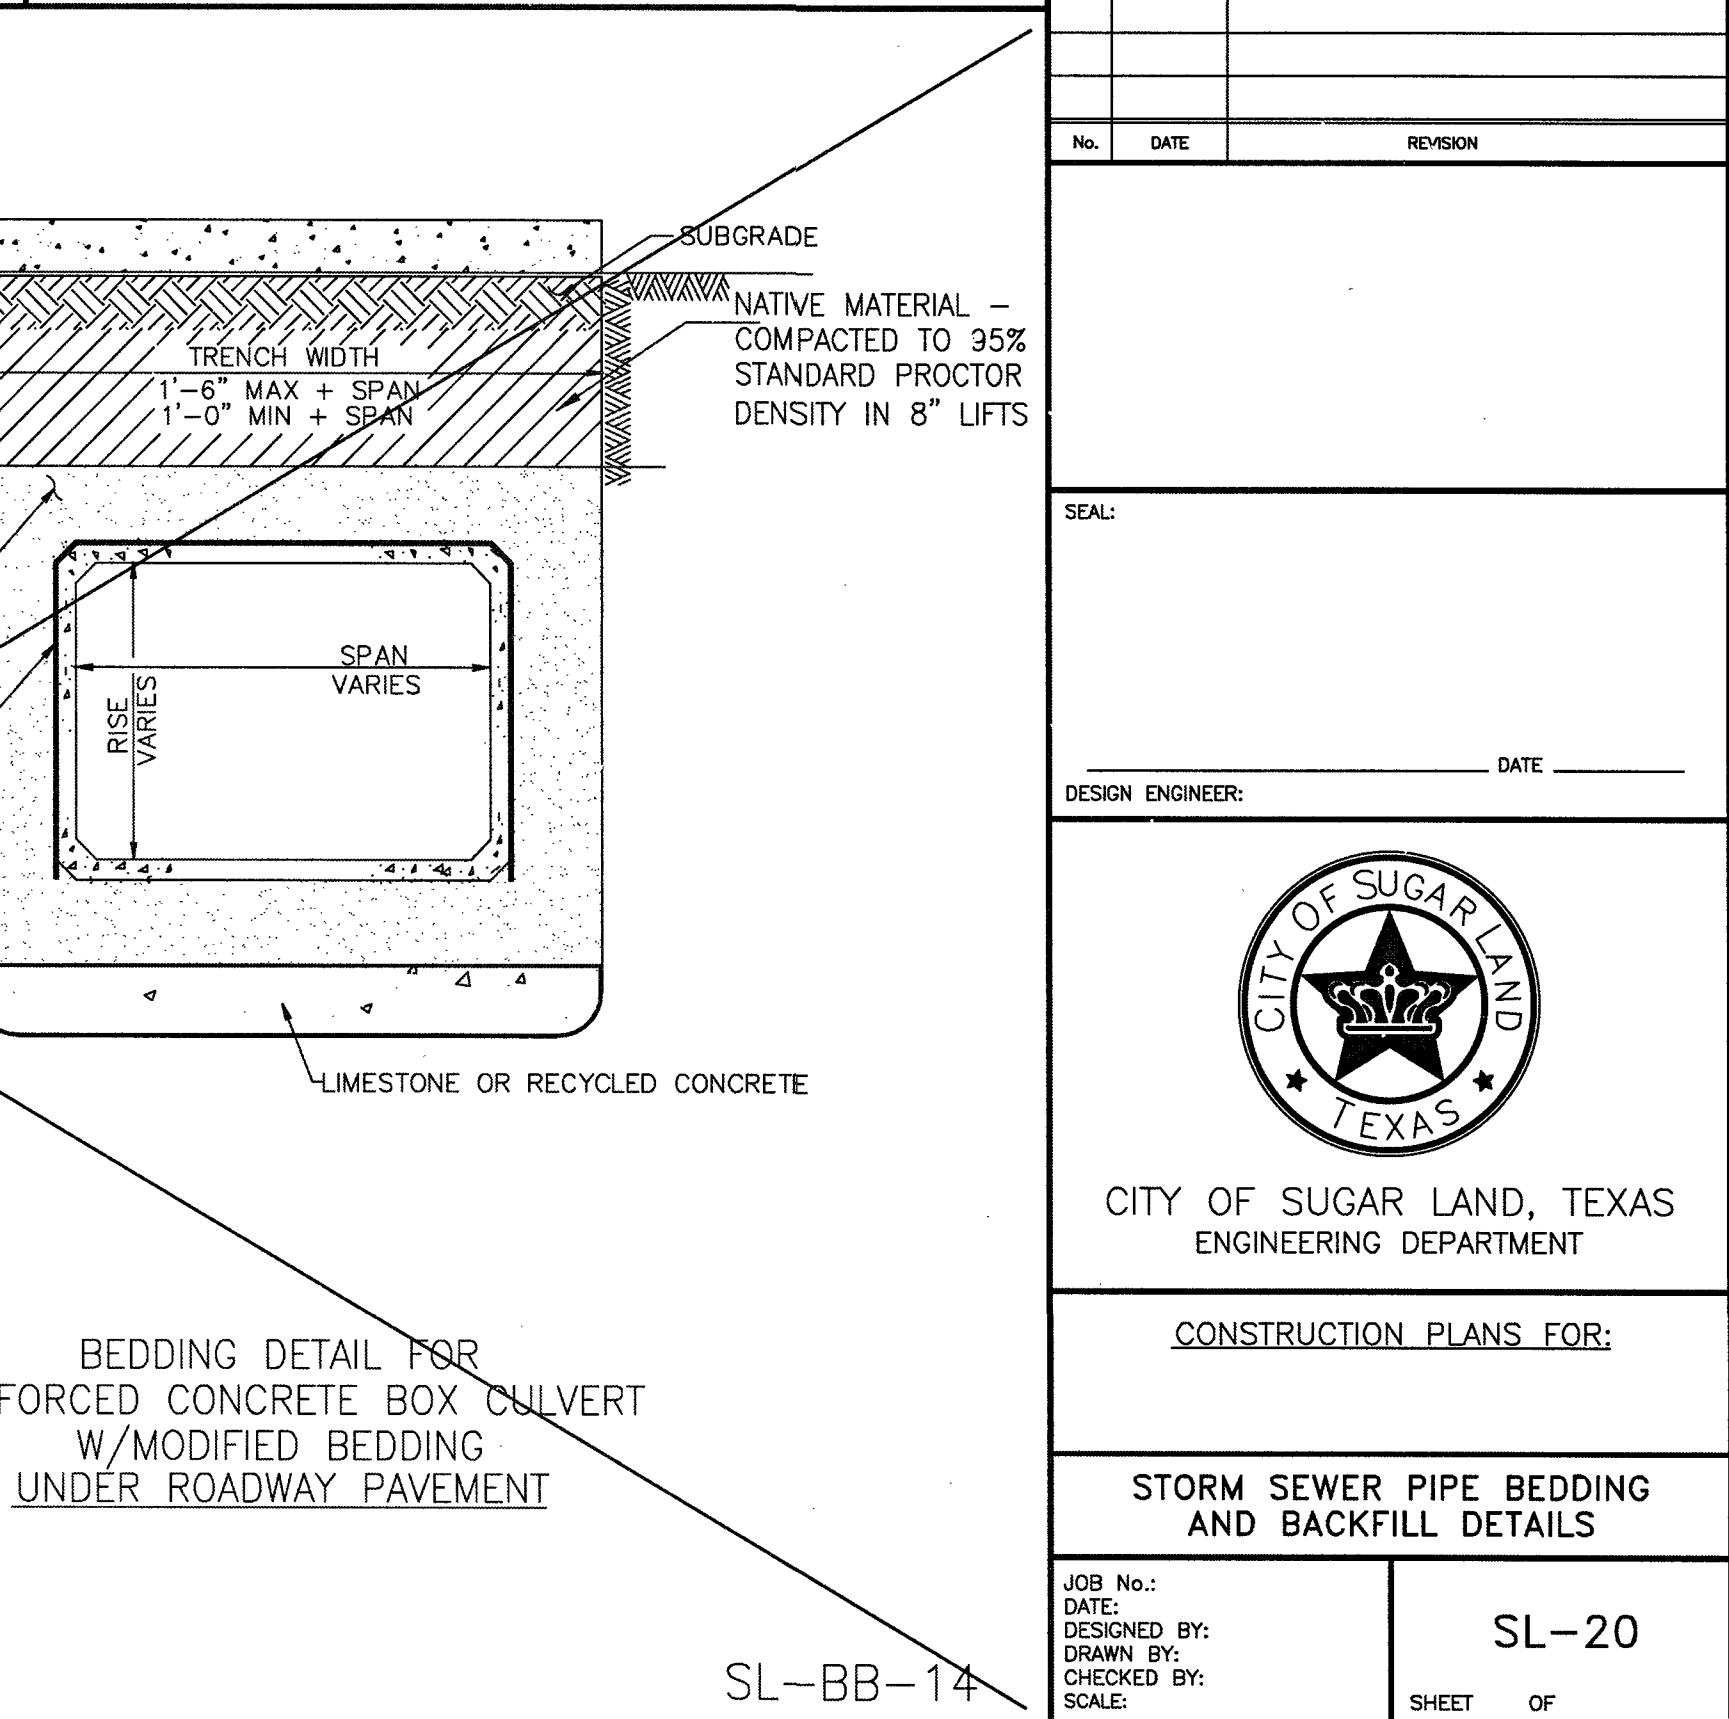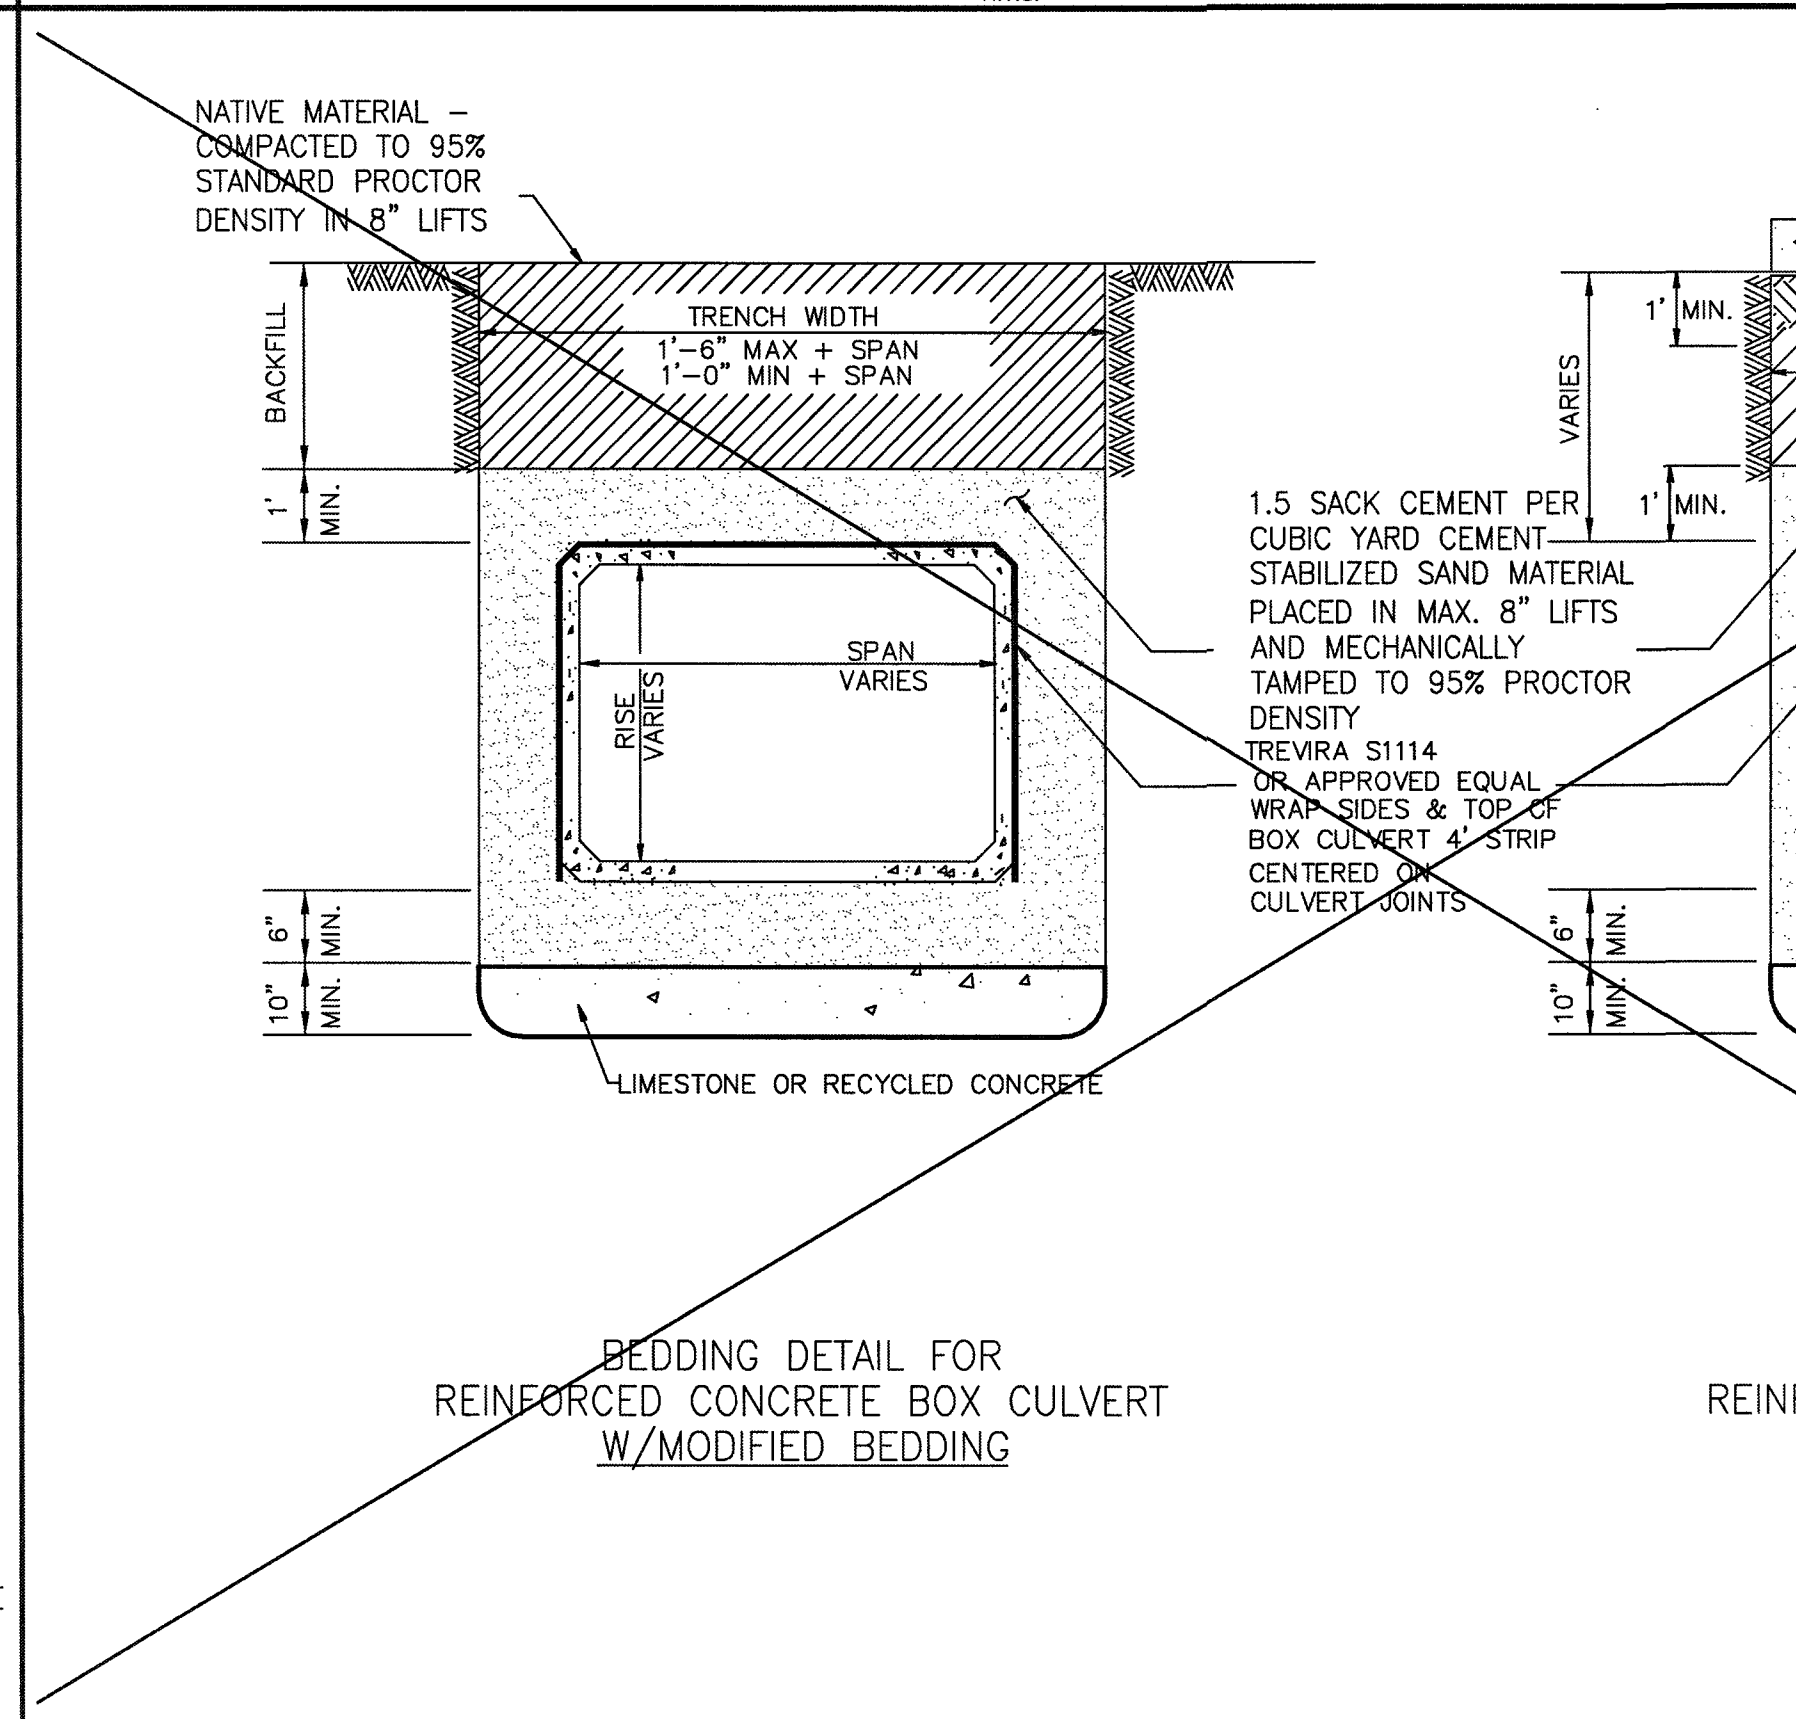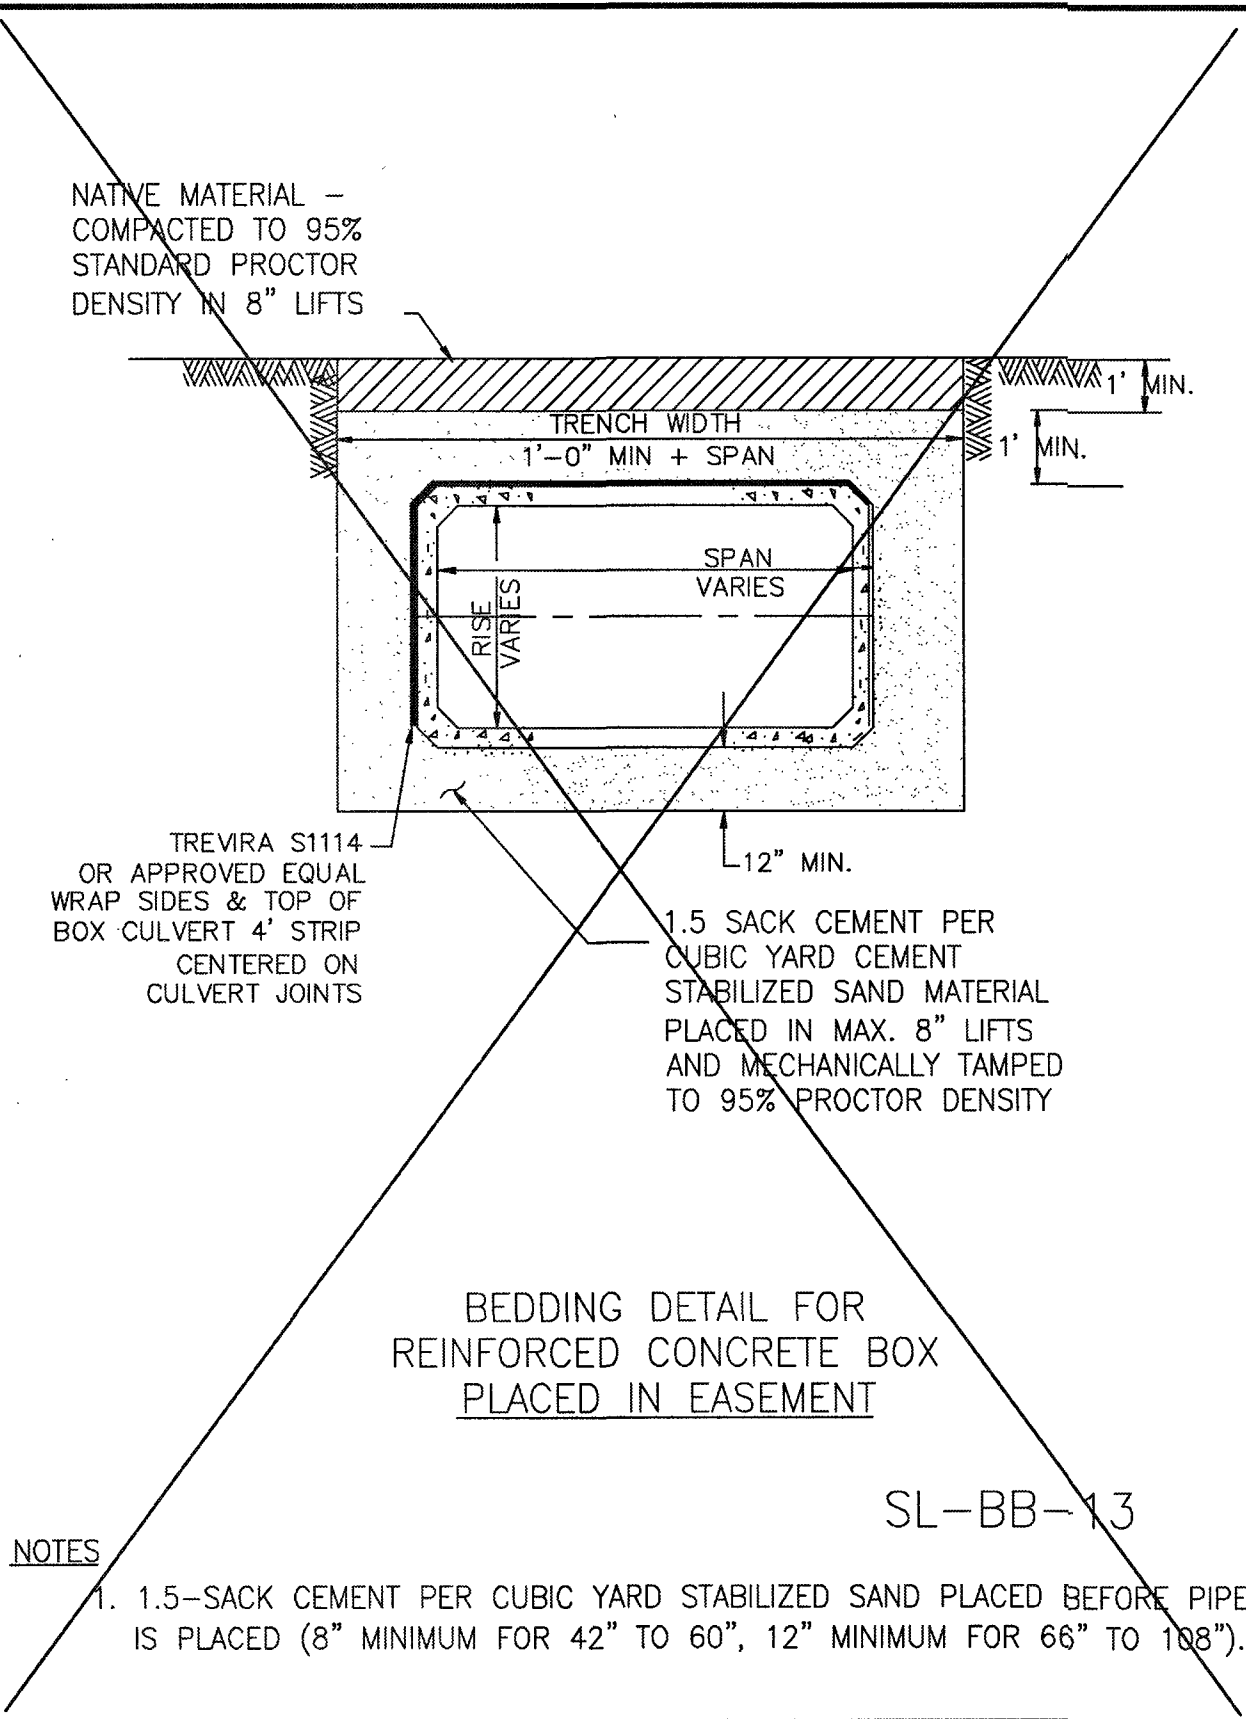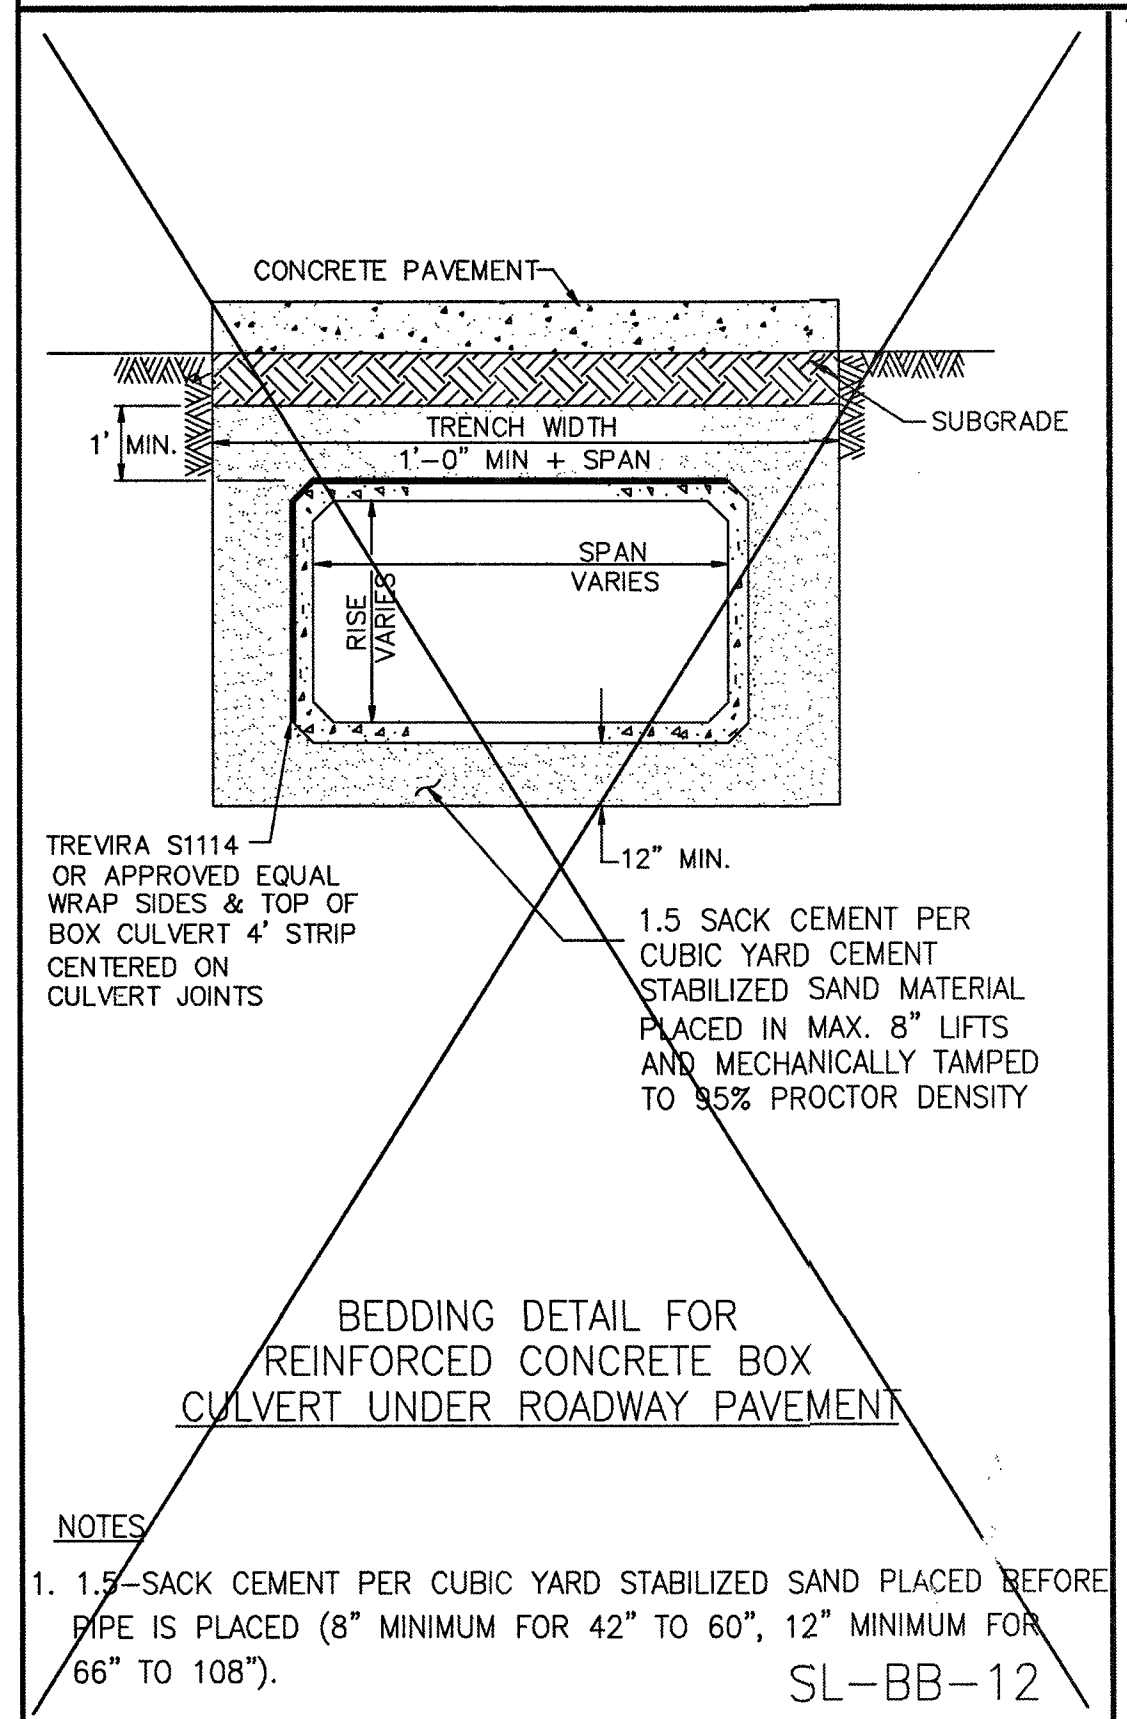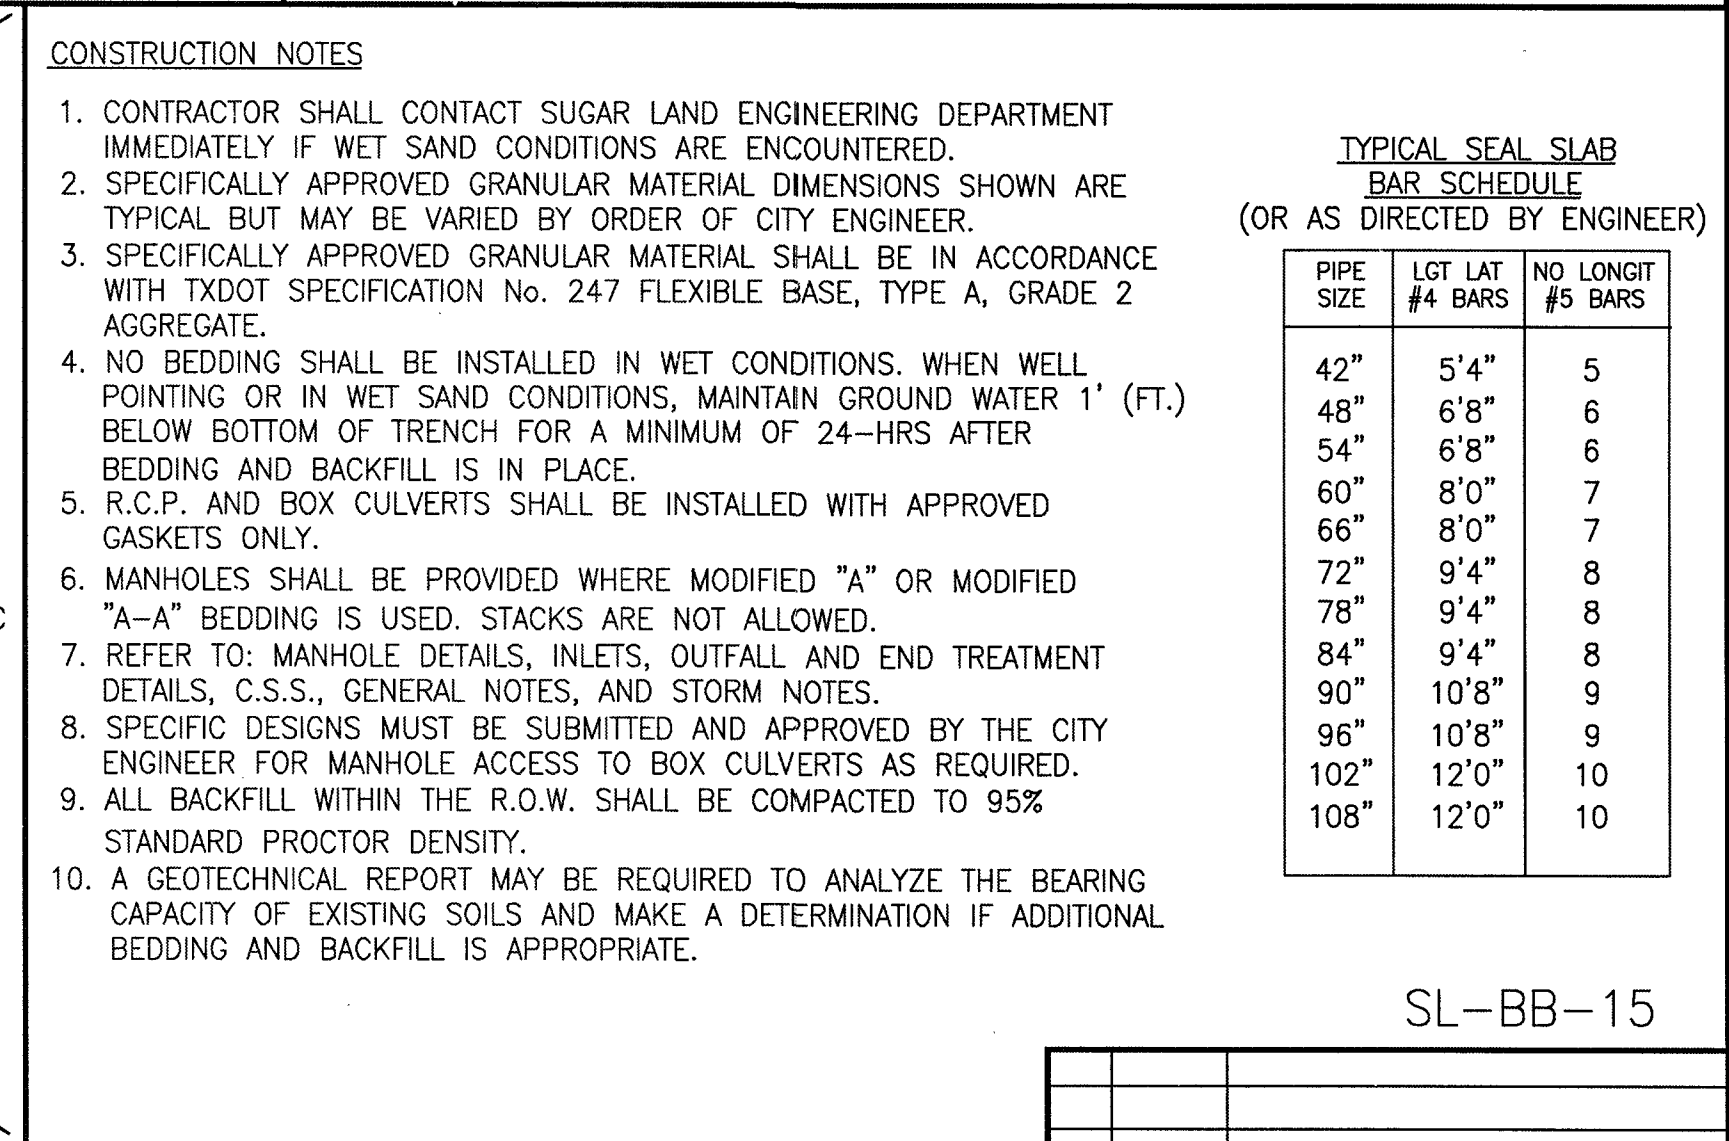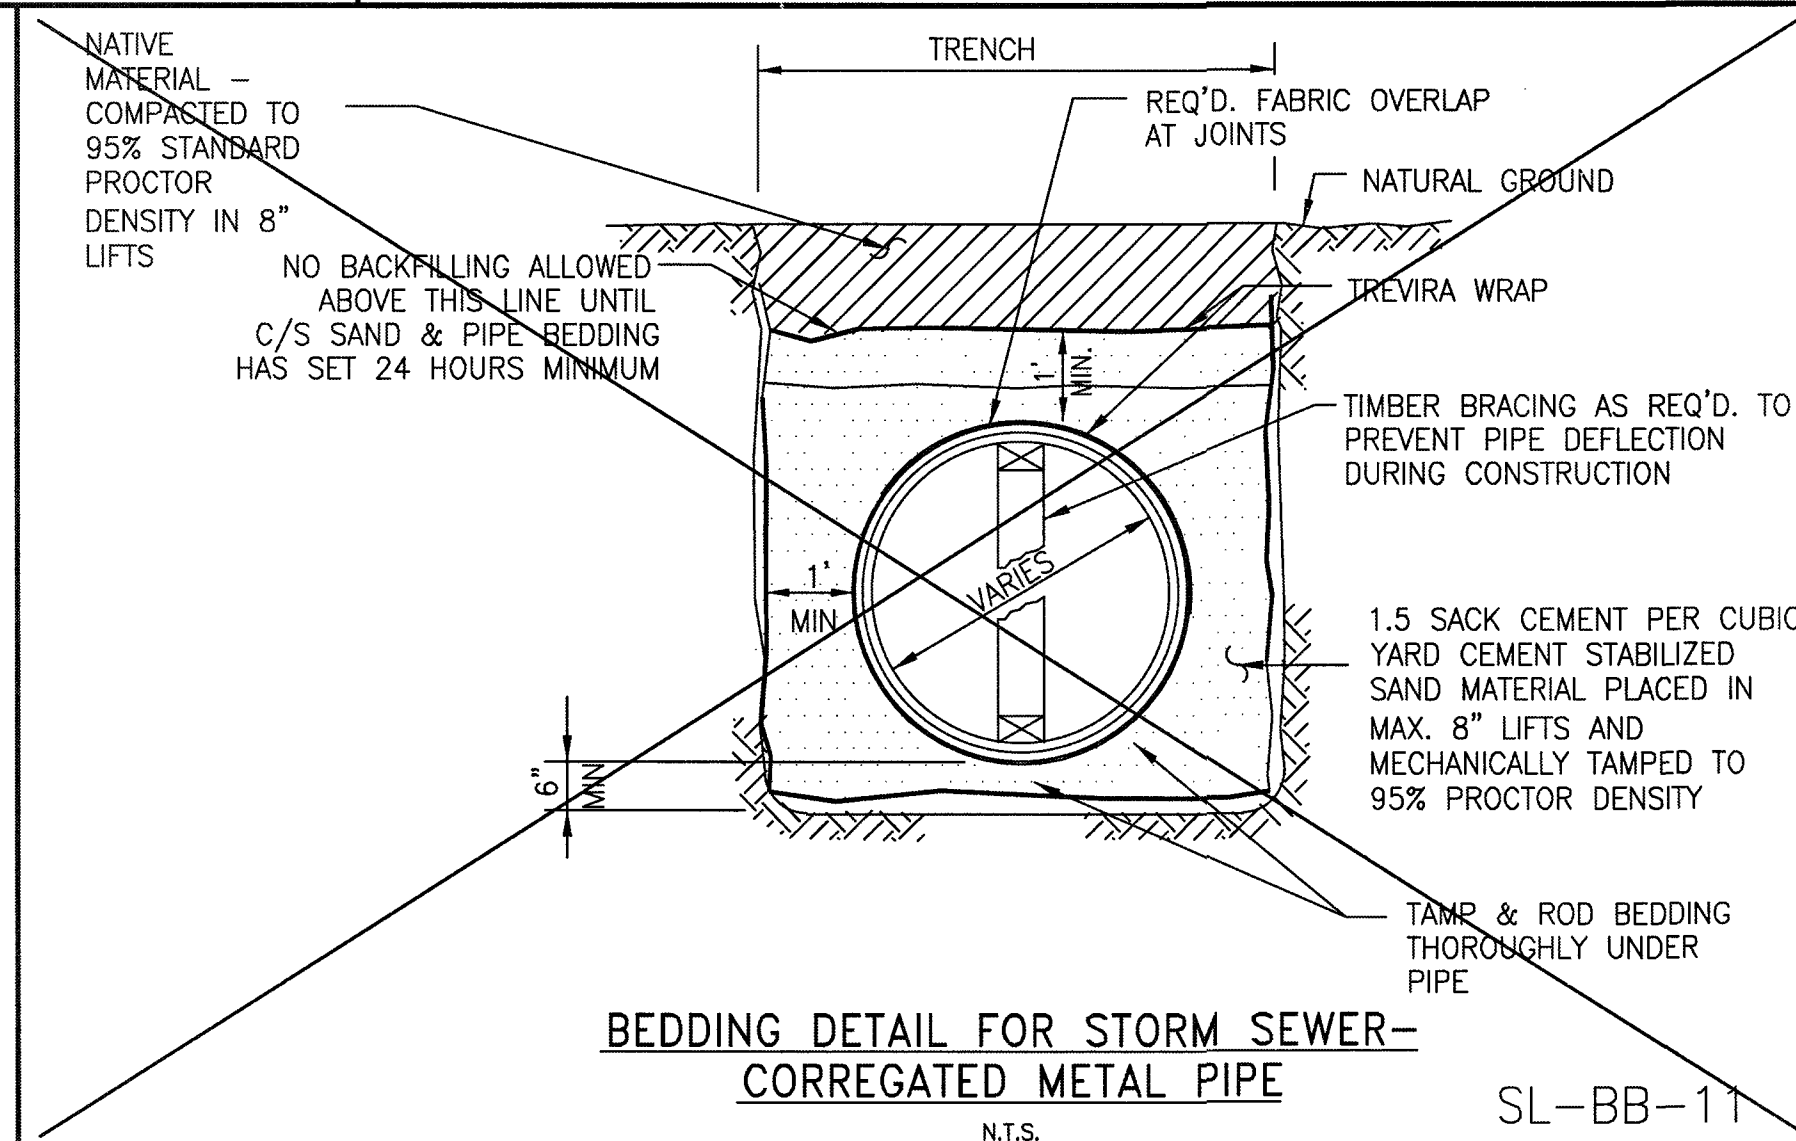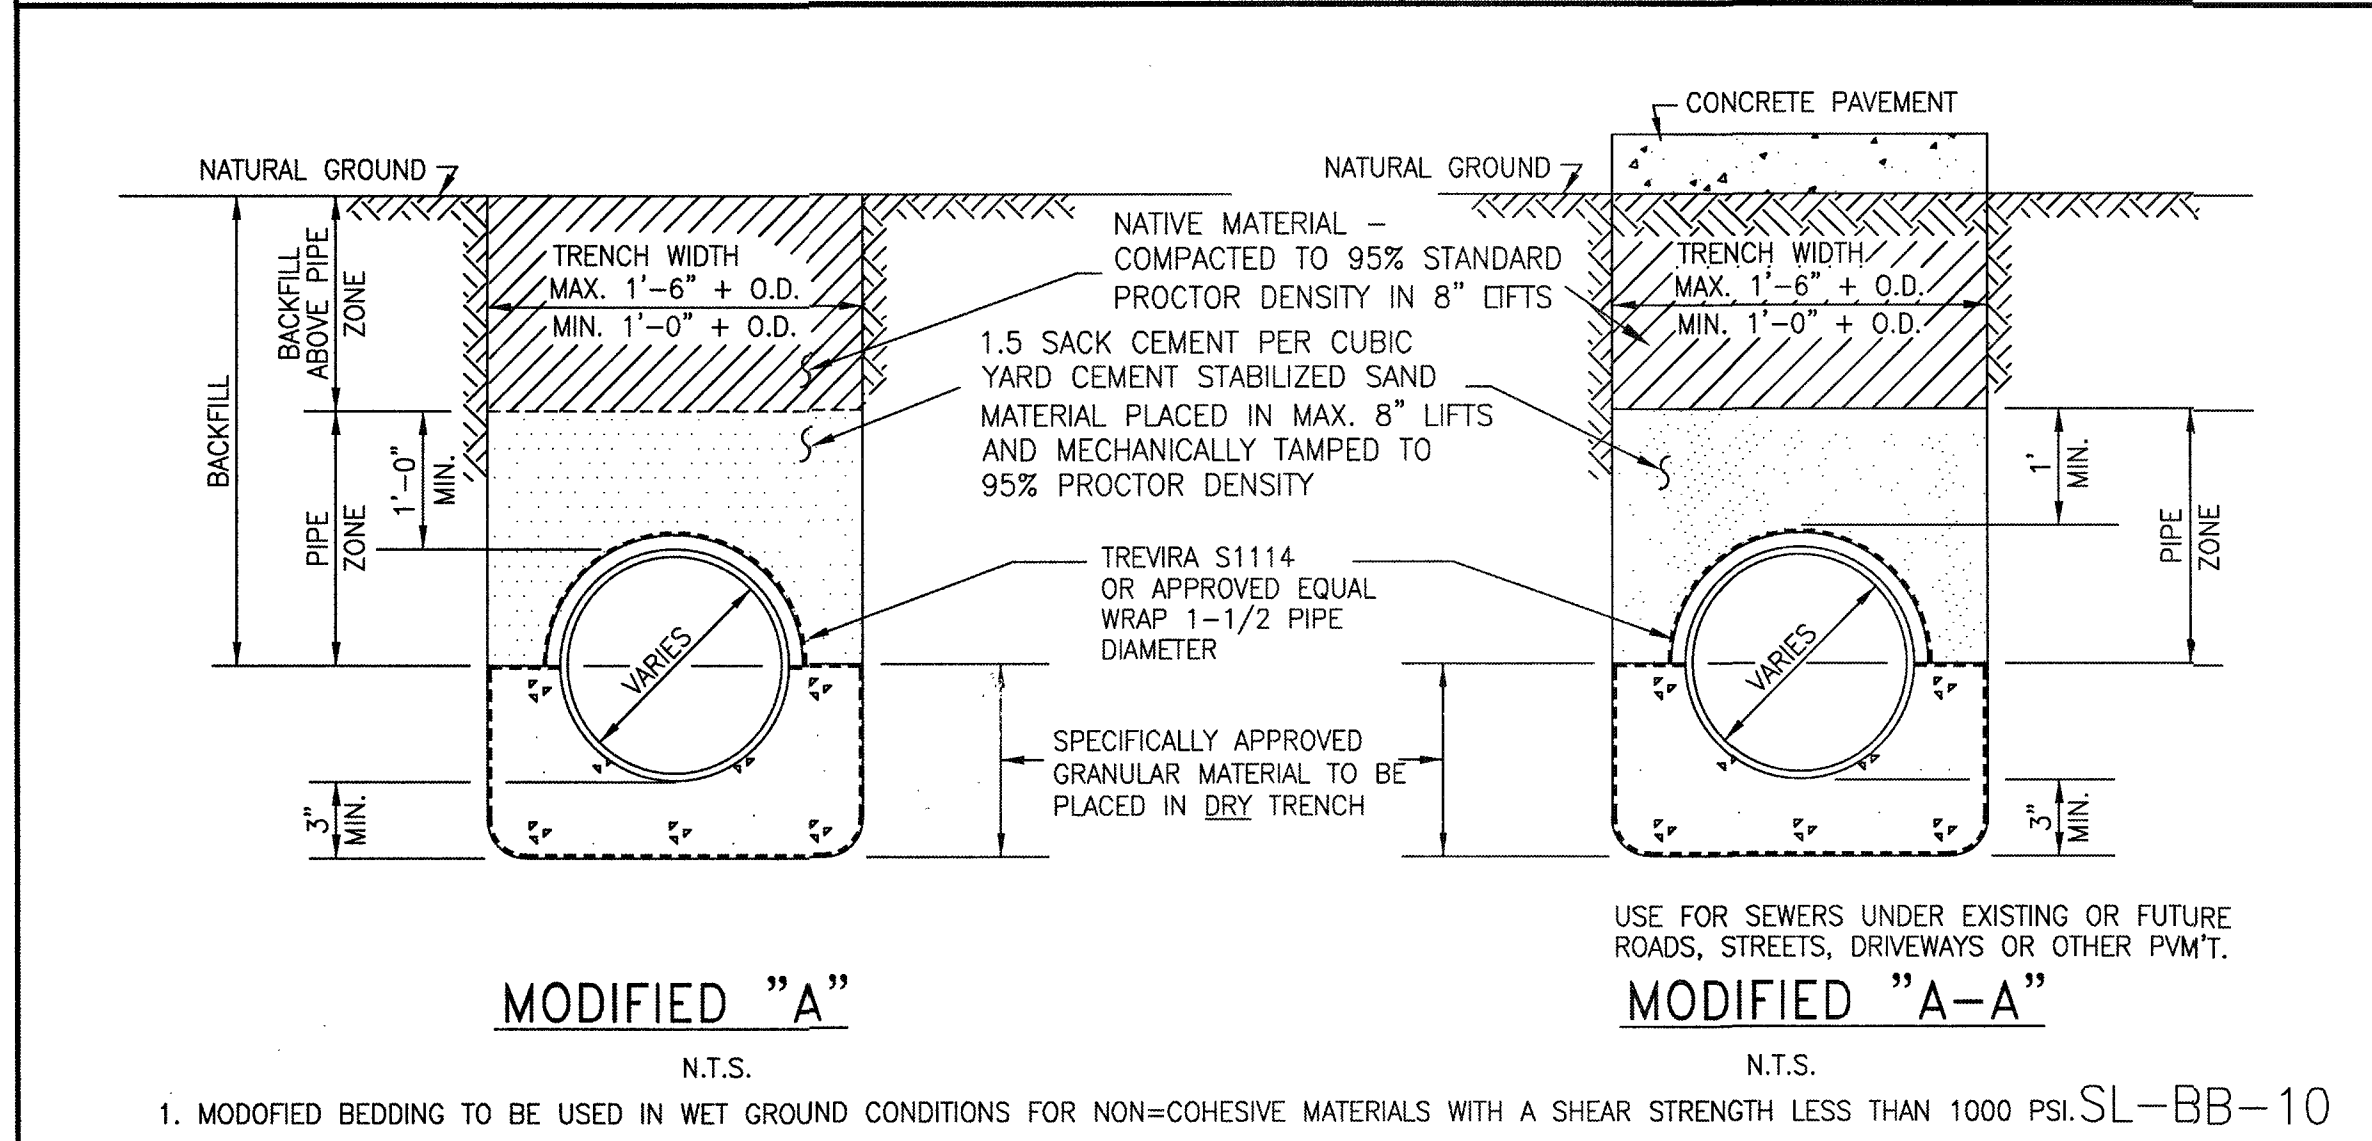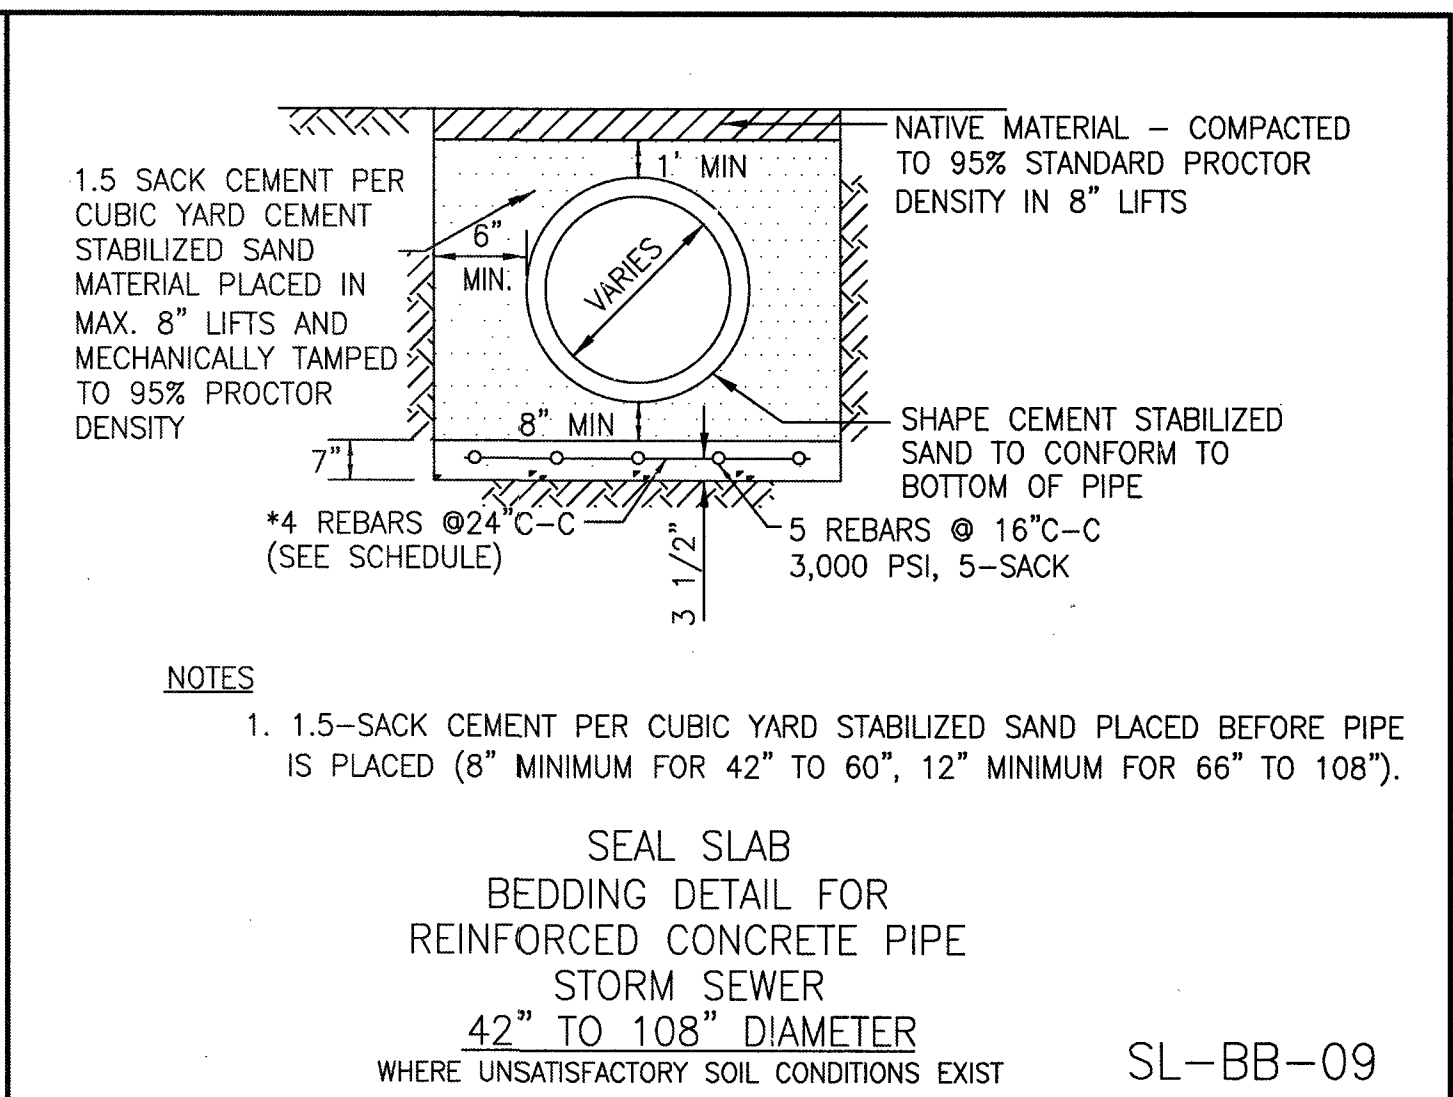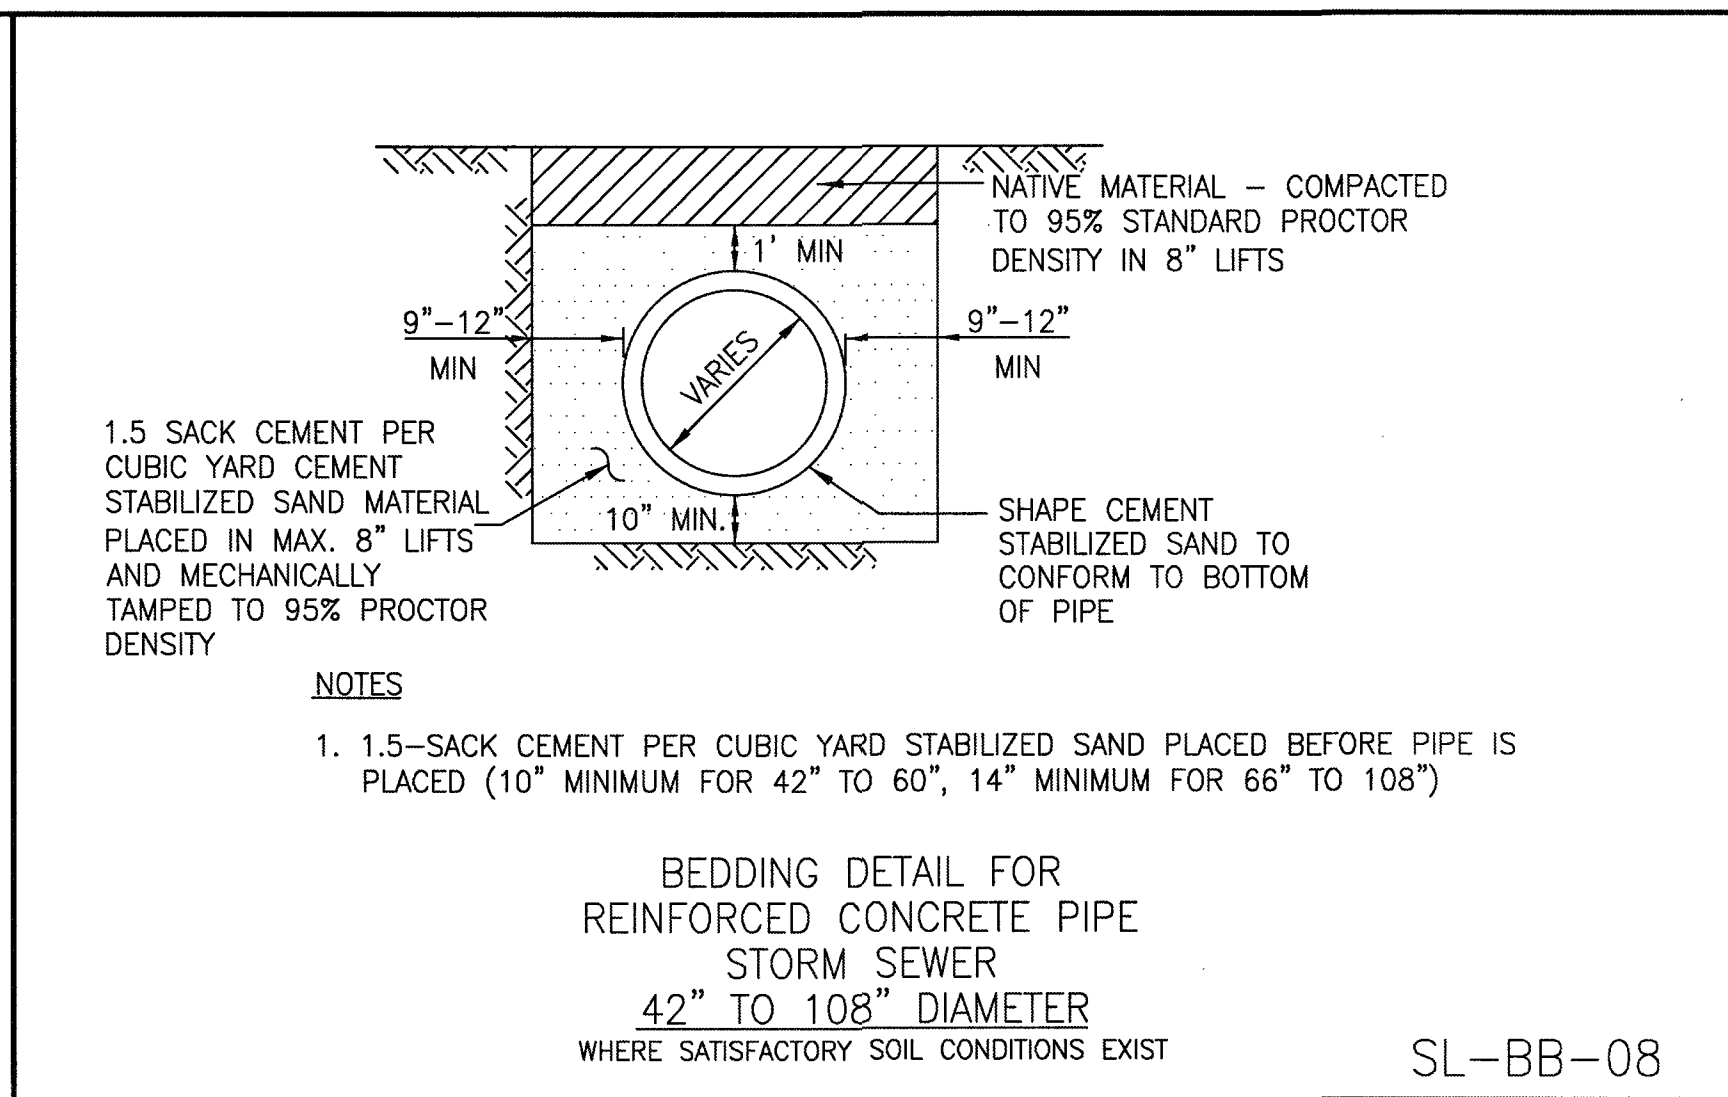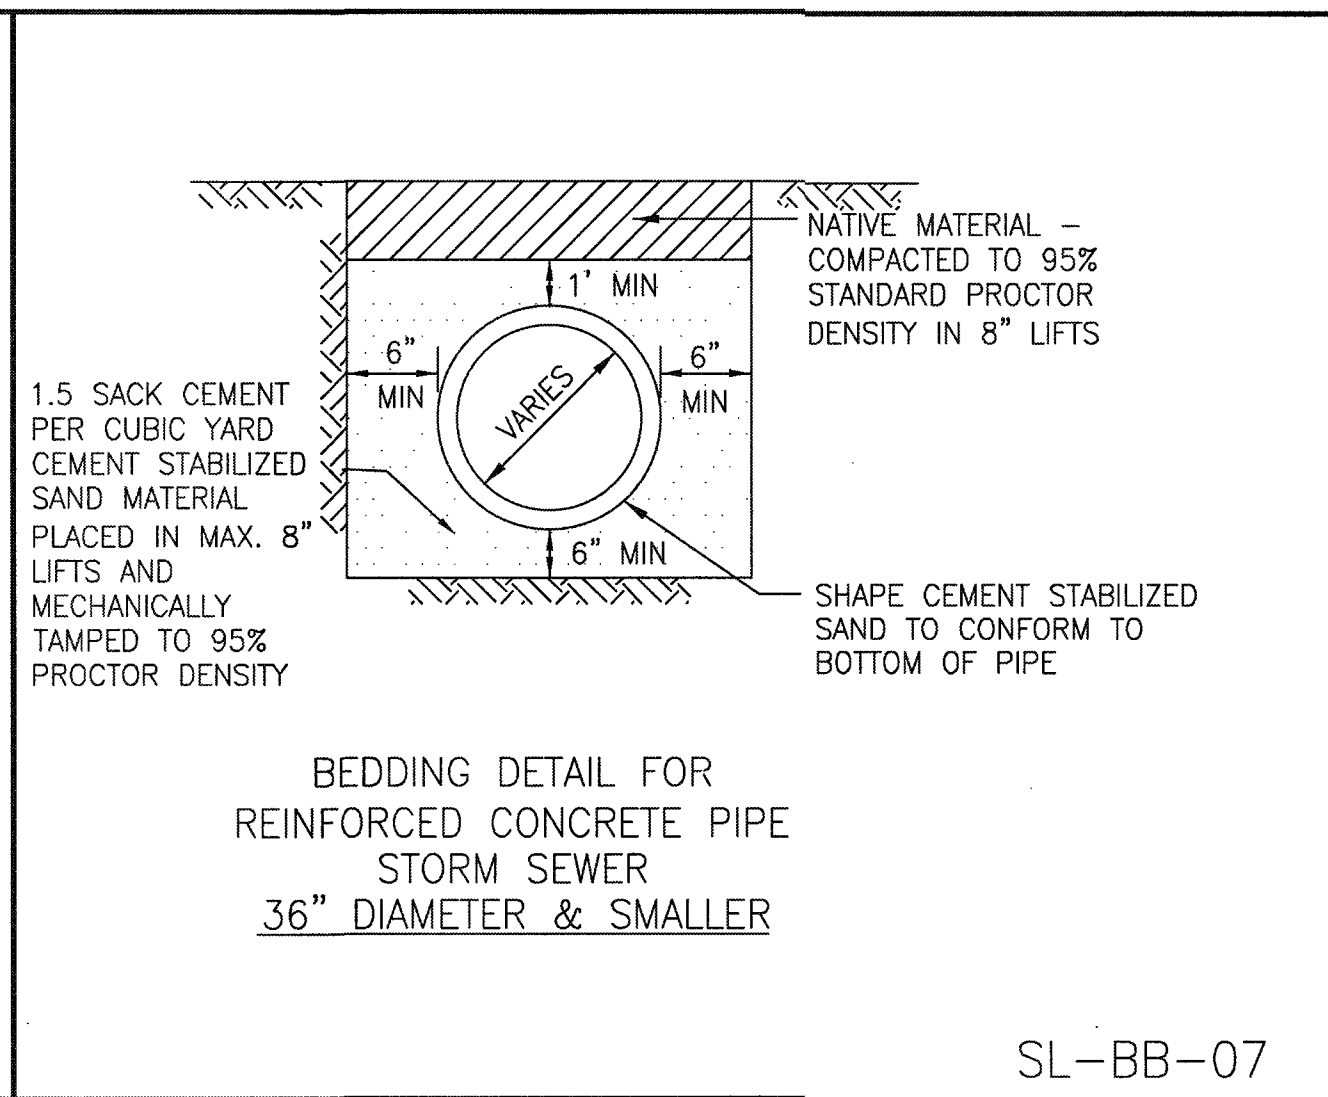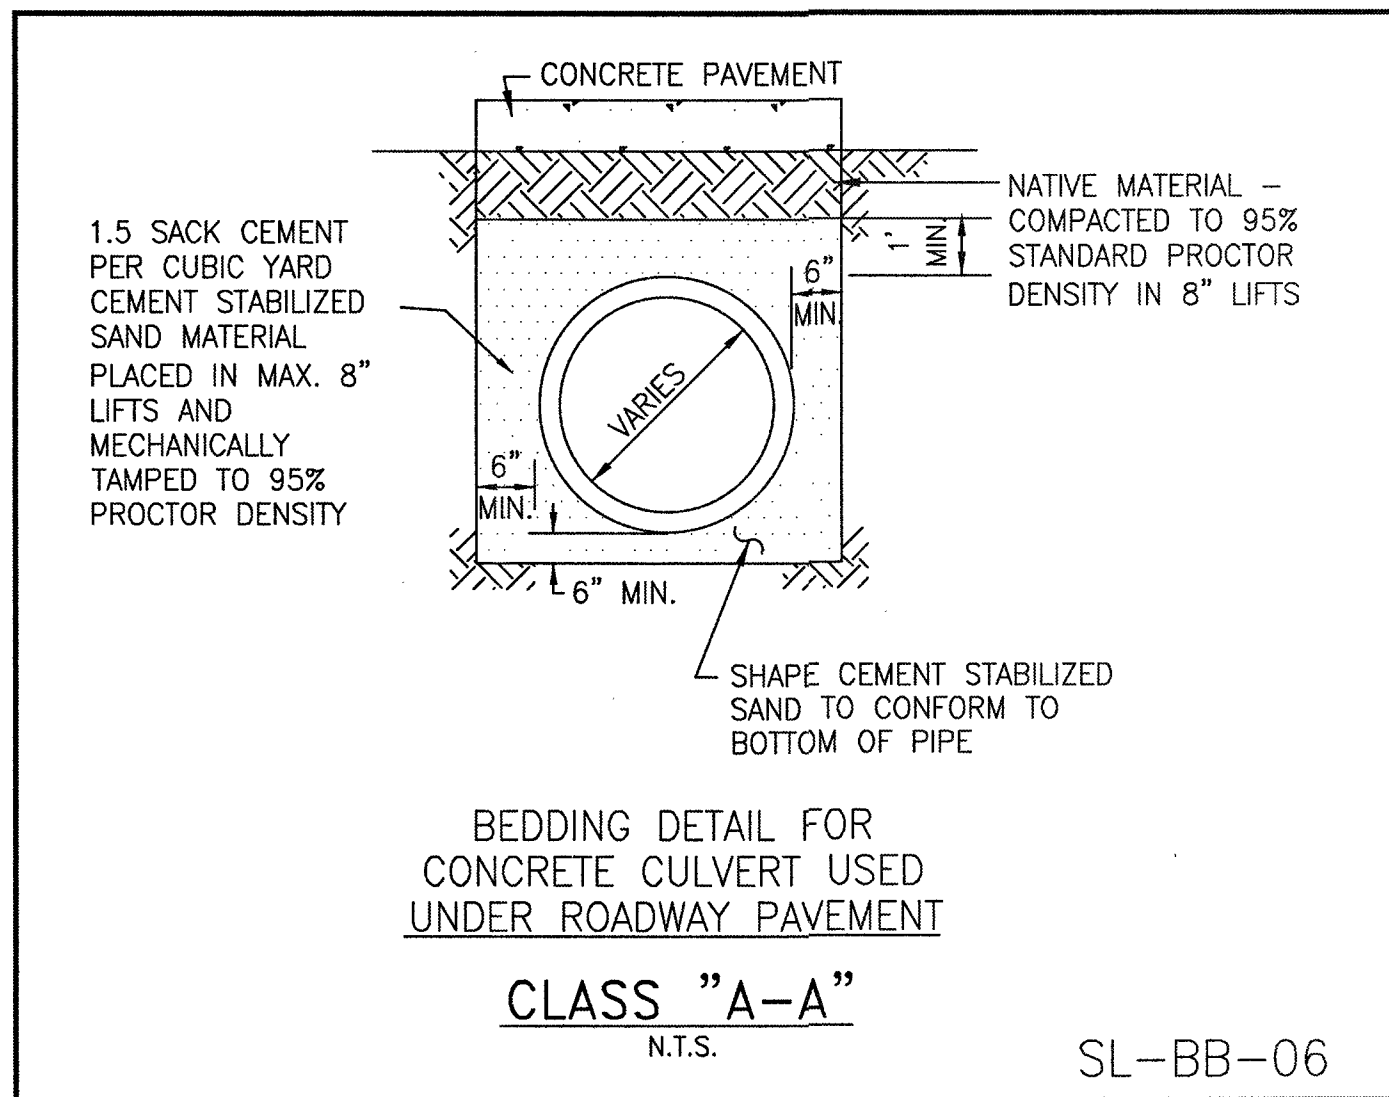

NO.	DATE	DESCRIPTION	APPROVED

DESIGNED	MS
DRAWN	BT
CHECKED	
DATE	

OWNER:

Clint Peltier

Clint Peltier Custom Homes

979-481-4840

PLAN:

PROFILE:

HORIZONTAL:

VERTICAL:

BAYOU BEND ESTATES

ANGLETON, TEXAS

PLANS FOR

GRADING, PAVING, UTILITIES

AND DETENTION

STORM SEWER PIPE BEDDING AND BACKFILL DETAILS

SL-20

PROJECT NO. 13454





SL-ST-13



SL-ST-15



N.T.S.

SL-ST-16



NOTES:

- 1.) 1.0 LBS. OF APPROVED NON-METALLIC FIBER MESH PER C/Y IN 4"x12" CURBS.
- 2.) #3 RE-BAR STIRRUPS TO BE PLACED AT INTERVALS OF 2' (FT) C-C.
- 3.) #4 RE-BAR LONGITUDINAL SHALL BE TIED TO EACH STIRRUP
- 4.) MOUNTABLE CURB ONLY ALLOWED ON $\leq 41'$ (FT), UNDIVIDED,
RESIDENTIAL ROADWAYS WITHIN SUBDIVISIONS.

SL-ST-17




SL-ST-18

4"x12" MOUNTABLE CONCRETE CURB AND
TRANSITION CURB NOTES:


1. 6-INCH CONCRETE CURB TO BE CONSTRUCTED ON ALL ESPLANADES, ISLANDS AND NON-RESIDENTIAL STREETS. RESIDENTIAL STREETS MAY BE CONSTRUCTED WITH EITHER 6-INCH CONCRETE CURB OR 4-INCH x 12-INCH CONCRETE CURB AS SHOWN ON THE PLAN.
 2. ALL 4-INCH x 12-INCH CONCRETE CURBS TO BE POURED SEPARATE FROM PROPOSED CONCRETE PAVEMENT.
 3. TRANSITIONS FROM 6-INCH CONCRETE CURB TO 4-INCH x 12-INCH CONCRETE CURB TO BE ACCOMPLISHED WITHIN 5 FEET (TYP.), UNLESS OTHERWISE SHOWN.
- REINFORCING STEEL AS SHOWN IN "4-INCH x 12-INCH TRANSITION CURB" DETAIL IS TO BE INSTALLED.

SL-ST-20

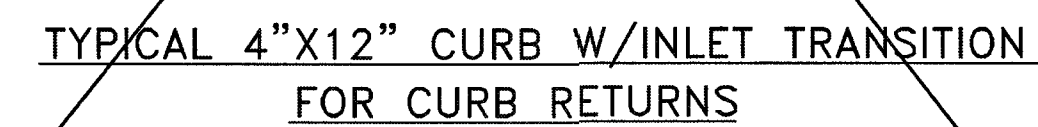

NTS

SL-ST-14

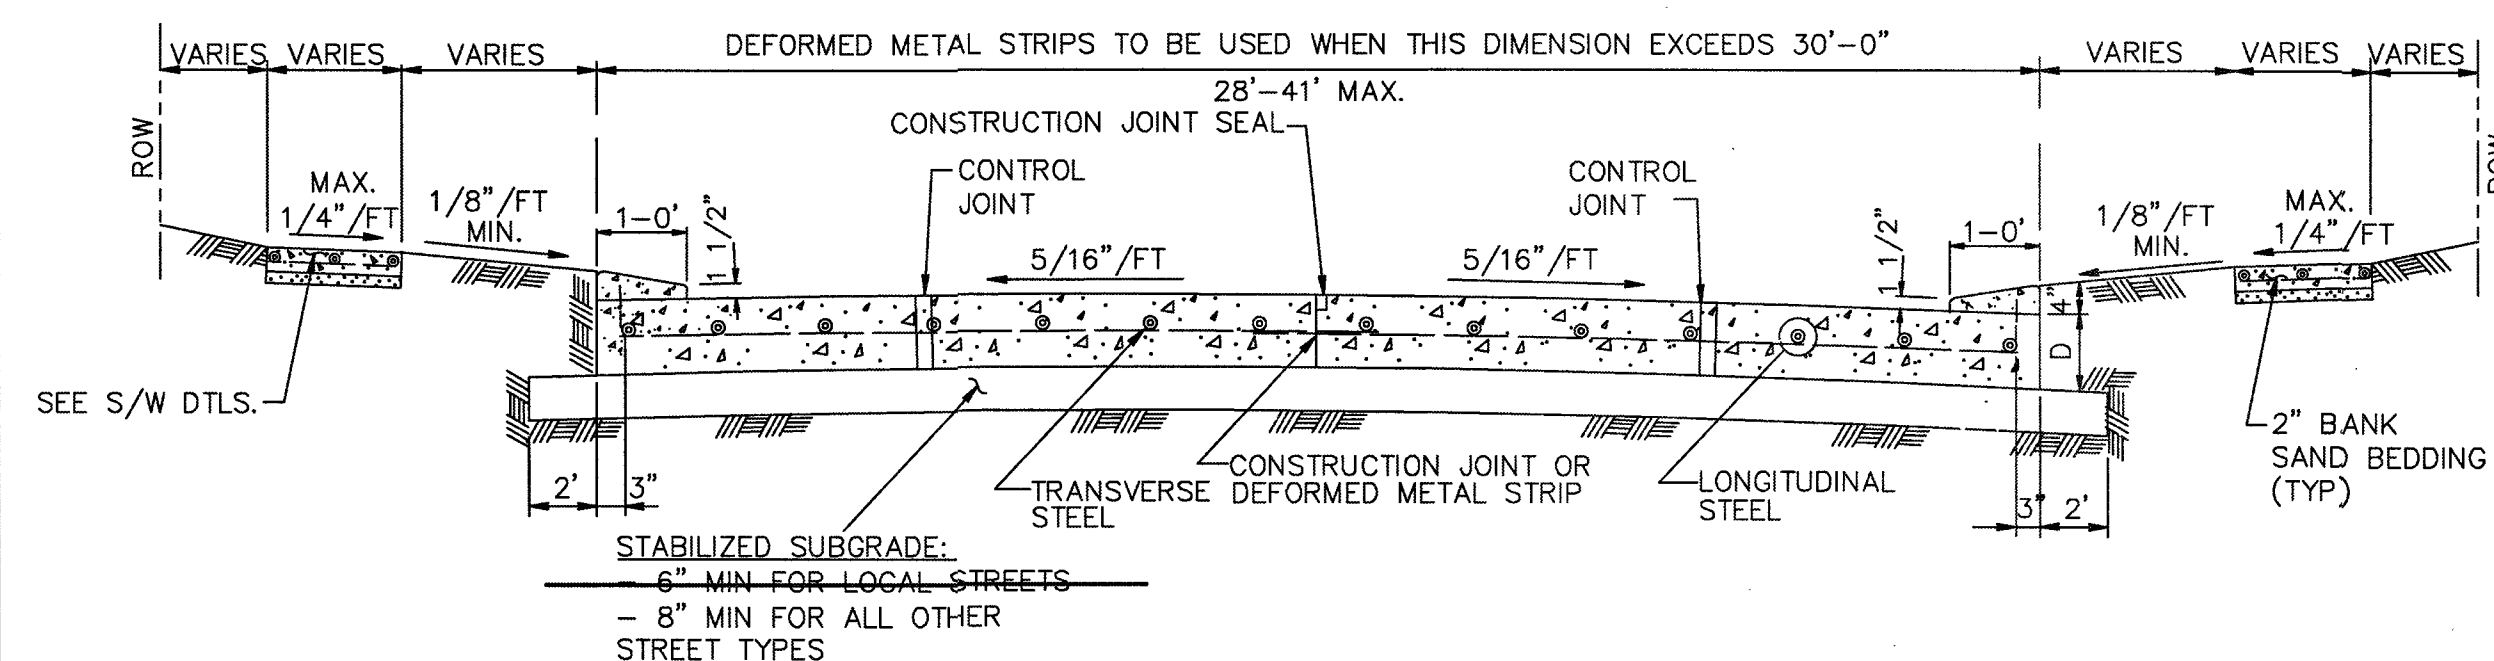

TYPICAL SINGLE ROADWAY SECTION FOR
CONCRETE PAVEMENT WITH 4"X12" CURB

* SEE 4" x 12" MOUNTABLE CURB DETAIL
(THIS SHEET)

OWNER:
Clint Peltier
Clint Peltier Custom Homes
979-481-4840

PLAN: _____

PROFILE: _____


HORIZONTAL: _____

VERTICAL: _____

CONSTRUCTION NOTES:



1. 6 INCH, 5.5 SACK CEMENT PER CUBIC YARD CONCRETE, 3500 PSI REINFORCED CONCRETE WITH #4 BARS 24 INCHES C-C, E.W. IS THE MINIMUM ACCEPTABLE PAVEMENT CONSTRUCTION FOR RESIDENTIAL STREETS.
2. 7 INCH, 5.5 SACK CEMENT PER CUBIC YARD CONCRETE, 3500 PSI REINFORCED CONCRETE WITH #4 BARS 24 INCHES C-C, IS THE MINIMUM ACCEPTABLE PAVEMENT CONSTRUCTION FOR COLLECTOR STREETS
3. EIGHT (8) INCH, 5.5 SK, 3500 PSI @ 28 DAYS, REINFORCED WITH #4 18" C.C. EACH WAY IS THE MINIMUM ACCEPTABLE FOR ARTERIAL STREETS.
4. TRANSVERSE EXPANSION JOINTS SHALL BE PLACED AT ALL POINTS OF CURVATURE, POINTS OF TANGENCY AND ALL INTERSECTION CURB RETURN POINTS MAXIMUM SPACING SHALL BE 200' AND BE SEALED CONFORMING TO TXDOT ITEM 360 (& ITEM 438) AND TXDOT DMS-6310, CLASS-2.
5. TRANSVERSE CONTROL JOINTS ARE REQUIRED AT MAXIMUM SPACING OF 20'-0" C-C, AND VERTICAL CURB JOINTS TO BE SEALED WITH SPECIAL JOINT SEALANT ASTM-D-1190-74 OR AASHTO-M173-60 FOR PAVEMENT 8" THICK AND GREATER. (ELASTONETRIC TYPE HOT POURED)
6. PAVEMENT FINISH SHALL BE BAKER BROOM FINISH. CURING COMPOUND ON ALL CONCRETE.
7. STORM WATER POLLUTION PROTECTION SHALL BE DESIGNED, CONSTRUCTED, MAINTAINED AND SHALL BE IN TOTAL COMPLIANCE WITH THE STORM WATER QUALITY MANUAL OF THE CITY OF SUGAR LAND.
8. UNSTABLE SUBGRADE SHALL BE EXCAVATED AND REPLACED WITH CEMENT STABILIZED SAND.
9. USE 1"x2" REDWOOD STAKES FOR HEADERS.
10. EDGE ALL SIDES WITH EDGING TOOL.
11. DOWEL SHALL BE 3/4" DIAMETER, WITH MINIMUM 8" PENETRATION (BOTH SIDES).
12. IT IS THE CONTRACTOR'S RESPONSIBILITY TO NOTIFY THE CITY OF SUGAR LAND OF ANY BIRDBATH PROBLEMS PRIOR TO CONSTRUCTION OF DRIVEWAY.
13. REFER TO GENERAL, C.S.S., AND PAVEMENT NOTES.
14. 1.0 LBS. OF APPROVED POLYPROPYLENE FIBER MESH PER C/Y IN 4"x12" CURBS REQUIRED.

SL-ST-20


No.	DATE	REVISION					
SEAL:							
_____ DATE _____							
DESIGN ENGINEER:							
<div><p>CITY OF SUGAR LAND, TEXAS ENGINEERING DEPARTMENT</p></div>							
<u>CONSTRUCTION PLANS FOR:</u>							
<div>RESIDENTIAL CURB CONSTRUCTION DETAILS</div>							
JOB No.: DATE: DESIGNED BY: DRAWN BY: CHECKED BY: SCALE:				SL-23			
				SHEET OF			

NO.	DATE	DESCRIPTION	APPROVED
REVISIONS			

DESIGNED MS
DRAWN BT
CHECKED _____
DATE _____

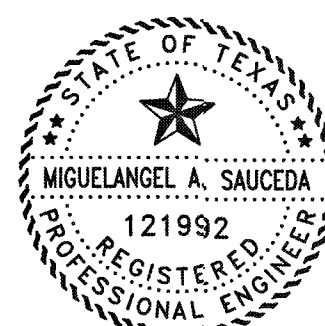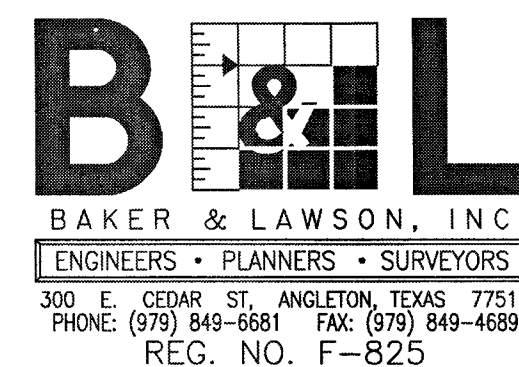

The seal appearing on
this document was
authorized by
Miguelangel A. Saucedo
P.E. 121992


Date: 1/11/28

OWNER:


Clint Peltier
Clint Peltier Custom Homes
979-481-4840

**BAYOU BEND ESTATES
ANGLETON, TEXAS
PLANS FOR
GRADING, PAVING, UTILITIES
AND DETENTION**


RESIDENTIAL CURB
CONSTRUCTION DETAILS
SL-23

PROJECT NO. 13454

33
3454 DETAIL SET DWG

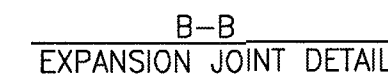

10. SIDEWALK EXPANSION JOINTS SHALL CONFORM TO STREET EXPANSION JOINT STANDARDS.

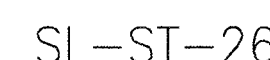

TYPICAL SINGLE ROADWAY SIDEWALK



TRUNCATED DOME PATTERN CURB RAMP



SL-ST-32



SL-ST-27



SL-ST-30



SL-ST-33


RECORD DRAWING

WHEEL CHAIR RAMP &
SIDEWALK DETAILS I
SL-25

PROJECT NO. 13454


34

JOURNAL OF CLIMATE

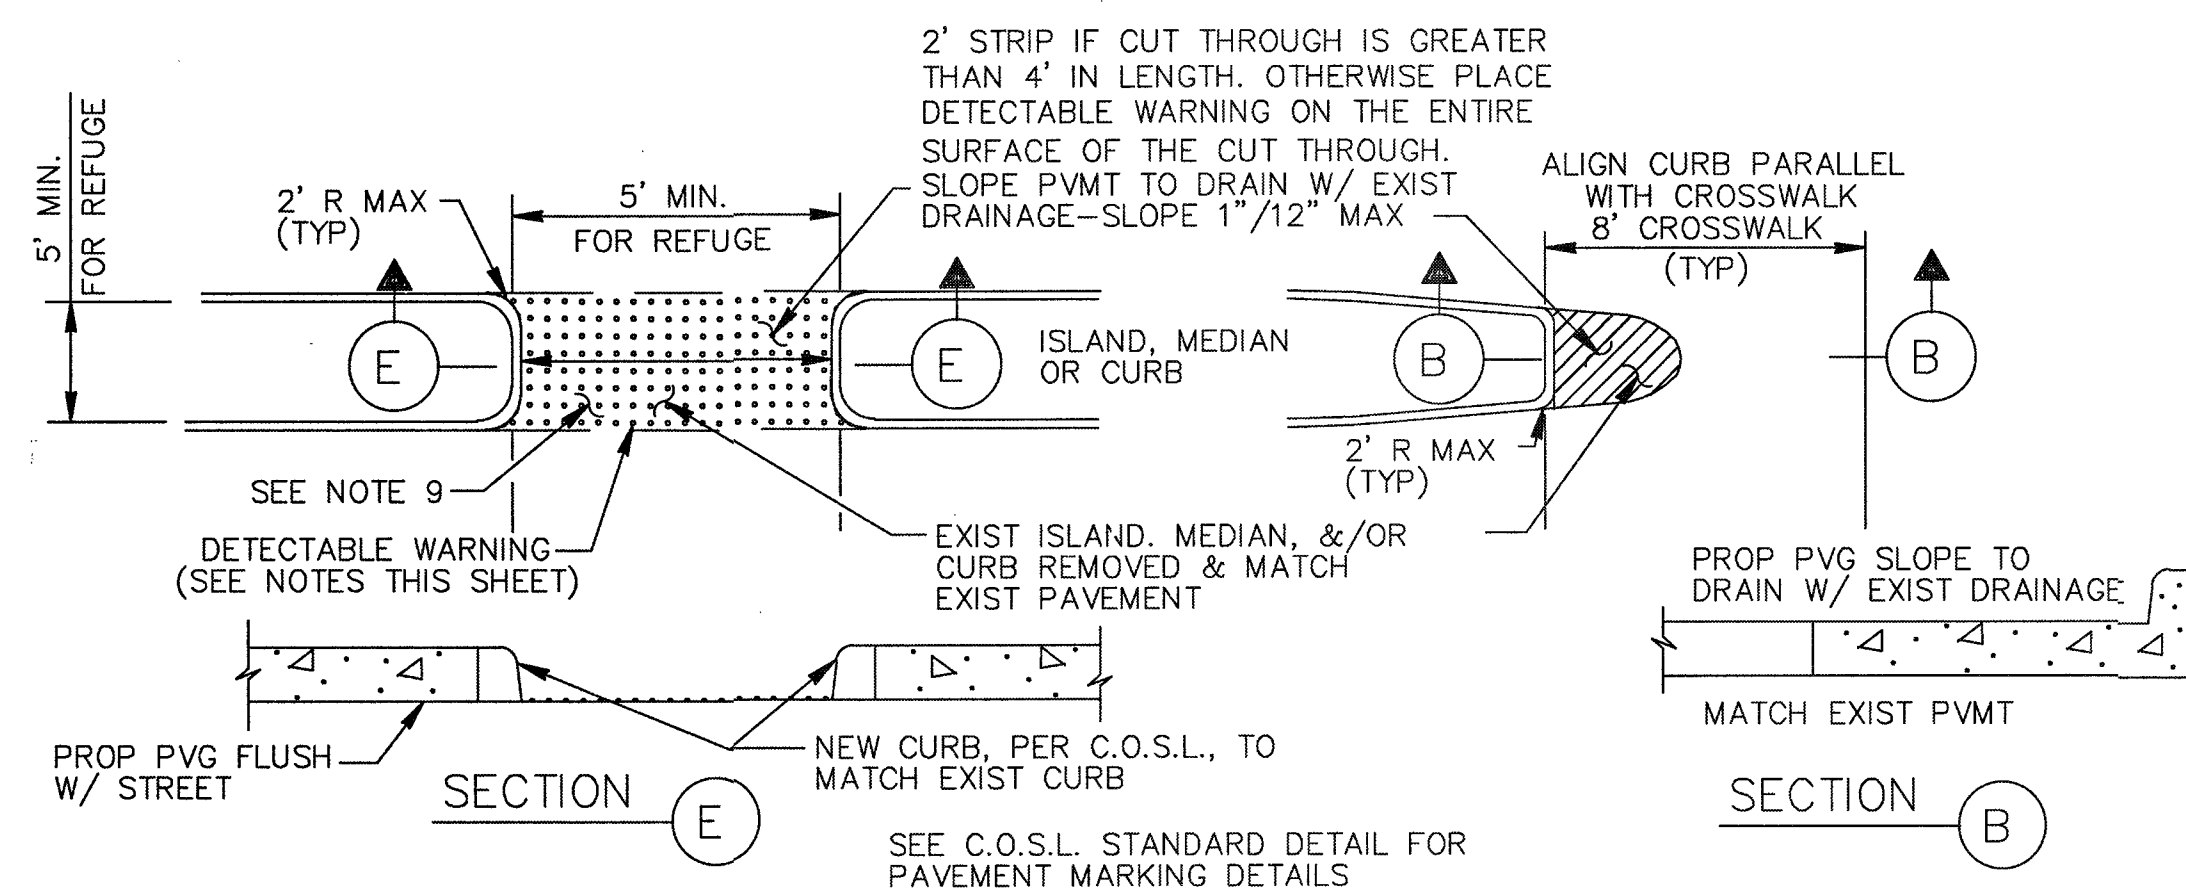

FOR ISLAND, MEDIAN, OR CURB MODIFICATIONS FOR CROSSWALKS

SL-ST-35

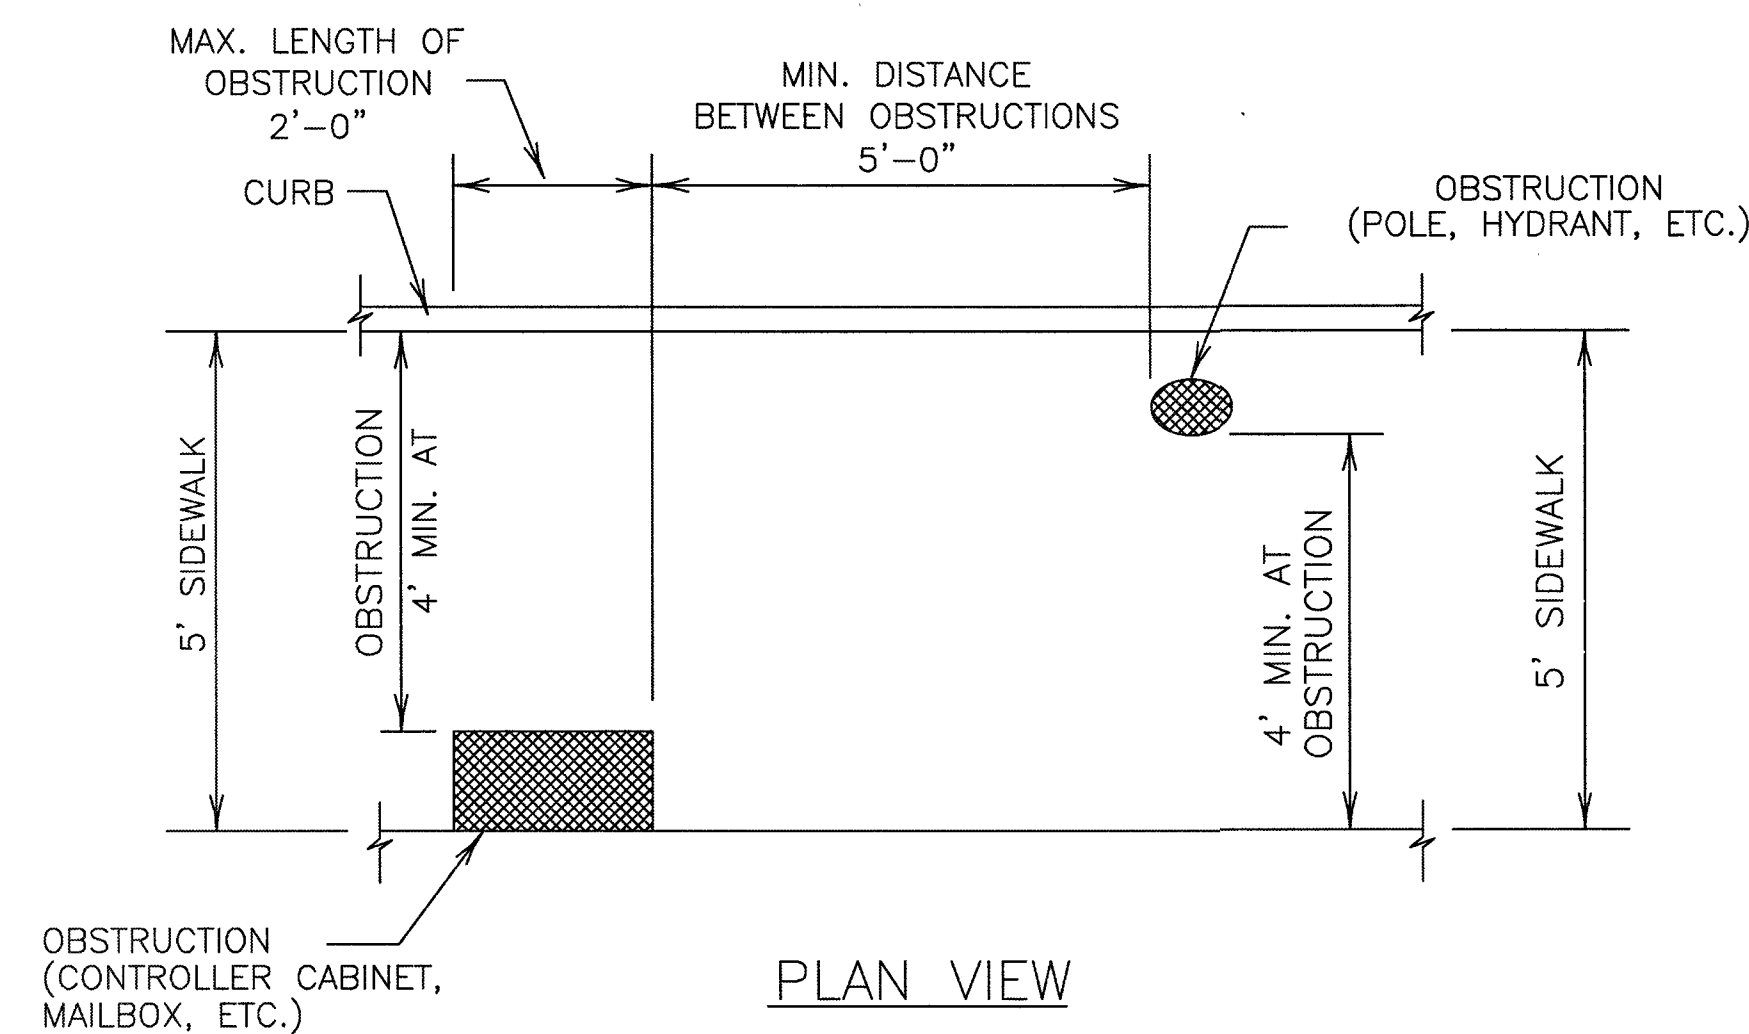

PLAN VIEW
PLACEMENT OF STREET FIXTURES


(ITEMS NOT INTENDED FOR PUBLIC USE.
MINIMUM 4' x 4' CLEAR GROUND SPACE
REQUIRED AT PUBLIC USE FIXTURES.)

SL-ST-36

NOTES:


1. ALL SLOPES ARE MAXIMUM ALLOWABLE. THE LEAST POSSIBLE SLOPE THAT WILL STILL DRAIN PROPERLY SHOULD BE USED. RAMP LENGTH OR GRADE OF APPROACH SIDEWALKS MAY BE ADJUSTED AS DIRECTED
2. THE MINIMUM SIDEWALK WIDTH IS 5' (FEET). THE LANDING SHALL BE 5' x 5' WITH A MAXIMUM SLOPE OF 2% IN ANY DIRECTION. MAXIMUM ALLOWABLE CROSS SLOPE ON SIDEWALK AND RAMP SURFACES IS 2%. USUAL SIDEWALK CROSS SLOPE EQUALS 1.5%. CHANGES IN LEVEL GREATER THAN 1/4" (IN.) ARE NOT PERMITTED.
3. MANEUVERING SPACE AT THE BOTTOM OF CURB RAMPS SHALL BE A MINIMUM OF 5' x 5' WHOLLY CONTAINED WITHIN THE CROSSWALK AND WHOLLY OUTSIDE THE PARALLEL VEHICULAR TRAVEL PATH.
4. ANY PART OF THE ACCESSIBLE ROUTE WITH A SLOPE GREATER THAN 1:20 (5%) SHALL BE CONSIDERED A RAMP. IF A RAMP HAS A RISE GREATER THAN 6" (IN.) OR A HORIZONTAL PROJECTION GREATER THAN 72 INCHES, THEN IT SHALL HAVE HANDRAILS ON BOTH SIDES, WITH THE FOLLOWING EXCEPTIONS:
 - A.) HANDRAILS ARE NOT REQUIRED ON CURB RAMPS. CURB RAMPS SHALL BE PROVIDED WHEREVER AN ACCESSIBLE ROUTE CROSSES (PENETRATES) A CURB.
 - B.) THE LEAST POSSIBLE GRADE SHOULD BE USED TO MAXIMIZE ACCESSIBILITY. WHERE STRUCTURALLY IMPRACTICAL TO ACHIEVE TEXAS ACCESSIBILITY STANDARDS (TAS) COMPLIANCE, THE RUNNING SLOPE OF SIDEWALKS AND CROSSWALKS, WITHIN THE PUBLIC R.O.W., MAY FOLLOW THE GRADE OF THE PARALLEL ROADWAY WITHOUT INVOKING TEXAS ACCESSIBILITY STANDARDS (TAS) VARIANCES FOR LANDINGS OR HANDRAILS. WHERE A CONTINUOUS GRADE GREATER THAN 5% MUST BE PROVIDED, HANDRAILS MAY BE DESIRABLE ON ONE OR BOTH SIDES OF THE SIDEWALK TO IMPROVE ACCESSIBILITY. HANDRAILS MAY ALSO BE NEEDED TO PROTECT PEDESTRIANS FROM POTENTIALLY HAZARDOUS CONDITIONS.
5. CURB RAMPS WITH RETURNED CURBS MAY BE USED ONLY WHERE PEDESTRIANS WOULD NOT NORMALLY WALK ACROSS THE RAMP. OTHERWISE, FLARED SIDES SHALL BE PROVIDED. ALL CONCRETE SURFACES SHALL RECEIVE A LIGHT BROOM FINISH UNLESS NOTED OTHERWISE IN THE PLANS.
6. RAMP TEXTURES MUST CONSIST OF TRUNCATED DOME SURFACES, IN ACCORDANCE WITH ADA AND TEXAS DEPARTMENT OF LICENSING AND REGULATIONS (TDLR), TEXTURES ARE REQUIRED TO BE DETECTABLE UNDERFOOT. TEXTURES ALSO SHALL CONTRAST VISUALLY WITH ADJOINING SURFACES. SURFACES THAT WOULD ALLOW WATER TO ACCUMULATE ARE PROHIBITED.
7. ADDITIONAL INFORMATION ON CURB RAMP LOCATION, DESIGN, LIGHT REFLECTIVE VALUE AND TEXTURE MAY BE FOUND IN THE CURRENT EDITION OF THE TEXAS ACCESSIBILITY STANDARDS (TAS) PREPARED AND ADMINISTERED BY THE TEXAS DEPARTMENT OF LICENSING AND REGULATION (TDLR).
8. RAISED MEDIANS SEPARATE OPPOSING DIRECTIONS OF TRAFFIC AND PROVIDE A REFUGE AREA FOR PEDESTRIANS UNABLE TO CROSS THE ENTIRE ROADWAY IN THE ALLOTTED SIGNAL PHASE. TO SERVE AS A REFUGE AREA, THE MEDIAN SHALL BE A MINIMUM OF 5' (FT.) WIDE. MEDIANS SHOULD BE DESIGNED TO PROVIDE ACCESSIBLE PASSAGE OVER OR THROUGH THEM.
9. SMALL CHANNELIZATION ISLANDS, WHICH CAN NOT PROVIDE A MINIMUM 5' x 5' LANDING AT THE TOP OF RAMPS, SHALL BE CUT THROUGH LEVEL WITH THE SURFACE OF THE STREET.
10. CROSSWALK DIMENSIONS, CROSSWALK MARKINGS AND STOP BAR LOCATIONS SHALL BE AS SHOWN IN THE PLANS. AT INTERSECTIONS WHERE CROSSWALK MARKINGS ARE NOT REQUIRED, RAMPS SHALL BE ALIGNED WITH THEORETICAL CROSSWALKS, OR AS DIRECTED BY THE ENGINEER.
11. EXISTING FEATURES THAT COMPLY WITH T.A.S. MAY REMAIN IN PLACE UNLESS OTHERWISE SHOWN ON THE PLANS.
12. TRAFFIC SIGNAL OR ILLUMINATION POLES, GROUND BOXES, CONTROLLER BOXES, SIGNS, DRAINAGE FACILITIES AND OTHER ITEMS SHALL BE PLACED SO NOT TO OBSTRUCT THE ACCESSIBLE ROUTE.

SL-ST-40

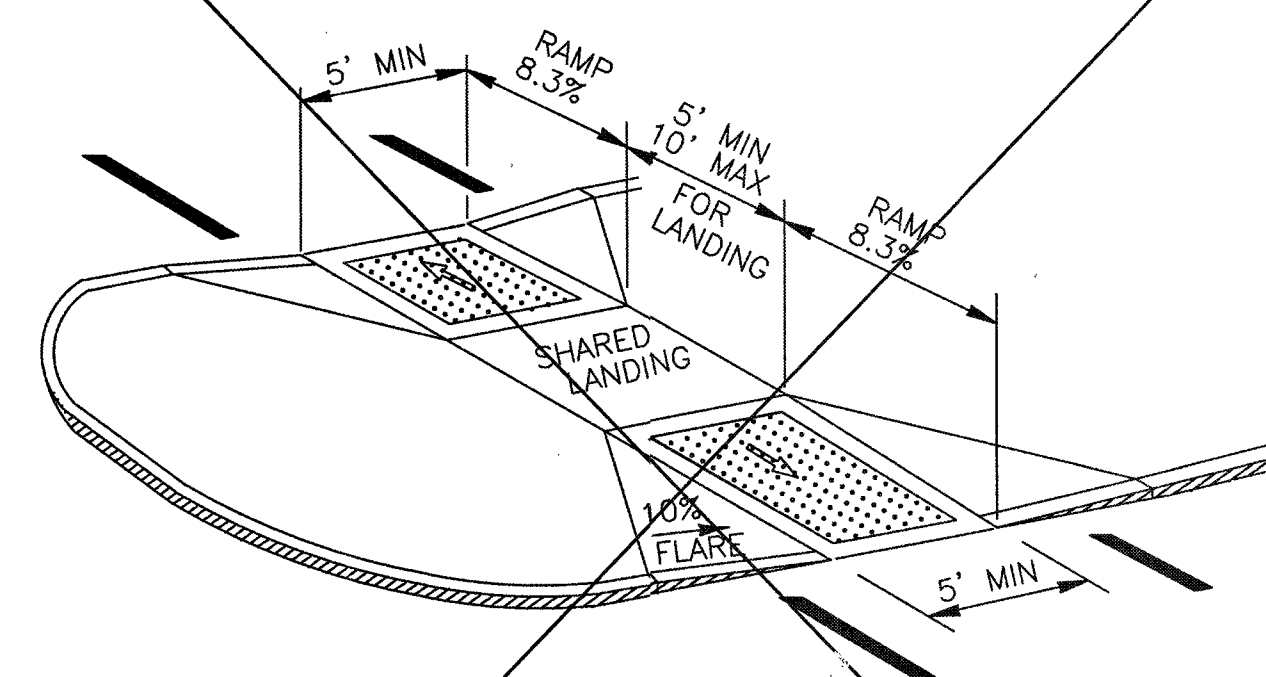

CURB/RAMPS AT MEDIAN ISLANDS


SL-ST-37

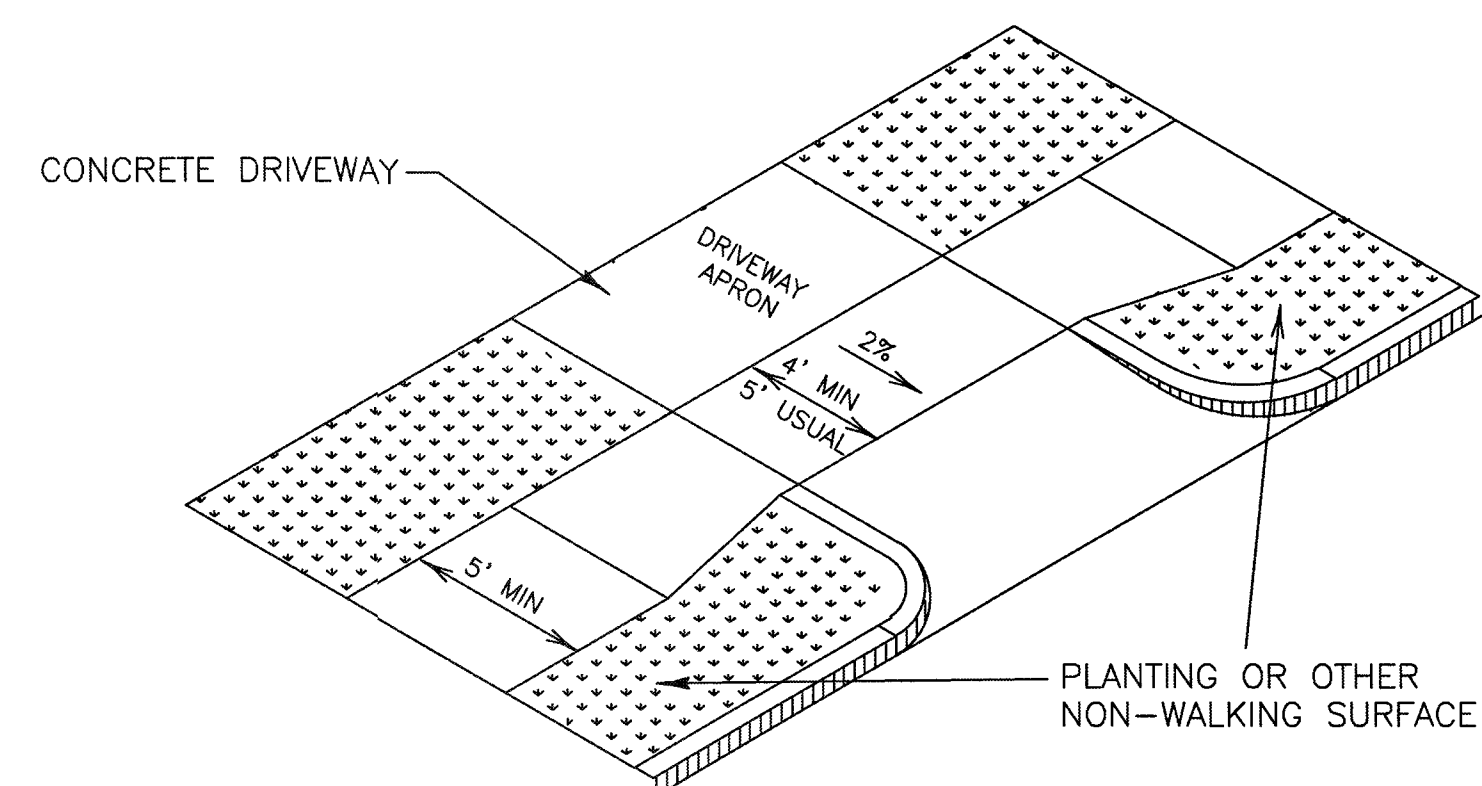

SETBACK SIDEWALK

SIDEWALK TREATMENT AT DRIVEWAYS

SL-ST-38

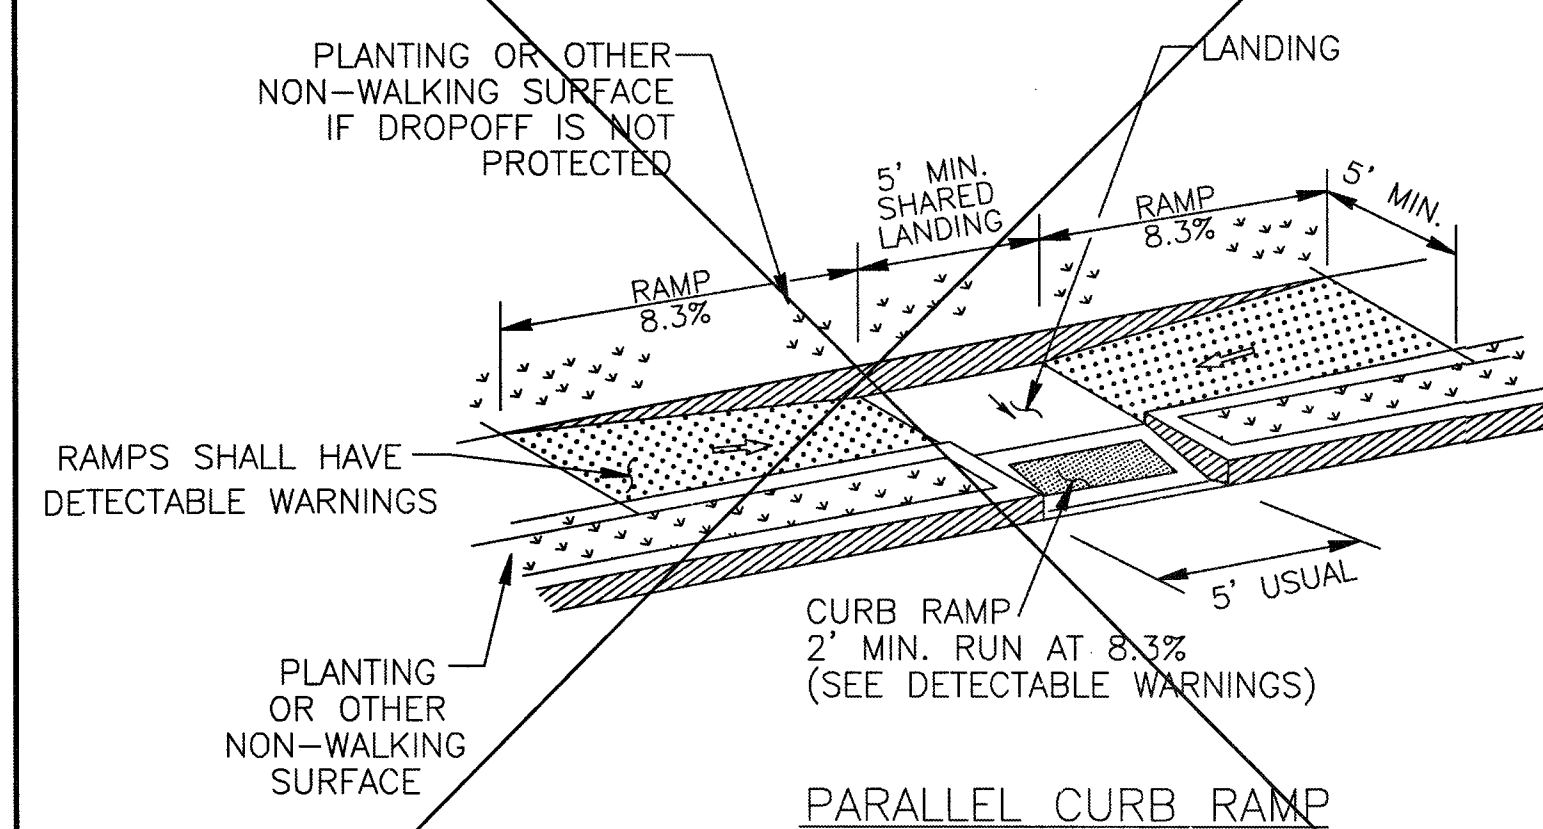

PARALLEL CURB RAMP



SL-ST-39

																																																																																																																																																																																																																																																																																																																																																																																																																																																																																																																																																																																																																																																																																																																																																																																																																																																																																																																																																																																																																																																																																																																																																																																																																																																																																																																																																																																																																					</
--	--	----


RECORD DRAWING

NO.	DATE	DESCRIPTION	APPROVED
REVISIONS			

DESIGNED MS
DRAWN BT
CHECKED _____
DATE _____

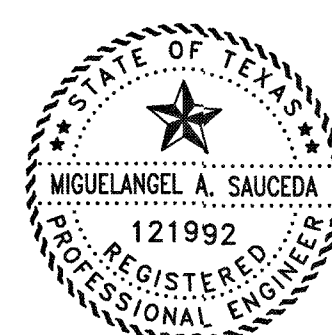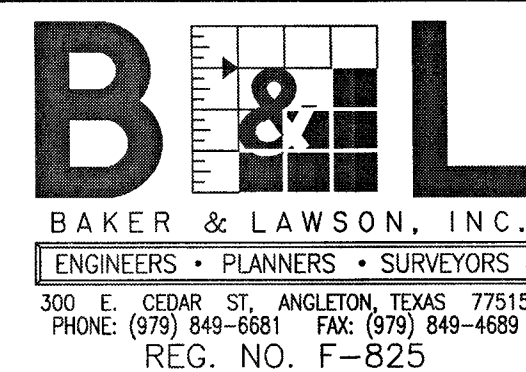

 The seal appearing on
this document was
authorized by
Miguelangel A. Saucedo
P.E. 121992



Date: 1/11/78

OWNER:
Clint Peltier
Clint Peltier Custom Homes
979-481-4840

PLAN: _____
 PROFILE: _____
 HORIZONTAL: _____
 VERTICAL: _____

**BAYOU BEND ESTATES
ANGLETON, TEXAS
PLANS FOR
GRADING, PAVING, UTILITIES
AND DETENTION**

WHEEL CHAIR RAMP &
SIDEWALK DETAILS II
SL-26

PROJECT NO. 13454

35

3454 DETAIL SET DWG

- NOTES:
- 1.) SAW CUT & BREAKOUT NO MORE THAN 72 HOURS PRIOR TO PROPOSED CONCRETE PLACEMENT. NOTIFY SUGAR LAND PRIOR TO CUT.
 - 2.) UNSTABLE SUBGRADE SHALL BE OVER EXCAVATED & REPLACED WITH CONCRETE.
 - 3.) IT IS CONTRACTOR'S RESPONSIBILITY TO NOTIFY SUGAR LAND OF ANY BIRD BATH PROBLEMS PRIOR TO CONSTRUCTION OF DRIVEWAY.
 - 4.) USE 1"x2" TREATED REDWOOD FOR HEADER.
 - 5.) EDGE ALL SIDES WITH EDGING TOOL AND BROOM FINISH
 - 6.) FOR INDUSTRIAL DRIVES, PAVEMENT SHALL HAVE A DEPTH OF 8" (IN).
 - 7.) EXPANSION JOINT AT PROPERTY LINE REQUIRED. 3/4" REDWOOD BOARD WITH No. 4 DOWELS MINIMUM.
 - 8.) MAXIMUM ALLOWABLE DRIVEWAY GRADE IN PULIC R.O.W. IS 5%.
 - 9.) DRIVEWAY GRADE MUST MEET A.D.A. AND T.A.S. SIDEWALK SLOPE. SIDEWALKS MUST BE SCORED TO MATCH ADJACENT SIDEWALK. IF SLOPE IS CONTINUED THROUGH THE R.O.W. LINE, PROVIDE A 3/4" REDWOOD EXPANSION JOINT WITH DOWELS AT R.O.W. LINE.
 - 10.) REFER TO GENERAL, C.S.S., ASPHALT, AND CONCRETE PAVEMENT NOTES.

CONCRETE APRON DETAIL - DRIVEWAY PROFILE FOR CULVERT DRAINAGE

N.T.S.

SL-ST-42

6" CONCRETE CURB DRIVEWAY PLAN

N.T.S.

SL-ST-41

TABLE-A

CEMENT STABILIZED SAND 2-SK/C.Y.	
RESIDENTIAL	4" MINIMUM
COMMERCIAL	6" MINIMUM
INDUSTRIAL	8" MINIMUM

REINFORCED CONCRETE PAVEMENT 3,000 PSI MIN	
RESIDENTIAL	4" MINIMUM
COMMERCIAL	6" MINIMUM
INDUSTRIAL	8" MINIMUM

DRIVEWAY PAVEMENT CONSTRUCTION TABLE

NO.	DATE	REVISION

SEAL: _____

DESIGN ENGINEER: _____ DATE: _____



CITY OF SUGAR LAND, TEXAS
ENGINEERING DEPARTMENT

CONSTRUCTION PLANS FOR:


DRIVEWAY CONSTRUCTION DETAILS

JOB NO.:
DATE:
DESIGNED BY:
DRAWN BY:
CHECKED BY:
SCALE:

SL-27

SHEET OF


RECORD DRAWING

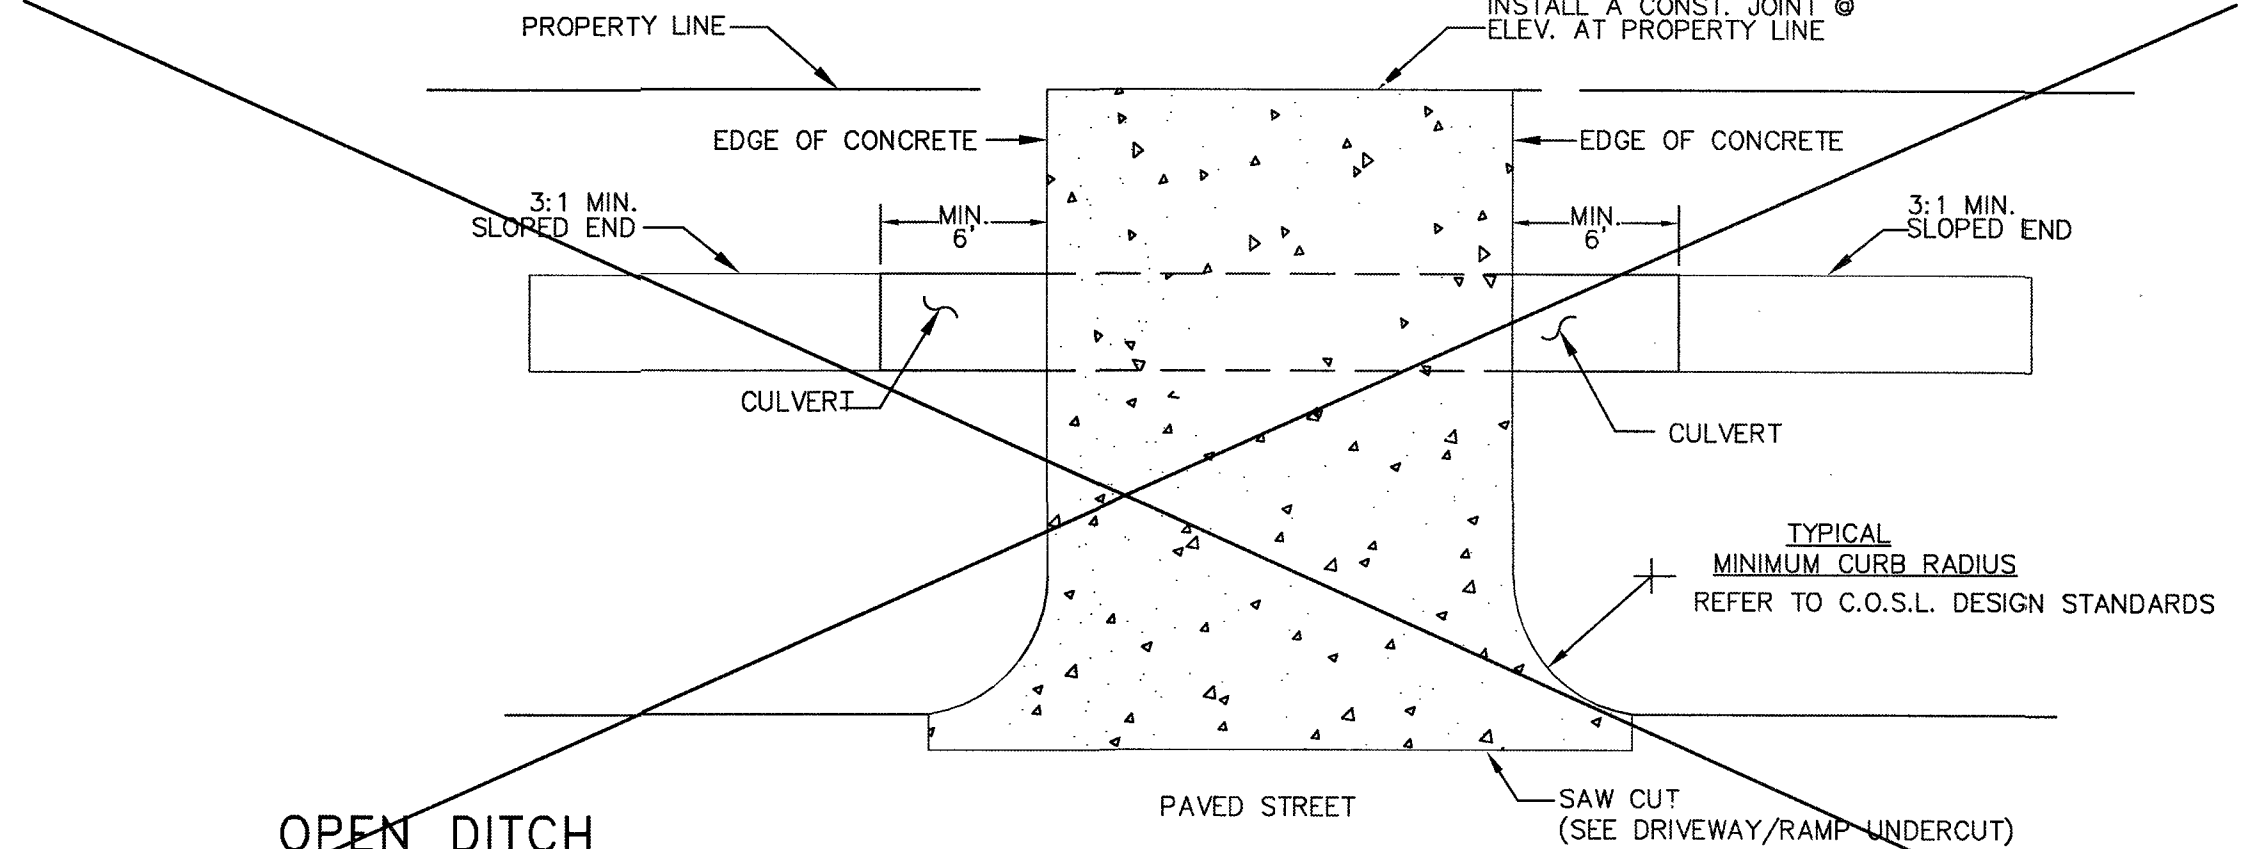

OPEN DITCH CONCRETE DRIVEWAY PLAN

(USED ONLY WHEN CONNECTING TO A CONCRETE ROADWAY)
N.T.S.


SL-ST-44

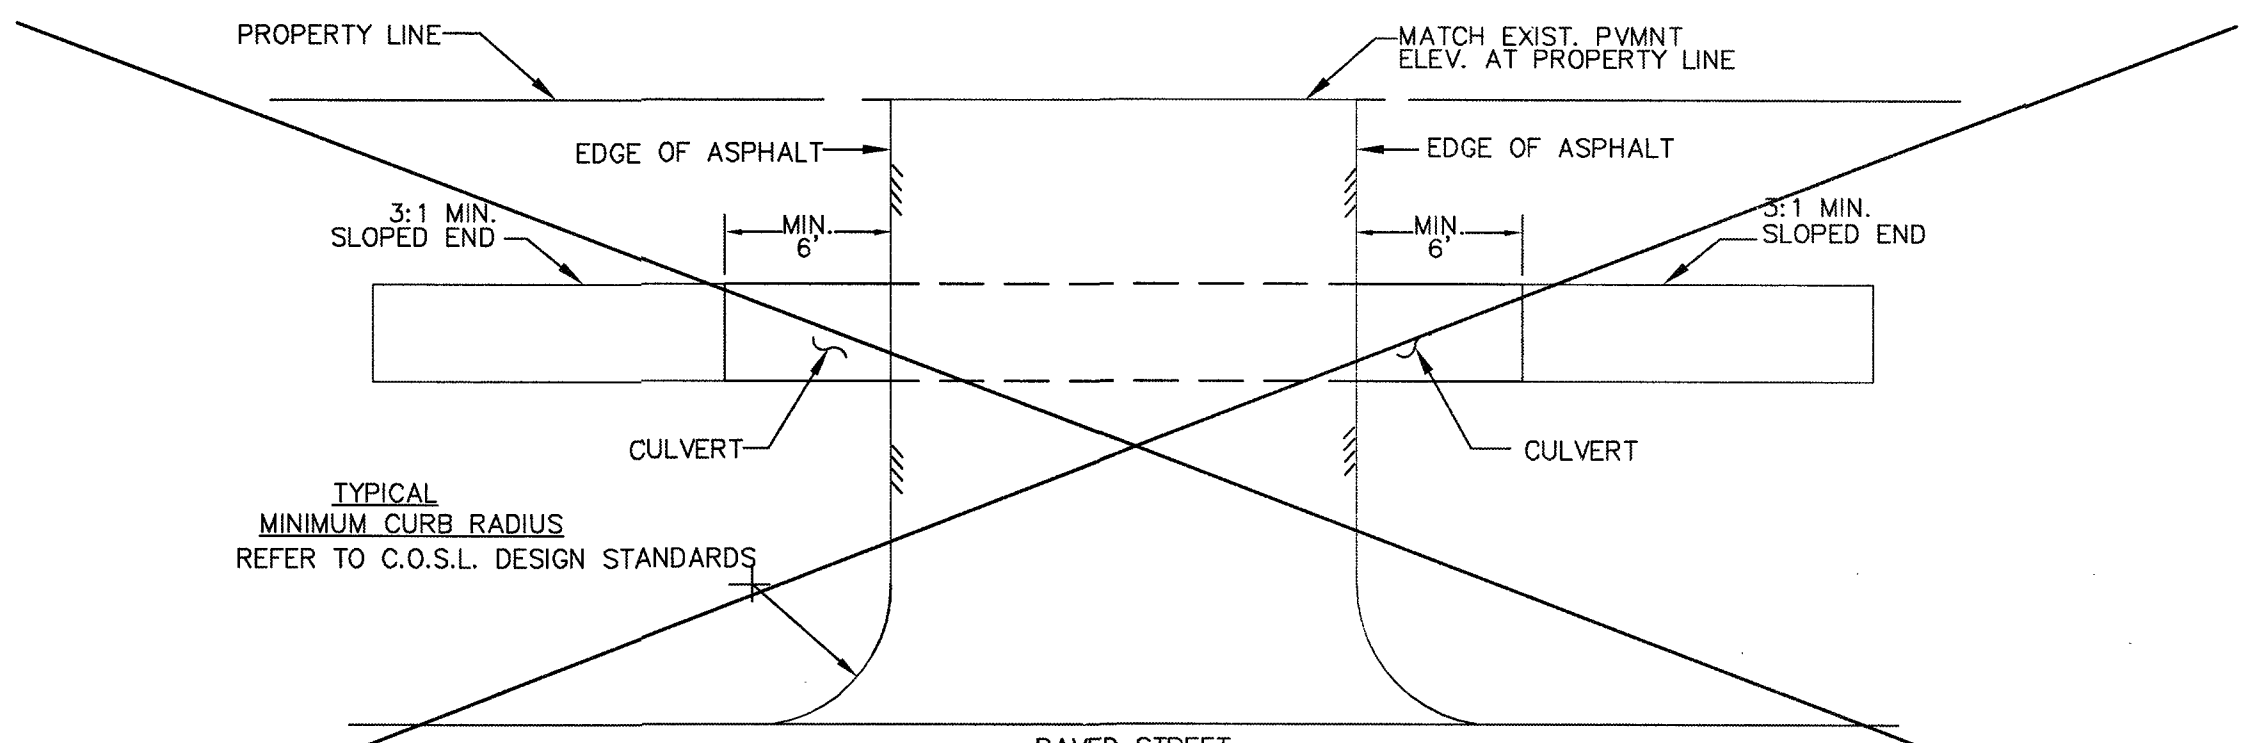

ASPHALT DRIVEWAY PLAN

(USED ONLY WHEN CONNECTING TO AN ASPHALT ROADWAY)
N.T.S.


SL-ST-46

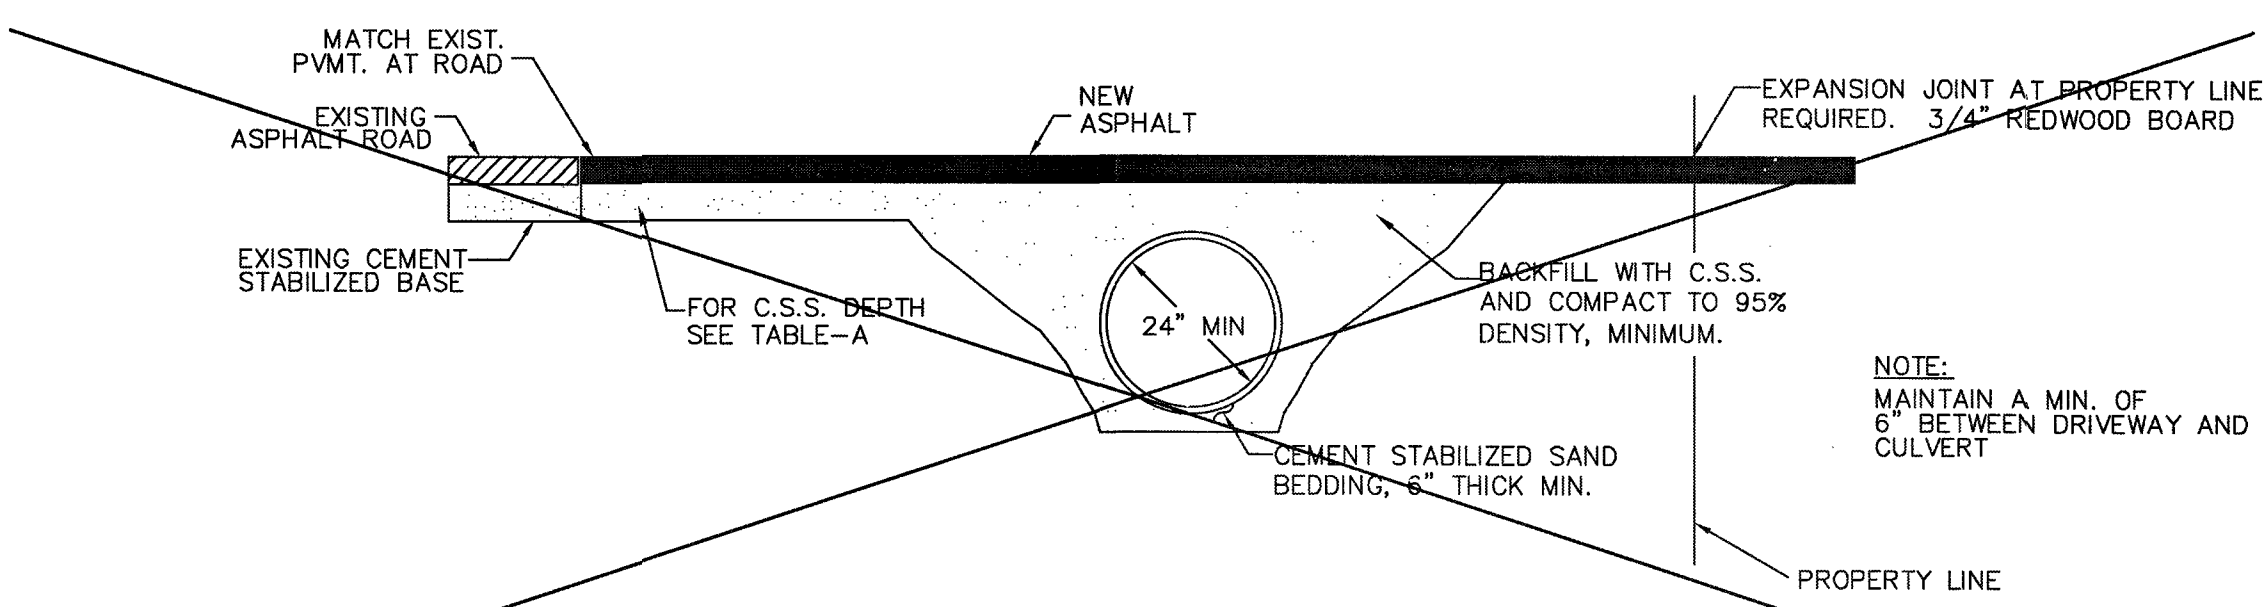

ASPHALT APRON DETAIL - DRIVEWAY PROFILE FOR CULVERT DRAINAGE

N.T.S.


SL-ST-48

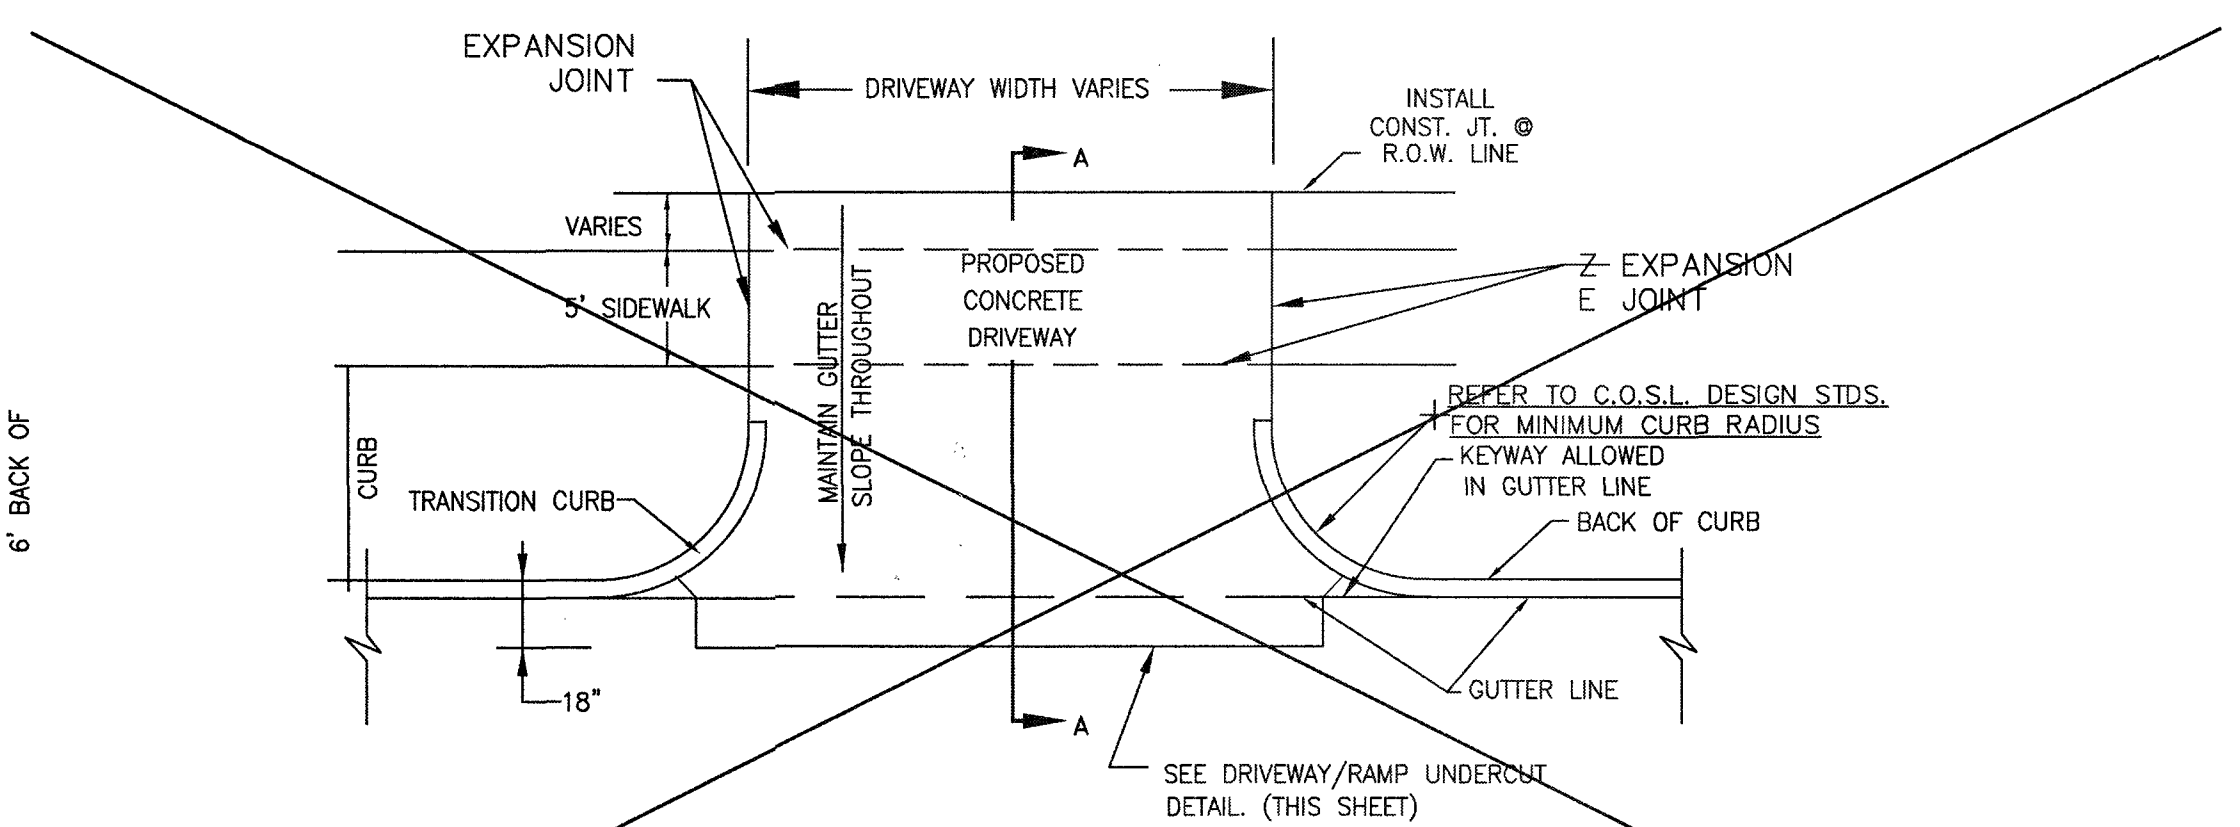

6" CONCRETE CURB DRIVEWAY PLAN


N.T.S.

SL-ST-41

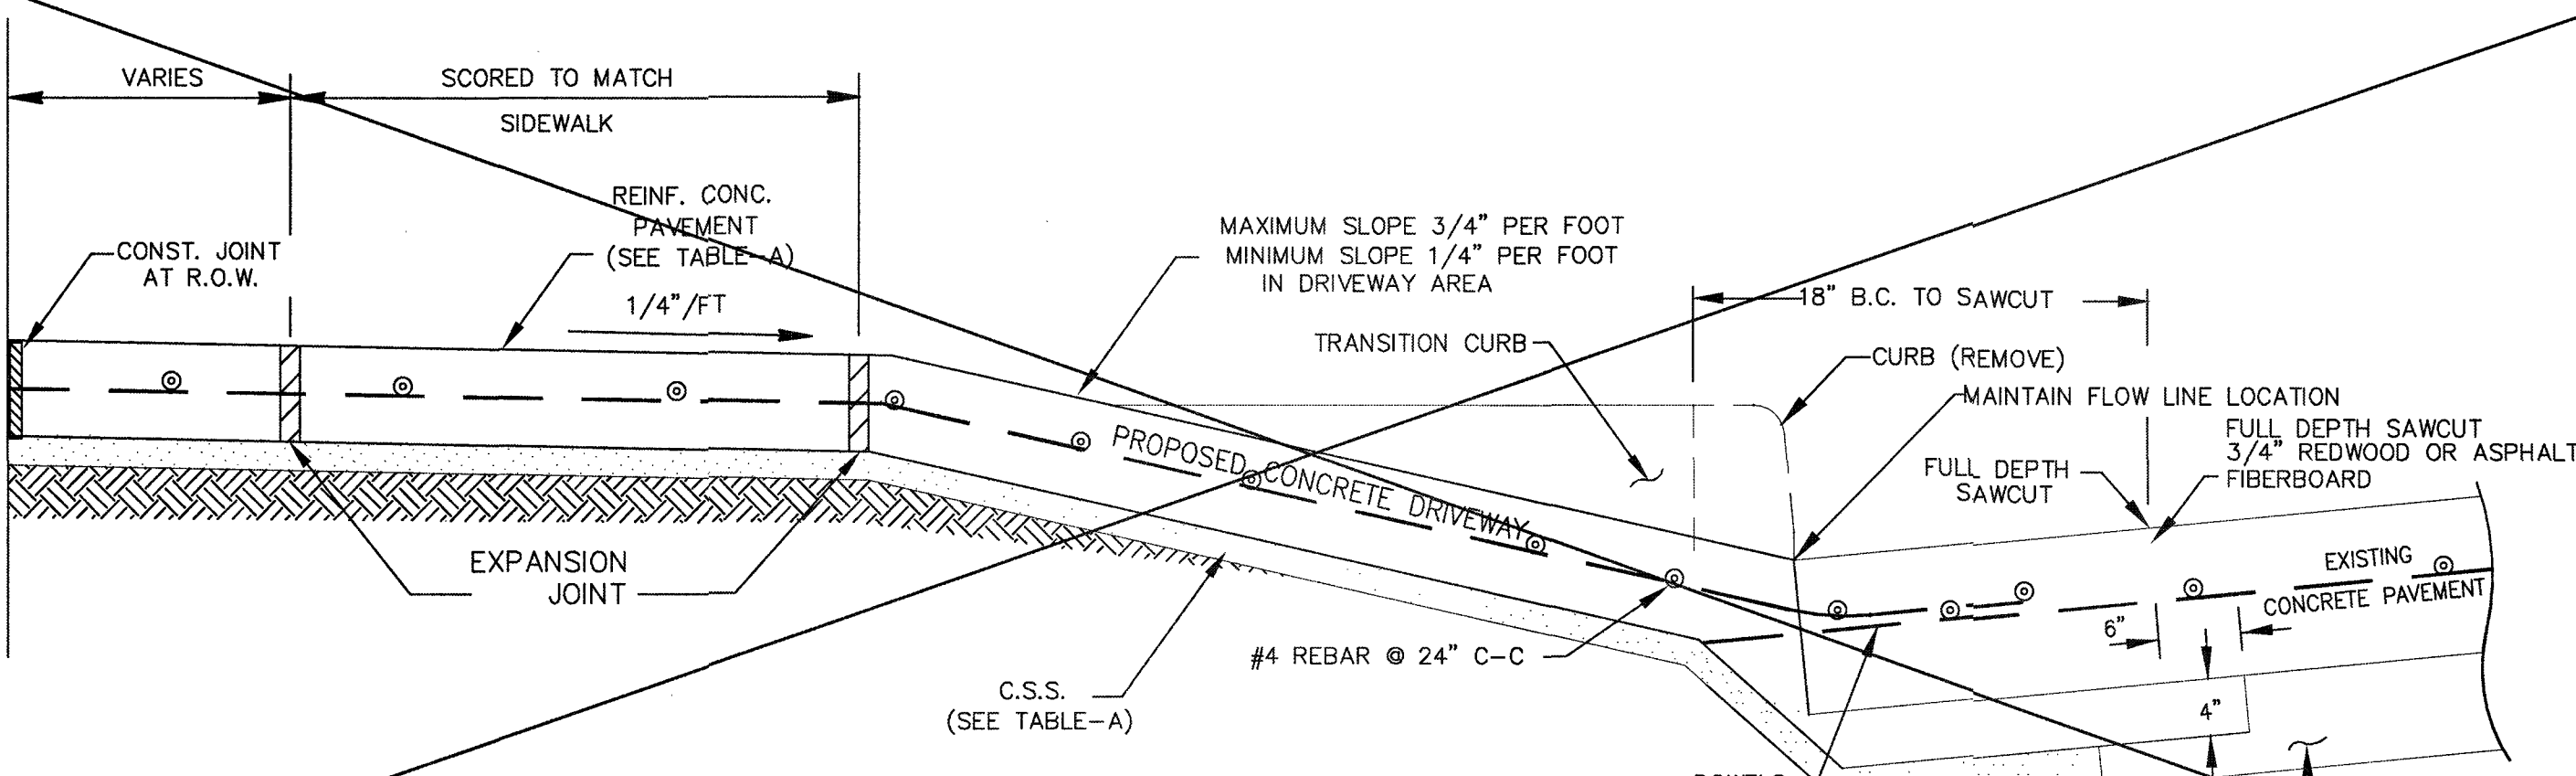

SECTION A


SL-ST-43

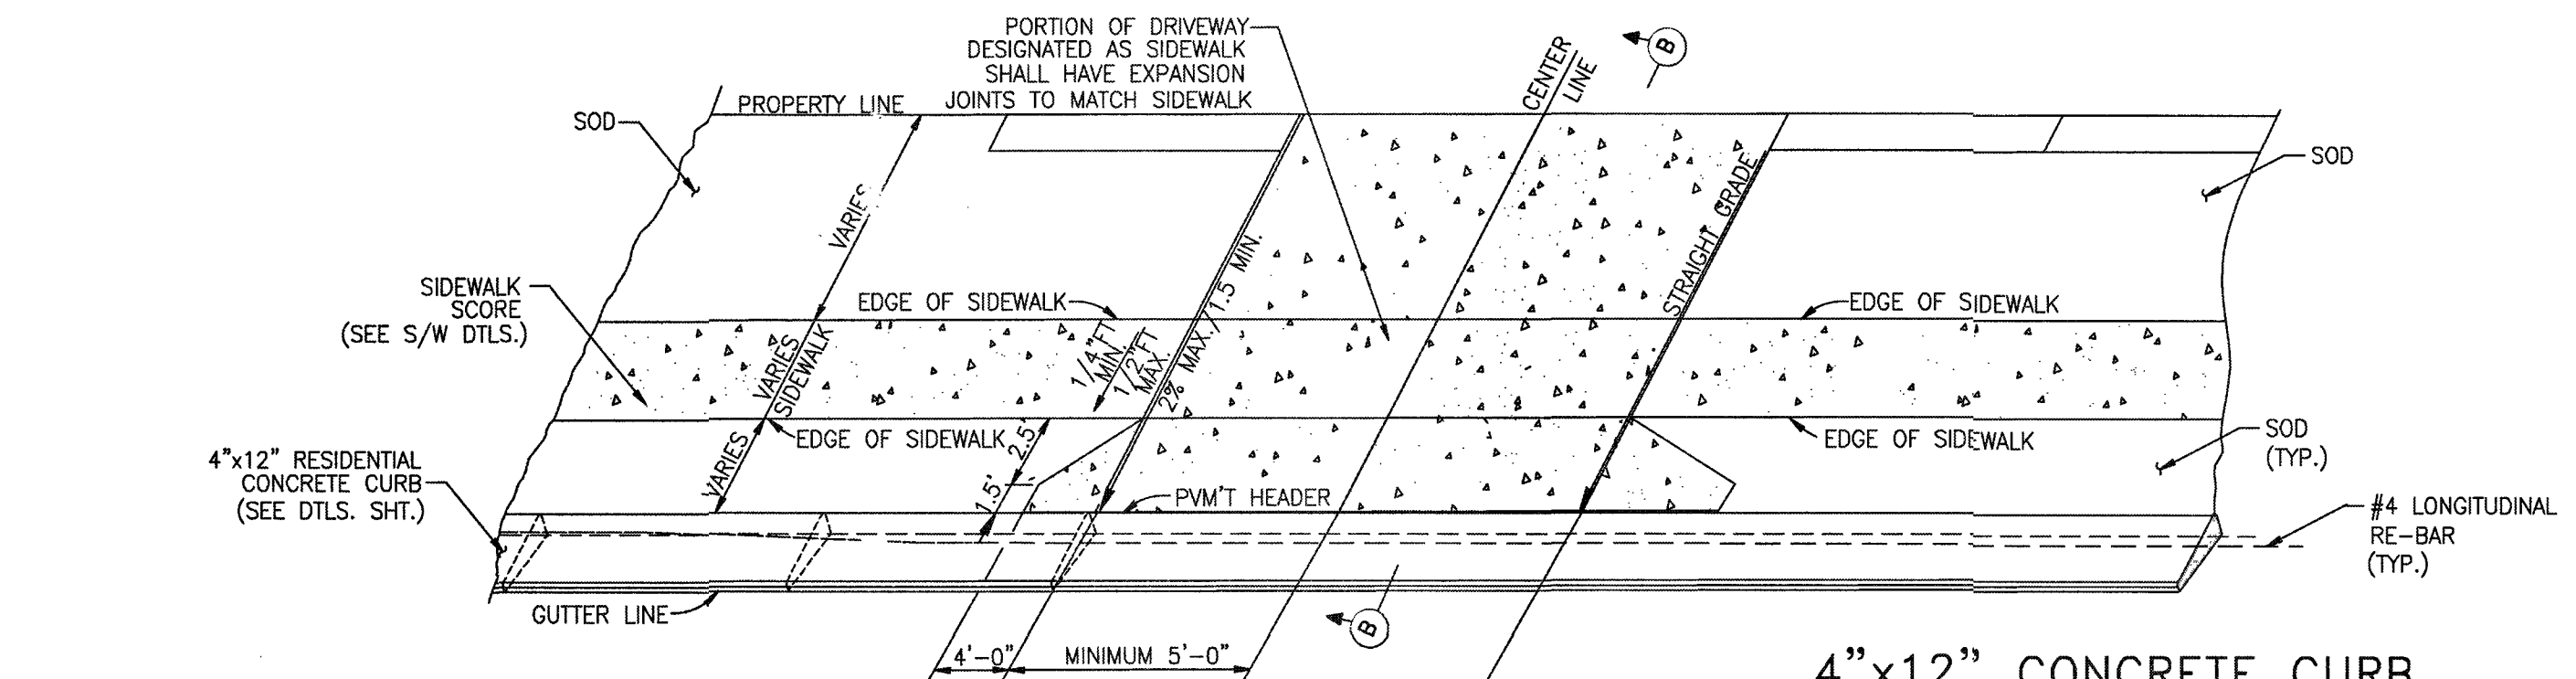

4"x12" CONCRETE CURB DRIVEWAY PLAN

N.T.S.

SL-ST-45

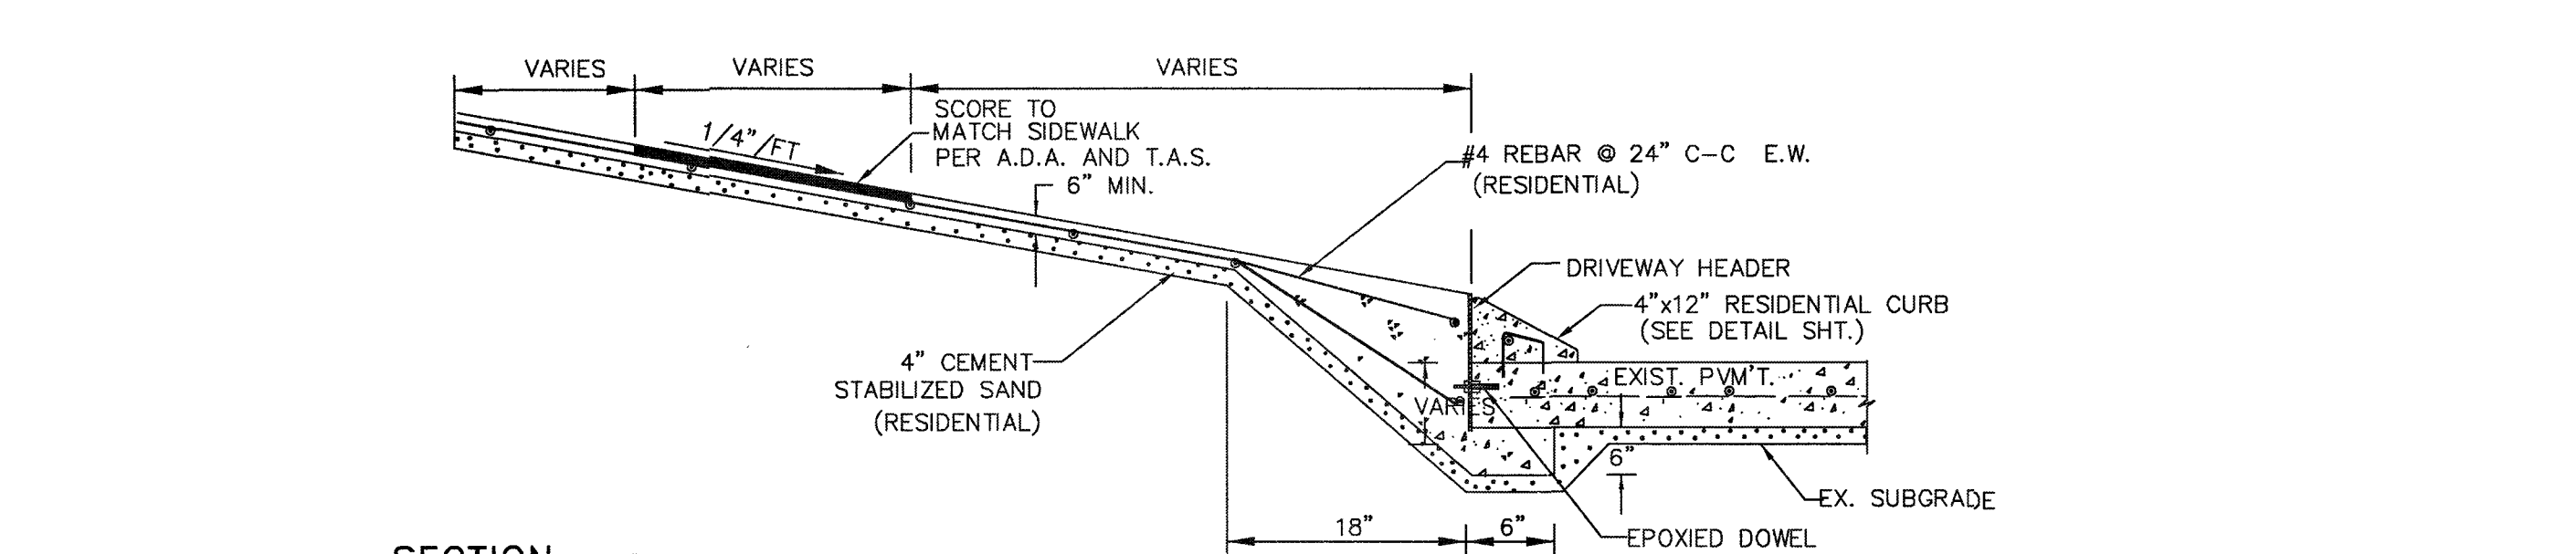



SECTION B

SL-ST-47

NO.	DATE	DESCRIPTION	APPROVED

REVISIONS

DESIGNED MS
DRAWN BT
CHECKED
DATE

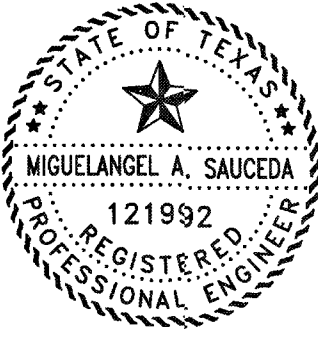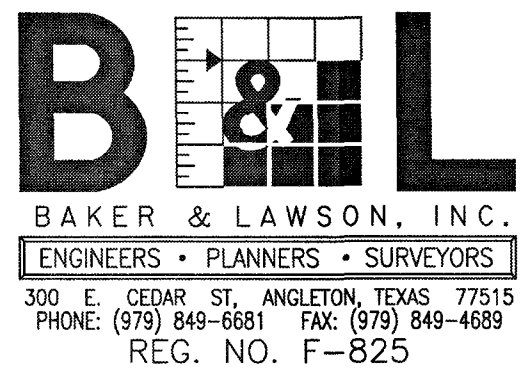

The seal appearing on this document was authorized by Miguelangel A. Saucedo P.E. 121992
Date: 11/11/22

OWNER:
Clint Peltier
Clint Peltier Custom Homes
979-481-4840

PLAN: _____
PROFILE: _____
HORIZONTAL: _____
VERTICAL: _____

BAYOU BEND ESTATES
ANGLETON, TEXAS
PLANS FOR
GRADING, PAVING, UTILITIES
AND DETENTION

DRIVEWAY CONSTRUCTION DETAILS
SL-27

PROJECT NO. 13454

HYPER-CHLORINATED WATER NOTES

1. HYPER-CHLORINATED WATER SHALL NOT BE DISCHARGED TO THE STORM SEWER OR DRAINAGE SYSTEM UNLESS THE CHLORINE CONCENTRATION IS REDUCED TO 4 PPM OR LESS BY CHEMICALLY TREATING THE DECHLORINATE OR BY ONSITE RETENTION UNTIL NATURAL ATTENUATION OCCURS.
2. DISCHARGE OF HIGH FLOW RATE AND VELOCITIES SHALL BE DIRECTED TO VELOCITY DISSIPATION DEVICES.
3. CHLORINE CAN BURN VEGETATION, SO IT SHOULD NOT BE USED TO WATER VEGETATION THAT IS BEING USED FOR STABILIZATION, VEGETATED FILTERS OR BUFFERS, OR OTHER VEGETATION TO BE PRESERVED.
4. HYPER-CHLORINATED WATER MAY BE DISCHARGED TO AN ONSITE RETENTION AREA UNTIL NATURAL ATTENUATION OCCURS. THE AREA MAY BE A DRY STORMWATER RETENTION BASIN, OR A PORTION OF THE SITE MAY BE GRADED TO FORM A TEMPORARY PIT OR BERMED AREA.
5. NATURAL ATTENUATION OF THE CHLORINE MAY BE AIDED BY AERATION. AIR CAN BE ADDED TO THE WATER BY DIRECTING THE DISCHARGE OVER A ROUGH SURFACE BEFORE IT ENTERS THE TEMPORARY RETENTION AREA OR AN AERATION DEVICE CAN BE PLACED IN THE RETENTION AREA.
6. ONSITE DISCHARGE MAY REQUIRE SEVERAL HOURS TO A FEW DAYS BEFORE THE WATER IS SAFE TO DISCHARGE. THE RATE AT WHICH CHLORINE WILL ATTENUATE IS AFFECTED BY SOIL CONDITIONS AND WEATHER CONDITIONS. ATTENUATION WILL OCCUR QUICKEST DURING WARM, SUNNY, AND DRY PERIODS.

SANITARY WASTE NOTES

1. THE CONTRACTOR SHALL PROVIDE AN APPROPRIATE NUMBER OF PORTABLE TOILETS BASED ON THE NUMBER OF EMPLOYEES USING THE TOILETS AND THE HOURS THEY WILL WORK.
2. SANITARY FACILITIES SHALL BE PLACED ON A MINIMUM OF 50 FEET AWAY FROM STORM DRAIN INLETS, CONVEYANCE, CHANNELS OR SURFACE WATERS. IF UNABLE TO MEET THE 50 FOOT REQUIREMENT DUE TO SITE CONFIGURATION, PORTABLE TOILETS SHALL BE A MINIMUM OF 20 FEET AWAY FROM STORM DRAIN INLETS, CONVEYANCE CHANNELS OR SURFACE WATER AND SECONDARY CONTAINMENT SHALL BE PROVIDE IN CASE OF SPILLS. THE LOCATION OF THE PORTABLE TOILETS SHALL BE ACCESSIBLE TO MAINTENANCE TRUCKS WITHOUT DAMAGING EROSION AND SEDIMENT CONTROLS OR CAUSING EROSION OR TRACKING PROBLEMS.
4. SANITARY FACILITIES SHALL BE FULLY ENCLOSED AND DESIGNED IN A MANNER THAT MINIMIZES THE EXPOSURE OF SANITARY WASTE TO PRECIPITATION AND STORMWATER RUNOFF.
5. WHEN HIGH WINDS ARE EXPECTED, PORTABLE TOILETS SHALL BE ANCHORED OR OTHERWISE SECURED TO PREVENT THEM FROM BEING BLOWN OVER.
6. THE COMPANY THAT SUPPLIES AND MAINTAINS THE PORTABLE TOILETS SHALL BE NOTIFIED IMMEDIATELY IF A TOILET IS TIPPED OVER OR DAMAGED IN A WAY THAT THE RESULTS IN A DISCHARGE. DISCHARGED SOLID MATTER SHALL BE VACUUMED INTO A SEPTIC TRUCK BY THE COMPANY THAT MAINTAINS THE TOILETS.
7. THE OPERATOR OF THE MUNICIPAL SEPARATE STORM SEWER SYSTEM (MS4) SHALL BE NOTIFIED IF A DISCHARGE FROM THE PORTABLE TOILETS ENTERS THE MS4 OR A NATURAL CHANNEL.
8. SANITARY FACILITIES SHALL NOT BE PERMITTED ON PUBLIC SIDEWALKS, STREETS OR INLETS.

DEBRIS AND TRASH NOTES

1. ALL WASTE SOURCES AND STORAGE AREAS SHALL BE LOCATED A MINIMUM OF 50 FEET AWAY FROM INLETS, SWALES, DRAINAGE WAYS, CHANNELS AND OTHER WATERS, IF THE SITE CONFIGURATION PROVIDES SUFFICIENT SPACE TO DO SO. IN NO CASE SHALL MATERIAL AND WASTE SOURCES BE CLOSER THAN 20 FROM INLETS, SWALES, DRAINAGE WAYS, CHANNELS, AND OTHER WATERS.
2. CONSTRUCTION WASTE AND TRASH SHALL BE STORED IN A MANNER THAT MINIMIZES ITS EXPOSURE TO PRECIPITATION AND STORMWATER RUNOFF.
3. WHENEVER POSSIBLE, MINIMIZE PRODUCTION OF DEBRIS AND TRASH.
4. INSTRUCT CONSTRUCTION WORKERS IN PROPER DEBRIS AND TRASH STORAGE AND HANDLING PROCEDURES.
5. SEGREGATE POTENTIAL HAZARDOUS WASTE FROM NON-HAZARDOUS CONSTRUCTION SITE DEBRIS.
6. PROHIBIT LITTERING BY WORKERS AND VISITORS.
7. POLICE SITE DAILY FOR LITTER AND DEBRIS.
8. ENFORCE SOLID WASTE HANDLING AND STORAGE PROCEDURES.
9. IF FEASIBLE, RECYCLE CONSTRUCTION AND DEMOLITION DEBRIS SUCH AS WOOD, METAL, AND CONCRETE.
10. TRASH AND DEBRIS SHALL BE REMOVED FROM THE SITE AT REGULAR INTERVALS THAT ARE SCHEDULED TO EMPTY CONTAINERS WHEN THEY ARE 90 PERCENT FULL OR MORE FREQUENTLY.
11. GENERAL CONSTRUCTION DEBRIS MAY BE HAULED TO A LICENSED CONSTRUCTION DEBRIS LANDFILL.
12. USE WASTE AND RECYCLING HAULERS/FACILITIES APPROVED BY THE LOCAL MUNICIPALITY.
13. CHIPPING OF TREES AND BRUSH FOR USE SUCH AS MULCH IS PREFERRED ALTERNATIVE TO OFFSITE DISPOSAL.
14. NO WASTE, TRASH, OR DEBRIS SHALL BE BURIED, BURNED OR OTHER WISE DISPOSED OF ONSITE.
15. CLEARLY MARK ON ALL DEBRIS AND TRASH CONTAINERS WHICH MATERIALS ARE ACCEPTABLE. FOREMAN AND/OR CONSTRUCTION SUPERVISOR SHALL MONITOR ONSITE SOLID WASTE STORAGE AND DISPOSAL PROCEDURES DAILY.

CONCRETE SAWCUTTING WASTE NOTES

1. DURING SAWCUTTING OPERATIONS, THE SLURRY AND CUTTINGS SHALL BE CONTINUOUSLY VACUUMED OR OTHERWISE RECOVERED AND NOT BE ALLOWED TO DISCHARGE FROM THE SITE.
2. IF THE PAVEMENT TO BE CUT IS NEAR A STORM DRAIN INLET, THE INLET SHALL BE BLOCKED BY SANDBAGS OR EQUIVALENT TEMPORARY MEASURES TO PREVENT THE SLURRY FROM ENTERING THE INLET. REMOVE THE SANDBAGS IMMEDIATELY AFTER COMPLETING SAWCUTTING OPERATIONS, SO THEY DO NOT CAUSE DRAINAGE PROBLEMS DURING STORM EVENTS.
3. SLURRY AND CUTTINGS SHALL NOT BE ALLOWED TO REMAIN ON THE PAVEMENT TO DRY OUT
4. DEVELOP PRE-DETERMINED, SAFE SLURRY DISPOSAL AREAS.
5. COLLECTED SLURRY AND CUTTINGS SHOULD BE IMMEDIATELY HAULED FROM THE SITE FOR DISPOSAL AT A WASTE FACILITY. IF THIS IS NOT POSSIBLE, THE SLURRY AND CUTTINGS SHALL BE DISCHARGED INTO ONSITE CONTAINMENT.
6. THE ONSITE CONTAINMENT MAY BE EXCAVATED OR BERMED PIT LINED WITH PLASTIC MINIMUM OF 10 MILIMETERS THICK. IF THE PROJECT INCLUDES PLACEMENT OF NEW CONCRETE, SLURRY FROM SAWCUTTING MAY BE DISPOSED OF IN FACILITIES DESIGNATED FOR THE WASHOUT OF CONCRETE TRUCKS INSTEAD CONSTRUCTING A SEPARATE CONTAINMENT.
7. THE CONTAINMENT SHALL BE LOCATED A MINIMUM OF 50 FEET AWAY FROM INLETS, SWALES, DRAINAGE WAYS, CHANNELS, AND OTHER WATERS, IF THE SITE CONFIGURATION PROVIDES SUFFICIENT SPACE TO DO SO. IN NO CASE SHALL THE COLLECTION AREA BE CLOSER THAN 20 FEET FROM INLETS, SWALES, DRAINAGE WAYS, CHANNELS AND OTHER WATERS.
8. SEVERAL, PORTABLE, PRE-FABRICATED, CONCRETE WASHOUT, COLLECTION BASINS ARE COMMERCIALY AVAILABLE AND ARE AN ACCEPTABLE ALTERNATIVE TO AN ONSITE CONTAINMENT PIT.
9. REMOVE WASTER CONCRETE WHEN THE CONTAINMENT IS HALF FULL. ALWAYS MAINTAIN A MINIMUM OF ONE FOOT FREEBOARD.
10. ONSITE EVAPORATION OF SLURRY WATER AND RECYCLING OF THE CONCRETE WASTE IS THE PREFERRED DISPOSAL METHOD. WHEN THIS IS NOT FEASIBLE, DISCHARGE FROM THE COLLECTION AREA SHALL ONLY BE ALLOWED IF A PASSIVE TREATMENT SYSTEM IS USED TO REMOVE THE FINES. MECHANICAL MIXING IS REQUIRED IN THE COLLECTION AREA. THE pH MUST BE TESTED, AND DISCHARGED IS ALLOWED IN IF THE pH DOES NOT EXCEED 8.0. THE pH MAY BE LOWERED BY ADDING SULFURIC ACID TO THE SLURRY WATER.
11. CARE SHALL BE EXERCISED WHEN TREATING THE SLURRY WATER FOR DISCHARGE. MONITORING MUST BE IMPLEMENTED TO VERIFY THAT DISCHARGES FROM THE COLLECTION AREA DO NOT VIOLATE GROUNDWATER OR SURFACE WATER QUALITY STANDARDS.
12. GEOTEXTILE FABRICS SUCH AS THOSE USED FOR SILT FENCE SHOULD NOT BE USED TO CONTROL SAWCUTTING WASTE, SINCE THE GRAIN SIZE IS SIGNIFICANTLY SMALLER THAN THE APPARENT OPENING SIZE OF THE FABRIC.

SPILL AND LEAK RESPONSE NOTES


1. RECORDS OF RELEASES THAT EXCEED THE REPORTABLE QUANTITY (RQ) FOR OIL AND HAZARDOUS SUBSTANCES SHOULD BE MAINTAINED IN ACCORDANCE WITH THE FEDERAL AND STATE REGULATIONS.
2. EMERGENCY CONTACT INFORMATION AND SPILL RESPONSE PROCEDURES SHALL BE POSTED IN A READILY AVAILABLE REA FOR ACCESS BY ALL EMPLOYEES AND SUBCONTRACTORS.
3. SPILL CONTAINMENT KITS SHOULD BE MAINTAINED FOR PETROLEUM PRODUCTS AND OTHER CHEMICALS THAT ARE REGULARLY ONSITE. MATERIALS IN KITS SHOULD BE BASED ON CONTAINMENT GUIDELINES IN THE MATERIALS SAFETY AND DATA SHEETS (MSDSS) FOR THE SUBSTANCE MOST FREQUENTLY ONSITE.
4. SPILL KITS ARE INTENDED FOR RESPONSE TO SMALL SPILLS, TYPICALLY LESS THAN 5 GALLONS, OF SUBSTANCES THAT ARE NOT EXTREMELY HAZARDOUS.
5. SIGNIFICANT SPILLS OR OTHER RELEASES WARRANT IMMEDIATE RESPONSE BY TRAINED PROFESSIONALS.
6. SUSPECTED JOB-SITE CONTAMINATION SHOULD BE IMMEDIATELY REPORTED TO REGULATORY AUTHORITIES AND PROTECTIVE ACTIONS TAKEN.
7. THE CONTRACTOR SHOULD BE REQUIRED TO DESIGNATE A SITE SUPERINTENDENT, FOREMAN, SAFETY OFFICER, OR OTHER SENIOR PERSON WHO IS ONSITE DAILY TO BE THE SPILL AND LEAK RESPONSE COORDINATOR (SLRC) AND MUST HAVE KNOWLEDGE OF AND BE TRAINED IN CORRECT SPILL AND LEAK RESPONSE PROCEDURES.

SUBGRADE STABILIZATION NOTES

1. MINIMIZE THE DISCHARGE OF THE CHEMICAL STABILIZERS BY THE CONTRACTOR LIMITING THE AMOUNT OF STABILIZING AGENT ONSITE TO THAT WHICH CAN BE THOROUGHLY MIXED AND COMPACTED BY THE END OF EACH WORKDAY.
2. STABILIZERS SHALL BE APPLIED AT RATES THAT RESULT IN NO RUN OFF.
3. STABILIZATION SHALL NOT OCCUR IMMEDIATELY BEFORE AND DURING RAINFALL EVENTS.
4. NO TRAFFIC OTHER THAN WATER TRUCKS AND MIXING EQUIPMENT SHALL BE ALLOWED TO PASS OVER THE AREA BEING STABILIZED UNTIL AFTER COMPLETION OF MIXING THE CHEMICAL.
5. AREA ADJACENT AND DOWNSTREAM OF STABILIZED AREAS SHALL BE ROUGHENED TO INTERCEPT CHEMICAL RUNOFF AND REDUCE RUNOFF VELOCITY.
6. GEOTEXTILE FABRICS SUCH AS THOSE USED FOR SILT FENCE SHOULD NOT BE USED TO TREAT CHEMICAL RUNOFF, BECAUSE THE CHEMICALS ARE DISSOLVED IN THE WATER AND WON'T BE AFFECTED BY A BARRIER AND THE SUSPENDED SOLIDS ARE SIGNIFICANTLY SMALLER THAN THE APPARENT OPENING SIZE OF THE FABRIC.
7. IF SOIL STABILIZERS ARE STORED ONSITE, THEY SHALL BE CONSIDERED HAZARDOUS MATERIAL AND SHALL BE MANAGED ACCORDING TO THE CRITERIA OF CHEMICAL MANAGEMENT TO CAPTURE ANY ACCIDENTAL LIME OR CHEMICAL OVERFLOW.
8. THE CONTRACRTOR SHALL INSTALL BMP'S TO ALL INLETS AND OPENINGS CONNECTED TO THE STORM SEWER SYSTEMS TO PREVENT LIME FROM ENTERING THE MS4 SYSTEM.

SANDBLASTING WASTE NOTES



1. THE CONTRACTOR SHOULD BE REQUIRED TO DESIGNATE THE SITE SUPERINTENDENT, FOREMAN, OR OTHER PERSON WHO IS RESPONSIBLE FOR SANDBLASTING TO ALSO BE RESPONSIBLE FOR SANDBLASTING WASTE MANAGEMENT.
2. PROHIBIT THE DISCHARGE OF SANDBLASTING WASTE.
3. USE ONLY INERT, NON-DEGRADABLE SANDBLAST MEDIA.
4. USE APPROPRIATE EQUIPMENT FOR THE JOB; DO NOT OVER-BLAST.
5. WHENEVER POSSIBLE, BLAST IN A DOWNWARD DIRECTION.
6. CEASE BLASTING ACTIVITIES IN HIGH WINDS OR IF WIND DIRECTION COULD TRANSPORT GRIT TO DRAINAGE FACILITIES.
7. INSTALL DUST SHIELDING AROUND SANDBLASTING AREAS.
8. COLLECT AND DISPOSE OF ALL SPENT SANDBLAST GRIT, USE DUST CONTAINMENT FABRICS AND DUST COLLECTION HOPPERS AND BARRELS.
9. NON-HAZARDOUS SANDBLAST GRIT MAY BE DISPOSED IN PERMITTED CONSTRUCTION DEBRIS LANDFILLS OR PERMITTED SANITARY LANDFILLS.
10. IF SANDBLAST MEDIA CANNOT BE FULLY CONTAINED, CONSTRUCT SEDIMENT TRAPS DOWNSTREAM FROM BLASTING AREA WHERE APPROPRIATE.
11. USE SAND FENCING WHERE APPROPRIATE IN AREAS WHERE BLAST MEDIA CANNOT BE FULLY CONTAINED.
12. IF NECESSARY, INSTALL MISTING EQUIPMENT TO REMOVE SANDBLAST GRIT FROM THE AIR PREVENT RUNOFF FROM MISTING OPERATIONS FROM ENTERING DRAINAGE SYSTEMS.
13. USE VACUUM GRIT COLLECTION SYSTEMS WHERE POSSIBLE.
14. KEEP RECORDS OF SANDBLASTING MATERIALS, PROCEDURES, AND WEATHER CONDITIONS ON A DAILY BASIS.
15. TAKE ALL REASONABLE PRECAUTIONS TO ENSURE THAT SANDBLASTING GRIT IS CONTAINED AND KEPT AWAY FROM DRAINAGE STRUCTURES.
16. SAND BLASTING MEDIA SHOULD ALWAYS BE STORED UNDER COVER AWAY FROM DRAINAGE STRUCTURES.
17. ENSURE THAT STORED MEDIA OR GRIT IS NOT SUBJECTED TO TRANSPORT BY WIND.
18. ENSURE THAT ALL SANDBLASTING EQUIPMENT AND STORAGE CONTAINERS COMPLY WITH CURRENT LOCAL, STATE, AND FEDERAL REGULATIONS.
19. CAPTURE AND TREAT RUNOFF, WHICH COMES INTO CONTACT WITH SANDBLASTING MATERIALS OR WASTE.

No.	DATE	REVISION
SEAL:		
DESIGN ENGINEER: _____ DATE _____		
		
CITY OF SUGAR LAND, TEXAS ENGINEERING DEPARTMENT		
CONSTRUCTION PLANS FOR:		
GENERAL EROSION CONTROL NOTES		
JOB No.: DATE: DESIGNED BY: DRAWN BY: CHECKED BY: SCALE:		SL-33 SHEET OF

RECORD DRAWING

NO.	DATE	DESCRIPTION	APPROVED
REVISIONS			

DESIGNED	MS
DRAWN	BT
CHECKED	
DATE	

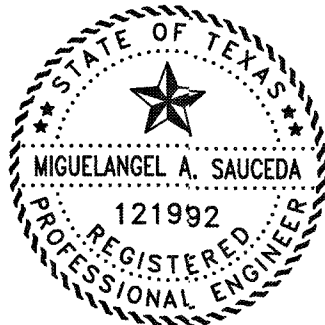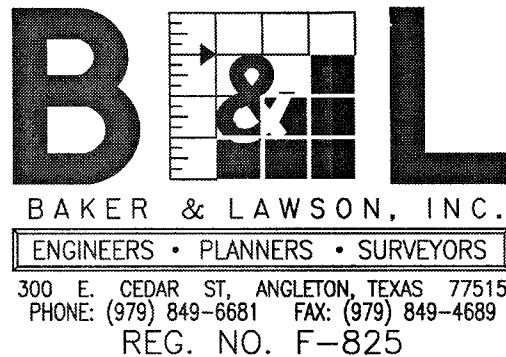

The seal appearing on this document was authorized by Miguelangel A. Saucedo P.E. 121992
Date: 1/11/24



OWNER:
Clint Peltier
Clint Peltier Custom Homes
979-481-4840

PLAN:	_____
PROFILE:	_____
HORIZONTAL:	_____
VERTICAL:	_____



BAYOU BEND ESTATES
ANGLETON, TEXAS
PLANS FOR
GRADING, PAVING, UTILITIES
AND DETENTION

GENERAL EROSION
CONTROL NOTES
SL-33

PROJECT NO. 13454

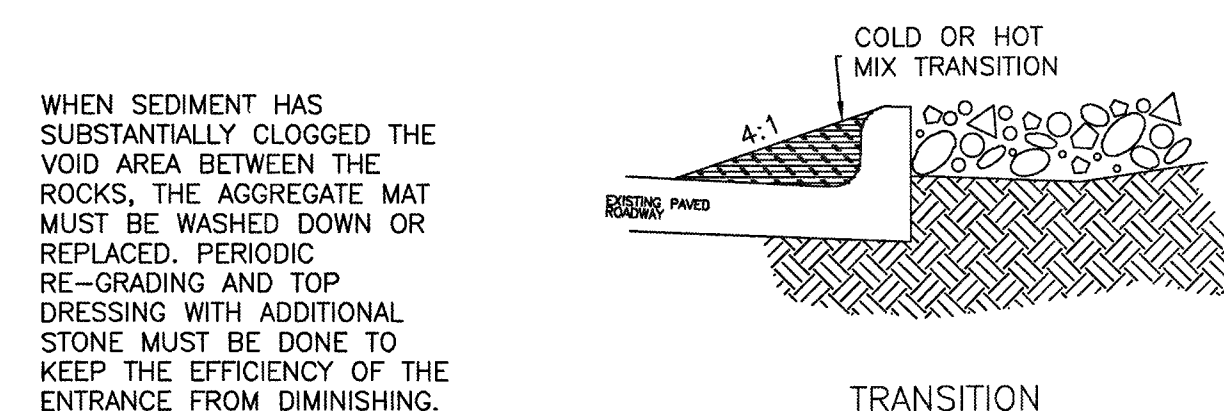
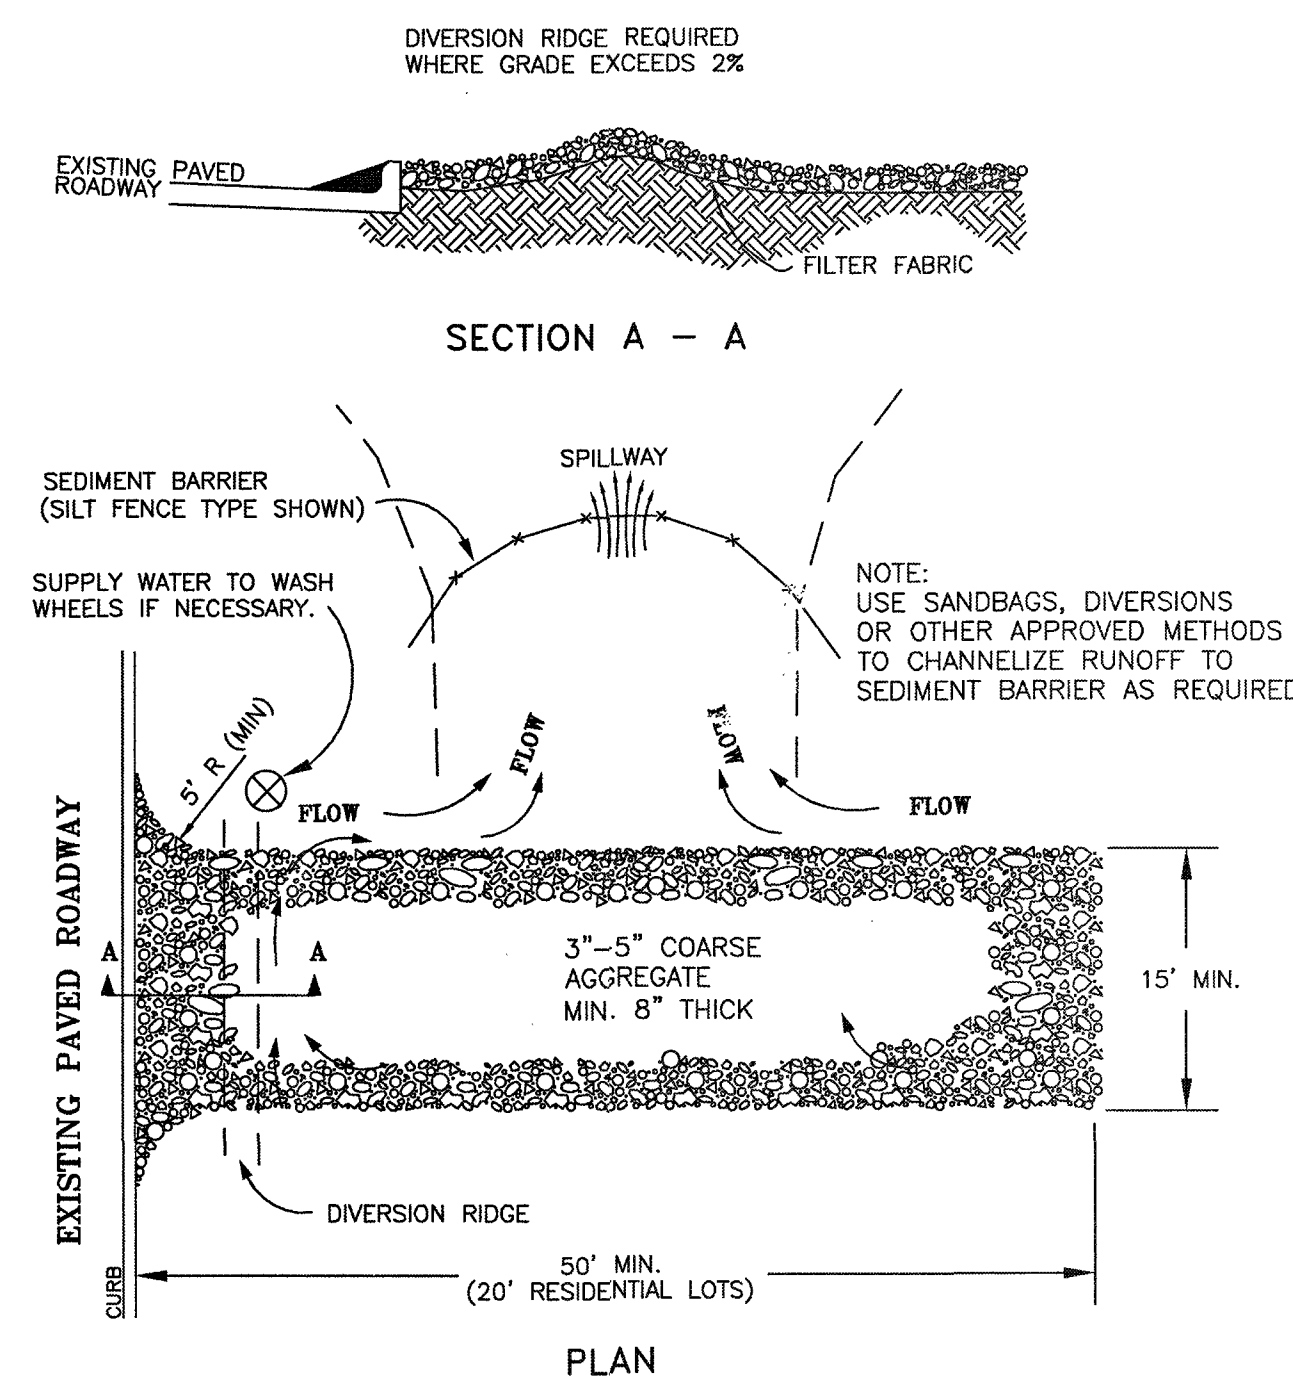


TEMPORARY STONE CONSTRUCTION
ENTRANCE/EXIT -
N.T.S.

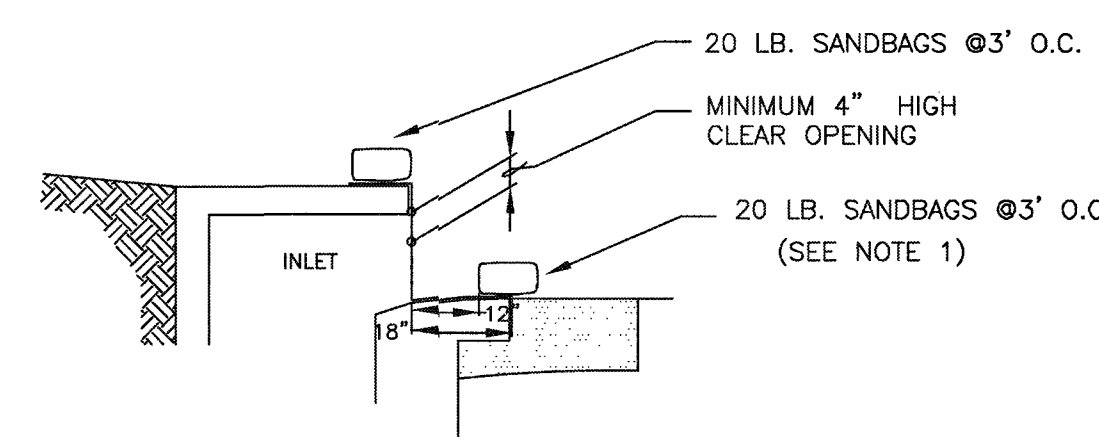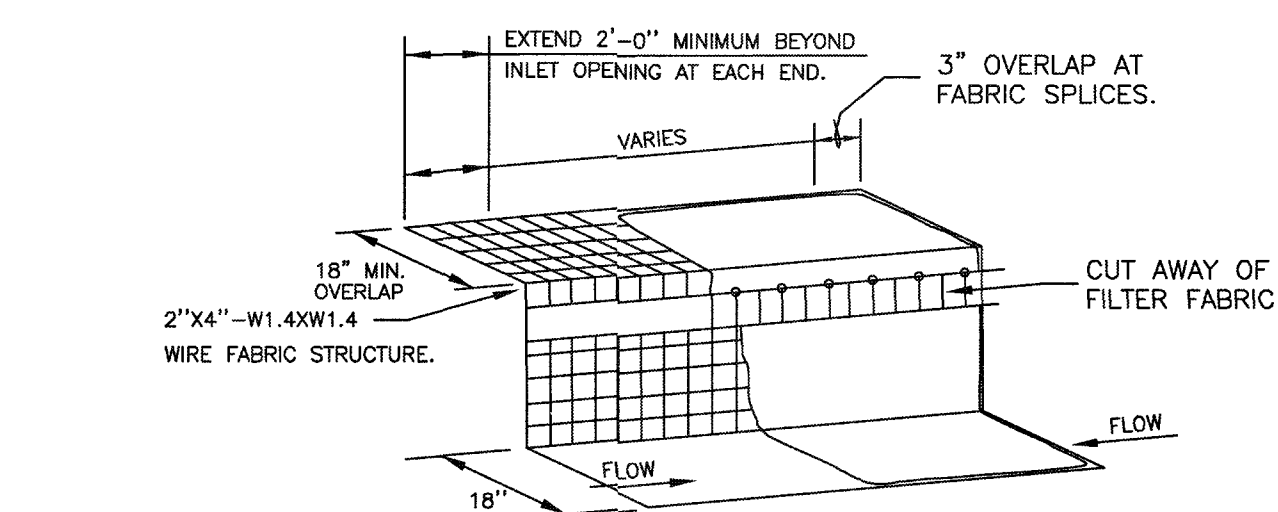


ROCK BERM GENERAL NOTES


1. USE ONLY OPEN GRADED ROCK 4-8 INCHES IN DIAMETER FOR STREAM FLOW CONDITION. USE OPEN GRADED ROCK 3-5 INCHES IN DIAMETER FOR OTHER CONDITIONS.
2. THE ROCK BERM SHALL BE SECURED WITH A WOVEN WIRE SHEATHING HAVING A MAXIMUM OPENING OF 1 INCH AND A MINIMUM WIRE SIZE OF 20 GAUGE AND SHALL BE BURIED IN A TRENCH APPROXIMATELY 3 TO 4 INCHES DEEP.
3. THE ROCK BERM SHALL BE INSPECTED EVERY TWO WEEKS OR AFTER EACH 1/2" RAIN EVENT AND SHALL BE REPLACED WHEN THE STRUCTURE CEASES TO FUNCTION AS INTENDED DUE TO SILT ACCUMULATION AMONG THE ROCKS, WASHOUT, CONSTRUCTION TRAFFIC DAMAGE, ETC.
4. WHEN SILT REACHES A DEPTH EQUAL TO ONE-THIRD OF THE HEIGHT OF THE BERM OR ONE FOOT, WHICHEVER IS LESS, THE SILT SHALL BE REMOVED AND DISPOSED OF PROPERLY.
5. WHEN THE SITE IS COMPLETELY STABILIZED, THE BERM AND ACCUMULATED SILT SHALL BE REMOVED AND DISPOSED OF IN AN APPROVED MANNER.
6. ROCK BERM SHOULD BE USED AS CHECK DAMS FOR CONCENTRATED FLOW AND ARE NOT INTENDED FOR USE IN PERIMETER PROTECTION.

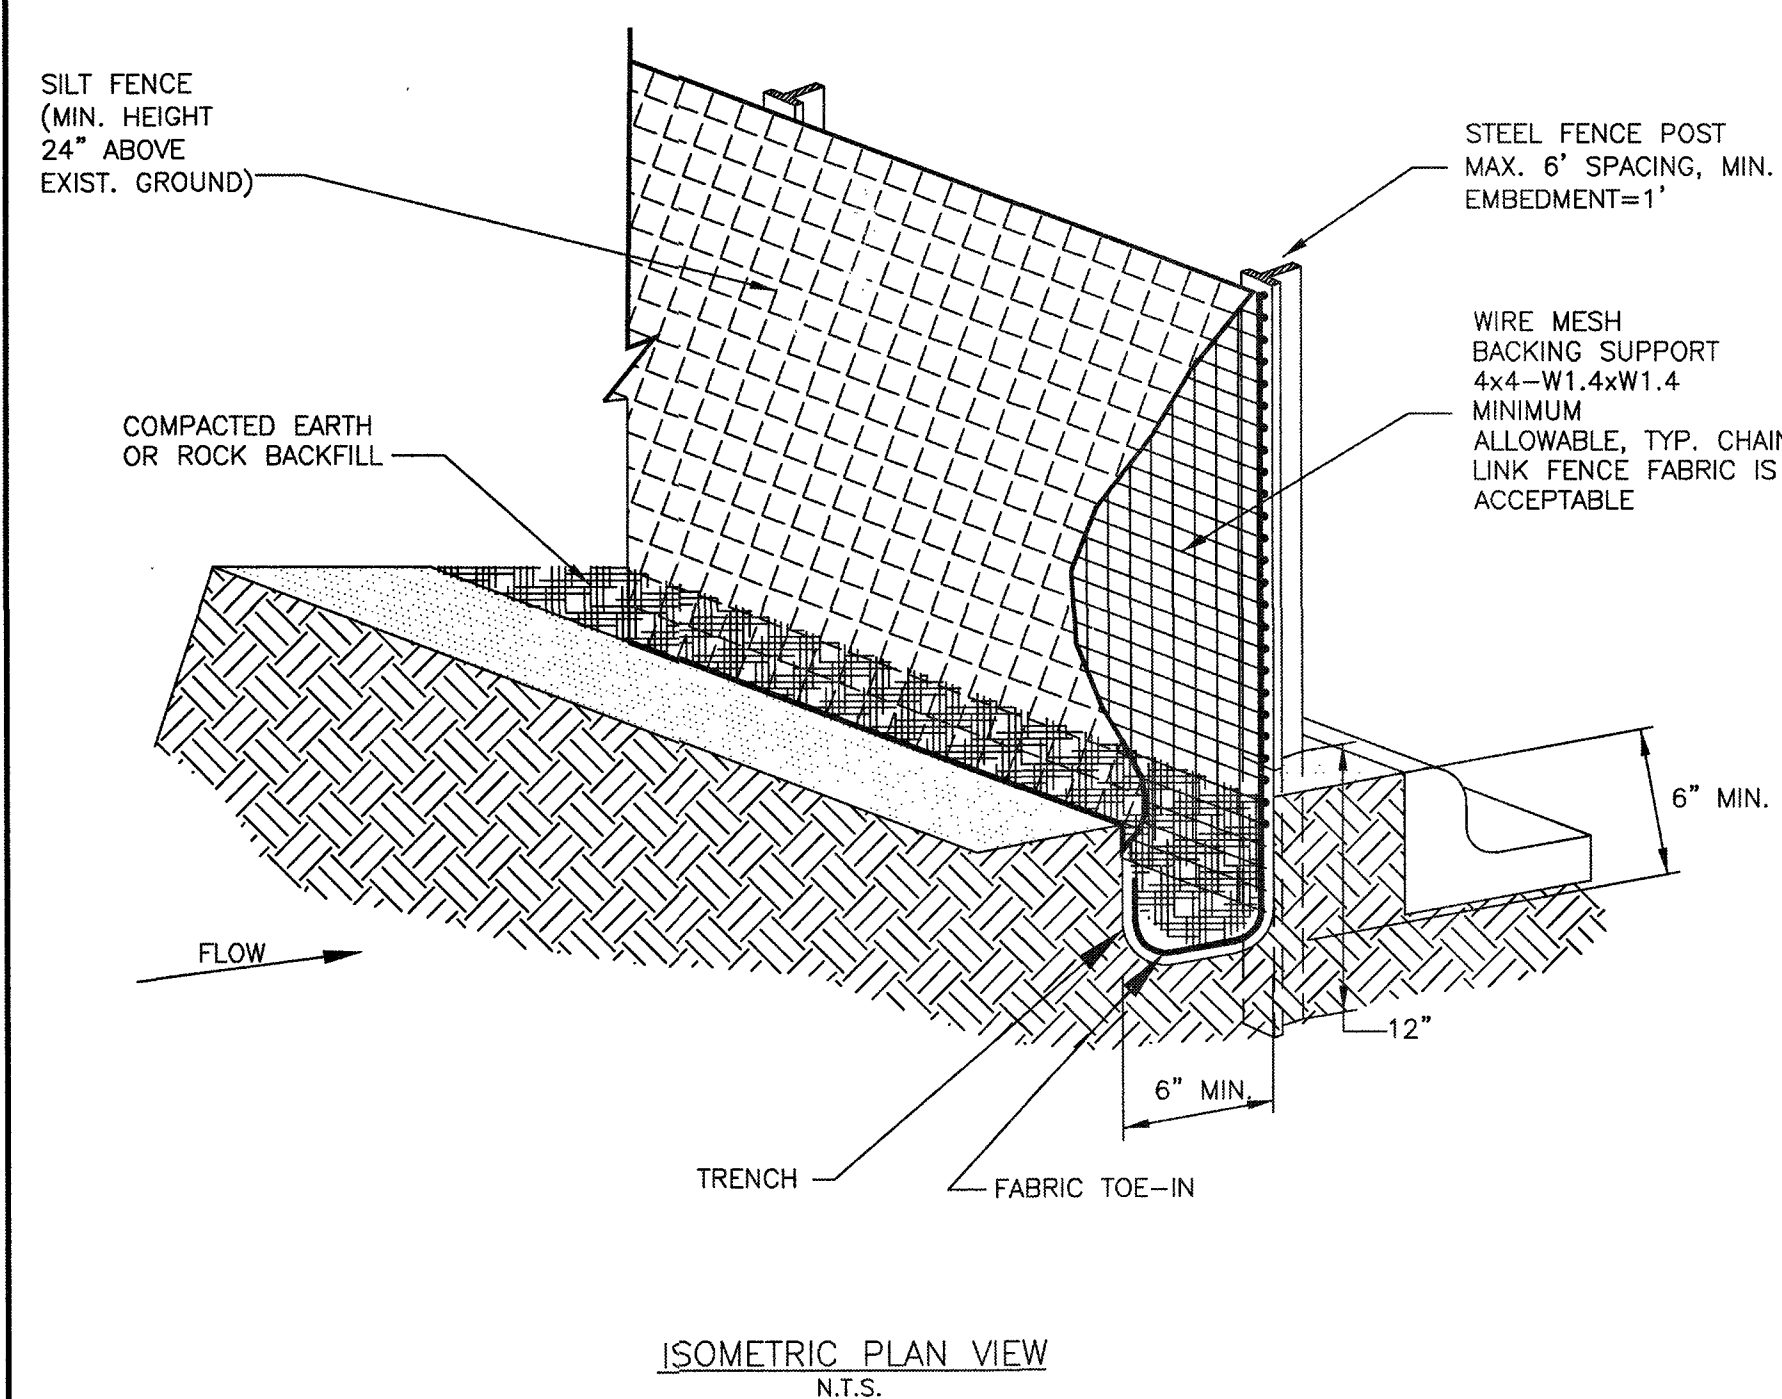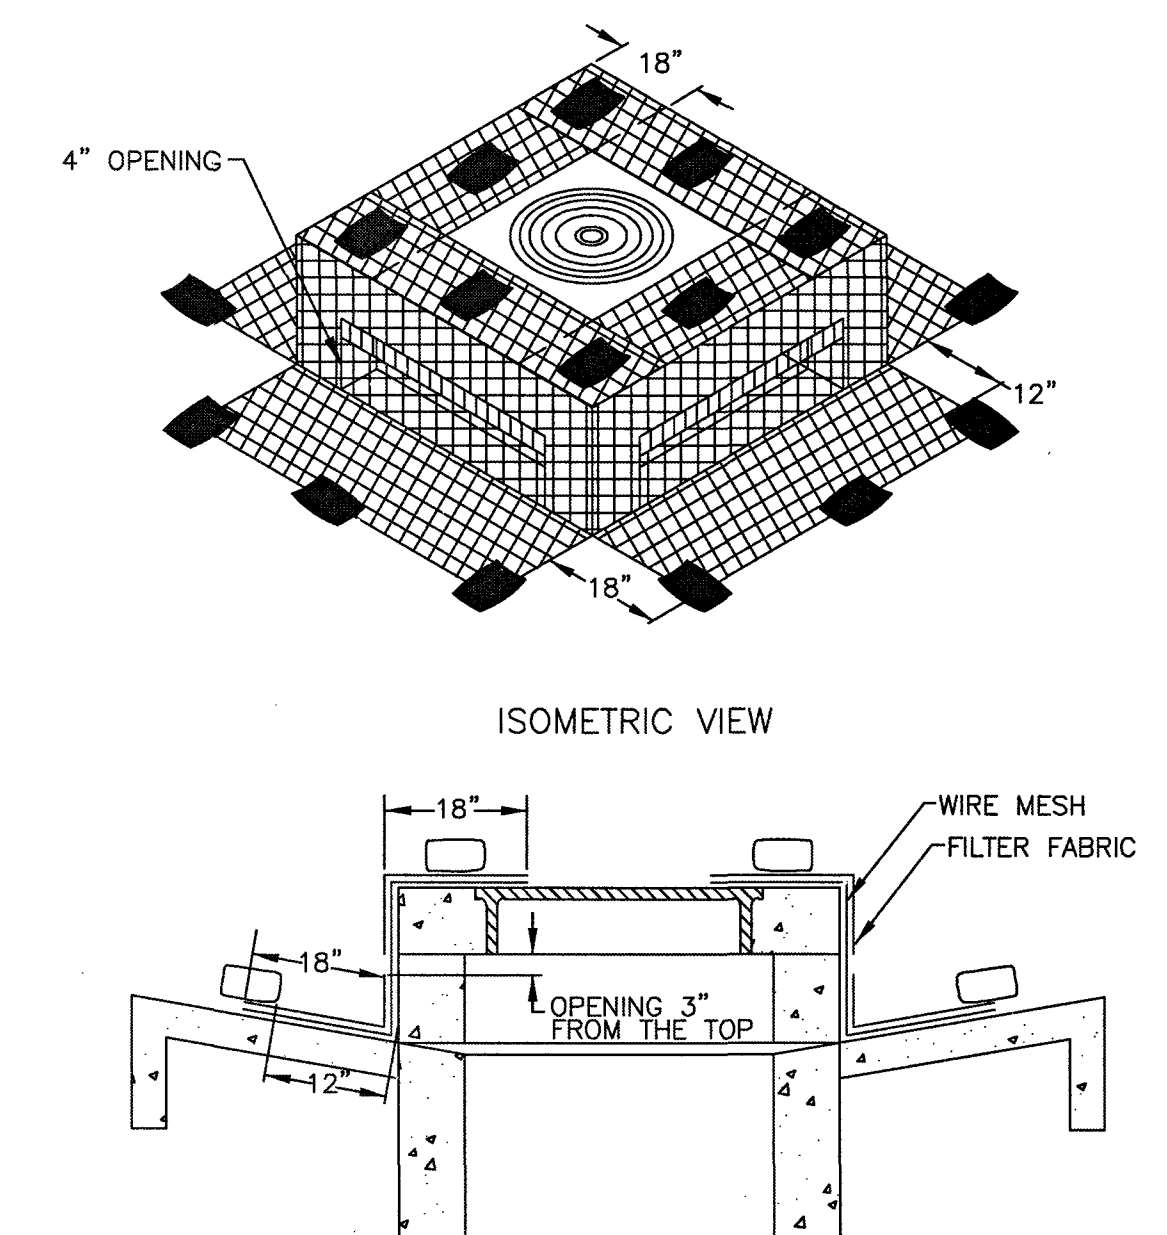



SILT FENCE GENERAL NOTES

1. STEEL POSTS WHICH SUPPORT THE SILT FENCE SHALL BE INSTALLED ON A SLIGHT ANGLE TOWARD THE ANTICIPATED RUNOFF SOURCE. POST MUST BE EMBEDDED A MINIMUM OF ONE FOOT.
2. THE TOE OF THE SILT FENCE SHALL BE TRENCHED IN WITH A SPADE OR MECHANICAL TRENCHER, SO THAT THE DOWNSLOPE FACE OF THE TRENCH IS FLAT AND FIRM. THE TRENCH SHALL BE THE LINE OF FLOW. WHERE FENCE CANNOT BE TRENCHED IN (E.G. PAVEMENT), WEIGHT FABRIC FLAP WITH ROCK ON UPHILL SIDE TO PREVENT FLOW FROM SEEPING UNDER FENCE.
3. THE TRENCH MUST BE A MINIMUM OF 6 INCHES DEEP AND 6 INCHES WIDE TO ALLOW FOR THE SILT FENCE FABRIC TO BE LAID IN THE GROUND AND BACKFILLED WITH COMPACTED MATERIAL.
4. SILT FENCE SHOULD BE SECURELY FASTENED TO EACH STEEL SUPPORT POST OR TO WOVEN WIRE, WHICH IN TURN IS ATTACHED TO THE STEEL FENCE POST. THERE SHALL BE A 3 FOOT OVERLAP, SECURELY FASTENED WHERE ENDS OF FABRIC MEET.
5. INSPECTION SHALL BE MADE EVERY TWO WEEKS AND AFTER EACH 1/2" RAINFALL. REPAIR OR REPLACEMENT SHALL BE MADE PROMPTLY AS NEEDED.
6. SILT FENCE SHALL BE REMOVED WHEN THE SITE IS COMPLETELY STABILIZED SO AS NOT TO BLOCK OR IMPEDE STORM FLOW OR DRAINAGE.
7. ACCUMULATED SILT SHALL BE REMOVED WHEN IT REACHES A DEPTH OF HALF THE HEIGHT OF THE FENCE. THE SILT SHALL BE DISPOSED OF AT AN APPROVED SITE AND IN SUCH A MANNER AS NOT TO CONTRIBUTE TO ADDITIONAL SILTATION.

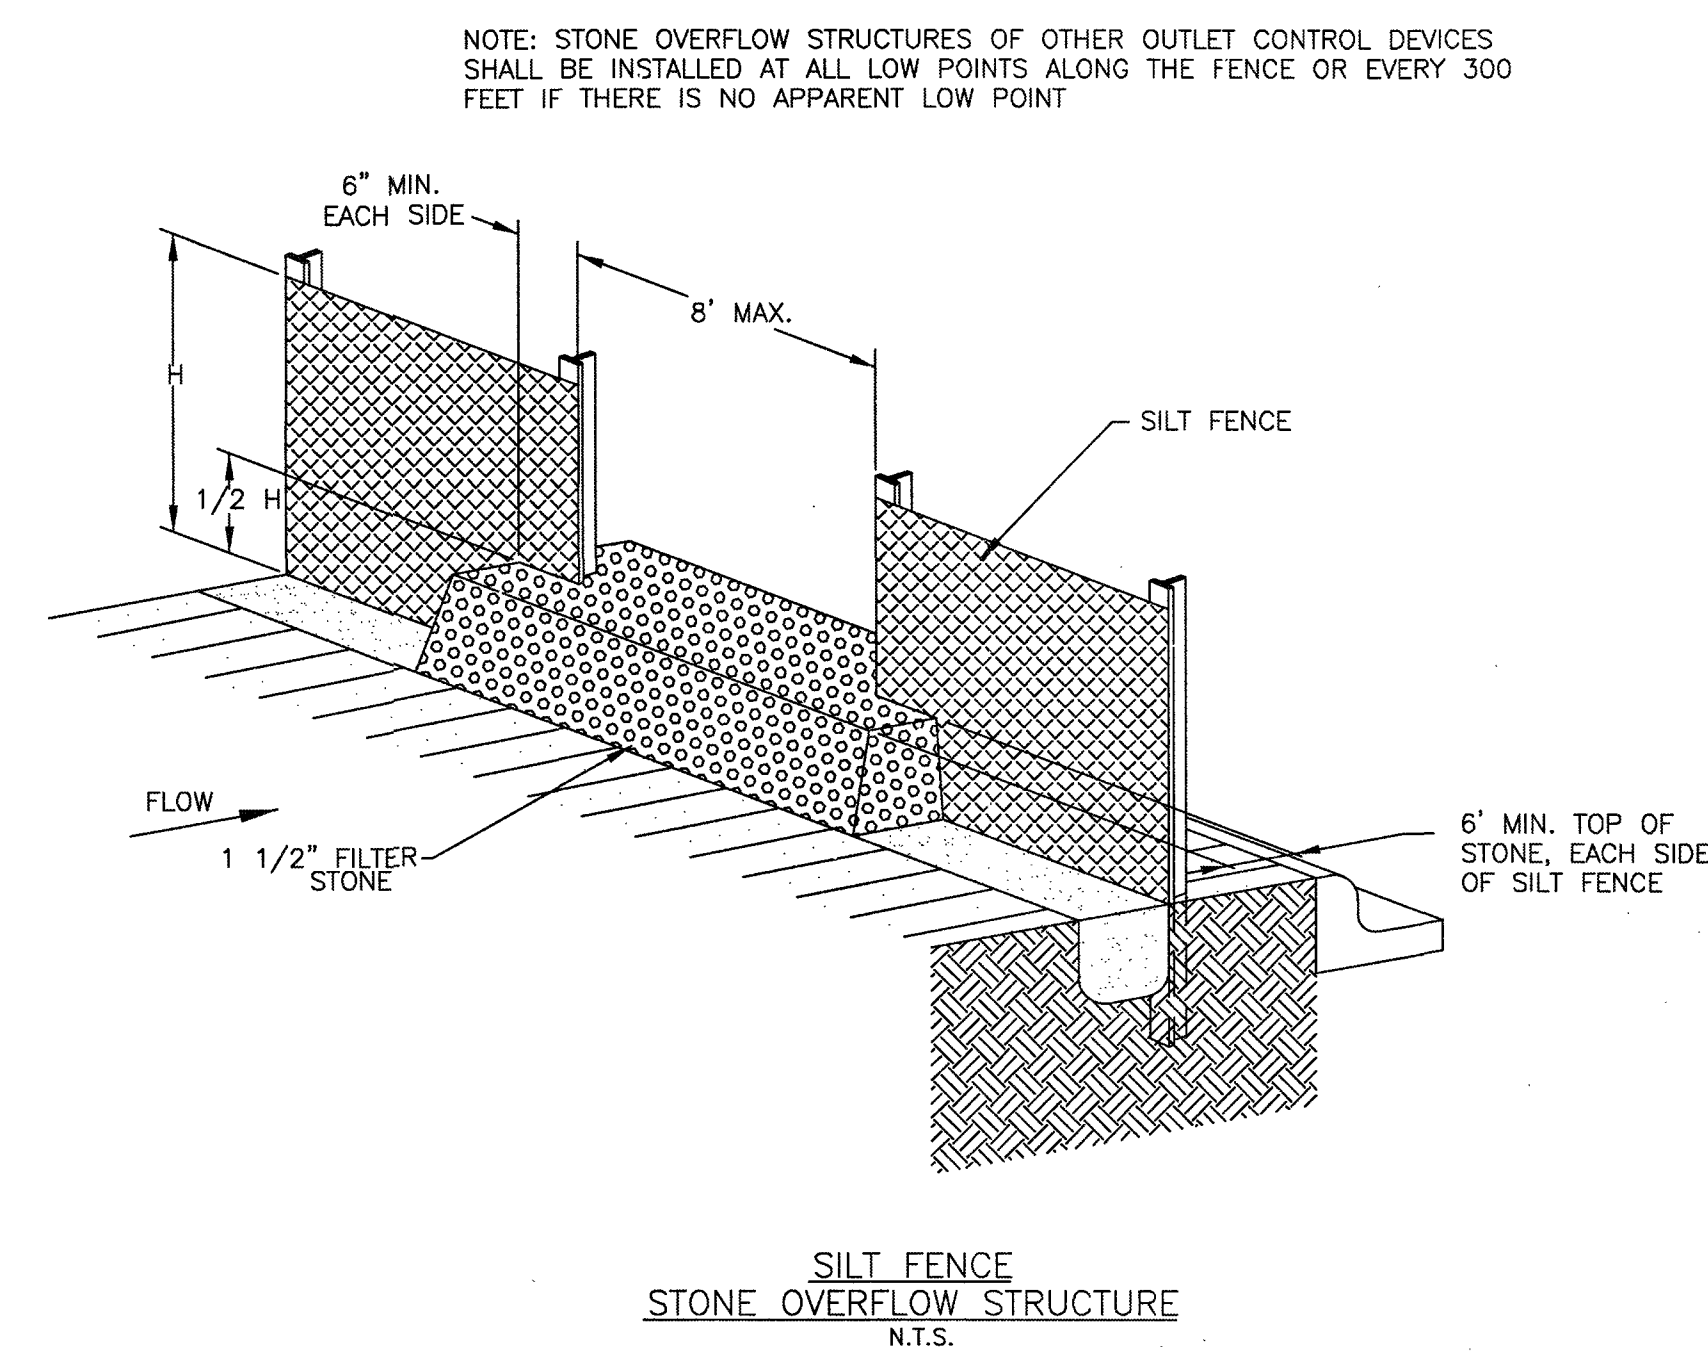

No.	DATE	REVISION			
SEAL:					
_____ DATE _____					
DESIGN ENGINEER:					
					
CITY OF SUGAR LAND, TEXAS ENGINEERING DEPARTMENT					
<u>CONSTRUCTION PLANS FOR:</u>					
EROSION CONTROL DETAILS - 1					
JOB No.: DATE: DESIGNED BY: DRAWN BY: CHECKED BY: SCALE:			SL-34 SHEET OF		

NO.	DATE	DESCRIPTION	APPROVED
REVISIONS			

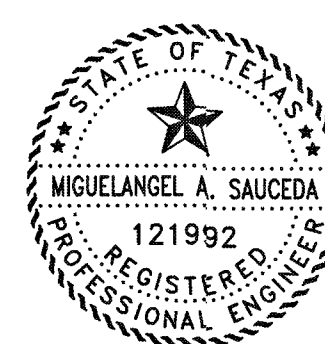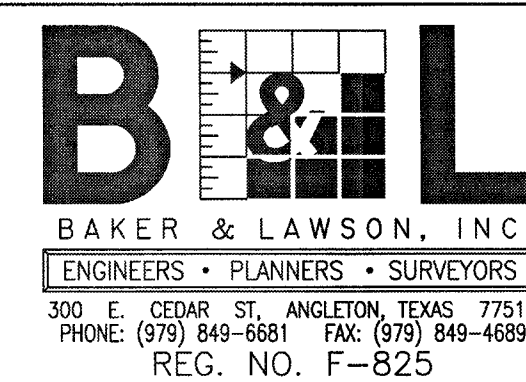

OWNER:
Clint Peltier
Clint Peltier Custom Homes
979-481-4840





PLAN: _____
 PROFILE: _____
 HORIZONTAL: _____
 VERTICAL: _____

**BAYOU BEND ESTATES
ANGLETON, TEXAS
PLANS FOR
GRADING, PAVING, UTILITIES
AND DETENTION**

EROSION CONTROL
DETAILS - 1
SL-34


PROJECT NO. 13454

38

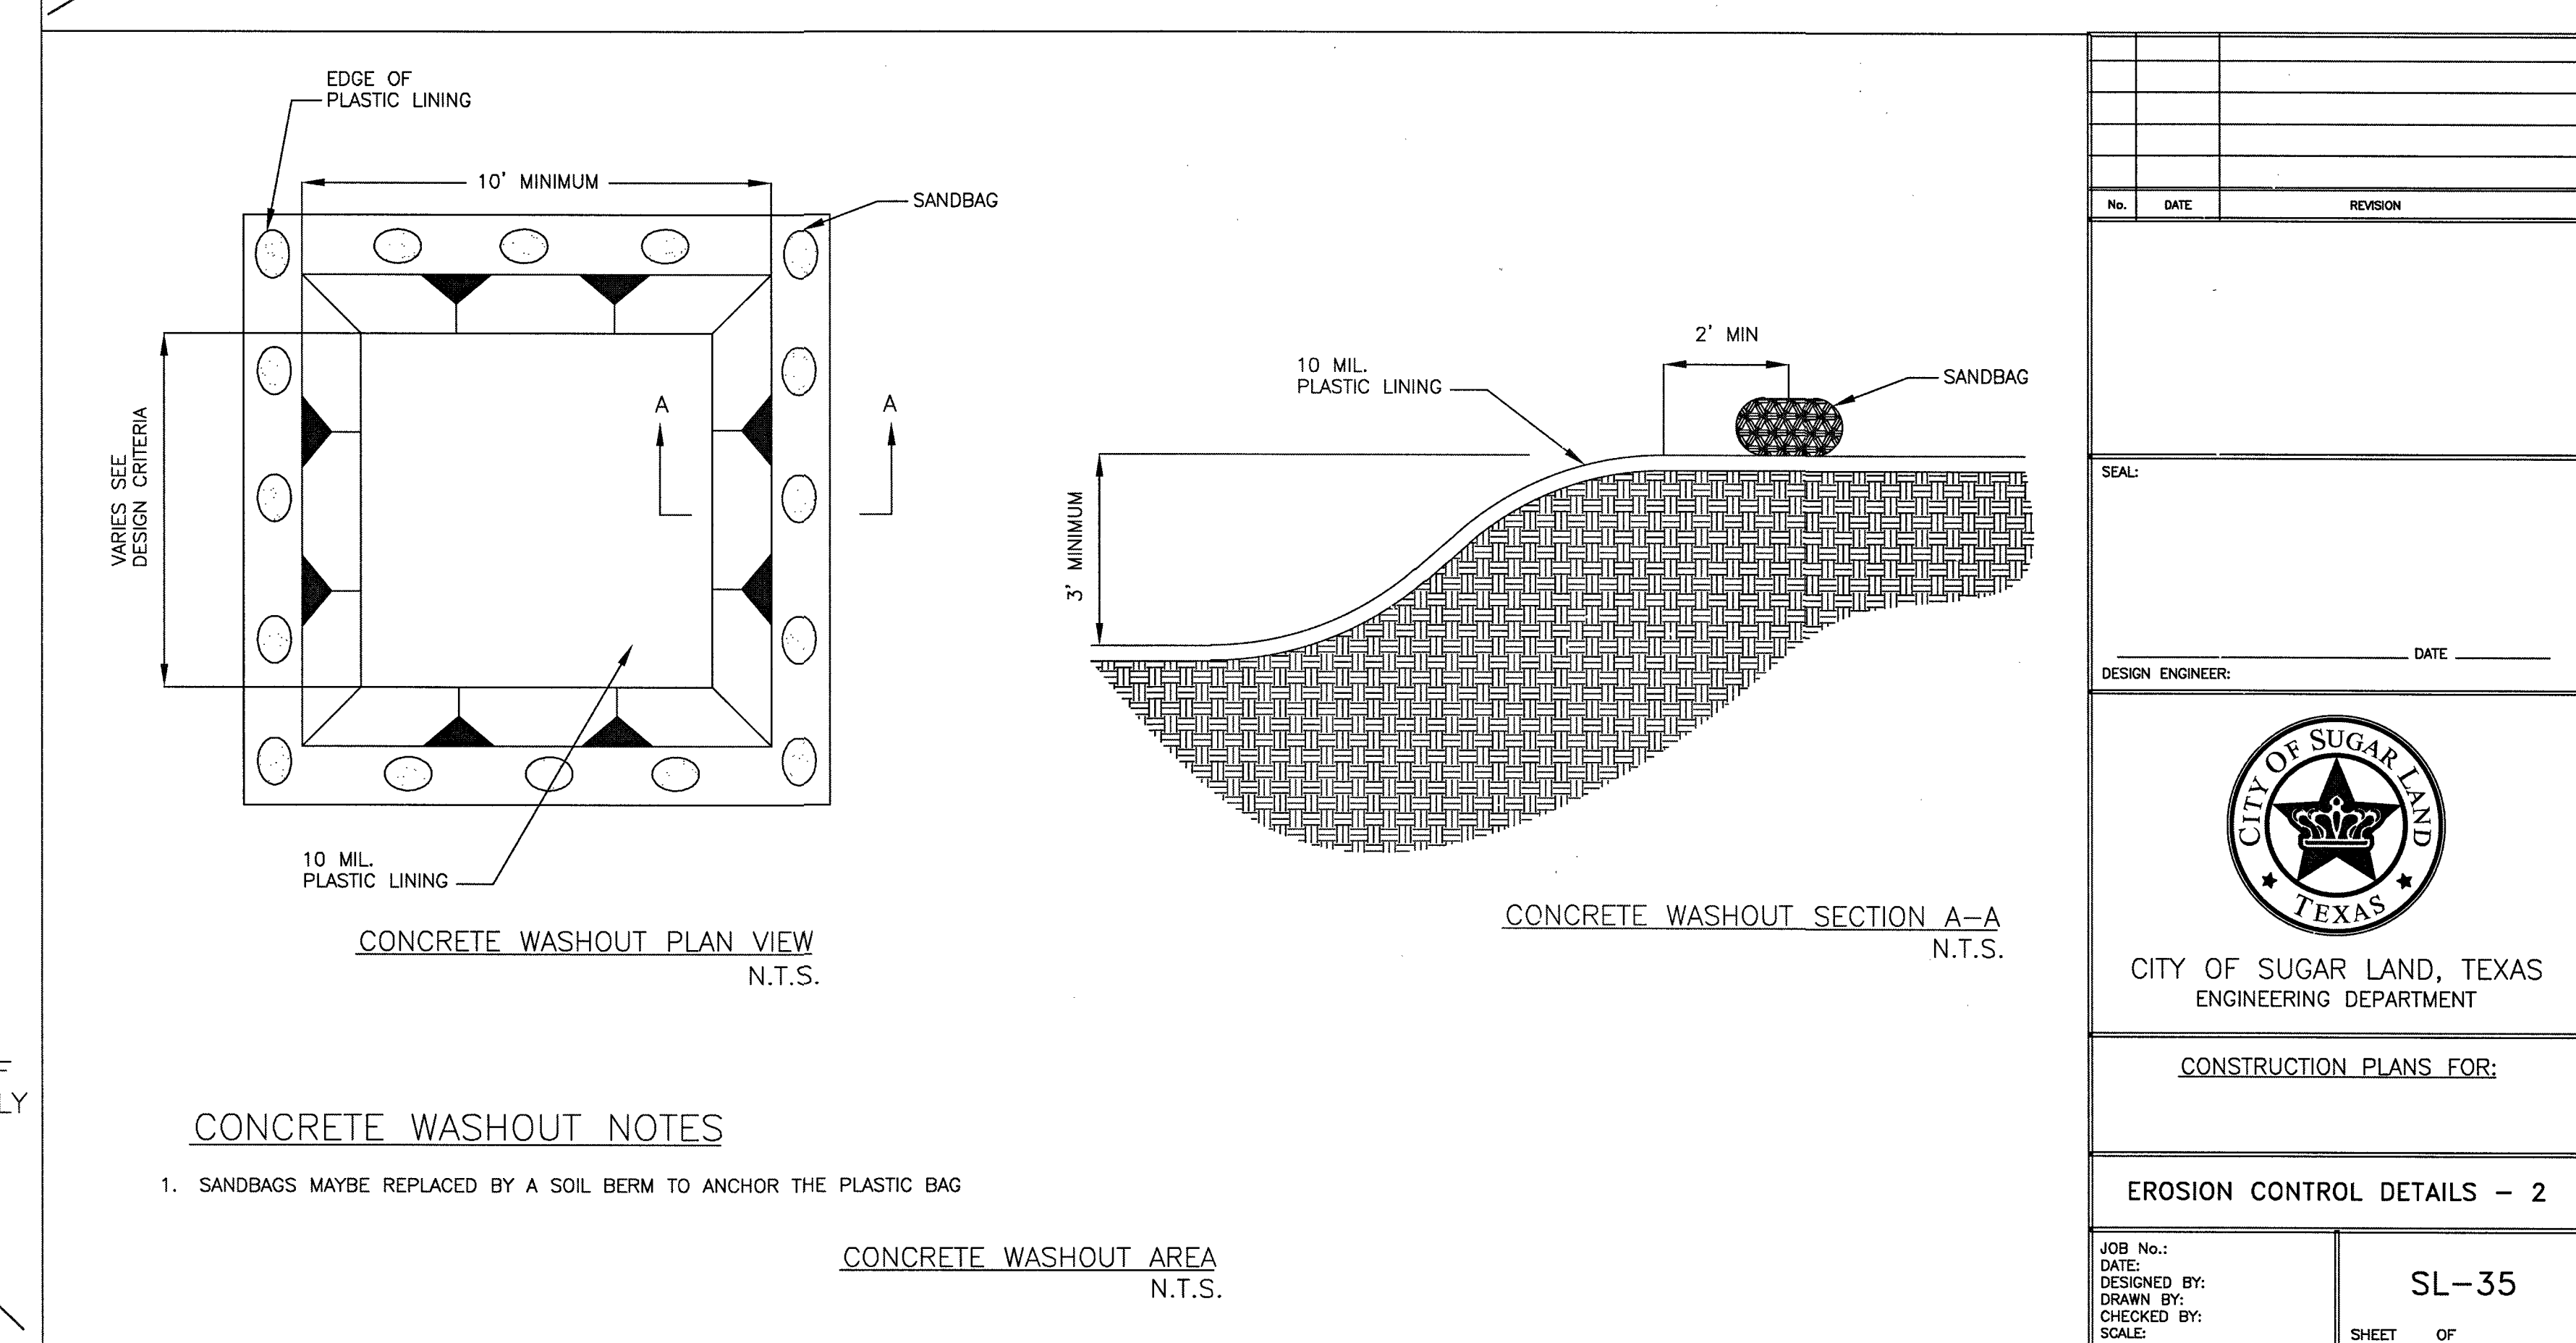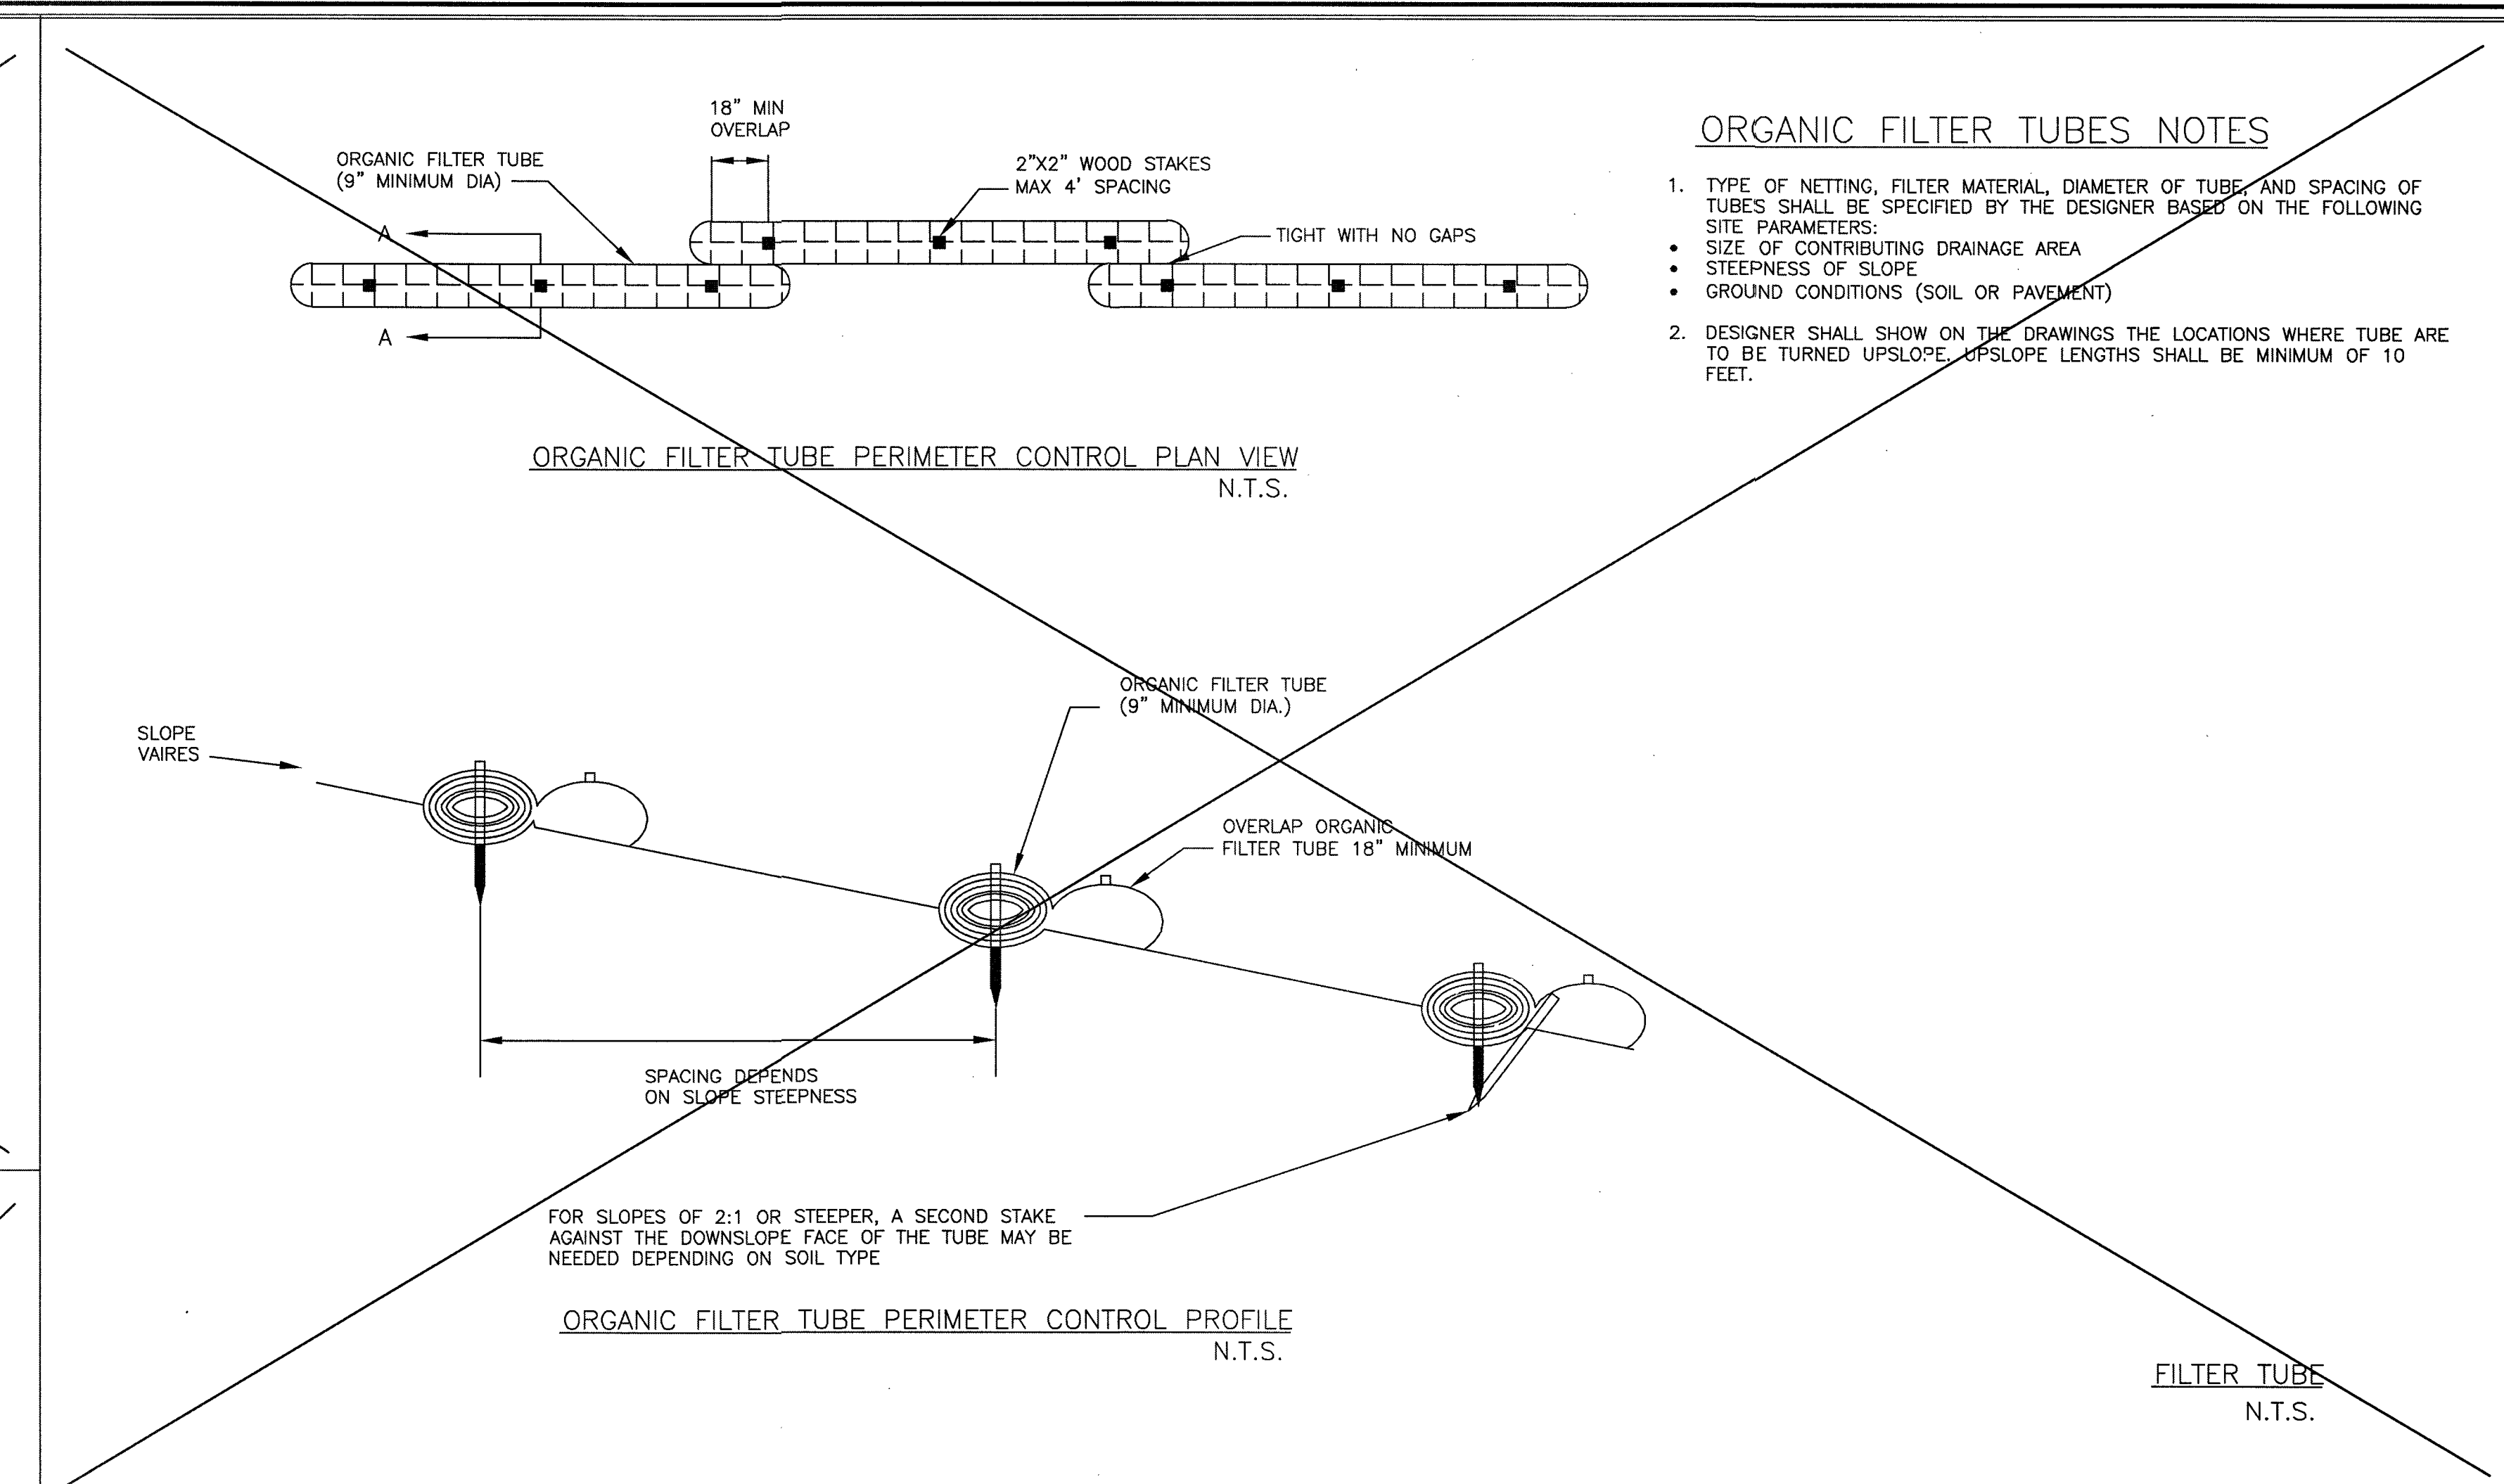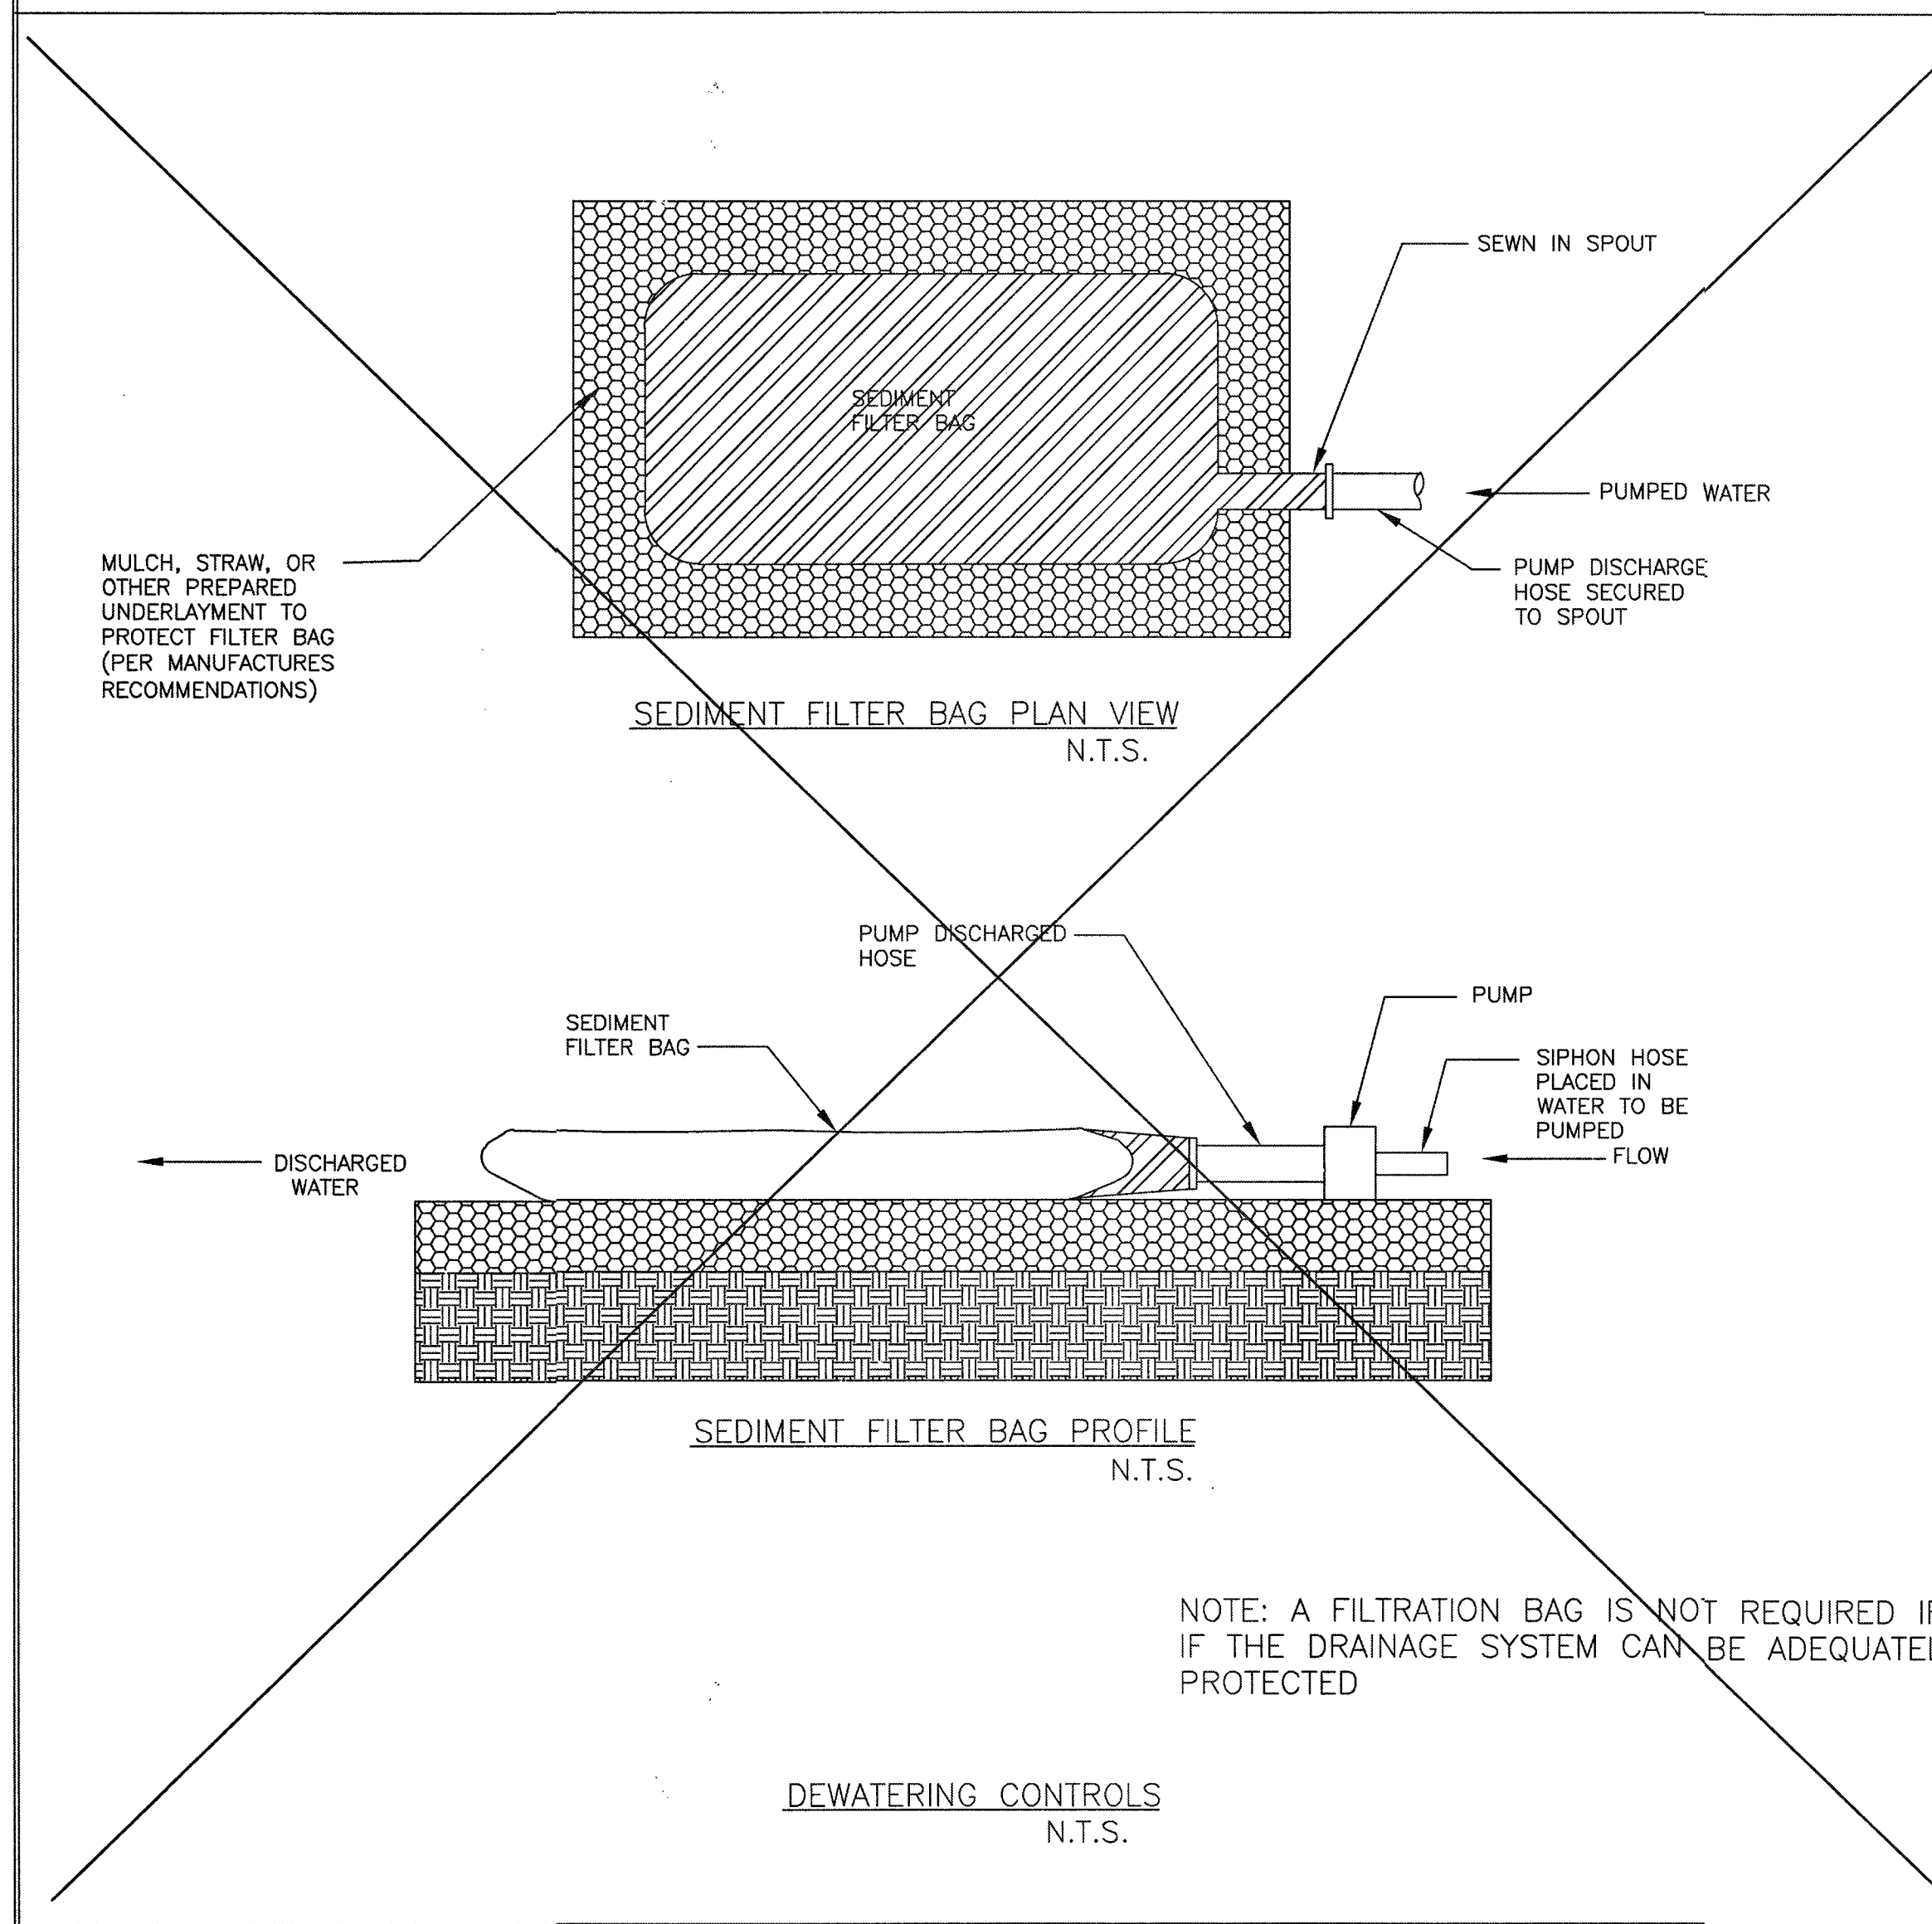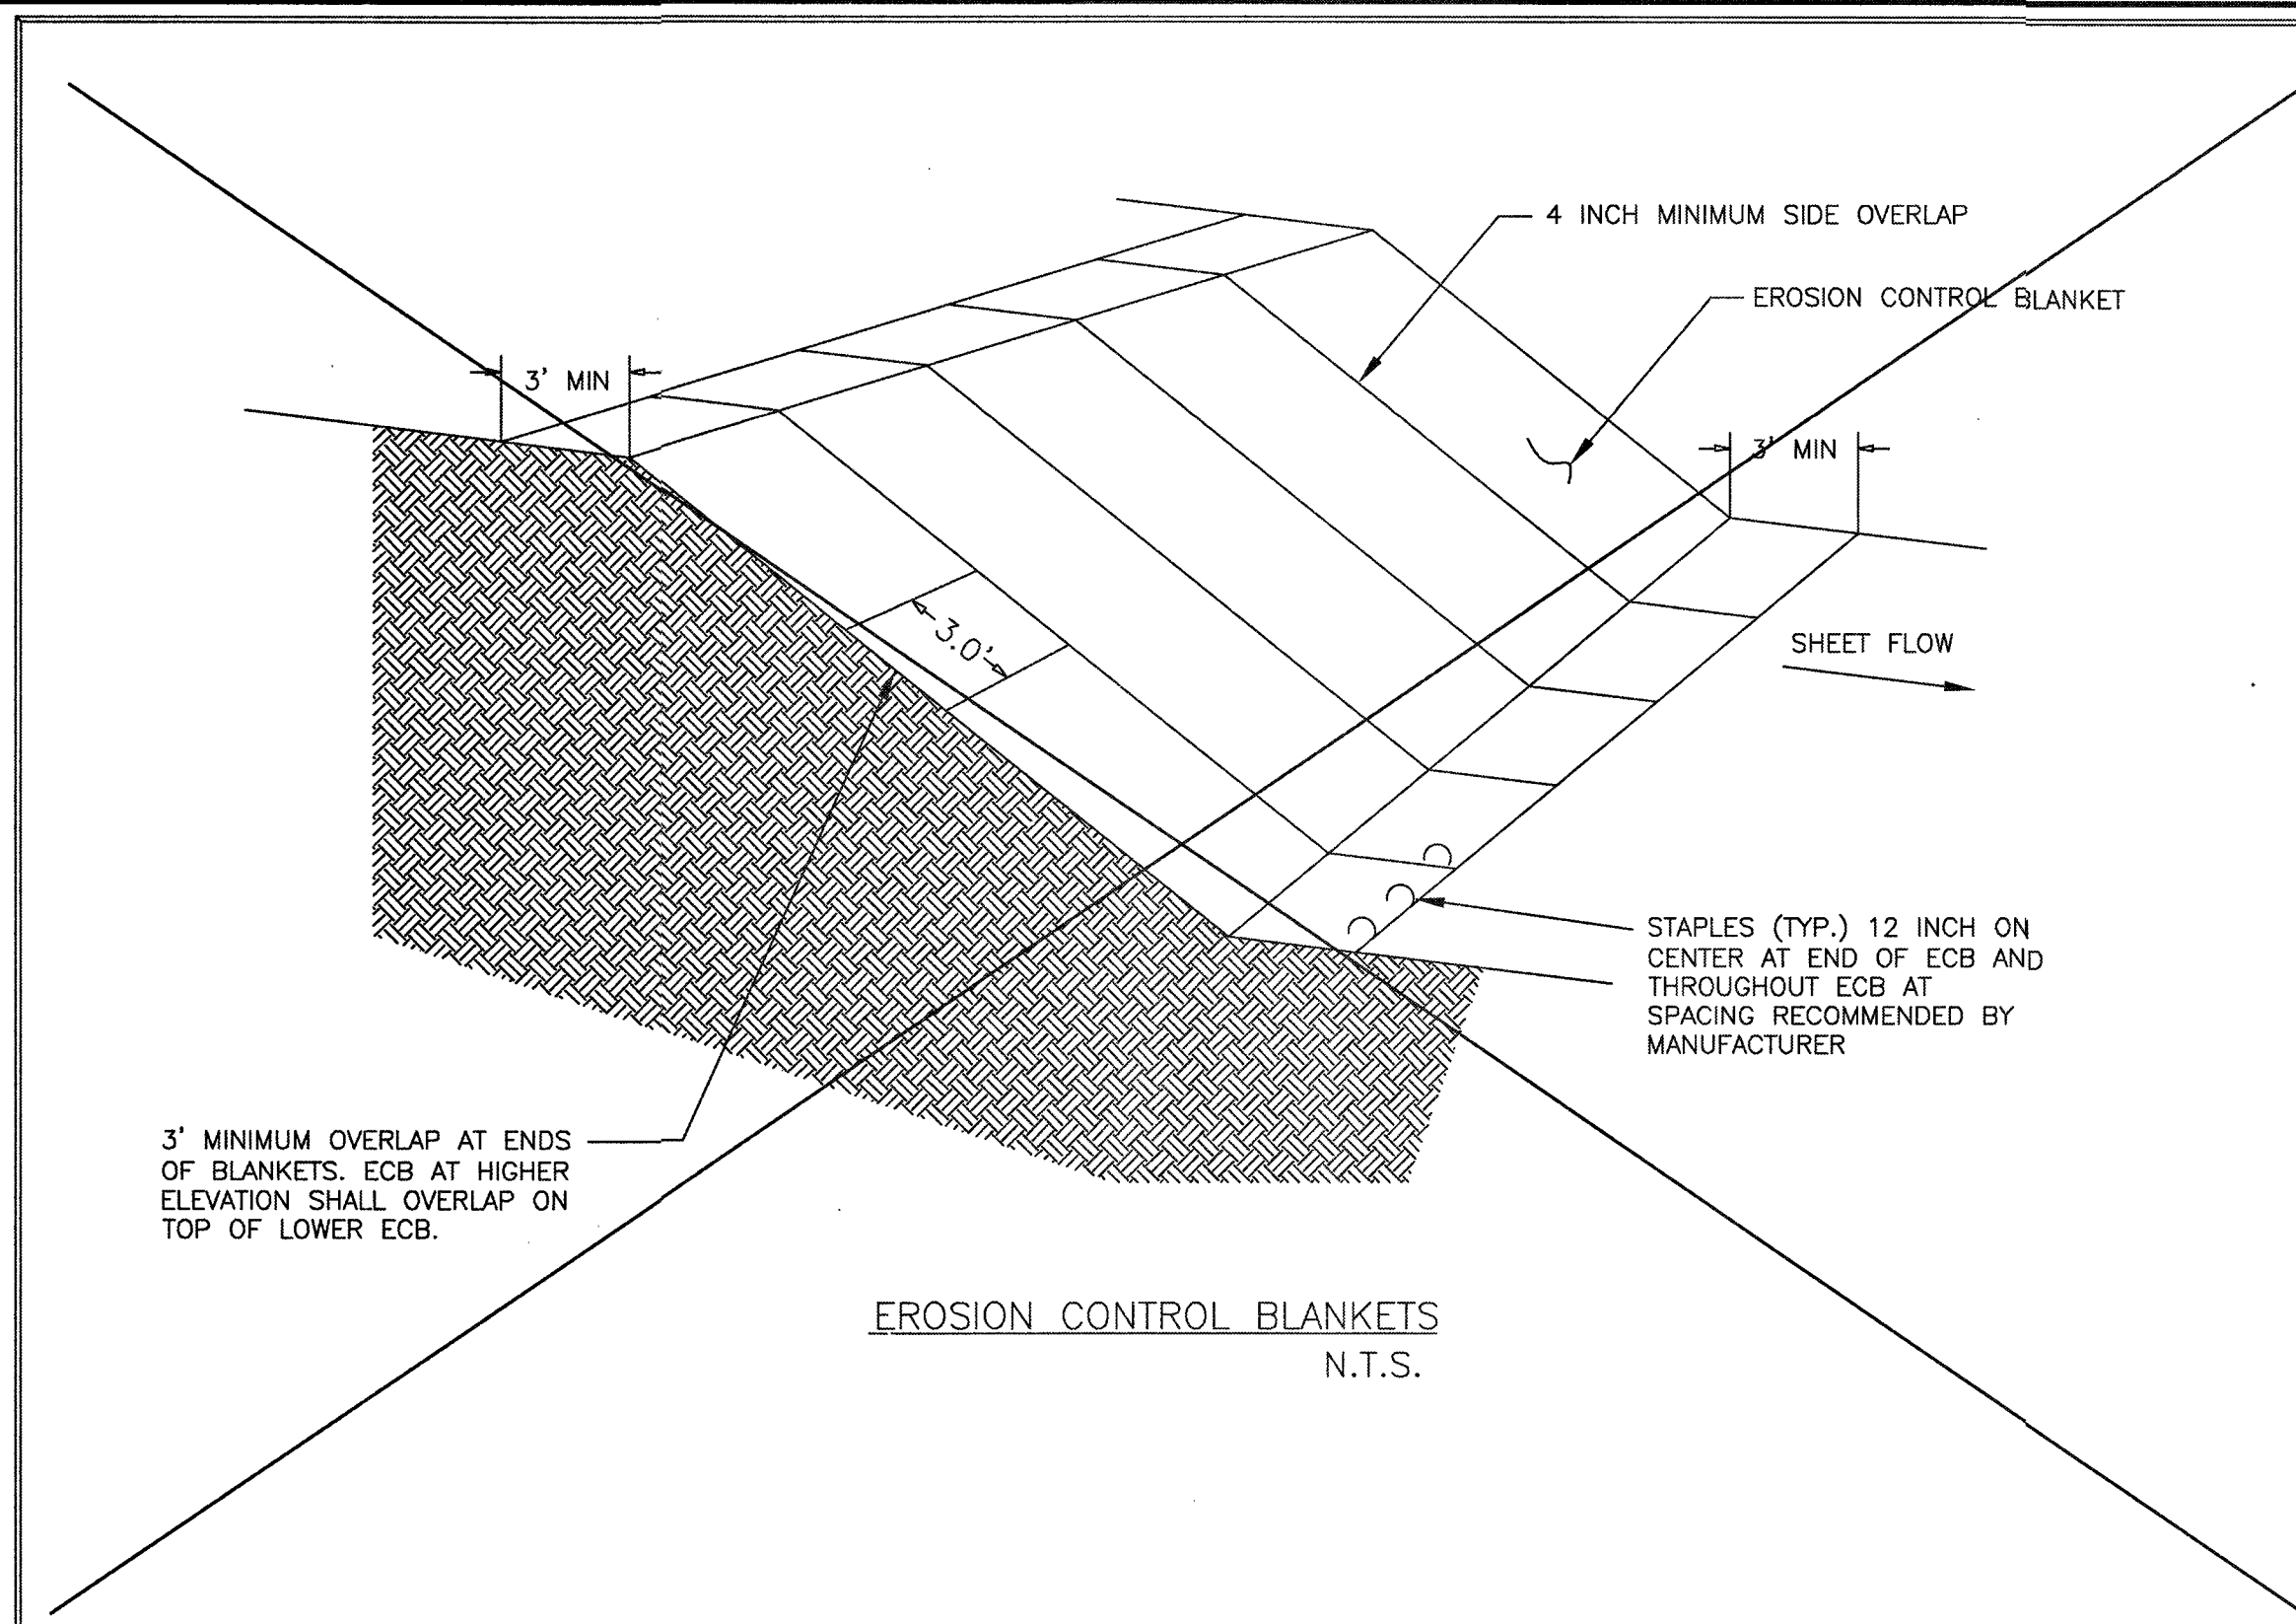



- ORGANIC FILTER TUBES NOTES**
1. TYPE OF NETTING, FILTER MATERIAL, DIAMETER OF TUBE, AND SPACING OF TUBES SHALL BE SPECIFIED BY THE DESIGNER BASED ON THE FOLLOWING SITE PARAMETERS:
 - SIZE OF CONTRIBUTING DRAINAGE AREA
 - STEEPNESS OF SLOPE
 - GROUND CONDITIONS (SOIL OR PAVEMENT)
 2. DESIGNER SHALL SHOW ON THE DRAWINGS THE LOCATIONS WHERE TUBE ARE TO BE TURNED UPSLOPE. UPSLOPE LENGTHS SHALL BE MINIMUM OF 10 FEET.

- CONCRETE WASHOUT NOTES**
1. SANDBAGS MAYBE REPLACED BY A SOIL BERM TO ANCHOR THE PLASTIC BAG

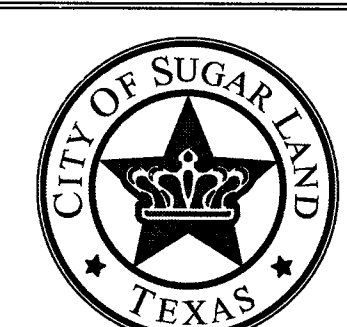NO.	DATE	REVISION
SEAL:		
DESIGN ENGINEER: _____ DATE: _____		
 CITY OF SUGAR LAND, TEXAS ENGINEERING DEPARTMENT		
CONSTRUCTION PLANS FOR:		
EROSION CONTROL DETAILS - 2		
JOB No.: DATE: DESIGNED BY: DRAWN BY: CHECKED BY: SCALE:	SL-35 SHEET OF	

NO.	DATE	DESCRIPTION	APPROVED

DESIGNED MS
 DRAWN BT
 CHECKED _____
 DATE _____

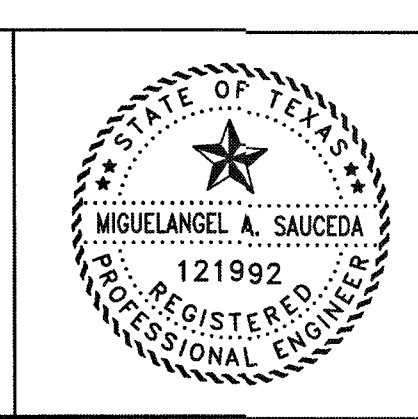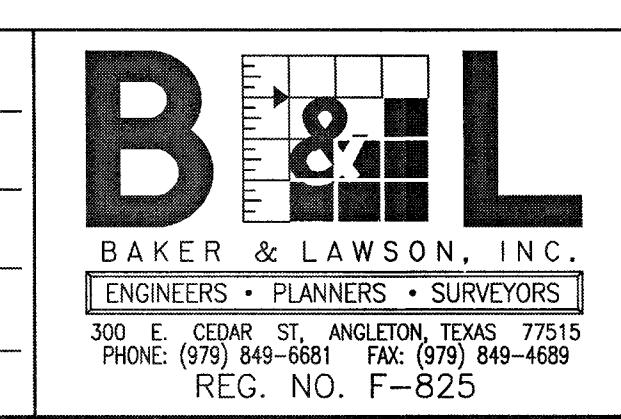

The seal appearing on this document was authorized by Miguelangel A. Saucedo P.E. 121992
 Date: 11/1/22

OWNER:
 Clint Peltier
 Clint Peltier Custom Homes
 979-481-4840

PLAN: _____
 PROFILE: _____
 HORIZONTAL: _____
 VERTICAL: _____

BAYOU BEND ESTATES
ANGLETON, TEXAS
PLANS FOR
GRADING, PAVING, UTILITIES
AND DETENTION

EROSION CONTROL
DETAILS - 2
SL-35
 PROJECT NO. 13454

RECORD DRAWING