



April 19, 2022

Mr. Walter Reeves
Director of Development Services
City of Angleton
121 S. Velasco
Angleton, TX 77515

Re: On-Going Services
Public Improvements Acceptance of Riverwood Ranch Section 2 Subdivision
Angleton, Texas
HDR Job No. 10283980

Dear Mr. Reeves:

HDR Engineering, Inc. (HDR) is in receipt of the request for Public Acceptance of the Riverwood Ranch Section 2 Subdivision public improvements in accordance with the Angleton Land Development Code (LDC) Sec. 23-98 – Public Improvements Acceptance. The following are exceptions noted in review of the Public Acceptance Process Criteria:

1. A Final Inspection walkthrough was performed on April 12, 2022 to review and verify the public improvements were constructed per the approved plat and plans. A Final Inspection report was generated for items to be completed and or corrected. Completion and correction of minor items noted are being coordinated and shall be completed as a condition of the Final Acceptance.
2. During the Final Inspection Walkthrough, a portion of concrete street paving near STA. 4+35 of the left lane on Bennet Loop was noted to have cracking. Public Works has directed the Contractor (Matula & Matula Construction, Inc.) to crack seal this area at this time and that a review of this panel and other street portions shall be provided 1-month prior to the end of maintenance period covered by bonding. Replacement of this concrete panel will be dependent on review of the cracking and if this deficiency has increased over the 1-year period.
3. A pdf set of As-Built (Record Drawing) plans dated April 18, 2022 by the Engineer of Record have been received by the City. It is noted that the proposed sidewalks shall be completed by the Homebuilder as shown on the plans. As a condition of the Final Acceptance, an electronic set of the As-Built plans shall be submitted in a GIS compatible format.
4. Testing reports as noted by Angleton LDC Sec. 23-98 have been received. No additional action is required for these items.
5. A Maintenance Bond has been provided by the Contractor and shall be filed with the City in accordance to the Angleton LDC Sec. 23-98.
6. As a condition of Final Acceptance, the Developer shall provide proof that there are no outstanding judgements or liens against the improvements within the public rights-of-way or against property on which easements contain public improvements.


7. As a condition of Final Acceptance, for the portion of public sidewalks constructed, the Developer shall provide the TDLR certification of compliance with Texas Accessibility Standards per LDC Sec. 23-14. A.5 Sidewalks and Accessibility.
8. A Final Plat, approved and filed with Brazoria County, shall be provided to include with the submitted and attached Record Drawings.

HDR takes no objection for the request of Final Acceptance for Public Improvements for the Riverwood Ranch Section 2 Subdivision with the exceptions noted. Please note that HDR has only reviewed the improvements for consistency with the Final Plat and Construction Plans and the general conformance of public improvements to the City requirements. It is noted that this does not release the Developer of any liability resulting from non-conformance of these items.

If you have any questions, please feel free to contact us at our office (713)-622-9264.

Sincerely,

HDR Engineering, Inc.

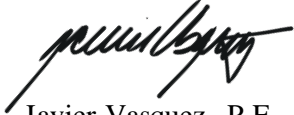

Javier Vasquez, P.E., CFM
City Engineer Representative

cc: Files (10283980)

ENGINEER'S CERTIFICATE OF COMPLETION

Project: RIVERWOOD RANCH SUBDIVISION, SECTION 2
DOWNING STREET
ANGLETON TEXAS

Owner: JOHN SANTASIERO
RIVERWAY PROPERTIES
1027 YALE STREET
HOUSTON, TEXAS 77008

Type of Facilities Constructed:
PAVING, GRADING, UTILITIES AND DRAINAGE
FOR RIVERWOOD RANCH, SECTION 2

Contractor: JAMES MICHAEL MURPHY
MATULA & MATULA CONSTRUCTION, INC.
122 WEST WAY SUITE 325
LAKE JACKSON TEXAS 77566
JMMURPHY@MATULAINC.COM
979-480-0030

Consulting Engineer: DOUGLAS B. ROESLER, P.E.
BAKER & LAWSON ENGINEER
300 E. CEDAR STREET
ANGLETON TX 77515
droesler@bakerlawson.com
979-849-6681

I, DOUGLAS B. ROESLER, P.E., hereby certify that I am a Registered Professional Engineer in the State of Texas. I certify this project was completed on the 12th day of April 2022 at the listed address above. The project was completed in conformance to the plans and specifications and in my professional opinion, is in compliance with the City of Angleton's Approved Plans. The project is ready for Final Inspection by the City Engineer. The "As-Built" drawings will be furnished to the office of the City Engineer of the City of Angleton within 15 calendar days of the date this certification is signed.

Signature: 

Date: 04-18-22

SHEET NO. SHEET NAME

1	TITLE SHEET
-	PRELIMINARY REPEAT
-	FINAL REPEAT
2	CONSTRUCTION NOTES
3	EXISTING CONDITIONS & DEMOLITION
4	DRAINAGE AREA MAP
5	LOT GRADING PLAN
6	UTILITY PLAN
7	PLAN & PROFILE - CULLEN STREET STA 0+00 TO 2+09
8	PLAN & PROFILE - BENNETT LOOP STA 0+00 TO 5+00
9	PLAN & PROFILE - BENNETT LOOP STA 5+00 TO 10+60
10	PLAN & PROFILE - BENNETT LOOP STA 10+60 TO 16+00
11	PLAN & PROFILE - BENNETT STREET STA 16+00 TO 21+00
12	PLAN & PROFILE - BENNETT STREET STA 21+00 TO 26+80
13	PLAN & PROFILE - AMY STREET STA 0+00 TO 3+80
14	PLAN & PROFILE - AMY STREET STA 3+80 TO 7+35
15	PLAN & PROFILE - HOSPITAL LANE STA 0+00 TO 2+00
16	PLAN & PROFILE - OUTFALL 1 STA 0+00 TO 5+00
17	PLAN & PROFILE - OUTFALL 2 STA 0+00 TO 5+00
18	PLAN & PROFILE - OUTFALL 3 STA 0+00 TO 3+00
19	SWPPP LAYOUT
20	SWPPP NARRATIVE
21	HYDROLOGICAL CALCULATIONS
22	CUT AND FILL PLAN
22B	SECTION 1 & 2 POND EXCAVATION CALCULATION PLAN
23	WINDSTORM DATA
24	WINDSTORM DATA
25	PAVEMENT MARKING, STREET SIGN AND ROADWAY LIGHTING LAYOUT
26	TRAFFIC CONTROL PLAN - TCP (1-1) - 18
26A	HERITAGE TREE PRESERVATION PLAN



27	MISCELLANEOUS DETAILS
28 (SL-03)	STORM SEWER MANHOLE CONSTR. DETAILS
29 (SL-08)	STORM SEWER INLET CONSTR. DETAILS II
30 (SL-09)	STORM SEWER INLET CONSTR. DETAILS III
31 (SL-10)	STORM SEWER CONSTR. DETAILS
32 (SL-11)	JUNCTION BOX MANHOLES
33 (SL-14)	SANITARY SEWER CONSTR. DETAILS
34 (SL-15)	WATER LINE CONSTR. DETAILS
35 (SL-16)	WATER LINE CROSSING DETAILS
36 (SL-19)	WATER LINE, SAN. SEW. F.M. BEDDING DETAILS
37 (SL-20)	STORM SEW. BEDDING AND BACKFILL DETAILS
38 (SL-21)	CONCRETE PAVEMENT CONSTR. DETAILS
39 (SL-22)	CONCRETE PAVEMENT CONSTR. DETAILS
40 (SL-23)	RESIDENTIAL CURB CONSTR. DETAILS
41 (SL-25)	WHEEL CHAIR RAMP & SIDEWALK DETAILS I
42 (SL-26)	WHEEL CHAIR RAMP & SIDEWALK DETAILS II
43 (SL-27)	DRIVEWAY CONSTR. DETAILS
44 (SL-33)	GENERAL EROSION CONTROL NOTES
45 (SL-34)	EROSION CONTROL DETAILS - 1
46 (SL-35)	EROSION CONTROL DETAILS - 2

The map shows the City of Angleton, Texas, with a grid of streets. Major roads include County Road 341 (top), County Road 428 (right), and State Highway 35 (bottom right). The city is bounded by Henderson Rd. to the north and County Road 210 to the south. The Project Location is marked with a black rectangle near the intersection of Hospital Drive and Rock St. Other streets shown include Brushy, Bayou, Valderas St., Downing Rd., Rock St., Tinsley St., and various residential streets like Northridge, Lorraine St, Kyle St, Wilkins St, E Miller St, E Cedar St, Locust St, Magnolia St, Myrtle St, Mulberry St, and Orange St. Landmarks such as the Adg Hospital and the Union Pacific Railroad are also indicated.


PROJECT NO. 14395

NO.	DATE	DESCRIPTION	APPROVED
REVISIONS			

DESIGNED _____ DR _____
DRAWN _____ BT _____
CHECKED _____
DATE _____

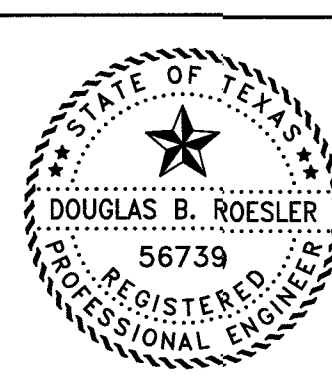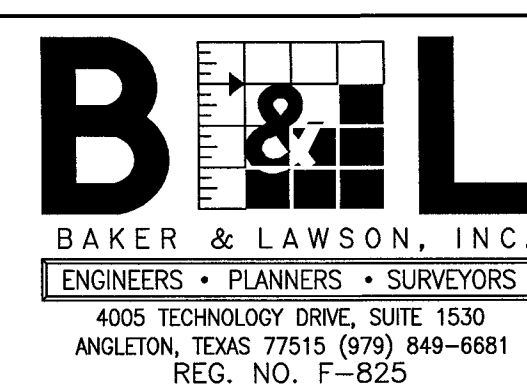

The seal appearing on
this document was
authorized by
Douglas B. Roesler
P-E 56739



Date: 04-18-12

**RIVERWAY PROPERTIES
6115 SKYLINE DR. STE A.
HOUSTON, TEXAS 77057**

PLAN: _____
 PROFILE: _____
 HORIZONTAL: _____
 VERTICAL: _____

RIVERWOOD RANCH SUBDIVISION
SECTION 2
A 78 AC, 109-LOT SUBDIVISION
ANGLETON, TEXAS 77515

GENERAL CONSTRUCTION NOTES

- CONTRACTOR SHALL NOTIFY THE "UNDERGROUND UTILITY COORDINATING COMMITTEE" (TELEPHONE NO. (979) 849-4364 AND THE CITY OF ANGLETON (TELEPHONE NO. (979) 849-4364) 48 HOURS BEFORE STARTING WORK IN STREET RIGHT-OF-WAYS OR EASEMENTS.
- ALL EXISTING UNDERGROUND UTILITIES ARE NOT GUARANTEED TO BE COMPLETE OR DEFINITE, BUT WERE OBTAINED FROM INFORMATION AVAILABLE. CONTRACTOR HAS SOLE RESPONSIBILITY FOR FIELD VERIFICATION OF ALL EXISTING FACILITIES SHOWN ON DRAWINGS. CONTRACTOR SHALL COORDINATE ALL CONFLICTS WITH THE APPROPRIATE GOVERNING AGENCY. NO SEPARATE PAY.
- CONTRACTOR SHALL PROVIDE A TRENCH SAFETY SYSTEM TO MEET, AS A MINIMUM, THE REQUIREMENTS OF OSHA SAFETY AND HEALTH REGULATION, PART 1926, SUBPART P AS PUBLISHED IN THE FEDERAL REGISTER, VOLUME 54, NO. 209, DATED OCTOBER 31, 1989.
- CONTRACTOR SHALL PROVIDE AND INSTALL TRAFFIC CONTROL DEVICES IN CONFORMANCE WITH PART VI OF THE TEXAS MANUAL ON UNIFORM TRAFFIC CONTROL DEVICES (TEXAS MUTCD MOST RECENT EDITION AS REVISED) DURING CONSTRUCTION.
- CONTRACTOR SHALL COVER OPEN EXCAVATIONS IN PUBLIC STREETS WITH AN*HORED STEEL PLATES DURING NON-WORKING HOURS.
- ADEQUATE DRAINAGE SHALL BE MAINTAINED AT ALL TIMES DURING CONSTRUCTION, AND ANY DRAINAGE DITCH OR STRUCTURE DISTURBED DURING CONSTRUCTION SHALL BE RESTORED TO THE SATISFACTION OF THE OWNING AUTHORITY. ALL CONSTRUCTION STORM RUNOFF SHALL COMPLY WITH THE NATIONAL POLLUTANT DISCHARGE ELIMINATION SYSTEM (NPDES) REQUIREMENTS.
- EXISTING PAVEMENTS, CURBS, SIDEWALKS, CULVERTS AND DRIVEWAYS (ADJACENT TO THE WORK) DAMAGED OR REMOVED DURING CONSTRUCTION SHALL BE REPLACED TO EQUAL OR BETTER THAN THEIR ORIGINAL CONDITION AT CONTRACTOR EXPENSE.
- CONDITION OF THE ROAD AND/OR RIGHT-OF-WAY, UPON COMPLETION OF JOB, SHALL BE AS GOOD AS OR BETTER THAN THE CONDITION PRIOR TO STARTING WORK. CONTRACTOR SHALL TAKE NECESSARY ACTIONS TO PROTECT THE EXISTING SURFACES OUTSIDE THE WORK AREA FROM THE EQUIPMENT USED. ALL TRACKED MACHINERY (STREET PADS INCLUDED) SHALL NOT BE OPERATED DIRECTLY ATOP THE PAVEMENT WITHOUT APPROPRIATE PADDING AND PROTECTION OF THE SURFACES. ANY MARRED OR DISTRESSED AREAS SHALL BE REMOVED AND RESTORED WITH NEW MATERIALS TO THE SATISFACTION OF THE ENGINEER. ANY EXISTING DISTRESSED AREAS SHALL BE MADE KNOWN TO THE ENGINEER PRIOR TO OPERATIONS IN THE WORK AREA.
- ALIGNMENT, CENTERLINE CURVE DATA AND STATIONING TO BE VERIFIED BY ON-THE-GROUND SURVEY FROM APPROVED SUBDIVISION PLAN (OR APPROVED PLOT FOR OFF SITE EASEMENTS), AND ELEVATIONS OF ALL CONNECTIONS TO EXISTING FACILITIES TO BE CONFIRMED PRIOR TO WORK START. CONTRACTOR TO NOTIFY OWNER'S REPRESENTATIVE OF ANY DISCREPANCIES PRIOR TO CONSTRUCTION.
- CONTRACTOR SHALL GIVE NOTICE TO ALL AUTHORIZED INSPECTORS, SUPERINTENDENTS, OR PERSONS IN CHARGE OF PRIVATE AND PUBLIC UTILITIES AFFECTED BY HIS OPERATIONS PRIOR TO COMMENCEMENT OF WORK.
- CONTRACTOR SHALL ASSURE HIMSELF THAT ALL CONSTRUCTION PERMITS HAVE BEEN OBTAINED PRIOR TO COMMENCEMENT OF WORK.
- ALL UTILITY TRENCHES TO BE BACK FILLED TO 90 PERCENT (90%) STANDARD PROCTOR DENSITY UNLESS OTHERWISE NOTED.
- ALL SURVEY, LAYOUT, MEASUREMENT, AND GRADE STAKE WORK SHALL BE PERFORMED BY BAKER & LAWSON, INC. AS PART OF THE WORK UNDER THIS CONTACT.
- BAKER & LAWSON, INC. WILL PROVIDE EXPERIENCED INSTRUMENT MEN, COMPETENT ASSISTANTS, AND SUCH INSTRUMENTS, TOOLS, STAKES, AND OTHER MATERIALS REQUIRED TO COMPLETE THE SURVEY, LAYOUT AND MEASUREMENT WORK.
- CONSTRUCTION DEBRIS AND OTHER UNCLASSIFIED UNSUITABLE EXCESS MATERIAL SHALL BE HAULED TO A STATE APPROVED DISPOSAL SITE OR AS DIRECTED BY THE ENGINEER. AN EXISTING LANDFILL APPROXIMATELY 10 MILES FROM THE PROJECT SITE IS THE NEAREST STATE APPROVED FEE FACILITY. ALL REFUSE MATERIALS (BROKEN CONCRETE, TREES, ASPHALT, ETC.) SHALL BE DISPOSED OF BY THE CONTRACTOR AT HIS EXPENSE.
- PLAN QUANTITIES WILL BE USED FOR FINAL PAYMENT UNLESS DESIGN CHANGES ARE MADE DURING CONSTRUCTION.

CONSTRUCTION NOTES FOR PAVING & DRAINAGE

- GUIDELINES SET FORTH IN THE MANUAL ON UNIFORM CONTROL DEVICES SHALL BE OBSERVED.
- FILL SHALL BE PLACED IN MAXIMUM 8" LOOSE LIFTS AND COMPACTED TO 95% OF OPTIMUM DENSITY AS DETERMINED USING TESTING METHOD ASTM D698.
- CONTRACTOR RESPONSIBLE FOR MAINTAINING BARRICADES TO PREVENT TRAFFIC FROM USING NEW PAVEMENT UNTIL PROJECT IS COMPLETED AND ACCEPTED BY PROPER AUTHORITY OR AS AUTHORIZED BY ENGINEER.
- B+8 INDICATES ROAD WIDTH TO BACK OF CURB. CURB RADI ARE TO FACE OF CURB. T.C. INDICATES TOP OF CURB ELEVATIONS (BASED ON 4" CURB UNLESS OTHERWISE NOTED) T.P. INDICATES TOP OF PAVEMENT ELEVATION.
- TRANSVERSE EXPANSION JOINTS SHALL BE INSTALLED AT MAXIMUM SPACING OF 40-FOOT INTERVALS (SAWCUTS @ 20'(2 1/2'DEEP). LONGITUDINAL JOINTS SHALL BE AT MAXIMUM OF 14-FOOT SPACING. WOOD JOINT SHALL BE SOUND HEART REDWOOD.
- 6-INCH CONCRETE PAVEMENT TO BE 5.5 SACK MIX MIN. (3,500 PSI) REINFORCING STEEL TO CONFORM TO ASTM A-615, GRADE 60. PROVIDE MINIMUM 18-INCH LAPS. (36 BAR DIA)
- SAW CUT TO EXPOSE EXISTING LONGITUDINAL STEEL REQUIRED TO CREATE A MINIMUM TWELVE-INCH (12") OVERLAP OF PROPOSED AND EXISTING LONGITUDINAL REINFORCING STEEL. WHEN MAKING A CONNECTION TO EXISTING CONCRETE PAVEMENT, WHERE SPACING OF EXISTING LONGITUDINAL STEEL DIFFERS FROM PROPOSED STEEL SPACING, NOTIFY THE ENGINEER.
- USE PLASTIC CHAIRS TO SUPPORT REINFORCEMENT AT 24-INCH SPACING EACH WAY.
- SUBGRADE TO BE STABILIZED 1-FOOT BACK OF PROPOSED CURB OR EDGE OF PAVEMENT. EXCESS LIME STABILIZED SOIL SHALL BE UTILIZED IN THE PREPARATION OF SUBGRADE FOR DRIVEWAYS. THERE WILL BE NO PAYMENT FOR PREPARING SUBGRADE FOR DRIVEWAYS AND SIDEWALKS. THIS WORK SHALL BE CONSIDERED INCIDENTAL TO THE ASSOCIATED CONCRETE PAY ITEMS. SUBGRADE PREPARATION FOR DRIVEWAYS AND PAVING SHALL INCLUDE PROOF ROLLING. SOFT AREAS TO BE EXCAVATED AND RECOMPACTED TO ADJACENT SOIL DENSITY.
- USE CONTINUOUS LONGITUDINAL REINFORCING BAR IN CURB.
- BACK FILL AND BEDDING FOR HEADWALL STRUCTURES, TYPE "C" INLETS, R.C.P. LEADS AND STORM SEWERS SHALL BE WITH 1.5 SACK CEMENT. STABILIZED SAND SHALL BE COMPACTED TO A DENSITY OF AT LEAST 90% OF DENSITY DETERMINED BY STANDARD MOISTURE-DENSITY RELATION (ASTM D-698) AT OPTIMUM MOISTURE AND SHALL BE PLACED AND FINISHED WITHIN 3 HRS. OF MIXING. TEMPORARY TRAVEL WAY SURFACE SHALL BE WITH CEMENT STABILIZED LIMESTONE. PAYMENT FOR THESE ITEMS SHALL BE SUBSIDIARY TO THE VARIOUS STRUCTURAL BID ITEMS. VERIFICATION OF CEMENT STABILIZED SAND MIXTURE SHALL BE FURNISHED UPON REQUEST OF ENGINEER.
- THE SUBGRADE SHALL BE BROUGHT TO THE REQUIRED GRADE BY THE USE OF GRADE STAKES (BLUE TOPS) AND APPROVED BY THE ENGINEER BEFORE LIME IS APPLIED.

- RATE OF APPLICATION FOR LIME SHALL BE SEVEN PERCENT (7%) OF THE DRY WEIGHT OF SOIL (QUALITY BASE ON 100 #/ C.F.) OR THIRTY ONE AND ONE HALF (31.5) POUNDS PER SQUARE YARD FOR SIX (6) INCH STABILIZED SUBGRADE. LIME STABILIZED SUBGRADE SHALL NOT BE MIXED MORE THAN ONE INCH IN EXCESS OF THE REQUIRED DEPTH. LIME STABILIZED SUBGRADE SHALL BE BROUGHT TO THE OPTIMUM MOISTURE CONTENT DURING THE FIRST MIXING OPERATIONS THEN LIME SHALL BE KEPT MOST CURED ON A DAILY BASIS WITH WATER TRUCKS OR SUBSTANTIAL SUPPLY HOSES FOR THE ENTIRE PERIOD THE SURFACE REMAINS UNCOVERED WITH ADDITIONAL COURSES. AFTER FINAL TESTING AND APPROVAL IS COMPLETE, TRACK EQUIPMENT, SCRAPERS AND OTHER HEAVY EQUIPMENT WILL NOT BE PERMITTED ON THE COMPLETED LIME STABILIZED AREA. LIGHT MOTOR GRADERS, RUBBER Tired TRACTORS, WATER TRUCKS AND ROLLERS USED IN THE FINISHING OPERATIONS WILL BE PERMITTED WITH THE APPROVAL OF THE ENGINEER. CONCRETE AND LOADED HAUL TRUCKS ARE STRICTLY PROHIBITED ON COMPLETED AREAS UNLESS THE TRAVELED AREA REGARDLESS OF CONDITION IS REMIXED COMPACTED AND TESTED FOR APPROVAL A SECOND TIME.
- FORMS SHALL BE EITHER WOOD OR STEEL, OF GOOD QUALITY, FREE OF WARP AND SUFFICIENTLY STAKED TO AVOID SHIFTING WHEN LOAD IS APPLIED. ALL REDWOOD EXPANSION BOARDS SHALL BE STAKED WITH 1X2 REDWOOD STAKES AND ALLOWED TO REMAIN WITHIN THE FOUR. METAL STAKES ARE APPROVED FOR USE TO STAKE METAL KEYS.
- REINFORCING SHALL BE SECURELY TIED AT ALL INTERSECTIONS AND SPLICES. ALL DOWELS SHALL BE SECURELY TIED. REINFORCEMENT SHALL BE CLEAN AND FREE OF RUST AT TIME OF USE. PLASTIC CHAIR OF THE CORRECT HEIGHT SHALL BE USED. SPACING SHALL BE SUFFICIENT TO SUPPORT REINFORCEMENT.
- PRIOR TO CONCRETE PLACEMENT, CONTRACTOR SHALL PRESENT A CERTIFIED COPY OF TOP OF FORM GRADES TO THE ENGINEER FOR REVIEW AND APPROVAL. ELEVATIONS OF FORMS SHALL BE RECORDED AT 10' INTERVALS. ADJUSTMENTS TO FORMS SHALL BE COMPLETE 4 HRS. PRIOR TO CONCRETE PLACEMENT.
- CONCRETE FOR STREET PAVEMENTS SHALL BE "CLASS A" CONCRETE, SHALL NOT HAVE LESS THAN FIVE AND ONE HALF (5 1/2) SACKS OF CEMENT PER CUBIC YARD, AND SHALL NOT HAVE MORE THAN SIX AND ONE HALF (6 1/2) GALLONS OF WATER PER SACK OF CEMENT. SLUMP SHALL NOT EXCEED FIVE (5) INCHES AND SHALL DEVELOP A MODULUS OF RUPTURE STRENGTH OF TWO THOUSAND FIVE HUNDRED (2500) P.S.I. AT TWENTY EIGHT (28) DAYS. CONCRETE SHALL BE PLACED IN SUCH A MANNER AS TO REQUIRE AS LITTLE HANDLING POSSIBLE. USE OF AN APPROVED VIBRATING SCREED WILL BE REQUIRED. AT INTERSECTIONS AND SMALL AREAS WHERE A VIBRATORY SCREED CAN NOT BE USED, A HAND VIBRATOR OR "JITTERBUG" SHALL BE USED. USE OF A TEN FOOT (10') CONCRETE PAVEMENT STRAIGHT EDGE WILL ALSO BE REQUIRED. ALL EXPOSED JOINTS SHALL BE EDGED AS NOTED ON DETAILS. SURFACE SHALL BE TYPICALLY A BELT FINISH OR BROOM FINISH (COARSE, MEDIUM OR LIGHT) AS REQUIRED BY THE APPLICATION AND DIRECTED BY THE ENGINEER.
- FLY ASH SHALL MAKE UP FROM 20-25% BY VOLUME OF THE SPECIFIED CEMENT VOLUME AND SHALL CONFORM TO ASTM C 618, CLASS F.
- CURING COMPOUND SHALL BE TYPE II WITH WHITE PIGMENT. APPLIED AT THE UNDILUTED RATE OF ONE GALLON PER TWO HUNDRED (200) SQUARE FEET.
- EXPANSION JOINTS SHALL BE CLEANED, WIRE BRUSHED, BLOWN OR FLAME DRIED SEALED WITH AN APPROVED LIST RUBBERIZED HOT LAID ASPHALT JOINT AND CRACK SEALANT OR A TWO (2) COMPONENT POLYMERIC SELF LEVELING COLD APPLIED SEALANT.
- CONTRACTOR WILL NOT PERMIT TRAFFIC ON NEW CONCRETE PAVEMENT UNTIL BOTH A MINIMUM OF SEVEN (7) CURING DAYS AND MODULUS OF RUPTURE STRENGTH OF THIRTY THOUSAND FIVE HUNDRED (3500) P.S.I. TAKES PLACE OR AS APPROVED BY THE ENGINEER/PUBLIC WORKS DEPARTMENT.
- CONCRETE FOR CURB SHALL BE A 3000 P.S.I. PERFORMANCE STRENGTH CONCRETE WITH A MINIMUM FIVE (5) SACK CEMENT PER CUBIC YARD CONTENT. CURB CONCRETE MIX MAY BE A SMALL AGGREGATE BATCH DESIGN.
- A CONCRETE MIX DESIGN OF CONCRETE PLUS FLY ASH MAY BE SUBSTITUTED IN LIEU OF THE STANDARD CONCRETE BATCH DESIGN. THE FLY ASH SHALL CONFORM TO THE REQUIREMENTS OF TxDOT MATERIAL SPECIFICATION D-9-8900, AND SHALL NOT EXCEED 25% BY ABSOLUTE VOLUME OF THE SPECIFIED CEMENT CONTENT. THE MODULUS OF RUPTURE STRENGTHS MINIMUMS AND DEVELOPMENT PERIOD OF THE STANDARD CONCRETE MIX DESIGN SHALL REMAIN IN EFFECT AND SHALL BE VERIFIED BY A CONCRETE BATCH MIX DESIGN PREPARED AND TESTED BY A GEOTECHNICAL LAB AND SUBMITTED FOR REVIEW AND APPROVAL BY THE CITY ENGINEERING/PUBLIC WORKS DEPARTMENT PRIOR TO PAVING OPERATIONS.
- ALL PAVEMENT SAW CUT REQUIRED IN THE PLANS SHALL BE CONSIDERED SUBSIDIARY TO THE PAVING REMOVAL PAY ITEM REQUIRING IT.
- BLOCK SOD SHALL BE PLACED 16" (ONE BLOCK WIDTH) WIDE ALONG THE EDGE OF ALL NEWLY CONSTRUCTED CURBS AND TO DRIVEWAY REPLACEMENT LIMITS.
- THE CONTRACTOR WILL BE RESPONSIBLE FOR ANALYZING WEATHER CONDITIONS AND TO SUSPEND OPERATIONS DURING PERIODS WHEN ADVERSE WEATHER CONDITIONS APPEAR LIKELY. NO CONCRETE SHALL BE PLACED WHEN THE TEMPERATURE IS 35°F AND RISING. HOWEVER, NO CONCRETE SHALL BE PLACED WHEN THE CONCRETE TEMPERATURE IS ABOVE 100°F. THE CONTRACTOR SHALL KEEP SUFFICIENT LENGTH OF COVERING MATERIAL ON THE JOB SITE TO PLACE OVER AND PROTECT THE SURFACE OF "FRESH" CONCRETE DURING PERIODS OF UNPREDICTED RAINS.
- CUL-DE-SACS TO BE PAVED COMPLETELY WITH NO ISLANDS

WASTEWATER CONSTRUCTION NOTES

- CONTRACTOR SHALL PROVIDE RECORD OF LOCATION OF ALL STACKS, STUBS, LEADS, ETC. TO CITY OF ANGLETON.
- SEPARATION DISTANCES FOR ALL SANITARY SEWER AND WATER MAIN CONSTRUCTION SHALL BE GOVERNED BY THE "TEXAS NATURAL RESOURCE CONSERVATION COMMISSION RULES AND REGULATIONS FOR DESIGN CONSERVATION COMMISSION RULES AND REGULATIONS FOR DESIGN CRITERIA FOR SEWAGE SYSTEMS "SECTION 317.20," LATEST PRINTING.
- MAINTAIN 12-INCH MINIMUM VERTICAL CLEARANCE AT CROSSINGS BETWEEN SANITARY SEWERS AND CULVERTS, UNLESS OTHERWISE NOTED.
- WHERE SANITARY SEWER LINE CROSSES A WATER LINE WITH LESS THAN 9- FEET BUT MORE THAN 6-INCHES VERTICAL SEPARATION, PROVIDE ONE MINIMUM 18-FOOT JOINT OF PRESSURE RATED P.V.C. SANITARY SEWER (ASTM D2241, CLASS 150, SDR 26) CENTERED ON WATER LINE. INCLUDE COST OF WATER LINE CROSSING IN UNIT PRICE BID PER LINEAR FOOT FOR SANITARY SEWER IN APPROPRIATE SIZES.
- CONTRACTOR TO NOTIFY OWNER'S REPRESENTATIVE UPON ENCOUNTERING ANY UNSUITABLE TRENCH CONDITIONS.
- SANITARY SEWER LEADS UNDER OR WITHIN 1' OF EXISTING OR FUTURE PAVEMENT SHALL BE BACK FILLED WITH CEMENT STABILIZED SAND UP TO WITHIN 1' OF TOP OF PAVING SUBGRADE. CEMENT STABILIZED SAND BACK FILL FOR LEADS SHALL BE INCLUDED IN THE BID UNIT PRICE FOR LEADS.
- LOW PRESSURE AIR TEST SHALL BE CONDUCTED PER TNRCC TAC 317.2. HOLDING TIMES SHALL BE AS ESTABLISHED BY TNRCC. CONTRACTOR TO PROVIDE TEST PLUGS AND RISERS. NO SEPARATE PAY.

- CONTRACTOR TO OPEN CUT ALL SANITARY SEWER CONSTRUCTION UNLESS NOTE OTHER WISE. SEWER SERVICES TO BE INSTALLED FULL WIDTH OF ROADWAY--NO HALF STREET INSTALLATIONS.
- CONTRACTOR SHALL AT ALL TIMES PROVIDE MAXIMUM UNINTERRUPTED SERVICE AND SHALL AVAIL OF ANY ROUTING METHOD AND EQUIPMENT TO ACCOMPLISH THIS.
- ALL SINGLE AND DOUBLE SERVICE LEAD SHALL BE A MINIMUM SIX INCH (6") UNLESS OTHERWISE DIRECTED BY THE ENGINEER/PUBLIC WORKS AND/OR FIELD ADJUSTED BY THE UTILITY DEPARTMENT IN THE FUTURE.

WATER CONSTRUCTION NOTES

- CONTRACTOR SHALL PROVIDE ADEQUATE THRUST BLOCKING TO WITHSTAND TEST PRESSURE AS SPECIFIED IN CONTRACT DOCUMENTS. THRUST BLOCKING SHALL BE CLASS "B" CONCRETE 2500 P.S.I. AND SHALL BE SUBSIDIARY TO THE BID ITEM PERTINENT TO ITS USE. ALL CEMENT STABILIZED SAND BACKFILL SHALL BE 1.5 SK/ CY CEMENT CONTENT, ALL M.J. D.I. FITTINGS WILL HAVE M.J. RESTRAINTS (STARGRIP OR EQUAL) WRAP FITTINGS & RESTRAINTS WITH 10 MIL POLY.
- SEPARATION DISTANCES OF ALL WATER MAIN AND SANITARY SEWER MAIN CONSTRUCTION SHALL BE GOVERNED BY THE "TEXAS NATURAL RESOURCE CONSERVATION COMMISSION RULES AND REGULATIONS FOR DESIGN CRITERIA FOR SEWAGE SYSTEMS," SECTION 317.20, LATEST PRINTING.
- ALL 4" THROUGH 12" WATER MAINS TO BE P.V.C. PIPE, AWWA C-900, CLASS 150, SDR 18, MEETING THE REQUIREMENTS OF ANSI/NSF 61 UNLESS OTHERWISE NOTED.
- WATER LINES UNDER OR WITHIN 1 FEET OF NEW OR EXISTING PAVEMENTS (STREETS AND DRIVEWAYS) SHALL BE BACK FILLED WITH CEMENT STABILIZED SAND AS SPECIFIED IN THE CONSTRUCTION DETAIL.
- PROVIDE A MINIMUM SIX-INCHES (6") OF CLEARANCE AT STORM SEWER AND WATER LINE CROSSINGS.
- 4-INCH THROUGH 12-INCH LINES TO HAVE A MINIMUM OF 4"-0" COVER BELOW TOP OF CURB. UNLESS OTHERWISE NOTED, VARY FLOW LINE UNIFORMLY FROM DEPTH SHOWN ON PLANS.
- CENTERLINE OF FIRE HYDRANT TO BE LOCATED AT 3' FROM BACK OF CURB WITH CENTERLINE OF STEAMER NOZZLE 22 INCHES ABOVE FINISHED GRADE. TURN STEAMER OUTLET TO FACE STREET.
- WHERE WATER LINE CROSSES SANITARY SEWER LINE OR LEAD WITH LESS THAN NINE FEET (9') VERTICAL SEPARATION, PROVIDE ONE MINIMUM 18-FOOT JOINT OF WATER LINE CENTERED ON LEAD. INCLUDE COST OF LEAD CROSSING IN UNIT PRICE BID PER LINEAR FOOT FOR WATER LINE IN APPROPRIATE SIZES.
- THE CONTRACTOR AT ALL TIMES PROVIDE MAXIMUM UNINTERRUPTED FLOW TO ALL SERVICES AND MAINS AND SHALL AVAIL OF ANY ROUTING METHOD AND EQUIPMENT TO ACCOMPLISH THIS.

CENTERPOINT ENERGY / ENTEX NOTES

CAUTION: UNDERGROUND GAS FACILITIES

LOCATIONS OF CENTERPOINT ENERGY MAIN LINES (TO INCLUDE CENTERPOINT ENERGY, INTRASTATE PIPELINE, LLC, WHERE APPLICABLE) ARE SHOWN IN AN APPROXIMATE LOCATION ONLY. SERVICE LINES ARE NOT USUALLY SHOWN. OUR SIGNATURE ON THESE PLANS ONLY INDICATES THAT OUR FACILITIES ARE SHOWN IN APPROXIMATE LOCATION. IT DOES NOT IMPLY THAT A CONFLICT ANALYSIS HAS BEEN MADE. THE CONTRACTOR SHALL CONTACT THE UTILITY COORDINATING COMMITTEE AT (979) 849-4364 OR 811 A MINIMUM OF 48 HOURS PRIOR TO CONSTRUCTION TO HAVE MAIN AND SERVICE LINES FIELD LOCATED.

* WHEN CENTERPOINT ENERGY PIPE LINE MARKINGS ARE NOT VISIBLE, CALL (800) 752-8036 OR (713) 659-2111 (7:00 A.M. TO 4:30 P.M.) FOR STATUS OF LINE LOCATION REQUEST BEFORE EXCAVATION BEGINS.

* WHEN EXCAVATING WITHIN EIGHTEEN INCHES (18") OF THE INDICATED LOCATION OF CENTERPOINT ENERGY FACILITIES, ALL EXCAVATION MUST BE ACCOMPLISHED USING NON-MECHANIZED EXCAVATION PROCEDURES.

* WHEN CENTERPOINT ENERGY FACILITIES ARE EXPOSED, SUFFICIENT SUPPORT MUST BE PROVIDED TO THE FACILITIES TO PREVENT EXCESSIVE STRESS ON THE PIPING.

* FOR EMERGENCIES REGARDING GAS LINES CALL (800) 659-2111 OR (713) 659-2111.

THE CONTRACTOR IS FULLY RESPONSIBLE FOR ANY DAMAGES CAUSED BY HIS FAILURE TO EXACTLY LOCATE AND PRESERVE THESE UNDERGROUND FACILITIES.

ACTIVITIES ON OR ACROSS CENTERPOINT ENERGY FEE OR EASEMENT PROPERTY NO APPROVAL TO USE, CROSS OR OCCUPY CENTERPOINT FEE OR EASEMENT PROPERTY IS GIVEN. IF YOU NEED TO USE CENTERPOINT PROPERTY, PLEASE CONTACT OUR SURVEYING & RIGHT OF WAY DIVISION AT (713) 207-5769.

WARNING: OVERHEAD ELECTRICAL FACILITIES

OVERHEAD LINES MAY EXIST ON THE PROPERTY. WE HAVE NOT ATTEMPTED TO MARK THOSE LINES SINCE THEY ARE CLEARLY VISIBLE, BUT YOU SHOULD LOCATE THEM PRIOR TO BEGINNING ANY CONSTRUCTION. TEXAS LAW, SECTION 752, HEALTH & SAFETY CODE, FORBIDS ALL ACTIVITIES IN WHICH PERSONS OR THINGS MAY COME WITHIN SIX (6) FEET OF LIVE OVERHEAD HIGH VOLTAGE LINES. PARTIES RESPONSIBLE FOR THE WORK, INCLUDING CONTRACTORS, ARE LEGALLY RESPONSIBLE FOR THE SAFETY OF CONSTRUCTION WORKERS UNDER THIS LAW. THIS LAW CARRIES BOTH CRIMINAL AND CIVIL LIABILITY. TO ARRANGE FOR LINES TO BE TURNED OFF OR REMOVED CALL CENTERPOINT ENERGY AT 713-207-2222.

SBC NOTES

THE LOCATIONS OF SOUTHWESTERN BELL TELEPHONE CO. UTILITIES ARE SHOWN IN AN APPROXIMATE WAY ONLY. THE CONTRACTOR SHALL DETERMINE THE EXACT LOCATION BEFORE COMMENCING WORK. HE AGREES TO BE FULLY RESPONSIBLE FOR ANY AND ALL DAMAGES WHICH MIGHT BE OCCASIONED BY HIS FAILURE TO EXACTLY LOCATE AND PRESERVE THESE UNDERGROUND UTILITIES.

TEXAS NEW MEXICO POWER NOTES

OVERHEAD LINES MAY EXIST ON THE PROPERTY. WE HAVE NOT ATTEMPTED TO MARK THOSE LINES SINCE THEY ARE CLEARLY VISIBLE, BUT YOU SHOULD LOCATE THEM PRIOR TO BEGINNING ANY CONSTRUCTION. TEXAS LAW, SECTION 752, HEALTH AND SAFETY CODE FORBIDS ALL ACTIVITIES IN WHICH PERSONS OR THINGS MAY COME WITHIN SIX (6) FEET OF LIVE OVERHEAD HIGH VOLTAGE LINES. PARTIES RESPONSIBLE FOR THE WORK, INCLUDING CONTRACTORS, ARE LEGALLY RESPONSIBLE FOR THE SAFETY OF CONSTRUCTION WORKERS UNDER THIS LAW. THIS LAW CARRIES BOTH CRIMINAL AND CIVIL LIABILITY. TO ARRANGE FOR LINES TO BE TURNED OFF OR REMOVED CALL TEXAS NEW MEXICO POWER AT (979) 829-5776.

OWNER:

RIVERWAY PROPERTIES
6115 SKYLINE DR. STE A.
HOUSTON, TEXAS 77057

PLAN:

PROFILE:

HORIZONTAL:



VERTICAL:

RIVERWOOD RANCH SUBDIVISION
SECTION 2
A 78 AC, 109-LOT SUBDIVISION
ANGLETON, TEXAS 77515

RECORD DRAWING


CONSTRUCTION NOTES

PROJECT NO. 14395

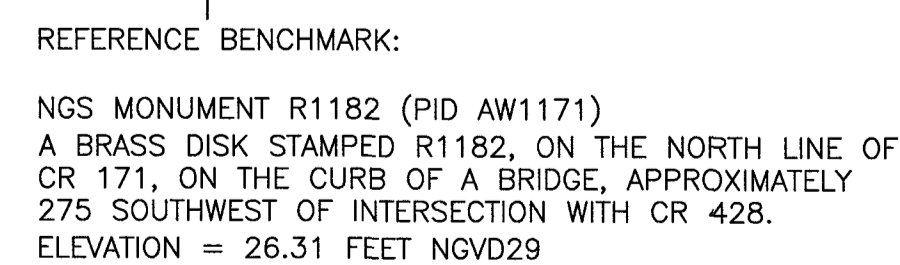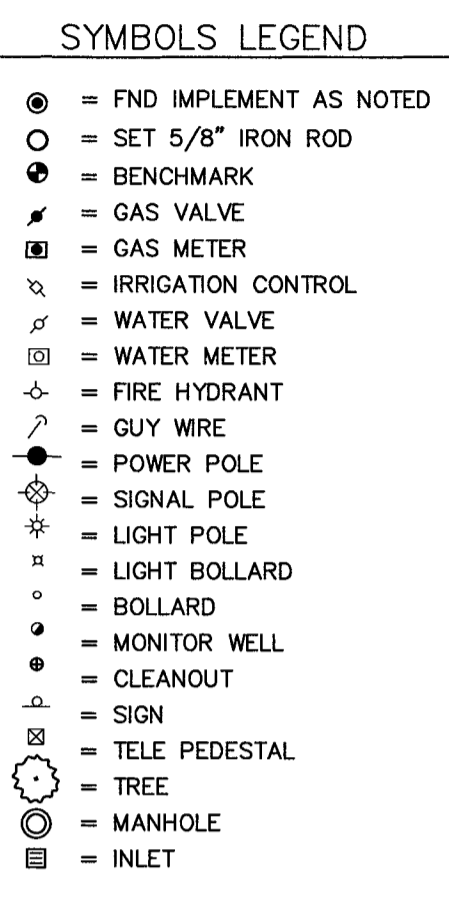

PROJECT NO. 14395

DESIGNED DR
DRAWN BT
CHECKED _____
DATE _____

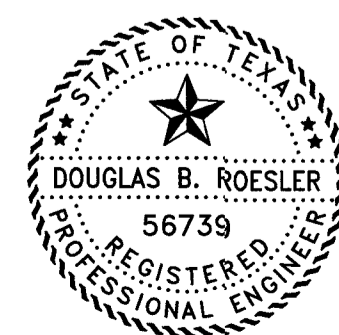

The seal appearing on
this document was
authorized by
Douglas B. Roesler
P.E. 56739

[Signature]

Date: 04-18-07


PLAN: _____ 1" = 60'

PROFILE: _____

HORIZONTAL: _____

VERTICAL: _____


RIVERWOOD RANCH SUBDIVISION
SECTION 2
A 78 AC, 109-LOT SUBDIVISION
ANGLETON, TEXAS 77515

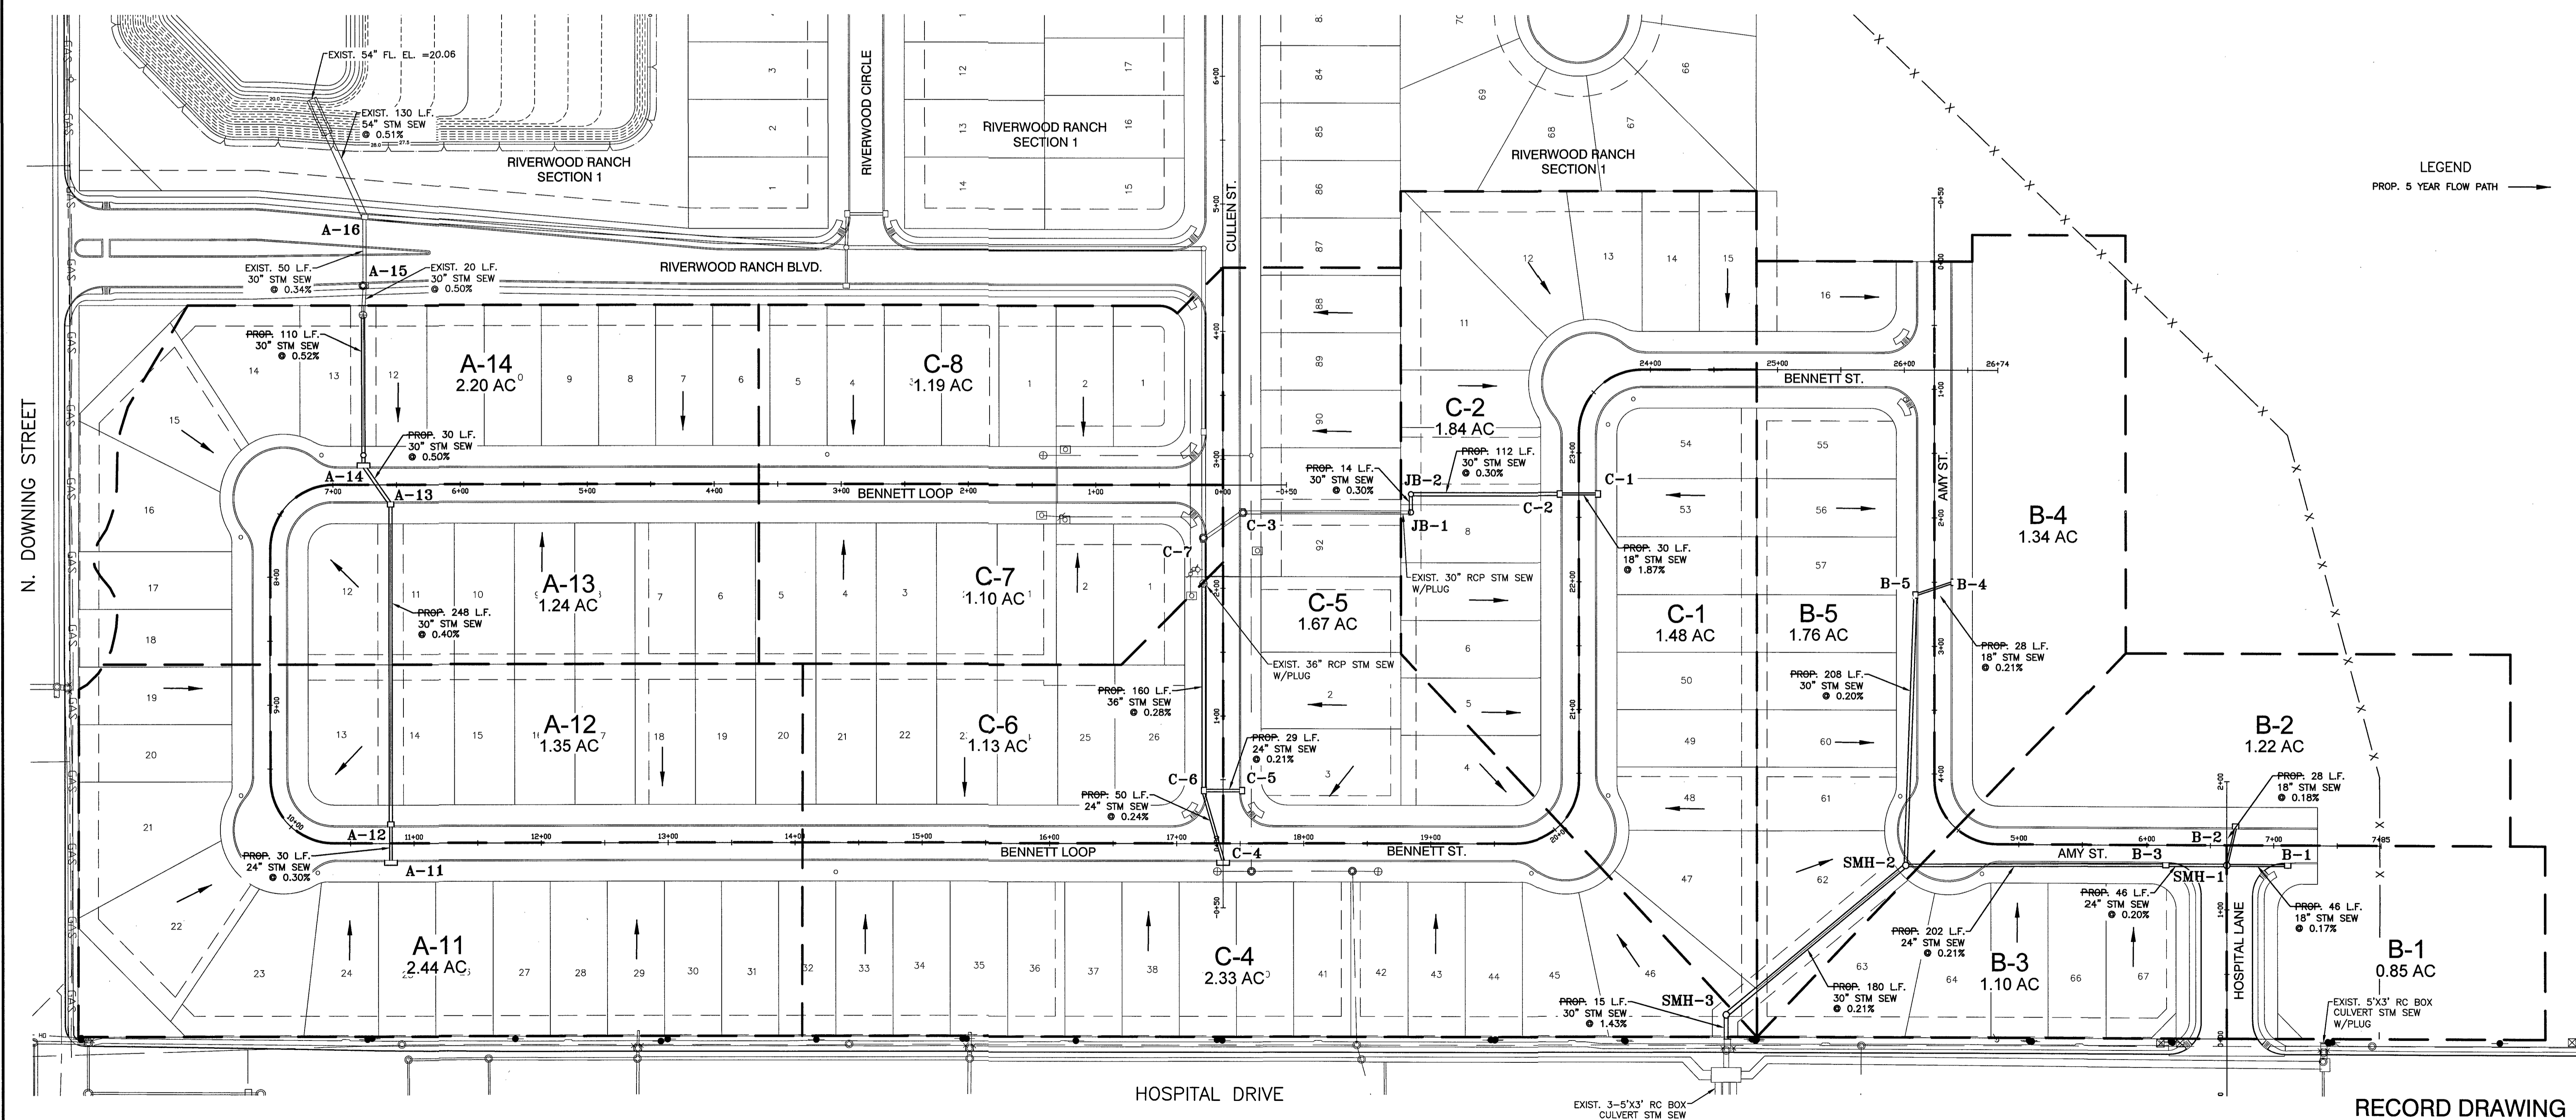


PROJECT NO. 14395

NO.	DATE	DESCRIPTION	APPROVED
REVISIONS			

DESIGNED _____ DR _____
DRAWN _____ BT _____
CHECKED _____
DATE _____

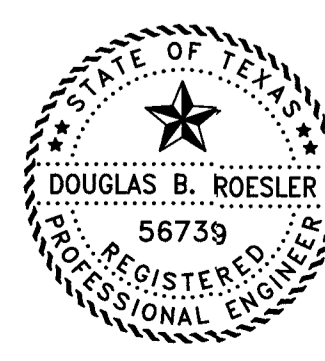


The seal appearing on
this document was
authorized by
Douglas B. Roesler
P.E. 56739


Date: 04-18-77

**RIVERWAY PROPERTIES
6115 SKYLINE DR. STE A.
HOUSTON, TEXAS 77057**

PLAN: 1" = 60'
 PROFILE:
 HORIZONTAL: _____
 VERTICAL: _____

RIVERWOOD RANCH SUBDIVISION
SECTION 2
A 78 AC, 109-LOT SUBDIVISION
ANGLETON, TEXAS 77515

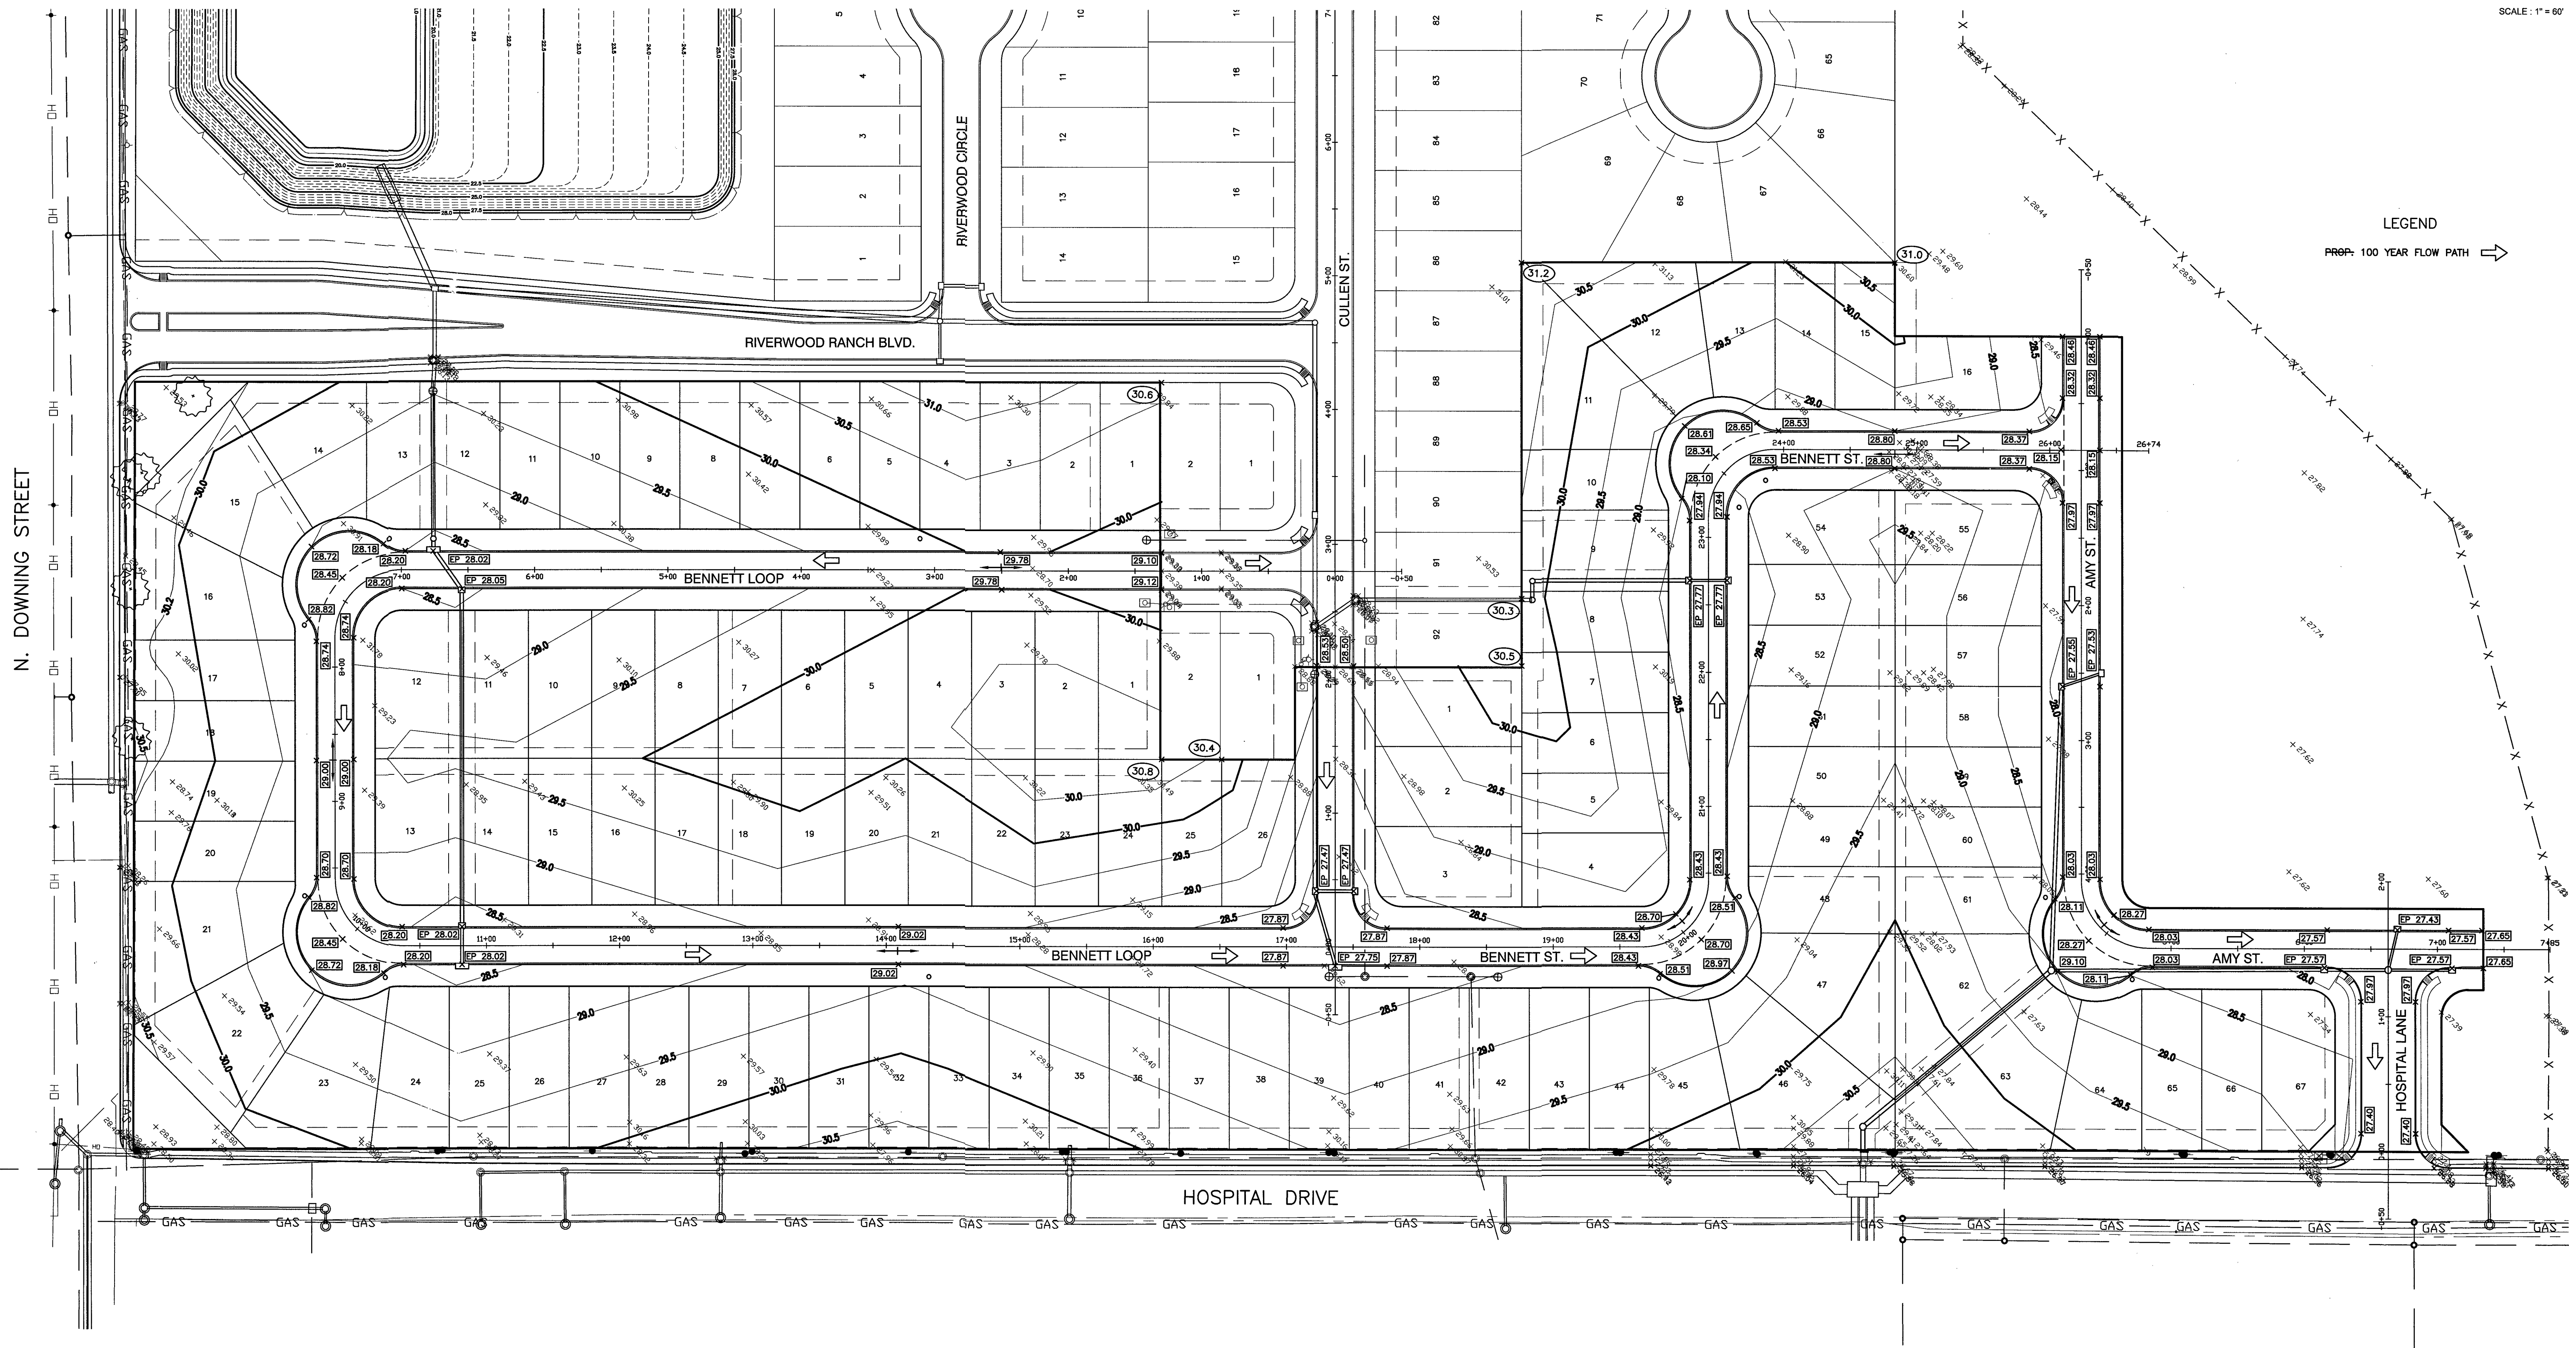

PROP: 100 YEAR FLOW PATH ➡


PROJECT NO.	14395
-------------	-------

DESIGNED DR

DRAWN BT



CHECKED _____

DATE _____

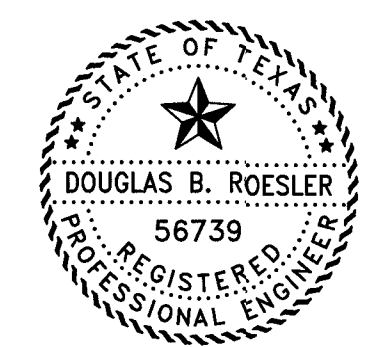

OWNER:
RIVERWAY PROPERTIES
6115 SKYLINE DR. STE A.
HOUSTON, TEXAS 77057

RIVERWOOD RANCH SUBDIVISION
SECTION 2
A 78 AC, 109-LOT SUBDIVISION
ANGLETON, TEXAS 77515

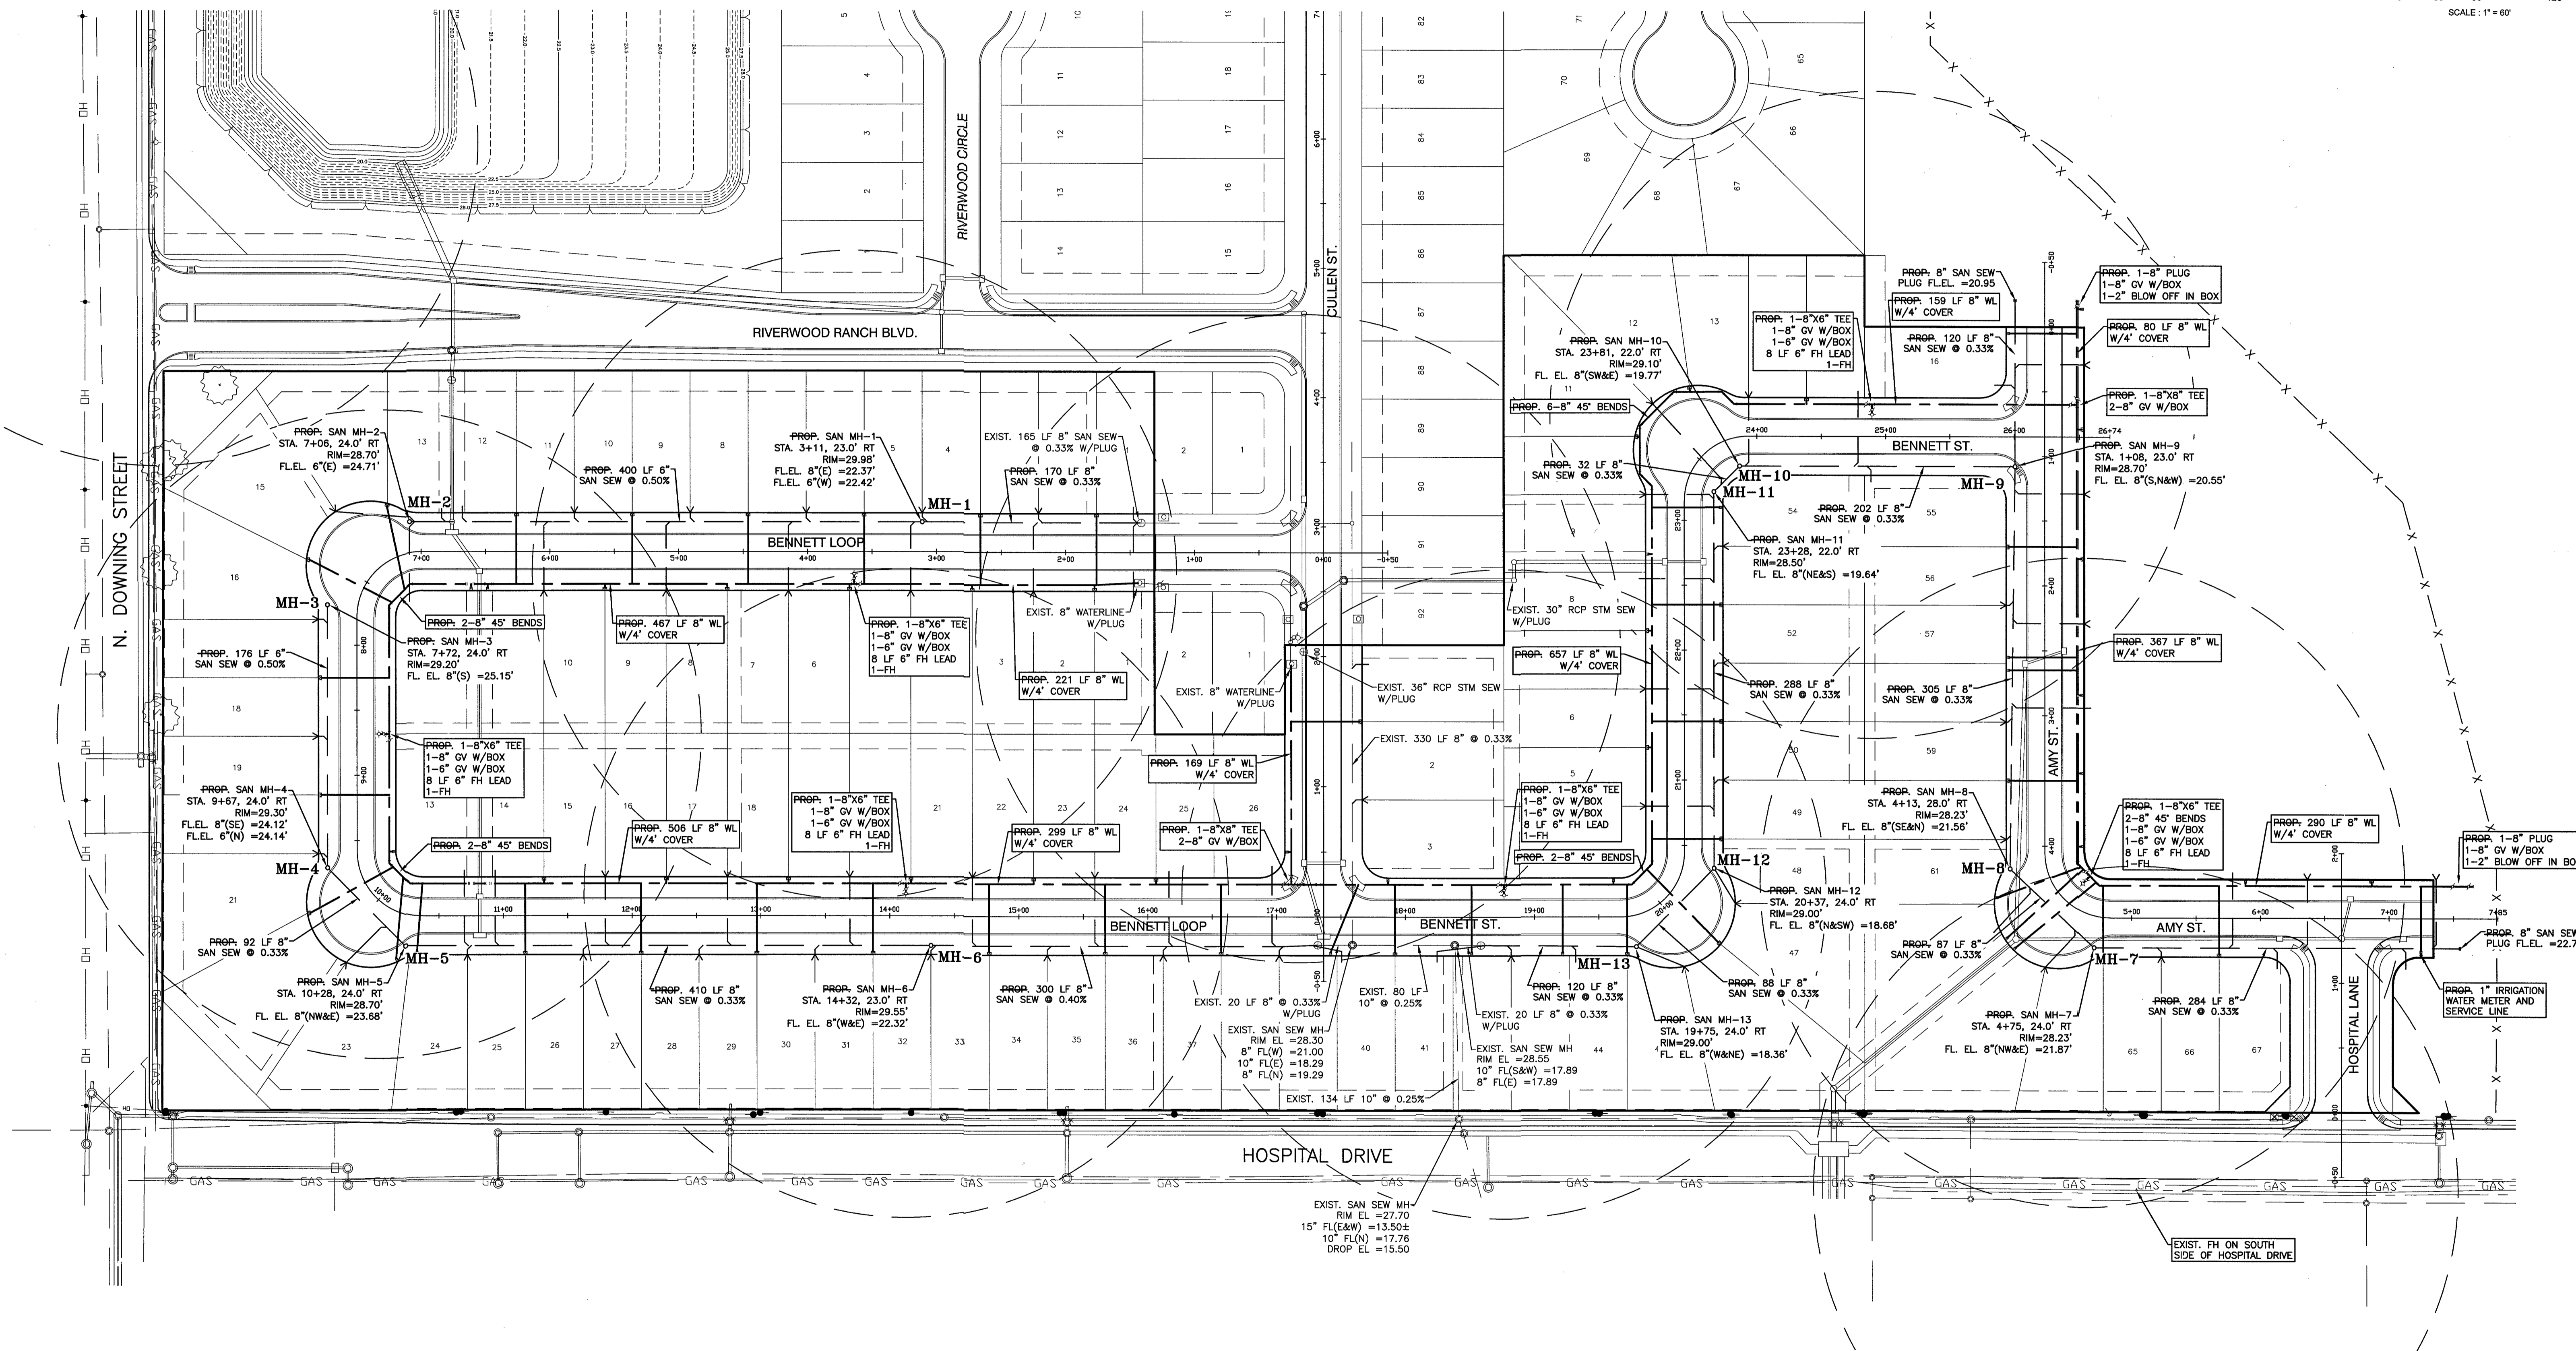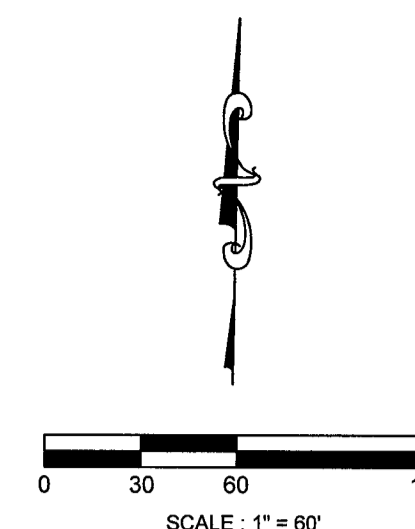


RECORD DRAWING

NO.	DATE	DESCRIPTION	APPROVED
REVISIONS			

DESIGNED	DR
DRAWN	BT
CHECKED	
DATE	

B&L
BAKER & LAWSON, INC.
ENGINEERS • PLANNERS • SURVEYORS
4005 TECHNOLOGY DRIVE, SUITE 1530
ANGLETON, TEXAS 77515 (979) 849-6681
REG. NO. F-825

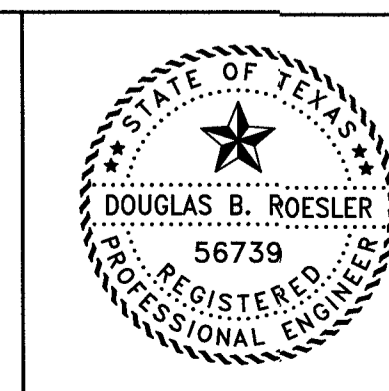


The seal appearing on this document was authorized by Douglas B. Roesler P.E. 56739
[Signature]
Date: 04-18-22

OWNER:
RIVERWAY PROPERTIES
6115 SKYLINE DR. STE A.
HOUSTON, TEXAS 77057


PLAN: 1" = 60'
PROFILE:
HORIZONTAL:
VERTICAL:

RIVERWOOD RANCH SUBDIVISION
SECTION 2
A 78 AC, 109-LOT SUBDIVISION
ANGLETON, TEXAS 77515

UTILITY PLAN
PROJECT NO. 14395

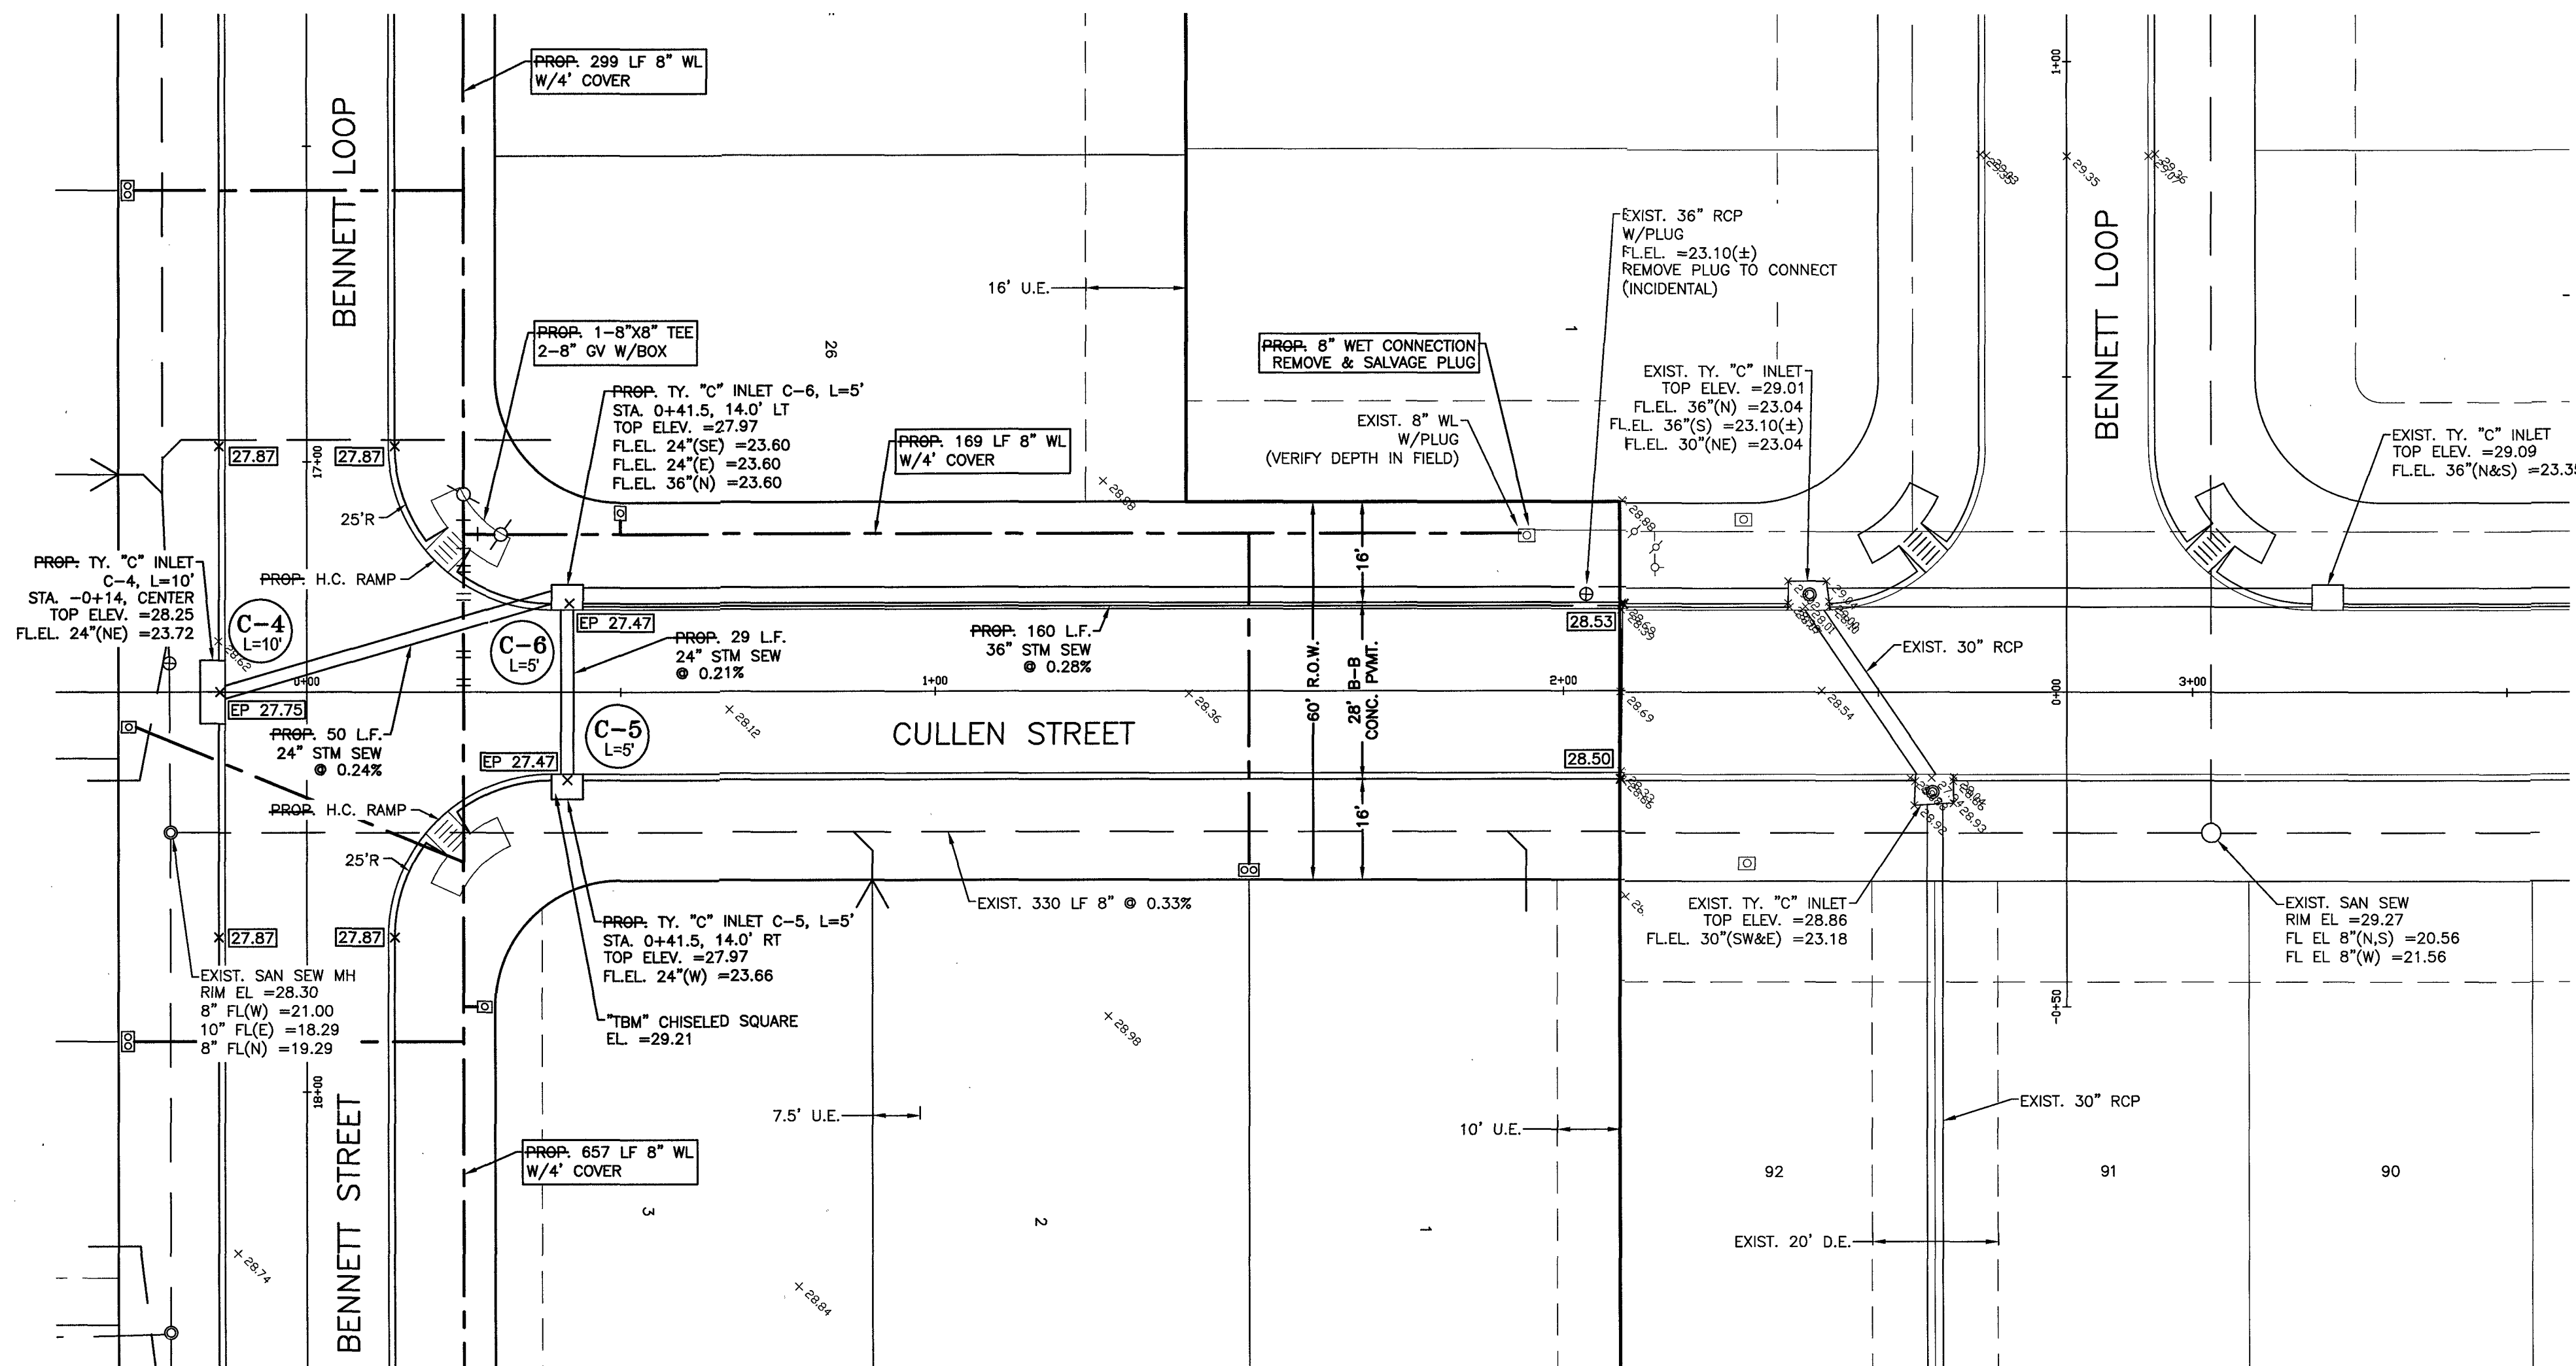

SEE SHEET 17

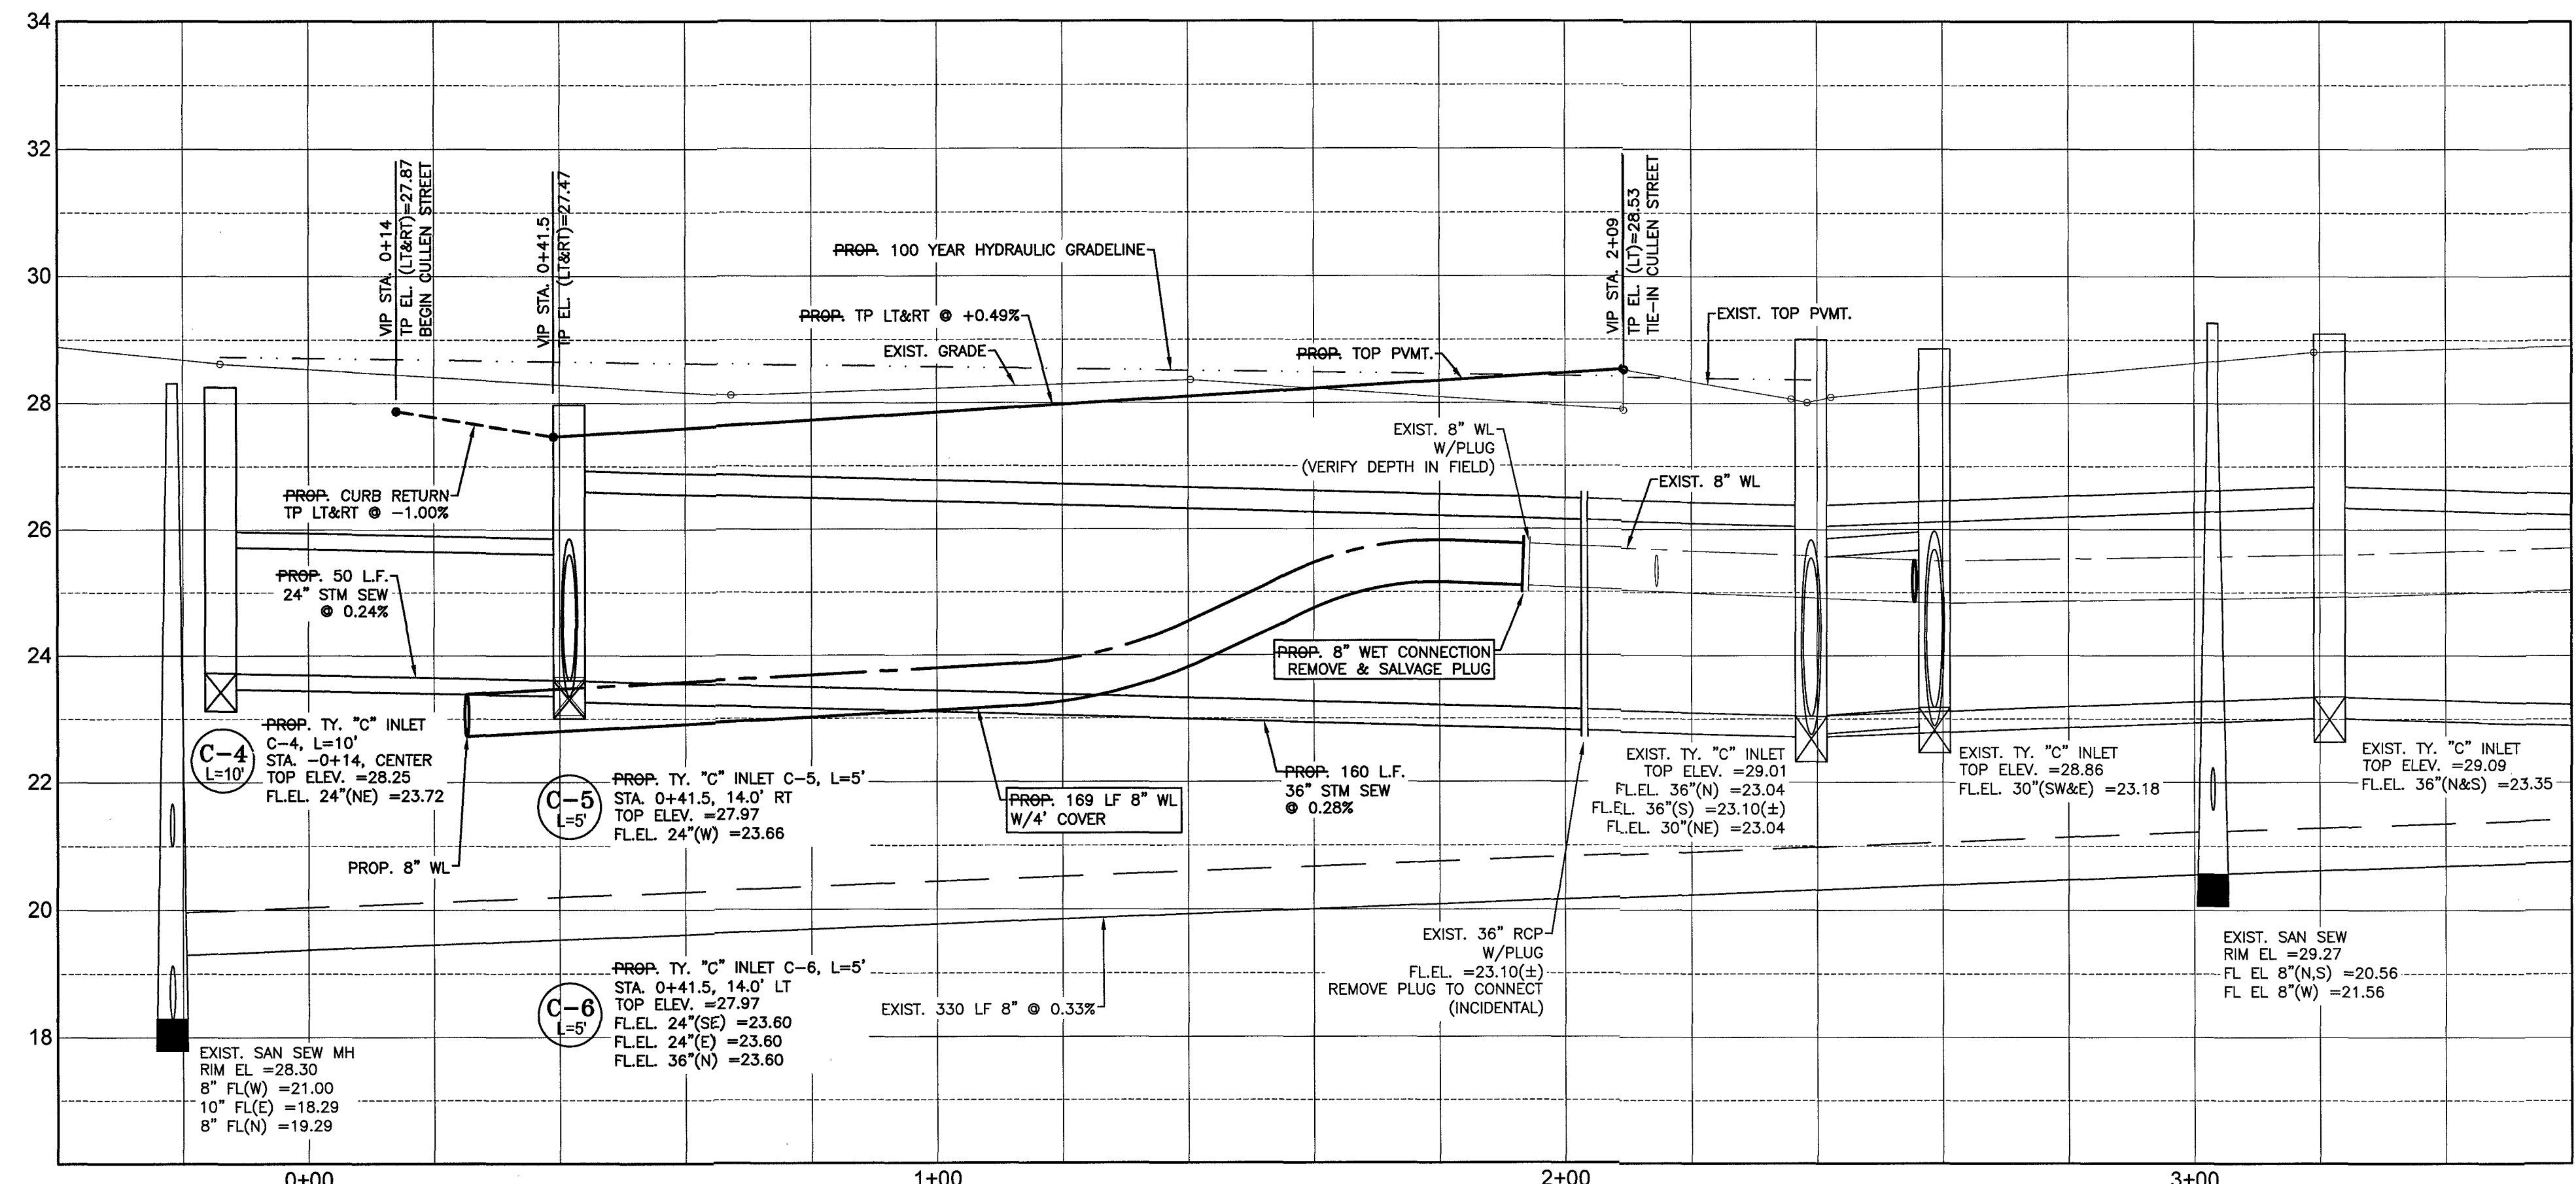



SYMBOLS LEGEND

- WATER METER
- FIRE HYDRANT
- WATER VALVE
- TAPPING SLEEVE AND VALVE
- REDUCER
- STORM SEWER MANHOLE (SMH-1)
- SANITARY SEWER MANHOLE (MH-1)
- TOP BANK
- STORM SEWER LINE (REINFORCED CONCRETE PIPE, ASTM C76)
- SANITARY SEWER LINE (D3034, SDR 26, 160 PR)
- WATERLINE (AWWA C900, CLASS 150, DR18)
- TOP OF PAVEMENT AT EDGE

RECORD DRAWING

NO.	DATE	DESCRIPTION	APPROVED
REVISIONS			

DESIGNED DR
DRAWN BT
CHECKED
DATE

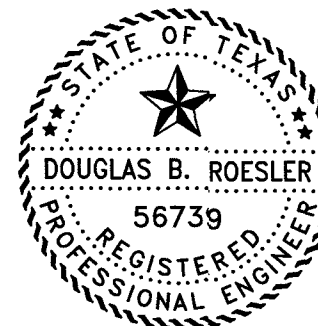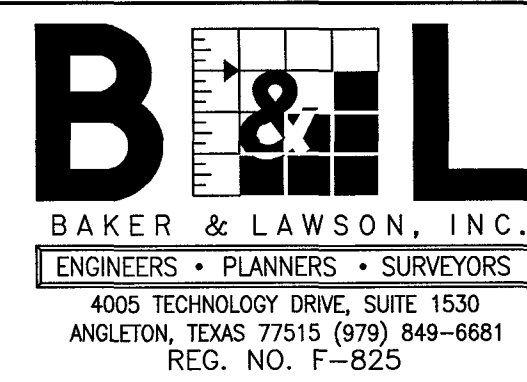




The seal appearing on this document was authorized by Douglas B. Roesler, P.E. 56739
Date: 04-18-22

OWNER:
RIVERWAY PROPERTIES
6115 SKYLINE DR. STE A.
HOUSTON, TEXAS 77057

PLAN: 1" = 20'
PROFILE:
HORIZONTAL: 1" = 2'
VERTICAL: 1" = 20'

RIVERWOOD RANCH SUBDIVISION
SECTION 2
A 78 AC, 109-LOT SUBDIVISION
ANGLETON, TEXAS 77515



PLAN & PROFILE
CULLEN STREET
STA. 0+00 TO 2+09

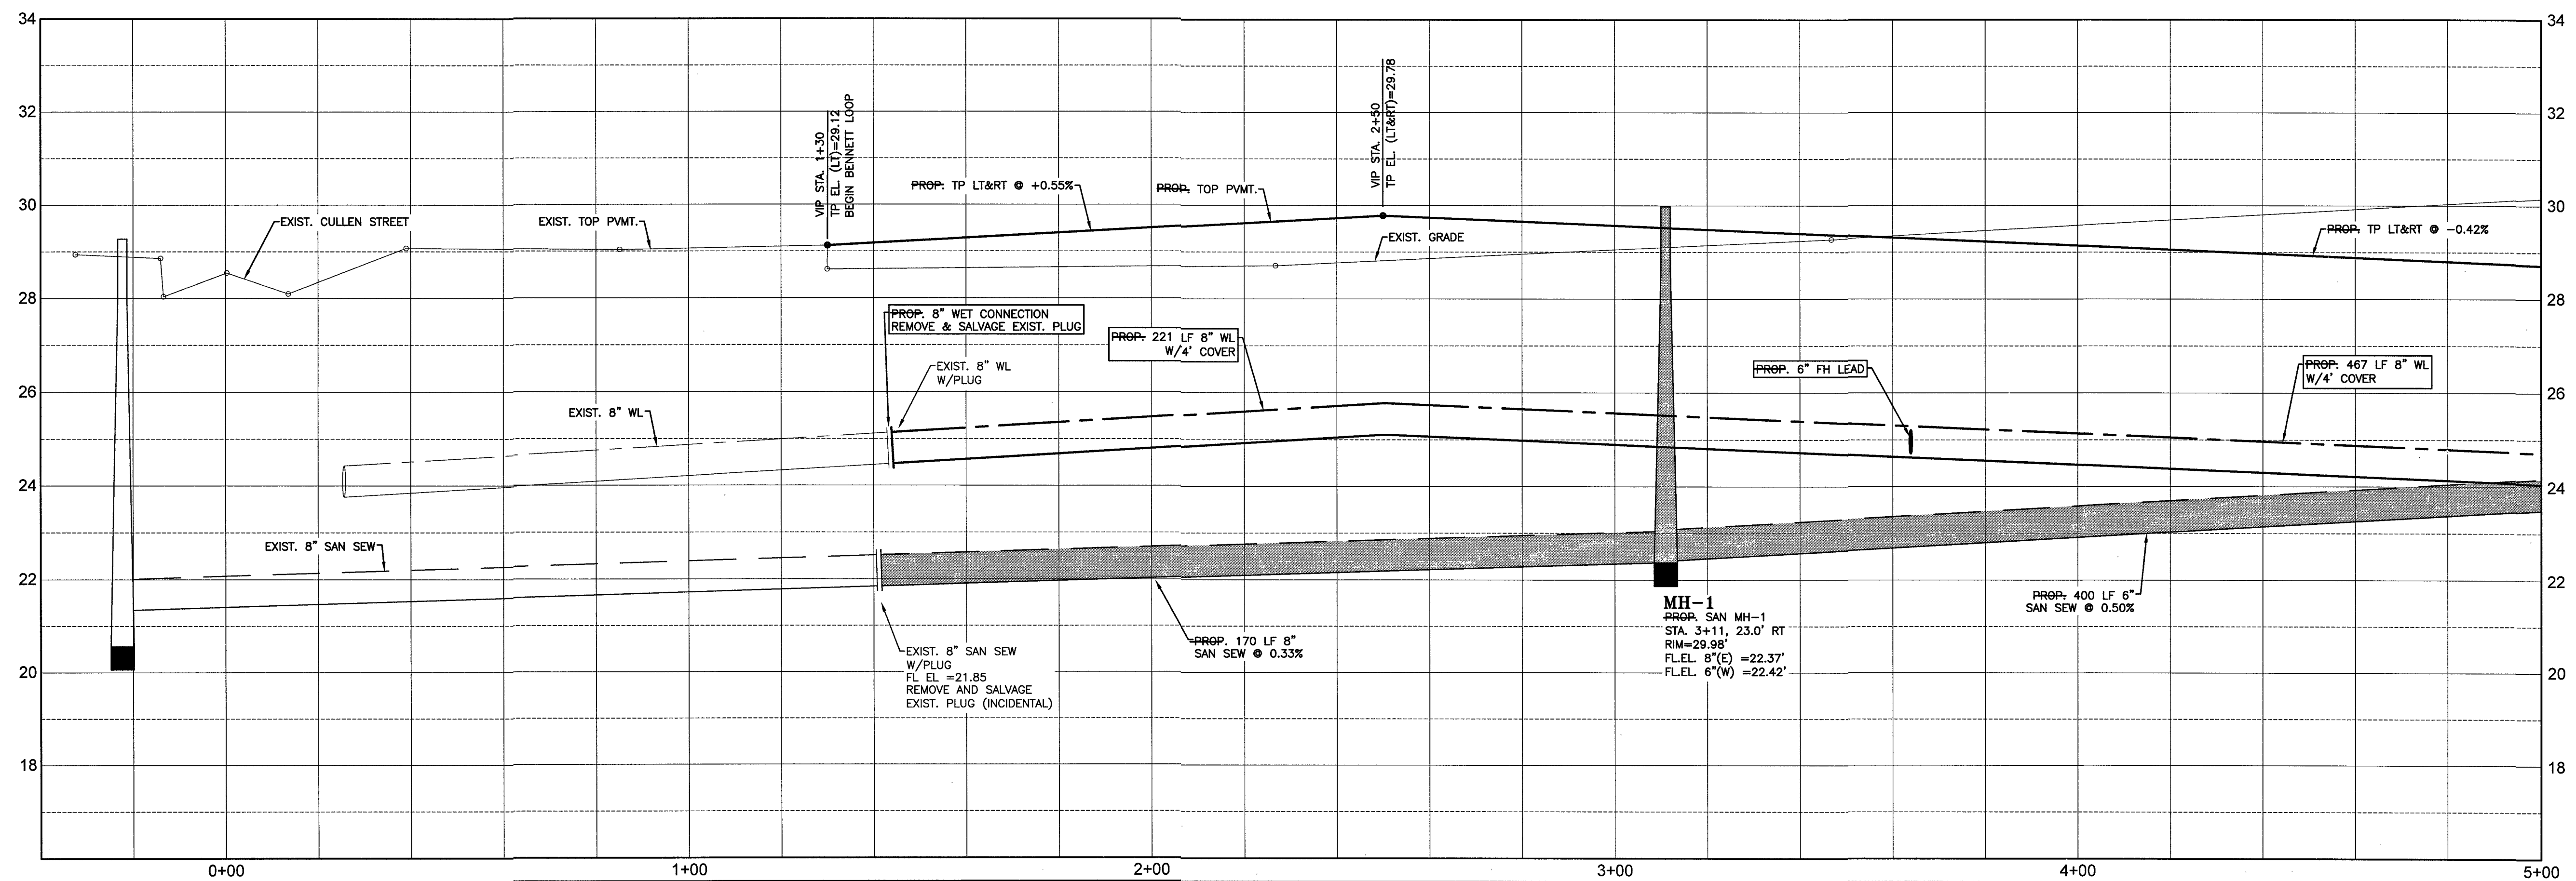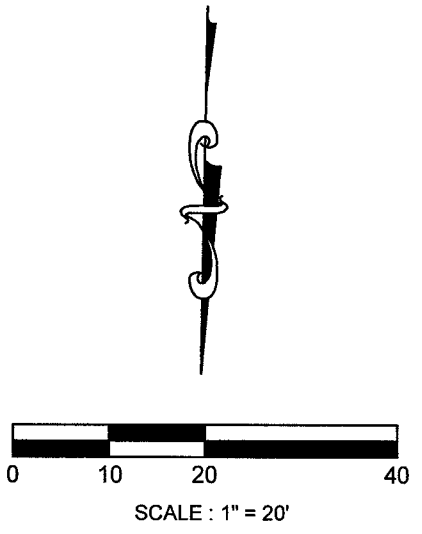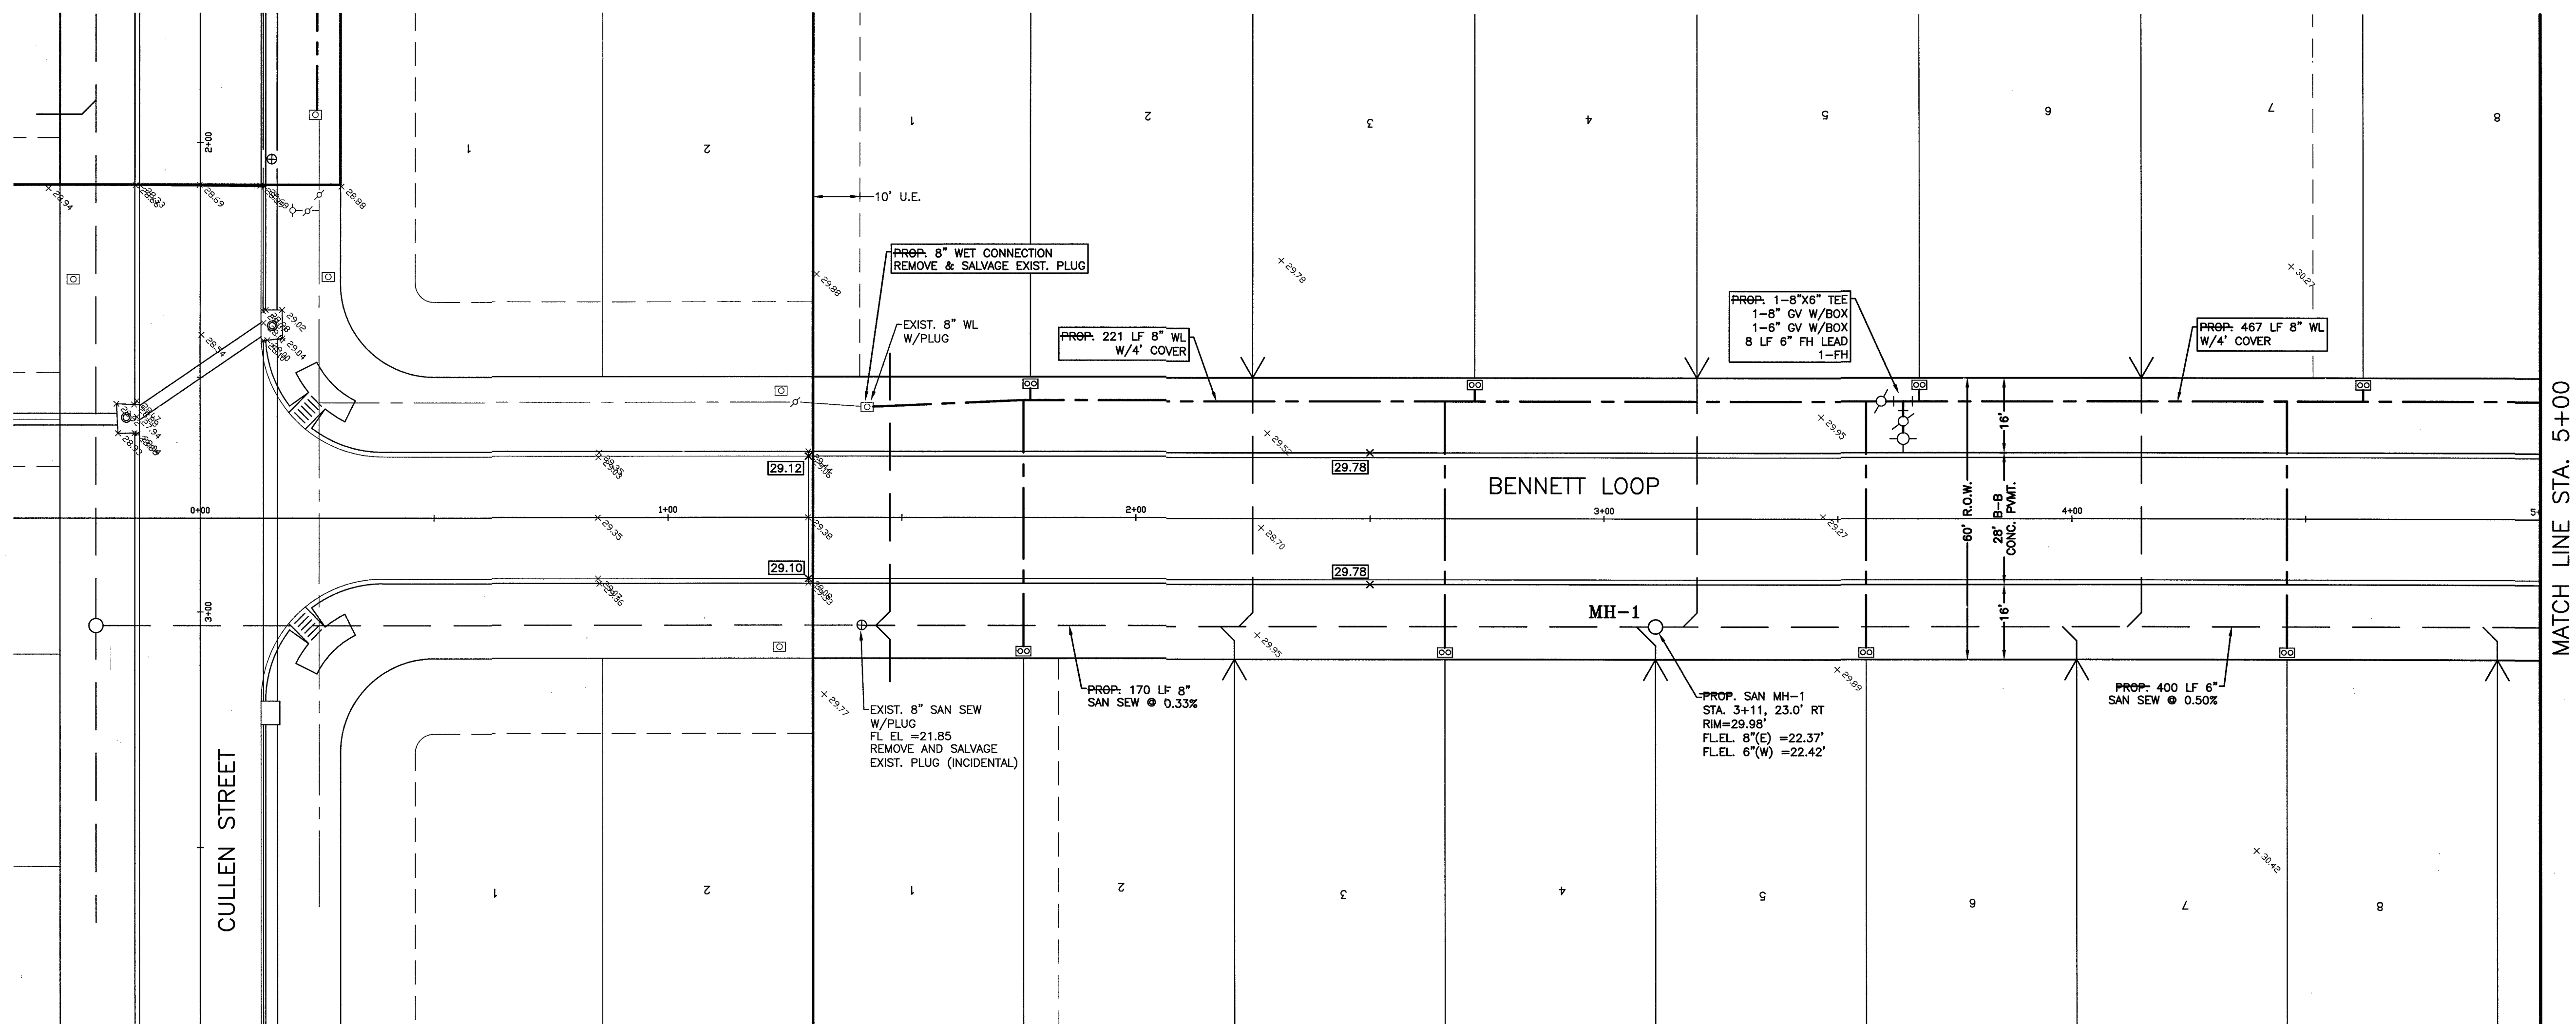


- ## SYMBOLS LEGEND

RECORD DRAWING

NO.	DATE	DESCRIPTION	APPROVED
REVISIONS			

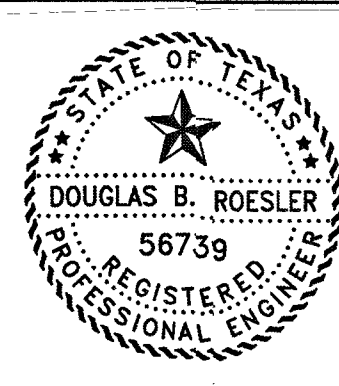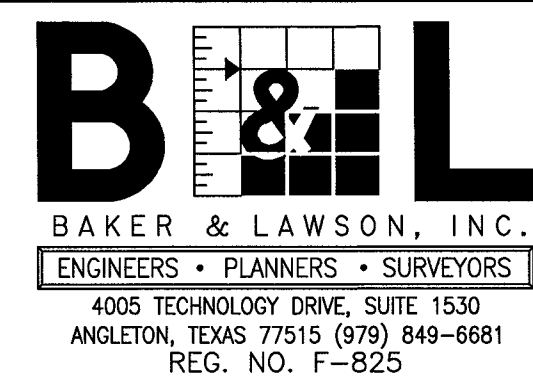

The seal appearing on
this document was
authorized by
Douglas B. Roesler
P.E. 56739


Date: 04-18-22

OWNER:





**RIVERWAY PROPERTIES
6115 SKYLINE DR. STE A.
HOUSTON, TEXAS 77057**

PLAN: 1" = 20'
 PROFILE:
 HORIZONTAL: 1" = 2'
 VERTICAL: 1" = 20'

RIVERWOOD RANCH SUBDIVISION
SECTION 2
A 78 AC, 109-LOT SUBDIVISION
ANGLETON, TEXAS 77515

PLAN & PROFILE
BENNETT LOOP
STA. 0+00 TO 5+00

PROJECT NO. 14395

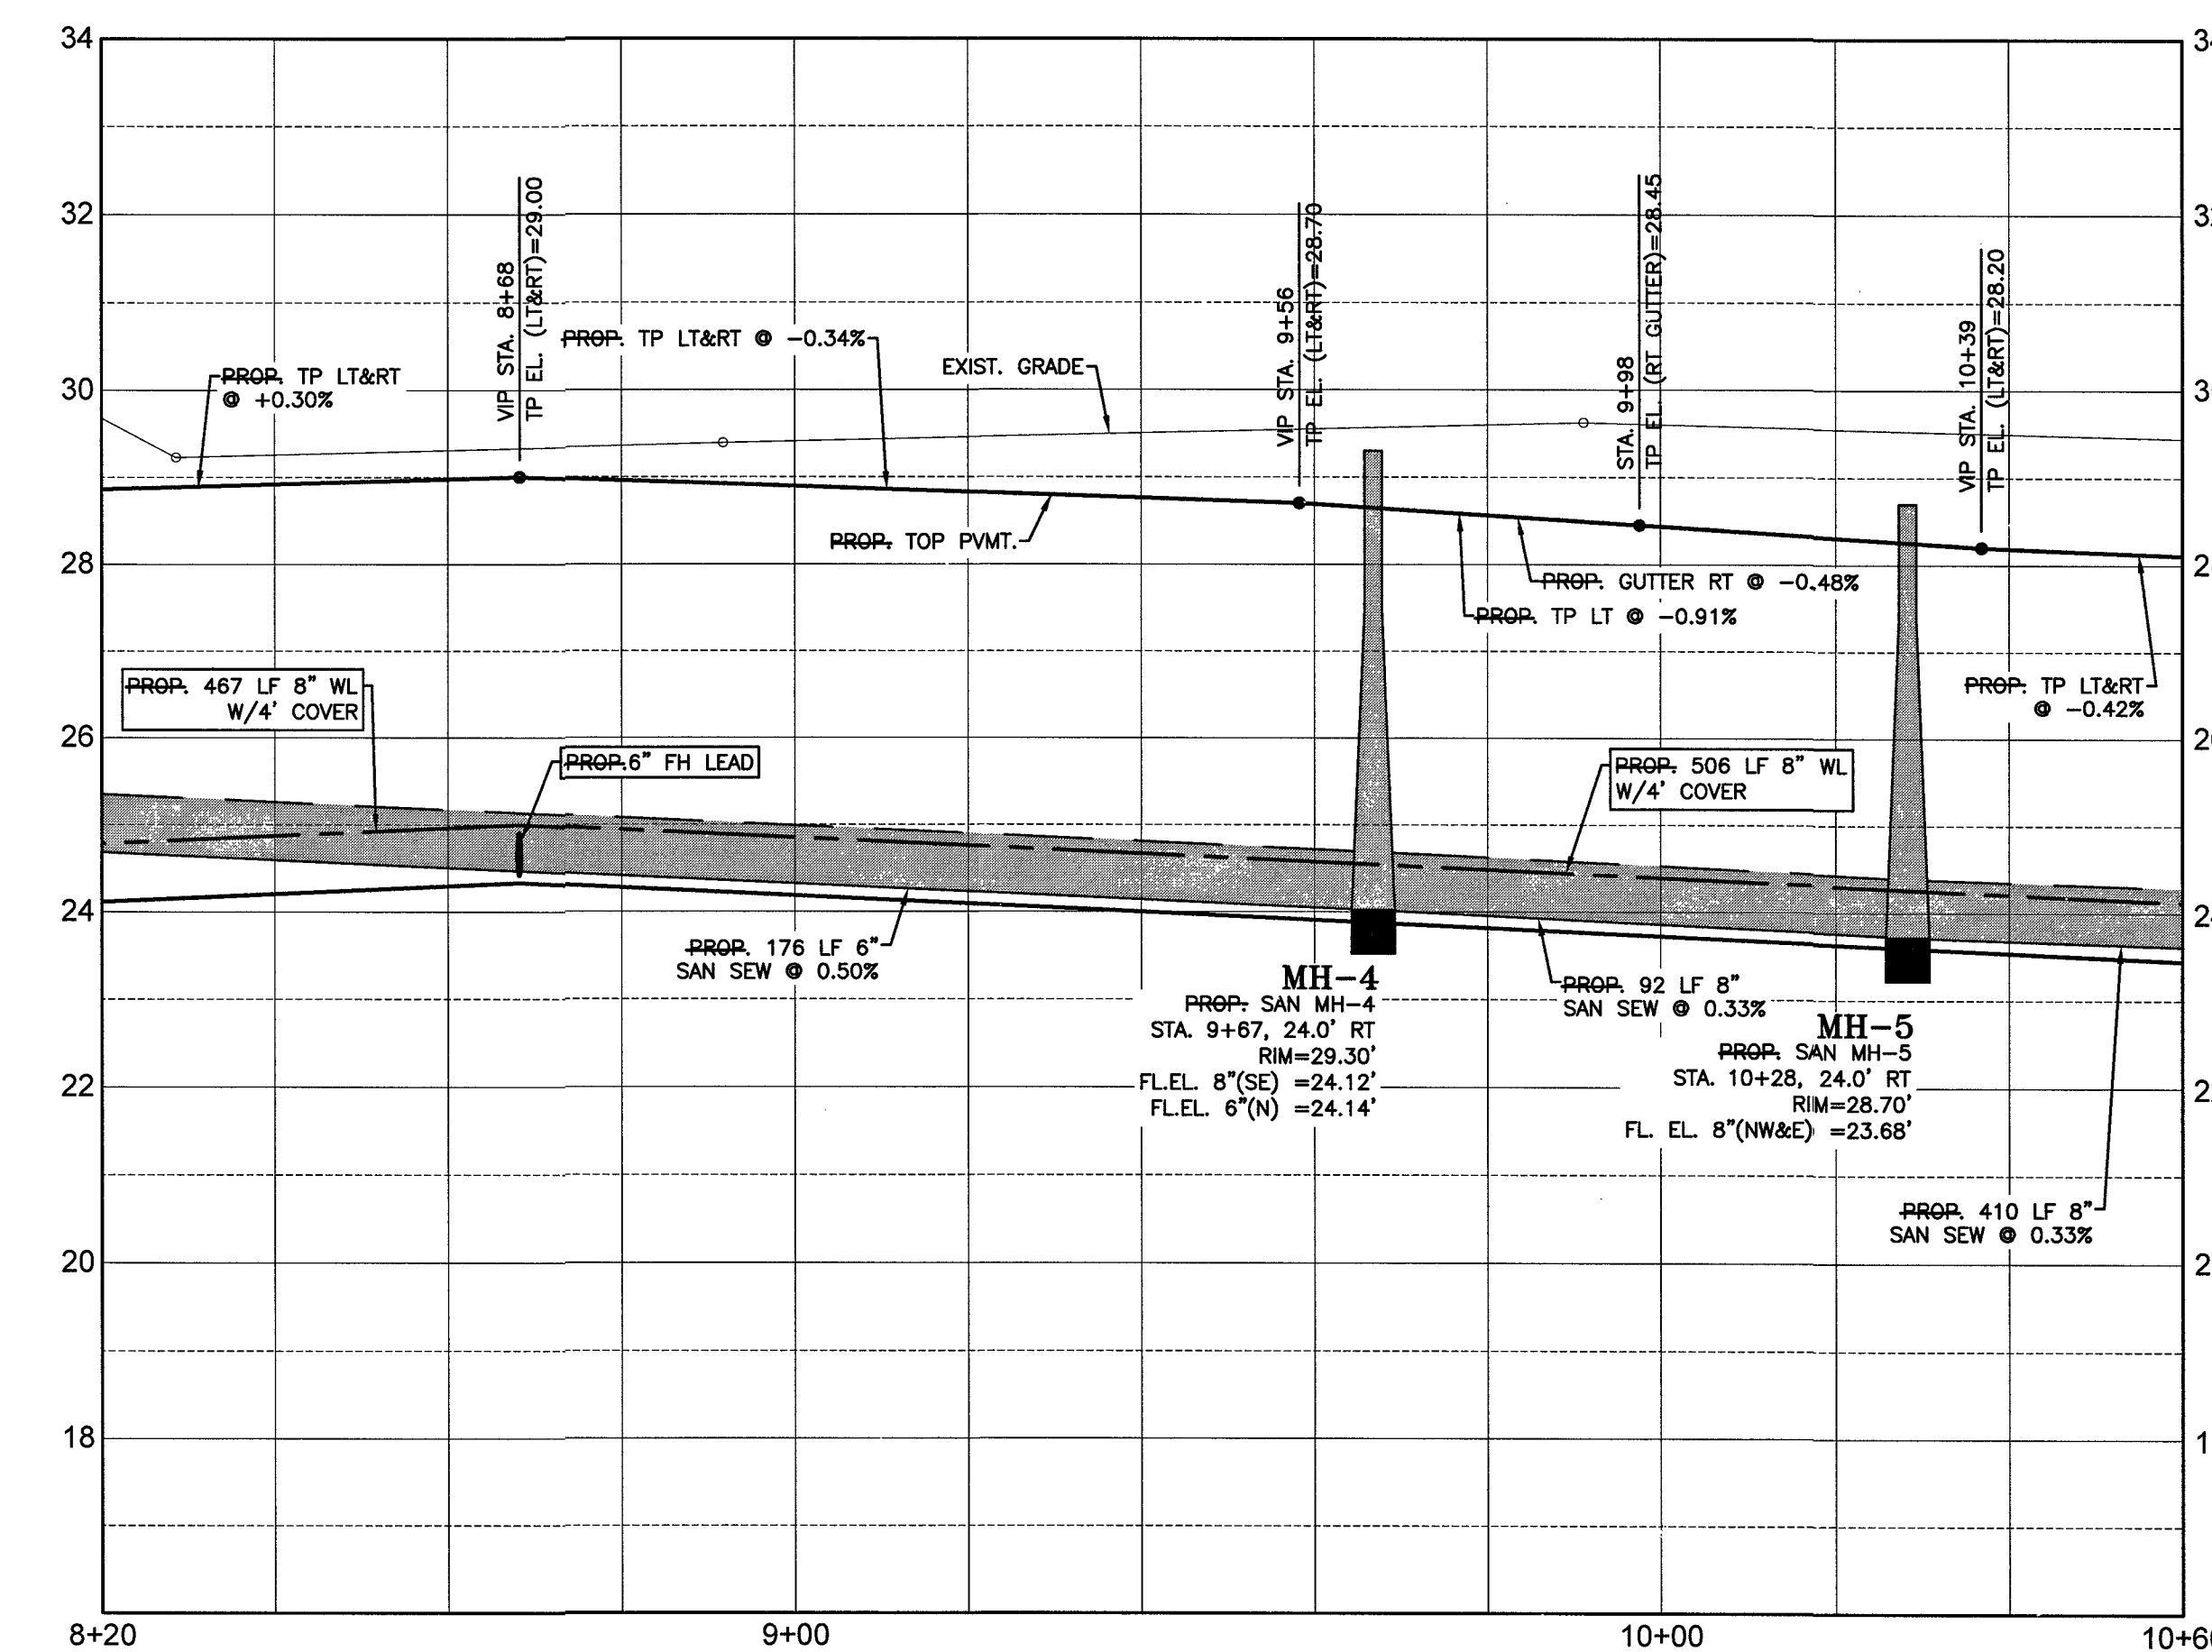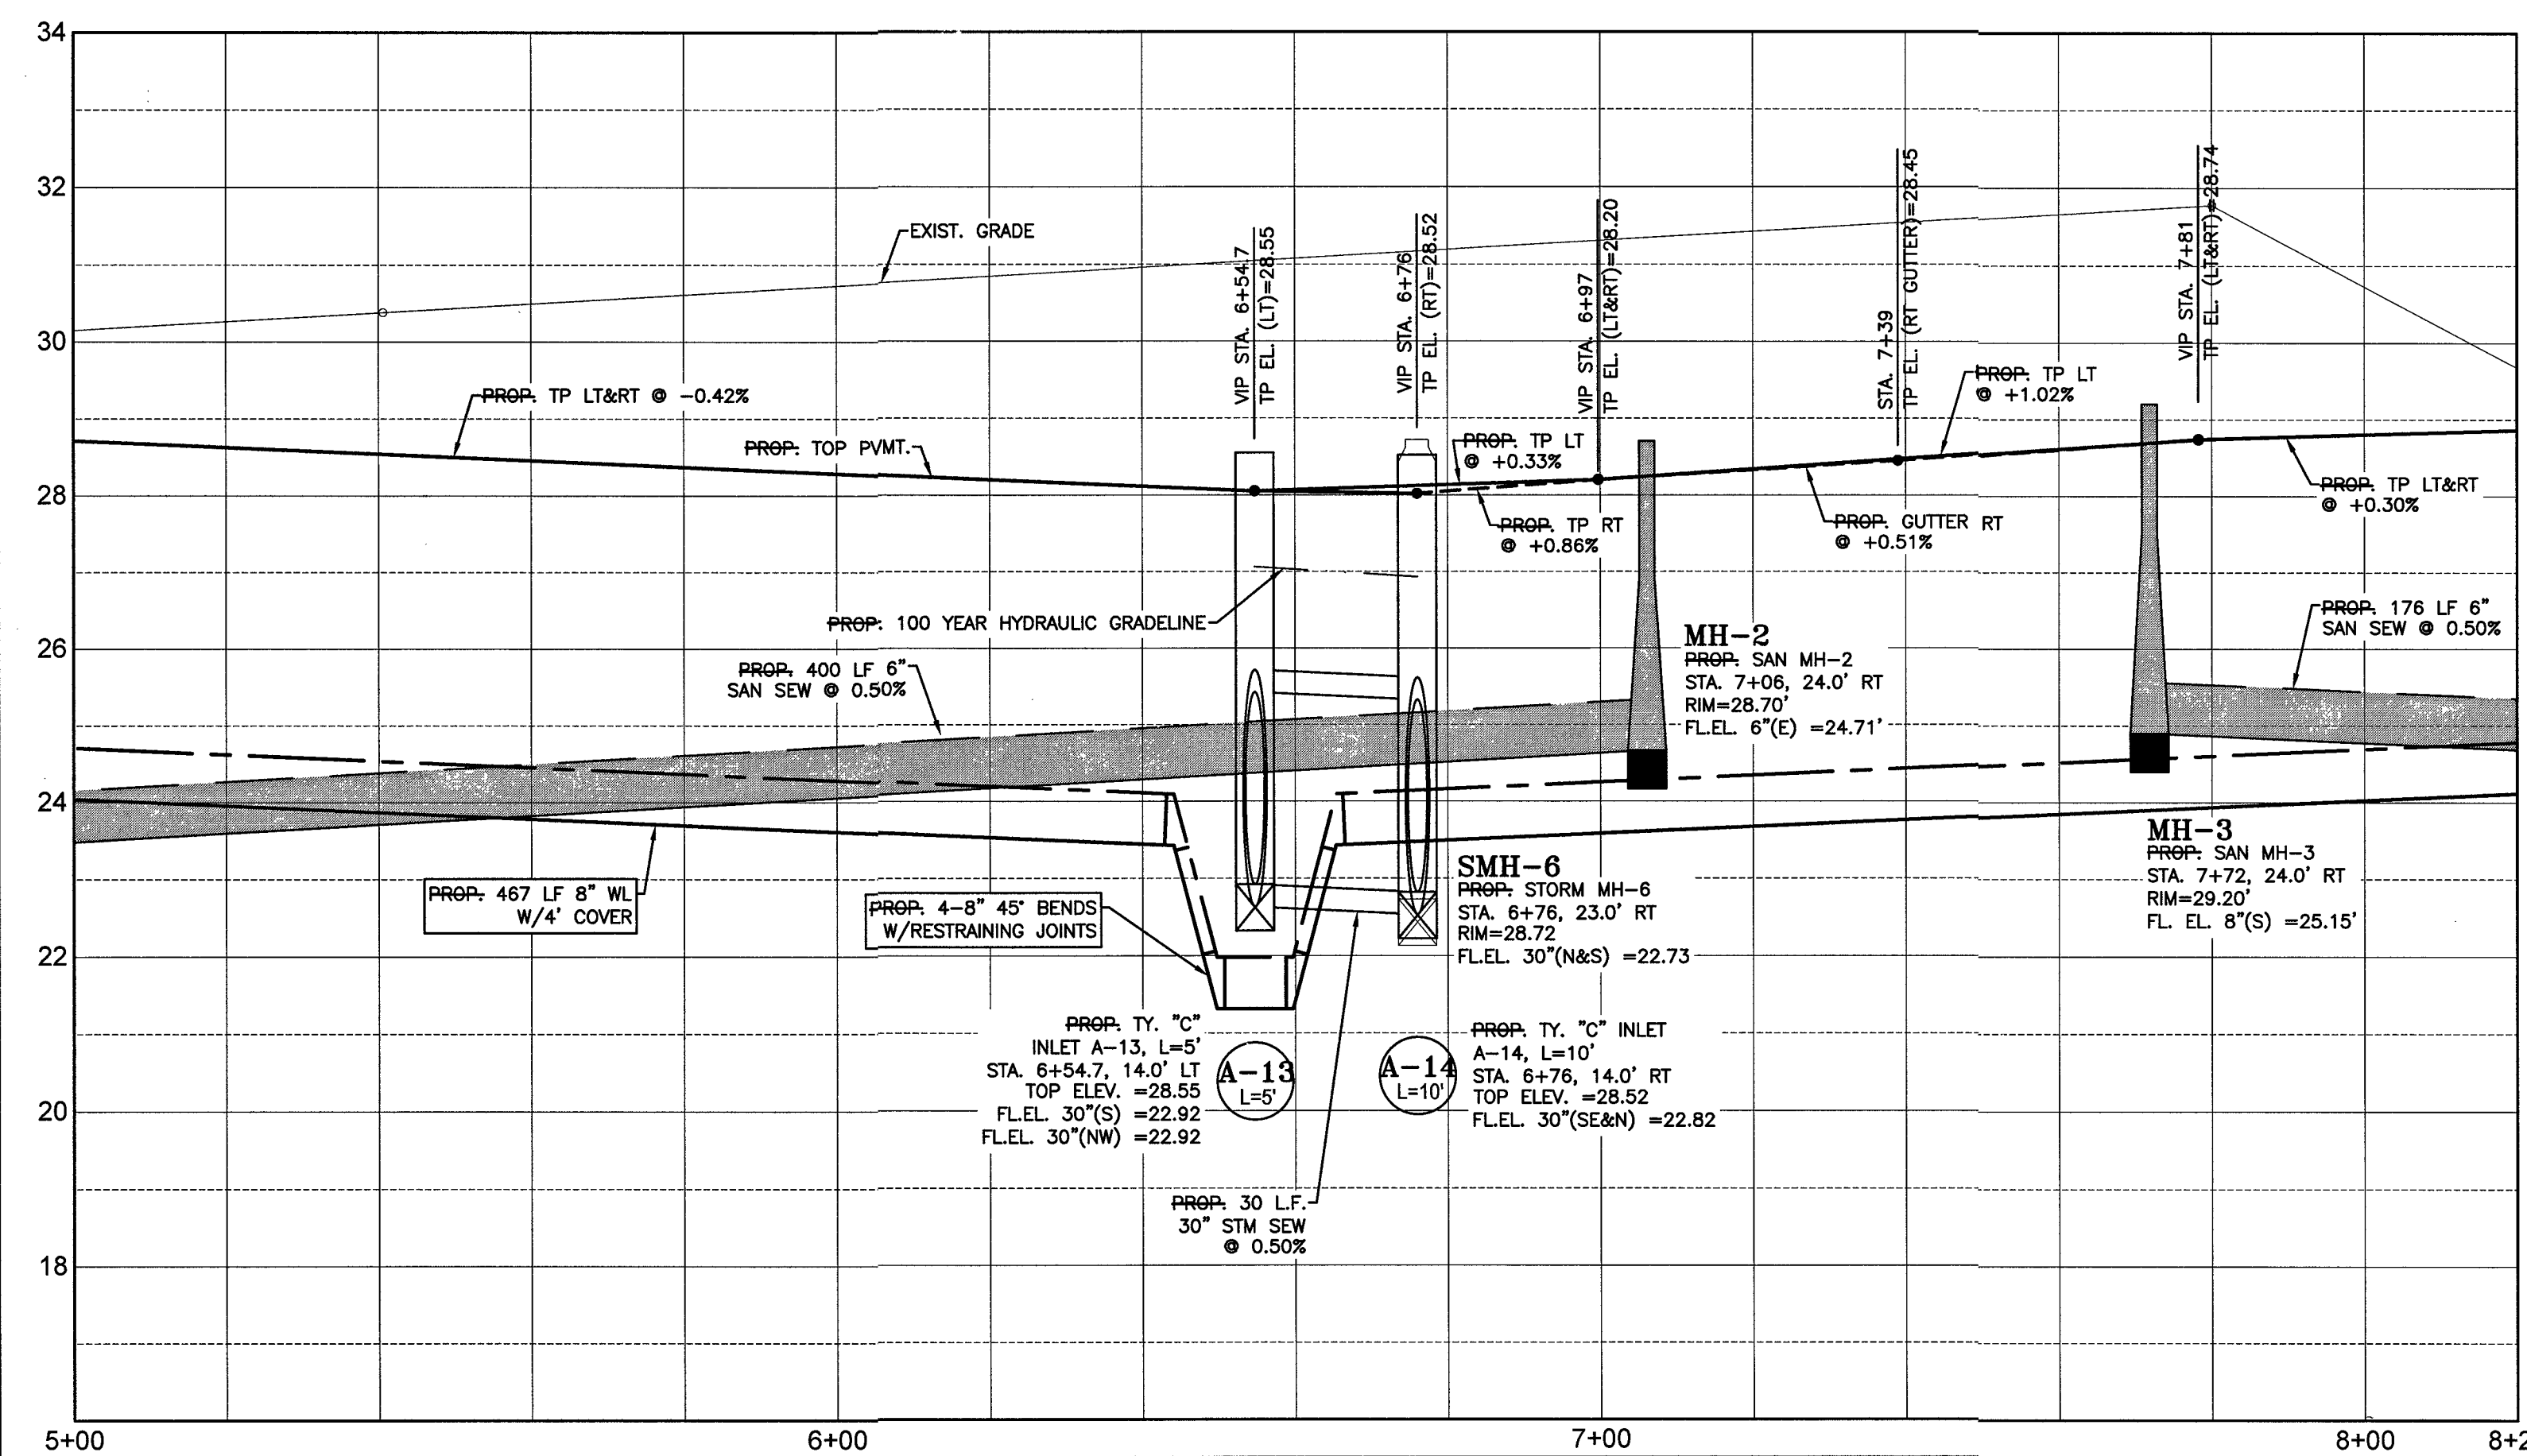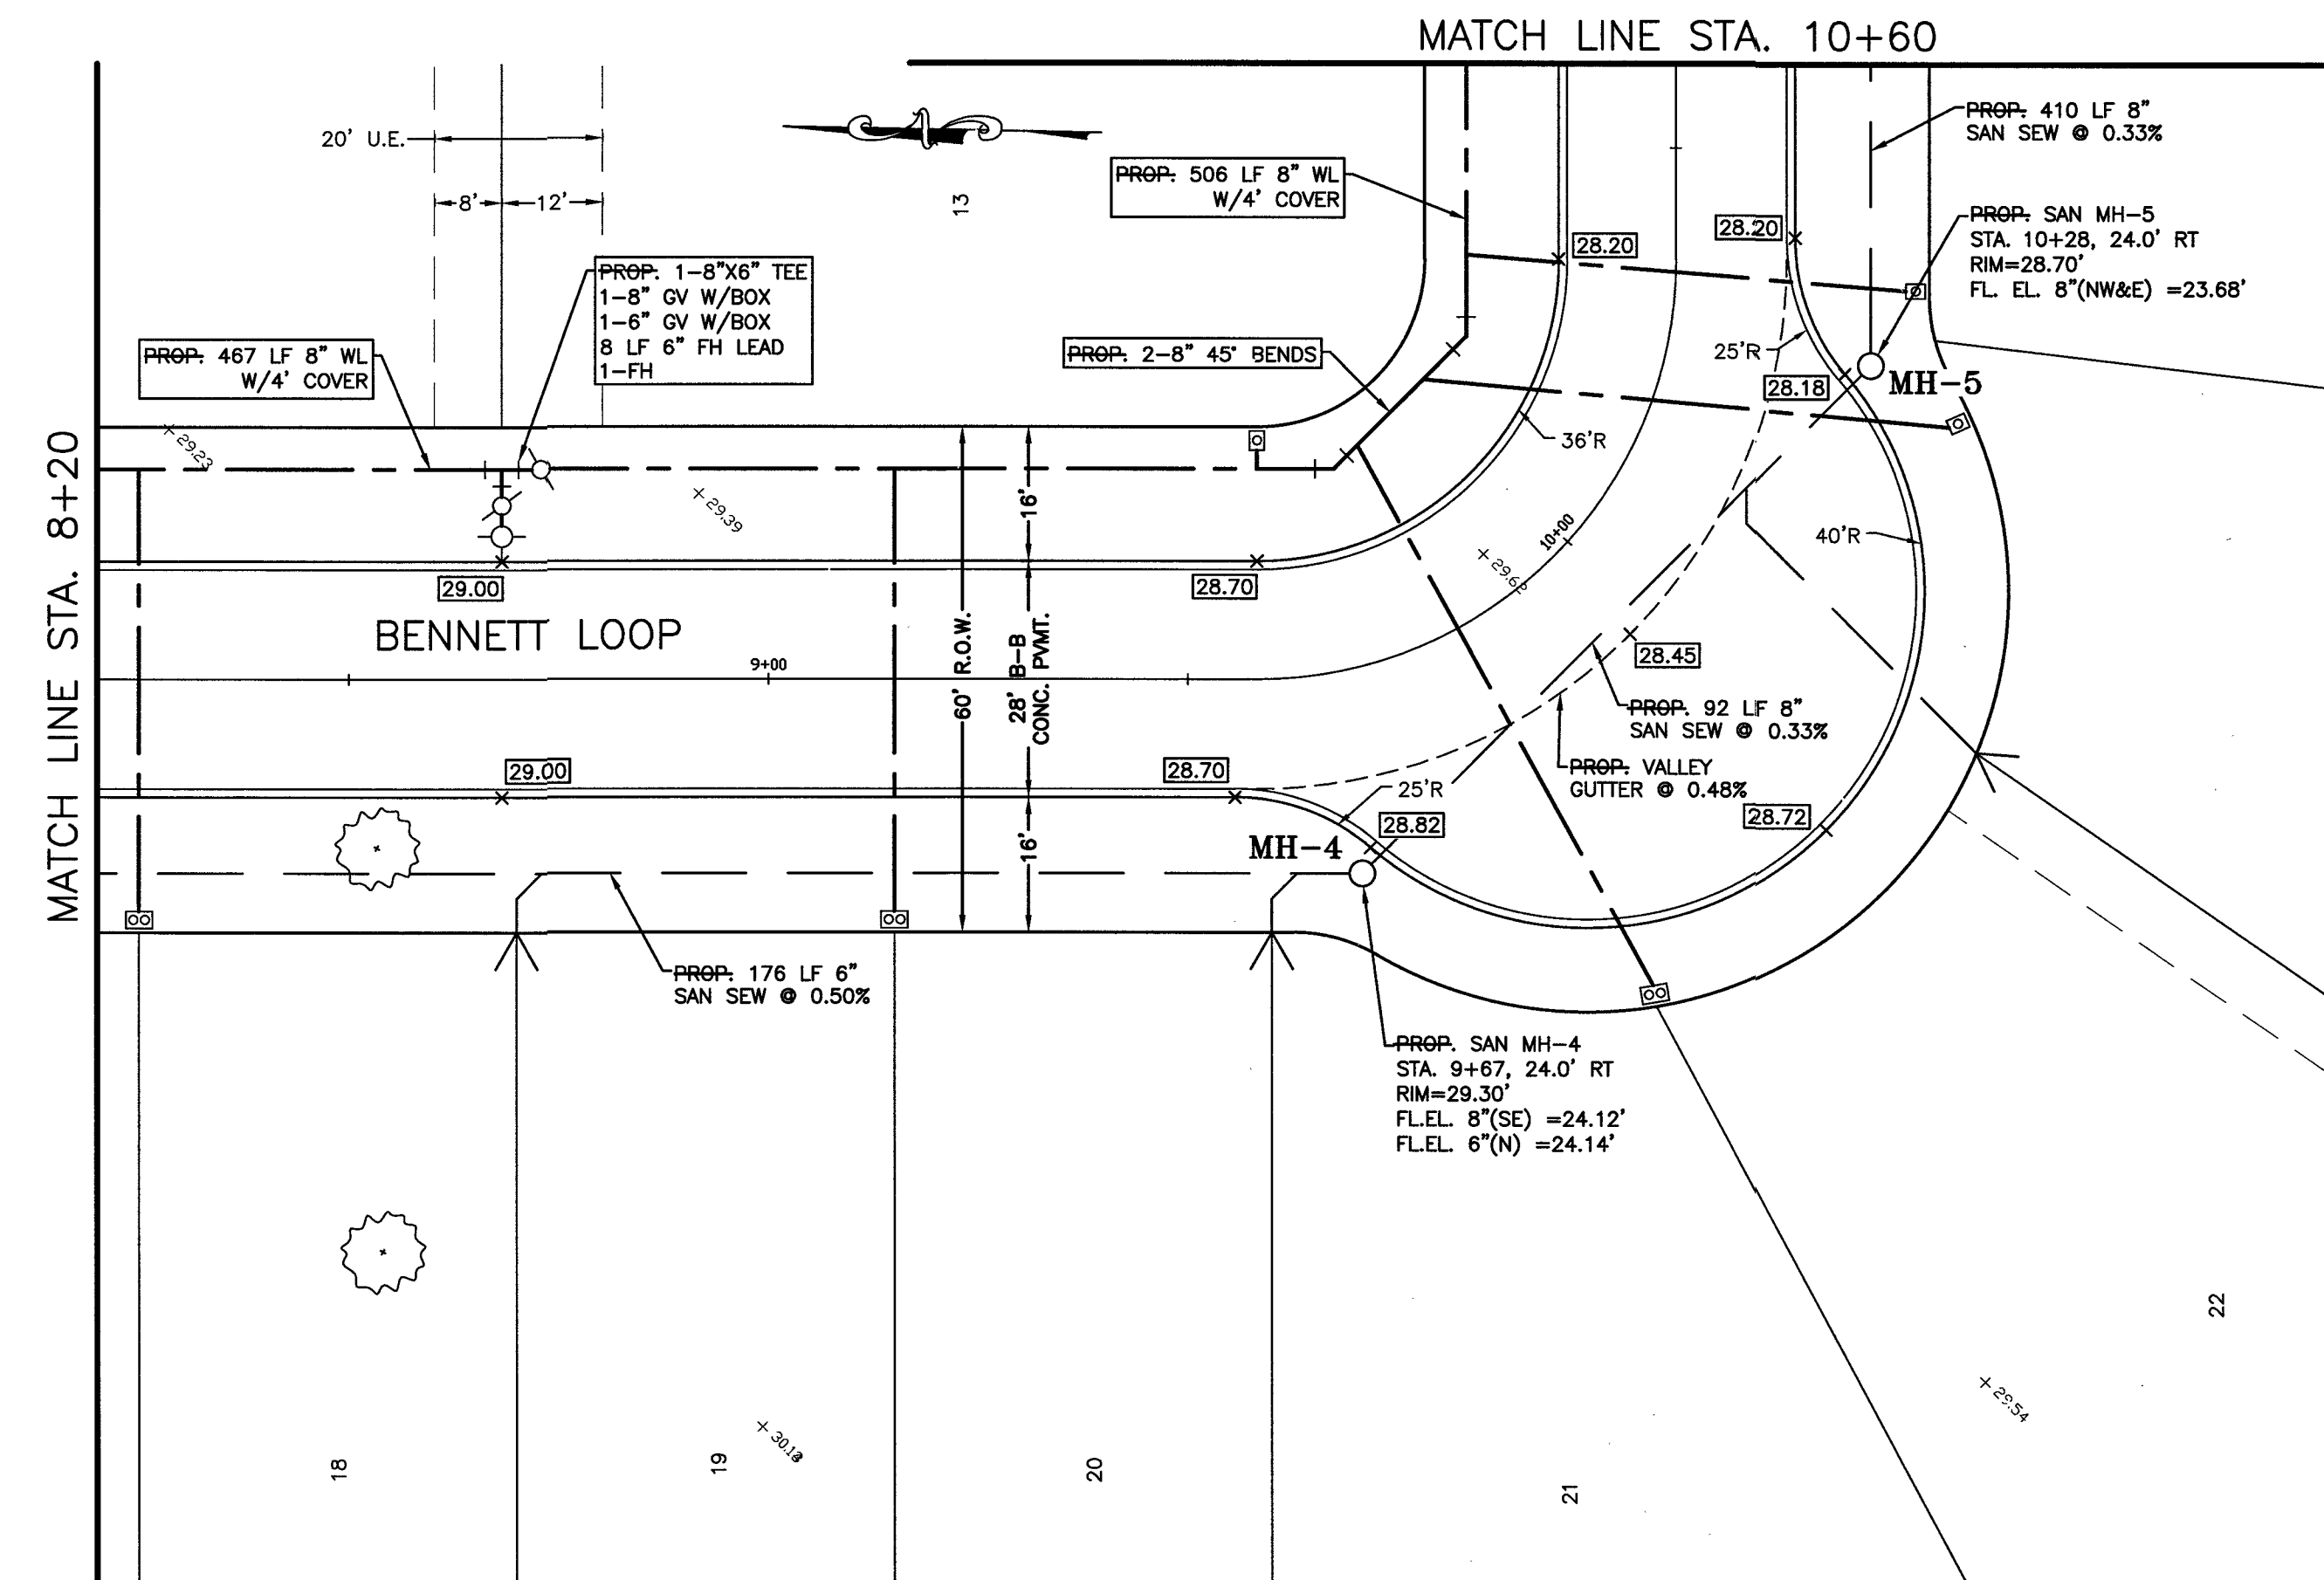
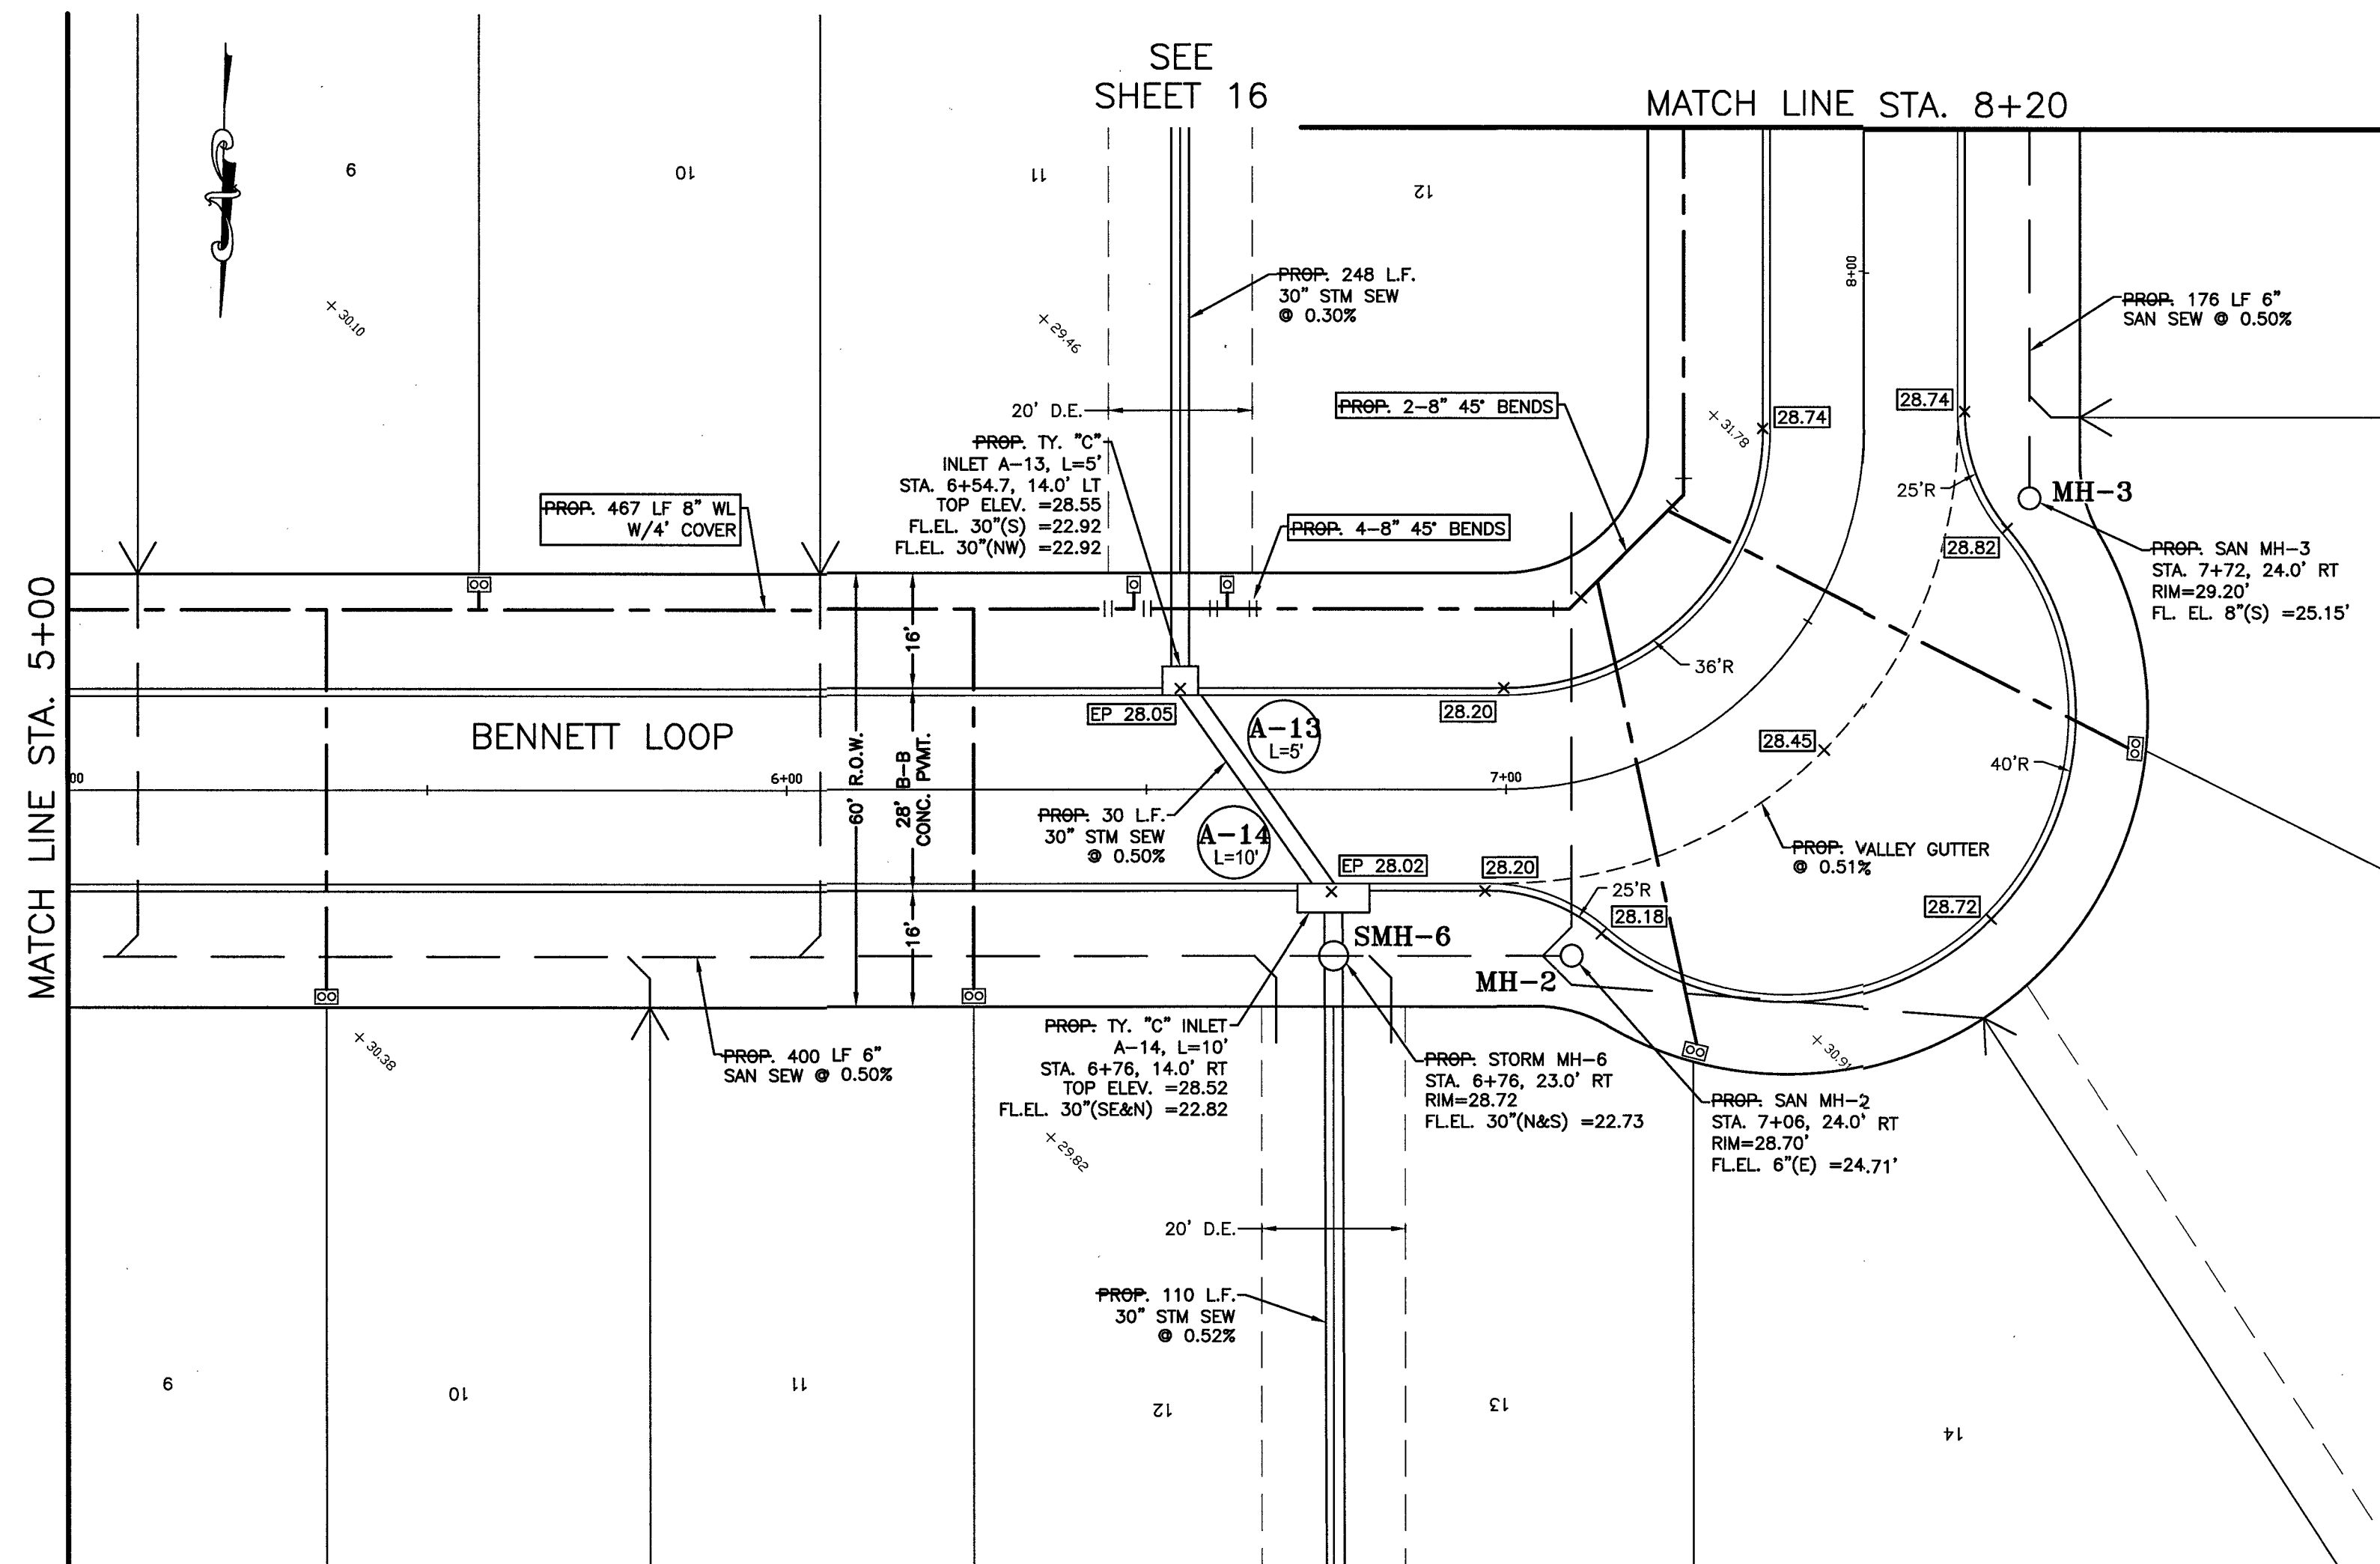


- SYMBOLS LEGEND**
- WATER METER
 - FIRE HYDRANT
 - WATER VALVE
 - TAPPING SLEEVE AND VALVE
 - REDUCER
 - STORM SEWER MANHOLE (SMH-1)
 - SANITARY SEWER MANHOLE (MH-1)
 - TOP BANK
 - STORM SEWER LINE (REINFORCED CONCRETE PIPE, ASTM C76)
 - SANITARY SEWER LINE (D3034, SDR 26, 160 PR)
 - WATERLINE (AWWA C900, CLASS 150, DR18)
 - TOP OF PAVEMENT AT EDGE

RECORD DRAWING

NO.	DATE	DESCRIPTION	APPROVED

DESIGNED	DR
DRAWN	BT
CHECKED	
DATE	

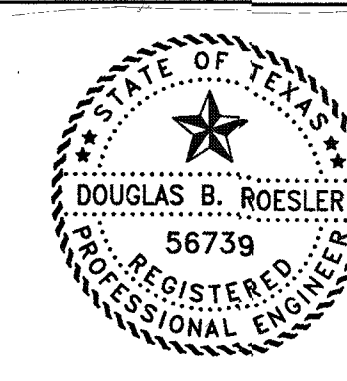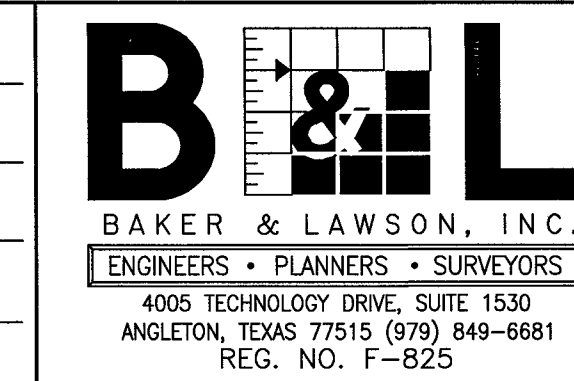

The seal appearing on this document was authorized by Douglas B. Roesler, P.E. 56739. Date: 04-16-22

OWNER:
RIVERWAY PROPERTIES
6115 SKYLINE DR. STE A.
HOUSTON, TEXAS 77057


PLAN: 1" = 20'
PROFILE:
HORIZONTAL: 1" = 2'
VERTICAL: 1" = 20'









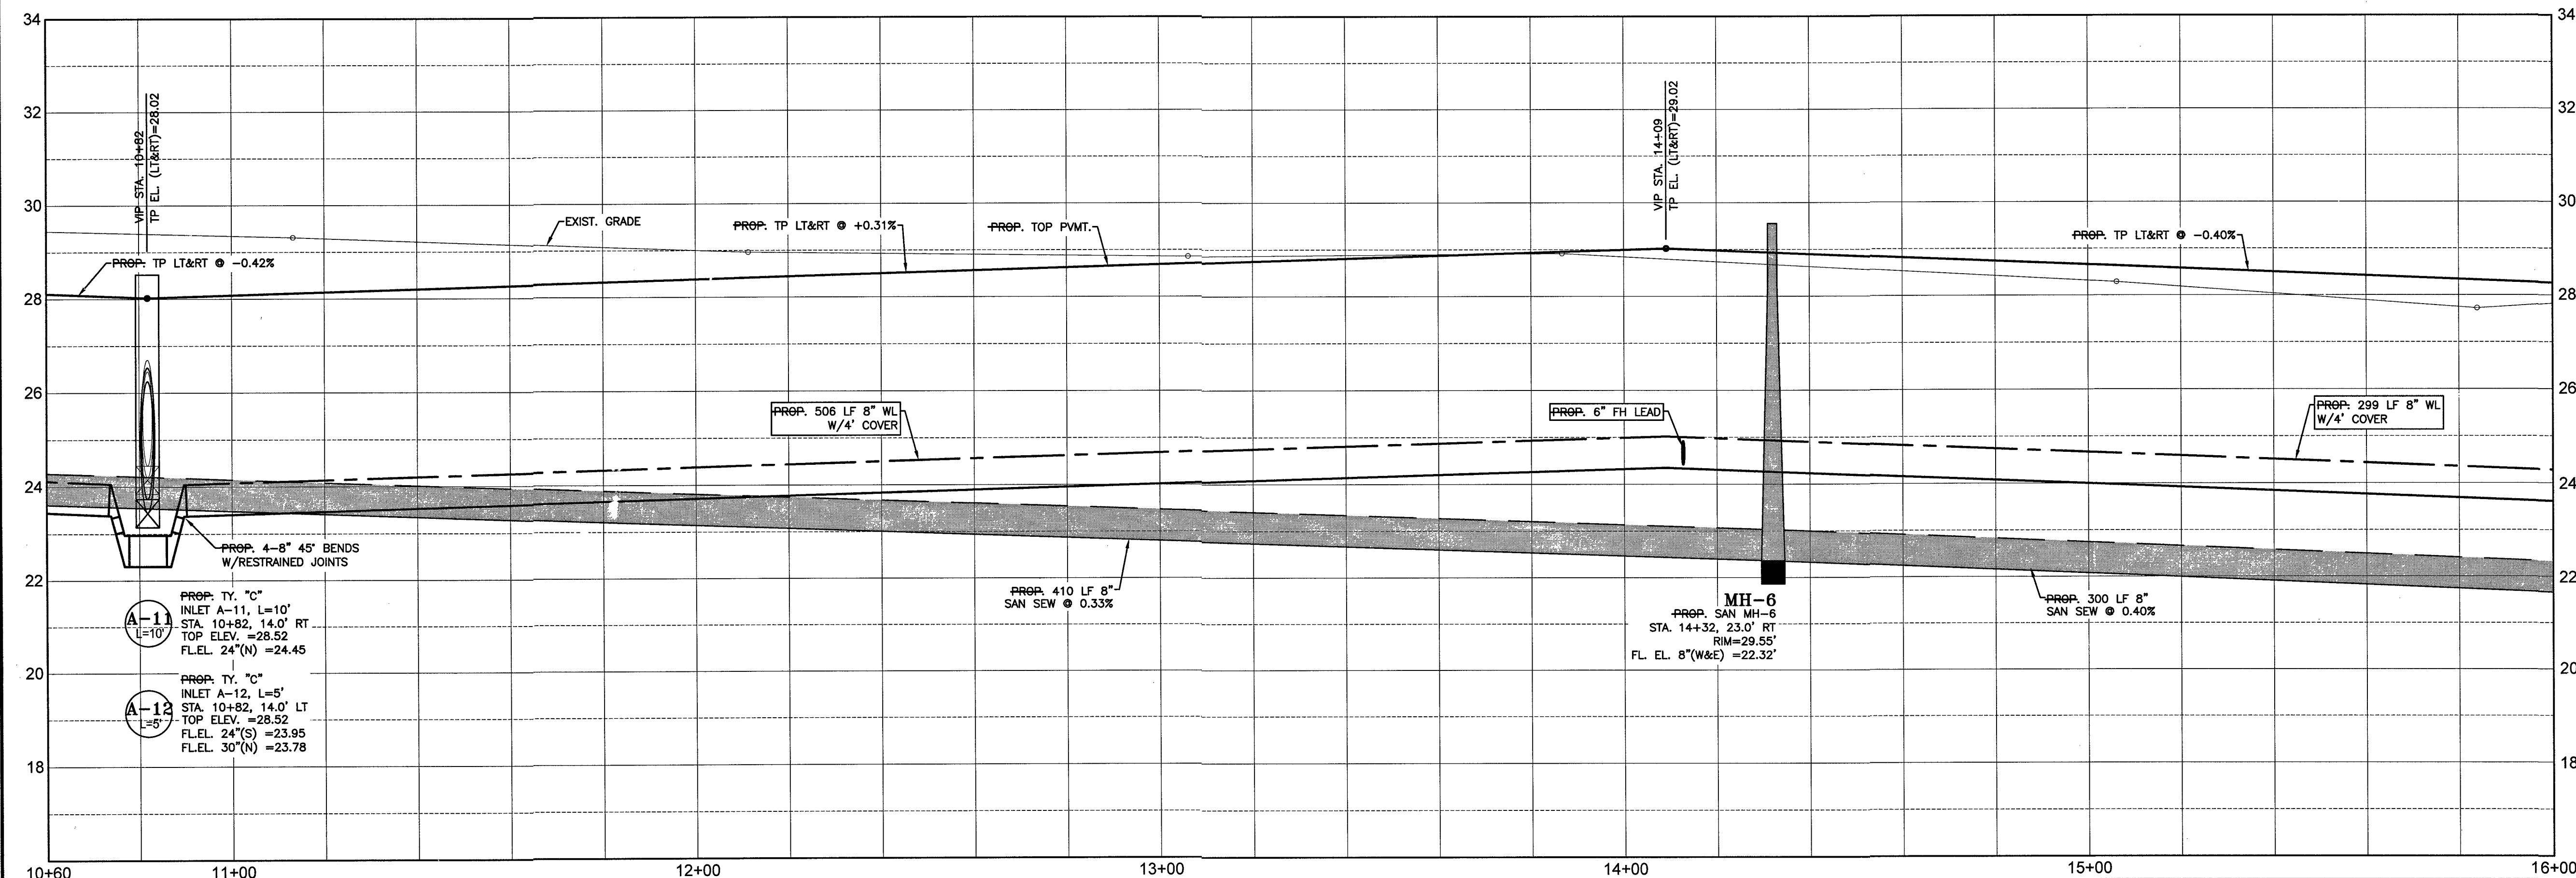





RIVERWOOD RANCH SUBDIVISION
SECTION 2
A 78 AC, 109-LOT SUBDIVISION
ANGLETON, TEXAS 77515

PLAN & PROFILE
BENNETT LOOP
STA. 5+00 TO 10+60

PROJECT NO. 14395


A graphic scale bar is shown below the map, with markings for 10, 20, and 40 units. Below the scale bar, the text "SCALE : 1" = 20'" is printed. To the right of the scale bar, a north arrow is depicted, consisting of a vertical line with a decorative, curved arrowhead pointing upwards.






- | | |
|---|---|
|  | WATER METER |
|  | FIRE HYDRANT |
|  | WATER VALVE |
|  | TAPPING SLEEVE AND VALVE |
|  | REDUCER |
|  | STORM SEWER MANHOLE (SMH-1) |
|  | SANITARY SEWER MANHOLE (MH-1) |
|  | TOP BANK |
|  | STORM SEWER LINE |
|  | (REINFORCED CONCRETE PIPE,
ASTM C76) |
|  | SANITARY SEWER LINE |
|  | (D3034, SDR 26, 160 PR) |
|  | WATERLINE (AWWA C900,
CLASS 150, DR18) |
|  | TOP OF PAVEMENT AT EDGE |

NO.	DATE	DESCRIPTION	APPROVED
REVISIONS			

B L
BAKER & LAWSON, INC.
ENGINEERS • PLANNERS • SURVEYORS
4005 TECHNOLOGY DRIVE, SUITE 1530
ANGLETON, TEXAS 77515 (979) 849-6681
REG. NO. F-825

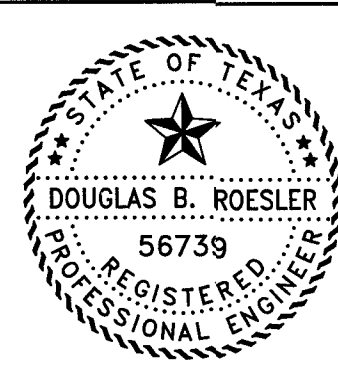

PROJECT NO. 14395

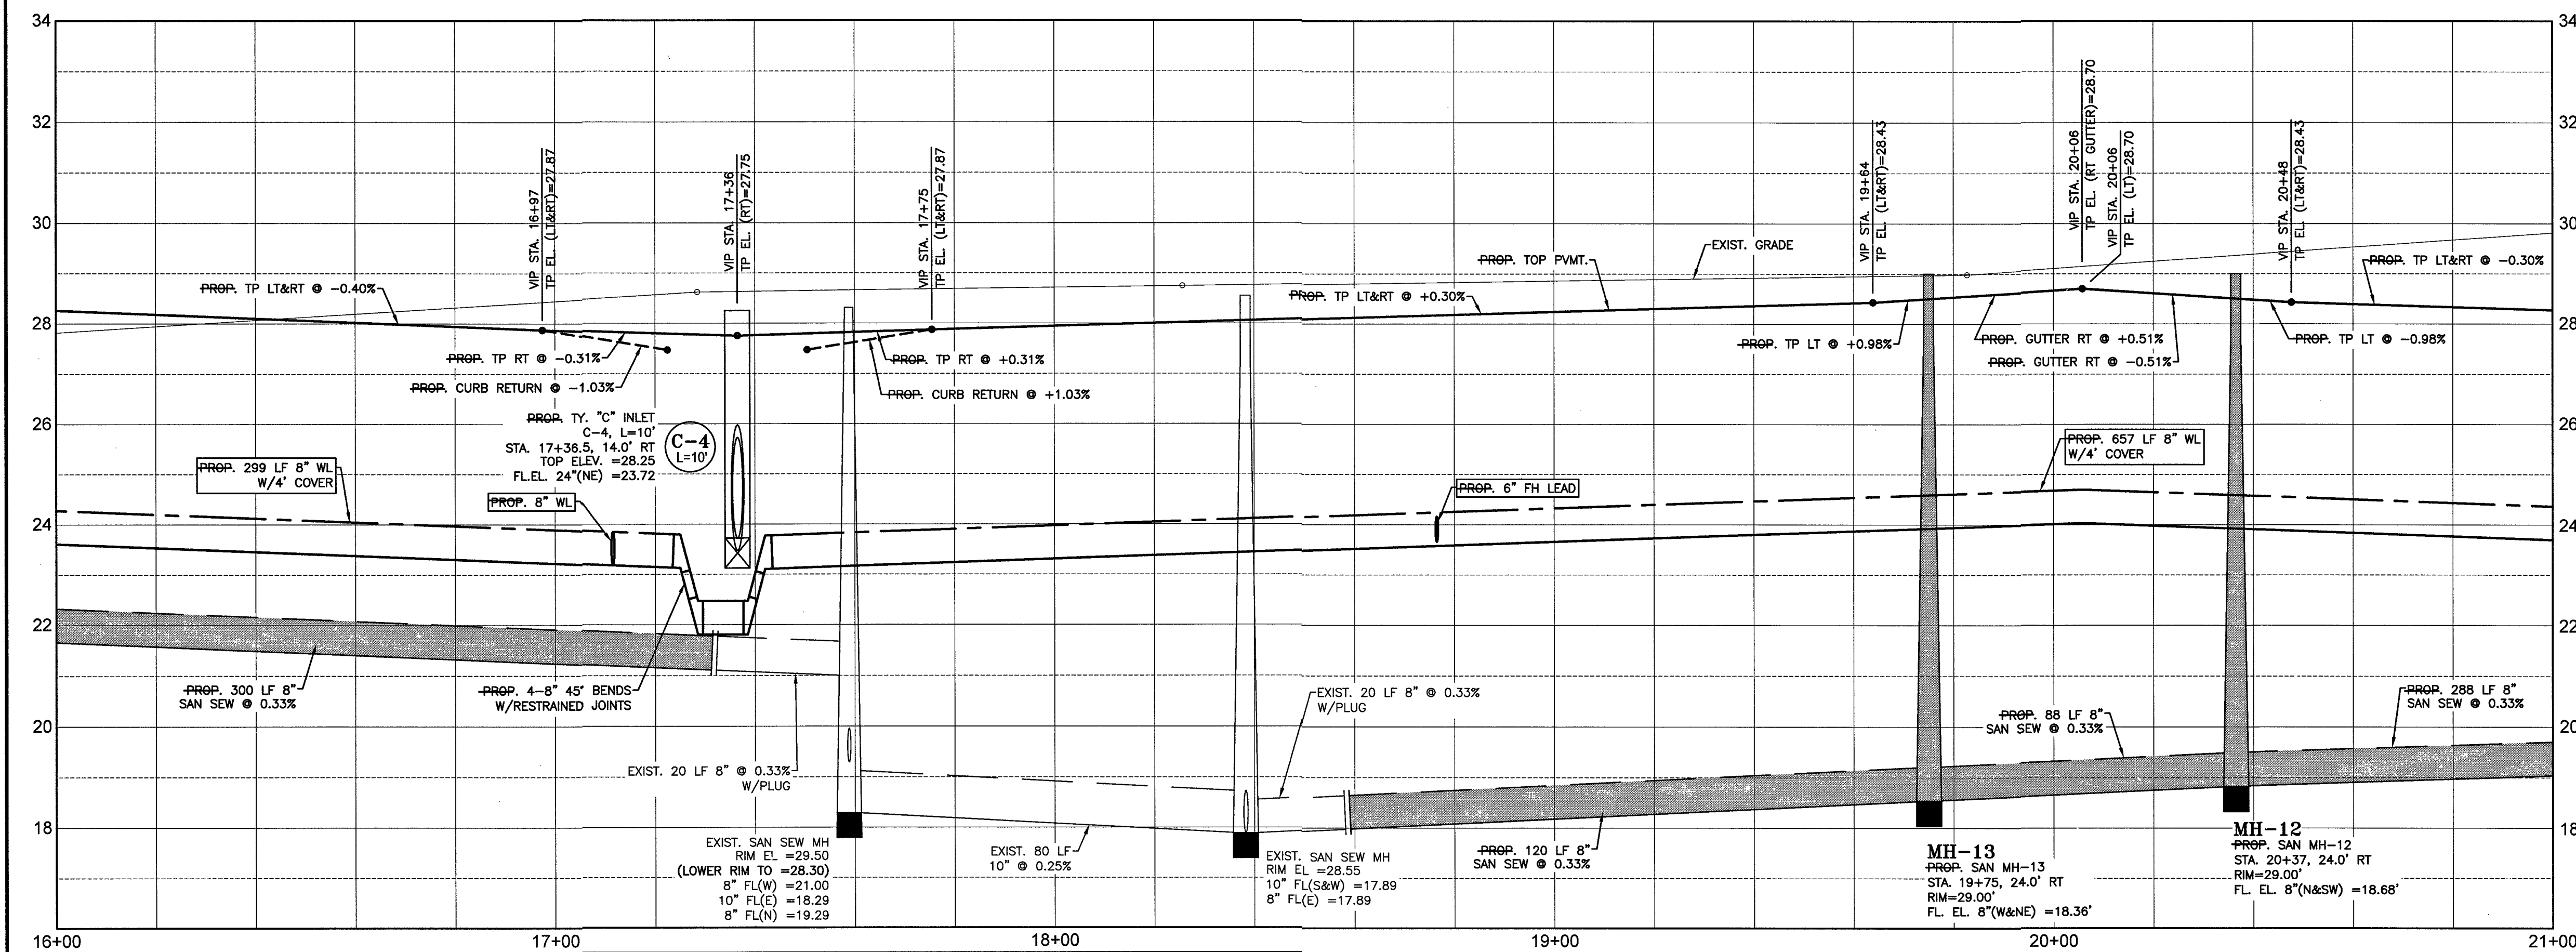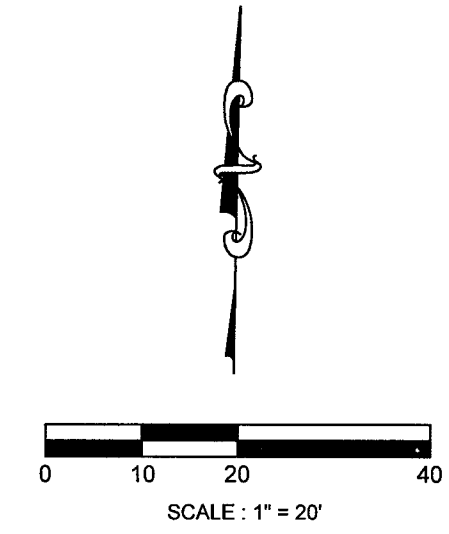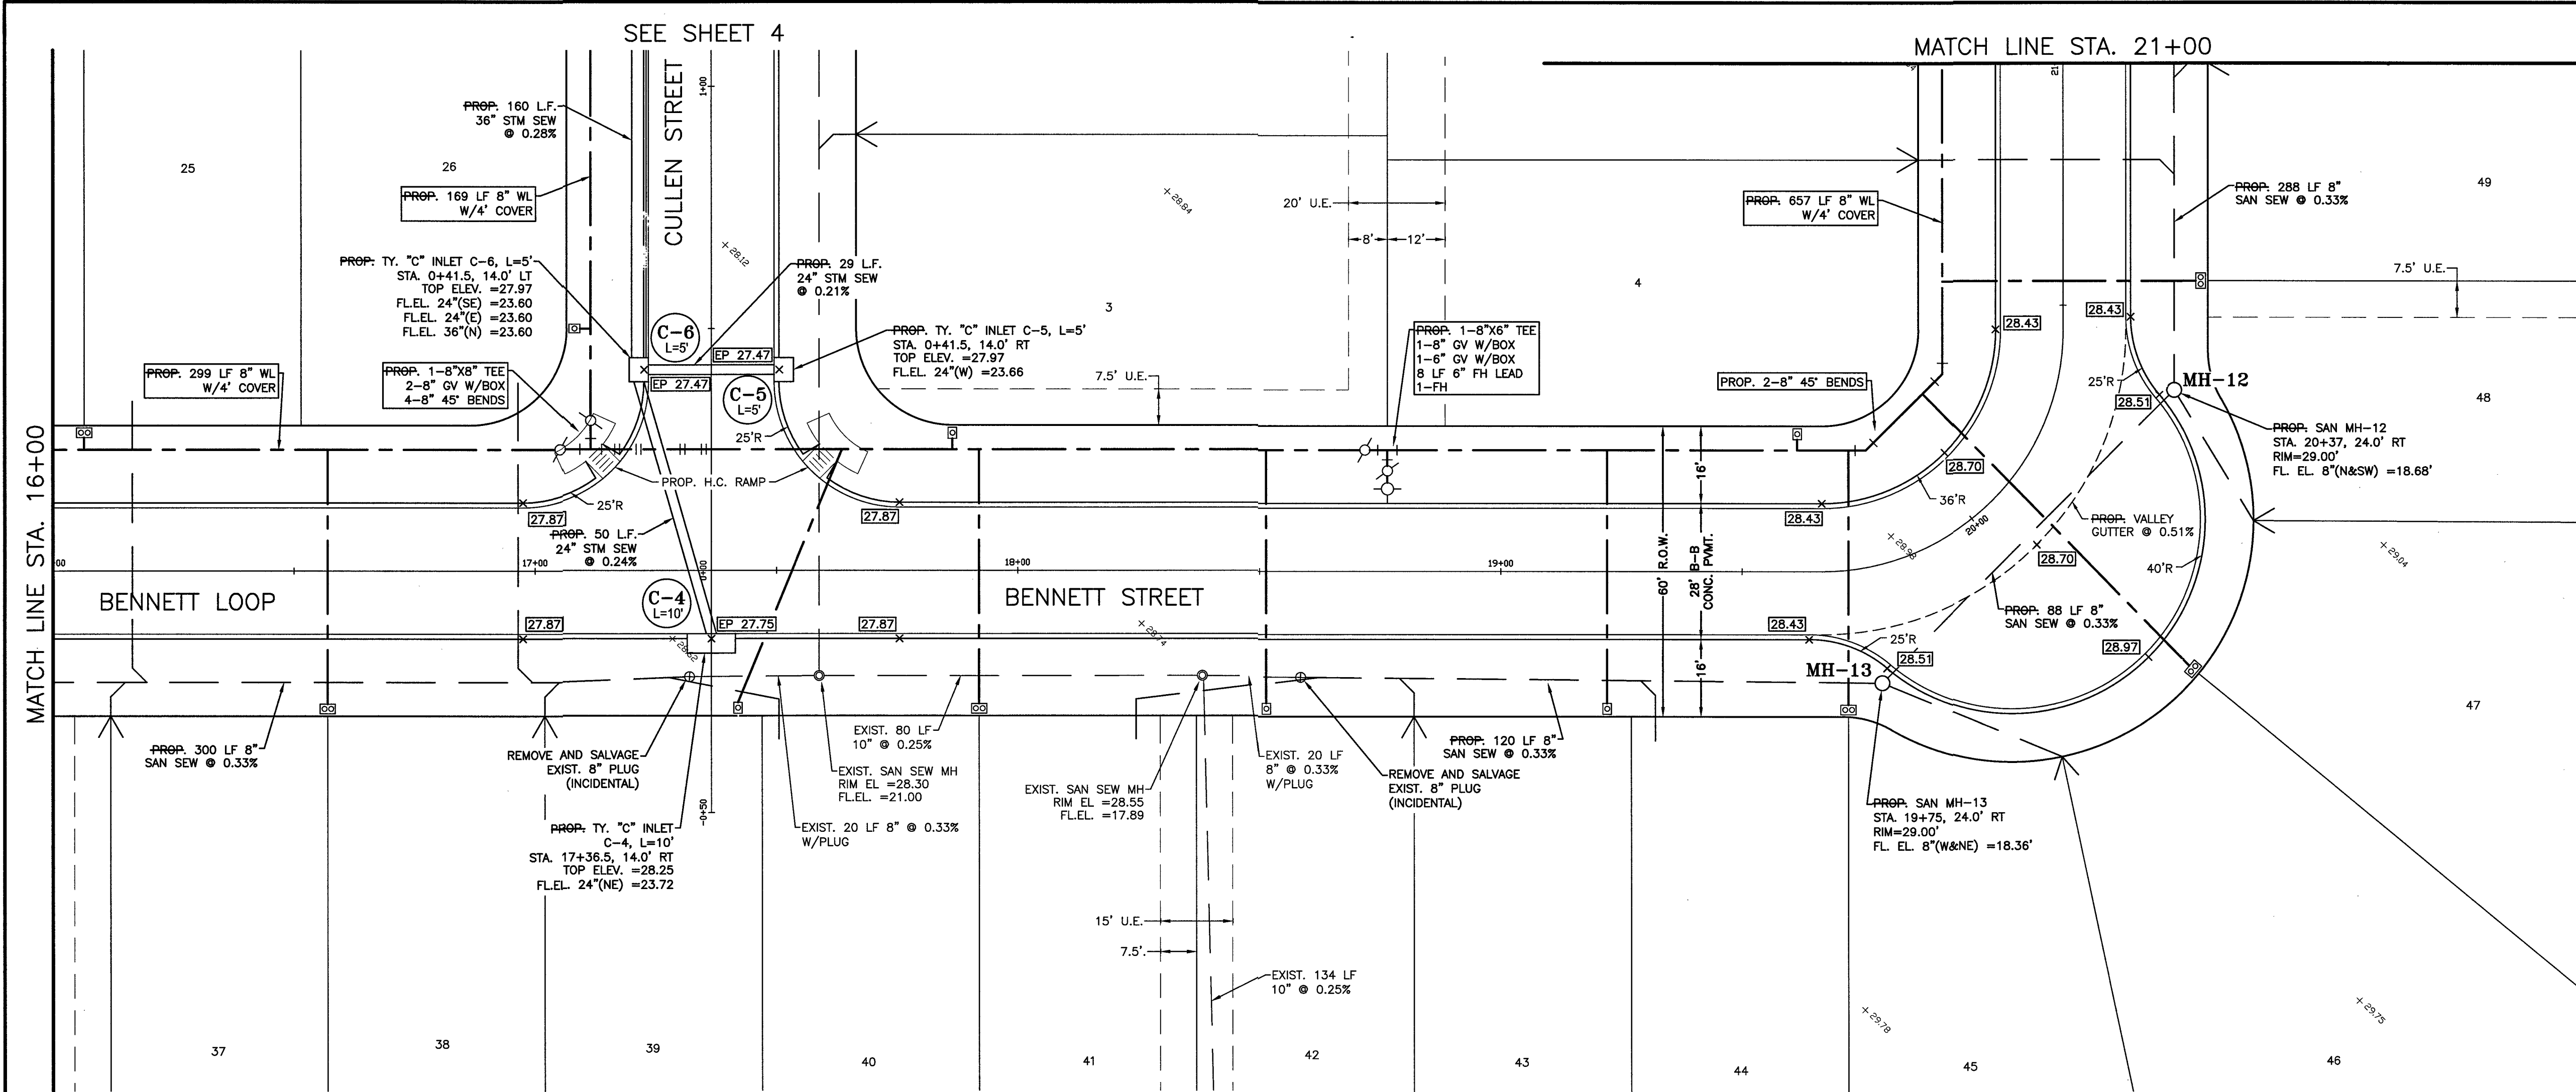


- SYMBOLS LEGEND**
- WATER METER
 - FIRE HYDRANT
 - WATER VALVE
 - TAPPING SLEEVE AND VALVE
 - REDUCER
 - STORM SEWER MANHOLE (SMH-1)
 - SANITARY SEWER MANHOLE (MH-1)
 - TOP BANK
 - STORM SEWER LINE (REINFORCED CONCRETE PIPE, ASTM C76)
 - SANITARY SEWER LINE (D3034, SDR 26, 160 PR)
 - WATERLINE (AWWA C900, CLASS 150, DR18)
 - TOP OF PAVEMENT AT EDGE

RECORD DRAWING

NO.	DATE	DESCRIPTION	APPROVED

DESIGNED	DR
DRAWN	BT
CHECKED	
DAT	

B & L
BAKER & LAWSON, INC.
ENGINEERS • PLANNERS • SURVEYORS
4005 TECHNOLOGY DRIVE, SUITE 1530
ANGLETON, TEXAS 77515 (979) 849-6681
REG. NO. F-825

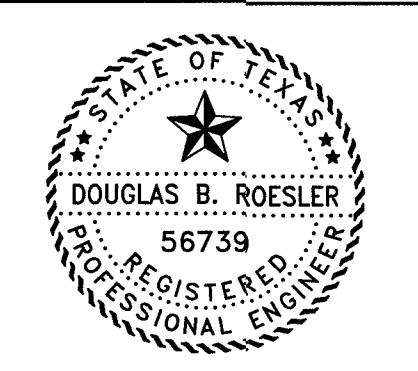

The seal appearing on this document was authorized by Douglas B. Roesler, P.E. 56739
Date: 04-18-00

OWNER:
RIVERWAY PROPERTIES
6115 SKYLINE DR. STE A.
HOUSTON, TEXAS 77057



PLAN: 1" = 20'
PROFILE: 1" = 2'
HORIZONTAL: 1" = 2'
VERTICAL: 1" = 20'

RIVERWOOD RANCH SUBDIVISION
SECTION 2
A 78 AC, 109-LOT SUBDIVISION
ANGLETON, TEXAS 77515



PLAN & PROFILE
BENNETT STREET
STA. 16+00 TO 21+00

PROJECT NO. 14395

SEE SHEET 17

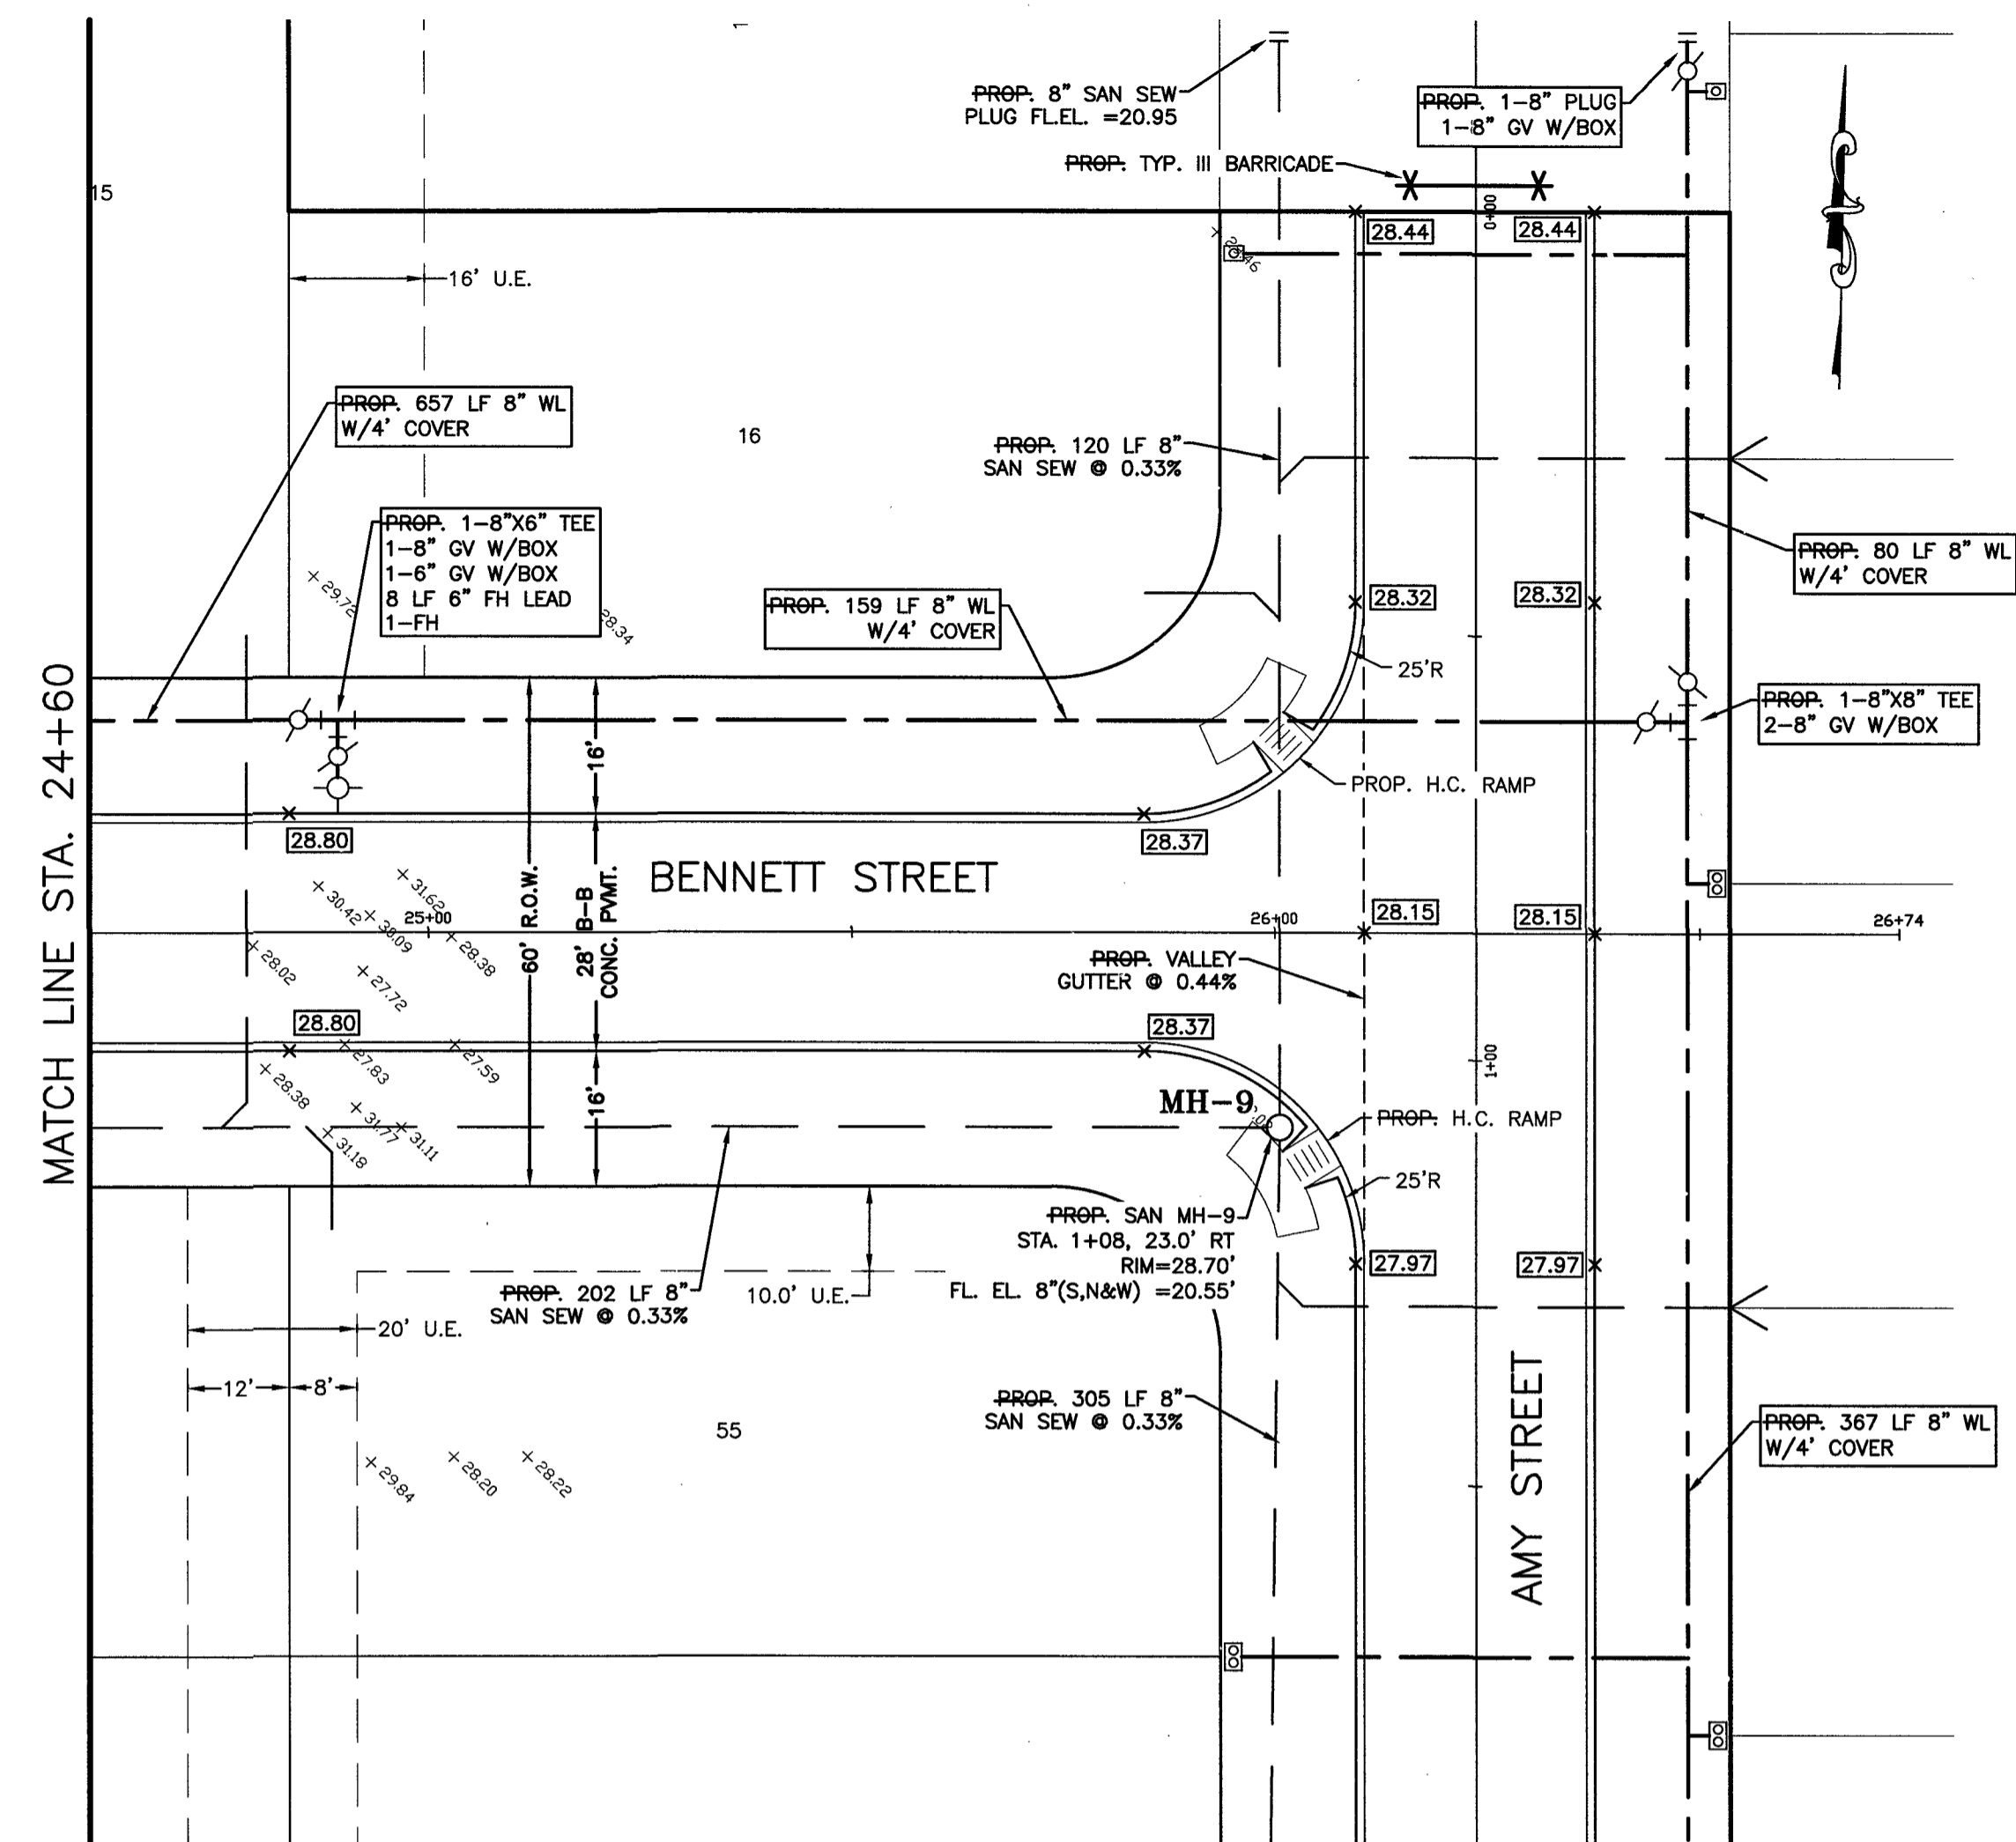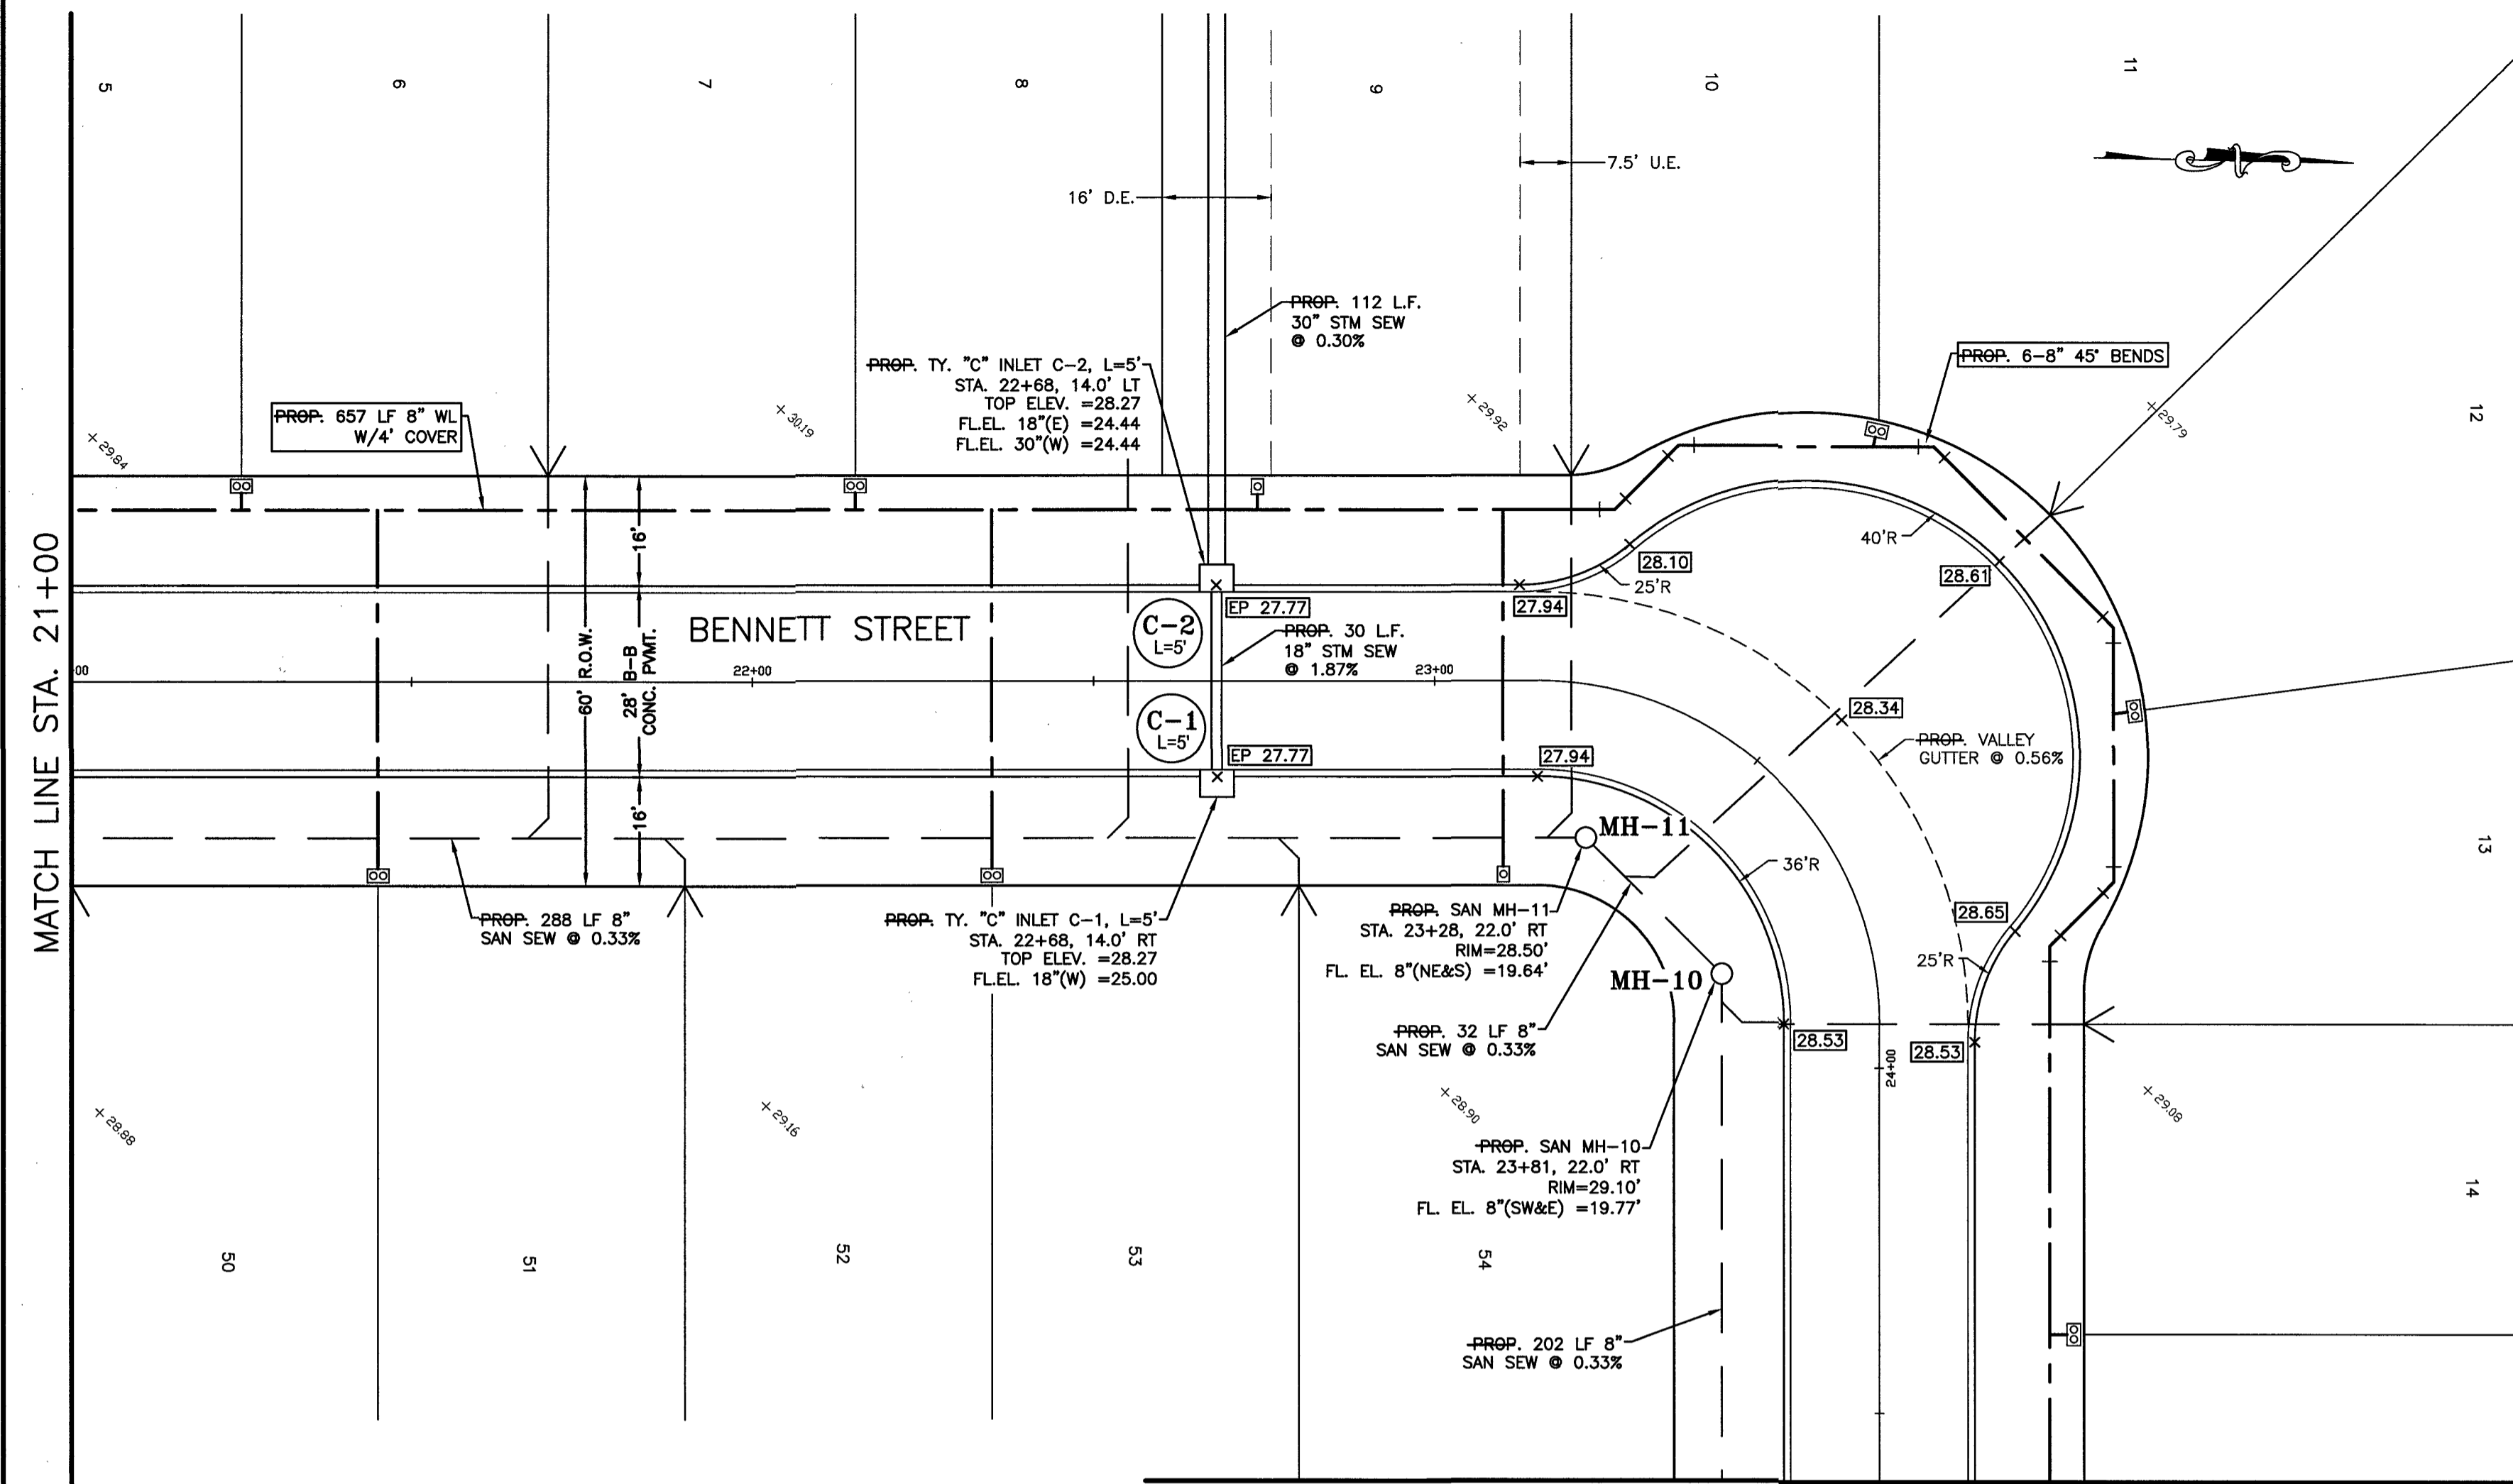

MATCH LINE STA. 24+60

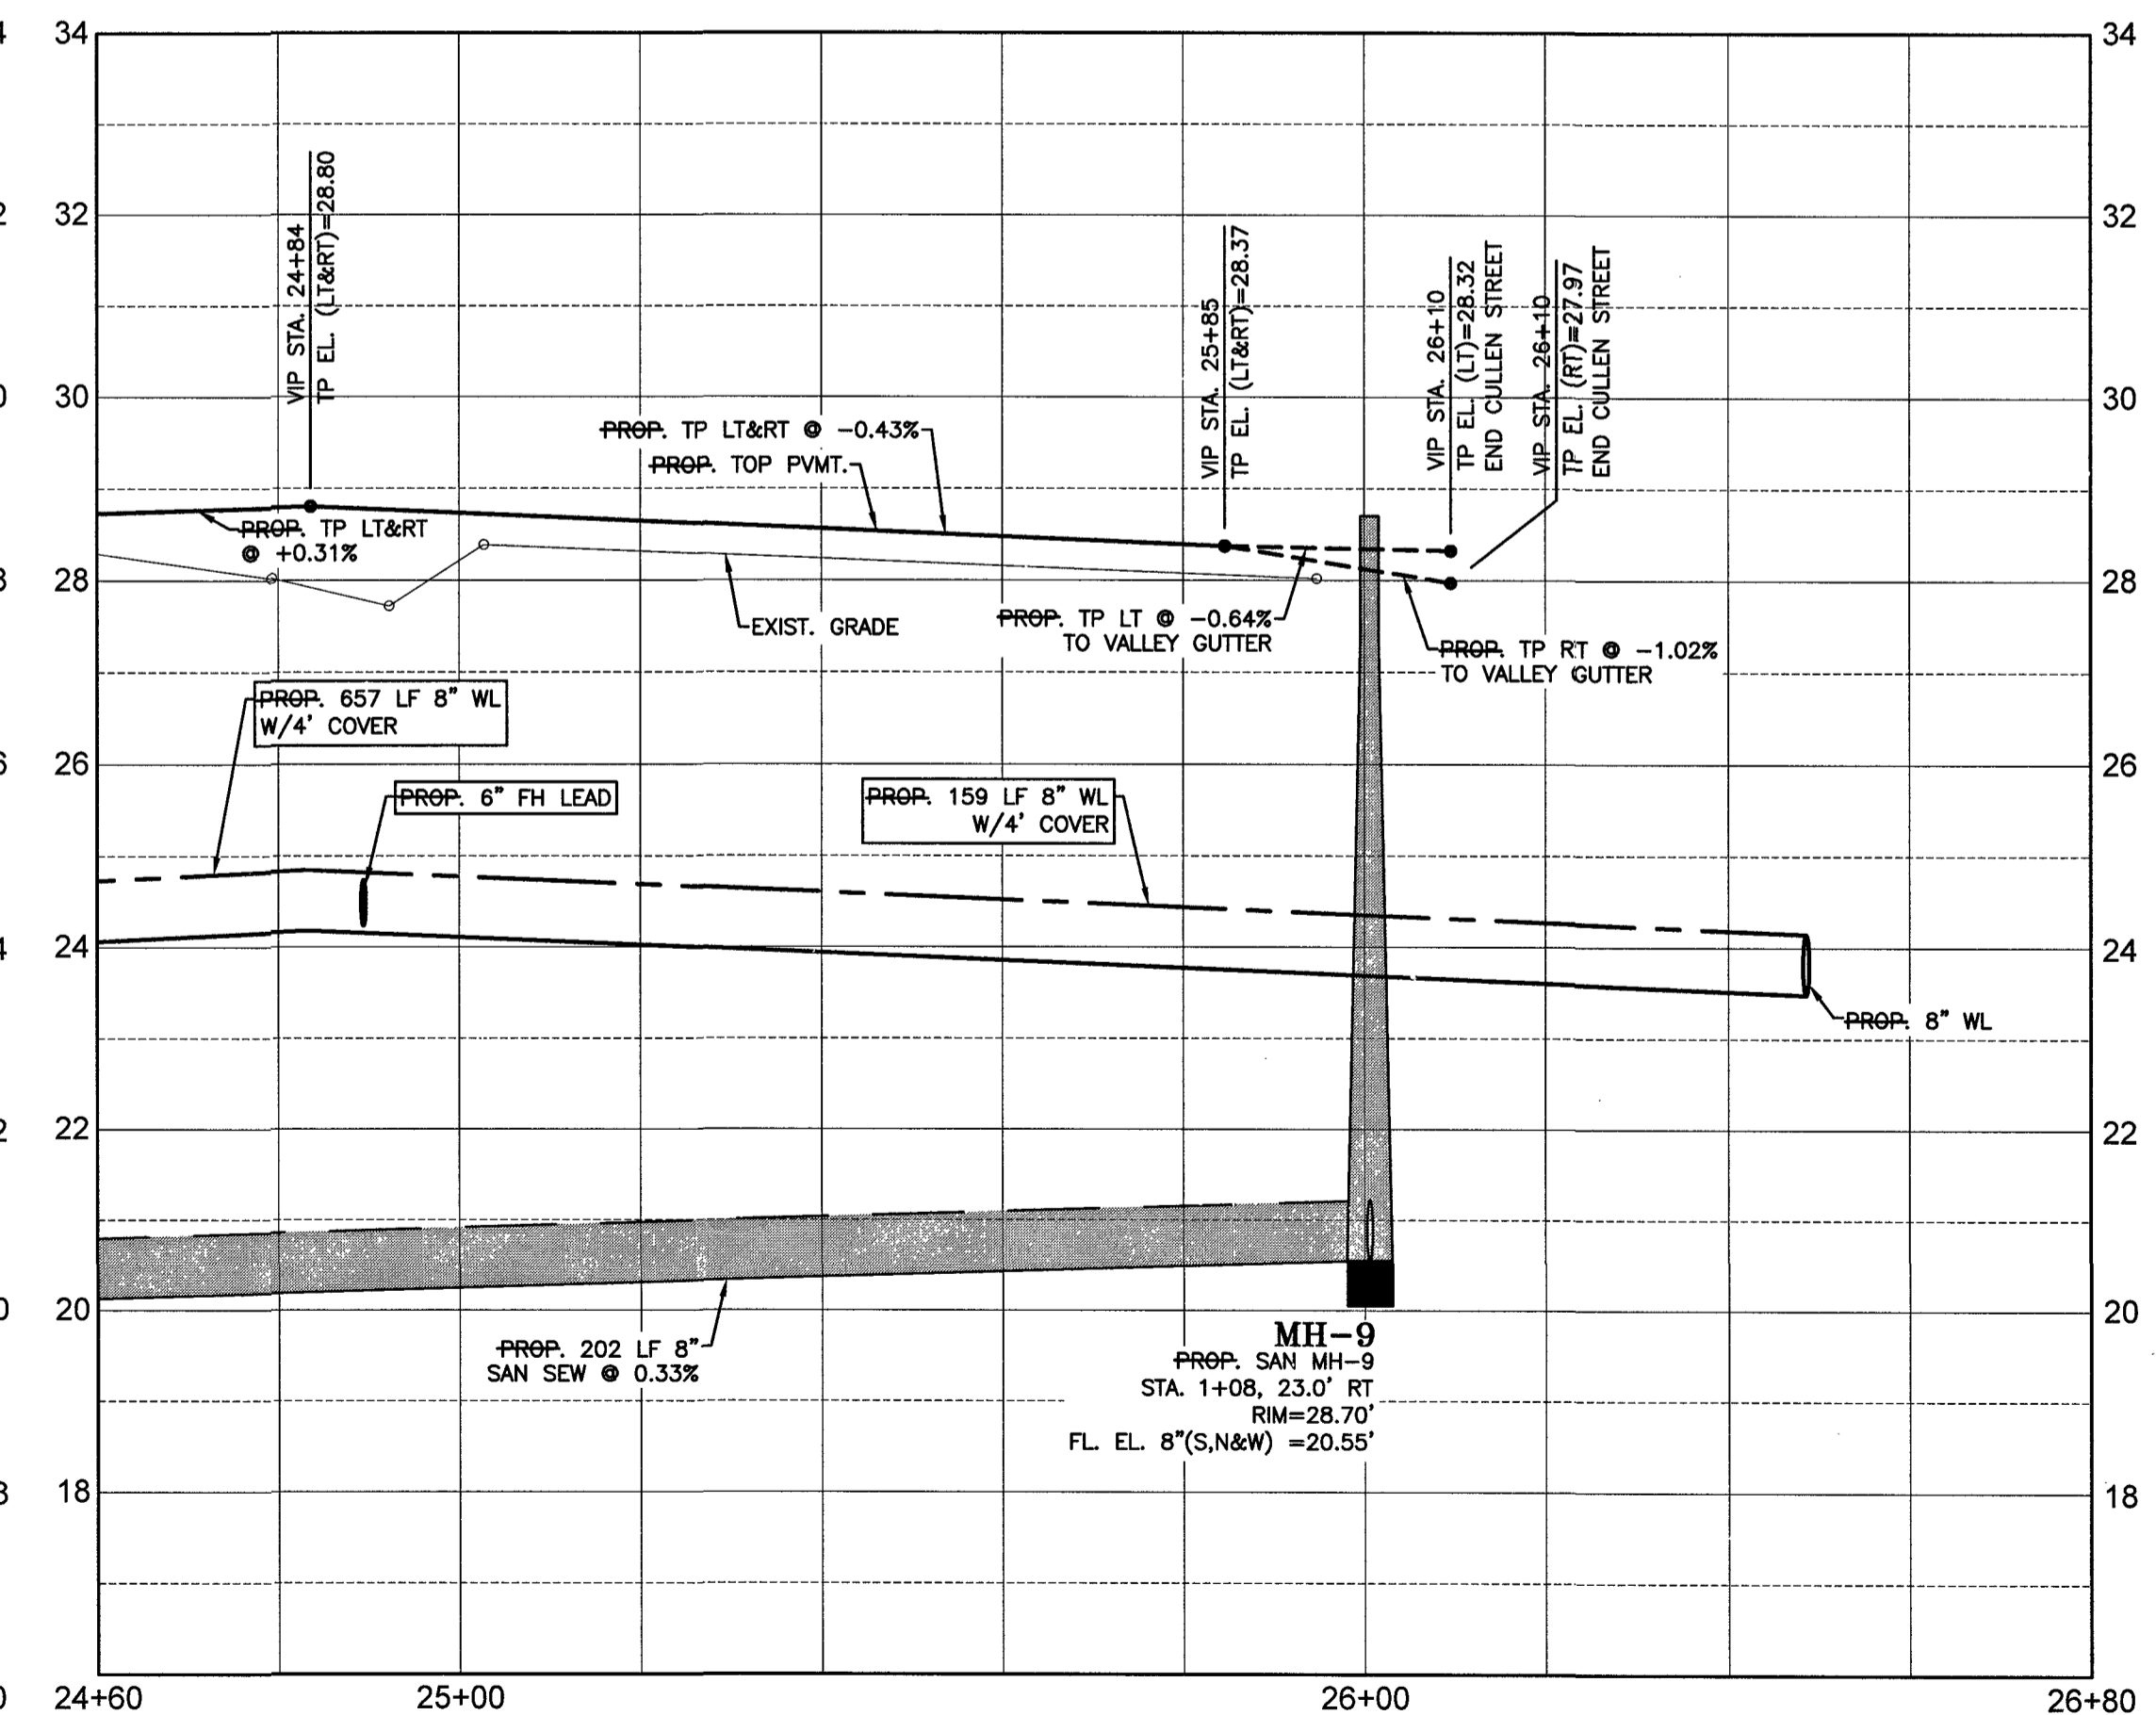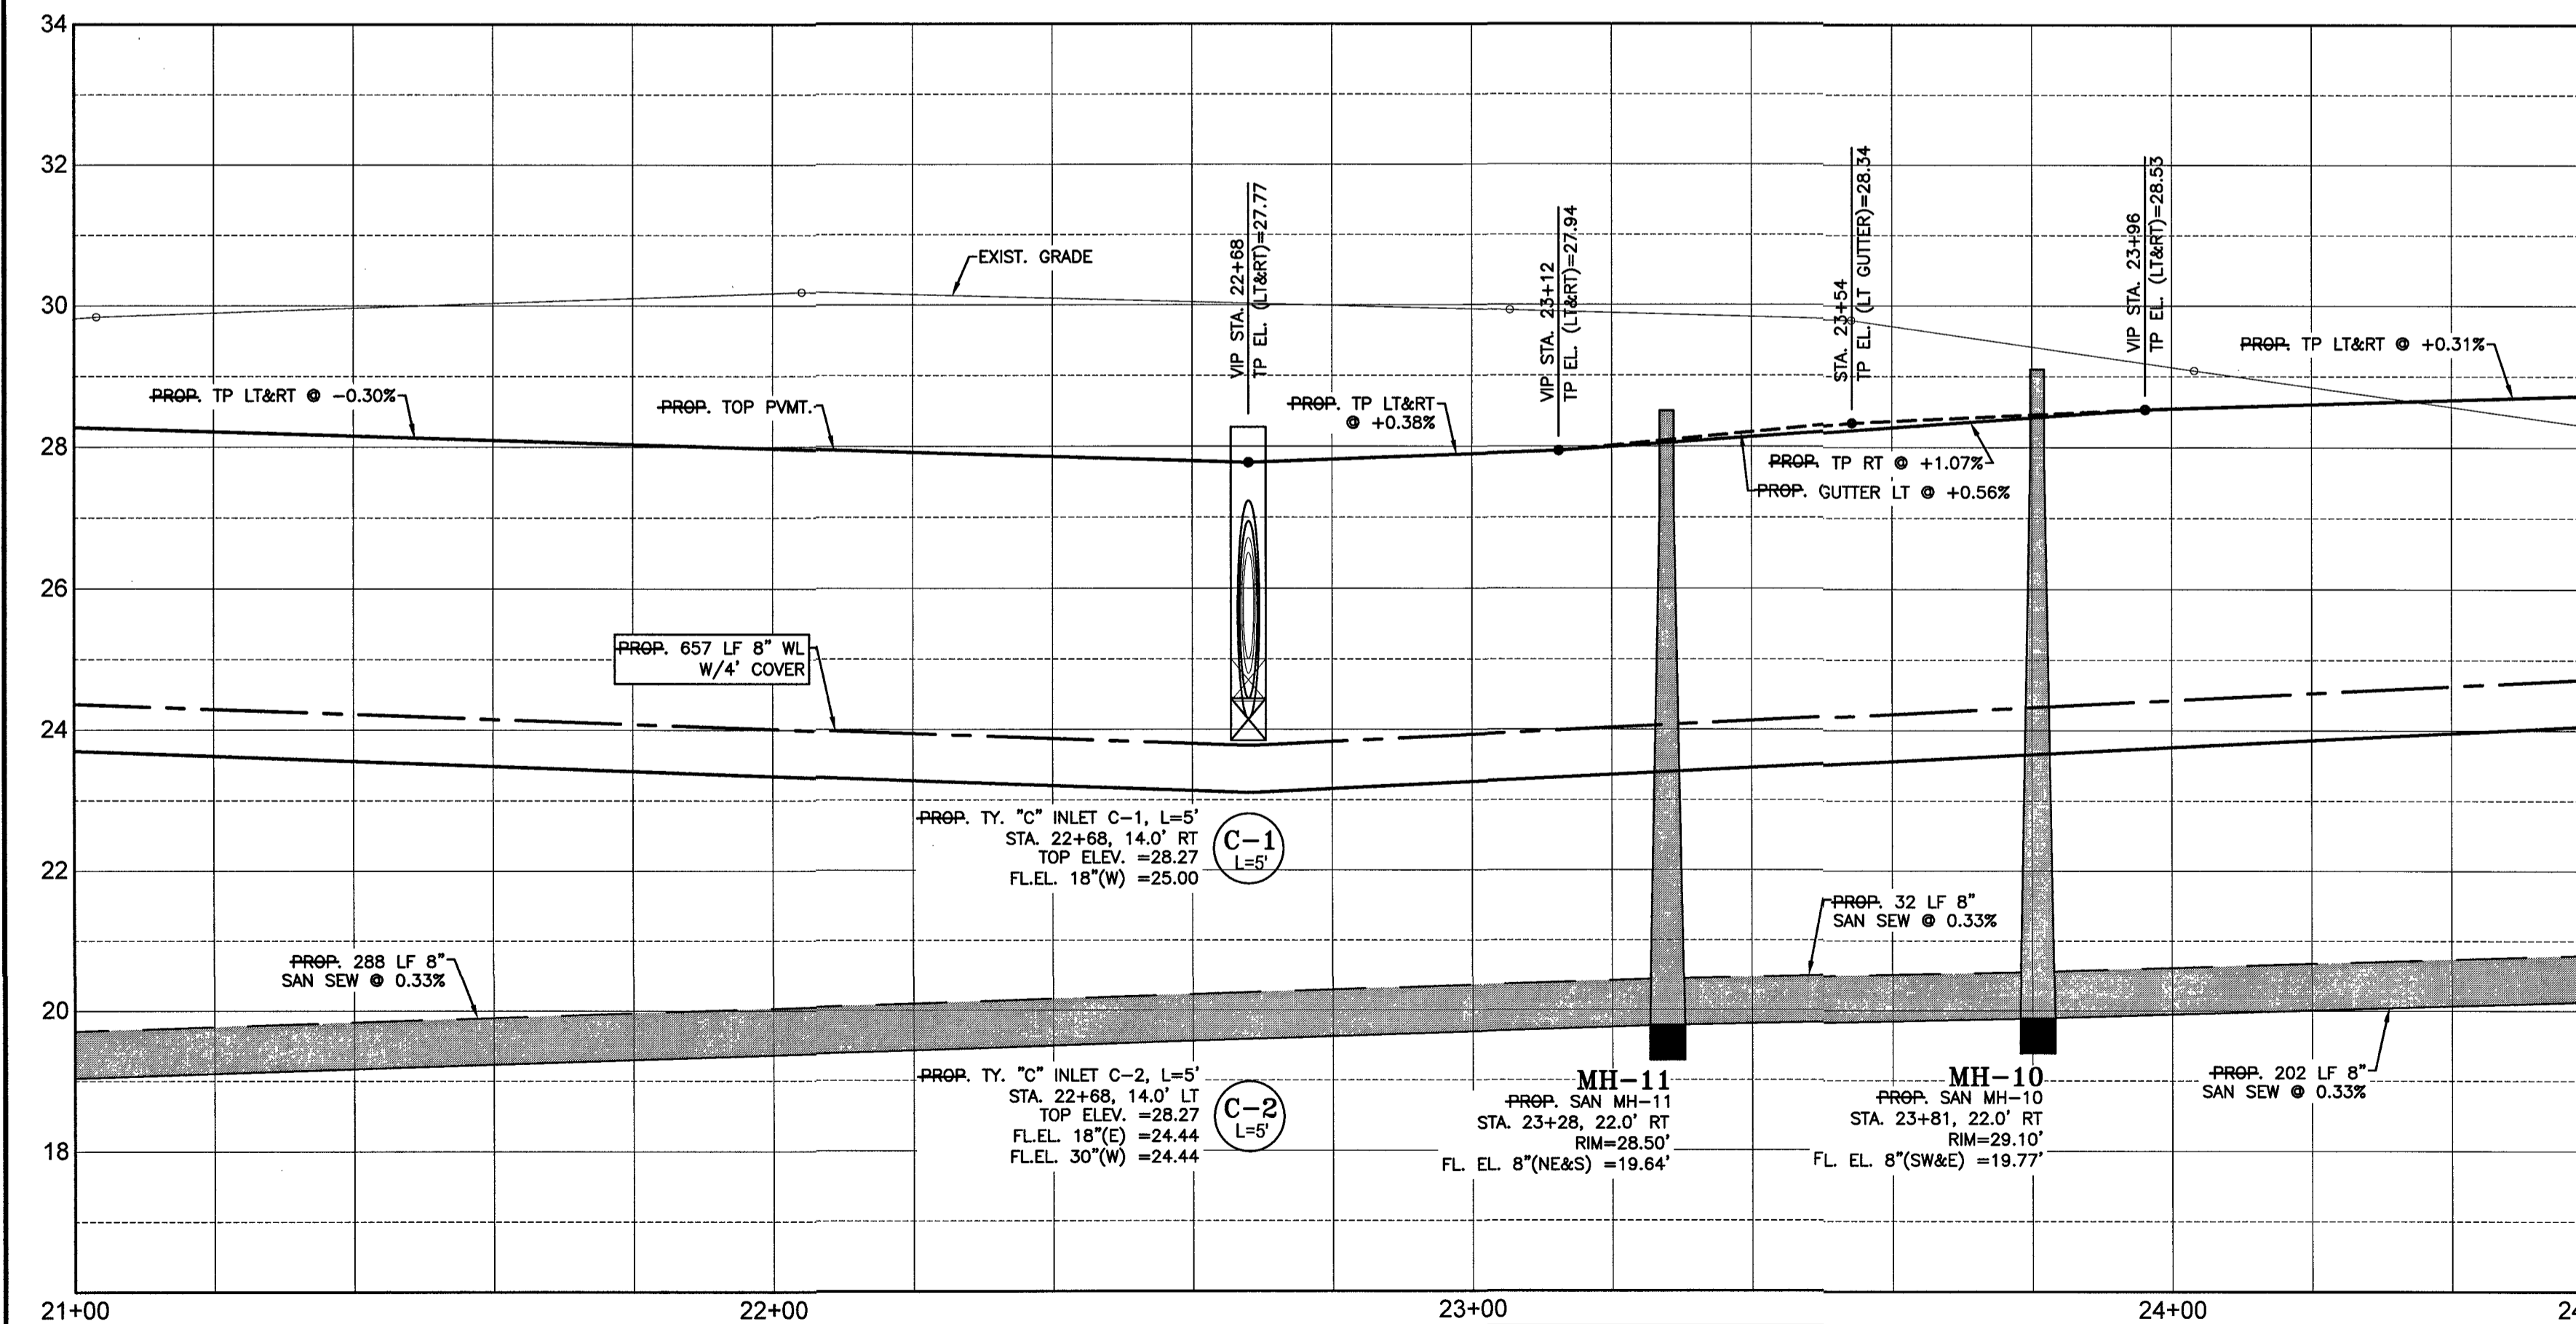



SYMBOLS LEGEND

- WATER METER
- FIRE HYDRANT
- WATER VALVE
- TAPPING SLEEVE AND VALVE
- REDUCER
- STORM SEWER MANHOLE (SMH-1)
- SANITARY SEWER MANHOLE (MH-1)
- TOP BANK
- STORM SEWER LINE (REINFORCED CONCRETE PIPE, ASTM C76)
- SANITARY SEWER LINE (D3034, SDR 26, 160 PR)
- WATERLINE (AWWA C900, CLASS 150, DR18)
- TOP OF PAVEMENT AT EDGE

RECORD DRAWING

NO.	DATE	DESCRIPTION	APPROVED

DESIGNED	DR
DRAWN	BT
CHECKED	
DATE	

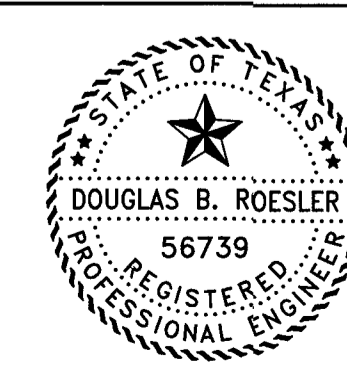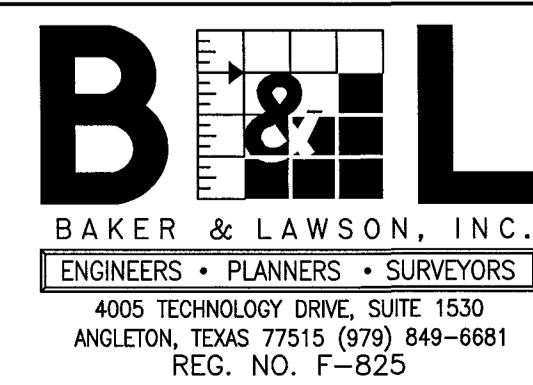

The seal appearing on this document was authorized by Douglas B. Roesler, P.E. 56739. Date: 04-18-22




OWNER:
RIVERWAY PROPERTIES
6115 SKYLINE DR. STE A.
HOUSTON, TEXAS 77057

PLAN: 1" = 20'
PROFILE:
HORIZONTAL: 1" = 2'
VERTICAL: 1" = 20'

RIVERWOOD RANCH SUBDIVISION
SECTION 2
A 78 AC, 109-LOT SUBDIVISION
ANGLETON, TEXAS 77515

PLAN & PROFILE
BENNETT STREET
STA. 21+00 TO 26+80

PROJECT NO. 14395

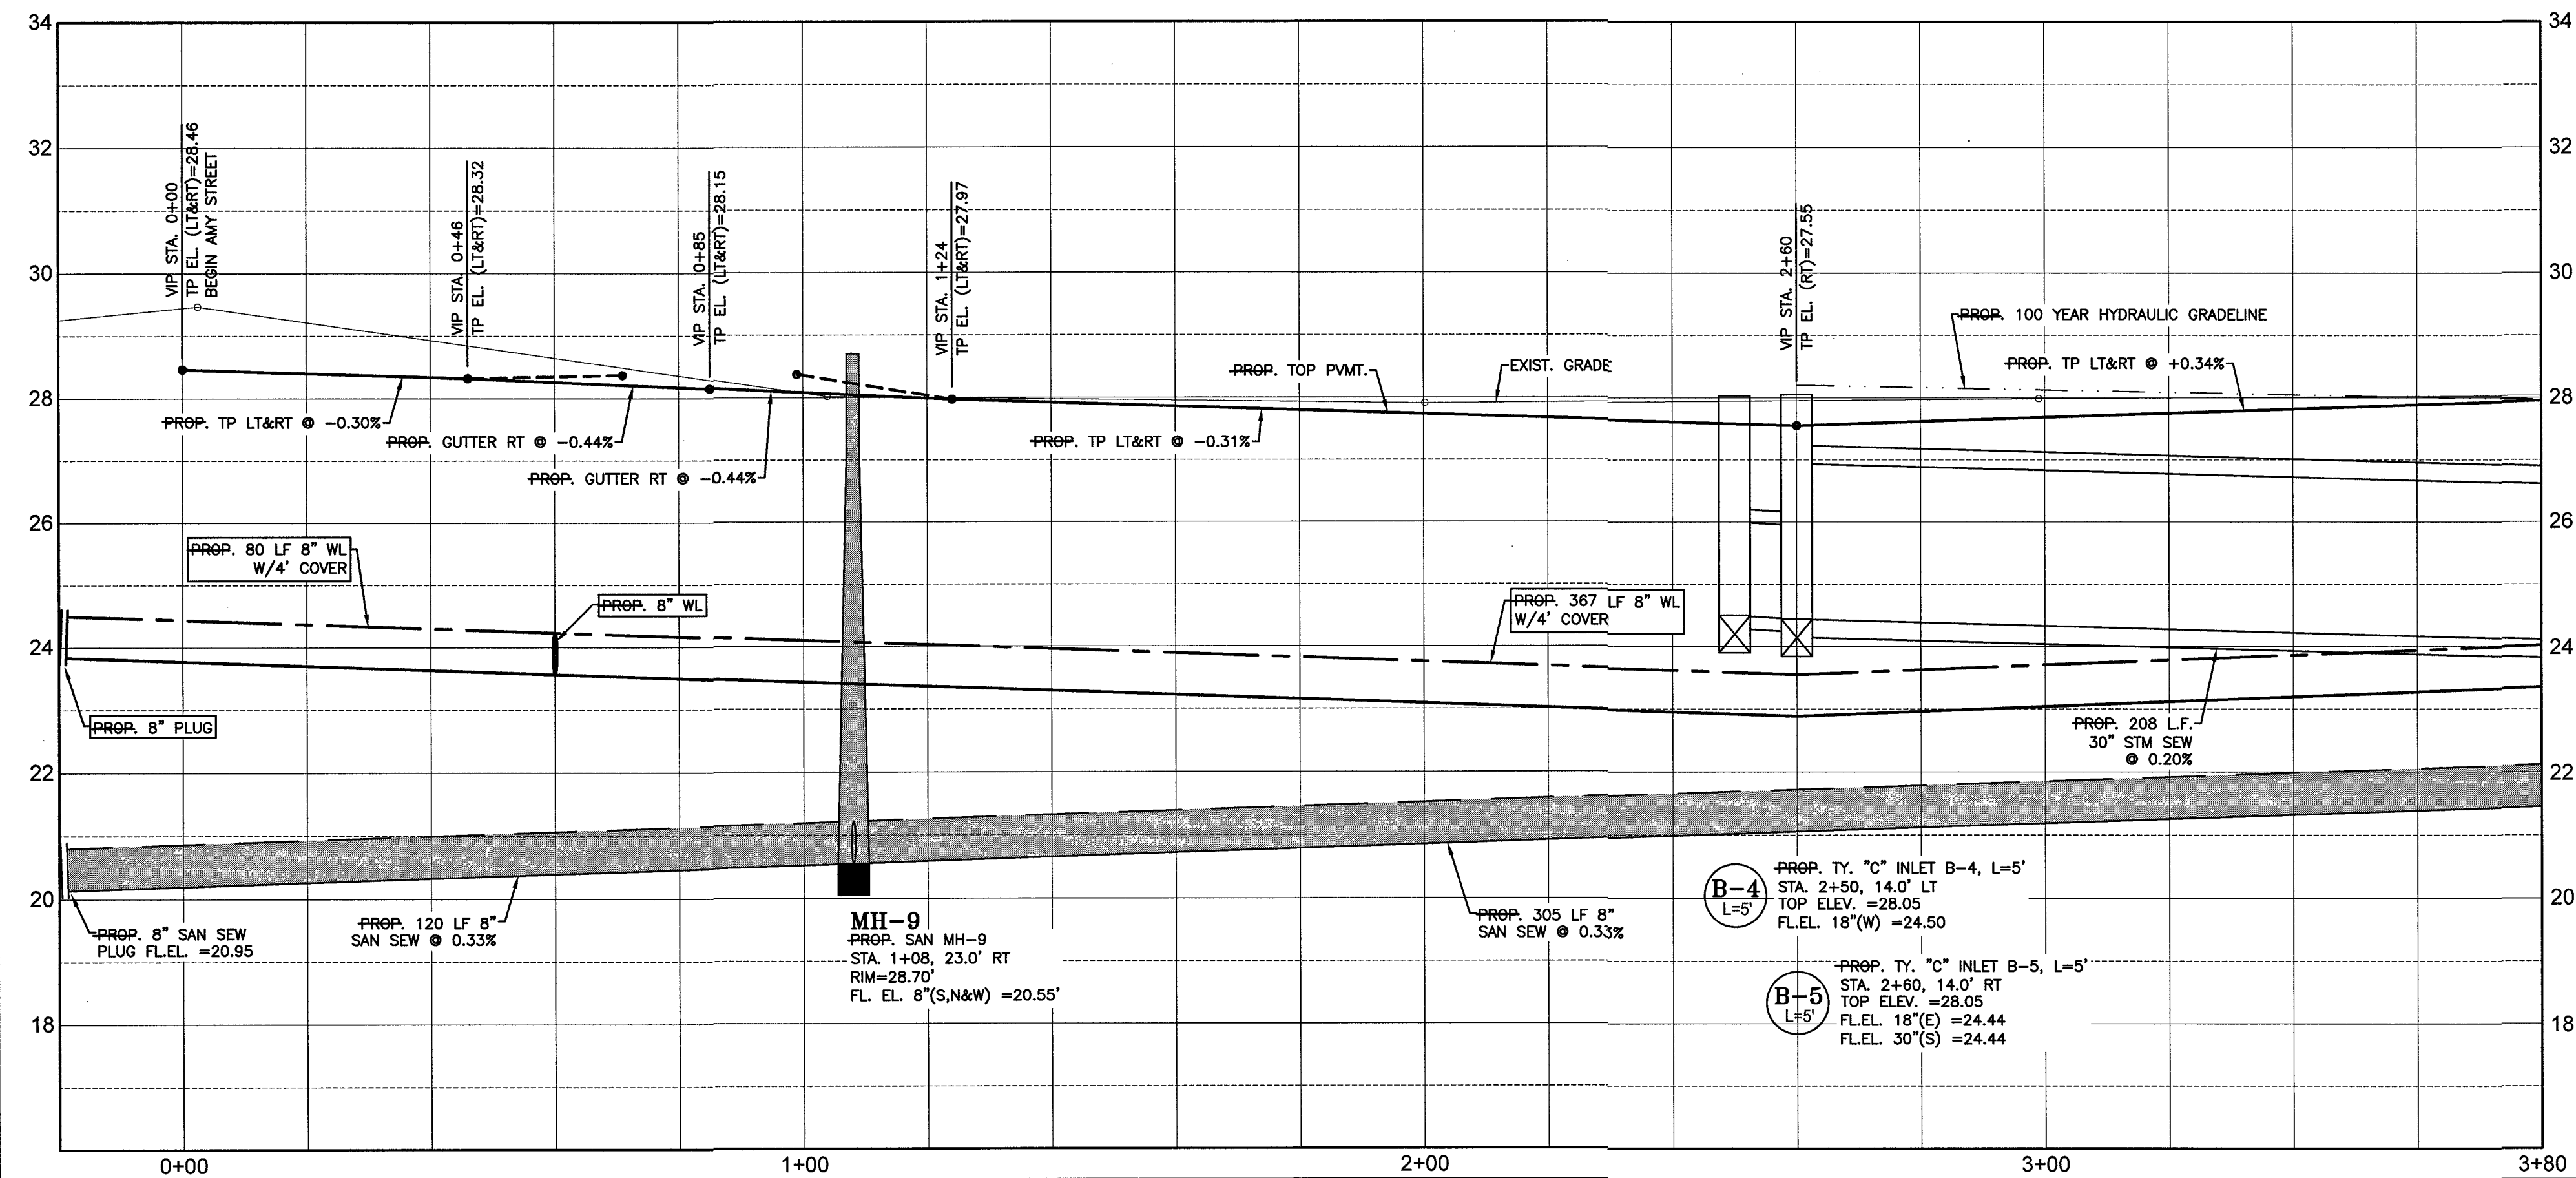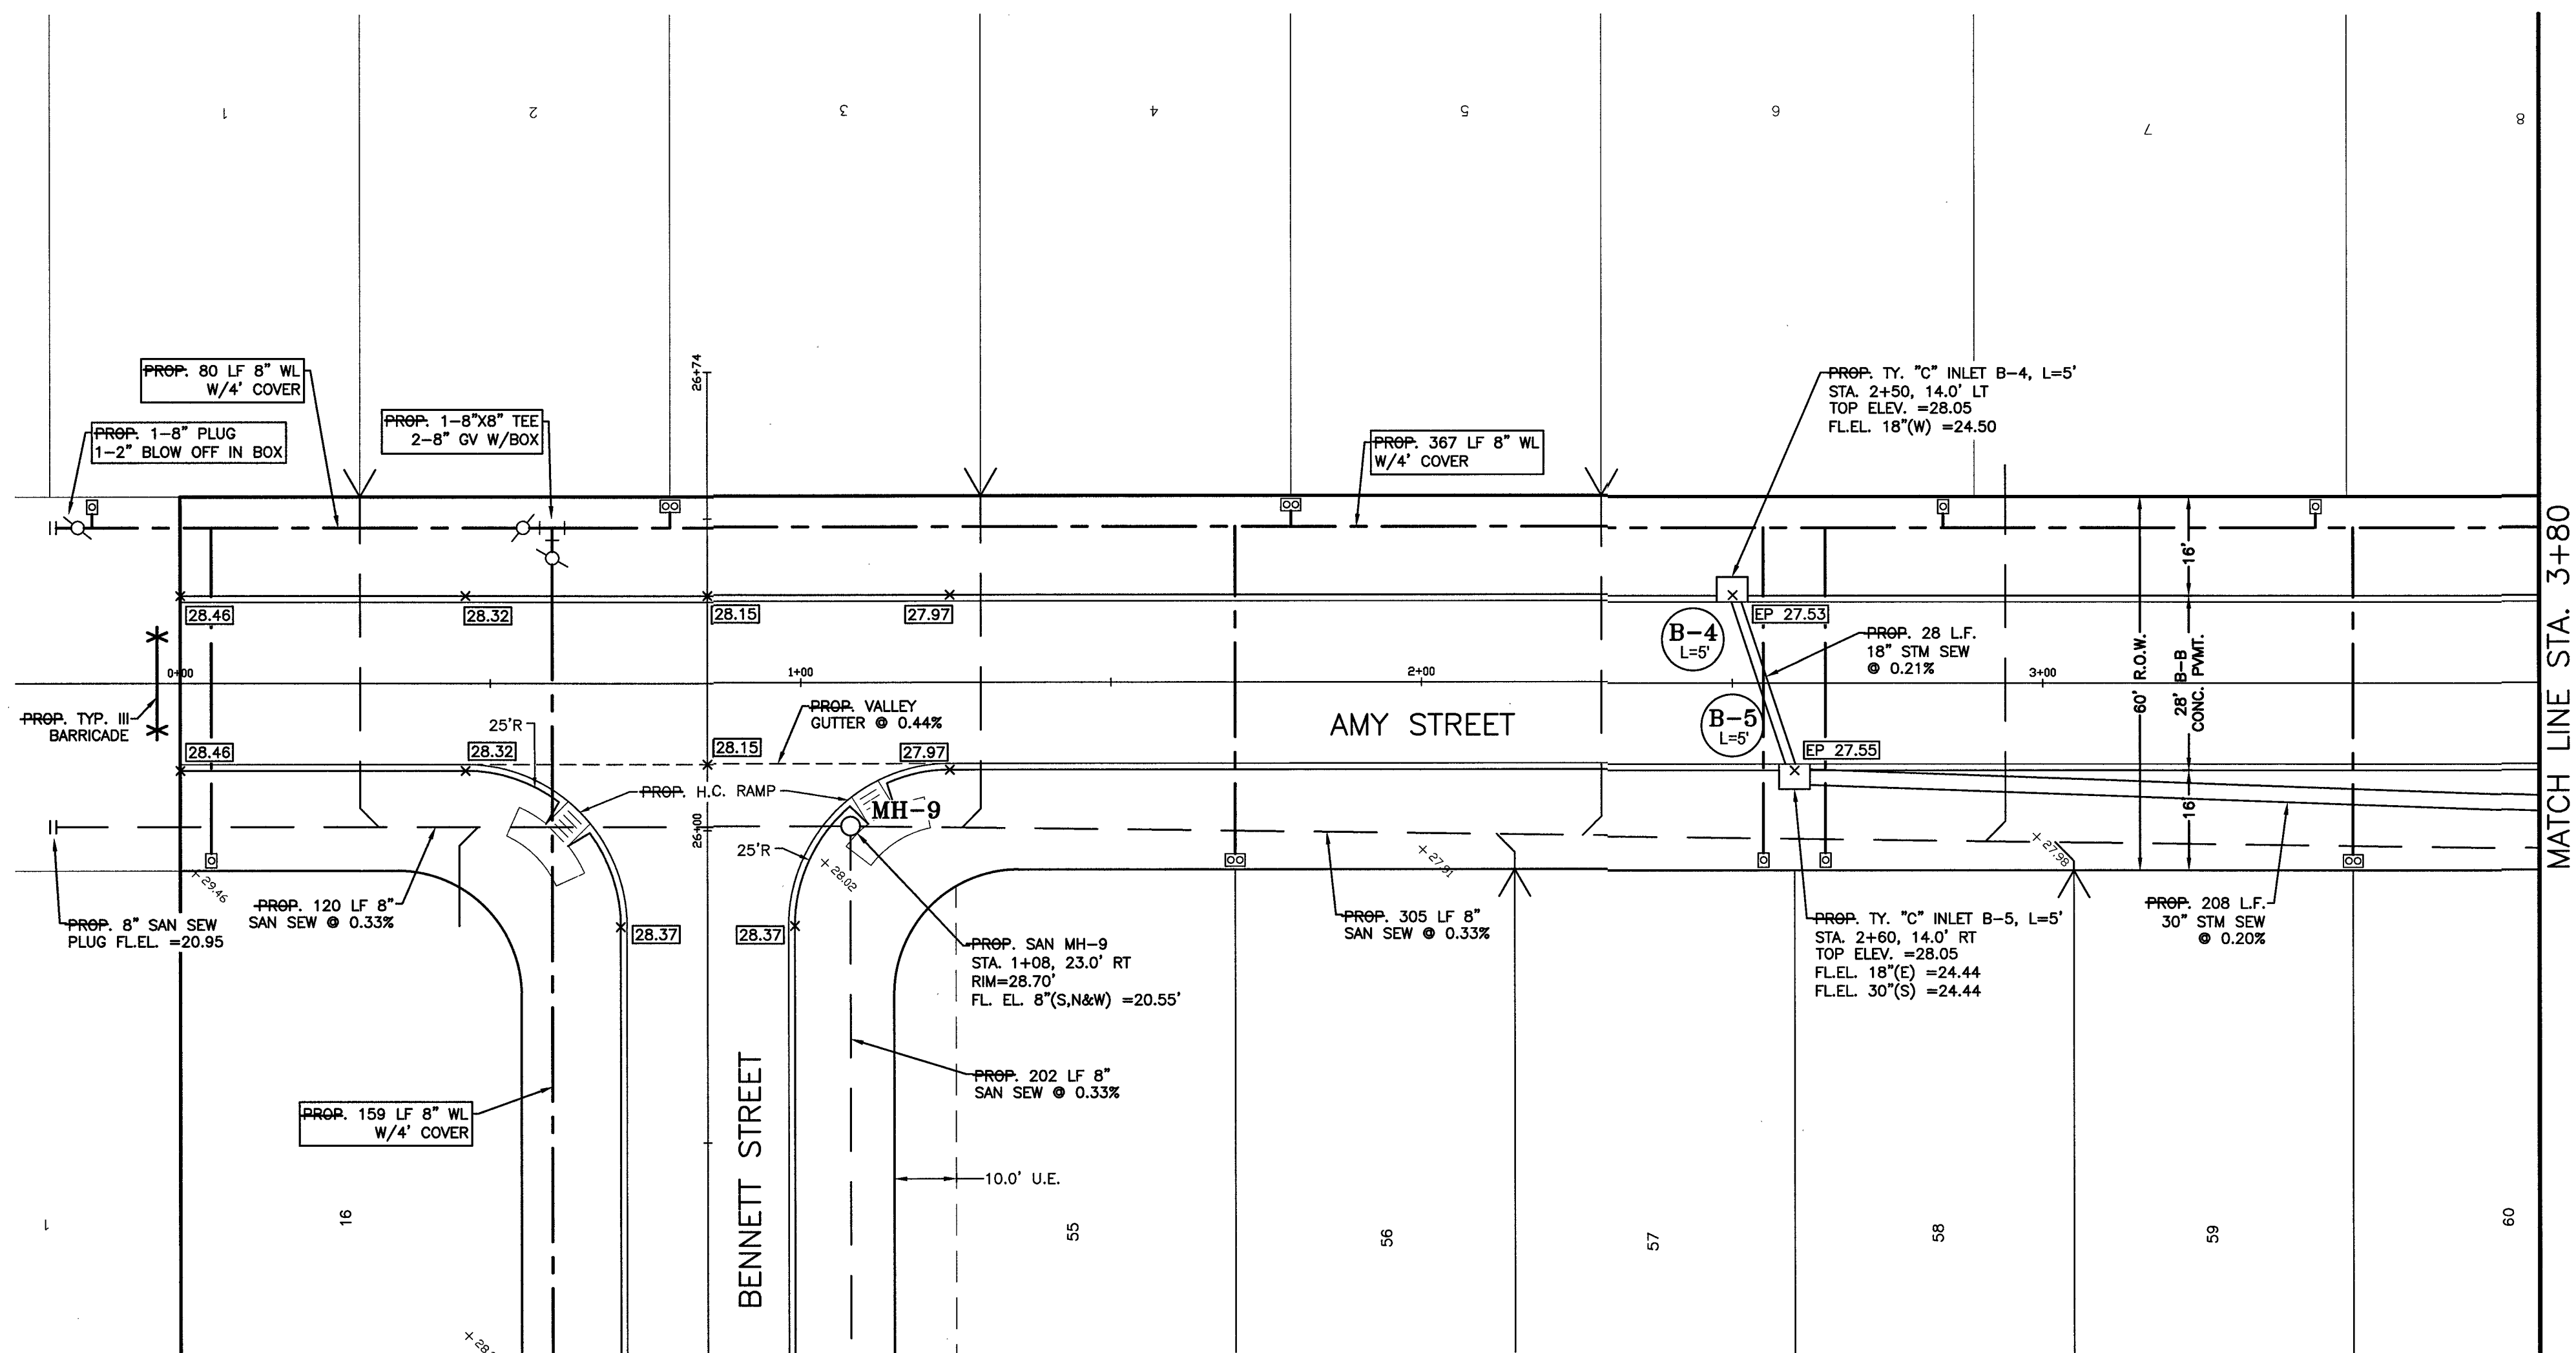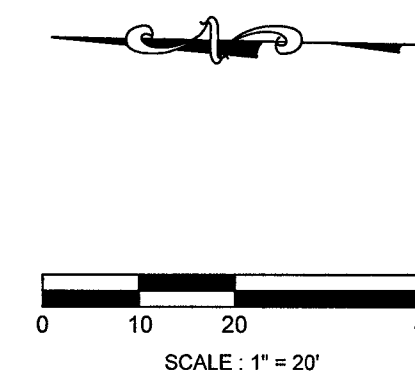



- SYMBOLS LEGEND**
- WATER METER
 - FIRE HYDRANT
 - WATER VALVE
 - TAPPING SLEEVE AND VALVE
 - REDUCER
 - STORM SEWER MANHOLE (SMH-1)
 - SANITARY SEWER MANHOLE (MH-1)
 - TOP BANK
 - STORM SEWER LINE
(REINFORCED CONCRETE PIPE, ASTM C76)
 - SANITARY SEWER LINE
(D3034, SDR 26, 160 PR)
 - WATERLINE (AWWA C900, CLASS 150, DR18)
 - TOP OF PAVEMENT AT EDGE

RECORD DRAWING

NO.	DATE	DESCRIPTION	APPROVED

REVISIONS

DESIGNED	DR
DRAWN	BT
CHECKED	
DATE	

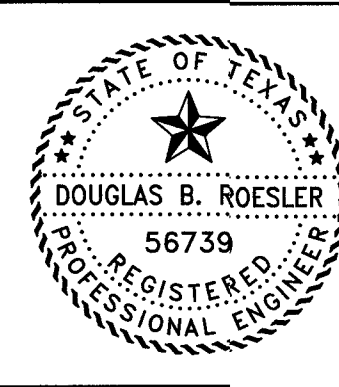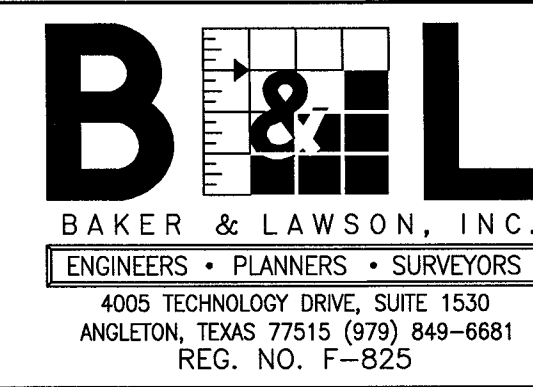

The seal appearing on this document was authorized by Douglas B. Roesler, P.E. 56739.

Date: 04-18-17


OWNER:
RIVERWAY PROPERTIES
6115 SKYLINE DR. STE A.
HOUSTON, TEXAS 77057

PLAN: 1" = 20'
PROFILE:
HORIZONTAL: 1" = 2'
VERTICAL: 1" = 20'


RIVERWOOD RANCH SUBDIVISION
SECTION 2
A 78 AC, 109-LOT SUBDIVISION
ANGLETON, TEXAS 77515

PLAN & PROFILE
AMY STREET
STA. 0+00 TO 3+80

PROJECT NO. 14395

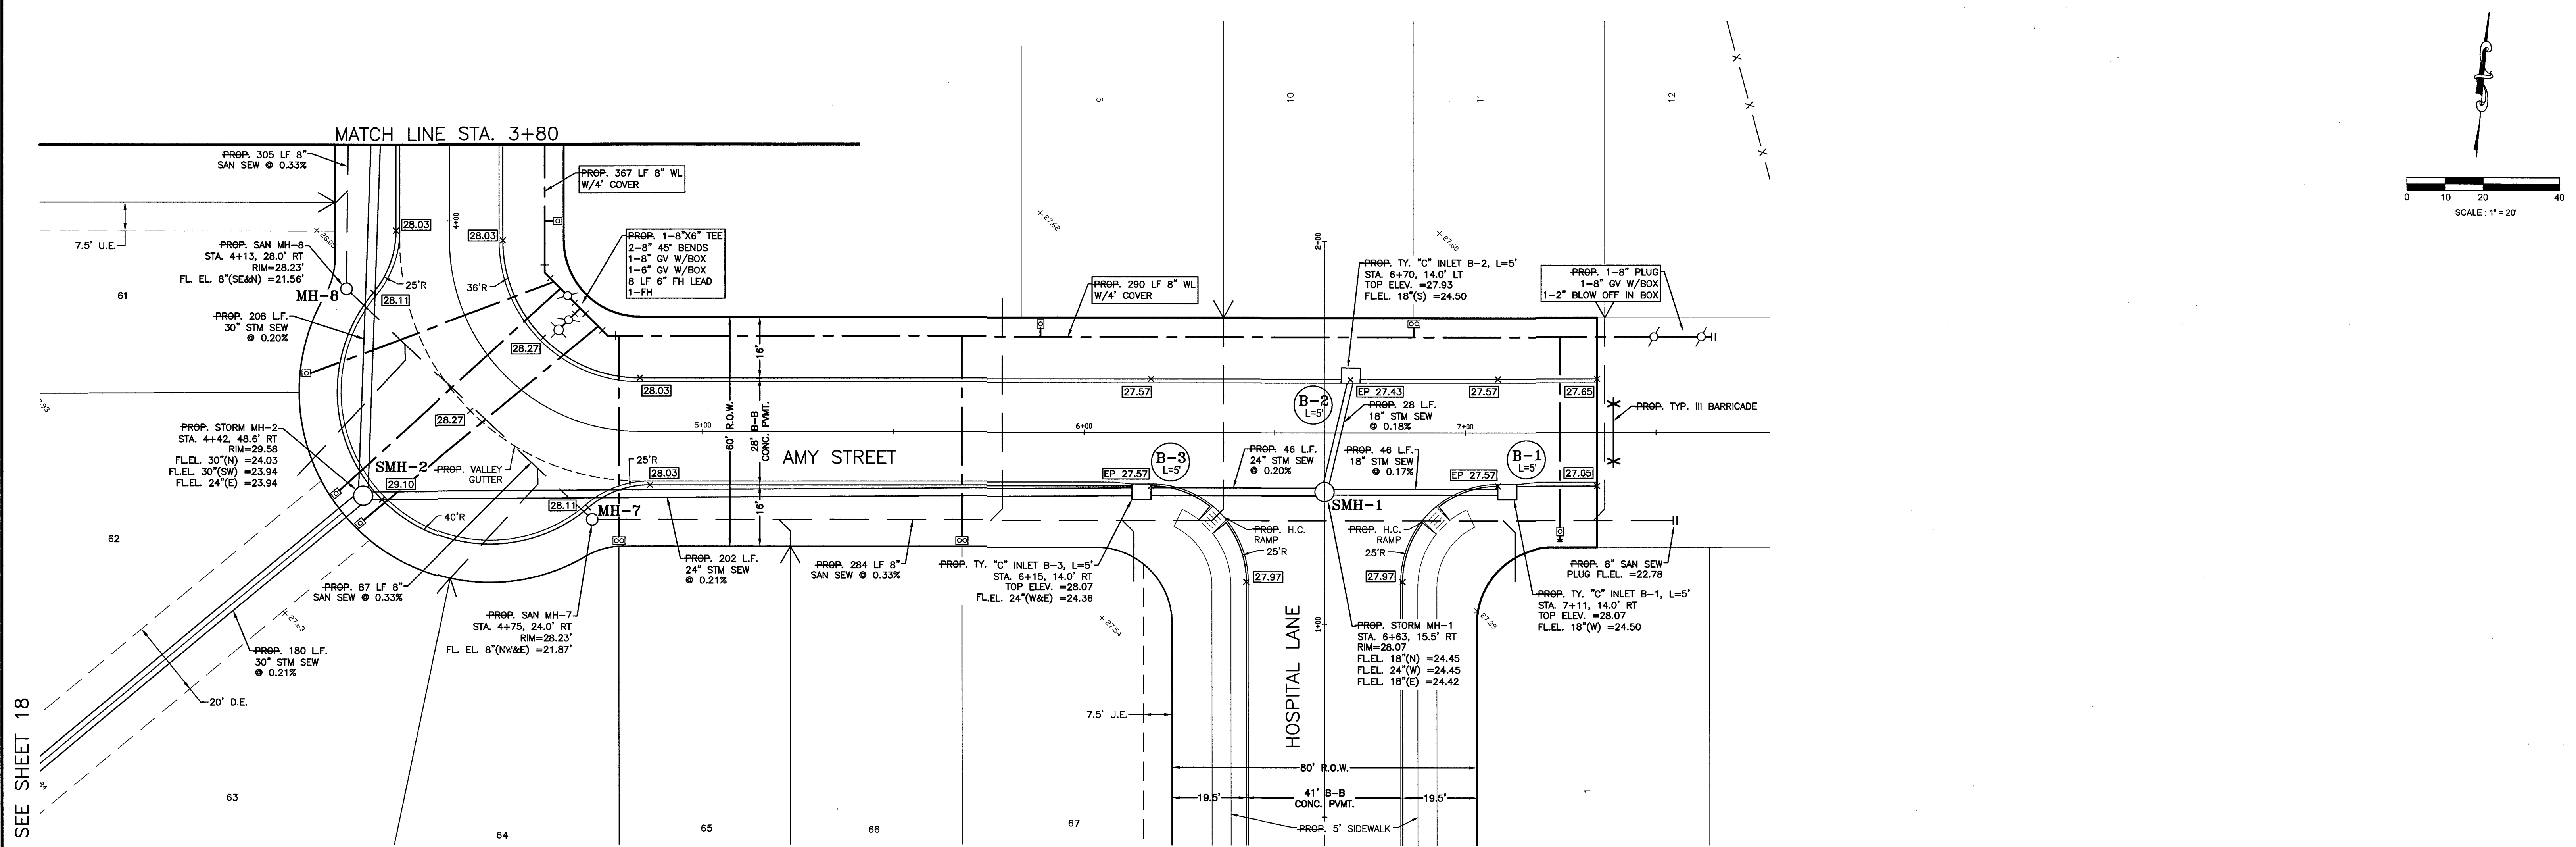

SEE SHEET 18

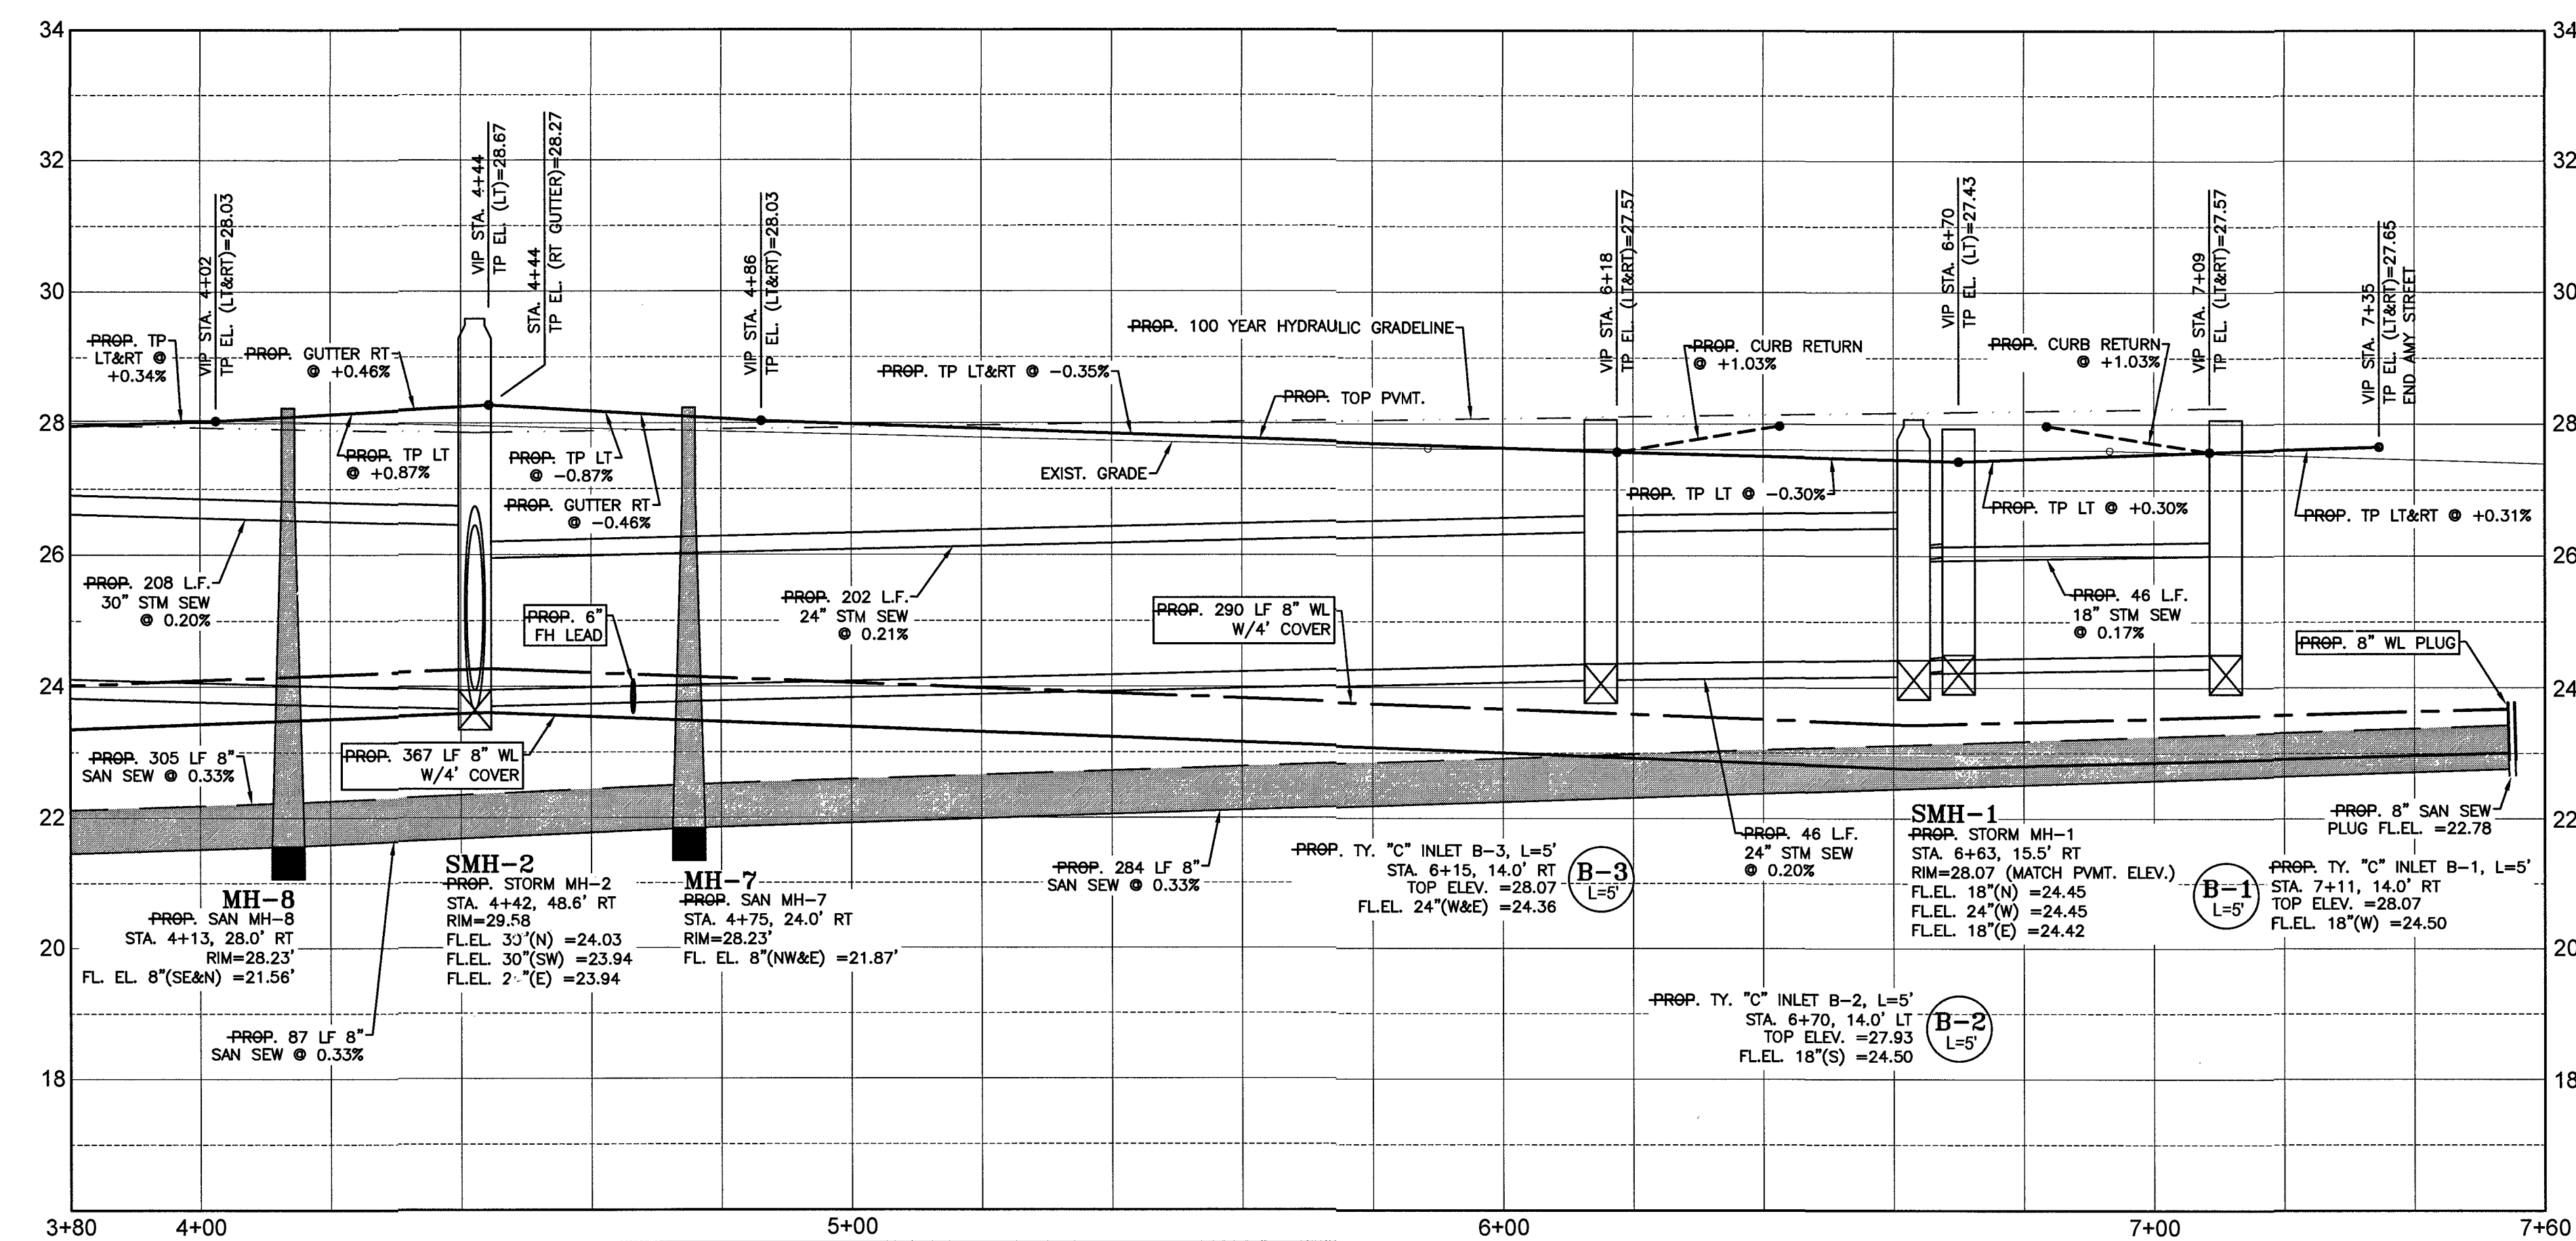


- SYMBOLS LEGEND**
- WATER METER
 - FIRE HYDRANT
 - ⊗ WATER VALVE
 - ⊗ TAPPING SLEEVE AND VALVE
 - △ REDUCER
 - STORM SEWER MANHOLE (SMH-1)
 - SANITARY SEWER MANHOLE (MH-1)
 - TOP BANK
 - STORM SEWER LINE (REINFORCED CONCRETE PIPE, ASTM C76)
 - SANITARY SEWER LINE (D3034, SDR 26, 160 PR)
 - WATERLINE (AWWA C900, CLASS 150, DR18)
 - TOP OF PAVEMENT AT EDGE

RECORD DRAWING

NO.	DATE	DESCRIPTION	APPROVED

DESIGNED DR
DRAWN BT
CHECKED
DATE

B & L
BAKER & LAWSON, INC.
ENGINEERS • PLANNERS • SURVEYORS
4005 TECHNOLOGY DRIVE, SUITE 1530
ANGLETON, TEXAS 77515 (979) 849-6681
REG. NO. F-825

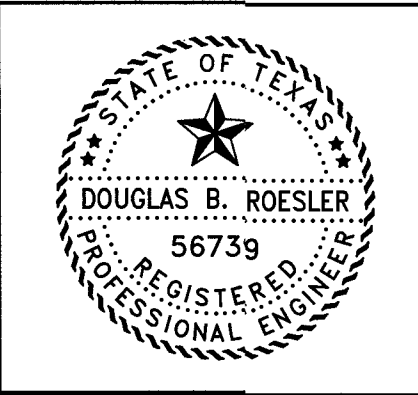



The seal appearing on this document was authorized by Douglas B. Roessler P.E. 56739
Date: 04-18-22

OWNER:
RIVERWAY PROPERTIES
6115 SKYLINE DR. STE A.
HOUSTON, TEXAS 77057

PLAN: 1" = 20'
PROFILE: 1" = 2'
HORIZONTAL: 1" = 2'
VERTICAL: 1" = 20'

RIVERWOOD RANCH SUBDIVISION
SECTION 2
A 78 AC, 109-LOT SUBDIVISION
ANGLETON, TEXAS 77515

PLAN & PROFILE
AMY STREET
STA. 3+80 TO 7+35
PROJECT NO. 14395

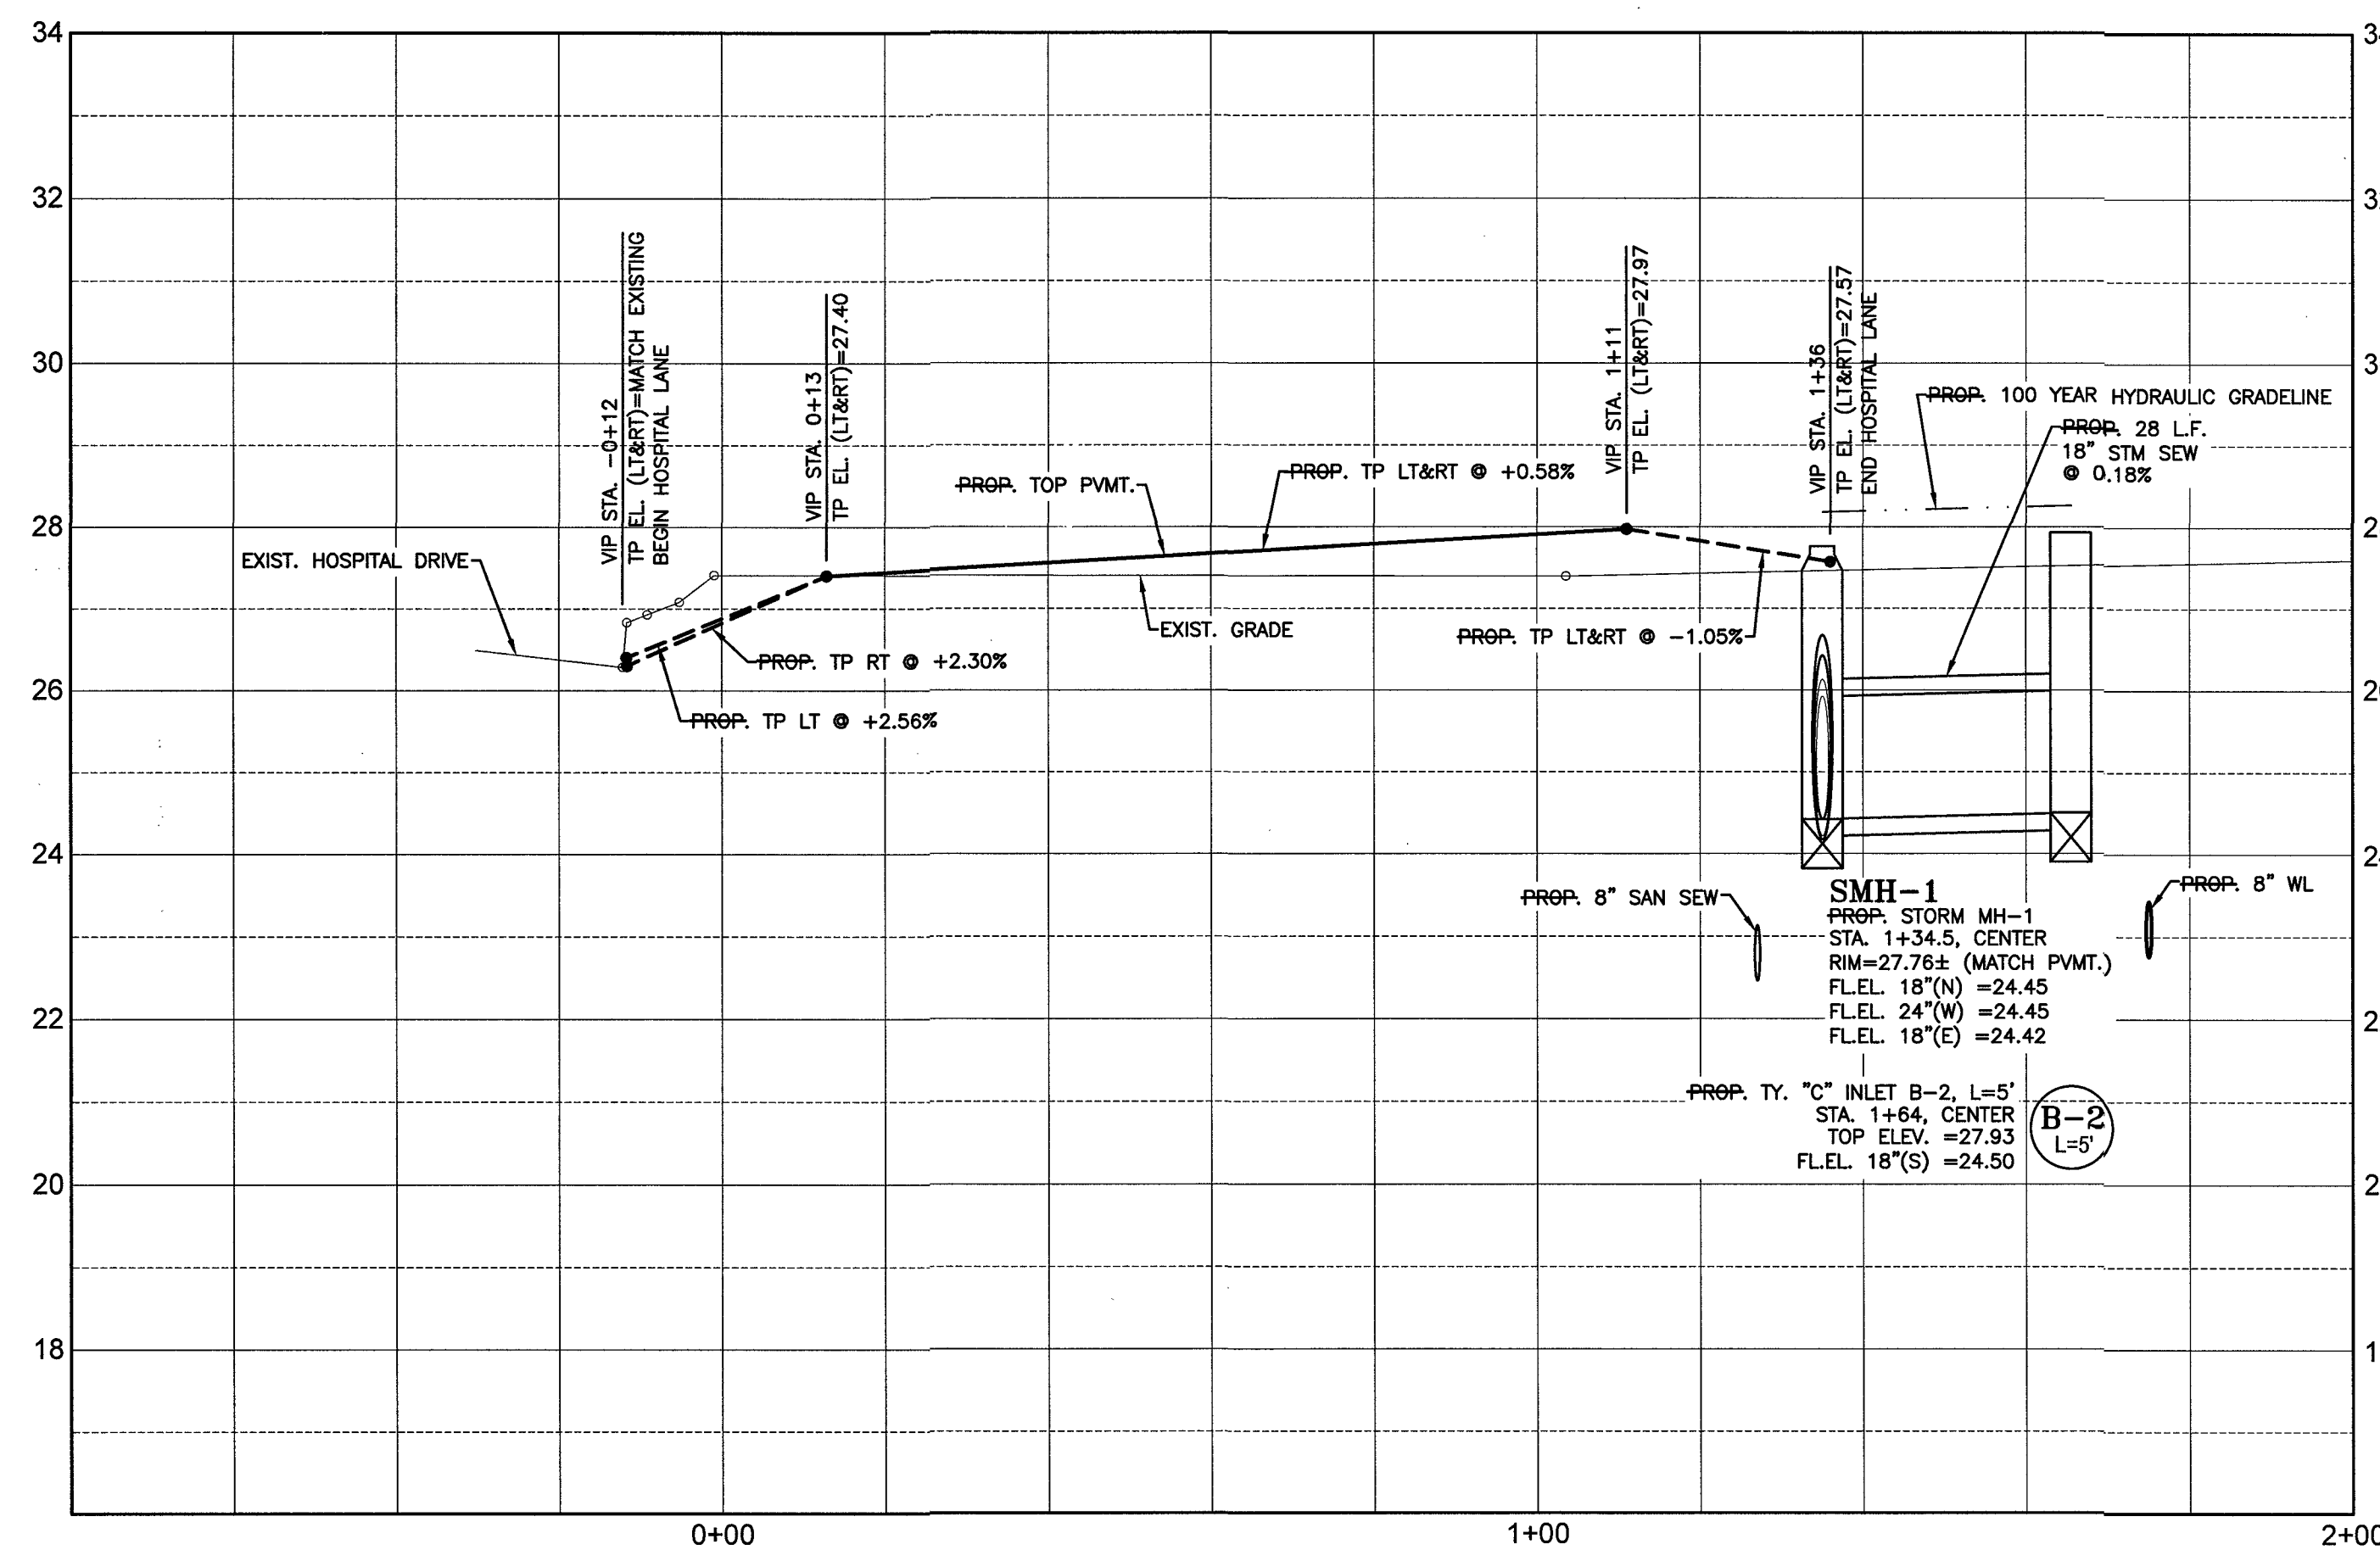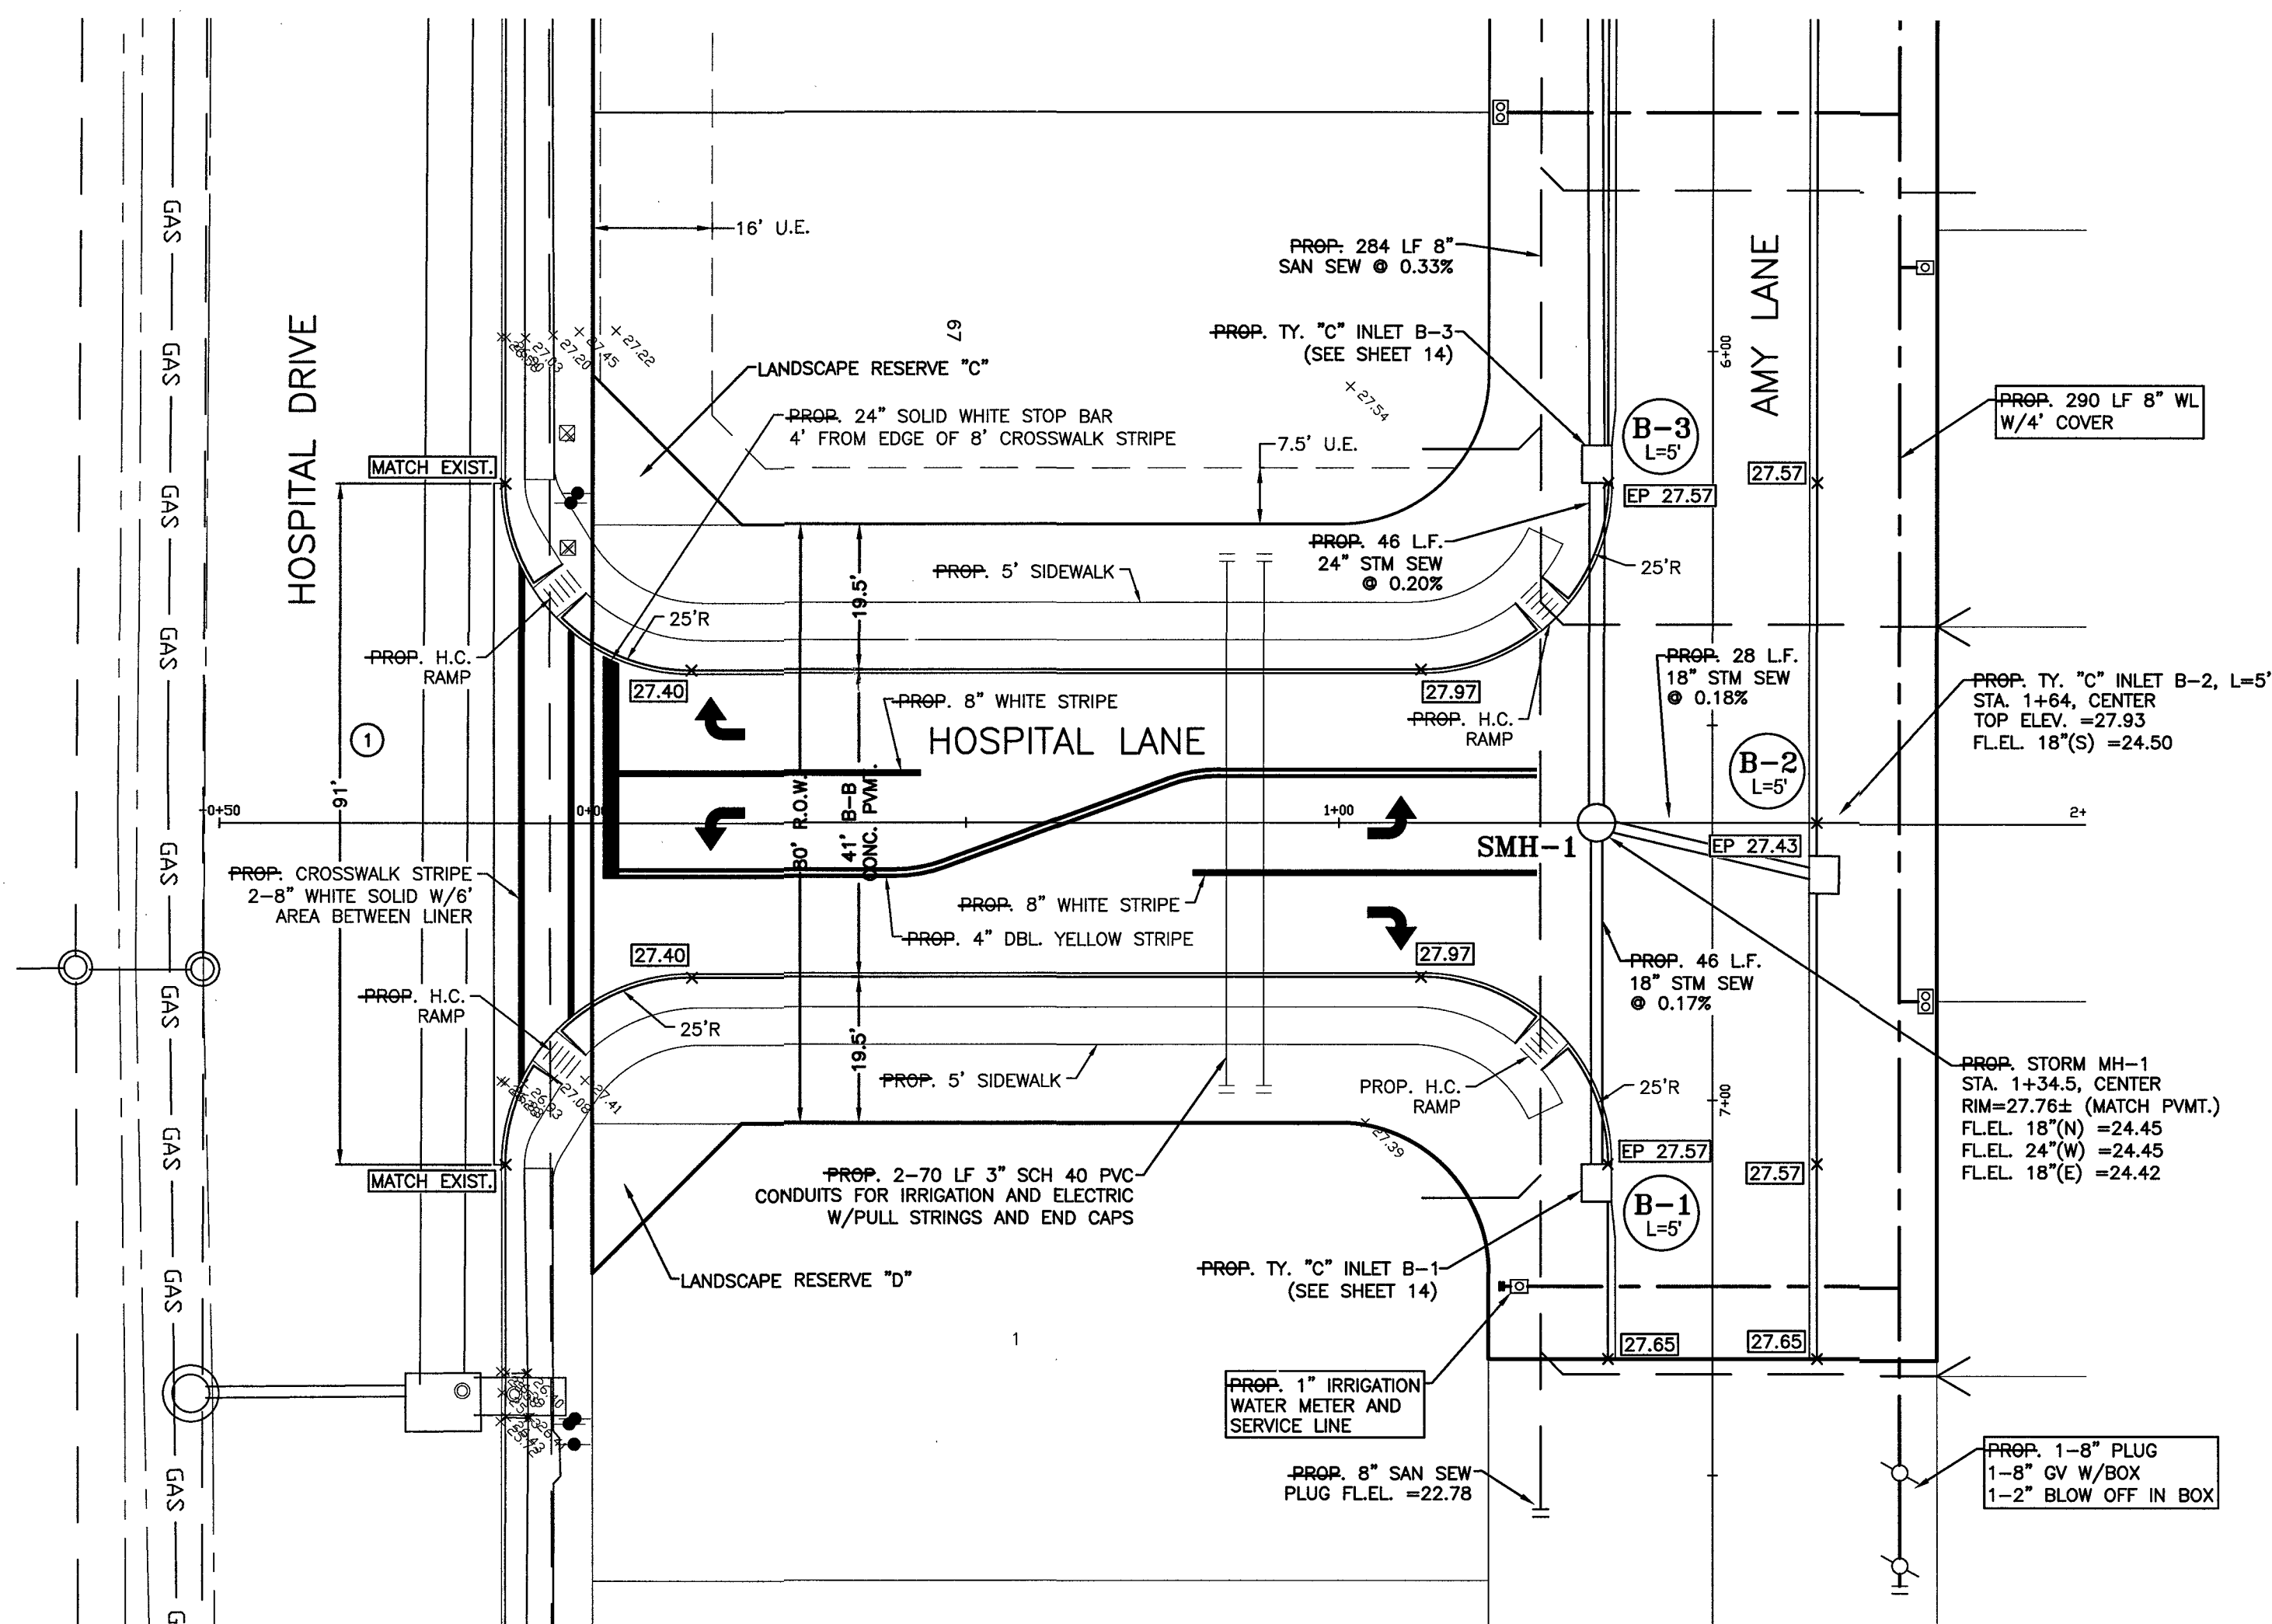

① PROP. SAWCUT PAVEMENT FULL DEPTH AND REMOVE 18" WIDE 91' LONG CONCRETE PAVEMENT, CURB AND SIDEWALK FOR HOSPITAL LANE CONNECTION. CONNECT USING UNDERCUT DETAIL WITH HEADER (SEE SHEET 38) (REMOVAL IS INCIDENTAL TO CLEARING R.O.W.)

SYMBOLS LEGEND


- WATER METER
- FIRE HYDRANT
- WATER VALVE
- TAPPING SLEEVE AND VALVE
- REDUCER
- STORM SEWER MANHOLE (SMH-1)
- SANITARY SEWER MANHOLE (MH-1)
- TOP BANK
- STORM SEWER LINE (REINFORCED CONCRETE PIPE, ASTM C76)
- SANITARY SEWER LINE (D3034, SDR 26, 160 PR)
- WATERLINE (AWWA C900, CLASS 150, DR18)
- TOP OF PAVEMENT AT EDGE

RECORD DRAWING

NO.	DATE	DESCRIPTION	APPROVED

DESIGNED	DR
DRAWN	BT
CHECKED	
DATE	

B & L
BAKER & LAWSON, INC.
ENGINEERS • PLANNERS • SURVEYORS
4005 TECHNOLOGY DRIVE, SUITE 1530
ANGLETON, TEXAS 77515 (979) 849-6681
REG. NO. F-825

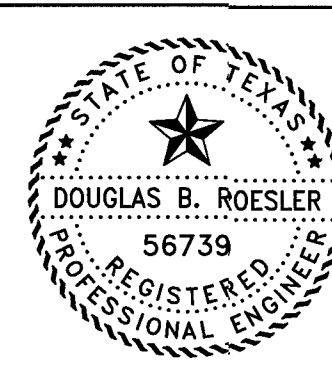

The seal appearing on this document was authorized by Douglas B. Roesler, P.E. 56739
Date: 04-18-02



OWNER:
RIVERWAY PROPERTIES
6115 SKYLINE DR. STE A.
HOUSTON, TEXAS 77057

PLAN: 1" = 20'
PROFILE:
HORIZONTAL: 1" = 2'
VERTICAL: 1" = 20'

RIVERWOOD RANCH SUBDIVISION
SECTION 2
A 78 AC, 109-LOT SUBDIVISION
ANGLETON, TEXAS 77515

PLAN & PROFILE
HOSPITAL LANE
STA. 0+00 TO 2+00

PROJECT NO. 14395

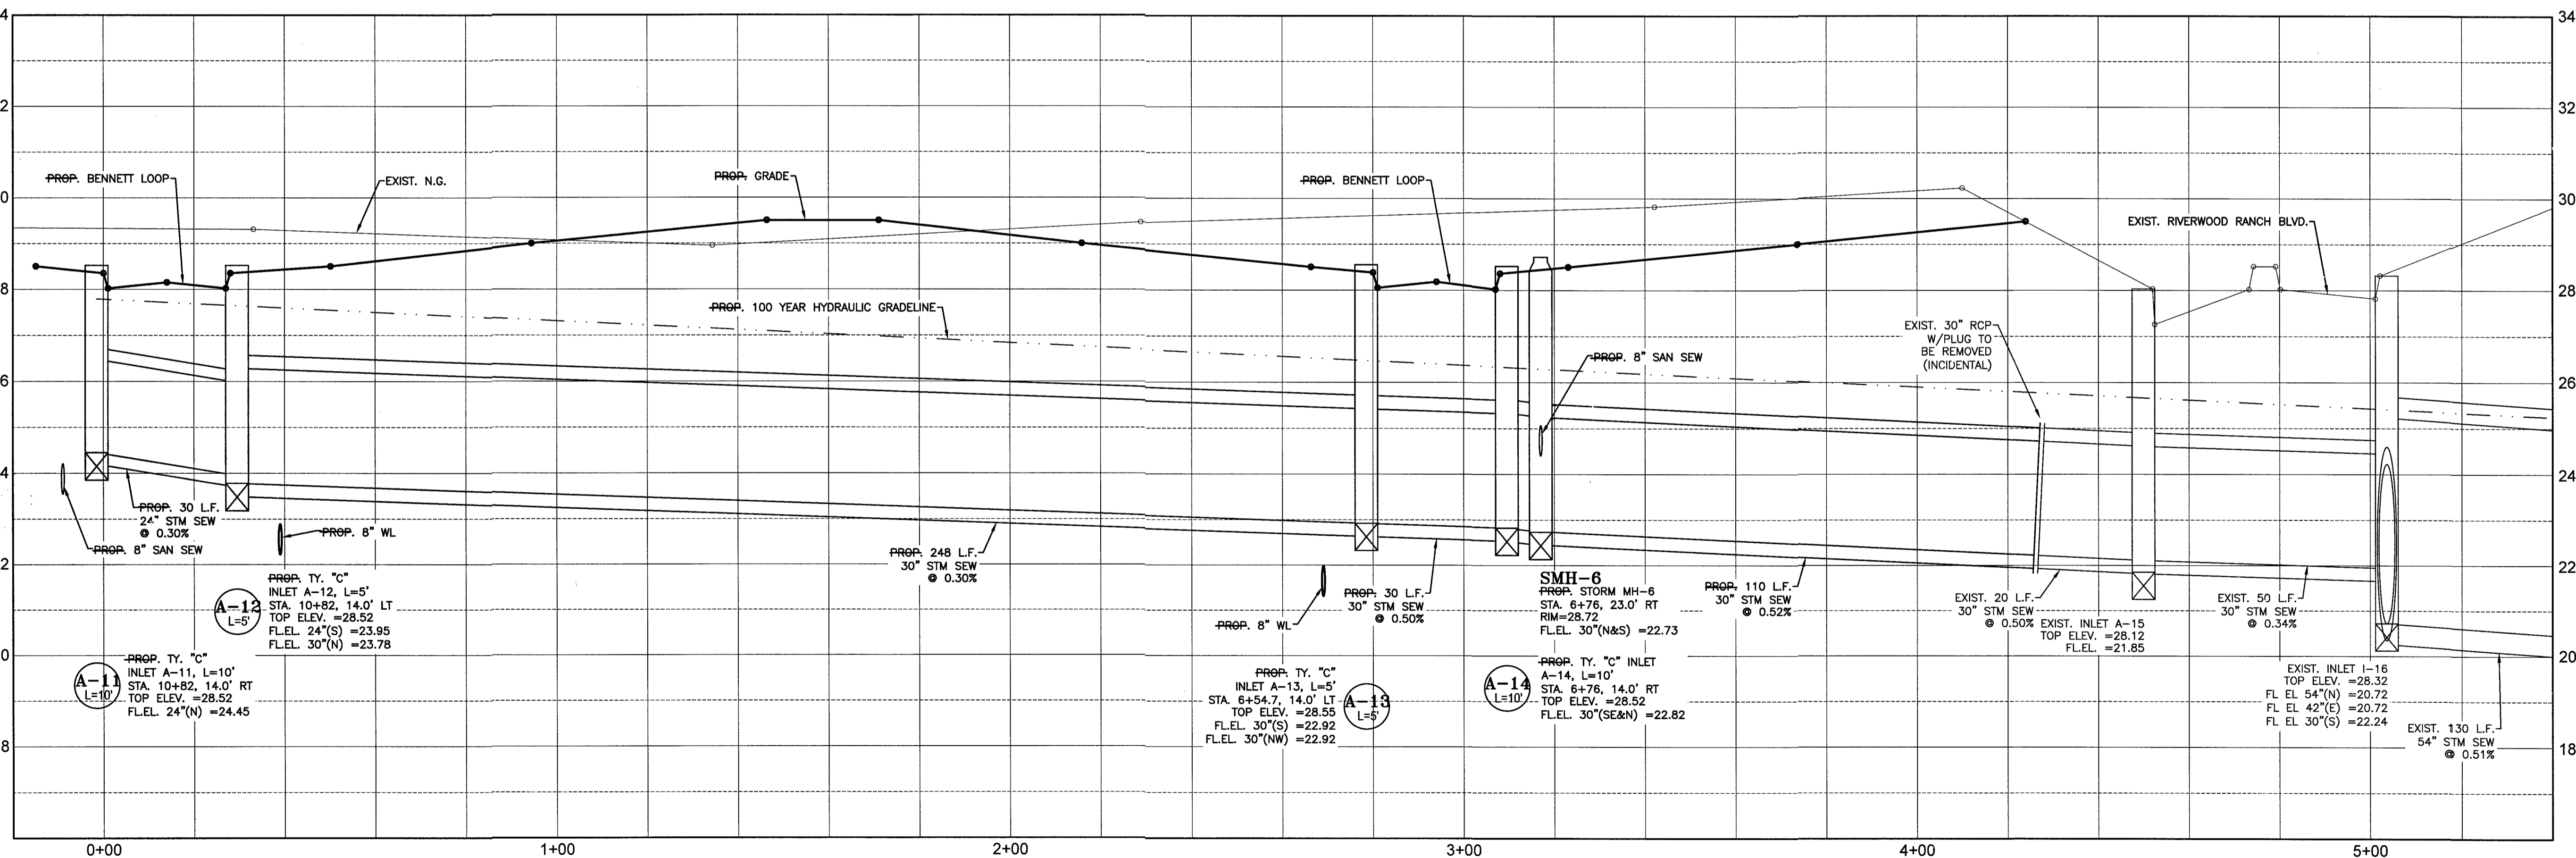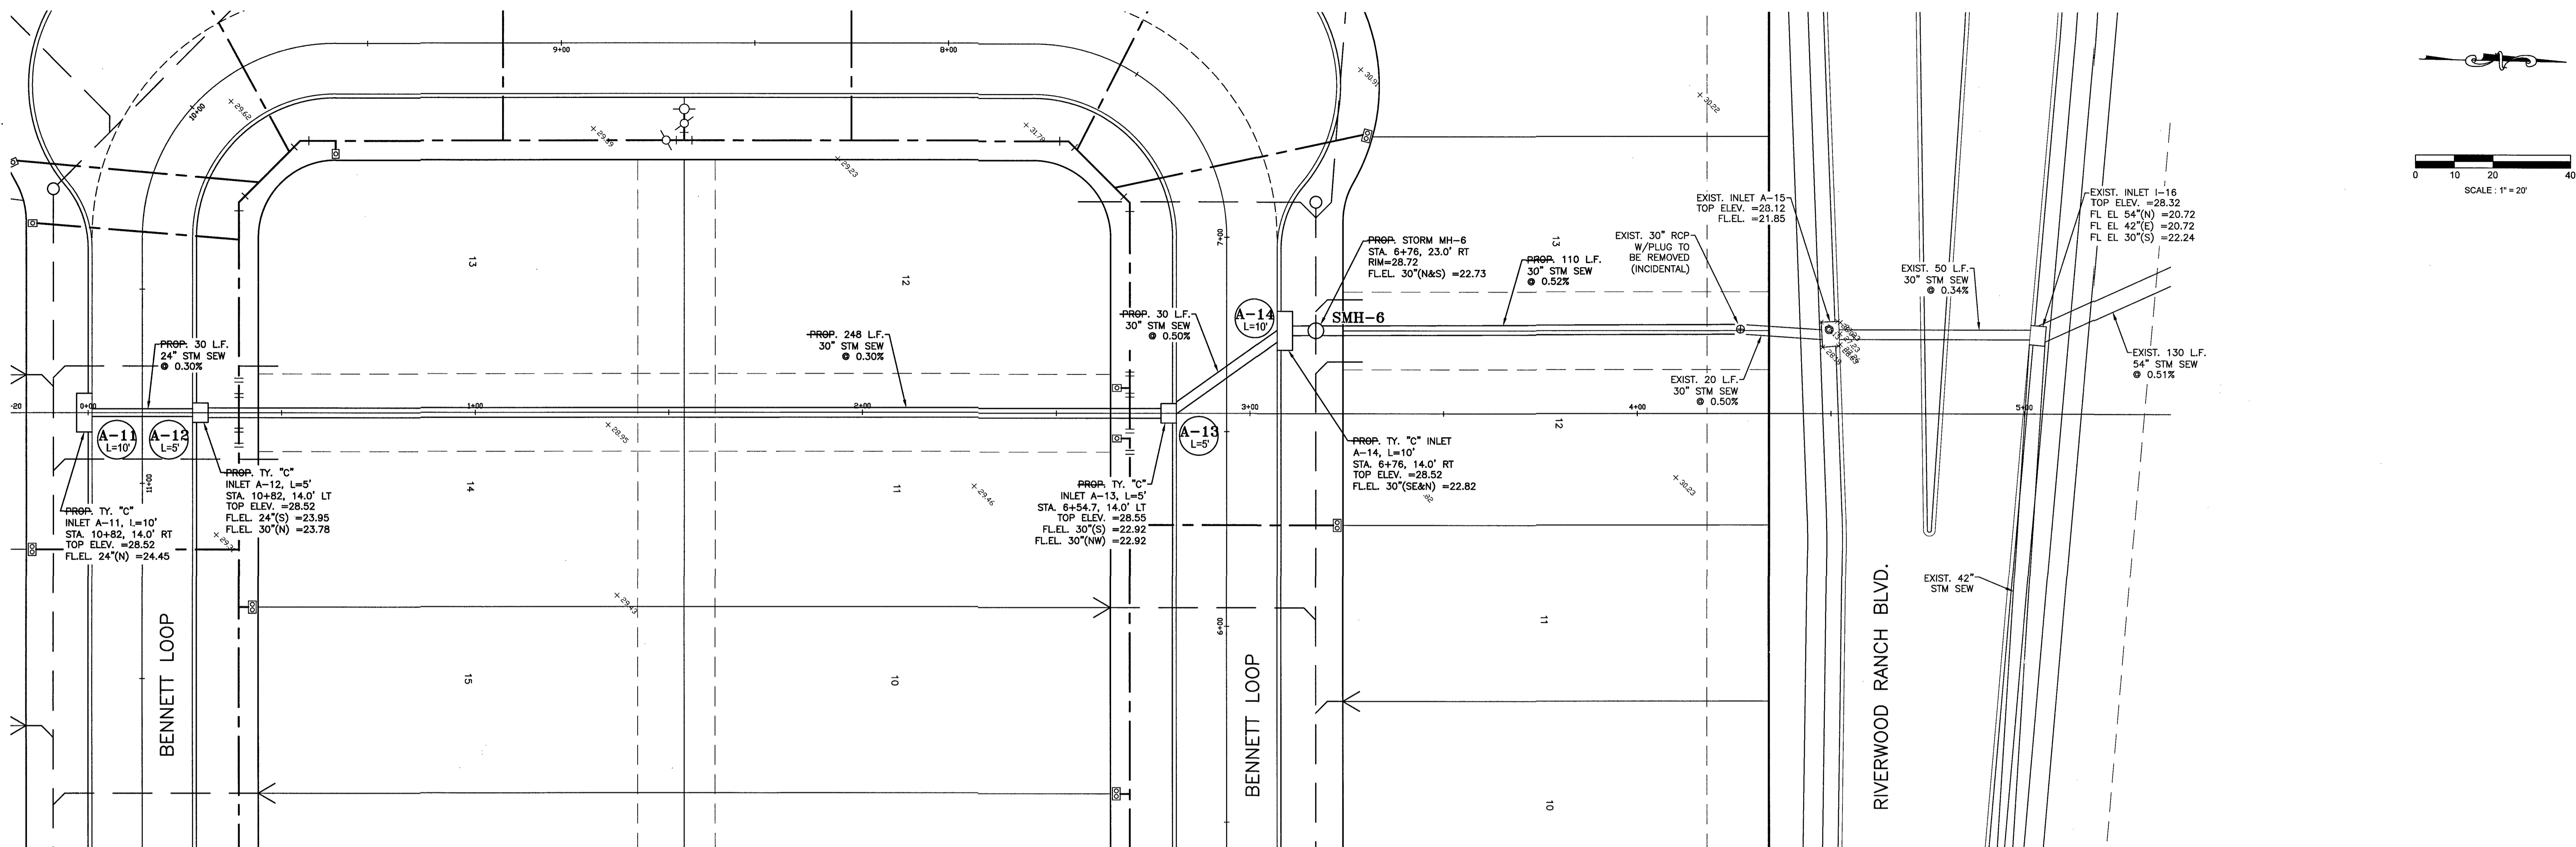



SYMBOLS LEGEND

- WATER METER
- FIRE HYDRANT
- WATER VALVE
- TAPPING SLEEVE AND VALVE
- REDUCER
- STORM SEWER MANHOLE (SMH-1)
- SANITARY SEWER MANHOLE (MH-1)
- TOP BANK
- STORM SEWER LINE (REINFORCED CONCRETE PIPE, ASTM C76)
- SANITARY SEWER LINE (D3034, SDR 26, 160 PR)
- WATERLINE (AWWA C900, CLASS 150, DR18)
- TOP OF PAVEMENT AT EDGE

RECORD DRAWING

NO.	DATE	DESCRIPTION	APPROVED

DESIGNED	DR
DRAWN	BT
CHECKED	
DATE	

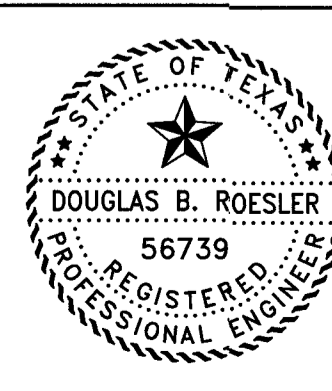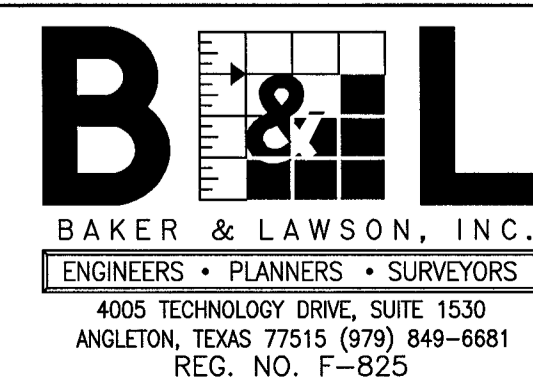

The seal appearing on this document was authorized by Douglas B. Roesler, P.E. 56739
Date: 04-18-22



OWNER:
RIVERWAY PROPERTIES
6115 SKYLINE DR. STE A.
HOUSTON, TEXAS 77057

PLAN: 1" = 20'
PROFILE:
HORIZONTAL: 1" = 2'
VERTICAL: 1" = 20'

RIVERWOOD RANCH SUBDIVISION
SECTION 2
A 78 AC, 109-LOT SUBDIVISION
ANGLETON, TEXAS 77515

PLAN & PROFILE
OUTFALL 1
STA. 0+00 TO 5+00

PROJECT NO. 14395

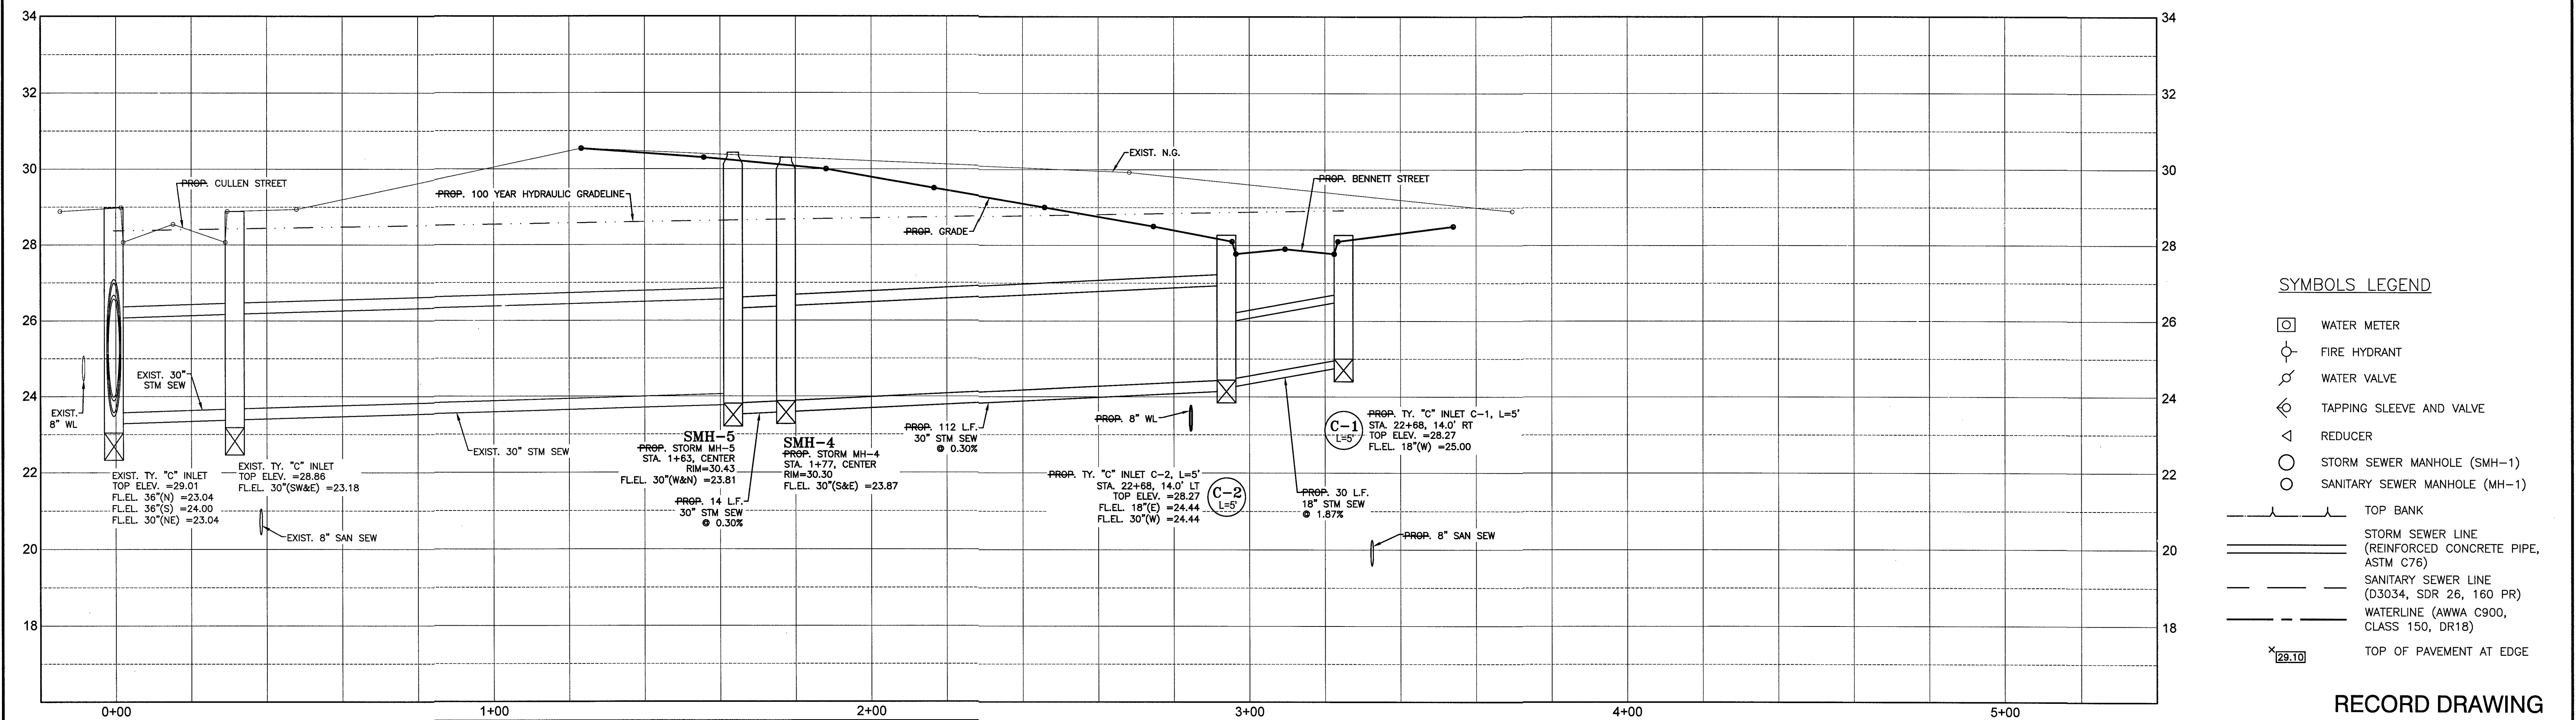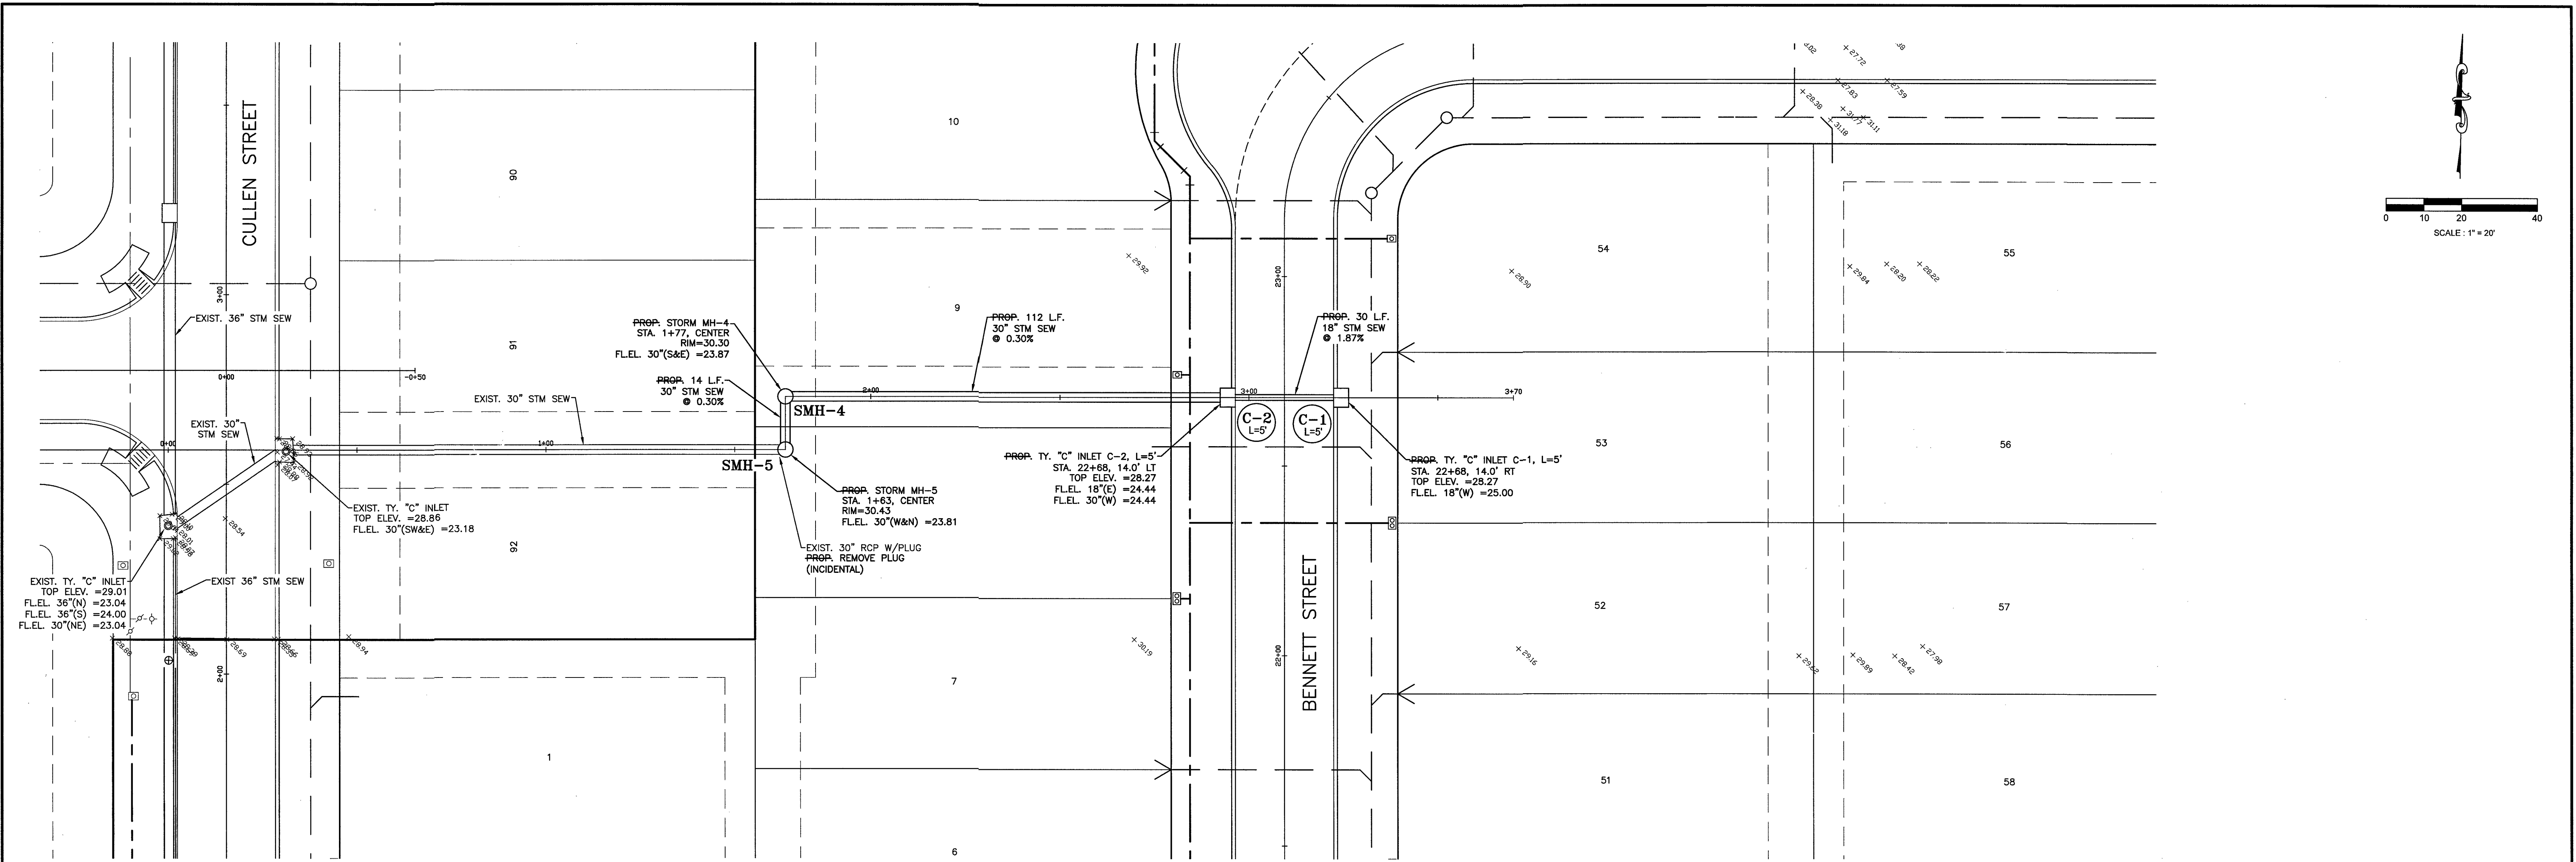


- SYMBOLS LEGEND**
- WATER METER
 - ⊕ FIRE HYDRANT
 - ⊗ WATER VALVE
 - ⊗ TAPPING SLEEVE AND VALVE
 - △ REDUCER
 - STORM SEWER MANHOLE (SMH-1)
 - SANITARY SEWER MANHOLE (MH-1)
 - TOP BANK
 - STORM SEWER LINE (REINFORCED CONCRETE PIPE, ASTM C76)
 - SANITARY SEWER LINE (D3034, SDR 26, 160 PR)
 - WATERLINE (AWWA C900, CLASS 150, DR18)
 - TOP OF PAVEMENT AT EDGE

REVISIONS			
NO.	DATE	DESCRIPTION	APPROVED

DESIGNED DR
DRAWN BT
CHECKED
DATE

B & L
BAKER & LAWSON, INC.
ENGINEERS • PLANNERS • SURVEYORS
4005 TECHNOLOGY DRIVE, SUITE 1530
ANGLETON, TEXAS 77515 (979) 849-6681
REG. NO. F-825

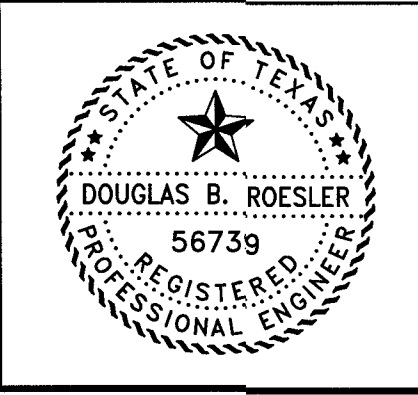

The seal appearing on this document was authorized by Douglas B. Roessler P.E. 56739
Date: 04-18-22

OWNER:
RIVERWAY PROPERTIES
6115 SKYLINE DR. STE A.
HOUSTON, TEXAS 77057




PLAN: 1" = 20'
PROFILE:
HORIZONTAL: 1" = 2'
VERTICAL: 1" = 20'

RIVERWOOD RANCH SUBDIVISION
SECTION 2
A 78 AC, 109-LOT SUBDIVISION
ANGLETON, TEXAS 77515

RECORD DRAWING

PLAN & PROFILE
OUTFALL 2
STA. 0+00 TO 5+00

PROJECT NO. 14395

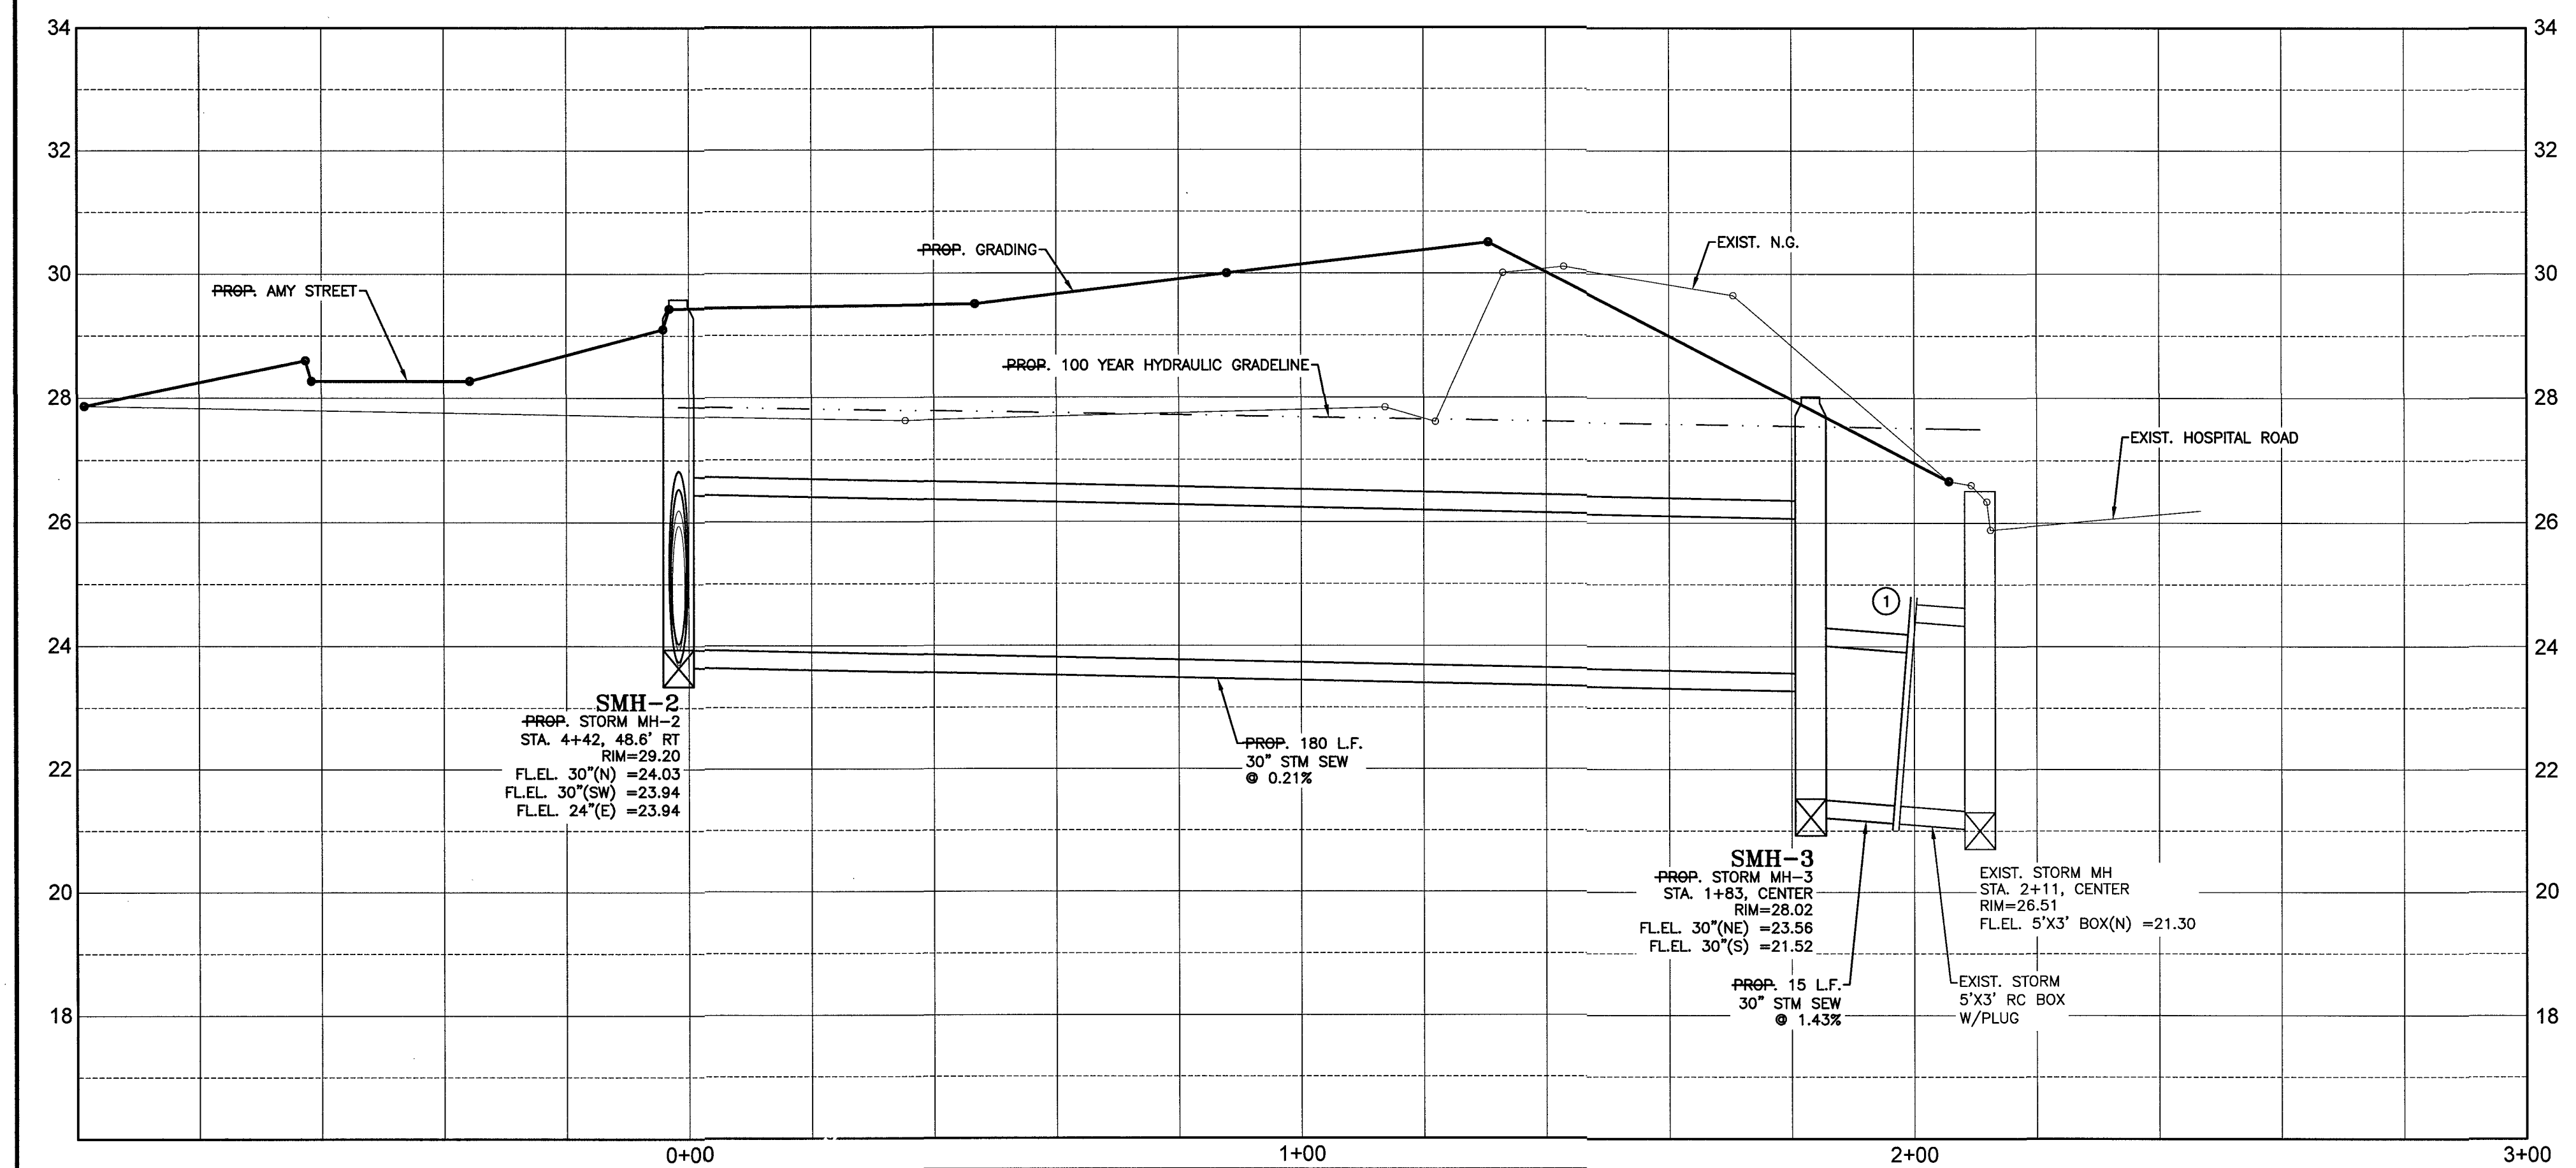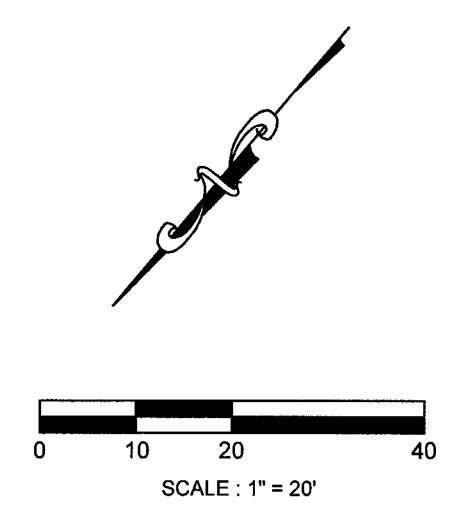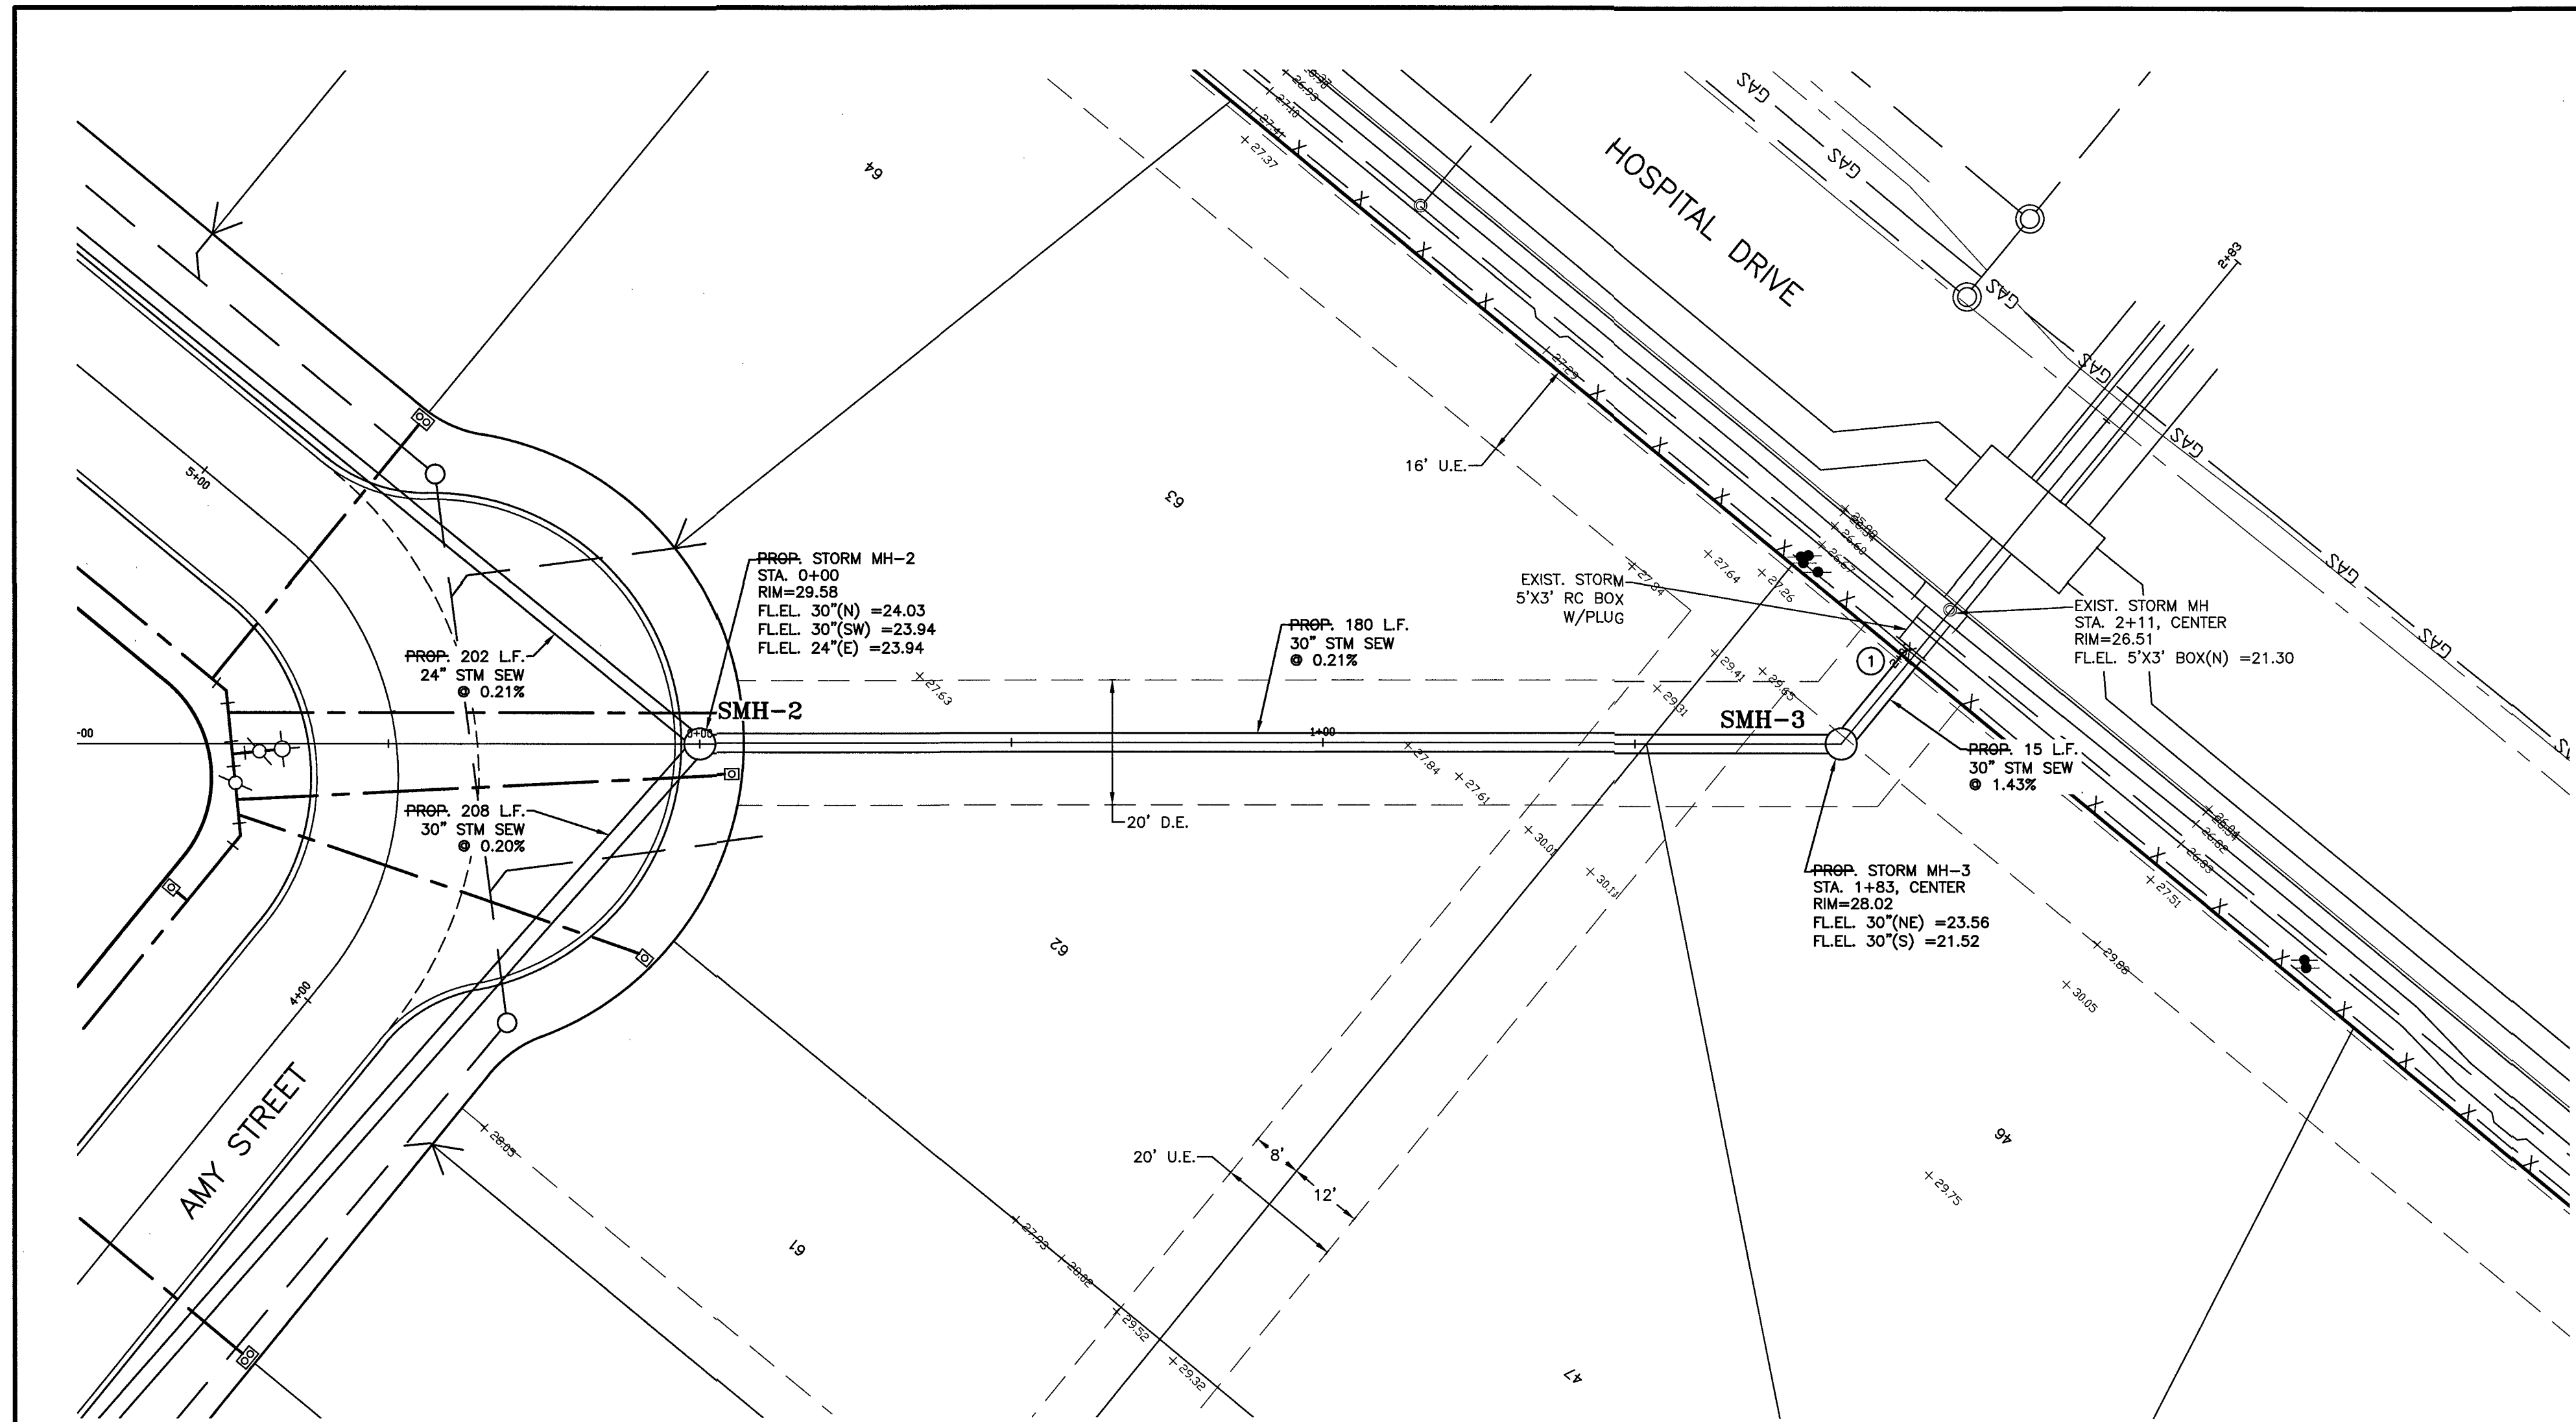


1 EXIST. 5'X3' STUB PLUGGED W/2-COURSE BRICK
REMOVE BRICK PLUG TO INSERT 30" RCP.
RE-BRICK W/2-COURSE WATER TIGHT. (INCIDENTAL)

- SYMBOLS LEGEND**
- WATER METER
 - FIRE HYDRANT
 - WATER VALVE
 - TAPPING SLEEVE AND VALVE
 - REDUCER
 - STORM SEWER MANHOLE (SMH-1)
 - SANITARY SEWER MANHOLE (MH-1)
 - TOP BANK
 - STORM SEWER LINE (REINFORCED CONCRETE PIPE, ASTM C76)
 - SANITARY SEWER LINE (D3034, SDR 26, 160 PR)
 - WATERLINE (AWWA C900, CLASS 150, DR18)
 - TOP OF PAVEMENT AT EDGE

NO.	DATE	DESCRIPTION	APPROVED

DESIGNED DR
DRAWN BT
CHECKED
DATE

B & L
BAKER & LAWSON, INC.
ENGINEERS • PLANNERS • SURVEYORS
4005 TECHNOLOGY DRIVE, SUITE 1530
ANGLETON, TEXAS 77515 (979) 849-6681
REG. NO. F-825

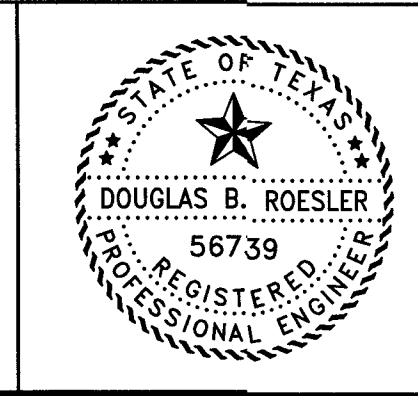



The seal appearing on this document was authorized by Douglas B. Roesler P.E. 56739
Date 04-18-22

OWNER:
RIVERWAY PROPERTIES
6115 SKYLINE DR. STE A.
HOUSTON, TEXAS 77057

PLAN: 1" = 20'
PROFILE:
HORIZONTAL: 1" = 2'
VERTICAL: 1" = 20'

RIVERWOOD RANCH SUBDIVISION
SECTION 2
A 78 AC, 109-LOT SUBDIVISION
ANGLETON, TEXAS 77515

RECORD DRAWING
PLAN & PROFILE
OUTFALL 3
STA. 0+00 TO 3+00
PROJECT NO. 14395

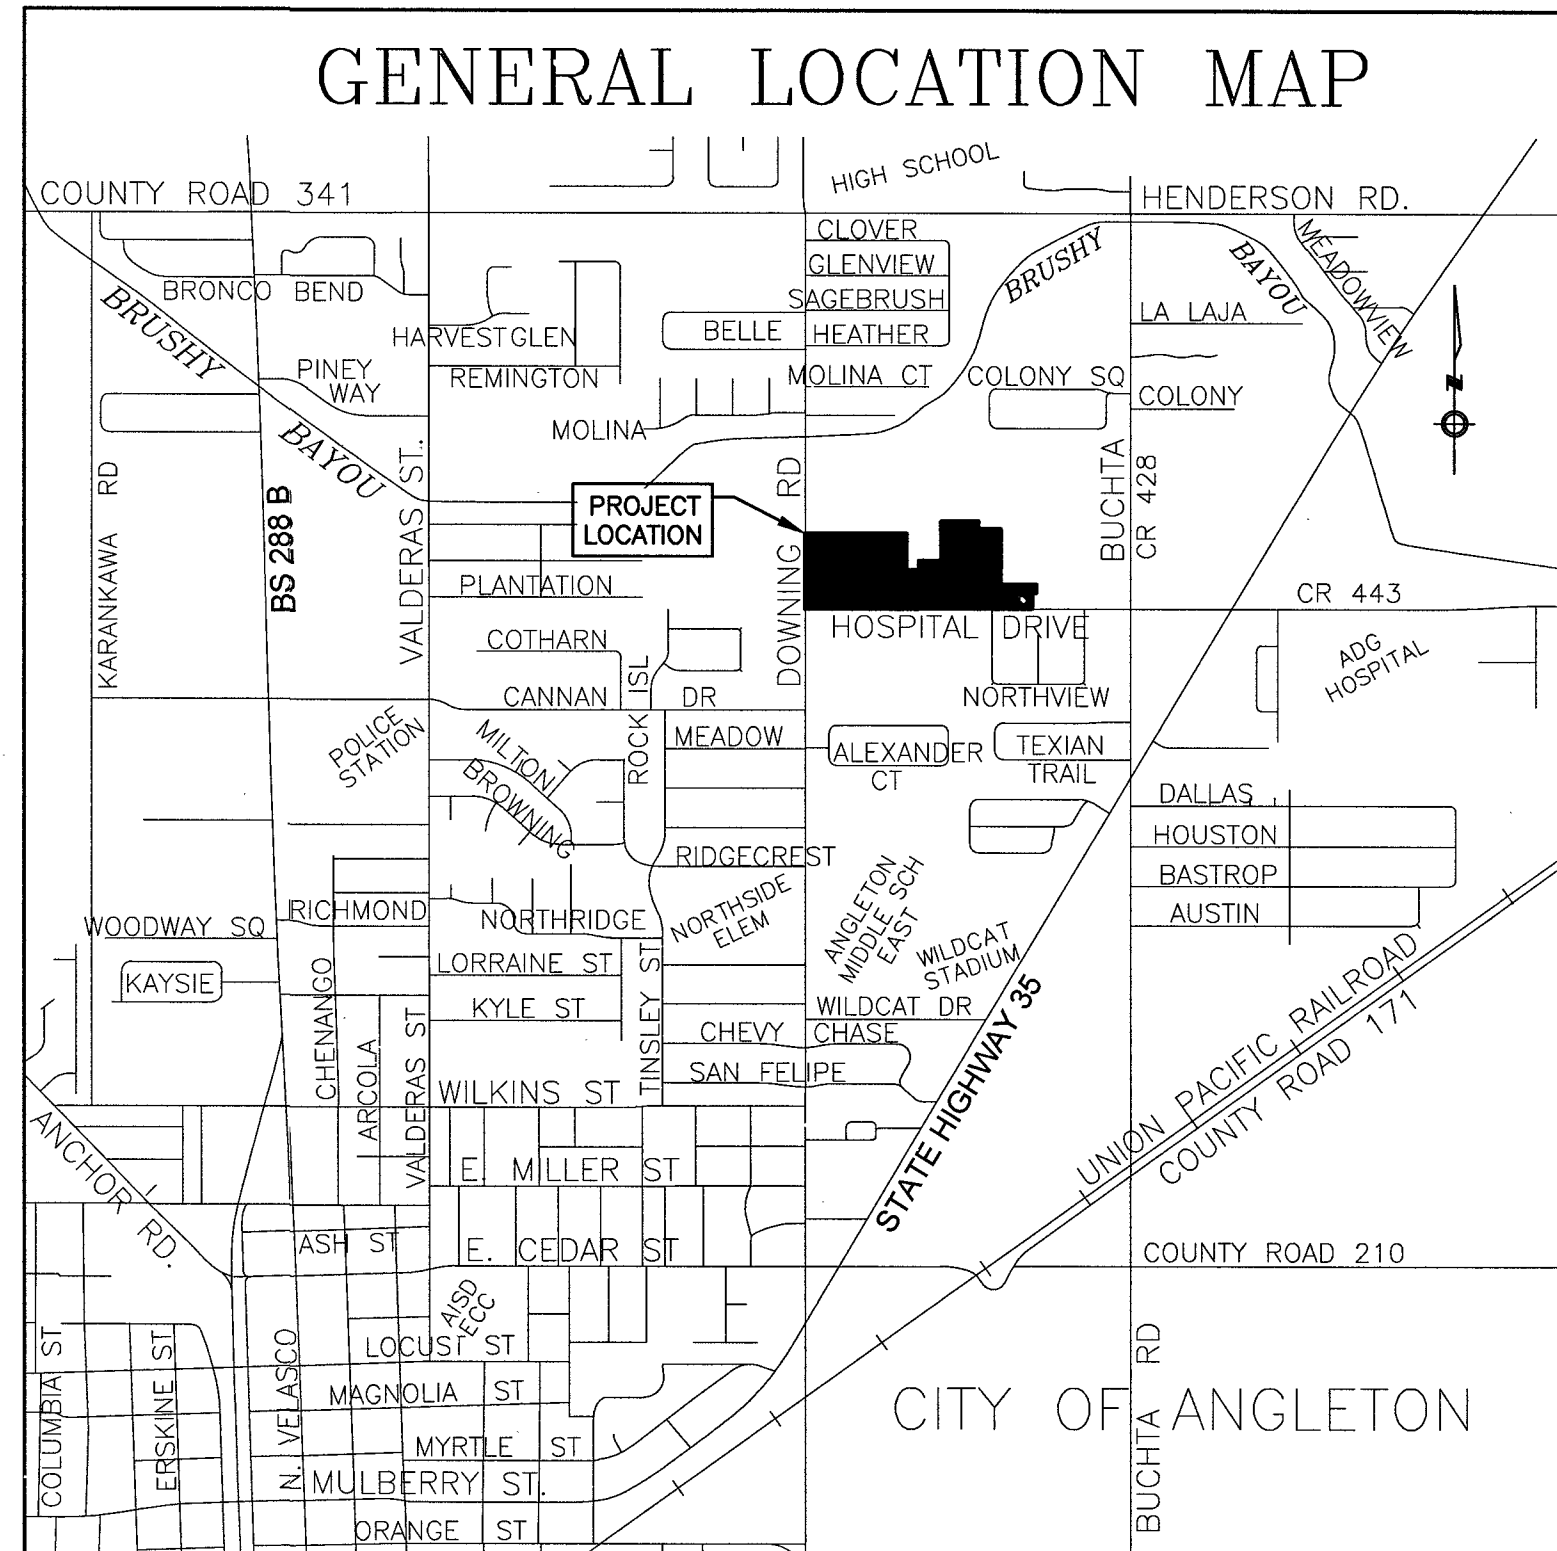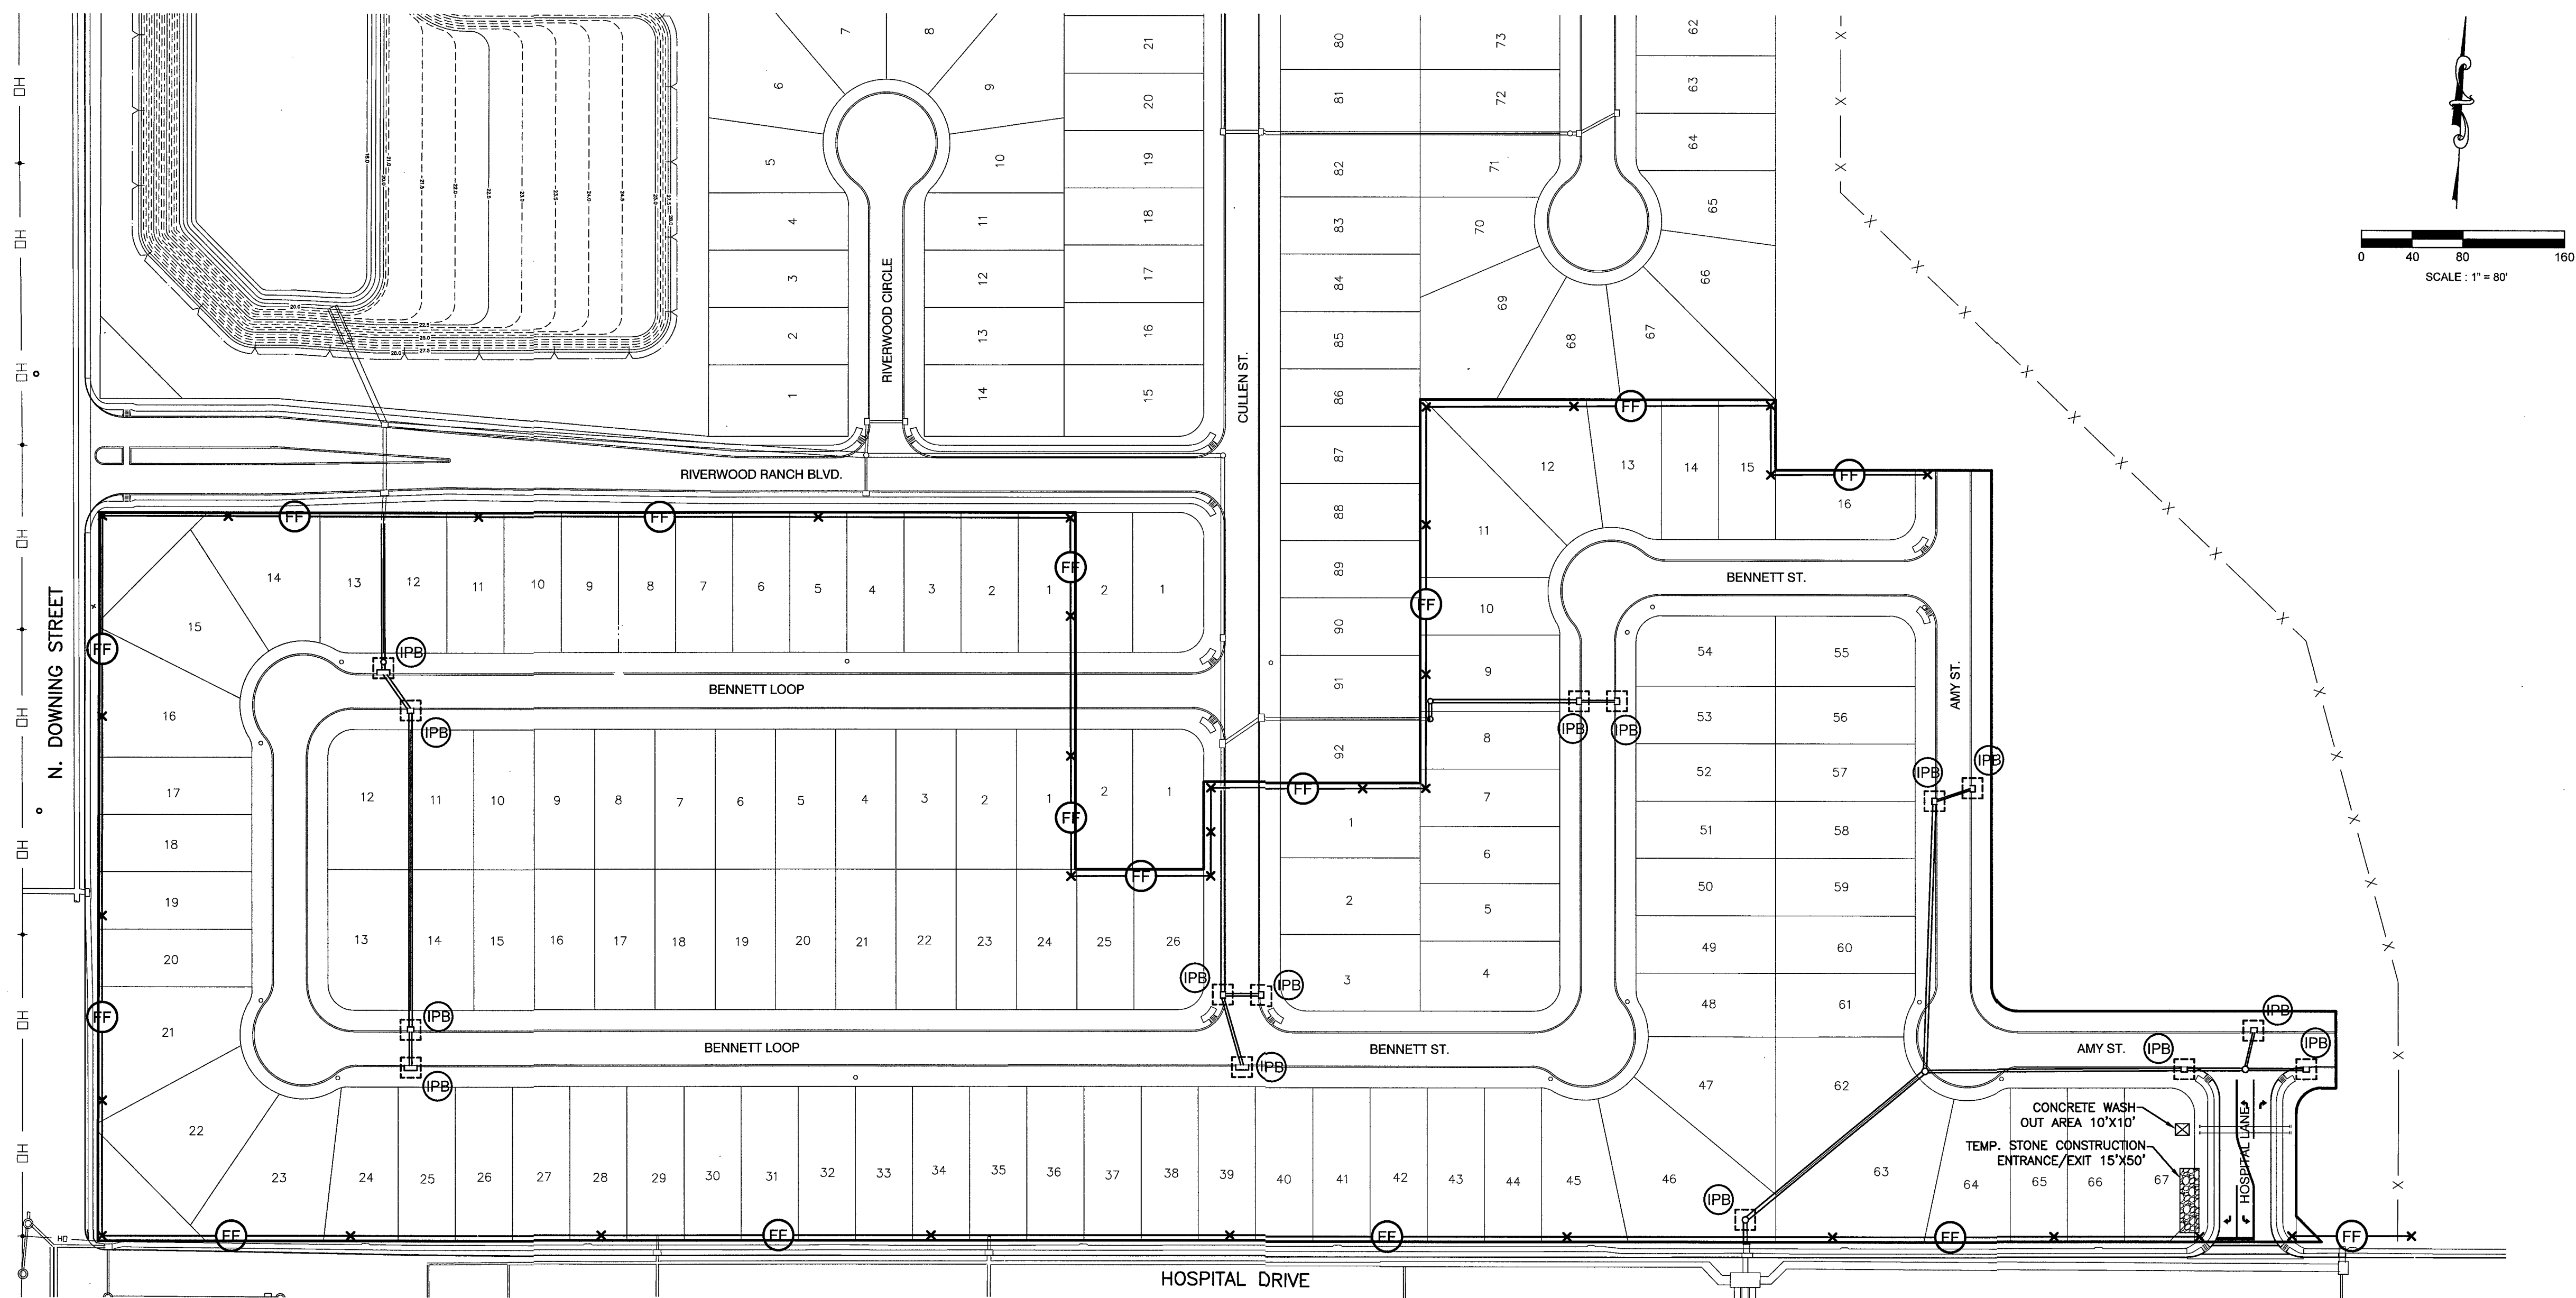

PROJECT/SITE INFORMATION

PROJECT NAME: RIVERWOOD RANCH SUBDIVISION, SECTION 2
PROJECT ADDRESS/LOCATION: NE CORNER OF DOWNING ROAD AND HOSPITAL DRIVE INTERSECTION
CITY: ANGLETON STATE: TX ZIP CODE: 77515
LATITUDE: 95°24'59.4" LONGITUDE: 29°11'08.5" COUNTY: BRAZORIA
NAME OF RECEIVING WATERS: GULF OF MEXICO

11/01/2021 5/01/2022
MONTH/DAY/YEAR MONTH/DAY/YEAR
ESTIMATED CONSTRUCTION START DATE ESTIMATED COMPLETION DATE
ESTIMATE OF AREA TO BE DISTURBED: 20.0 ACRES
ESTIMATE OF LIKELIHOOD OF DISCHARGE:

☐ UNLIKELY ☐ ONCE PER WEEK ☐ CONTINUAL
☒ ONCE PER MONTH ☐ ONCE PER DAY


ARE THERE ANY LISTED ENDANGERED OR THREATENED SPECIES, OR DESIGNATED CRITICAL HABITAT IN THE PROJECT AREA?

☐ YES ☒ NO

ELIGIBILITY WITH REGARD TO PROTECTION OF ENDANGERED SPECIES HAS BEEN SATISFIED THROUGH THE INDICATED SECTION OF PART 1.B.3.e.(2) OF THE PERMIT.


(a) ☒ (b) ☐ (c) ☐ (d) ☐

RECORD DRAWING

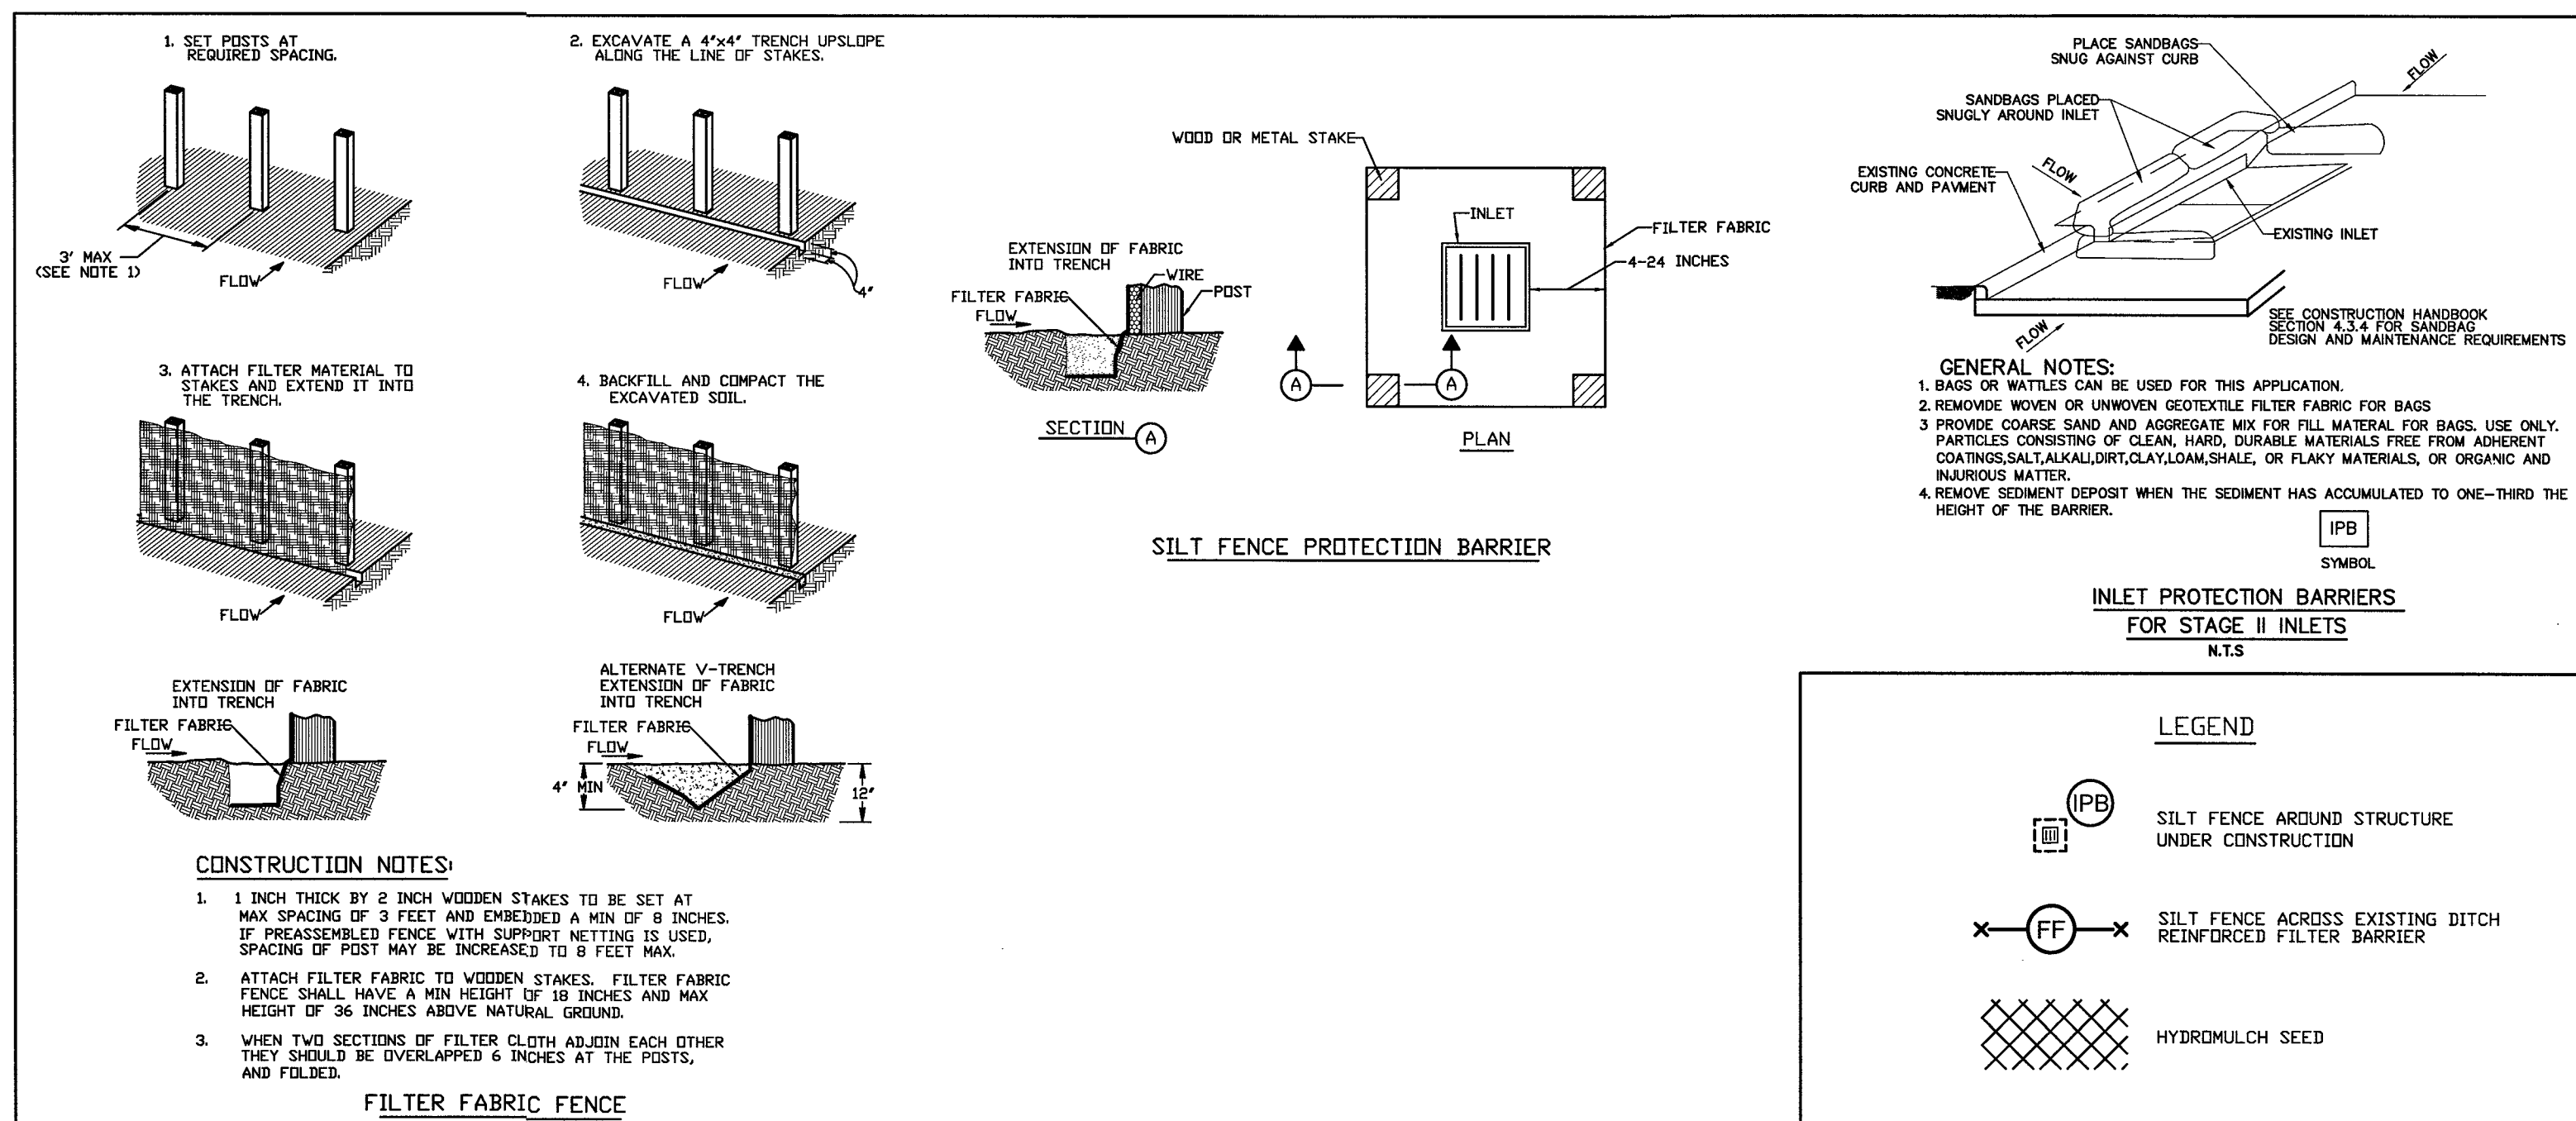

					DESIGNED	DR
					DRAWN	BT
					CHECKED	
NO.	DATE	DESCRIPTION			APPROVED	DATE
REVISIONS						

B & L
BAKER & LAWSON, INC.
ENGINEERS • PLANNERS • SURVEYORS
4005 TECHNOLOGY DRIVE, SUITE 1530
ANGLETON, TEXAS 77515 (979) 849-6681
REG. NO. F-825

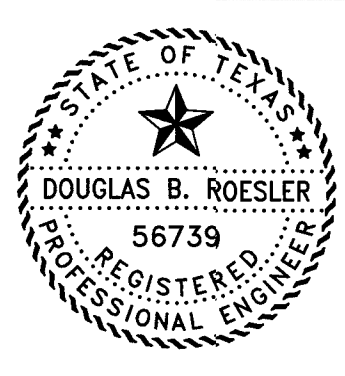

The seal appearing on this document was authorized by Douglas B. Roesler P.E. 56739
Date: 04-18-22

OWNER:
RIVERWAY PROPERTIES
6115 SKYLINE DR. STE A.
HOUSTON, TEXAS 77057

PLAN:
PROFILE:
HORIZONTAL:
VERTICAL:

RIVERWOOD RANCH SUBDIVISION
SECTION 2
A 78 AC, 109-LOT SUBDIVISION
ANGLETON, TEXAS 77515

SWPPP LAYOUT

PROJECT NO. 14395

1. SITE DESCRIPTION

A. NATURE OF THE CONSTRUCTION ACTIVITY:

RIVERWOOD RANCH SUBDIVISION SECTION 2, ANGLETON, BRAZORIA COUNTY, TEXAS, BEING A 19.793 ACRE WHICH WILL BE DEVELOPED INTO A RESIDENTIAL SUBDIVISION OF 109 LOTS (45' WIDE USUALLY).CONSTRUCTION WILL INCLUDE UNDERGROUND UTILITIES, STORM SEWERS AND CONCRETE ROADWAYS WITH CURBS WITH EXCESS EXCAVATION WITH MATERIAL SPREAD FOR LOT GRADING.

B. INTENDED SEQUENCE OF MAJOR SOIL DISTURBING ACTIVITIES:

STREET RIGHT OF WAY AND LOT AREAS WILL BE STRIPPED OF ALL VEGETATIVE MATTER. THIS MATERIAL WILL BE STOCKPILED ADJACENT TO THE WORK TO BE SPREAD ON DEVELOPED LOTS AFTER FINAL GRADING. UTILITY AND STORM SEWER CONSTRUCTION WILL REQUIRE TRENCHING. EXCAVATION FOR ROADWAY SUBGRADE WILL INVOLVE SPREADING EXCAVATED MATERIAL ON ADJACENT LOTS. RAINFALL RUNOFF WILL BE DIRECTED TO THE STREET GUTTERS AND TO THE CONSTRUCTED STORM SEWER SYSTEM. TRUCKS WILL BE USED TO DELIVER MATERIAL TO THE PROJECT INCLUDING LIME, CONCRETE, UTILITY AND STORM SEWER MATERIALS AND OTHER CONSTRUCTION MATERIALS. TRUCKS WILL ALSO BE USED TO HAUL CONSTRUCTION DEBRIS AWAY FROM THE SITE. THESE TRUCKS WILL BE ROUTED ALONG HOSPITAL DR. AND DOWNING ROADS FOR INGRESS AND EGRESS. RUTTING DURING WET WEATHER WILL PROVIDE POTENTIAL FOR TRACKING MUD ALONG THE ROUTE.

C. TOTAL PROJECT AREA: 20 ACRES

D. TOTAL AREA TO BE DISTURBED: 20 ACRES

WEIGHTED RUNOFF COEFFICIENT (BEFORE CONSTRUCTION): 0.25 (AFTER CONSTRUCTION): 0.55

E. REFER TO GENERAL LOCATION MAP AND SITE MAP FOR DRAINAGE PATTERNS AND APPROXIMATE SLOPES ANTICIPATED AFTER MAJOR GRADING ACTIVITIES; AREAS OF SOIL DISTURBANCE; AREAS WHICH WILL NOT BE DISTURBED; LOCTIONS OF MAJOR STRUCTURAL AND NON-STRUCTURAL CONTROLS; LOCATIONS WHERE STABILIZATION PRACTICES ARE EXPECTED TO OCCUR; LOCATION OF OFF-SITE MATERIAL, WASTE, BORROW OR EQUIPMENT STORAGE AREAS; SURFACE WATERS (INCLUDING WETLANDS); AND LOCATIONS WHERE STORM WATER DISCHARGES TO A SURFACE WATER.

F. LOCATION AND DESCRIPTION OF ANY DISCHARGE ASSOCIATED WITH INDUSTRIAL ACTIVITY OTHER THAN CONSTRUCTION:

G. NAME OF RECEIVING WATERS:

RUNOFF WILL BE COLLECTED IN THE STORM SEWER SYSTEM AND ROUTED TO THE EXISTING DETENTION POND IN SECTION 1, AND TO A 5'X3' BOX CULVERT STUBBED OUT FROM HOSPITAL DR. TO SERVE THIS TRACT. THE POND AND THE 5'X3' BOX CULVERT OUTFALL INTO BRUSHY BAYOU WHICH FLOWS TO BASTROP BAYOU AND THEN TO THE GULF OF MEXICO.

AREAL EXTENT AND DESCRIPTION OF WETLAND OR SPECIAL AQUATIC SITE AT OR NEAR THE SITE WHICH WILL BE DISTURBED OR WHICH WILL RECEIVE DISCHARGES FROM DISTURBED AREAS OFTHE PROJECT.

NONE

H. REFER TO FEDERAL REGISTER, VOLUME 63, NO.128, MONDAY JULY 6, 1998, PAGES 36497 TO 36515 FOR REQUIREMENTS OF NPDES GENERAL PERMITS FOR STORM WATER DISCHARGES FROM CONSTRUCTION ACTIVITIES IN REGION 6.

I. LISTED ENDANGERED OR THREATENED SPECIES OR CRITICAL HABITAT FOUND IN PROXIMITY TO THE CONSTRUCTION ACTIVITY:

NONE

J. PROPERTY LISTED OR ELIGIBLE FOR LISTING ON THE NATIONAL REGISTER OF HISTORIC PLACES:

NONE

2. CONTROLS

NARRATIVE - SEQUENCE OF CONSTRUCTION ACTIVITIES AND APPROPRIATE CONTROL MEASURES DURING CONSTRUCTION

THE ORDER OF CONSTRUCTION WILL BEGIN WITH STRIPPING OF ALL VEGETATION FROM THE WORK AREA.

1. INSTALL SILT FENCE AROUND THE PERIMETER OF THE AREA TO BE DISTURBED. THE ORDER OF ACTIVITIES WILL BEGIN WITH THE COMPLETE STRIPPING OF ALL AREAS TO RECEIVE FILL MATERIAL. REMOVED VEGETATION TO BE STOCKPILED ADJACENT TO THE WORK TO BE SPREAD AFTER LOT GRADING IS COMPLETE.

2. INSTALL WATER LINES, SANITARY SEWER LINES AND MANHOLES AND STORM SEWER PIPES, INLETS AND MANHOLES. INSTALL INLET PROTECTION BARRIERS AROUND ALL INLETS.

3. ROADWAY EXCAVATION, LIME STABILIZATION AND CONCRETE PAVING WILL FOLLOW UNDERGROUND UTILITY AND STORM SEWER CONSTRUCTION.

4. AS SOON AS CONCRETE CURBS ARE INSTALLED, PLACE 18" WIDE SOLID SOD BEHIND ALL CURBS, OR FILTER FABRIC FENCE.

A. EROSION AND SEDIMENT CONTROLS: EROSION AND SEDIMENT CONTROLS SHALL RETAIN SEDIMENT ON SITE TO THE EXTENT PRACTICABLE. CONTROL MEASURES SHALL BE INSTALLED AND MAINTAINED IN ACCORDANCE WITH MANUFACTURER'S SPECIFICATIONS (WHERE APPLICABLE) AND GOOD ENGINEERING PRACTICES. OFFSITE SEDIMENT ACCUMULATIONS MUST BE REMOVED AT A FREQUENCY SUFFICIENT TO MINIMIZE OFFSITE IMPACTS. SEDIMENT MUST BE REMOVED FROM SEDIMENT TRAPS OR SEDIMENTATION PONDS WHEN CAPACITY HAS BEEN REDUCED BY 50%. LITTER, CONSTRUCTION DEBRIS, AND CONSTRUCTION CHEMICALS EXPOSED TO STORM WALL SHALL BE PREVENTED FROM BECOMING A POLLUTANT SOURCE FOR STORM WATER DISCHARGES.

SOIL STABILIZATION PRACTICES:	OWNER/ DEVELOPER	GENERAL CNTRTR.	BUILDER	OTHER
TEMPORARY SEEDING				
PERMANENT PLANTING, SODDING, OR SEEDING		X		
MULCHING-WHERE INDICATED		X		
SOIL RETENTION BLANKET				
VEGETATIVE BUFFER STRIPS				
PRESERVATION OF NATURAL RESOURCES				
OTHER:				

THE FOLLOWING RECORDS SHALL BE MAINTAINED AND ATTACHED TO THIS SWPPP:
DATES WHEN MAJOR GRADING ACTIVITIES OCCUR, DATES WHEN CONSTRUCTION ACTIVITIES TEMPORARILY OR PERMANENTLY CEASE ON A PORTION OF THE SITE, DATES WHEN STABILIZATION MEASURES ARE INITIATED.

STRUCTURAL PRACTICES:	OWNER/ DEVELOPER	GENERAL CNTRTR.	BUILDER	OTHER
SILT FENCES		X		
HAY BALES				
ROCK BERMS				
DIVERSION, INTERCEPTOR, OR PERIMETER DIKES				
DIVERSION, INTERCEPTOR, OR PERIMETER SWALES				
DIVERSION DIKE AND SWALE COMBINATIONS				
PIPE SLOPE DRAINS				
ROCK BEDDING AT CONSTRUCTION EXIT				
TIMBER MATTING AT CONSTRUCTION EXIT				
SEDIMENT TRAPS				
SEDIMENT BASINS				
STORM INLET PROTECTION		X		
STONE OUTLET STRUCTURES				
OTHER:				

B. STORM WATER MANAGEMENT MEASURES INSTALLED DURING CONSTRUCTION TO CONTROL POLLUTANTS IN STORM WATER DISCHARGES THAT WILL OCCUR AFTER CONSTRUCTION:

CURBS & GUTTERS STORM SEWERS

C. OTHER CONTROLS

NO SOLID MATERIALS, INCLUDING BUILDING MATERIALS, SHALL BE DISCHARGED TO WATERS OF THE UNITED STATES, EXCEPT AS AUTHORIZED BY A PERMIT ISSUED UNDER SECTION 404 OF THE CLEAN WATER ACT.

WASTE MATERIALS: ALL WASTE MATERIALS WILL BE COLLECTED AND STORED IN A SECURELY LIDDED METAL CONTAINER. THE CONTAINER SHALL MEET ALL STATE AND CITY SOLID WASTE MANAGEMENT REGULATIONS. THE CONTAINER SHALL BE EMPTIED AS NECESSARY AND THE TRASH HAULED TO AN APPROPRIATE DUMP SITE. NO CONSTRUCTION MATERIALS WILL BE BURIED ON SITE.

HAZARDOUS WASTE (INCLUDING SPILL REPORTING): AT A MINIMUM, ANY PRODUCTS IN THE FOLLOWING CATEGORIES ARE CONSIDERED TO BE HAZARDOUS: PAINT, CLEANING SOLVENTS, ASPHALT PRODUCTS, PETROLEUM PRODUCTS, CHEMICAL ADDITIVES FOR SOIL STABILIZATION, AND CONCRETE CURING COMPOUNDS AND ADDITIVES. IN THE EVENT OF A SPILL WHICH MAY BE HAZARDOUS, THE SPILL COORDINATOR SHOULD BE CONTACTED IMMEDIATELY.

SANITARY WASTE: PORTABLE SANITARY FACILITIES WILL BE PROVIDED BY THE CONTRACTOR. ALL SANITARY WASTES WILL BE COLLECTED FROM PORTABLE UNITS AND SERVICED BY A LICENSED SANITARY WASTE MANAGEMENT CONTRACTOR.

OFFSITE VEHICLE TRACKING SHALL BE MINIMIZED BY:

HAUL ROADS DAMPENED FOR DUST CONTROL LOADED
X HAUL TRUCKS TO BE COVERED WITH TARPAULIN
X EXCESS DIRT ON ROAD REMOVED DAILY STABILIZED
CONSTRUCTION ENTRANCE

OTHER: TRUCKS HAULING VEGETATION AND DEBRIS WILL BE MONITORED AND SHALL BE COVERED WITH TARPAULINS IF REQUIRED TO PREVENT DUST OR OTHER PARTICLES FROM BLOWING OR FALLING FROM TRUCK.

REMARKS: ALL OPERATIONS WILL BE CONDUCTED IN A MANNER THAT WILL MINIMIZE AND CONTROL THE AMOUNTS OF SEDIMENT THAT MAY ENTER THE RECEIVING WATERS. DISPOSAL AREAS SHALL NOT BE LOCATED IN ANY WETLAND, WATERBODY, OR STREAMBED. CONSTRUCTION STAGING AREAS AND VEHICLE MAINTENANCE AREAS SHALL BE CONSTRUCTED BY THE CONTRACTOR IN A MANNER TO MINIMIZE THE RUNOFF OF POLLUTANTS.

3. MAINTENANCE

ALL EROSION AND SEDIMENT CONTROLS WILL BE MAINTAINED IN EFFECTIVE OPERATING CONDITION. IF A REPAIR IS NECESSARY IT SHALL BE DONE AT THE EARLIEST TIME POSSIBLE, BUT NO LATER THAN SEVEN CALENDAR DAYS AFTER THE GROUND HAS DRIED SUFFICIENTLY TO PREVENT FURTHER DAMAGE FROM HEAVY EQUIPMENT. THE AREAS ADJACENT TO DRAINAGE WAYS SHALL HAVE PRIORITY, FOLLOWED BY DEVICES PROTECTING STORM SEWER INLETS. MAINTENANCE SHALL BE PERFORMED BEFORE THE NEXT ANTICIPATED STORM EVENT OR AS SOON AS PRACTICABLE.

4. INSPECTION

AN INSPECTION WILL BE PERFORMED BY THE PERMITEE EVERY FOURTEEN DAYS AS WELL AS AFTER EVERY ONE-HALF INCH OR GREATER RAINFALL EVENT. AN INSPECTION AND RAINFALL REPORT WILL BE MADE AFTER EACH INSPECTION. ANY DEFICIENCIES WILL BE NOTED AND APPROPRIATE CHANGES SHALL BE MADE TO THE SYSTEM TO COMPLY WITH REQUIREMENTS.



5. NON-STORMWATER DISCHARGES

FIRE HYDRANT FLUSHING
X BUILDING WASHDOWN WITHOUT DETERGENTS
X PAVEMENT WASHDOWN WITHOUT DETERGENTS
X CONDENSATE
UNCONTAMINATED GROUNDWATER
UNCONTAMINATED FOUNDATION DRAINS

RECORD DRAWING

NO.	DATE	DESCRIPTION	APPROVED
REVISIONS			

DESIGNED DR
DRAW'N BT
CHE' KED
DATE

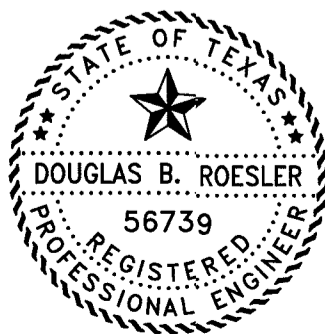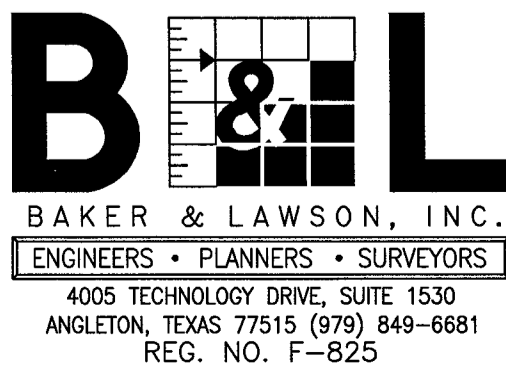

The seal appearing on this document was authorized by Douglas B. Roesler P.E. 56739
Date: 04/18/22

OWNER:
RIVERWAY PROPERTIES
6115 SKYLINE DR. STE A.
HOUSTON, TEXAS 77057

PLAN:
PROFILE:
HORIZONTAL:
VERTICAL:

RIVERWOOD RANCH SUBDIVISION
SECTION 2
A 78 AC, 109-LOT SUBDIVISION
ANGLETON, TEXAS 77515

SWPPP NARRATIVE

PROJECT NO. 14395

1

Hydrological and Hydraulic Impacts
Riverwood Ranch Subdivision - Sec. 1 & 2

Job # 13032

Brazoria County, Texas

A= 42.474 Acre Development :

Pre Development:

C = 0.2186
TC = 90.0 Minutes, I = 3.66
Q = 100 Year Storm = 34.82 cfs
Q-Allowable is 0.80 cfs / ac. = 33.98 cfs

Post Development

C = 0.60
T/C = 27.6 Minutes, I = 6.732
Q = 100 Year Storm = 214.44 cfs

Required Detention:

20.834 acre - feet (907,529 c.f.)

Douglas B. Roesler, P.E. Sep. 18, 2021

EXISTING CONDITIONS

Bra. Co. Master Drg. Study allows only 0.80 cfs/acre in this area. These are Bastrop Bayou drainage areas BB 35 and BB 36.

TC = 15 Minutes gather time plus diagonal length (1,800') overland at 0.40 fps = 90.0 Minutes

PROPOSED CONDITIONS

TC = 15 Minutes gather time + 150' overland at 0.50 fps + 1,360 l.f. storm sewer at 3 fps = 27.6 Minutes
C = 0.60 (Sugarland allows C=0.55)

2

Drainage Analysis

Job # 13032 - Riverwood Ranch Subdivision - Sections 1 and 2

Rainfall intensity calculations for Brazoria County

I = intensity (in/hr)
b = coefficient
t = time of concentration
d = coefficient
e = coefficient

subscript i=1 = 2 year storm
i=2 = 5 year storm
i=3 = 10 year storm
i=4 = 25 year storm
i=5 = 50 year storm
i=6 = 100 year storm

i := 1..6

b _i :=	e _i :=	d _i :=
71.0	0.774	8.4
70.1	0.752	7.7
96.6	0.770	7.7
89.2	0.736	17.2
86.5	0.709	10.4
120.2	0.741	21.3

T₀ := 90.0 ENTER PREDEVELOPMENT TIME OF CONCENTRATION

I₁ := $\frac{b_1}{(d_1 + T_0)^{e_1}}$ I₀ = 3.66 Predevelopment Intensity of interest

C_{pre} := .2186 ENTER PREDEVELOPMENT C VALUE

A := 42.474 ENTER AREA

3

Predevelopment hydrograph

T₀ := 27.6 ENTER POST DEVELOPMENT TIME OF CONCENTRATION

I₁ := $\frac{b_1}{(d_1 + T_0)^{e_1}}$ I₀ = 6.732 Post development I of interest

C_{pre} := 0.60 ENTER POST DEVELOPMENT C FACTOR
C_{de} := 1.25 REVISE C AND AREA IF NECESSARY

Q_{pre} := C_{de} * I₀ * A * C_{pre}

Q = 214.443

V_{pre} := (C) * A * 43560 * 1.08

V = 1.199 x 10⁶

T := $\frac{V}{1.39 \cdot Q}$ T = 4.022 x 10³

t := 0, 1000..25000

4

C_{de} := 1.00

Q := C_{de} * I₀ * A Must insert correct subscript for I to obtain the relevant Q

Q = 33.98

V_{pre} := (C) * A * 43560 * 1.08 For these calculations, total volume storage is assumed to equal (C)*A with A converted to square feet multiplied by 13' (1.08)

V = 4.368 x 10⁵

DEVELOPMENT OF RUNOFF HYDROGRAPH
MALCOM'S METHOD AS DESCRIBED IN THE
BRAZORIA COUNTY DRAINAGE CRITERIA
MANUAL

T := $\frac{V}{1.39 \cdot Q}$ T = 9.248 x 10³ T = Time to peak, presented as a function of volume and peak flow and therefore indirectly related to time of concentration

t := 0, 1000..84000

f(t) := $\left(\frac{Q}{2}\right) \cdot \left(1 - \cos\left(\frac{t \cdot \pi}{T}\right)\right)$ f(t) describes rising limb of hydrograph

g(t) := 4.34 * Q * exp $\left[-1.30 \cdot \left(\frac{t}{T}\right)\right]$ g(t) describes descending limb of hydrograph

q(t) := if(t ≤ 1.25 * T, f(t), g(t))

Volume_{pre} := $\int_0^{86400} q(t) dt$

Volume_{pre} = 4.383 x 10⁵

5

f(t) := $\left(\frac{Q}{2}\right) \cdot \left(1 - \cos\left(\frac{t \cdot \pi}{T}\right)\right)$

g(t) := 4.34 * Q * exp $\left[-1.30 \cdot \left(\frac{t}{T}\right)\right]$

r(t) := if(t ≤ 1.25 * T, f(t), g(t))

Volume_{post} := $\int_0^{86400} r(t) dt$

Volume_{post} = 1.203 x 10⁶

Post development hydrograph

Combined pre and post development hydrographs

6

f(t) := ((r(t) - q(t))) * 1

v(t) := if(f(t) > 0, f(t), 0)

THE REQUIRED STORAGE COMPUTED AS THAT PART OF THE POST DEVELOPMENT HYDROGRAPH THAT FALLS ABOVE THE PREDEVELOPMENT HYDROGRAPH

ACRE- FEET

$\int_0^{86400} v(t) dt$
43560 = 20.834

14395 - RIVERWOOD RANCH IN ANGLETON, NW DETENTION POND - SECTIONS 1 AND 2
ULTIMATE - 42.484 AC COMBINED. - RESTRICTIVE OUTLET WITH MAX. FLOW RATE OF 33.99 CFS AND 1.0' HEAD

A	B	C	D	E	F	G	H	I	J	K	L	M	N
1	H.C.F.C.D. EQUATION FOR A HDPE PIPE WITH KNOWN "L", "n", "D" AND ASSUMED "H"												
2	H"	Q"	ENTR.	n	L	D		EQ.	EQ.	EQ.	EQ.	EQ.	EQ.
3			LOSS					2.5204(1+D4)	ERR	B4/(C4/10)^2	14/G4^4	J4/G4^5.333	L4-(L4+M4)
4	1	26.2	0.5	0.011	116	2.5		3.7806	6.5433	0.1462	0.0968	0.0494	0.0000
5	1	39.1	0.5	0.011	116	3		3.7806	6.5433	0.0654	0.0467	0.0187	0.0000

USE 30" RESTRICTIVE OUTLET

ORIFICE EQUATION

Q = Cd * A * (2 * G * H)^0.5

Where:


Cd = 0.8

G = 32.2

H = 1

Q = 33.99


A = 5.29 30" Dia. 4.91 S.F.

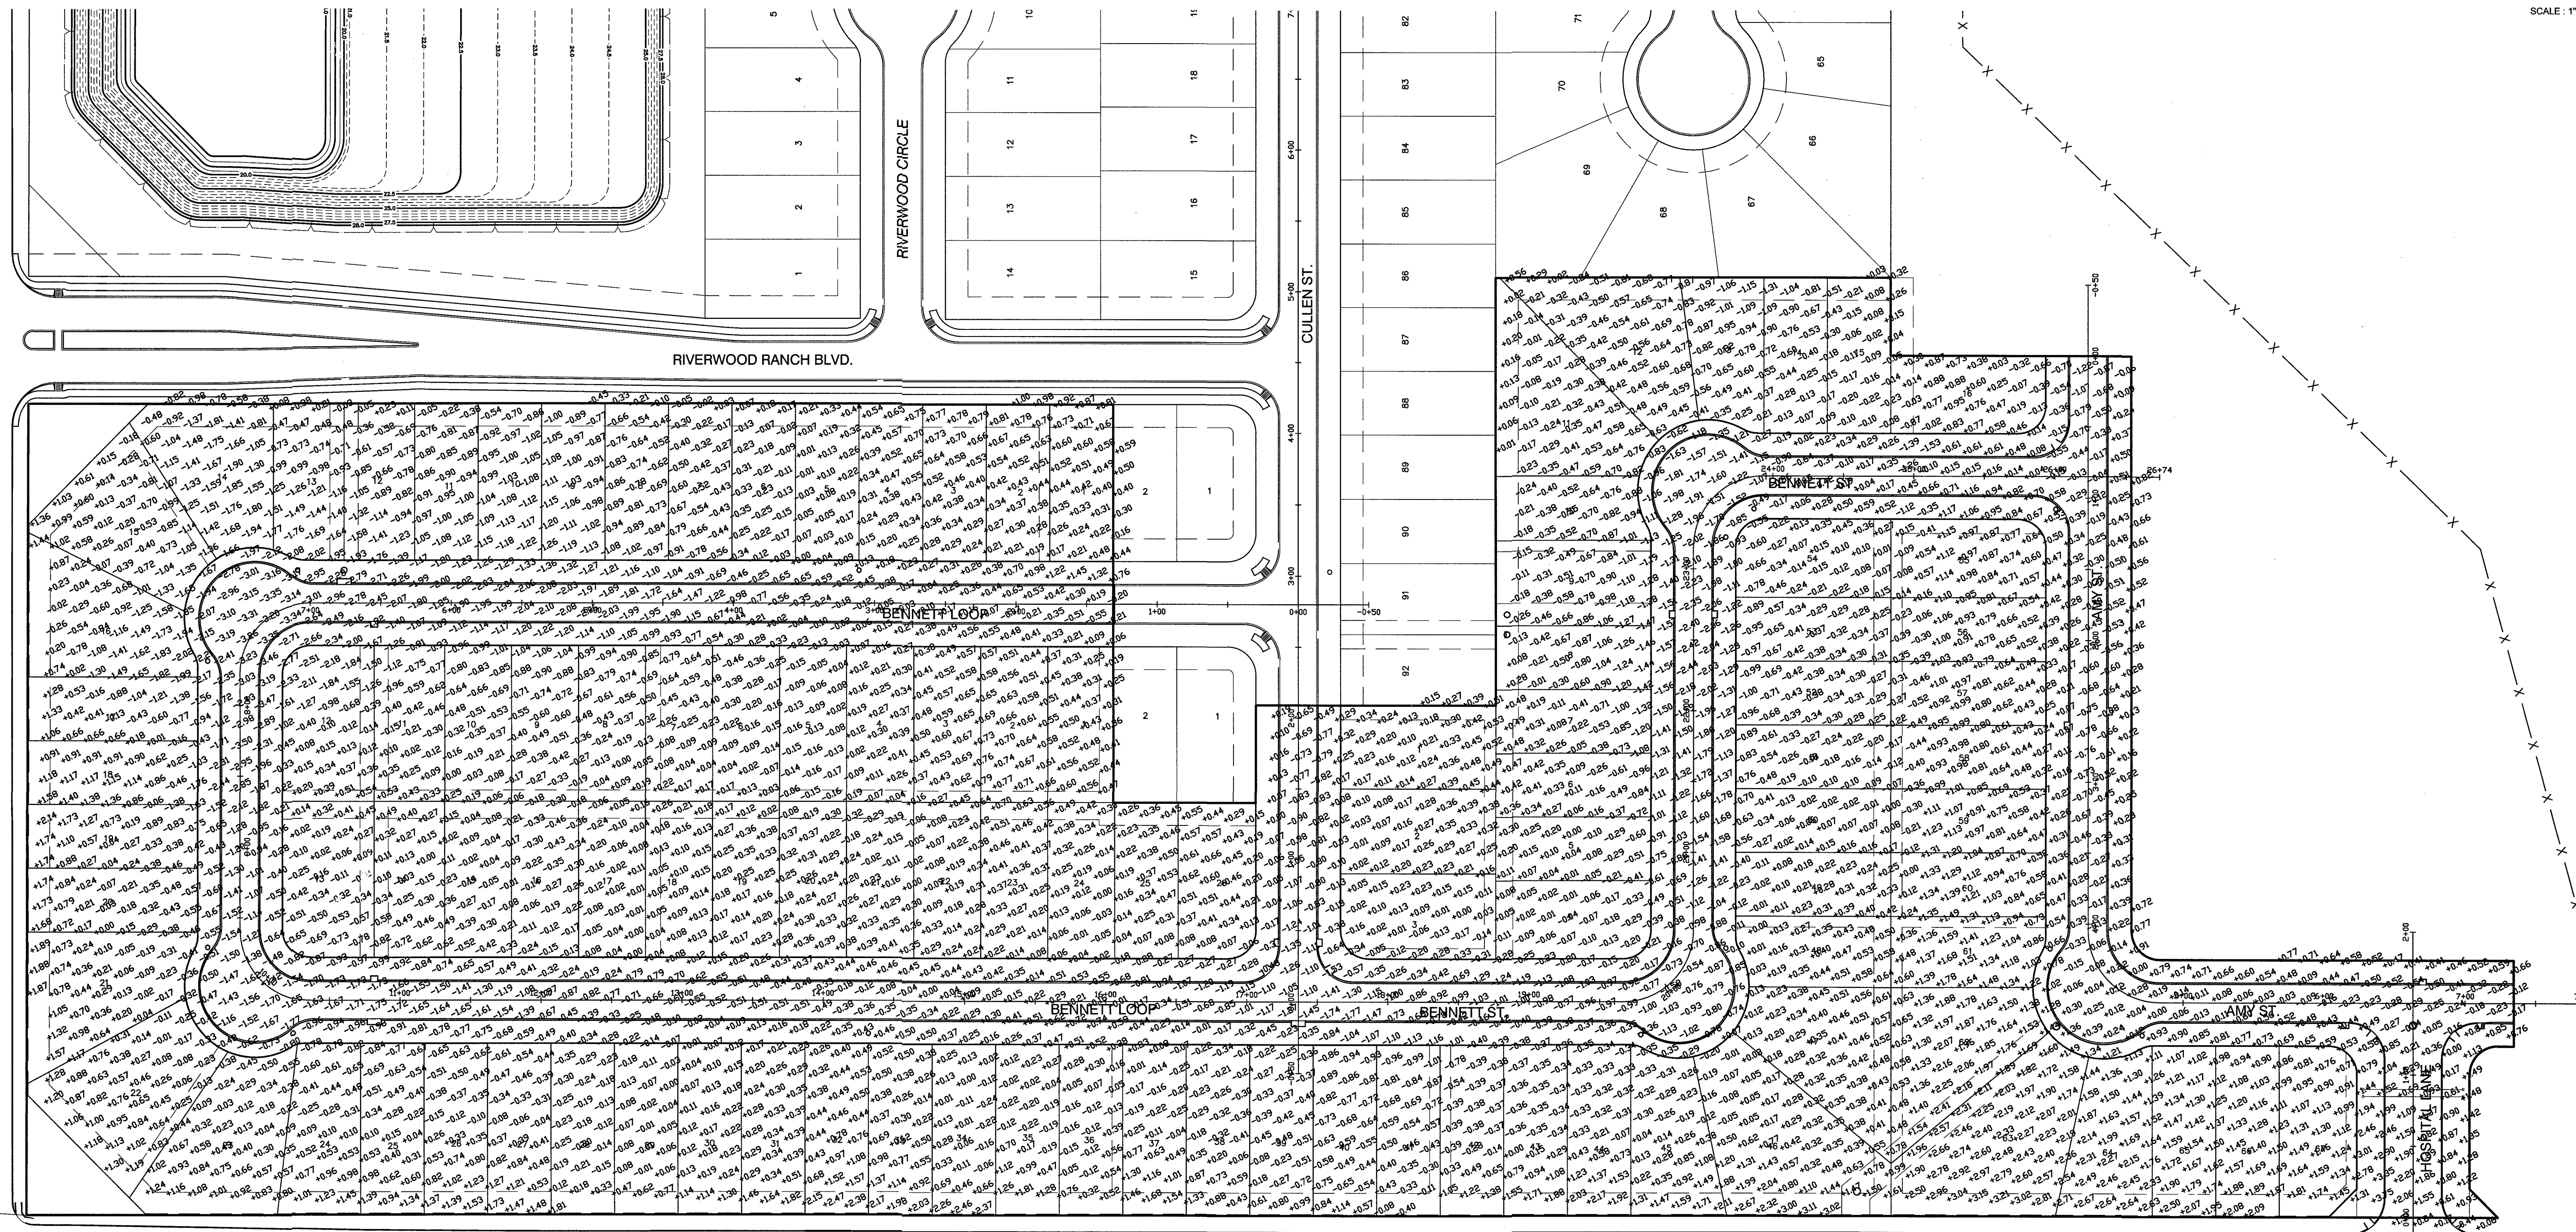

RECORD DRAWING

CUT AND FILL PLAN

PROJECT NO. 14-395 22

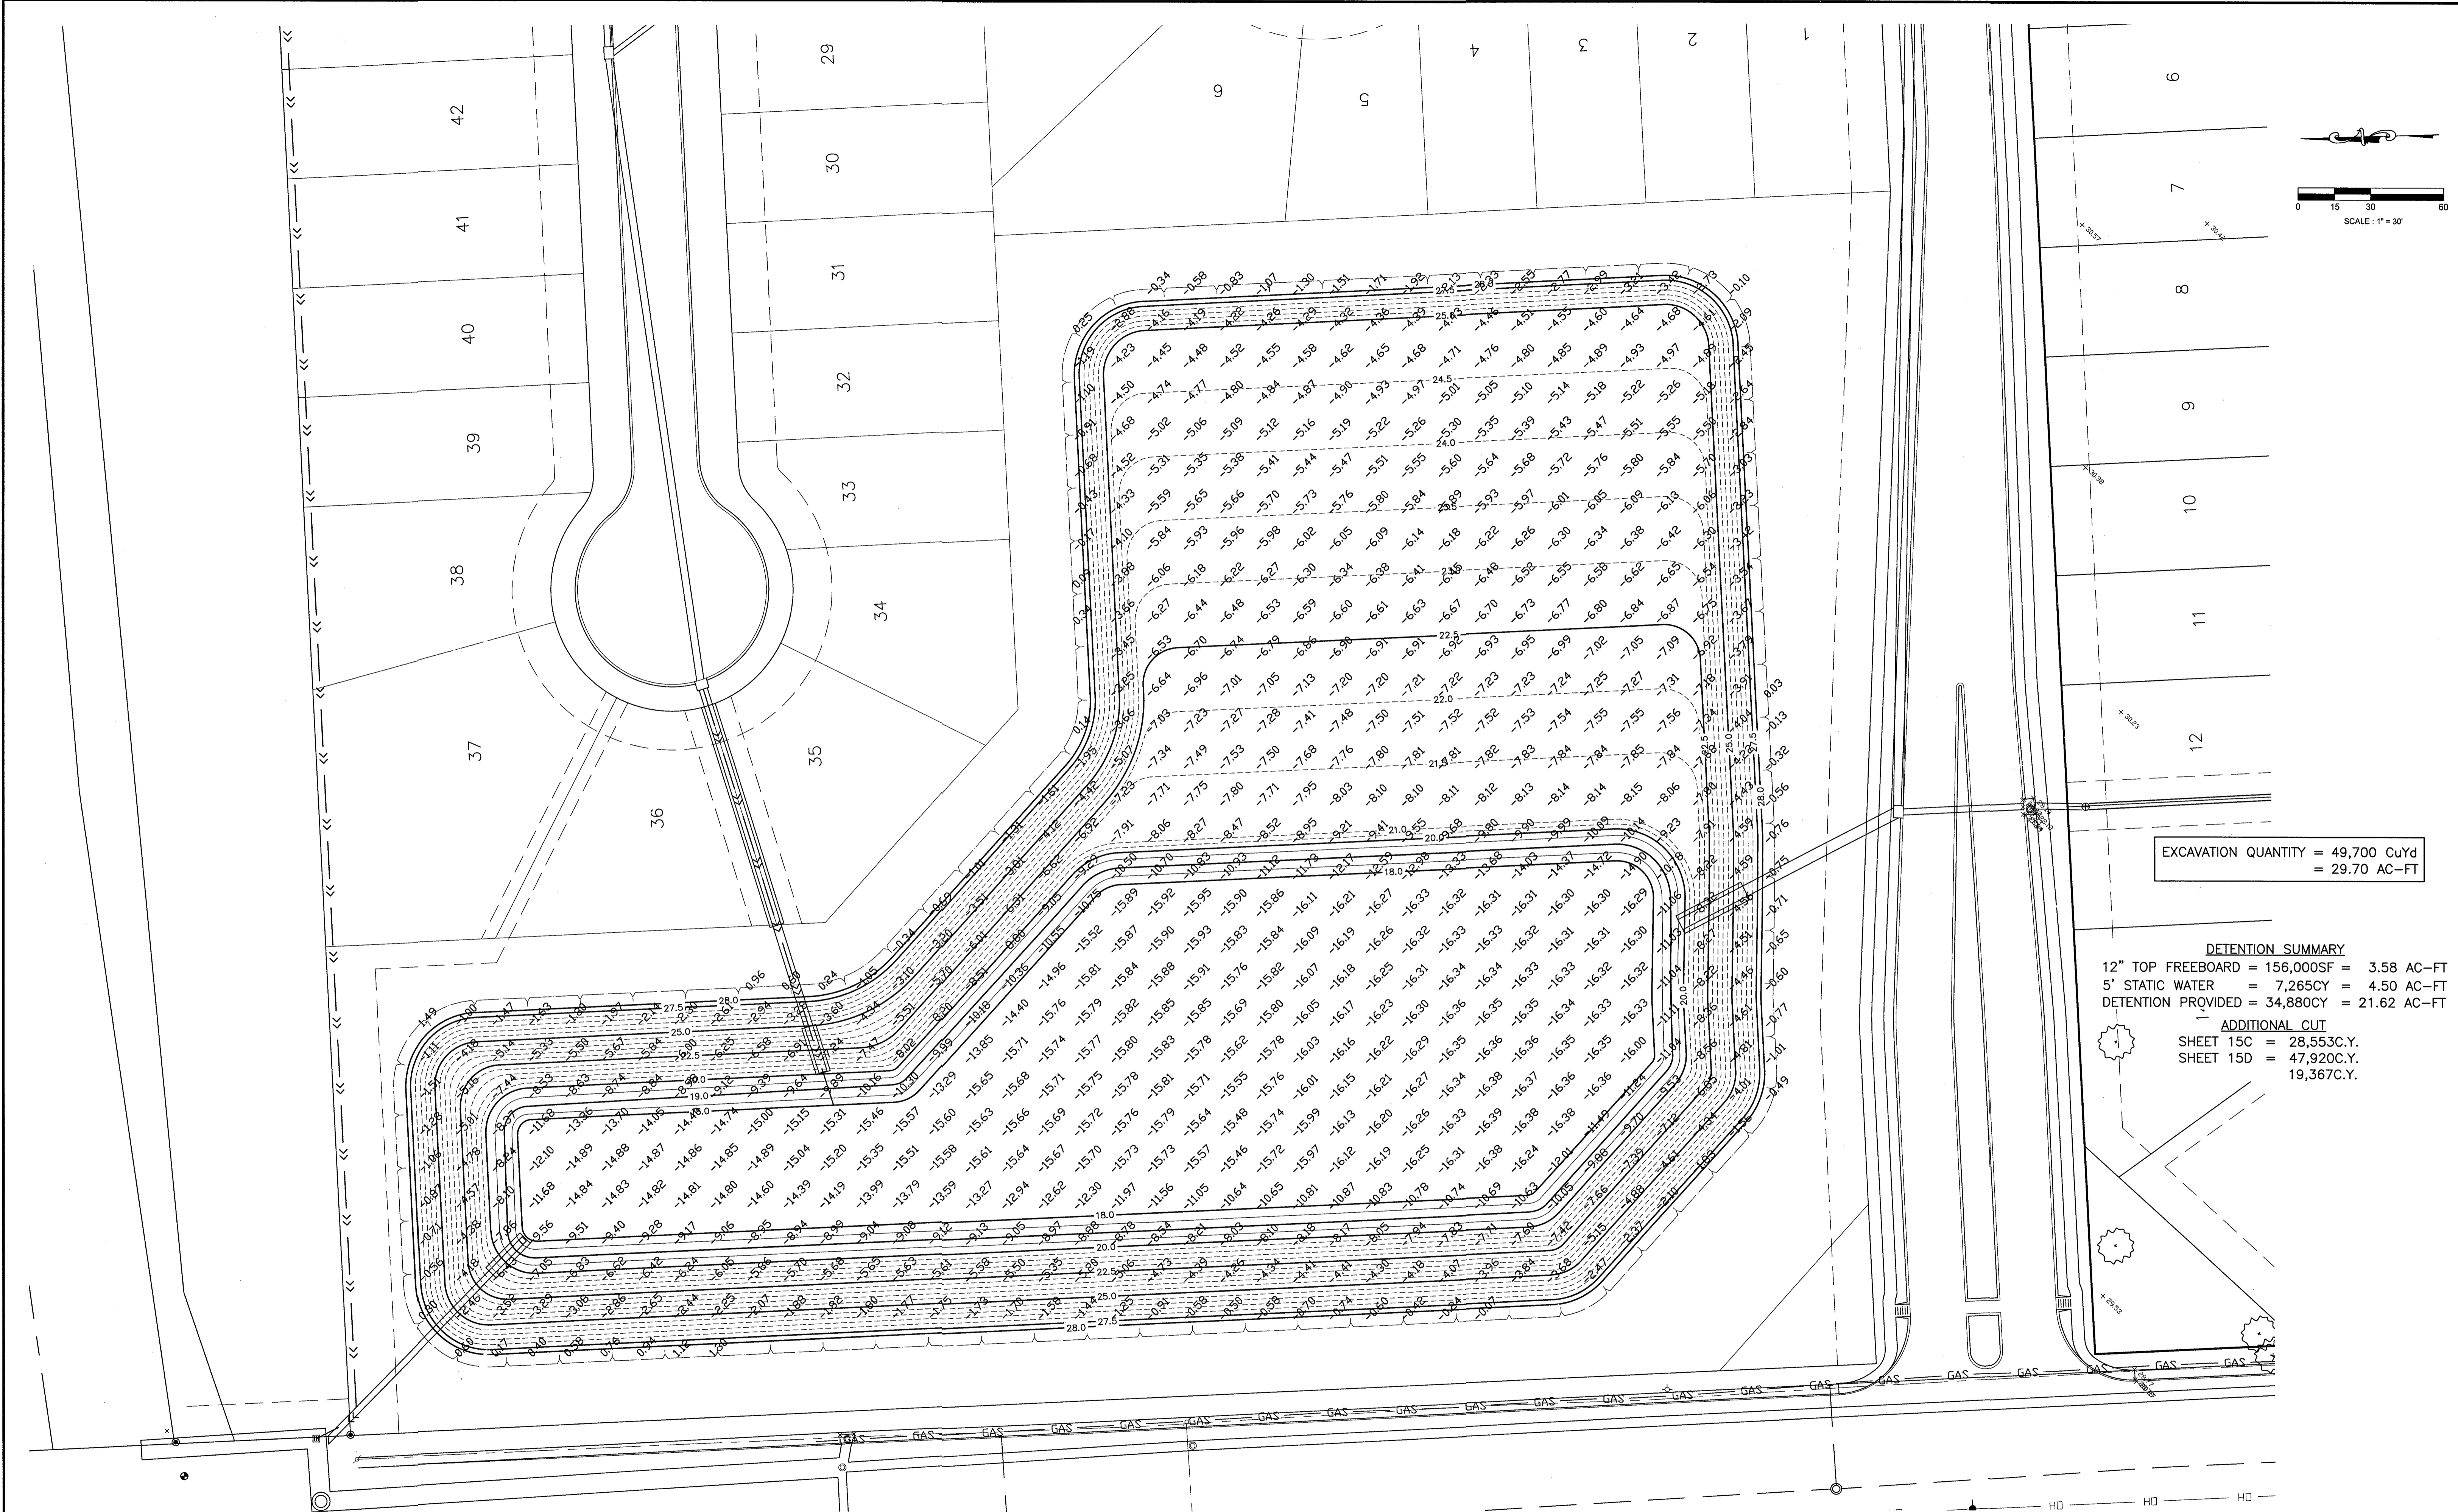

EXCAVATION QUANTITY = 49,700 CuYd
= 29.70 AC-FT


DETENTION SUMMARY
12" TOP FREEBOARD = 156,000SF = 3.58 AC-FT
5' STATIC WATER = 7,265CY = 4.50 AC-FT
DETENTION PROVIDED = 34,880CY = 21.62 AC-FT

ADDITIONAL CUT
SHEET 15C = 28,553C.Y.
SHEET 15D = 47,920C.Y.
19,367C.Y.

NO.	DATE	DESCRIPTION	APPROVED

DESIGNED DR
DRAWN BT
CHECKED
DATE

B & L
BAKER & LAWSON, INC.
ENGINEERS • PLANNERS • SURVEYORS
4005 TECHNOLOGY DRIVE, SUITE 1530
ANGLETON, TEXAS 77515 (979) 849-6681
REG. NO. F-825

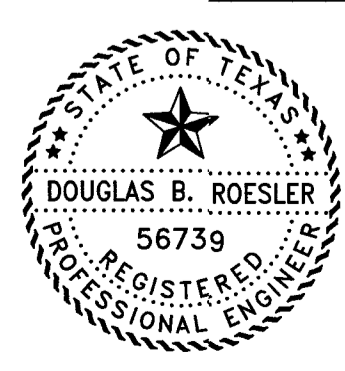

The seal appearing on this document was authorized by Douglas B. Roesler, P.E. 56739
Date: 04-18-02

OWNER:
RIVERWAY PROPERTIES
6115 SKYLINE DR. STE A.
HOUSTON, TEXAS 77057

PLAN: 1" = 30'
PROFILE:
HORIZONTAL:
VERTICAL:

RIVERWOOD RANCH SUBDIVISION
SECTION 2
A 78 AC, 109-LOT SUBDIVISION
ANGLETON, TEXAS 77515

RECORD DRAWING
SECTION 1 & 2
POND EXCAVATION
CALCULATION PLAN
PROJECT NO. 14395

ULTIMATE OUTFALL FOR RUNS A AND C IS TO BRUSHY BAYOU
2004 LOMR HAS A 100 YEAR WSEL = 24.00' AND 5 YEAR WSEL 23.00'

NOTE: FOR WINDSTORM RUN A-11 TO A-16

ADDED 43.32 CFS TO INLET A-16 FOR 5-YEAR RUN FROM C-1 TO C-11
ADDED 63.95 CFS TO INLET A-16 FOR 100-YEAR RUN FROM C-1 TO C-11

Winstorm (STORM DRAIN DESIGN) Version 3.05, Jan. 25, 2002
Run @ 8/6/2021 1:33:44 PM

PROJECT NAME : Riverwood Section2
JOB NUMBER : 14395
PROJECT DESCRIPTION : Inlets A-11 to A-16 5-Year
DESIGN FREQUENCY : 5 Years
ANALYSIS FREQUENCY : 100 Years
MEASUREMENT UNITS: ENGLISH

OUTPUT FOR DESIGN FREQUENCY of: 5 Years

Runoff Computation for Design Frequency.

ID	C Value	Area (acre)	Tc (min)	Tc Used (min)	Intensity (in/hr)	Supply Q (cfs)	Total Q (cfs)
A-11	0.55	2.44	15.00	15.00	5.66	0.000	7.592
A-12	0.55	1.35	15.00	15.00	5.66	0.000	4.200
A-13	0.55	1.24	15.00	15.00	5.66	0.000	3.892
A-14	0.55	2.28	15.00	15.00	5.66	0.000	7.094
A-15	0.55	0.31	15.00	15.00	5.66	0.000	0.965
A-16	0.55	1.04	15.00	15.00	5.66	0.000	3.236

Sag Inlets Configuration Data.

Inlet ID	Inlet Type	Inlet Length (ft)	Grate Perim. (sf)	Left-Slope Long Trans (ft)	Right-Slope Long Trans (ft)	Gutter n	Depth Depw (ft)	Allowed (ft)	Critic Elev. (ft)
A-11	Curb	8.00	n/a	0.50 2.00	0.50 2.00	0.014	1.50	0.50	31.00
A-12	Curb	4.00	n/a	0.50 2.00	0.50 2.00	0.014	1.50	0.50	31.00
A-13	Curb	4.00	n/a	0.50 2.00	0.50 2.00	0.014	1.50	0.50	31.00
A-14	Curb	7.00	n/a	0.50 2.00	0.50 2.00	0.014	1.50	0.50	31.00
A-15	Curb	2.00	n/a	0.50 2.00	0.50 2.00	0.014	1.50	0.50	29.40
A-16	Curb	3.00	n/a	0.50 2.00	0.50 2.00	0.014	1.50	0.50	29.40

Sag Inlets Computation Data.

Inlet ID	Inlet Type	Inlet Length (ft)	Grate Perim. Area (sf)	Grate Area (sf)	Total Q (cfs)	Inlet Capacity (cfs)	Head (ft)	Left Right (ft)	Ponded Width (ft)
A-11	Curb	8.00	n/a	n/a	7.592	8.701	0.457	12.85	12.85
A-12	Curb	4.00	n/a	n/a	4.200	5.448	0.420	10.30	10.30
A-13	Curb	4.00	n/a	n/a	3.858	5.448	0.397	10.00	10.00
A-14	Curb	7.00	n/a	n/a	7.094	7.888	0.466	12.55	12.55
A-15	Curb	2.00	n/a	n/a	0.965	3.822	0.200	5.95	5.95
A-16	Curb	3.00	n/a	n/a	3.236	4.635	0.393	9.35	9.35

Cumulative Junction Discharge Computations

I.D.	Node	Type	C-Value	Dr.Area (acres)	Tc (min)	Cumulat. Intens. (in/hr)	user Supply Q (cfs)	Additional Q in Node (cfs)	Total Disch. (cfs)
A-11	Curb	0.550	2.44	15.00	5.66	0.000	0.00	7.592	7.592
A-12	Curb	0.550	3.79	15.12	5.64	0.000	0.00	11.758	11.758
A-13	Curb	0.550	5.03	15.92	5.53	0.000	0.00	15.308	15.308
A-14	Curb	0.550	7.31	16.01	5.52	0.000	0.00	22.204	22.204
A-15	Curb	0.550	7.62	16.33	5.48	0.000	0.00	22.968	22.968
A-16	Curb	0.550	8.66	16.48	5.46	0.000	42.32	68.332	68.332
OUT	outlet	0.550	8.66	16.48	5.46	0.000	42.32	68.332	68.332

Conveyance Configuration Data

Run#	Node I.D.	US	DS	Flowline Elev. (ft)	Shape #	Span (ft)	Rise (ft)	Length (ft)	Slope (%)	n_value
13	A-11	A-12	24.31	24.22	Circ 1	0.00	2.00	30.00	0.30	0.013
14	A-12	A-13	24.22	23.23	Circ 1	0.00	2.50	248.00	0.40	0.013
15	A-13	A-14	23.23	23.08	Circ 1	0.00	2.50	30.00	0.50	0.013
16	A-14	A-15	23.08	22.41	Circ 1	0.00	2.50	130.00	0.52	0.013
17	A-15	A-16	22.41	22.24	Circ 1	0.00	2.50	50.00	0.34	0.013
18	A-16	OUT	20.72	20.06	Circ 1	0.00	4.50	130.00	0.51	0.013

Conveyance Hydraulic Computations. Tailwater = 23.000 (ft)

Run#	US Elev (ft)	DS Elev (ft)	Fr.Slope (%)	unif. (ft)	Actual (ft)	Depth (ft)	Velocity (f/s)	Q (cfs)	Cap (cfs)	Junc Loss (ft)
13	25.47	25.40	0.113	1.13	1.18	4.17	3.93	7.59	12.39	0.000
14	25.40	24.71	0.082	1.18	1.48	5.15	3.90	11.76	25.92	0.000
15*	24.71	24.70	0.139	1.29	1.62	6.00	4.54	15.31	29.01	0.000
16	24.70	24.36	0.293	1.62	1.95	6.59	5.40	22.20	29.45	0.000
17	24.36	23.87	0.313	1.95	1.95	5.58	5.58	22.97	23.92	0.000
18*	23.16	23.00	0.121	2.21	2.94	8.77	6.21	68.33	140.14	0.000

* Super critical flow.

NORMAL TERMINATION OF WINSTORM.

Winstorm (STORM DRAIN DESIGN) Version 3.05, Jan. 25, 2002
Run @ 8/6/2021 1:34:46 PM

PROJECT NAME : Riverwood Section2untitled
JOB NUMBER : 14395
PROJECT DESCRIPTION : Inlets A-11 to A-16 100-Yr
DESIGN FREQUENCY : 5 Years
ANALYSIS FREQUENCY : 100 Years
MEASUREMENT UNITS: ENGLISH

OUTPUT FOR ANALYSIS FREQUENCY of: 100 Years

Runoff Computation for Analysis Frequency.

ID	C Value	Area (acre)	Tc (min)	Tc Used (min)	Intensity (in/hr)	Supply Q (cfs)	Total Q (cfs)
A-11	0.65	2.44	15.00	15.00	8.39	0.000	13.314
A-12	0.65	1.35	15.00	15.00	8.39	0.000	7.366
A-13	0.65	1.24	15.00	15.00	8.39	0.000	6.766
A-14	0.65	2.28	15.00	15.00	8.39	0.000	12.441
A-15	0.65	0.31	15.00	15.00	8.39	0.000	1.692
A-16	0.65	1.04	15.00	15.00	8.39	0.000	5.675

Sag Inlets Configuration Data.

Inlet ID	Inlet Type	Length/Perim. (ft)	Grate Area (sf)	Left-Slope Long Trans (ft)	Right-Slope Long Trans (ft)	Gutter n	Depth Allowed (ft)	Critical Elev. (ft)
A-11	Curb	15.00	n/a	0.50 2.00	0.50 2.00	0.014 1.50	0.50	31.00
A-12	Curb	7.00	n/a	0.50 2.00	0.50 2.00	0.014 1.50	0.50	31.00
A-13	Curb	7.00	n/a	0.50 2.00	0.50 2.00	0.014 1.50	0.50	31.00
A-14	Curb	14.00	n/a	0.50 2.00	0.50 2.00	0.014 1.50	0.50	31.00
A-15	Curb	2.00	n/a	0.50 2.00	0.50 2.00	0.014 1.50	0.50	29.40
A-16	Curb	5.00	n/a	0.50 2.00	0.50 2.00	0.014 1.50	0.50	29.40

Sag Inlets Computation Data.

Inlet ID	Inlet Type	Inlet Length (ft)	Grate Perim. Area (sf)	Grate Area (sf)	Total Q (cfs)	Inlet Capacity (cfs)	Head (ft)	Left Right (ft)	Ponded Width (ft)
A-11	Curb	15.00	n/a	n/a	13.314	14.393	0.475	15.90	15.90
A-12	Curb	7.00	n/a	n/a	7.366	7.888	0.478	12.75	12.75
A-13	Curb	7.00	n/a	n/a	6.766	7.888	0.451	12.35	12.35
A-14	Curb	14.00	n/a	n/a	12.441	13.580	0.472	15.50	15.50
A-15	Curb	2.00	n/a	n/a	1.692	3.822	0.290	7.35	7.35
A-16	Curb	5.00	n/a	n/a	5.675	6.261	0.468	11.55	11.55

Cumulative Junction Discharge Computations

I.D.	Node	Type	C-Value	Dr.Area (acres)	Tc (min)	Cumulat. Intens. (in/hr)	user Supply Q (cfs)	Additional Q in Node (cfs)	Total Disch. (cfs)
A-11	Curb	0.650	2.44	15.00	8.39	0.000	0.00	20.632	20.632
A-12	Curb	0.650	3.79	15.11	8.38	0.000	0.00	26.998	26.998
A-13	Curb	0.650	5.03	15.82	8.26	0.000	0.00	39.177	39.177
A-14	Curb	0.650	7.31	15.89	8.25	0.000	0.00	40.610	40.610
A-15	Curb	0.650	7.62	16.17	8.20	0.000	63.95	110.041	110.041
A-16	Curb	0.650	8.66	16.24	8.19	0.000	63.95	110.041	110.041
OUT	outlet	0.650	8.66	16.24	8.19	0.000	63.95	110.041	110.041

Conveyance Configuration Data

Run#	Node I.D.	US	DS	Flowline Elev. (ft)	Shape #	Span (ft)	Rise (ft)	Length (ft)	Slope (%)	n_value
13	A-11	A-12	24.31	24.22	Circ 1	0.00	2.00	30.00	0.30	0.013
14	A-12	A-13	24.22	23.23	Circ 1	0.00	2.50	248.00	0.40	0.013
15	A-13	A-14	23.23	23.08	Circ 1	0.00	2.50	30.00	0.50	0.013
16	A-14	A-15	23.08	22.41	Circ 1	0.00	2.50	135.00	0.50	0.013
17	A-15	A-16	22.41	22.24	Circ 1	0.00	2.50	34.00	0.50	0.013
18	A-16	OUT	20.72	20.46	Circ 1	0.00	4.50	130.00	0.20	0.013

Conveyance Hydraulic Computations. Tailwater = 24.000 (ft)

Run#	US Elev (ft)	DS Elev (ft)	Fr.Slope (%)	unif. (ft)	Actual (ft)	Depth (ft)	Velocity (f/s)	Q (cfs)	Cap (cfs)	Junc Loss (ft)
13	27.79	27.69	0.346	1.88	2.00	4.35	4.24	13.31	12.39	0.000
14	27.69	27.06	0.253	1.68	2.50	5.88	4.20	20.63	25.92	0.000
15	27.06	26.93	0.433	1.91	2.50	6.69	5.50	27.00	29.01	0.000
16	26.93	25.70	0.912	2.50	2.50	7.98	7.98	39.18	28.90	0.000
17	25.70	25.37	0.980	2.50	2.50	8.27	8.27	40.61	29.01	0.000
18	25.37	24.96	0.313	4.50	4.50	6.92	6.92	110.04	87.96	0.000

NORMAL TERMINATION OF WINSTORM.

ULTIMATE OUTFALL FOR RUN B IS TO HOSPITAL DRIVE OUTFALL CHANNEL
HOSPITAL DRIVE H & H HAS A 100 YEAR WSEL = 27.50' AND 5 YEAR WSEL 27.00' +/-

Winstorm (STORM DRAIN DESIGN) Version 3.05, Jan. 25, 2002
Run @ 8/6/2021 1:24:00 PM

PROJECT NAME : Riverwood Section 2
JOB NUMBER : 14395
PROJECT DESCRIPTION : Inlets I-1 to I-5 Drain to Hospital 5-Year
DESIGN FREQUENCY : 5 Years
ANALYSIS FREQUENCY : 100 Years
MEASUREMENT UNITS: ENGLISH

OUTPUT FOR DESIGN FREQUENCY of: 5 Years

Runoff Computation for Design Frequency.

ID	C value	Area (acre)	Tc (min)	Tc Used (min)	Intensity (in/hr)	Supply Q (cfs)	Total Q (cfs)
B-1	0.55	0.85	15.00	15.00	5.66	0.000	2.645
B-2	0.55	1.22	15.00	15.00	5.66	0.000	3.796
B-3	0.55	1.10	15.00	15.00	5.66	0.000	3.423
B-4	0.55	1.34	15.00	15.00	5.66	0.000	4.169
B-5	0.55	1.76	15.00	15.00	5.66	0.000	5.476

Sag Inlets Configuration Data.

Inlet ID	Inlet Type	Length/Perim. (ft)	Grate Area (sf)	Left-Slope Long Trans (%)	Right-Slope Long Trans (%)	Gutter n	Depth Allowed (ft)	Critic Elev. (ft)
B-1	Curb	3.00	n/a	0.50 2.00	0.50 2.00	0.014 1.50	0.50	28.39
B-2	Curb	4.00	n/a	0.50 2.00	0.50 2.00	0.014 1.50	0.50	28.26
B-3	Curb	4.00	n/a	0.50 2.00	0.50 2.00	0.014 1.50	0.50	28.39
B-4	Curb	4.00	n/a	0.50 2.00	0.50 2.00	0.014 1.50	0.50	28.38
B-5	Curb	5.00	n/a	0.50 2.00	0.50 2.00	0.014 1.50	0.50	28.38

Sag Inlets Computation Data.

Inlet ID	Inlet Type	Inlet Length (ft)	Grate Perim. Area (sf)	Grate Area (sf)	Total Q (cfs)	Inlet Capacity (cfs)	Head (ft)	Left Right (ft)	Ponded Width (ft)
B-1	Curb	3.00	n/a	n/a	2.645	4.635	0.344	8.65	8.65
B-2	Curb	4.00	n/a	n/a	3.796	5.448	0.393	9.95	9.95
B-3	Curb	4.00	n/a	n/a	3.423	5.448	0.367	9.55	9.55
B-4	Curb	4.00	n/a	n/a	4.169	5.448	0.418	10.30	10.30
B-5	Curb	5.00	n/a	n/a	5.476	6.261	0.457	11.40	11.40

Cumulative Junction Discharge Computations

I.D.	Node	Type	Weight	C-Value	Dr. Area (acres)	Cumulat. Tc (min)	Cumulat. Intens. (in/hr)	User Supply (cfs)	Additional Q in Node (cfs)	Total Disch. (cfs)
B-1	curb		0.550		0.85	15.00	5.66	0.000	0.00	2.645
B-2	curb		0.550		1.22	15.00	5.66	0.000	0.00	3.796
B-3	curb		0.550		3.17	15.52	5.59	0.000	0.00	9.740
B-4	curb		0.550		6.27	16.43	5.47	0.000	0.00	18.855
B-4	curb		0.550		1.34	15.00	5.66	0.000	0.00	4.169
B-5	curb		0.550		3.10	15.15	5.64	0.000	0.00	9.610
M4	crtrch		0.550		6.27	16.43	5.47	0.000	0.00	18.855
M4	crtrch		0.550		6.27	16.43	5.47	0.000	0.00	18.855
OUT	outlet		0.550		6.27	16.43	5.47	0.000	0.00	18.855

ULTIMATE OUTFALL FOR RUNS A AND C IS TO BRUSHY BAYOU
2004 LOMR HAS A 100 YEAR WSEL = 24.00' AND 5 YEAR WSEL 23.00'

Winstorm (STORM DRAIN DESIGN)

Version 3.05, Jan. 25, 2002
Run @ 8/6/2021 1:15:53 PM

PROJECT NAME : Riverwood Section 2untitled
JOB NUMBER : 14395
PROJECT DESCRIPTION : Original Run from Riverwood Section1 - 5 Year
DESIGN FREQUENCY : 5 Years
ANALYSYS FREQUENCY : 100 Years
MEASUREMENT UNITS: ENGLISH

OUTPUT FOR DESIGN FREQUENCY of: 5 Years

Runoff Computation for Design Frequency.

ID	C Value	Area (acre)	Tc (min)	Tc Used (min)	Intensity (in/hr)	Supply Q (cfs)	Total Q (cfs)
C-1	0.55	1.48	15.00	15.00	5.66	0.000	4.605
C-2	0.55	1.84	15.00	15.00	5.66	0.000	5.725
C-3	0.55	0.74	15.00	15.00	5.66	0.000	2.302
C-4	0.55	2.33	15.00	15.00	5.66	0.000	7.250
C-5	0.55	1.67	15.00	15.00	5.66	0.000	5.196
C-6	0.55	1.13	15.00	15.00	5.66	0.000	3.516
C-7	0.55	1.10	15.00	15.00	5.66	0.000	3.423
C-8	0.55	1.19	15.00	15.00	5.66	0.000	3.703
C-9	0.55	0.24	15.00	15.00	5.66	0.000	0.747
C-10	0.55	1.47	15.00	15.00	5.66	0.000	4.574
C-11	0.55	1.23	15.00	15.00	5.66	0.000	3.827

Sag Inlets Configuration Data.

Inlet ID	Inlet Type	Inlet Length/Perim. (ft)	Grate Area (sf)	Left-Slope Long Trans (ft)	Right-Slope Long Trans (ft)	Gutter n	Depth Depn (ft)	Allowed (ft)	Critic Elev. (ft)
C-1	Curb	4.00	n/a	0.50 2.00	0.50 2.00	0.014 1.50	0.50	28.80	
C-2	Curb	5.00	n/a	0.50 2.00	0.50 2.00	0.014 1.50	0.50	28.80	
C-3	Curb	3.00	n/a	0.50 2.00	0.50 2.00	0.014 1.50	0.50	30.00	
C-4	Curb	7.00	n/a	0.50 2.00	0.50 2.00	0.014 1.50	0.50	28.75	
C-5	Curb	5.00	n/a	0.50 2.00	0.50 2.00	0.014 1.50	0.50	29.00	
C-6	Curb	4.00	n/a	0.50 2.00	0.50 2.00	0.014 1.50	0.50	29.00	
C-7	Curb	4.00	n/a	0.50 2.00	0.50 2.00	0.014 1.50	0.50	30.10	
C-8	Curb	4.00	n/a	0.50 2.00	0.50 2.00	0.014 1.50	0.50	30.10	
C-9	Curb	2.00	n/a	0.50 2.00	0.50 2.00	0.014 1.50	0.50	29.90	
C-10	Curb	4.00	n/a	0.50 2.00	0.50 2.00	0.014 1.50	0.50	29.50	
C-11	Curb	4.00	n/a	0.50 2.00	0.50 2.00	0.014 1.50	0.50	29.50	

Sag Inlets Computation Data.

Inlet ID	Inlet Type	Inlet Length (ft)	Perim Area (sf)	Grate Area (sf)	Total Q (cfs)	Inlet Capacity (cfs)	Inlet Head (ft)	Ponded width Left (ft)	Ponded width Right (ft)
C-1	Curb	4.00	n/a	n/a	4.605	5.448	0.447	10.65	10.65
C-2	Curb	5.00	n/a	n/a	5.725	6.261	0.471	11.60	11.60
C-3	Curb	3.00	n/a	n/a	2.302	4.635	0.314	8.25	8.25
C-4	Curb	7.00	n/a	n/a	7.250	7.888	0.473	12.65	12.65
C-5	Curb	5.00	n/a	n/a	5.196	6.261	0.442	11.15	11.15
C-6	Curb	4.00	n/a	n/a	3.516	5.448	0.373	9.65	9.65
C-7	Curb	4.00	n/a	n/a	3.423	5.448	0.367	9.55	9.55
C-8	Curb	4.00	n/a	n/a	3.703	5.448	0.386	9.85	9.85
C-9	Curb	2.00	n/a	n/a	0.747	3.822	0.168	5.40	5.40
C-10	Curb	4.00	n/a	n/a	4.574	5.448	0.445	10.65	10.65
C-11	Curb	4.00	n/a	n/a	3.827	5.448	0.395	9.95	9.95

Cumulative Junction Discharge Computations

Node I.D.	Node Type	Node C-value	Node Weighted Dr. Area (acres)	Cumulat. Tc (min)	Cumulat. Intensity (in/hr)	Cumulat. Supply Q (cfs)	Cumulat. Intensity (in/hr)	User Supply Q (cfs)	Additional Q in Node (cfs)	Total Disch. (cfs)
C-1	Curb	0.550	1.48	15.00	5.66	0.000	0.00	0.00	4.605	4.605
C-2	Curb	0.550	3.32	15.07	5.65	0.000	0.00	0.00	10.313	10.313
C-3	Curb	0.550	4.06	15.86	5.54	0.000	0.00	0.00	12.374	12.374
C-4	Curb	0.550	2.33	15.00	5.66	0.000	0.00	0.00	7.250	7.250
C-5	Curb	0.550	1.67	15.00	5.66	0.000	0.00	0.00	5.196	5.196
C-6	Curb	0.550	5.13	15.22	5.63	0.000	0.00	0.00	15.875	15.875
C-7	Curb	0.550	10.29	15.97	5.53	0.000	0.00	0.00	31.280	31.280
C-8	Curb	0.550	11.48	16.21	5.50	0.000	0.00	0.00	34.700	34.700
JB-1	CircWh	0.550	11.48	16.21	5.50	0.000	0.00	0.00	34.700	34.700
JB-2	Junct	0.550	14.42	17.50	5.34	0.000	0.00	0.00	42.320	42.320
C-9	Curb	0.550	0.24	15.00	5.66	0.000	0.00	0.00	0.747	0.747
C-10	Curb	0.550	1.47	15.00	5.66	0.000	0.00	0.00	4.574	4.574
C-11	Curb	0.550	2.70	15.15	5.64	0.000	0.00	0.00	8.370	8.370
OUT	outlet	0.550	14.42	17.50	5.34	0.000	0.00	0.00	42.320	42.320

Conveyance Configuration Data

Run#	Node I.D.	Flowline Elev.		Shape	#	Span (ft)	Rise (ft)	Length (ft)	Slope (%)	n-value	
		US (ft)	DS (ft)								
1	C-1	C-2	25.00	24.44	circ	1	0.00	1.50	30.00	1.87	0.013
2	C-2	C-3	24.44	23.18	circ	1	0.00	2.50	255.00	0.49	0.013
3	C-3	C-7	23.18	23.04	circ	1	0.00	2.50	35.00	0.40	0.013
4	C-4	C-6	23.72	23.60	circ	1	0.00	2.00	50.00	0.24	0.013
5	C-5	C-9	23.66	23.60	circ	1	0.00	2.00	29.00	0.21	0.013
6	C-6	C-7	23.60	23.04	circ	1	0.00	3.00	200.00	0.28	0.013
7	C-7	C-8	23.04	22.83	circ	1	0.00	3.00	80.00	0.26	0.013
8	C-8	JB-1	22.83	22.46	circ	1	0.00	3.00	140.00	0.26	0.013
9	JB-1	JB-2	22.46	21.74	circ	1	0.00	3.00	280.00	0.26	0.013
10	C-9	C-10	25.00	24.94	circ	1	0.00	1.50	29.00	0.21	0.013
11	C-10	C-11	25.00	24.94	circ	1	0.00	2.00	29.00	0.21	0.013
12	C-11	JB-2	24.94	24.88	circ	1	0.00	2.00	20.00	0.30	0.013
13	JB-2	OUT	21.74	20.72	circ	1	0.00	4.00	378.00	0.27	0.013

Conveyance Hydraulic Computations. Tailwater = 23.000 (ft)

Run#	Hydraulic Grade Line			Depth		Velocity			Cap	Junc Loss
	US Elev (ft)	DS Elev (ft)	Fr.Slope (%)	Unif. (ft)	Actual (ft)	Unif. (f/s)	Actual (f/s)	Q (cfs)		
1*	25.76	25.70	0.192	0.58	1.26	7.23	2.91	4.60	14.35	0.000
2*	25.70	25.54	0.063	1.04	2.36	5.37	2.15	10.31	28.84	0.000
3	25.54	25.52	0.091	1.21	2.48	5.25	2.52	12.37	25.95	0.000
4	25.65	25.60	0.103	1.19	2.00	7.73	2.31	7.25	11.08	0.000
5	25.60	25.52	0.053	1.00	2.00	3.31	1.65	5.20	10.29	0.000
6	25.60	25.52	0.057	1.41	2.48	4.88	2.54	15.88	35.30	0.000
7	25.52	25.36	0.220	2.25	2.53	5.50	4.92	31.28	34.18	0.000
8	25.36	24.98	0.271	2.53	2.53	5.45	5.45	34.70	34.29	0.000
9	24.99	23.90	0.271	2.53	2.53	5.45	5.45	34.70	33.83	0.000
10	25.40	25.26	0.005	0.40	0.40	1.98	1.98	0.75	4.78	0.000
11	26.16	26.14	0.041	0.94	1.20	3.16	2.32	4.57	10.29	0.000
12	26.14	25.91	0.137	1.20	1.20	4.24	4.24	8.37	12.39	0.000
13	23.90	23.00	0.087	2.16	2.28	6.13	5.72	32	74.63	0.000

* Super critical flow.

NORMAL TERMINATION OF WINSTORM.

Winstorm (STORM DRAIN DESIGN)

Version 3.05, Jan. 25, 2002
Run @ 8/6/2021 1:13:45 PM

PROJECT NAME : Riverwood Section 2untitled
JOB NUMBER : 14395
PROJECT DESCRIPTION : Original Run from Riverwood Section1 - 100 Year
DESIGN FREQUENCY : 5 Years
ANALYSYS FREQUENCY : 100 Years
MEASUREMENT UNITS: ENGLISH

OUTPUT FOR ANALYSYS FREQUENCY of: 100 Years

Runoff Computation for Analysis Frequency.

ID	C Value	Area (acre)	Tc (min)	Tc Used (min)	Intensity (in/hr)	Supply Q (cfs)	Total Q (cfs)
C-1	0.55	1.48	15.00	15.00	8.39	0.000	6.833
C-2	0.55	1.84	15.00	15.00	8.39	0.000	8.496
C-3	0.55	0.74	15.00	15.00	8.39	0.000	3.417
C-4	0.55	2.33	15.00	15.00	8.39	0.000	10.758
C-5	0.55	1.67	15.00	15.00	8.39	0.000	7.711
C-6	0.55	1.13	15.00	15.00	8.39	0.000	5.217
C-7	0.55	1.10	15.00	15.00	8.39	0.000	5.079
C-8	0.55	1.19	15.00	15.00	8.39	0.000	5.494
C-9	0.55	0.24	15.00	15.00	8.39	0.000	1.108
C-10	0.55	1.47	15.00	15.00	8.39	0.000	6.787
C-11	0.55	1.23	15.00	15.00	8.39	0.000	5.679

Sag Inlets Configuration Data.


Inlet ID	Inlet Type	Inlet Length/Perim. (ft)	Grate Area (sf)	Left-Slope Long Trans (ft)	Right-Slope Long Trans (ft)	Gutter n	Depth Depn (ft)	Allowed (ft)	Critic Elev. (ft)
C-1	Curb	7.00	n/a	0.50	2.00	0.014	1.50	0.50	28.80
C-2	Curb	9.00	n/a	0.50	2.00	0.014	1.50	0.50	28.80
C-3	Curb	4.00	n/a	0.50	2.00	0.014	1.50	0.50	30.00
C-4	Curb	12.00	n/a	0.50	2.00	0.014	1.50	0.50	28.75
C-5	Curb	8.00	n/a	0.50	2.00	0.014	1.50	0.50	29.00
C-6	Curb	5.00	n/a	0.50	2.00	0.014	1.50	0.50	29.00
C-7	Curb	5.00	n/a	0.50	2.00	0.014	1.50	0.50	30.10
C-8	Curb	5.00	n/a	0.50	2.00	0.014	1.50	0.50	30.10
C-9	Curb	2.00	n/a	0.50	2.00	0.014	1.50	0.50	29.90
C-10	Curb	7.00	n/a	0.50	2.00	0.014	1.50	0.50	29.50
C-11	Curb	5.00	n/a	0.50	2.00	0.014	1.50	0.50	29.50

Sag Inlets Computation Data.

Inlet ID	Inlet Type	Inlet Length (ft)	Perim Area (sf)	Grate Area (sf)	Total Q (cfs)	Inlet Capacity (cfs)	Inlet Head (ft)	Ponded width Left (ft)	Ponded width Right (ft)
C-1	Curb	7.00	n/a	n/a	6.833	7.888	0.454	12.40	12.40
C-2	Curb	9.00	n/a	n/a	8.496	9.514	0.464	13.45	13.45
C-3	Curb	4.00	n/a	n/a	3.417	5.448	0.366	9.55	9.55
C-4	Curb	12.00	n/a	n/a	10.758	11.954	0.466	14.65	14.65
C-5	Curb	8.00	n/a	n/a	7.711	8.701	0.461	12.95	12.95
C-6	Curb	5.00	n/a	n/a	5.217	6.261	0.443	11.20	11.20
C-7	Curb	5.00	n/a	n/a	5.079	6.261	0.435	11.05	11.05
C-8	Curb	5.00	n/a	n/a	5.494	6.261	0.458	11.40	11.40
C-9	Curb	2.00	n/a	n/a	1.108	3.822	0.239	6.25	6.25
C-10	Curb	7.00	n/a	n/a	6.787	7.888	0.452	12.35	12.35
C-11	Curb	5.00	n/a	n/a	5.679	6.261	0.468	11.55	11.55

Cumulative Junction Discharge Computations

</

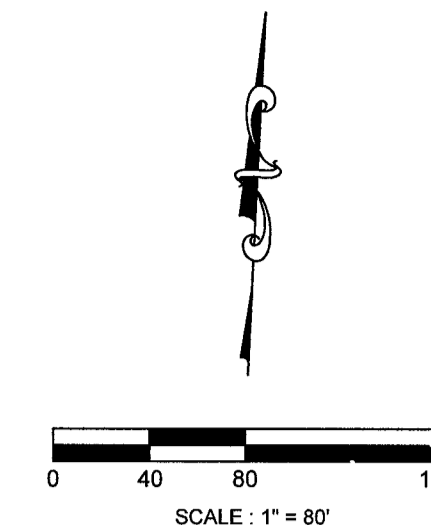


1. SECURELY ATTACH STREET NAME SIGN TO TRAFFIC SIGNAL SUPPORT WIRES WITH MULTI-LEVELING, WIND DUMPING BRACKETS.
2. SUPPORT WIRES SHOULD NOT BE PROHIBITED FROM INDEPENDENT MOVEMENT.
3. INSTALL ONE STREET NAME SIGN APPROXIMATE 2' FROM POLE ABOVE ON-COMING TRAFFIC ON EACH TRAFFIC SIGNAL SPAN.
4. THE FIRST LETTER OF EACH WORD SHALL BE UPPER CASE, SUBSEQUENT LETTERS SHALL BE LOWER CASE, ALL INDIVIDUAL LETTERS SHOULD EXCEED 1/2" IN HEIGHT. ALL LETTERS SHALL BE STRUTTED & "NO OUTLET" SHALL BE UPPER CASE.
5. ALL SHEETING SHALL BE "DIAMOND GRADE" OR APPROVED EQUIV.
6. USE ANODIZED BLANKS ONLY.
7. STREET SIGN FONTS SHALL BE HELVETICA REG, MEDIUM SIZE.
8. MINIMUM SIGN THICKNESS: 2" SIGNS = .082", 14" SIGNS = .1875"

NOTES:


1. HELVETICA BOLD, MEDIUM STYLE; WITH 9" UPPER CASE LETTERS AND 6" LOWER CASE LETTERS.
2. REFER TO C.O.S.L. DESIGN STANDARDS FOR MORE INFO.

SI-ST-67

Wedge Anchor System

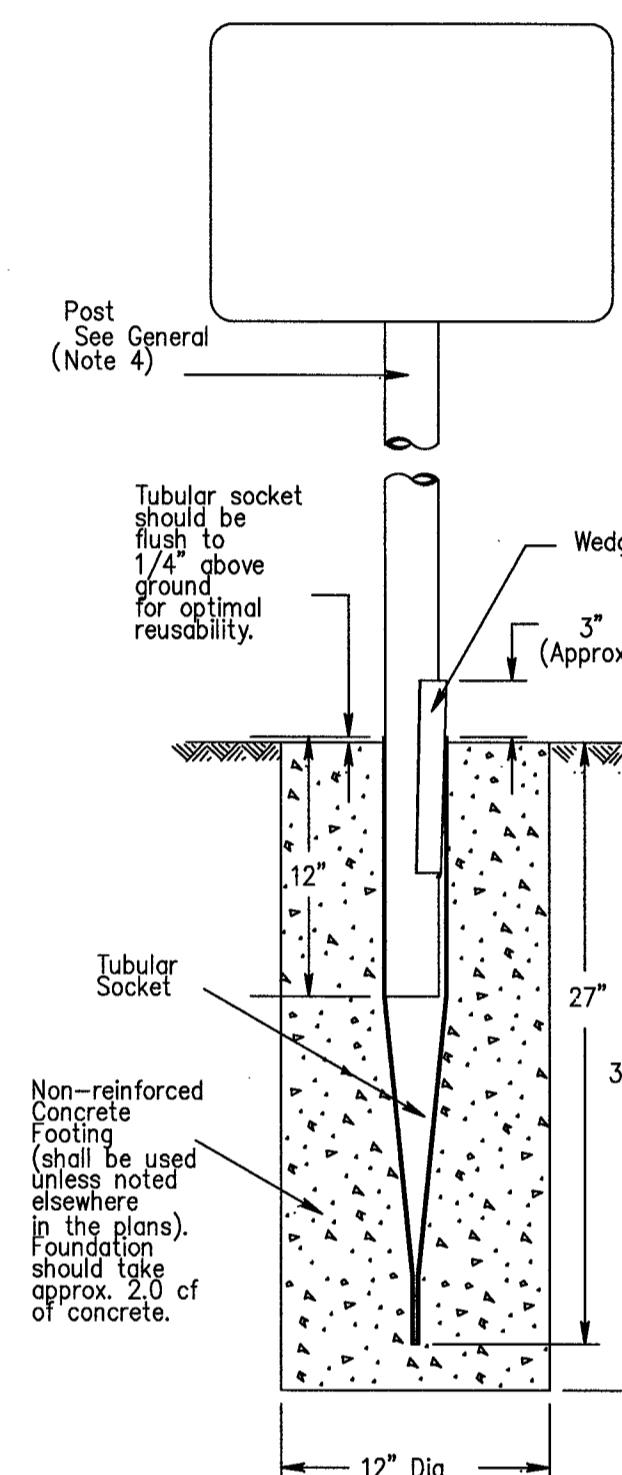


SL-ST-68

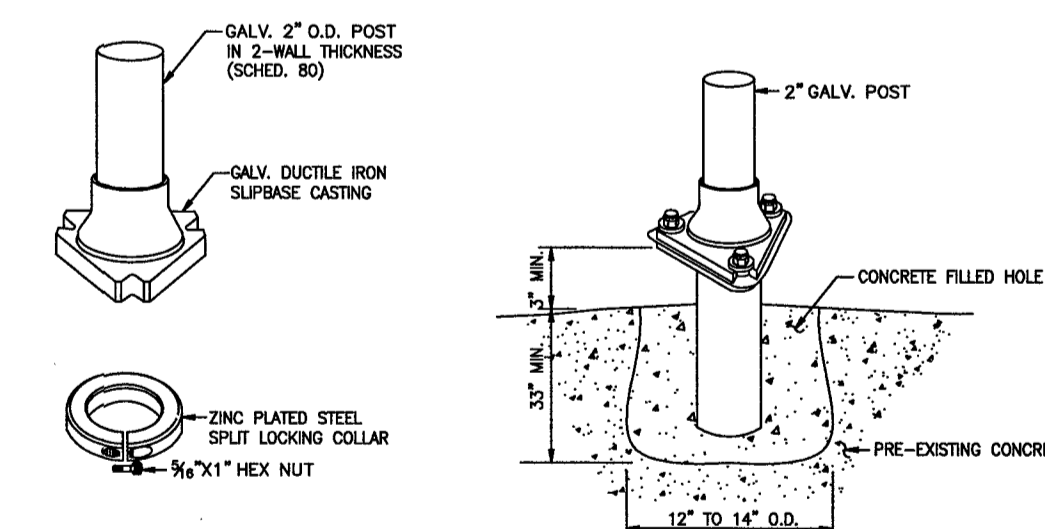

CONCRETE SIGN PEDESTAL SL-ST-65

NOTES:

- 1.) FILL HOLE TO GROUND LEVEL.
- 2.) PRESS BASE INTO CENTER OF CONCRETE.
- 3.) LEVEL BASE 3" ABOVE GROUND.
- 4.) TIGHTEN (TORQUE) NUTS BETWEEN 60 TO 80 FT/LB MAX.

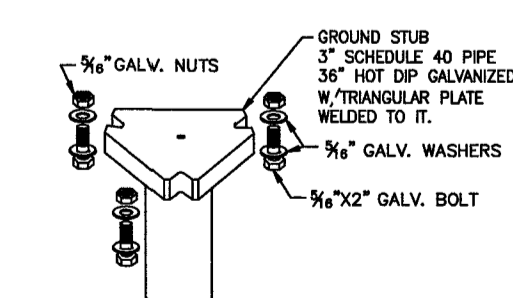

POZ-LOCK SLIPBASE SYSTEM

SI-ST-64

- ① STOP - FACING BENNETT LOOP
BENNETT STREET / CULLEN STREET
- ② STOP - FACING CULLEN STREET
CULLEN STREET / BENNETT LOOP
- ③ STOP - FACING BENNETT STREET
BENNETT STREET / AMY STREET
- ④ STOP - FACING HOSPITAL LANE
HOSPITAL LANE / AMY STREET
- ⑤ 30 MPH SPEED LIMIT
- ⑥ STOP - FACING HOSPITAL LANE
HOSPITAL LANE / HOSPITAL DRIVE

 STREET AREA LIGHTING (12 LOCATIONS)

 STREET SIGNS (5 LOCATIONS)


○ STREET SIGNS (1 LOCATION)
30 MPH


LIGHTING PLAN PROVIDED IS SHOWN AS RECOMMENDED. FINAL LOCATIONS AND QUANTITIES ARE DETERMINED BY TEXAS NEW MEXICO POWER (TNMP).

NO.	DATE	DESCRIPTION	APPROVE
REVISIONS			

DESIGNED _____ DR _____
DRAWN _____ BT _____
CHECKED _____
DATE _____

B & L
BAKER & LAWSON, INC.
ENGINEERS • PLANNERS • SURVEYORS
4005 TECHNOLOGY DRIVE, SUITE 1530
ANGLETON, TEXAS 77515 (979) 849-6681
REG. NO. F-825

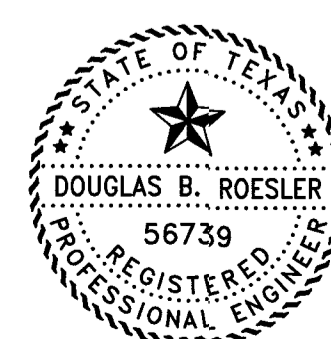

The seal appearing on
this document was
authorized by
Douglas B. Roesler
P.E. 56739

Date: 04-16-2018

OWNER:

**RIVERWAY PROPERTIES
6115 SKYLINE DR. STE A
HOUSTON, TEXAS 77057**

PLAN: _____
 PROFILE: _____
 HORIZONTAL: _____
 VERTICAL: _____

RIVERWOOD RANCH SUBDIVISION
SECTION 2
A 78 AC, 109-LOT SUBDIVISION
ANGLETON, TEXAS 77515



PAVEMENT MARKING,
STREET SIGN AND
ROADWAY LIGHTING LAYOUT

PROJECT NO. 14395

25

DISCLAIMER: The use of this standard is governed by the "Texas Engineering Practice Act". No warranty of any kind is made by TxDOT or any purpose whatsoever. TxDOT assumes no responsibility for the conversion of this standard to other formats or for incorrect results or damages resulting from its use.

DATE: FILE:

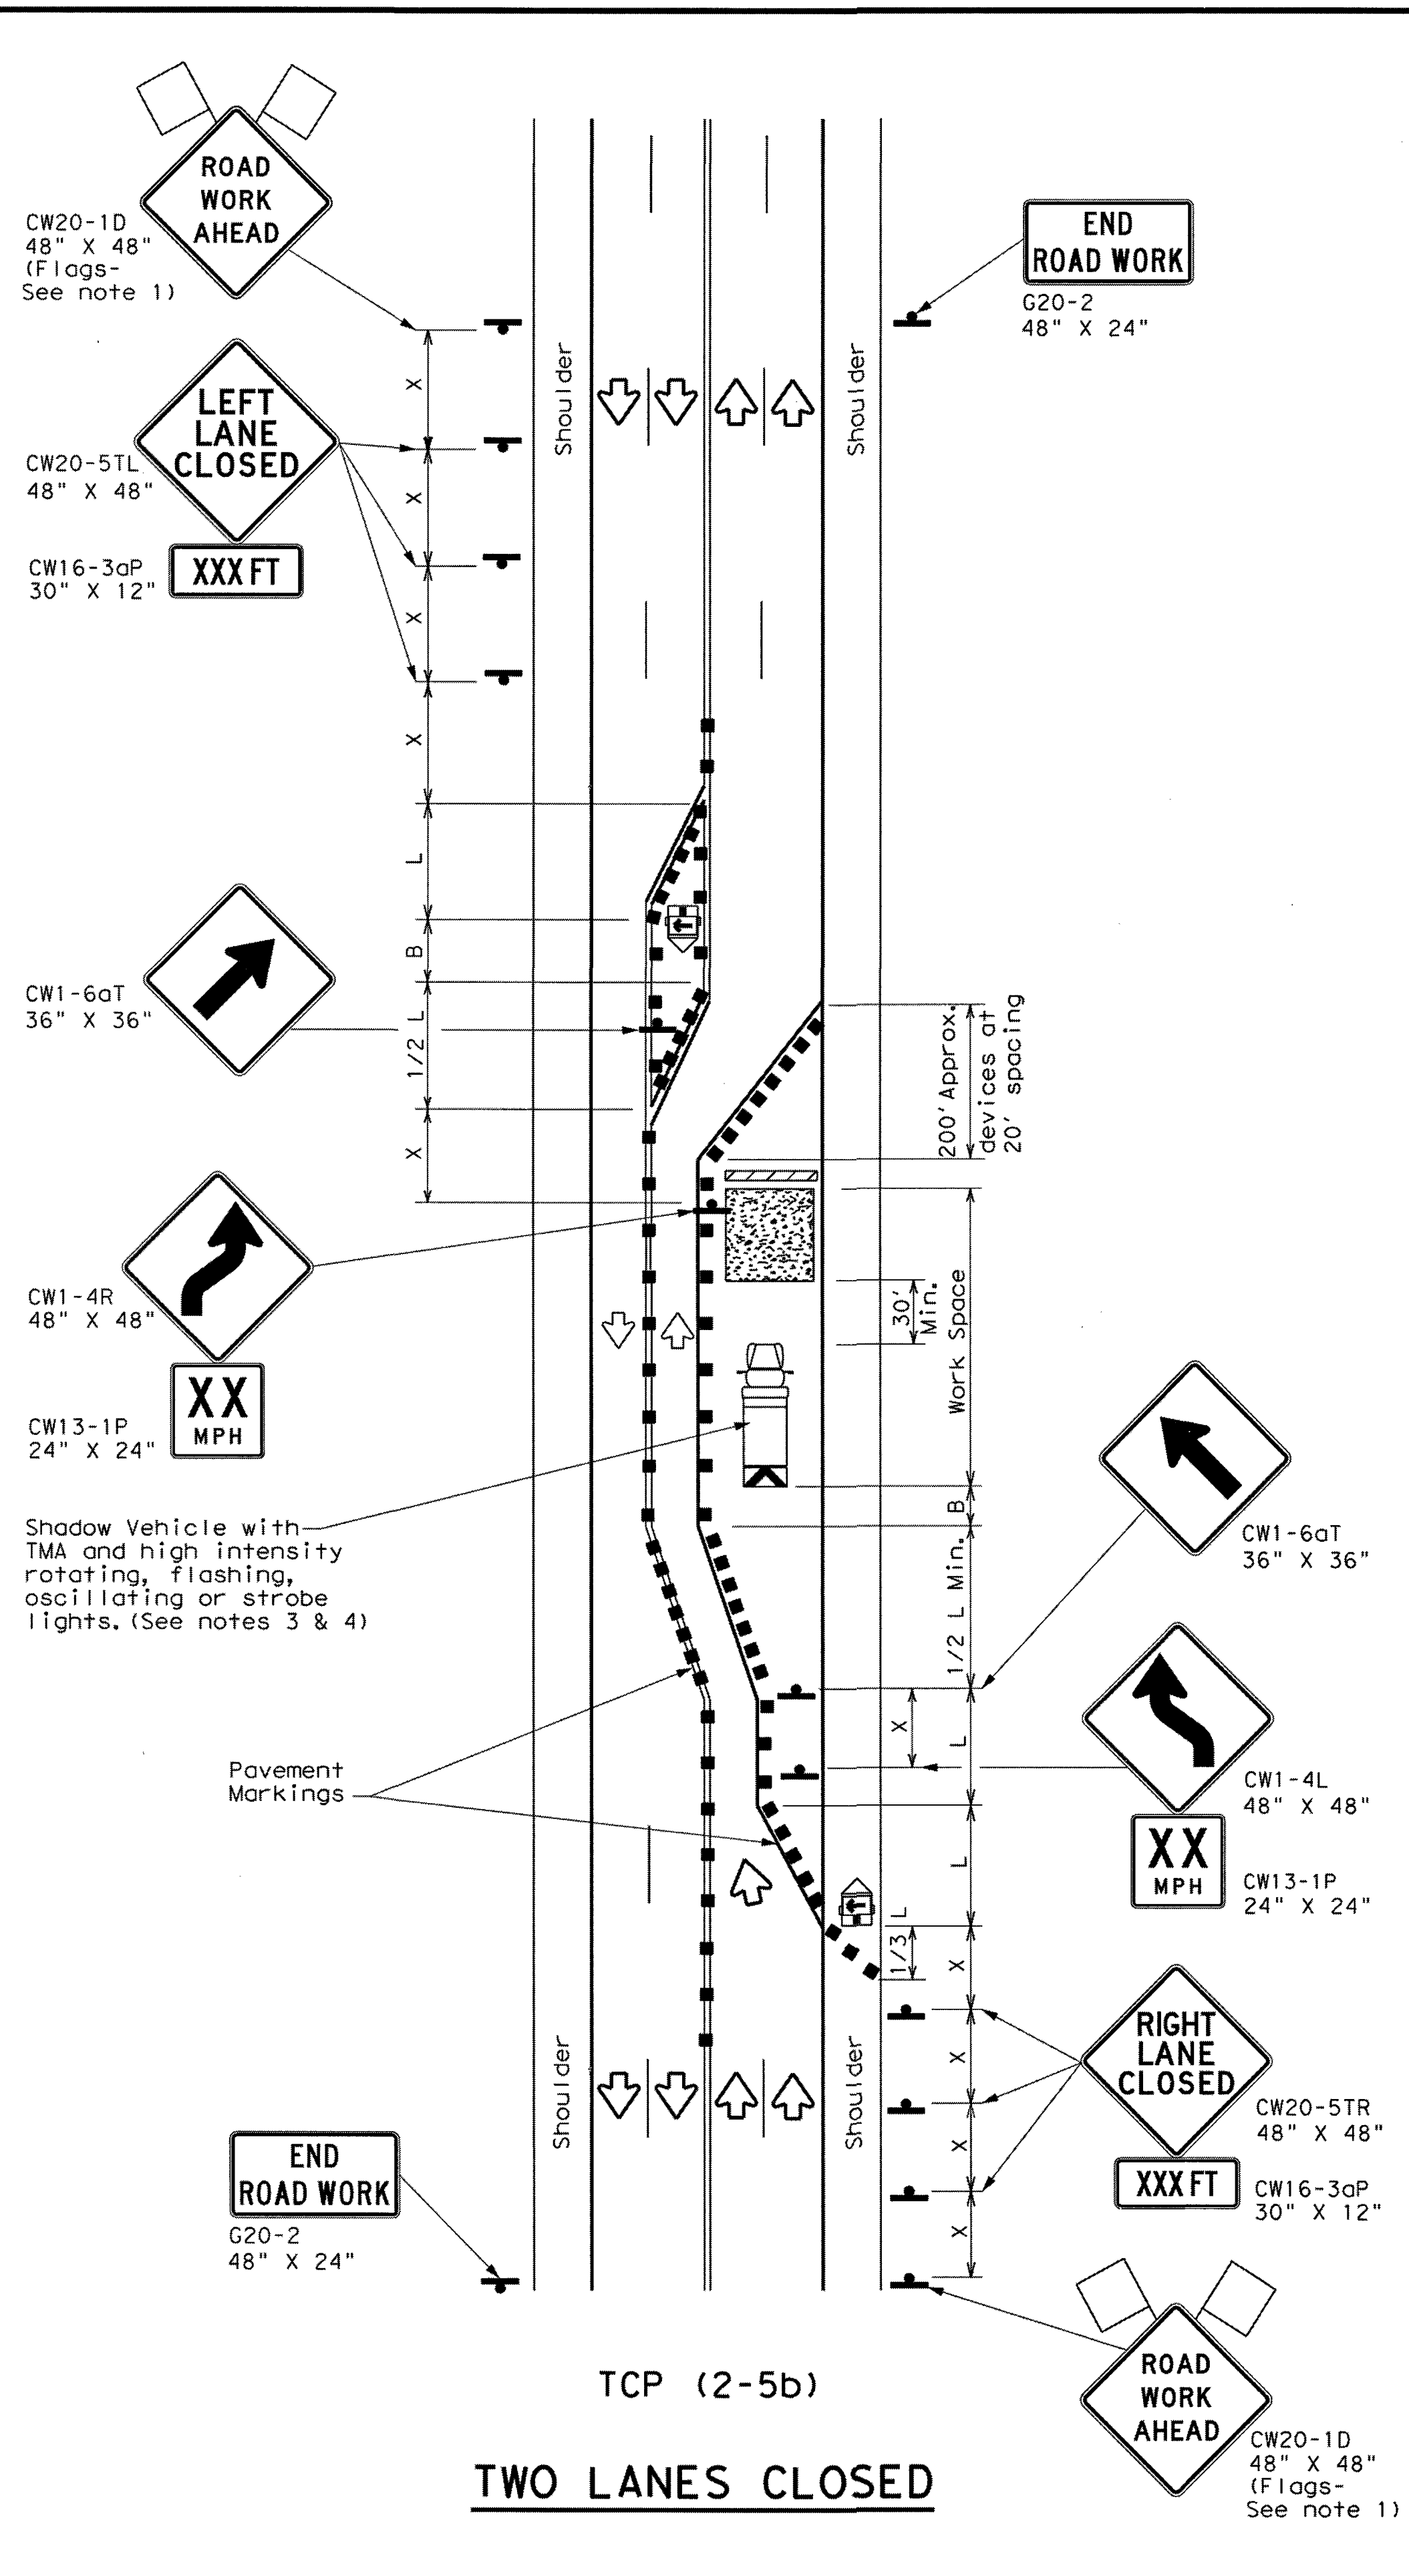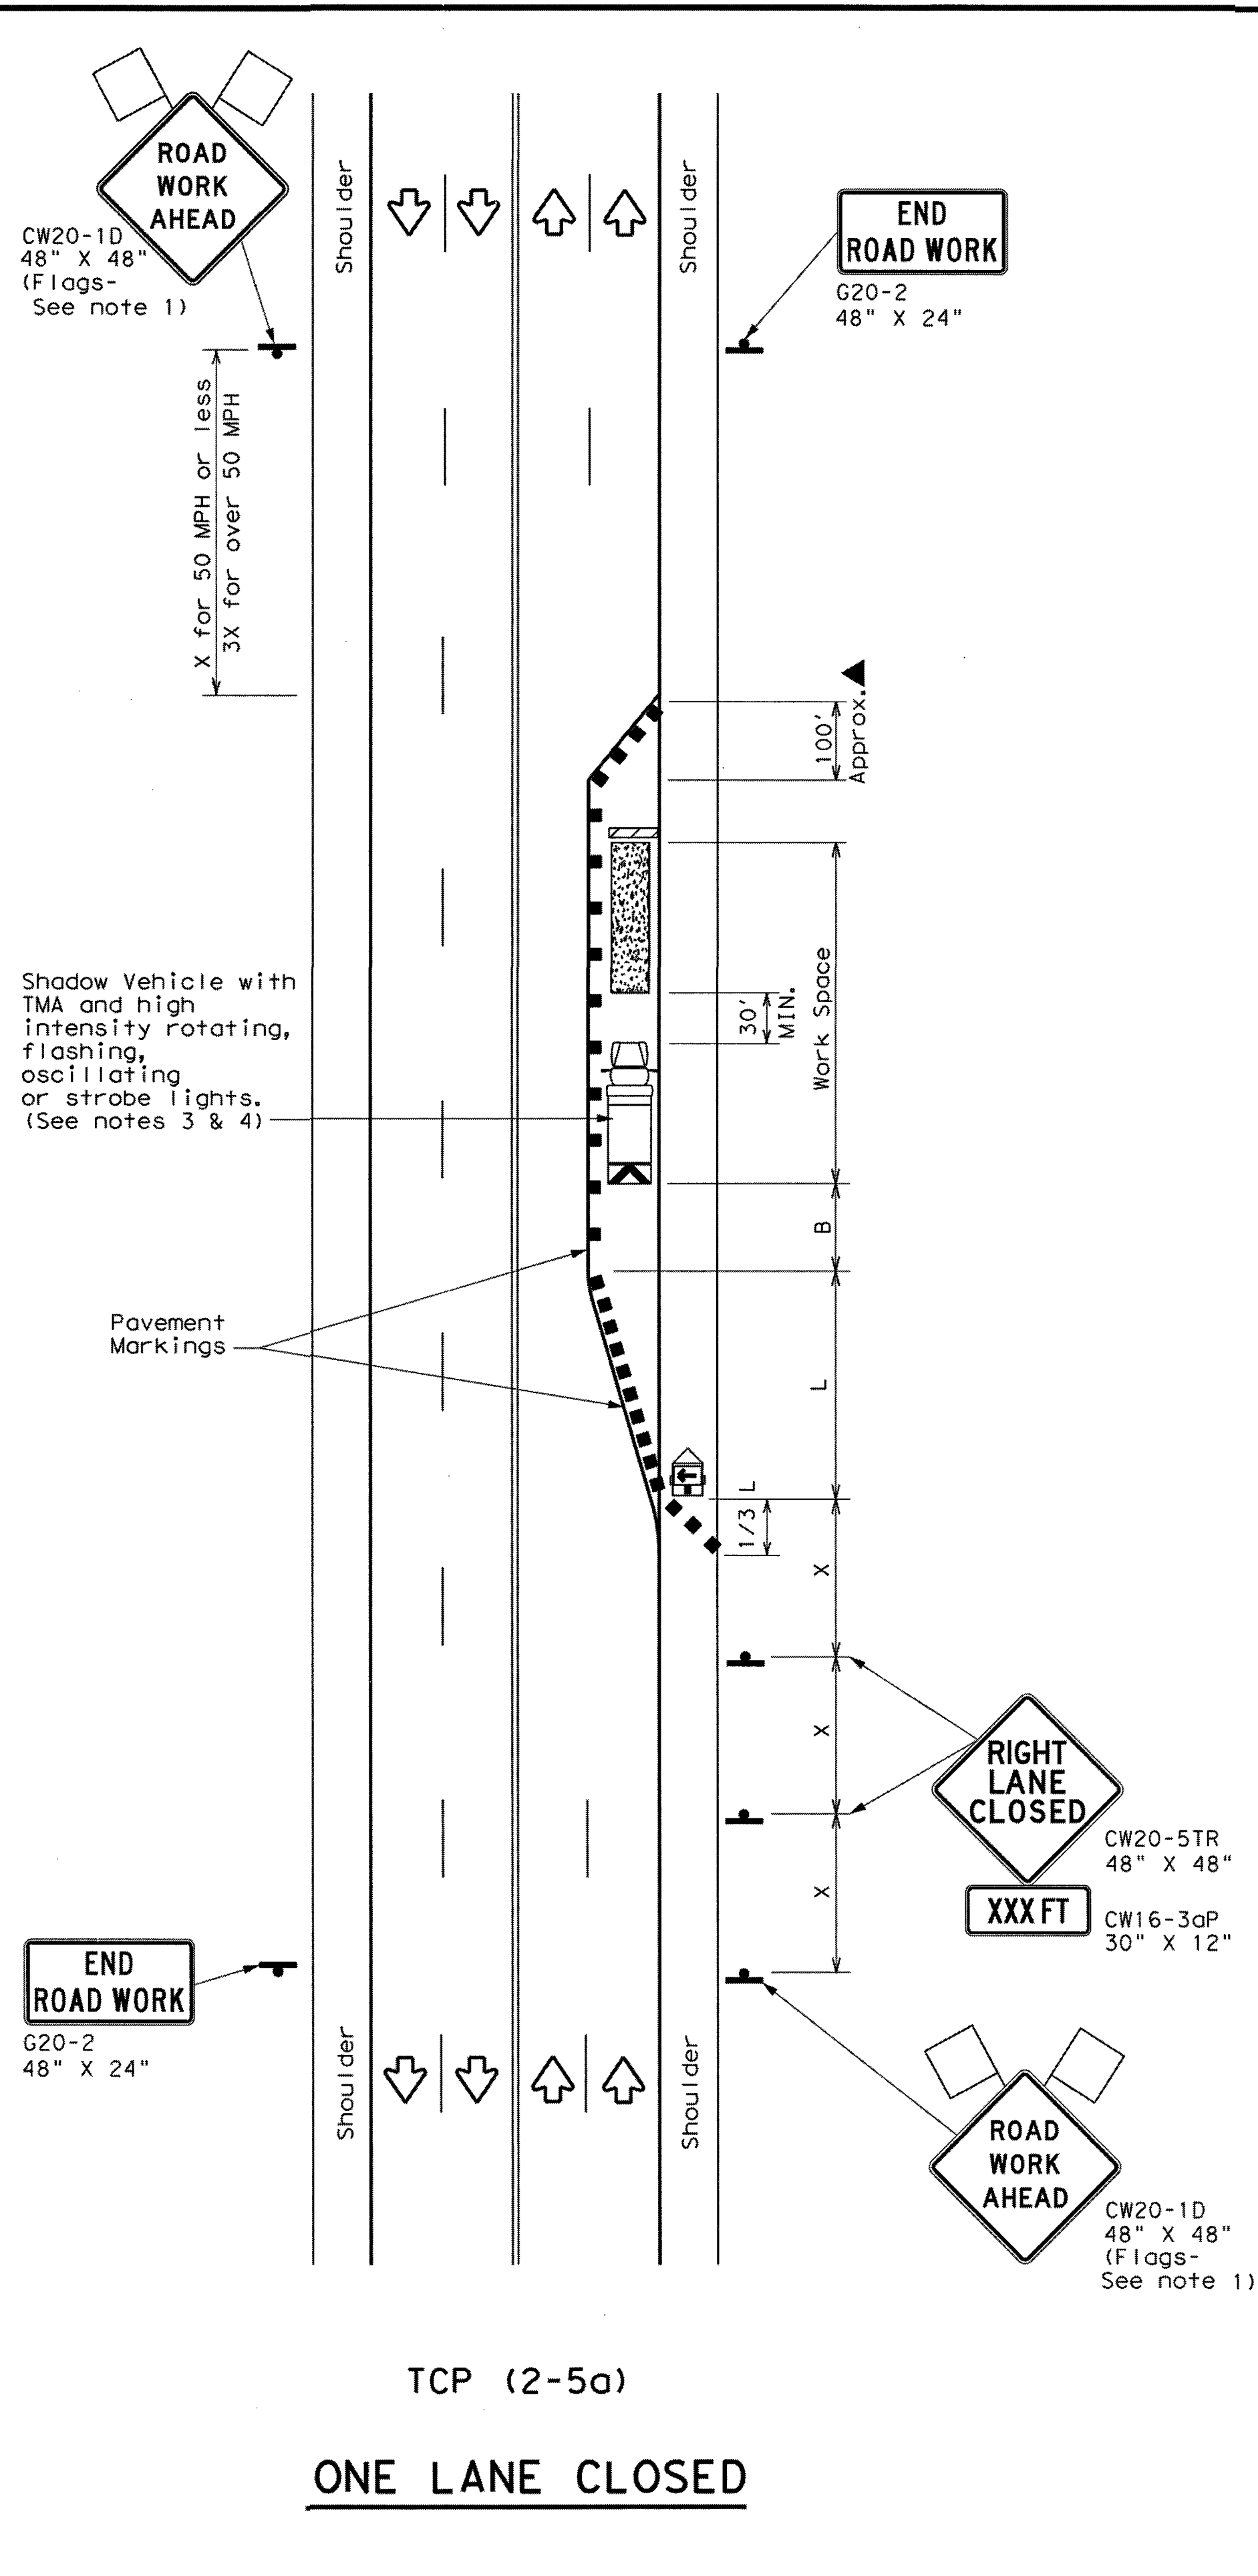

LEGEND			
	Type 3 Barricade		Channelizing Devices
	Heavy Work Vehicle		Truck Mounted Attenuator (TMA)
	Trailer Mounted Flashing Arrow Board		Portable Changeable Message Sign (PCMS)
	Sign		Traffic Flow
	Flag		Flagger

Posted Speed * X	Formula L = WS / 60	Minimum Desirable Taper Lengths **			Suggested Maximum Spacing of Channelizing Devices		Minimum Sign Spacing "X" Distance	Suggested Longitudinal Buffer Space "B"
		10' Offset	11' Offset	12' Offset	On a Taper	On a Tangent		
30	L = WS	150'	165'	180'	30'	60'	120'	90'
35		205'	225'	245'	35'	70'	160'	120'
40		265'	295'	320'	40'	80'	240'	155'
45		450'	495'	540'	45'	90'	320'	195'
50		500'	550'	600'	50'	100'	400'	240'
55	L = WS	550'	605'	660'	55'	110'	500'	295'
60		600'	660'	720'	60'	120'	600'	350'
65		650'	715'	780'	65'	130'	700'	410'
70		700'	770'	840'	70'	140'	800'	475'
75		750'	825'	900'	75'	150'	900'	540'

* Conventional Roads Only

** Taper lengths have been rounded off.

L=Length of Taper (FT) W=Width of Offset (FT) S=Posted Speed (MPH)

TYPICAL USAGE				
MOBILE	SHORT DURATION	SHORT TERM STATIONARY	INTERMEDIATE TERM STATIONARY	LONG TERM STATIONARY

GENERAL NOTES

- Flags attached to signs where shown, are REQUIRED.
- All traffic control devices illustrated are REQUIRED, except those denoted with the triangle symbol may be omitted when stated elsewhere in the plans, or for routine maintenance work, when approved by the Engineer.
- A Shadow Vehicle with a TMA should be used anytime it can be positioned 30 to 100 feet in advance of the area of crew exposure without adversely affecting the performance or quality of the work. If workers are no longer present but road or work conditions require the traffic control to remain in place, Type 3 Barricades or other channelizing devices may be substituted for the Shadow Vehicle and TMA.
- Additional Shadow Vehicles with TMAs may be positioned in each closed lane, on the shoulder or off the paved surface, next to those shown in order to protect a wider work space.
- The downstream taper is optional. When used, it should be 100 feet approximately per lane, with channelizing devices spaced at 20 feet.

TCP (2-5a)

- If this TCP is used for a left lane closure, CW20-5TL "LEFT LANE CLOSED" signs shall be used and channelizing devices shall be placed on the centerline to protect the work space from opposing traffic, with the arrow board placed in the closed lane near the end of the merging taper.



TCP (2-5b)

- Conflicting pavement markings shall be removed for long-term projects.

		Traffic Operations Division Standard			
TRAFFIC CONTROL PLAN LONG TERM LANE CLOSURES MULTILANE CONVENTIONAL RDS.					
TCP (2-5) - 18					
FILE: tcp2-5-18.dgn	DWG: Ck1	DWG: Dk1	CK1		
© TxDOT December 1985	CONT	SECT	JOB		
REVISIONS		DIST			
8-95 2-12		COUNTY			
1-97 3-03		SHEET NO.			
4-98 2-18					
165					

RECORD DRAWING

NO.	DATE	DESCRIPTION	APPROVED
REVISIONS			

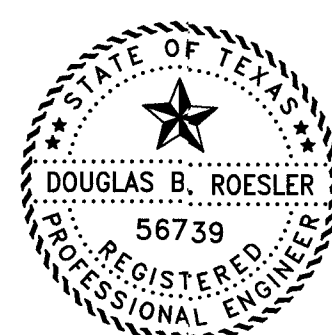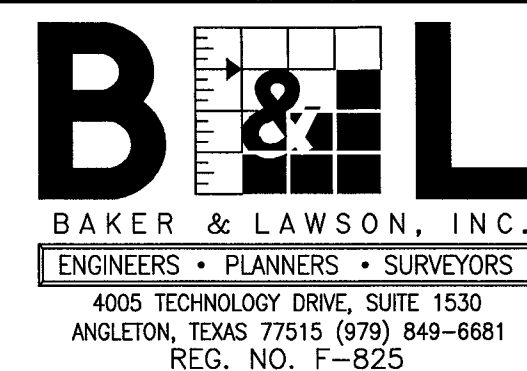

The seal appearing on this document was authorized by Douglas B. Roesler, P.E. 56739
Date: 04-18-22


OWNER:
RIVERWAY PROPERTIES
6115 SKYLINE DR. STE A.
HOUSTON, TEXAS 77057

PLAN: _____
PROFILE: _____
HORIZONTAL: _____
VERTICAL: _____


RIVERWOOD RANCH SUBDIVISION
SECTION 2
A 78 AC, 109-LOT SUBDIVISION
ANGLETON, TEXAS 77515

TRAFFIC CONTROL PLAN
TCP (1-1)-18

PROJECT NO. 14395

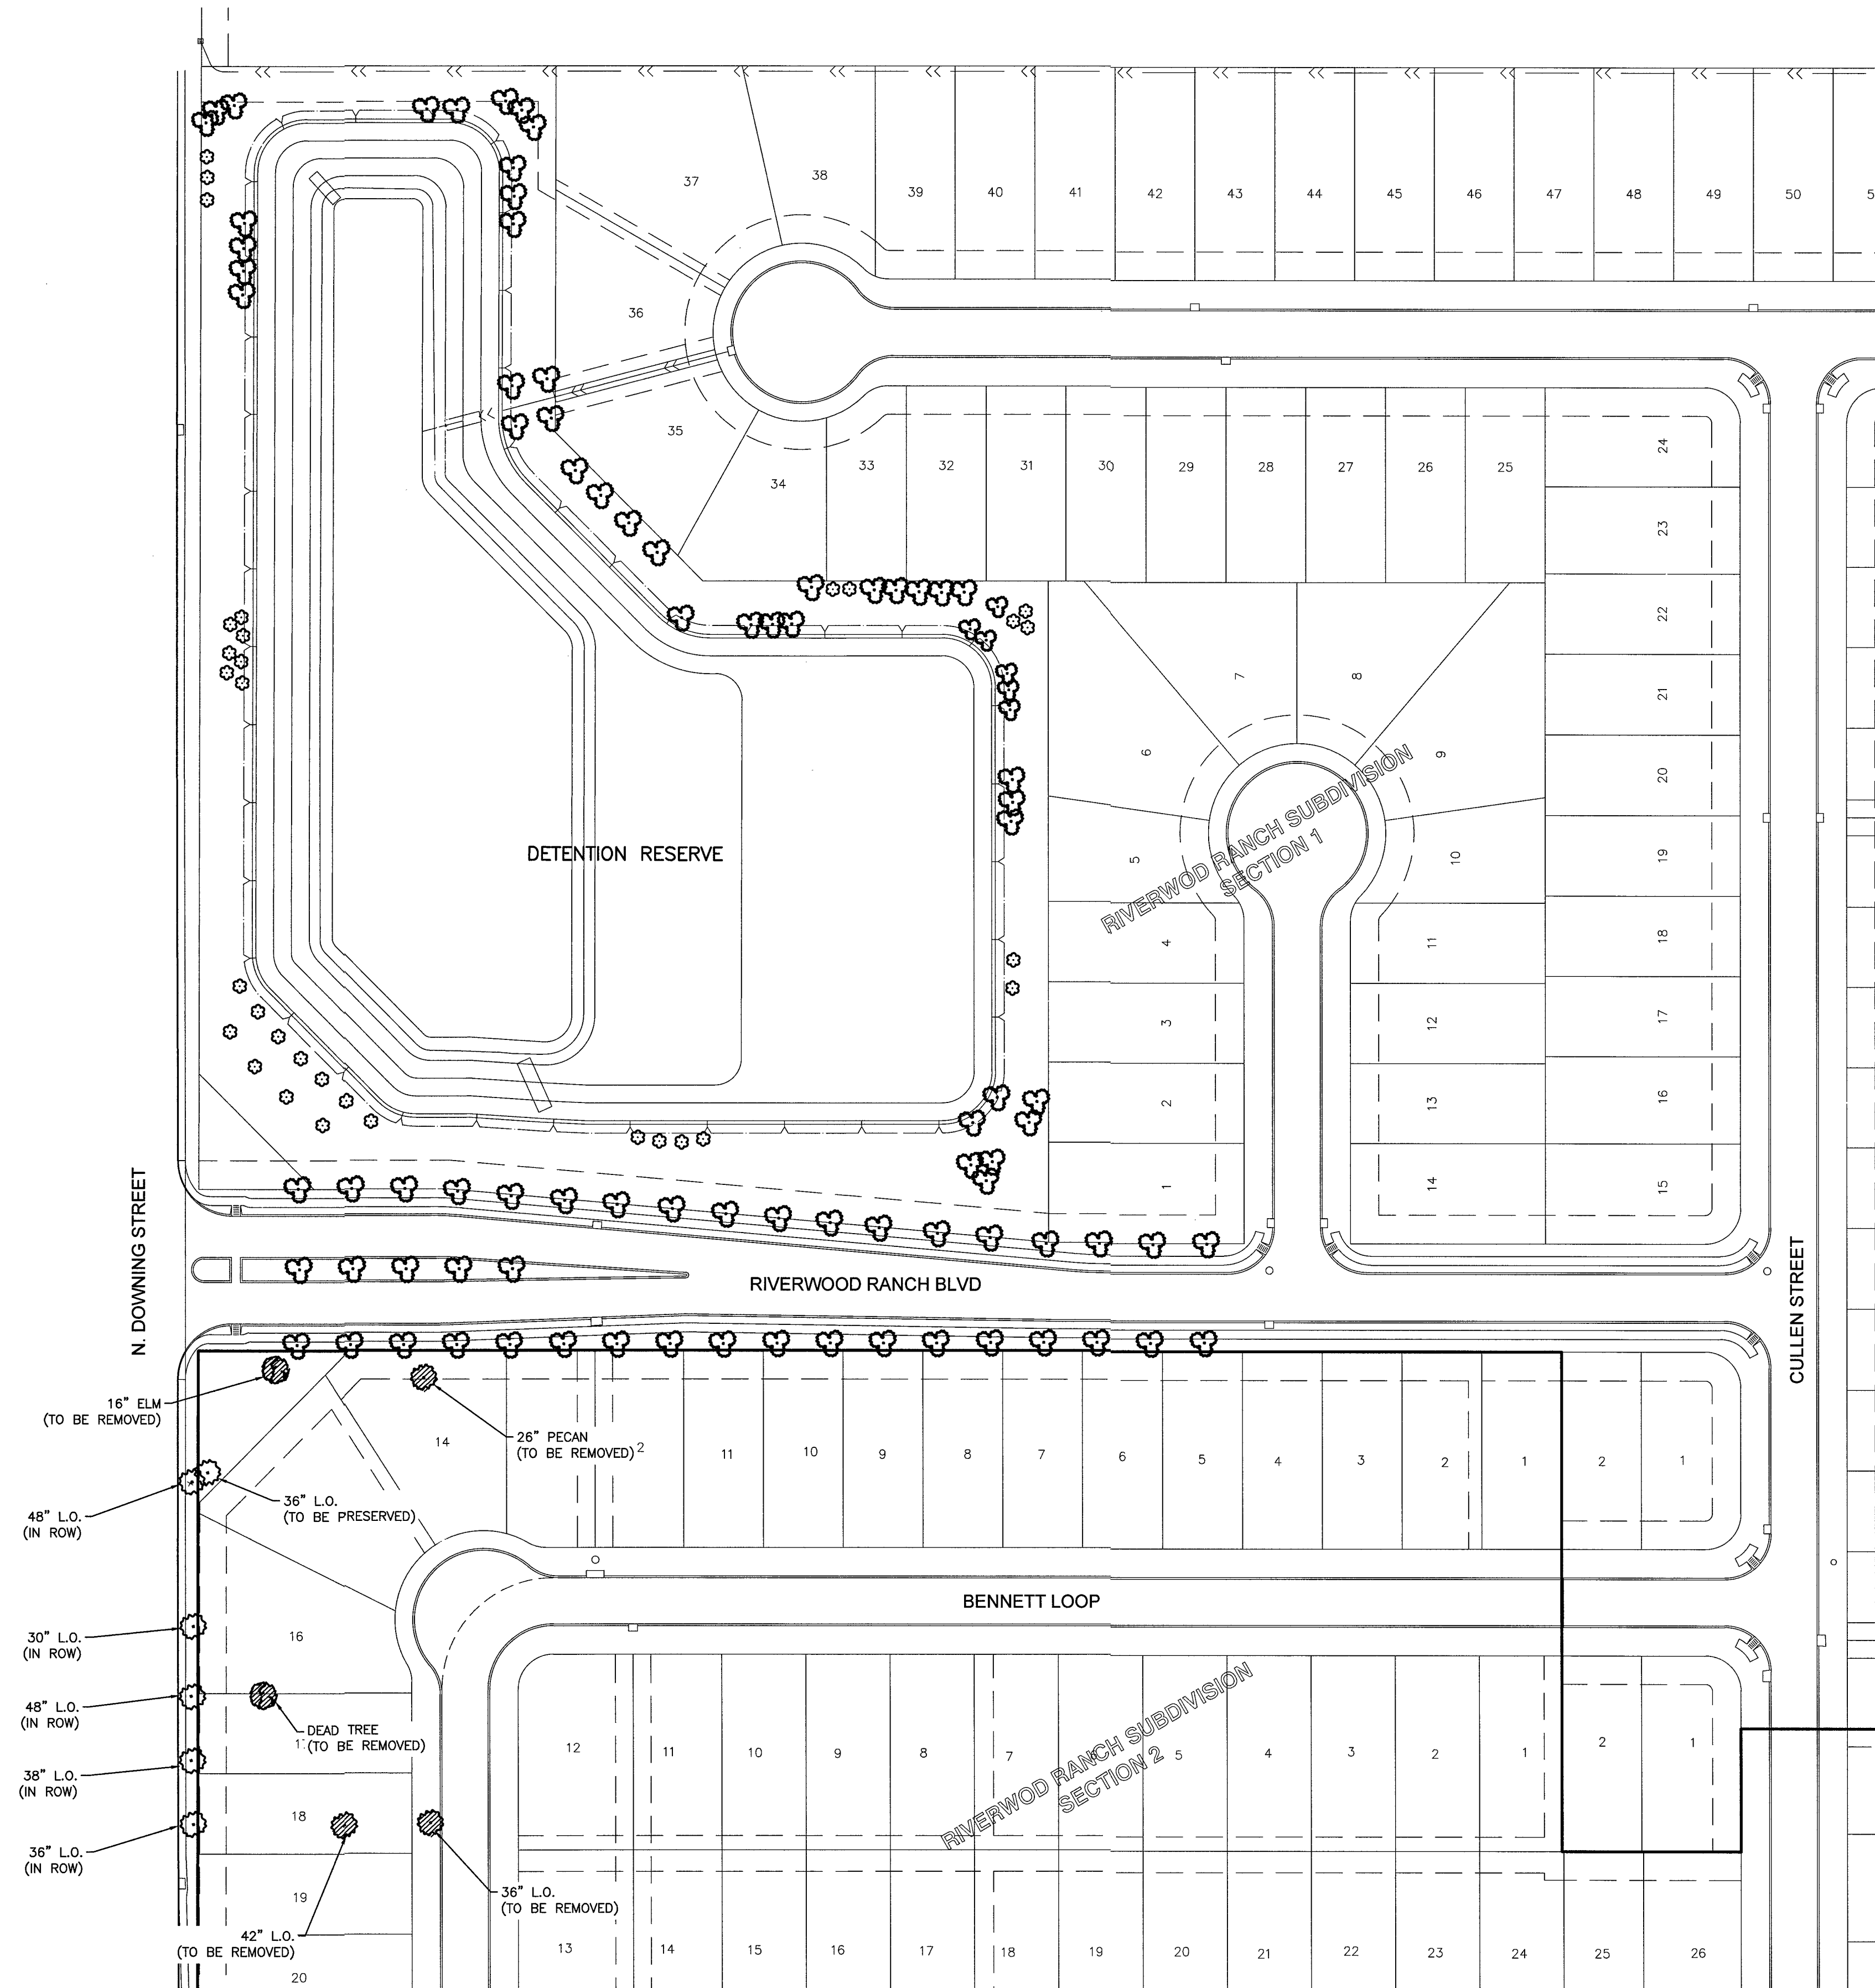

TREE LEGEND	
	HERITAGE TREE (PECAN & LIVE OAK)
	SIGNIFICANT TREE (OAK & ELM)
	PROP CREPE MYRTLE
	PROP OAK TREE

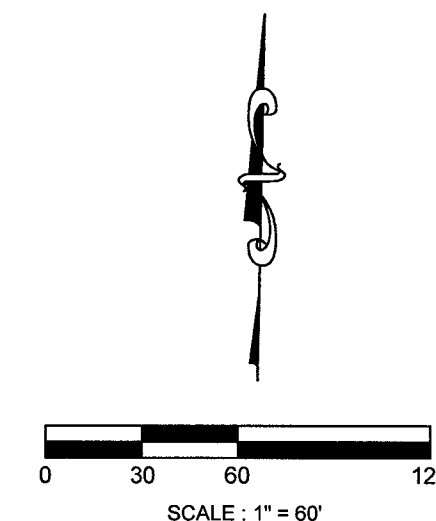

SITE TREE SUMMARY

TOTAL NUMBER OF HERITAGE TREES = 4
 TOTAL CALIPER OF HERITAGE TREES = 140 IN

HERITAGE TREES TO BE REMOVED* = 3
 CALIPER OF REMOVED HERITAGE TREES = 104 IN

HERITAGE & SIGNIFICANT TREES TO BE PRESERVED = 1
 CALIPER OF HERITAGE/SIGNIFICANT TREES TO BE PRESERVED = 36 IN

REQUIRED REPLACEMENT CALIPER = $(104 - 36) \times 3 = 204"$

REQUIRED REPLACEMENT TREES (3"-CALIPER OAK TREES) = 68 TREES

REPLACEMENT TREES PROVIDED IN RIVERWOOD RANCH BLVD ROW = 41 TREES
 REPLACEMENT TREES PROVIDED IN DETENTION RESERVE = 49 TREES
 TOTAL REPLACEMENT TREES PROVIDED = 90 TREES

32 PROPOSED CREPE MYRTLE ARE PROVIDED IN THIS TREE PRESERVATION PLAN.
 CREPE MYRTLES ARE NOT CLASSIFIED AS REPLACEMENT TREES AND ARE NOT COUNTED TOWARDS THE REPLACEMENT TOTAL.



PER SECTION 23-60.H.7 OF THE ANGLETON LDC, THE HOMEOWNER WILL PROVIDE TWO TREES PER LOT IN ADDITION TO THE REQUIRED REPLACEMENT CALIPER.

TREES LOCATED IN THE SOUTH DOWNING ROW ARE TO BE PRESERVED. TREES IN THE DOWLING ROW ARE NOT COUNTED FOR OR AGAINST THE HERITAGE TREE PRESERVATION PLAN.

RECORD DRAWING

NO.	DATE	DESCRIPTION	APPROVED

DESIGNED DR
 DRAWN BT
 CHECKED
 DATE

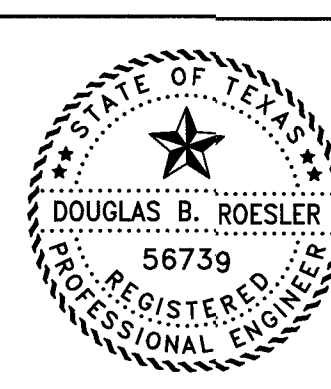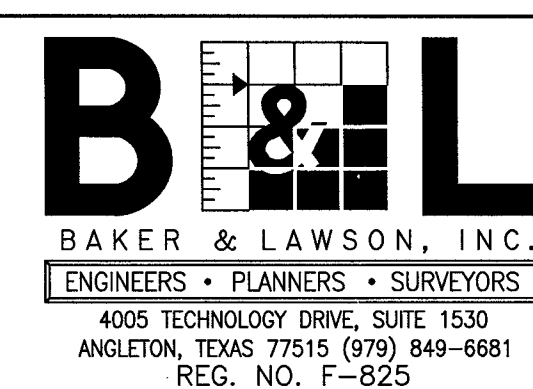

The seal appearing on this document was authorized by Douglas B. Roessler P.E. 56739
 Date: 04-18-22


OWNER:
RIVERWAY PROPERTIES
6115 SKYLINE DR. STE A.
HOUSTON, TEXAS 77057

PLAN: 1" = 60'
 PROFILE:
 HORIZONTAL:
 VERTICAL:

RIVERWOOD RANCH SUBDIVISION
SECTION 2
A 78 AC, 109-LOT SUBDIVISION
ANGLETON, TEXAS 77515


HERITAGE TREE
 PRESERVATION PLAN

PROJECT NO. 14395

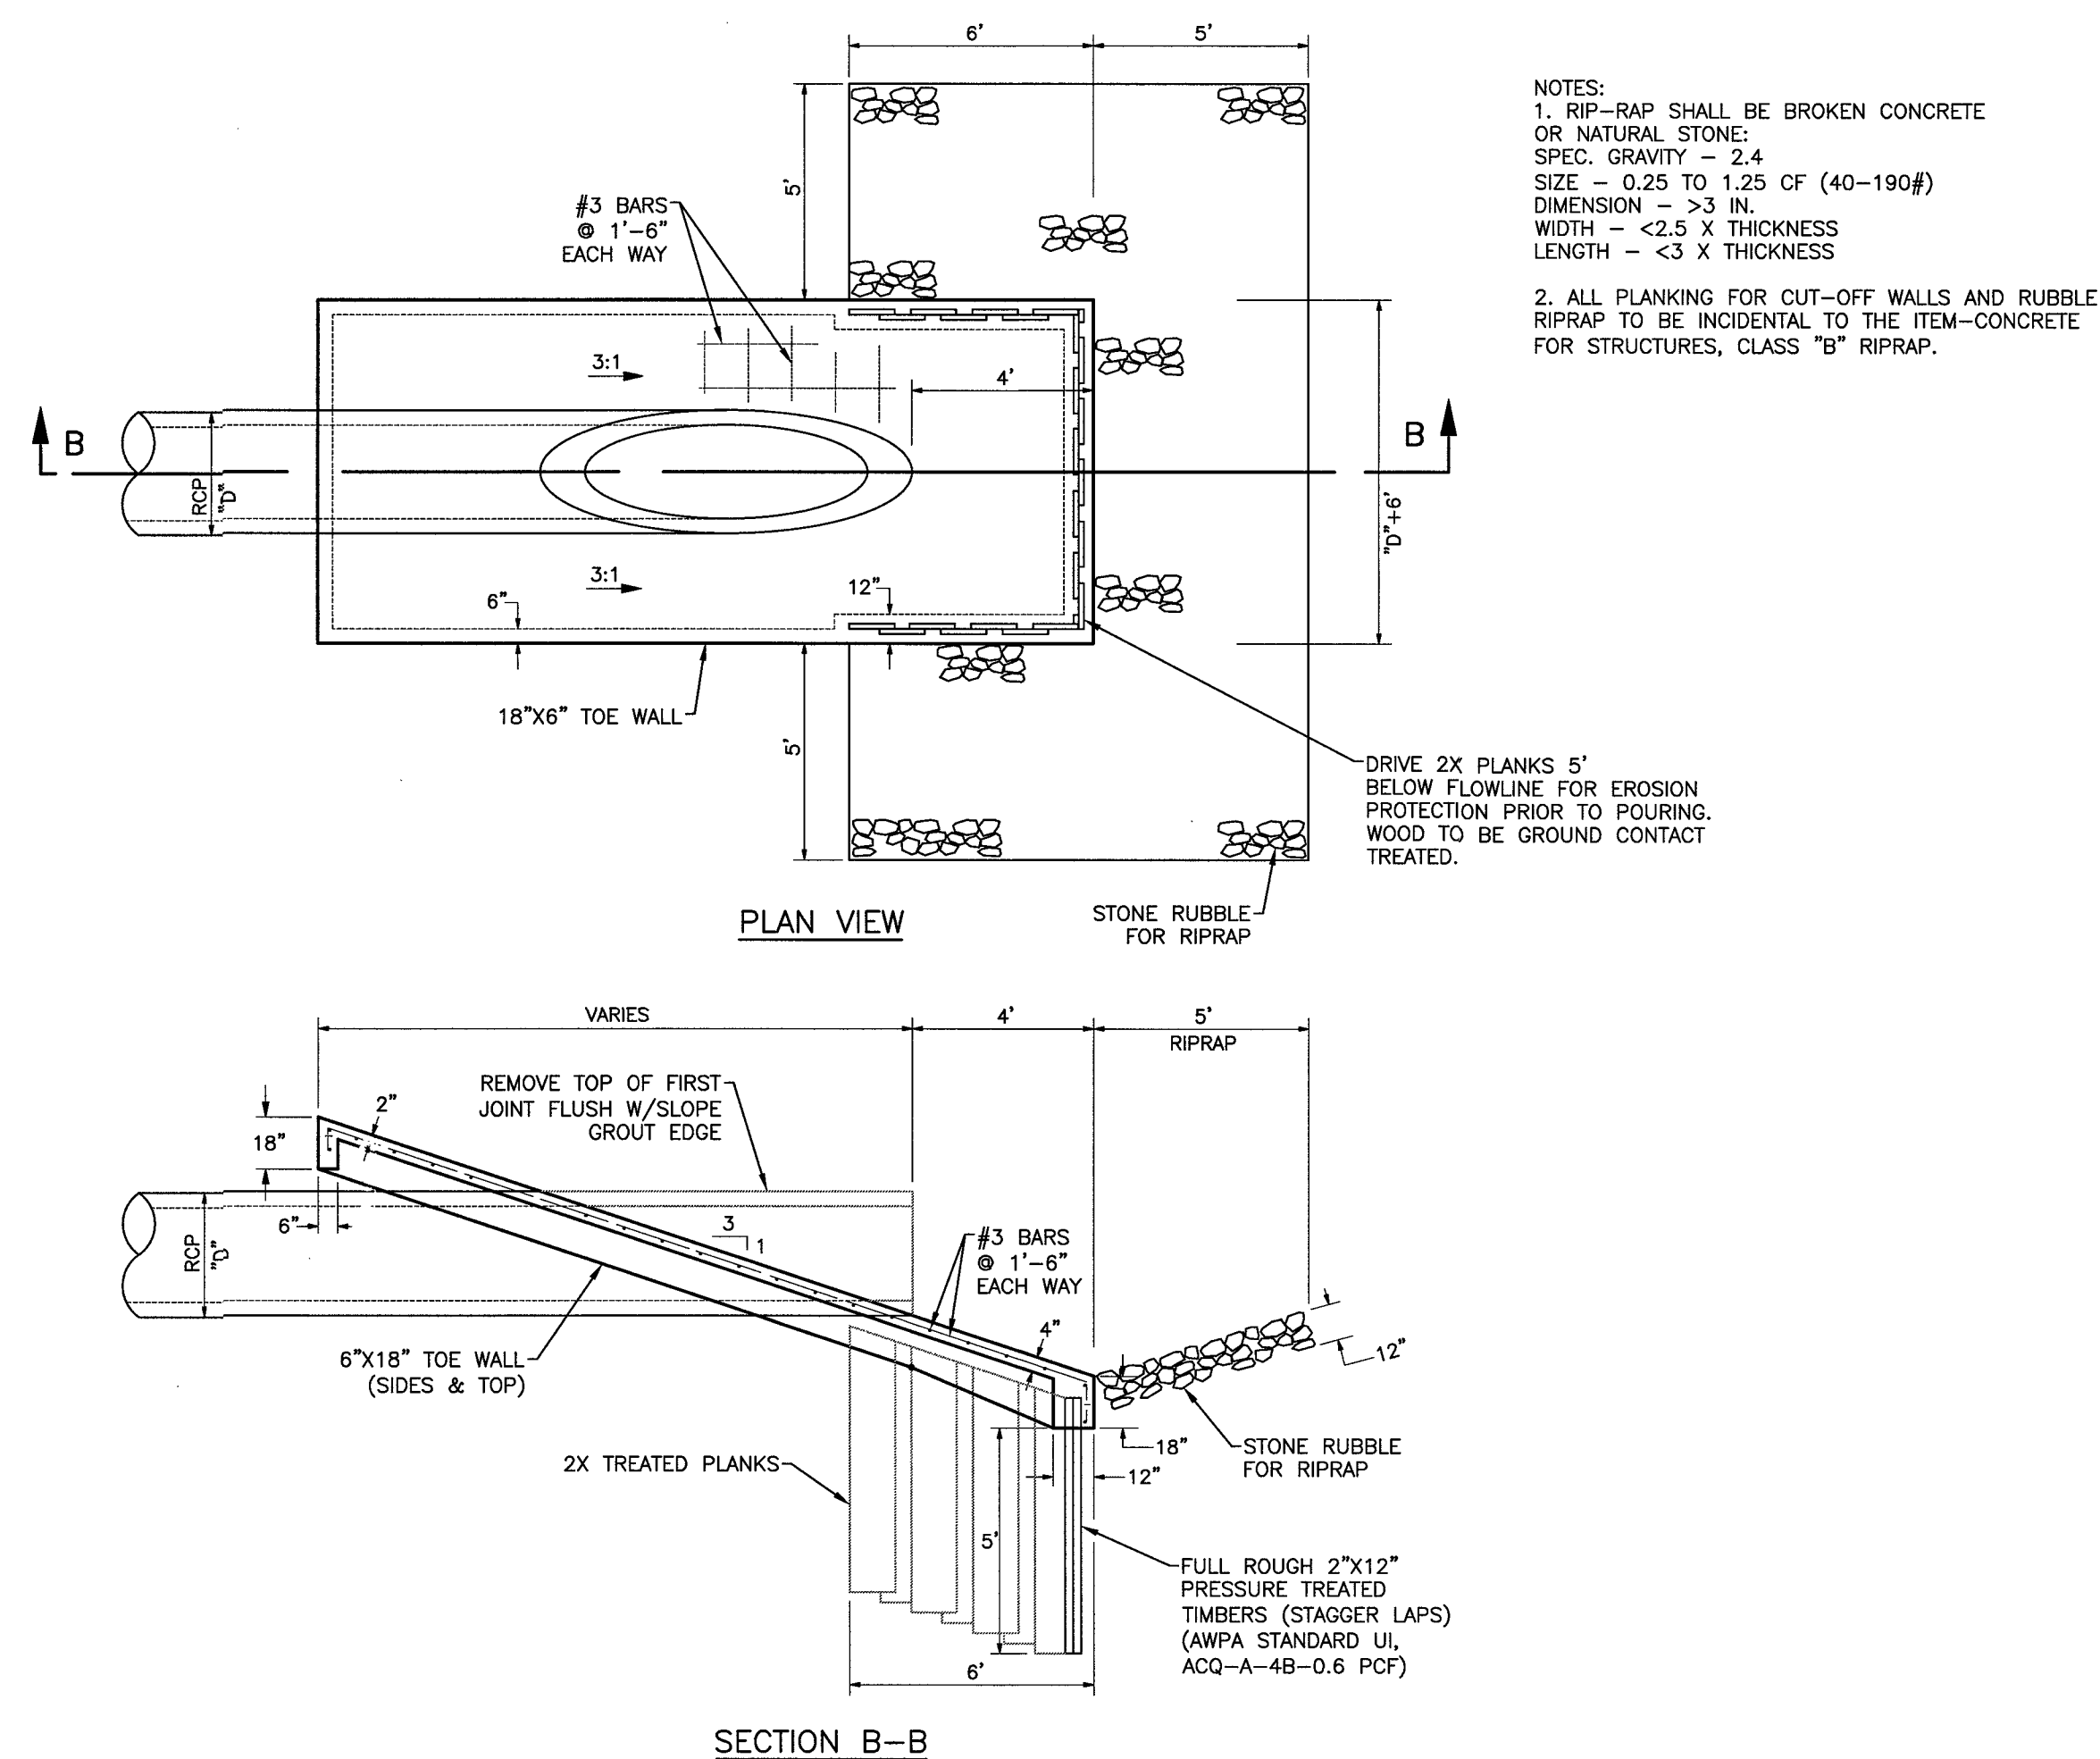

TYPE (A)
STANDARD CONCRETE SLOPE PAVING PIPE OUTFALL
NTS

V1420-1 Cover

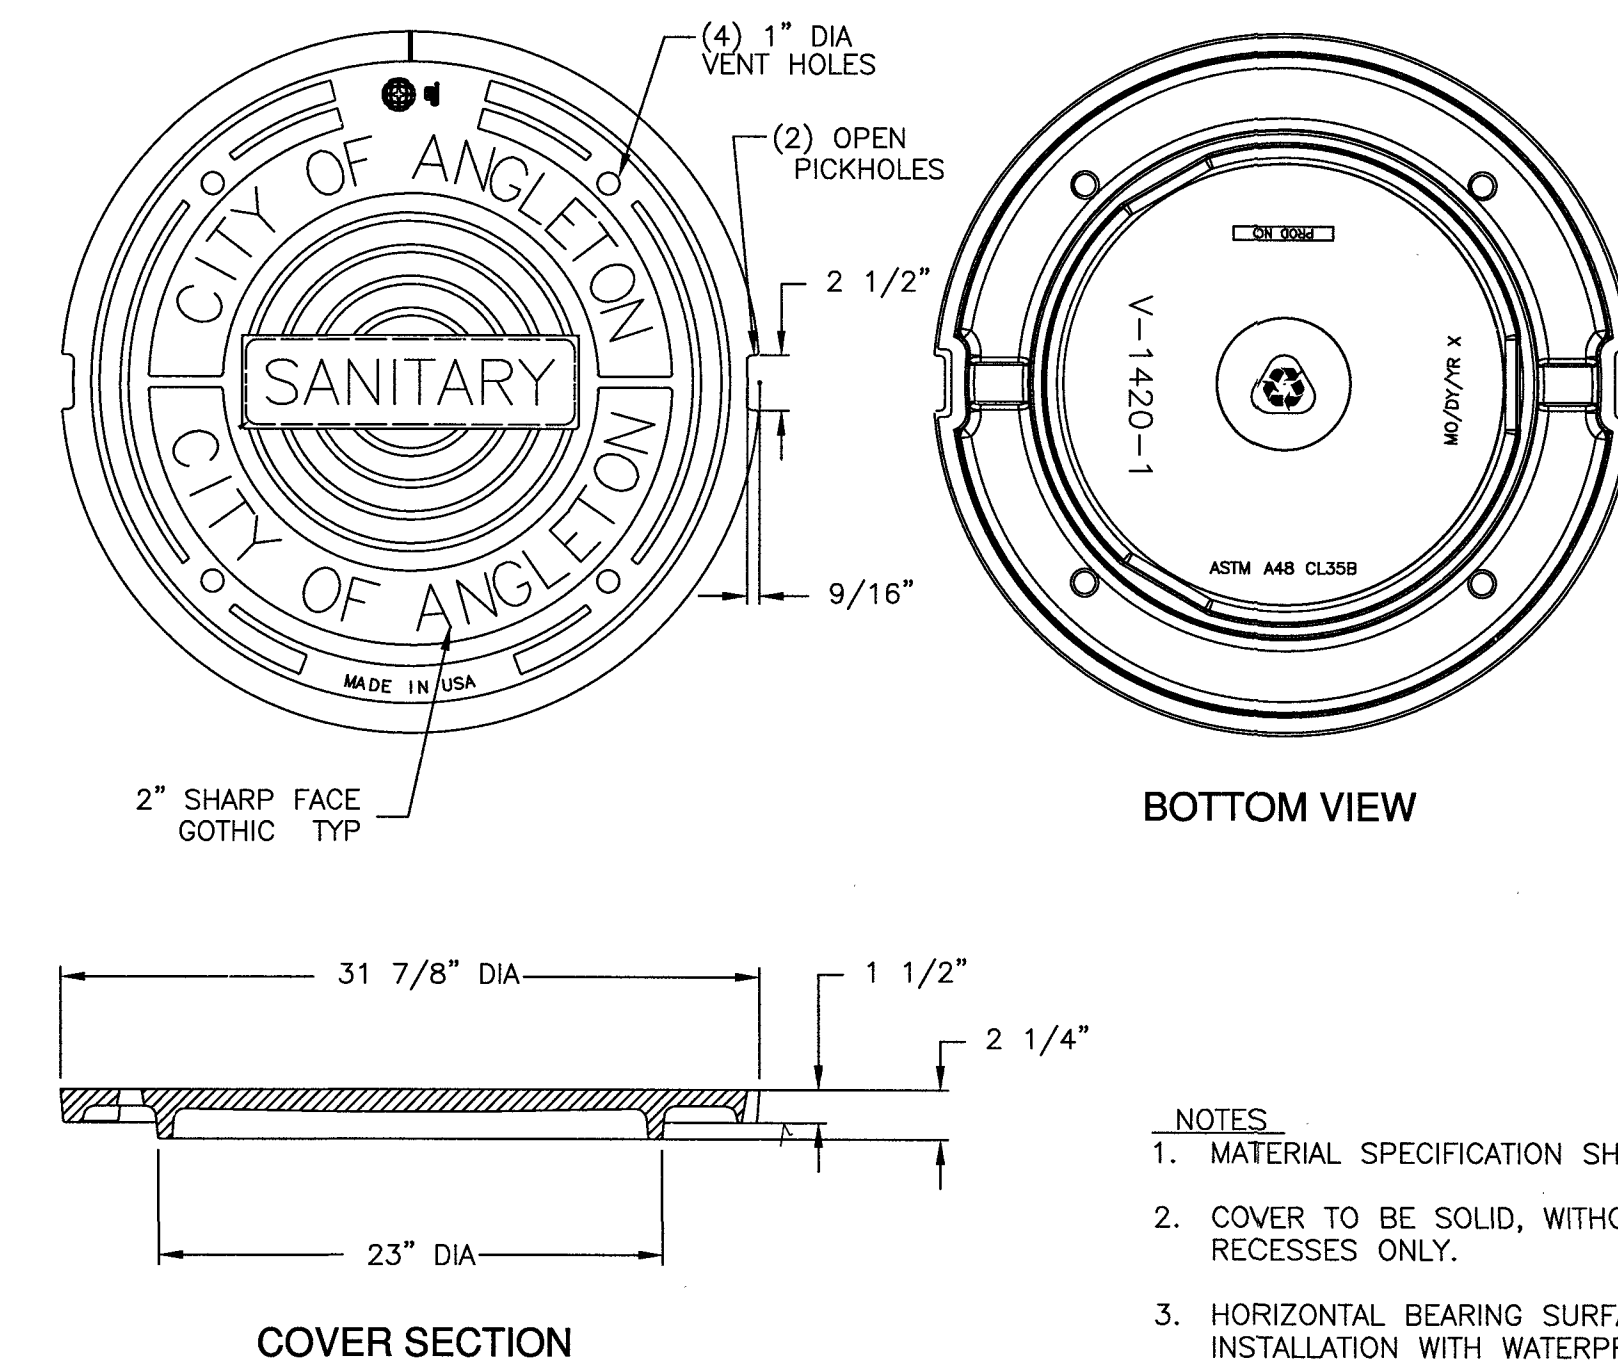


1 32" Manhole Cover and Frame
Scale: NTS

RECORD DRAWING

NO.	DATE	DESCRIPTION	APPROVED

DESIGNED	DR
DRAWN	BT
CHECKED	
DATE	

B & L
BAKER & LAWSON, INC.
ENGINEERS • PLANNERS • SURVEYORS
4005 TECHNOLOGY DRIVE, SUITE 1530
ANGLETON, TEXAS 77515 (979) 849-6681
REG. NO. F-825

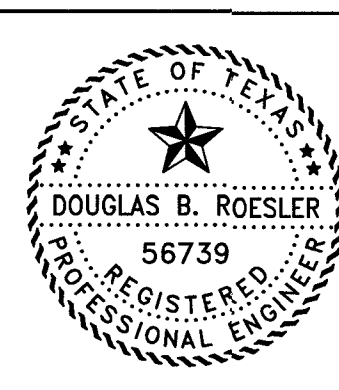

The seal appearing on this document was authorized by Douglas B. Roesler P.E. 56739
Date: 04-28-22



OWNER:
RIVERWAY PROPERTIES
6115 SKYLINE DR. STE A.
HOUSTON, TEXAS 77057

PLAN:	
PROFILE:	
HORIZONTAL:	
VERTICAL:	

RIVERWOOD RANCH SUBDIVISION
SECTION 2
A 78 AC, 109-LOT SUBDIVISION
ANGLETON, TEXAS 77515

MISCELLANEOUS DETAILS


PROJECT NO. 14395

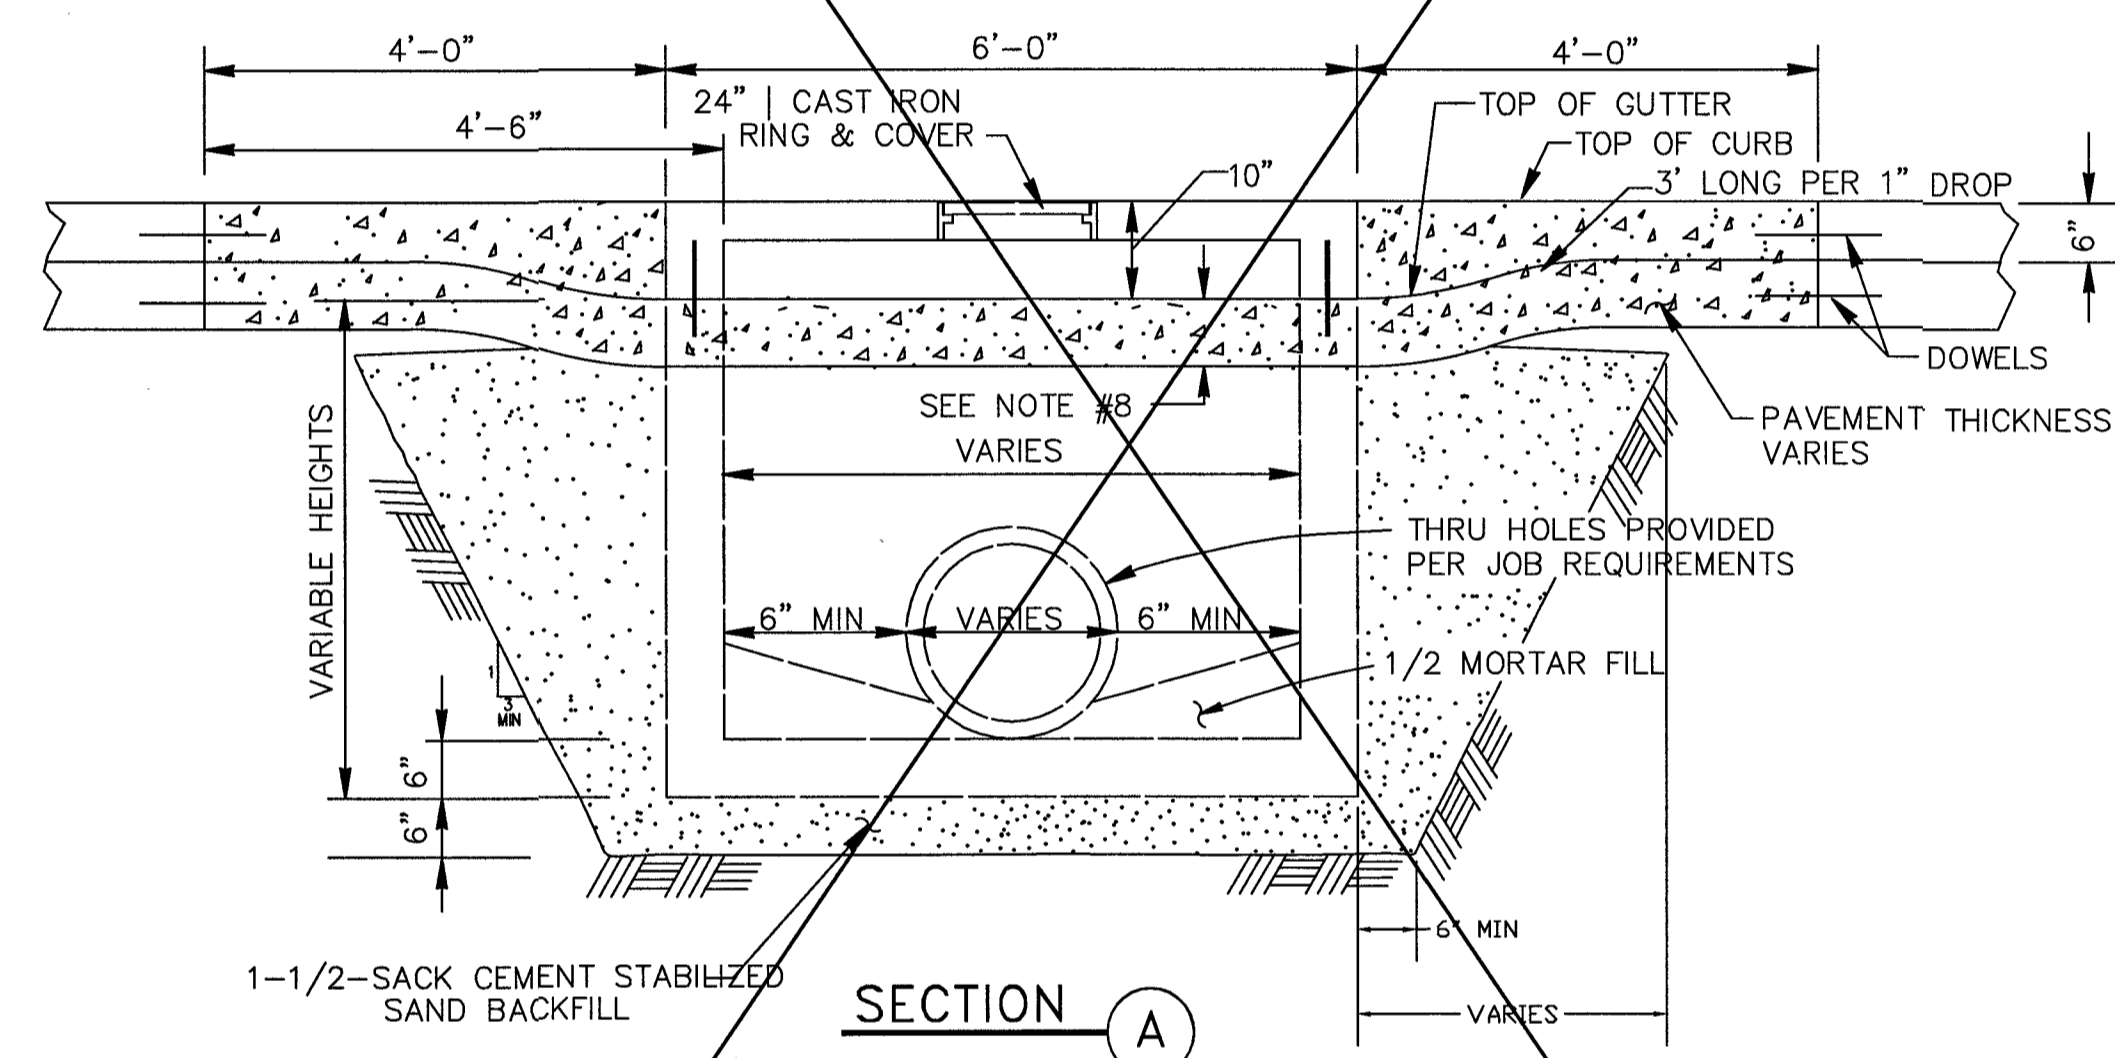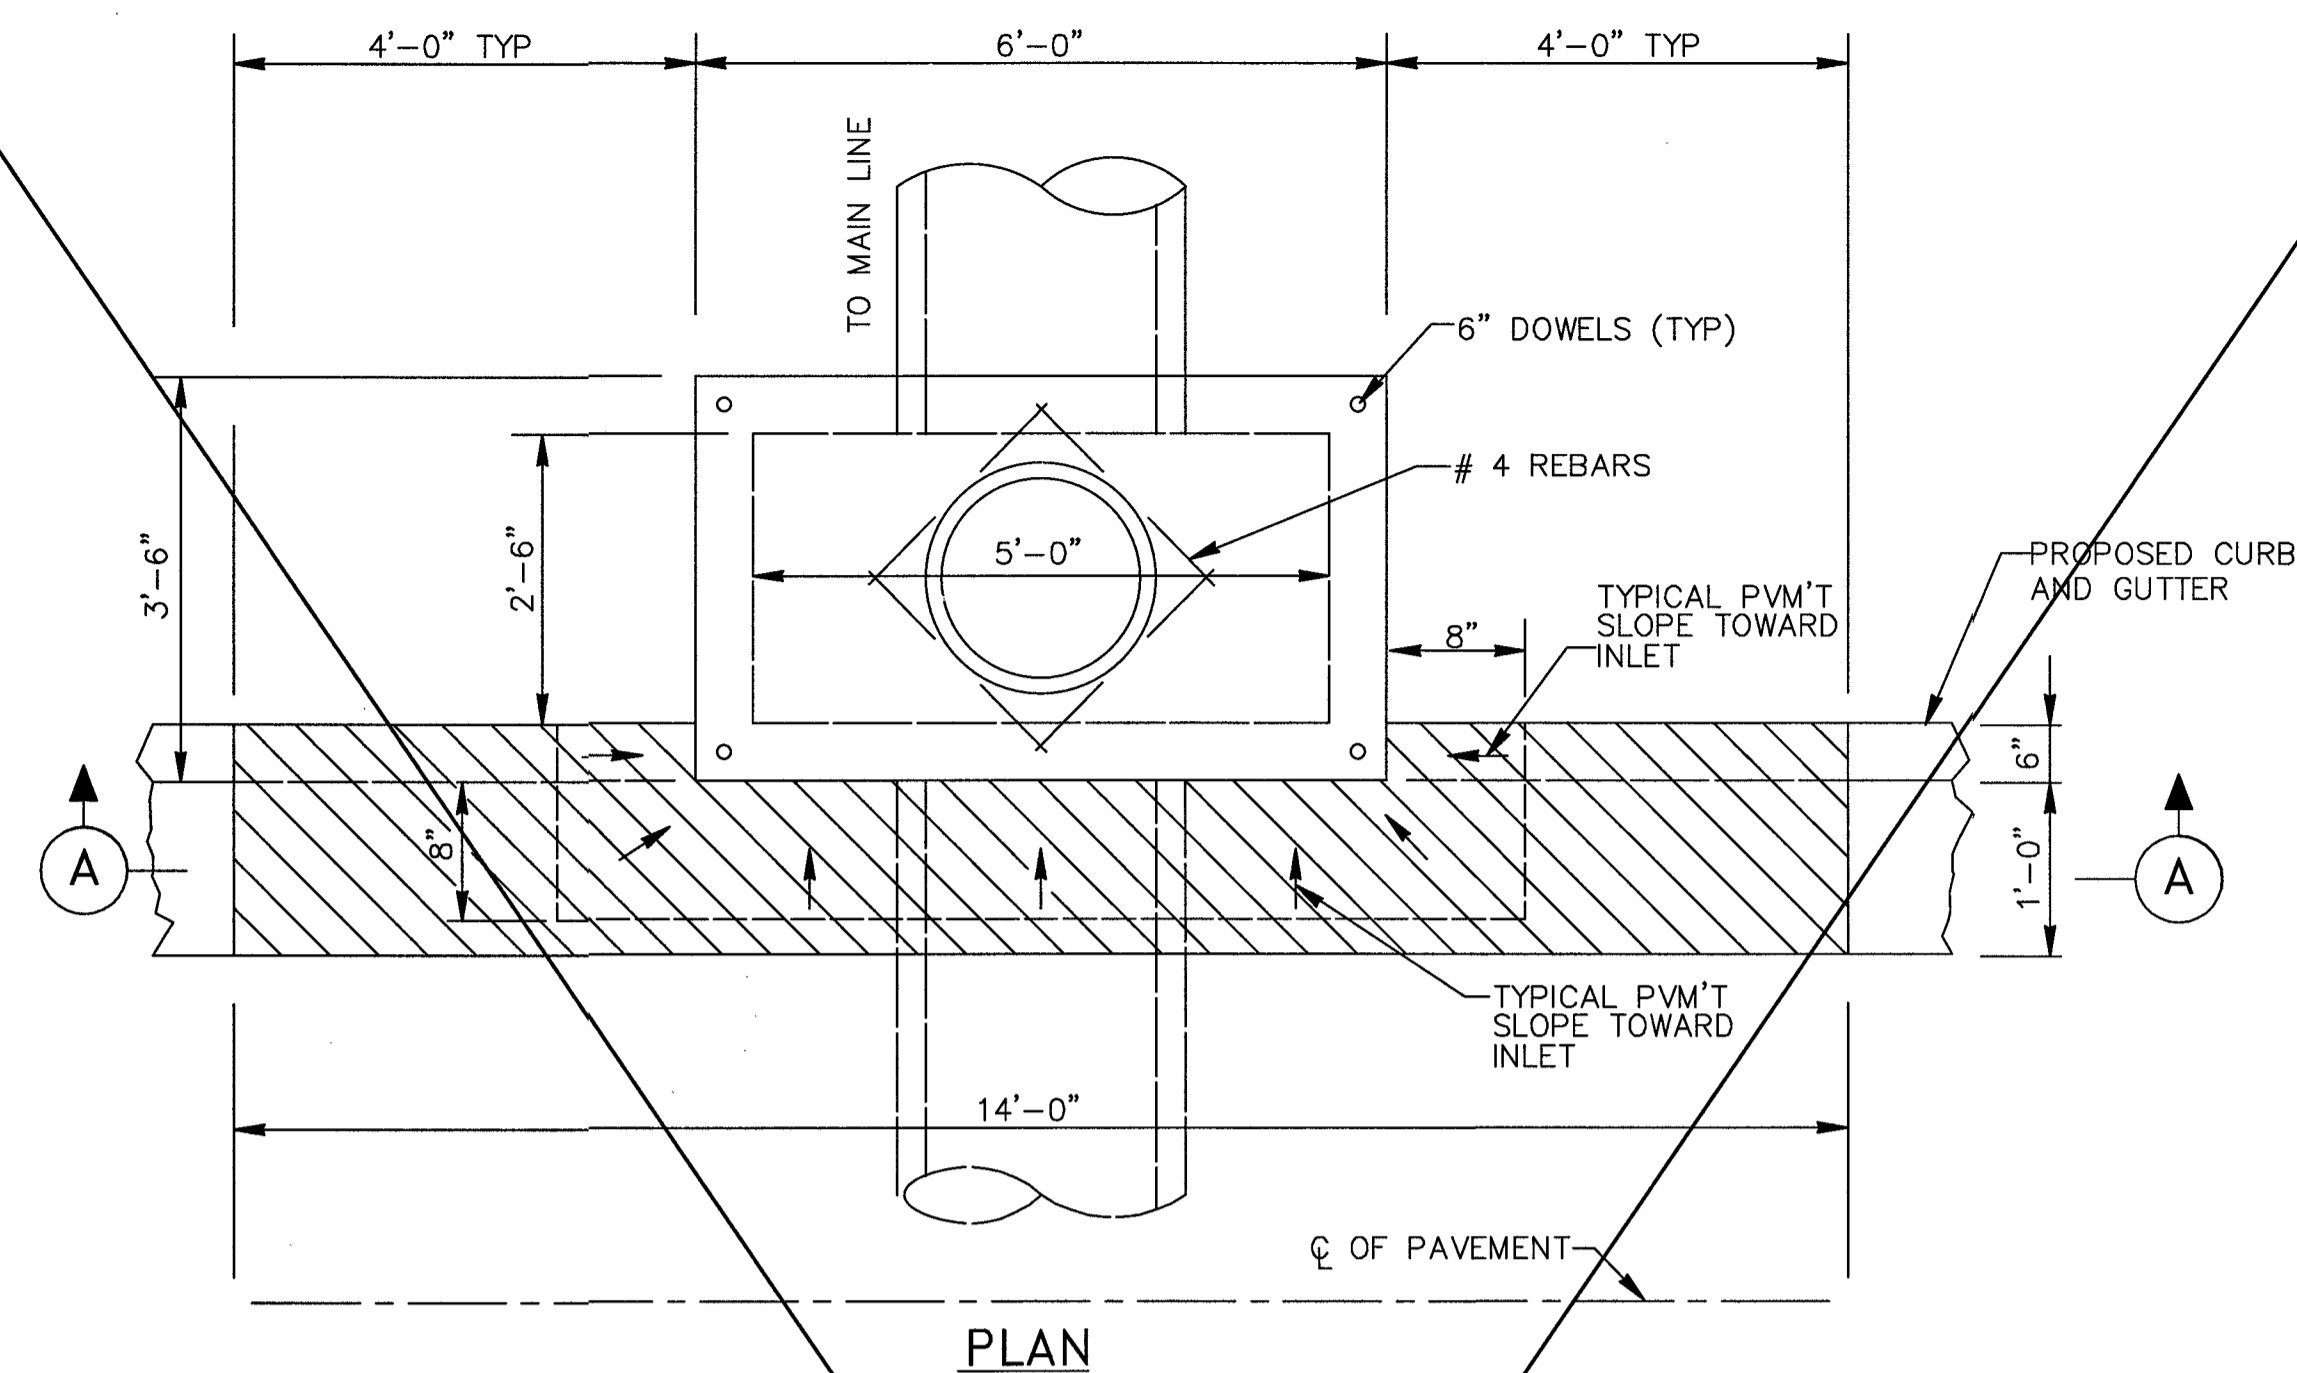


TYPE "H-2" INLET

SL-DR-25

- NOTES:**
1. INLET WALLS MAY BE EXTENDED USING PRECAST RISER SECTION.
 2. INLET TOPS MUST BE SECURED TO THE INLET WALL USING #6 DOWELS DRILLED AND GROUTED A MINIMUM DEPTH OF 5" INTO THE INLET WALL. A PLAN PREPARED BY THE MANUFACTURER MUST BE SUBMITTED FOR APPROVAL PRIOR TO INSTALLATION. THE PLAN SHOULD DETAIL CONNECTIONS AND SEALING OF JOINTS.
 3. PRECAST INLET TOPS SHALL NOT UTILIZE MULTIPLE ONE-FOOT SECTIONS TO ACHIEVE GRADE.
 4. INLET BACKFILL SHALL BE CEMENT STABILIZED SAND TO THE TOP OF THE INLET FIRST STAGE.
 5. GRADE 60 REINFORCEMENT. #4 STEEL REBAR TO CONFORM TO ASTM A615 ON REQUIRED CENTERS OR EQUAL.
 6. PRECAST INLET MUST BE CONSTRUCTED TO SPECIFICATIONS REQUIRED BY APPROVED DRAWINGS. (SEE GENERAL NOTES).
 7. TOPS POURED-IN-PLACE REQUIRE #4 REBAR @ 12" C-C EACH WAY, 4,500 PSI CONCRETE MINIMUM AND 3" THICK MINIMUM.
 8. PAVEMENT DEPTH AT INLET SHALL BE EQUAL TO OR GREATER THAN REQUIRED PAVEMENT DEPTH.
 9. DEPRESS GUTTER TO INLET.
 10. ALL SIDES OF ALL INLETS MUST BE COMPACTED.
 11. REFER TO GEOTECHNICAL REPORTS FOR RECOMMENDED TRENCH SIDE SLOPES.

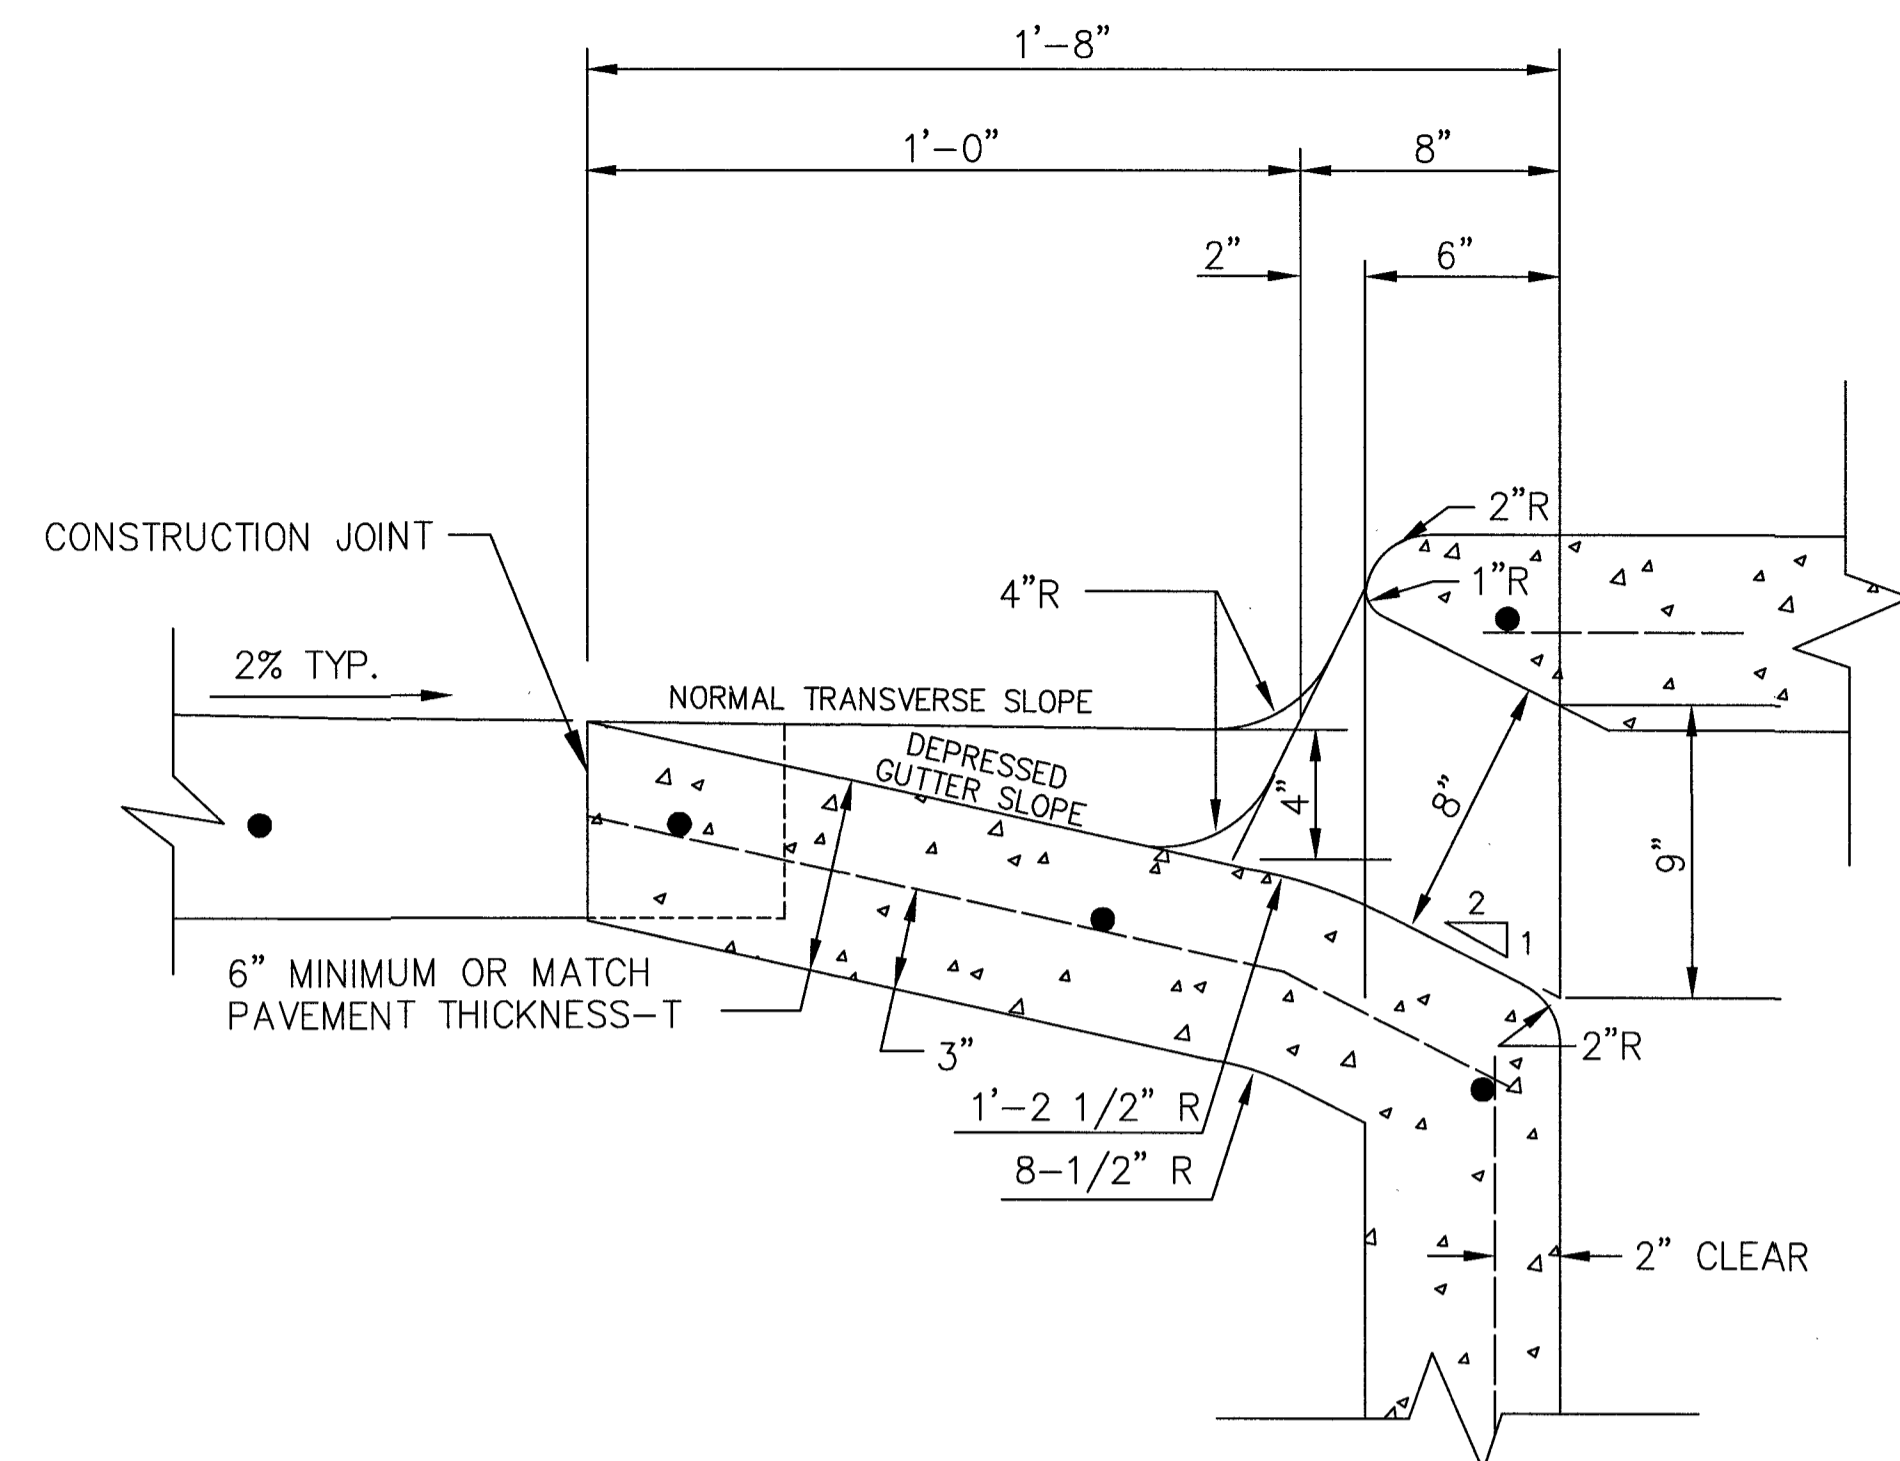

SL-DR-40

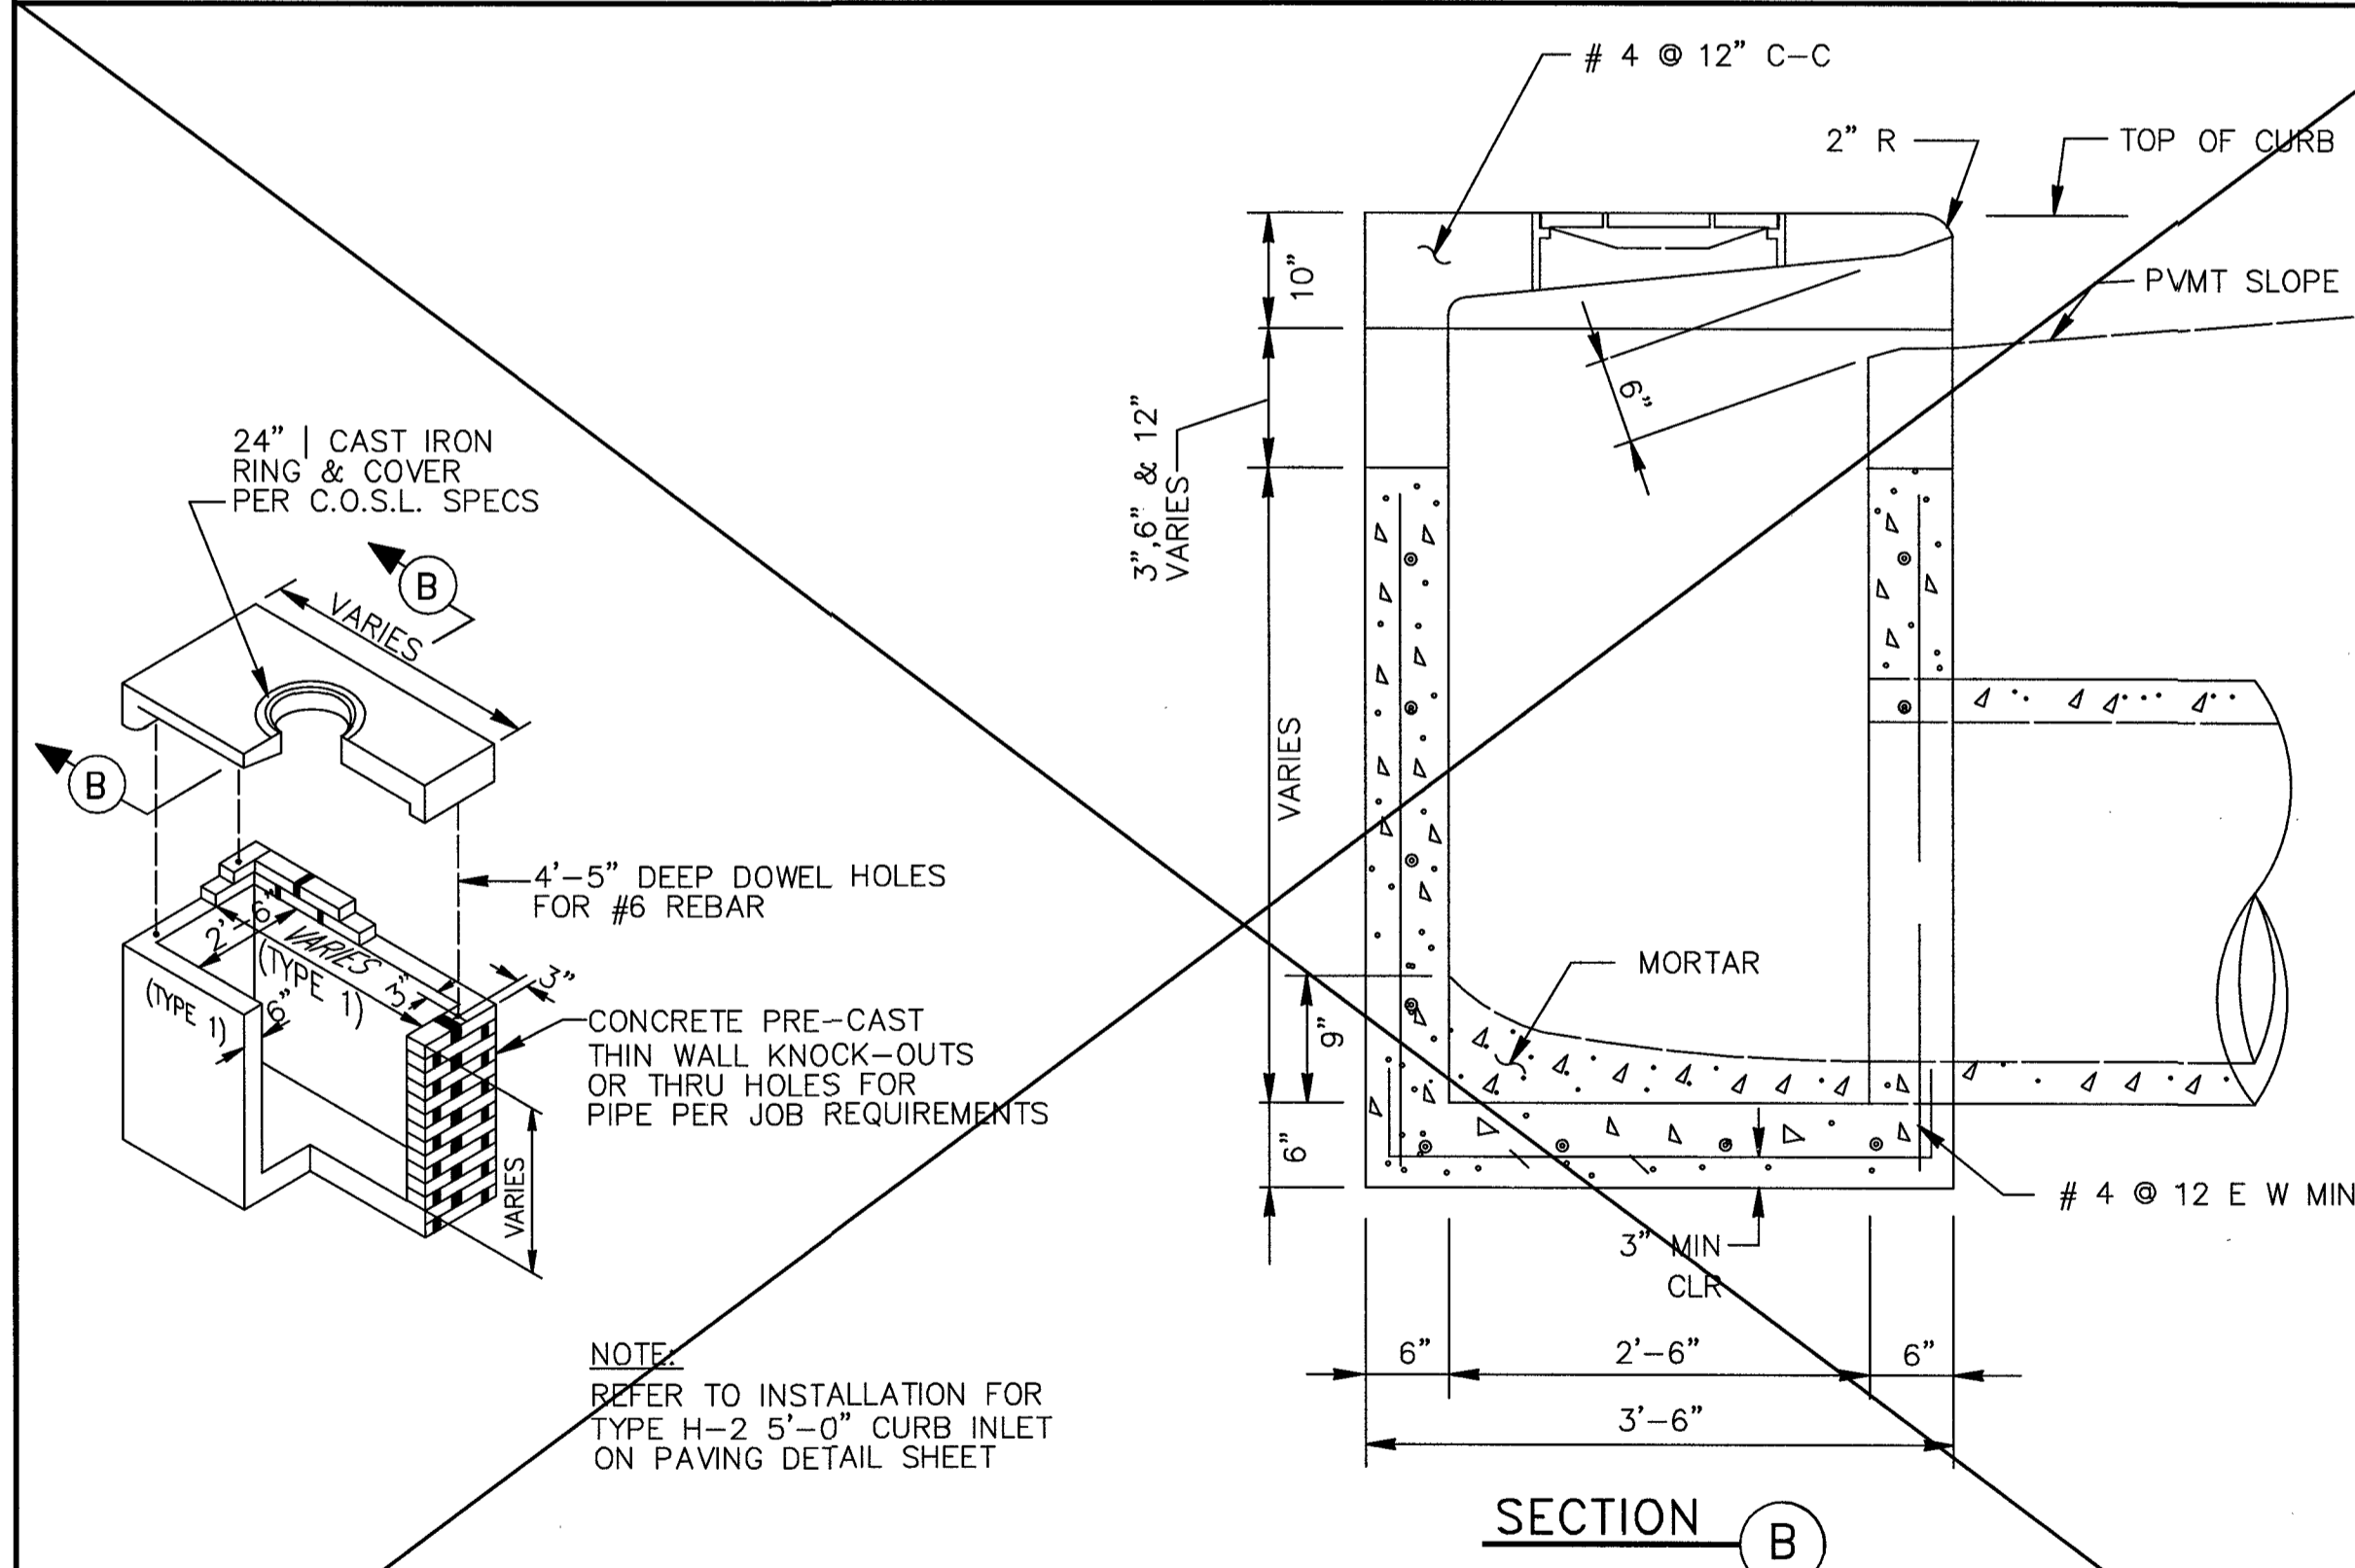

TYPE "H-2" PRECAST INLET

N.T.S.

SL-DR-26

REFER TO:

1. GENERAL NOTES
2. SEE C.S.S., PAVEMENT NOTES

No.	DATE	REVISION

SEAL:

DESIGN ENGINEER:



CITY OF SUGAR LAND, TEXAS
ENGINEERING DEPARTMENT

CONSTRUCTION PLANS FOR:

STORM SEWER INLET CONSTRUCTION DETAILS II

No.:	
------	--

JOB No.:
DATE:
DESIGNED BY:
DRAWN BY:
CHECKED BY:
SCALE:

SL-08

SHEET OF

RECORD DRAWING



NO.	DATE	DESCRIPTION	APPROVED
REVISIONS			

DESIGNED DR

DRAWN BT

CHECKED

DATE _____

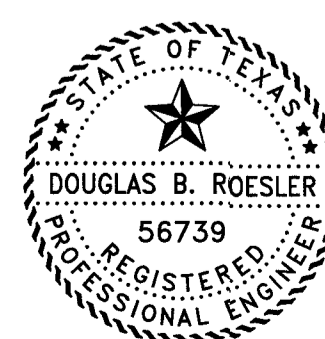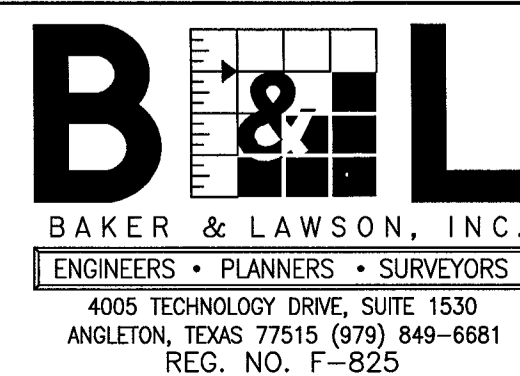

The seal appearing on
this document was
authorized by
Douglas B. Roesler

Date: 04-18-22

OWNER:

**RIVERWAY PROPERTIES
6115 SKYLINE DR. STE A.
HOUSTON, TEXAS 77057**

PLAN:

PROFILE:

HORIZONTAL:


VERTICAL:

RIVERWOOD RANCH SUBDIVISION
SECTION 2
A 78 AC, 109-LOT SUBDIVISION
ANGLETON, TEXAS 77515

STORM SEWER INLET
CONSTRUCTION DETAILS II
SL-08

PROJECT NO. 14395

29

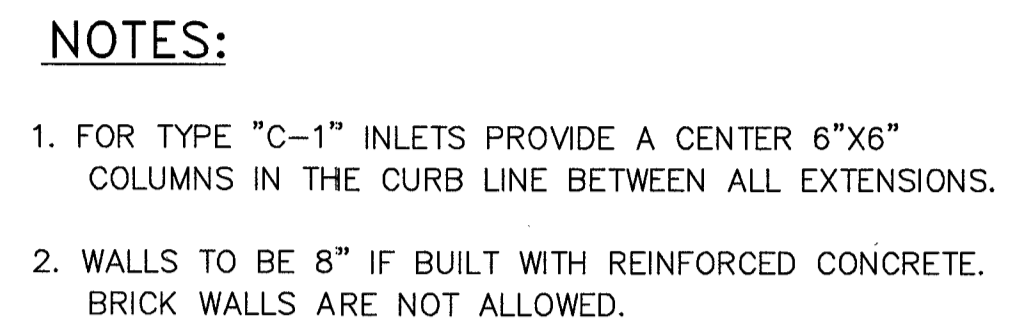

N.T.S.

SL-DR-28



REFER TO:


1. GENERAL NOTES
2. STORM SEWER NOTES

RECORD DRAWING

NO.	DATE	DESCRIPTION	APPROVED
REVISIONS			

DESIGNED _____ DR _____
DRAWN _____ BT _____
CHECKED _____
DATE _____

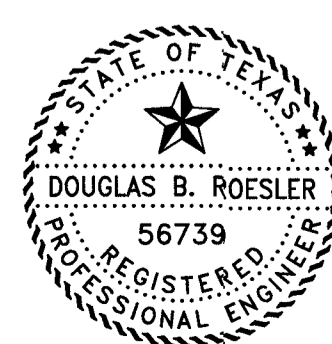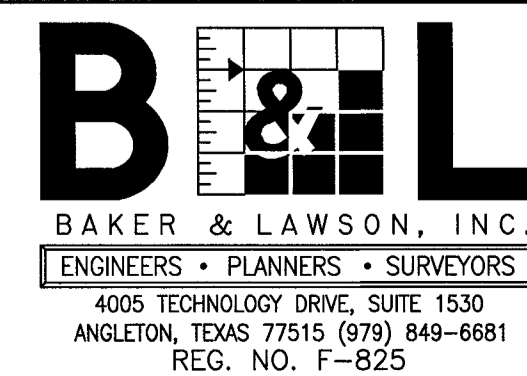

The seal appearing on
this document was
authorized by
Douglas B. Roesler
P.E. 56739

Date: 04-18-22

OWNER:

**RIVERWAY PROPERTIES
6115 SKYLINE DR. STE A.
HOUSTON, TEXAS 77057**

PLAN: _____

PROFILE: _____

HORIZONTAL: _____



VERTICAL: _____

RIVERWOOD RANCH SUBDIVISION
SECTION 2
A 78 AC, 109-LOT SUBDIVISION
ANGLETON, TEXAS 77515

STORM SEWER INLET
CONSTRUCTION DETAILS II
SL-09

PROJECT NO. 14395

30 | 470E

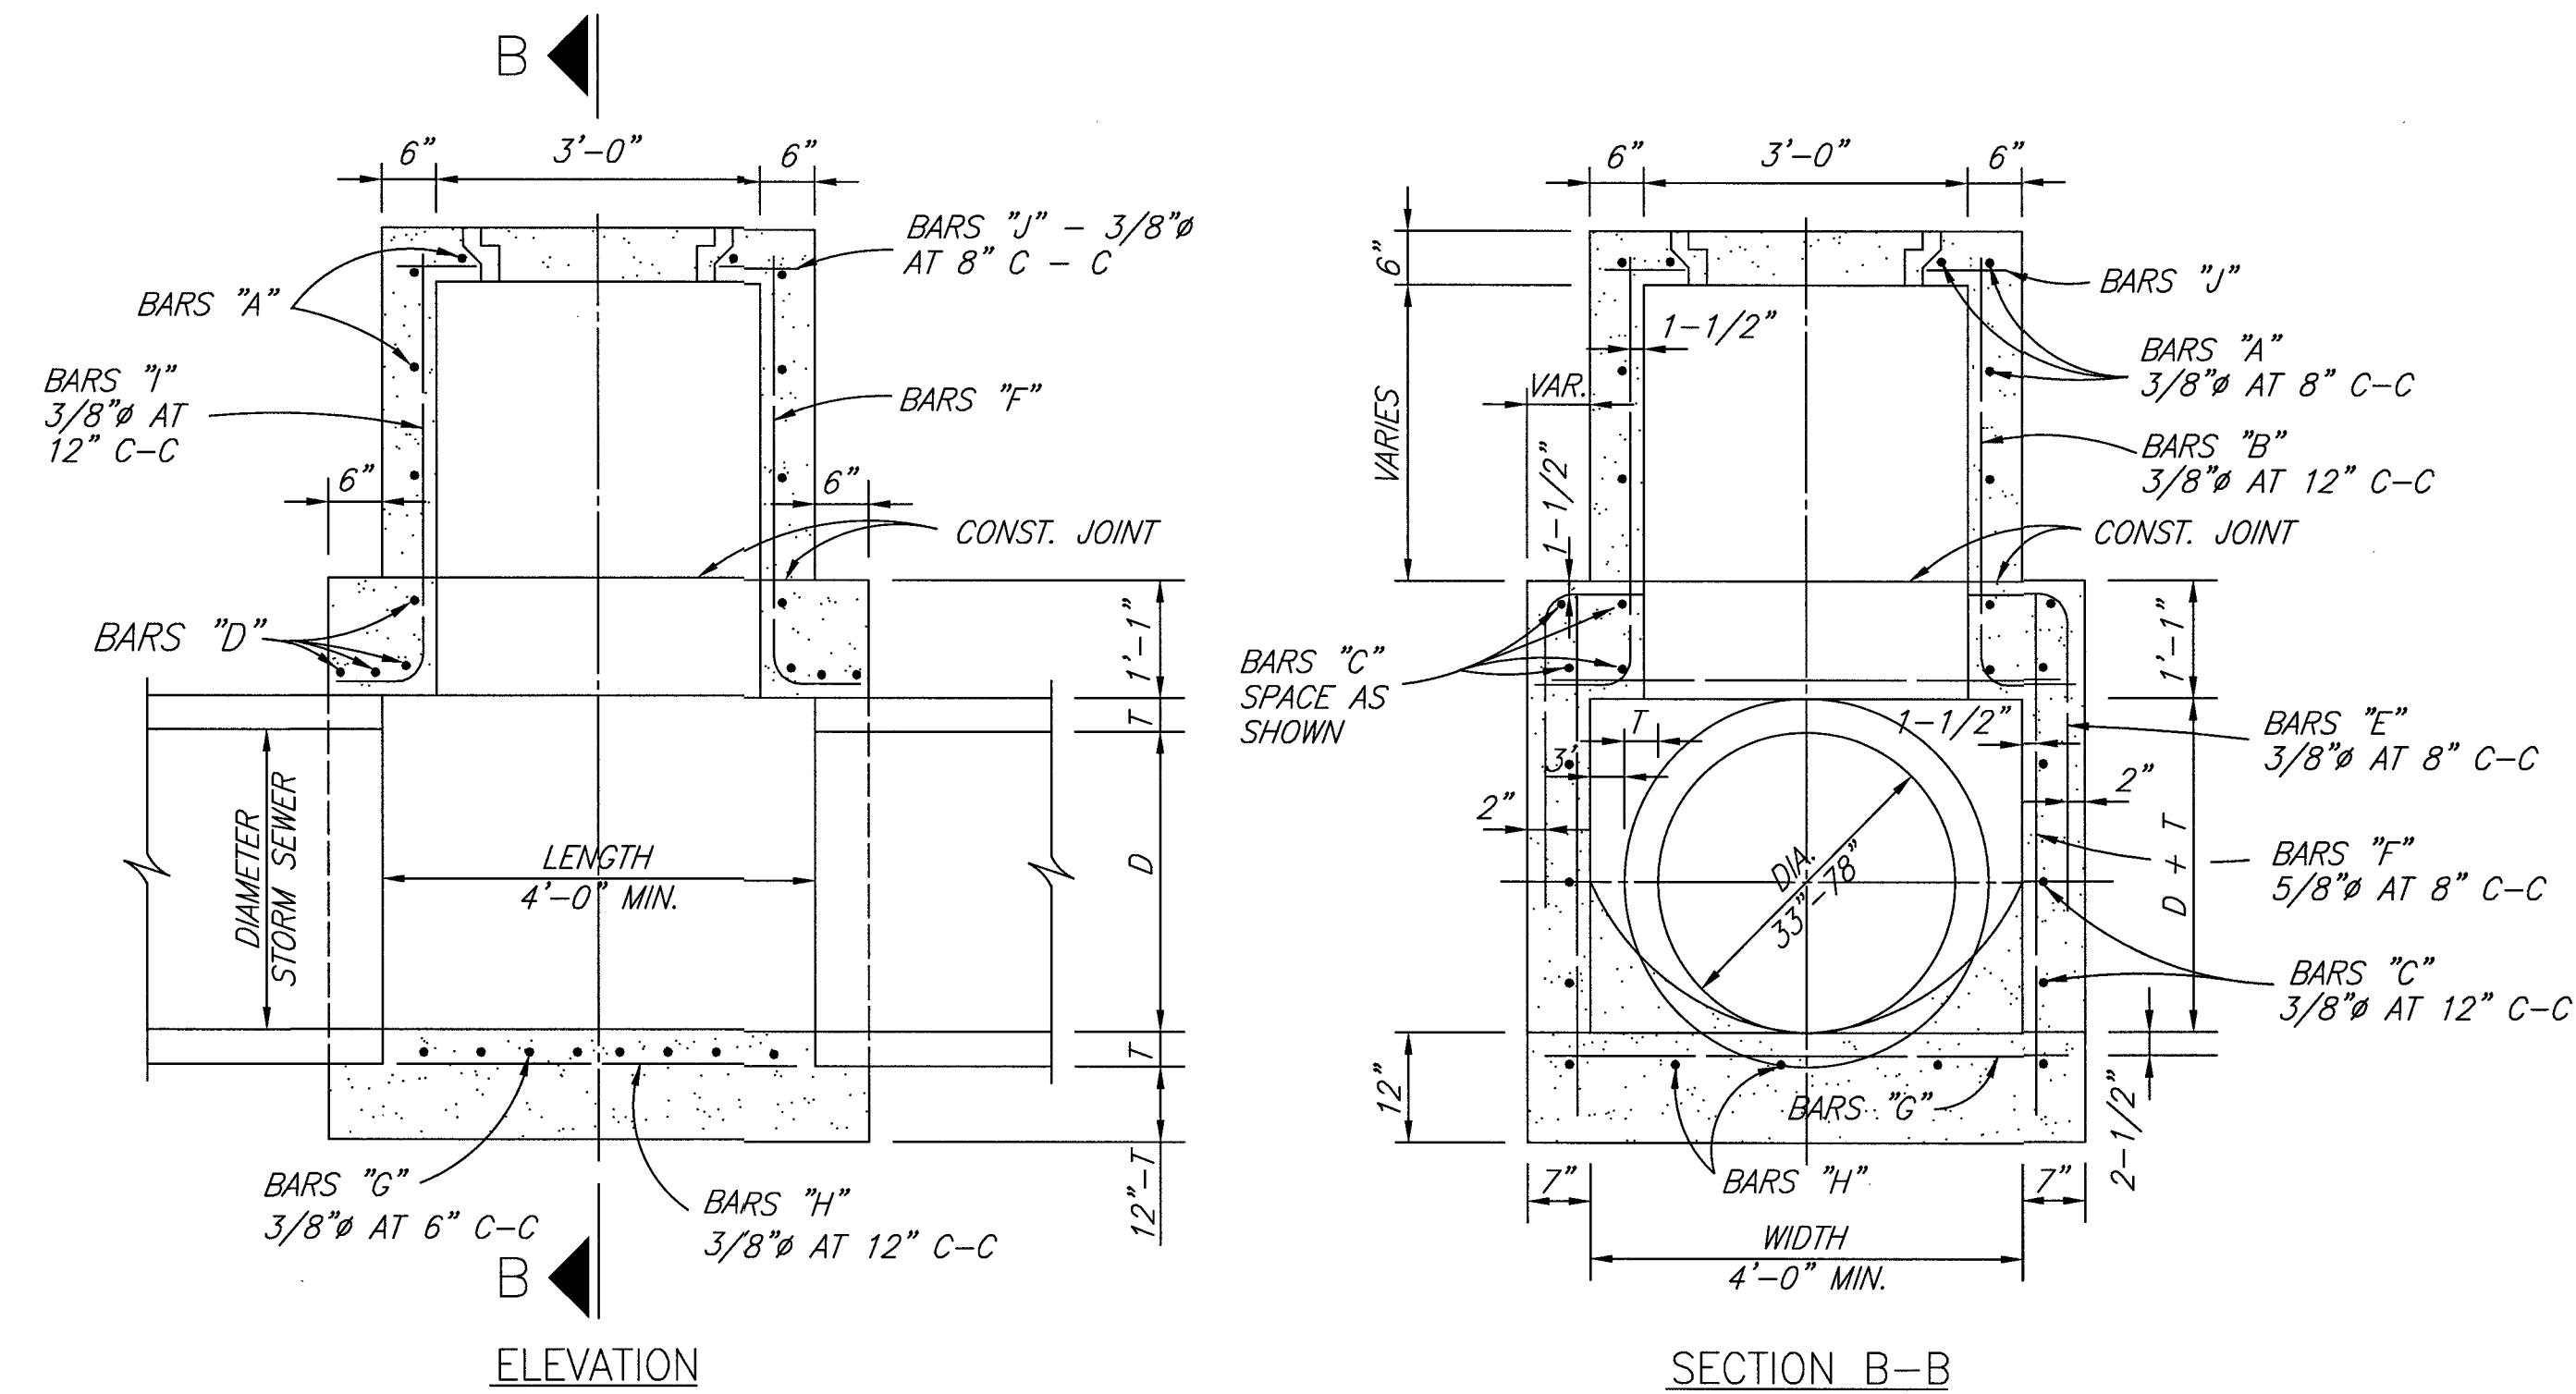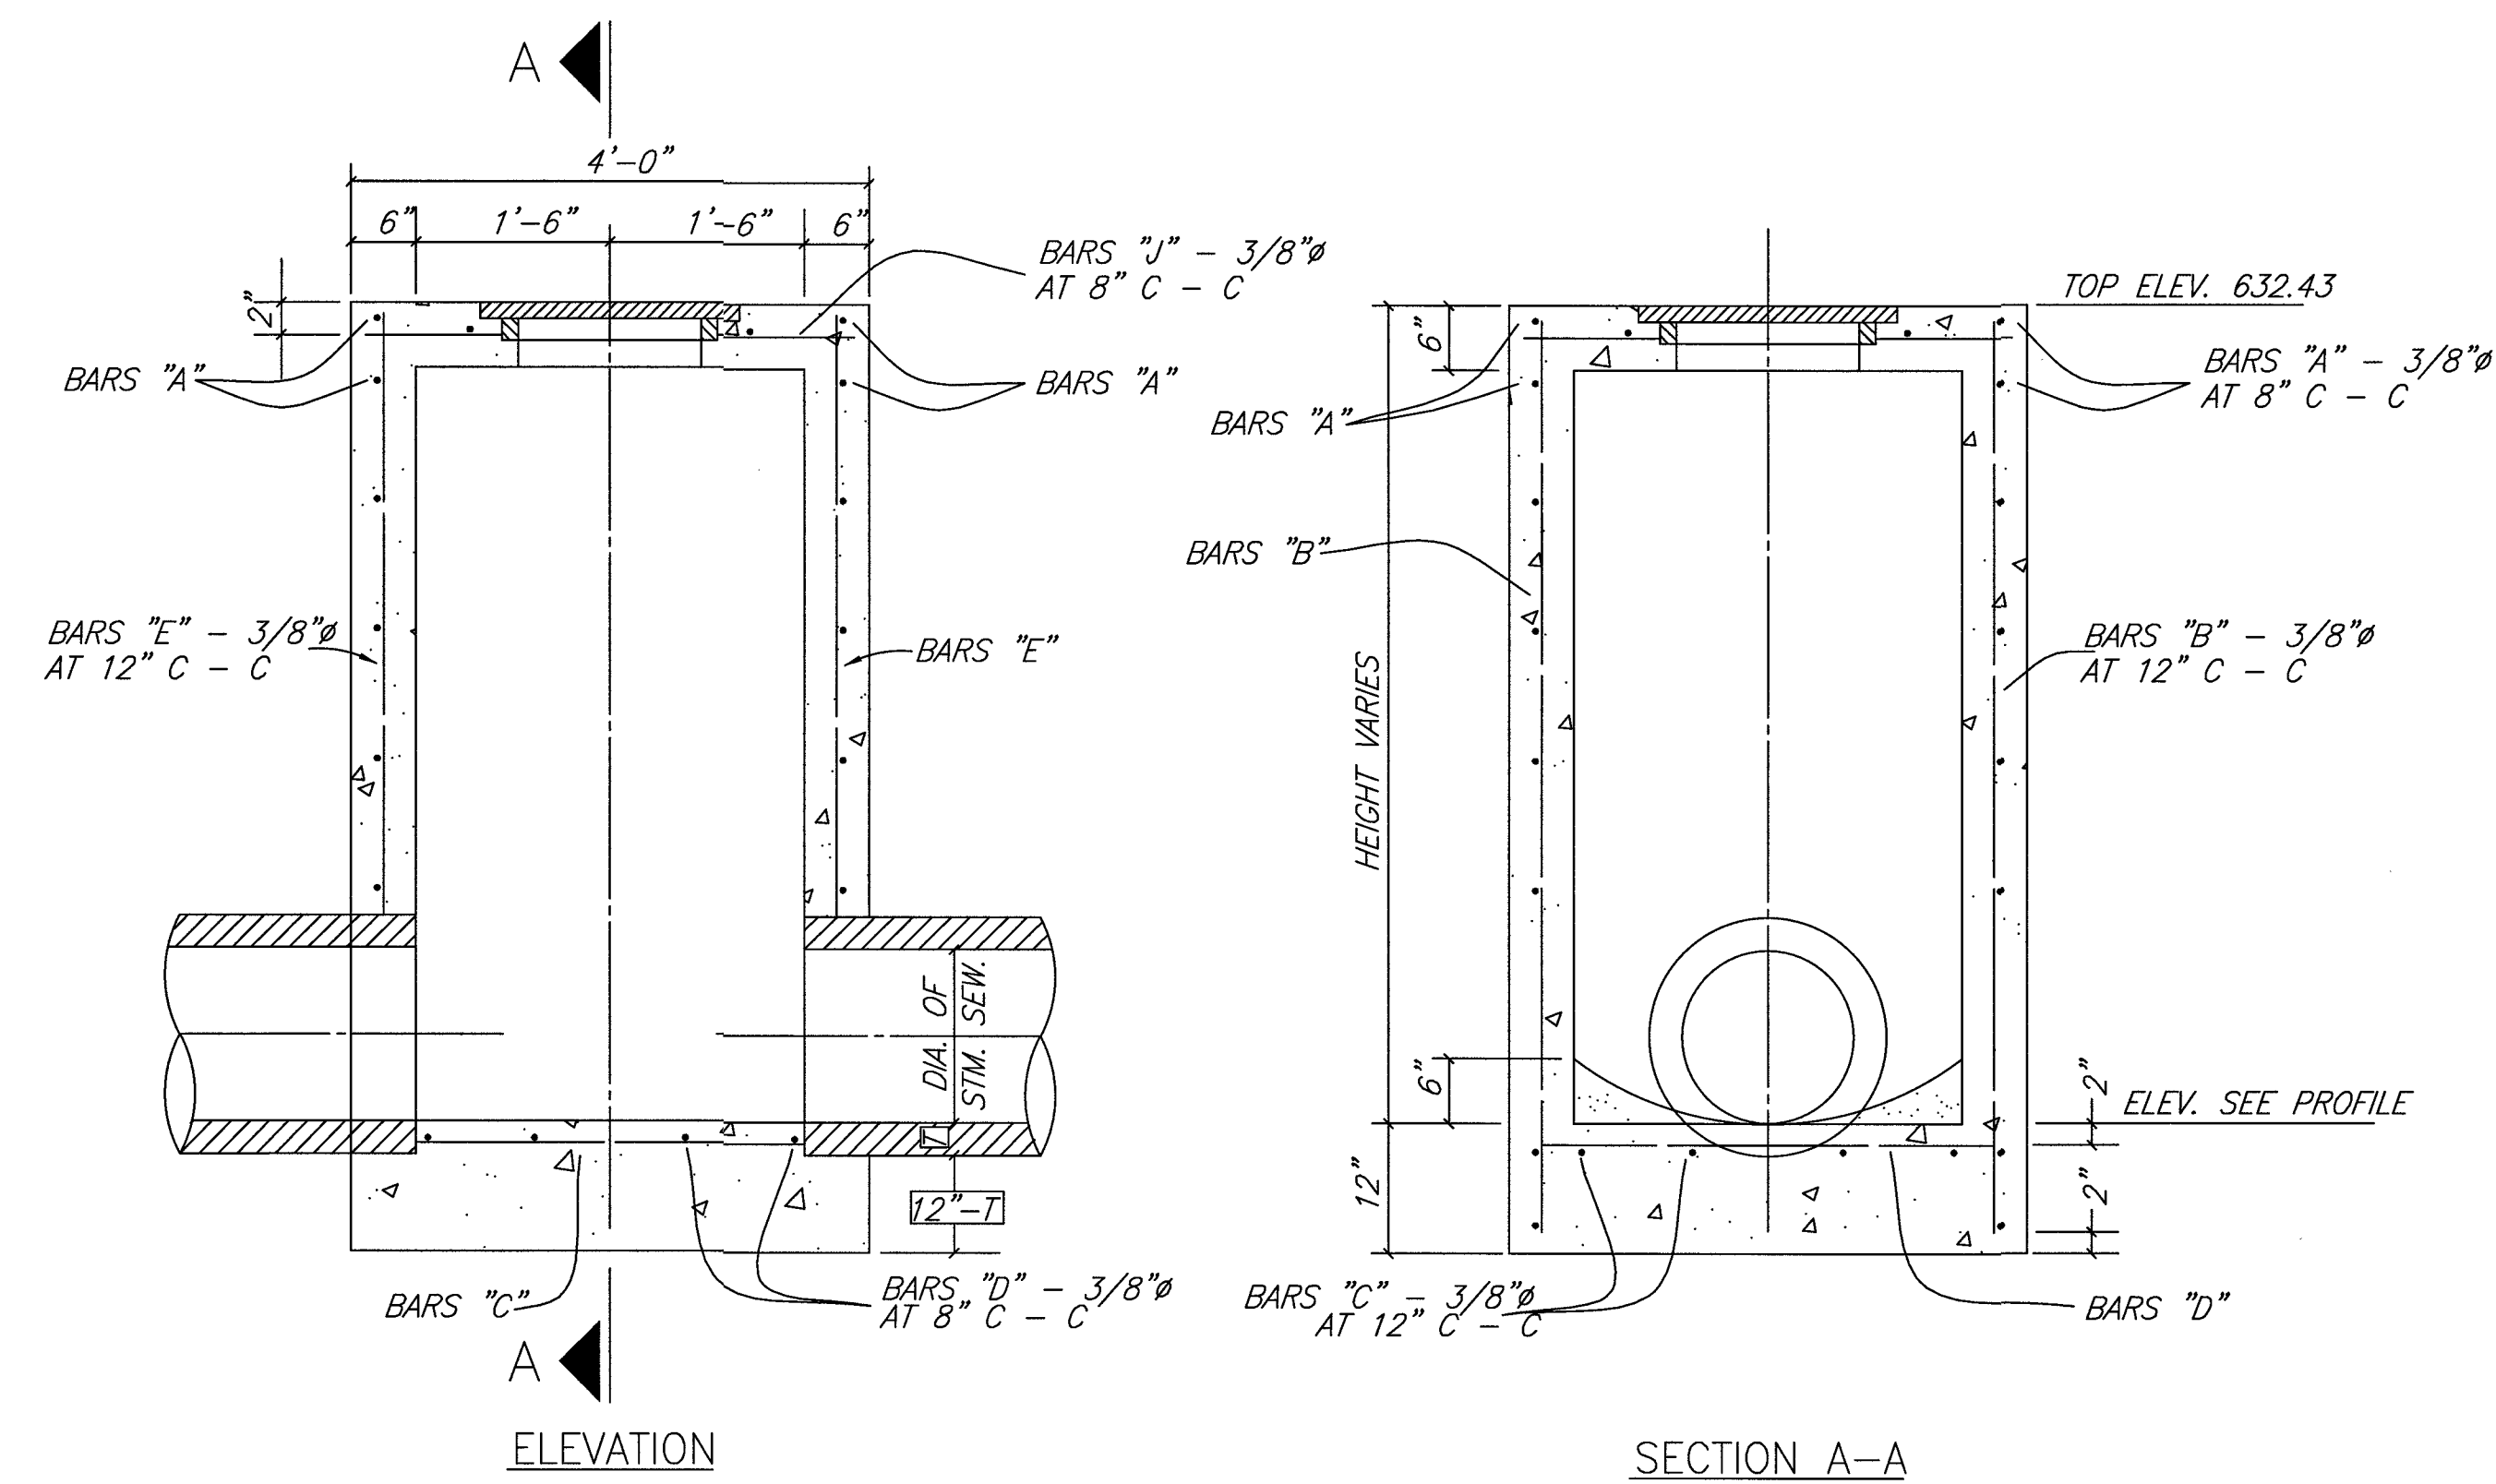


NO.	DATE	DESCRIPTION	APPROVAL
REVISIONS			

DESIGNED	DR
DRAWN	BT
CHECKED	
DATE	

B & L
BAKER & LAWSON, INC.
ENGINEERS • PLANNERS • SURVEYORS
4005 TECHNOLOGY DRIVE, SUITE 1530
ANGLETON, TEXAS 77515 (979) 849-6681
REG. NO. F-825

The seal appearing on
this document was
authorized by
Douglas B. Roesler
P.E. 56739



Date: 04-18-22

OWNER:
RIVERWAY PROPERTIES
6115 SKYLINE DR. STE A.
HOUSTON, TEXAS 77057

PLAN: _____



PROFILE: _____

HORIZONTAL: _____



VERTICAL: _____

**RIVERWOOD RANCH SUBDIVISION
SECTION 2
A 78 AC, 109-LOT SUBDIVISION
ANGLETON, TEXAS 77515**

PROJECT NO. 14395


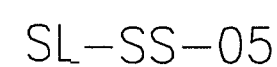
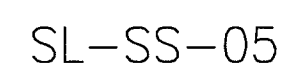


- SL-SS-03





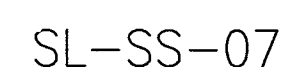
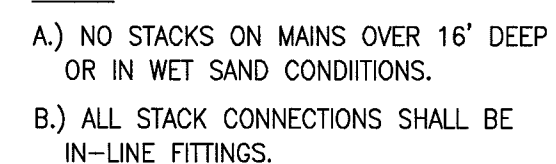


RECORD DRAWING

PROJECT NO. 14395

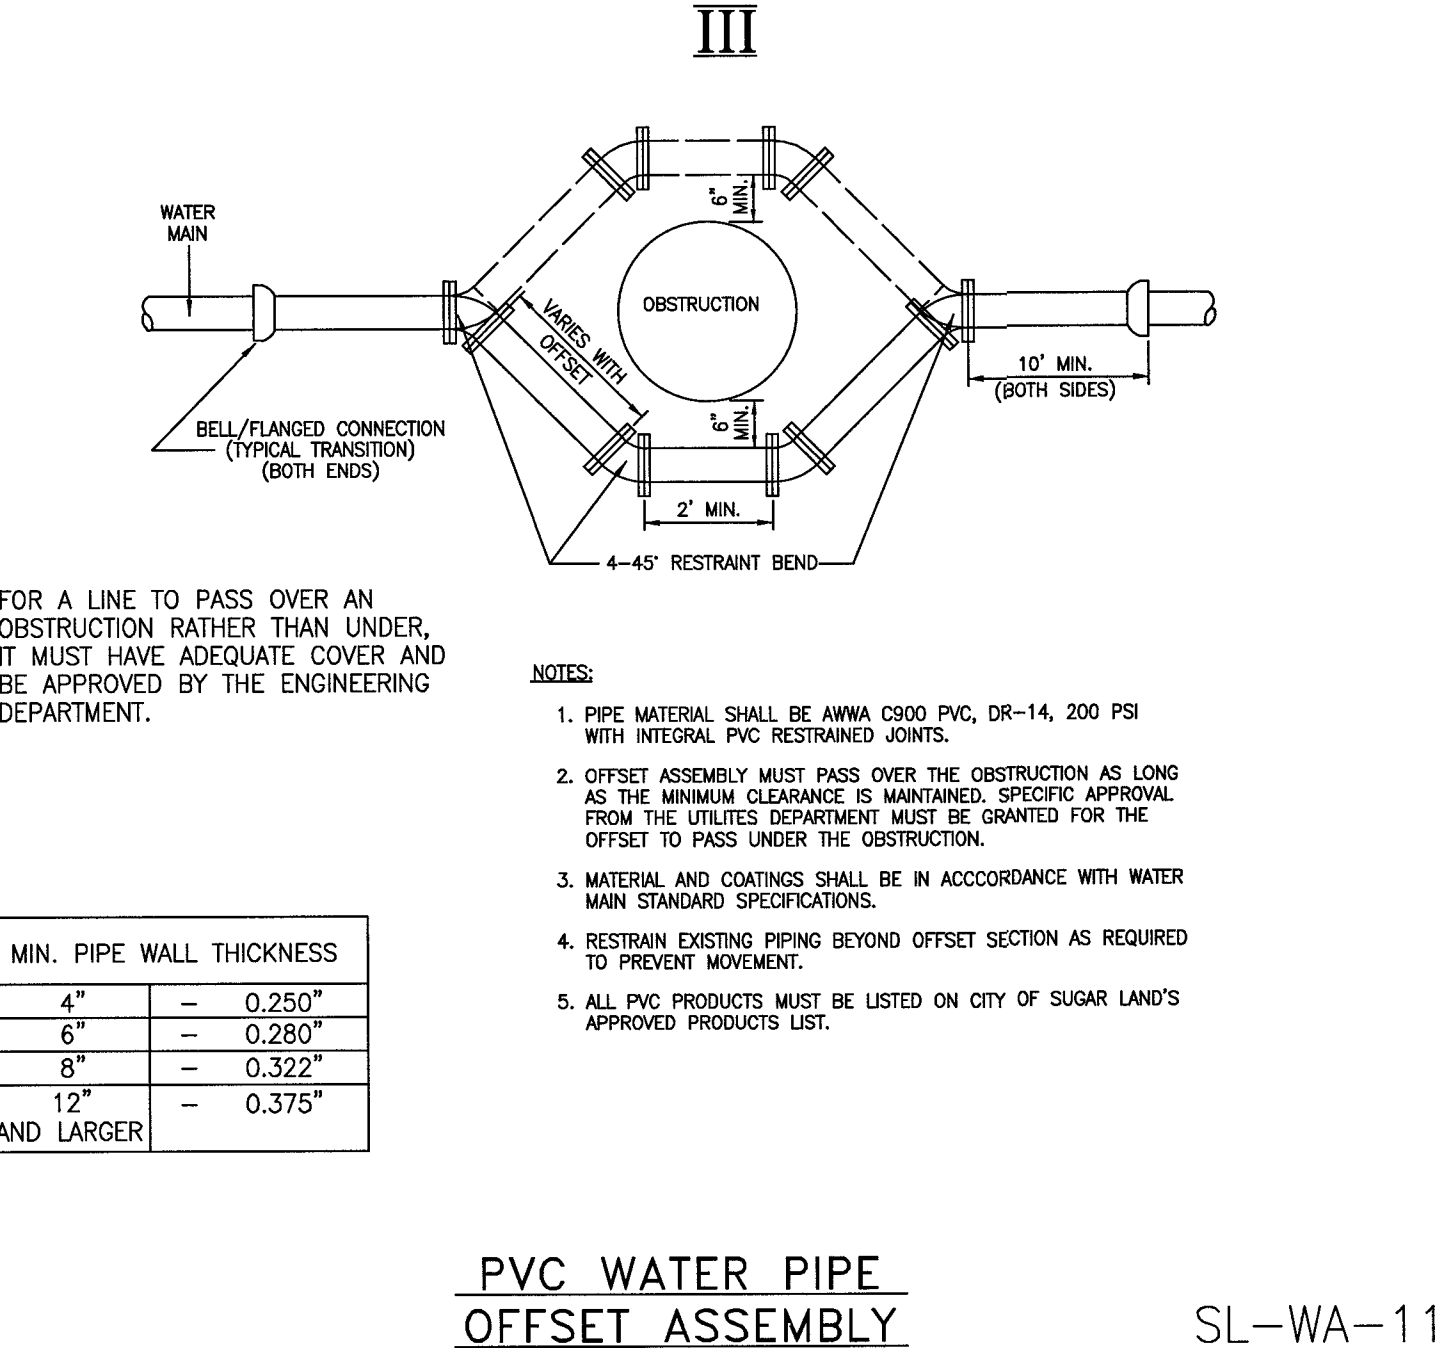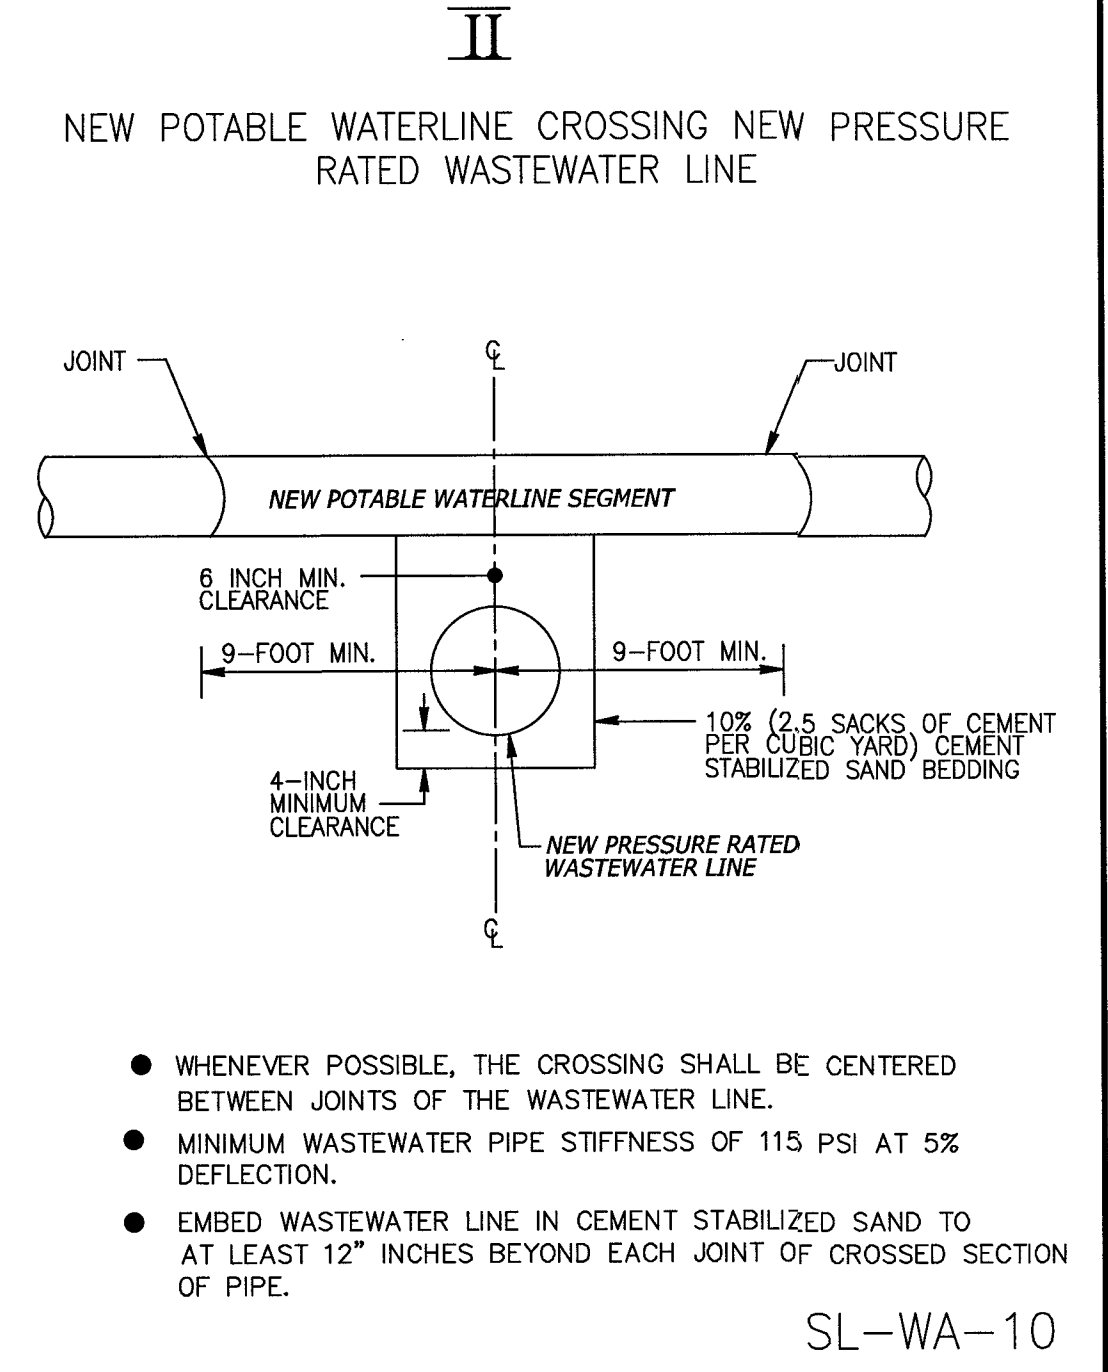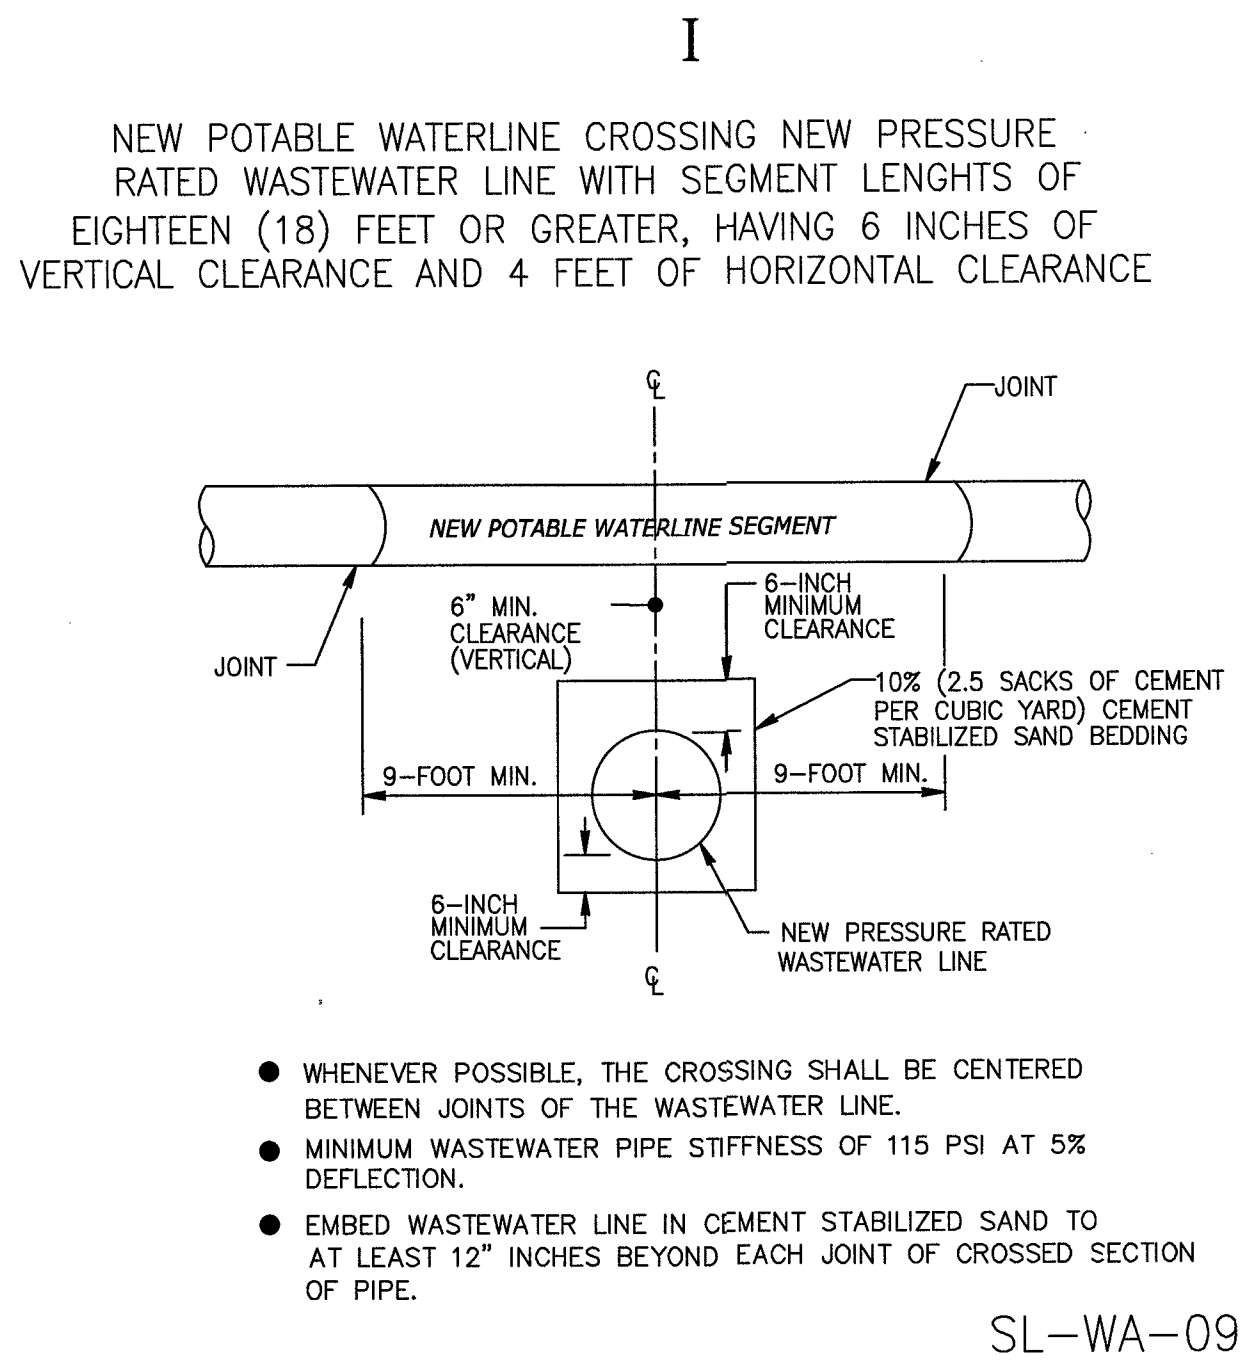

- GENERAL NOTES:
- CONTRACTOR SHALL CONTACT CITY OF SUGAR LAND ENGINEERING DEPARTMENT AT (281) 275-2780 IF WET SAND OR OTHER UNSTABLE SOIL CONDITIONS, HIGH WATER TABLE AND/OR UNDERGROUND OBSTRUCTIONS ARE ENCOUNTERED.
 - SHOULD A CONFLICT ARISE BETWEEN INFORMATION DEPICTED ON APPROVED CONSTRUCTION DRAWINGS AND INFORMATION INCLUDED IN PROJECT SPECIFICATIONS, CITY OF SUGAR LAND DESIGN STANDARDS SHALL GOVERN.
 - ALL NEW POTABLE WATER LINES AND SANITARY SEWER FORCE MAINS SHALL BE BEDDED IN COMPACTED BANK SAND A MINIMUM OF 6 INCHES BELOW, ABOVE AND TO EITHER SIDE OF SUCH PIPING.
 - ALL NEW SANITARY SEWER GRAVITY DRAIN LINES SHALL BE BEDDED IN CEMENT STABILIZED SAND CONFORMING TO THE REQUIREMENTS FOR EITHER CLASS "A" STANDARD BEDDING OR CLASS "A-A" BEDDING AS APPLICABLE. USE OF MODIFIED "A" OR MODIFIED "A-A" BEDDING FOR SANITARY SEWER INSTALLATIONS WHERE WET SAND CONDITIONS ARE ENCOUNTERED AND SEPARATION DISTANCE TO POTABLE WATER LINES IS LESS THAN 9 FEET REQUIRES APPROVAL BY CITY ENGINEER.
 - CEMENT STABILIZED BEDDING SHALL BE A MINIMUM 1.5 SACK PER CUBIC YARD C.S.S., INSTALLED IN MAXIMUM LIFTS OF 8 INCHES AND MECHANICALLY TAMPED TO 95% PROCTOR.
 - WHERE REQUIRED, SLEEVING (ENCASEMENT) OF POTABLE WATER PIPING AND/OR SANITARY SEWER GRAVITY DRAIN LINES AND FORCE MAINS SHALL BE PROVIDED. SUCH SLEEVING (ENCASEMENT) SHALL BE CONSTRUCTED OF APPROVED PIPING MATERIALS HAVING A MINIMUM PRESSURE RATING OF 150 PSI AND ANNULAR SPACES AT EACH END SHALL BE SEALED WITH A MATERIAL APPROVED FOR SUCH USE.
 - ALL NEW POTABLE WATER LINES SHALL BE SLEEVED (ENCASED) WHERE A MINIMUM OF 9 FEET SEPARATION DISTANCE TO EXISTING OR PROPOSED SANITARY SEWER MANHOLE, LIFT STATION OR WASTEWATER TREATMENT PLANT CANNOT BE MAINTAINED. SLEEVING SHALL BE A MINIMUM OF 18 FEET IN LENGTH AND CENTERED ON THE POINT OF CLOSEST PROXIMITY.
 - ALL NEW POTABLE WATER LINES SHALL BE SLEEVED (ENCASED) WHERE LESS THAN 2 FEET VERTICAL OR 4 FEET HORIZONTAL CLEARANCE TO EXISTING OR PROPOSED SANITARY SEWER GRAVITY LINES OR FORCE MAINS CANNOT BE MAINTAINED. SLEEVING SHALL BE A MINIMUM OF 18 FEET IN LENGTH AND CENTERED ON THE POINT OF CROSSING. WHERE PIPING IS LAID PARALLEL AND MINIMUM SEPARATION DISTANCES CANNOT BE MAINTAINED, SLEEVING SHALL EXTEND AT LEAST 9 FEET PAST THE POINT WHERE MINIMUM SEPARATION DISTANCES ARE ACHIEVED.
 - ALL NEW POTABLE WATER LINES SHALL BE CONSTRUCTED ABOVE EXISTING OR PROPOSED SANITARY SEWER GRAVITY LINES OR FORCE MAINS WHERE POSSIBLE. WHERE INSTALLATION OF SANITARY SEWER GRAVITY LINES OR FORCE MAINS IS UNAVOIDABLE AT POINTS OF CROSSING, SLEEVING (ENCASEMENT) IS REQUIRED FOR ALL NEW POTABLE WATER LINES CONSTRUCTED OF PVC PIPING MATERIALS, REGARDLESS OF SEPARATION DISTANCE. SLEEVING SHALL BE A MINIMUM OF 18 FEET IN LENGTH AND CENTERED ON THE POINT OF CROSSING.
 - ALL NEW SANITARY SEWER GRAVITY LINES AND/OR FORCE MAINS CONSTRUCTED OF PVC PIPING MATERIALS SHALL BE SLEEVED (ENCASED) WHERE LESS THAN 2 FEET VERTICAL OR 4 FEET HORIZONTAL CLEARANCE TO EXISTING POTABLE WATER PIPING CANNOT BE MAINTAINED. SLEEVING SHALL BE A MINIMUM OF 18 FEET IN LENGTH AND CENTERED ON THE POINT OF CLOSEST PROXIMITY.
 - ALL NEW SANITARY SEWER GRAVITY LINES AND/OR FORCE MAINS SHALL BE CONSTRUCTED BELOW EXISTING POTABLE WATER LINES WHERE POSSIBLE. WHERE INSTALLATION OF POTABLE WATER LINES IS UNAVOIDABLE, SLEEVING (ENCASEMENT) IS REQUIRED FOR ALL SUCH SANITARY SEWER LINES CONSTRUCTED OF PVC PIPING MATERIALS, REGARDLESS OF SEPARATION DISTANCE. SLEEVING SHALL BE A MINIMUM OF 18 FEET IN LENGTH AND CENTERED ON THE POINT OF CROSSING.
 - WHERE NEW SANITARY SEWER SIZING (24 INCH AND GREATER) PRECLUDES THE USE OF PVC PIPING MATERIALS AND SLEEVING (ENCASEMENT) OF THE SANITARY SEWER WOULD OTHERWISE BE REQUIRED BUT IS IMPRACTICAL, THE EXISTING POTABLE WATER PIPING SHALL EITHER BE OFFSET TO PROVIDE THE REQUIRED MINIMUM CLEARANCES OR SLEEVED (ENCASED) IN LIEU OF SLEEVING (ENCASING) THE SANITARY SEWER LINE. SLEEVING SHALL BE A MINIMUM OF 18 FEET IN LENGTH AND CENTERED ON THE POINT OF CROSSING.
 - IN NO INSTANCE SHALL A FIRE HYDRANT BE INSTALLED WITHIN 9 LINEAR FEET OF A SANITARY SEWER SYSTEM.
 - NOTE: SEPARATION DISTANCES ARE MEASURED FROM THE OUTSIDE DIAMETERS OF EACH PIPE AND FROM THE EXTERIOR SURFACES OF MANHOLES, LIFT STATIONS, WASTEWATER TREATMENT PLANTS AND ASSOCIATED APPURTENANCES.
 - REFER TO GENERAL SANITARY, WATER AND C.S.S. NOTES.
- SL-WA-18

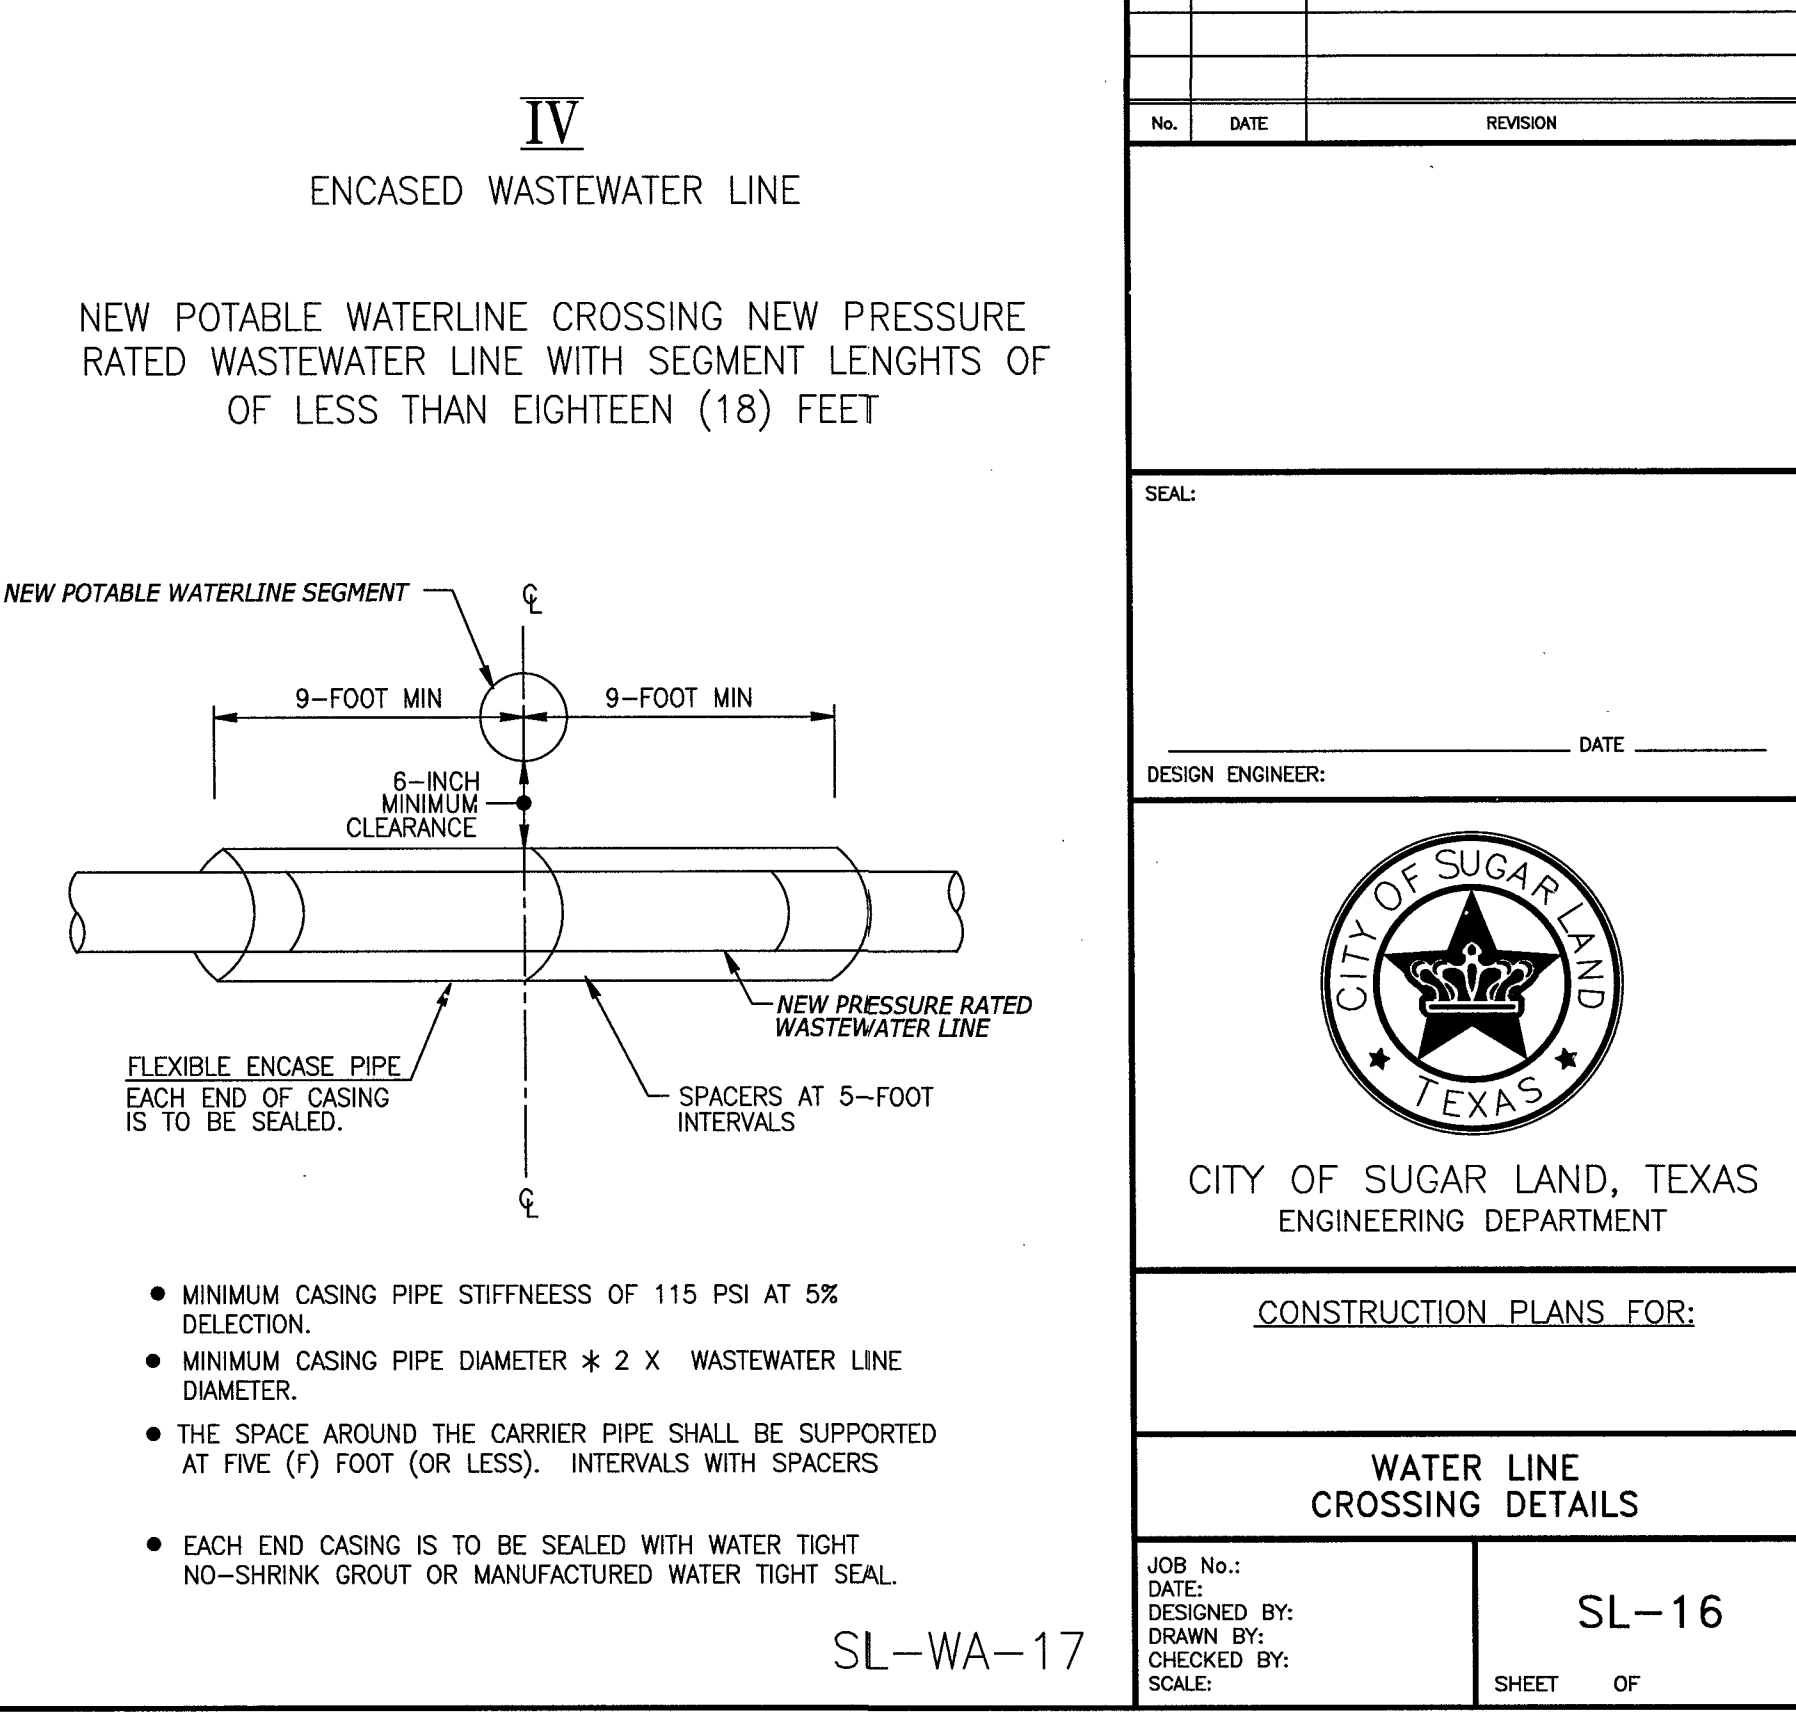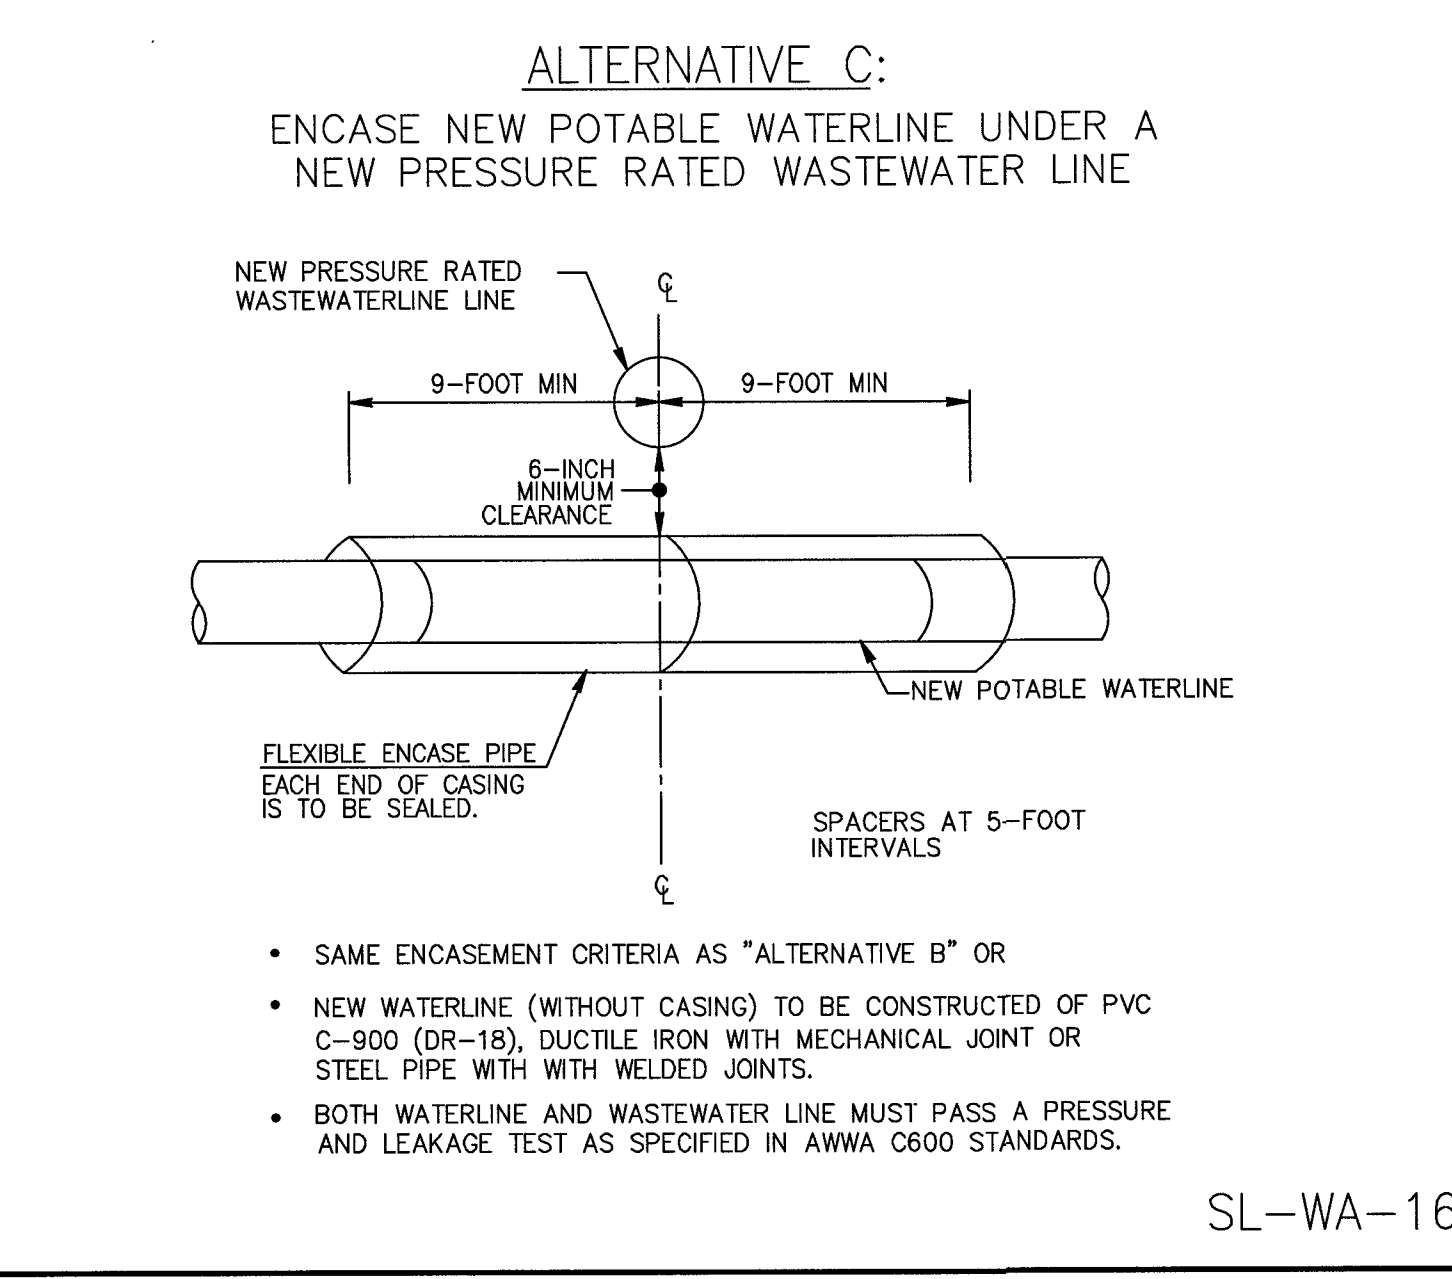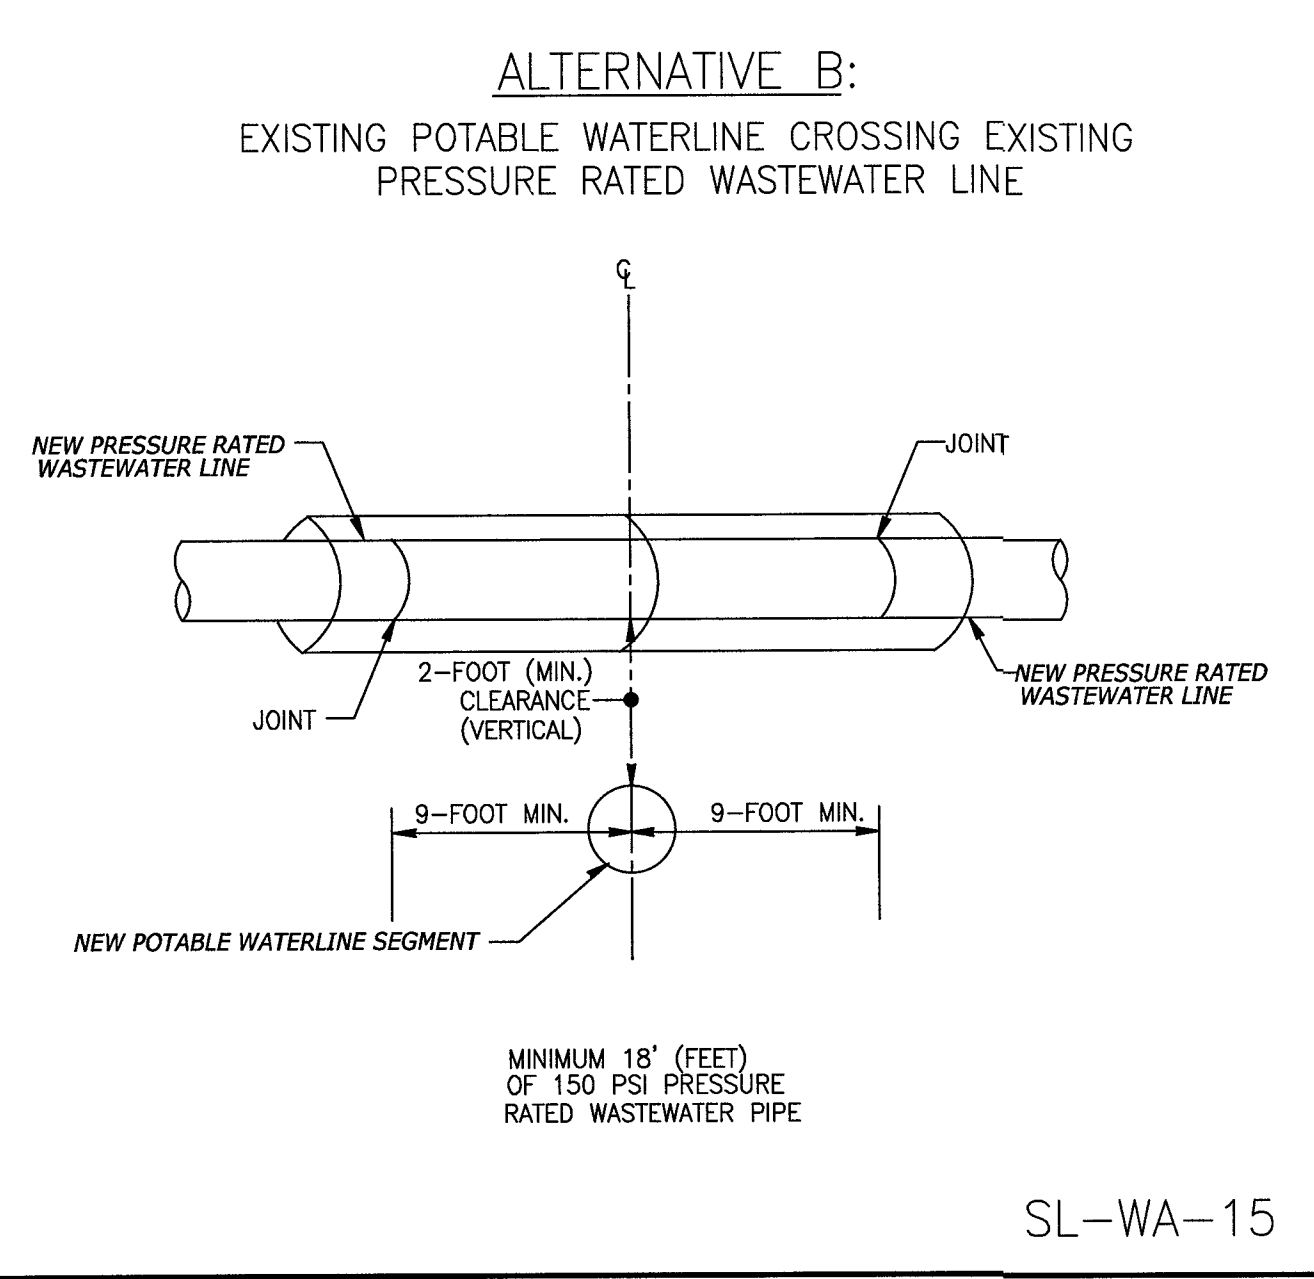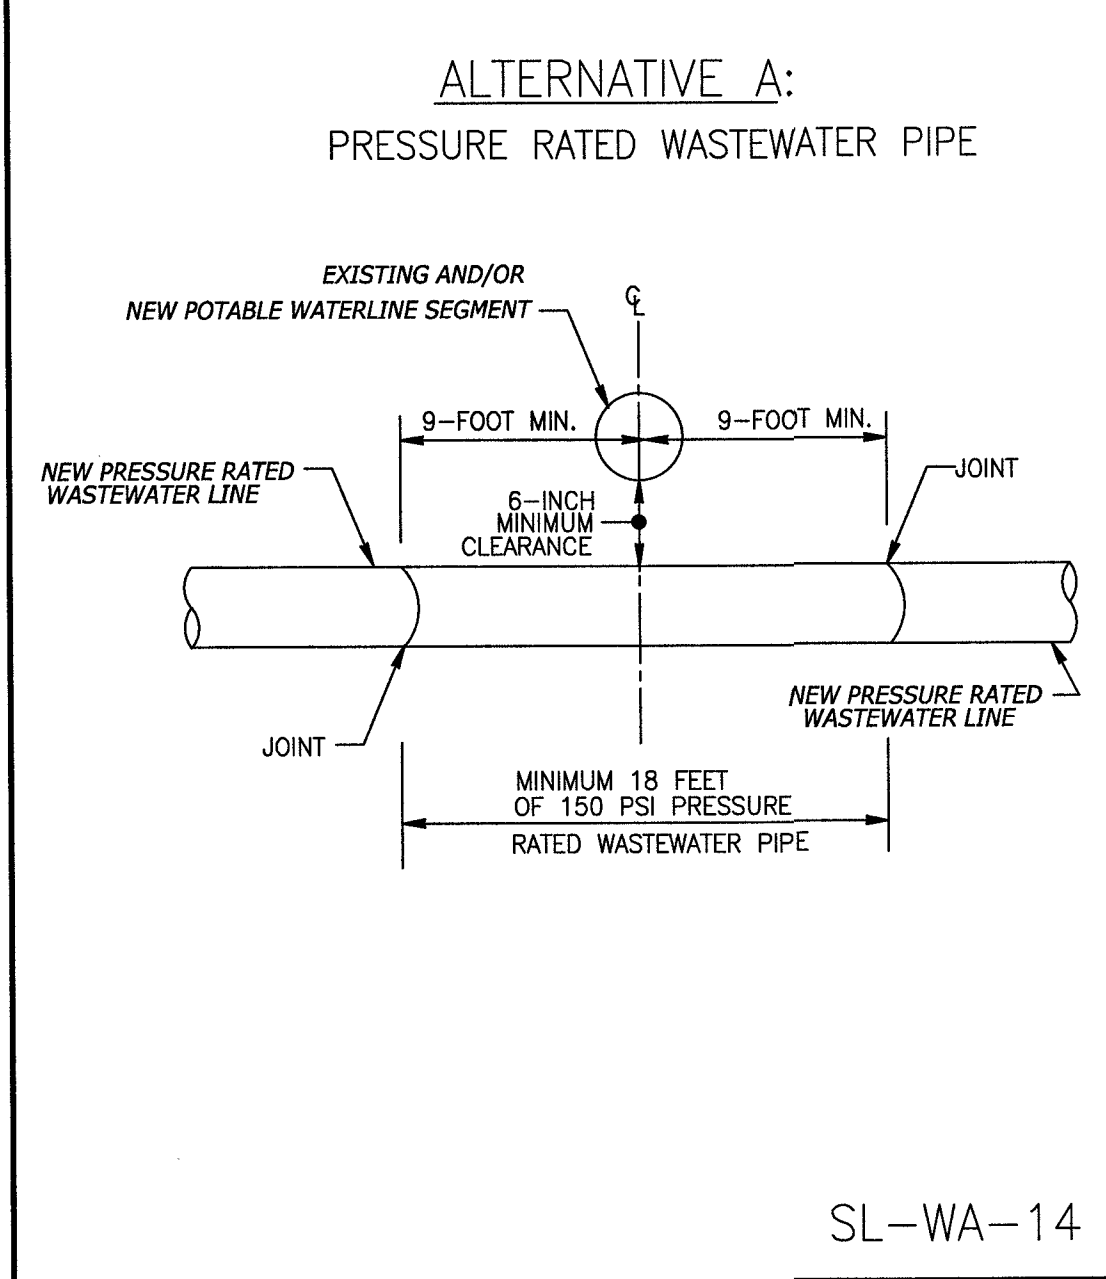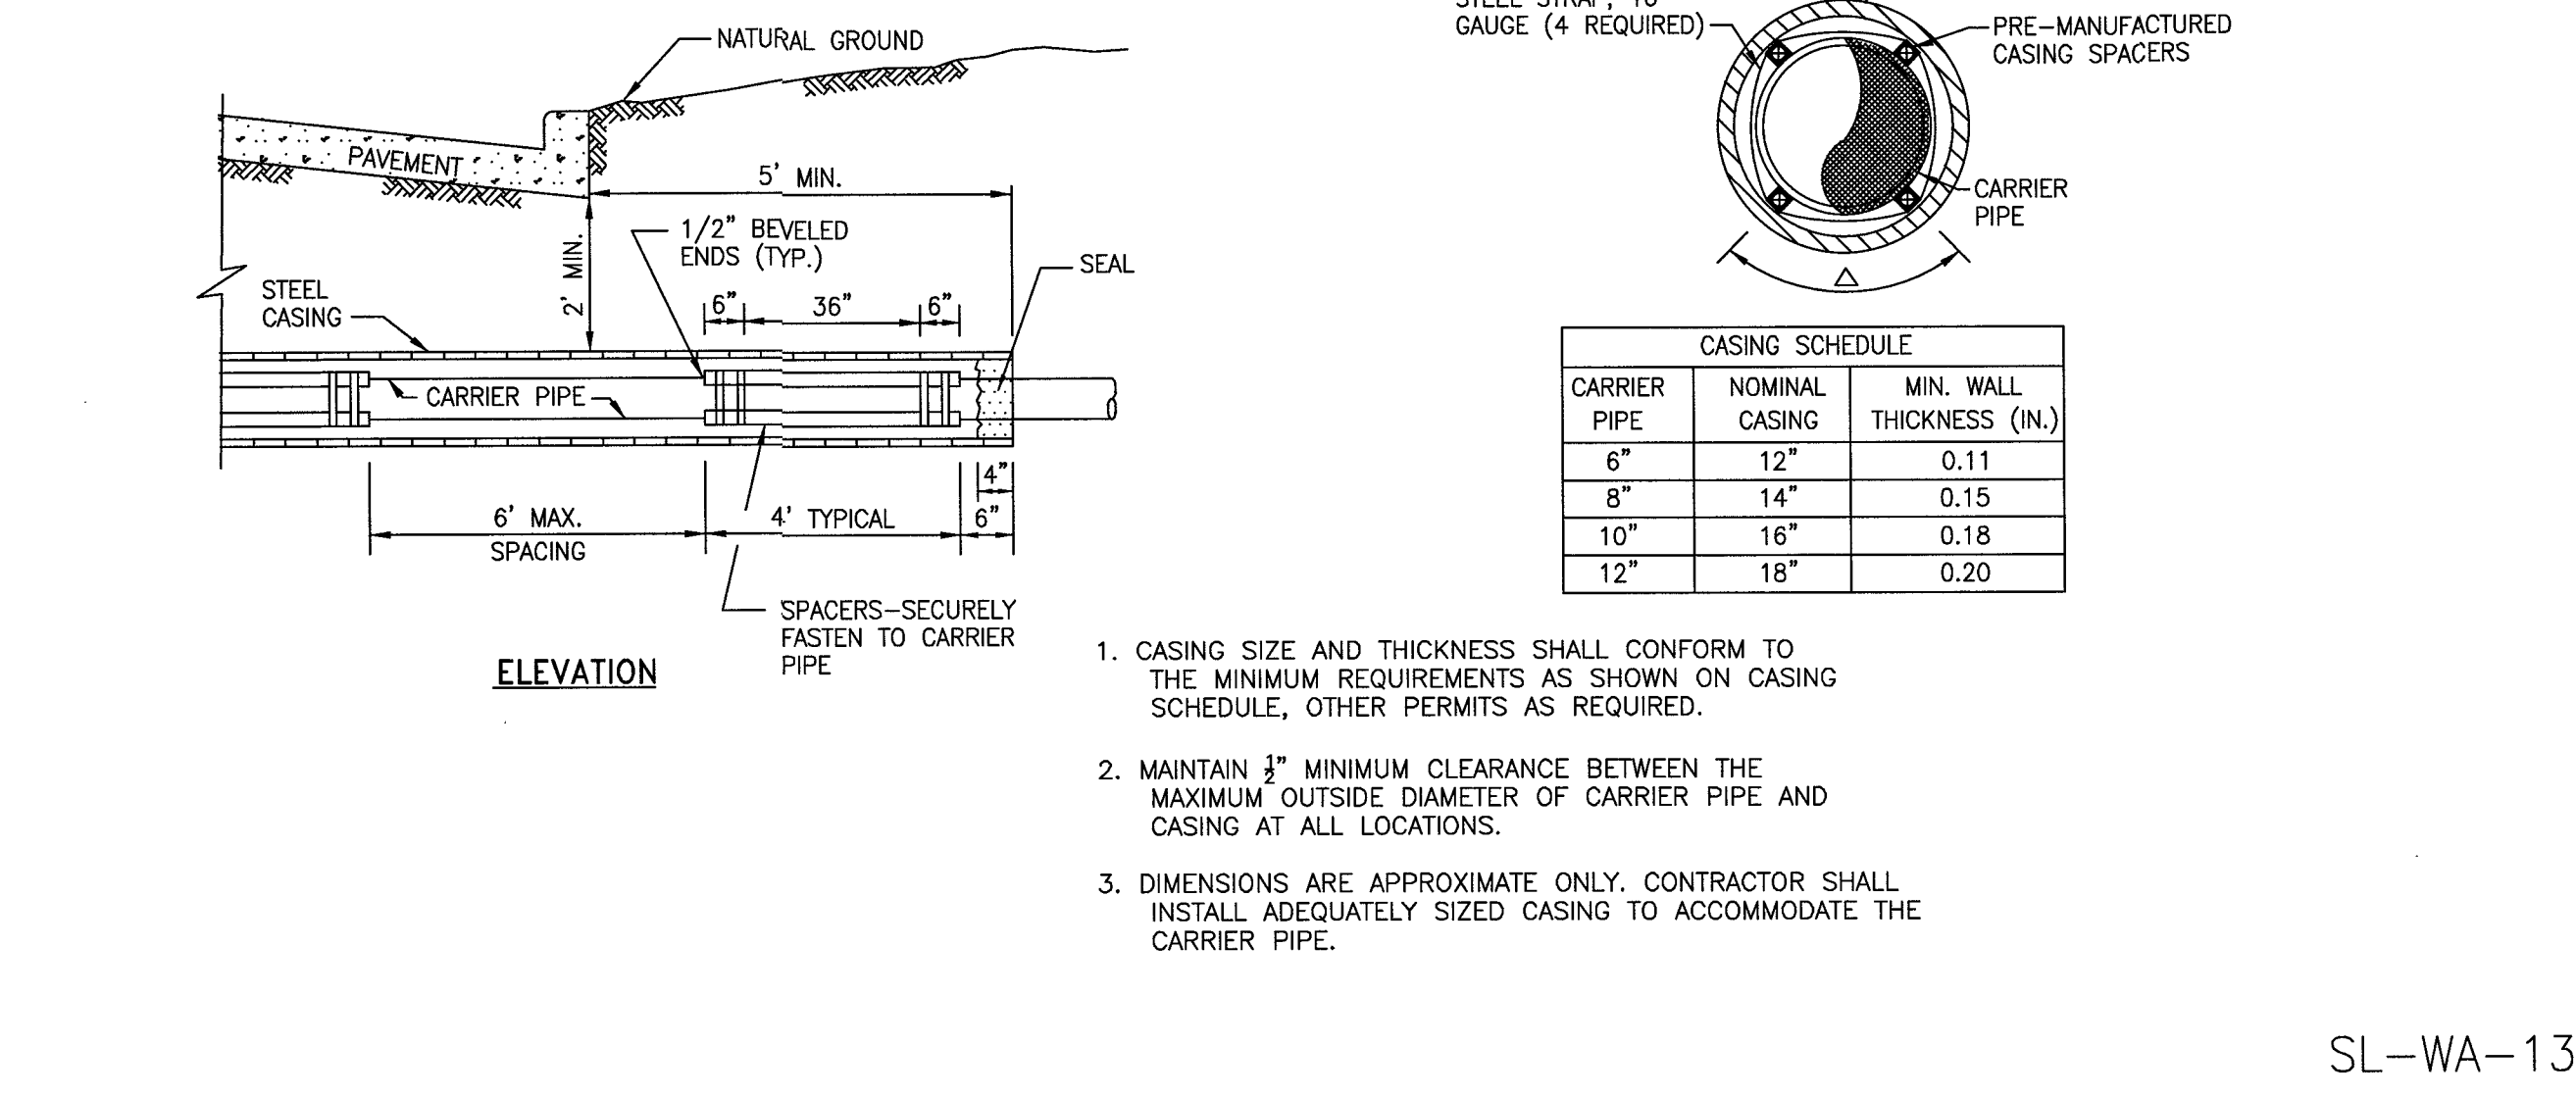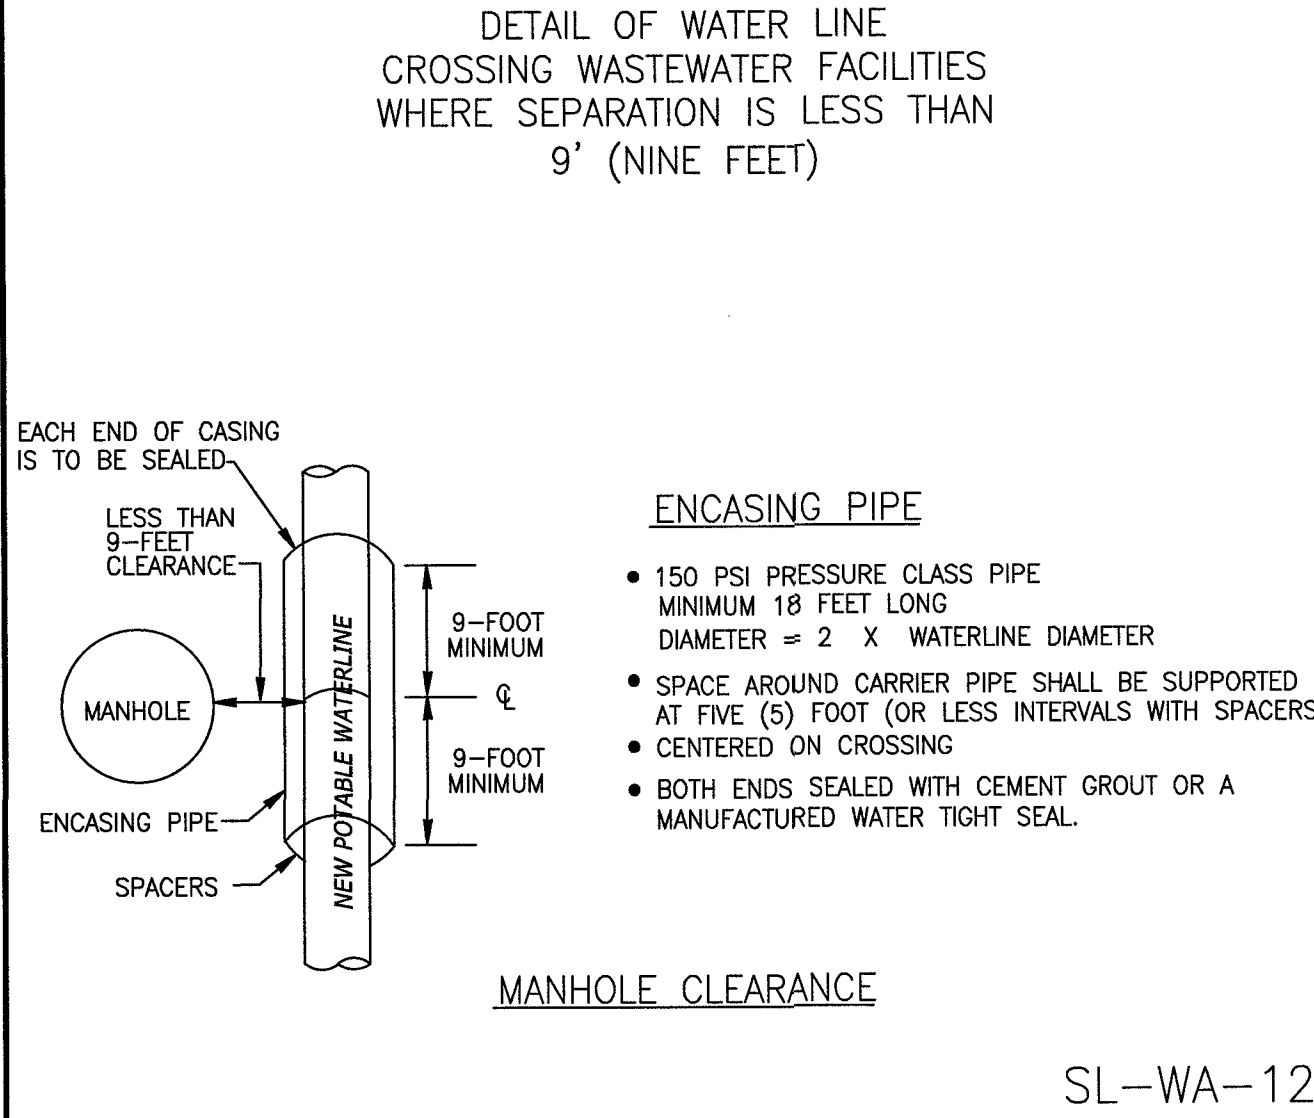

No.	DATE	REVISION

DESIGN ENGINEER: _____ DATE: _____

CITY OF SUGAR LAND, TEXAS
ENGINEERING DEPARTMENT

CONSTRUCTION PLANS FOR:


WATER LINE CROSSING DETAILS

JOB No.: _____
DATE: _____
DESIGNED BY: _____
DRAWN BY: _____
CHECKED BY: _____
SCALE: _____

SL-16
SHEET OF

NO.	DATE	DESCRIPTION	APPROVED	
REVISIONS				

B & L
BAKER & LAWSON, INC.
ENGINEERS • PLANNERS • SURVEYORS
4005 TECHNOLOGY DRIVE, SUITE 1530
ANGLETON, TEXAS 77515 (979) 849-6681
REG. NO. F-825

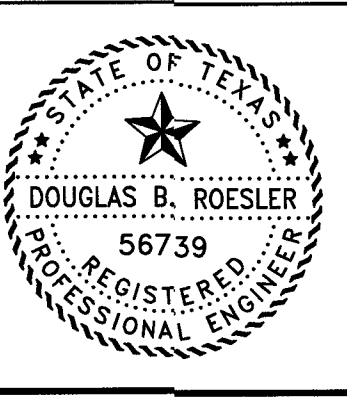


The seal appearing on this document was authorized by Douglas B. Roesler P.E. 56739
Date: 04-15-22

OWNER:
RIVERWAY PROPERTIES
6115 SKYLINE DR. STE A.
HOUSTON, TEXAS 77057

PLAN: _____
PROFILE: _____
HORIZONTAL: _____
VERTICAL: _____

RIVERWOOD RANCH SUBDIVISION
SECTION 2
A 78 AC, 109-LOT SUBDIVISION
ANGLETON, TEXAS 77515


WATER LINE CROSSING DETAILS
SL-16
PROJECT NO. 14395

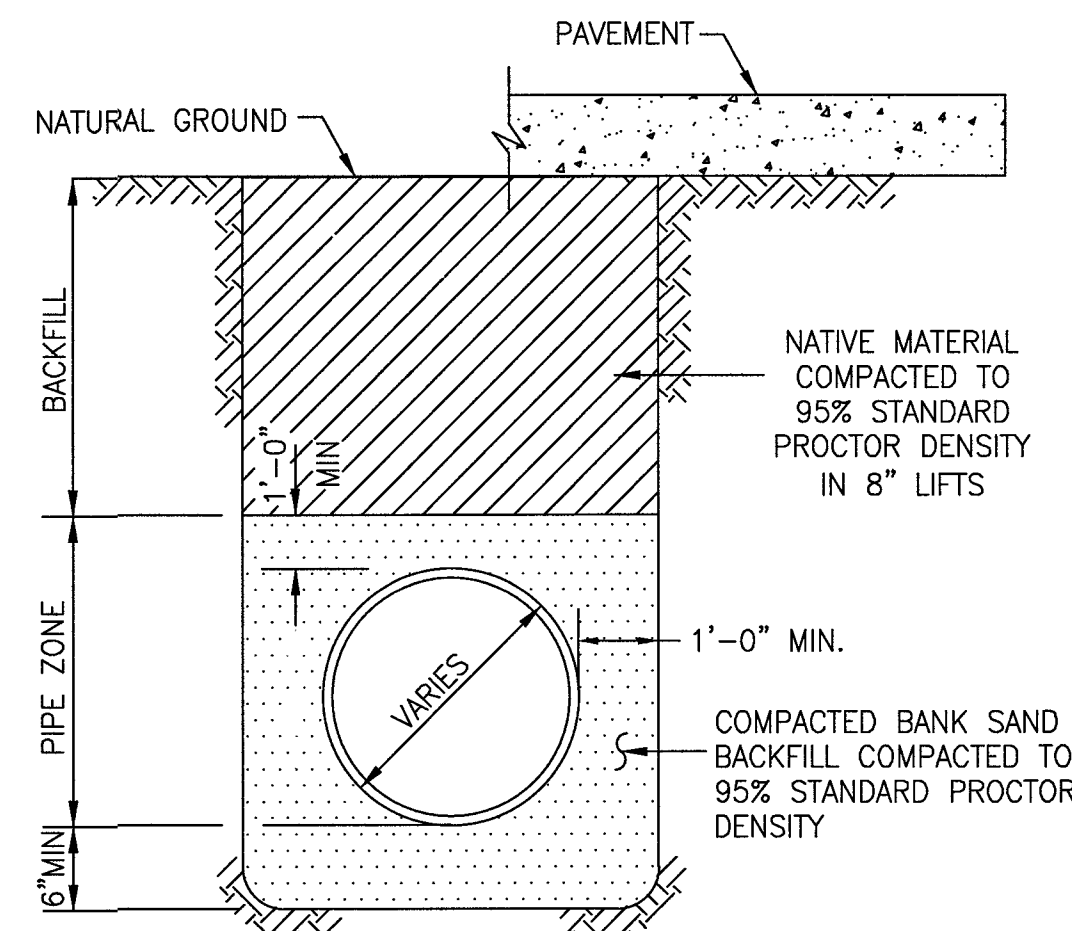

P.V.C. PIPE BEDDING & BACKFILL
N.T.S.
*SEE CONSTRUCTION NOTES

SANITARY FORCE MAIN & WATER LINE BEDDING AND BACKFILL

SL-BB-01

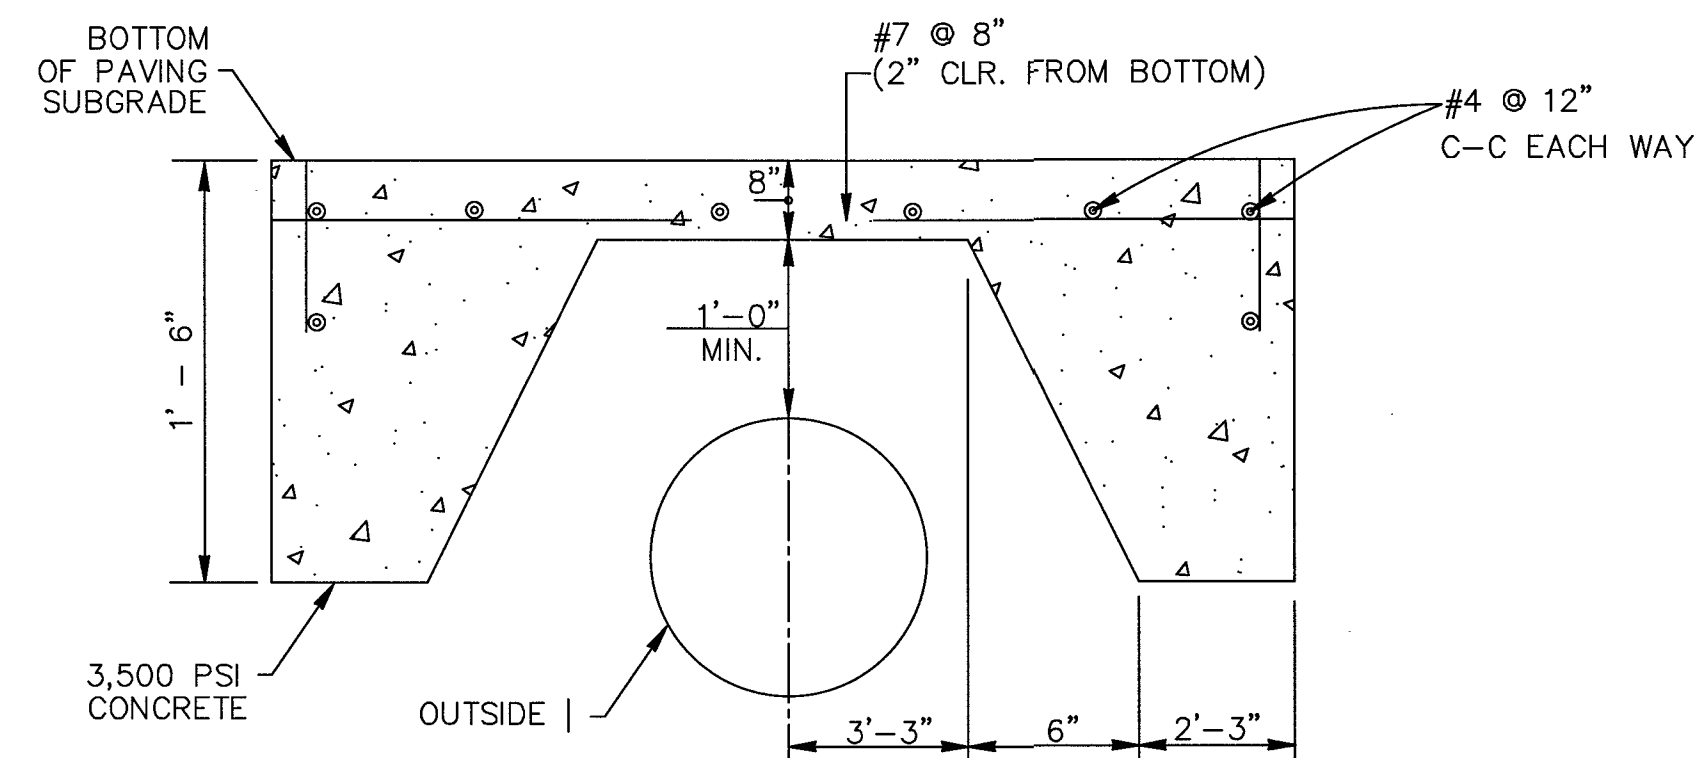


PROTECTIVE SLAB DETAIL
ZERO LOAD TRANSFER CONCRETE SLAB

SL-BB-04


CONSTRUCTION NOTES

1. CONTRACTOR SHALL CONTACT SUGAR LAND ENGINEERING DEPARTMENT IMMEDIATELY IF WET SAND CONDITIONS ARE ENCOUNTERED.
2. LIMESTONE AND RECYCLED CONCRETE DIMENSIONS SHOWN ARE TYPICAL BUT MAY BE VARIED BY ORDER OF CITY ENGINEER.
3. LIMESTONE OR RECYCLED CONCRETE SHALL BE IN ACCORDANCE WITH TXDOT SPECIFICATION No. 248 FLEXIBLE BASE, TYPE A, GRADE 2 AGGREGATE.
4. NO BEDDING SHALL BE INSTALLED IN WET CONDITIONS. WHEN WELL POINTING OR IN WET SAND CONDITIONS, MAINTAIN GROUND WATER 1 (FT) BELOW BOTTOM OF TRENCH FOR A MINIMUM OF 24-HRS AFTER BEDDING AND BACKFILL IS IN PLACE.
5. ALL MATERIALS SHALL BE FROM THE APPROVED PRODUCTS LIST UNLESS SPECIFICALLY APPROVED BY THE CITY ENGINEER.
6. SANITARY SEWER BEDDING FOR WET SAND CONDITIONS SHALL BE AS PER MODIFIED "A".
7. ALL SAND BEDDING FOR WATER LINES SHALL BE CLEAN, MECHANICALLY COMPACTED BANK SAND.
8. REFER TO: MANHOLE DETAILS, SANITARY, C.S.S., GENERAL, WATER CROSSING, WATER DISTRIBUTION DETAILS AND NOTES.
9. ALL BEDDING WILL BE COMPACTED TO 95% STANDARD PROCTOR DENSITY.
10. A GEOTECHNICAL REPORT MAY BE REQUIRED TO ANALYZE THE BEARING CAPACITY OF EXISTING SOILS AND MAKE A DETERMINATION IF ADDITIONAL BEDDING AND BACKFILL IS APPROPRIATE.


SL-BB-05

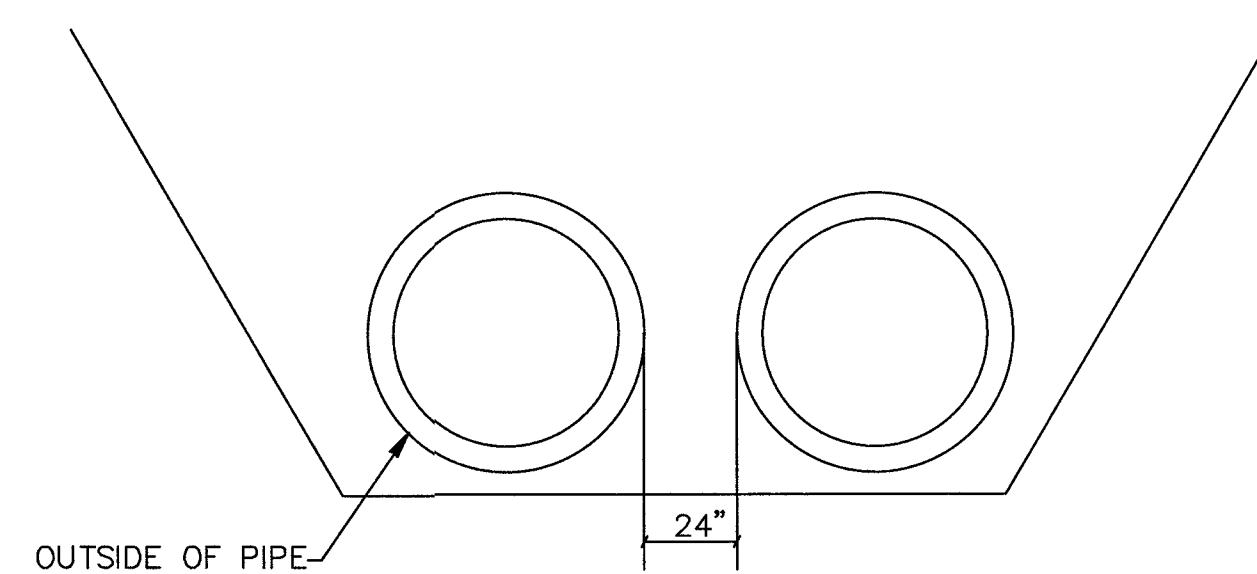

PIPE SEPARATION

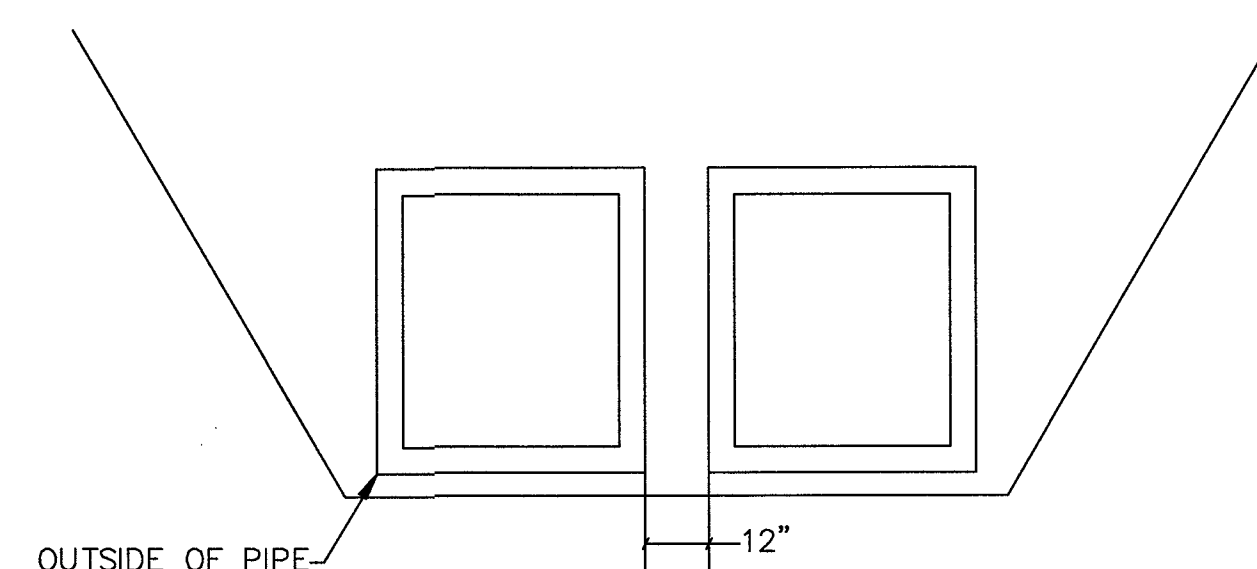

RCB SEPARATION

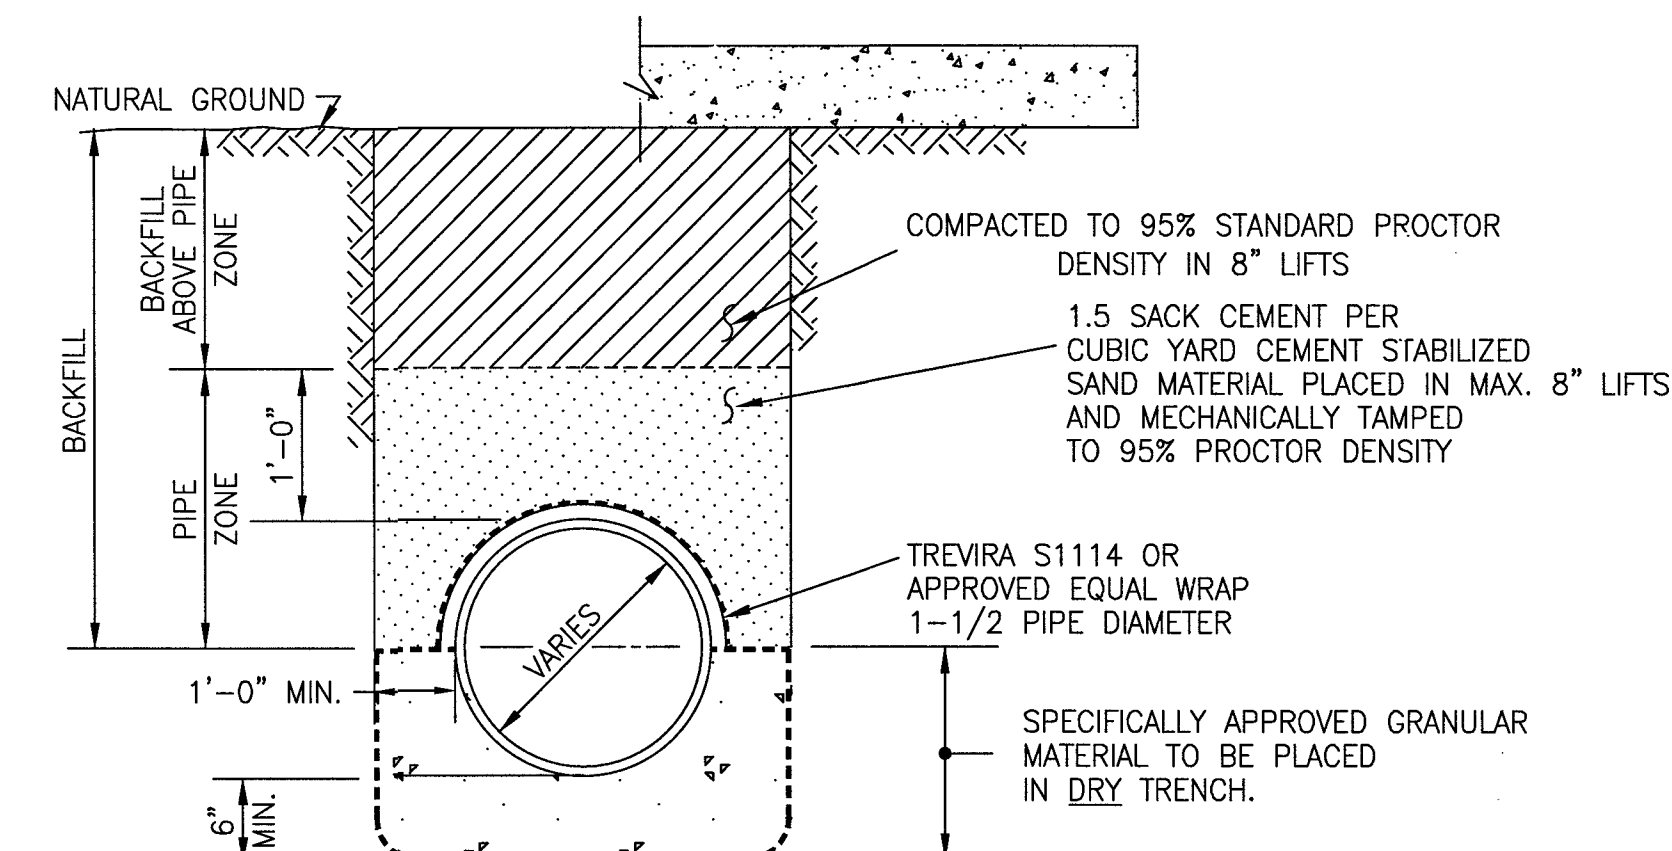

MODIFIED "A"
N.T.S.


NOTE: C.S.S. SHALL BE INSTALLED A MIN. 1' ABOVE TOP OF PIPE.

SANITARY SEWER BEDDING AND BACKFILL

SL-BB-03

REFER TO:



1. GENERAL NOTES
2. C.S.S. NOTES

No.	DATE	REVISION
SEAL:		
DESIGN ENGINEER: _____ DATE: _____		
 CITY OF SUGAR LAND, TEXAS ENGINEERING DEPARTMENT		
CONSTRUCTION PLANS FOR:		
WATER LINE, SANITARY SEWER FORCE MAIN BEDDING DETAILS		
JOB No.: DATE: DESIGNED BY: DRAWN BY: CHECKED BY: SCALE:	SL-19 SHEET OF	

RECORD DRAWING

NO.	DATE	DESCRIPTION	APPROVED

DESIGNED DR
DRAWN BT
CHECKED
DATE

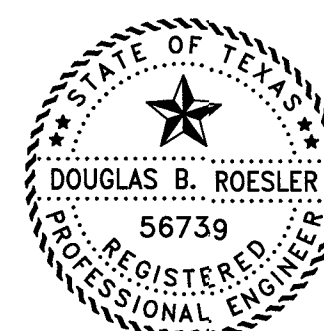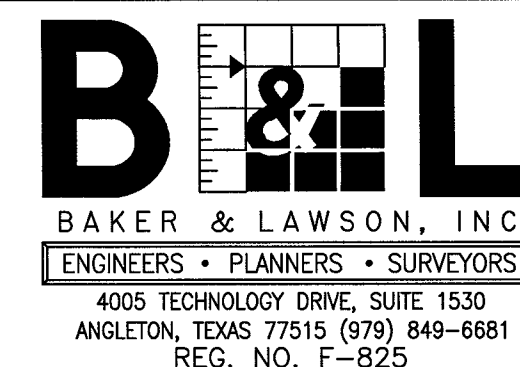

The seal appearing on this document was authorized by Douglas B. Roesler P.E. 56739
Date: 04-18-02

OWNER:

RIVERWAY PROPERTIES
6115 SKYLINE DR. STE A.
HOUSTON, TEXAS 77057







PLAN: _____
PROFILE: _____
HORIZONTAL: _____
VERTICAL: _____

RIVERWOOD RANCH SUBDIVISION
SECTION 2
A 78 AC, 109-LOT SUBDIVISION
ANGLETON, TEXAS 77515

WATER LINE, SANITARY
SEWER FORCE MAIN
BEDDING DETAILS
SL-19

PROJECT NO. 14395





14395 SHEET SET.DWG 36

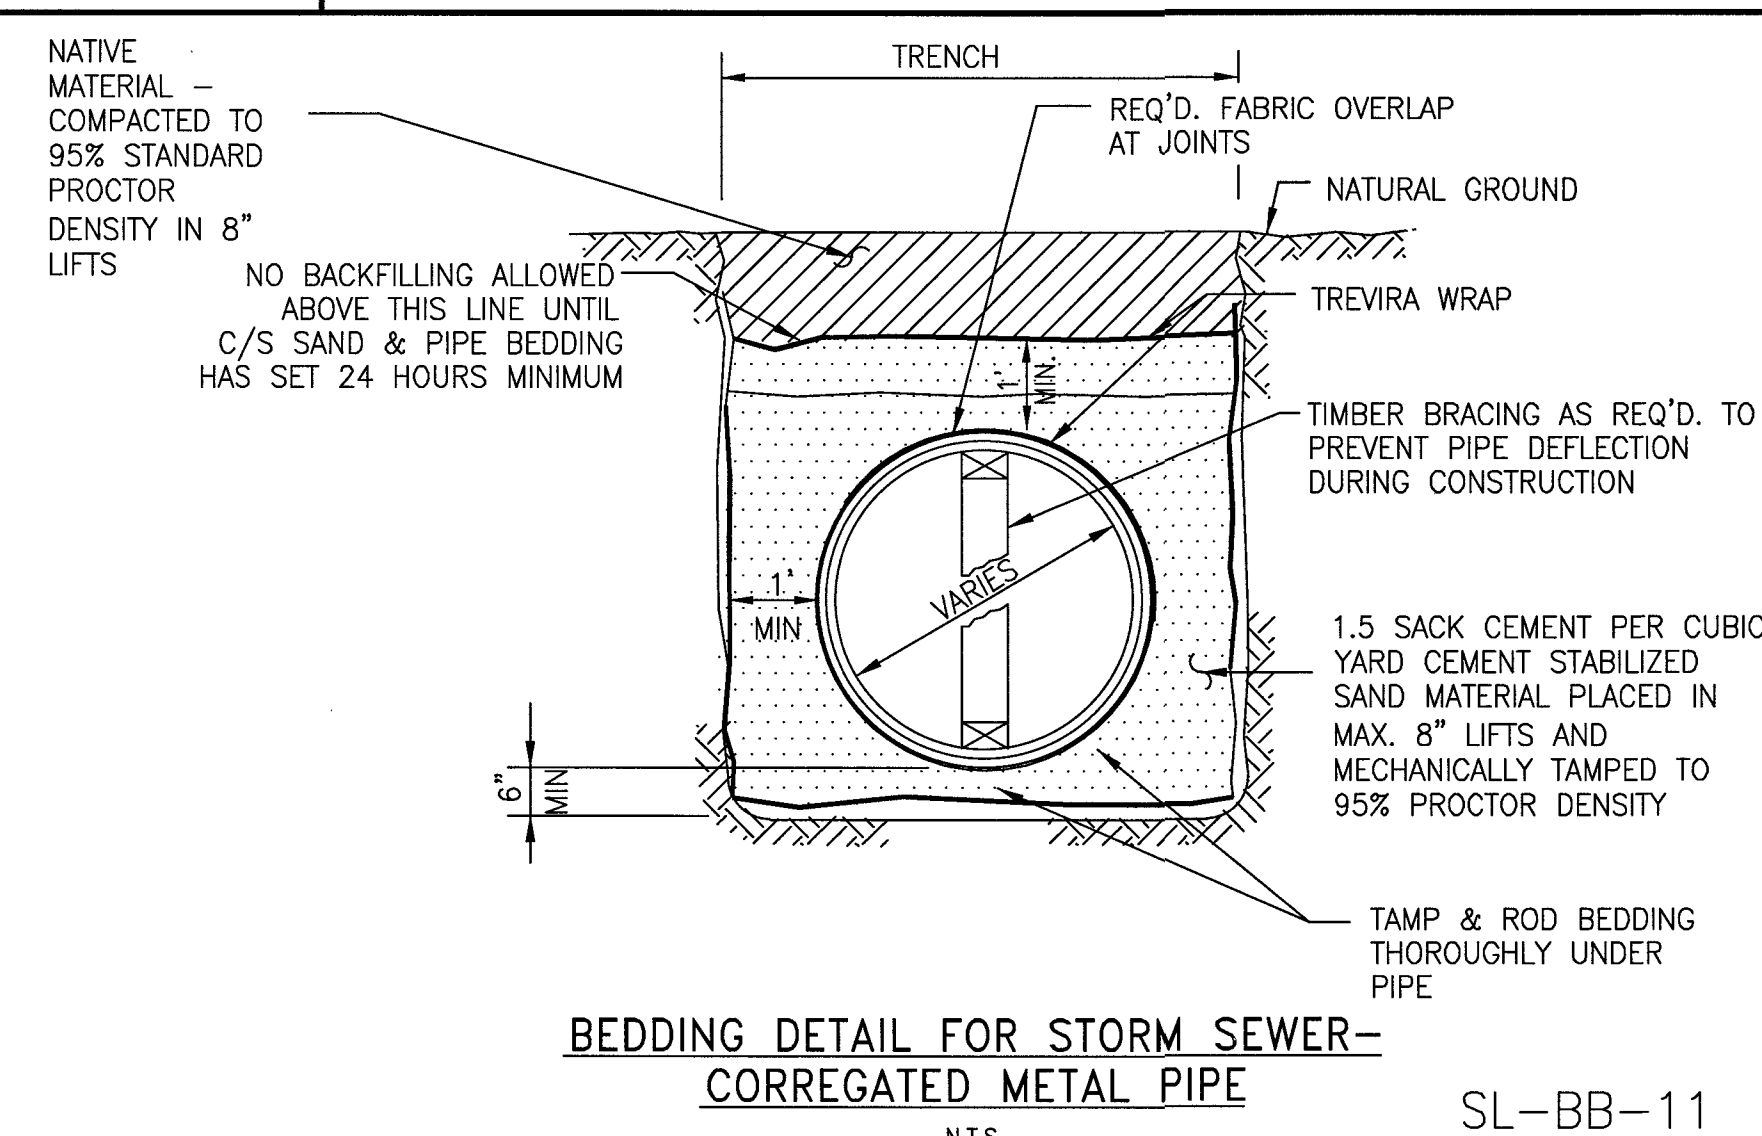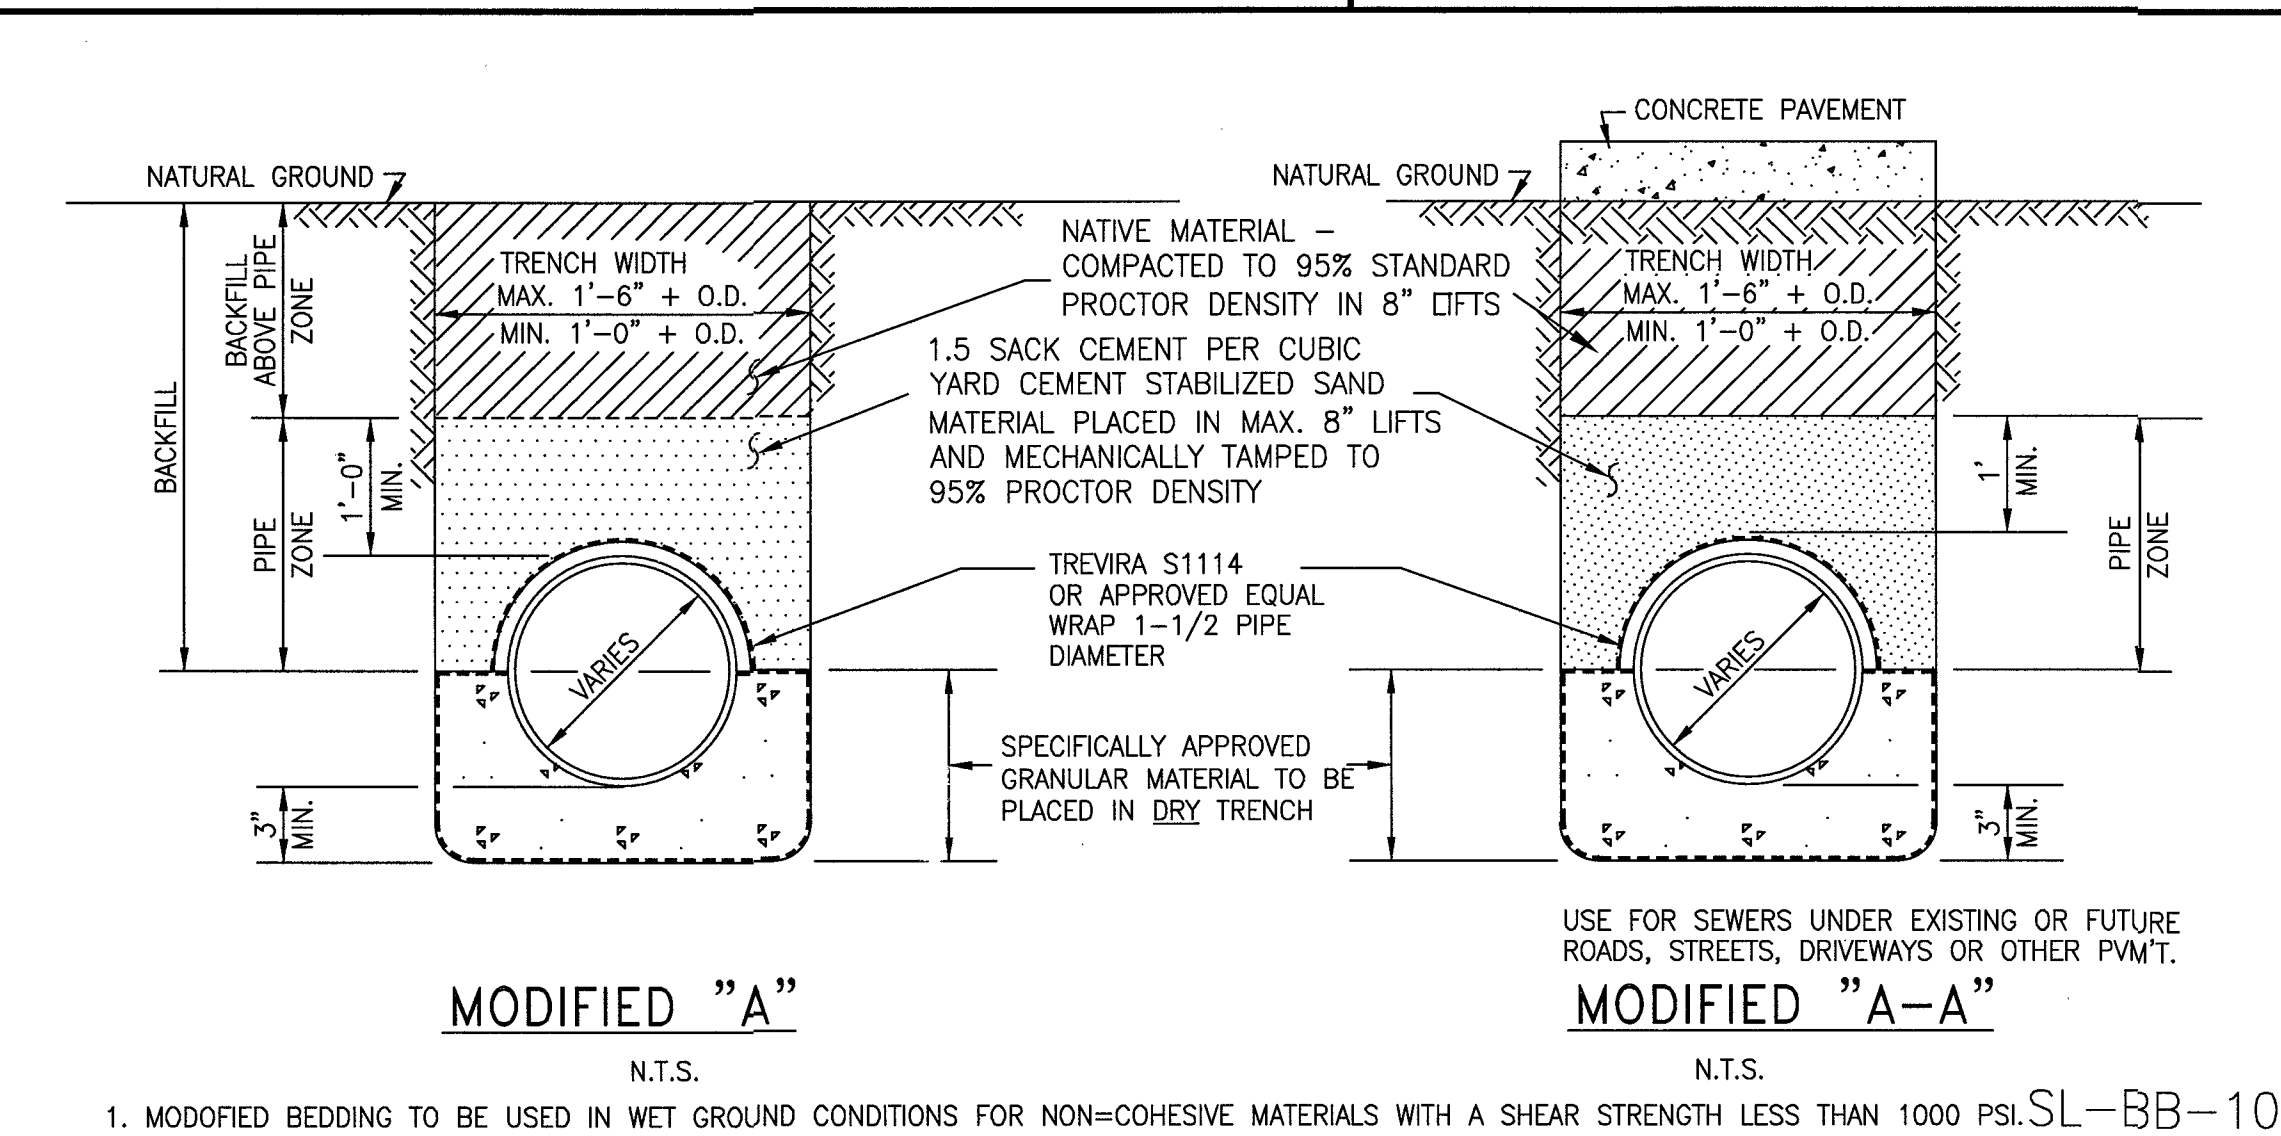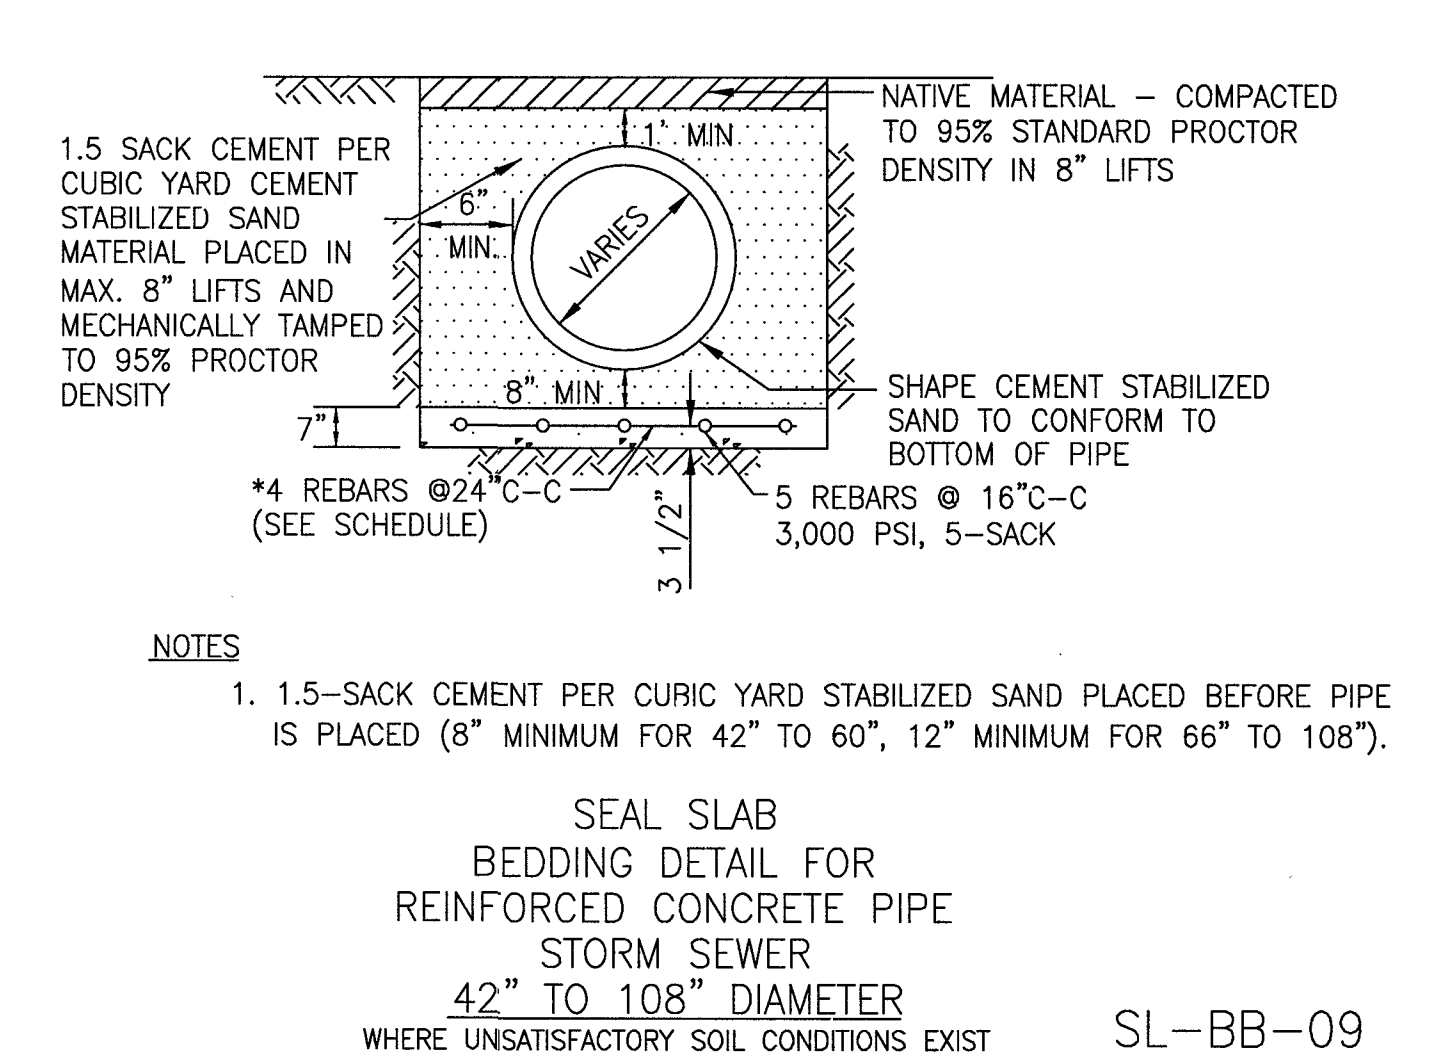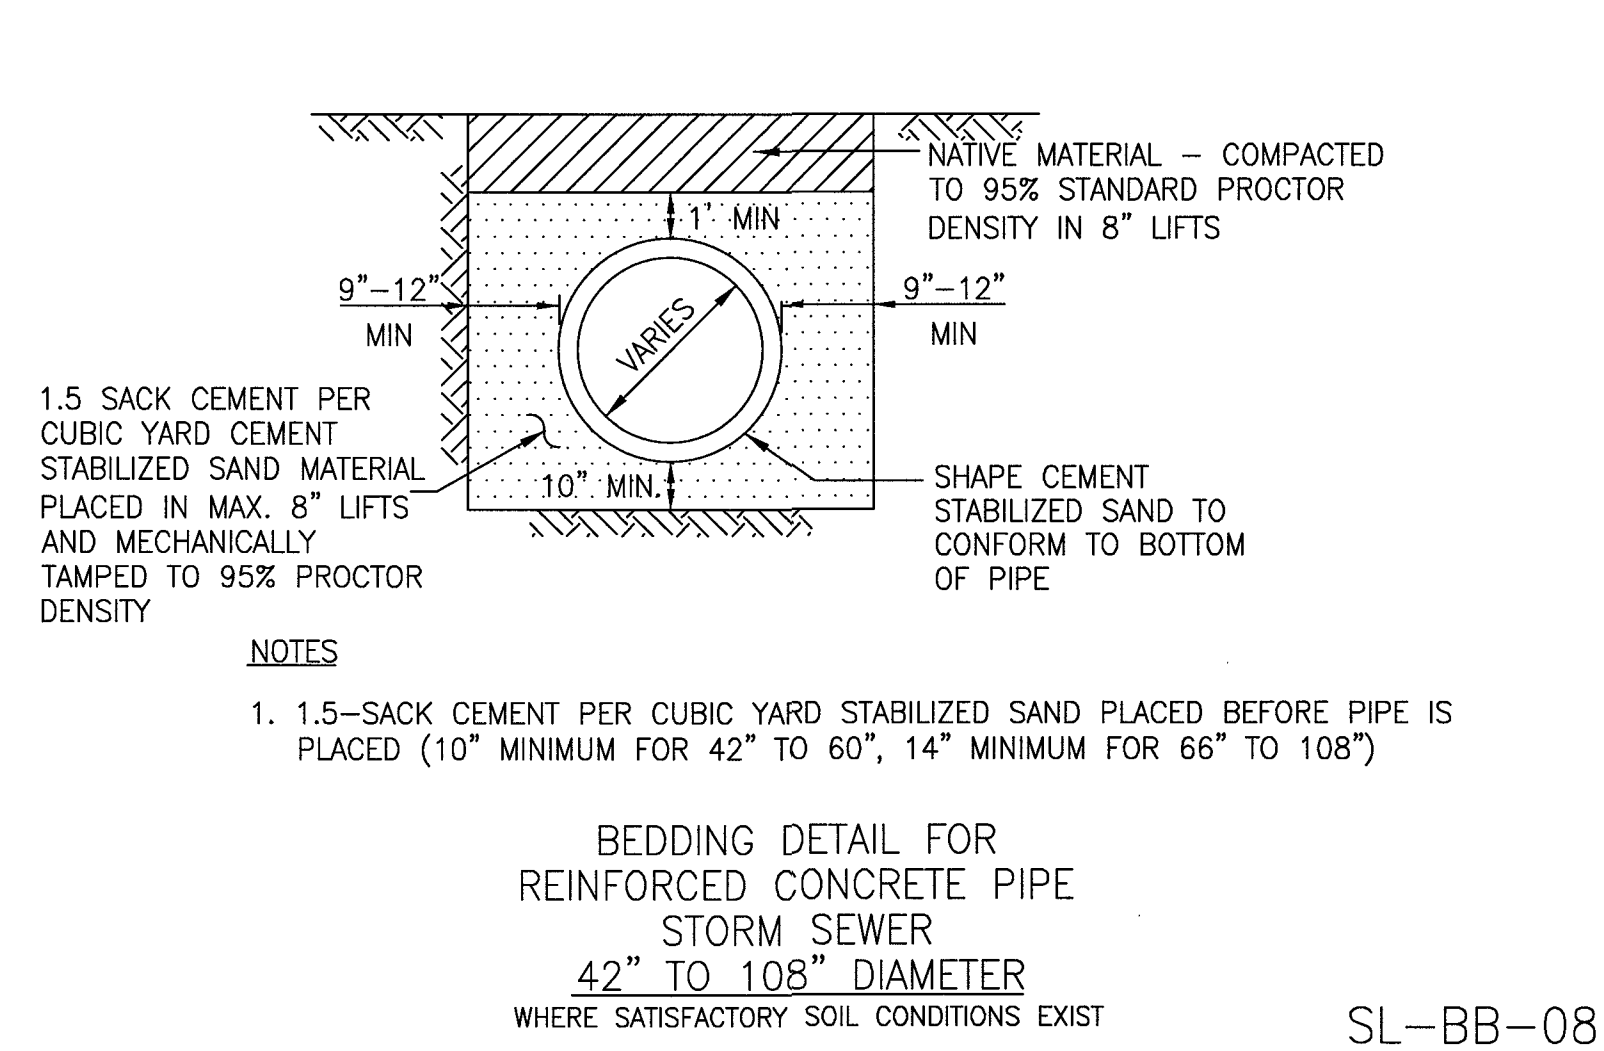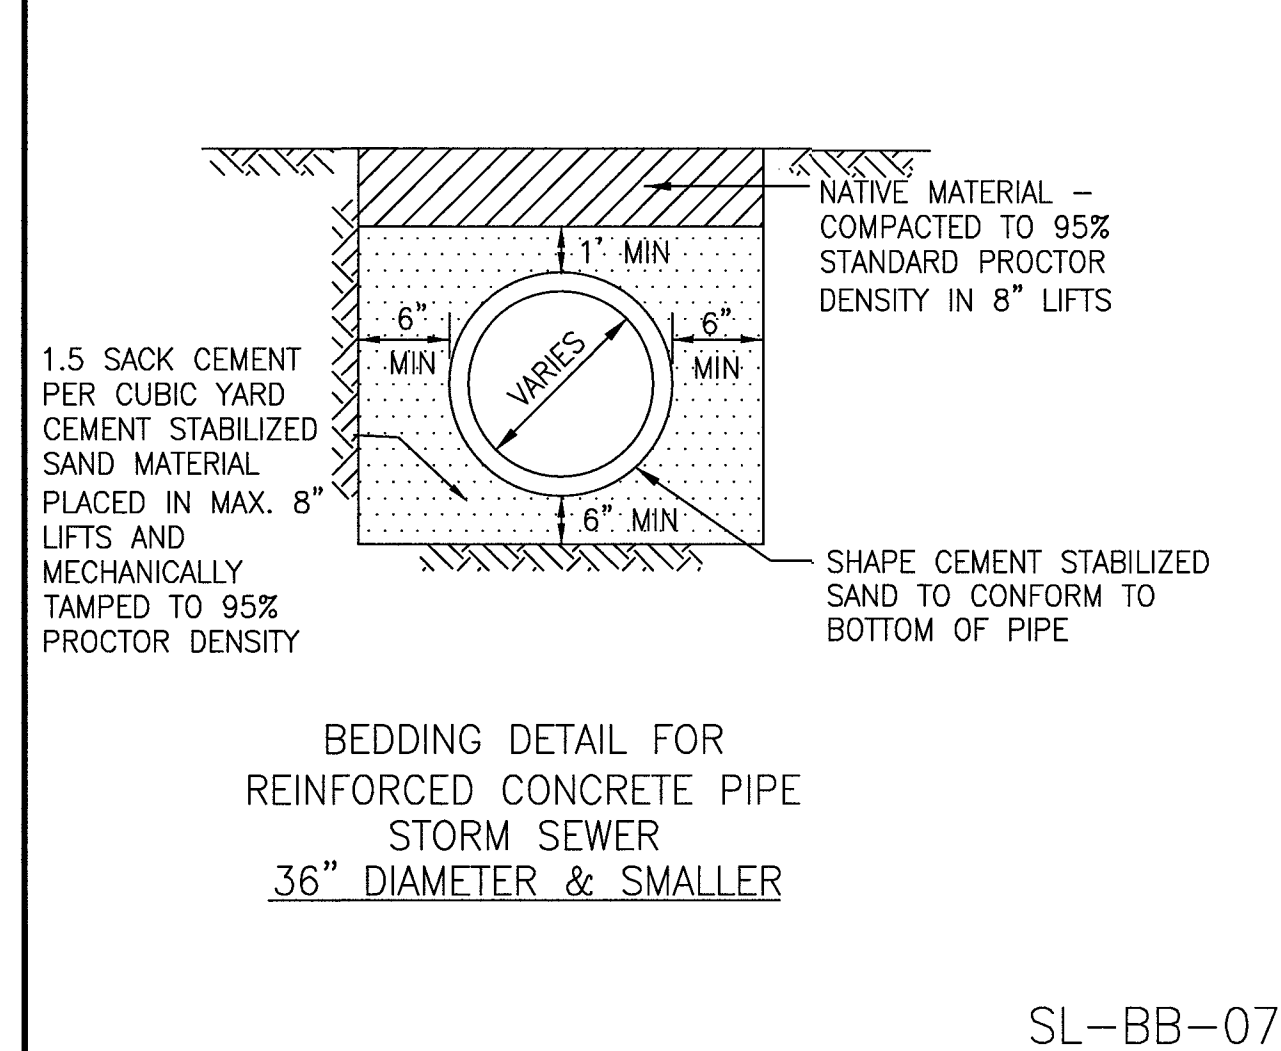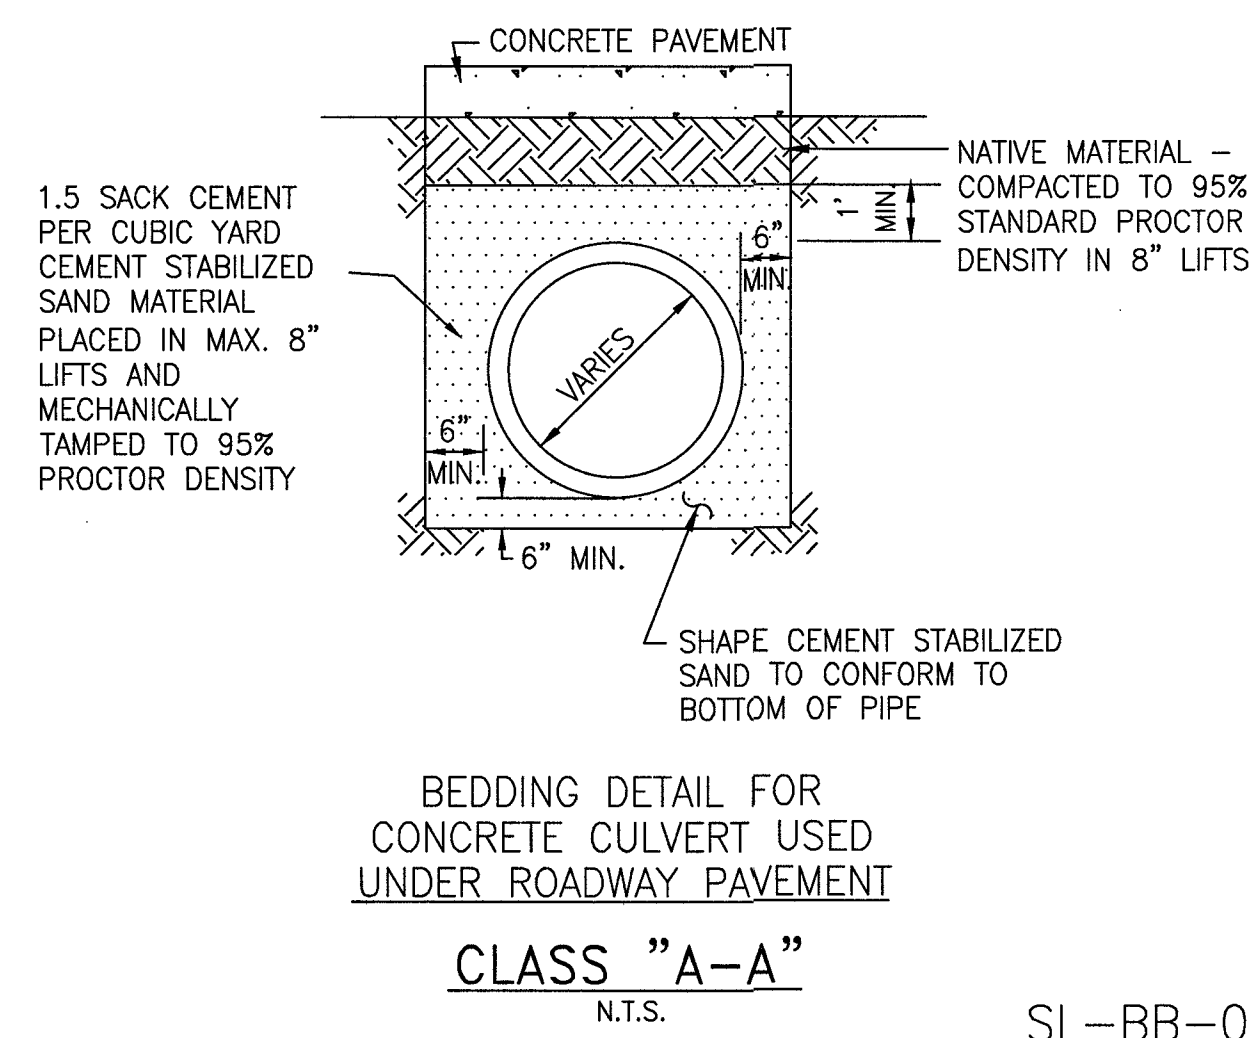

CONSTRUCTION NOTES



1. CONTRACTOR SHALL CONTACT SUGAR LAND ENGINEERING DEPARTMENT IMMEDIATELY IF WET SAND CONDITIONS ARE ENCOUNTERED.
2. SPECIFICALLY APPROVED GRANULAR MATERIAL DIMENSIONS SHOWN ARE TYPICAL BUT MAY BE VARIED BY ORDER OF CITY ENGINEER.
3. SPECIFICALLY APPROVED GRANULAR MATERIAL SHALL BE IN ACCORDANCE WITH TxDOT SPECIFICATION No. 247 FLEXIBLE BASE, TYPE A, GRADE 2 AGGREGATE.
4. NO BEDDING SHALL BE INSTALLED IN WET CONDITIONS. WHEN WELL POINTING OR IN WET SAND CONDITIONS, MAINTAIN GROUND WATER 1' (FT.) BELOW BOTTOM OF TRENCH FOR A MINIMUM OF 24-HRS AFTER BEDDING AND BACKFILL IS IN PLACE.
5. R.C.P. AND BOX CULVERTS SHALL BE INSTALLED WITH APPROVED GASKETS ONLY.
6. MANHOLES SHALL BE PROVIDED WHERE MODIFIED "A" OR MODIFIED "A-A" BEDDING IS USED. STACKS ARE NOT ALLOWED.
7. REFER TO: MANHOLE DETAILS, INLETS, OUTFALL AND END TREATMENT DETAILS, C.S.S., GENERAL NOTES, AND STORM NOTES.
8. SPECIFIC DESIGNS MUST BE SUBMITTED AND APPROVED BY THE CITY ENGINEER FOR MANHOLE ACCESS TO BOX CULVERTS AS REQUIRED.
9. ALL BACKFILL WITHIN THE R.O.W. SHALL BE COMPACTED TO 95% STANDARD PROCTOR DENSITY.
10. A GEOTECHNICAL REPORT MAY BE REQUIRED TO ANALYZE THE BEARING CAPACITY OF EXISTING SOILS AND MAKE A DETERMINATION IF ADDITIONAL BEDDING AND BACKFILL IS APPROPRIATE.


TYPICAL SFEAL SLAB BAR SCHEDULE (OR AS DIRECTED BY ENGINEER)		
PIPE SIZE	LOT LAT #4 BARS	NO LONGIT #5 BARS
42"	5' 4"	5
48"	6' 8"	6
54"	6' 8"	6
60"	8' 0"	7
66"	8' 0"	7
72"	9' 4"	8
78"	9' 4"	8
84"	9' 4"	8
90"	10' 8"	9
96"	10' 8"	9
102"	12' 0"	10
108"	12' 0"	10

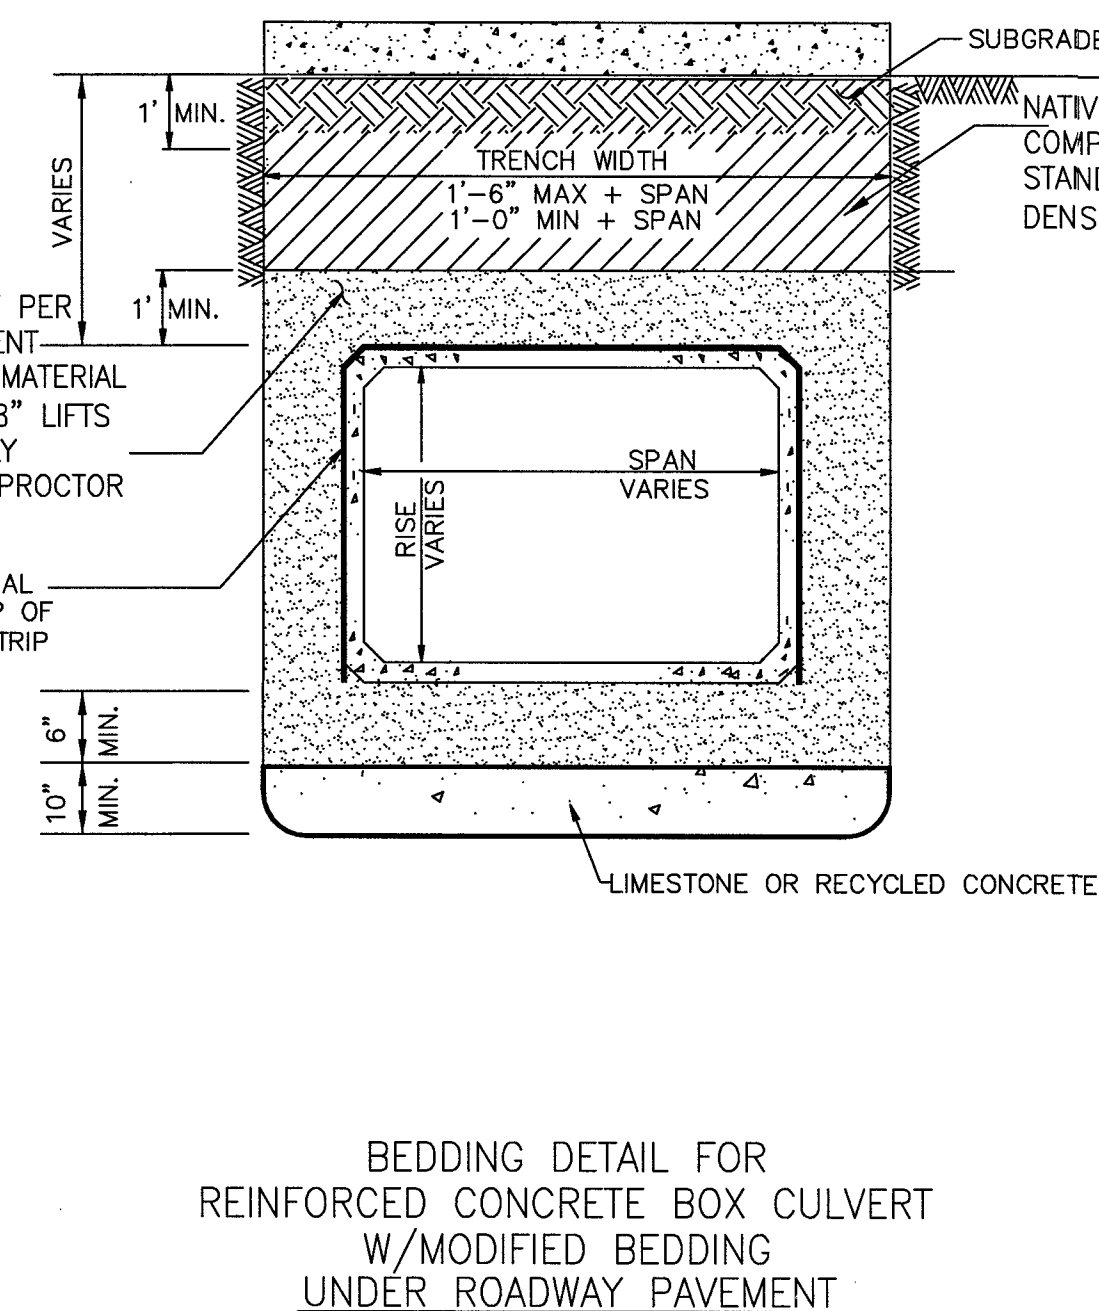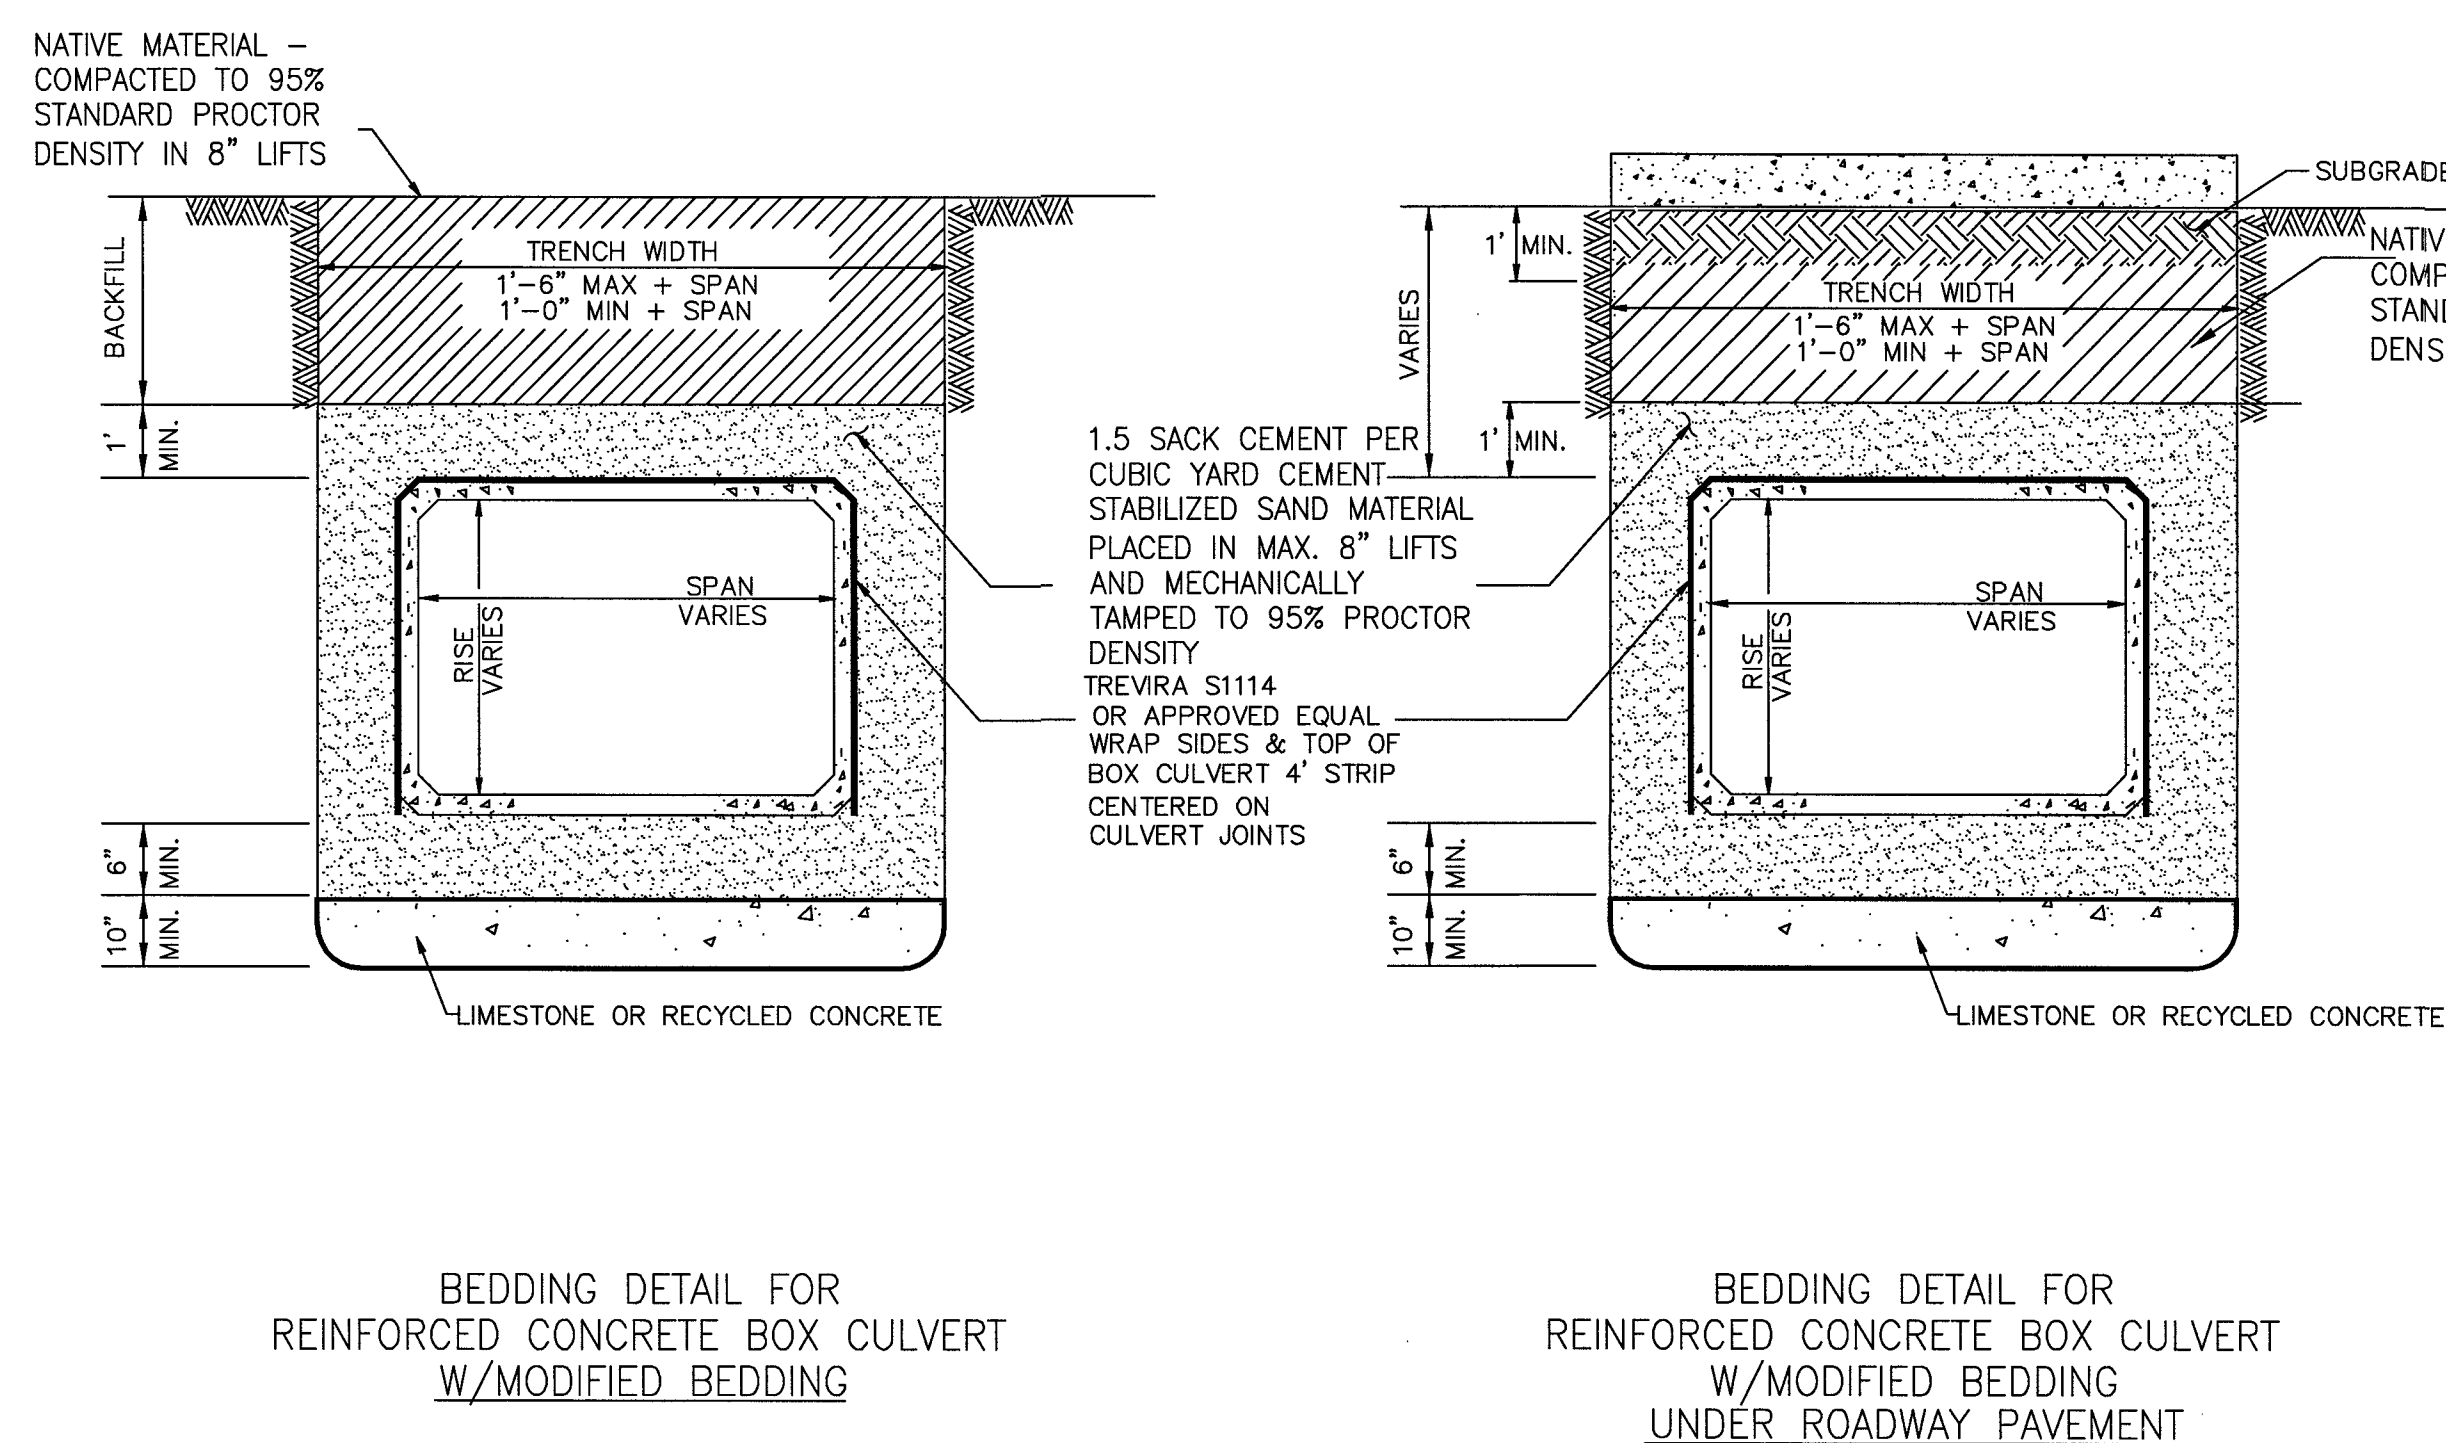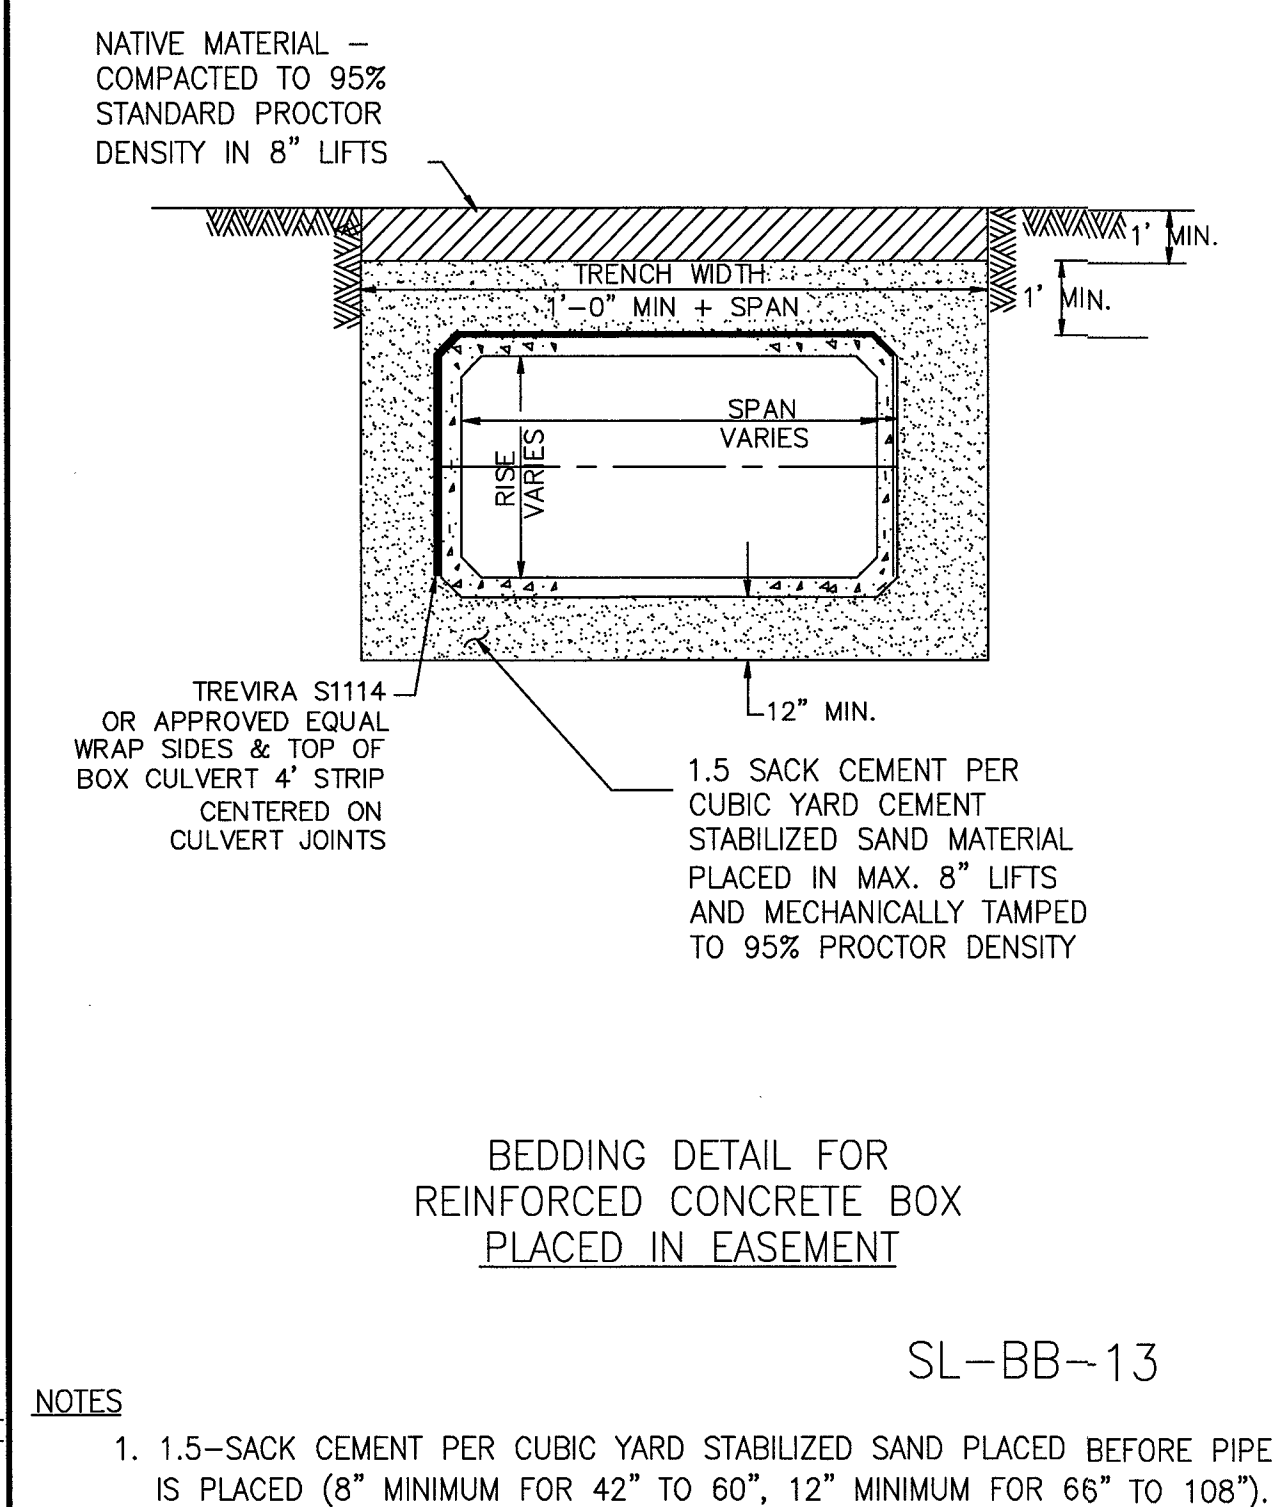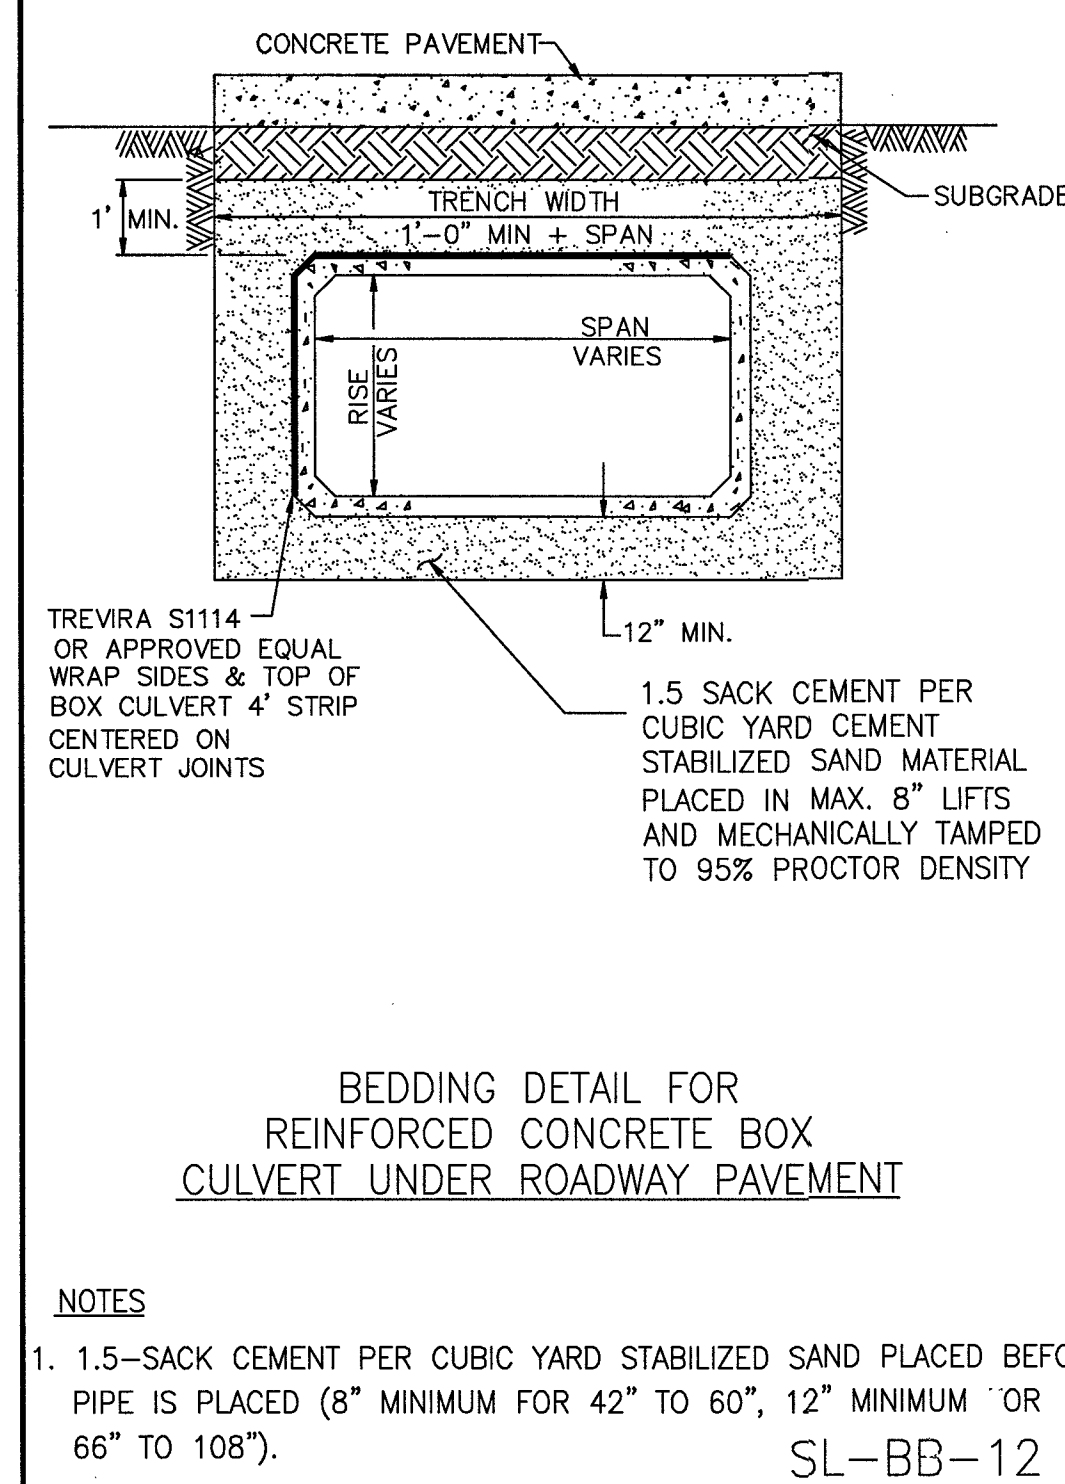

																																																																																																																																																																																																																																																																																																																																																																																																																																																																																																																																																																																																																																																																																																																																																																																																																																																																																																																																																																																																																																																																																																																																																																																																																																																																																																																																																																																																																					</
--	--	----

NO.	DATE	DESCRIPTION	APPROVED
REVISIONS			

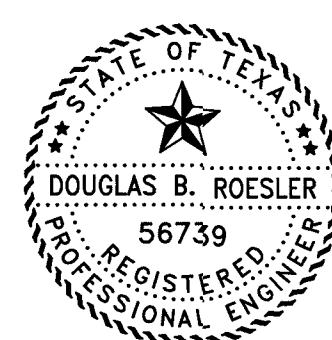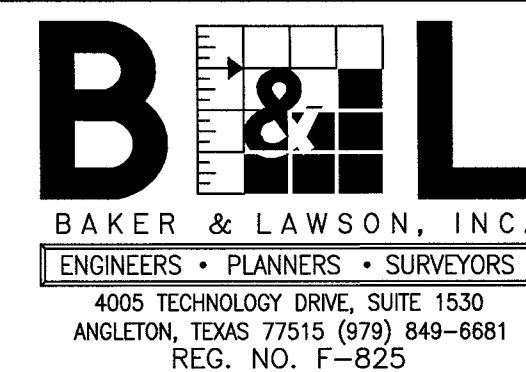

The seal appearing on
this document was
authorized by
Douglas B. Roesler
P.E. 56739

Date: 04-18-27

OWNER:


**RIVERWAY PROPERTIES
6115 SKYLINE DR. STE A.
HOUSTON, TEXAS 77057**

PLAN: _____
 PROFILE: _____
 HORIZONTAL: _____
 VERTICAL: _____

RIVERWOOD RANCH SUBDIVISION
SECTION 2
A 78 AC, 109-LOT SUBDIVISION
ANGLETON, TEXAS 77515

STORM SEWER PIPE
BEDDING AND BACKFILL
DETAILS
SL-20

PROJECT NO. 14395

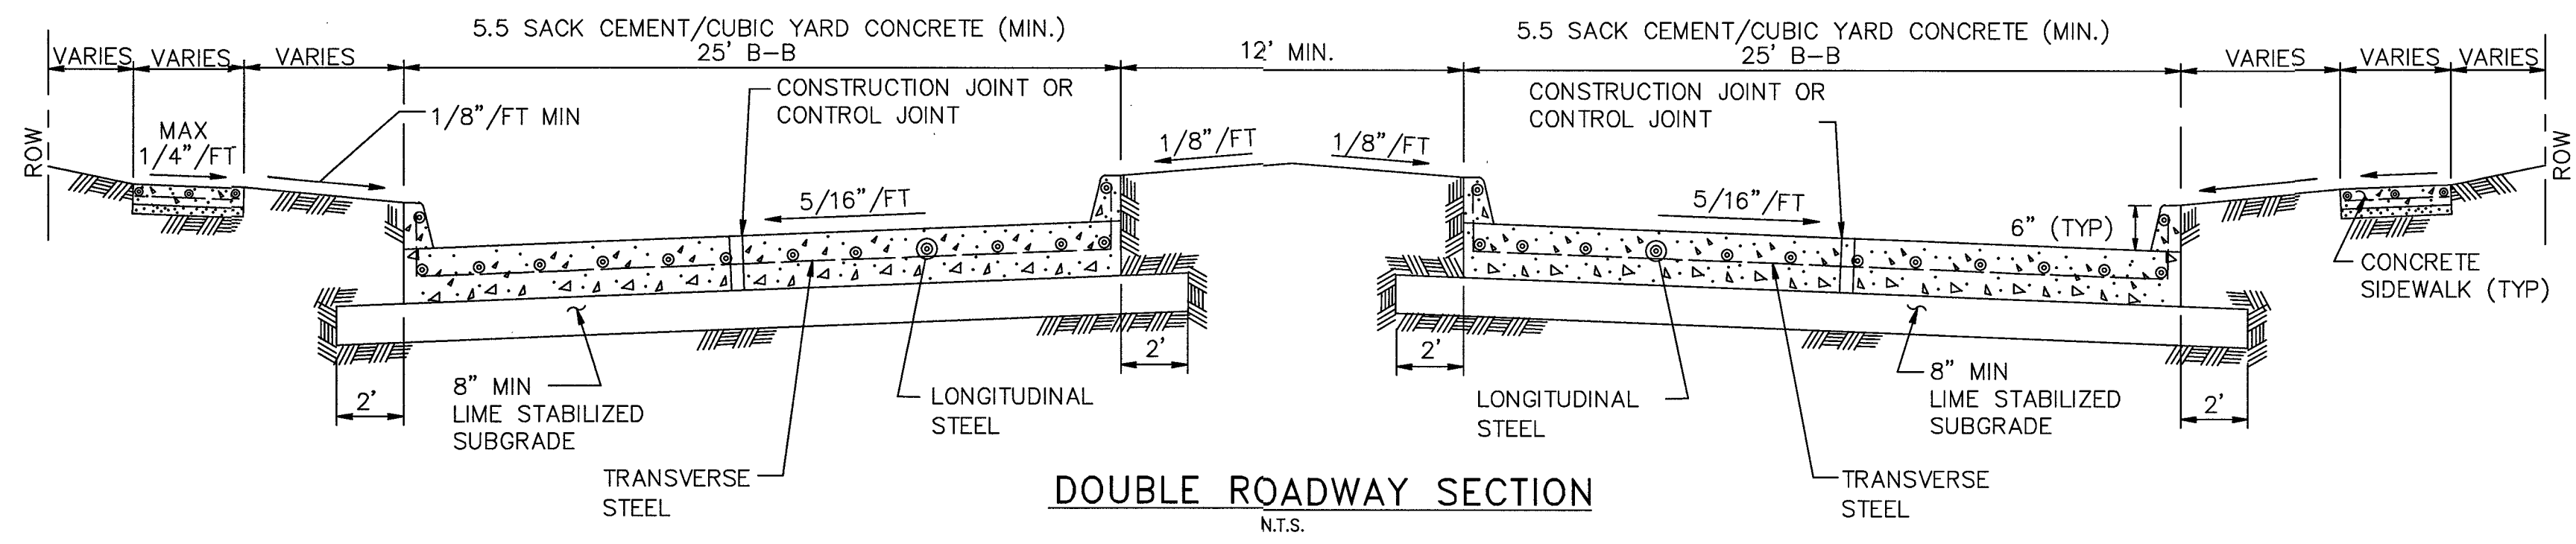


SL-ST-01


CONSTRUCTION NOTES:

1. 6 INCH, 5.5 SACK CEMENT PER CUBIC YARD CONCRETE, 3500 PSI REINFORCED CONCRETE WITH #4 BARS 24 INCHES C-C, E.W. IS THE MINIMUM ACCEPTABLE PAVEMENT CONSTRUCTION FOR LOCAL STREETS
2. 7 INCH, 5.5 SACK CEMENT PER CUBIC YARD CONCRETE, 3500 PSI REINFORCED CONCRETE WITH #4 BARS 18 INCHES C-C, IS THE MINIMUM ACCEPTABLE PAVEMENT CONSTRUCTION FOR COLLECTOR STREETS
3. EIGHT (8) INCH, 5.5 SK. 3500 PSI @ 28 DAYS, REINFORCED WITH #4 18" C.C. EACH WAY IS THE MINIMUM ACCEPTABLE FOR ARTERIAL STREETS.
4. HARD AGGREGATE IS NOT ALLOWED IN STREET PAVEMENT MIX. ADMIXTURES REQUIRE CITY OF SUGAR LAND PUBLIC WORKS DEPARTMENT APPROVAL.
5. TRANSVERSE EXPANSION JOINTS SHALL BE PLACED AT ALL POINTS OF CURVATURE, POINTS OF TANGENCY AND ALL INTERSECTION CURB RETURN POINTS. MAXIMUM SPACING SHALL BE 200' AND BE SEALED WITH SEALANT CONFORMING TO TXDOT ITEM 360 (& ITEM 438) AND TXDOT DMS-6310, CLASS-2.
6. TRANSVERSE CONTROL JOINTS ARE REQUIRED AT MAXIMUM SPACING OF 20'-0" C-C, AND VERTICAL CURB JOINTS TO BE SEALED WITH SPECIAL JOINT SEALANT ASTM-D-1190-74 OR AASHTO-M173-60 FOR PAVEMENT 8" THICK AND GREATER. (ELASTOMERIC TYPE HOT Poured)
7. PAVEMENT FINISH SHALL BE BAKER BROOM FINISH. CURING COMPOUND REQUIRED ON ALL CONCRETE.
8. STORM WATER POLLUTION PROTECTION SHALL BE DESIGNED, CONSTRUCTED, MAINTAINED AND SHALL BE IN TOTAL COMPLIANCE WITH THE STORM QUALITY MANUAL OF THE CITY OF SUGAR LAND. CITY ENGINEER'S APPROVAL.
9. REFER TO GENERAL, C.S.S., AND PAVEMENT NOTES.


SL-ST-12

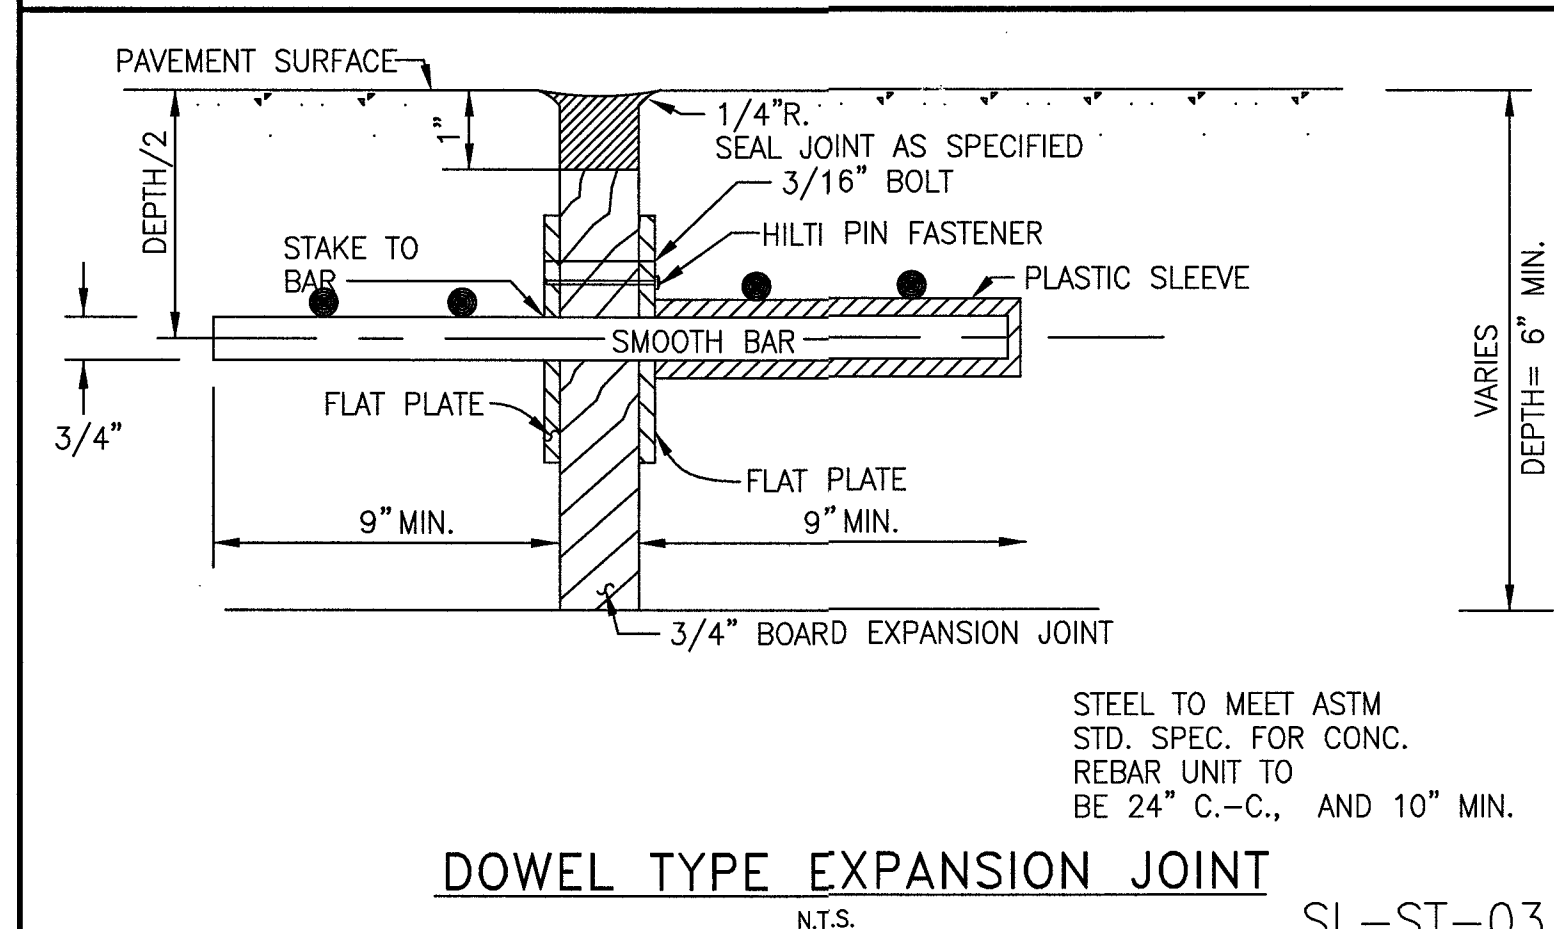


SL-ST-03

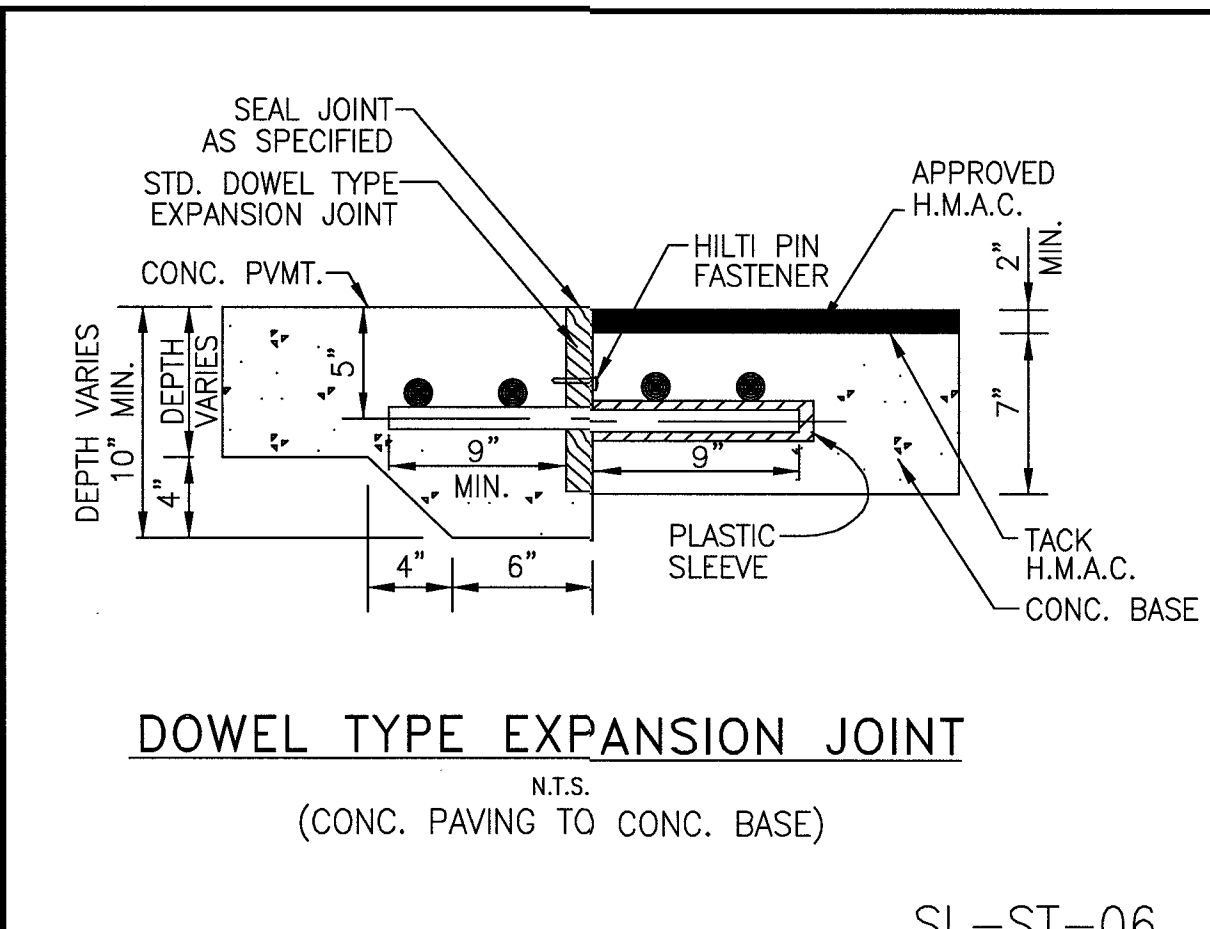


SL-ST-06

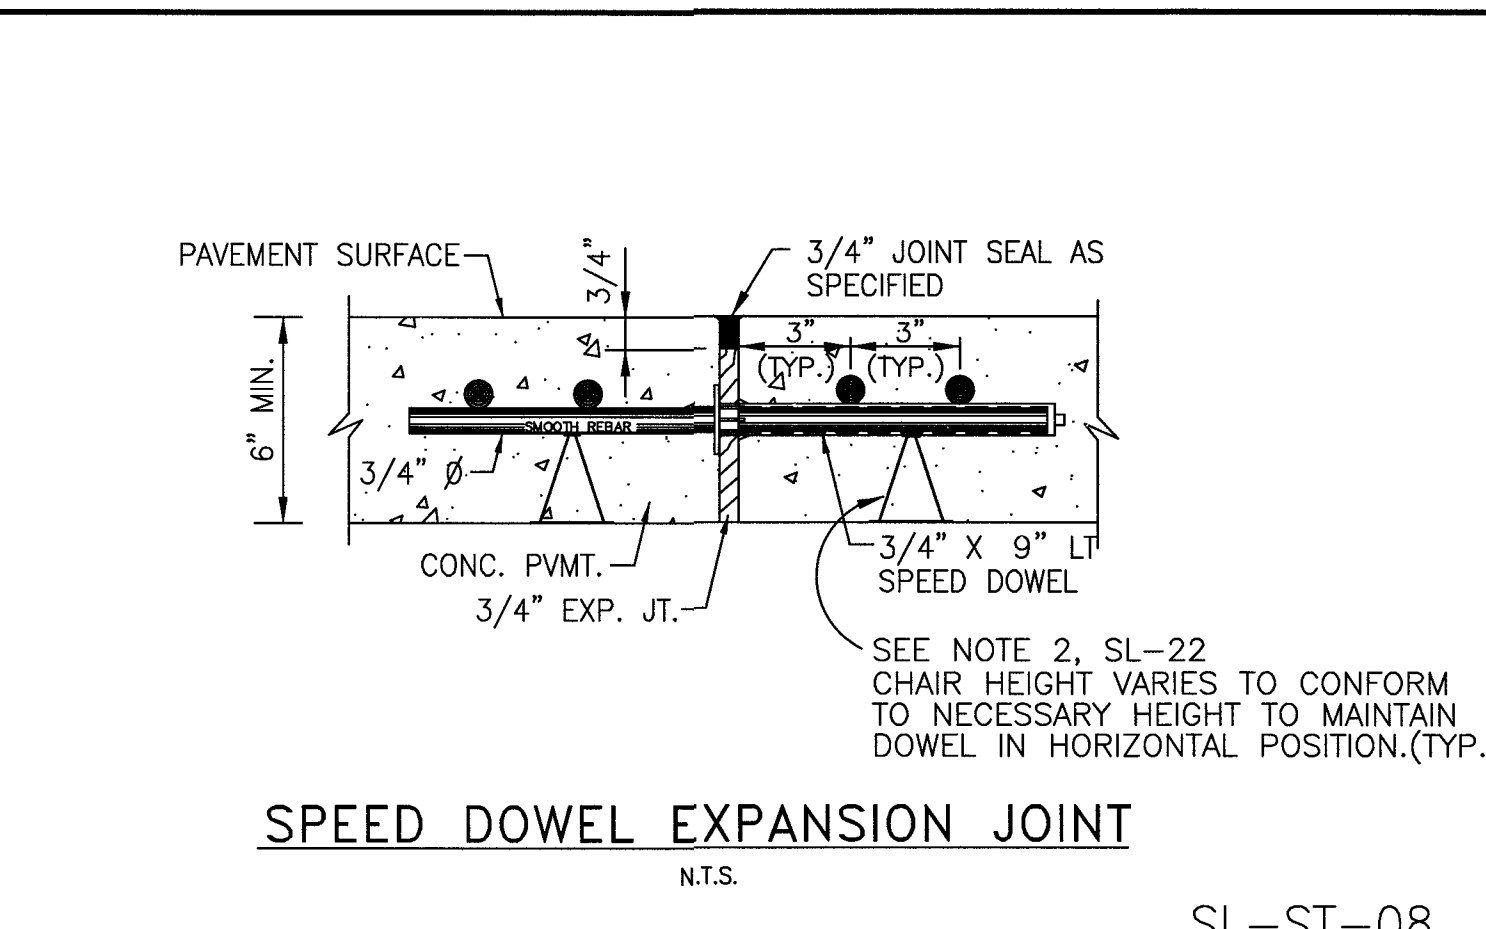


SL-ST-08

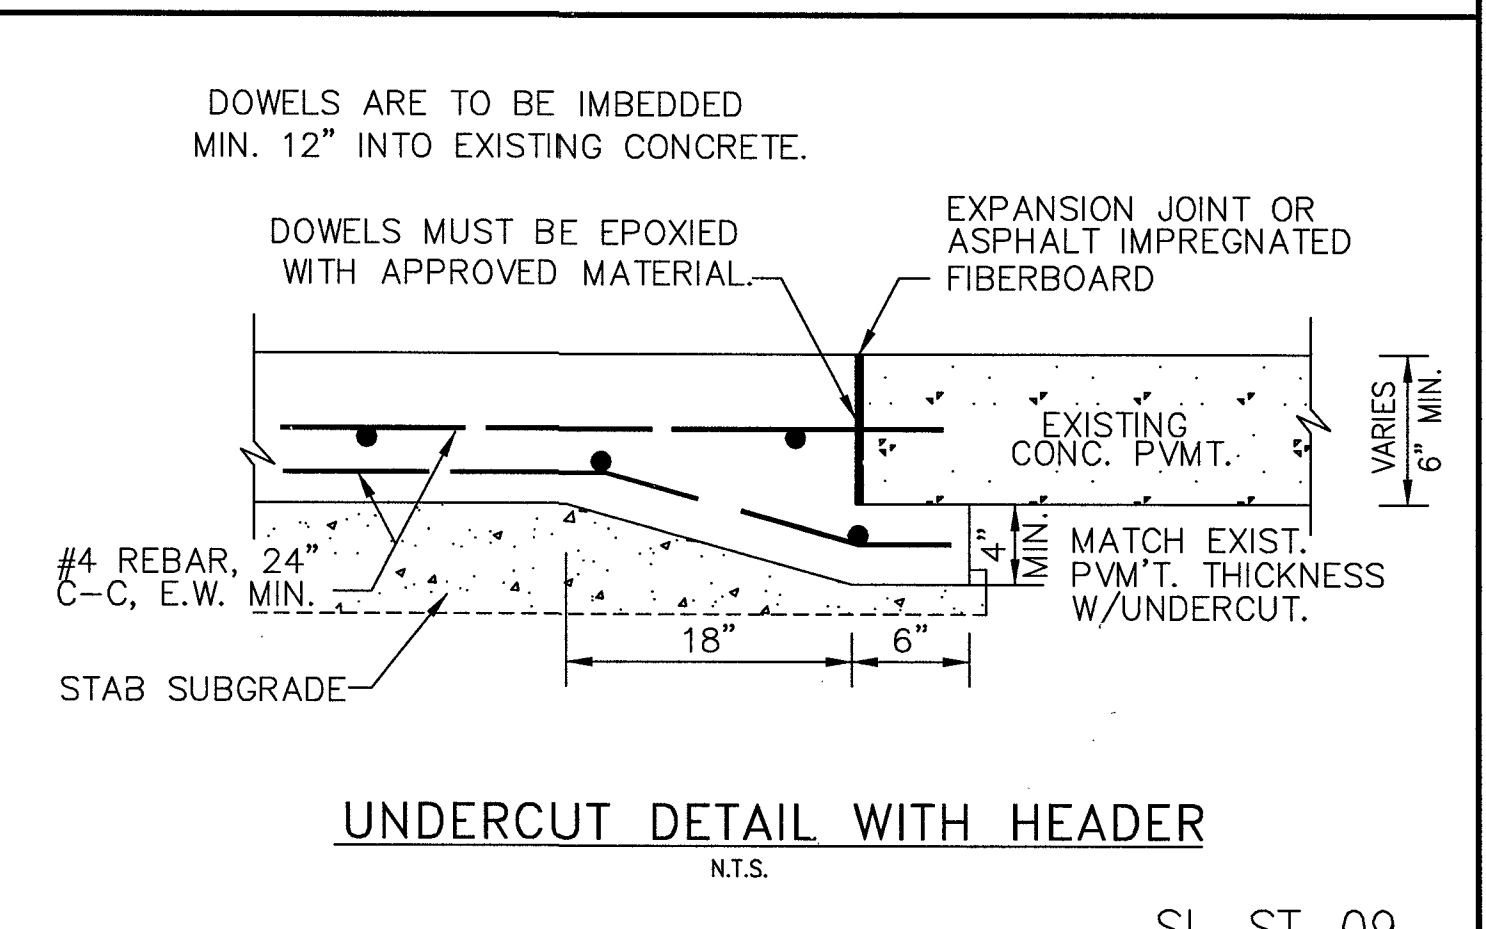


SL-ST-09

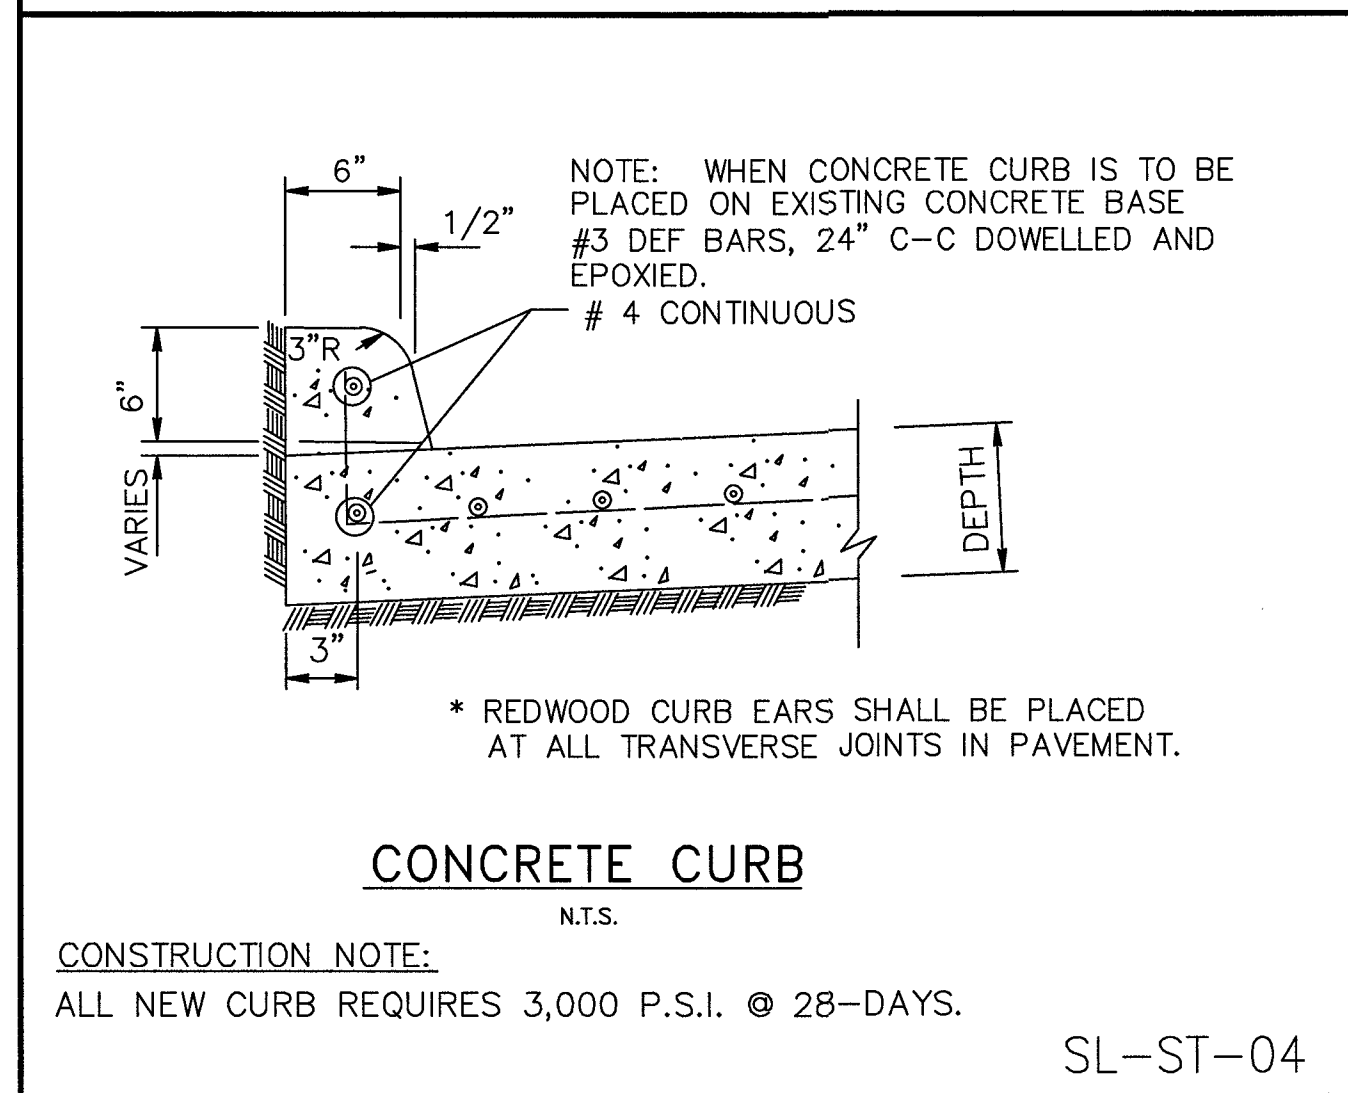


SL-ST-04

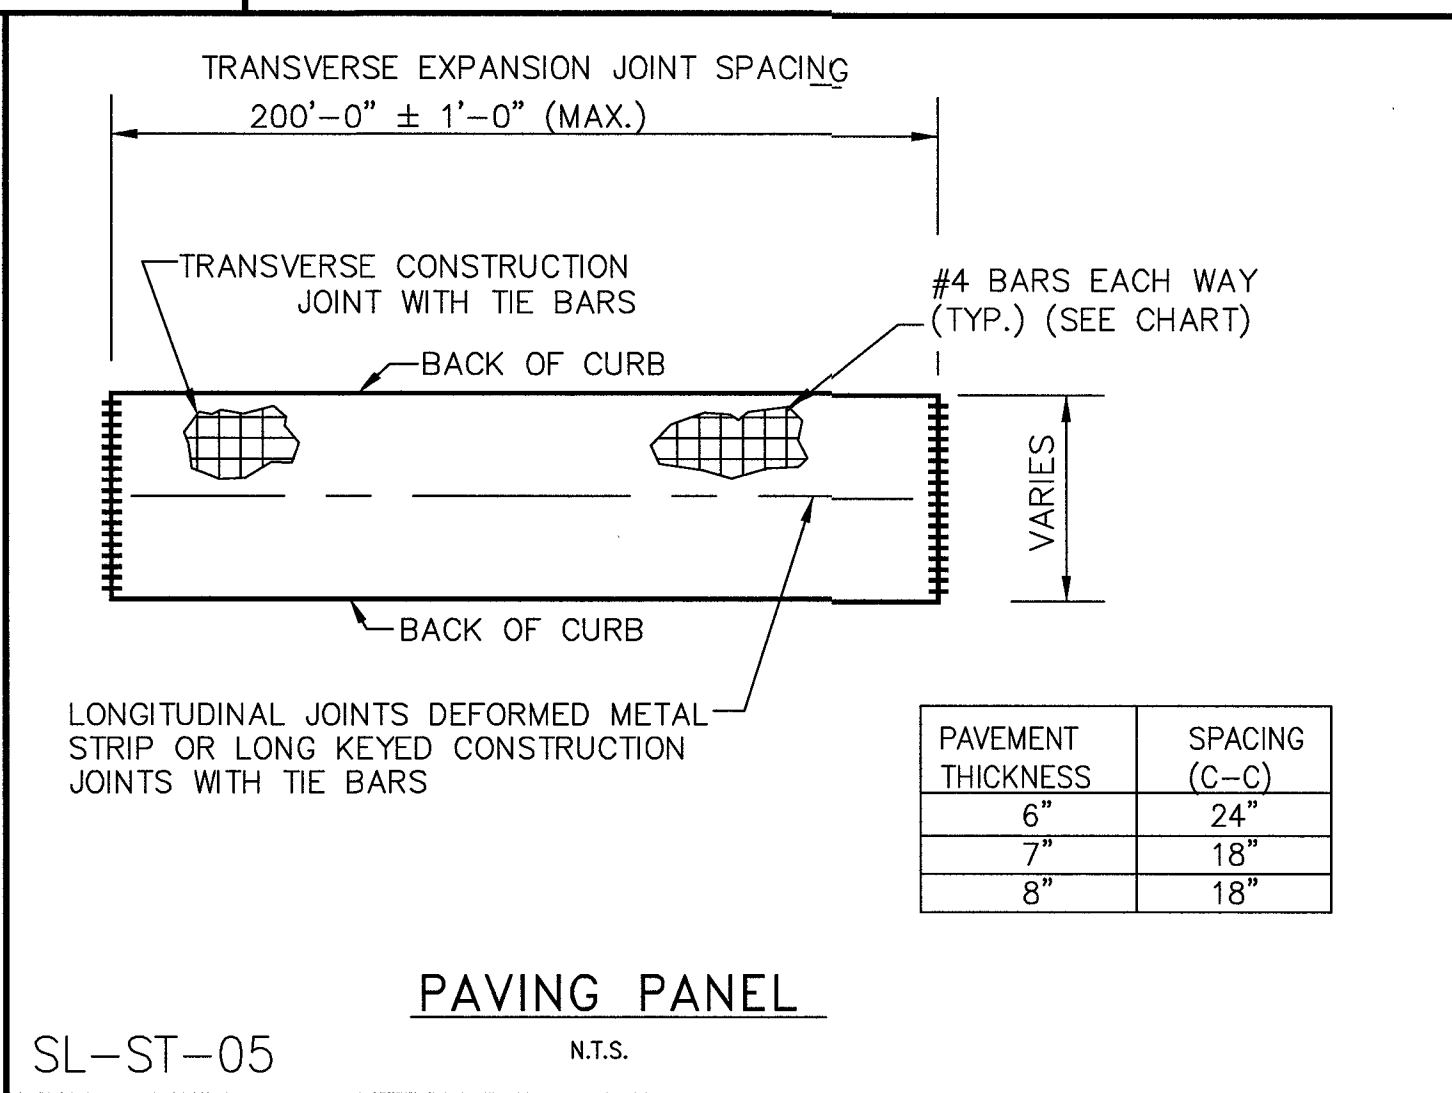


SL-ST-05

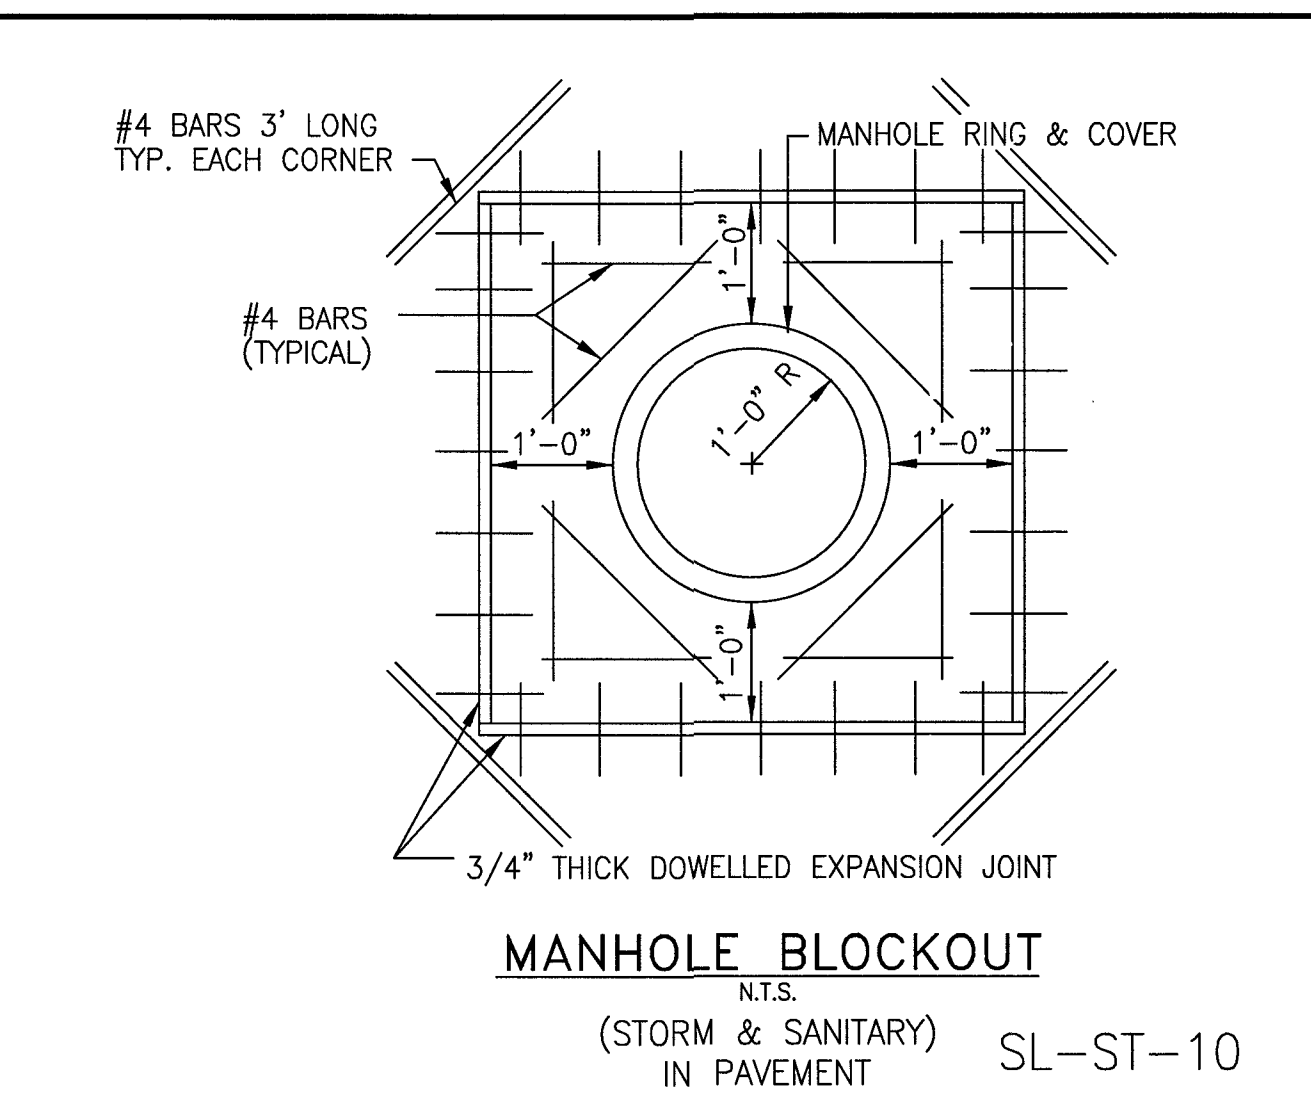

SL-ST-10

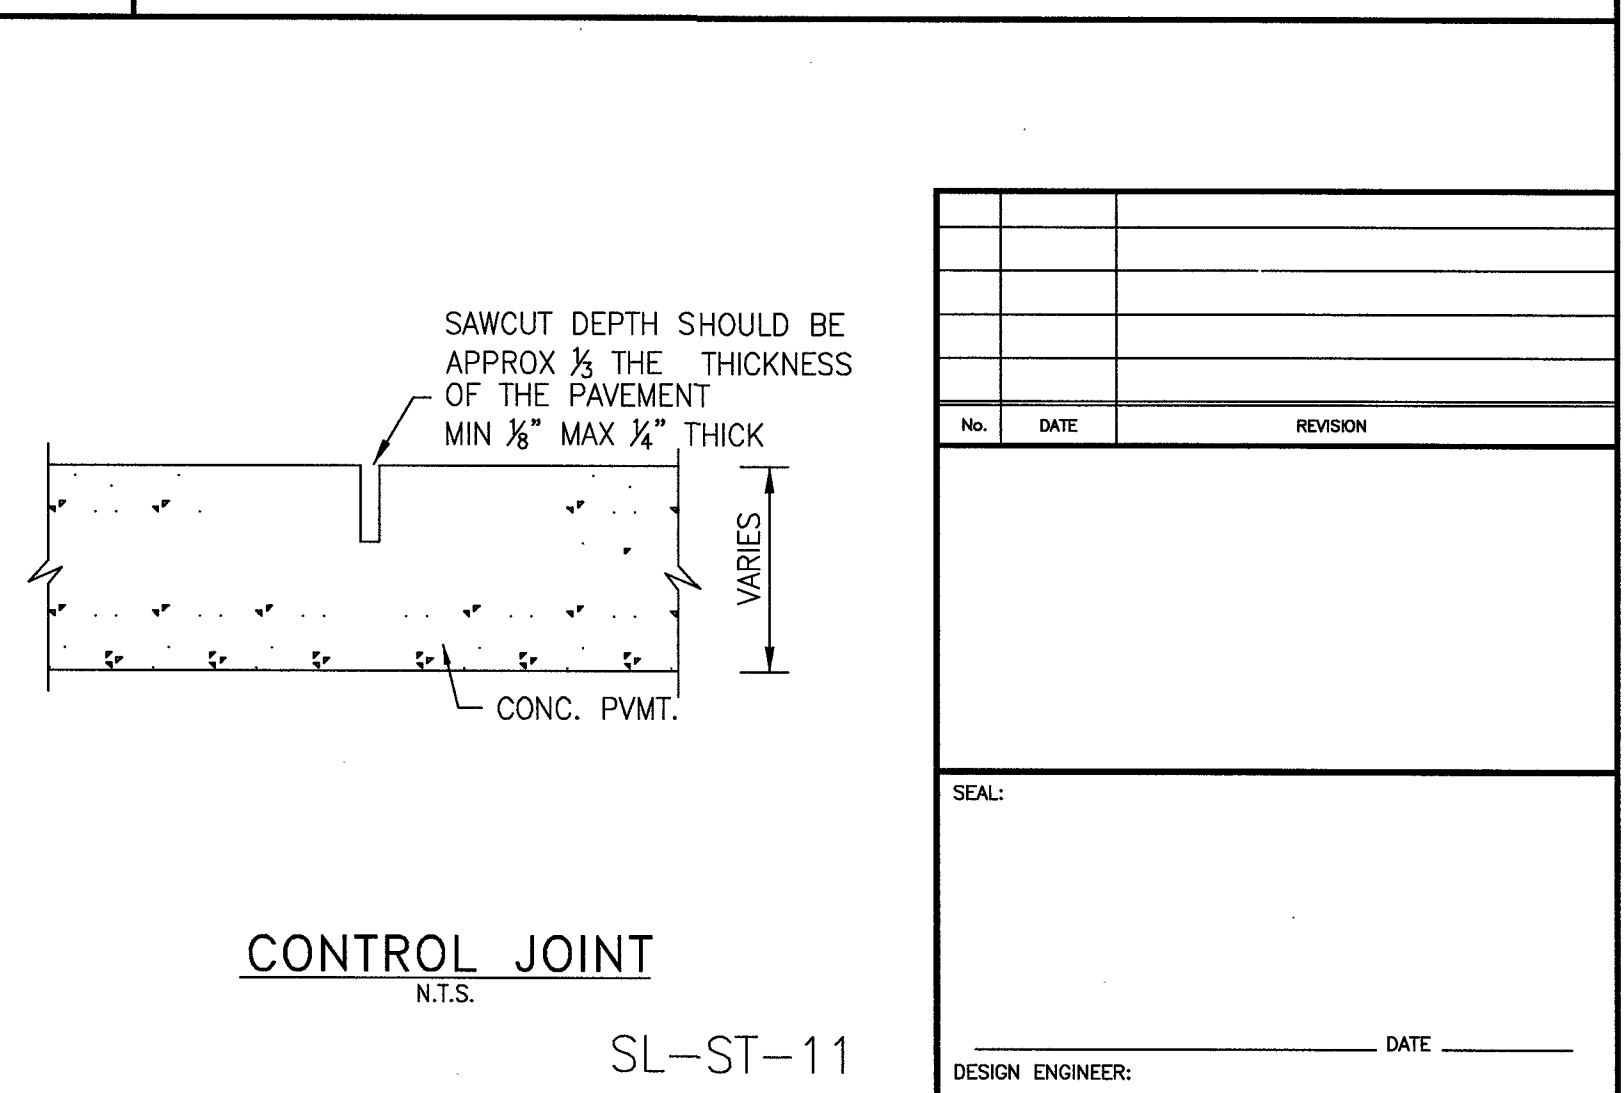


SL-ST-11

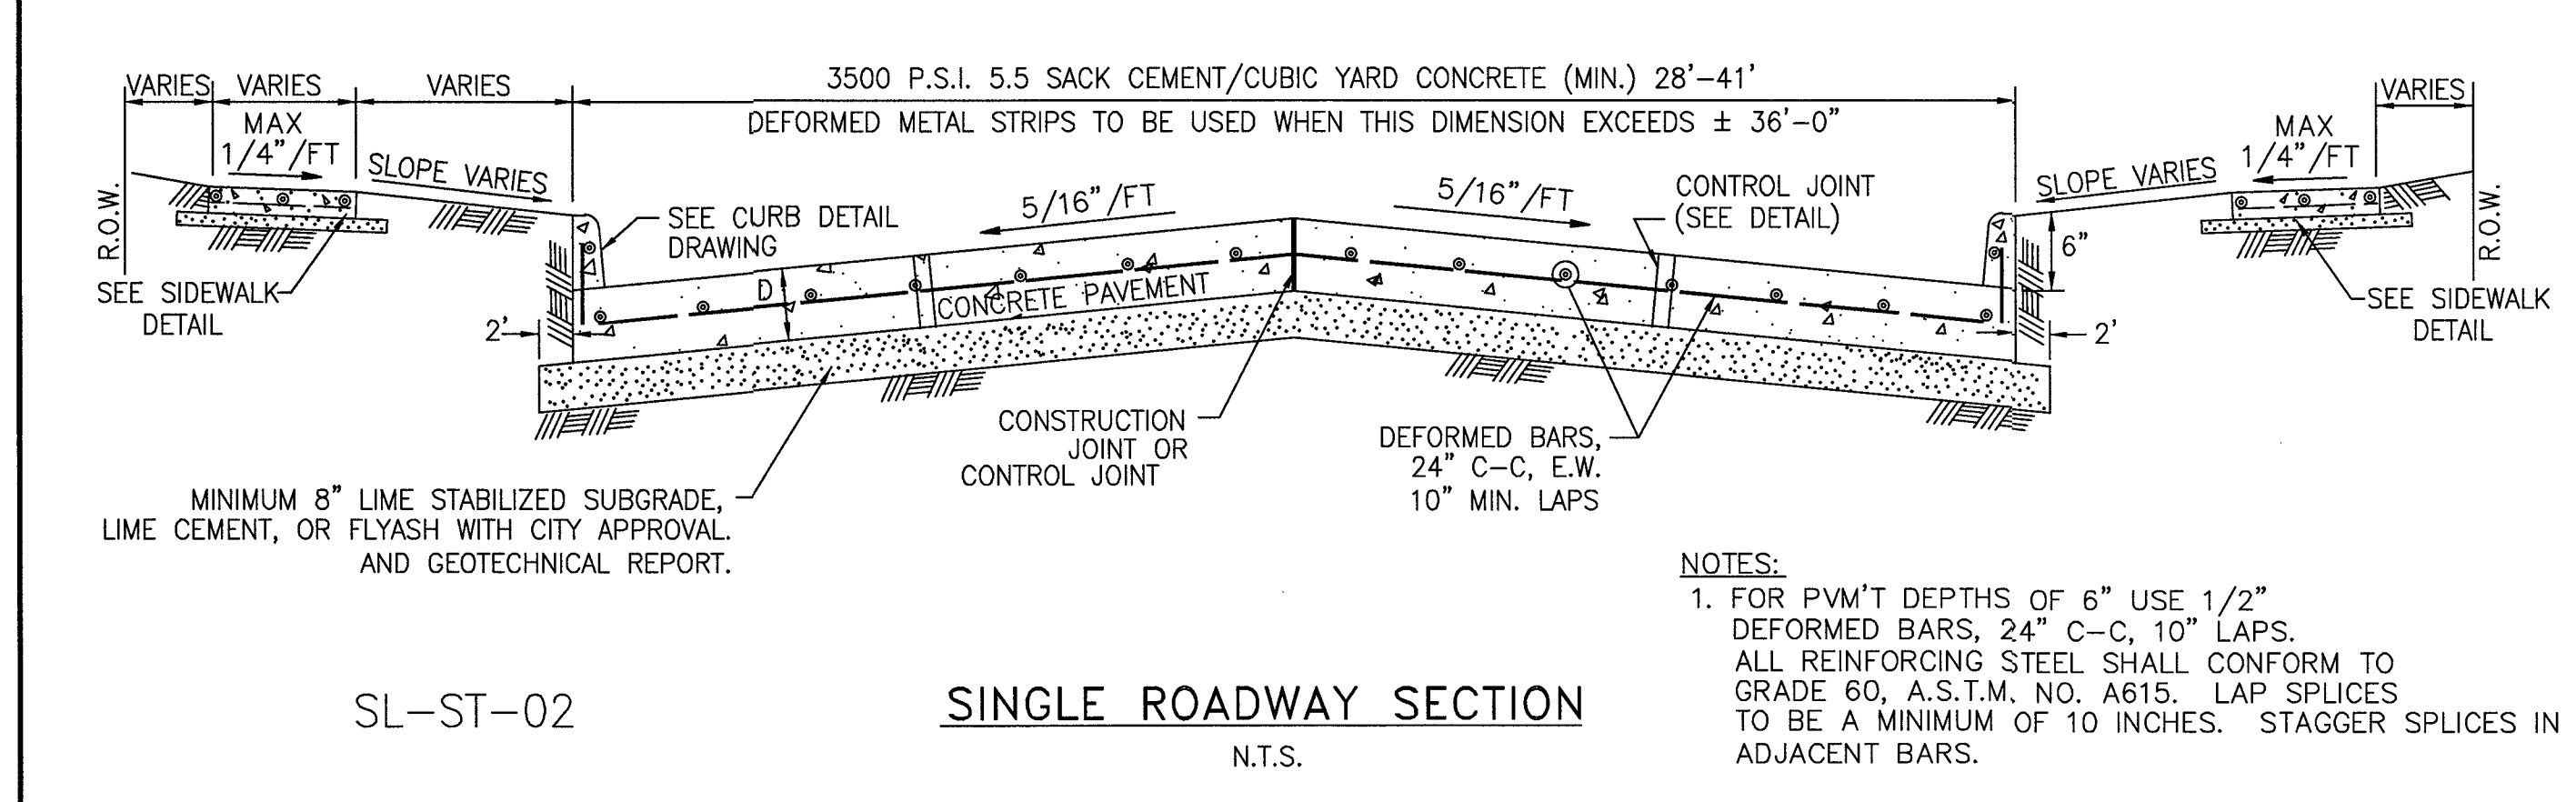


SL-ST-02

SINGLE ROADWAY SECTION

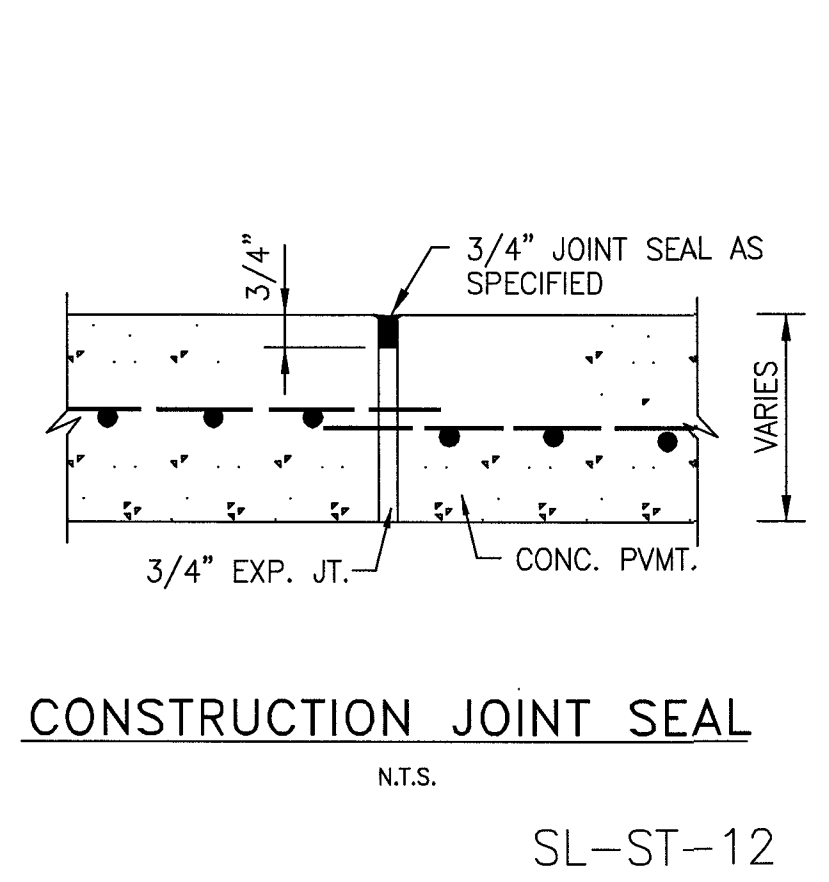

SL-ST-12

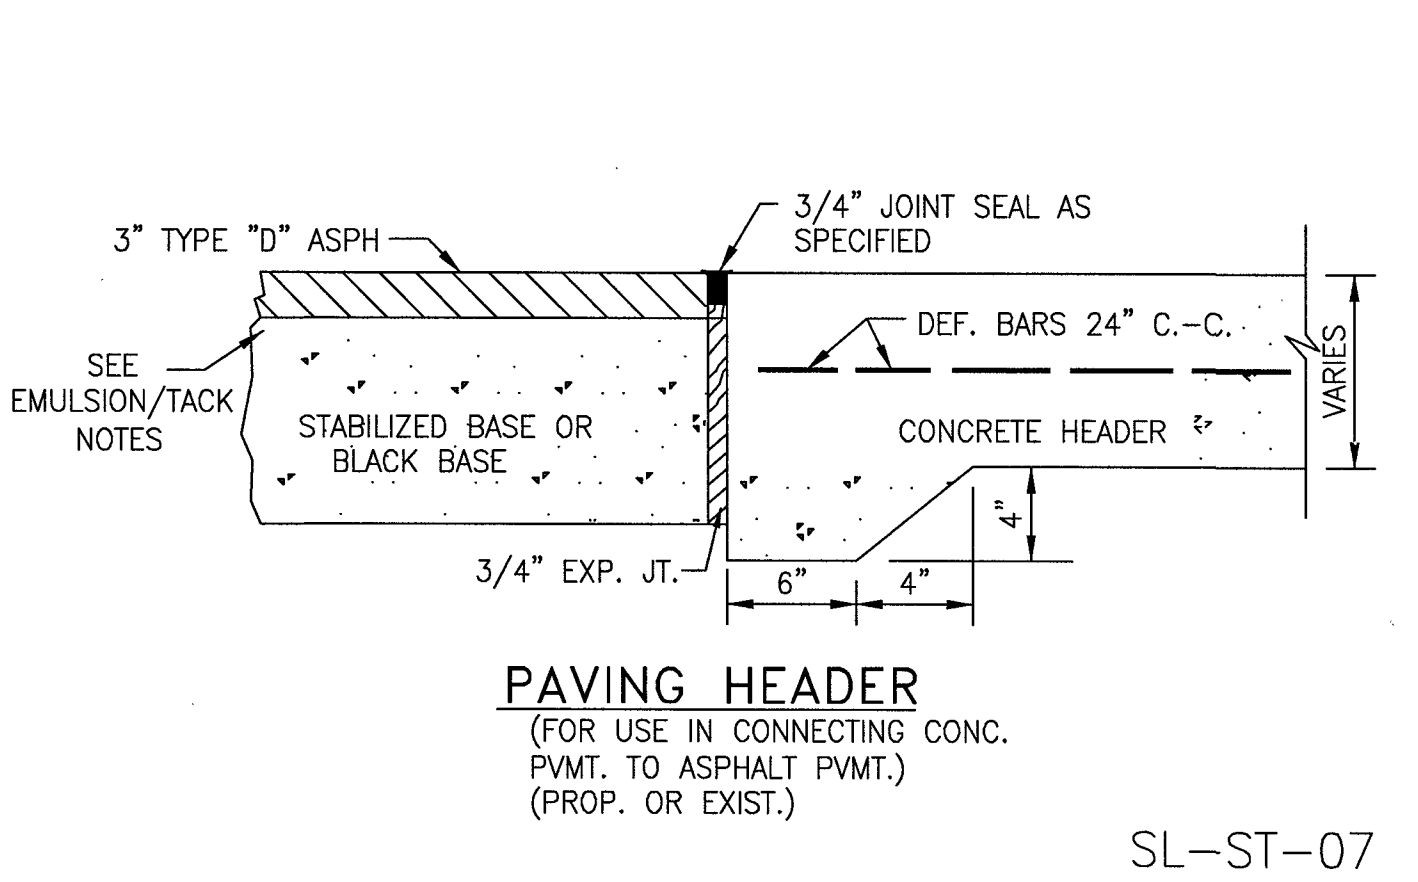

SL-ST-07

NO.	DATE	REVISION

SEAL: _____

DESIGN ENGINEER: _____ DATE: _____

CITY OF SUGAR LAND, TEXAS
ENGINEERING DEPARTMENT

CONSTRUCTION PLANS FOR:

CONCRETE PAVEMENT
CONSTRUCTION DETAILS

JOB No.: _____
DATE: _____
DRAWN BY: _____
CHECKED BY: _____
SCALE: _____

SL-21

SHEET OF

RECORD DRAWING



NO.	DATE	DESCRIPTION	APPROVED

DESIGNED DR

DRAWN BT

CHECKED

DATE

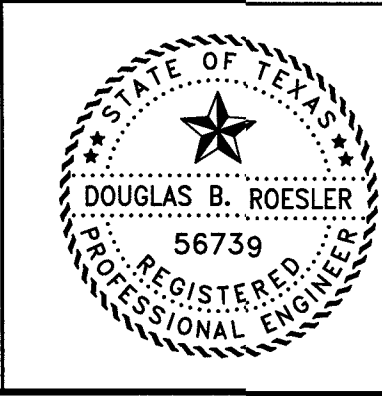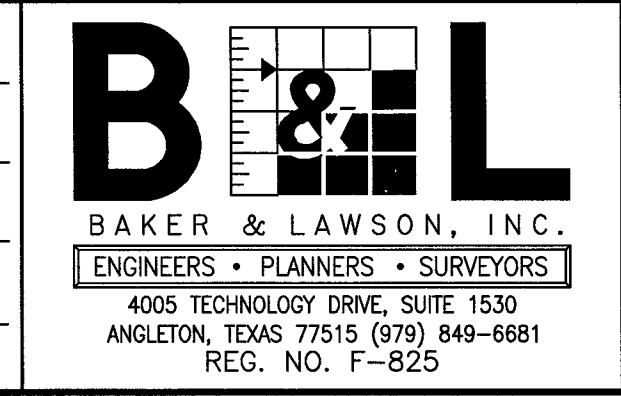

The seal appearing on this document was authorized by Douglas B. Roesler P.E. 56739

Date: 04-18-22

OWNER:

RIVERWAY PROPERTIES
6115 SKYLINE DR. STE A.
HOUSTON, TEXAS 77057

PLAN: _____

PROFILE: _____


HORIZONTAL: _____

VERTICAL: _____

RIVERWOOD RANCH SUBDIVISION
SECTION 2
A 78 AC, 109-LOT SUBDIVISION
ANGLETON, TEXAS 77515

CONCRETE PAVEMENT
CONSTRUCTION DETAILS
SL-21


PROJECT NO. 14395

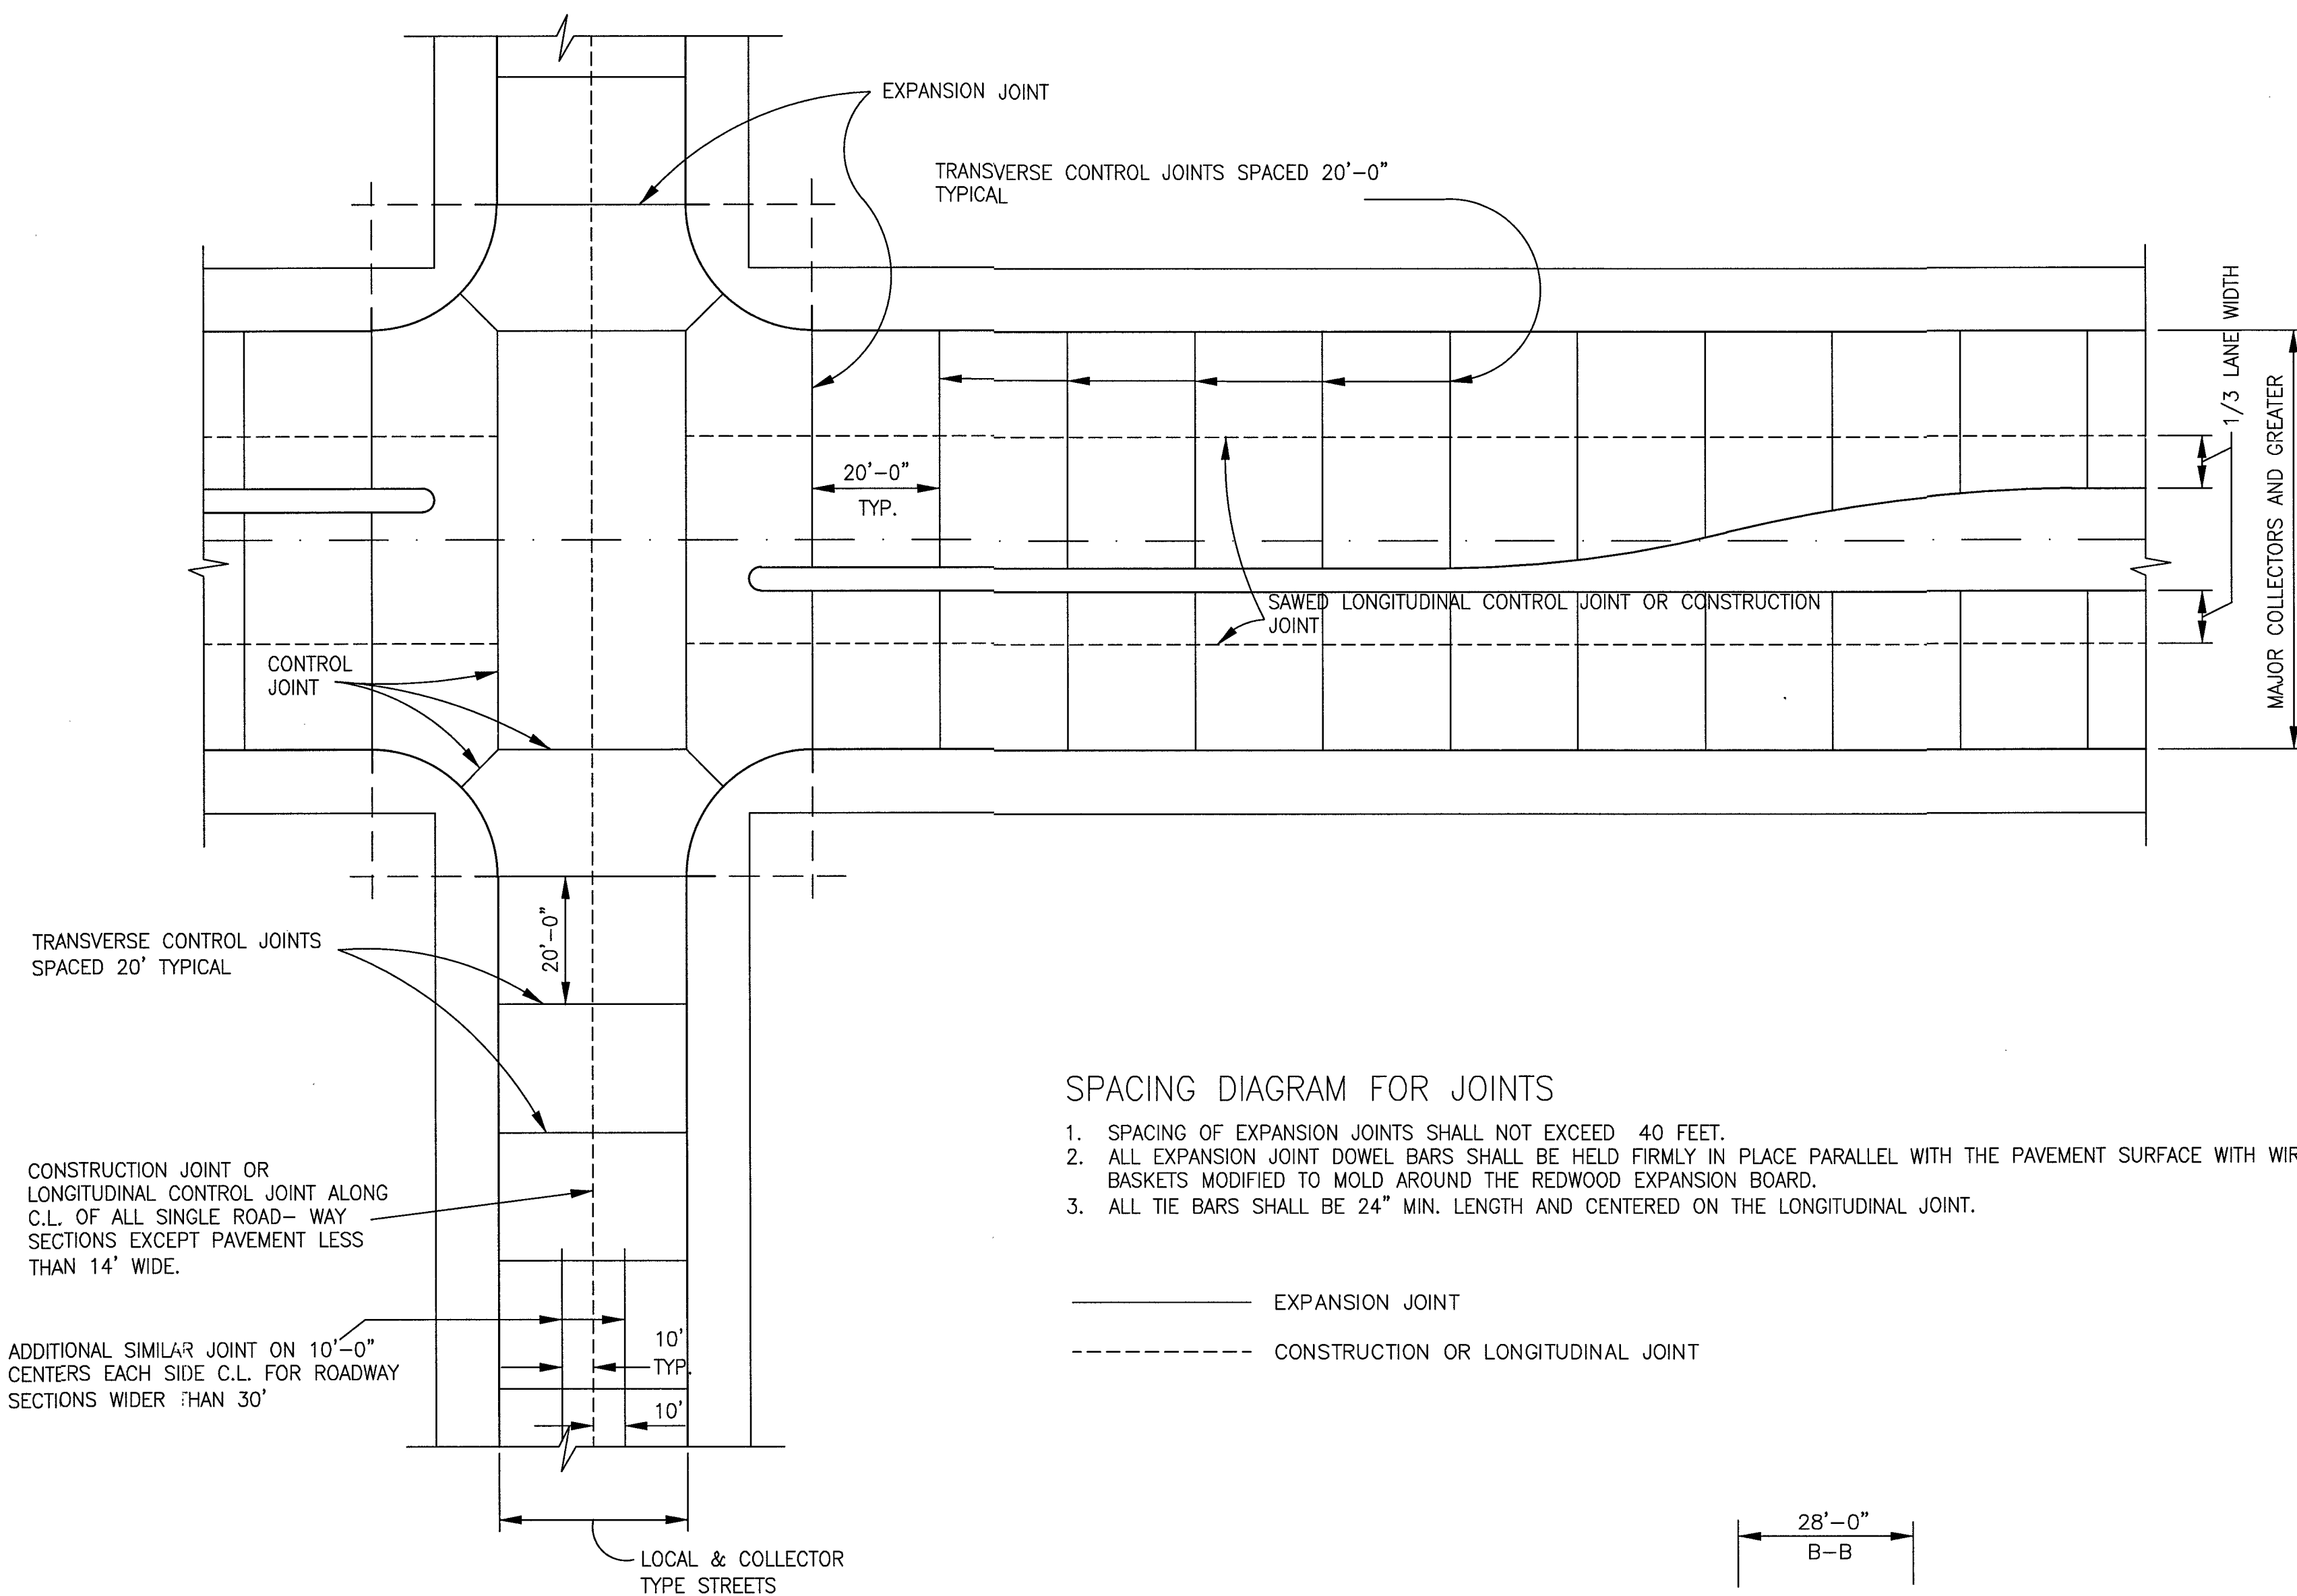


SPACING DIAGRAM FOR JOINTS

1. SPACING OF EXPANSION JOINTS SHALL NOT EXCEED 40 FEET.
2. ALL EXPANSION JOINT DOWEL BARS SHALL BE HELD FIRMLY IN PLACE PARALLEL WITH THE PAVEMENT SURFACE WITH WIRE BASKETS MODIFIED TO MOLD AROUND THE REDWOOD EXPANSION BOARD.
3. ALL TIE BARS SHALL BE 24" MIN. LENGTH AND CENTERED ON THE LONGITUDINAL JOINT.

————— EXPANSION JOINT
 - - - - - CONSTRUCTION OR LONGITUDINAL JOINT

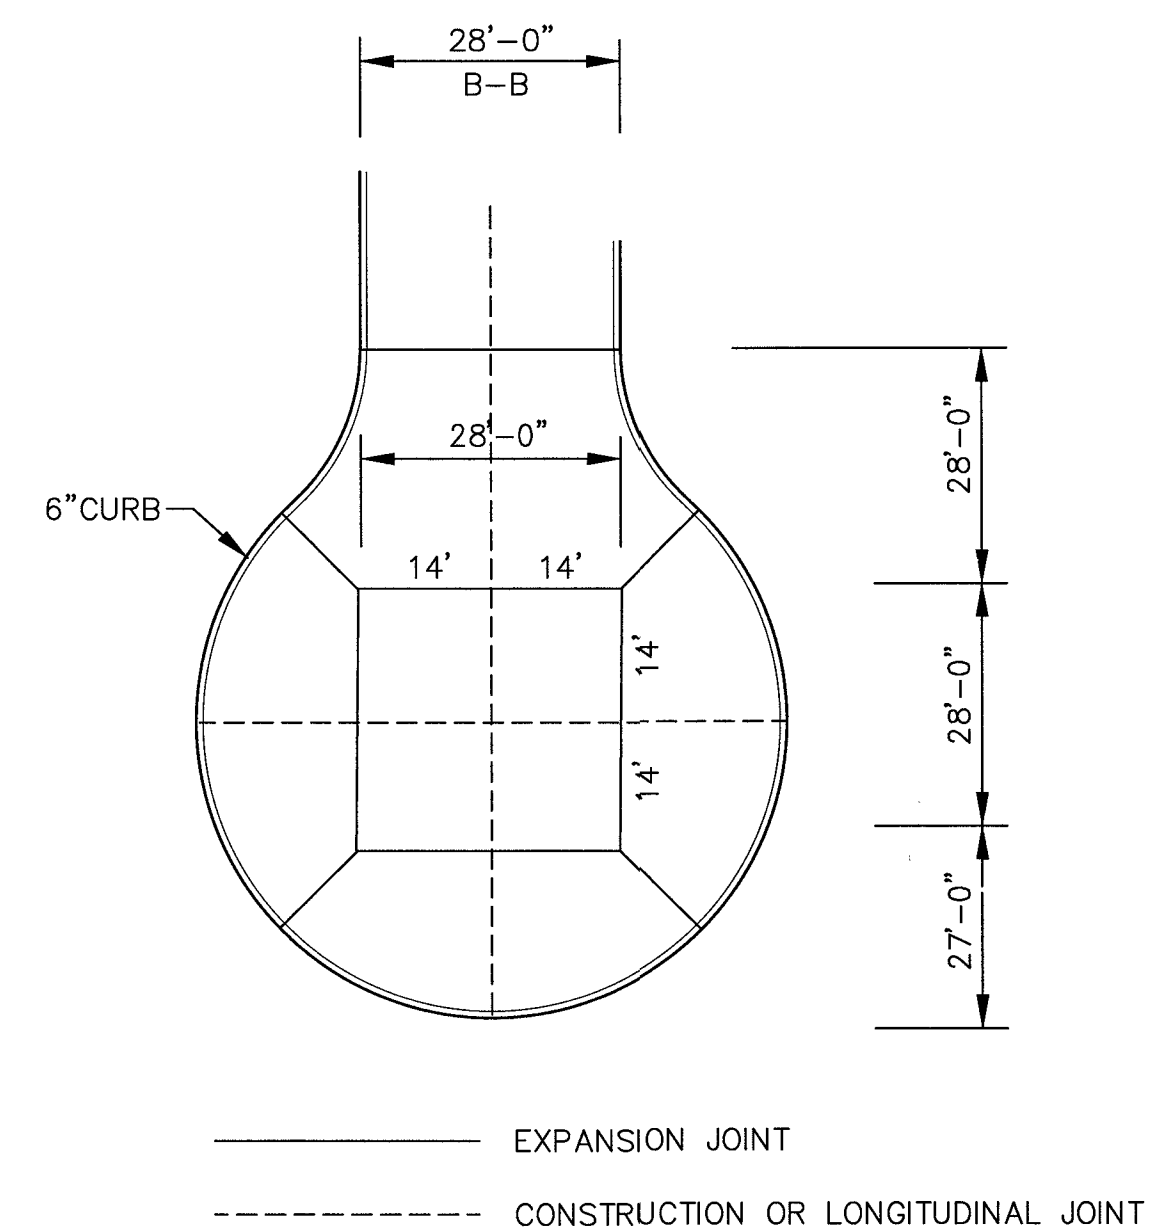

TYPICAL JOINT LAYOUT
FOR CUL-DE-SAC


No.	DATE	REVISION
SEAL:		
DESIGN ENGINEER: _____ DATE _____		
 CITY OF SUGAR LAND, TEXAS ENGINEERING DEPARTMENT		
CONSTRUCTION PLANS FOR:		
CONCRETE PAVEMENT CONSTRUCTION DETAILS		
JOB No.: DATE: DESIGNED BY: DRAWN BY: CHECKED BY: SCALE:	SL-22 SHEET OF	

RECORD DRAWING

NO.	DATE	DESCRIPTION	APPROVED

DESIGNED DR
 DRAWN BT
 CHECKED
 DATE

B & L
 BAKER & LAWSON, INC.
 ENGINEERS • PLANNERS • SURVEYORS
 4005 TECHNOLOGY DRIVE, SUITE 1530
 ANGLETON, TEXAS 77515 (979) 849-6681
 REG. NO. F-825

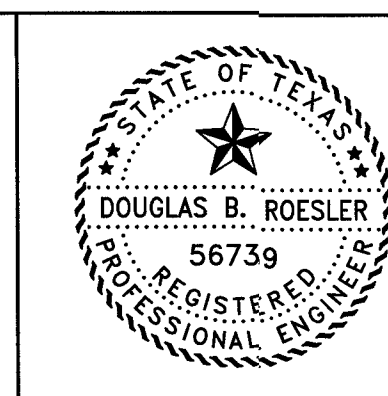

The seal appearing on this document was authorized by Douglas B. Roesler P.E. 56739
 Date: 04/18/22


OWNER:
RIVERWAY PROPERTIES
6115 SKYLINE DR. STE A.
HOUSTON, TEXAS 77057

PLAN:
 PROFILE:
 HORIZONTAL:
 VERTICAL:


RIVERWOOD RANCH SUBDIVISION
SECTION 2
A 78 AC, 109-LOT SUBDIVISION
ANGLETON, TEXAS 77515

CONCRETE PAVEMENT
CONSTRUCTION DETAILS
SL-22


PROJECT NO. 14395

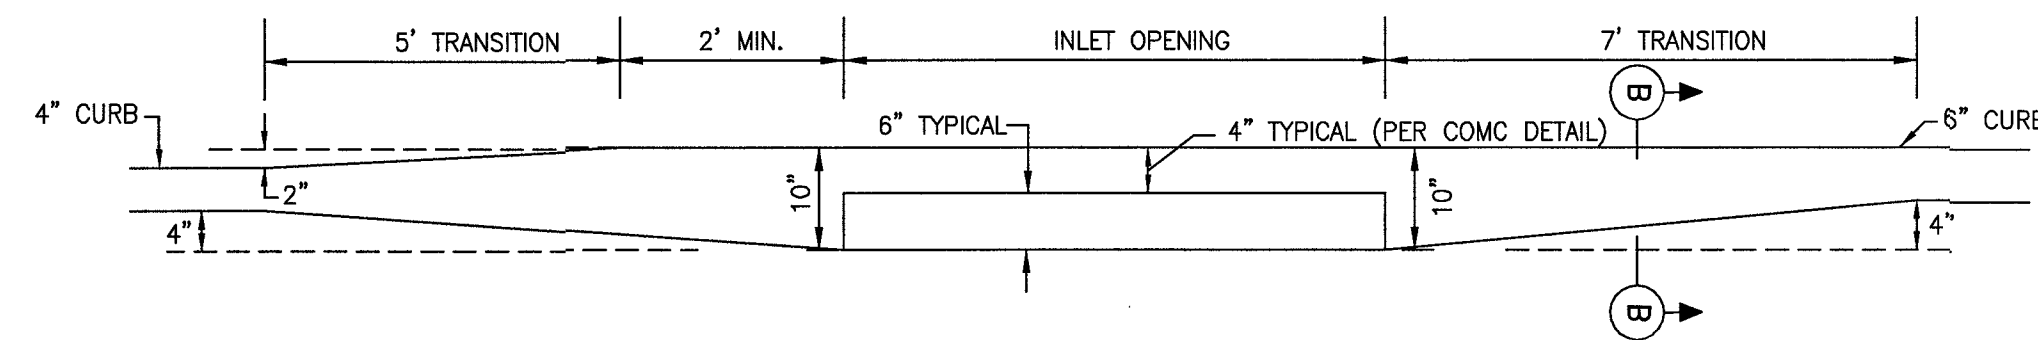


SL-ST-13

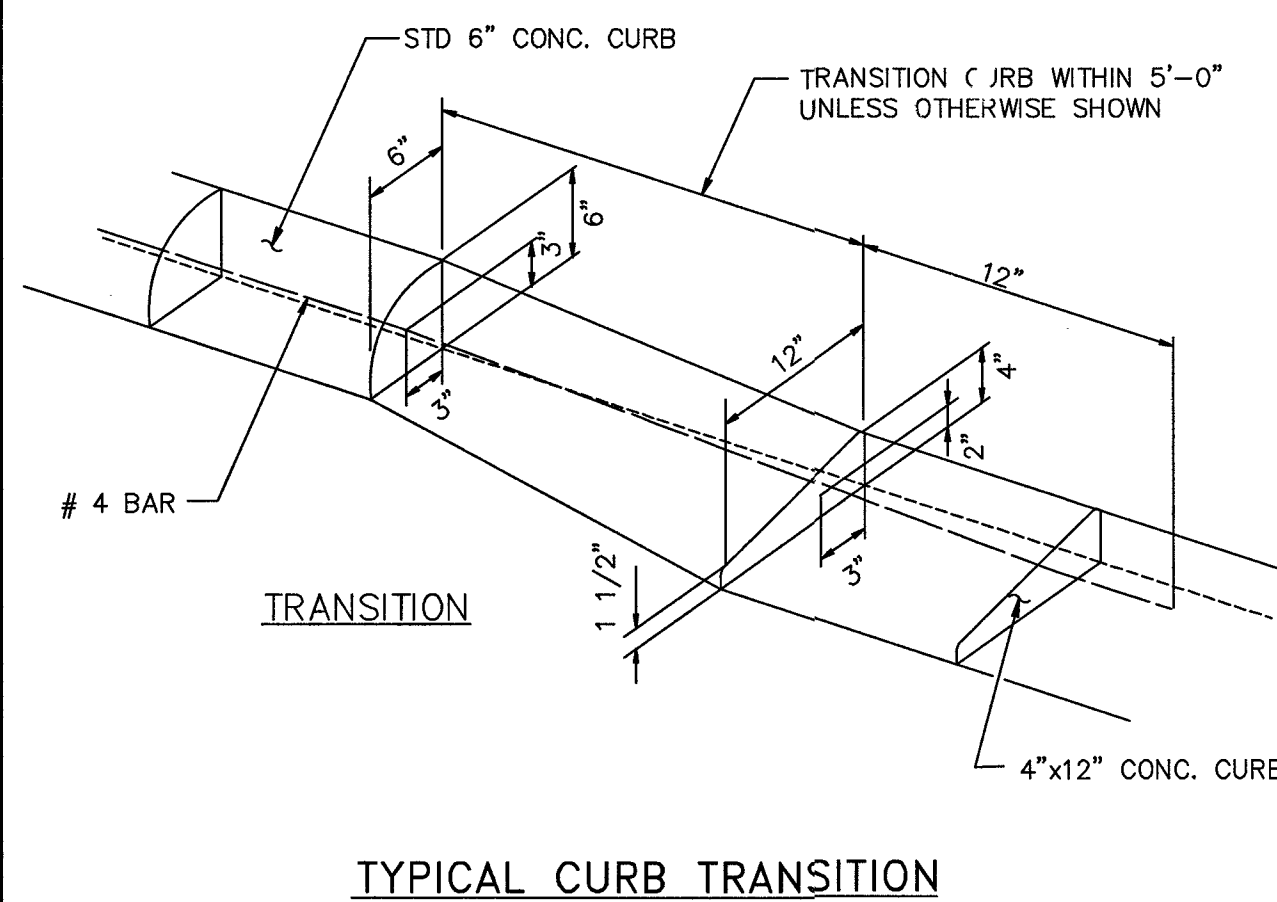

SL-ST-15

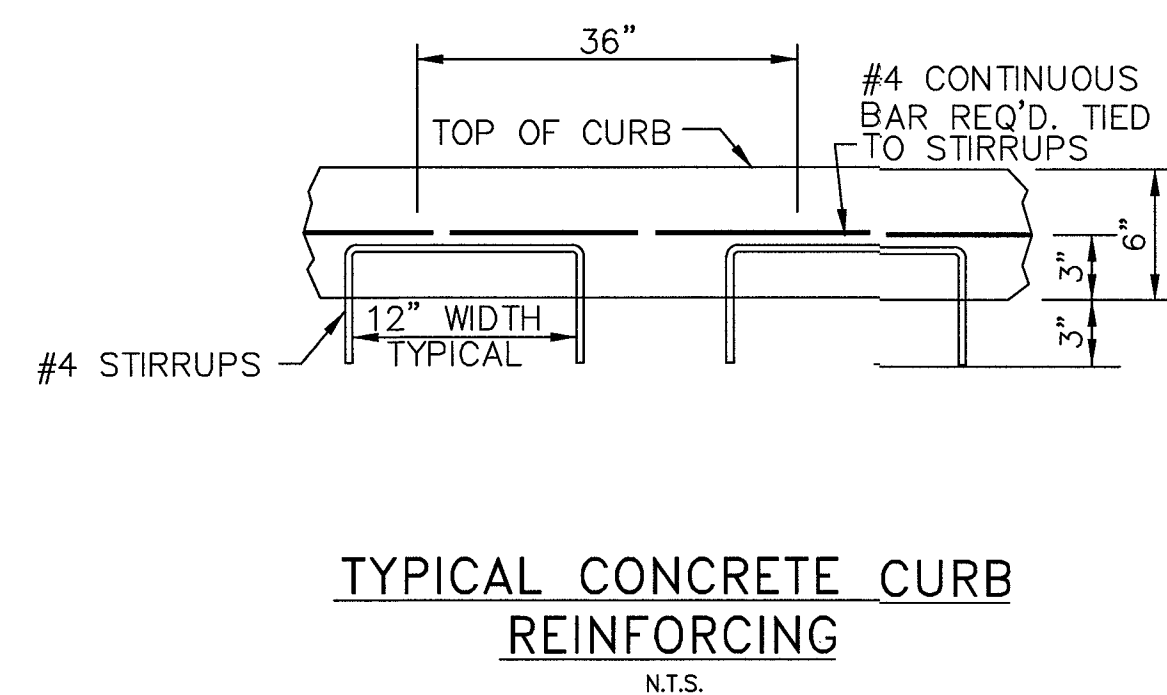

SL-ST-16

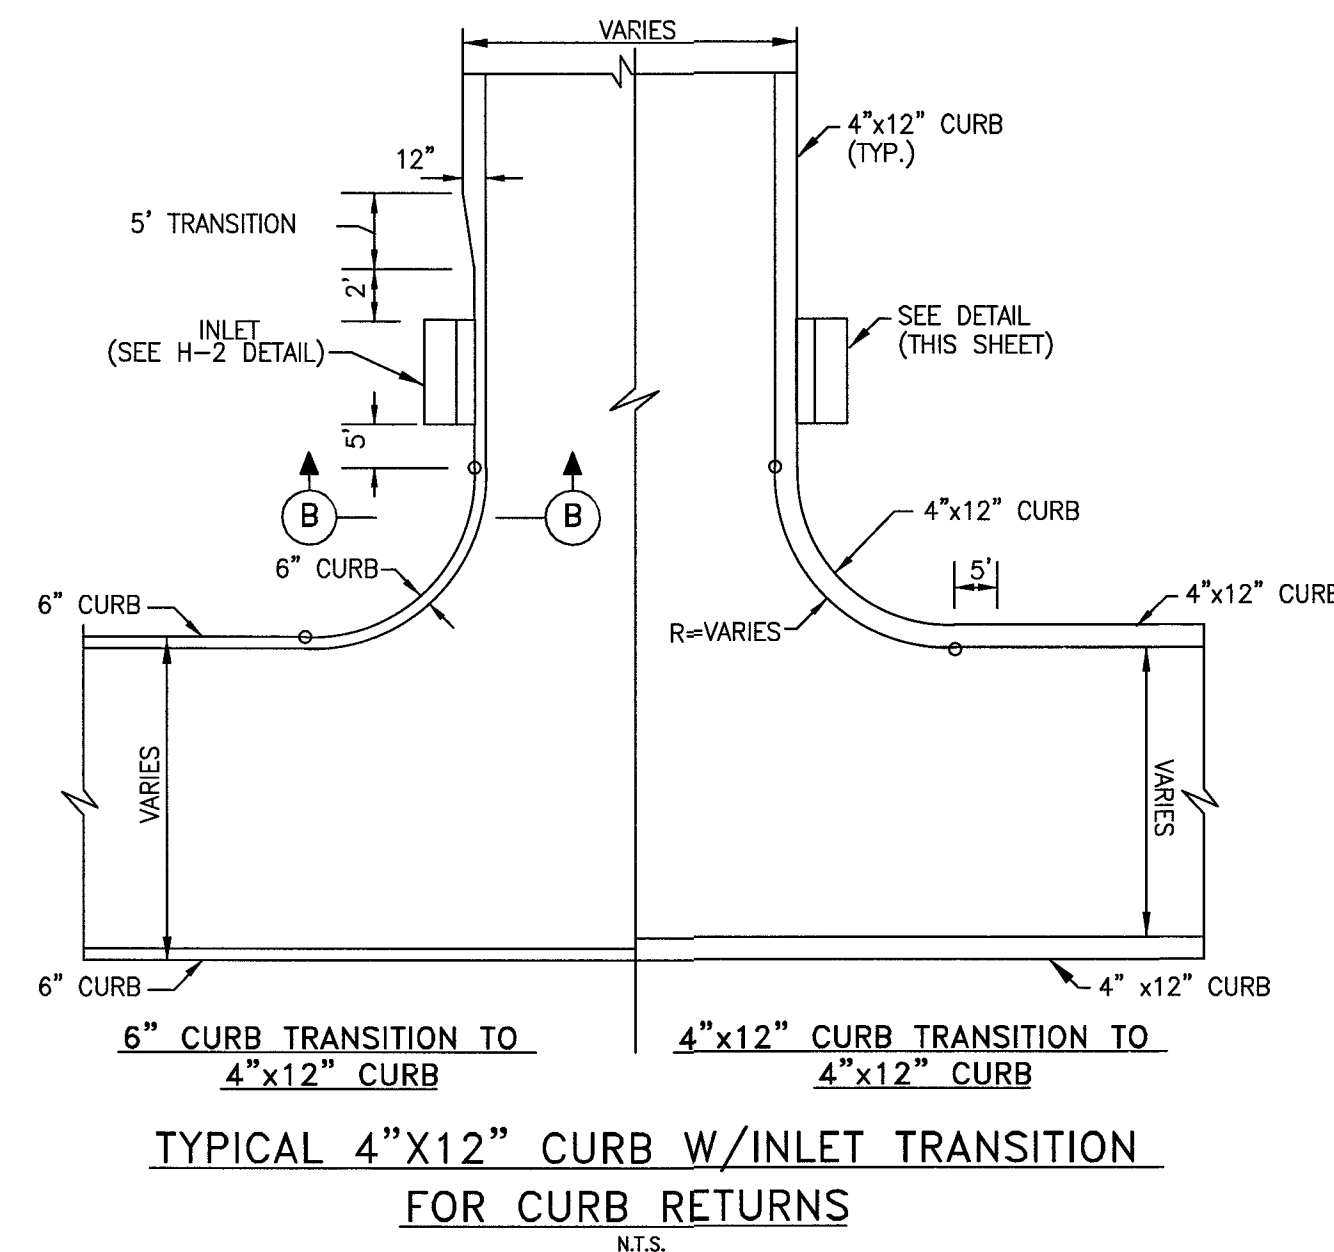


SL-ST-14


- CONSTRUCTION NOTES:

1. 6 INCH, 5.5 SACK CEMENT PER CUBIC YARD CONCRETE, 3500 PSI REINFORCED CONCRETE WITH #4 BARS 24 INCHES C-C, E.W. IS THE MINIMUM ACCEPTABLE PAVEMENT CONSTRUCTION FOR RESIDENTIAL STREETS.
2. 7 INCH, 5.5 SACK CEMENT PER CUBIC YARD CONCRETE, 3500 PSI REINFORCED CONCRETE WITH #4 BARS 24 INCHES C-C, IS THE MINIMUM ACCEPTABLE PAVEMENT CONSTRUCTION FOR COLLECTOR STREETS
3. EIGHT (8) INCH, 5.5 SK, 3500 PSI @ 28 DAYS, REINFORCED WITH #4 18" C.C. EACH WAY IS THE MINIMUM ACCEPTABLE FOR ARTERIAL STREETS.
4. TRANSVERSE EXPANSION JOINTS SHALL BE PLACED AT ALL POINTS OF CURVATURE, POINTS OF TANGENCY AND ALL INTERSECTION CURB RETURN POINTS MAXIMUM SPACING SHALL BE 200' AND BE SEALED CONFORMING TO TxDOT ITEM 360 (& ITEM 438) AND TxDOT DMS-6310, CLASS-2.
5. TRANSVERSE CONTROL JOINTS ARE REQUIRED AT MAXIMUM SPACING OF 20'-0" C-C, AND VERTICAL CURB JOINTS TO BE SEALED WITH SPECIAL JOINT SEALANT ASTM-D-1190-74 OR AASHTO-M173-60 FOR PAVEMENT 8" THICK AND GREATER. (ELASTONETRIC TYPE HOT POURED)
6. PAVEMENT FINISH SHALL BE BAKER BROOM FINISH. CURING COMPOUND ON ALL CONCRETE.
7. STORM WATER POLLUTION PROTECTION SHALL BE DESIGNED, CONSTRUCTED, MAINTAINED AND SHALL BE IN TOTAL COMPLIANCE WITH THE STORM WATER QUALITY MANUAL OF THE CITY OF SUGAR LAND.
8. UNSTABLE SUBGRADE SHALL BE EXCAVATED AND REPLACED WITH CEMENT STABILIZED SAND.
9. USE 1"x2" REDWOOD STAKES FOR HEADERS.
10. EDGE ALL SIDES WITH EDGING TOOL.
11. DOWEL SHALL BE 3/4" DIAMETER, WITH MINIMUM 8" PENETRATION (BOTH SIDES).
12. IT IS THE CONTRACTOR'S RESPONSIBILITY TO NOTIFY THE CITY OF SUGAR LAND OF ANY BIRDBATH PROBLEMS PRIOR TO CONSTRUCTION OF DRIVEWAY.
13. REFER TO GENERAL, C.S.S., AND PAVEMENT NOTES.
14. 1.0 LBS. OF APPROVED POLYPROPYLENE FIBER MESH PER C/Y IN 4"x12" CURBS REQUIRED.


SL-ST-20

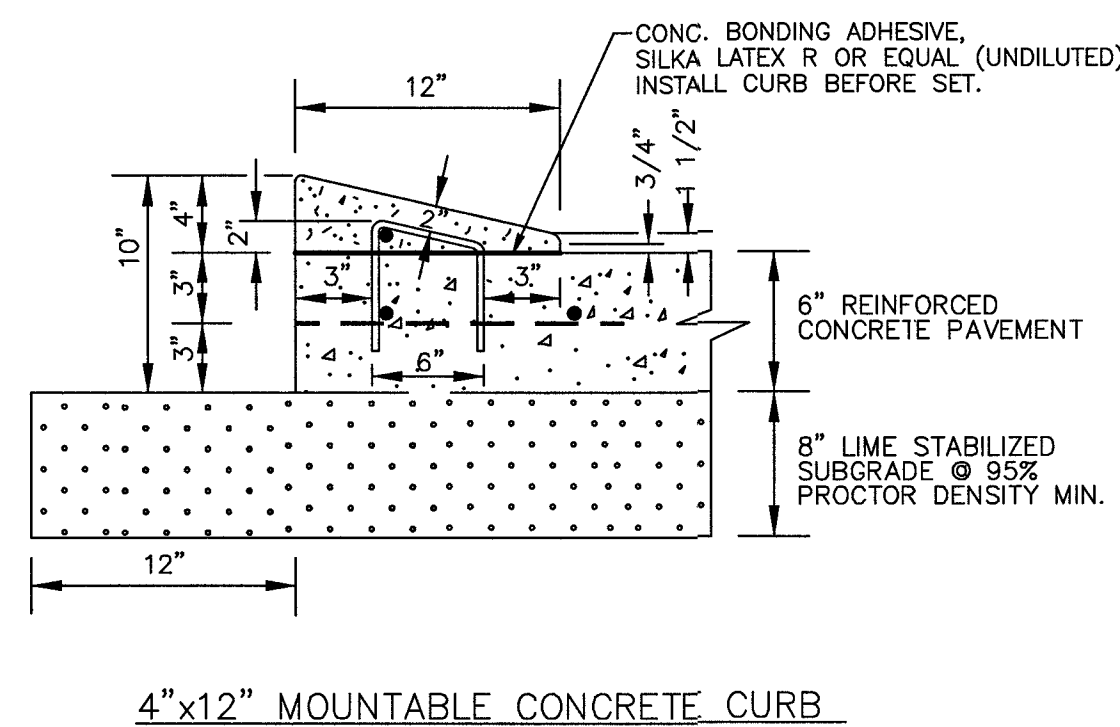

SL-ST-17

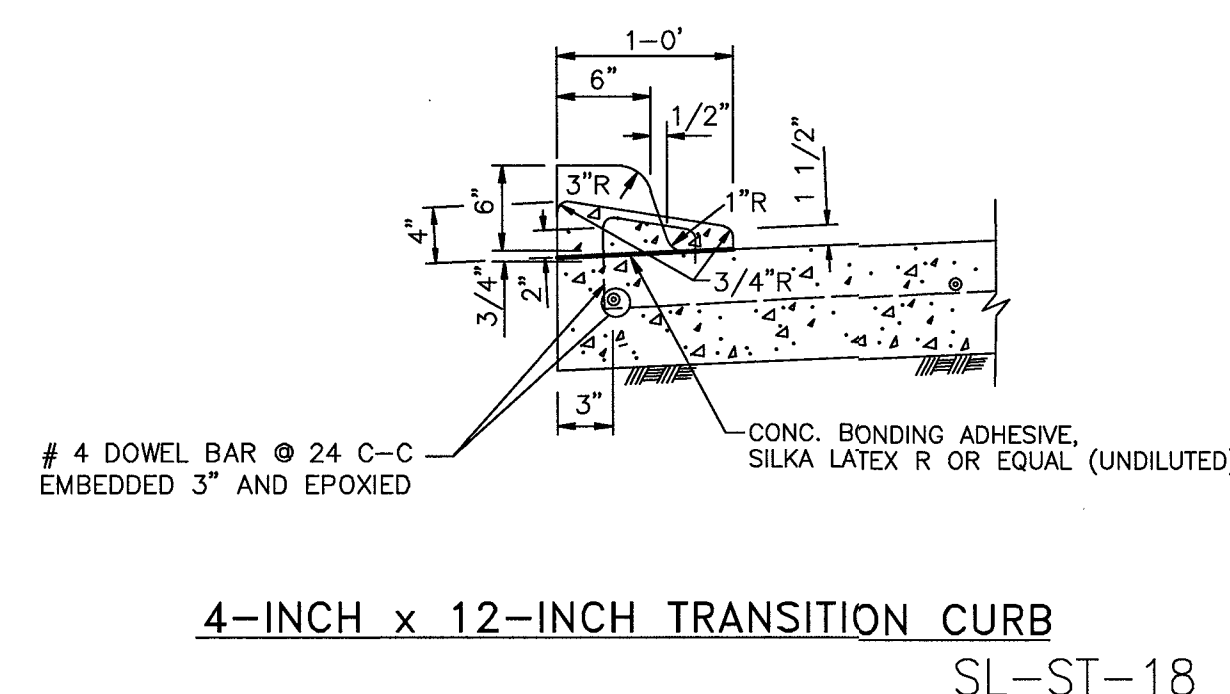


SL-ST-18

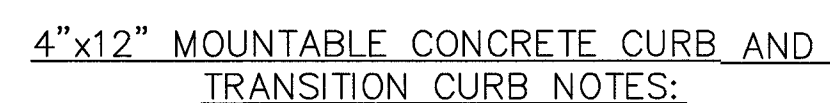

1. 6-INCH CONCRETE CURB TO BE CONSTRUCTED ON ALL ESPLANADES, ISLANDS AND NON-RESIDENTIAL STREETS. RESIDENTIAL STREETS MAY BE CONSTRUCTED WITH EITHER 6-INCH CONCRETE CURB OR 4-INCH X 12-INCH CONCRETE CURB AS SHOWN ON PLAN.
2. ALL 4-INCH X 12-INCH CONCRETE CURBS TO BE POURED SEPARATE FROM PROPOSED CONCRETE PAVEMENT.
3. TRANSITIONS FROM 6-INCH CONCRETE CURB TO 4-INCH X 12-INCH CONCRETE CURB TO BE ACCOMPLISHED WITHIN 5 FEET (TYPE), UNLESS OTHERWISE SHOWN. REINFORCING SEE "AS SHOWN IN "4-INCH X 12-INCH TRANSITION CURB" DETAIL IS TO BE INSTALLED.

SL-ST-20

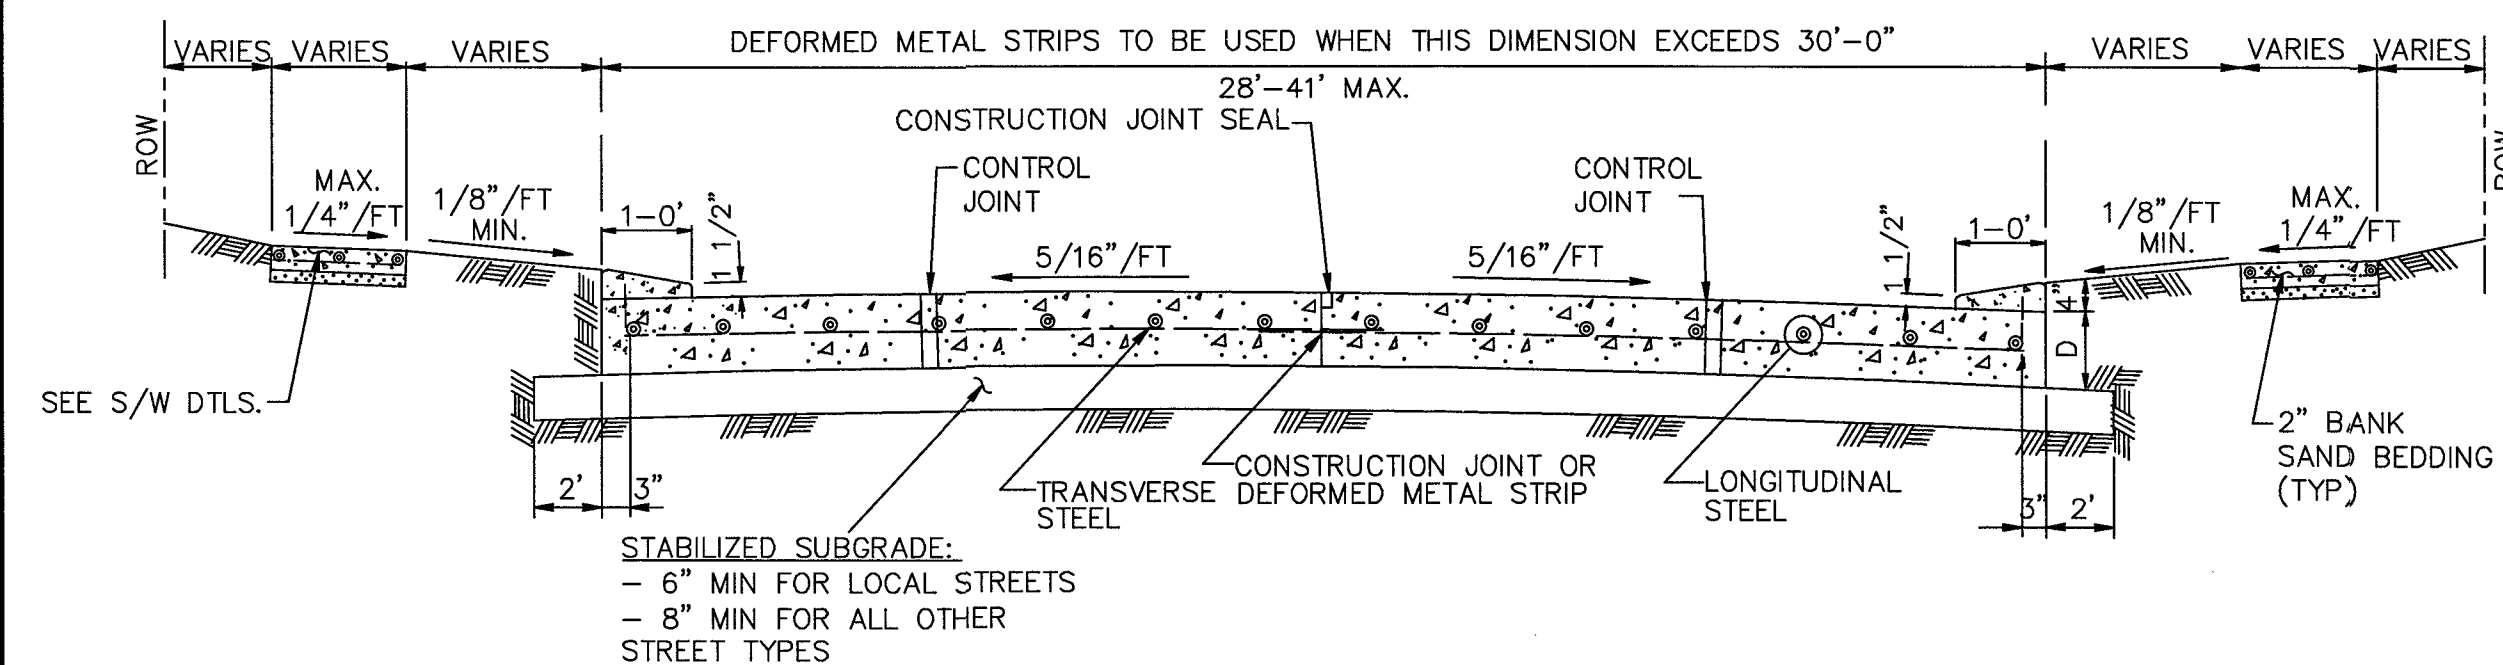

TYPICAL SINGLE ROADWAY SECTION FOR
CONCRETE PAVEMENT WITH 4"X12" CURB

* SEE 4" x 12" MOUNTABLE CURB DETAIL
(THIS SHEET)

SL-ST-19

																																																																																																																																																																																																																																																																																																																																																																																																																																																																																																																																																																																																																																																																																																																																																																																																																																																																																																																																																																																																																																																																																																																																																																																																																																																																																																																																																																																																																					</
--	--	----



[illegible]


DESIGNED DR

DRAWN BT

CHECKED

DATE _____

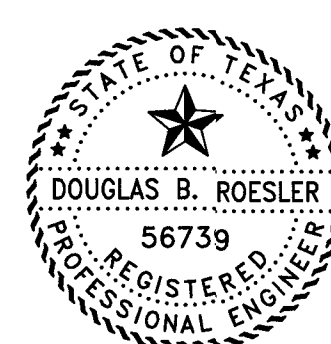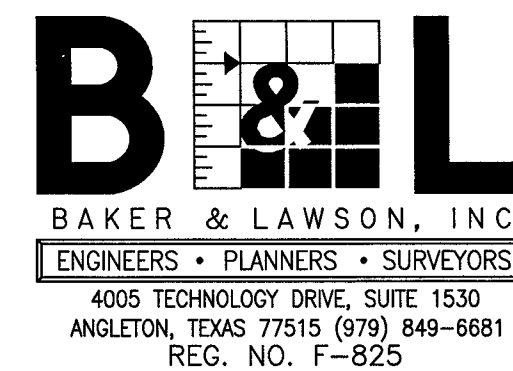

The seal appearing on
this document was
authorized by
Douglas B. Roesler
P.E. 56739

Date: 04-18-27

OWNER:

**RIVERWAY PROPERTIES
6115 SKYLINE DR. STE A.
HOUSTON, TEXAS 77057**

PLAN:

PROFILE:

HORIZONTAL:

VERTICAL:


RIVERWOOD RANCH SUBDIVISION
SECTION 2
A 78 AC, 109-LOT SUBDIVISION
ANGLETON, TEXAS 77515

RESIDENTIAL CURB
CONSTRUCTION DETAILS
SL-23

PROJECT NO. 14395


40

2101 DAIR

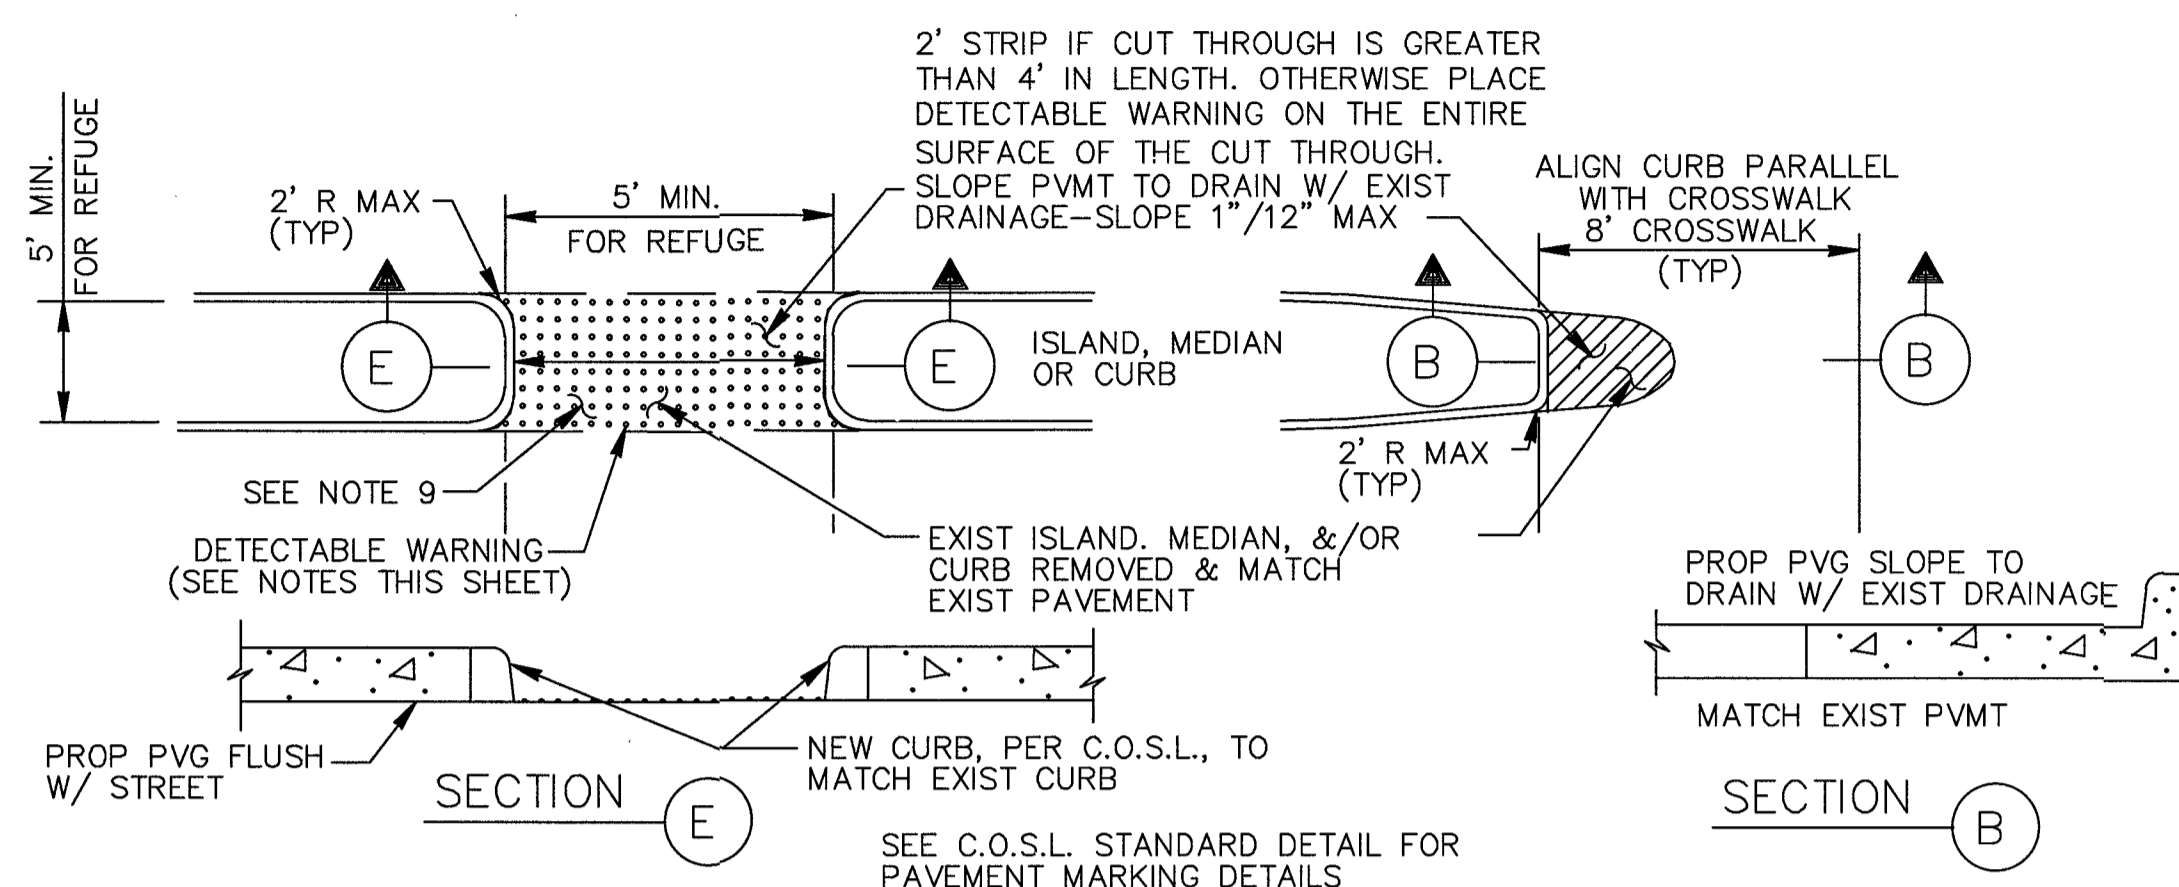

FOR ISLAND, MEDIAN, OR CURB MODIFICATIONS FOR CROSSWALKS

SL-ST-35

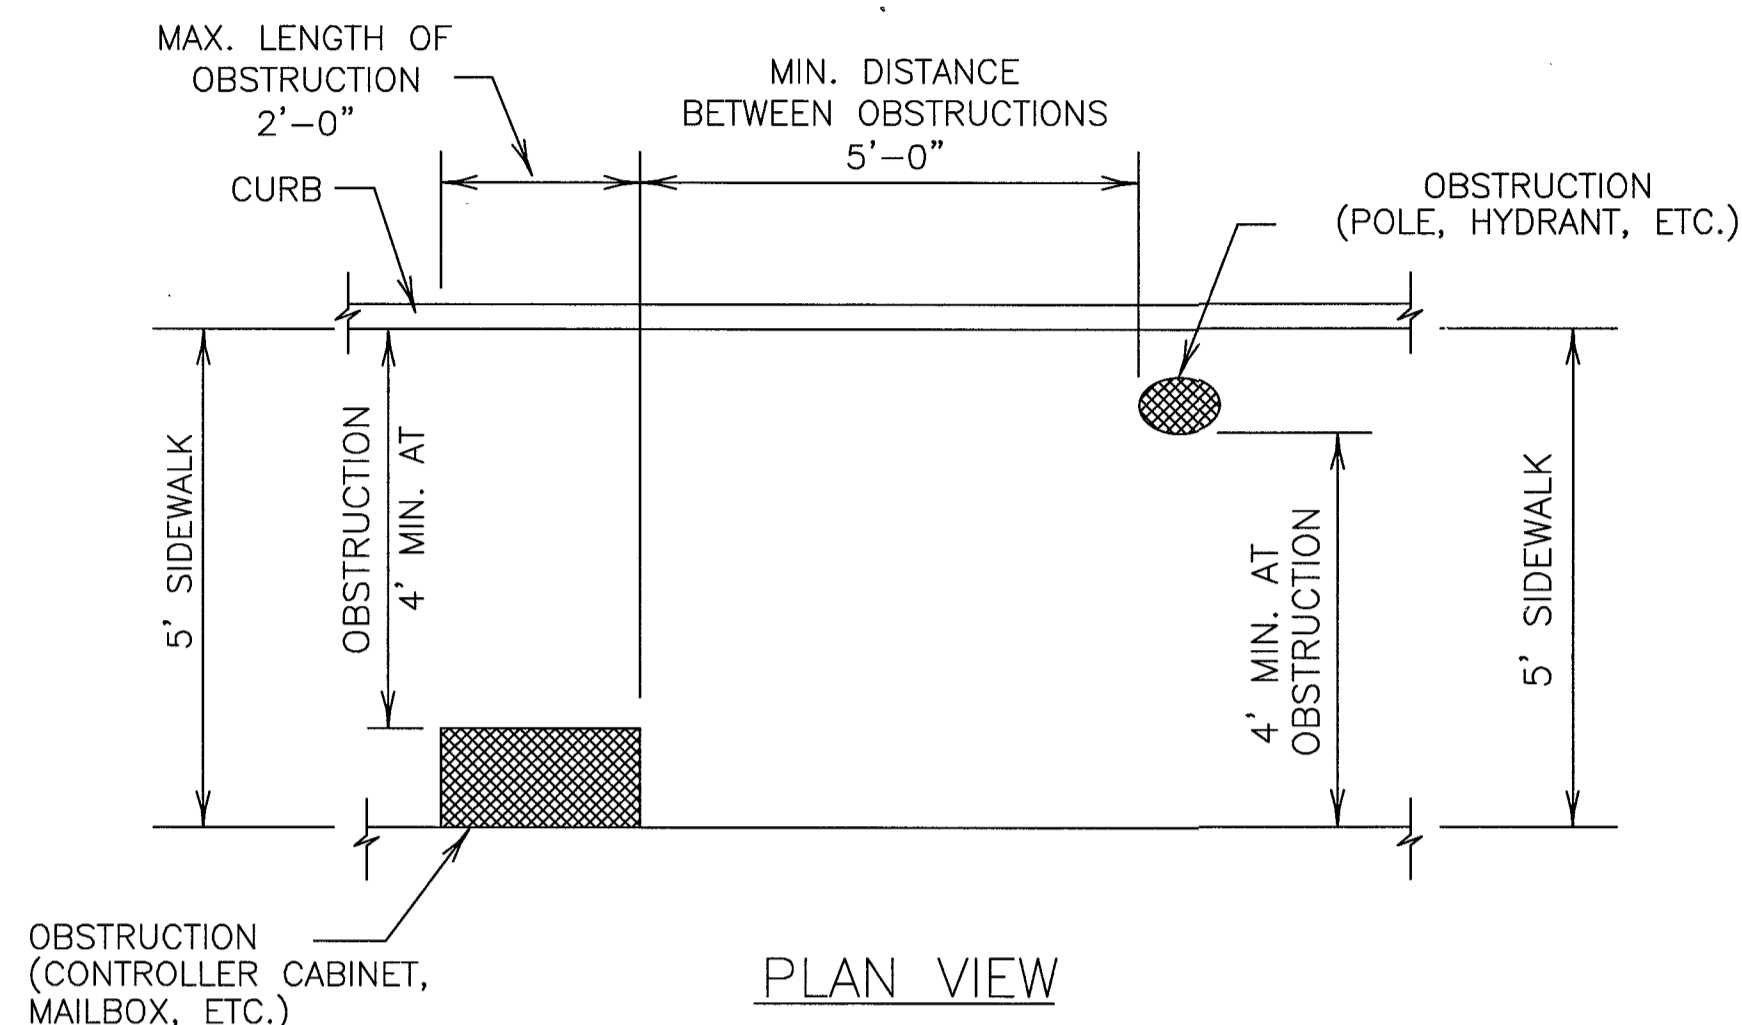

T, PLAN VIEW
PLACEMENT OF STREET FIXTURES


(ITEMS NOT INTENDED FOR PUBLIC USE.
MINIMUM 4' x 4' CLEAR GROUND SPACE
REQUIRED AT PUBLIC USE FIXTURES.)

SL-ST-36

NOTES:


1. ALL SLOPES ARE MAXIMUM ALLOWABLE. THE LEAST POSSIBLE SLOPE THAT WILL STILL DRAIN PROPERLY SHOULD BE USED. RAMP LENGTH OR GRADE OF APPROACH SIDEWALKS MAY BE ADJUSTED AS DIRECTED
2. THE MINIMUM SIDEWALK WIDTH IS 5' (FEET). THE LANDING SHALL BE 5' x 5' WITH A MAXIMUM SLOPE OF 2% IN ANY DIRECTION. MAXIMUM ALLOWABLE CROSS SLOPE ON SIDEWALK AND RAMP SURFACES IS 2%. USUAL SIDEWALK CROSS SLOPE EQUALS 1.5%. CHANGES IN LEVEL GREATER THAN 1/4" (IN.) ARE NOT PERMITTED.
3. MANEUVERING SPACE AT THE BOTTOM OF CURB RAMPS SHALL BE A MINIMUM OF 5' x 5' WHOLLY CONTAINED WITHIN THE CROSSWALK AND WHOLLY OUTSIDE THE PARALLEL VEHICULAR TRAVEL PATH.
4. ANY PART OF THE ACCESSIBLE ROUTE WITH A SLOPE GREATER THAN 1:20 (5%) SHALL BE CONSIDERED A RAMP. IF A RAMP HAS A RISE GREATER THAN 6" (IN.) OR A HORIZONTAL PROJECTION GREATER THAN 72 INCHES, THEN IT SHALL HAVE HANDRAILS ON BOTH SIDES, WITH THE FOLLOWING EXCEPTIONS:
 - A) HANDRAILS ARE NOT REQUIRED ON CURB RAMPS. CURB RAMPS SHALL BE PROVIDED WHEREVER AN ACCESSIBLE ROUTE CROSSES (PENETRATES) A CURB.
 - B) THE LEAST POSSIBLE GRADE SHOULD BE USED TO MAXIMIZE ACCESSIBILITY. WHERE STRUCTURALLY IMPRACTICAL TO ACHIEVE TEXAS ACCESSIBILITY STANDARDS (TAS) COMPLIANCE, THE RUNNING SLOPE OF SIDEWALKS AND CROSSWALKS, WITHIN THE PUBLIC ROW, MAY FOLLOW THE GRADE OF THE PARALLEL ROADWAY WITHOUT INVOKING TEXAS ACCESSIBILITY STANDARDS (TAS) VARIANCES FOR LANDINGS OR HANDRAILS. HOWEVER, A CONTINUOUS GRADE GREATER THAN 5% MUST BE PROVIDED. HANDRAILS MAY BE DESIRABLE ON ONE OR BOTH SIDES OF THE SIDEWALK TO IMPROVE ACCESSIBILITY. HANDRAILS MAY ALSO BE NEEDED TO PROTECT PEDESTRIANS FROM POTENTIALLY HAZARDOUS CONDITIONS.
5. CURB RAMPS WITH RETURNED CURBS MAY BE USED ONLY WHERE PEDESTRIANS WOULD NOT NORMALLY WALK ACROSS THE RAMP. OTHERWISE, FLARED SIDES SHALL BE PROVIDED. ALL CONCRETE SURFACES SHALL RECEIVE A LIGHT BROOM FINISH UNLESS NOTED OTHERWISE IN THE PLANS.
6. RAMP TEXTURES MUST CONSIST OF TRUNCATED DOME SURFACES, IN ACCORDANCE WITH ADA AND TEXAS DEPARTMENT OF LICENSING AND REGULATIONS (TDLR). TEXTURES ARE REQUIRED TO BE DETECTABLE UNDERFOOT. TEXTURES ALSO SHALL CONTRAST VISUALLY WITH ADJOINING SURFACES. SURFACES THAT WOULD ALLOW WATER TO ACCUMULATE ARE PROHIBITED.
7. ADDITIONAL INFORMATION ON CURB RAMP LOCATION, DESIGN, LIGHT REFLECTIVE VALUE AND TEXTURE MAY BE FOUND IN THE CURRENT EDITION OF THE TEXAS ACCESSIBILITY STANDARDS (TAS) PREPARED AND ADMINISTERED BY THE TEXAS DEPARTMENT OF LICENSING AND REGULATION (TDLR).
8. RAISED MEDIANS SEPARATE OPPOSING DIRECTIONS OF TRAFFIC AND PROVIDE A REFUGE AREA FOR PEDESTRIANS UNABLE TO CROSS THE ENTIRE ROADWAY IN THE ALLOTTED SIGNAL PHASE. TO SERVE AS A REFUGE AREA, THE MEDIAN SHALL BE A MINIMUM OF 5' (FT.) WIDE. MEDIANS SHOULD BE DESIGNED TO PROVIDE ACCESSIBLE PASSAGE OVER OR THROUGH THEM.
9. SMALL CHANNELIZATION ISLANDS, WHICH CAN NOT PROVIDE A MINIMUM 5' x 5' LANDING AT THE TOP OF RAMPS, SHALL BE CUT THROUGH LEVEL WITH THE SURFACE OF THE STREET.
10. CROSSWALK DIMENSIONS, CROSSWALK MARKINGS AND STOP BAR LOCATIONS SHALL BE AS SHOWN IN THE PLANS. AT INTERSECTIONS WHERE CROSSWALK MARKINGS ARE NOT REQUIRED, RAMPS SHALL BE ALIGNED WITH THEORETICAL CROSSWALKS, OR AS DIRECTED BY THE ENGINEER.
11. EXISTING FEATURES THAT COMPLY WITH T.A.S. MAY REMAIN IN PLACE UNLESS OTHERWISE SHOWN ON THE PLANS.
12. TRAFFIC SIGNAL OR ILLUMINATION POLES, GROUND BOXES, CONTROLLER BOXES, SIGNS, DRAINAGE FACILITIES AND OTHER ITEMS SHALL BE PLACED SO AS NOT TO OBSTRUCT THE ACCESSIBLE ROUTE.

SL-ST-40

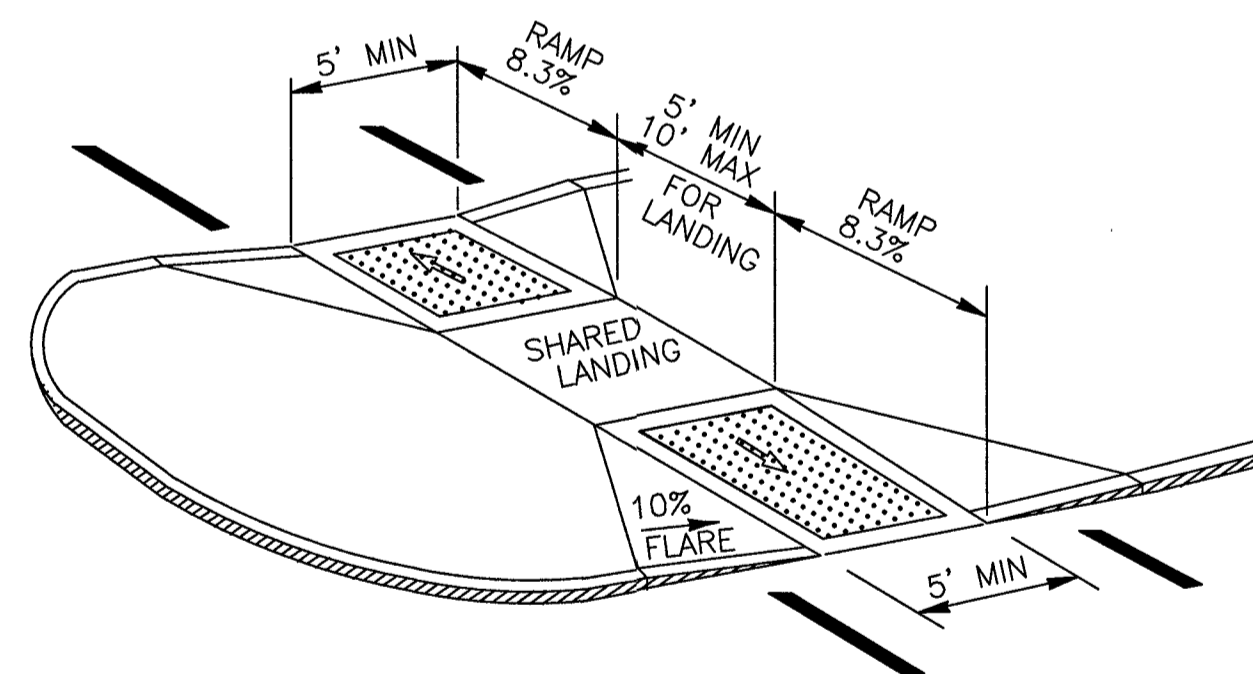


CURB RAMPS AT MEDIAN ISLANDS

SL-ST-37

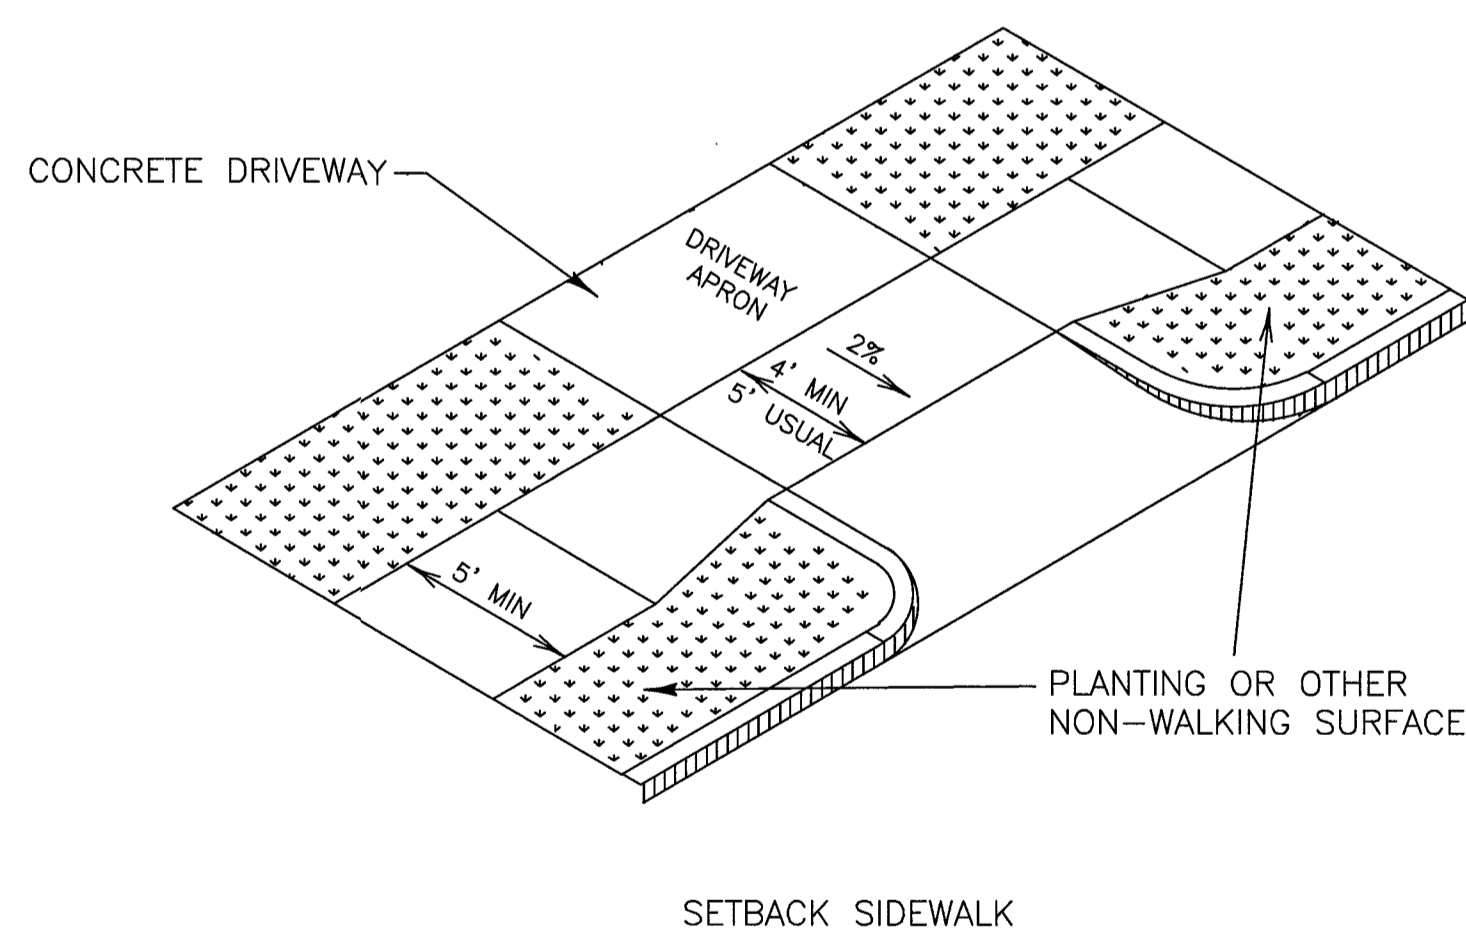

SIDEWALK TREATMENT AT DRIVEWAYS

SL-ST-38

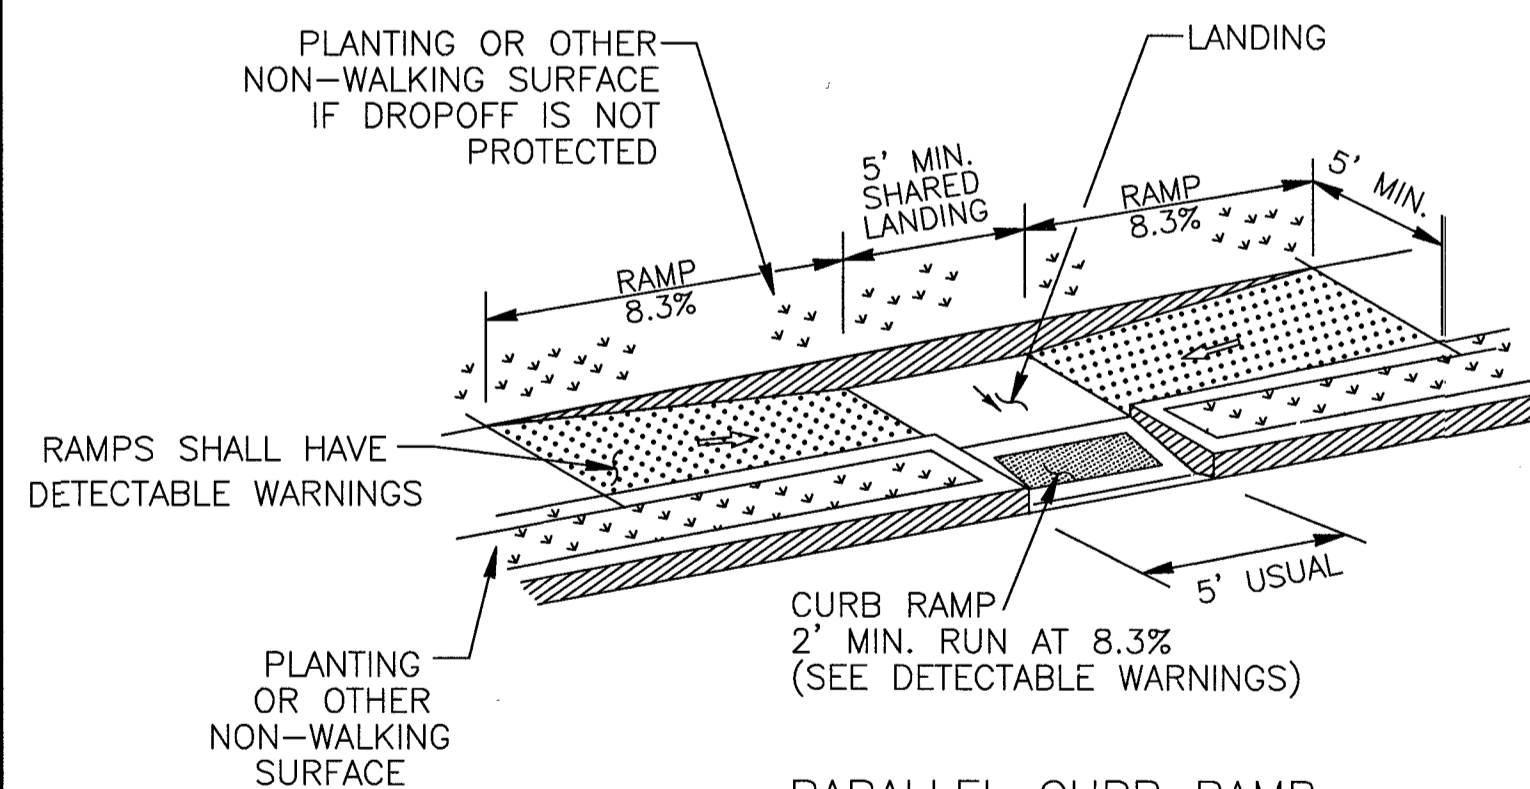



PARALLEL CURB RAMP


SL-ST-39

RECORD DRAWING

NO.	DATE	DESCRIPTION	APPROVED
REVISIONS			

DESIGNED DR
DRAWN BT
CHECKED _____
DATE _____

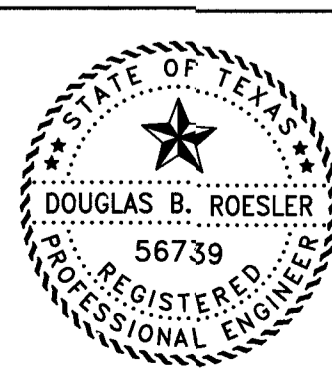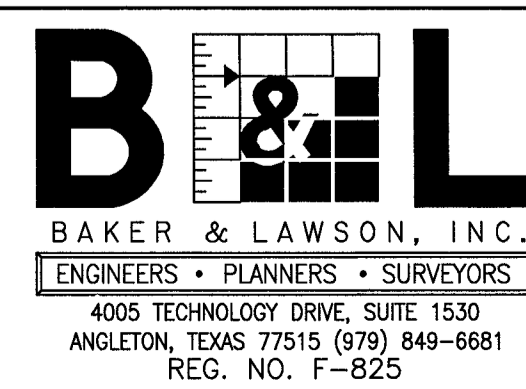

The seal appearing on
this document was
authorized by
Douglas B. Roesler
P.E. 56739

Date: 04-18-22

OWNER:
RIVERWAY PROPERTIES
6115 SKYLINE DR. STE A.
HOUSTON, TEXAS 77057



PLAN: _____
 PROFILE: _____
 HORIZONTAL: _____
 VERTICAL: _____

RIVERWOOD RANCH SUBDIVISION
SECTION 2
A 78 AC, 109-LOT SUBDIVISION
ANGLETON, TEXAS 77515

WHEEL CHAIR RAMP &
SIDEWALK DETAILS II
SL-26

PROJECT NO. 14395

42

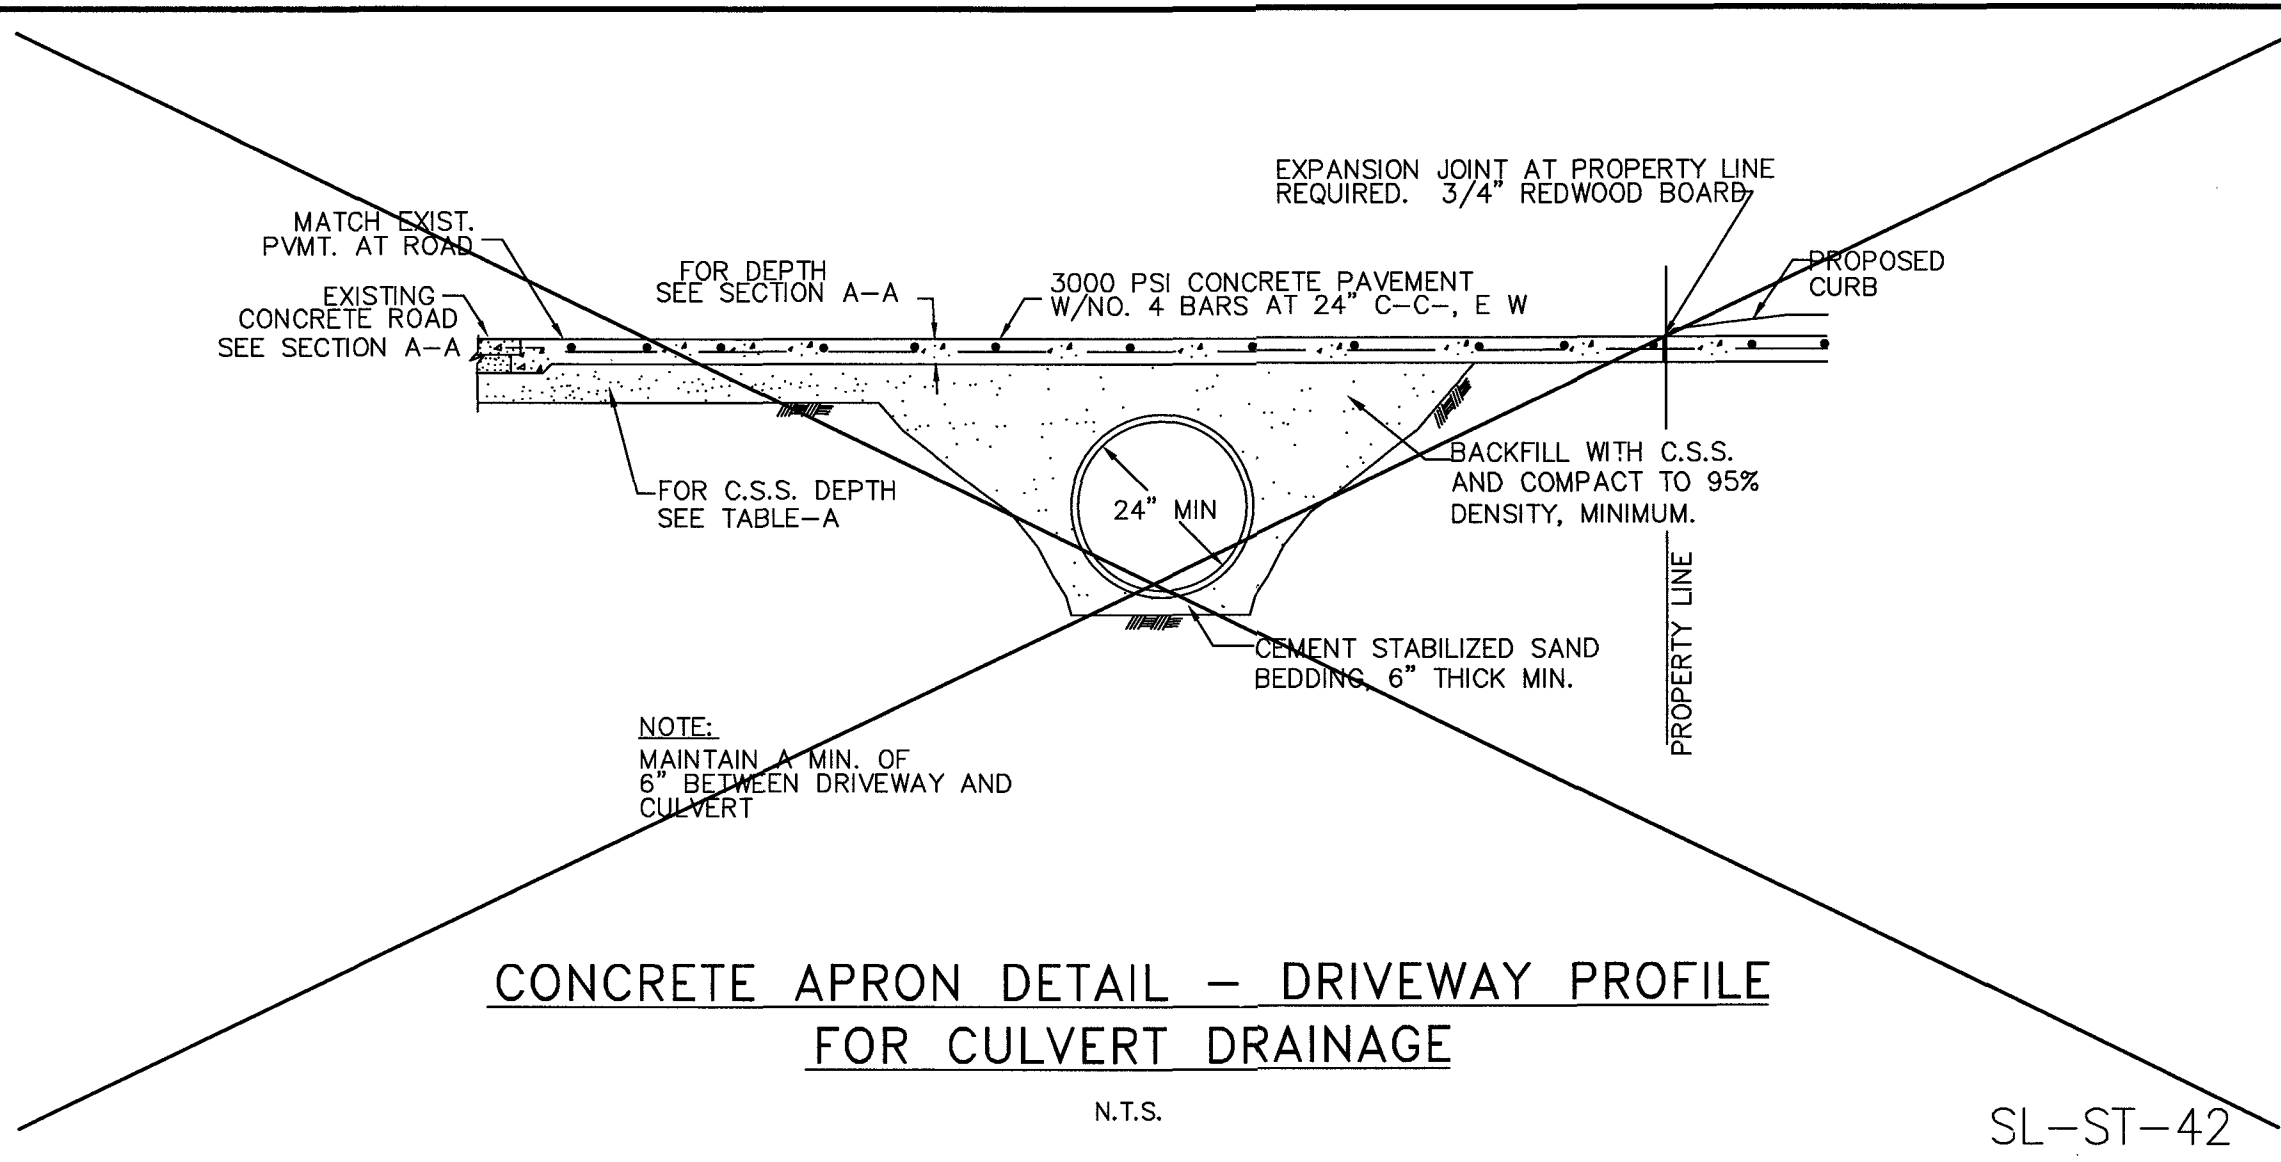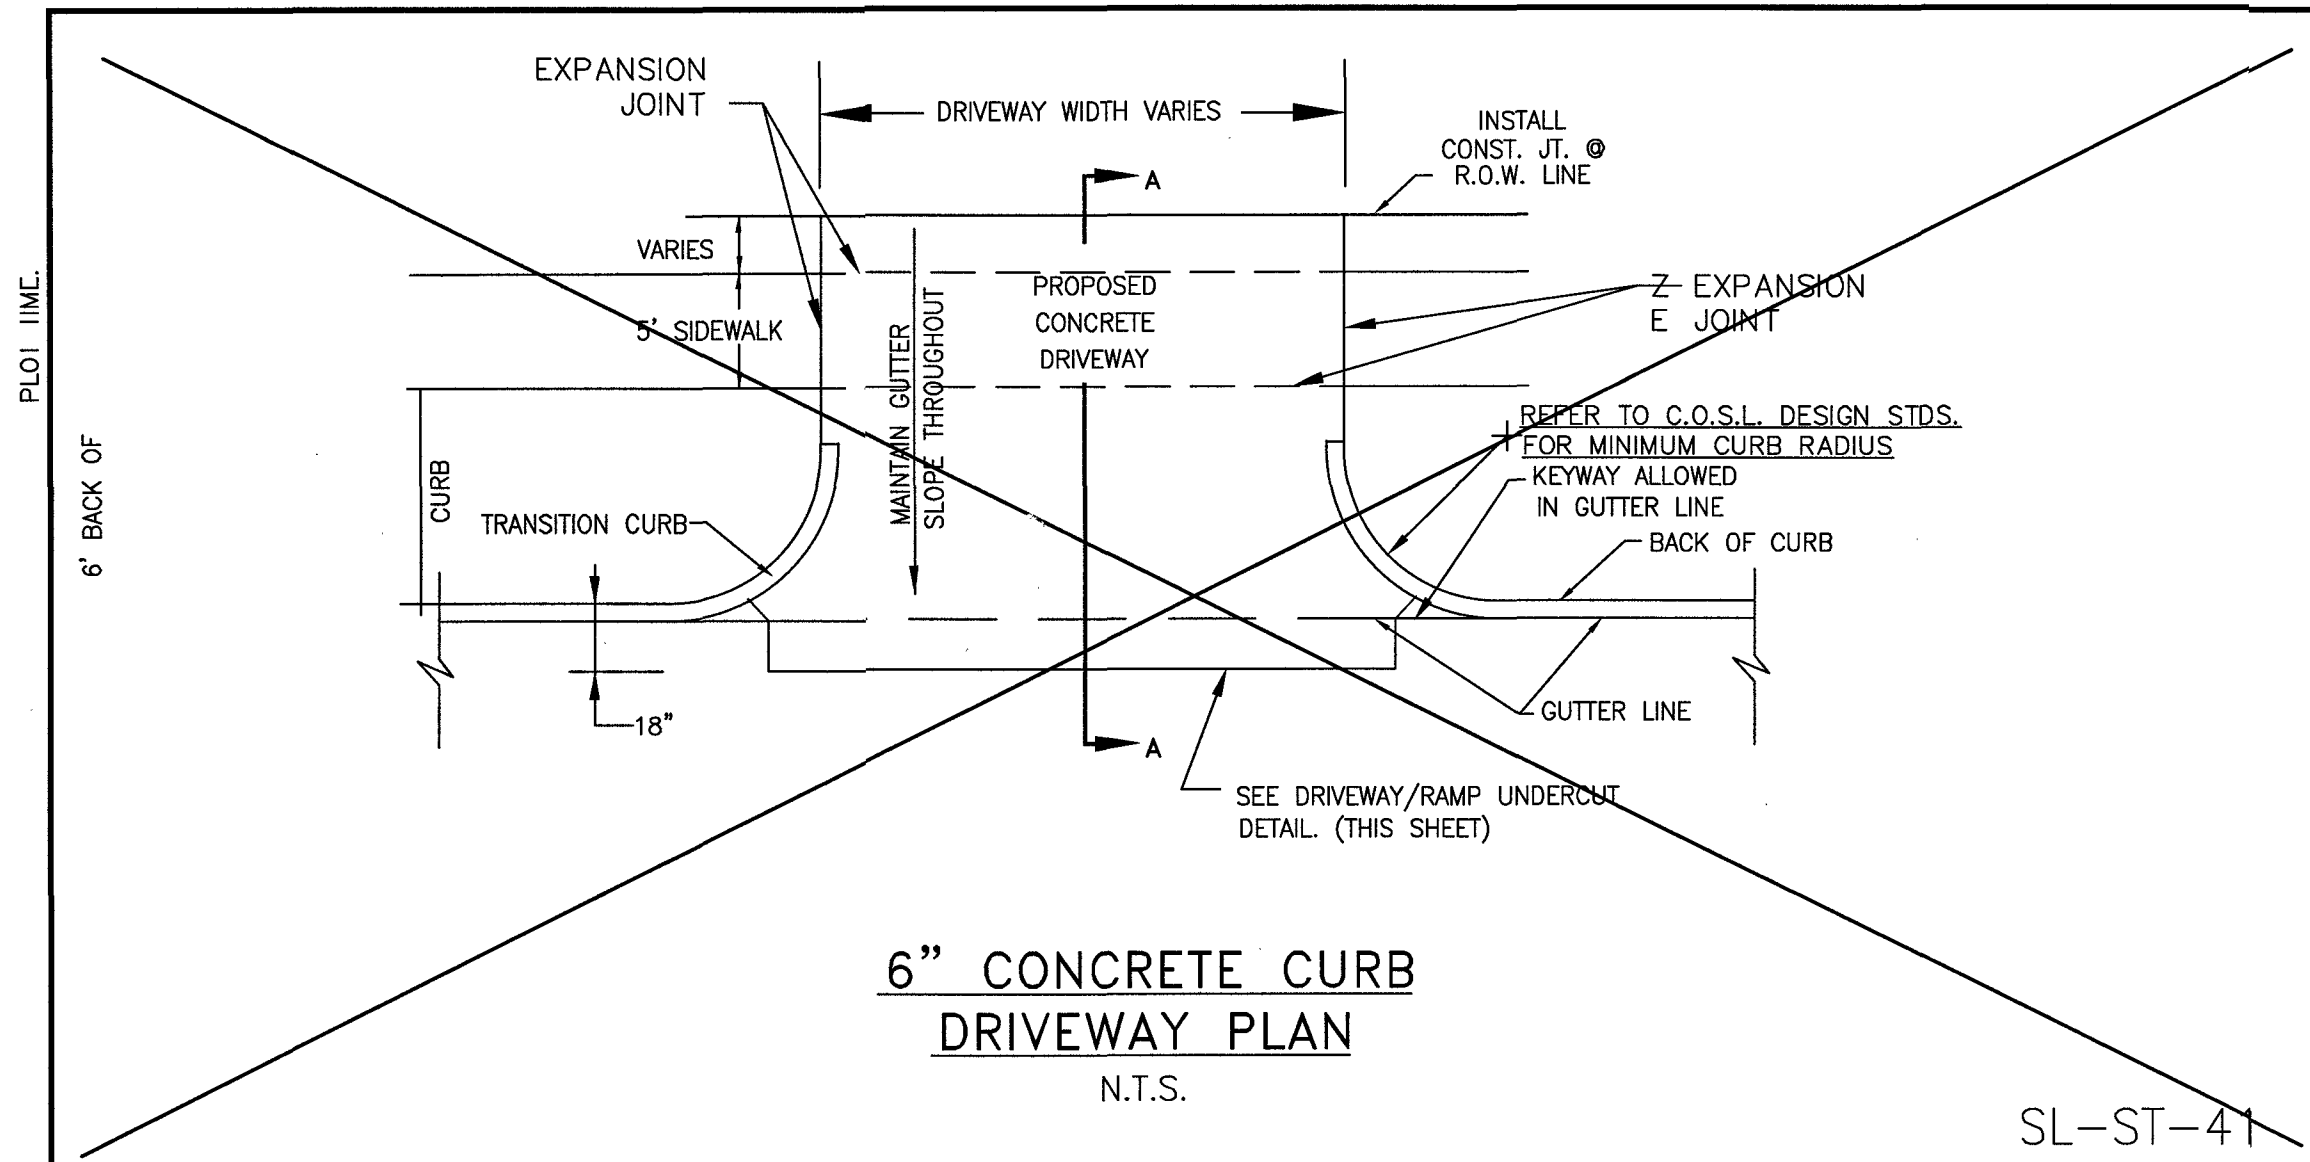

- NOTES:
- 1.) SAW CUT & BREAKOUT NO MORE THAN 72 HOURS PRIOR TO PROPOSED CONCRETE PLACEMENT. NOTIFY SUGAR LAND PRIOR TO CUT.
 - 2.) UNSTABLE SUBGRADE SHALL BE OVER EXCAVATED & REPLACED WITH CONCRETE.
 - 3.) IT IS CONTRACTOR'S RESPONSIBILITY TO NOTIFY SUGAR LAND OF ANY BIRD BATH PROBLEMS PRIOR TO CONSTRUCTION OF DRIVEWAY.
 - 4.) USE 1"x2" TREATED REDWOOD FOR HEADER.
 - 5.) EDGE ALL SIDES WITH EDGING TOOL AND BROOM FINISH
 - 6.) FOR INDUSTRIAL DRIVES, PAVEMENT SHALL HAVE A DEPTH OF 8" (IN).
 - 7.) EXPANSION JOINT AT PROPERTY LINE REQUIRED. 3/4" REDWOOD BOARD WITH NO. 4 DOWELS MINIMUM.
 - 8.) MAXIMUM ALLOWABLE DRIVEWAY GRADE IN PULIC R.O.W. IS 5%.
 - 9.) DRIVEWAY GRADE MUST MEET A.D.A. AND T.A.S. SIDEWALK SLOPE, SIDEWALKS MUST BE SCORED TO MATCH ADJACENT SIDEWALK. IF SLOPE IS CONTINUED THROUGH THE R.O.W. LINE, PROVIDE A 3/4" REDWOOD EXPANSION JOINT WITH DOWELS AT R.O.W. LINE.
 - 10.) REFER TO GENERAL, C.S.S., ASPHALT, AND CONCRETE PAVEMENT NOTES.

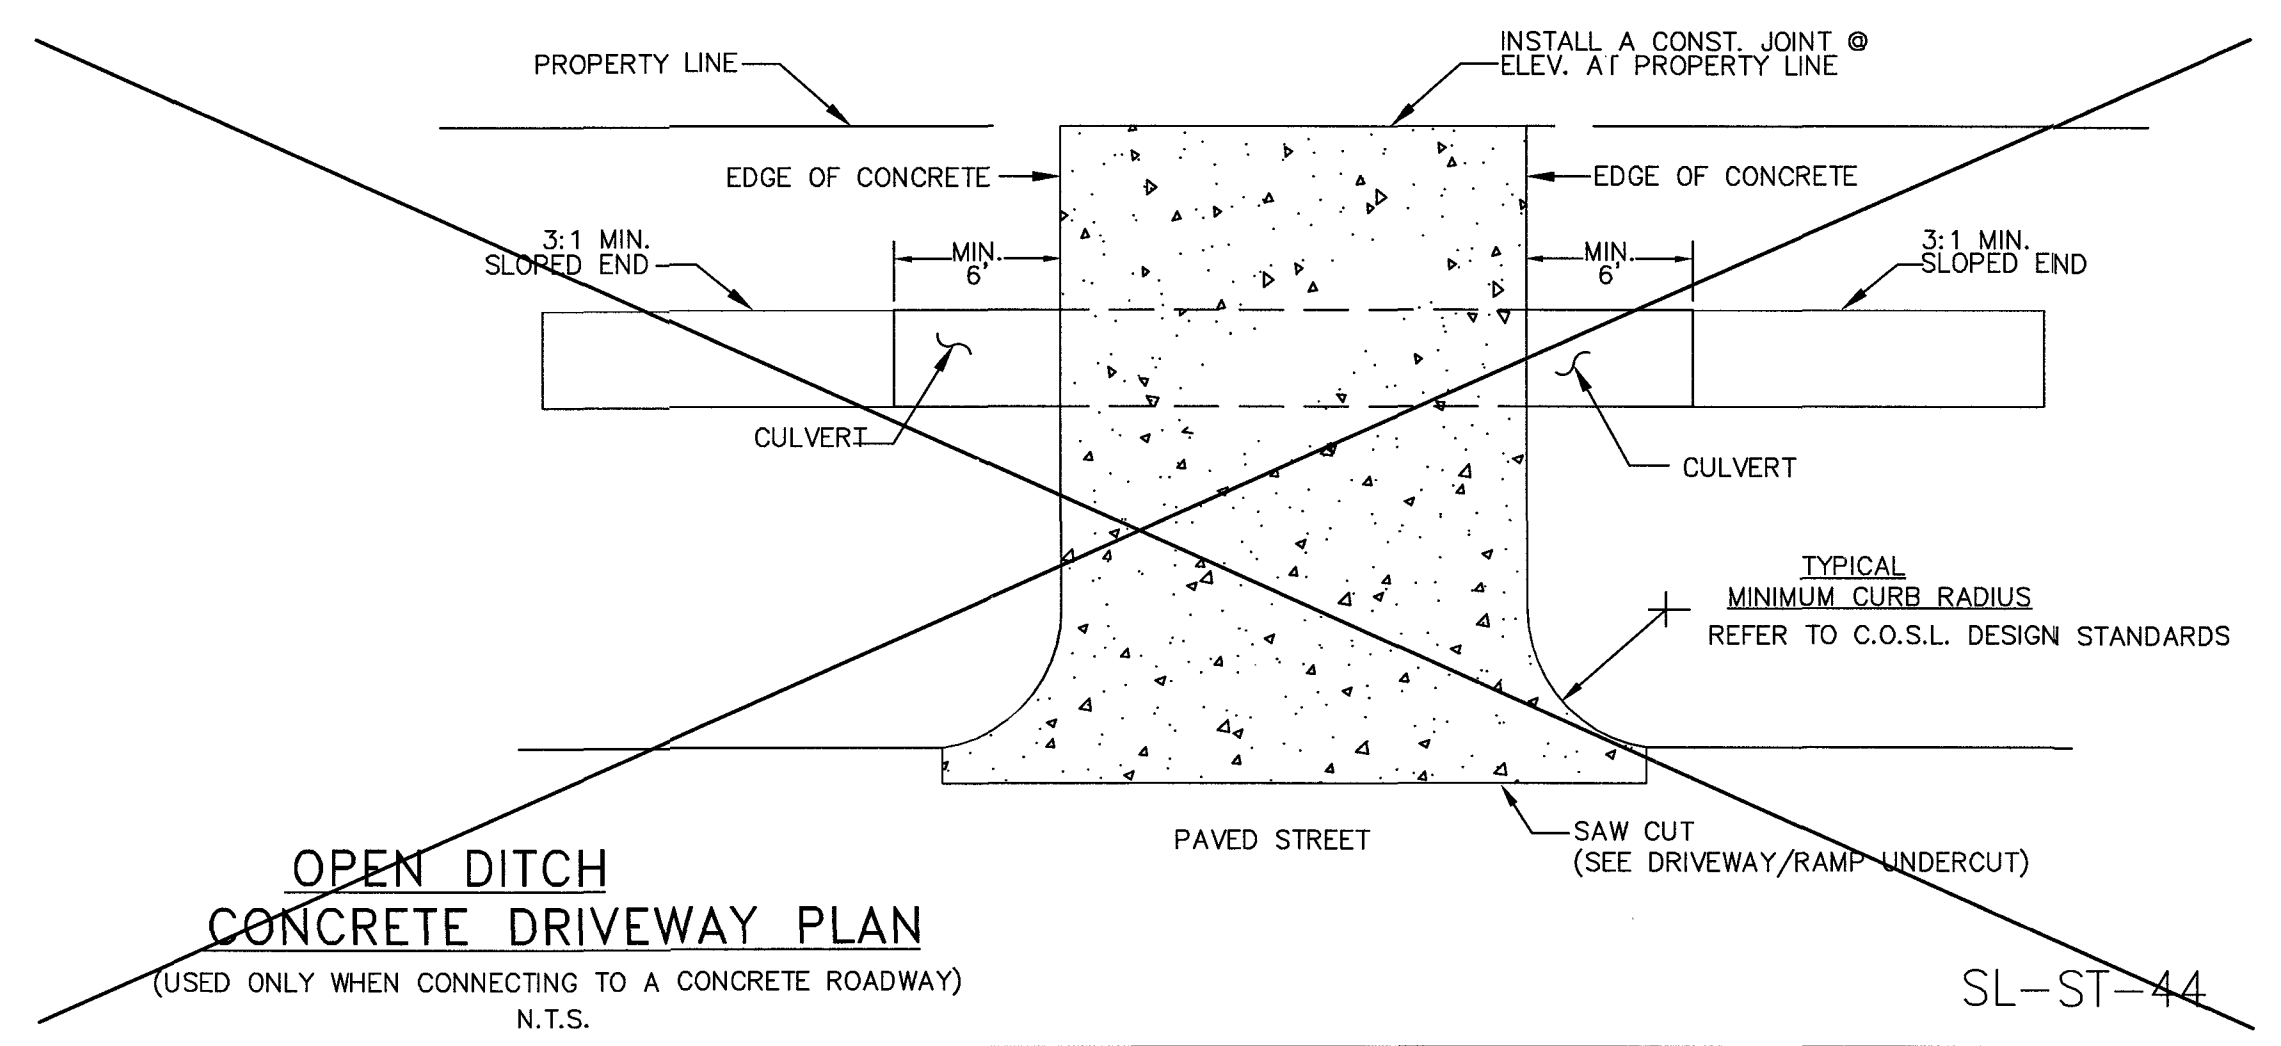
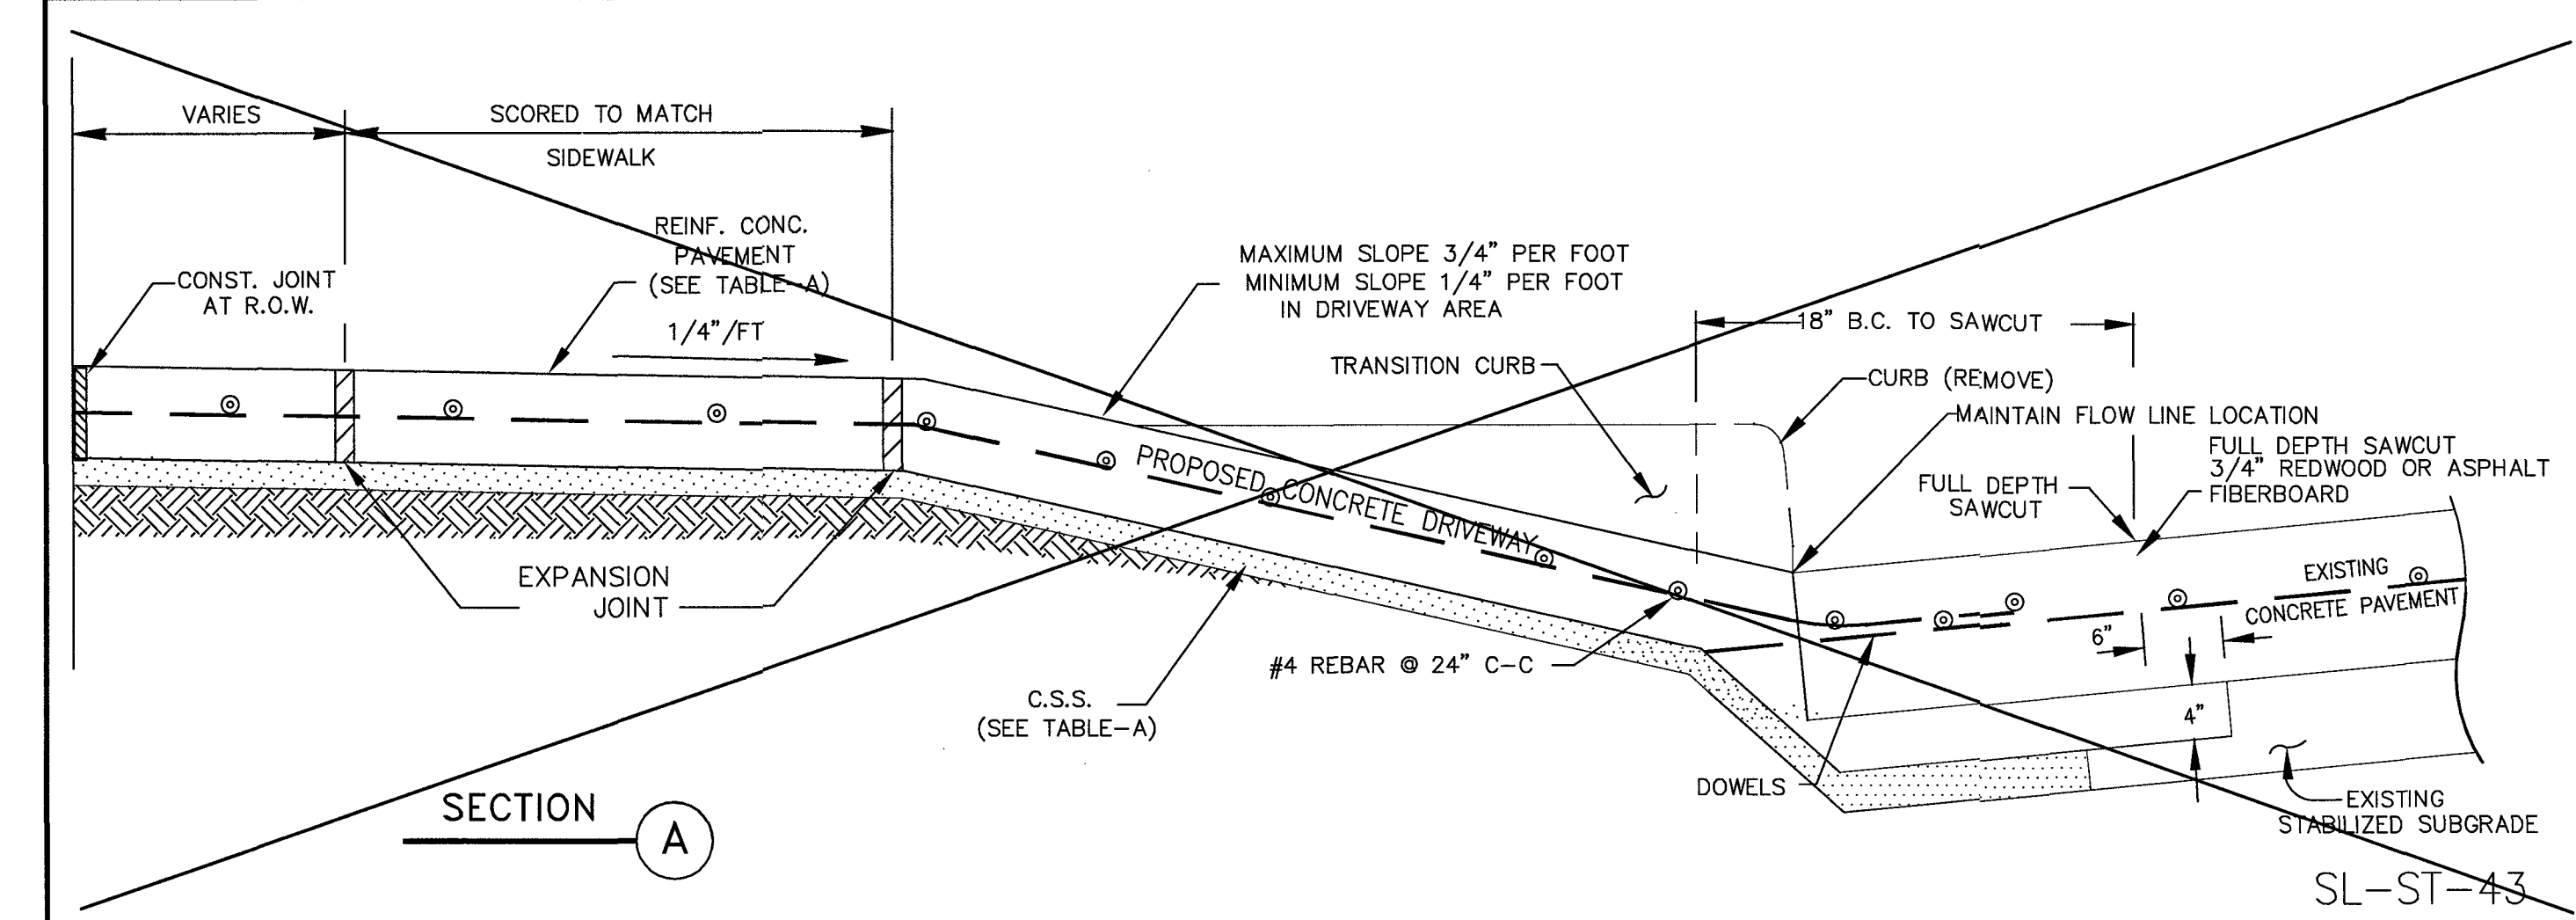


TABLE-A

CEMENT STABILIZED SAND 2-SK/C.Y.	
RESIDENTIAL	4" MINIMUM
COMMERCIAL	6" MINIMUM
INDUSTRIAL	8" MINIMUM
REINFORCED CONCRETE PAVEMENT 3,000 PSI MIN	
RESIDENTIAL	4" MINIMUM
COMMERCIAL	6" MINIMUM
INDUSTRIAL	8" MINIMUM

DRIVEWAY
PAVEMENT
CONSTRUCTION TABLE

No.	DATE	REVISION

DESIGN ENGINEER: _____ DATE: _____

SEAL: _____







CONSTRUCTION PLANS FOR:

DRIVEWAY
CONSTRUCTION DETAILS

JOB No.: _____
DATE: _____
DESIGNED BY: _____
DRAWN BY: _____
CHECKED BY: _____
SCALE: _____

SL-27

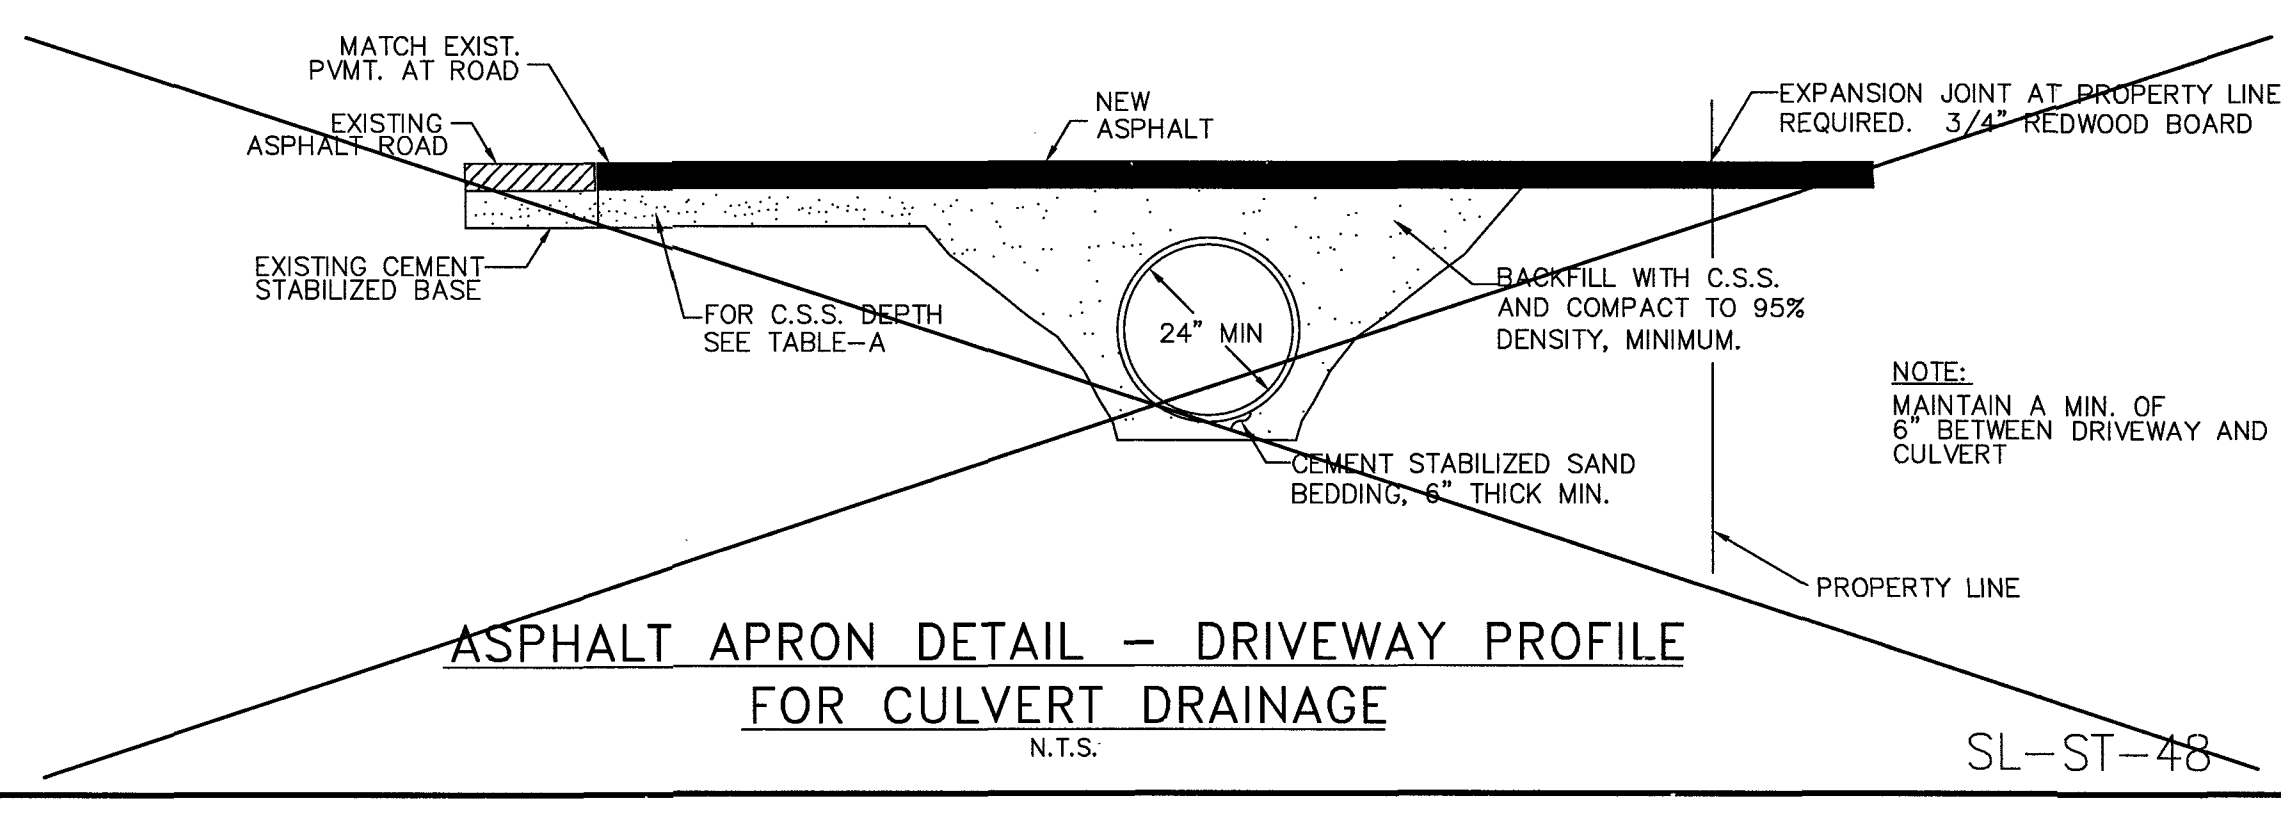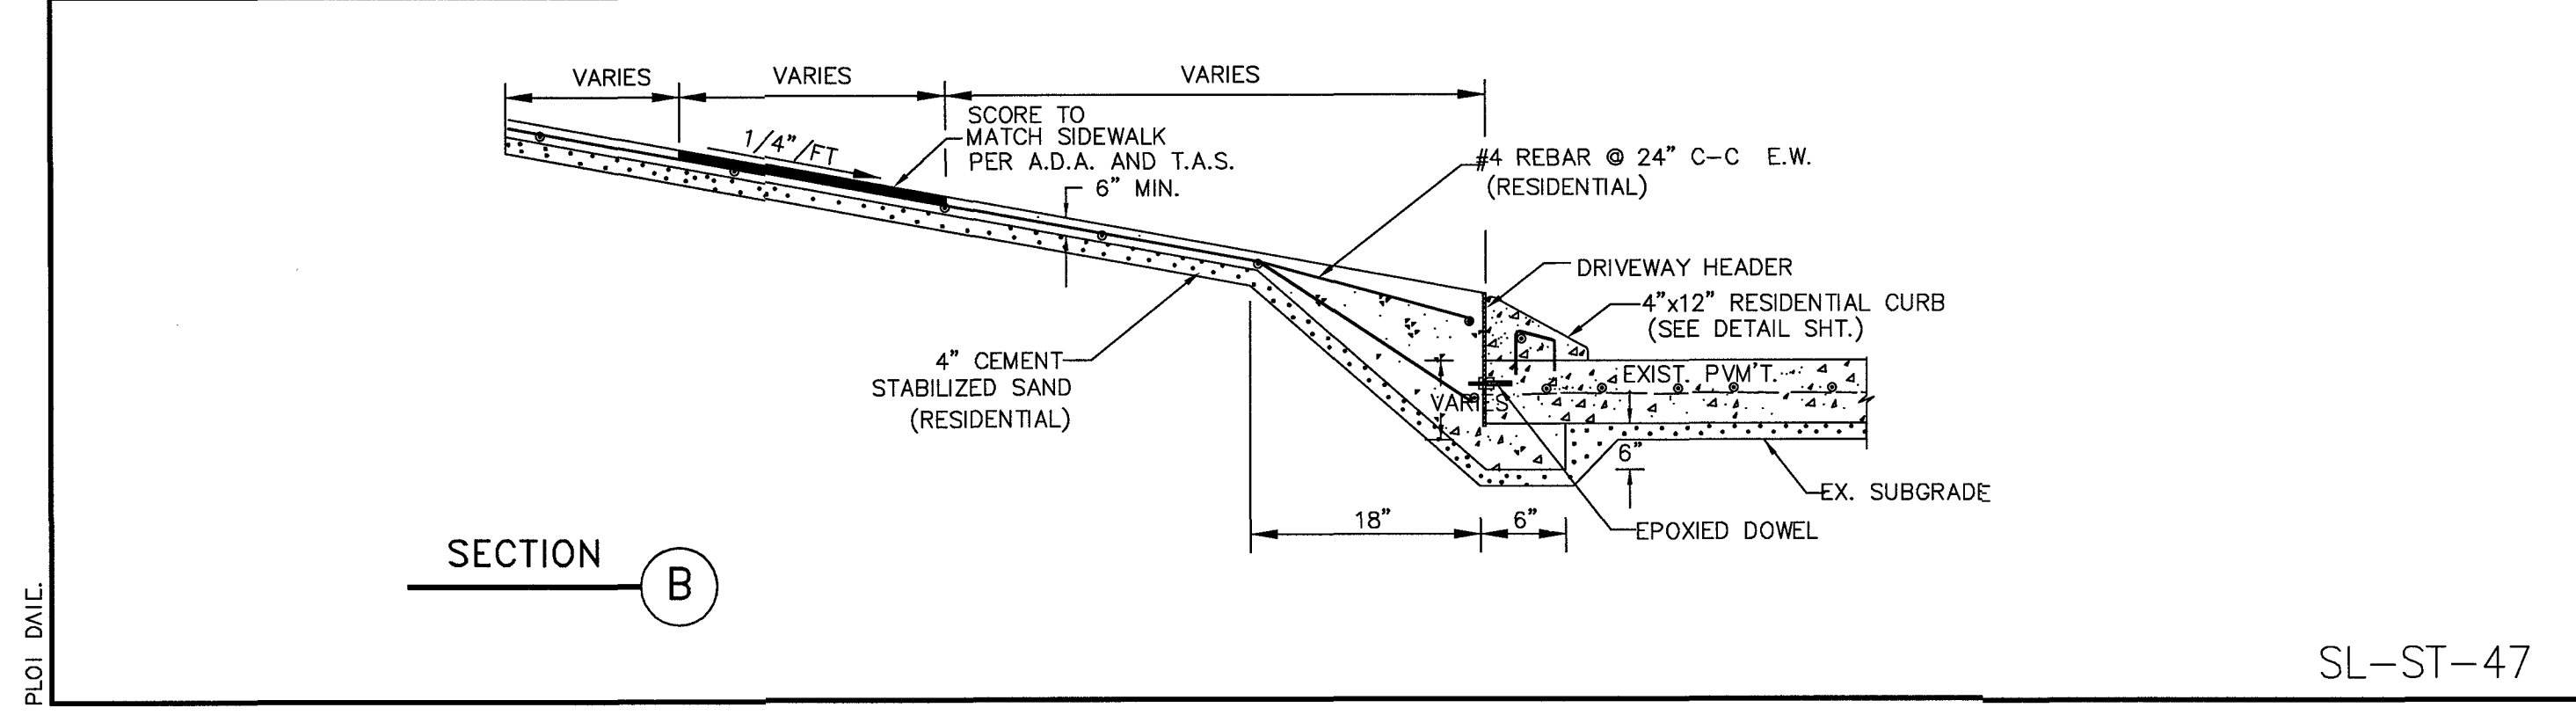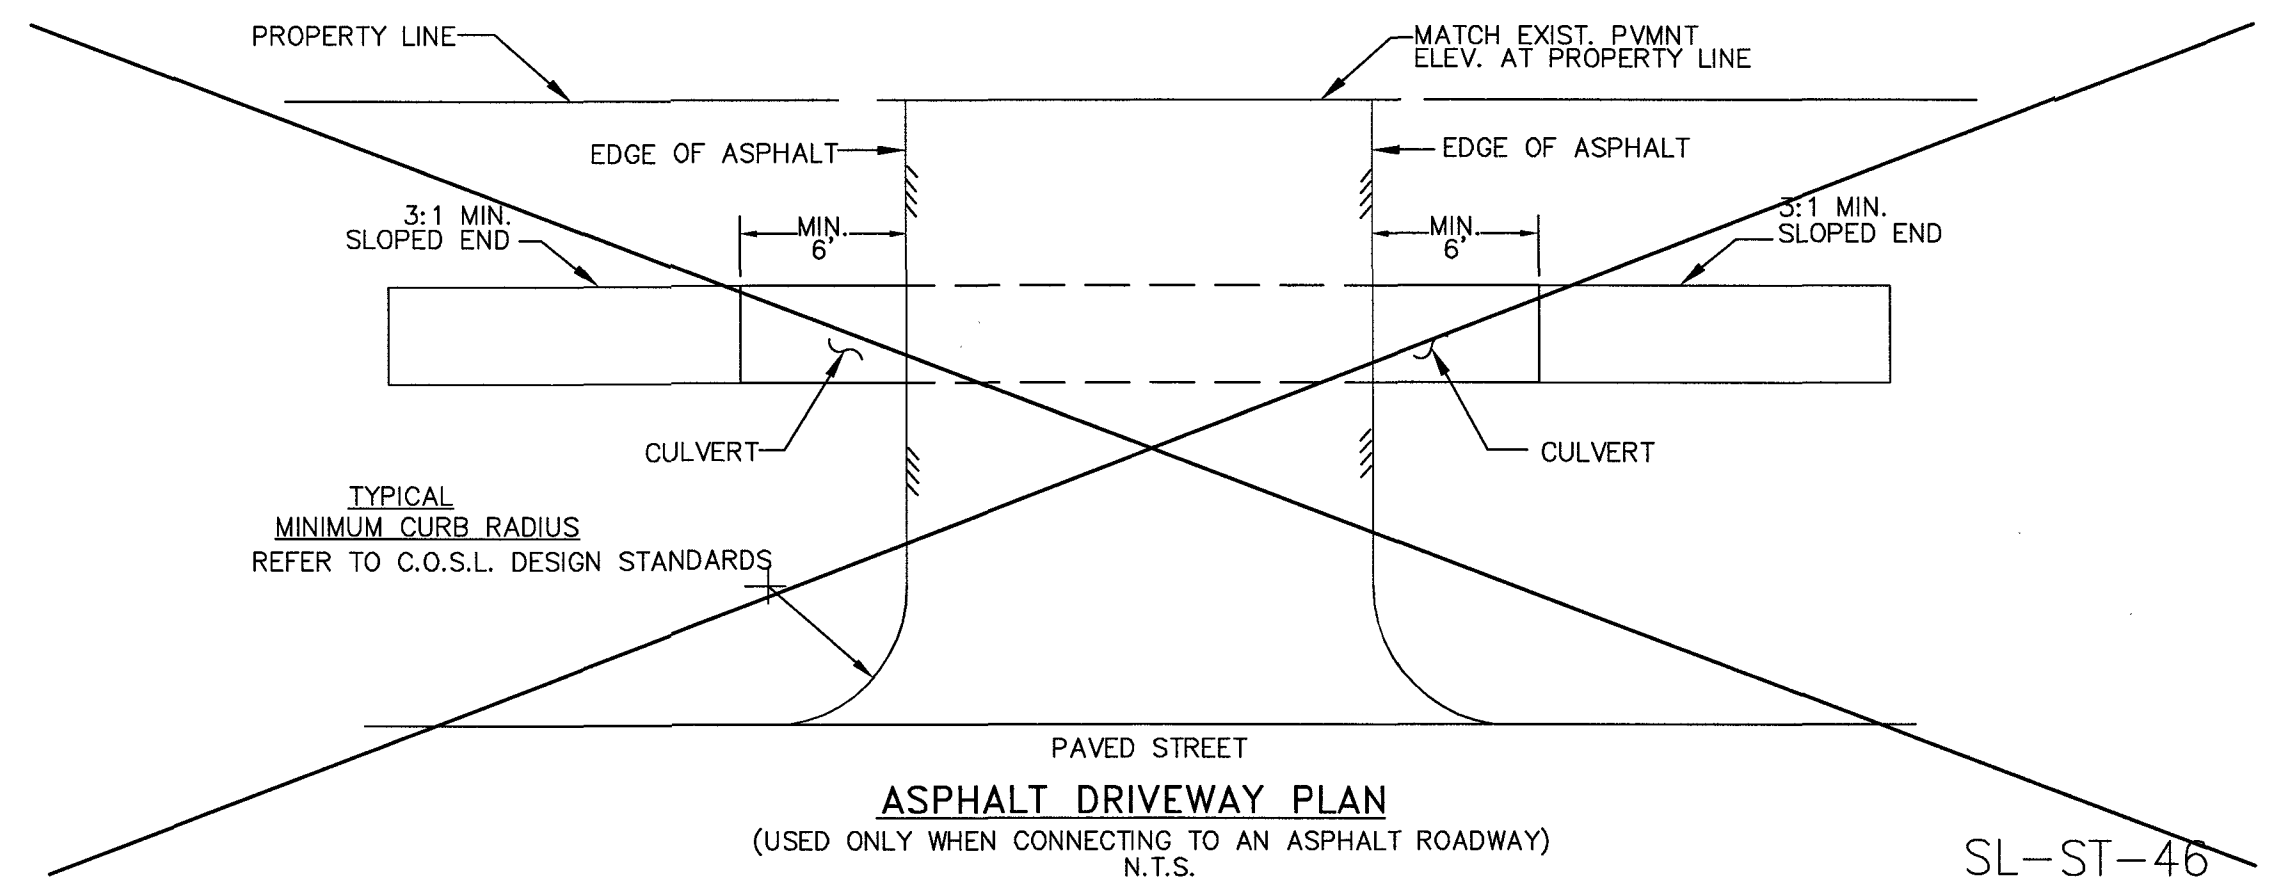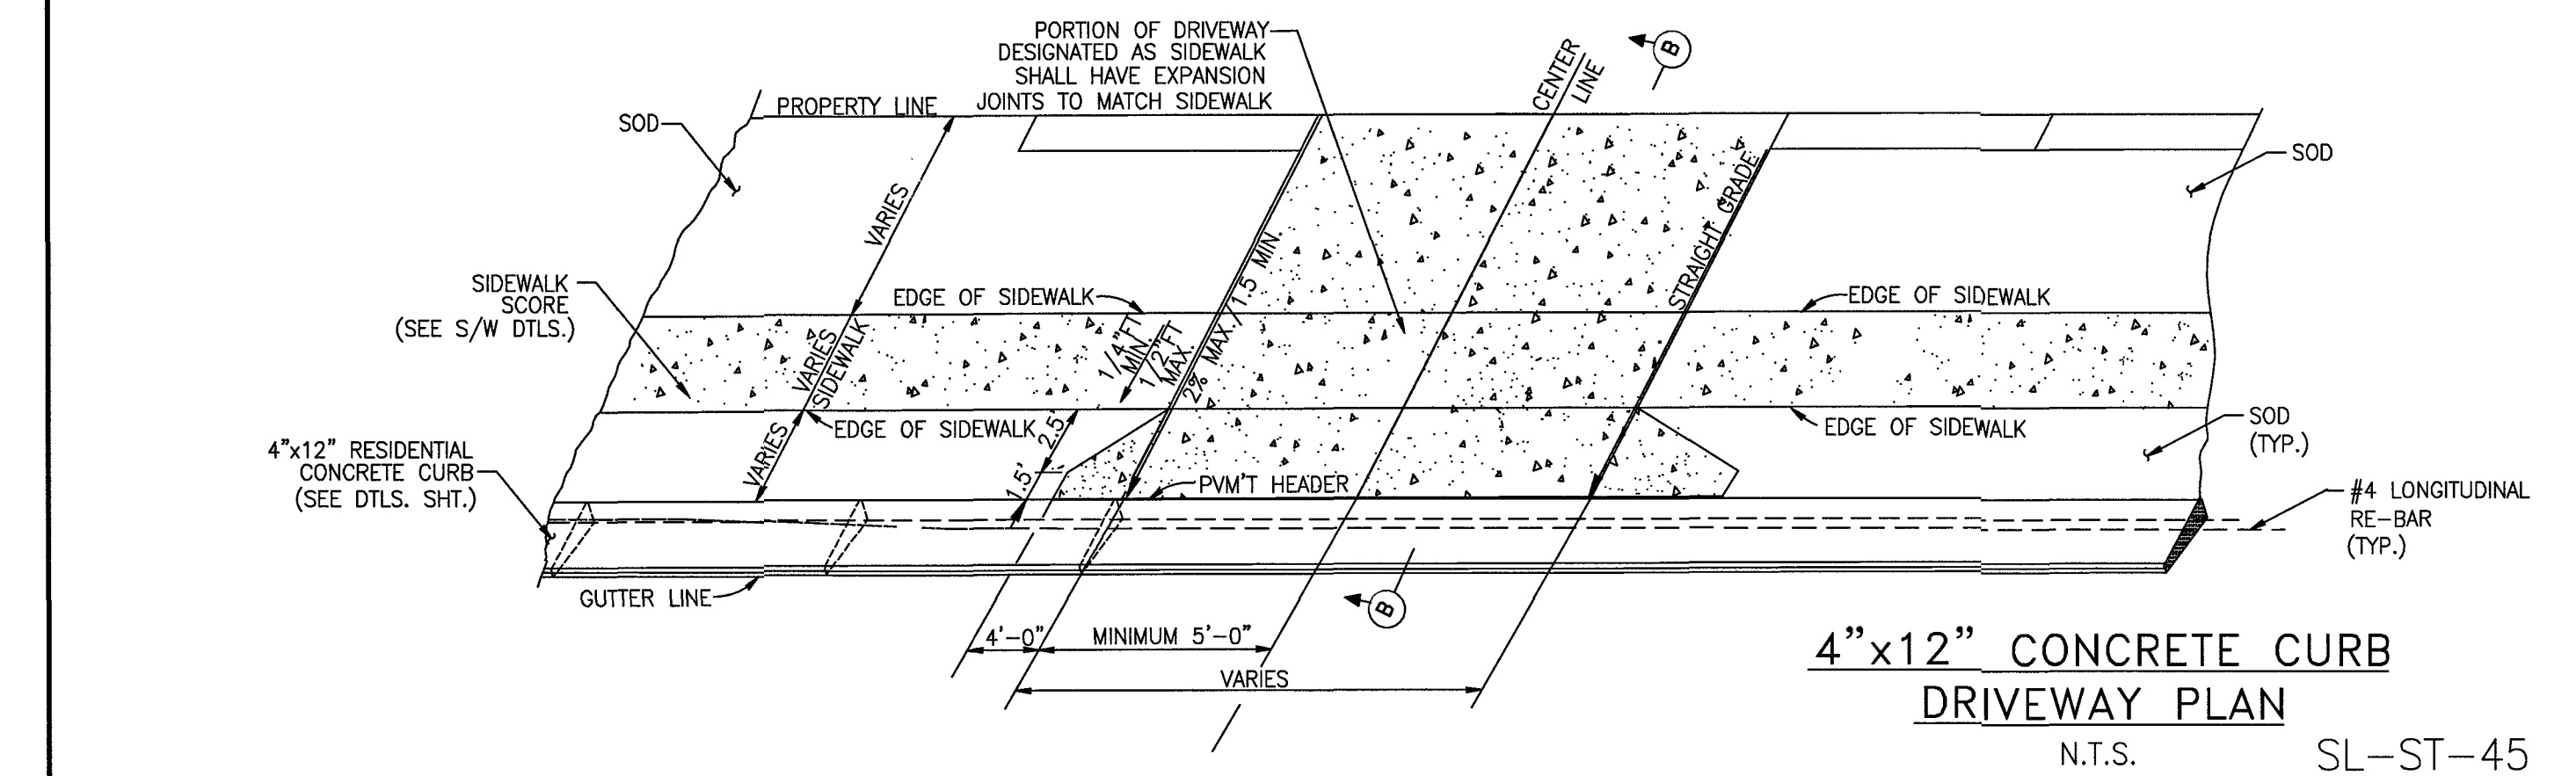

NO.	DATE	DESCRIPTION	APPROVED



REVISIONS

DESIGNED DR

DRAWN BT

CHECKED _____

DATE _____

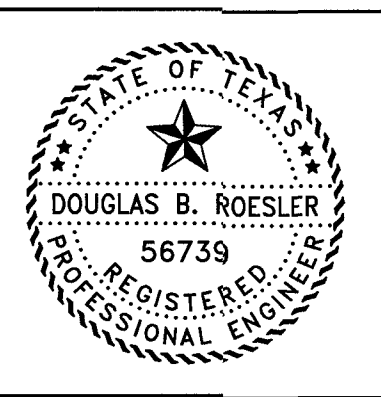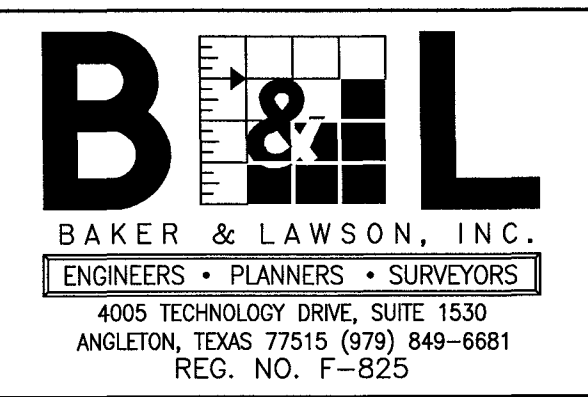

The seal appearing on this document was authorized by Douglas B. Roessler P.E. 56739

Date: 04-18-22

OWNER:

RIVERWAY PROPERTIES
6115 SKYLINE DR. STE A.
HOUSTON, TEXAS 77057

PLAN: _____

PROFILE: _____

HORIZONTAL: _____

VERTICAL: _____

RIVERWOOD RANCH SUBDIVISION
SECTION 2
A 78 AC, 109-LOT SUBDIVISION
ANGLETON, TEXAS 77515

DRIVEWAY
CONSTRUCTION DETAILS
SL-27

PROJECT NO. 14395

HYPER-CHLORINATED WATER NOTES

- 1. HYPER-CHLORINATED WATER SHALL NOT BE DISCHARGED TO THE STORM SEWER OR DRAINAGE SYSTEM UNLESS THE CHLORINE CONCENTRATION IS REDUCED TO 4 PPM OR LESS BY CHEMICALLY TREATING THE DECHLORINATE OR BY ONSITE RETENTION UNTIL NATURAL ATTENUATION OCCURS.
- 2. DISCHARGE OF HIGH FLOW RATE AND VELOCITIES SHALL BE DIRECTED TO VELOCITY DISSIPATION DEVICES.
- 3. CHLORINE CAN BURN VEGETATION, SO IT SHOULD NOT BE USED TO WATER VEGETATION THAT IS BEING USED FOR STABILIZATION, VEGETATED FILTERS OR BUFFERS, OR OTHER VEGETATION TO BE PRESERVED.
- 4. HYPER-CHLORINATED WATER MAY BE DISCHARGED TO AN ONSITE RETENTION AREA UNTIL NATURAL ATTENUATION OCCURS. THE AREA MAY BE A DRY STORMWATER RETENTION BASIN, OR A PORTION OF THE SITE MAY BE GRADED TO FORM A TEMPORARY PIT OR BERMED AREA.
- 5. NATURAL ATTENUATION OF THE CHLORINE MAY BE AIDED BY AERATION. AIR CAN BE ADDED TO THE WATER BY DIRECTING THE DISCHARGE OVER A ROUGH SURFACE BEFORE IT ENTERS THE TEMPORARY RETENTION AREA OR AN AERATION DEVICE CAN BE PLACED IN THE RETENTION AREA.
- 6. ONSITE DISCHARGE MAY REQUIRE SEVERAL HOURS TO A FEW DAYS BEFORE THE WATER IS SAFE TO DISCHARGE. THE RATE AT WHICH CHLORINE WILL ATTENUATE IS AFFECTED BY SOIL CONDITIONS AND WEATHER CONDITIONS. ATTENUATION WILL OCCUR QUICKEST DURING WARM, SUNNY, AND DRY PERIODS.

SANITARY WASTE NOTES

- 1. THE CONTRACTOR SHALL PROVIDE AN APPROPRIATE NUMBER OF PORTABLE TOILETS BASED ON THE NUMBER OF EMPLOYEES USING THE TOILETS AND THE HOURS THEY WILL WORK.
- 2. SANITARY FACILITIES SHALL BE PLACED ON A MINIMUM OF 50 FEET AWAY FROM STORM DRAIN INLETS, CONVEYANCE, CHANNELS OR SURFACE WATERS. IF UNABLE TO MEET THE 50 FOOT REQUIREMENT DUE TO SITE CONFIGURATION, PORTABLE TOILETS SHALL BE A MINIMUM OF 20 FEET AWAY FROM STORM DRAIN INLETS, CONVEYANCE CHANNELS OR SURFACE WATER AND SECONDARY CONTAINMENT SHALL BE PROVIDE IN CASE OF SPILLS.
- 3. THE LOCATION OF THE PORTABLE TOILETS SHALL BE ACCESSIBLE TO MAINTENANCE TRUCKS WITHOUT DAMAGING EROSION AND SEDIMENT CONTROLS OR CAUSING EROSION OR TRACKING PROBLEMS.
- 4. SANITARY FACILITIES SHALL BE FULLY ENCLOSED AND DESIGNED IN A MANNER THAT MINIMIZES THE EXPOSURE OF SANITARY WASTE TO PRECIPITATION AND STORMWATER RUNOFF.
- 5. WHEN HIGH WINDS ARE EXPECTED, PORTABLE TOILETS SHALL BE ANCHORED OR OTHERWISE SECURED TO PREVENT THEM FROM BEING BLOWN OVER.
- 6. THE COMPANY THAT SUPPLIES AND MAINTAINS THE PORTABLE TOILETS SHALL BE NOTIFIED IMMEDIATELY IF A TOILET IS TIPPED OVER OR DAMAGED IN A WAY THAT THE RESULTS IN A DISCHARGE. DISCHARGED SOLID MATTER SHALL BE VACUUMED INTO A SEPTIC TRUCK BY THE COMPANY THAT MAINTAINS THE TOILETS.
- 7. THE OPERATOR OF THE MUNICIPAL SEPARATE STORM SEWER SYSTEM (MS4) SHALL BE NOTIFIED IF A DISCHARGE FROM THE PORTABLE TOILETS ENTERS THE MS4 OR A NATURAL CHANNEL.
- 8. SANITARY FACILITIES SHALL NOT BE PERMITTED ON PUBLIC SIDEWALKS, STREETS OR INLETS.

DEBRIS AND TRASH NOTES

- 1. ALL WASTE SOURCES AND STORAGE AREAS SHALL BE LOCATED A MINIMUM OF 50 FEET AWAY FROM INLETS, SWALES, DRAINAGE WAYS, CHANNELS AND OTHER WATERS, IF THE SITE CONFIGURATION PROVIDES SUFFICIENT SPACE TO DO SO. IN NO CASE SHALL MATERIAL AND WASTE SOURCES BE CLOSER THAN 20 FROM INLETS, SWALES, DRAINAGE WAYS, CHANNELS, AND OTHER WATERS.
- 2. CONSTRUCTION WASTE AND TRASH SHALL BE STORED IN A MANNER THAT MINIMIZES ITS EXPOSURE TO PRECIPITATION AND STORMWATER RUNOFF.
- 3. WHENEVER POSSIBLE, MINIMIZE PRODUCTION OF DEBRIS AND TRASH.
- 4. INSTRUCT CONSTRUCTION WORKERS IN PROPER DEBRIS AND TRASH STORAGE AND HANDLING PROCEDURES.
- 5. SEGREGATE POTENTIAL HAZARDOUS WASTE FROM NON-HAZARDOUS CONSTRUCTION SITE DEBRIS.
- 6. PROHIBIT LITTERING BY WORKERS AND VISITORS.
- 7. POLICE SITE DAILY FOR LITTER AND DEBRIS.
- 8. ENFORCE SOLID WASTE HANDLING AND STORAGE PROCEDURES.
- 9. IF FEASIBLE, RECYCLE CONSTRUCTION AND DEMOLITION DEBRIS SUCH AS WOOD, METAL, AND CONCRETE.
- 10. TRASH AND DEBRIS SHALL BE REMOVED FROM THE SITE AT REGULAR INTERVALS THAT ARE SCHEDULED TO EMPTY CONTAINERS WHEN THEY ARE 90 PERCENT FULL OR MORE FREQUENTLY.
- 11. GENERAL CONSTRUCTION DEBRIS MAY BE HAULED TO A LICENSED CONSTRUCTION DEBRIS LANDFILL.
- 12. USE WASTE AND RECYCLING HAULERS/FACILITIES APPROVED BY THE LOCAL MUNICIPALITY.
- 13. CHIPPING OF TREES AND BRUSH FOR USE SUCH AS MULCH IS PREFERRED ALTERNATIVE TO DEBRIS DISPOSAL.
- 14. NO WASTE, TRASH, OR DEBRIS SHALL BE BURIED, BURNED OR OTHER WISE DISPOSED OF ONSITE.
- 15. CLEARLY MARK ON ALL DEBRIS AND TRASH CONTAINERS WHICH MATERIALS ARE ACCEPTABLE. FOREMAN AND/OR CONSTRUCTION SUPERVISOR SHALL MONITOR ONSITE SOLID WASTE STORAGE AND DISPOSAL PROCEDURES DAILY.

CONCRETE SAWCUTTING WASTE NOTES

- 1. DURING SAWCUTTING OPERATIONS, THE SLURRY AND CUTTINGS SHALL BE CONTINUOUSLY VACUUMED OR OTHERWISE RECOVERED AND NOT BE ALLOWED TO DISCHARGE FROM THE SITE.
- 2. IF THE PAVEMENT TO BE CUT IS NEAR A STORM DRAIN INLET, THE INLET SHALL BE BLOCKED BY SANDBAGS OR EQUIVALENT TEMPORARY MEASURES TO PREVENT THE SLURRY FROM ENTERING THE INLET. REMOVE THE SANDBAGS IMMEDIATELY AFTER COMPLETING SAWCUTTING OPERATIONS, SO THEY DO NOT CAUSE DRAINAGE PROBLEMS DURING STORM EVENTS.
- 3. SLURRY AND CUTTINGS SHALL NOT BE ALLOWED TO REMAIN ON THE PAVEMENT TO DRY OUT.
- 4. DEVELOP PRE-DETERMINED, SAFE SLURRY DISPOSAL AREAS.
- 5. COLLECTED SLURRY AND CUTTINGS SHOULD BE IMMEDIATELY HAULED FROM THE SITE FOR DISPOSAL AT A WASTE FACILITY. IF THIS IS NOT POSSIBLE, THE SLURRY AND CUTTINGS SHALL BE DISCHARGED INTO ONSITE CONTAINMENT.
- 6. THE ONSITE CONTAINMENT MAY BE EXCAVATED OR BERMED PIT LINED WITH PLASTIC MINIMUM OF 10 MILIMETERS THICK. IF THE PROJECT INCLUDES PLACEMENT OF NEW CONCRETE, SLURRY FROM SAWCUTTING MAY BE DISPOSED OF IN FACILITIES DESIGNATED FOR THE WASHOUT OF CONCRETE TRUCKS INSTEAD CONSTRUCTING A SEPARATE CONTAINMENT.
- 7. THE CONTAINMENT SHALL BE LOCATED A MINIMUM OF 50 FEET AWAY FROM INLETS, SWALES, DRAINAGE WAYS, CHANNELS, AND OTHER WATERS, IF THE SITE CONFIGURATION PROVIDES SUFFICIENT SPACE TO DO SO. IN NO CASE SHALL THE COLLECTION AREA BE CLOSER THAN 20 FEET FROM INLETS, SWALES, DRAINAGE WAYS, CHANNELS AND OTHER WATERS.
- 8. SEVERAL, PORTABLE, PRE-FABRICATED, CONCRETE WASHOUT, COLLECTION BASINS ARE COMMERCIALLY AVAILABLE AND ARE AN ACCEPTABLE ALTERNATIVE TO AN ONSITE CONTAINMENT PIT.
- 9. REMOVE MASTER CONCRETE WHEN THE CONTAINMENT IS HALF FULL. ALWAYS MAINTAIN A MINIMUM OF ONE FOOT FREEBOARD.
- 10. ONSITE EVAPORATION OF SLURRY WATER AND RECYCLING OF THE CONCRETE WASTE IS THE PREFERRED DISPOSAL METHOD. WHEN THIS IS NOT FEASIBLE, DISCHARGE FROM THE COLLECTION AREA SHALL ONLY BE ALLOWED IF A PASSIVE TREATMENT SYSTEM IS USED TO REMOVE THE FINES. MECHANICAL MIXING IS REQUIRED IN THE COLLECTION AREA. THE pH MUST BE TESTED, AND DISCHARGED IS ALLOWED IN IF THE pH DOES NOT EXCEED 8.0. THE pH MAY BE LOWERED BY ADDING SULFURIC ACID TO THE SLURRY WATER.
- 11. CARE SHALL BE EXERCISED WHEN TREATING THE SLURRY WATER FOR DISCHARGE. MONITORING MUST BE IMPLEMENTED TO VERIFY THAT DISCHARGES FROM THE COLLECTION AREA DO NOT VIOLATE GROUNDWATER OR SURFACE WATER QUALITY STANDARDS.
- 12. GEOTEXTILE FABRICS SUCH AS THOSE USED FOR SILT FENCE SHOULD NOT BE USED TO CONTROL SAWCUTTING WASTE, SINCE THE GRAIN SIZE IS SIGNIFICANTLY SMALLER THAN THE APPARENT OPENING SIZE OF THE FABRIC.

SPILL AND LEAK RESPONSE NOTES


- 1. RECORDS OF RELEASES THAT EXCEED THE REPORTABLE QUANTITY (RQ) FOR OIL AND HAZARDOUS SUBSTANCES SHOULD BE MAINTAINED IN ACCORDANCE WITH THE FEDERAL AND STATE REGULATIONS.
- 2. EMERGENCY CONTACT INFORMATION AND SPILL RESPONSE PROCEDURES SHALL BE POSTED IN A READILY AVAILABLE REA FOR ACCESS BY ALL EMPLOYEES AND SUBCONTRACTORS.
- 3. SPILL CONTAINMENT KITS SHOULD BE MAINTAINED FOR PETROLEUM PRODUCTS AND OTHER CHEMICALS THAT ARE REGULARLY ONSITE. MATERIALS IN KITS SHOULD BE BASED ON CONTAINMENT GUIDELINES IN THE MATERIALS SAFETY AND DATA SHEETS (MSDS) FOR THE SUBSTANCE MOST FREQUENTLY ONSITE.
- 4. SPILL KITS ARE INTENDED FOR RESPONSE TO SMALL SPILLS, TYPICALLY LESS THAN 5 GALLONS, OF SUBSTANCES THAT ARE NOT EXTREMELY HAZARDOUS.
- 5. SIGNIFICANT SPILLS OR OTHER RELEASES WARRANT IMMEDIATE RESPONSE BY TRAINED PROFESSIONALS.
- 6. SUSPECTED JOB-SITE CONTAMINATION SHOULD BE IMMEDIATELY REPORTED TO REGULATORY AUTHORITIES AND PROTECTIVE ACTIONS TAKEN.
- 7. THE CONTRACTOR SHOULD BE REQUIRED TO DESIGNATE A SITE SUPERINTENDENT, FOREMAN, SAFETY OFFICER, OR OTHER SENIOR PERSON WHO IS ONSITE DAILY TO BE THE SPILL AND LEAK RESPONSE COORDINATOR (SLRC) AND MUST HAVE KNOWLEDGE OF AND BE TRAINED IN CORRECT SPILL AND LEAK RESPONSE PROCEDURES.

SUBGRADE STABILIZATION NOTES

- 1. MINIMIZE THE DISCHARGE OF THE CHEMICAL STABILIZERS BY THE CONTRACTOR LIMITING THE AMOUNT OF STABILIZING AGENT ONSITE TO THAT WHICH CAN BE THOROUGHLY MIXED AND COMPACTED BY THE END OF EACH WORKDAY.
- 2. STABILIZERS SHALL BE APPLIED AT RATES THAT RESULT IN NO RUN OFF.
- 3. STABILIZATION SHALL NOT OCCUR IMMEDIATELY BEFORE AND DURING RAINFALL EVENTS.
- 4. NO TRAFFIC OTHER THAN WATER TRUCKS AND MIXING EQUIPMENT SHALL BE ALLOWED TO PASS OVER THE AREA BEING STABILIZED UNTIL AFTER COMPLETION OF MIXING THE CHEMICAL.
- 5. AREA ADJACENT AND DOWNSTREAM OF STABILIZED AREAS SHALL BE ROUGHENED TO INTERCEPT CHEMICAL RUNOFF AND REDUCE RUNOFF VELOCITY.
- 6. GEOTEXTILE FABRICS SUCH AS THOSE USED FOR SILT FENCE SHOULD NOT BE USED TO TREAT CHEMICAL RUNOFF, BECAUSE THE CHEMICALS ARE DISSOLVED IN THE WATER AND WON'T BE AFFECTED BY A BARRIER AND THE SUSPENDED SOLIDS ARE SIGNIFICANTLY SMALLER THAN THE APPARENT OPENING SIZE OF THE FABRIC.
- 7. IF SOIL STABILIZERS ARE STORED ONSITE, THEY SHALL BE CONSIDERED HAZARDOUS MATERIAL AND SHALL BE MANAGED ACCORDING TO THE CRITERIA OF CHEMICAL MANAGEMENT TO CAPTURE ANY ACCIDENTAL LIME OR CHEMICAL OVERFLOW.
- 8. THE CONTRACTOR SHALL INSTALL BMP'S TO ALL INLETS AND OPENINGS CONNECTED TO THE STORM SEWER SYSTEMS TO PREVENT LIME FROM ENTERING THE MS4 SYSTEM.

SANDBLASTING WASTE NOTES

- 1. THE CONTRACTOR SHOULD BE REQUIRED TO DESIGNATE THE SITE SUPERINTENDENT, FOREMAN, OR OTHER PERSON WHO IS RESPONSIBLE FOR SANDBLASTING TO ALSO BE RESPONSIBLE FOR SANDBLASTING WASTE MANAGEMENT.
- 2. PROHIBIT THE DISCHARGE OF SANDBLASTING WASTE.
- 3. USE ONLY INERT, NON-DEGRADABLE SANDBLAST MEDIA.
- 4. USE APPROPRIATE EQUIPMENT FOR THE JOB; DO NOT OVER-BLAST.
- 5. WHENEVER POSSIBLE, BLAST IN A DOWNWARD DIRECTION.
- 6. CEASE BLASTING ACTIVITIES IN HIGH WINDS OR IF WIND DIRECTION COULD TRANSPORT GRIT TO DRAINAGE FACILITIES.
- 7. INSTALL DUST SHIELDING AROUND SANDBLASTING AREAS.
- 8. COLLECT AND DISPOSE OF ALL SPENT SANDBLAST GRIT, USE DUST CONTAINMENT FABRICS AND DUST COLLECTION HOPPERS AND BARRELS.
- 9. NON-HAZARDOUS SANDBLAST GRIT MAY BE DISPOSED IN PERMITTED CONSTRUCTION DEBRIS LANDFILLS OR PERMITTED SANITARY LANDFILLS.
- 10. IF SANDBLAST MEDIA CANNOT BE FULLY CONTAINED, CONSTRUCT SEDIMENT TRAPS DOWNSTREAM FROM BLASTING AREA WHERE APPROPRIATE.
- 11. USE SAND FENCING WHERE APPROPRIATE IN AREAS WHERE BLAST MEDIA CANNOT BE FULLY CONTAINED.
- 12. IF NECESSARY, INSTALL MISTING EQUIPMENT TO REMOVE SANDBLAST GRIT FROM THE AIR PREVENT RUNOFF FROM MISTING OPERATIONS FROM ENTERING DRAINAGE SYSTEMS.
- 13. USE VACUUM GRIT COLLECTION SYSTEMS WHERE POSSIBLE.
- 14. KEEP RECORDS OF SANDBLASTING MATERIALS, PROCEDURES, AND WEATHER CONDITIONS ON A DAILY BASIS.
- 15. TAKE ALL REASONABLE PRECAUTIONS TO ENSURE THAT SANDBLASTING GRIT IS CONTAINED AND KEPT AWAY FROM DRAINAGE STRUCTURES.
- 16. SAND BLASTING MEDIA SHOULD ALWAYS BE STORED UNDER COVER AWAY FROM DRAINAGE STRUCTURES.
- 17. ENSURE THAT STORED MEDIA OR GRIT IS NOT SUBJECTED TO TRANSPORT BY WIND.
- 18. ENSURE THAT ALL SANDBLASTING EQUIPMENT AND STORAGE CONTAINERS COMPLY WITH CURRENT LOCAL, STATE, AND FEDERAL REGULATIONS.
- 19. CAPTURE AND TREAT RUNOFF, WHICH COMES INTO CONTACT WITH SANDBLASTING MATERIALS OR WASTE.

No.	DATE	REVISION
SEAL:		
DESIGN ENGINEER: _____ DATE: _____		
 CITY OF SUGAR LAND, TEXAS ENGINEERING DEPARTMENT		
CONSTRUCTION PLANS FOR:		
GENERAL EROSION CONTROL NOTES		
JOB No.: DATE: DESIGNED BY: DRAWN BY: CHECKED BY: SCALE:	SL-33 SHEET OF	

RECORD DRAWING


NO.	DATE	DESCRIPTION	APPROVED
REVISIONS			

DESIGNED	DR
DRAWN	BT
CHECKED	
DATE	

BAKER & LAWSON, INC.

ENGINEERS • PLANNERS • SURVEYORS

4025 TECHNOLOGY DRIVE, SUITE 1530
ANGLETON, TEXAS 77515 (979) 849-6681
REG. NO. F-825

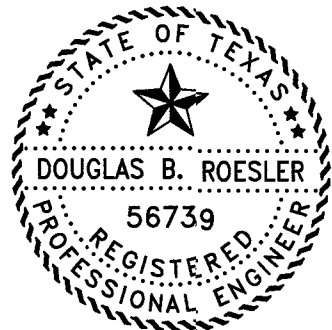







The seal appearing on this document was authorized by Douglas B. Roesler P.E. #6739
Date: 04-18-22

OWNER:
RIVERWAY PROPERTIES
6115 SKYLINE DR. STE A.
HOUSTON, TEXAS 77057

PLAN: _____
PROFILE: _____
HORIZONTAL: _____
VERTICAL: _____

RIVERWOOD RANCH SUBDIVISION
SECTION 2
A 78 AC, 109-LOT SUBDIVISION
ANGLETON, TEXAS 77515

GENERAL EROSION
CONTROL NOTES
SL-33

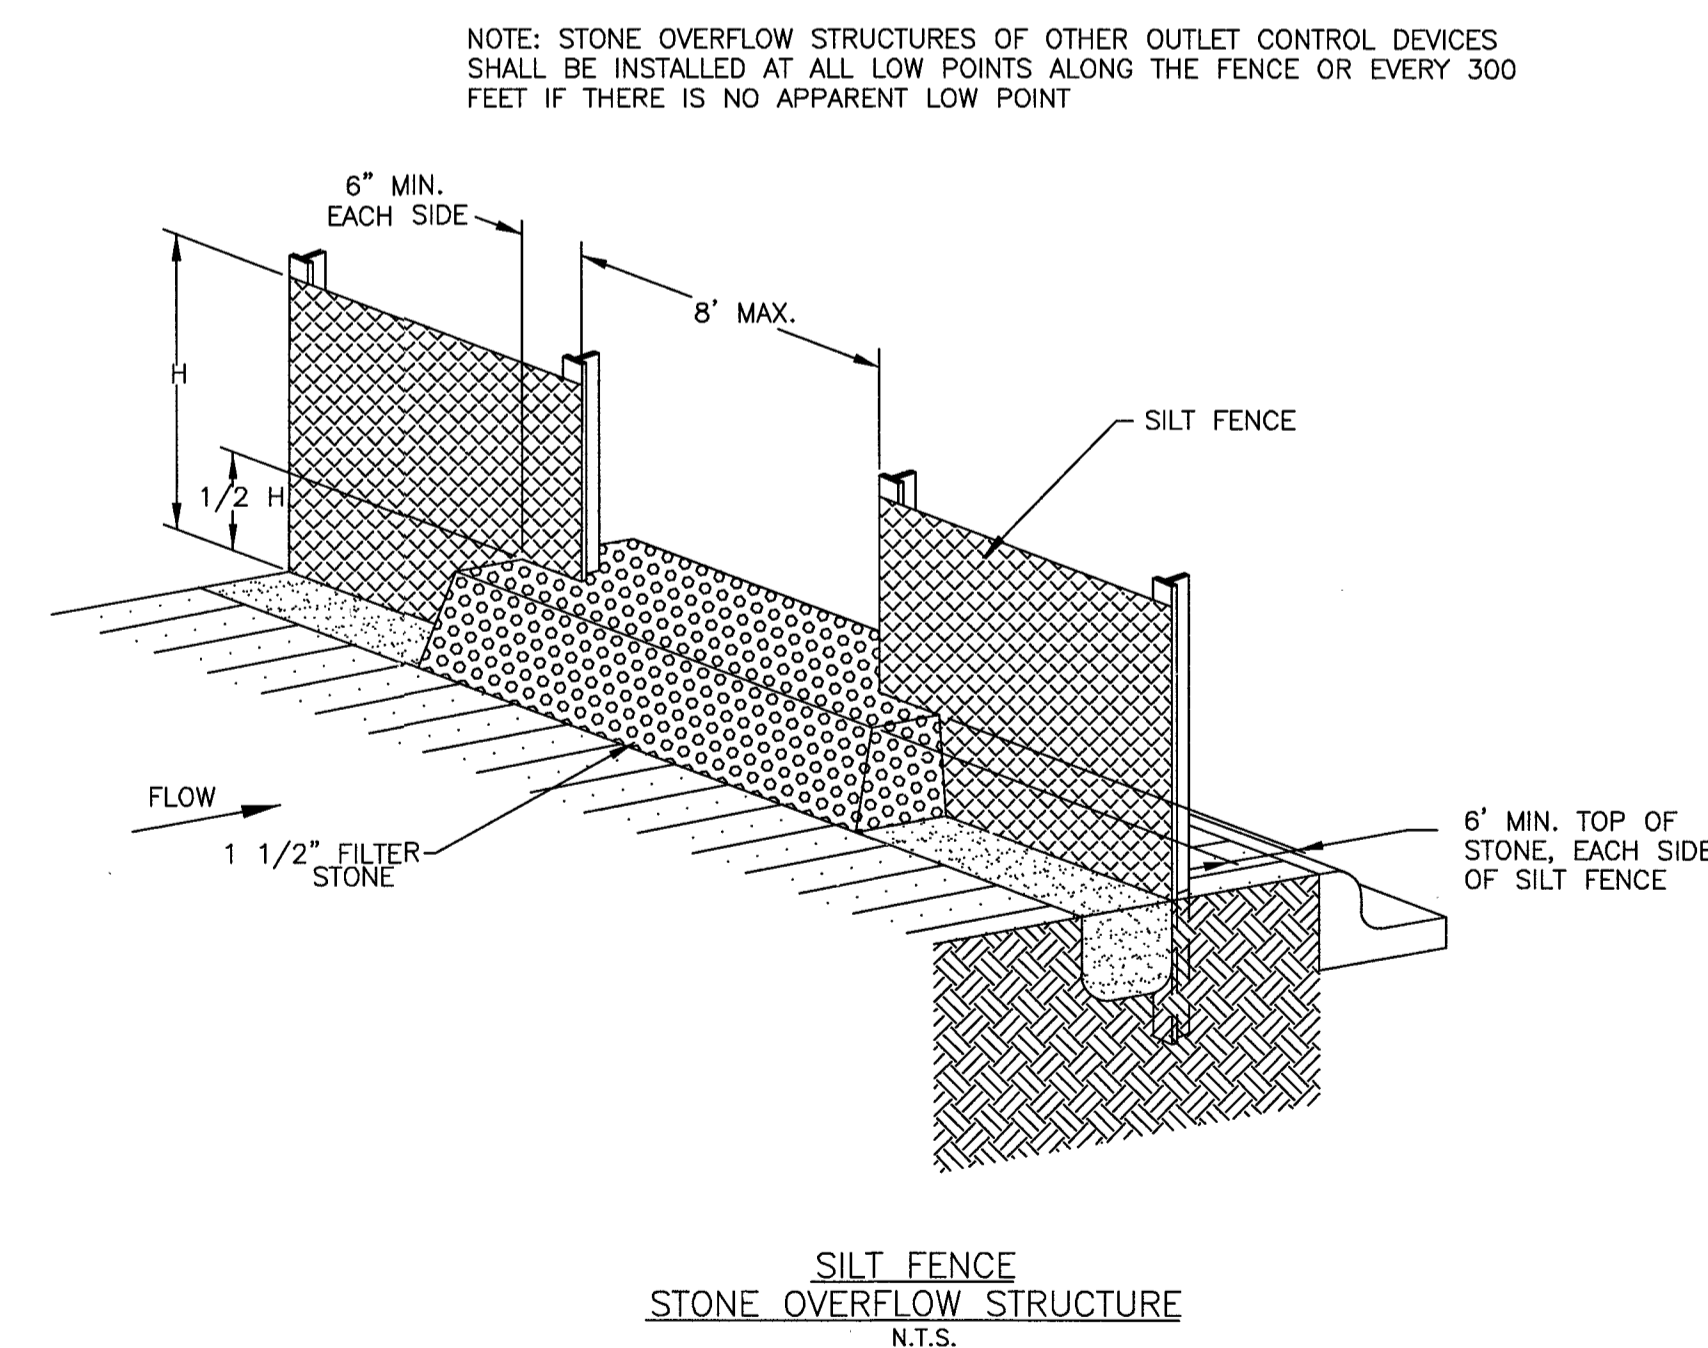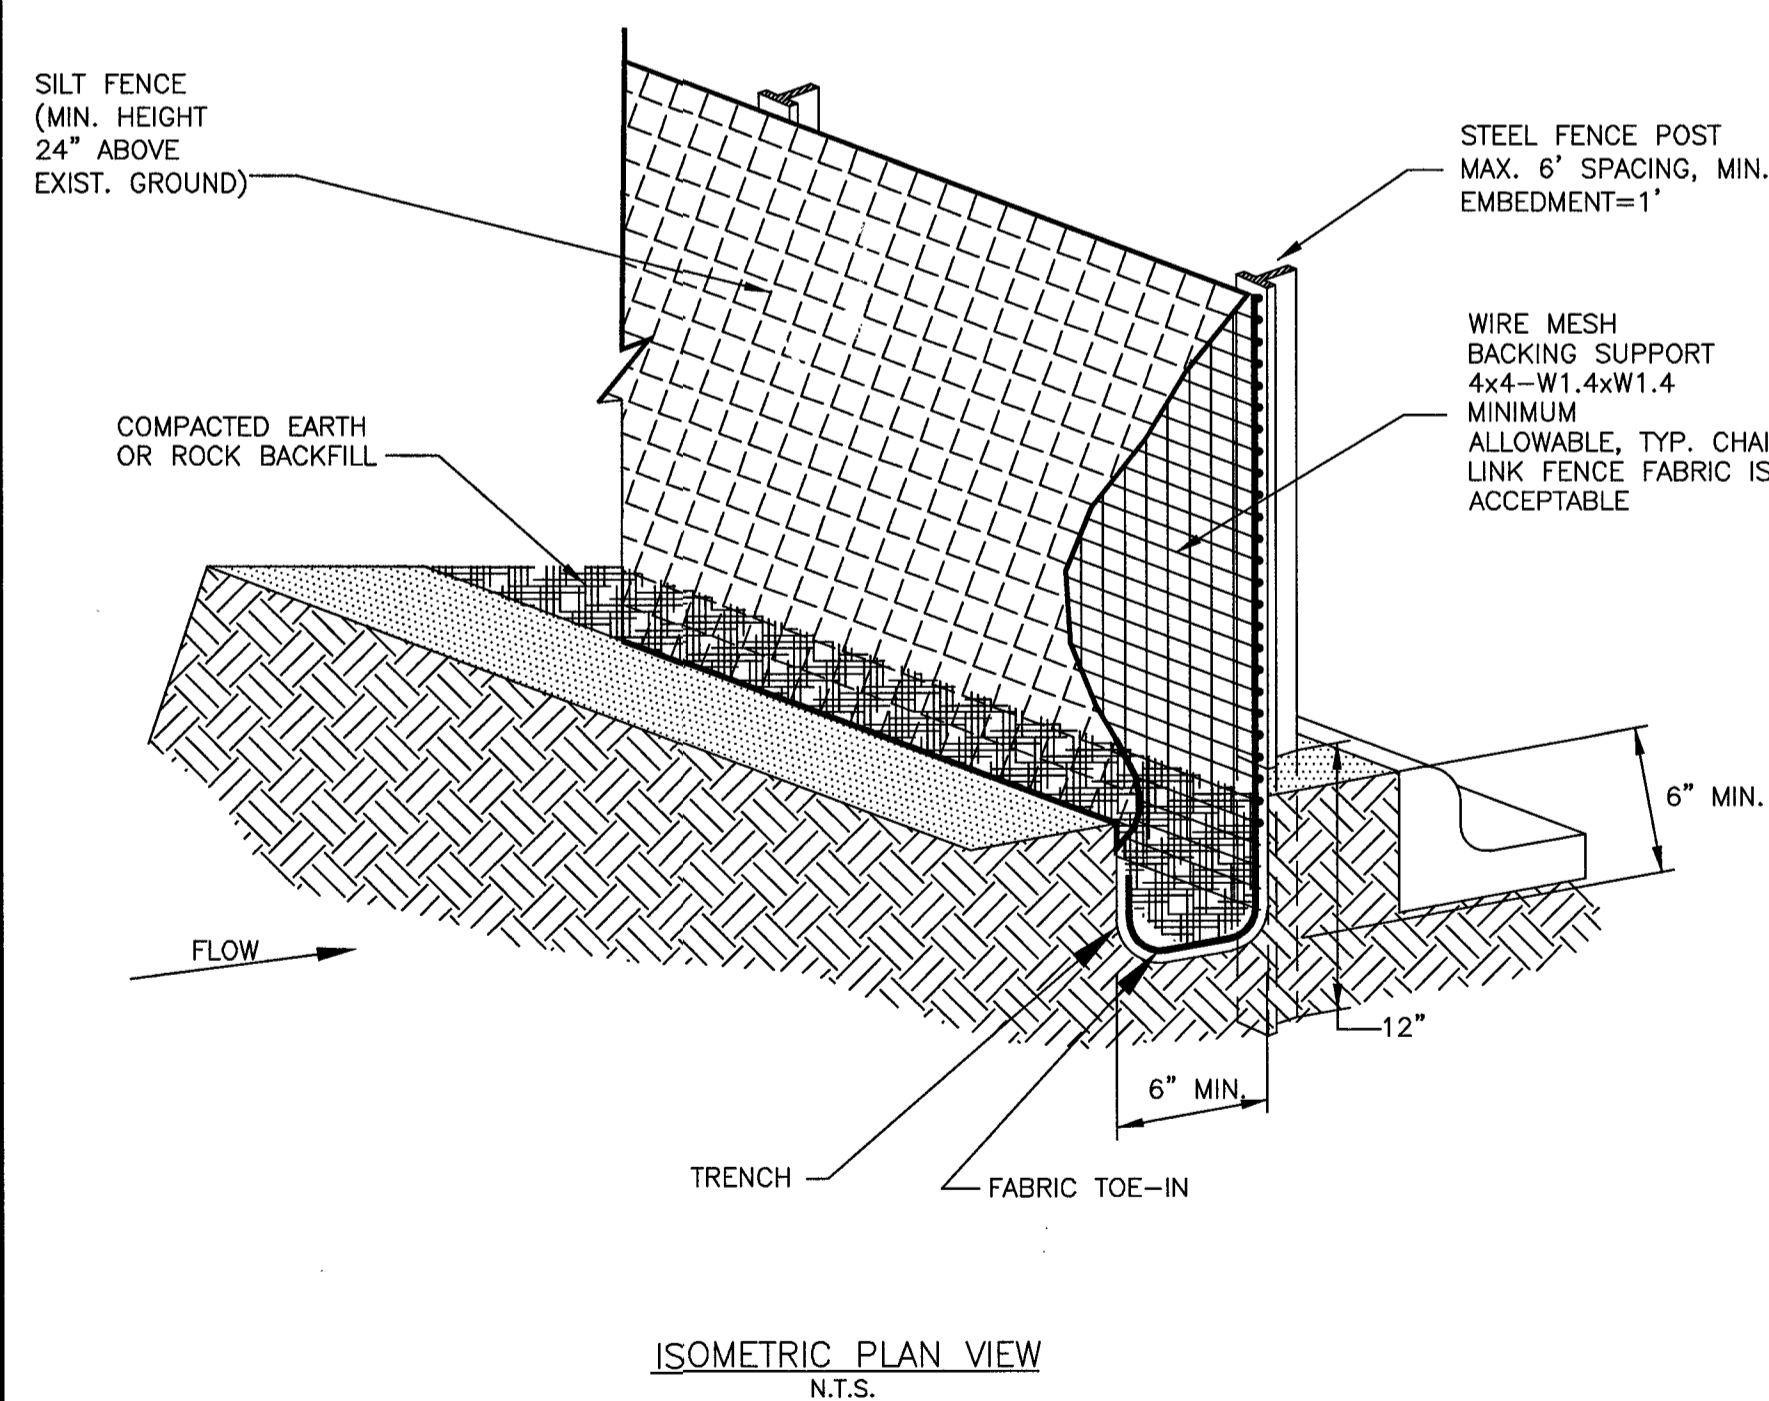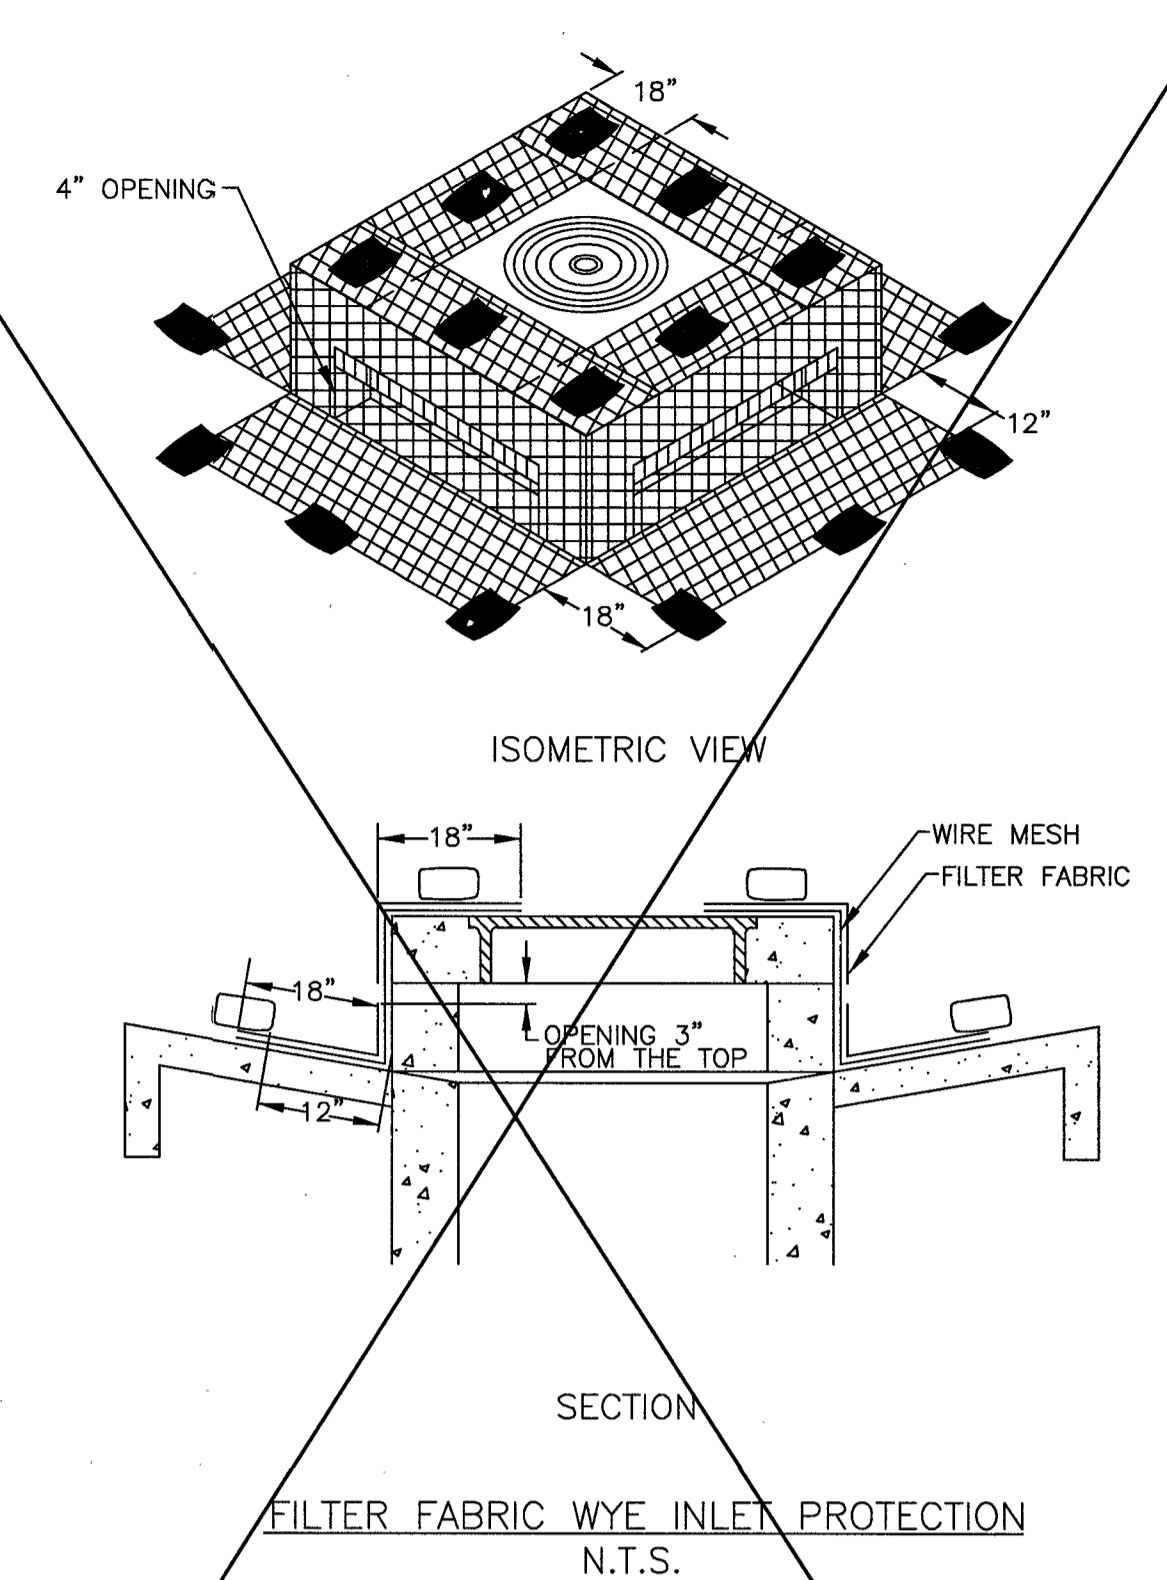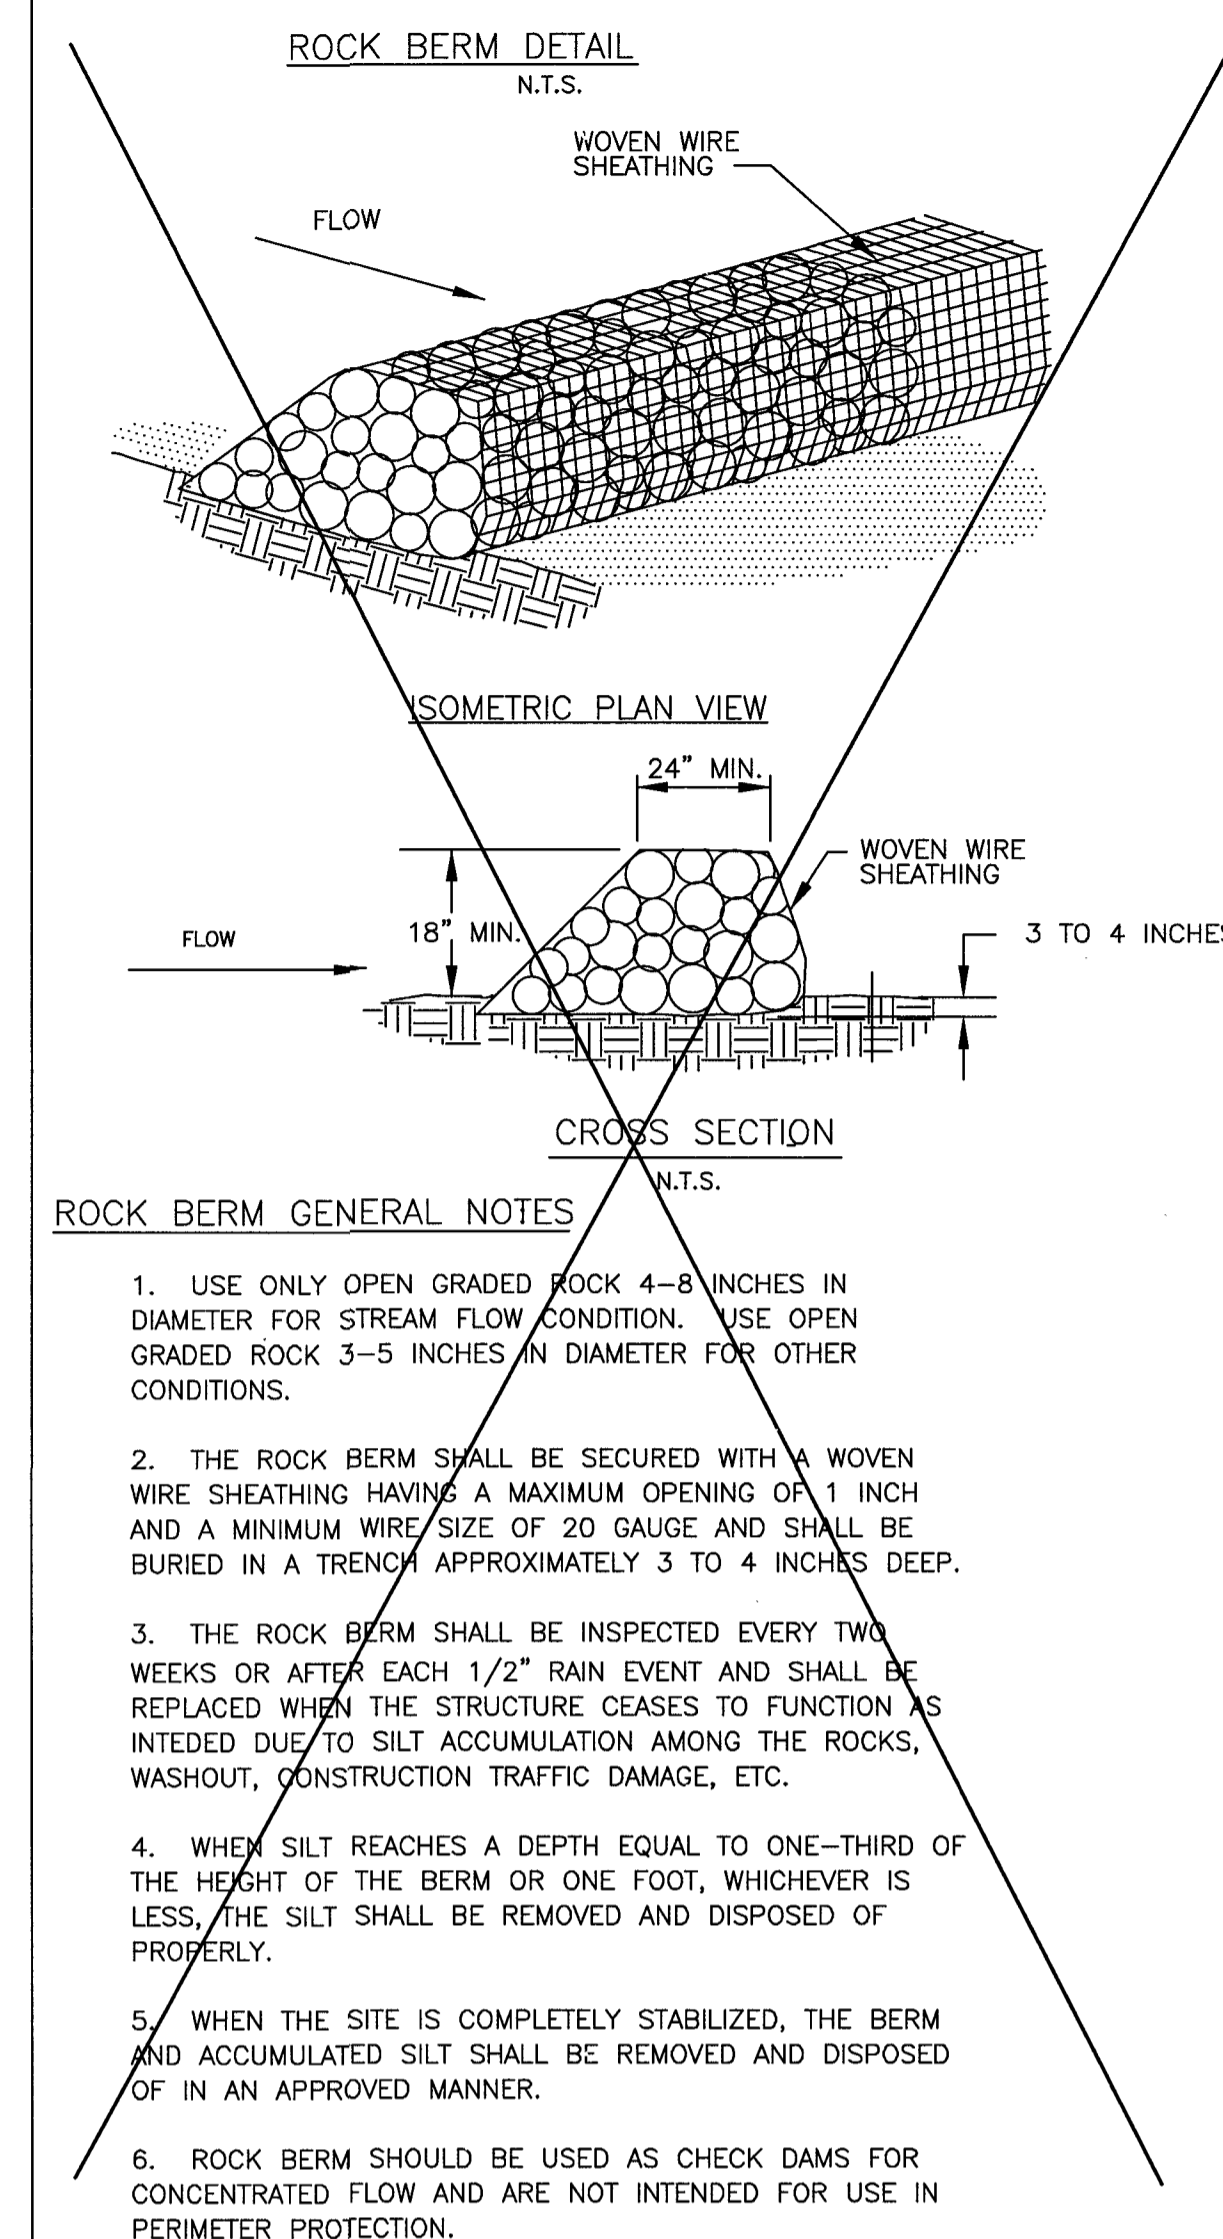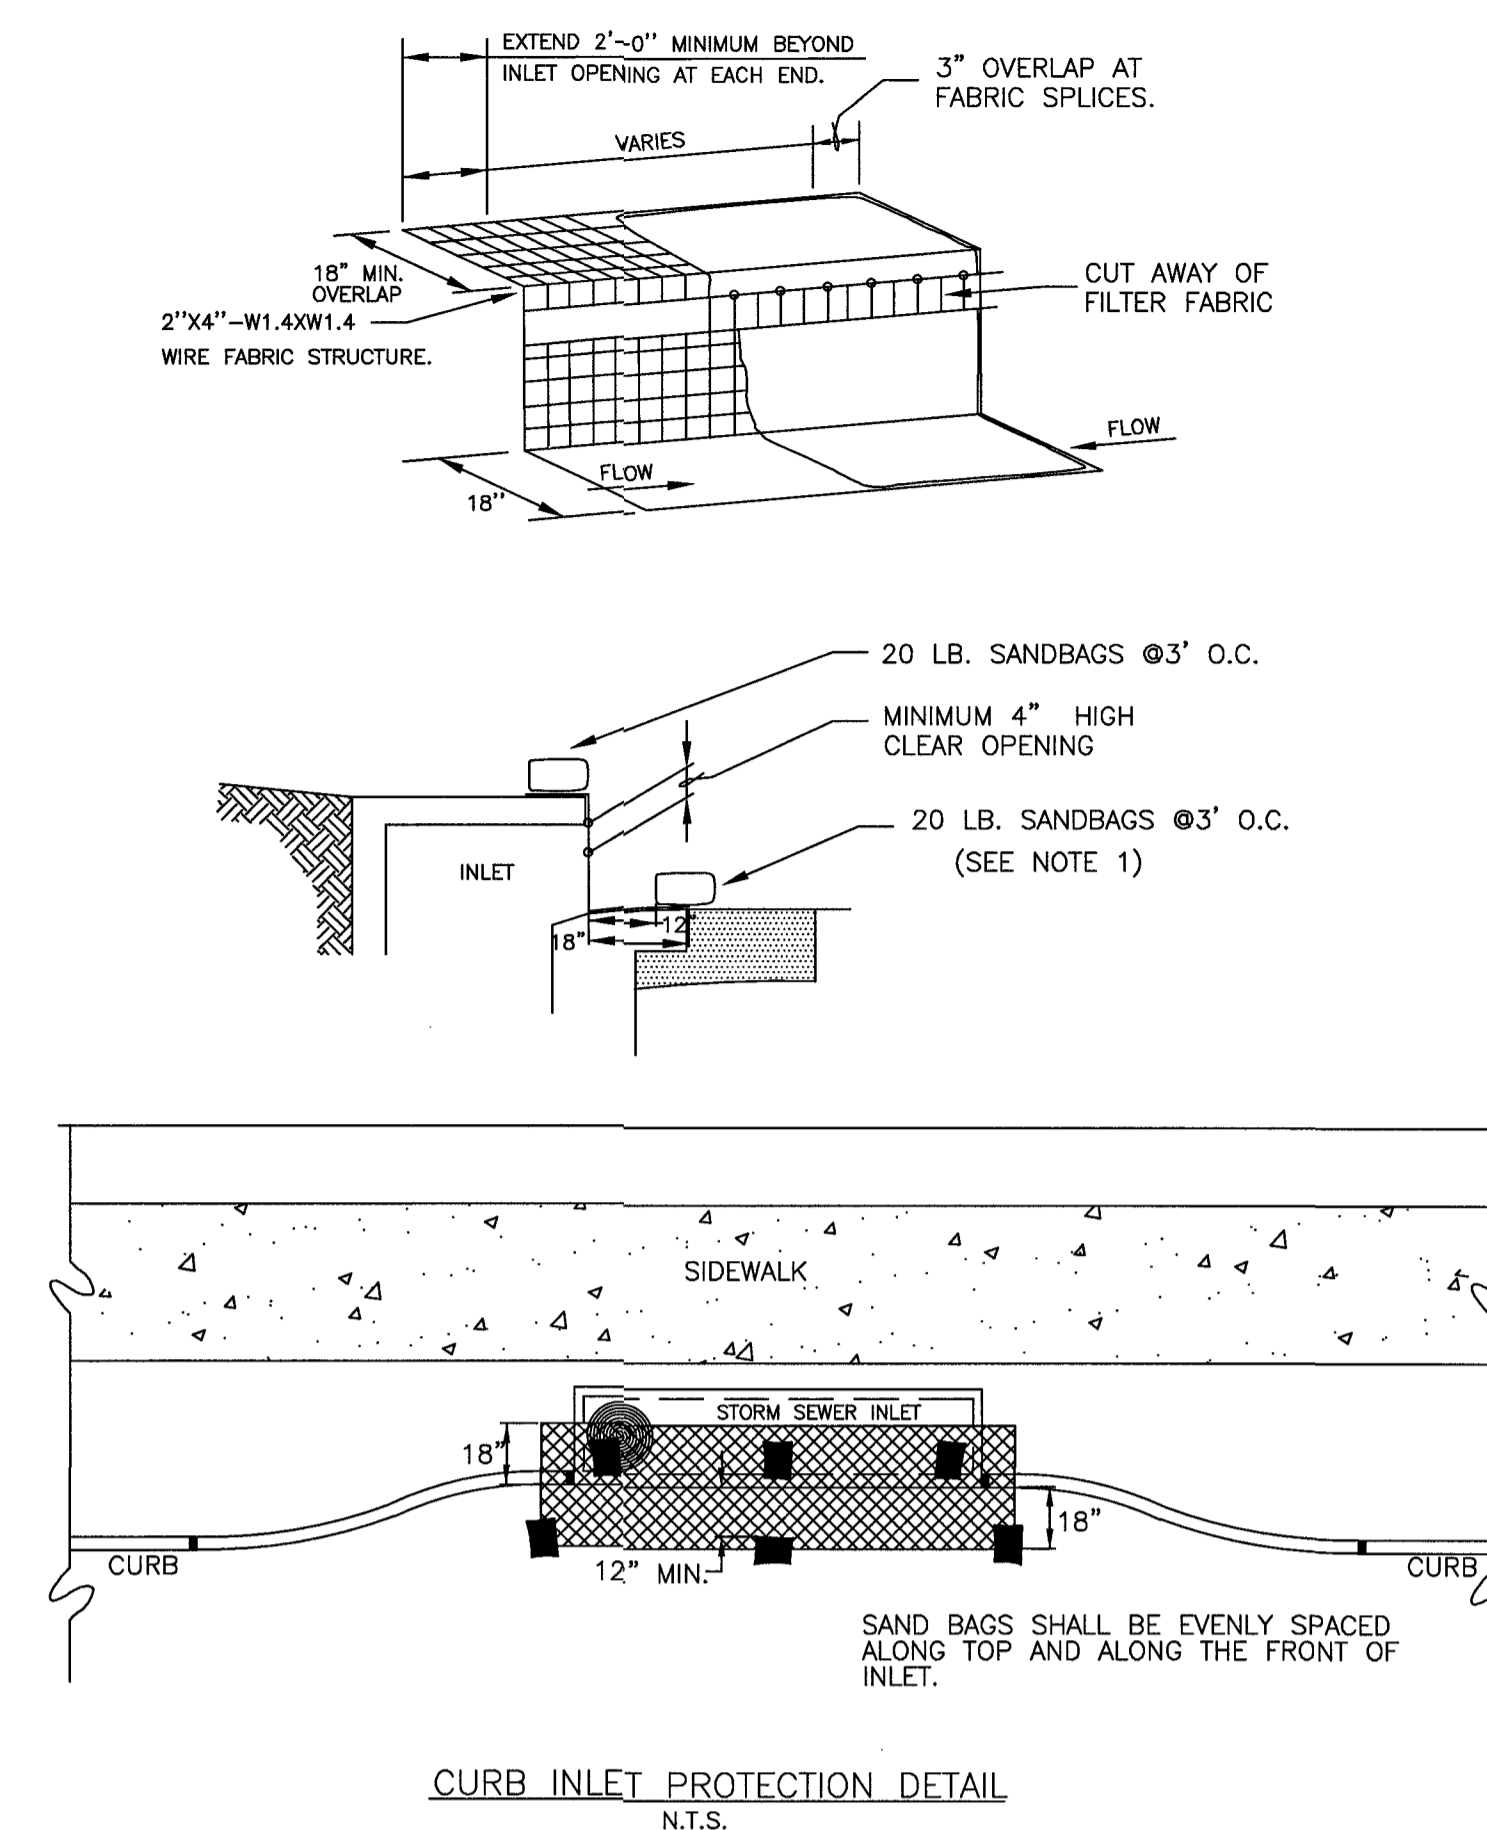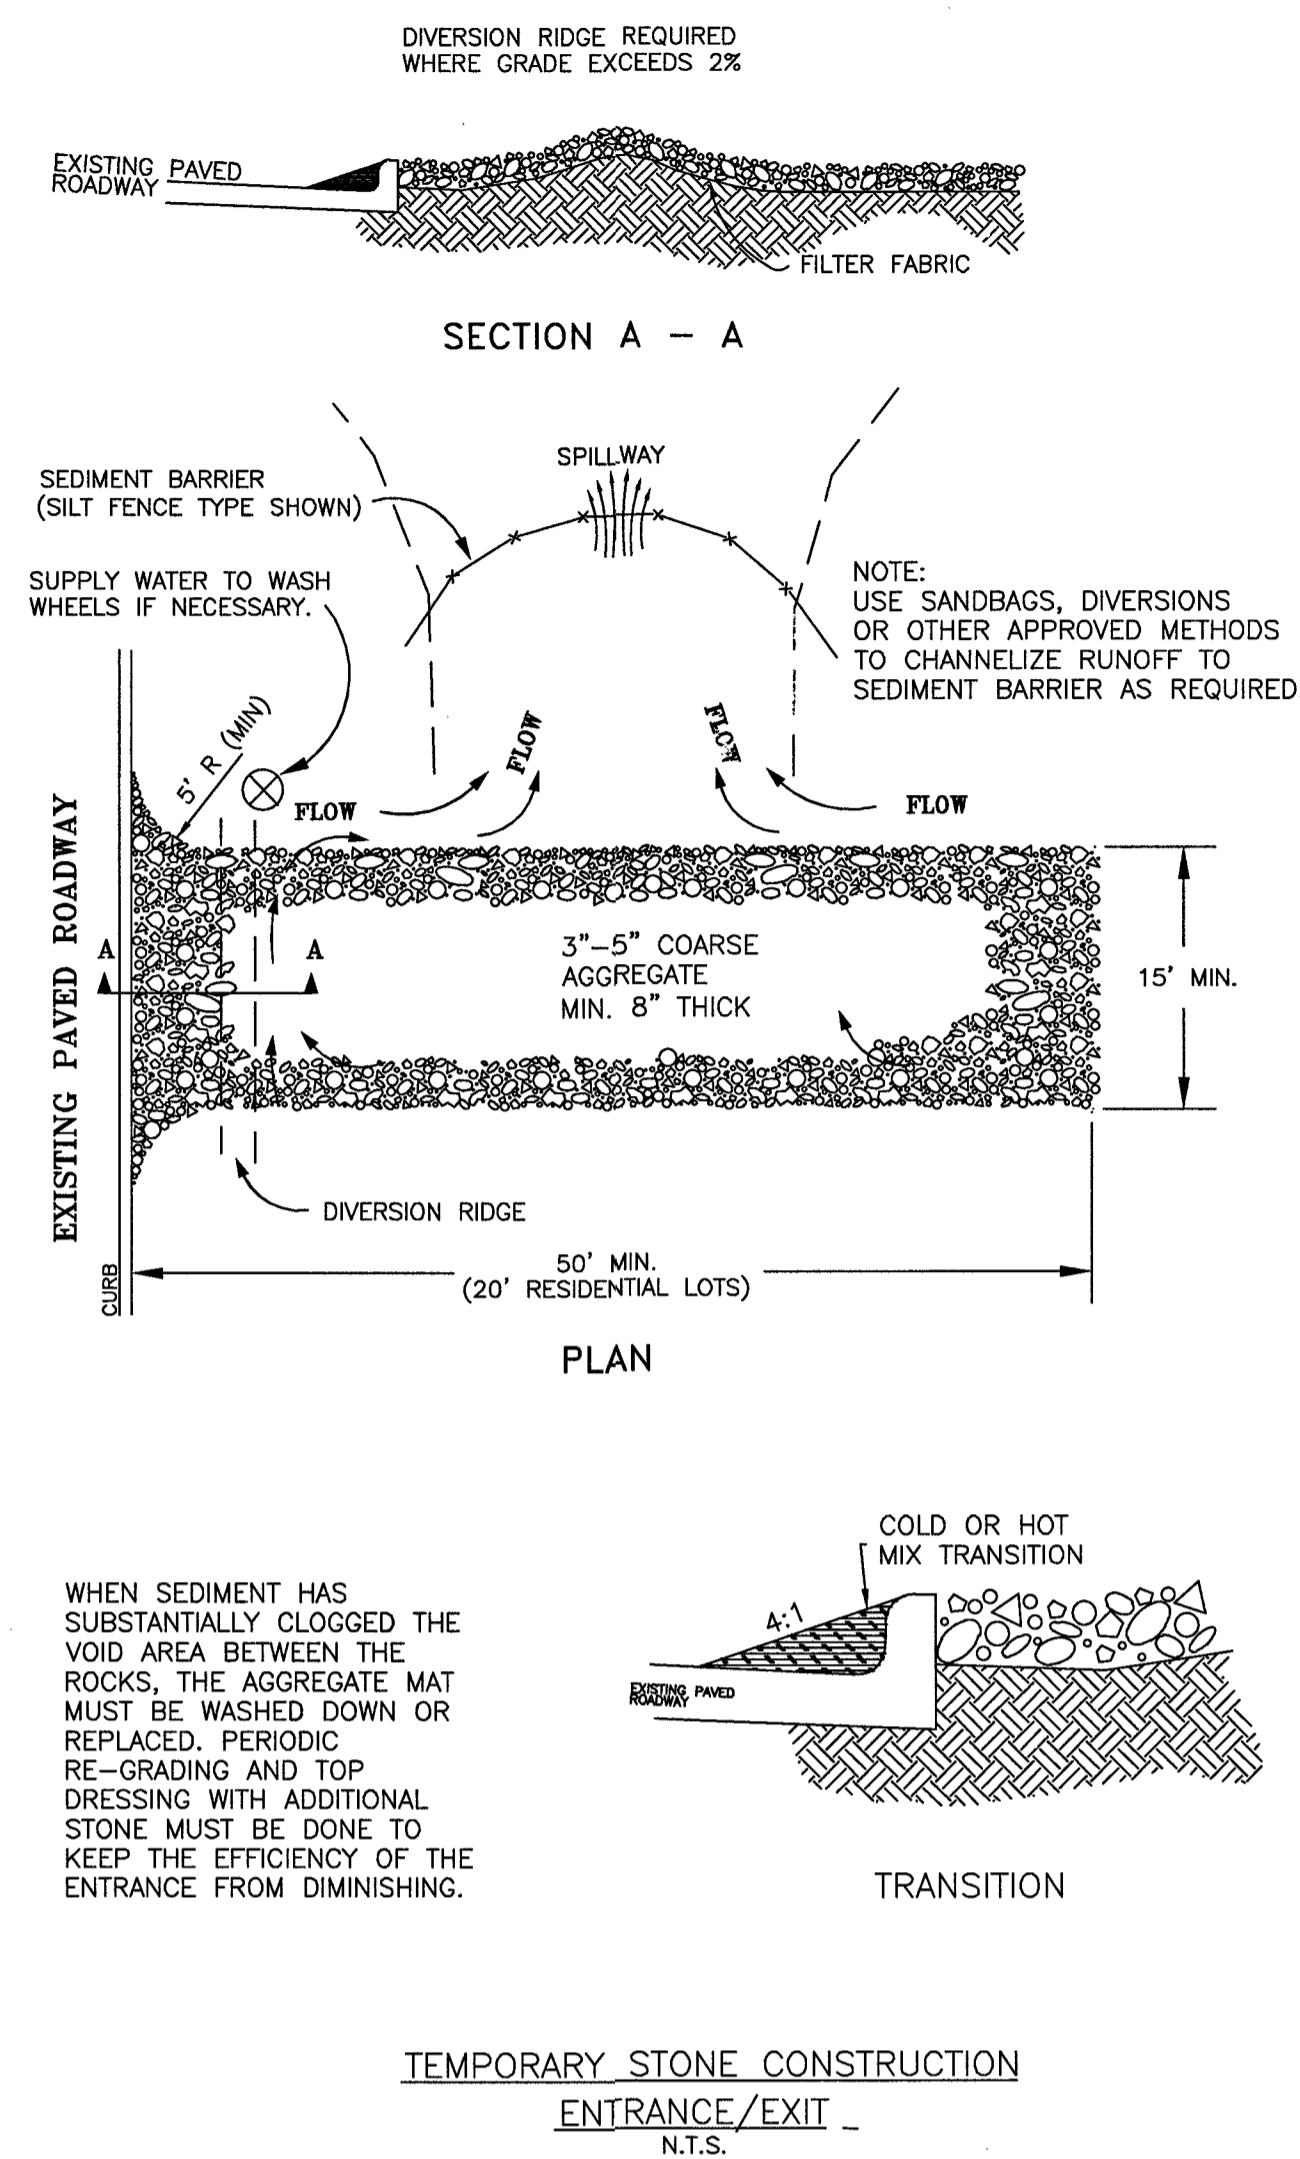[illegible]

NO.	DATE	DESCRIPTION	APPROVED
REVISIONS			

DESIGNED DR

DRAWN BT


CHECKED _____

DATE _____

B & L
BAKER & LAWSON, INC.
ENGINEERS • PLANNERS • SURVEYORS
4005 TECHNOLOGY DRIVE, SUITE 1530
ANGLETON, TEXAS 77515 (979) 849-6681
REG. NO. F-825

A circular professional engineer seal for the State of Texas. The outer ring contains the text "STATE OF TEXAS" at the top and "REGISTERED PROFESSIONAL ENGINEER" at the bottom, separated by two stars on each side. In the center is a five-pointed star. Below the star, the name "DOUGLAS B. ROESLER" is printed, followed by the number "56739".

The seal appearing on
this document was
authorized by
Douglas B. Roesler
P.F. 56739



Date: 04-18-22

OWNER:

***RIVERWAY PROPERTIES
6115 SKYLINE DR. STE A.
HOUSTON, TEXAS 77057***

PLAN: _____

PROFILE: _____

HORIZONTAL: _____

VERTICAL: _____

RIVERWOOD RANCH SUBDIVISION
SECTION 2
A 78 AC, 109-LOT SUBDIVISION
ANGLETON, TEXAS 77515

EROSION CONTROL
DETAILS - 1
SL-34

PROJECT NO. 14395

45

