



VICINITY MAP  
NOT TO SCALE

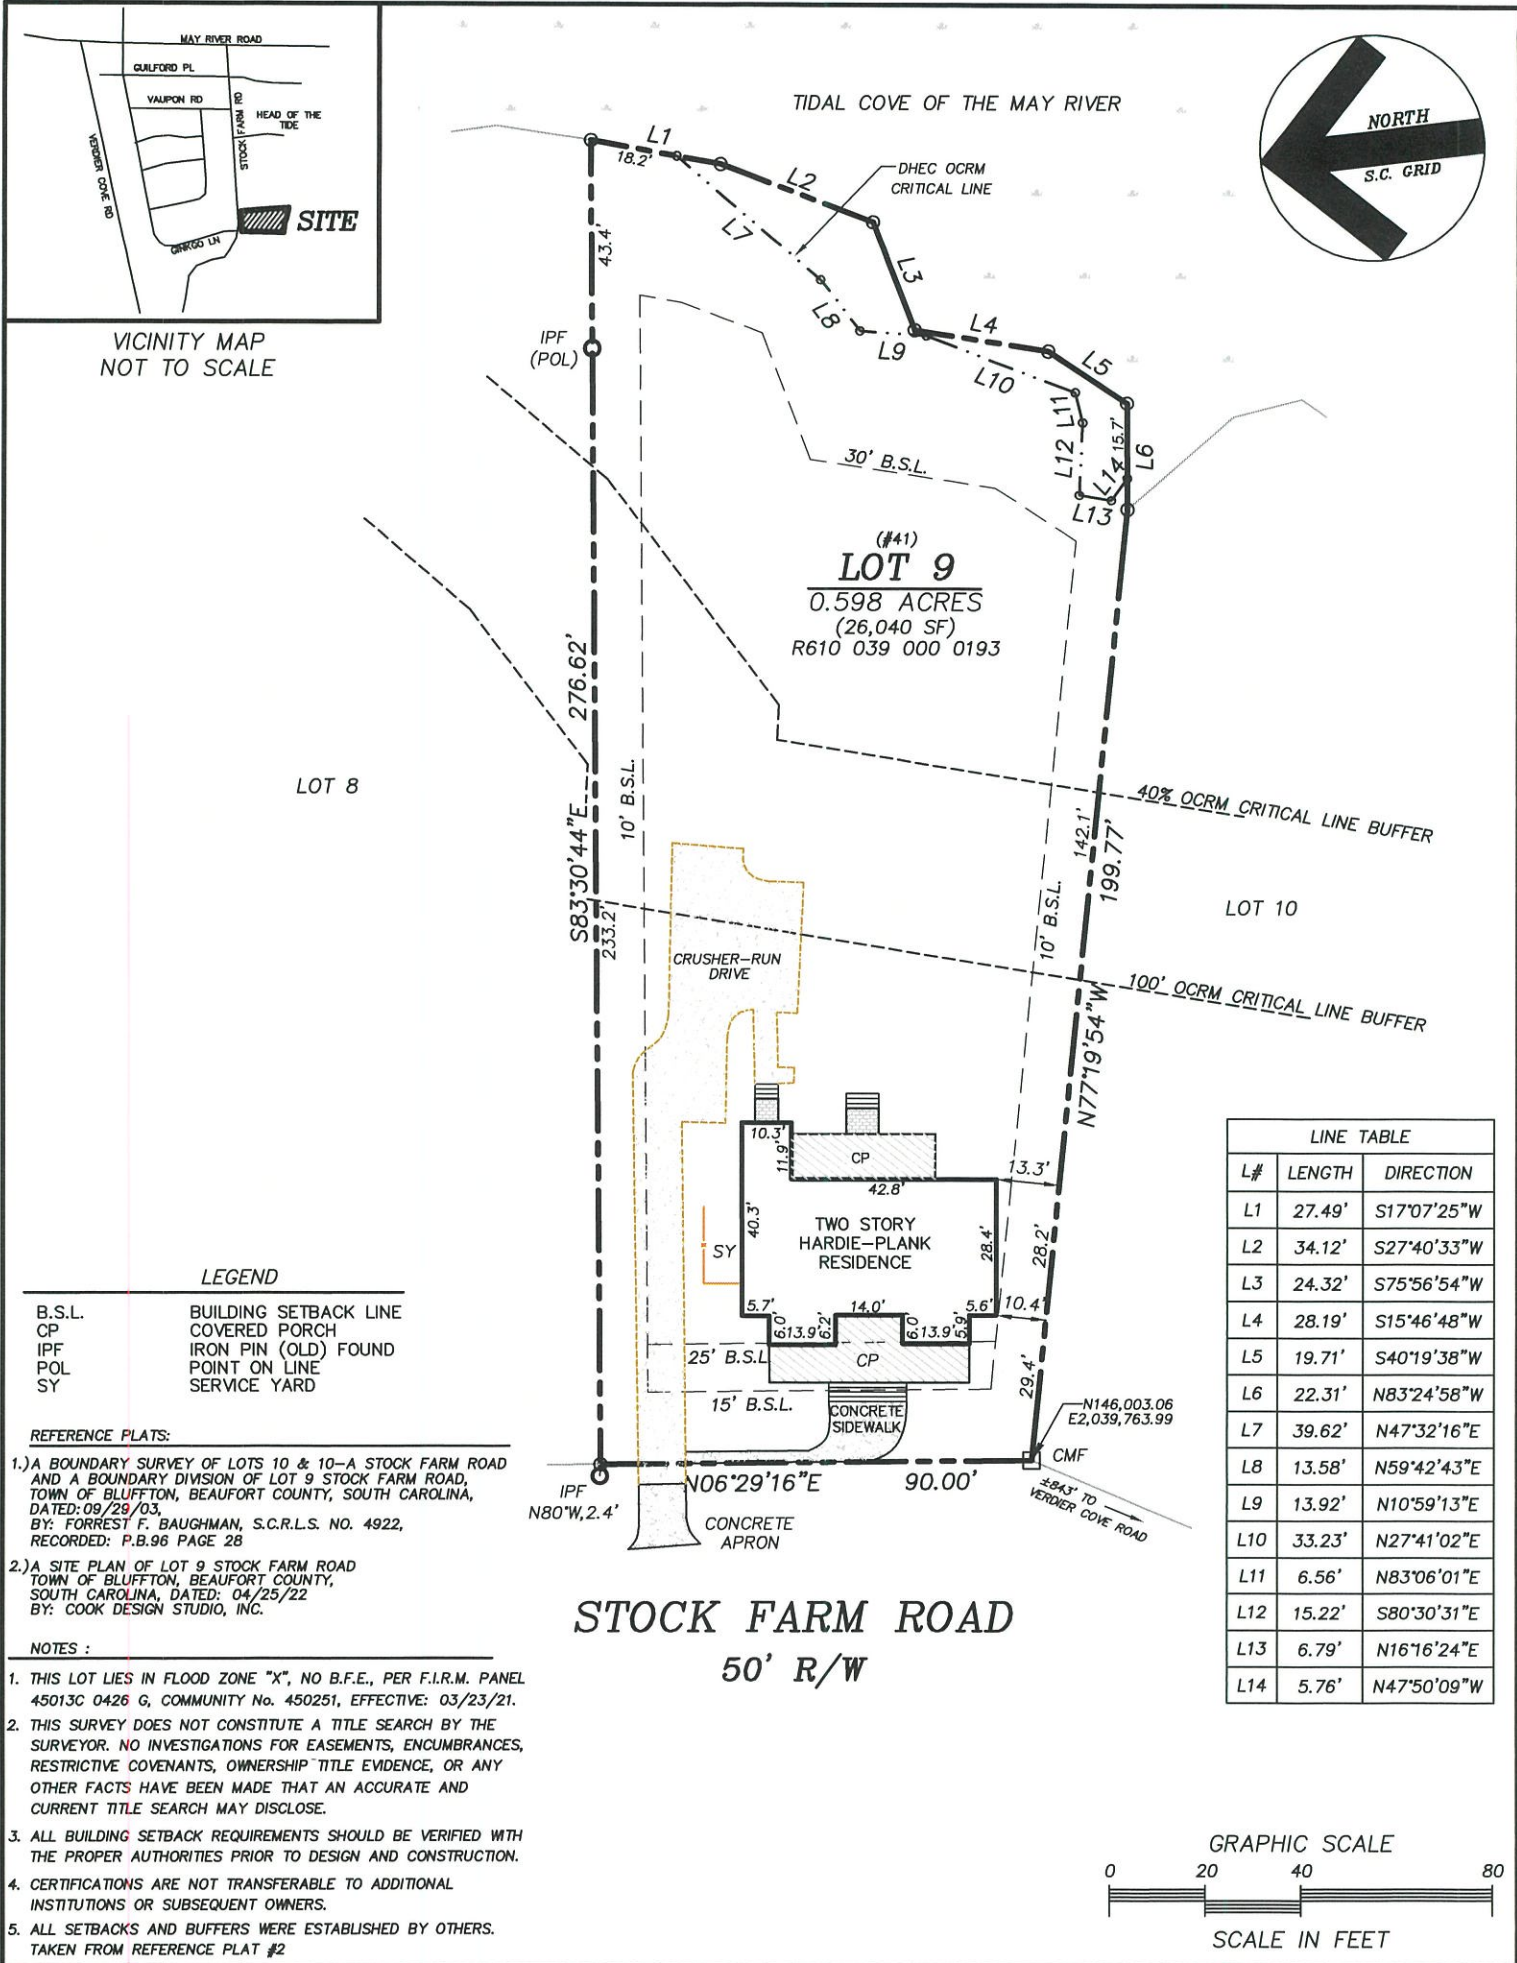

LINE TABLE		
L#	LENGTH	DIRECTION
L1	27.49'	S17°07'25"W
L2	34.12'	S27°40'33"W
L3	24.32'	S75°56'54"W
L4	28.19'	S15°46'48"W
L5	19.71'	S40°19'38"W
L6	22.31'	N83°24'58"W
L7	39.62'	N47°32'16"E
L8	13.58'	N59°42'43"E
L9	13.92'	N10°59'13"E
L10	33.23'	N27°41'02"E
L11	6.56'	N83°06'01"E
L12	15.22'	S80°30'31"E
L13	6.79'	N16°16'24"E
L14	5.76'	N47°50'09"W

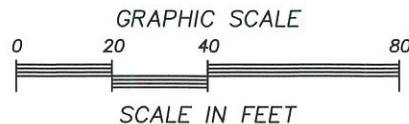

SCALE: 1"=40'

DATE: 06/26/24

FIELD CK: MS

DRAWN BY: RJW

OFFICE CK: MRD

JOB#: 76,510A

PREPARED FOR:

**RFD CONSTRUCTION**

I HEREBY STATE THAT TO THE BEST OF MY KNOWLEDGE, INFORMATION, AND BELIEF, THE SURVEY SHOWN HEREON WAS MADE IN ACCORDANCE WITH THE REQUIREMENTS OF THE MINIMUM STANDARDS MANUAL FOR THE PRACTICE OF LAND SURVEYING IN SOUTH CAROLINA, AND MEETS OR EXCEEDS THE REQUIREMENTS FOR A CLASS "A" SURVEY, AS SPECIFIED THEREIN; ALSO THERE ARE NO VISIBLE ENCROACHMENTS OR PROJECTIONS OTHER THAN SHOWN.

**Michael R. Dunigan**

MICHAEL R. DUNIGAN  
S.C.P.L.S. No. 11,905

AN ASBUILT LAND SURVEY FOR

**LOT 9**

**STOCK FARM ROAD**

A PORTION OF  
**STOCK FARM**  
**MCCRACKEN SUBDIVISION**

TOWN OF BLUFFTON, BEAUFORT COUNTY,  
SOUTH CAROLINA

**COASTAL SURVEYING CO., INC.**

49 RIVERWALK BLVD.  
BUILDING 8  
RIDGELAND, SC 29936  
(843) 645-4448