


Resolution 409-18 Attachment.

#2

4 sided sign cabinet
X2 SIGNS

DIRECTIONAL
AT
ROUND ABOUTS

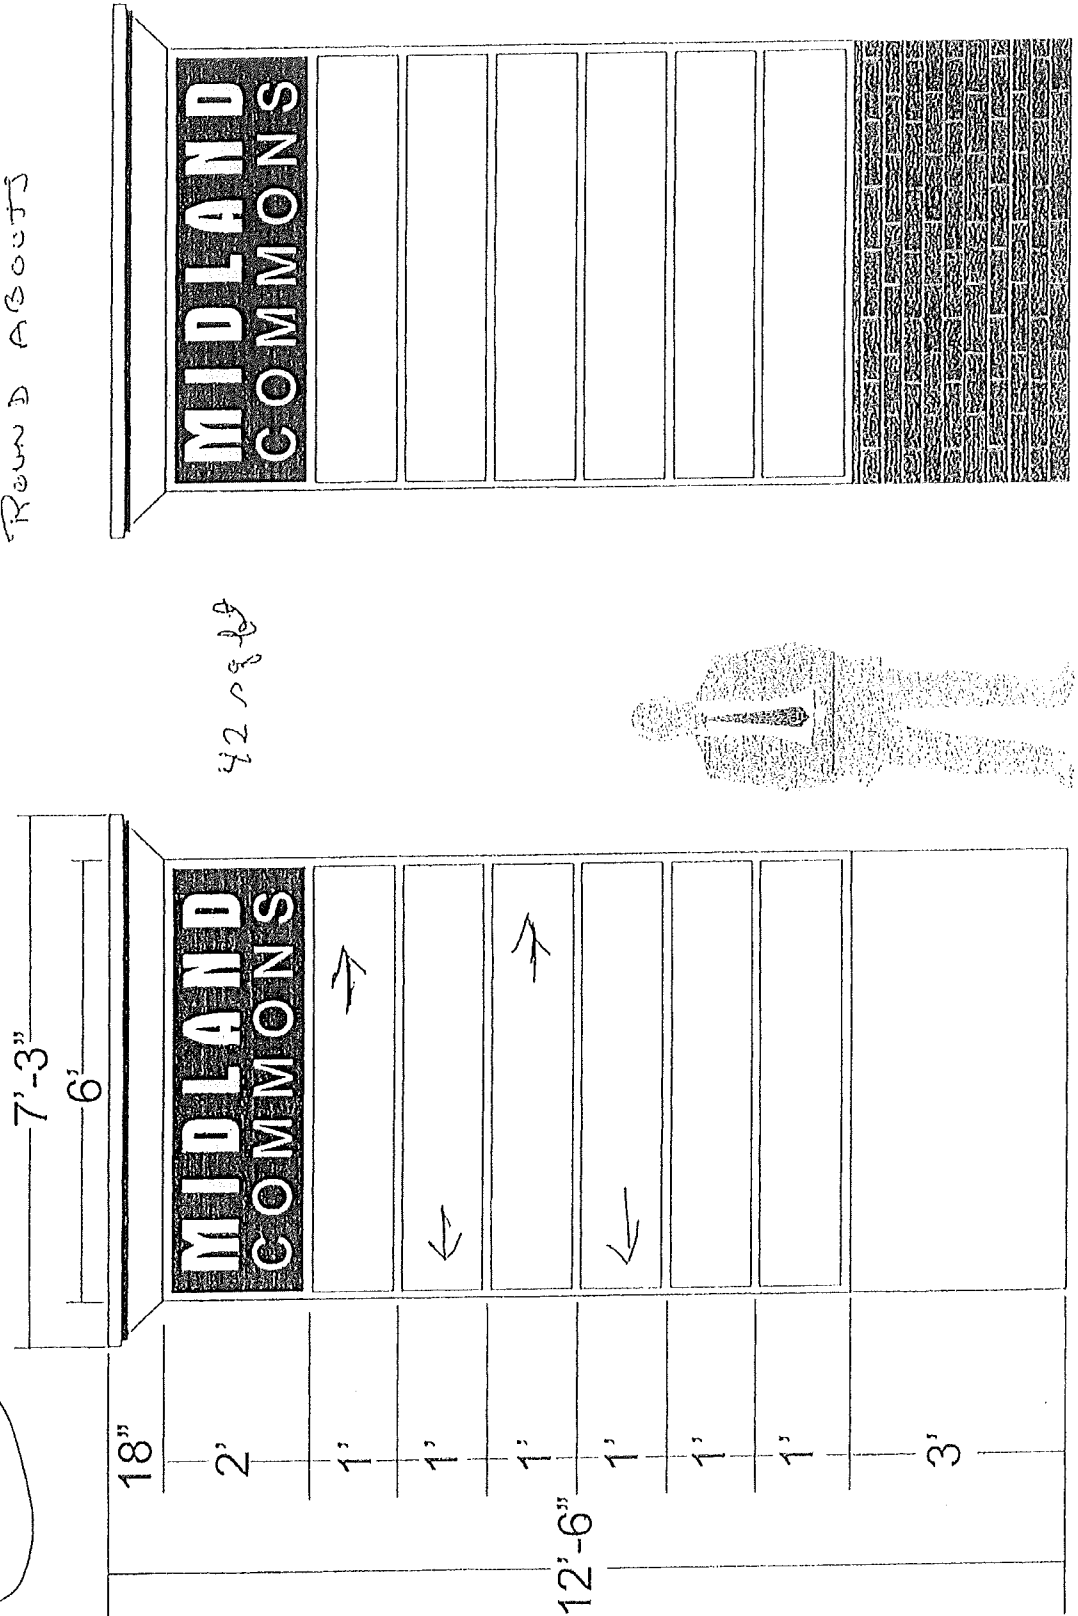

THIS ARTWORK IS PROPERTY OF SIGNS INC AND IS NOT TO BE USED WITHOUT WRITTEN CONSENT OF SAME. UNAUTHORIZED USE WILL BE BILLED A FEE OF \$300.00 BY SIGNS INC.

CUSTOMER APPROVAL
 APPROVED APPROVED AS NOTED
DATE / /
BY:

DATE 5-21-18
DRAWN BY: M. BARFIELD

5100 Coca Cola Blvd.
Columbus, GA 31909
TEL 706-505-9923
FAX 706-502-4747
TOLL FREE 833-324-1424

SIGNS INC
SIGNSINC@AFT
DUE TO PRINTER INK COLORS MAY VARY TO ACTUAL FINISHED COLORS