

1 MAIN LEVEL FLOOR PLAN
 A1.0 SCALE: 1/4"=1'-0"

ESTIMATED LEASE AREA
 10,032 TOTAL SQ. FT.

Essential Service for
 Architects, Builders,
 Retailers, etc...

Precision Architectural
 AS-BUILTS

Phone: (303) 625-9900
 Fax: (616) 307-5663
 Email: support@precisionasbuilts.com
 1801 N. Broadway Suite #1750
 Denver, CO 80202


65 SHERMAN STREET
DEADWOOD, SD 57732

KR DEADWOOD
 SHERMAN STREET 2020, LLC


ISSUE DATE:
05/09/24

PROJECT NO 24107
 DRAWN BY CWB
 REVISED BY CWB

MAIN LEVEL FLOOR PLAN
A1.0

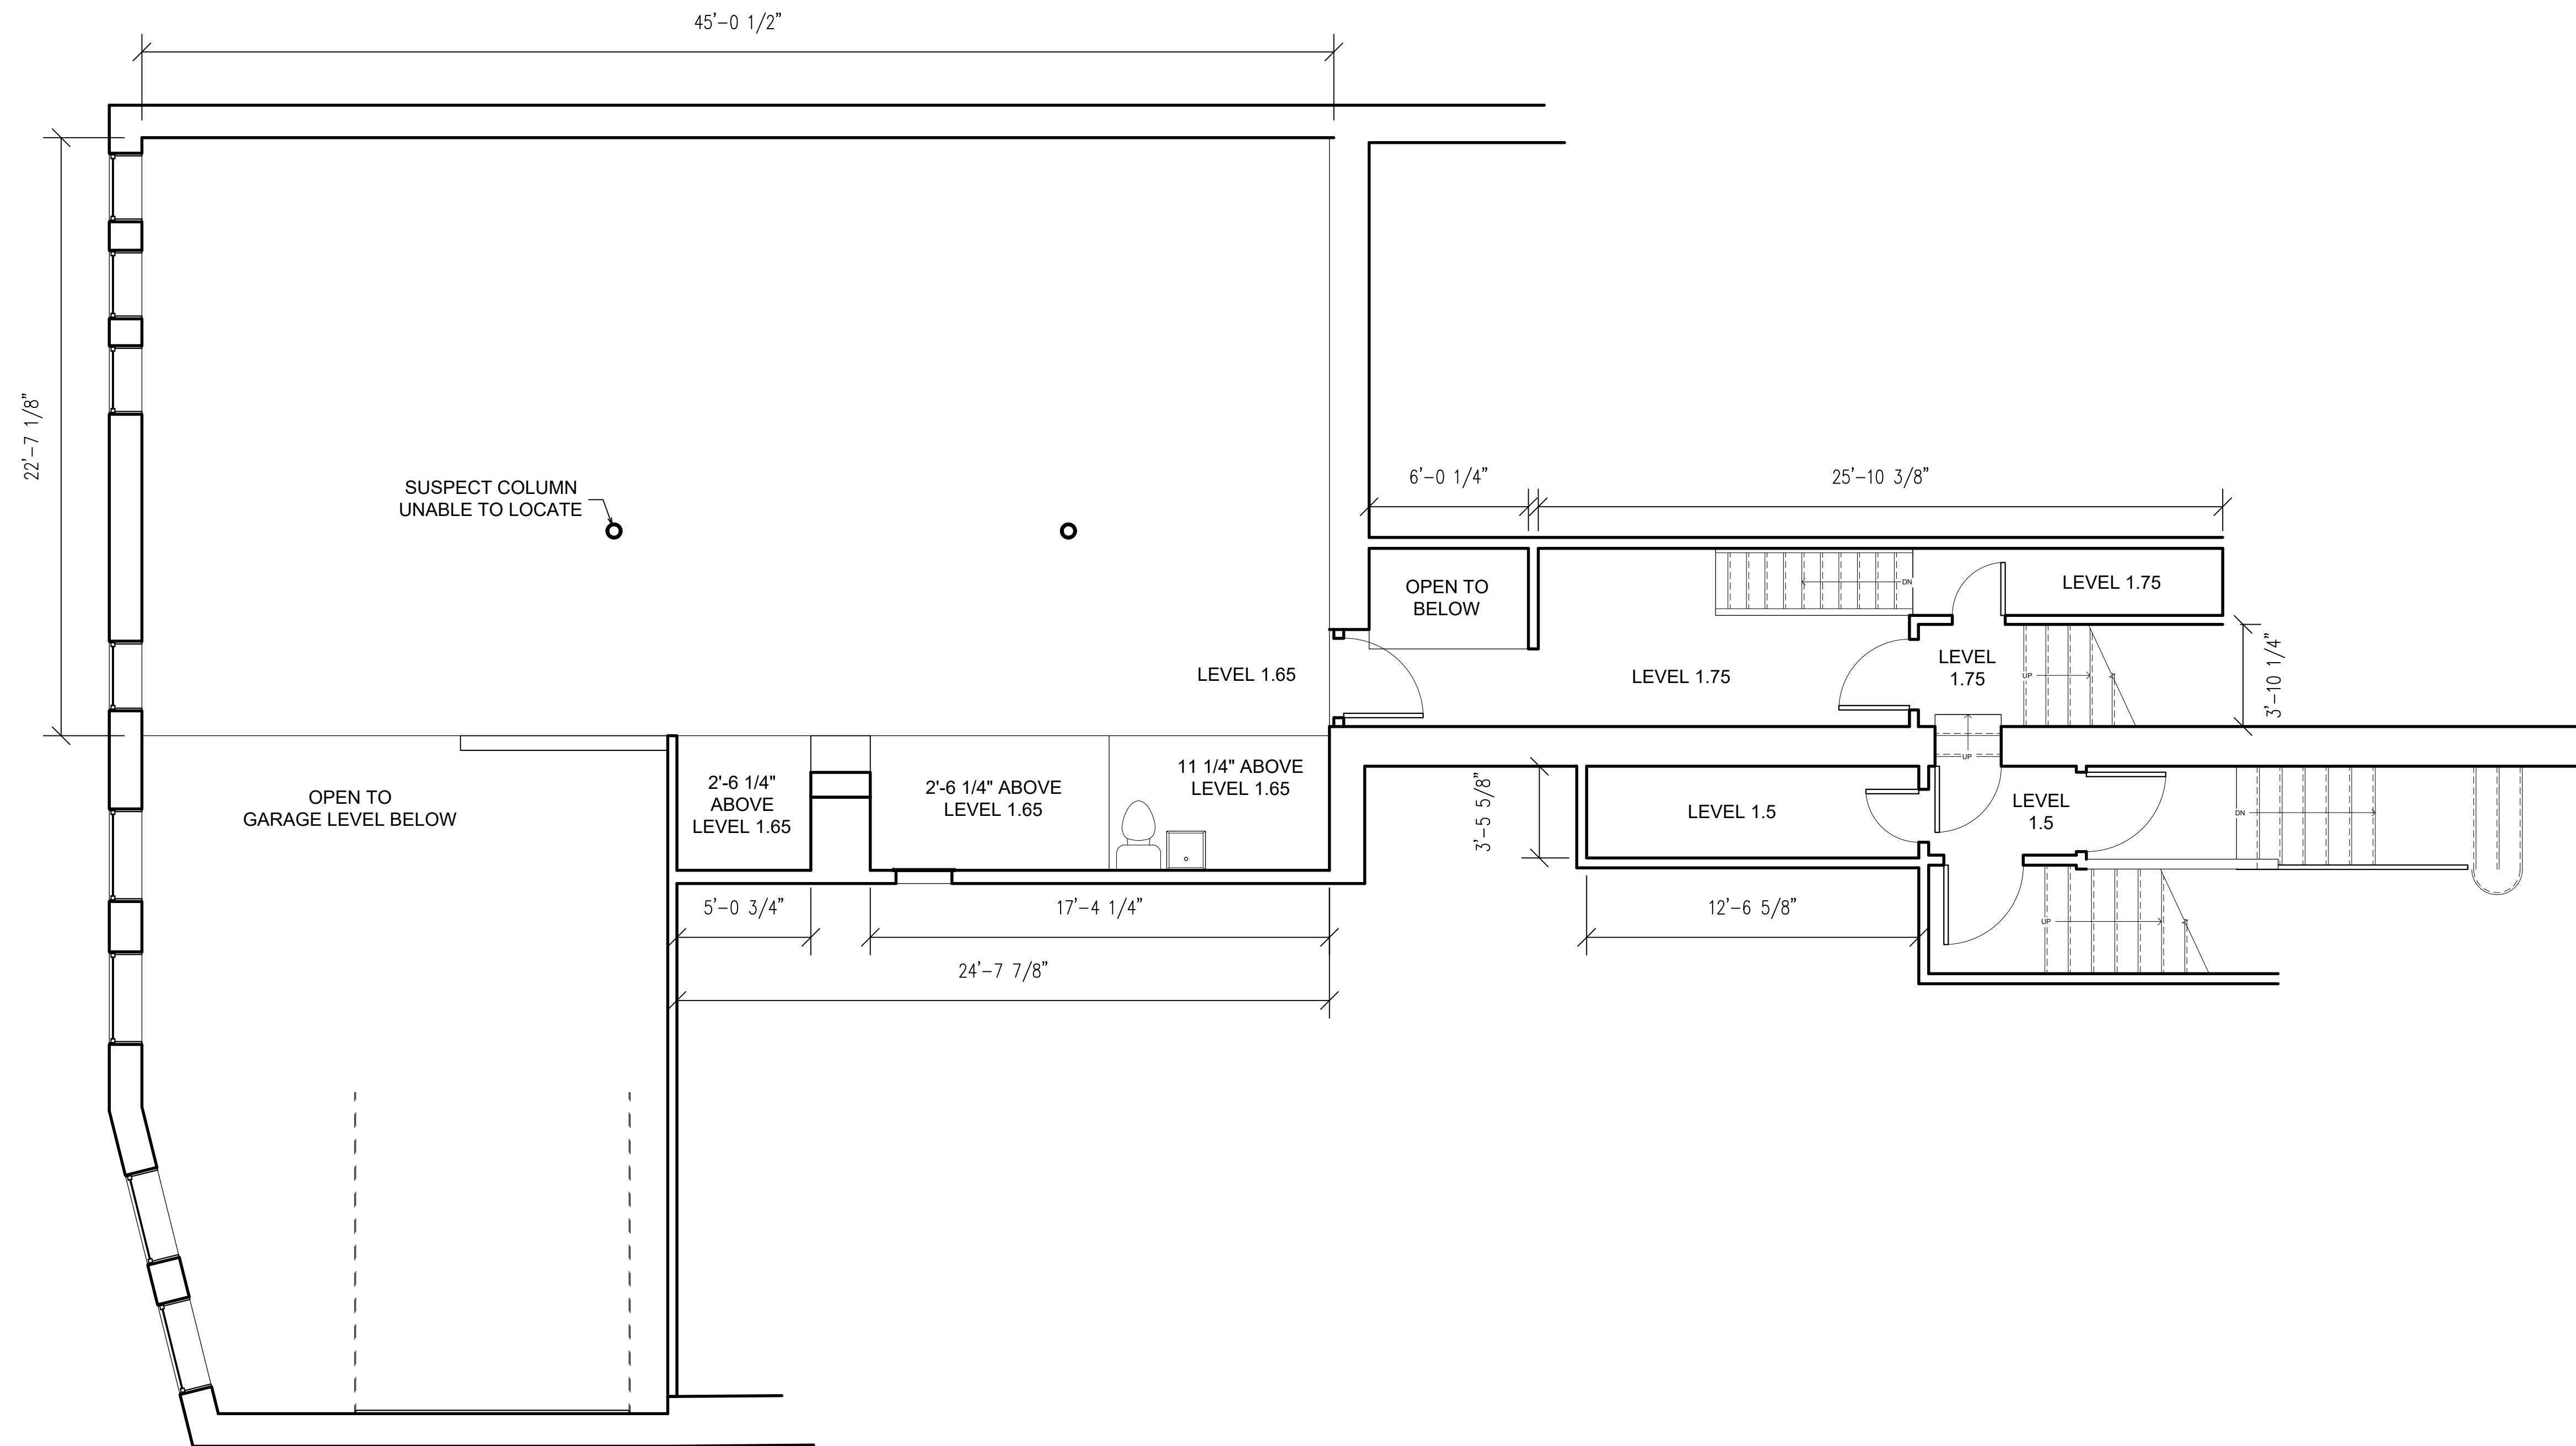

1 LEVELS 1.5, 1.65, 1.75
 A1.1 SCALE: 1/4"=1'-0"

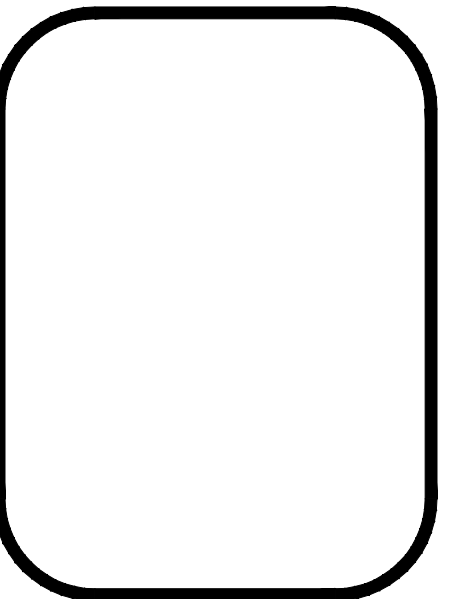


Essential Service for
 Architects, Builders,
 Retailers, etc...
Precision Architectural
 AS-BUILTS
 Phone: (303) 625-9900
 Fax: (616) 307-5663
 Email: support@precisionasbuilds.com
 1801 N. Broadway Suite #1750
 Denver, CO 80202

**65 SHERMAN STREET
 DEADWOOD, SD 57732**


KR DEADWOOD
 SHERMAN STREET 2020, LLC

**ISSUE DATE:
 05/09/24**


PROJECT NO 24107
 DRAWN BY CWB
 REVISED BY CWB
**LEVELS 1.5
 1.65 + 1.75
 FLOOR PLANS**
A1.1

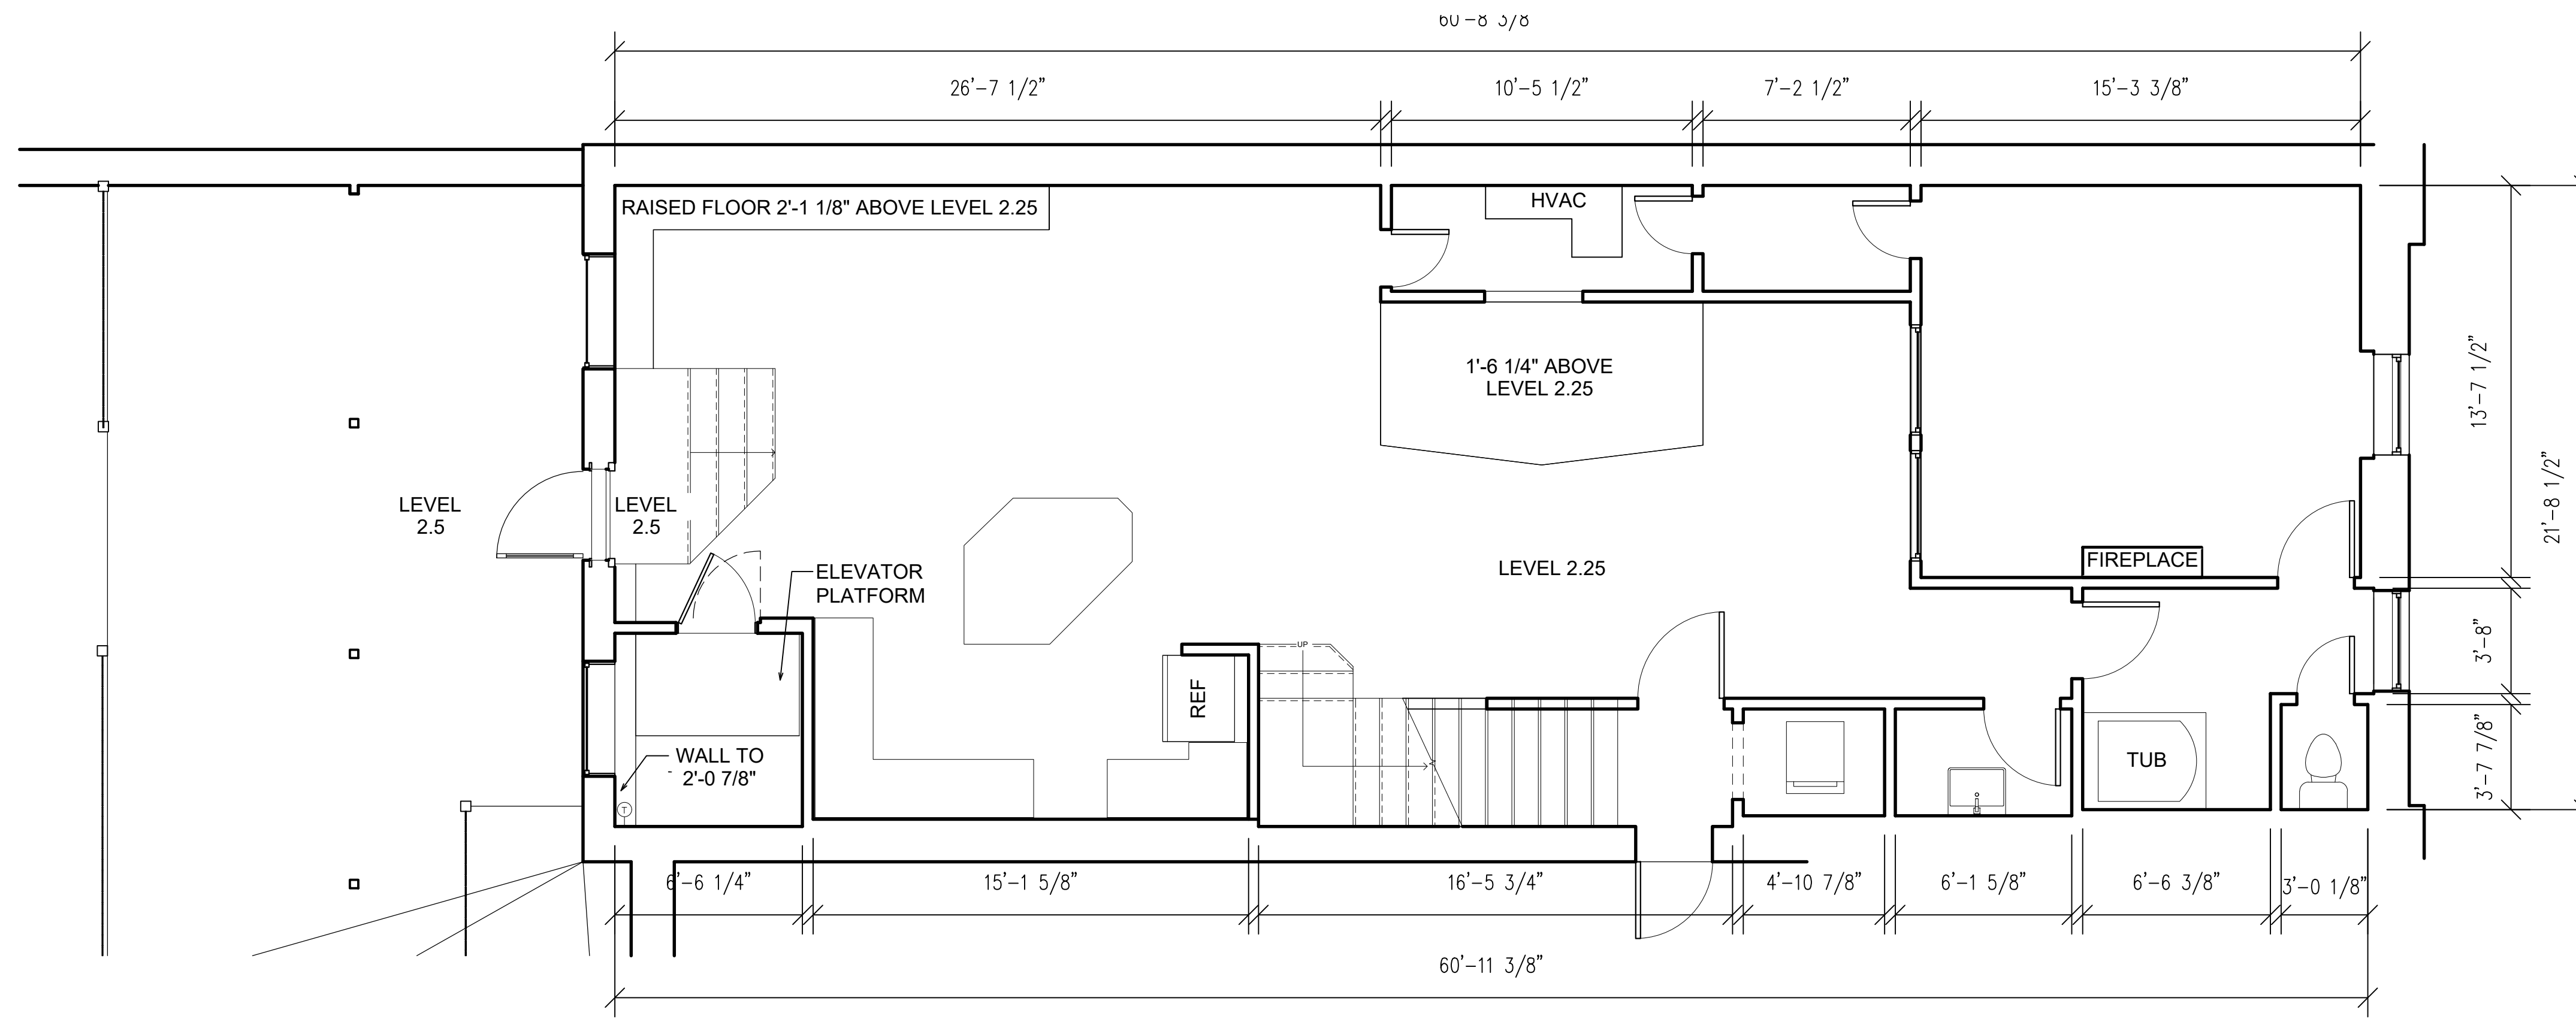

1 LEVEL 2.25
 A1.2 SCALE: 1/4"=1'-0"

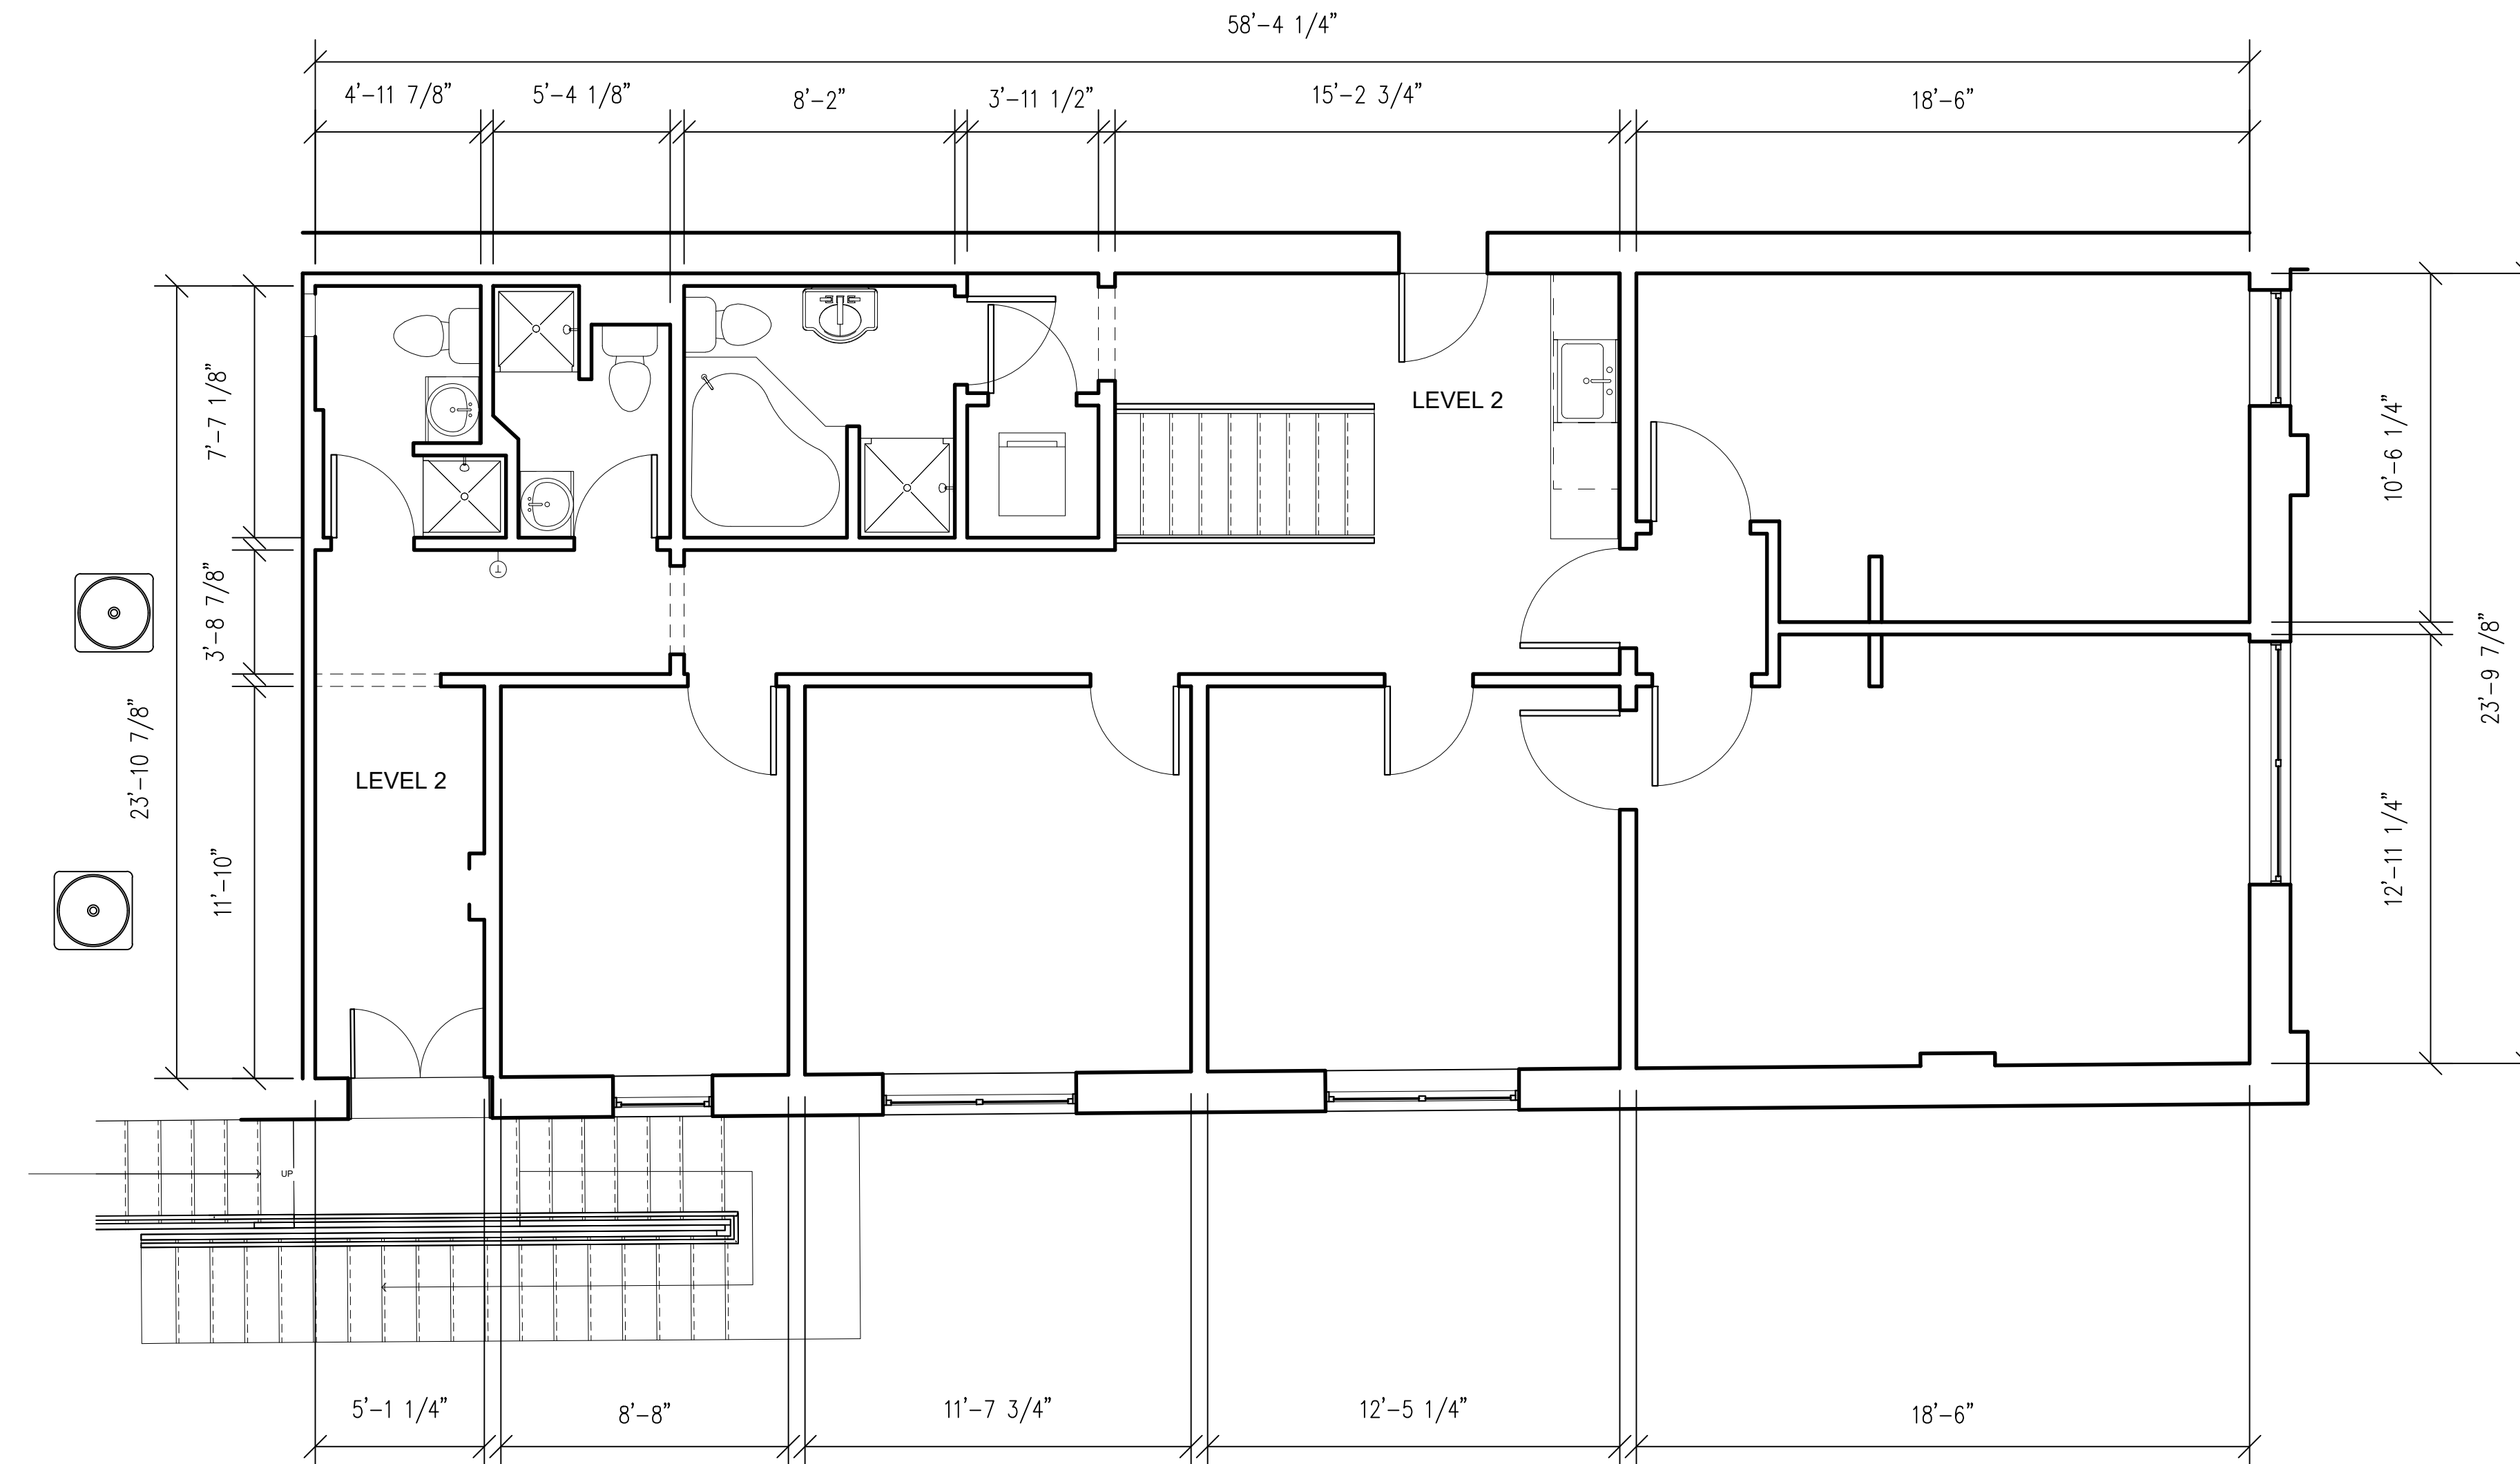

2 LEVEL 2
 A1.2 SCALE: 1/4"=1'-0"

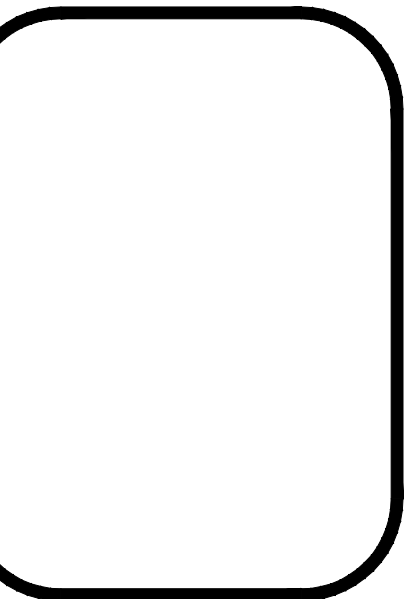

Essential Service for
 Architects, Builders,
 Realtors, etc...
Precision Architectural
 AS-Built
 Phone: (303) 625-9900
 Fax: (616) 307-5663
 Email: support@precisionasbuilt.com
 1801 N. Broadway Suite #1750
 Denver, CO 80202


65 SHERMAN STREET
DEADWOOD, SD 57732

KR DEADWOOD
 SHERMAN STREET 2020, LLC


ISSUE DATE:
 05/09/24

PROJECT NO 24107
 DRAWN BY CWB
 REVISED BY CWB
 LEVEL 2 + 2.25
 FLOOR PLANS

A1.2

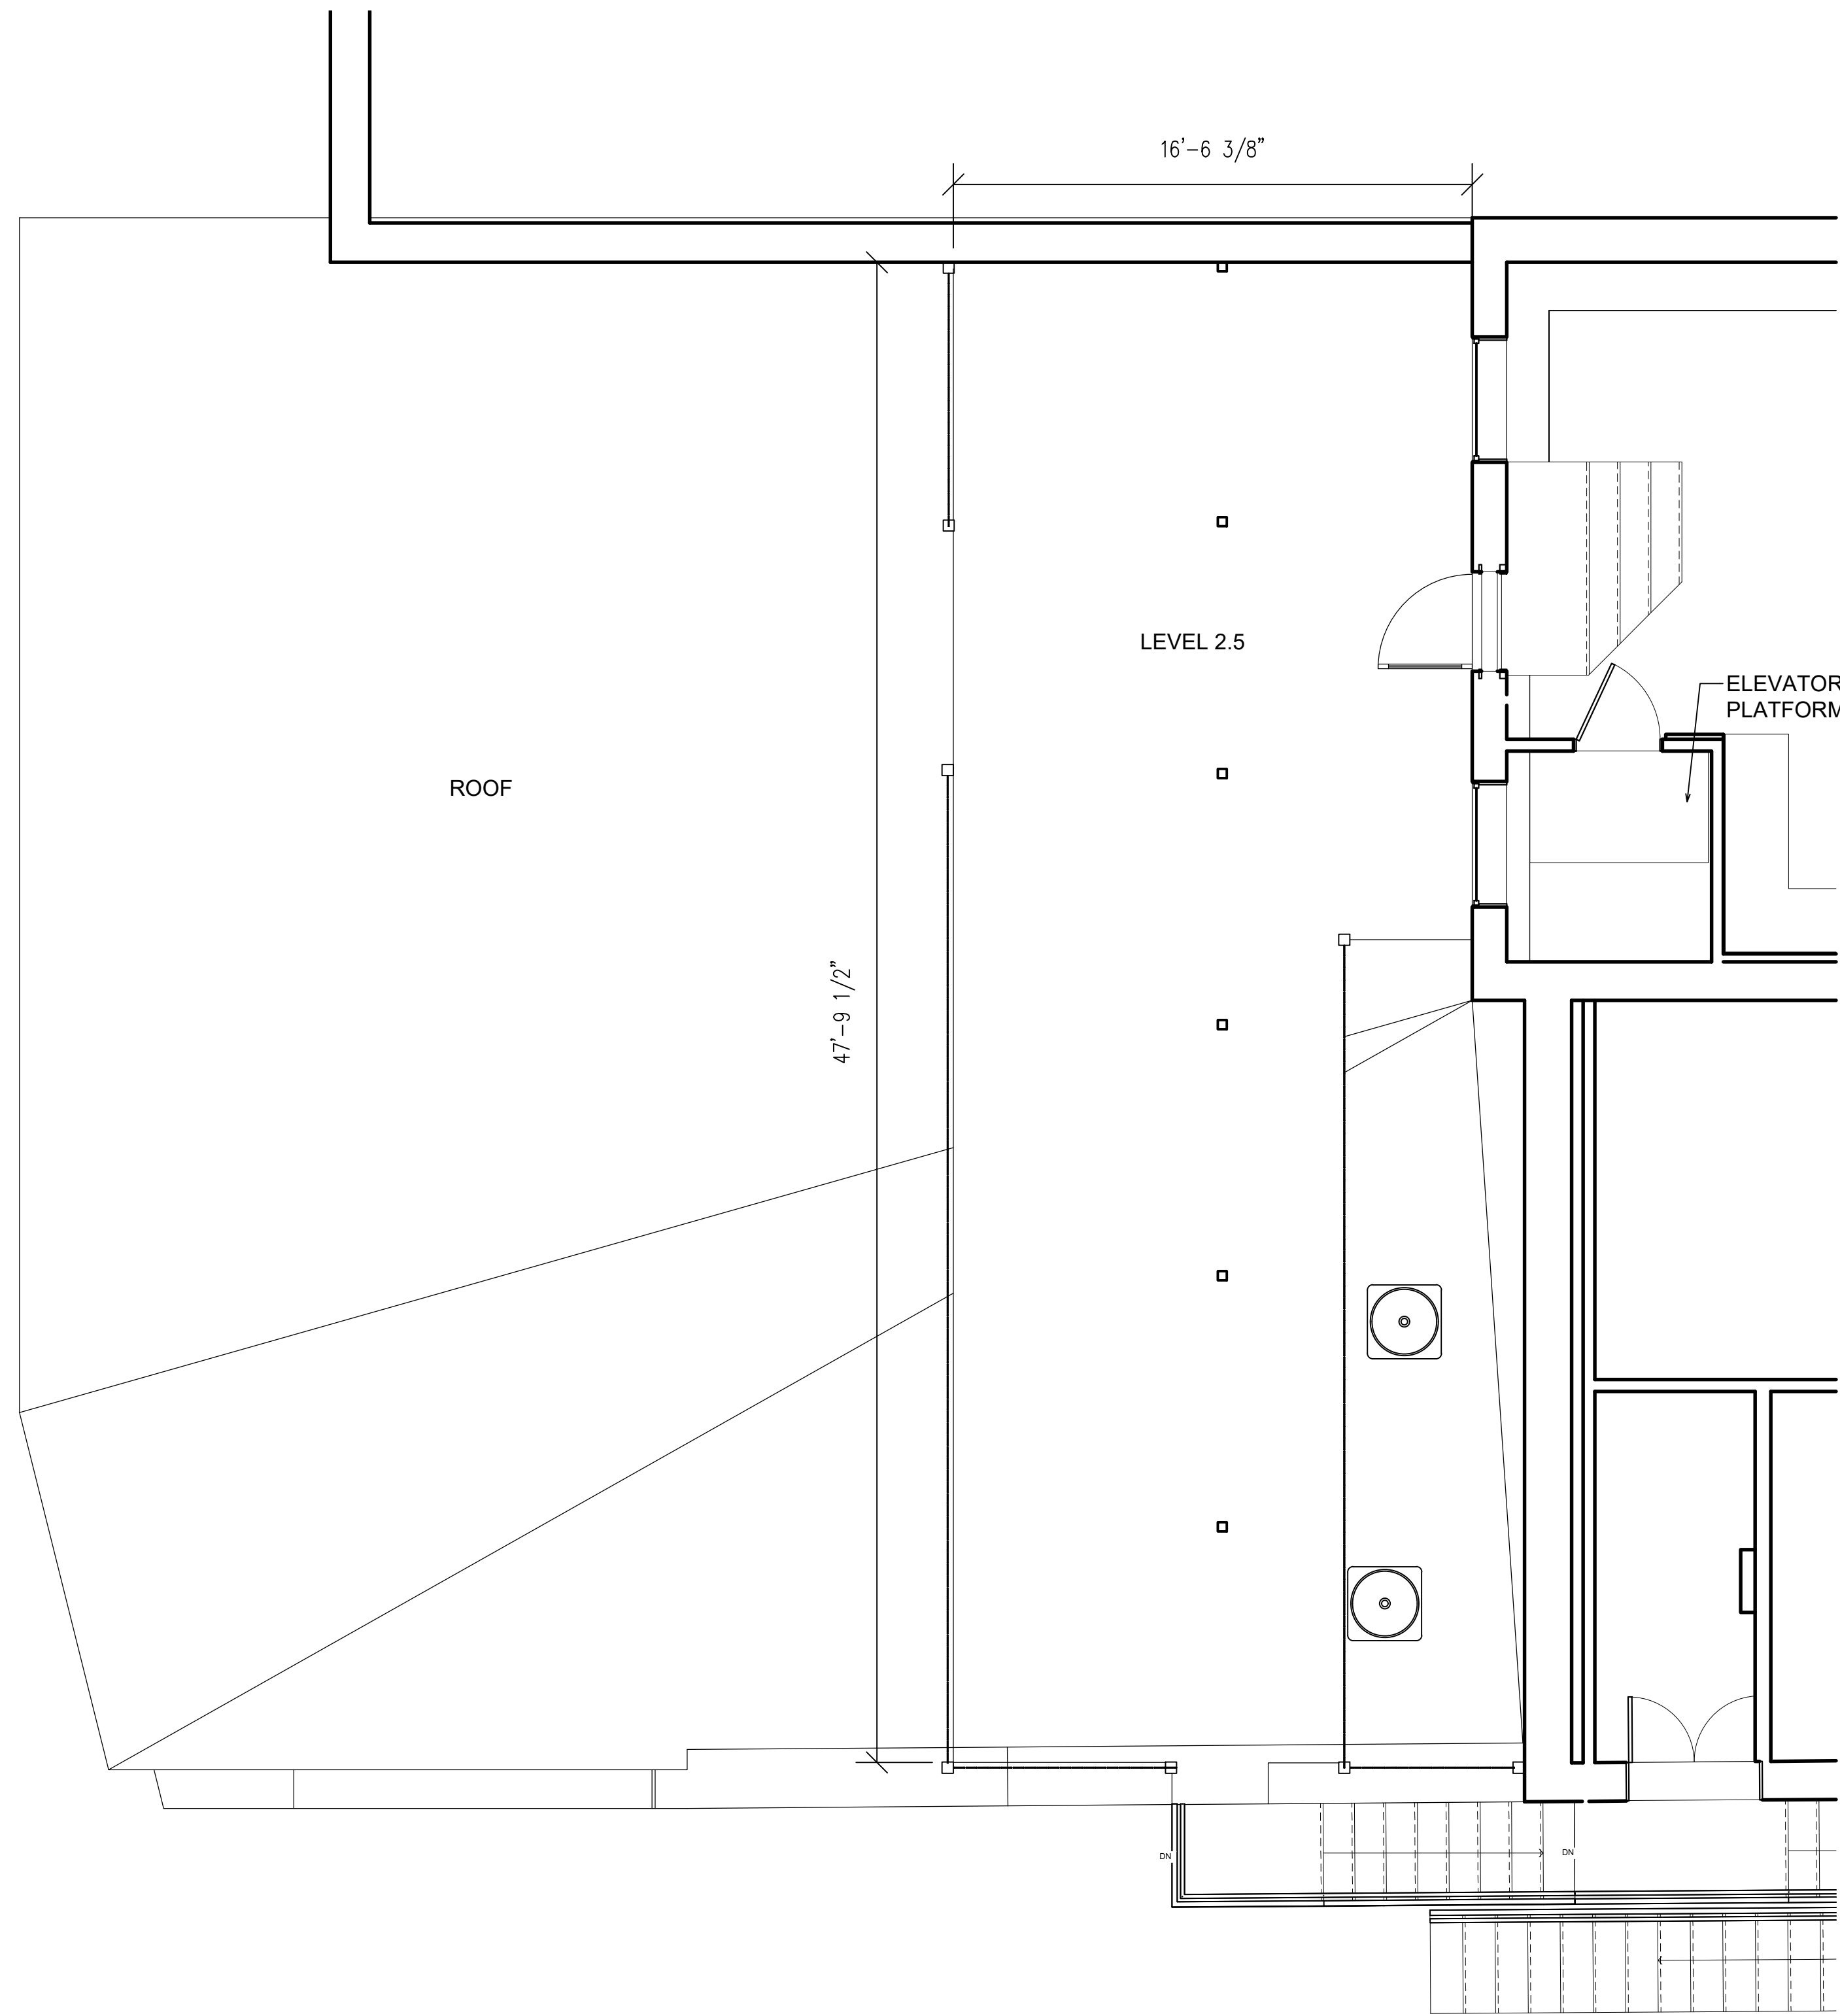

1 LEVEL 2.5
A1.3 SCALE: 1/4"=1'-0"

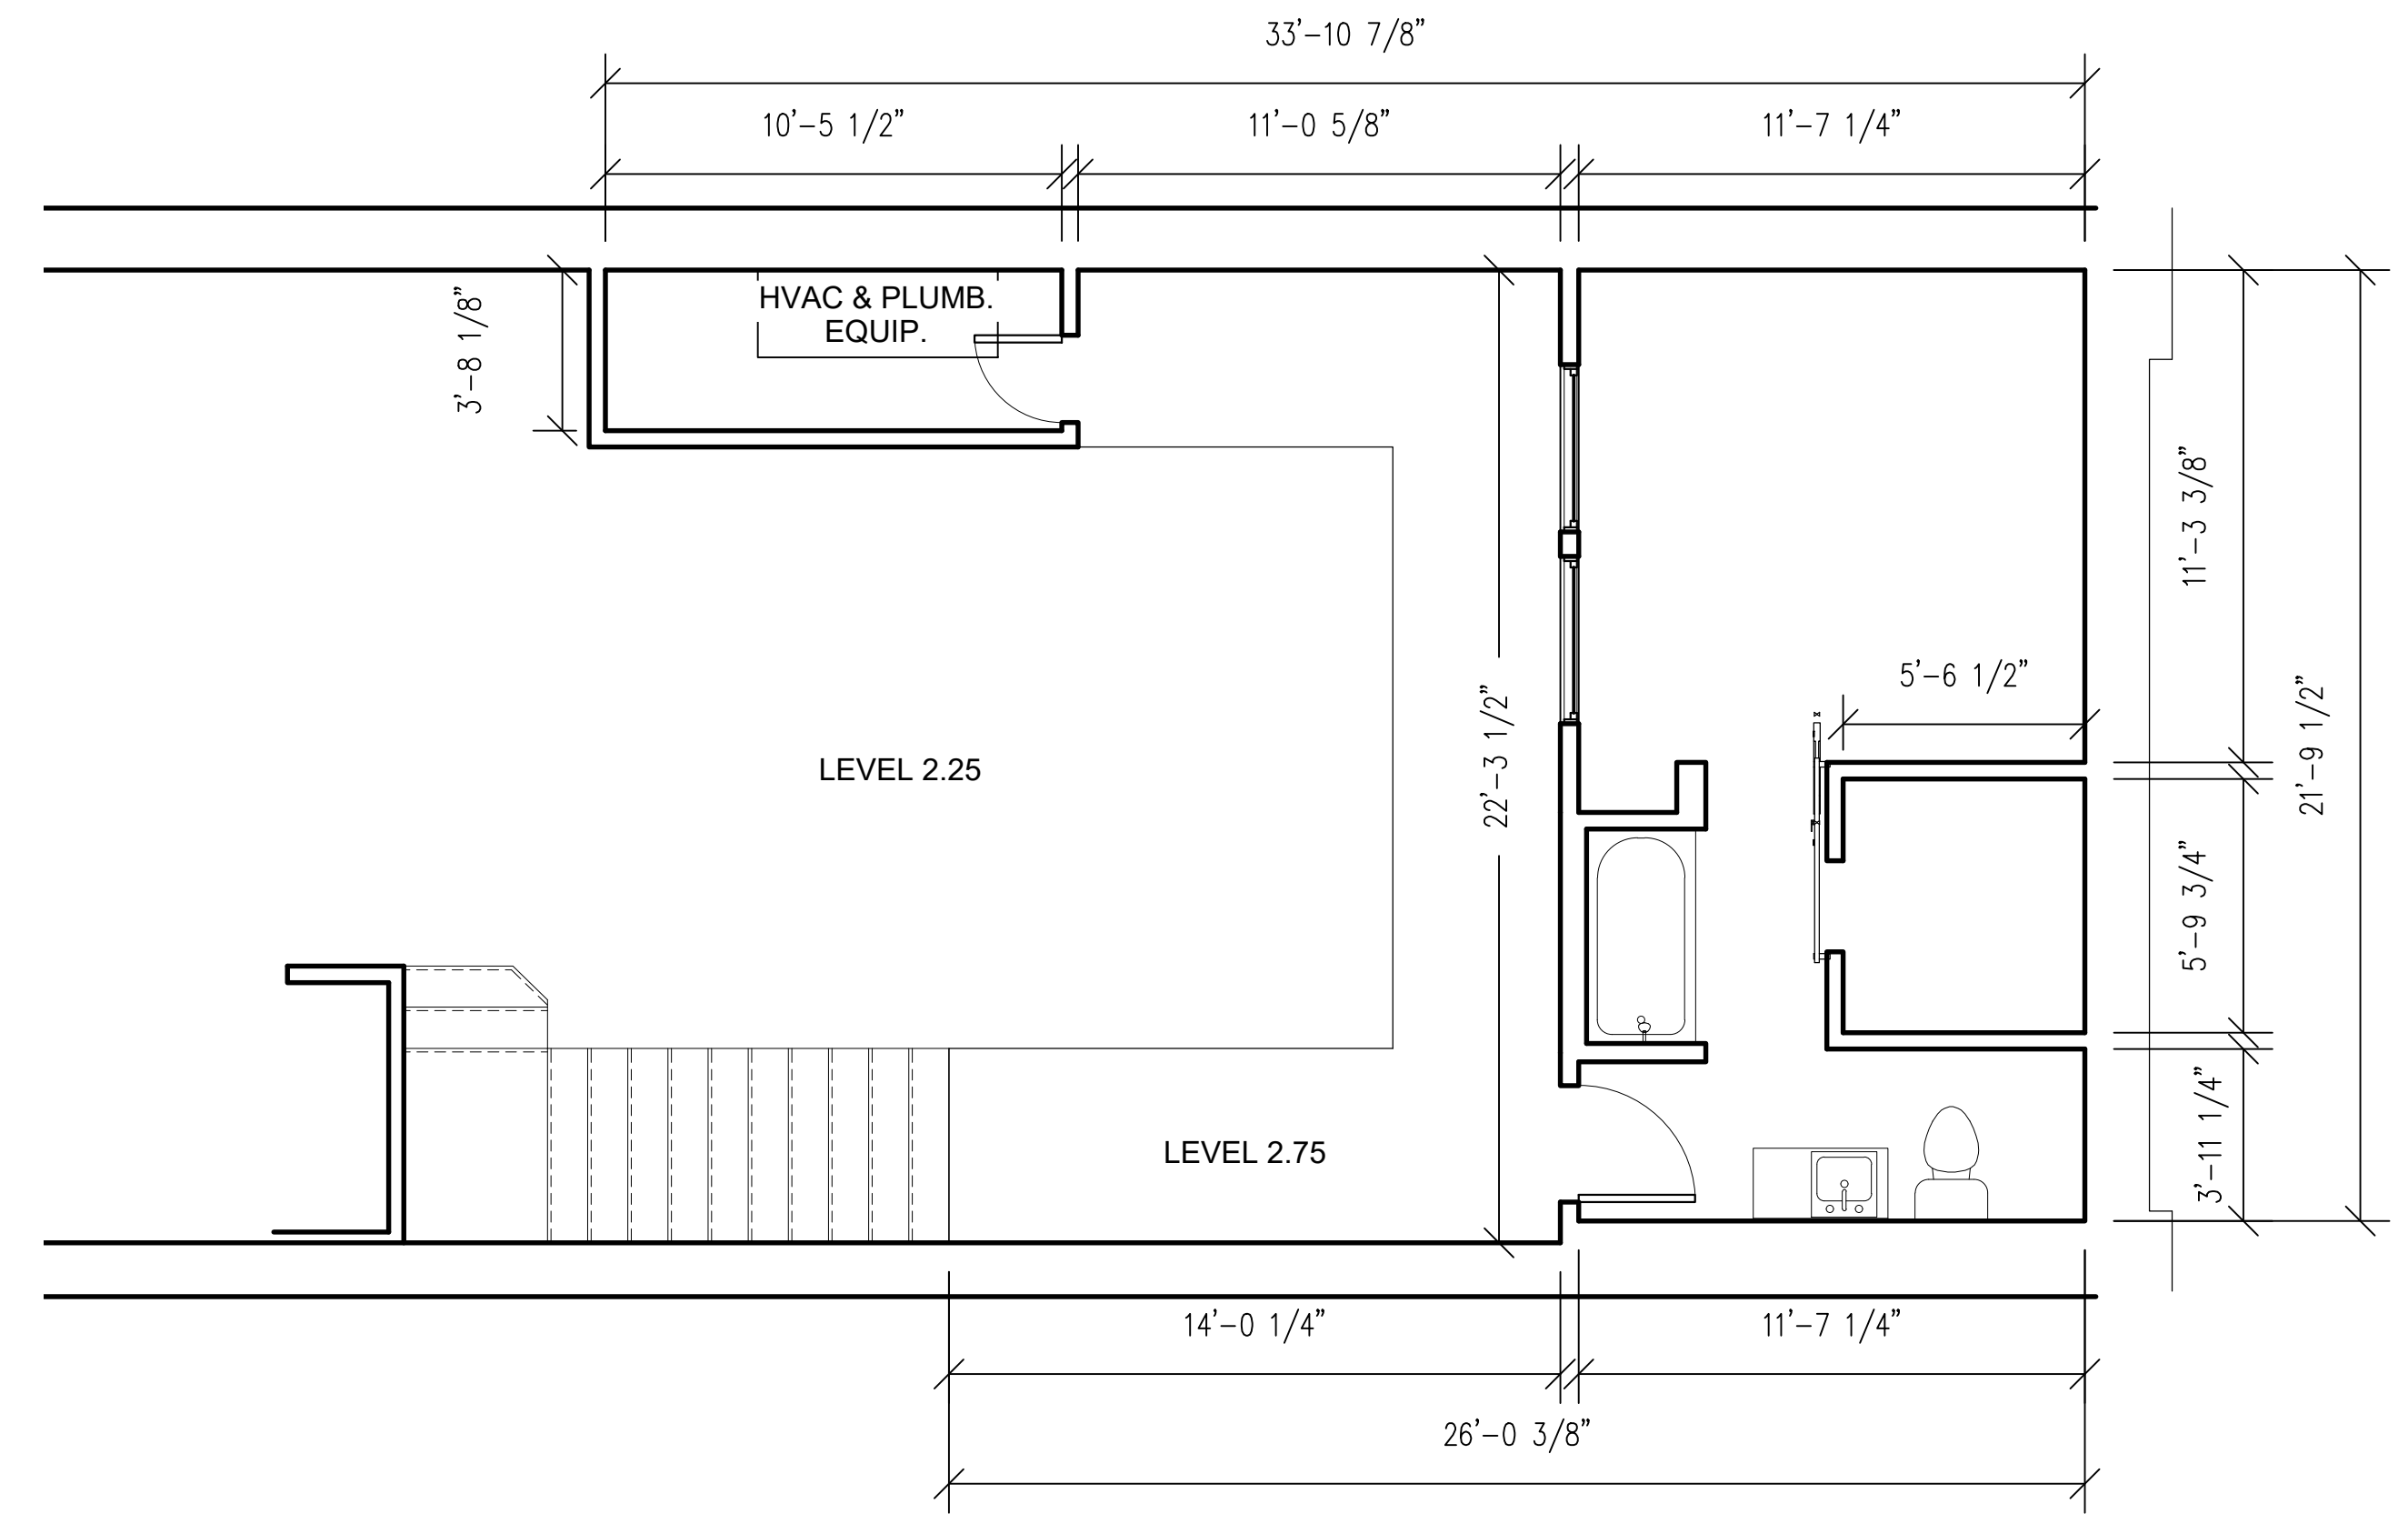

1 LEVEL 2.75
A1.3 SCALE: 1/4"=1'-0"

Essential Service for
Architects, Builders,
Retailers, etc...
Precision Architectural
AS-BUILTS
Phone: (303) 625-9900
Fax: (616) 307-5663
Email: support@precisionasbuilds.com
1801 N. Broadway Suite #1750
Denver, CO 80202

**65 SHERMAN STREET
DEADWOOD, SD 57732**


KR DEADWOOD
SHERMAN STREET 2020, LLC

**ISSUE DATE:
05/09/24**


PROJECT NO 24107
DRAWN BY CWB
REVISED BY CWB

**LEVEL 2.5 + 2.75
FLOOR PLANS**

A1.3

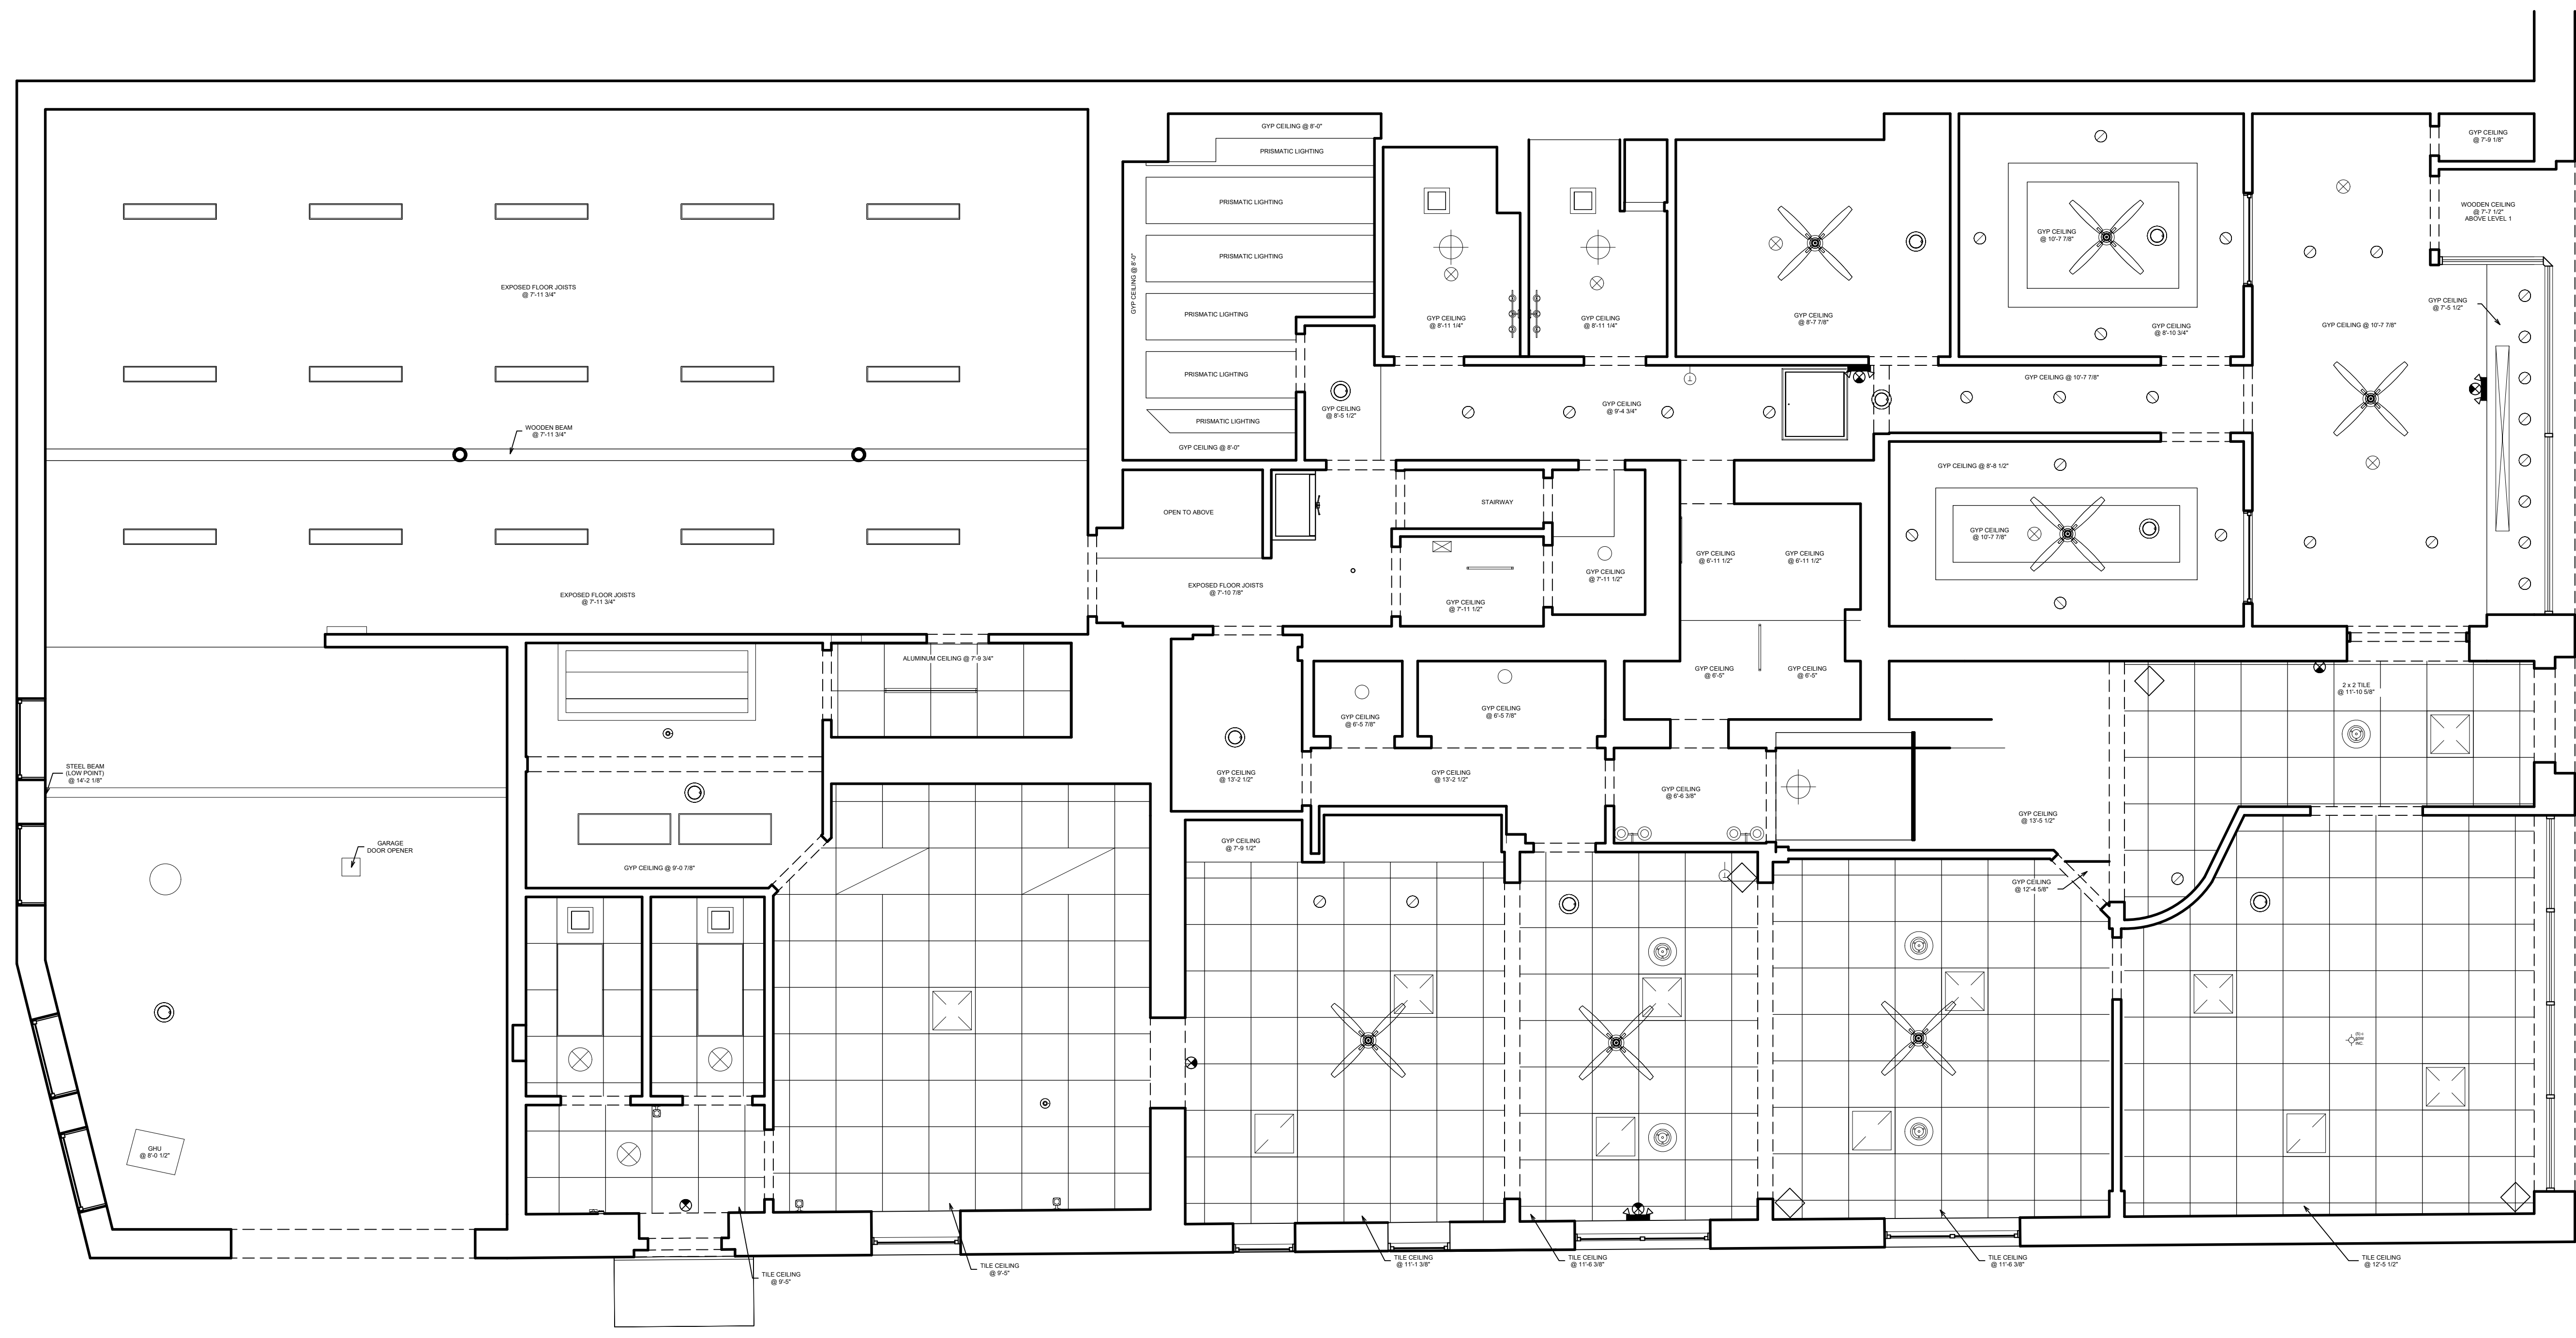

1 REFLECTED CEILING PLAN MAIN LEVEL
 A2.0 SCALE: 1/4"=1'-0"

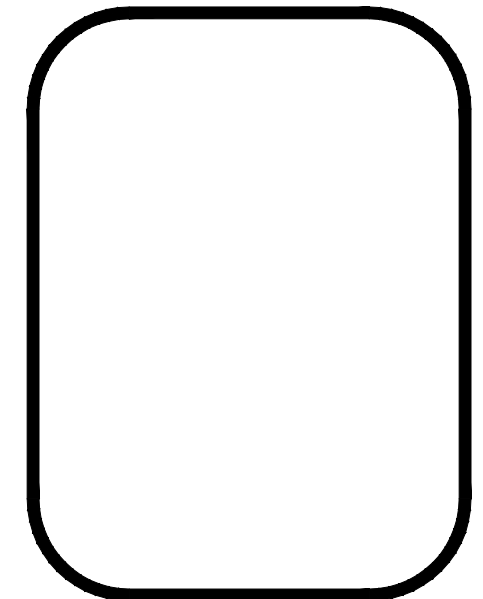


Essential Service for
 Architects, Builders,
 Retailers, etc...
Precision Architectural
 AS-Built
 Phone: (303) 625-9900
 Fax: (616) 307-5663
 Email: support@precisionbuilt.com
 1801 N. Broadway Suite #1750
 Denver, CO 80202

65 SHERMAN STREET
 DEADWOOD, SD 57732

KR DEADWOOD
 SHERMAN STREET 2020, LLC

ISSUE DATE:
 05/09/24

PROJECT NO 24107
 DRAWN BY CWB
 REVISED BY CWB
 MAIN LEVEL
 CEILING PLAN
 A2.0

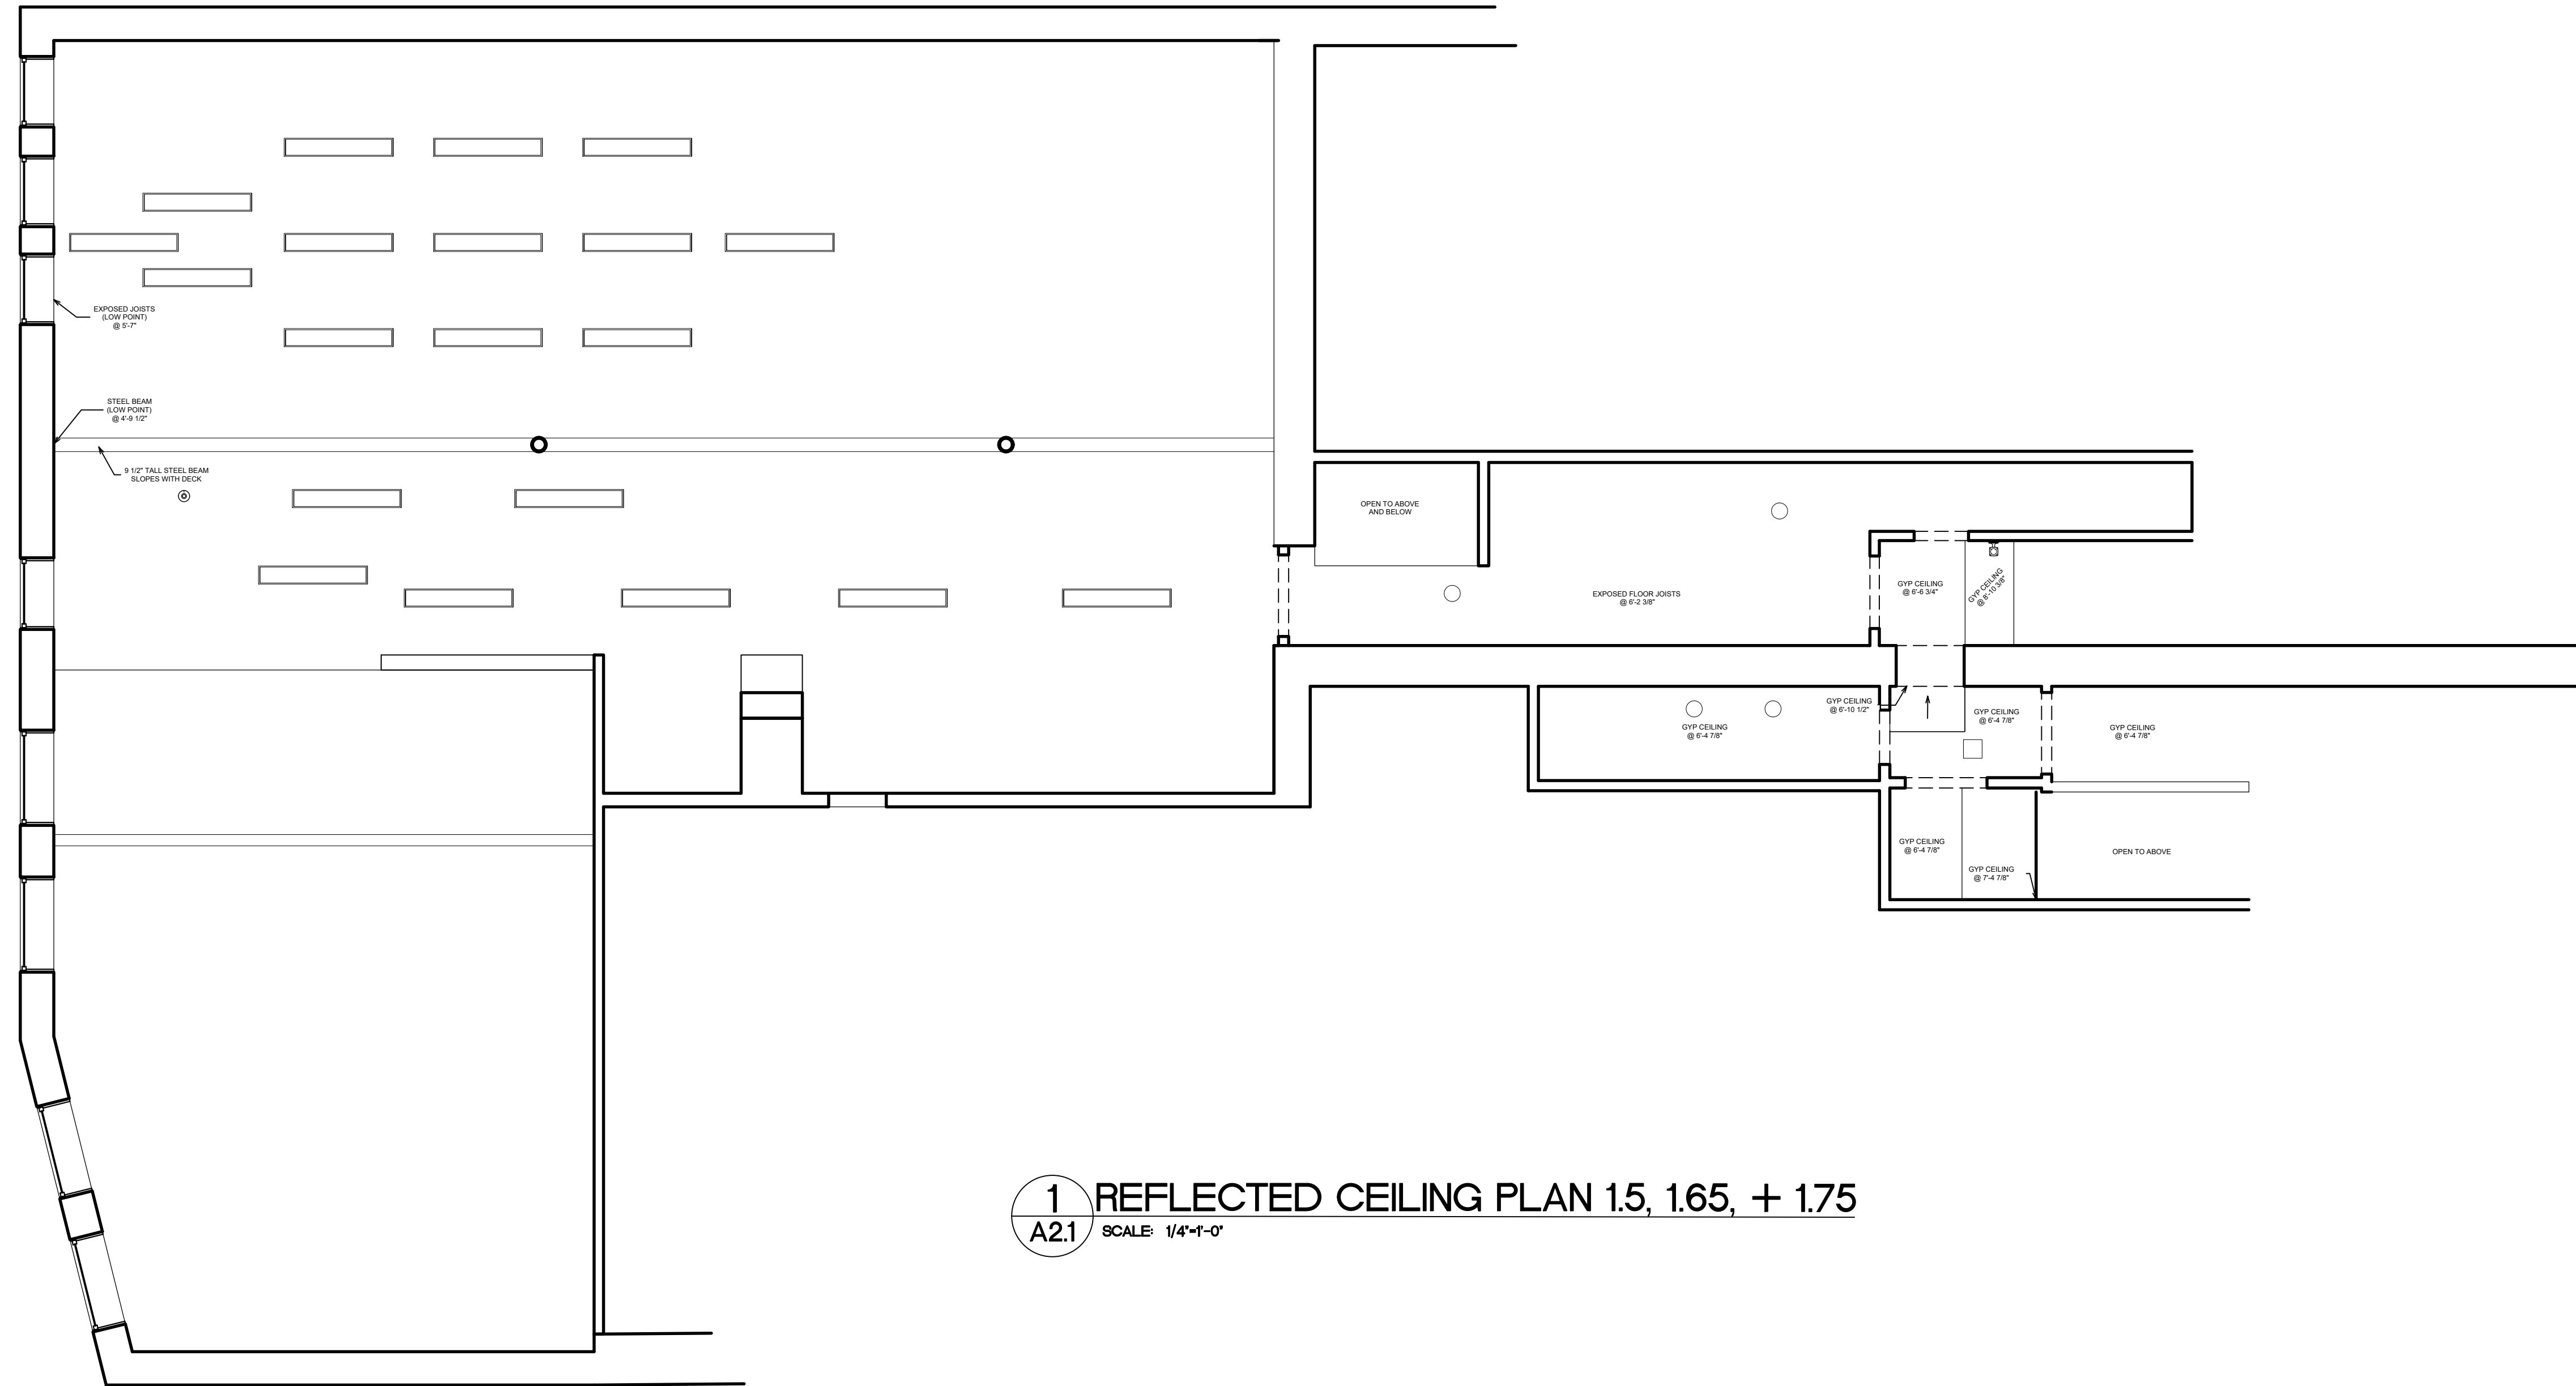

1 REFLECTED CEILING PLAN 15, 165, + 175
 A2.1 SCALE: 1/4"=1'-0"


Essential Service for
 Architects, Builders,
 Retailers, etc...
Precision Architectural
 AS-BUILTS
 Phone: (303) 625-9900 1801 N. Broadway Suite #1750
 Fax: (616) 307-5663 Denver, CO 80202
 Email: support@precisionasbuilts.com

65 SHERMAN STREET
 DEADWOOD, SD 57732


KR DEADWOOD
 SHERMAN STREET 2020, LLC

ISSUE DATE:
 05/09/24


PROJECT NO 24107
 DRAWN BY CWB
 REVISED BY CWB
 LEVEL 15,
 165 + 175
 CEILING PLANS
 A2.1

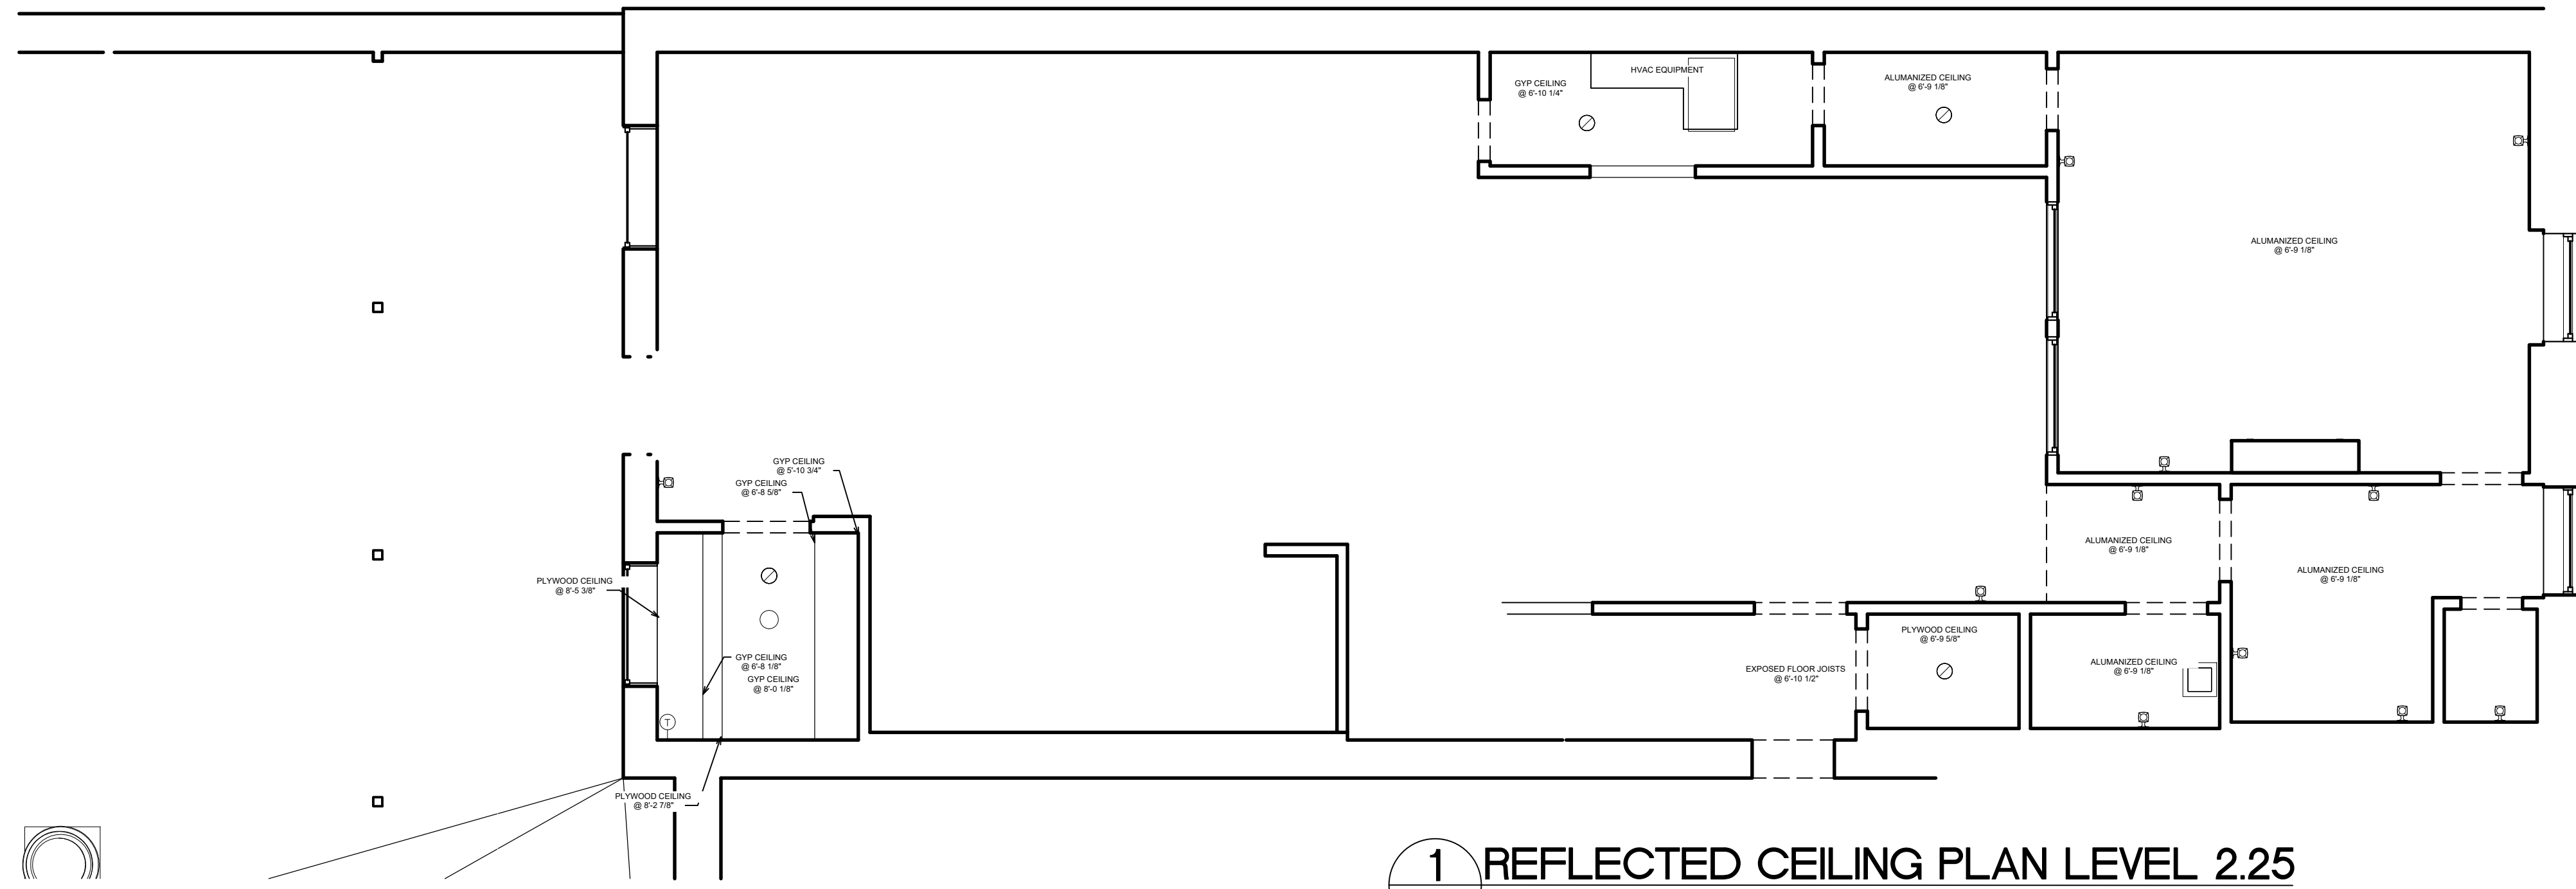

1 REFLECTED CEILING PLAN LEVEL 2.25
 A2.2 SCALE: 1/4"=1'-0"

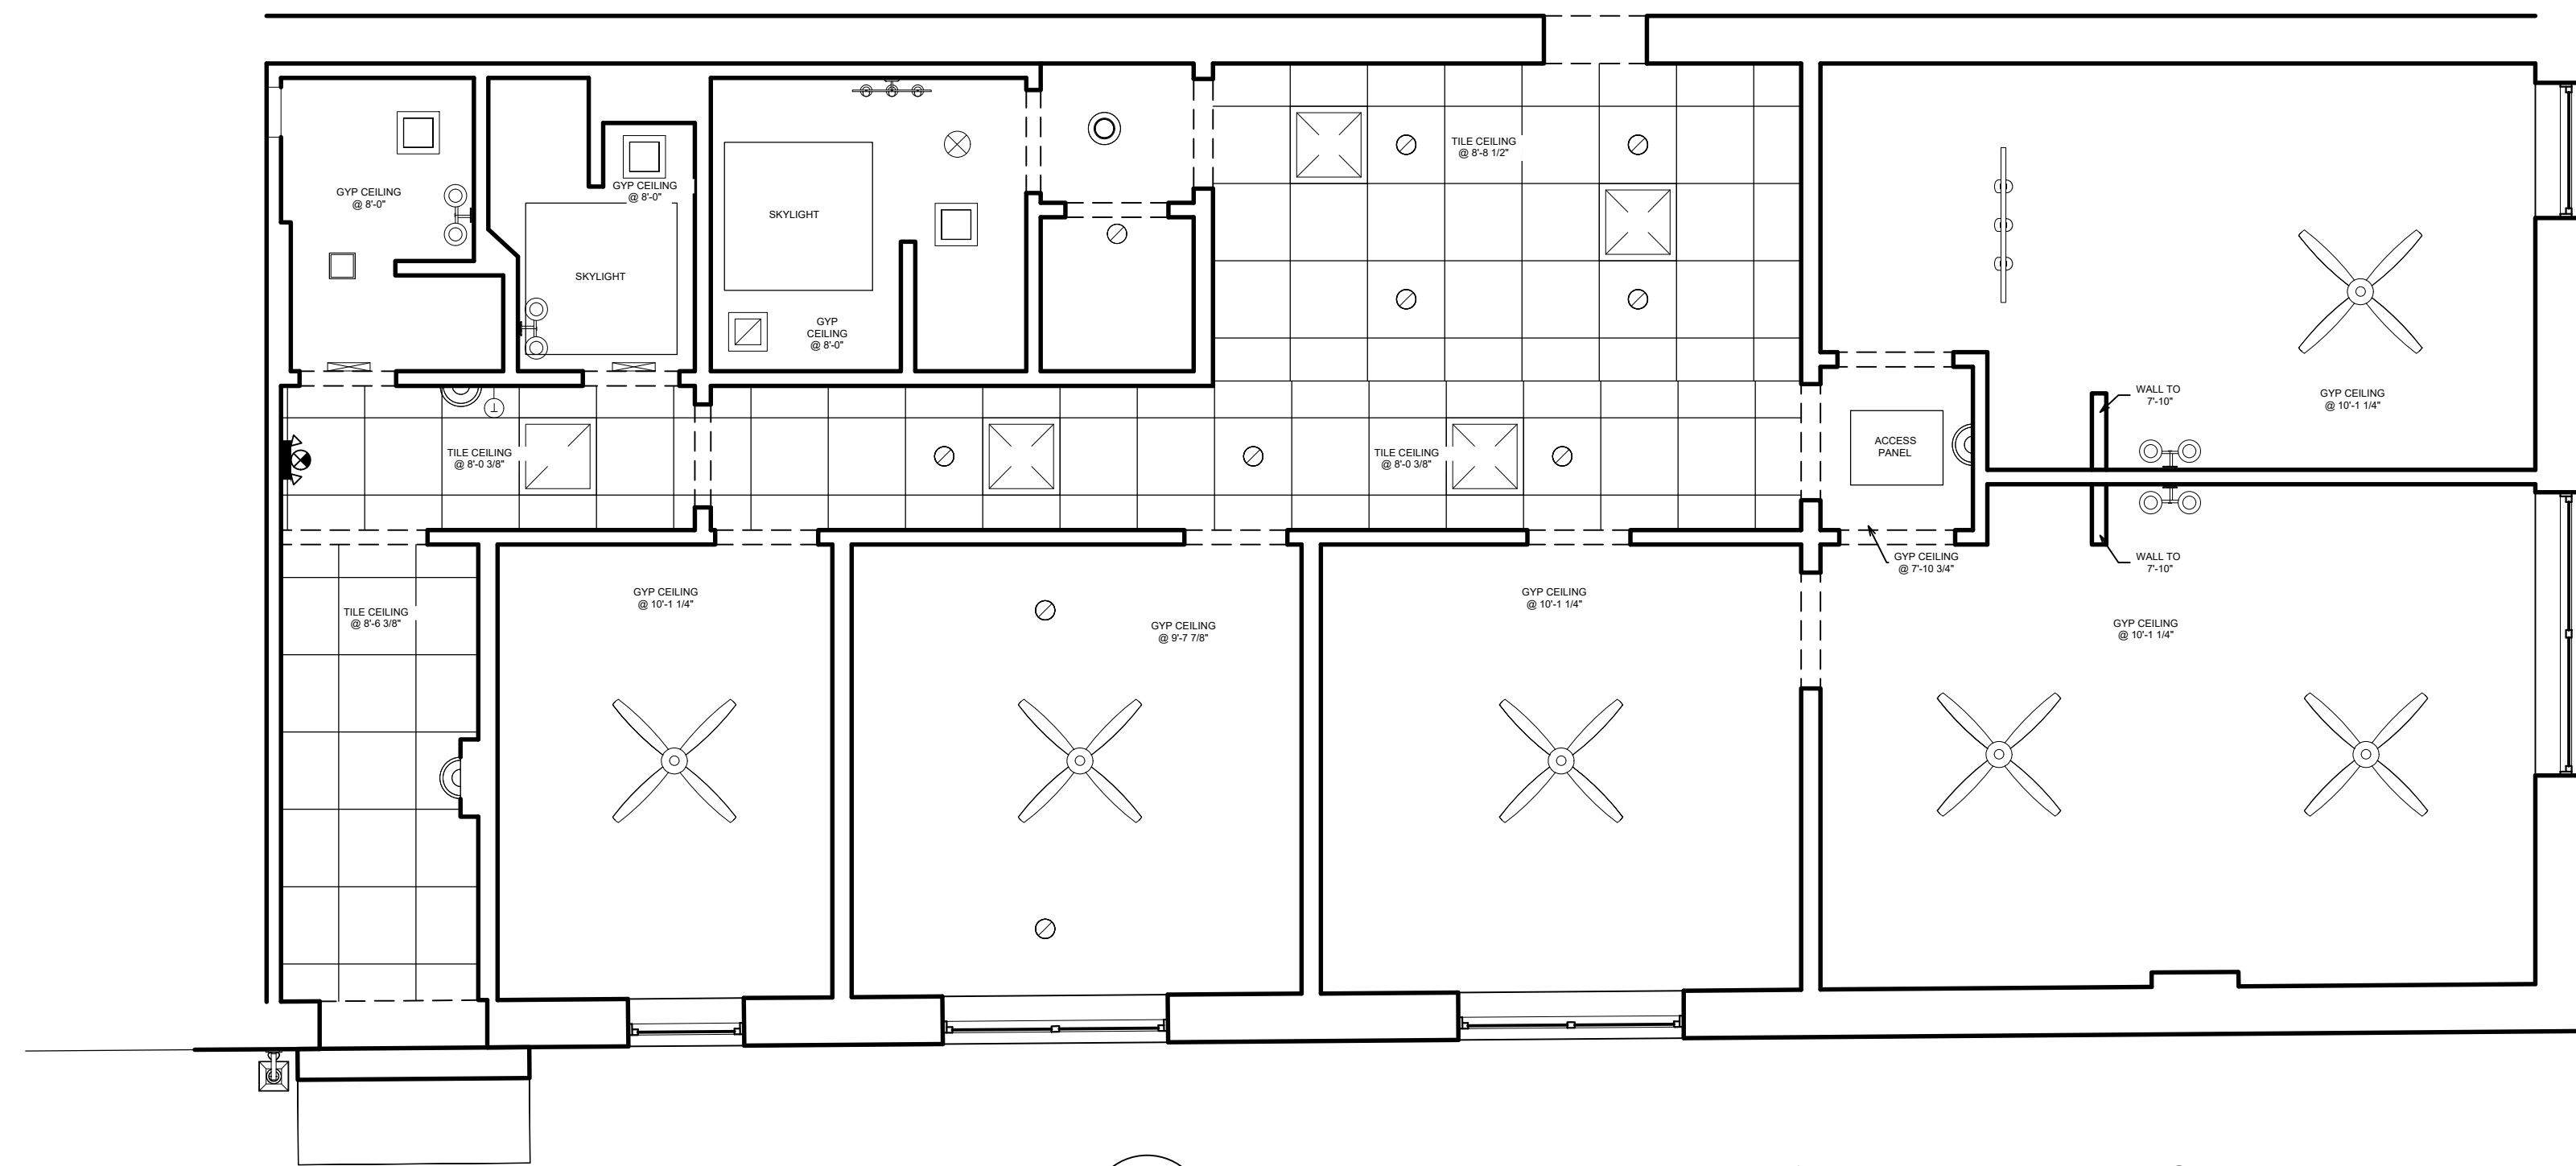

2 REFLECTED CEILING PLAN LEVEL 2.0
 A2.2 SCALE: 1/4"=1'-0"

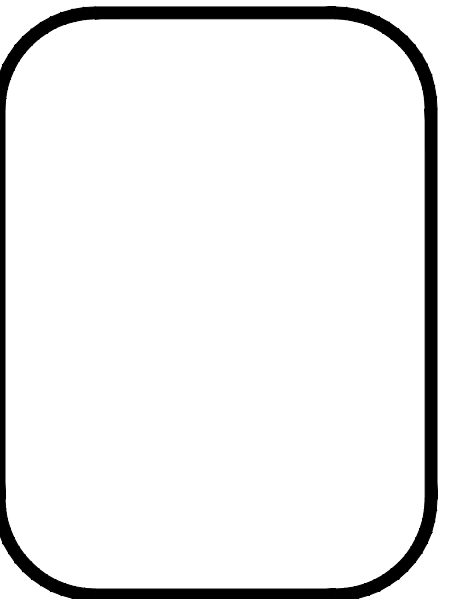

Essential Service for
 Architects, Builders,
 Retailers, etc...

Precision Architectural
 AS-BUILTS

Phone: (303) 625-9900
 Fax: (616) 307-5663
 Email: support@precisionasbuilds.com

1801 N. Broadway Suite #1750
 Denver, CO 80202

65 SHERMAN STREET
DEADWOOD, SD 57732


KR DEADWOOD
 SHERMAN STREET 2020, LLC

ISSUE DATE:
05/09/24


PROJECT NO 24107
 DRAWN BY CWB
 REVISED BY CWB

LEVEL 20 + 2.25
CEILING PLANS

A2.2

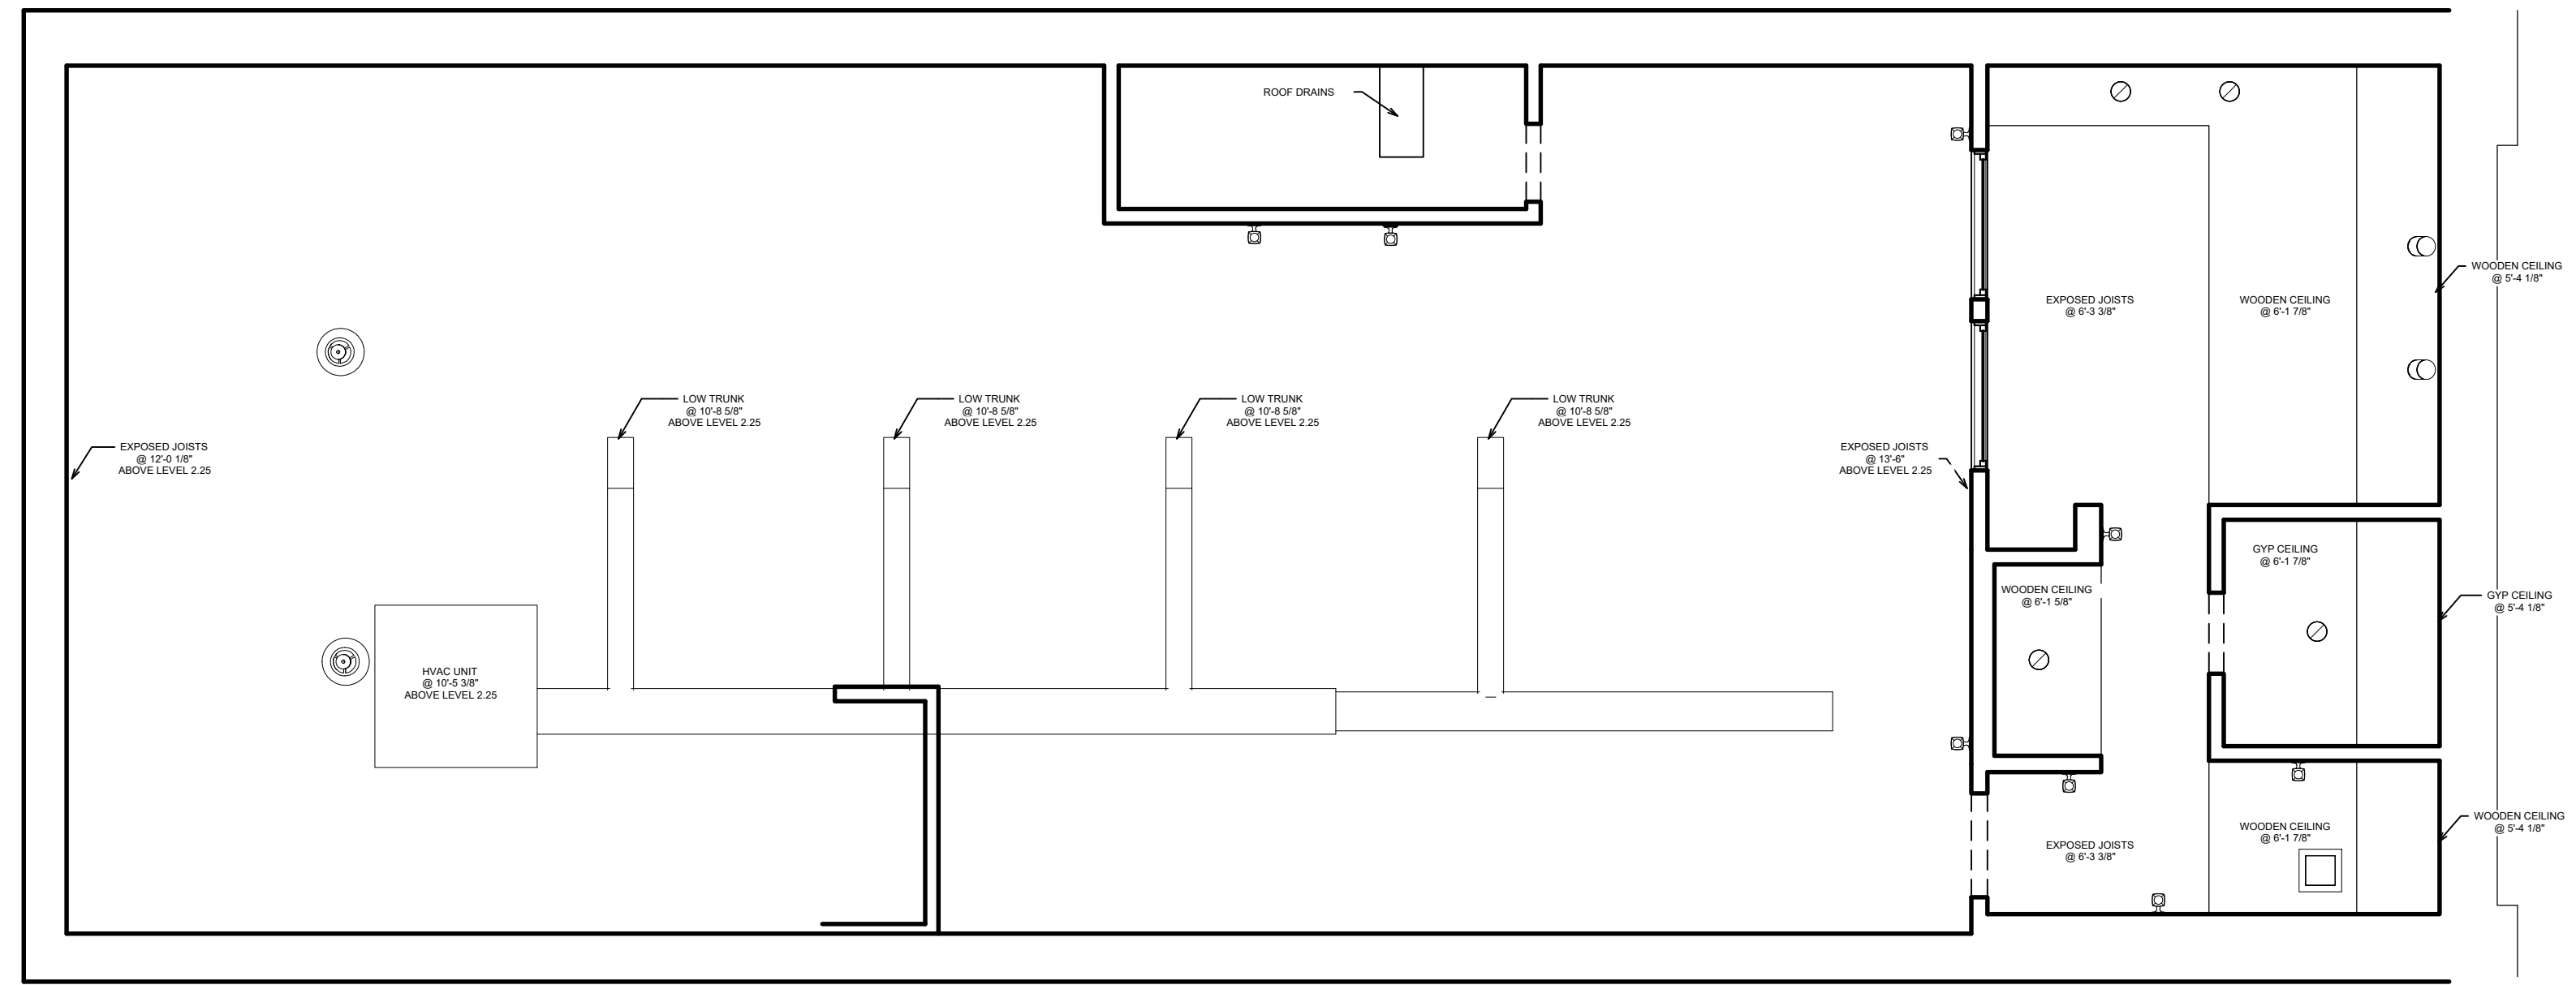

1 REFLECTED CEILING PLAN LEVEL 2.75
A2.3 SCALE: 1/4"=1'-0"

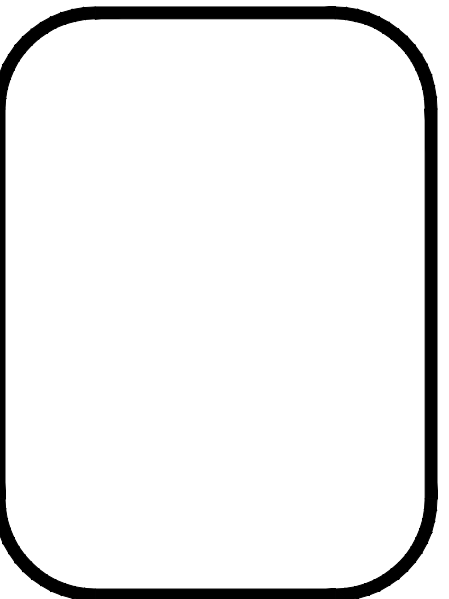

Essential Service for
Architects, Builders,
Retailers, etc...

Precision Architectural
AS-BUILTS

Phone: (303) 625-9900 1801 N. Broadway Suite #1750
Fax: (616) 307-5663 Denver, CO 80202
Email: support@precisionasbuilts.com

65 SHERMAN STREET
DEADWOOD, SD 57732

KR DEADWOOD
SHERMAN STREET 2020, LLC

ISSUE DATE:
05/09/24


PROJECT NO 24107
DRAWN BY CWB
REVISED BY CWB

LEVEL 2.75
CEILING PLAN

A2.3



1 FRONT ELEVATION
A3.0 SCALE: 1/4"=1'-0"

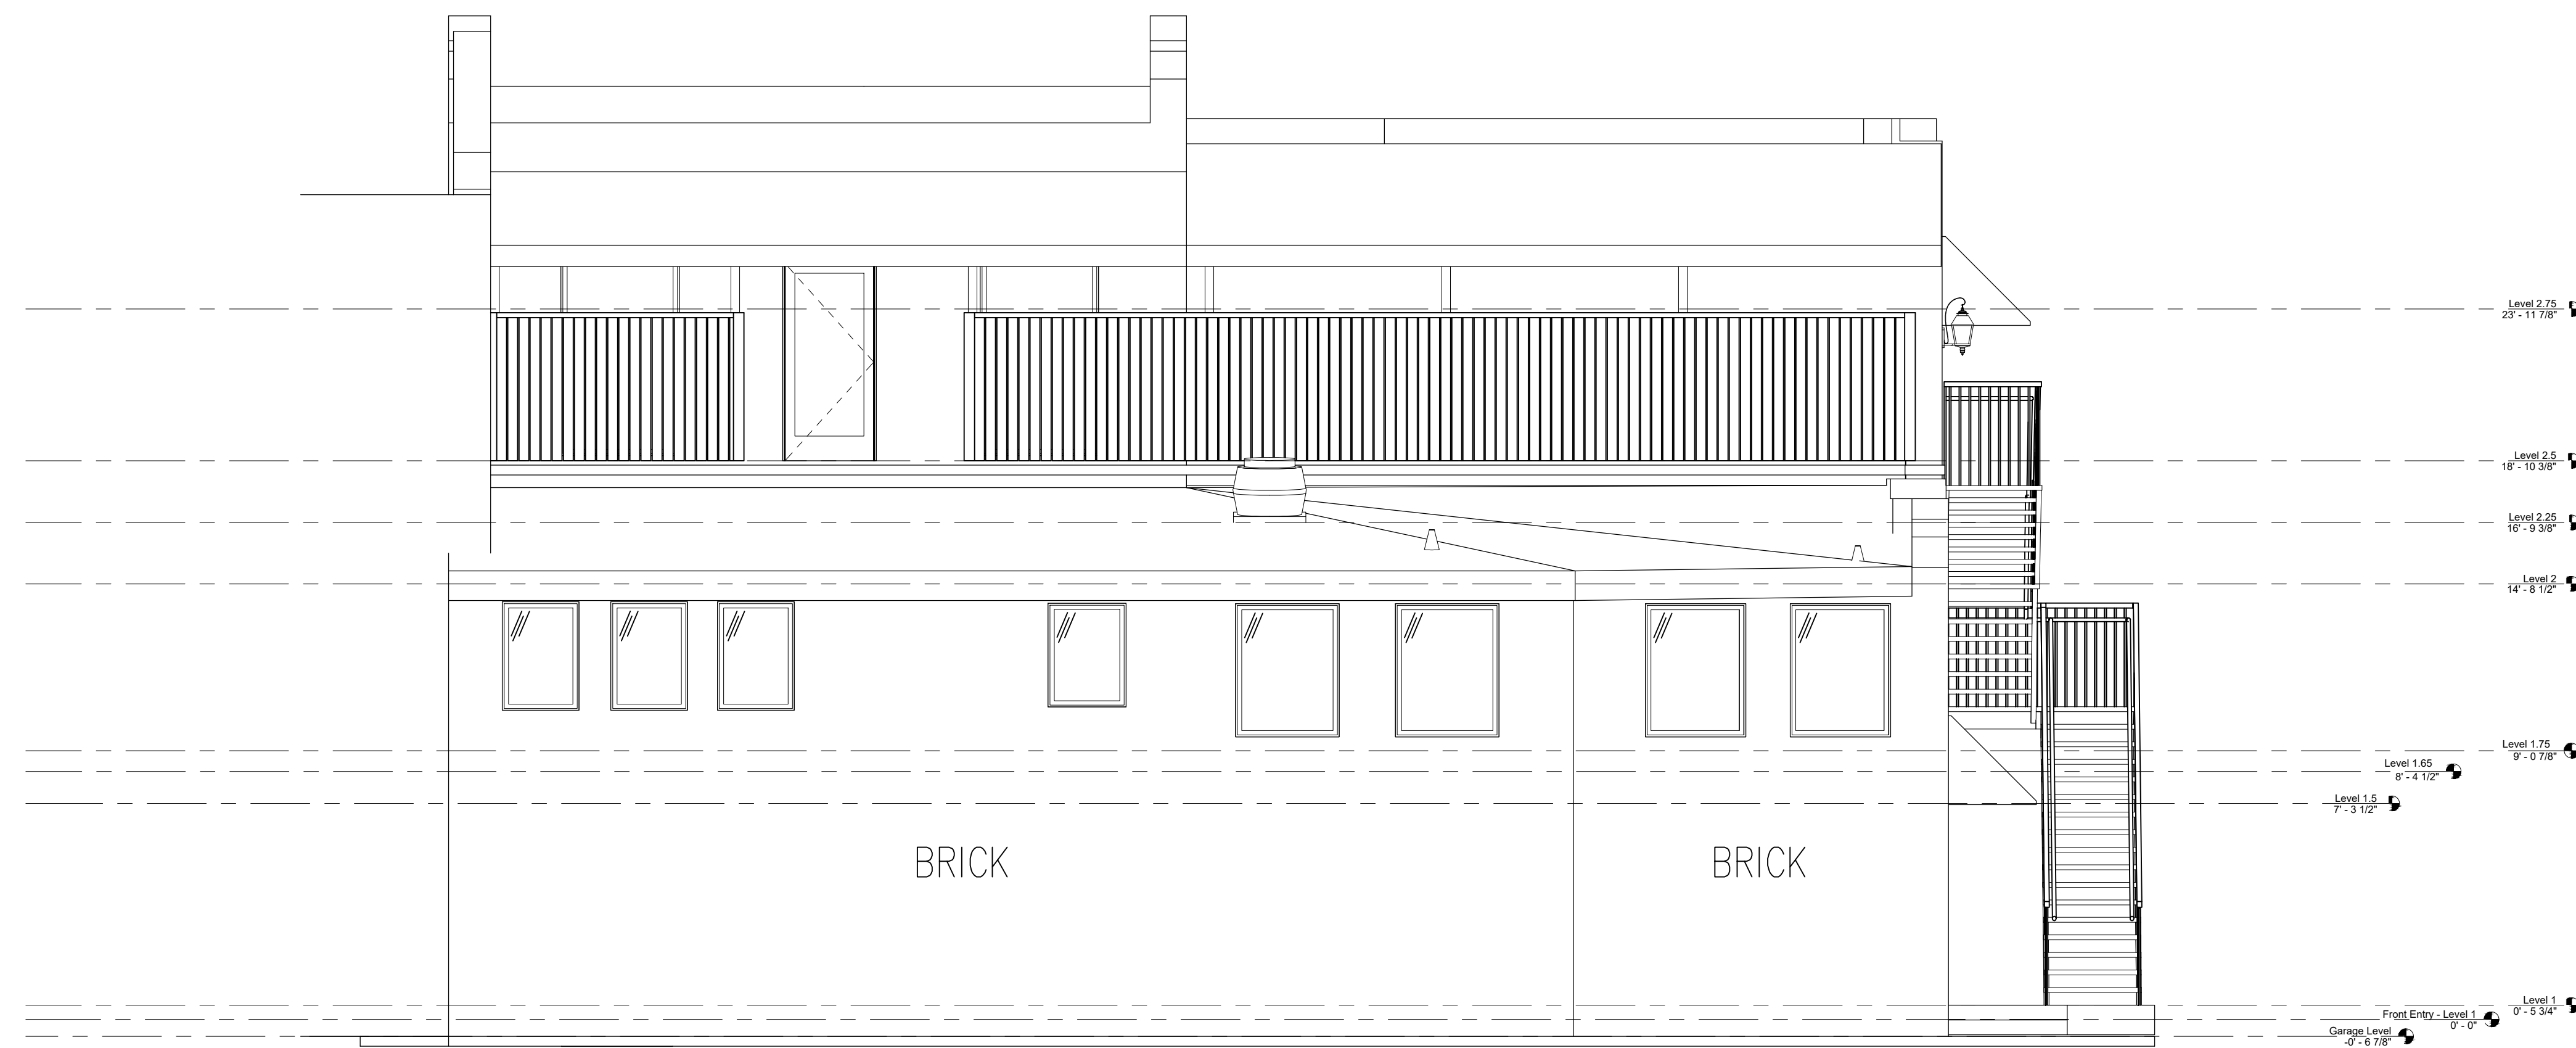

2 REAR ELEVATION
A3.0 SCALE: 1/4"=1'-0"

Essential Service for
 Architects, Builders,
 Realtors, etc...
Precision Architectural
 AS-BUILTS
 Phone: (303) 625-9900
 Fax: (616) 307-5663
 Email: support@precisionasbuilds.com
 1801 N. Broadway Suite #1750
 Denver, CO 80202

65 SHERMAN STREET
DEADWOOD, SD 57732


KR DEADWOOD
 SHERMAN STREET 2020, LLC

ISSUE DATE:
05/09/24


PROJECT NO 24107
DRAWN BY CWB
REVISED BY CWB

FRONT + REAR
ELEVATIONS

A3.0

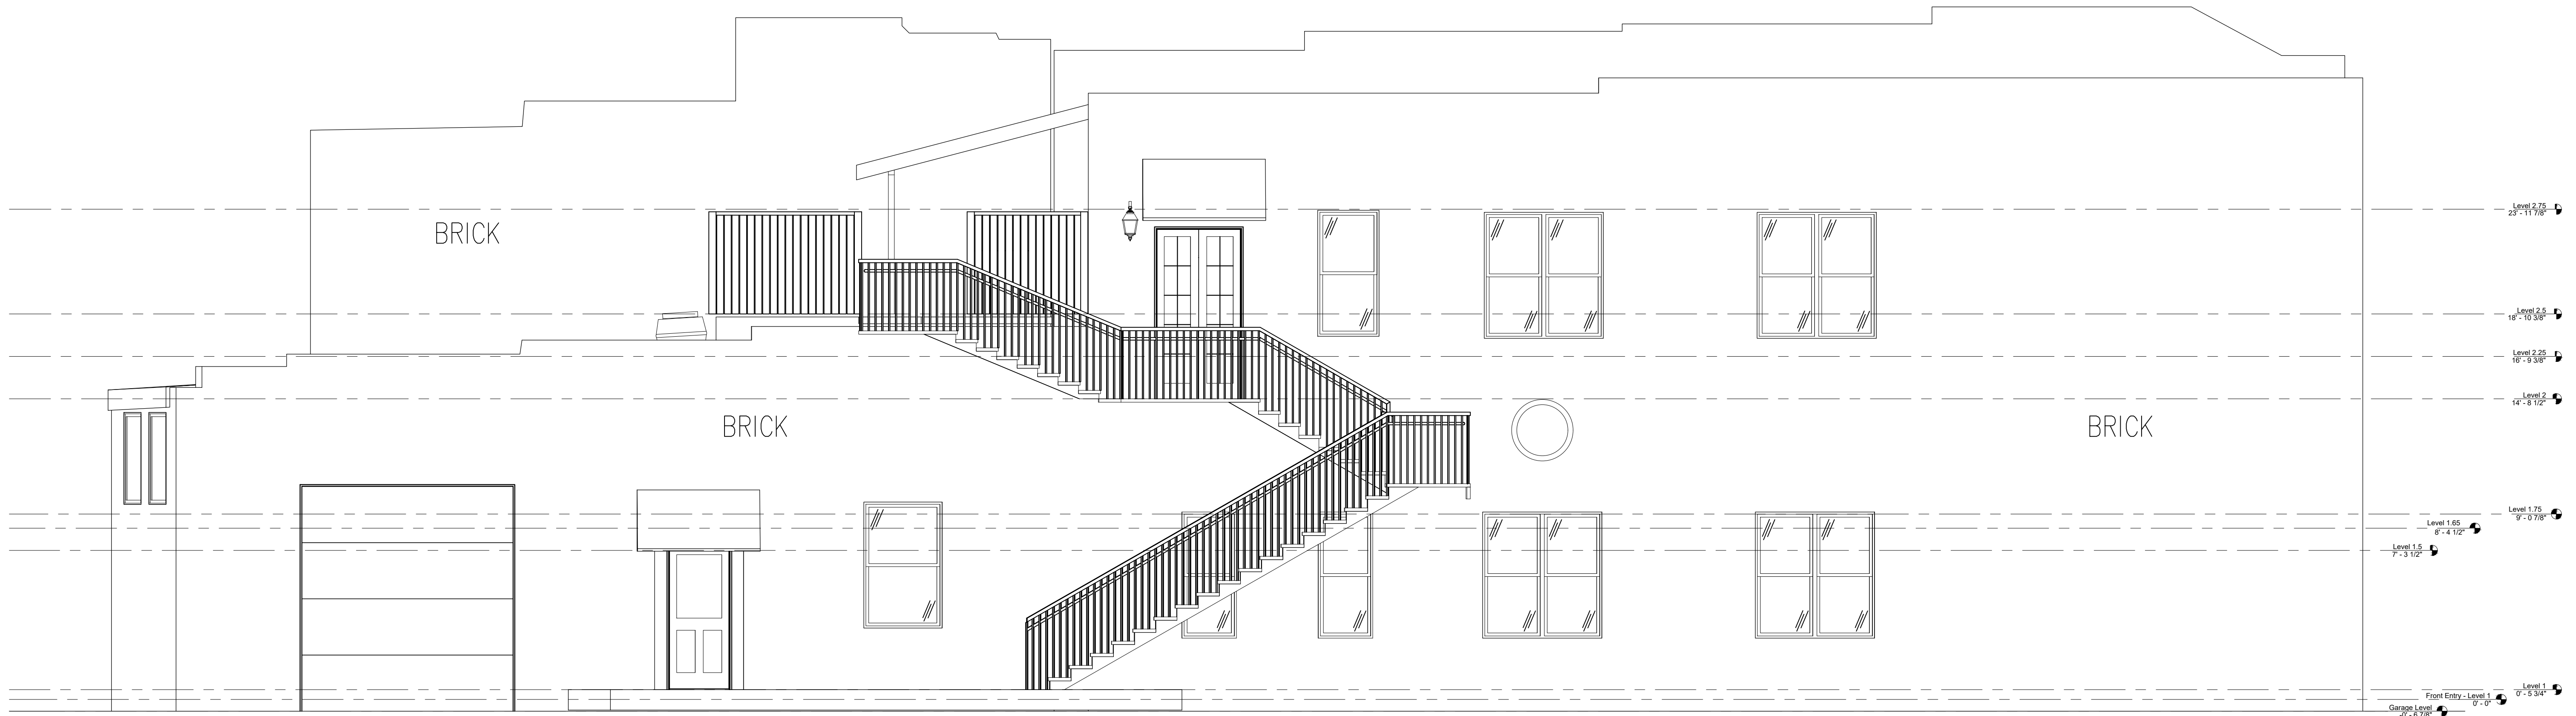

1 LEFT ELEVATION
 A3.1 SCALE: 1/4"=1'-0"

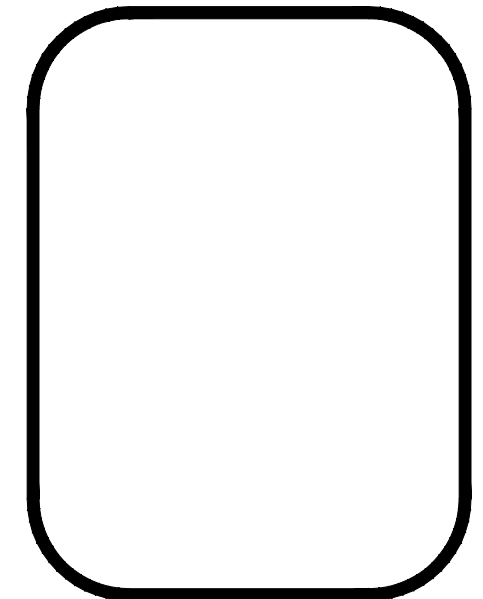

Essential Service for
 Architects, Builders,
 Realtors, etc...

Precision Architectural
 AS-BUILTS

Phone: (303) 625-9900
 Fax: (616) 307-5663
 Email: support@precisionbuilds.com

1801 N. Broadway Suite #1750
 Denver, CO 80202

**65 SHERMAN STREET
 DEADWOOD, SD 57732**

KR DEADWOOD
 SHERMAN STREET 2020, LLC

**ISSUE DATE:
 05/09/24**

PROJECT NO 24107
 DRAWN BY CWB
 REVISED BY CWB

LEFT
 ELEVATION

A3.1