

Date of Issuance: May 25, 2023	Effective Date: May 29, 2023
Owner: City of Eden	Owner's Contract No.: N/A
Contractor: Darnell Construction	Contractor's Project No.: N/A
Engineer: Enprotec / Hibbs & Todd, Inc.	Engineer's Project No.: 7300
Project: North Water System Improvements	Contract Name: North Water System Improvements

The Contract is modified as follows upon execution of this Change Order:

**Description:**

A previously unidentified fire flow line supplying protection to medical/nursing facility on Eaker Street was discovered after abandonment of the existing water main. Additional work was necessary to reconnect the existing fire line to the newly installed main.

- Addition of \$8,772.00 due to field discovered items during construction.

**Attachments:** Attachment A – Quantities Rectification Spreadsheet

CHANGE IN CONTRACT PRICE	CHANGE IN CONTRACT TIMES
Original Contract Price: \$ <u>2,095,427.18</u>	Original Contract Times (days): Substantial Completion: <u>180</u> Ready for Final Payment: <u>210</u>
[Increase] <del>[Decrease]</del> from previously approved Change Orders No. <u>0</u> to No. <u>2</u> : \$ <u>89,354.51</u>	[Increase] <del>[Decrease]</del> from previously approved Change Orders No. <u>0</u> to No. <u>2</u> : Substantial Completion: <u>210</u> days Ready for Final Payment: <u>210</u> days
Contract Price prior to this Change Order: \$ <u>2,184,781.69</u>	Contract Times prior to this Change Order (days): Substantial Completion: <u>390</u> Ready for Final Payment: <u>420</u>
[Increase] <del>[Decrease]</del> of this Change Order: \$ <u>8,772.00</u>	[Increase] <del>[Decrease]</del> of this Change Order: Substantial Completion: <u>175</u> days Ready for Final Payment: <u>175</u> days
Contract Price incorporating this Change Order: \$ <u>2,193,553.69</u>	Contract Times with all approved Change Orders (days): Substantial Completion: <u>565</u> Ready for Final Payment: <u>595</u>

RECOMMENDED:	ACCEPTED:	ACCEPTED:
By: _____ Engineer (if required)	By: _____ Owner (Authorized Signature)	By: _____ Contractor (Authorized Signature)
Title: _____	Title _____	Title _____
Date: _____	Date _____	Date _____



Approved by Funding Agency (if applicable)

By: \_\_\_\_\_ Date: \_\_\_\_\_  
Title: \_\_\_\_\_



MEDICAL FACILITY

6" Fire Protection Line

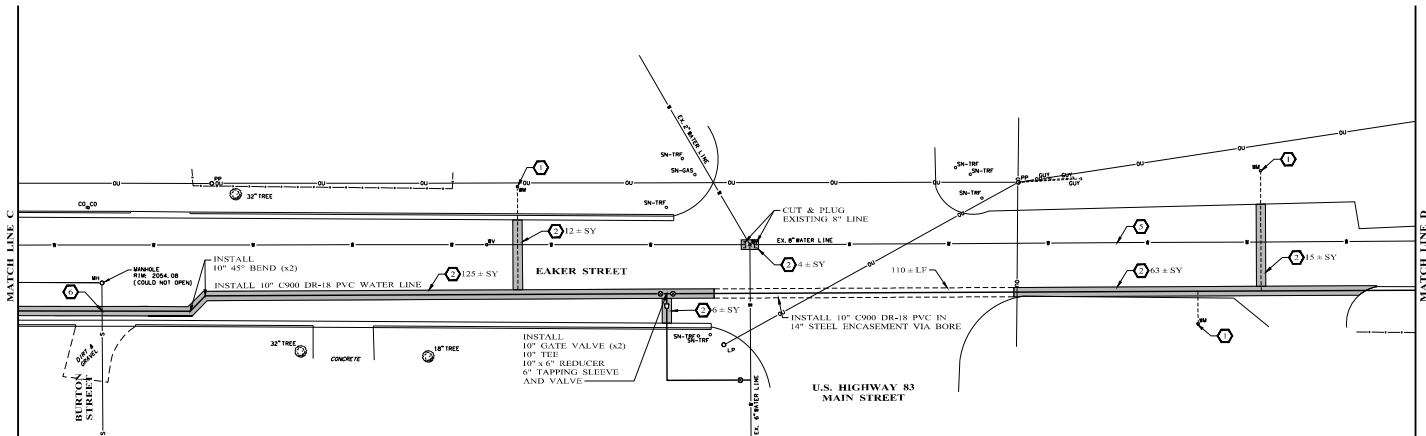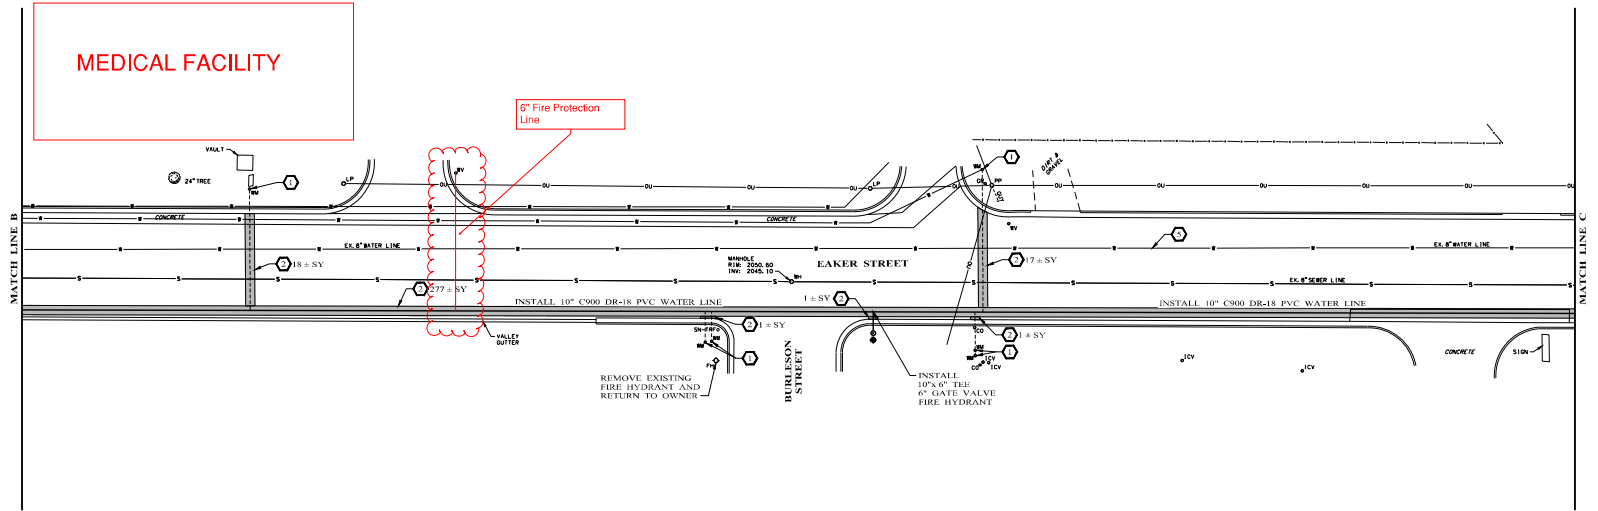

**LEGEND**

● <sup>18"</sup>	SANITARY SEWER MANHOLE	● <sup>6"</sup>	TELEPHONE PULL-BOX	●	PROPOSED FIRE HYDRANT
● <sup>24"</sup>	SANITARY SEWER CLEANOUT	○ <sup>24"</sup>	SIGN	○	PROPOSED GATE VALVE
● <sup>30"</sup>	FIRE HYDRANT	○ <sup>24"-TRF</sup>	SIGN - TRAFFIC	○	PROPOSED PLUG
● <sup>36"</sup>	WATER METER	○ <sup>24"-GAS</sup>	SIGN - BURIED GAS LINE	○	RECONNECT METER SERVICE
● <sup>48"</sup>	WATER VALVE	○ <sup>18"</sup>	PIPE BOLLAR	○	INSTALL ASPHALT PAVEMENT REPLACEMENT
● <sup>60"</sup>	GAS METER	○ <sup>18"</sup>	MAILBOX	○	INSTALL CONCRETE PAVEMENT REPLACEMENT
● <sup>66"</sup>	GAS VALVE	○ <sup>18"</sup>	CLY ANCHOR	○	INSTALL GRAVEL REPLACEMENT
● <sup>72"</sup>	GAS RISER	○ <sup>18"</sup>	GAS LINE	○	ABANDON EXISTING WATER LINE IN PLACE
● <sup>78"</sup>	ELECTRIC METER	○ <sup>18"</sup>	WATER LINE	○	CONTRACTOR TO INSTALL WATERSEWER CROSSING IN ACCORDANCE WITH 39 FAC 290.46-6.4.6. IF APPLICABLE, PAYMENT FOR ENCASEMENT WILL BE SUBSIDIARY TO PROJECT COST.
● <sup>84"</sup>	LIGHT POLE	○ <sup>18"</sup>	OVERHEAD UTILITY	○	
● <sup>90"</sup>	POWER POLE	○ <sup>18"</sup>	PROPOSED WATER LINE	○	
		○ <sup>18"</sup>	PROPOSED SERVICE LINE	○	

**CHANGE ORDER 3**

<b>ENPROTEC/HIBBS &amp; TODD, INC.</b> ENVIRONMENTAL AND CIVIL ENGINEERS 411 South Street, Suite 1000 Edin, Texas 79120 P.O. Box 290464, No. 1111 Edin, Texas 79120-0464 (940) 356-2222	PROJECT NO. 0603042021 DATE C.E.T. DESIGNED BY J.B.H. DRAWN BY S.D. CHECKED BY:
	PROJECT NO. 0603042021 DATE C.E.T. DESIGNED BY J.B.H. DRAWN BY S.D. CHECKED BY:
<b>CONSTRUCTION PLANS FOR NORTH WATER SYSTEM IMPROVEMENTS EDEN, CONCHO COUNTY, TEXAS</b>	
<b>EAKER STREET</b>	
<b>13 OF 34</b>	