




BIERSDORFER - NICHOLS RESIDENCE
1204 WEST PORTAL ROAD

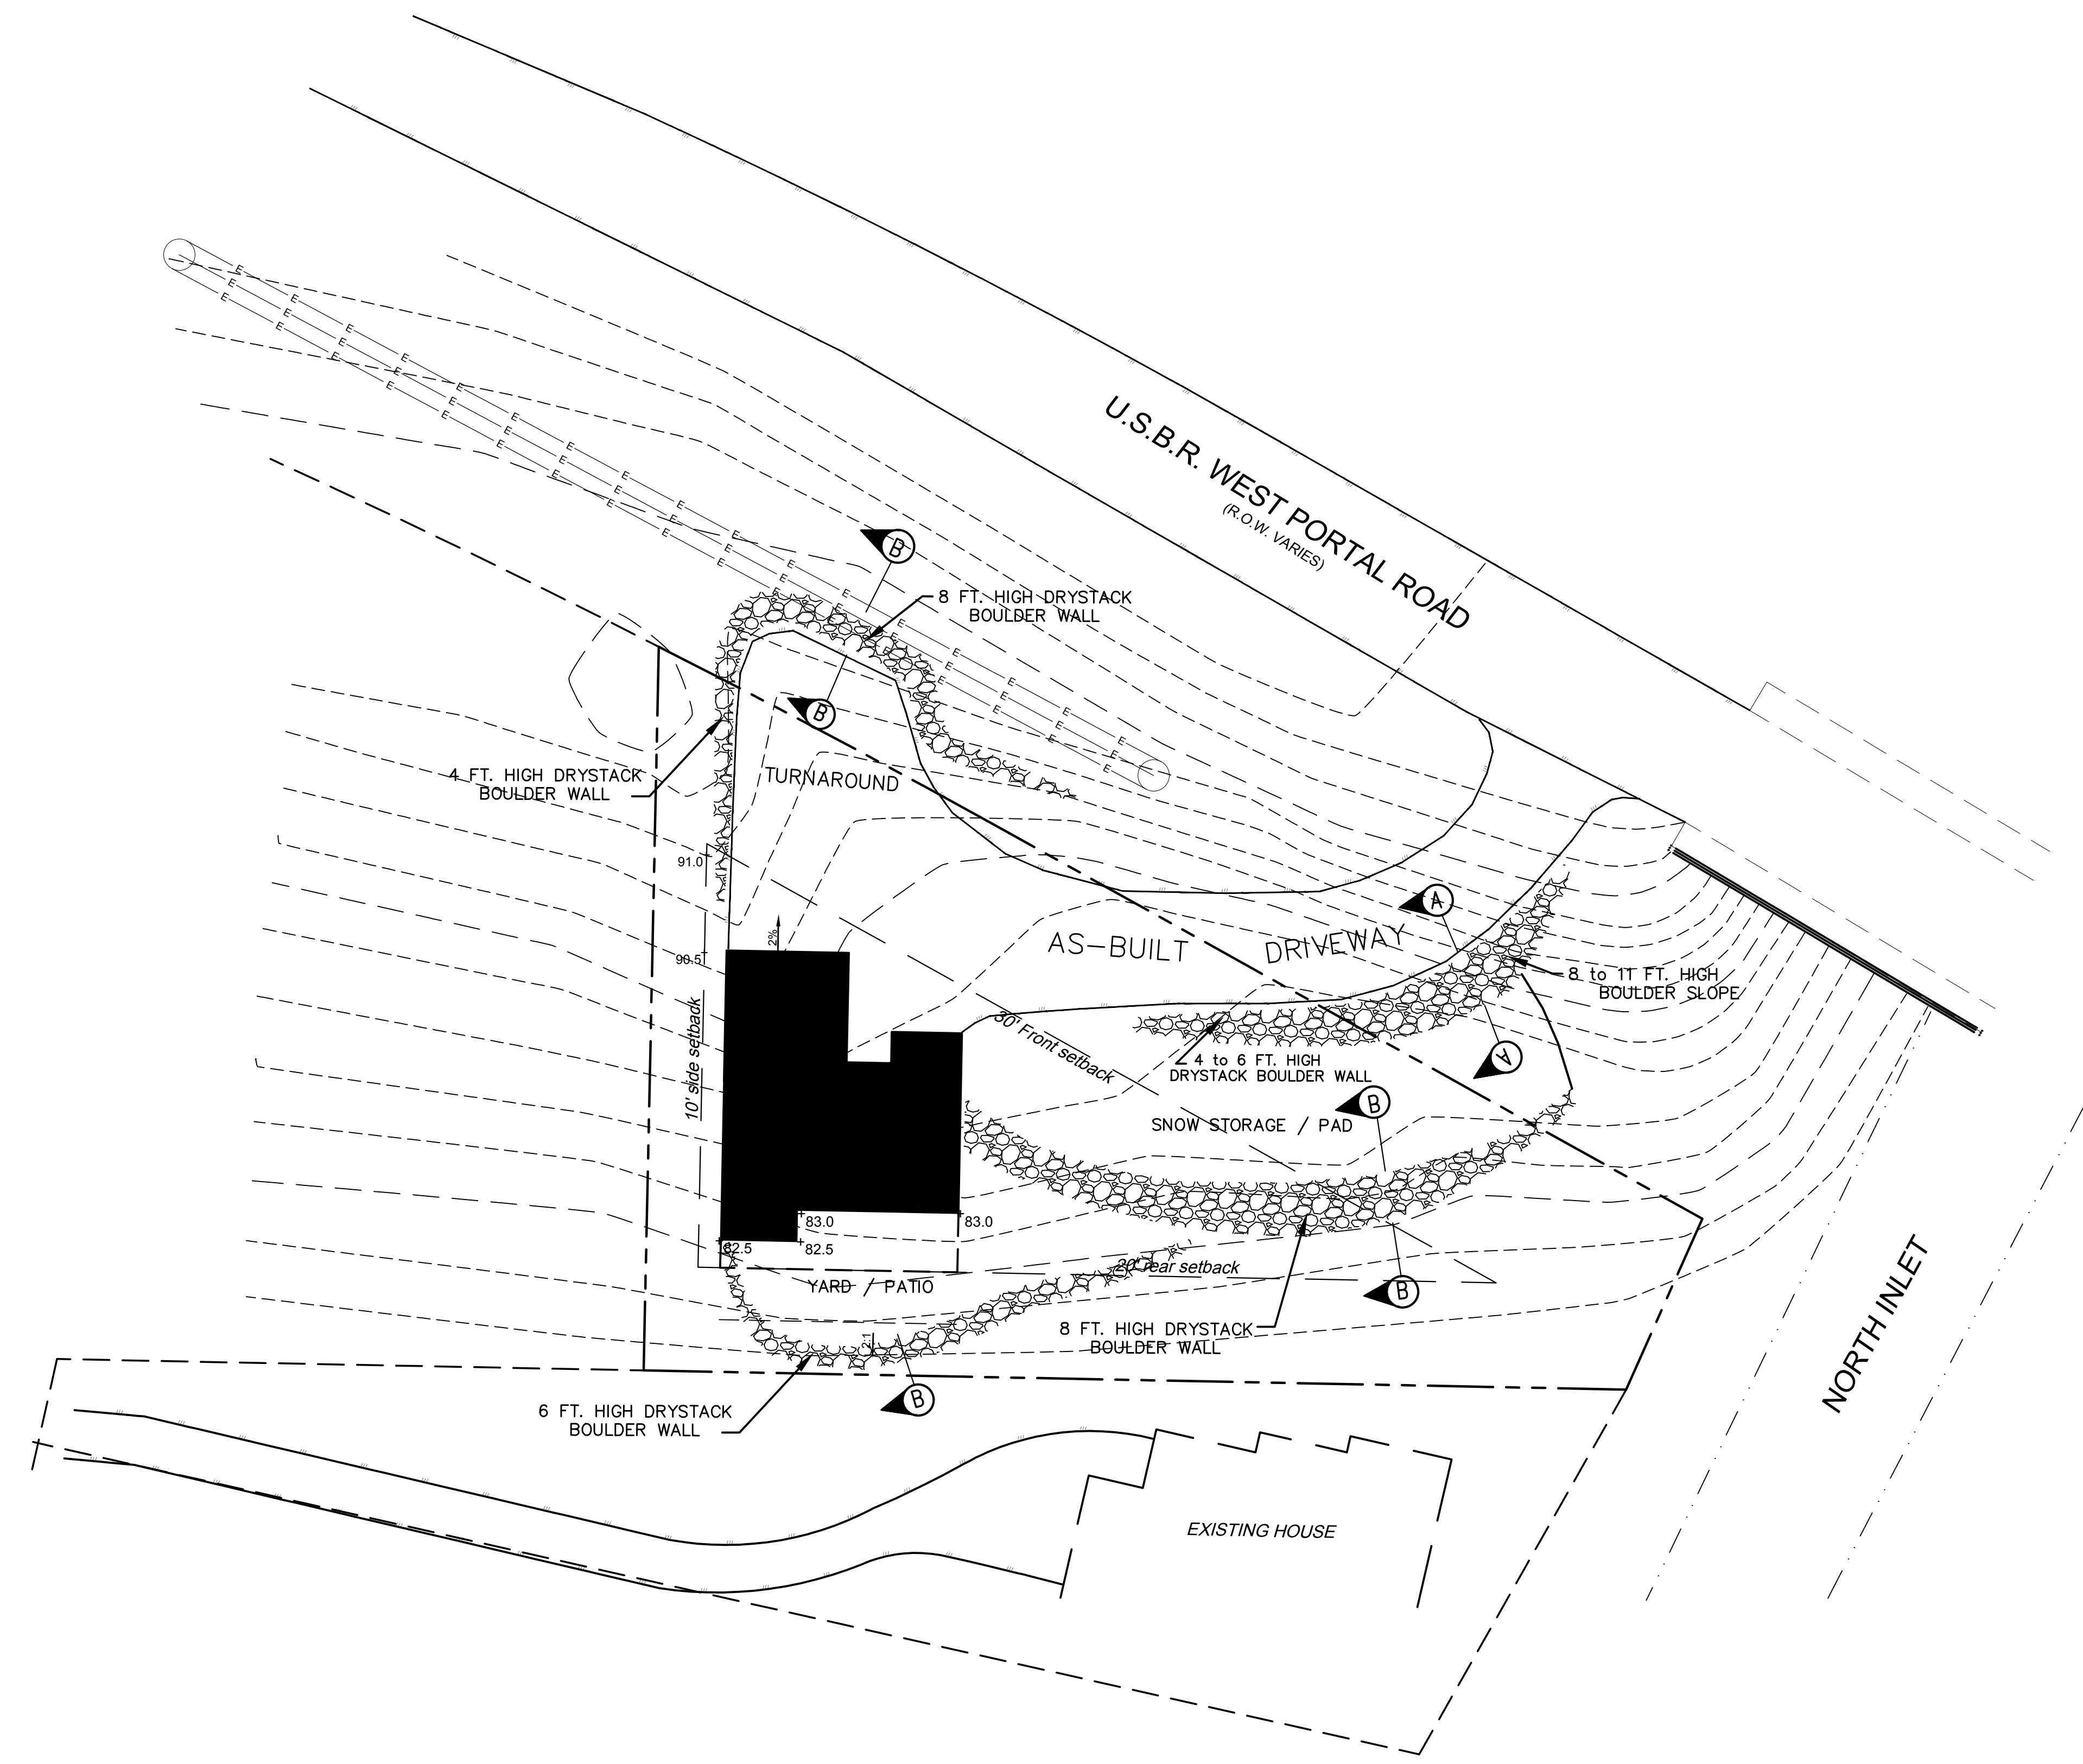

AS-BUILT SITE PLAN
AND WALL LOCATION PLAN

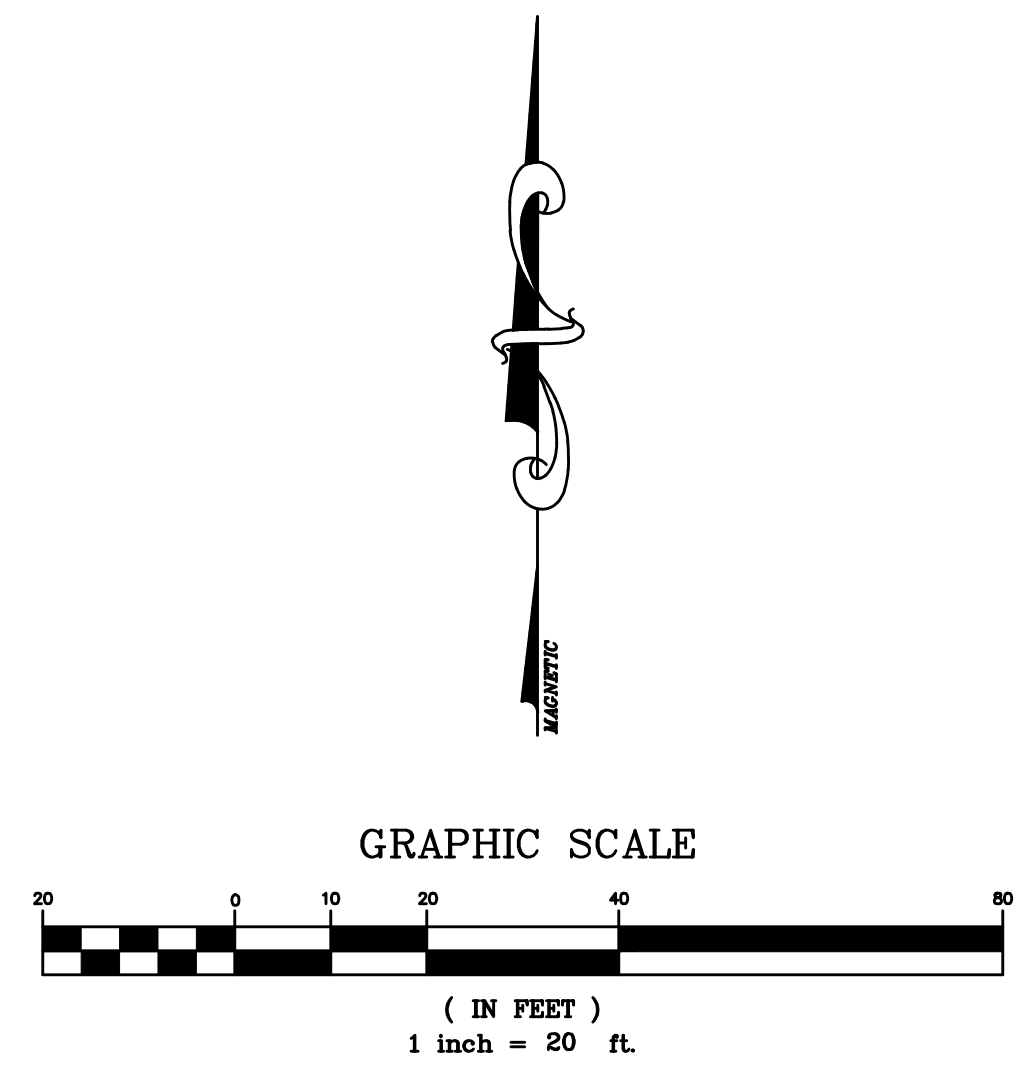

CALL UTILITY NOTIFICATION
CENTER OF COLORADO
1-800-922-1987
OR 303-534-6700 IN METRO DENVER
CALL 2-BUSINESS DAYS IN ADVANCE
BEFORE YOU DIG, GRADE, OR EXCAVATE
FOR THE MARKING OF UNDERGROUND
MEMBER UTILITIES

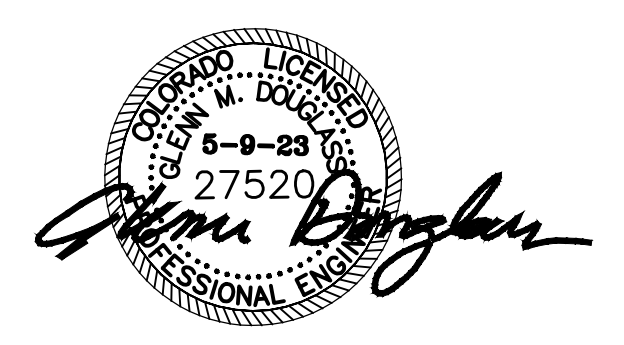

PREPARED BY
DOUGLASS ENGINEERING
15153 WEST 32ND DRIVE
GOLDEN, COLORADO 80401
(303) 421-4165
1204 WEST PORTAL ROAD
AS-BUILT PLAN