

- ① N89°58'28\"/>
- ② N09°33'44\"/>
- ③ N41°10'59\"/>
- ④ N89°51'33\"/>
- ⑤ S41°10'59\"/>
- ⑥ S09°33'44\"/>
- ⑦ N89°58'28\"/>
- ⑧ N89°59'17\"/>
- ⑨ S89°59'20\"/>
- ⑩ N76°34'13\"/>
- ⑪ S77°02'35\"/>
- ⑫ N89°58'28\"/>
- ⑬ S89°58'28\"/>
- ⑭ N89°51'33\"/>
- ⑮ N00°08'27\"/>
- ⑯ N00°12'39\"/>
- ⑰ N00°08'27\"/>
- ⑱ S00°12'39\"/>

SECTION 3

SHEET 3 OF 4

NE 1/4 SE 1/4 NE 1/4
SHEET 4 OF 4

SE 1/4 SE 1/4 NE 1/4

668.16' N89°39'19\"/>E



1332.33' S00°20'12\"/>E

E 1/2

3.88, 50.00S, .46151C1

GL #1

SHEET 2 OF 4

W 1/2

GL #1

BEARTRACK RIDGE SUBD (Plat 88-26)

TR. IV LOT 1 plat 92-45

TR. III

TR. VII-A


TR. VII-B

LOT 2



SHEET 1 OF 4

SCALE 1"=220'

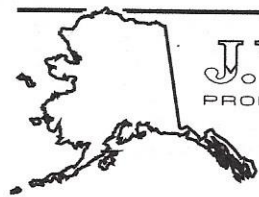


J.W. BEAN
 PROFESSIONAL SURVEYOR
 1070 ARCTIC CIRCLE
 JUNEAU - ALASKA
 (907) 723-3610
 SURVEYOR - PLANNER

AS-BUILT SURVEY OF BURIED ELECTRIC LINE WITHIN EAST PORTION OF SECTION 3 T40S, R59E, CRM

15.0' EASEMENT
2009-007070-0

DOUG FINLEY
CORNER RECOVERED

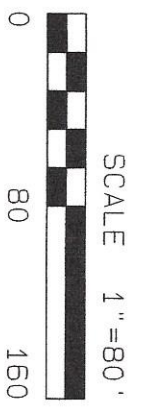

SHEET 2 OF 4

- 7 N89°58'28"W 24.00'
- 8 N89°59'17"E 24.00'
- 9 S89°59'20"W 24.00'
- 10 N76°34'13"W 24.68'
- 11 S77°02'35"E 24.64'
- 12 N89°58'28"W 24.00'

TR. III

N00°05'38"W 310.61'

**BEARTRACK
RIDGE SUBD**

TR. IV
LOT 2

N00°05'38"W 330.63'

REACTOR CABINET
SPLICE CABINET

W 1/2

20.0' ACCESS EASEMENT

24.0' EASEMENT
Plat 88-26

RE-BAR W/CAP
DOUG FILEY
24.0' EASEMENT
2009-007070-0

GL #1

TR. VII-A

N00°05'38"W 286.66'

S00°05'38"E 292.40'

RINK CREEK ROAD

TR. VII-B

LOT 2

11

SW 1/4 NE 1/4

SW 1/4 SE 1/4 NE 1/4
SHEET 3 OF 4


SECTION 3

- ① N89°58'28"W 15.00'
- ② N09°33'44"E 83.61'
- ③ N41°10'59"E 53.90'
- ⑤ S41°10'59"W 42.92'
- ⑥ S09°33'44"W 68.71'
- ⑬ S89°58'28"E 15.00'



30.0' EASEMENT
2009-006623-0

N50°40'55"E 203.97'
S50°40'55"W 196.38'

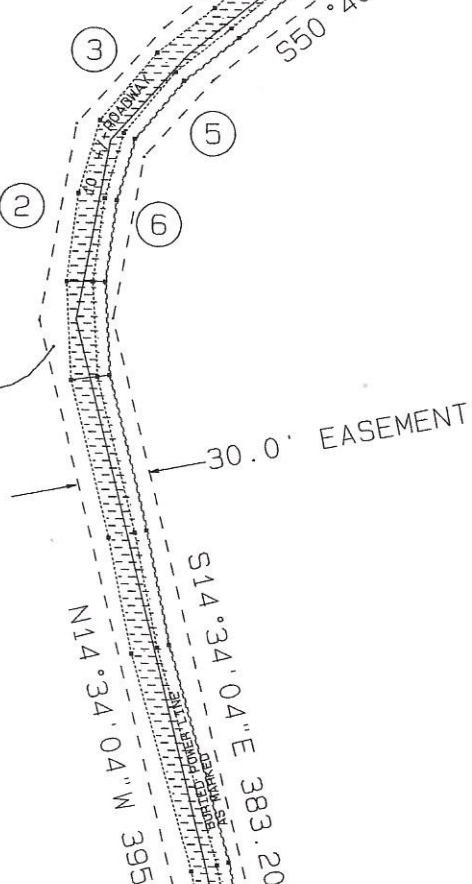

S14°34'04"E 383.20'
N14°34'04"W 395.96'

S38°25'38"E 149.81'
N38°25'38"W 169.95'

15.0' EASEMENT
2009-006623-0

15.0' EASEMENT
2009-007070-0

N00°10'09"E 361.16'

S00°10'09"W 361.16'

N00°10'08"E 351.57'

S00°10'08"W 351.57'

S00°08'27"E 311.75'

N00°08'27"W 311.75'

15.0' EASEMENT

15.0' EASEMENT
2009-007070-0

DOUG FINLEY
CORNER RECOVERED

TR. III

RECOVERED CORNER AS MARKED

PLAT

SECTION 2

2011-9



NE 1/4 NE 1/4

LOT 12

4

17

15.0' EASEMENT
2009-006623-0

EASEMENT
15.0'

N00°08'27"W 275.68'

N00°08'27"E 302.16'

N00°08'27"W 222.16'

N00°08'27"W 54.00'

N00°12'39"W 26.00'

N00°08'27"W 30.00'

N89°51'33"E 30.00'

N89°51'33"E 15.00'

N89°51'33"E 15.00'

N00°08'27"W 54.00'

N00°12'39"W 26.00'

N00°08'27"W 30.00'

N89°51'33"E 30.00'

N89°51'33"E 629.34'

S89°51'33"W 659.36'

S89°51'33"W 657.60'

N89°51'33"E 1316.93'

30.0' EASEMENT
2009-006622-0

N89°51'33"E 1316.93'

30'-7" ROADWAY
DOTTED POWER LINE
AS MARKED

S89°51'33"W 659.36'

N89°51'33"E 629.34'

S89°51'33"W 657.60'

N89°51'33"E 657.65'

30.0' EASEMENT
2009-007070-0

15.0' EASEMENT

15.0' EASEMENT

SHEET 4 OF 4

NE1/4SE1/4NE1/4