




GENERAL NOTES:
Area Certification/As Built Layout
18201 Dixie Highway
Homewood, IL

Building Gross Area - 19,540 S.F.

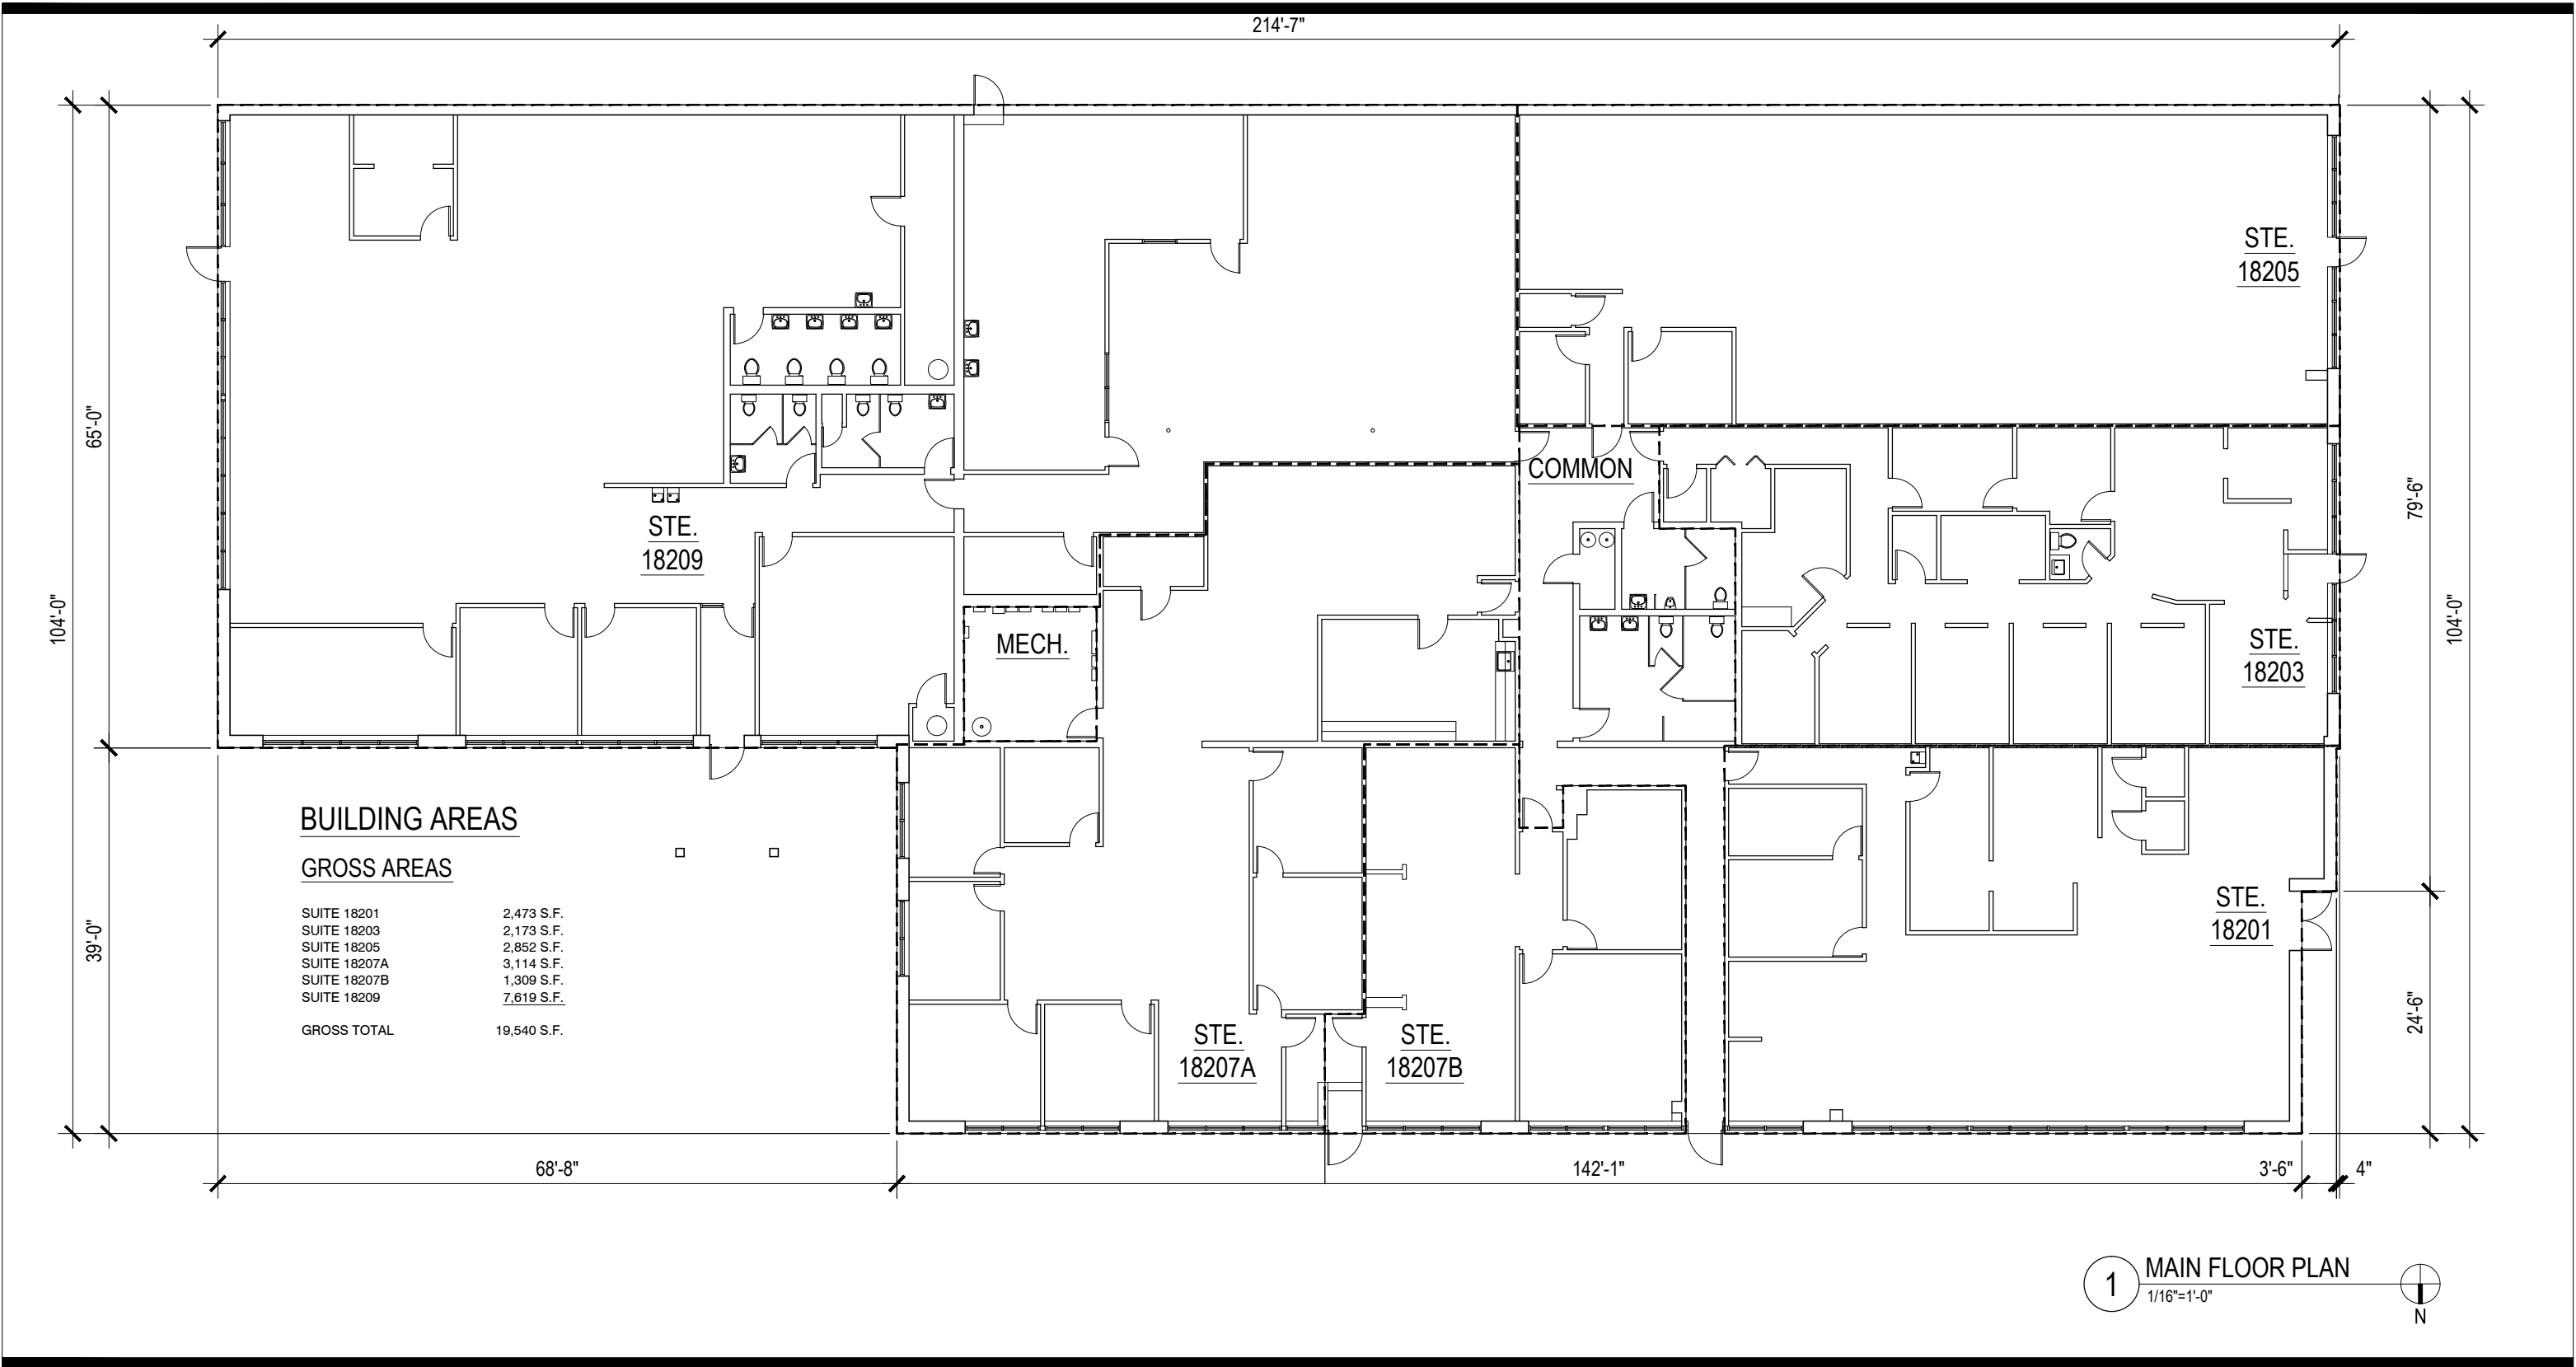

Novamar
Building Documents
Area Certification
Architecture

1321 Washington
Evanston, IL 60202
T 847.530.1294
www.buildingdocument.com

NO.	DATE	REVISIONS/ISSUANCES

PROJECT NUMBER: _____
PROJECT MANAGER: _____
ARCH/ENG: _____
SCALE: _____
DRAWN BY: _____
CHECKED BY: _____
SKETCH NUMBER: _____