Submit Close Save

FORM APPROVED OMB NO. 0575-0042

Form RD 1924-7

ORDER NO. 7	
DATE 4/26/21	
STATE NC	

(Rev. 2-97)	UNITED STATES DEPARTMENT OF AGE		7			
	RURAL DEVELOPMENT AND FARM SERVICE AGENCY)	DATE 4/26/	/21		
	CONTRACT CHANGE ORDER		STATE			
CONTRACT FOR	R Hendersonville Police Department		COUNT	Y Hender	son	
OWNER	City of Henders	onville	•			
	ore, or nemaers					=
To Edifice	(Contractor)					_
You are hereby	y requested to comply with the following changes from	n the contract pla	ns and spe	ecifications:		
(Su	Description of Changes applemental Plans and Specifications Attached)	DECREA in Contract			REASE tract Price	_
RFI-040 - Ya	ard Inlet & Revised Grades	\$		\$	4668.7	4
	TOTALS NET CHANGE IN CONTRACT PRICE	s	0		4668.7	_
JUSTIFICATION	N:					
The amount of	f the Contract will be (Decreased) (Increased) By The	Sum Of: Four	Thousan	ıd Six Hı	ındred	=
Sixty-Eight	Dollars and Seventy-Four Cents		Dollars (\$	4668.74).
The Contract T	Γotal Including this and previous Change Orders Will	Be: Nine Millio	on Six H	lundred F	Fifty	
	en Hundred Ninety-Eight Dollars and Sevent).
	Period Provided for Completion Will Be (Increased) (I t will become a supplement to the contract and all pro-		-	0	Day	ys.
Requested				(D)		_
Recommended	(Ow	ner)		(Date)		
Accepted		4/2	26/21	(Date)		
Approved by Age	(Contraction of the Contraction	etor)		(Date)		
11 - 7 - 8-	(Name and T			(Date)		_

According to the Paperwork Reduction Act of 1995, an agency may not conduct or sponsor, and a person is not required to respond to a collection of information unless it displays a valid OMB control number. The valid OMB control number for this information collection is 0575-01042. The time required to complete this information collection is estimated to average 15 minutes per response, including the time for reviewing instructions, searching existing data sources, gathering and maintaining the data needed, and completing and reviewing the collection of information.

☐ ORIGINAL-BORROWER'S CASE FOLDER
☐ COPY-CONTRACTOR
COPY-BORROWER



Proposed Change Order

Edifice, LLC

Post Office Box 36349 Charlotte, NC 28236

Phone: 704-332-0900

Owner: City of Hendersonville

Date Submitted:

Project: NC3934 - Hendersonville Police Department

Headquarters

RFI-040 - Y	Yard Inlet &	Revised	Grades -	Change	Request
	RFI-040 - `	RFI-040 - Yard Inlet &	RFI-040 - Yard Inlet & Revised	RFI-040 - Yard Inlet & Revised Grades -	RFI-040 - Yard Inlet & Revised Grades - Change

Description of Change:

Description	Scope of Work	
Item No: 1 - RFI-040 - Yard Inl	let & Revised Grades - Change Request	
Earthwork	(Moore & Sons) - Supply and install 6" schedule 40 PVC between the building and existing retaining wall (Jonas Street Elevation) along with (3) three 12" yard drain boxes. 6" PVC to be installed under sidewalk to avoid geogrid and tee'd at locations of yard drains.	4,350.00
	(Moore & Sons) - Repair/Adjust the tops on the existing nyloplast yard inlets on the front side of the building to meet the revised grades.	
	Subtotal	\$4,350.00
	Change Order Add Ons	
	Builders Risk Insurance	15.23
	General Liability	26.19
	Bonds	43.91
	Fee	221.77
	Electronic Equipment	11.64
	Total Add-Ons	\$318.74
	Total Amount Requested	\$4,668.74

City of Hendersonville	Other: If Applicable	Edifice, LLC
Print:	Print:	Print:
Signed:	Signed:	Signed:
Date:	Date:	Date:



Project: Hendersonville Police Dept.

General Contractor Edifice Const.

Company:

Name:

Description

Item#

NO. 11

Cost

Date: 04/13/2021

1	Install 6" Schedule 40 PVC on the south side of the building between the building and the existing retaining wall along with 3-12" yard drain boxes. Per the attached sketch, pipe to be located under the sidewalk with three tee's at the locations of the yard drains.	\$2,700.00
2	Repair and adjust the tops on the existing nyo-plast yard inlets on the front side of the building to meet the revised grades.	\$1,650.00
	TOTAL	\$4,350.00
Item #		
	TOTAL	\$0.00
	CHANGE ORDER REQUEST TOTAL	\$4,350.00
	Please sign and return if Approved:	

Title: Signature:



Edifice, LLC.
Post Office Box 36349
Charlotte, NC 28236

REQUEST FOR INFORMATION No. 40

Edifice Project No. NC3934.

SUBJECT: Yard Inlet Clarification DATE: 3/16/2021

PROJECT: Hendersonville Police Department Headquarters DATE REQUIRED: 03/23/2021

TO: John Kappers **PHONE:** 704-379-1919 ADW Architects, P.A. **FAX:** 704-379-1920

2815 Coliseum Centre Drive, Suite 500 **EMAIL:** jkappers@adwarchitects.com

Phone: 704-332-0900 Fax: 704-332-0901

Charlotte, NC 28217

REQUEST:

Reference: C400

Drawing: Specification:

Please reference attached. Based on discussion with the site contractor the area between the segmental retaining wall and Jonas Street elevation provides no yard inlets which may pond up in areas during heavy precipitation. Please advise if yard inlets are necessary and if they can be tied back to the catch basin in front of the transformer.

Requested by: Brian Kirk brian@mooreandson.net

SUGGESTION:

RESPONSE:

Date From (Firm) From (Contact)

Please see attached (last page) revised C400. Contractor must coordinate with electrical and other utility contractors to determine any conflicts prior to installation of piping. Area of most conflict potential is from electrical room to transformer at corner of building. Furthermore, Contractor should consult with retaining wall engineer as to impact of not installing yard inlets. Gravel at back of retaining wall and weeps at bottom of wall may provide adequate drainage without expense of yard inlets and piping. ADW 03/29/2021

	STORM	WATER PIPE	TABLE	
PIPE		PIPE	PIPE	PIPE
NO.	MATERIAL	SIZE	LENGTH	SLOPE
		in	ft	ft/ft
1	HDPE	12	30	0.0100
2	HDPE	12	75	0.0100
3	HDPE	12	33	0.0100
4	HDPE	12	70	0.0154
5	HDPE	12	25	0.0100
6	HDPE	12	39	0.0100
7	HDPE	12	88	0.0100
8	HDPE	12	30	0.0100
9	HDPE	12	30	0.0100
10	HDPE	12	59	0.0100
11	HDPE	12	117	0.0100
12	HDPE	15	51	0.0800
13	HDPE	15	41	0.0100
14	HDPE	15	67	0.0100
15	HDPE	12	20	0.0465
16	HDPE	12	87	0.0206

SEE SHEET C401 FOR STORMWATER NOTES AND DETAILS.

SEE SHEET C101 FOR GRADING AND STORMWATER NOTES.


CONTRACTOR SHALL SLOPE GRADES AWAY FROM BUILDING.

CONTRACTOR SHALL TIE FOUNDATION DRAINS AND ELEVATOR FOUNDATION DRAINS INTO STORMWATER.

SIDEWALKS SHALL HAVE A MAXIMUM CROSS SLOPE OF 1/4" IN 1' (2%) AND A LONGITUDINAL SLOPE OF 1' IN 12' (8.33%).

RETAINING WALLS HAVE BEEN SHOWN SCHEMATICALLY AS AN INDICATION OF GRADE BREAK ONLY. WALL DESIGN SHALL BE PREPARED AT CONTRACTORS EXPENSE. SEE DETAIL SHEET FOR SCHEMATIC WALL SECTION.

CONTRACTOR SHALL PROVIDE ASBUILT/RECORD DRAWINGS.

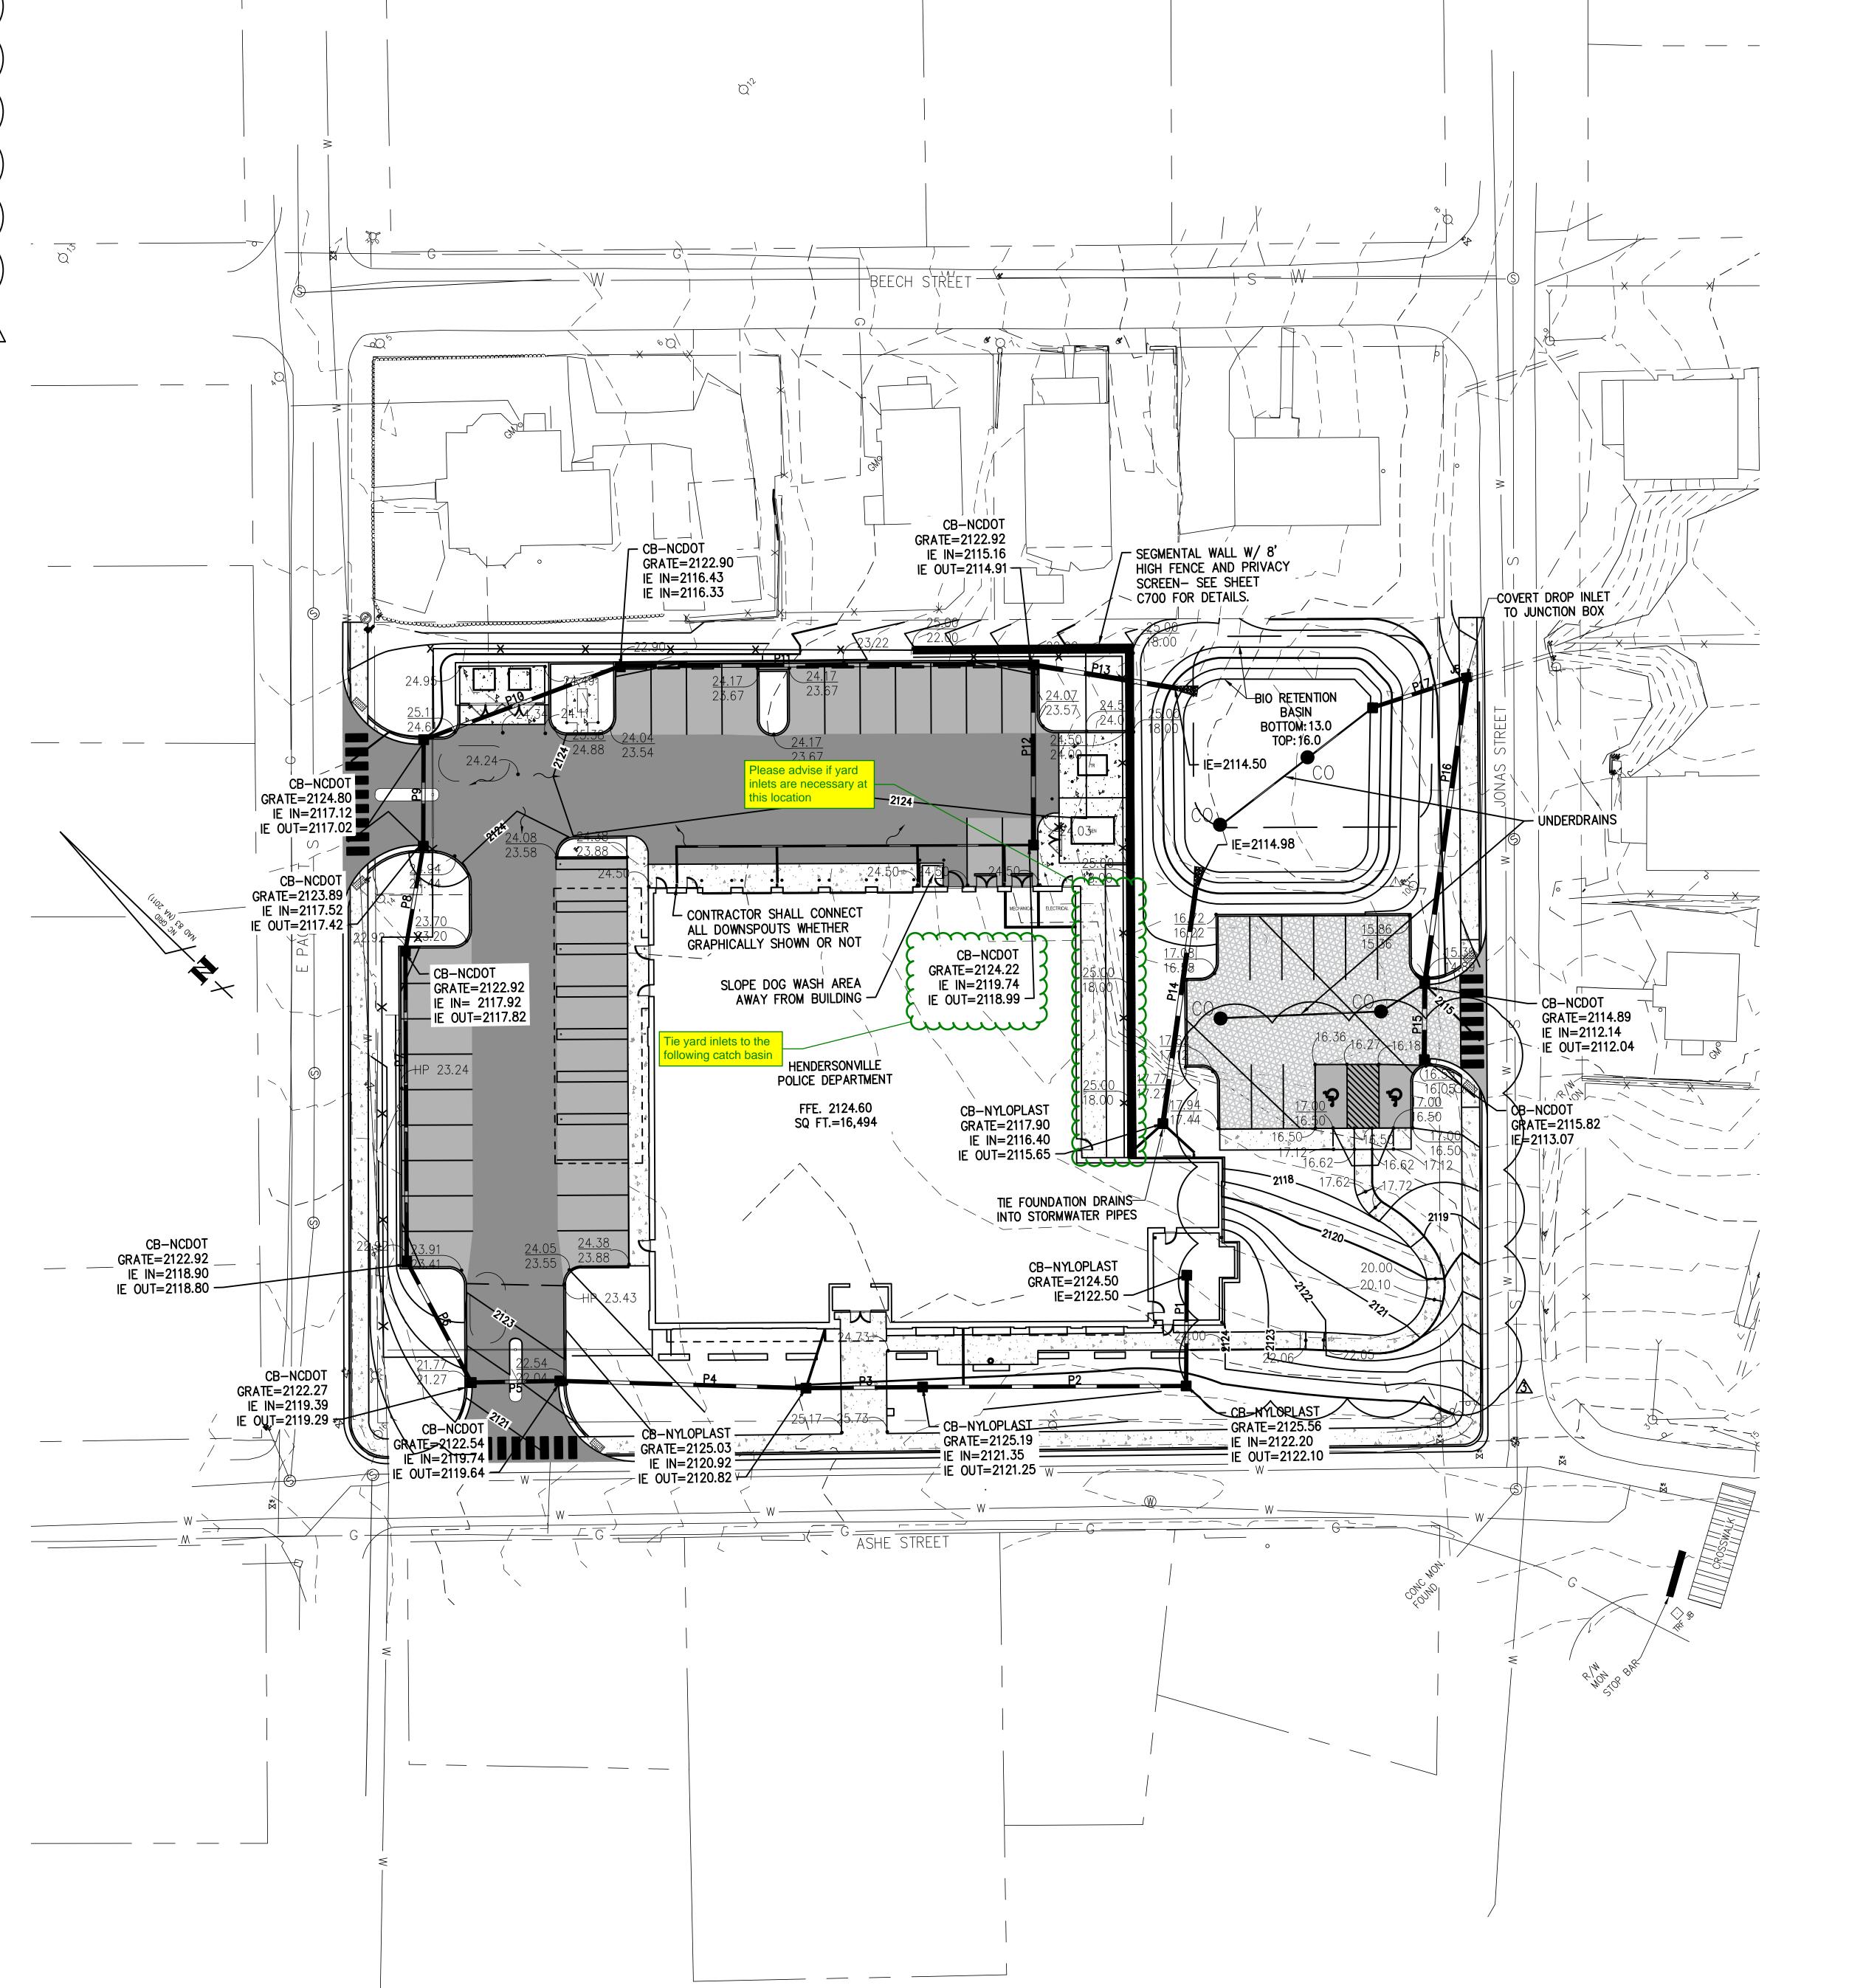

adwarchitects

www.adwarchitects.com

2815 COLISEUM CENTRE DRIVE SUITE 500 CHARLOTTE, NORTH CAROLINA 28217 P704.379.1919 F704.379.1920







Hendersonville Police Department

630 Ashe Street Hendersonville, NC 28792

100% CONSTRUCTION DRAWINGS

09-09-2019


17032

GRADING & STORM WATER PLAN

PROJECT NO:

REVISIONS NO:DATE:DESCRIPTION:12/19/19PERMIT REVIEW/VE1/31/20ADDENDUM #2

THIS DRAWING IS THE PROPERTY OF ADW ARCHITECTS, P.A. AND SHALL NOT BE REPRODUCED OR COPIED IN WHOLE OR PART. IT

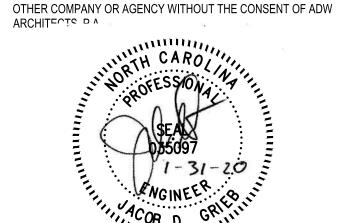

SHALL NOT BE USED ON ANY OTHER PROJECT OR GIVEN TO ANY

PIPE		PIPE	PIPE	PIPE
NO.	MATERIAL	SIZE	LENGTH	SLOPE
		in	ft	ft/ft
1	HDPE	12	30	0.0100
2	HDPE	12	75	0.0100
3	HDPE	12	33	0.0100
4	HDPE	12	70	0.0154
5	HDPE	12	25	0.0100
6	HDPE	12	39	0.0100
7	HDPE	12	88	0.0100
8	HDPE	12	30	0.0100
9	HDPE	12	30	0.0100
10	HDPE	12	59	0.0100
11	HDPE	12	117	0.0100
12	HDPE	15	51	0.0800
13	HDPE	15	41	0.0100
14	HDPE	15	67	0.0100
15	HDPE	12	20	0.0465
16	HDPE	12	87	0.0206

SEE SHEET C401 FOR STORMWATER NOTES AND DETAILS.

SEE SHEET C101 FOR GRADING AND STORMWATER NOTES.

CONTRACTOR SHALL SLOPE GRADES AWAY FROM BUILDING.


CONTRACTOR SHALL TIE FOUNDATION DRAINS AND ELEVATOR FOUNDATION DRAINS INTO STORMWATER.

SIDEWALKS SHALL HAVE A MAXIMUM CROSS SLOPE OF 1/4" IN 1' (2%) AND A LONGITUDINAL SLOPE OF 1' IN 12' (8.33%).

RETAINING WALLS HAVE BEEN SHOWN SCHEMATICALLY AS AN INDICATION OF GRADE BREAK ONLY. WALL DESIGN SHALL BE PREPARED AT CONTRACTORS EXPENSE. SEE DETAIL SHEET FOR SCHEMATIC WALL

CONTRACTOR SHALL PROVIDE ASBUILT/RECORD DRAWINGS.

SCALE: 1" = 20'-0"

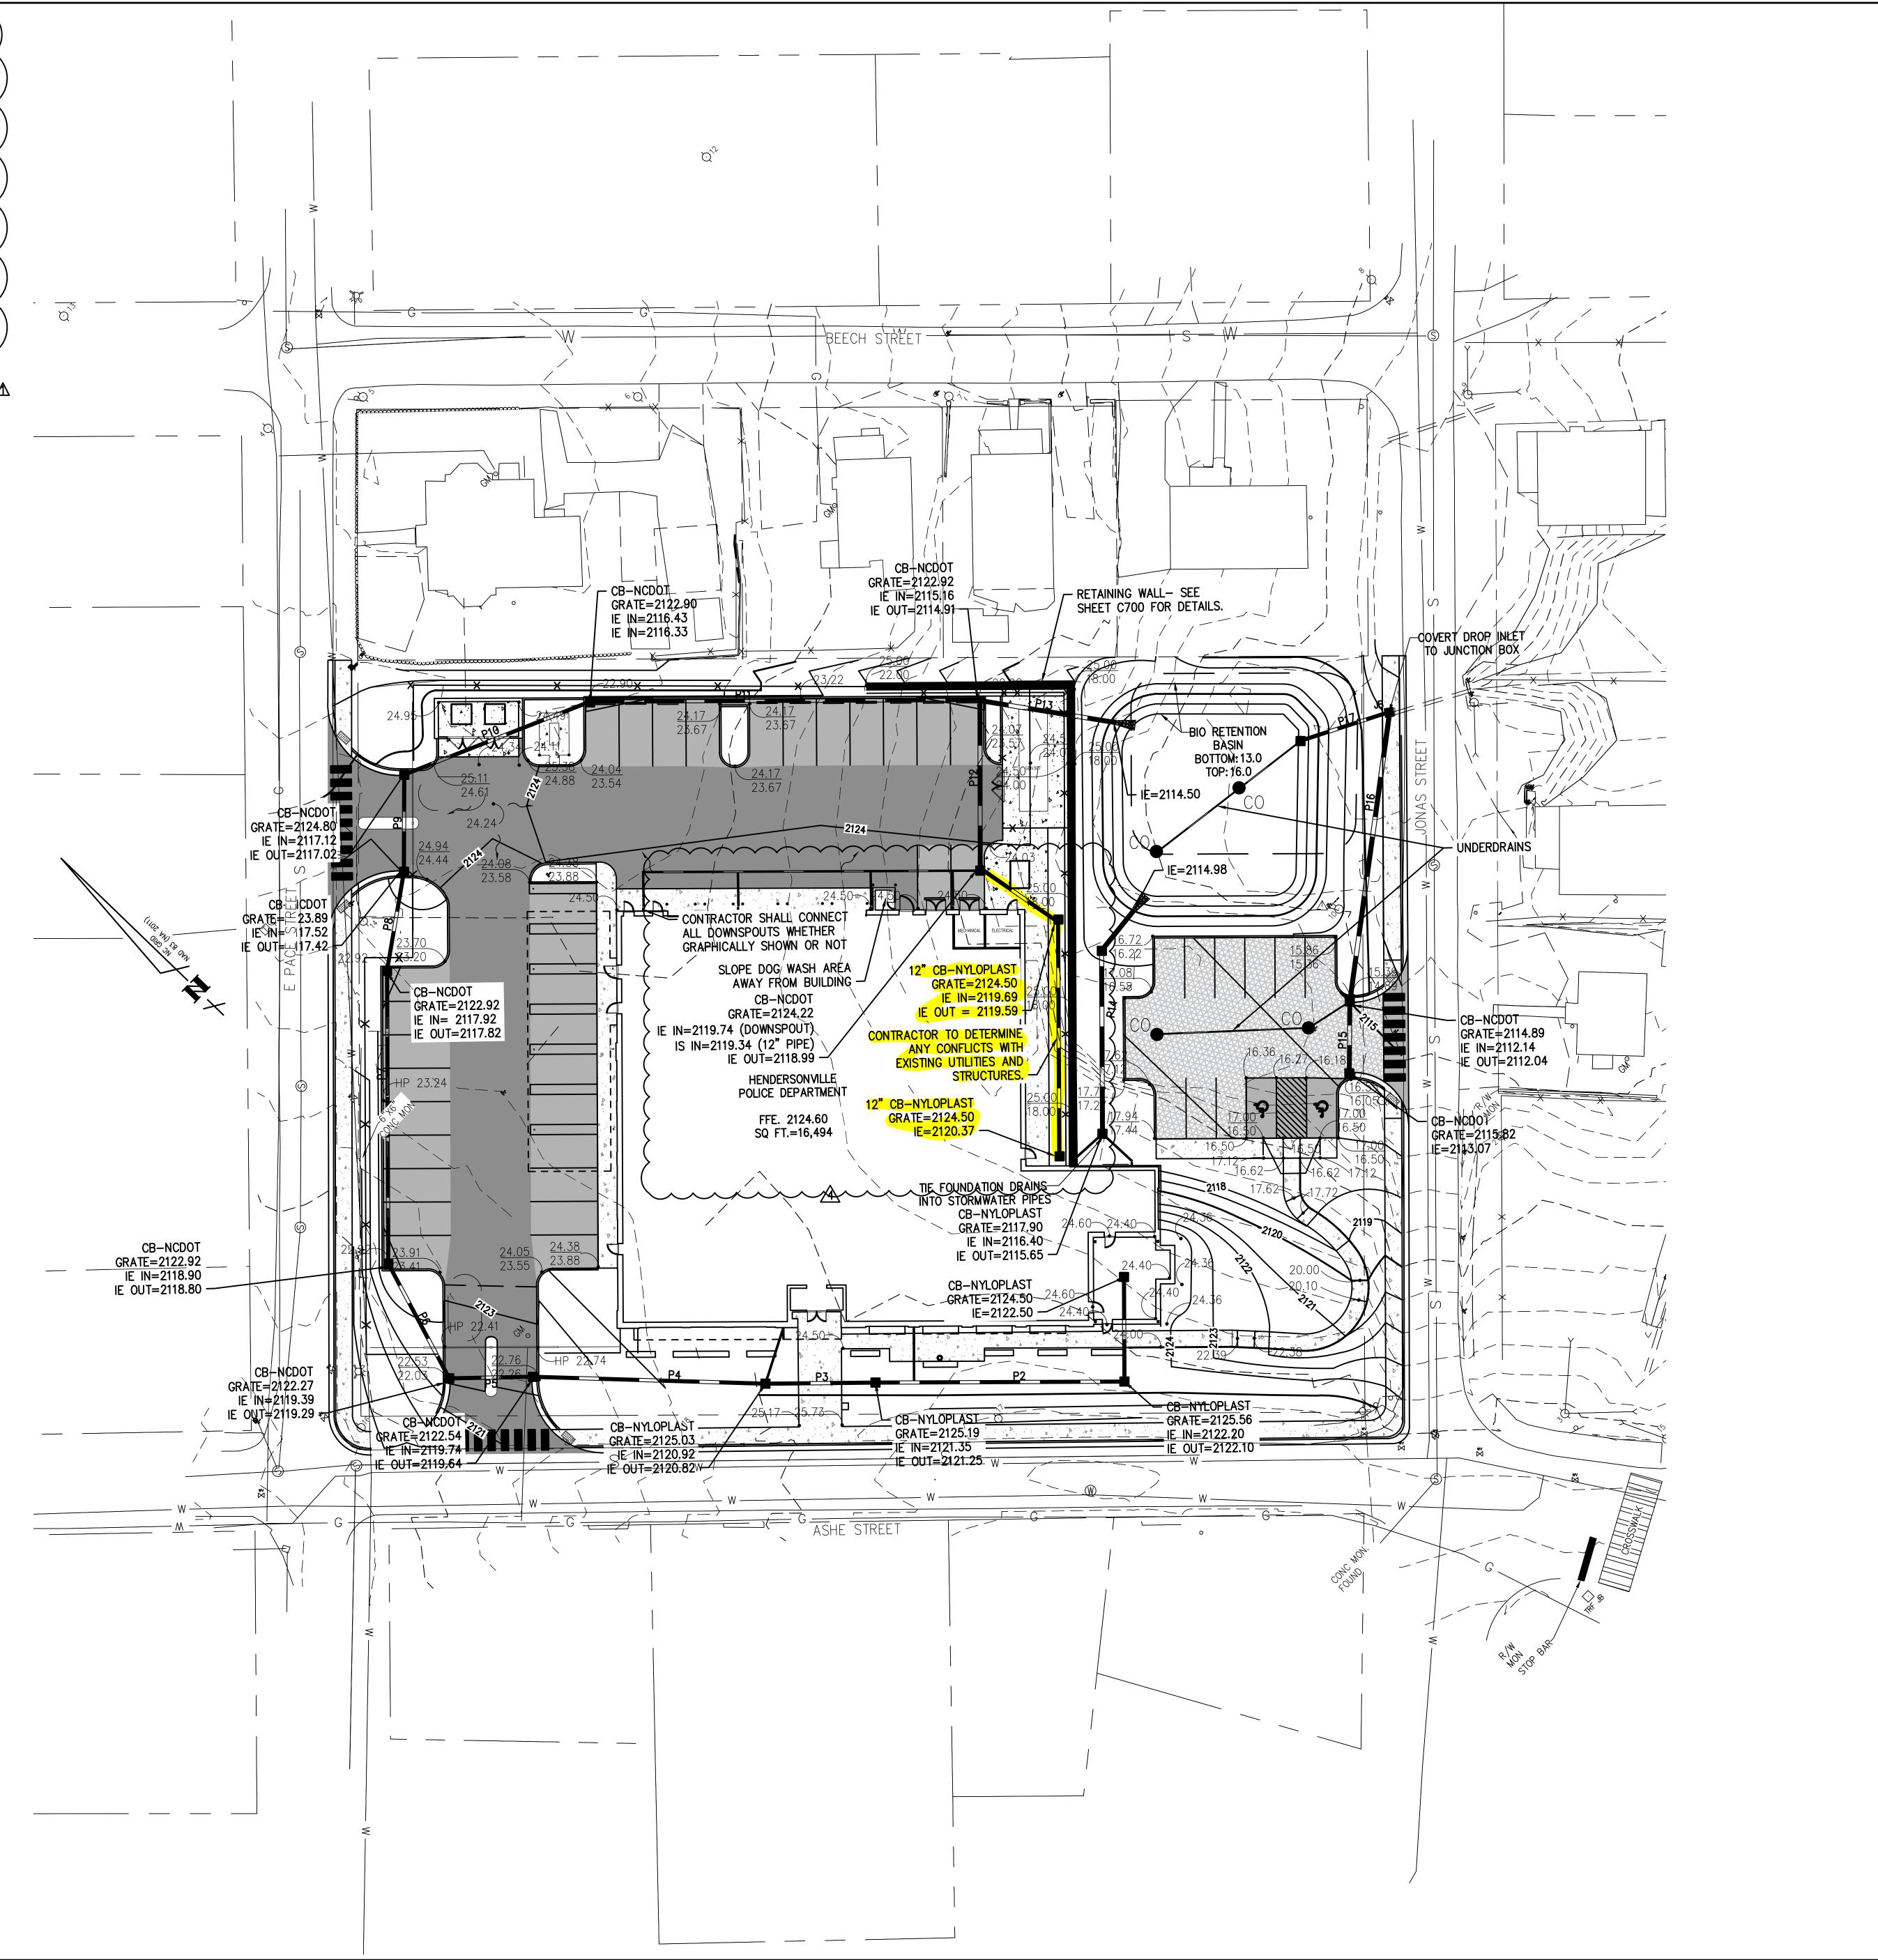

adwarchitects

2815 COLISEUM CENTRE DRIVE SUITE 500

CHARLOTTE, NORTH CAROLINA 28217 P704.379.1919 F704.379.1920 www.adwarchitects.com







Hendersonville Police Department

630 Ashe Street Hendersonville, NC 28792

100% CONSTRUCTION DRAWINGS

09-09-2019

17032

GRADING & STORM WATER PLAN

PROJECT NO:

REVISIONS

REVISIONS					
NO:	DATE:	DESCRIPTION:			
\triangle	12/30/19	NCDEQ			
<u> </u>	1/6/2020	NCDEQ			
4	3/18/21	CONTRACTOR			

THIS DRAWING IS THE PROPERTY OF ADW ARCHITECTS, P.A. AND SHALL NOT BE REPRODUCED OR COPIED IN WHOLE OR PART. IT SHALL NOT BE USED ON ANY OTHER PROJECT OR GIVEN TO ANY OTHER COMPANY OR AGENCY WITHOUT THE CONSENT OF ADW ARCHITECTS DA

