

## **GENERAL NOTES**

- CONTRACTOR TO NOTIFY TENANT, A MINIMUM OF TWO (2) WEEKS PRIOR TO SLAB POUR FOR COORDINATION.
- CONTRACTOR TO PROVIDE FOUNDATION VERIFY EXACT LOCATION; SPECIFICATIONS AND ANCHOR BOLT LAYOUTS WITH INTERIOR PACKAGE, SKIN VENDORS.
- FIRE HYDRANT WITHIN 400' OF ALL PORTIONS OF THE BUILDING.
- GENERAL CONTRACTOR SHALL DELIVER A LEVEL AND SMOOTH CONCRETE SLAB FREE OF LEVELING PRODUCTS WITH NOT MORE THAN ONE QUARTER (1/4") VARIATION IN TEN FEET (10'). ALL EXPANSION AND CONTROL JOINTS SHALL BE PROPERLY INSTALLED AND SHALL BE READY TO ACCEPT TENANT'S FLOOR FINISHES. FLOOR SLAB SHALL BE BROOM CLEAN, FREE OF TRASH AND DEBRIS.
- REVIEW DOCUMENTS, VERIFY DIMENSIONS AND FIELD CONDITIONS, AND CONFIRM THAT WORK IS BUILDABLE AS SHOWN. REPORT ANY CONFLICTS OR OMISSIONS TO THE ARCHITECT FOR CLARIFICATION PRIOR TO PERFORMING ANY WORK IN QUESTION.
- DO NOT SCALE DRAWINGS. IF DIMENSIONS ARE IN QUESTION, THE CONTRACTOR SHALL BE RESPONSIBLE FOR OBTAINING CLARIFICATIONS
- FROM THE ARCHITECT. PARTITIONS ARE DIMENSIONED FROM FINISH FACE TO FINISH FACE, U.N.O. MAINTAIN DIMENSIONS MARKED CLEAR. ALLOW FOR THE THICKNESS OF
- ALL CONSTRUCTION TO COMPLY WITH ALL APPLICABLE STATE AND LOCAL BUILDING CODES, REGULATIONS, AND CITY ORDINANCES.
- REFER TO SHEET A601 FOR DOOR/FRAME/HARDWARE TYPES AND
- ALL NEW DOORS TO HAVE TAS COMPLIANT LEVER HARDWARE SETS, U.N.O.
- REFER TO A601 FOR DOOR/HARDWARE SCHEDULES. CAULK AT JUNCTURE OF INTERIOR FACES OF DOOR FRAMES, VIEW WINDOW
- W/ADJACENT MATERIALS EVEN THOUGH JOINT MAY NOT BE VISIBLE. GC TO PROVIDE HM DOORS AND FRAMES, AS NEEDED, ON REAR OF BUILDING; VERIFY WITH OWNER FOR DOOR LOCATIONS PRIOR TO INSTALL.
- REFER TO CIVIL DWGS FOR SIDEWALK AND CURB DIMENSIONS.

## SITE PLAN KEYNOTES

LANDSCAPED AREA , RE: LANDSCAPE DWGS

EXISTING SIDE WALK ACCESSIBLE ROUTE STRIPING, RE:D2/A031 4 ACCESSIBLE PARKING STALLS, RE: A1/031 AND A2/A031

6 ROOF ACCESS LADDER, RE: A3/A314 PROPERTY LINE, TYP. NEW CONCRETE SIDEWALK, RE: CIVIL

PREFABRICATED METAL CANOPY ABOVE, TYP., RE: SECTIONS 10 TRASH ENCLOSURE, RE: A1/A032

11 ADA RAMP, RE:D1/A031 12 FIRE RISER ROOM

ELECTRICAL GUTTER LOCATION, RE: ELECTRICAL DWGS FIRE RISER ROOM, RE:MEP FOR DETAILS

LIGHT POLE INSTALL 3"-0" BEHIND CURB, U.N.O., RE: 14 STRUCTURAL AND MEP FOR SPECS AND FOUNDATION, RE: ELECTRICAL

15 PERGOLA RE: STRUCTURAL 16 WHEELSTOP, RE: C3/A031

17 TYPICAL 6" CONCRETE CURB, RE: CIVIL DRAWINGS TYPICAL 18" CONCRETE CURB & LANDING @ ADJACENT LANDSCAPE AREA, RE: CIVIL DWGS

19 POLE MOUNTED ACCESSIBILITY SIGN, RE: A4/A031 20 PROPOSED FIRE LANE RE: CIVIL 21 STAMPED CONCRETE

SCHEDULED PREFINISHED ROOF GUTTER & DOWNSPOUT,RE:B2 & C1/A521

JURISDICTION

PARKING SYNOPSIS

PAD D (2.35 AC) RETAIL (@4PS / 1K)

PS REQ'D PS PROVIDED

115 PS (@5.7 PS / 1K)

443957 SF (+- 10.1 AC) IOWA COLONY, TEXAS

SITE PLAN LEGEND PROPERTY LINE **EASEMENTS** 

the cessation of such construction or building being seized and razed.

© 2023 IDENTITY ARCHITECTS INC.

Under the Copyright Act, 17 U.S.C. as amended December 1, 1990, also known as the

"Architectural Works Protection Act of 1990", these documents are copyrighted and are subject to copyright protection as an "Architectural Work". The design, spatial forms,

ideas, compositions and arrangement of items delineated in this set of plans are proprietary of Identity Architects. unauthorized use of these plans can legally result in

ALJ Lindsey, LLC 5629 FM 1960 West, Suite 314 Houston, TX 77069 Phone (281) 301-5955

OWNER:

Chris Merchant

Malabar Hill Capital LLC 6003 Isla Vista Ct. Houston, TX 77041

CERTIFICATION AND SEAL THIS DOCUMENT SET IS "NOT INTENDED FOR REGULATORY APPROVAL,

PERMITTING, PRICING, OR CONSTRUCTION".

KEENON RAYNER TX REG. # 18268

STRUCTURE:

CJG Engineers 3200 Wilcrest Drive, Suite 305 Houston, TX 77042 Phone (713) 780-3345 Fax (713) 780-3712

CMB Landscape Architecture, L Navasota, TX 77868 Phone (832) 428-1209 Charles Bridges

**LANDSCAPE:** ASEI Engineering 350 Glenborough Dr. Suite 270 Houston, TX 77067 Phone (713) 300-9579, ext. 108

REVISION ISSUE

PROJECT NAME AND ADDRESS:

SWC MERIDIANA CRYSTAL VIEW, PAD D SIERRA VISTA

MERIDIANA PKWY AND CRYSTAL VIEW DR. **IOWA COLONY, TX 77583** BRAZORIA COUNTY

DRAWN: MC,PG

REFERENCE NUMBER:

**OVERALL SITE PLAN** 


CHECKED: BC

22122-02

DRAWING NUMBER:

A1 OVERALL SITE PLAN

1" = 20'-0"

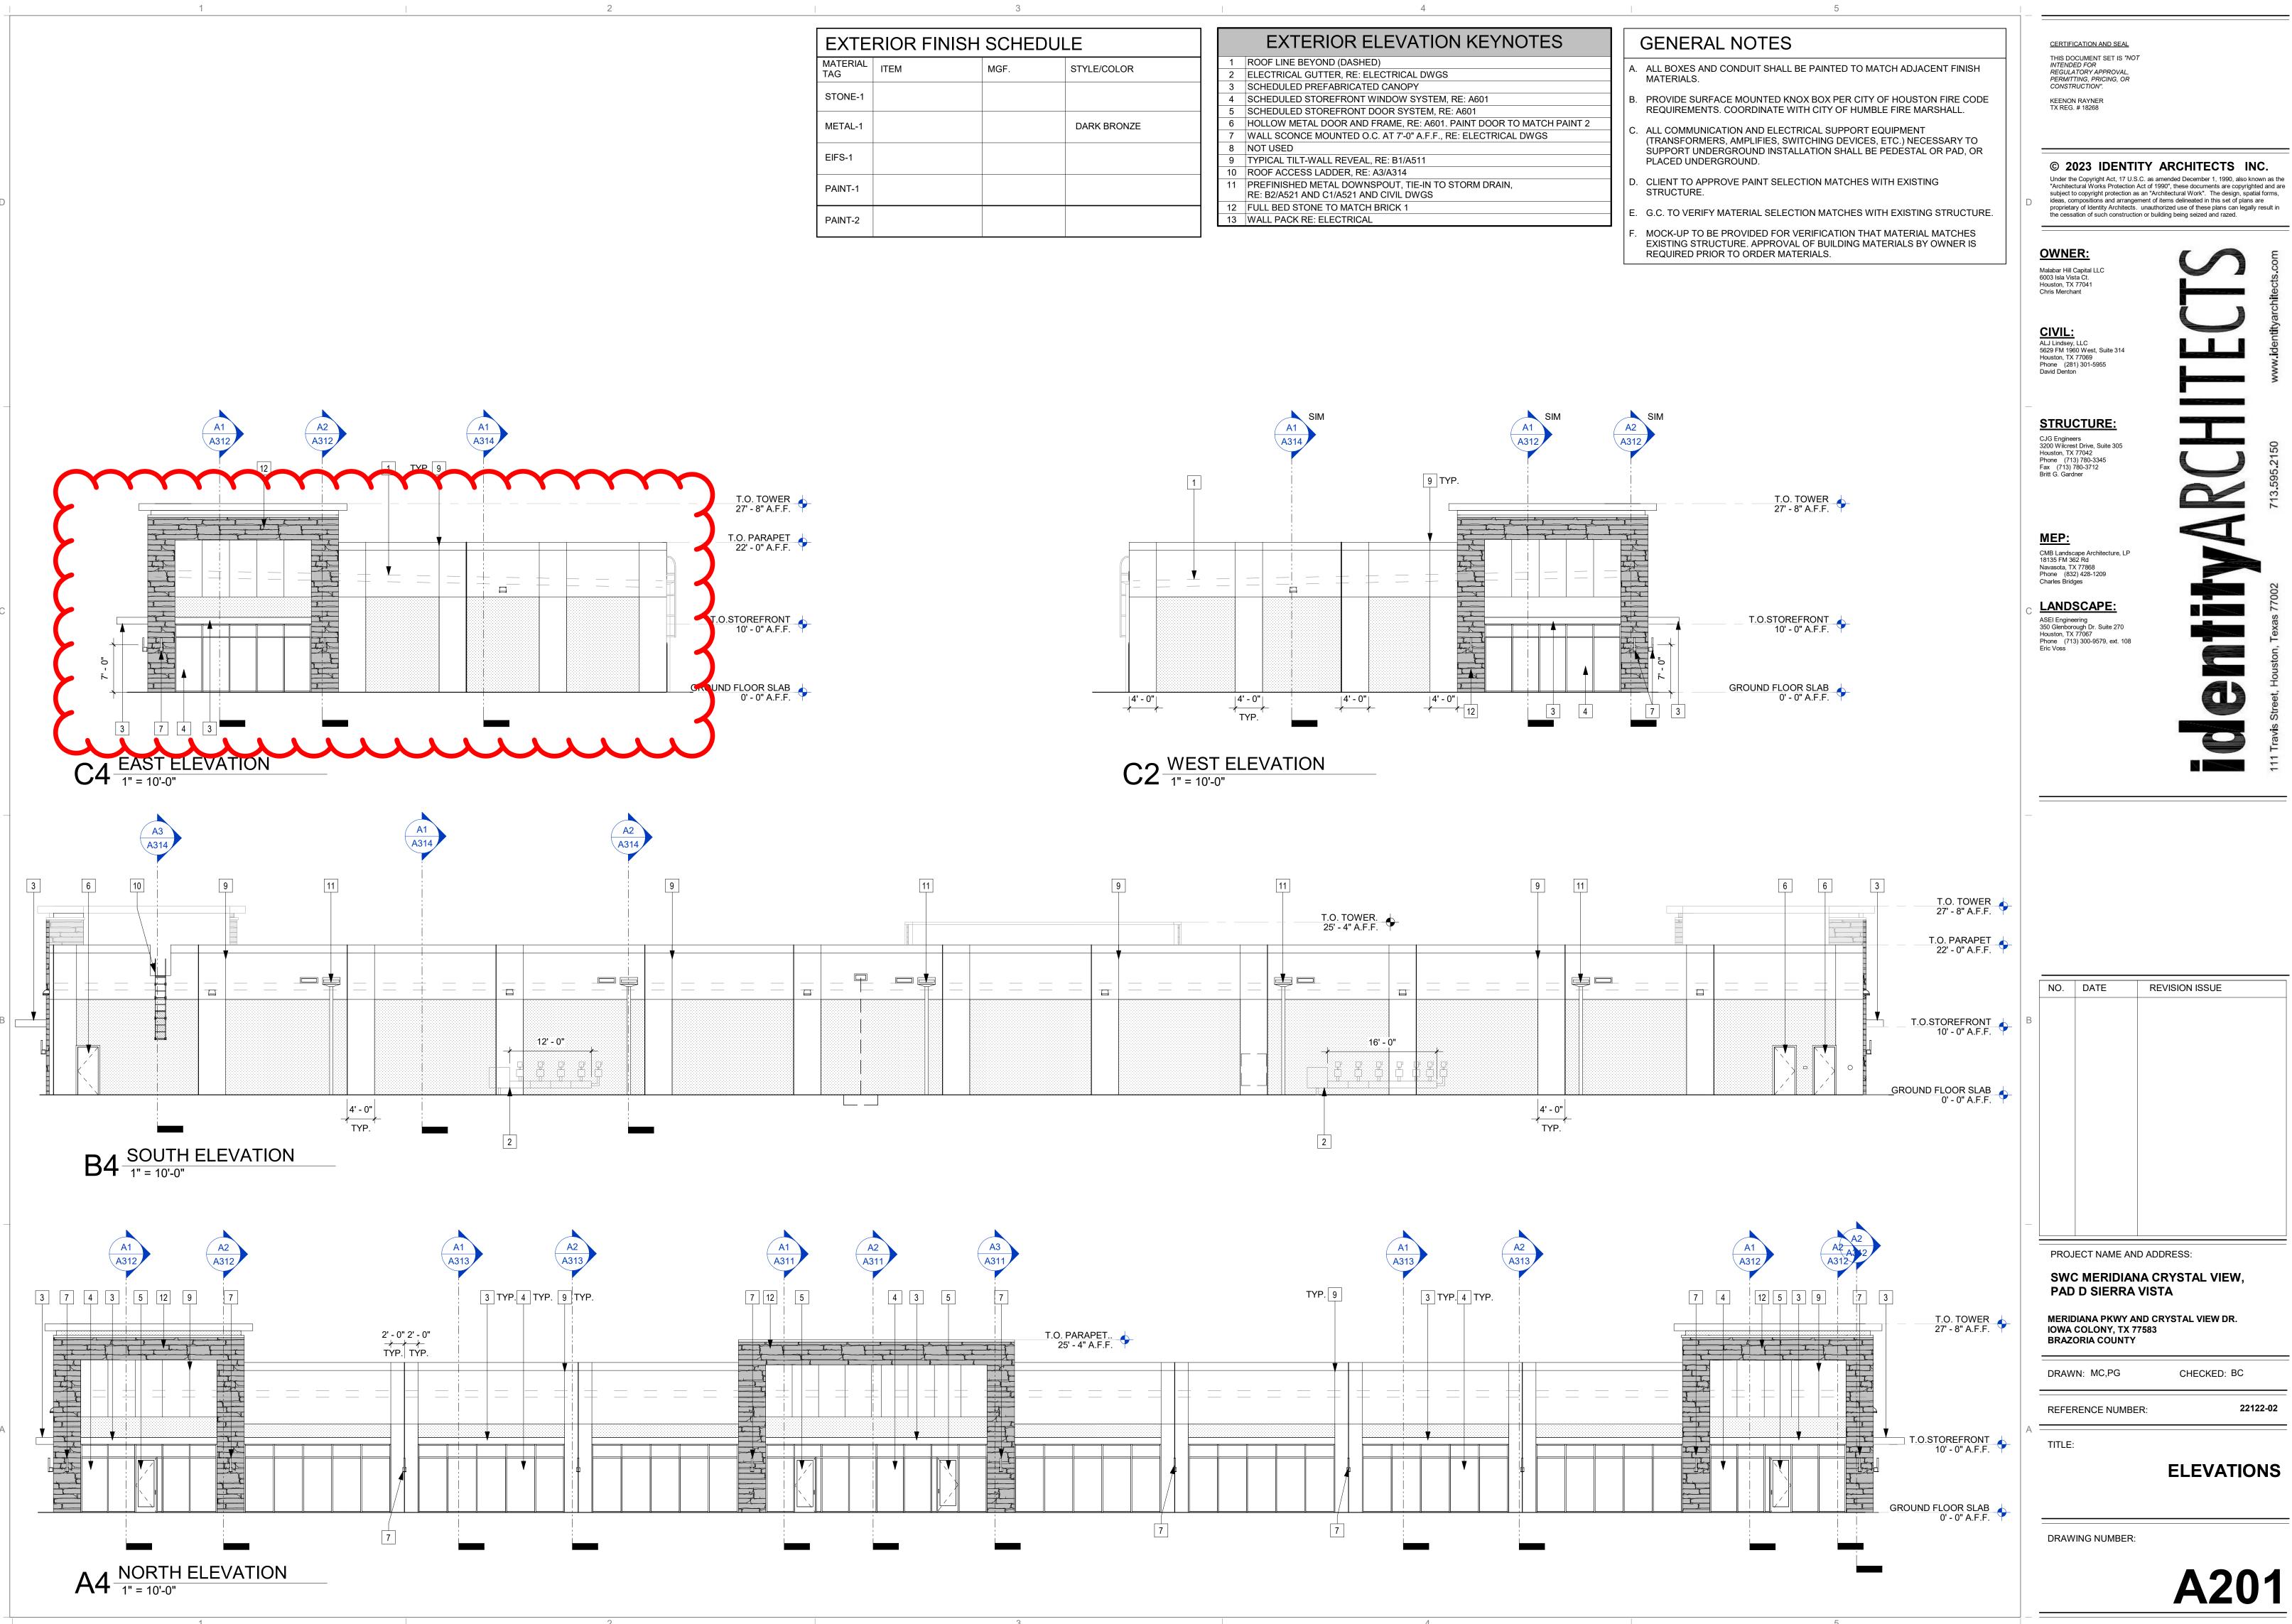

CERTIFICATION AND SEAL

THIS DOCUMENT SET IS "NOT INTENDED FOR REGULATORY APPROVAL, PERMITTING, PRICING, OR CONSTRUCTION".

KEENON RAYNER TX REG. # 18268

© 2023 IDENTITY ARCHITECTS INC. Under the Copyright Act, 17 U.S.C. as amended December 1, 1990, also known as the

Malabar Hill Capital LLC

Houston, TX 77069 Phone (281) 301-5955

**STRUCTURE:** 

CJG Engineers 3200 Wilcrest Drive, Suite 305 Houston, TX 77042 Phone (713) 780-3345 Fax (713) 780-3712

CMB Landscape Architecture, LP 18135 FM 362 Rd Navasota, TX 77868 Phone (832) 428-1209

LANDSCAPE:

ASEI Engineering 350 Glenborough Dr. Suite 270 Houston, TX 77067 Phone (713) 300-9579, ext. 108

REVISION ISSUE

PROJECT NAME AND ADDRESS:

SWC MERIDIANA CRYSTAL VIEW, PAD D SIERRA VISTA

MERIDIANA PKWY AND CRYSTAL VIEW DR. IOWA COLONY, TX 77583 **BRAZORIA COUNTY** 


CHECKED: BC

REFERENCE NUMBER:

**ELEVATIONS** 

22122-02

DRAWING NUMBER:

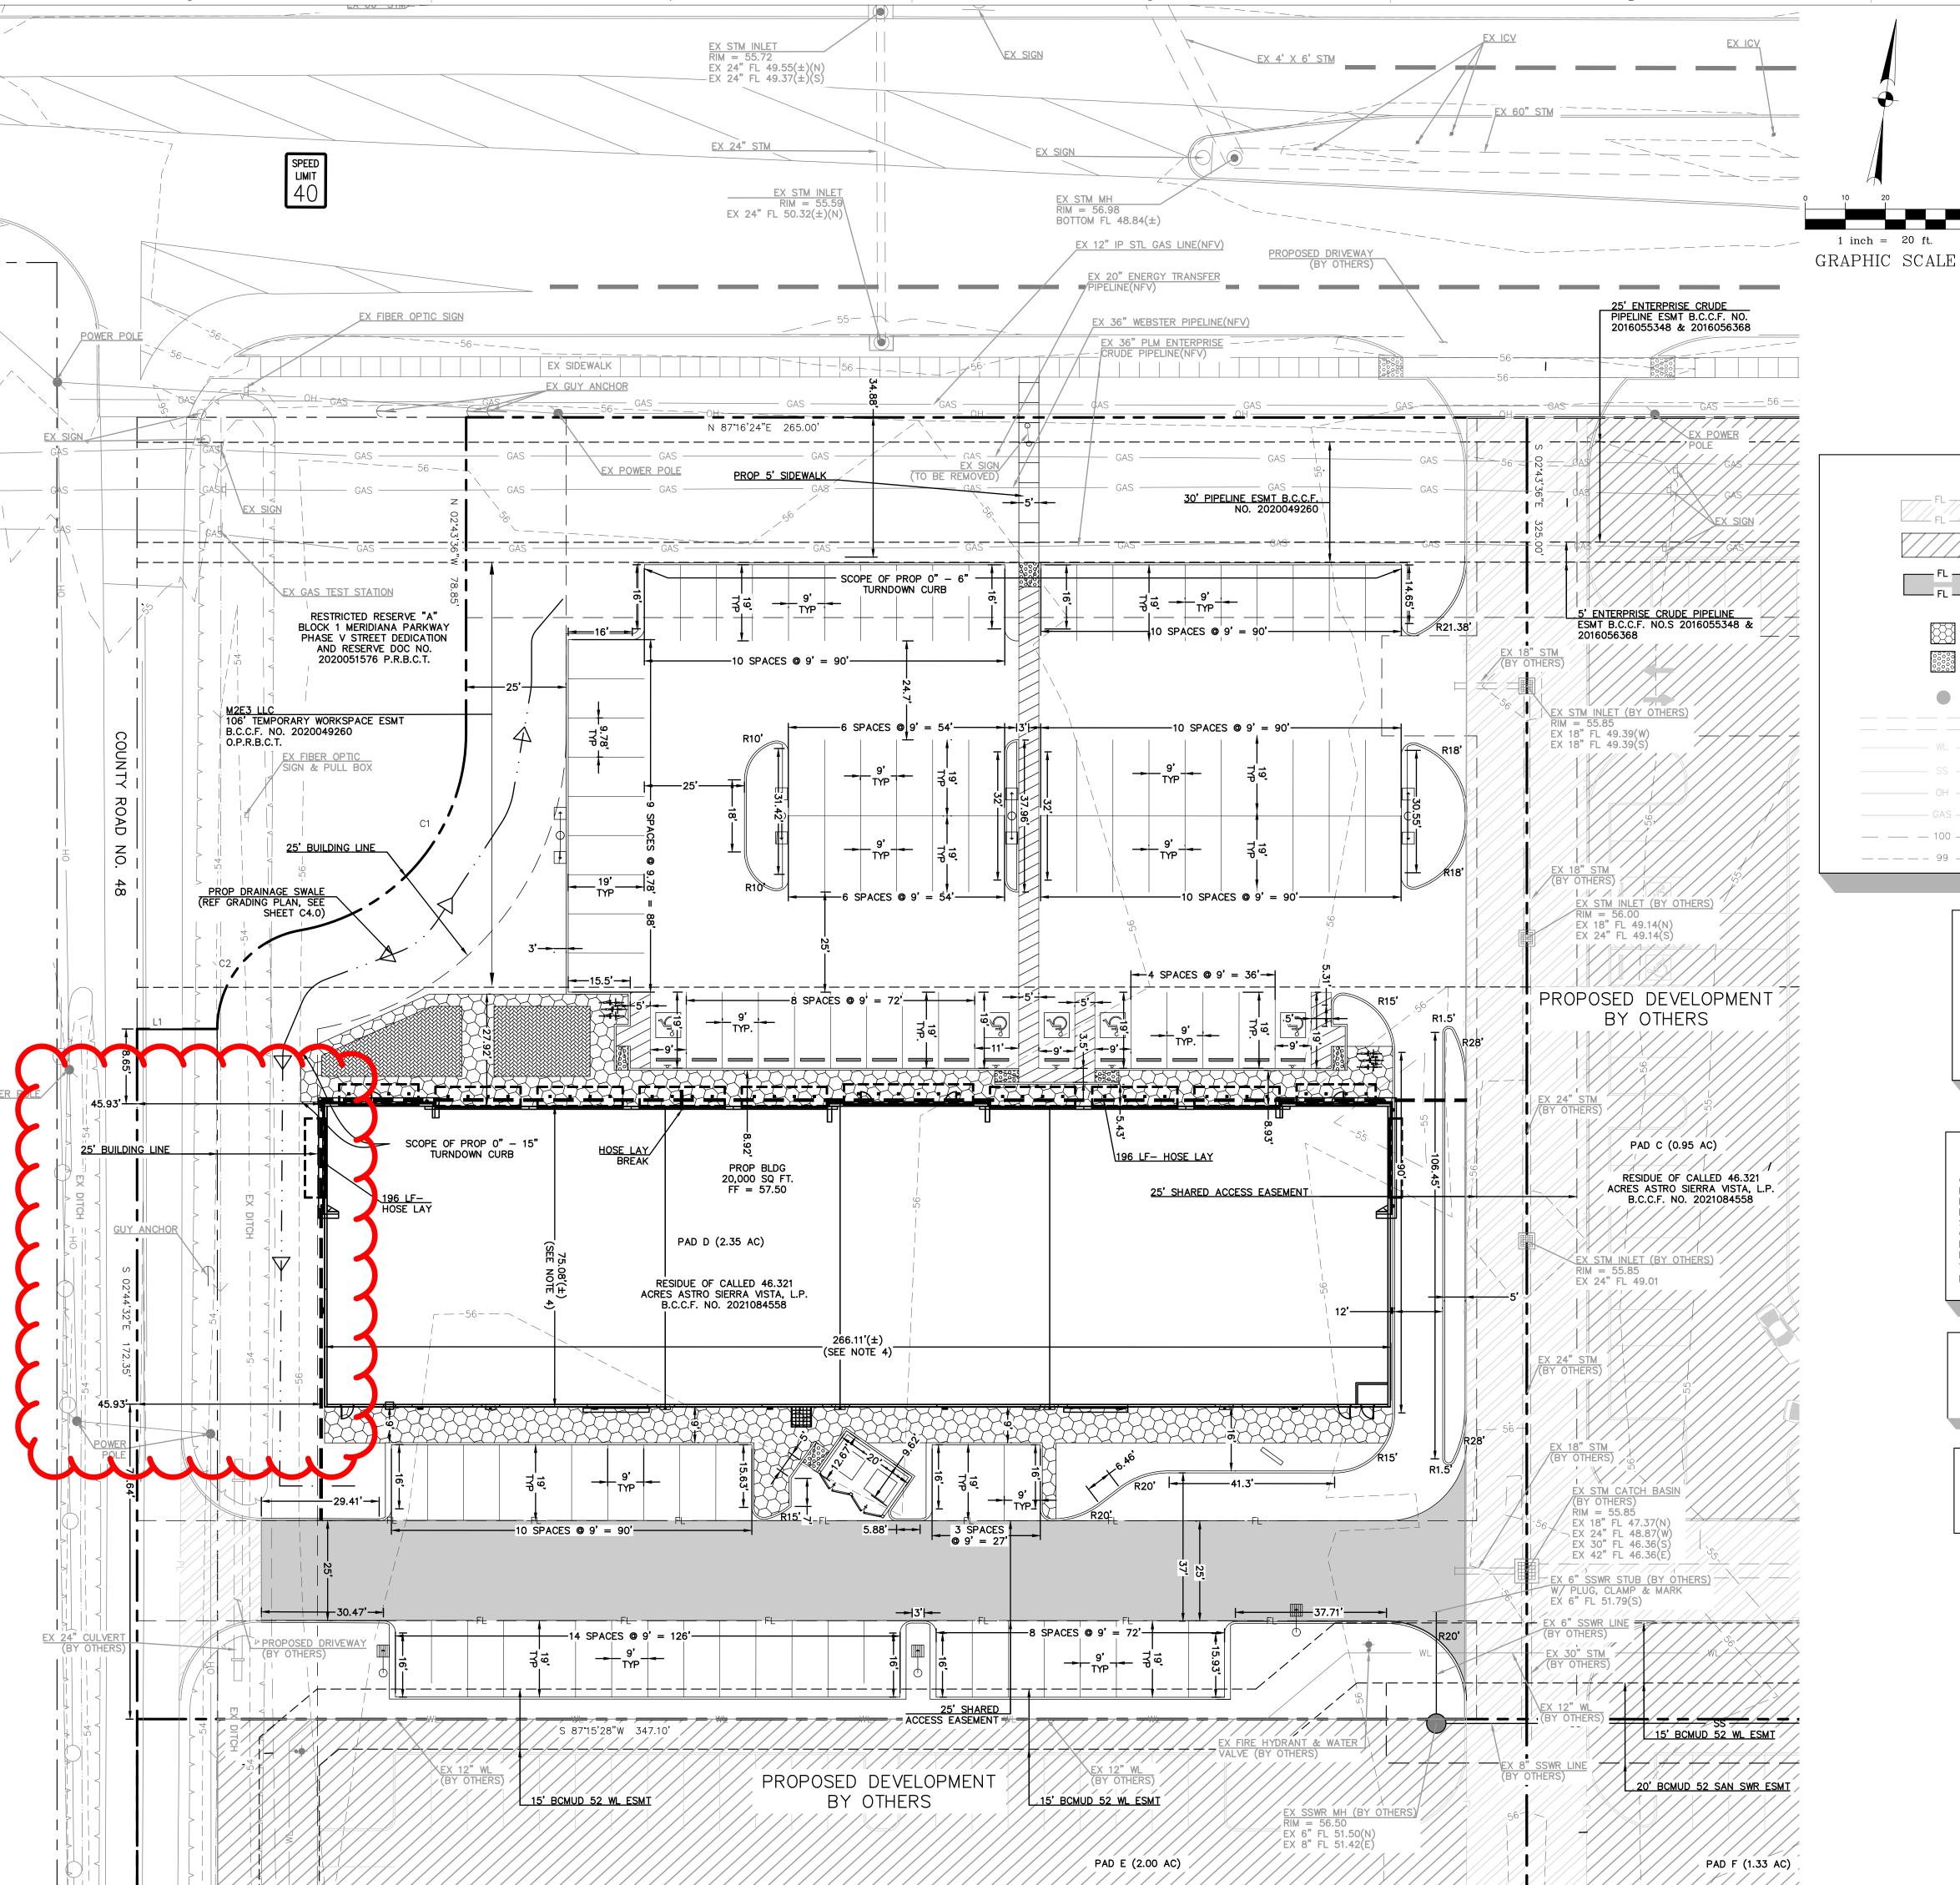

ELEVATIONS HEREON ARE BASED UPON A NGS OPUS SOLUTION DERIVED FROM ACCORDING TO THE NGS OPUS REPORT, THE FOLLOWING CORS STATIONS WERE USED: PID DH3614 DESIGNATION TXLM, PID DG6956 DESIGNATION QWI1, AND PID DE 5999 DESIGNATION ADKS; THE NEAREST NGS PUBLISHED CONTROL POINT IS PID AW4037 DESIGNATION C692. (NAVD88, COMPUTED USING GEOID18)

TEMPORARY BENCHMARK "A": ELEVATION: 51.6
TBM "A" BEING A CUT BOX ON CONCRETE INLET LOCATED APPROXIMATELY ± 380 FEET ON A SOUTHERLY DIRECTION FROM THE INTERSECTION OF THE WEST R.O.W. LINE OF CRYSTAL VIEW DRIVE AND THE SOUTH R.O.W. LINE OF MERIDIANA

TBM "B" BEING A CUT BOX ON CONCRETE INLET LOCATED APPROXIMATELY ± 615 <sup>40</sup> FEET ON A WESTERLY DIRECTION FROM THE INTERSECTION OF THE WEST R.O.W. LINE OF CRYSTAL VIEW DRIVE AND THE NORTH R.O.W. LINE OF MERIDIANA

<u>LEGEND</u>

(BY OTHERS) PROPOSED FIRE LANE (RED STRIPING)

PROPOSED DEVELOPMENT

EXISTING FIRE LANE

(RED STRIPING)

PROPOSED BUILDING PERIMETER SIDEWALK PROPOSED CURB RAMP

> EX. MANHOLE EX. STORM SEWER

EX. WATER LINE EX. SANITARY SEWER LINE

EX. OVERHEAD POWER LINE EX. UNDERGROUND GAS LINE

EX. MAJOR CONTOUR

EX MINOR. CONTOUR

#### **GENERAL NOTES**

- PAVEMENT DIMENSIONS AND RADII ARE FACE TO FACE OF CURB, UNLESS OTHERWISE NOTED.
- 2. RADII ARE 3' UNLESS OTHERWISE NOTED.
- 3. REFER TO SITE ELECTRICAL PLAN FOR PROPOSED SITE LIGHTING LAYOUT.
- REFER TO ARCHITECTURAL PLANS FOR EXACT BUILDING/FOUNDATION DIMENSIONS.

# FIRE LANE MARKING NOTES

CURBS LOCATED ON EITHER SIDE OF A FIRE LANE SHALL BE PAINTED RED OR A RED STRIPE SHALL BE PLACED ALONG THE PAVEMENT WHERE THERE IS NO CURB. WHERE A FIRE LANE PASSES BETWEEN HEAD—IN PARKING SPACES, THE RED STRIPE SHOULD BE PLACED ALONG THE REAR OF THESE SACES CLEARLY DEFINING THE FIRE LANE. PAINTED CURBS AND FIRE LANE STRIPES SHALL ALSO BE CONSPICUOUSLY AND LEGIBLY MARKED WITH THE WARNING "FIRE LANE-TOW AWAY ZONE" IN WHITE LETTERS AT LEAST THREE (3) INCHES IN HEIGHT, AT INTERVALS NOT EXCEEDING (50) FEÉT

MULTIPLE EXISTING PUBLIC AND PRIVATE UTILITY LINES EXIST ON THIS SITE. THE UTILITY LINES SHOWN ON THESE DRAWINGS REFLECT INFORMATION OBTAINED FROM RECORD DRAWINGS AND MAY NOT INCLUDE ALL EXISTING UTILITIES. CONTRACTOR IS TO USE EXTREME CAUTION DURING ALL CONSTRUCTION ACTIVITIES AND IS SOLELY RESPONSIBLE FOR DAMAGE TO EXISTING FACILITIES.

#### BY OTHERS NOTE

FOR DEVELOPED "BY OTHERS", REFERENCE PLANS TITLED "SIERRA VISTA DRIVEWAYS AND UTILITY EXTENSIONS" PREPARED BY IDENTITY ARCHITECTS (JOB NO. 22122-02)

CALL BEFORE YOU DIG TEXAS ONE CALL PARTICIPANTS REQUEST

72 HOURS NOTICE BEFORE YOU DIG, DRILL OR BLAST — STOP CALL

TEXAS ONE CALL SYSTEM 1-800-344-8377

IN HOUSTON (713)-223-4567

DRAWING NUMBER:

C1.0

Under the Copyright Act, 17 U.S.C. as amended December 1, 1990, also known as the "Architectural Works Protection Act of 1990", these documents are copyrighted and are subject to copyright protection as an "Architectural Work". The design, spatial forms, ideas, compositions and arrangement of items delineated in this set of plans are proprietary of Identity Architects. unauthorized use of these plans can legally result in the cessation of such construction or building being seized and razed. Malabar Hill Capital LLC 6003 Isla Vista Ct.

© 2023 IDENTITY ARCHITECTS INC

Houston, TX 77041 Chris Merchant

CIVIL:

ALJ Lindsey, LLC 18635 N. Eldridge Pkwy, Suite 200 Tomball, TX 77377 Phone (281) 301-5955

#### David Denton

STRUCTURAL: 3200 Wilcrest Drive, Suite 305

### LANDSCAPE:

Houston, TX 77042

Phone (713) 780-3345

Fax (713) 780-3712

Britt G. Gardner

CMB Landscape Architecture, LF 18135 FM 362 Rd Navasota, TX 77868 Phone (832) 428-1209 Charles Bridges

ASEI Engineering 350 Glenborough Dr. Suite 270 Houston, TX 77067 Phone (713) 300-9579, ext. 108 Eric Voss

> BRETT T. HANRAHAN 112908

> > 11 JULY 2023

NO. DATE REVISION ISSUE 05.11.23 50% CLIENT REVIEW 06.07.23 90% CLIENT REVIEW 07.10.23 PERMIT ISSUE

PROJECT NAME AND ADDRESS:

SIERRA VISTA PAD D

MERIDIANA PKWY AND CRYSTAL VIEW DR. IOWA COLONY, TX 77583 **BRAZORIA COUNTY** 

CHECKED:

22122-02 REFERENCE NUMBER:

DIMENSION CONTROL **PLAN** 

