
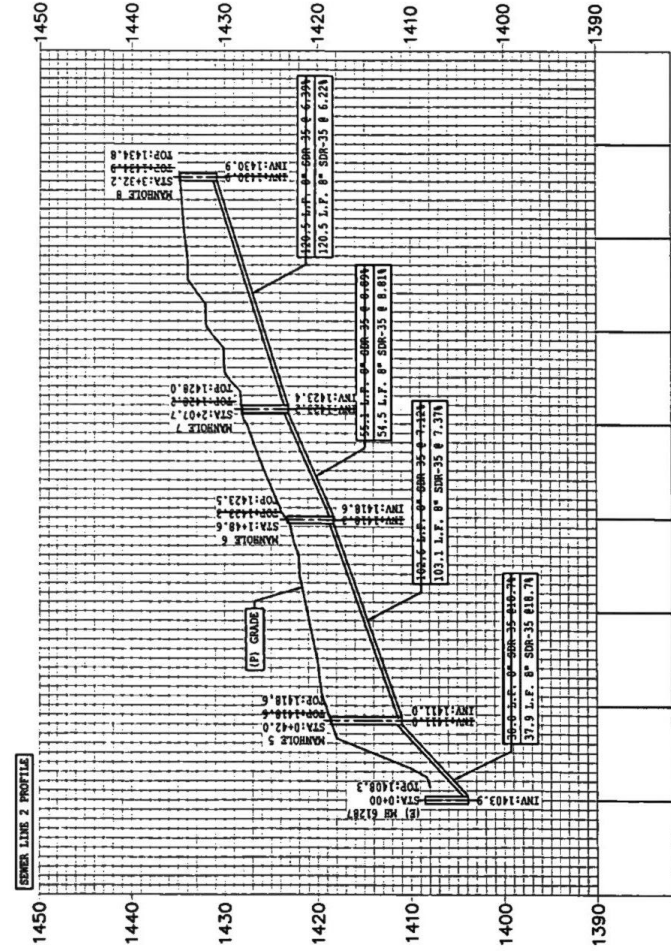
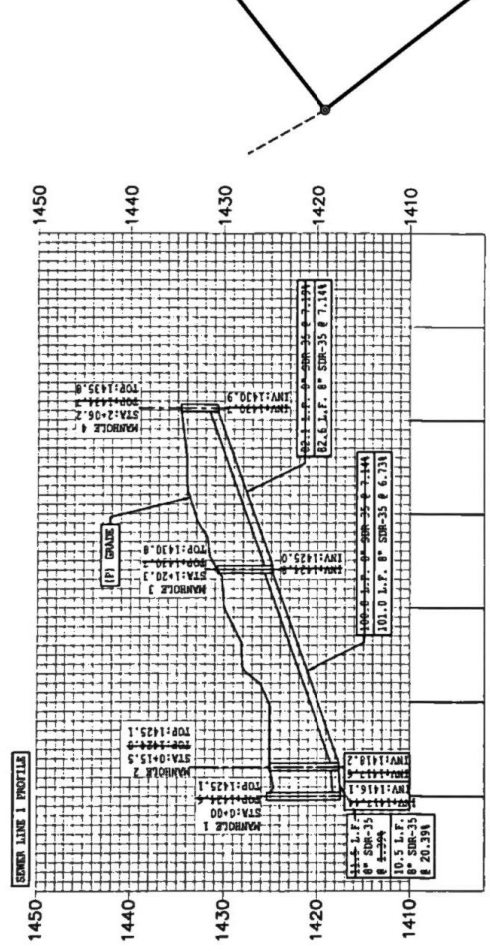



NOTE:
THE PURPOSE OF THIS SURVEY IS TO PROVIDE A POST CONSTRUCTION RECORD OF SANITARY SEWER FEATURES INSTALLED.

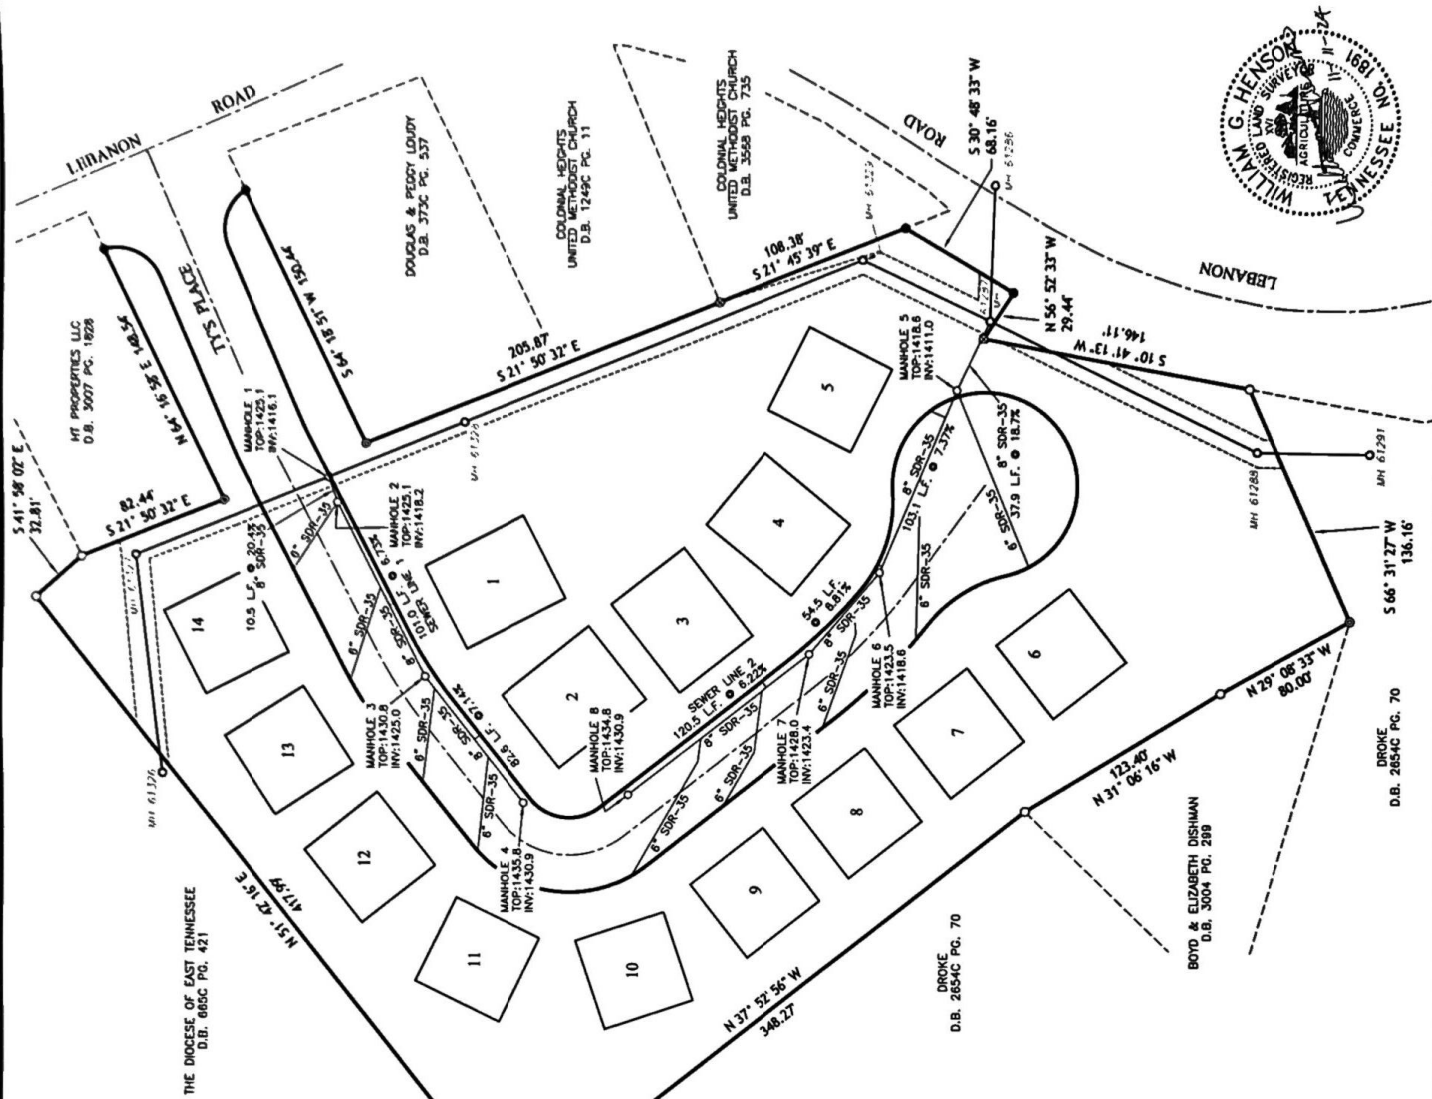

DATE: 11-11-2024
PROJECT NO.: 1792

**SANITARY SEWER RECORD DRAWING
LEBANON MEADOWS SUBDIVISION**

CIVIL DISTRICT: 14TH
COUNTY: SULLIVAN
STATE: TENNESSEE

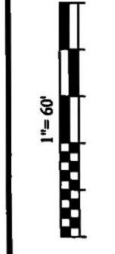

HENSON LAND SURVEYS
404 GLEN OAKS DRIVE
JACKSON CITY, TN 30615
PHONE: (615) 483-9664