



**IRON MOUNTAIN SURVEY CO. INC.**  
 744 ALLISON RD.  
 PINEY FLATS, TN  
 (423) 391-8200



\*ALL ELEVATIONS RELATIVE TO MEAN SEA LEVEL (NAVD88)

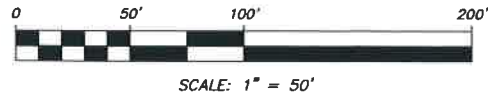

- LEGEND**
- ☒ LIGHT POLE
  - ⊠ WATER METER
  - ⊠ FIBEROPTICS BOX
  - ⊠ ELECTRIC BOX
  - ⊠ TELEPHONE BOX
  - ⊠ CABLE BOX
  - ⊠ WATER VALVE
  - ⊠ FIRE HYDRANT
  - ⊠ MANHOLE (STORM OR SEWER, SEE PLAT)
  - ⊠ STORM DRAIN INLET
  - ⊠ SEWER CLEANOUT
  - ⊠ TRANSFORMER BOX
  - ⊠ AIR RELEASE VALVE
  - O/H UTILITY LINE
  - CENTERLINE (C/L)
  - EASEMENT MARGIN
  - BOUNDARY LINE/ ADJOINER LINE/ R.O.W. MARGIN (NOT SURVEYED UNLESS NOTED)
  - SS SANITARY SEWER LINE
  - GAS GAS PIPELINE
  - STORM DRAINAGE LINE
  - HDPE HIGH-DENSITY POLYETHYLENE PIPE
  - PVC POLYVINYL CHLORIDE PIPE
  - W/ WITH

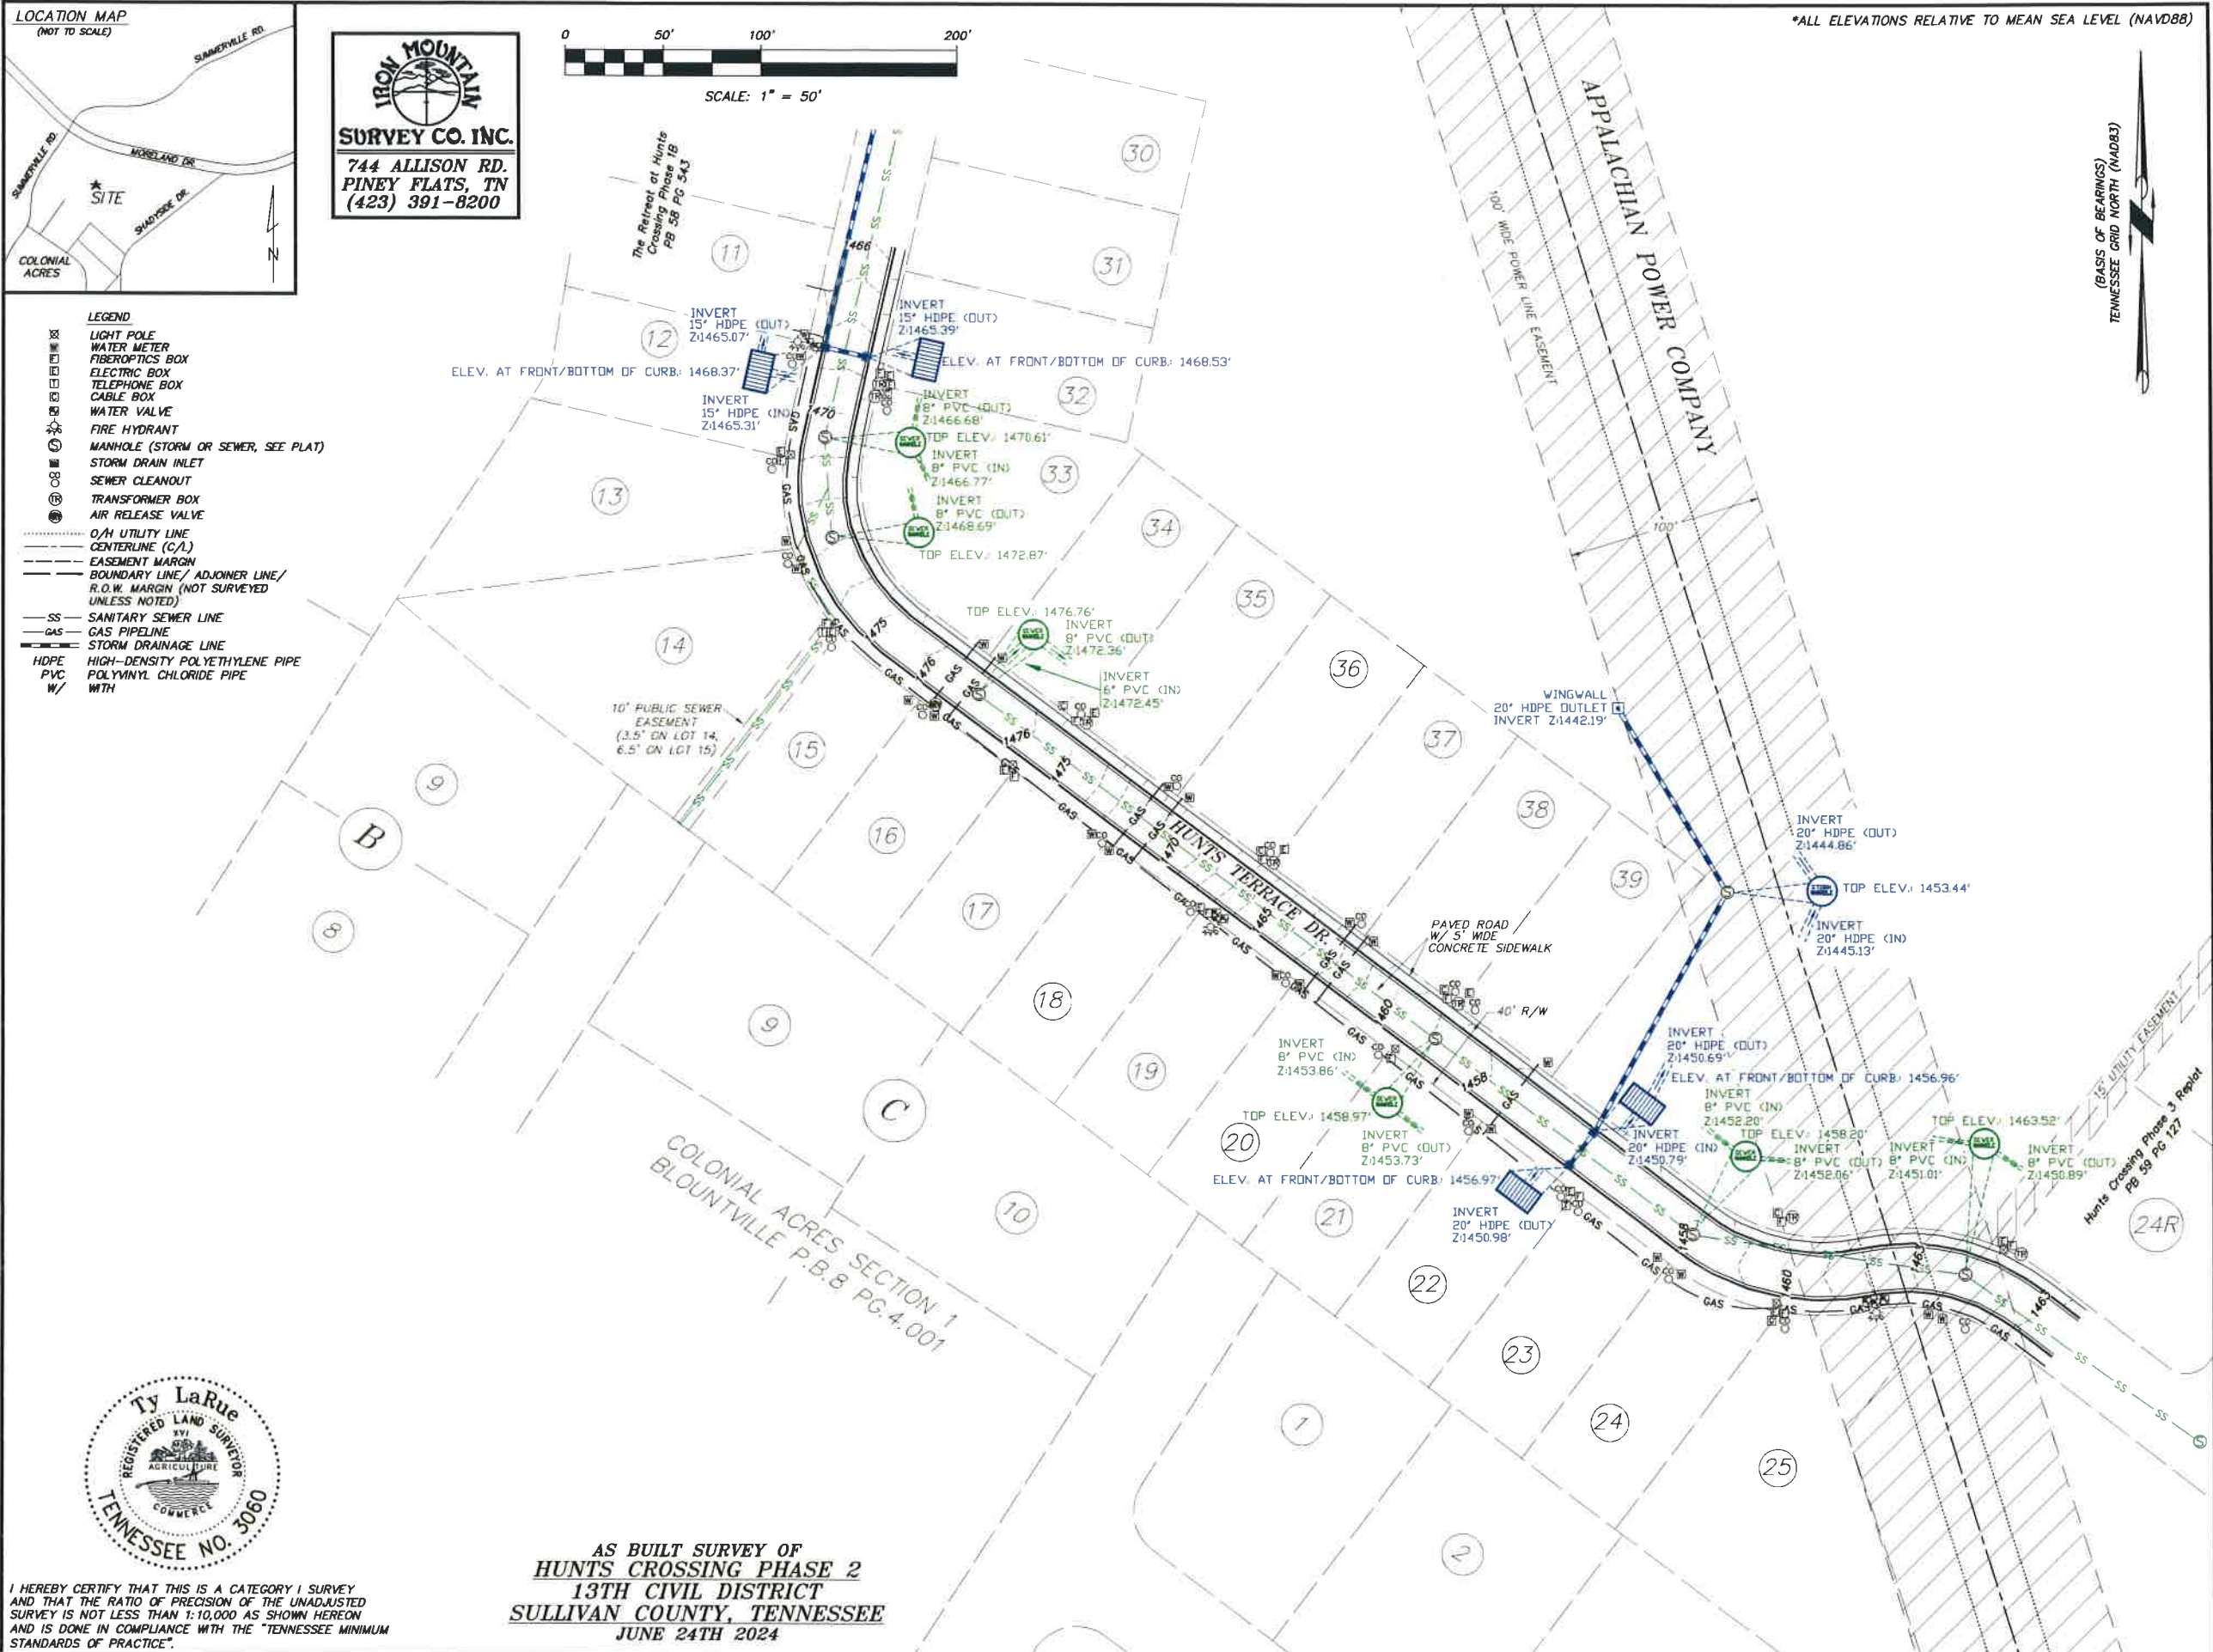

**AS BUILT SURVEY OF  
 HUNTS CROSSING PHASE 2  
 13TH CIVIL DISTRICT  
 SULLIVAN COUNTY, TENNESSEE  
 JUNE 24TH 2024**

I HEREBY CERTIFY THAT THIS IS A CATEGORY I SURVEY AND THAT THE RATIO OF PRECISION OF THE UNADJUSTED SURVEY IS NOT LESS THAN 1:10,000 AS SHOWN HEREON AND IS DONE IN COMPLIANCE WITH THE "TENNESSEE MINIMUM STANDARDS OF PRACTICE".