



SEE NOTE 1

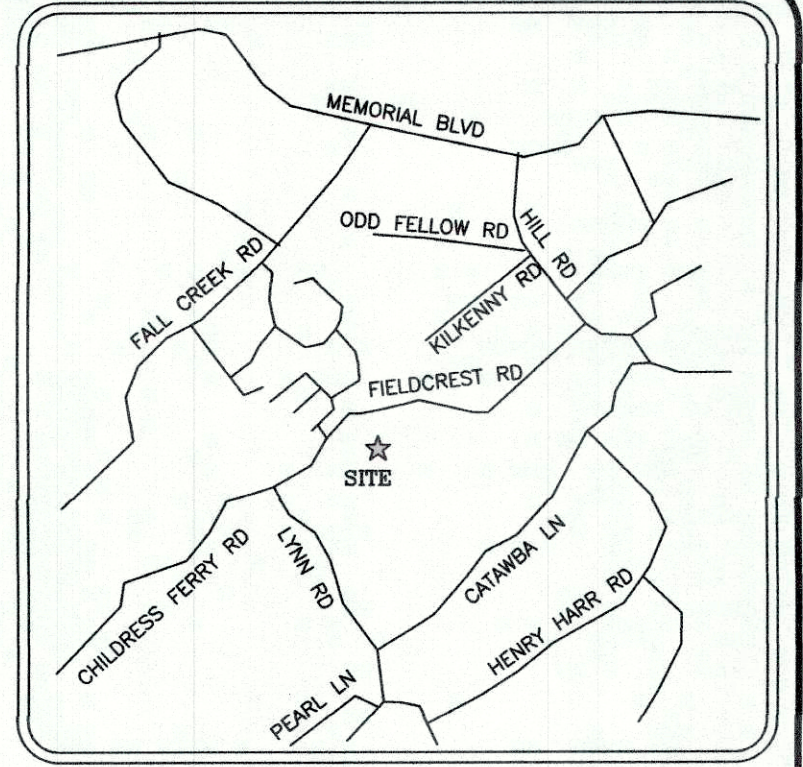

LOCATION MAP
N.T.S.

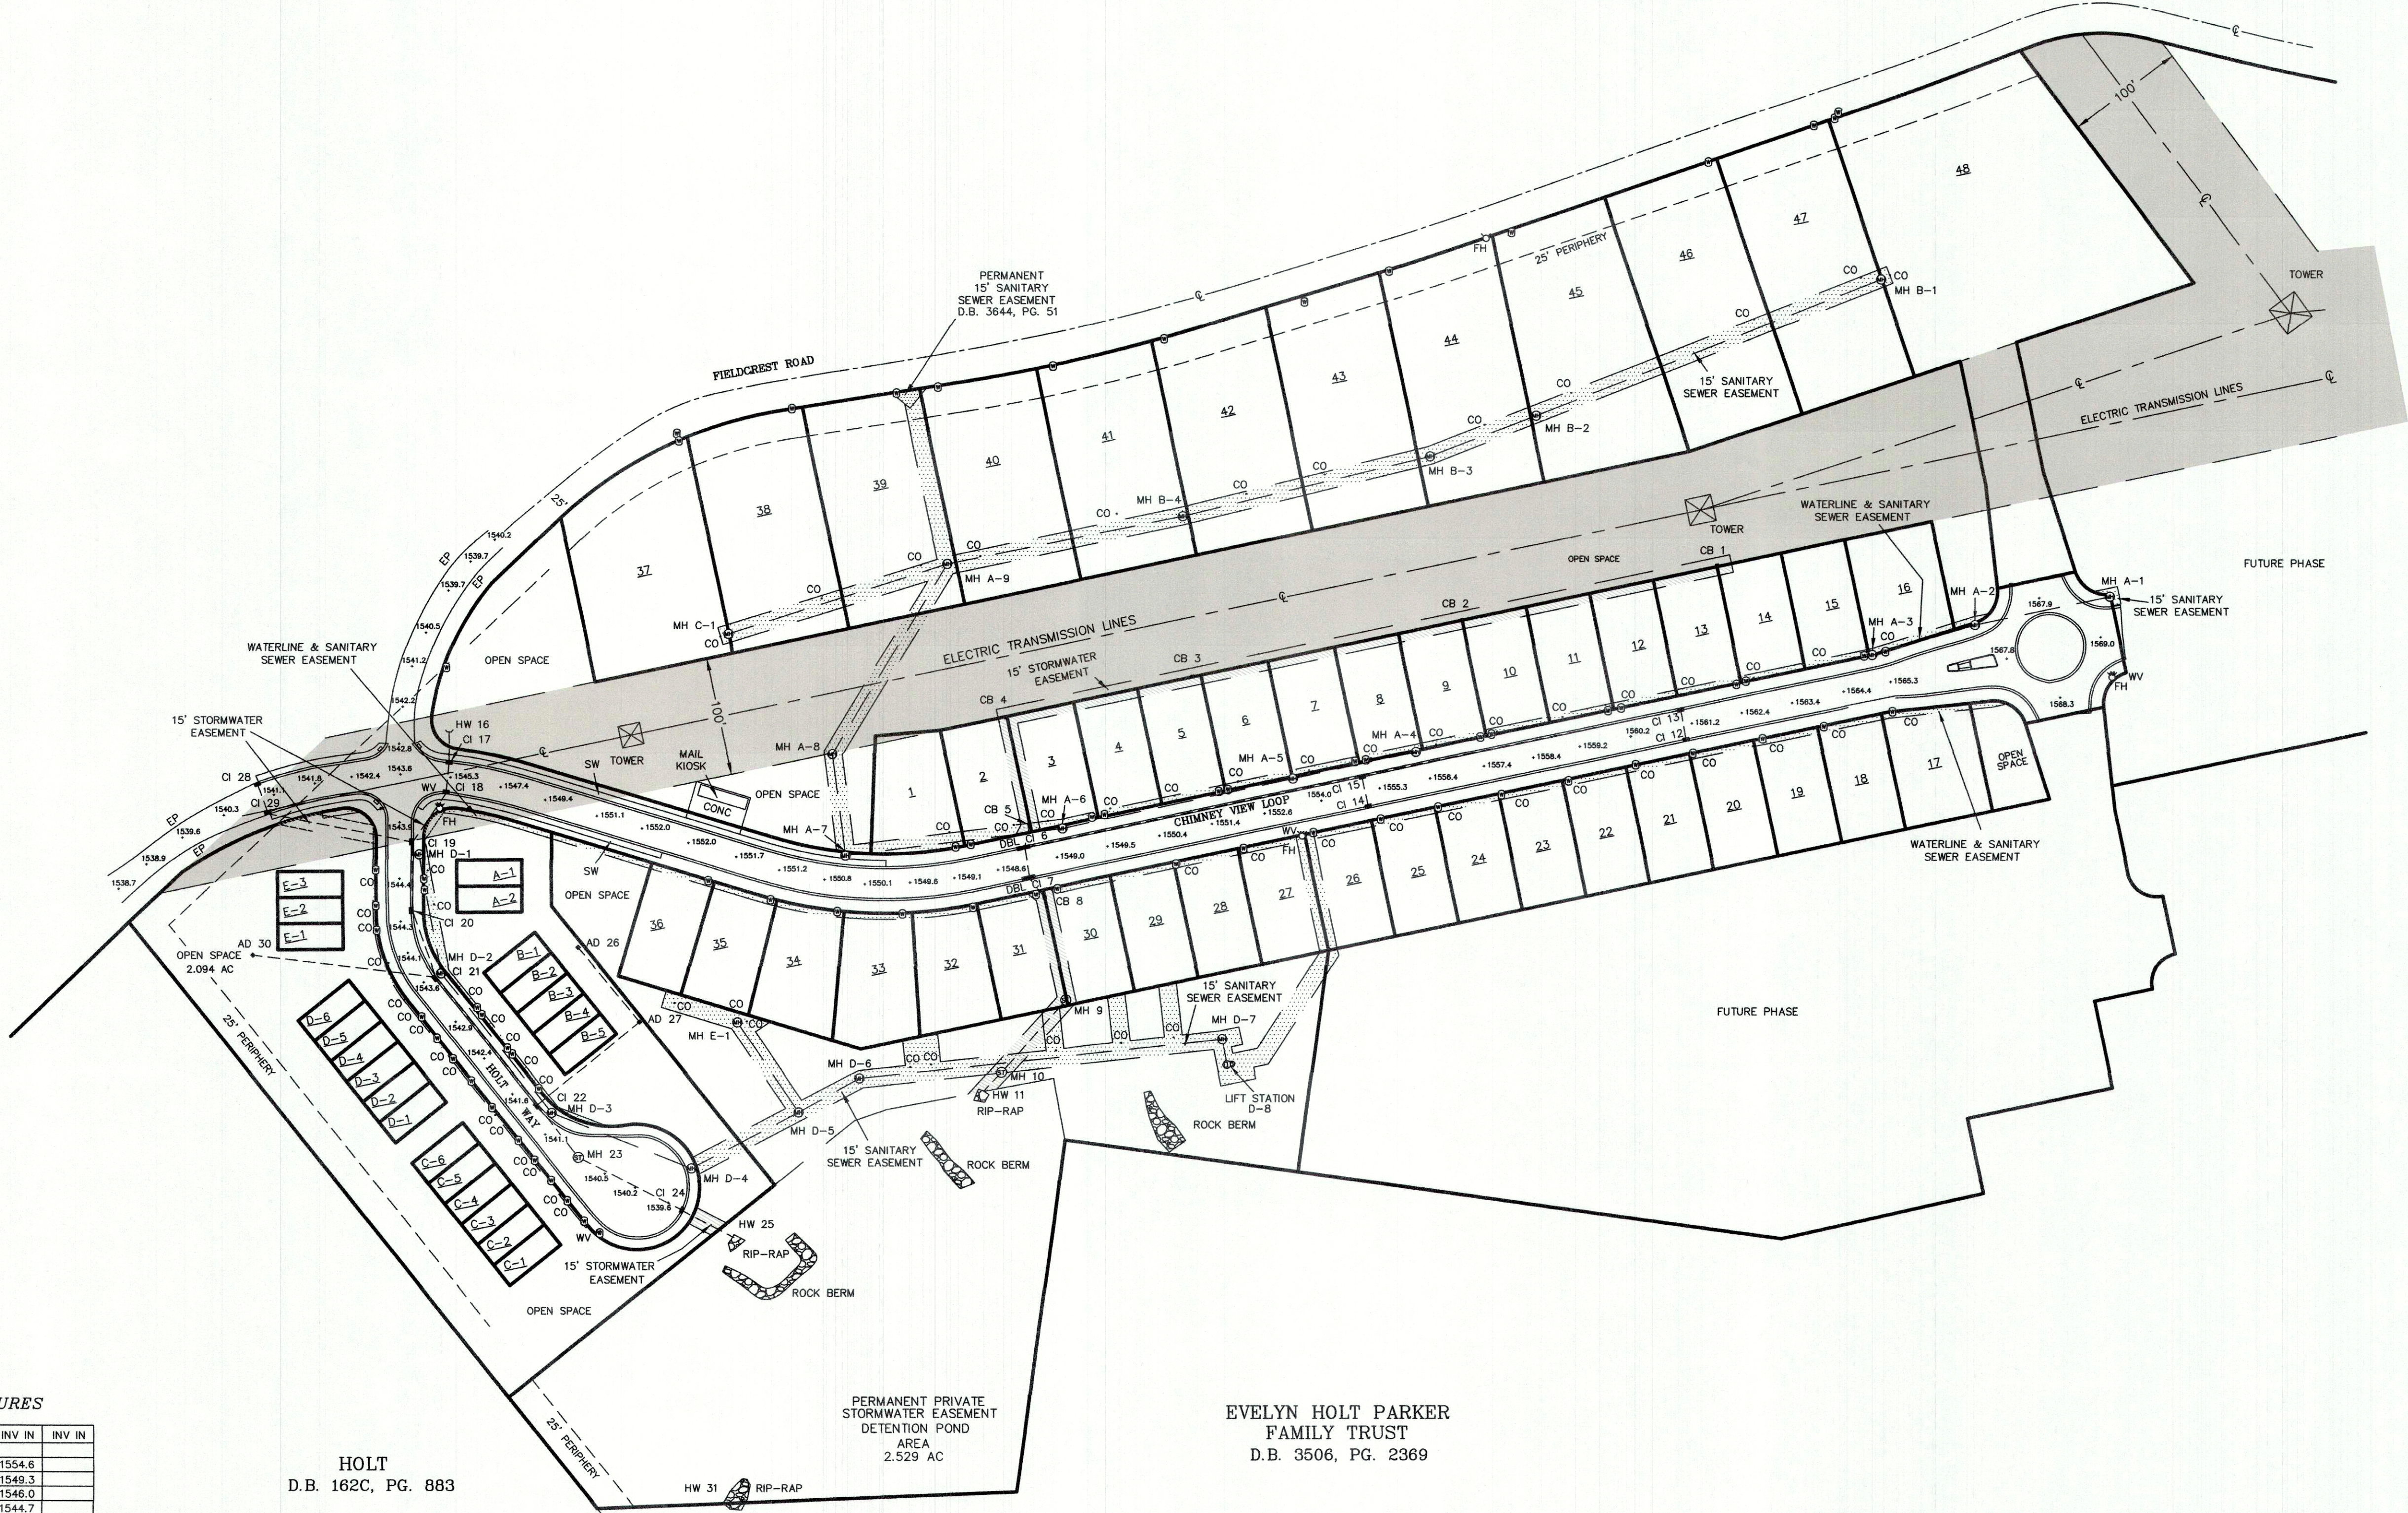

LEGEND

- HW HEAD WALL
INV INVERT
MH MANHOLE
CO CLEAN OUT
AD AREA DRAIN
CB CATCH BASIN
CI CURB INLET
FH FIRE HYDRANT
WV WATER VALVE
CONC CONCRETE
SW SIDEWALK
EP EDGE OF PAVEMENT
D.B. DEED BOOK
PC PAGE
CL CENTERLINE
W WATER METER
ST STORM MANHOLE
MH SEWER MANHOLE
+ 1234.0 SPOT ELEVATION

STORM STRUCTURES

STRUCTURE	TOP	INV OUT	INV IN	INV IN
CB 1	1562.5	1559.8		
CB 2	1557.4	1554.5	1554.6	
CB 3	1552.2	1549.2	1549.3	
CB 4	1549.2	1545.9	1546.0	
CB 5	1548.6	1539.5	1544.7	
DBL CI 6	1548.1	1538.7	1539.0	1539.2
DBL CI 7	1548.0	1538.6	1538.7	
CB 8	1547.5	1538.0	1538.1	
MH 9	1544.8	1536.5	1536.6	
MH 10	1531.0	1525.0	1525.9	
HW 11		1524.3		
CI 12	1560.6	1556.3		
CI 13	1560.7	1551.5	1556.0	
CI 14	1554.3	1550.0		
CI 15	1554.3	1545.1	1545.2	1549.5
CI 16	1554.3	1550.0		
CI 17	1554.3	1545.1	1545.2	
HW 18		1537.5		
CI 19	1544.5	1537.1	1537.2	
CI 20	1544.9	1536.8	1536.8	
CI 21	1543.6	1535.3	1534.4	1535.5
CI 22	1543.8	1534.7	1534.8	
CI 23	1543.0	1534.1	1534.4	1536.4
CI 24	1540.1	1536.5		
CI 25	1540.1	1536.5		
CI 26	1540.2	1536.0	1536.0	
AD 30	1543.3	1540.2		
HW 31		1540.2		
RISER				

SANITARY SEWER STRUCTURES

STRUCTURE	TOP	INV OUT	INV IN	INV IN	INV IN
MH A-1	1568.4	1560.1			
MH A-2	1567.0	1559.2	1559.3		
MH A-3	1564.9	1558.9	1559.0		
MH A-4	1555.9	1549.7	1549.8		
MH A-5	1553.2	1547.2	1547.2	1547.2	
MH A-6	1548.6	1544.0	1544.1		
MH A-7	1550.3	1543.4	1543.4		
MH A-8	1549.9	1543.1	1543.2		
MH A-9	1553.8	1542.3	1542.4	1542.4	1542.4
MH B-1	1575.7	1570.5	1570.6		
MH B-2	1577.0	1568.7	1568.8		
MH B-3	1573.8	1565.9	1566.0		
MH B-4	1562.3	1552.3	1552.4		
MH C-1	1548.4	1544.0	1544.1		
MH D-1	1544.2	1538.0			
MH D-2	1543.3	1537.3	1537.4		
MH D-3	1541.4	1535.1	1535.2		
MH D-4	1539.5	1533.6	1533.7		
MH D-5	1538.6	1532.8	1532.9	1533.0	
MH D-6	1536.3	1527.7	1527.8		
MH D-7	1529.5	1521.7	1521.8	1521.9	
MH D-8	1528.6		1521.4		
MH E-1	1549.3	1543.4	1543.6	1543.6	

HOLT
D.B. 162C, PG. 883

EVELYN HOLT PARKER
FAMILY TRUST
D.B. 3506, PG. 2369



I, MATTHEW STRICKLER (RLS #22950), HEREBY CERTIFY THAT I AM A
LAND SURVEYOR REGISTERED IN THE STATE OF TENNESSEE. I HAVE
LOCATED ALL VISIBLE, MANMADE WATERLINE AND SANITARY SEWER
FEATURES SHOWN ON THIS PLAN ON AUGUST 4, 2025. I CERTIFY THE
LOCATION, ELEVATION AND DESCRIPTION OF THESE FEATURES.

MATTHEW STRICKLER, PLS
ALLEY & ASSOCIATES, INC.

I, CHRISTOPHER D. ALLEY (TN PE #103754), HEREBY CERTIFY THAT I AM AN
ENGINEER LICENSED IN THE STATE OF TENNESSEE. I HAVE REVIEWED THE
INFORMATION BASED ON FIELD SURVEY DATA PROVIDED TO ME BY MATTHEW
STRICKLER, A STATE OF TENNESSEE REGISTERED LAND SURVEYOR (TN RLS #2950).

BASED ON THE AFOREMENTIONED SURVEY AND TO THE BEST OF MY KNOWLEDGE,
INFORMATION, AND BELIEF, THE SANITARY SEWER, WATERLINE, & STORM SEWER
IMPROVEMENTS SHOWN ON THIS PLAN FUNCTION AS INTENDED ON THE APPROVED
DESIGN FOR THIS DEVELOPMENT.



STORM, SANITARY SEWER & WATER AS-BUILT
FIELDCREST ACRES PHASE 1
KINGSPORT, TENNESSEE

ALLEY & ASSOCIATES, INC.
SURVEYORS
422 E. MARKET STREET KINGSPORT, TENNESSEE 37660
TELEPHONE (423) 392-8896
E-MAIL: lungefell@alleyassociates.com