



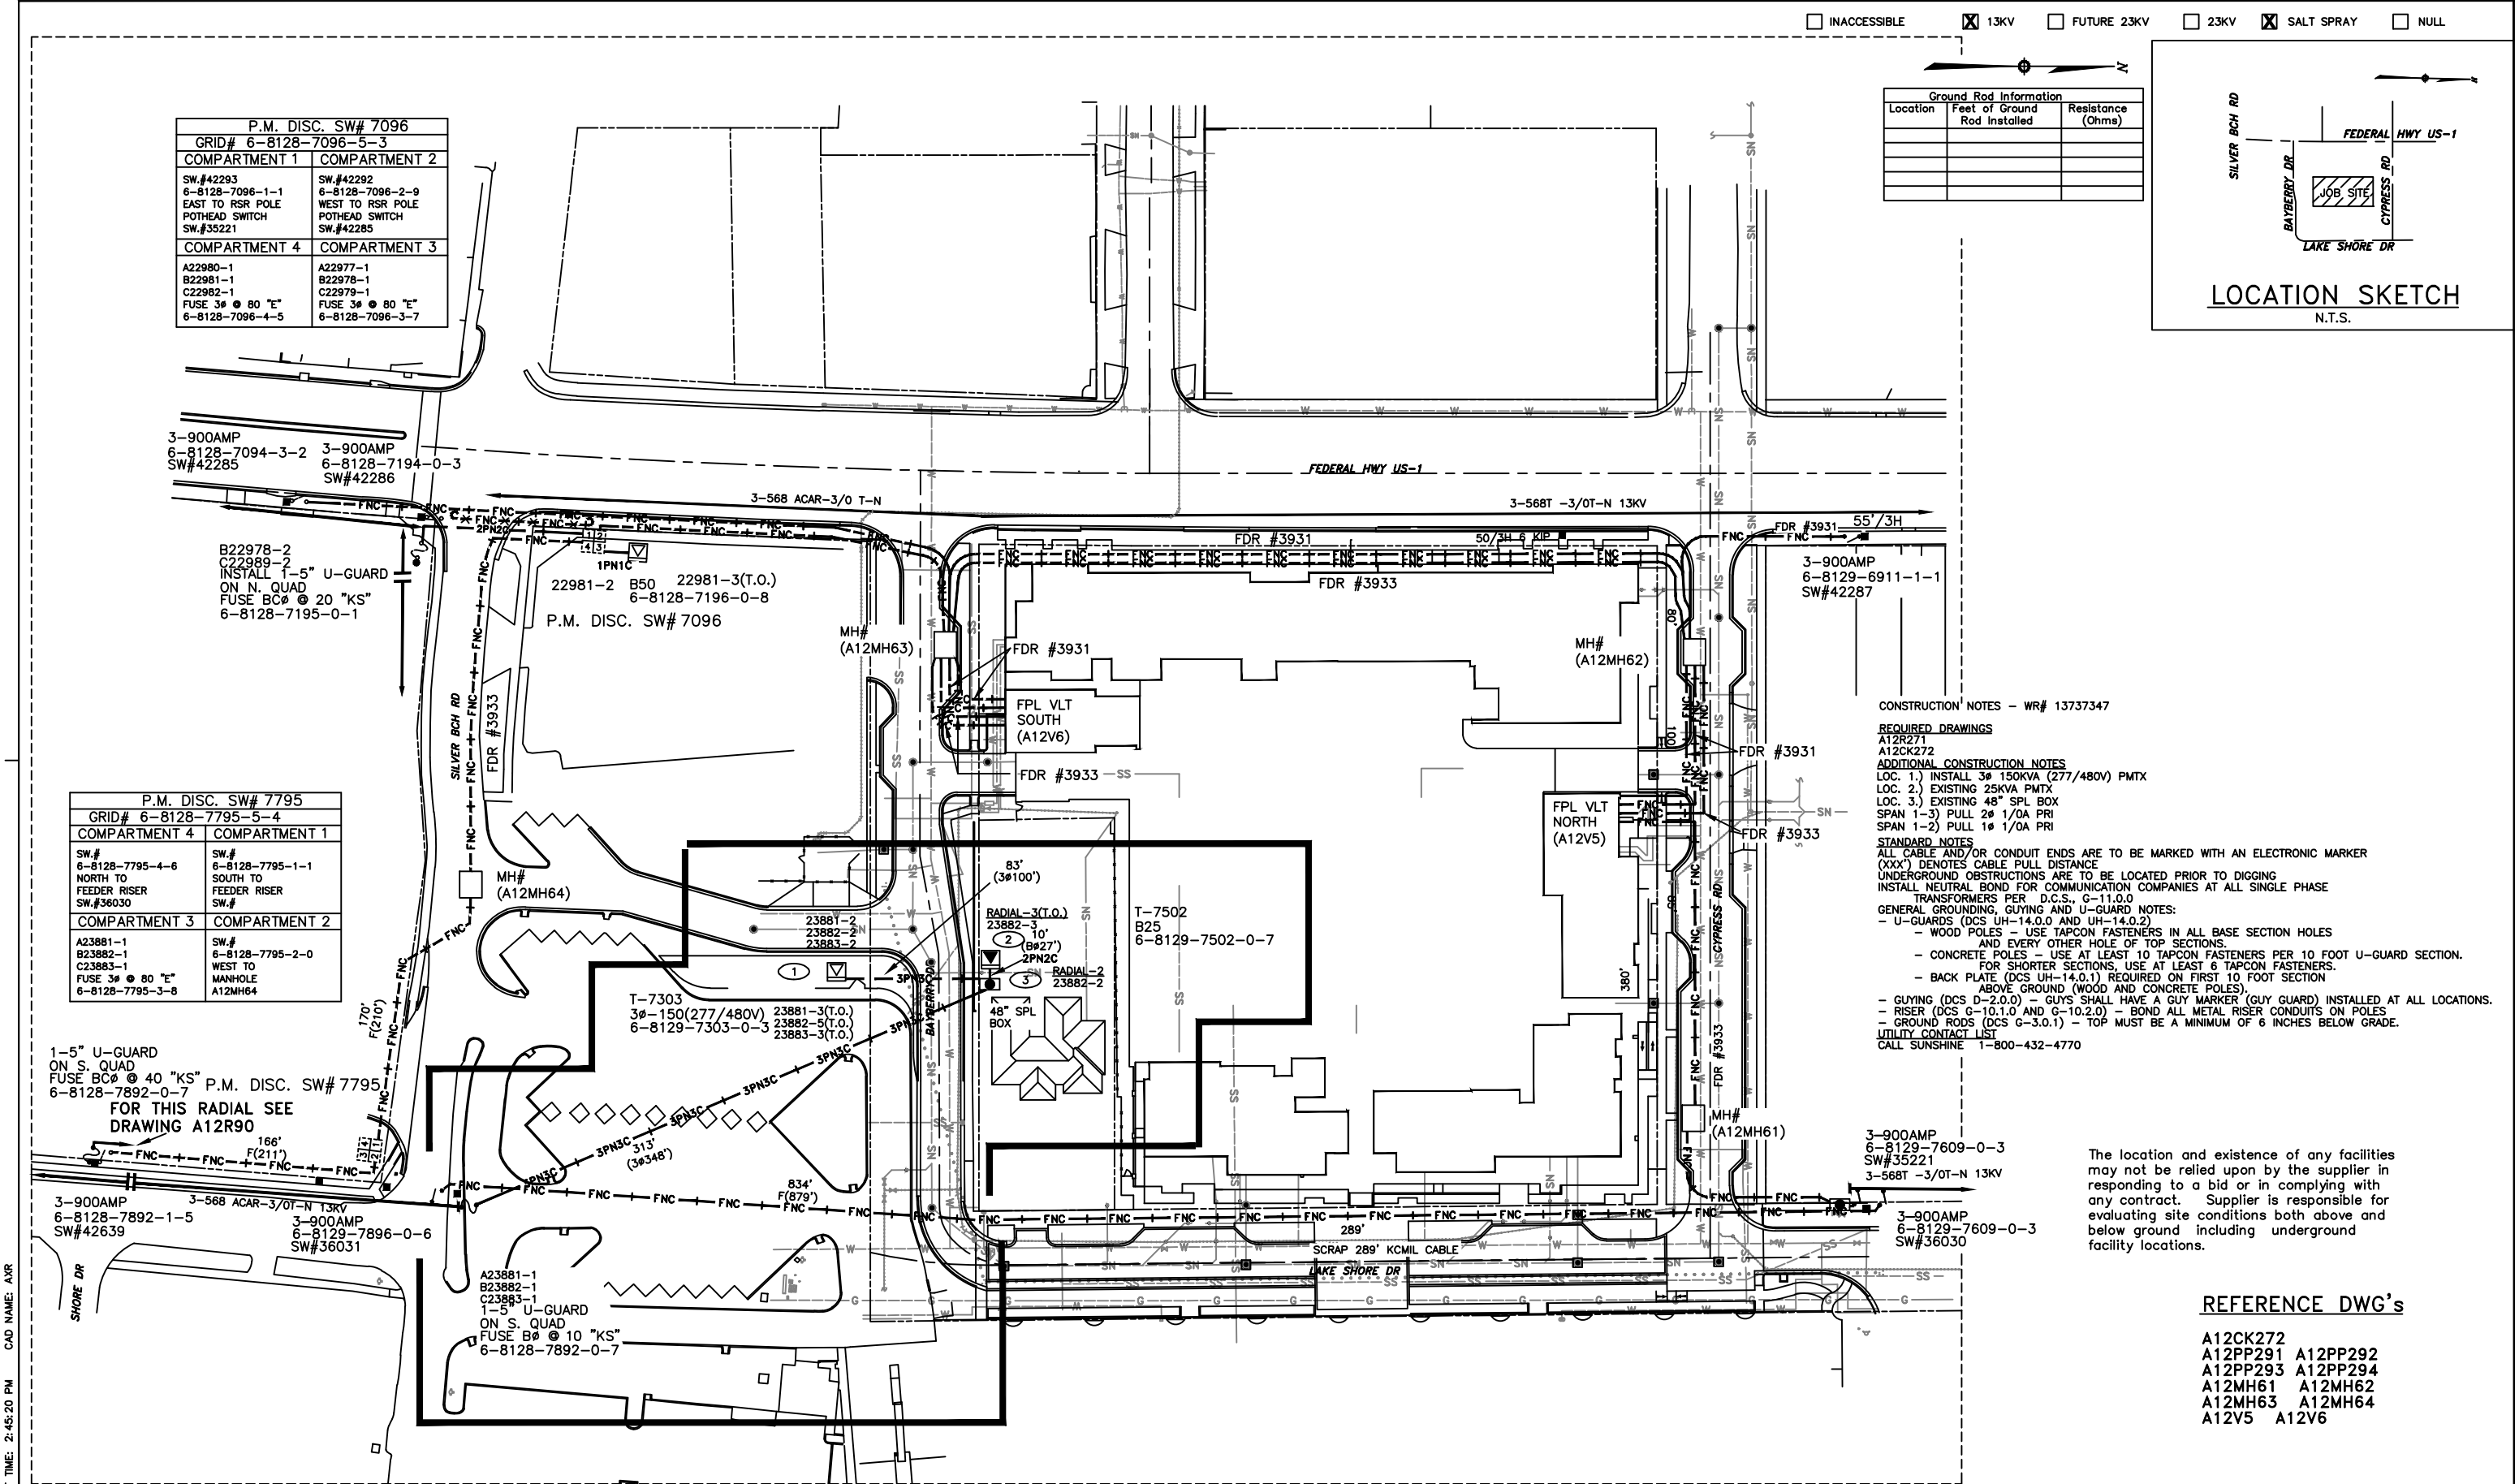

Ground Rod Information		
Location	Feet of Ground Rod Installed	Resistance (Ohms)

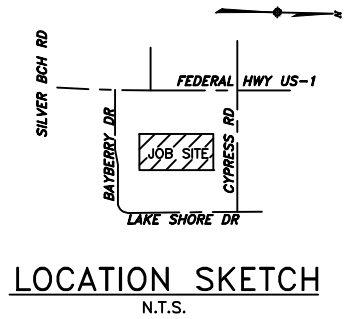

CONSTRUCTION NOTES - WR# 13737347

REQUIRED DRAWINGS
A12R271
A12CK272

ADDITIONAL CONSTRUCTION NOTES
LOC. 1.) INSTALL 3# 150KVA (277/480V) PMTX
LOC. 2.) EXISTING 25KVA PMTX
LOC. 3.) EXISTING 48" SPL BOX
SPAN 1-3) PULL 2# 1/0A PRI
SPAN 1-2) PULL 1# 1/0A PRI

STANDARD NOTES
ALL CABLE AND/OR CONDUIT ENDS ARE TO BE MARKED WITH AN ELECTRONIC MARKER (XXX) DENOTES CABLE PULL DISTANCE.
UNDERGROUND OBSTRUCTIONS ARE TO BE LOCATED PRIOR TO DIGGING
INSTALL NEUTRAL BOND FOR COMMUNICATION COMPANIES AT ALL SINGLE PHASE TRANSFORMERS PER D.C.S., G-11.0.0
GENERAL GROUNDING, GUYING AND U-GUARD NOTES:
- U-GUARDS (DCS UH-14.0.0 AND UH-14.0.2)
- WOOD POLES - USE TAPCON FASTENERS IN ALL BASE SECTION HOLES AND EVERY OTHER HOLE OF TOP SECTIONS.
- CONCRETE POLES - USE AT LEAST 10 TAPCON FASTENERS PER 10 FOOT U-GUARD SECTION. FOR SHORTER SECTIONS, USE AT LEAST 6 TAPCON FASTENERS.
- BACK PLATE (DCS UH-14.0.1) REQUIRED ON FIRST 10 FOOT SECTION ABOVE GROUND (WOOD AND CONCRETE POLES).
- GUYING (DCS D-2.0.0) - GUYS SHALL HAVE A GUY MARKER (GUY GUARD) INSTALLED AT ALL LOCATIONS.
- RISER (DCS G-10.1.0 AND G-10.2.0) - BOND ALL METAL RISER CONDUITS ON POLES
- GROUND RODS (DCS G-3.0.1) - TOP MUST BE A MINIMUM OF 6 INCHES BELOW GRADE.
UTILITY CONTACT LIST
CALL SUNSHINE 1-800-432-4770

The location and existence of any facilities may not be relied upon by the supplier in responding to a bid or in complying with any contract. Supplier is responsible for evaluating site conditions both above and below ground including underground facility locations.

REFERENCE DWG's

- A12CK272
- A12PP291 A12PP292
- A12PP293 A12PP294
- A12MH61 A12MH62
- A12MH63 A12MH64
- A12V5 A12V6

PLOT DATE: 12/27/2024 PLOT TIME: 2:45:20 PM CAD NAME: AXR

13737347				14	12/17/24	INSTALL RADIAL LOOP	AS-BUILT COPY		AS-BUILT CREW PRINT				Easement? YES ☐ NO ☒		Survey/Stake? YES ☐ NO ☒		Work with SMO? YES ☐ NO ☒		 FPL		DESIGNED BY		A. BOUTTE		M/A: WB NAUTILUS 131 US HIGHWAY 1 LAKE PARK/PALM BEACH COUNTY, FL					
13464639				13	08/20/24	PROVIDE SERVICE TO LIFT STATION	Initials		Cert. Date		Foreman's Signature		Date		Tree Work? YES ☐ NO ☒		Designer/Stake? YES ☐ NO ☒				CT/Special Mtr? YES ☐ NO ☒		DRAWN BY				T. COLLINS			
13474667				12	08/20/24	INSTALL SW CABINET & FEEDER	Job CERTIFIED COMPLETED as shown on this AS-BUILT print. Material changes shown on ROS.		Supervisor's Signature		Date		Map Posting? YES ☒ NO ☐		Trench Feet		Duct Bank Feet				DATE		12/17/24							
13131882				11	03/29/24	ABANDON THEN REPUILL NEW FEEDER FOR NAUTILUS	All required ground rods Have been driven & verified to be within FPL standards. Values are shown at all locations.		Foreman's Signature		Date		CITY		DR. DIST.		COUNTY		AIR		STATE RD		FAA		MAP NO.		0-0454		DWG NO. A12R271 WR: 13737347 IWR: D137 -37 -347	
10345434				0	10/11/22	INSTALL FEEDER DIP	AS-BUILT		AUTH NO.		NO.		NO.		DATE		WMD		RR XING		COUNTY RD.		TRANS.		Telephone Request? YES ☐ NO ☒		CATV Request? YES ☐ NO ☒			
REVISION				DATE		DATE		DATE		DATE		DATE		DATE		DATE		DATE		DATE		DATE		DATE		DATE				