


- NOTES:
1. PIPE-DUCTILE IRON, CLASS 52, 8" DIA. PUSH ON JOINTS
 2. RESILIENT SEAT GATE VALVES 6" & 8" BY KENNEDY MANUFACTURED 5-25-2013
 3. CLOW-EDDY HYDRANTS, BY CLOW VALVE COMPANY F-2640, MANUFACTURED 2013
 4. DEPTH OF COVER MIN. 5'-0" EXCEPT 4'-10" WHERE APPROVED WITH 2" R-10 SOLID INSULATION OVER PIPE. DEPTH TEMPORARILY 9'-10" IN FORMER MOUND AREA EAST OF BUILDING 1069. WHEN MOUND IS REMOVED MIN. DEPTH WILL BE 5'-0".
 5. INSTALLATION 5-15-14 TO 6-10-14

I HEREBY CERTIFY THAT THIS IS AN ACCURATE "AS BUILT" OF THE WATERMAIN & APPURTENCES SHOWN.

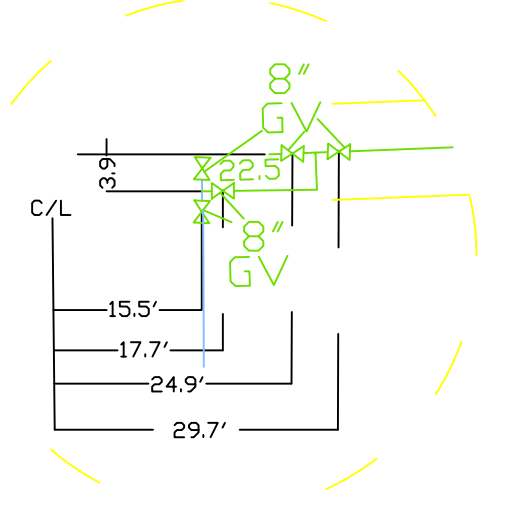


RECORD DRAWING

BONE PLAIN TANK PRESSURE ZONE

TOWN OF LANSING
COUNTY OF TOMPKINS
STATE OF NEW YORK

LANDS OF LUCENTE	SCALE AS SHOWN	SURVEY BY L.FABBRONI
	DATE: 6-4-14	NYSLS
	REV.	49682

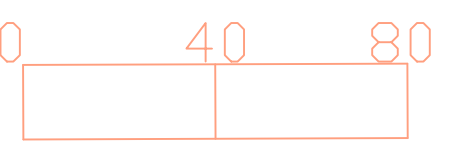

T.P. 39-1-50.2
KAIDA COMPUTER TECH. LLC
(INSTR#488698-001)

T.P. 39-1-50.4
R.D. KAIDA COMPUTER TECH. LLC
(INSTR# 471363-001)