


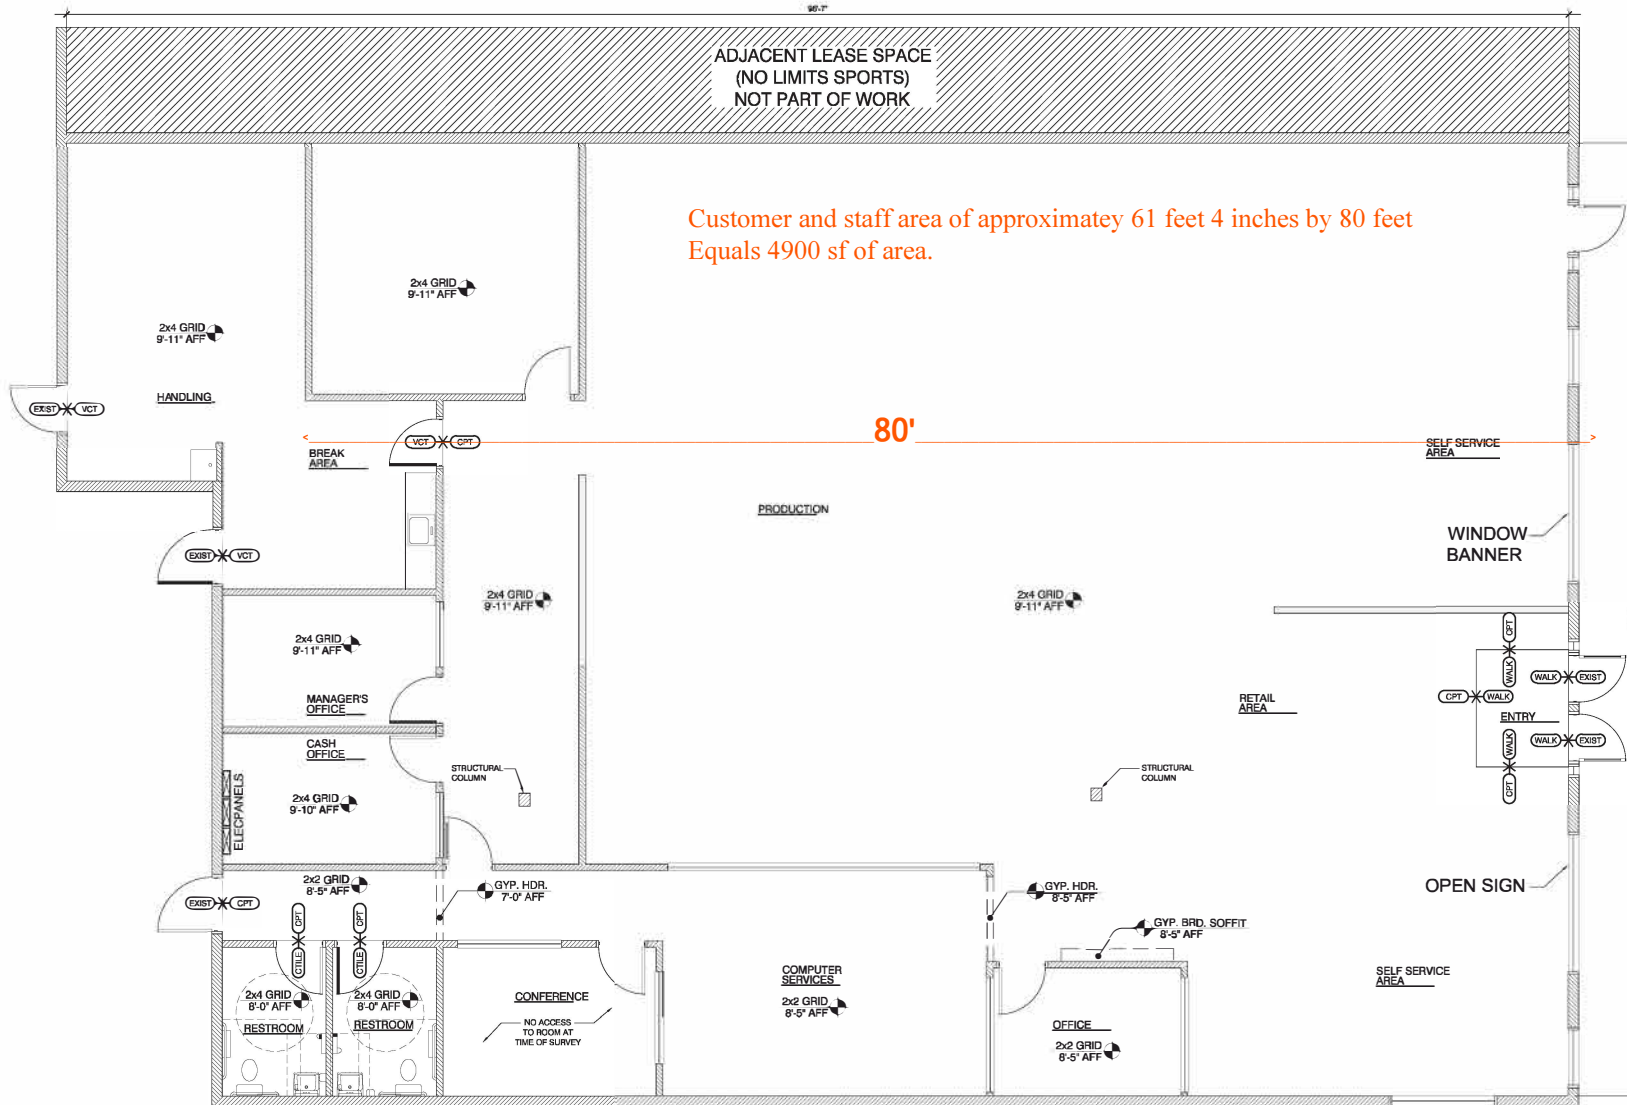

Customer and staff area of approximate 61 feet 4 inches by 80 feet
Equals 4900 sf of area.

80'



**FRCH
NELSON**
A NELSON BRAND

311 Elm Street Suite 600
Cincinnati OH 45202
513 241 3000
www.frch.com

PROJECT NO.: **036628.000**

CENTER NO.: **0480** SITEID NO.: **1003836** PROGRAM: **REF**

FedEx Office™
LATHRUP VILLAGE, MI
SOUTHFIELD
27861 Southfield Rd
Lathrup Village, MI 48076

EQUIPMENT & FIXTURE LEGEND	
NEW	[Symbol]
EXISTING	[Symbol]
RELOCATED WITHIN	[Symbol]
RELOCATED REMOTE	[Symbol]
FUTURE	[Symbol]
REMOVE	[Symbol]
ANCILLARY	[Symbol]
REPROGRAPHIC	[Symbol]
MERCHANDISING	[Symbol]
COMPUTER	[Symbol]

WALL LEGEND	
NEW FULL HT WALL	[Symbol]
NEW LOW WALL	[Symbol]
NEW FURRING	[Symbol]
EXIST'G FULL HT WALL	[Symbol]
EXIST'G LOW WALL	[Symbol]

PROJECT DESCRIPTION
\$ 705 SF LEASE ME
\$ 525 SF USEABLE

EXISTING SHELL/
END CAP/
EXISTING CENTER

DRAWING ISSUE
08/23/19
FIRST ISSUE

REVISIONS	
1	
2	
3	
4	
5	

DRAWING TITLE
FIRST FLOOR
AS-BUILT
FLOOR
PLAN

© 2019 FedEx Office Q3-FY19