


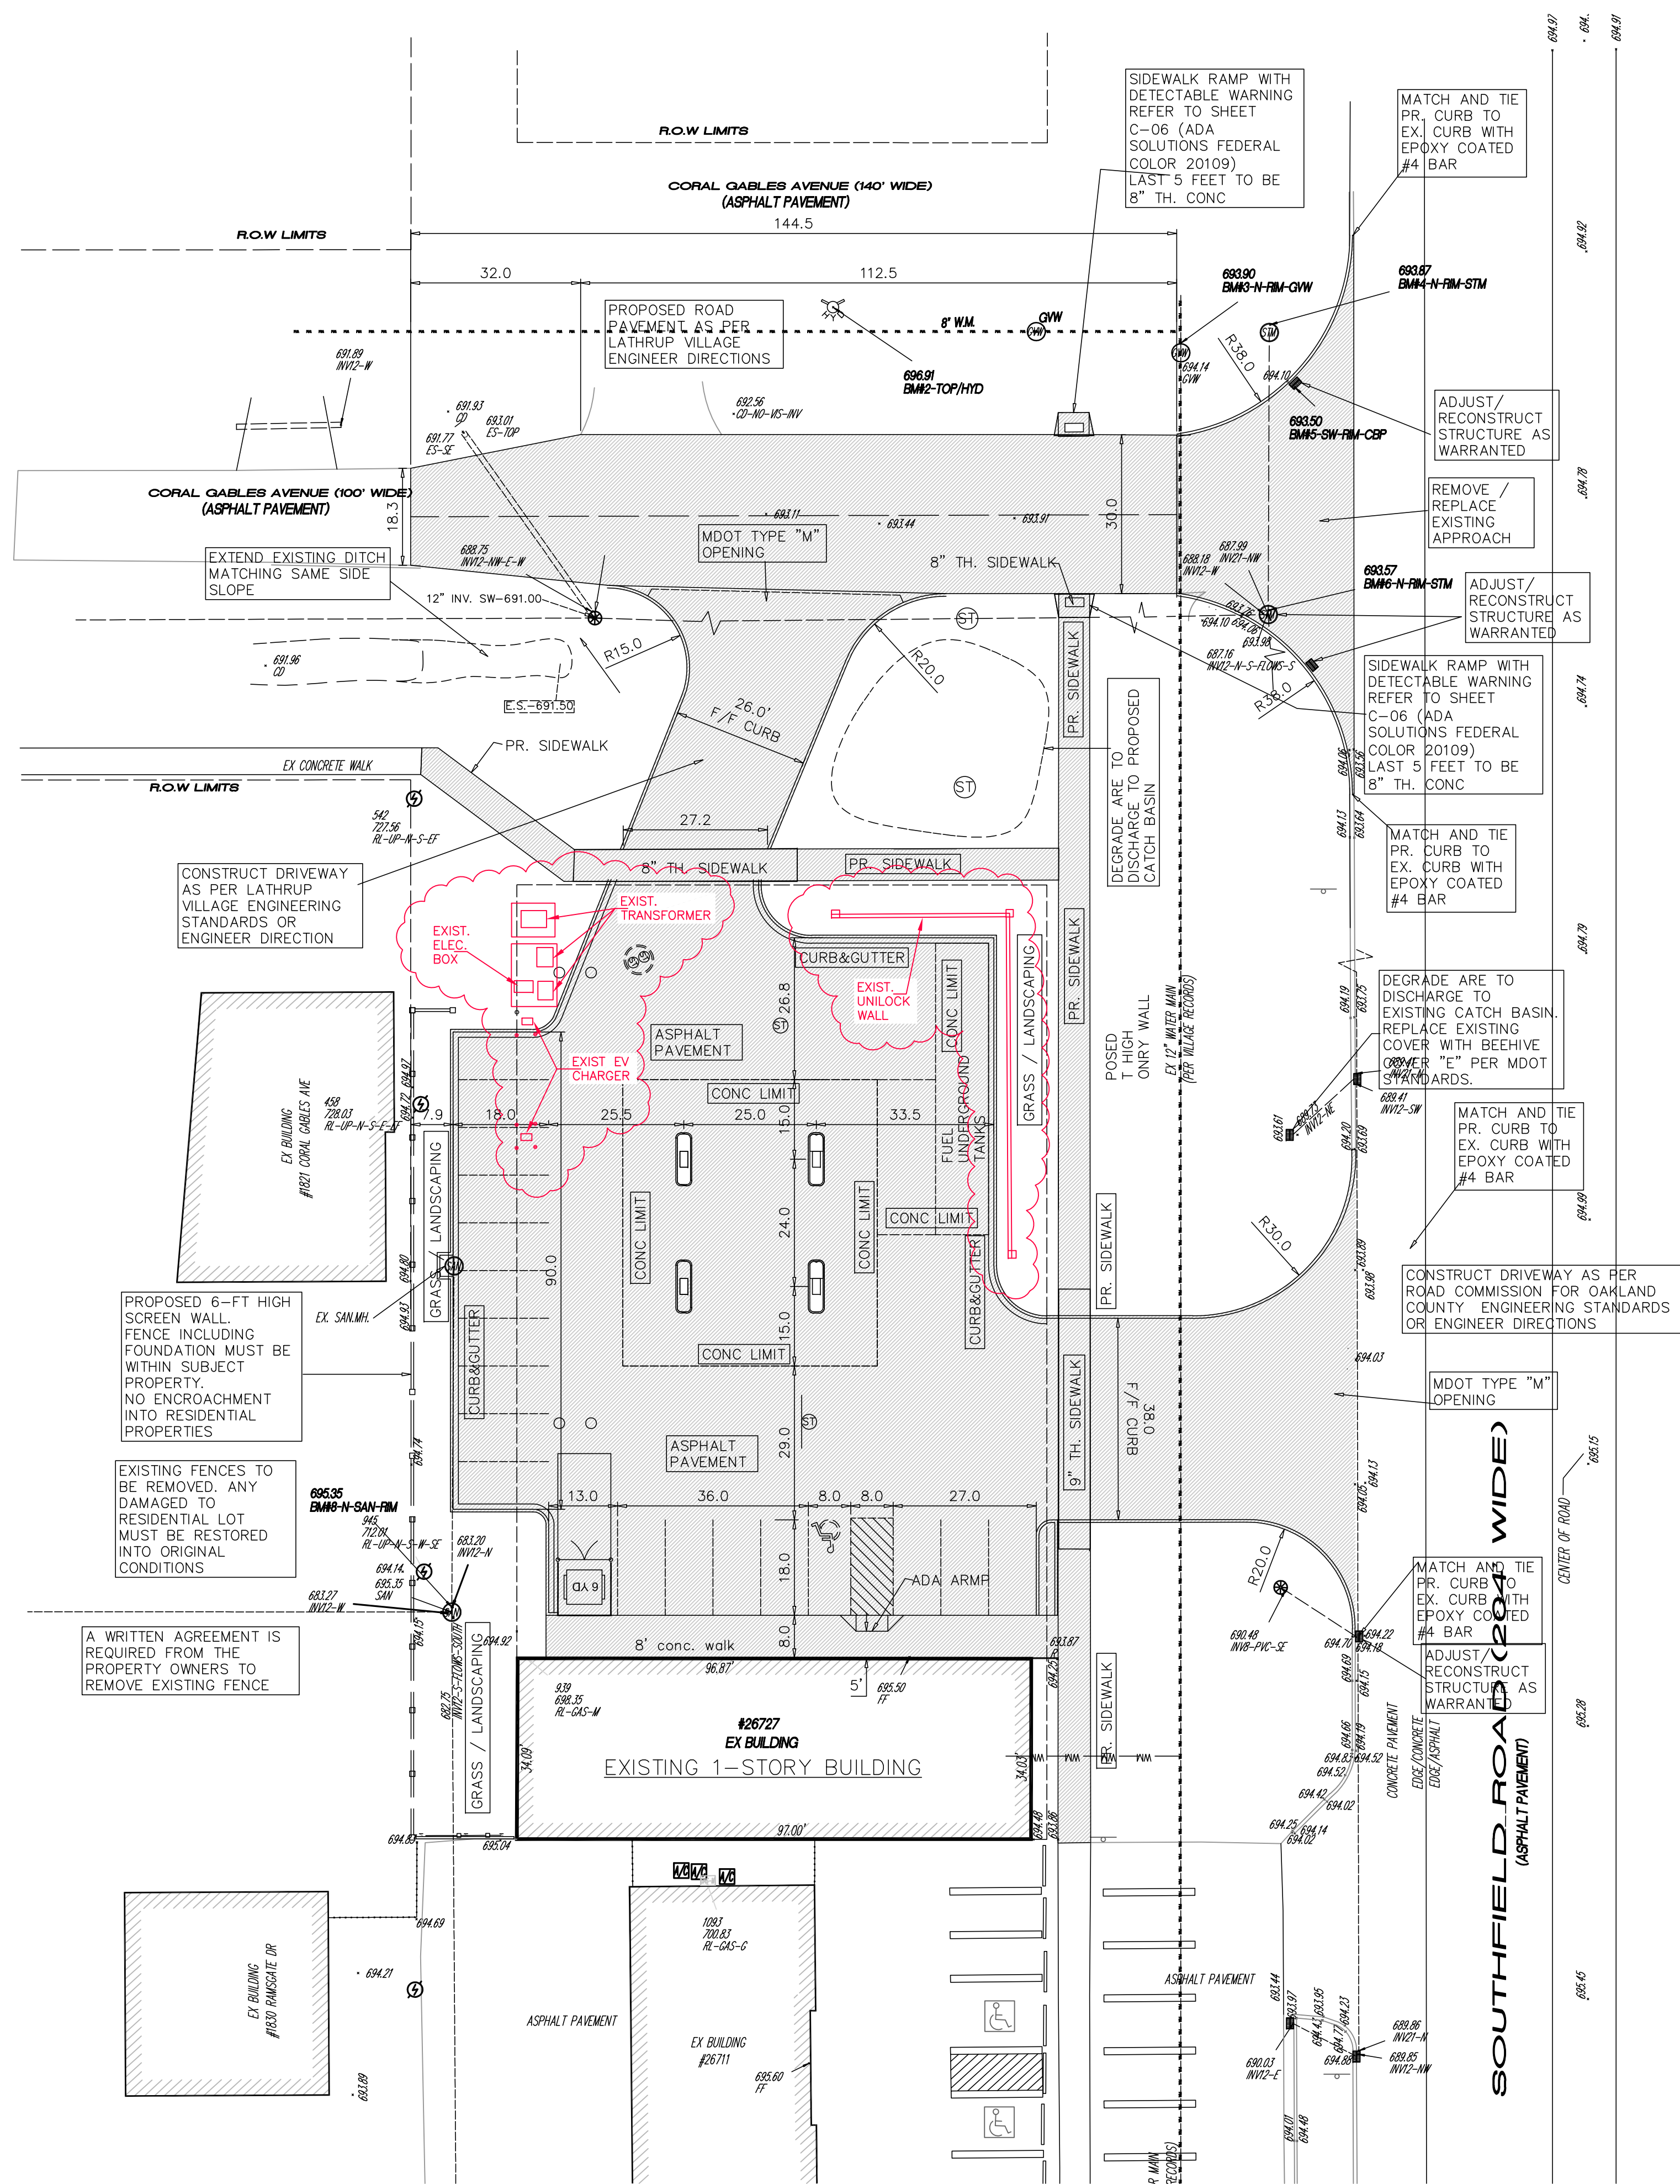


E:\Land Projects\2005\21-153.dwg, 21-153AS01.dwg

DRN:	A.S.	CHKD:	A.S.
FILE NO.	21-153AS01.dwg		
SHEET NO.	SP - 1		

AS-BUILT SITE PLAN
PROJECT: BP FUELING STATION
26727 SOUTHFIELD RD,
LATHRUP VILLAGE, MICHIGAN

CLIENT: L V PETRO
SCALE 1 INCH = 20 FEET
0 10 20 30 40

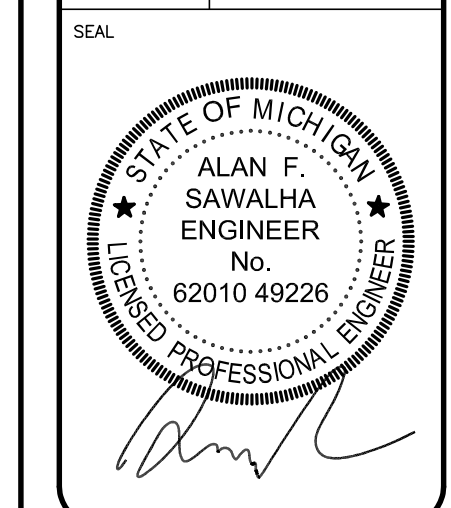

ISSUE / REVISIONS	
DATE	REMARKS
20/21/2022	ORIGINAL ISSUE

This drawing, design, concept, ideas, and specifications, are property of LANDWISE, INC. and must be returned to LANDWISE, INC. immediately upon request. They are submitted for the purpose of presentation / or construction of this specific project on the condition that they are not to be used, reproduced, or copied, in whole or in part, or used for other projects or for furnishing information to others, without prior written consent of LANDWISE, INC.

Landwise
Inc.
Civil Engineers - Land Surveyors
P.O. Box 1952, Dearborn, MI 48121
Tel: 248-257-5700, Fax: 248-257-5555
email: info@landwiseinc.com