

B 15564

BUILDING PERMIT APPROVAL		DATE
PLAN DEPT	July 8, 1984	8/21/84
PLUMBING DEPT		1/1
FIRE DEPT	John Smith	8/22/84
BUILDING DEPT	C. C. [unclear]	8/23/84
SEWER CONCRETE		
TR SR		TYPE CONST
DEAR SR		CCC GROUP
LEFT SR		USE ZONE
RIGHT SR		FIRE SPR
VALUATION	\$ 8,000	
FEES & TAXES		
BUILDING PERMIT	\$	99
SEISMIC TAX		51
CONSTRUCTION TAX		—
UTILITY TAX		
PARK TAX		
PLAN CHECK FEE		64
TOTAL \$		163 91

INSPECTION RECORD

	DATE	INSPECTOR'S SIGNATURE
FOUNDATION LOCATION FORMS, MATERIALS		
FRAME FIRE STOPS BRACING, BOLTS		
FURNACE LOCATION GAS VENT, DUCTS		
INSULATION		
LATH EFT		
INSULATION EFT		
LANDSCAPING PAVING AND GRADING IMPROVEMENTS COMPLETED		
FINAL	10/10/2010	[Signature]

CENTURY PATIO VILLAGE, INC.

PLANNING DEPARTMENT
APPROVED

SEE PLANS HAVE BEEN APPROVED AS SHOWN. ANY MODIFICATION TO WHAT HAS BEEN PROPOSED OR TO WHAT IS SHOWN AS EXISTING, MAY REQUIRE A SEPARATE APPROVAL. 5/28/88


PROPOSED PATIO COVER

ENCLOSED 420 #

OPEN 165 #

EXISTING CONCRETE

155.90'

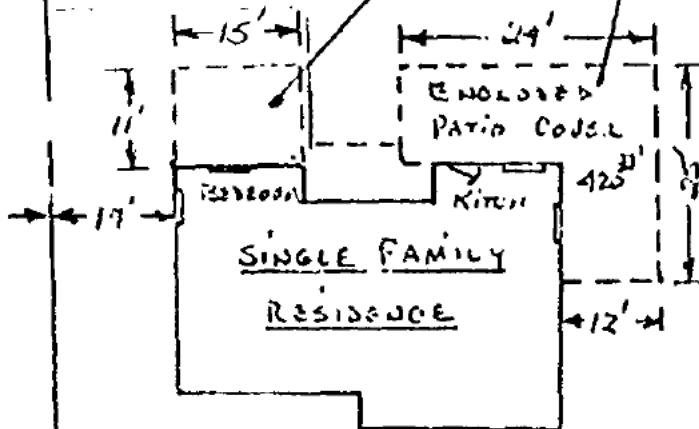

SINGLE FAMILY
RESIDENCE

25' FRONT
YARD

REVISED
PLOT PLAN

8-24-88

125' BLOSSOM HILL ROAD




SCALE 1" = 20'

CUSTOMER: JACK GEORGE	PHONE: [REDACTED]
ADDRESS: 15116 BLOSSOM HILL RD	SALESMAN: HAL JARVIS
CITY: LOS GATOS 95030	PRICE:
COUNTY:	ITEMS:


B15564

PLANNING DEPARTMENT
APPROVED

REVISIONS HAVE BEEN APPROVED AS
SHOWN. ANY MODIFICATION TO WHAT HAS
BEEN PROPOSED OR TO WHAT IS SHOWN AS
EXISTING, MAY REQUIRE A SEPARATE
APPROVAL. 12/13/85

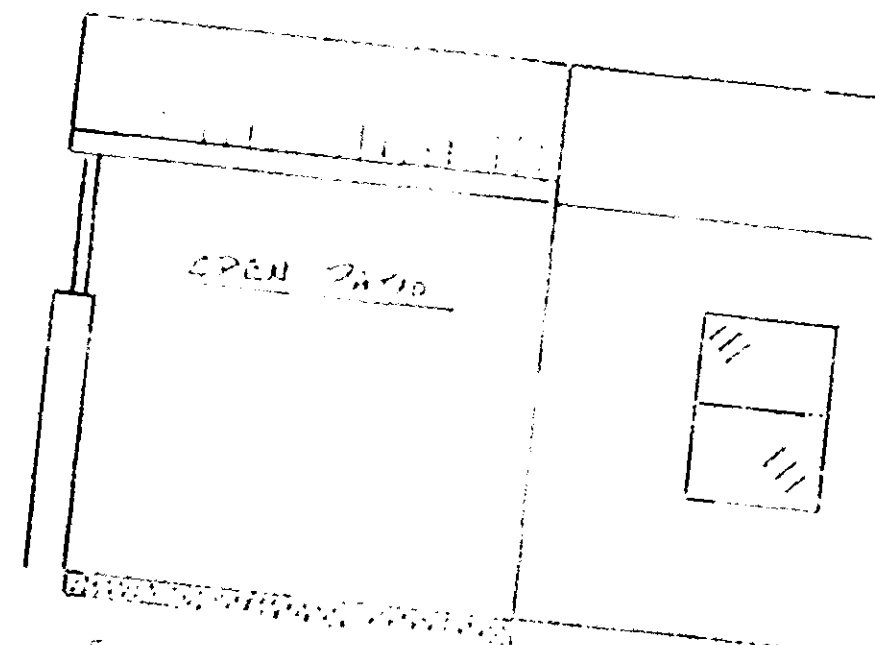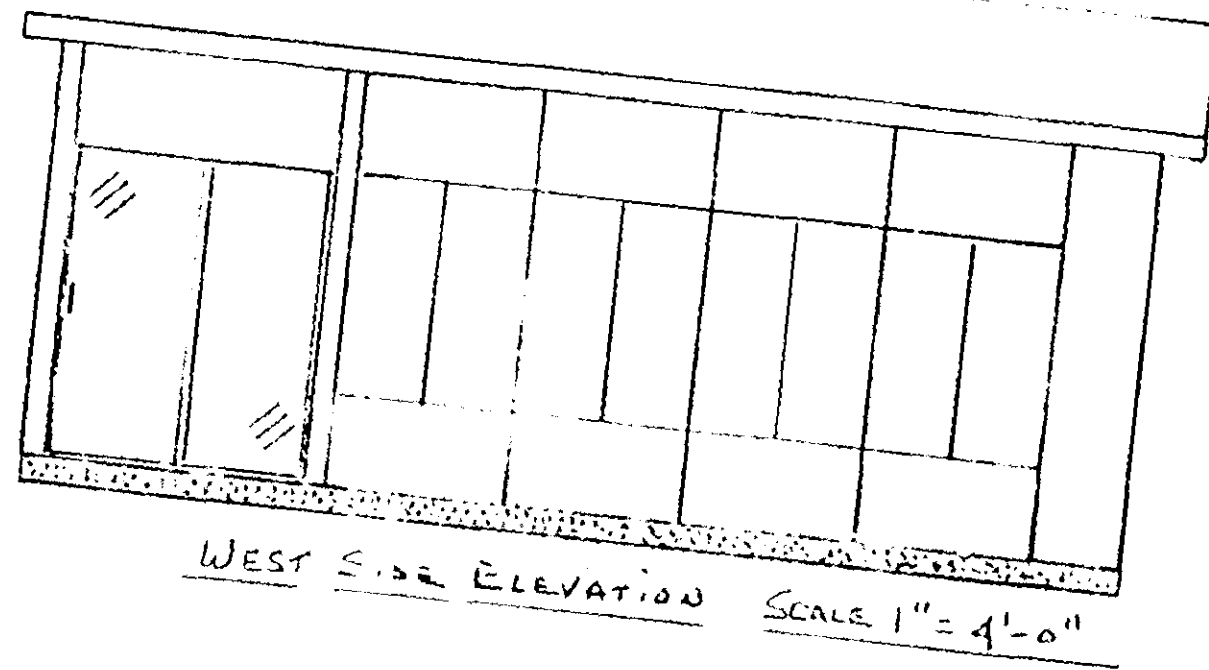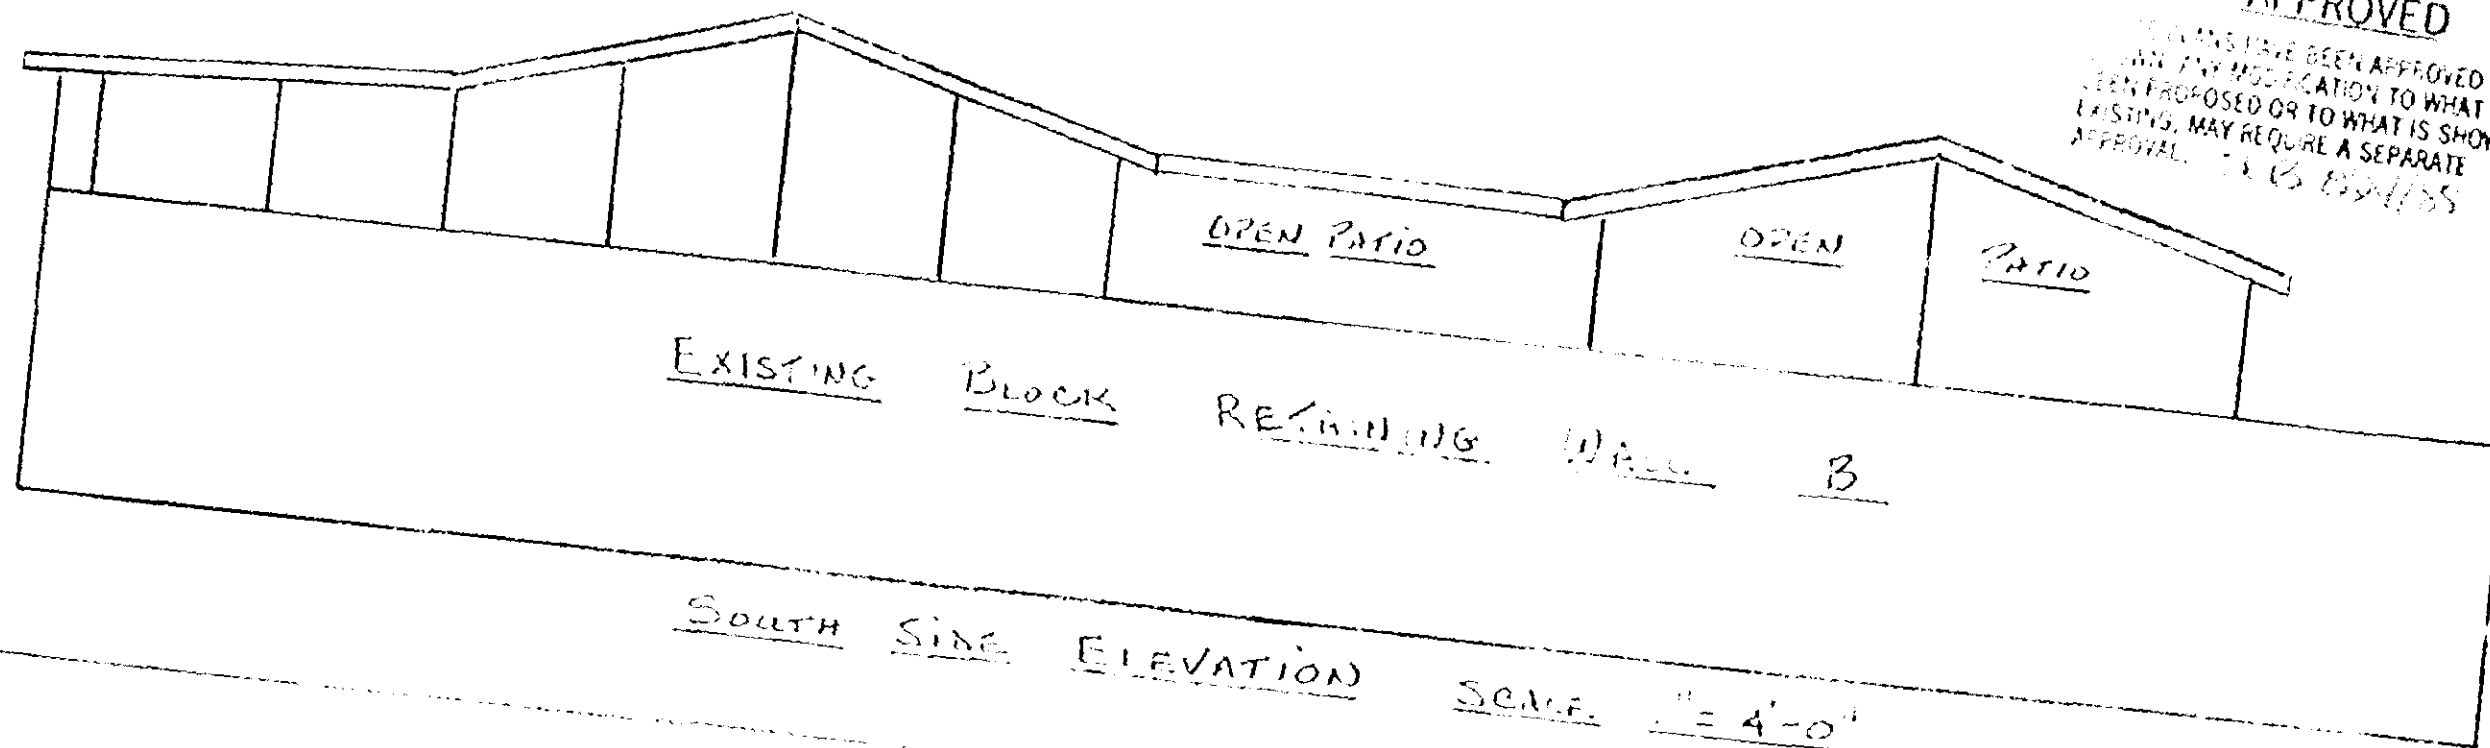

FOR: JACK GEORGE
15116 BLOSSOM HILL
LOS GATOS 950-6210

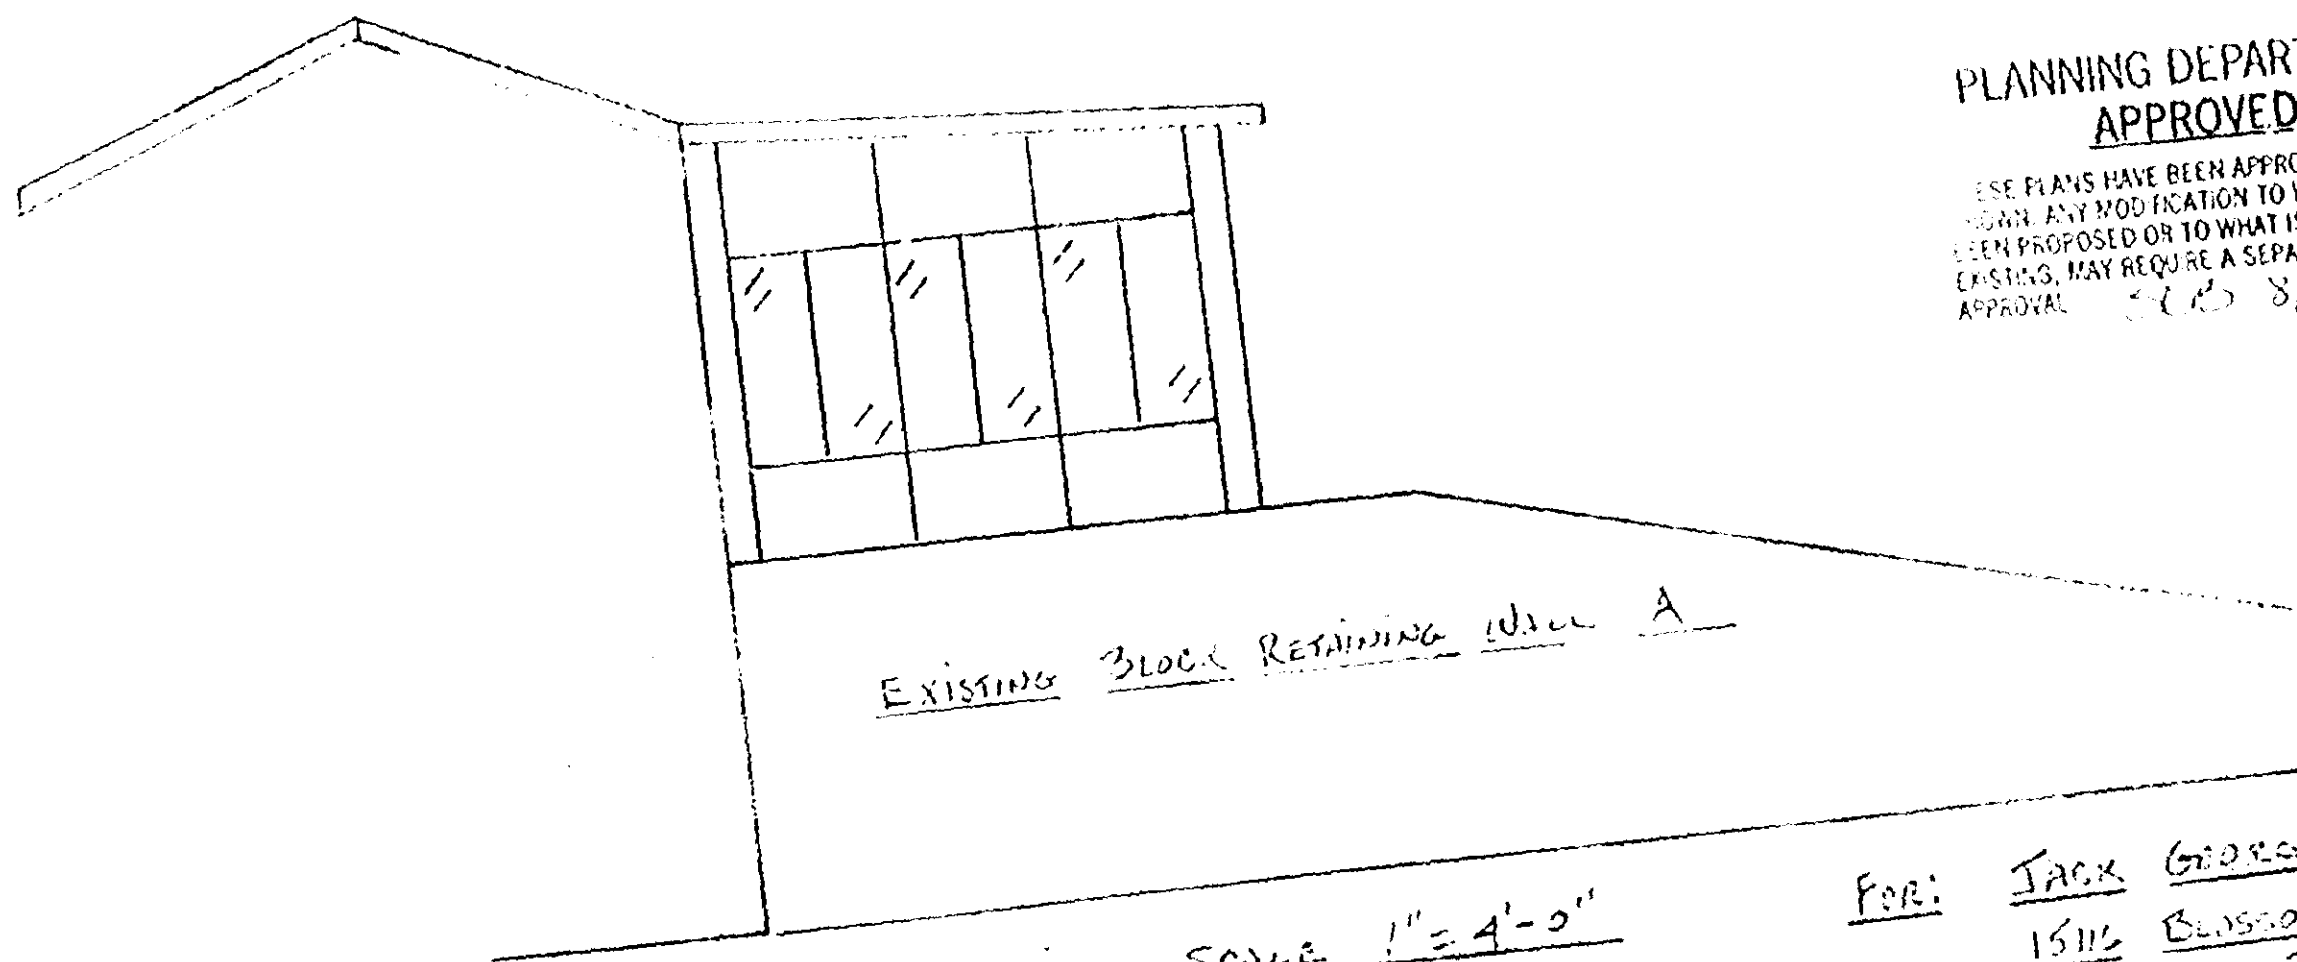

PLANNING DEPARTMENT
APPROVED
THESE PLANS HAVE BEEN APPROVED AS
SHOWN. ANY MODIFICATION TO WHAT HAS
BEEN PROPOSED OR TO WHAT IS SHOWN AS
EXISTING, MAY REQUIRE A SEPARATE
APPROVAL SUB 8/24/88

NORTH SIDE ELEVATION SCALE 1" = 4'-0"

FOR: JACK GEORGE.
15116 BLOSSOM HILL
LOS ANGELES 356-6360

**TOWN OF LOS GATOS
COMMUNITY DEVELOPMENT DEPARTMENT
BUILDING PERMIT**

Permit Number: **803-000561**

Work Description: **T/O (E) PITCH ROOF R/R 1500 SF CLASS COMP**

Building Address: **15116 BLOSSOM HILL RD LG**

Status: **ISSUED**

Applied: **07/23/2003** Issued: **07/23/2003**

Approved: **07/23/2003** Expires: **01/19/2004**

OWNER

GEORGE JACK E, ELIZABETH J TR 07/23/2003 Phone: [REDACTED]

15116 BLOSSOM HILL RD

LOS GATOS, CA

95032-4906

License:

CONTRACTOR **ARMSTRONG ROOFING**

07/23/2003 Phone: [REDACTED]

Valuation: **\$4,500.00**

Total Sq. Ft.: **1500**

Liveable Sq. Ft.: **0**

Class Code: **434**

Bldg Count: **1**

House Count: **0**

Description Tot Fee

Building Permit Fees 145.00

Computer Services Fee 4.56

Microfilm Fees - Bldg. 2.20

Road Impact Basin #1 60.00

Seismic Tax 5% .03

Seismic Tax 95% .47

Total Calculated Fees: \$212.26

Total Additional Fees: \$0.00

Total Fees Due: \$212.26

Total Payments: \$0.00

Balance Due: \$212.26

LICENSED CONTRACTOR'S DECLARATION

I hereby affirm under penalty of perjury that I am licensed under provisions of Chapter 9 of division 3 of the Business and Professions Code, and my license is in full force and effect.

Signature X _____

COMPLETE A or B

WORKER'S COMPENSATION DECLARATION

A) I hereby affirm under penalty of perjury I have and will maintain workers' compensation insurance, as required by Section 3700 of the Labor Code, for the performance of the work for which this permit is issued.

Signature X _____

CERTIFICATE OF EXEMPTION FROM WORKER'S COMPENSATION INSURANCE

B) I certify that, in the performance of the work for which this permit is issued, I shall not employ any person in any manner so as to become subject to the workers' compensation laws of California, and agree that, if I should become subject to the worker's compensation provisions of Section 3700 of the Labor Code, I shall forthwith comply with those provisions.

Signature X _____

WARNING: FAILURE TO SECURE WORKER'S COMPENSATION COVERAGE IS UNLAWFUL, AND SHALL SUBJECT AN EMPLOYER TO CRIMINAL PENALTIES AND CIVIL FINES UP TO \$100,000, IN ADDITION TO THE COST OF COMPENSATION, DAMAGES AS PROVIDED FOR IN SECTION 3706 OF THE LABOR CODE.

CERTIFICATION OF OWNER/BUILDER DECLARATION

I hereby affirm under penalty of perjury that I, as owner of the property, have read this application and the owner/builder information form attached is correct. I agree to comply with all Town ordinances and State Laws relating to building construction, and hereby authorize representatives of this Town to enter upon the above mentioned property for inspections.

Signature X _____



TOWN of LOS GATOS
Community Development
Building Permit

Permit ID/Type:	B13-0616 BUILDING/BUILDING/RESIDENTIAL/ALTERATION	Applied:	08/29/2013
Work Description:	INSTALL 40 SQ FT OF VINYL SIDING TO EAST WALL OF SUN ROOM - INSIDE AND OUT, LIKE FOR LIKE.	Approved:	
Status:		Issued:	<\$ISSUED_DATE\$>
Address:	15116 BLOSSOM HILL RD, LOS GATOS, CA 95032	Expires:	2/24/2014
Owner:	GEORGE JACK E; ELIZABETH J TRUSTEE 15116 BLOSSOM HILL RD LOS GATOS, CA 95032	Phone:	[REDACTED]
Contractor:	SEARS HOME IMPROVEMENTS P.O. BOX 588888 LONGWOOD, FL 32750-8888	Phone:	[REDACTED]
License No.:	721379		

Job Value:	\$6,291.00	Buildings:	1
Total Sq. Ft.:	<\$SQUARE_FEET\$>	Houses:	0
Building Use:	Dwellings	Census #:	434
Occupancy Type:	R-3	Construction Type:	V-B

Total Fees	\$325.54
Total Payments	\$0.00
Balance Due	\$325.54

LICENSED CONTRACTOR'S DECLARATION

I hereby affirm under penalty of perjury that I am licensed under provisions of Chapter 9 (commencing with Section 7000) of Division 3 of the Business and Professions Code, and my license is in full force and effect.

License Class B, C36, C20 California Contractor License No. 721379
 Expiration Date 4/30/14 Contractor Signature _____

WORKERS' COMPENSATION DECLARATION WARNING: FAILURE TO SECURE WORKERS' COMPENSATION COVERAGE IS UNLAWFUL, AND SHALL SUBJECT AN EMPLOYER TO CRIMINAL PENALTIES AND CIVIL FINES UP TO ONE HUNDRED THOUSAND DOLLARS (\$100,000), IN ADDITION TO THE COST OF COMPENSATION, DAMAGES AS PROVIDED FOR IN SECTION 3706 OF THE LABOR CODE, INTEREST, AND ATTORNEY'S FEES.

I hereby affirm under penalty of perjury one of the following declarations:

____ I have and will maintain a certificate of consent to self-insure for workers' compensation, issued by the Director of Industrial Relations as provided for by Section 3700 of the Labor Code, for the performance of the work for which this permit is issued. Policy No. _____

X I have and will maintain workers' compensation insurance, as required by Section 3700 of the Labor Code, for the performance of the work for which this permit is issued. My workers' compensation insurance carrier and policy number are: Carrier ACE AMER. INS. Policy Number WLR C4322534 Expiration Date 8/1/14
 Name of Agent _____ Phone # _____

____ I certify that, in the performance of the work for which this permit is issued, I shall not employ any person in any manner so as to become subject to the workers' compensation laws of California, and agree that, if I should become subject to the workers' compensation provisions of Section 3700 of the Labor Code, I shall forthwith comply with those provisions.

Signature of Applicant _____

Date 8/29/13



TOWN OF LOS GATOS

COMMUNITY DEVELOPMENT DEPARTMENT
BUILDING DIVISION
PHONE: (408) 354-6876 FAX: (408) 354-7593
www.losgatosca.gov/building

CIVIC CENTER
110 E. MAIN STREET
P.O. Box 949
LOS GATOS, CA 95031

Application #

BUILDING DIVISION PERMIT APPLICATION

SITE ADDRESS 15116 Blossom Hill RD Suite _____ Today's Date _____

TYPE OF WORK TO BE DONE ☐ New ☐ Addition ☐ Alteration ☐ Repair ☒ Reroof ☐ Deck ☐ Pool/Spa ☐ Ret Wall

DETAILED DESCRIPTION OF WORK TO BE DONE INSTALL 405 S.F. OF VINYL SIDING TO EAST WALL OF SUN ROOM - INSIDE AND OUT. LIKE FOR LIKE.

PROJECT AREA	New/Add Sq. Ft.	Remodel/Alter Sq. Ft.	Reroof/Pool/Porch/Deck SF	Retaining Wall L.F.
1 st Floor	_____	_____	_____	_____
2 nd Floor	_____	_____	_____	_____
Attic/Basement/Cellar/Porch	_____	_____	_____	_____
Attached/Detached Garage	_____	_____	_____	_____

CONSTRUCTION VALUATION (Required): 6,291.04 Include costs of all labor and materials

BUILDING DETAILS: Heated? ☐ Cooled? ☐ # of Stories _____ ☐ Pre 1941/Historic District ☐ Has A Fire Sprinkler System

Is there a Swimming Pool and/or Spa located at this address: ☐ Yes ☐ No

Proposed Use of Building: RES Construction Type _____ Occupancy Type _____

CONTACT NAME JEFF RAINEY Phone _____ Fax _____
Address _____ City _____ Zip _____

Property Owner Name JACK GEORGE Phone (Required) _____
Address 15116 Blossom Hill RD City LOS GATOS Zip 95032

Architect/Engineer/Designer _____ License # _____ Phone _____
Address _____ City _____ Zip _____

Contractor Name SEARS HOME IMPROVEMENT, INC.
State License No. 721379 License Type B, C36, C20, D41, C17 Expires 04/30/14 Town Business Lic. No. _____

Commercial Tenant _____ Phone _____
Address _____ City _____ Zip _____

Please complete the Electrical, Mechanical & Plumbing details on reverse side

N:\DEV\FORMS\Building\BdgApplication.wpd





TOWN of LOS GATOS
Community Development
Building Permit

Permit ID/Type:	P16-054 BUILDING/PLUMBING/RESIDENTIAL/WATER HEATER	Applied:	04/06/2016
Work Description:	REPLACE WATER HEATER SAME LOCATION	Approved:	
Status:	ISSUEDONLINE	Issued:	<\$ISSUED_DATES>
Address:	15116 BLOSSOM HILL RD, LOS GATOS, CA 95032	Expires:	10/3/2016
Owner:	GEORGE JACK E;ELIZABETH J TRUSTEE 15116 BLOSSOM HILL RD LOS GATOS, CA CA 95032 AFFORDABLE WATER HEATERS	Phone:	408-252-8920
Contractor:	[REDACTED]		924-220-2500
License No.:	627368		

Job Value:	\$0.00	Buildings:	1
Total Sq. Ft.:	<\$SQUARE_FEET\$>	Houses:	0
Building Use:	Dwellings	Census #:	434
Occupancy Type:	R-3.1	Construction Type:	V-B

Total Fees	\$110.38
Total Payments	\$110.38
Balance Due	\$0.00

LICENSED CONTRACTOR'S DECLARATION

I hereby affirm under penalty of perjury that I am licensed under provisions of Chapter 9 (commencing with Section 7000) of Division 3 of the Business and Professions Code, and my license is in full force and effect.

License Class _____ California Contractor License No. _____
Expiration Date _____ Contractor Signature _____

WORKERS' COMPENSATION DECLARATION WARNING: FAILURE TO SECURE WORKERS' COMPENSATION COVERAGE IS UNLAWFUL, AND SHALL SUBJECT AN EMPLOYER TO CRIMINAL PENALTIES AND CIVIL FINES UP TO ONE HUNDRED THOUSAND DOLLARS (\$100,000), IN ADDITION TO THE COST OF COMPENSATION, DAMAGES AS PROVIDED FOR IN SECTION 3706 OF THE LABOR CODE, INTEREST, AND ATTORNEY'S FEES.

I hereby affirm under penalty of perjury one of the following declarations:

____ I have and will maintain a certificate of consent to self-insure for workers' compensation, issued by the Director of Industrial Relations as provided for by Section 3700 of the Labor Code, for the performance of the work for which this permit is issued. Policy No. _____

____ I have and will maintain workers' compensation insurance, as required by Section 3700 of the Labor Code, for the performance of the work for which this permit is issued. My workers' compensation insurance carrier and policy number are: Carrier _____ Policy Number _____ Expiration Date _____
Name of Agent _____ Phone # _____

____ I certify that, in the performance of the work for which this permit is issued, I shall not employ any person in any manner so as to become subject to the workers' compensation laws of California, and agree that, if I should become subject to the workers' compensation provisions of Section 3700 of the Labor Code, I shall forthwith comply with those provisions.

Signature of Applicant _____

Date _____