


Owner - Regent Homes, LLC
Deed Book R2762, Page 1255
Plat Book P23, Page 120



TAX MAP 133B, Group 'F', Parcel 46.00

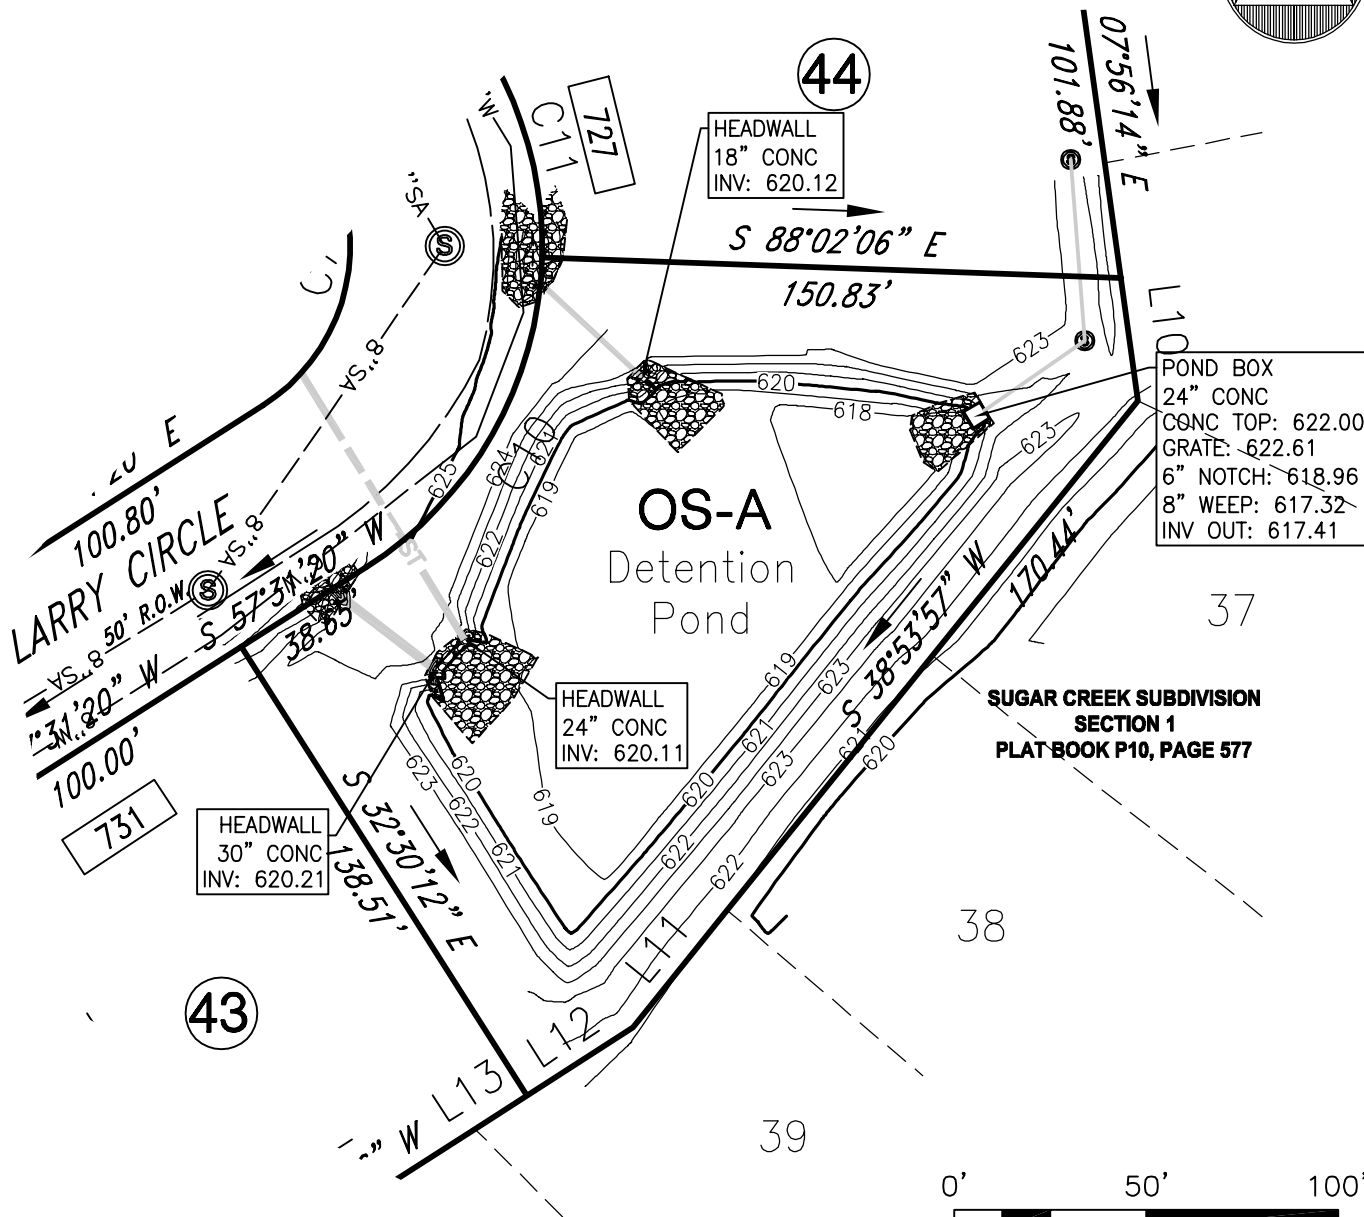

CIVIL ENGINEERING SURVEYING PLANNING
2486 Nashville Hwy
COLUMBIA, TN 38401
PHONE: (931) 388-2329

CLIENT:

Regent Homes, LLC
6901 Lenox Village Dr
Suite 107
Nashville, TN 37211

REVISION:

DATE:

PROJECT:

Pond As Built - Open Space A
Sugar Creek, Phase 3
Larry Circle
Mt. Pleasant, TN 38474

DRAWN BY: AO

SCALE: 1" = 50'

SHEET: 1 OF 1

PROJECT NO: 16612-10

DATE: 11-19-2024

SEAL

