



REFERENCES:
LAND COURT PLAN 30123 A
LAND COURT CERT. NO. 192999

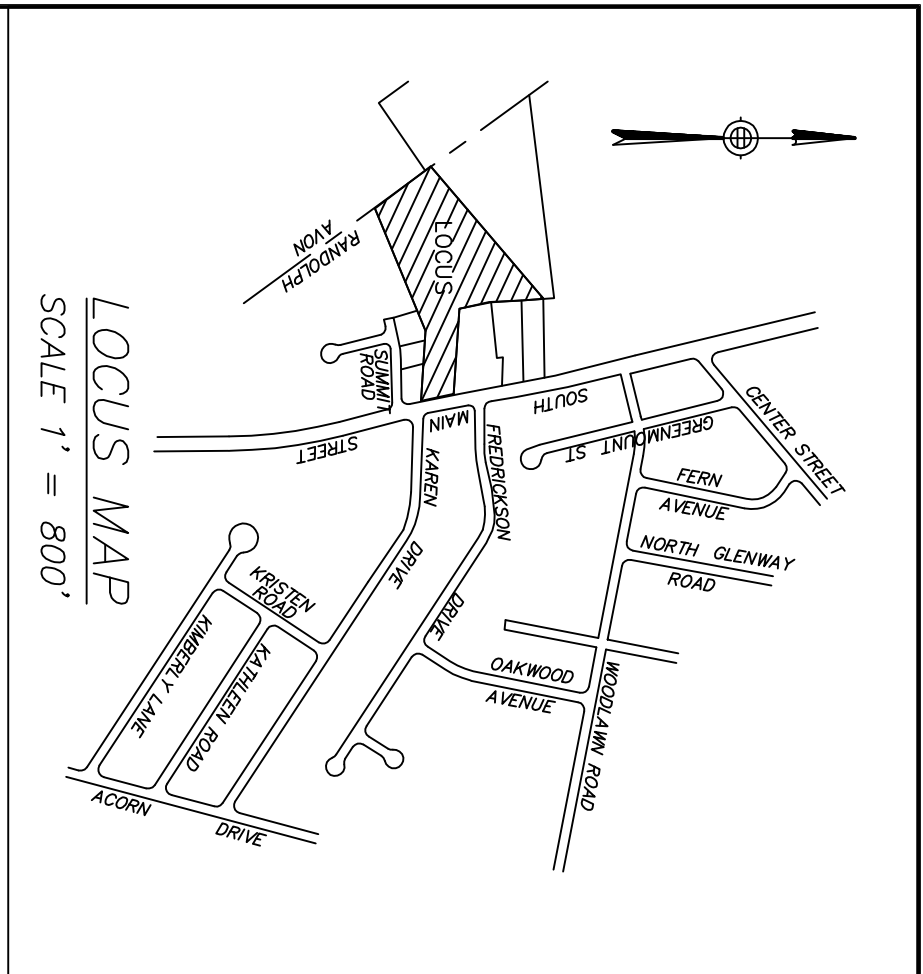

- LEGEND
- IP(F) IRON PIPE FOUND
 - SBAC(F) STONE BOUND BACK CENTER
 - CBAC(F) CONCRETE BOUND LEAD PLUG FOUND
 - SPK(S) SPIKE SET
 - × REC RECORD LOCATION
 - IR(S) IRON ROD SET
 - SR(M) STONE BOUND NOT FOUND

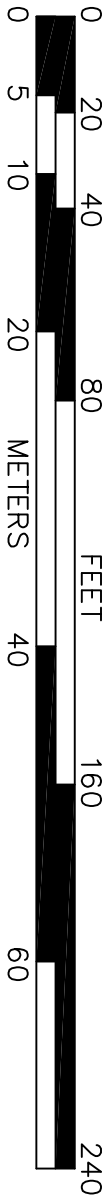

B.M. SWH RIM
E.L.=229.10 (NAD 88)

REVISIONS	
NO.	DATE
1	9-9-22
	SEWER AND DRAINAGE SHOULDER

BORDERLAND ENGINEERING, INC.

61b Pleasant Street
Randolph, Ma 02368

Office 781-963-9500
Fax 888-566-4131

INTERIM AS-BUILT PLAN

RANDOLPH, MASSACHUSETTS

PHAM ESTATES - MARY LEE WAY

OWNERS:

THUY PHAM AND HUNG T. PHAM
631 SOUTH MAIN STREET
RANDOLPH, MA 02368

DRAWING SCALE: 1 INCH = 40 FEET

DATE: MARCH 22, 2022 PROJECT NUMBER: P2094