


LOCUS PLAN



LOCUS
MAP 70
BLOCK A
LOT 12
8.0± ACRES

UNDERGROUND UTILITY NOTE:
ALL EXISTING UNDERGROUND UTILITY LOCATIONS, AS SHOWN ON THIS PLAN, ARE BASED ON CONTRACTOR PROVIDED INFORMATION. UNDERGROUND UTILITY LOCATIONS ARE APPROXIMATE AND MAY NOT REPRESENT ALL UNDERGROUND UTILITIES OR SERVICE LINES. CONTRACTOR IS RESPONSIBLE FOR VERIFYING EXACT LOCATIONS, DEPTH, SIZE AND TYPE OF UTILITIES OR SERVICE LINES PRIOR TO ANY FUTURE CONSTRUCTION. CONTRACTOR SHALL NOTIFY THE TOWN OF ANY DISCREPANCIES.

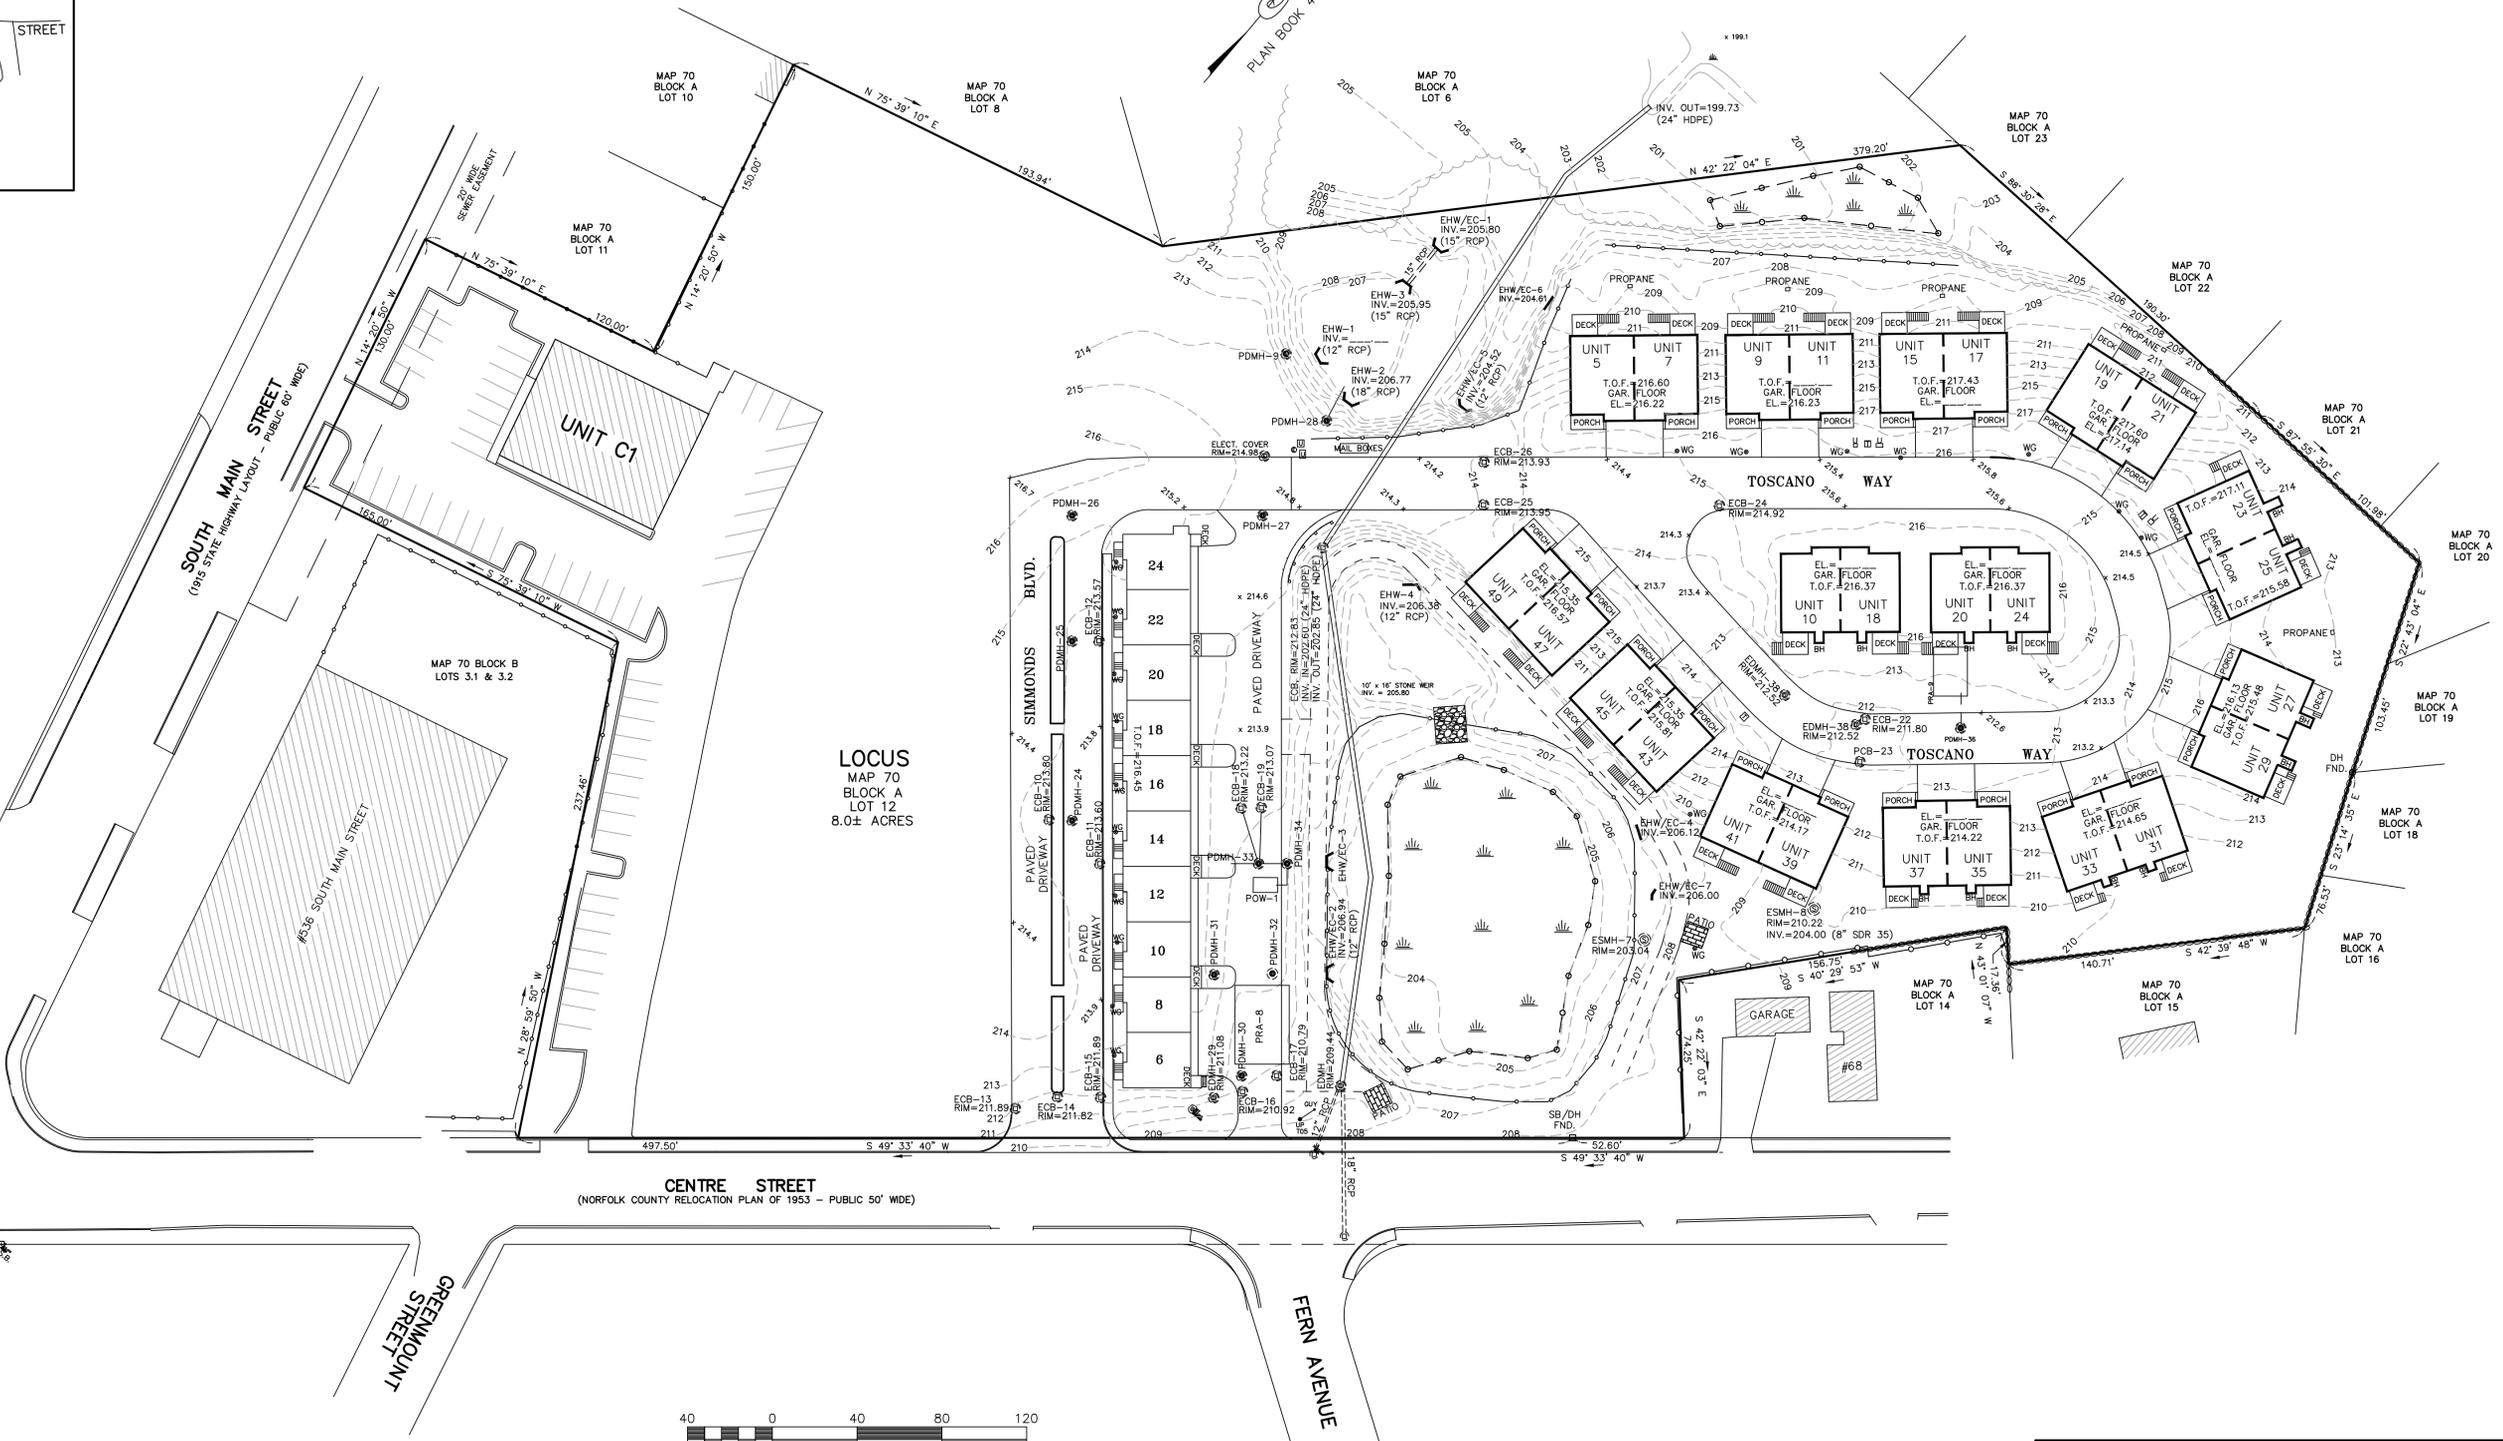

**PARTIAL AS-BUILT PLAN
THE VILLAGE AT CENTRE
STREET CROSSING CONDOMINIUM
RANDOLPH, MASSACHUSETTS**

PREPARED FOR:
502 MAIN STREET HOLDINGS LLC

SCALE: AS SHOWN DATE: 11-25-25
PROJECT NO. 17-020-043

COLLINS CIVIL ENGINEERING GROUP, INC.
BRAintree - FALMOUTH - WEST BRIDGEWATER, MA
CIVIL ENGINEERING - LAND SURVEY - L.S.P. SERVICES
225 SOUTH MAIN STREET, WEST BRIDGEWATER, MA 02379
TEL: 508-580-2332 MOBILE: 617-347-1363 E-MAIL: GRCPE@AOL.COM