FLAT TOP COTTAGE

39 OCEAN BLVD, SOUTHERN SHORES, NORTH CAROLINA



1) FRONT PERPECTIVE

LIST OF DRAWINGS

ARCHITECTURAL DRAWINGS

T1.1 TITLE SHEET A1.1 FIRST FLOOR

A1.2 ROOF FRAMING PLAN & ROOF PLAN

A2.1 ELEVATIONS

PROJECT NAME:

39 OCEAN BLVD SOUTHERN SHORES NORTH CAROLINA

REVISIONS:	DATE:
AS- BUILTS	6/26/19

DRAWING NAME:

TITLE SHEET

PRELIMINARY DRAWINGS NOT FOR CONSTRUCTION:

DRAWN BY:

SCALE: SEE PLANS


6 / 26 / 19


STAMP:

DATE:

SHEET

T1.1

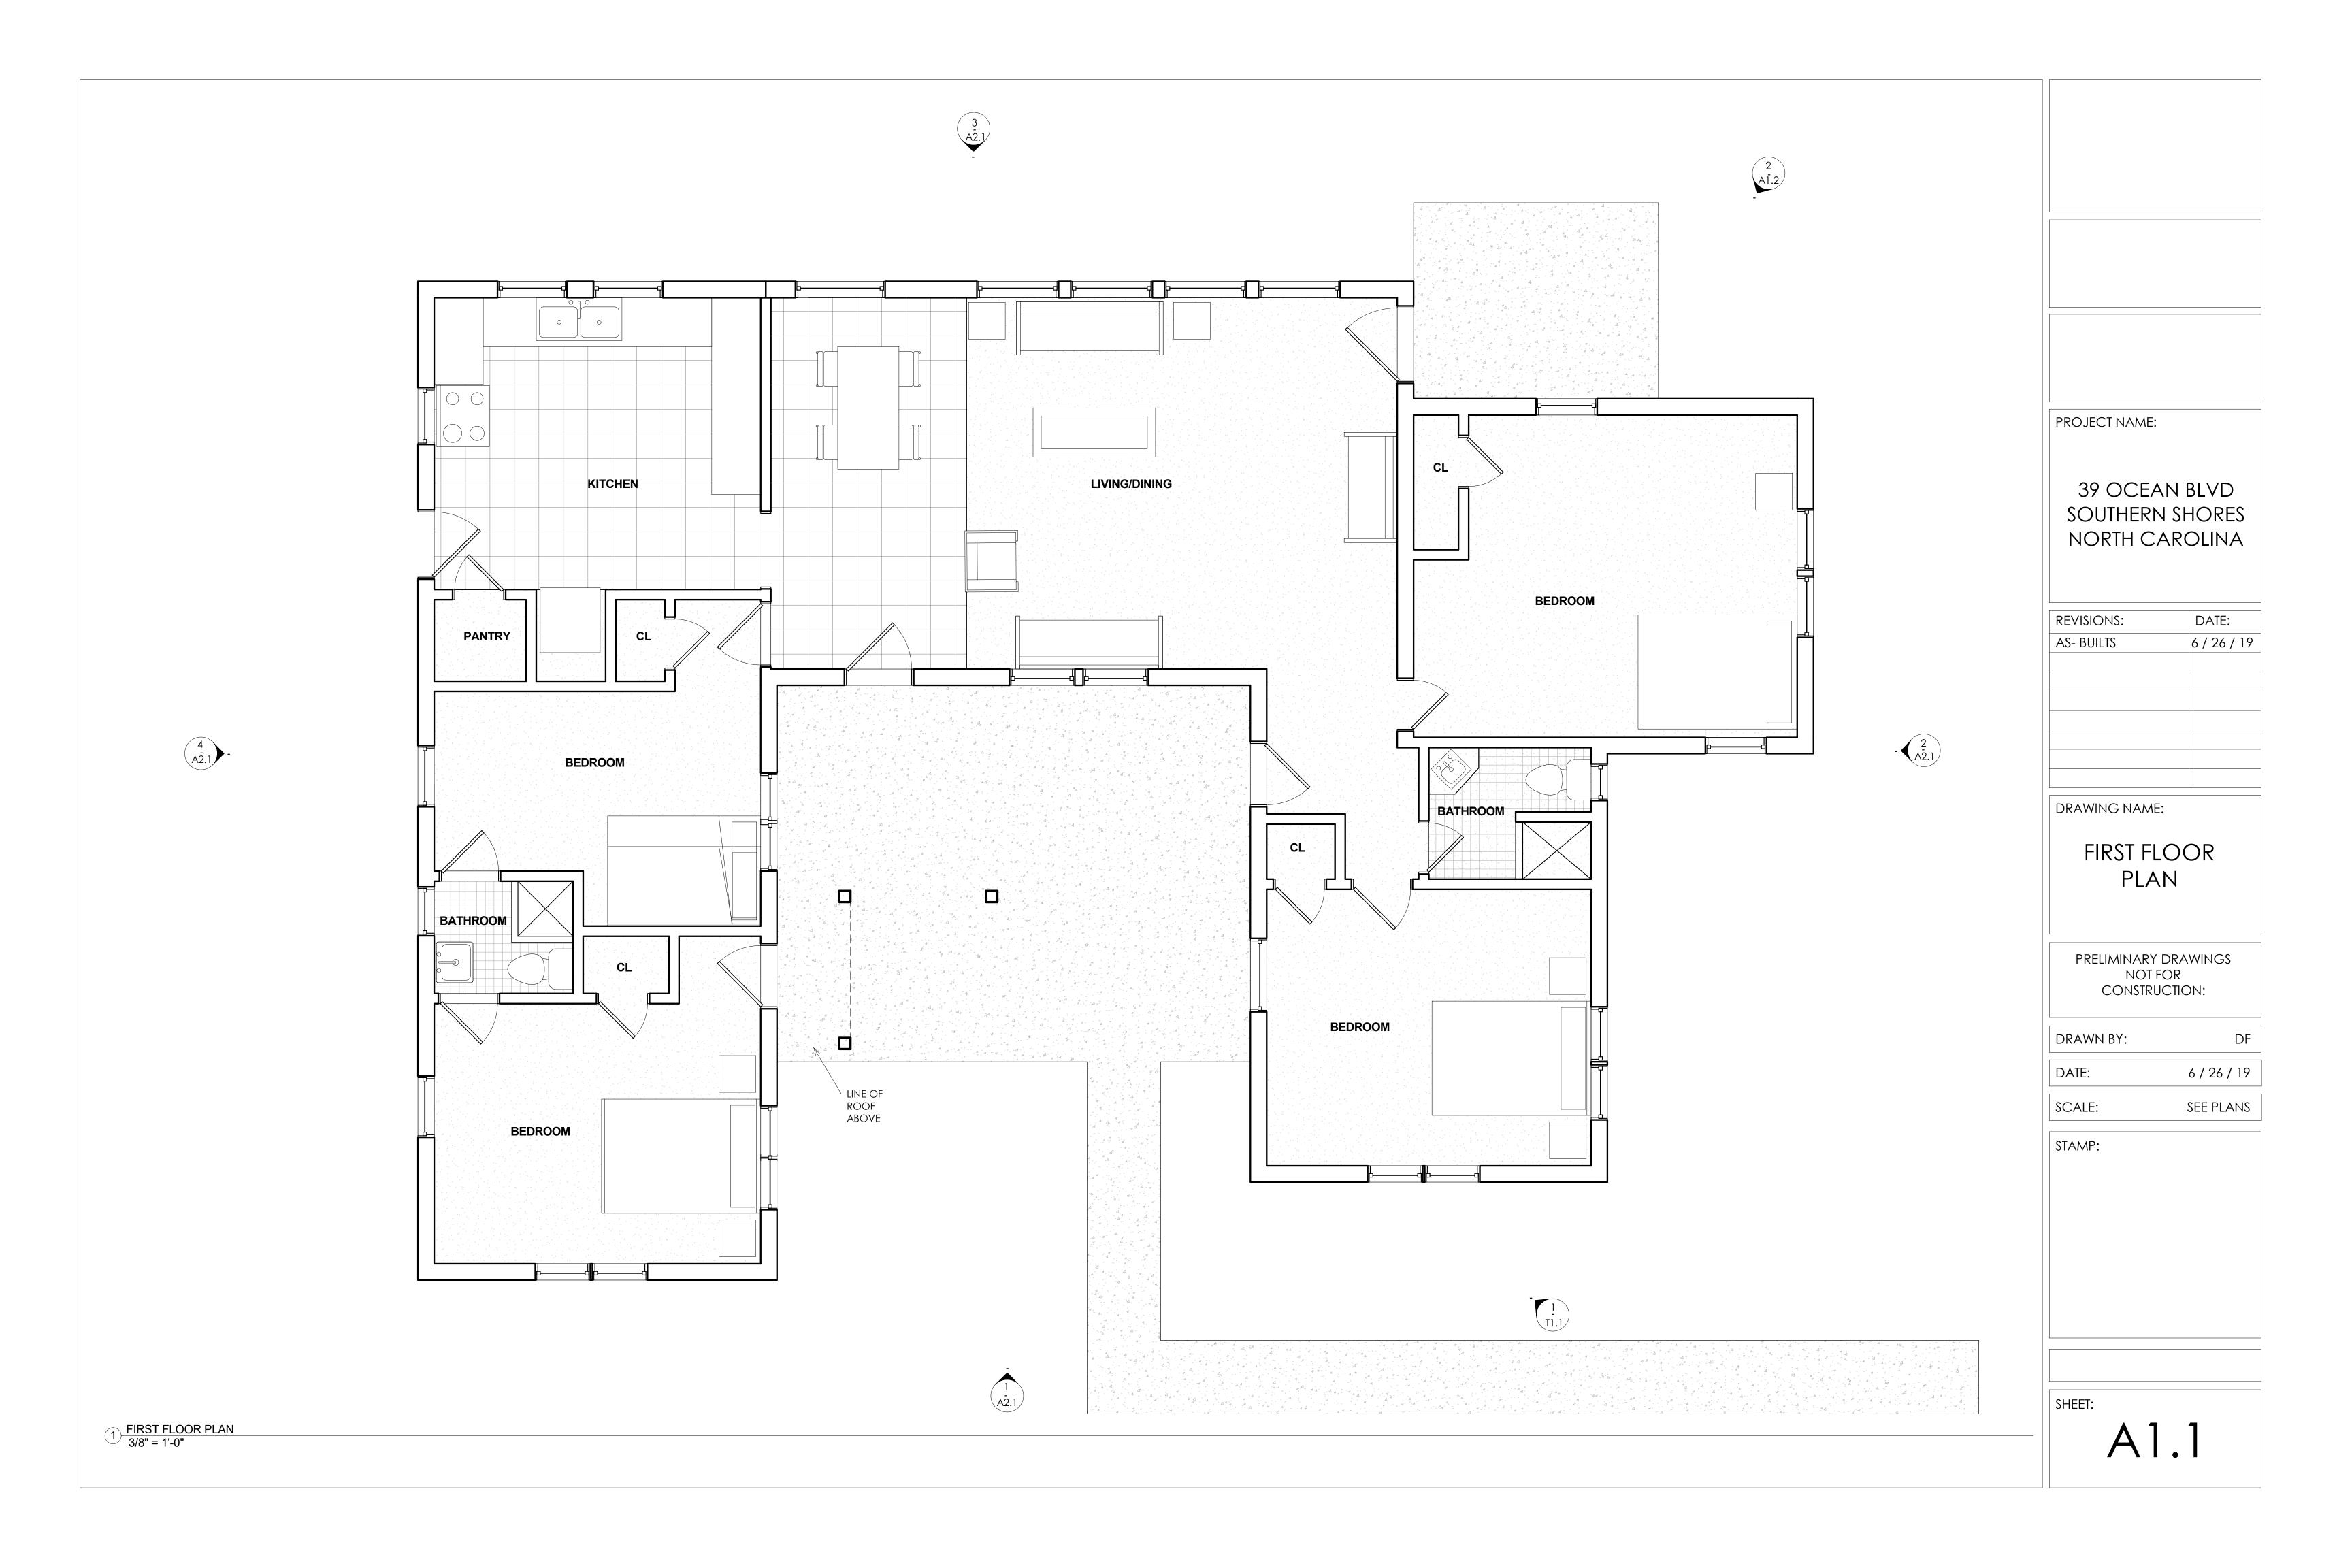

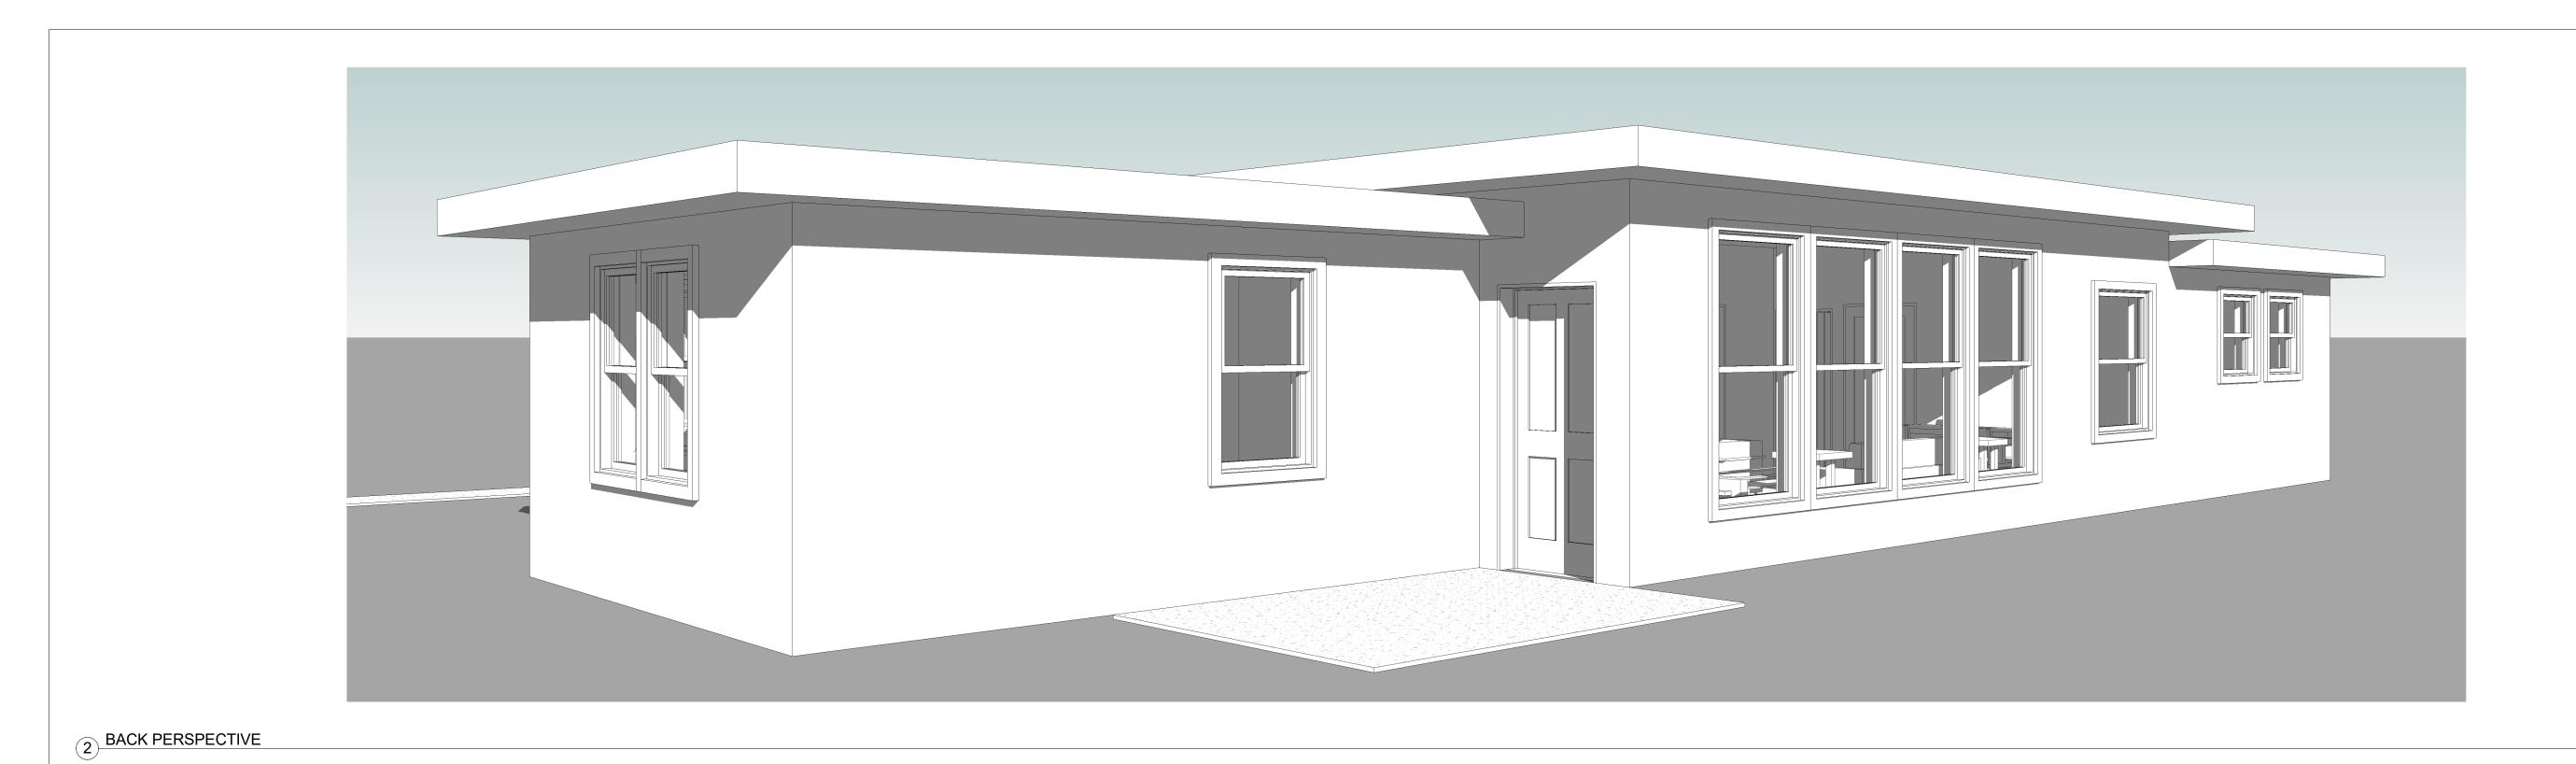

EXTERIOR
WALL BELOW,
TYP

1 ROOF PLAN 1/4" = 1'-0" PROJECT NAME:

39 OCEAN BLVD SOUTHERN SHORES NORTH CAROLINA

FLATROOP
OIL

THAT NOO

DATES OF THE PARTY O

REVISIONS: DATE:

AS-BUILTS 6 / 26 / 19

DRAWING NAME:

ROOF PLAN

PRELIMINARY DRAWINGS NOT FOR CONSTRUCTION:

DRAWN BY:

DATE: 6 / 26 / 19

SCALE: SEE PLANS

STAMP:

SHE

A1.2

