


TOPOGRAPHIC SURVEY OF A PORTION OF THE NORTHWEST QUARTER OF
THE NORTHWEST QUARTER OF SECTION 5, AND A PORTION OF GOVERNMENT
LOT 7 (THE FRACTIONAL NORTHEAST QUARTER OF THE NORTHEAST
QUARTER) OF SECTION 6, IN TOWNSHIP 17 NORTH, RANGE 2 WEST, W.M., IN
THURSTON COUNTY, WASHINGTON.


Attachment G

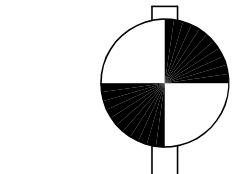

VERTICAL DATUM
NAVD 88
Contour Interval = 1'

SCALE: 1"=40'
0 20 40 80

LINE	BEARING	DISTANCE
L1	S 24°16'42" E	30.80
L2	S 88°07'15" E	30.00
L3	N 88°10'13" W	18.84
L4	S 88°11'19" E	150.00
L5	S 01°46'23" W	30.00

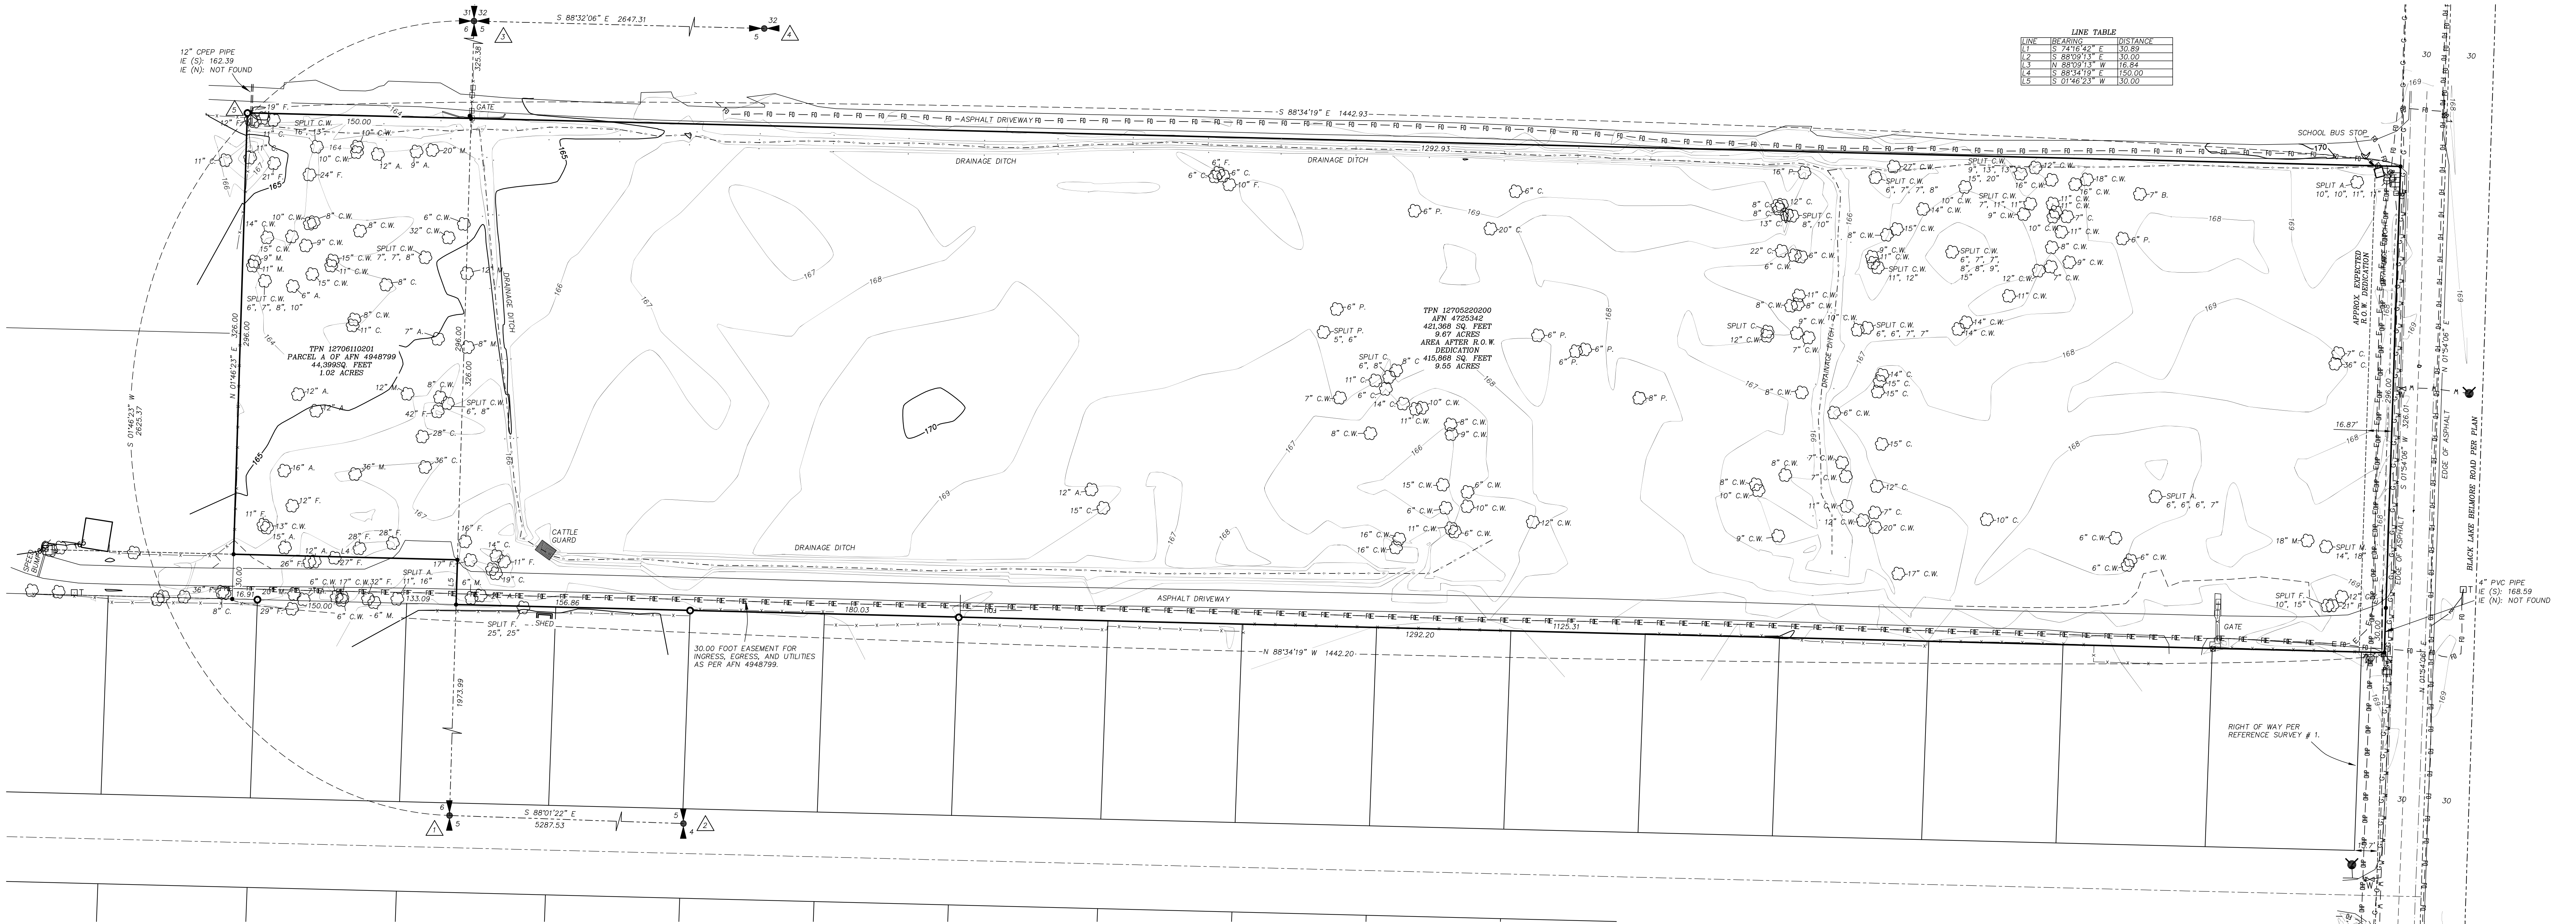

LEGEND

- FOUND CORNER AS NOTED
- FOUND 1/2" IRON PIPE
- CALCULATED POSITION
- WM WATER METER
- WV WATER VALVE
- PH FIRE HYDRANT
- UP UTILITY POLE
- PM POWER METER
- JB JUNCTION BOX
- GV GAS VALVE
- TP TELEPHONE PEDESTAL
- SM SANITARY SINKER MANHOLE
- FL FENCE LINE
- TREE
- MB MAILBOX
- X" F. SIZE FIR
- X" A. SIZE ALDER
- X" M. SIZE MAPLE
- X" C.W. SIZE COTTONWOOD
- X" P. SIZE PINE
- X" C. SIZE CEDAR
- W — WATER LINE
- RD — COMMUNICATIONS LINE
- E — UNDERGROUND ELECTRIC
- G — GAS LINE
- DP — OVERHEAD POWER

- △ WEST QUARTER CORNER OF SECTION 5-T17N-R2W, THURSTON COUNTY CONTROL POINT # 958, FOUND 3" BRASS THURSTON COUNTY MONUMENT IN INTERSECTION OF 66TH AVENUE AND FAIRVIEW ROAD AND HELD FOR BASIS OF BEARINGS AND ELEVATIONS (2024).
- △ EAST QUARTER CORNER OF SECTION 5-T17N-R2W, THURSTON COUNTY CONTROL POINT # 959, FOUND 3" BRASS THURSTON COUNTY MONUMENT IN INTERSECTION OF 66TH AVENUE AND KIRKOP ROAD AND HELD FOR ROTATION OF BEARINGS (2024).
- △ NORTHWEST CORNER OF SECTION 5-T17N-R2W, THURSTON COUNTY CONTROL POINT # 7597, FOUND 2" BRASS MONUMENT IN CONCRETE AT 2 WAY FENCE CORNER (2024).
- △ NORTH QUARTER CORNER OF SECTION 5-T17N-R2W, THURSTON COUNTY CONTROL POINT # 6486, FOUND BRASS PIN SET IN 10" BY 10" CONCRETE SQUARE (2024).
- △ FOUND 1/2" IRON PIPE WITH CAP PLS 5154 AS PER REFERENCE SURVEY # 3 (2024).
- △ FOUND 2" BRASS MONUMENT PLS 29538 AS PER REFERENCE SURVEY # 5 (2024).
- △ FOUND 2" BRASS MONUMENT ON EAST RIGHT OF WAY AS PER REFERENCE SURVEY # 5 (2024).



BASIS OF BEARINGS: WASHINGTON STATE PLANE SOUTH ZONE (NAD 83/2010)
AS PER TIES TO THURSTON COUNTY CONTROL POINTS # 958 AND # 959
HELD THE PUBLISHED COORDINATE AT # 958 AND APPLIED THE COMBINED
SCALE FACTOR OF 0.999934861 TO PRODUCE THE DISTANCES SHOWN HEREON.

BASIS OF ELEVATIONS: NORTH AMERICAN VERTICAL DATUM OF 1988 (NAVD
88) DERIVED FROM TIES TO THURSTON COUNTY CONTROL POINT # 958
HAVING A PUBLISHED ELEVATION OF 164.02' (NAVD 88).

REFERENCE SURVEYS:

- 1) W.F. KROGER, PLS 5452, APN 799858 (1989)
- 2) S.R. STILLWELL, PLS 18928, APN 850925000 (1985)
- 3) S.R. STILLWELL, PLS 18928, APN 940819000 (1994)
- 4) L.S. PANTIER, PLS 20073, APN 3439029 (2002)
- 5) S.L. AZELINE, PLS 29538, APN 4320843 (2013)
- 6) T.E. BATTY, PLS 30425, APN 4987624 (2023)

METHOD OF SURVEY: GNSS OBSERVATIONS USING JAVAD TRIUMPH LS
RECEIVERS. THIS SURVEY MEETS OR EXCEEDS PRECISION REQUIREMENTS AS
SET FORTH IN WAC 332-130-090.

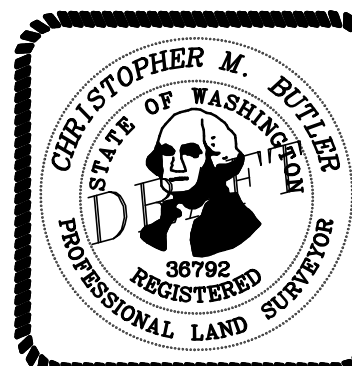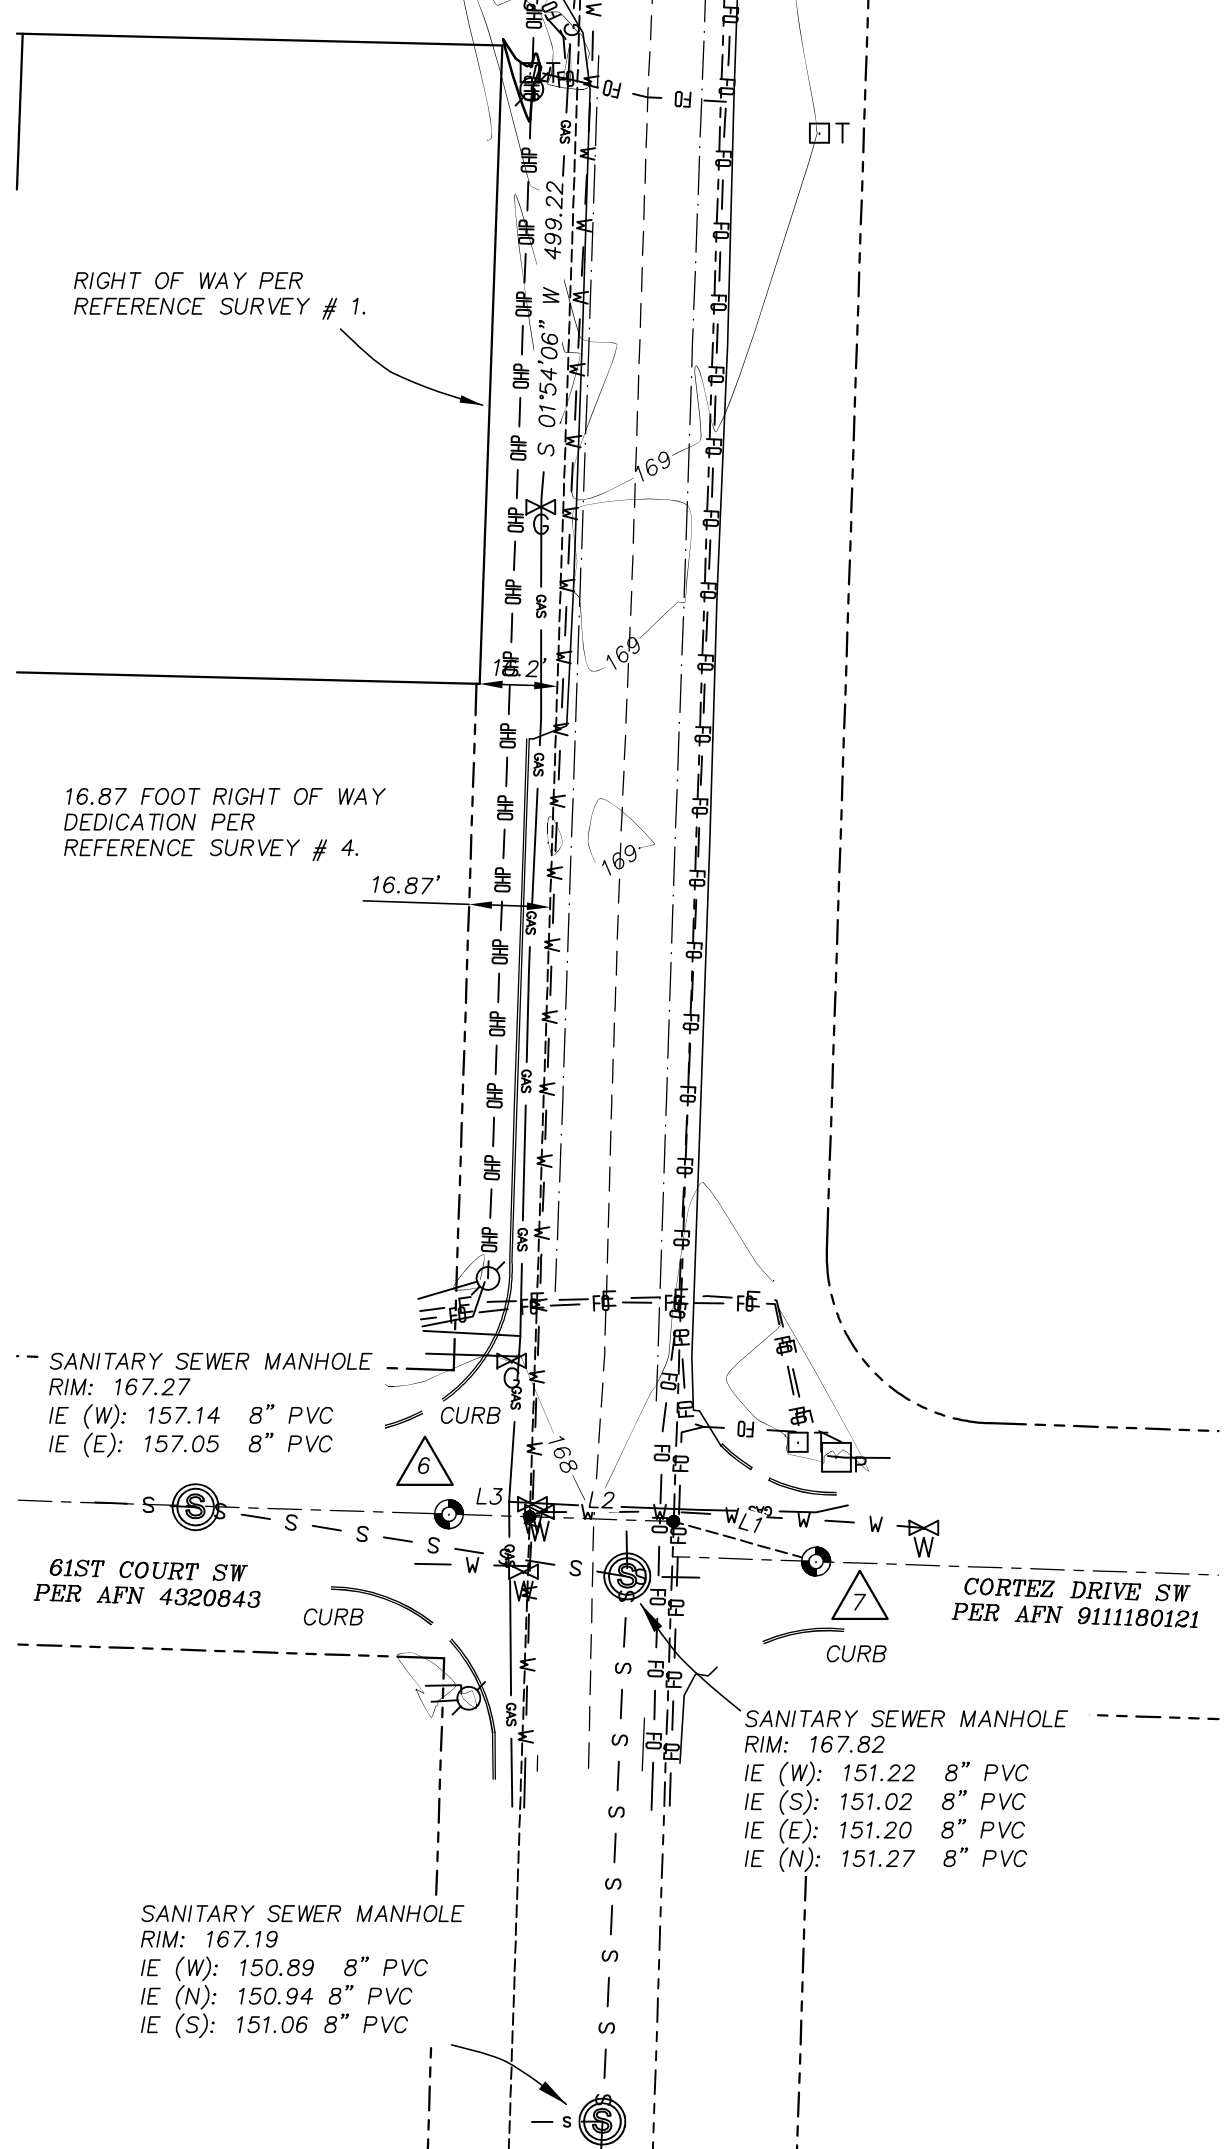

BUTLER SURVEYING INC.
475 NW CHEHALIS AVENUE
P.O. BOX 148 CHERALIS, WA 98532
360/748-8803

Drawn: RAW Date: 10/04/2024
Checked: RAW/CB Job No.: 24-287
Scale: 1" = 40' Sheet 1 of 1