



1st Floor



Elevation drawing of exterior
kitchen window and vent placement

[illegible]

Cooke Exterior Kitchen wall

Cornerstone Home Solutions
6713 Huntland Dr
Bealeton, VA. 22712

DATE:


/16/2024

SCALE:


SHEET:

1P-1

Red line denotes new remodel.
Black line is existing.

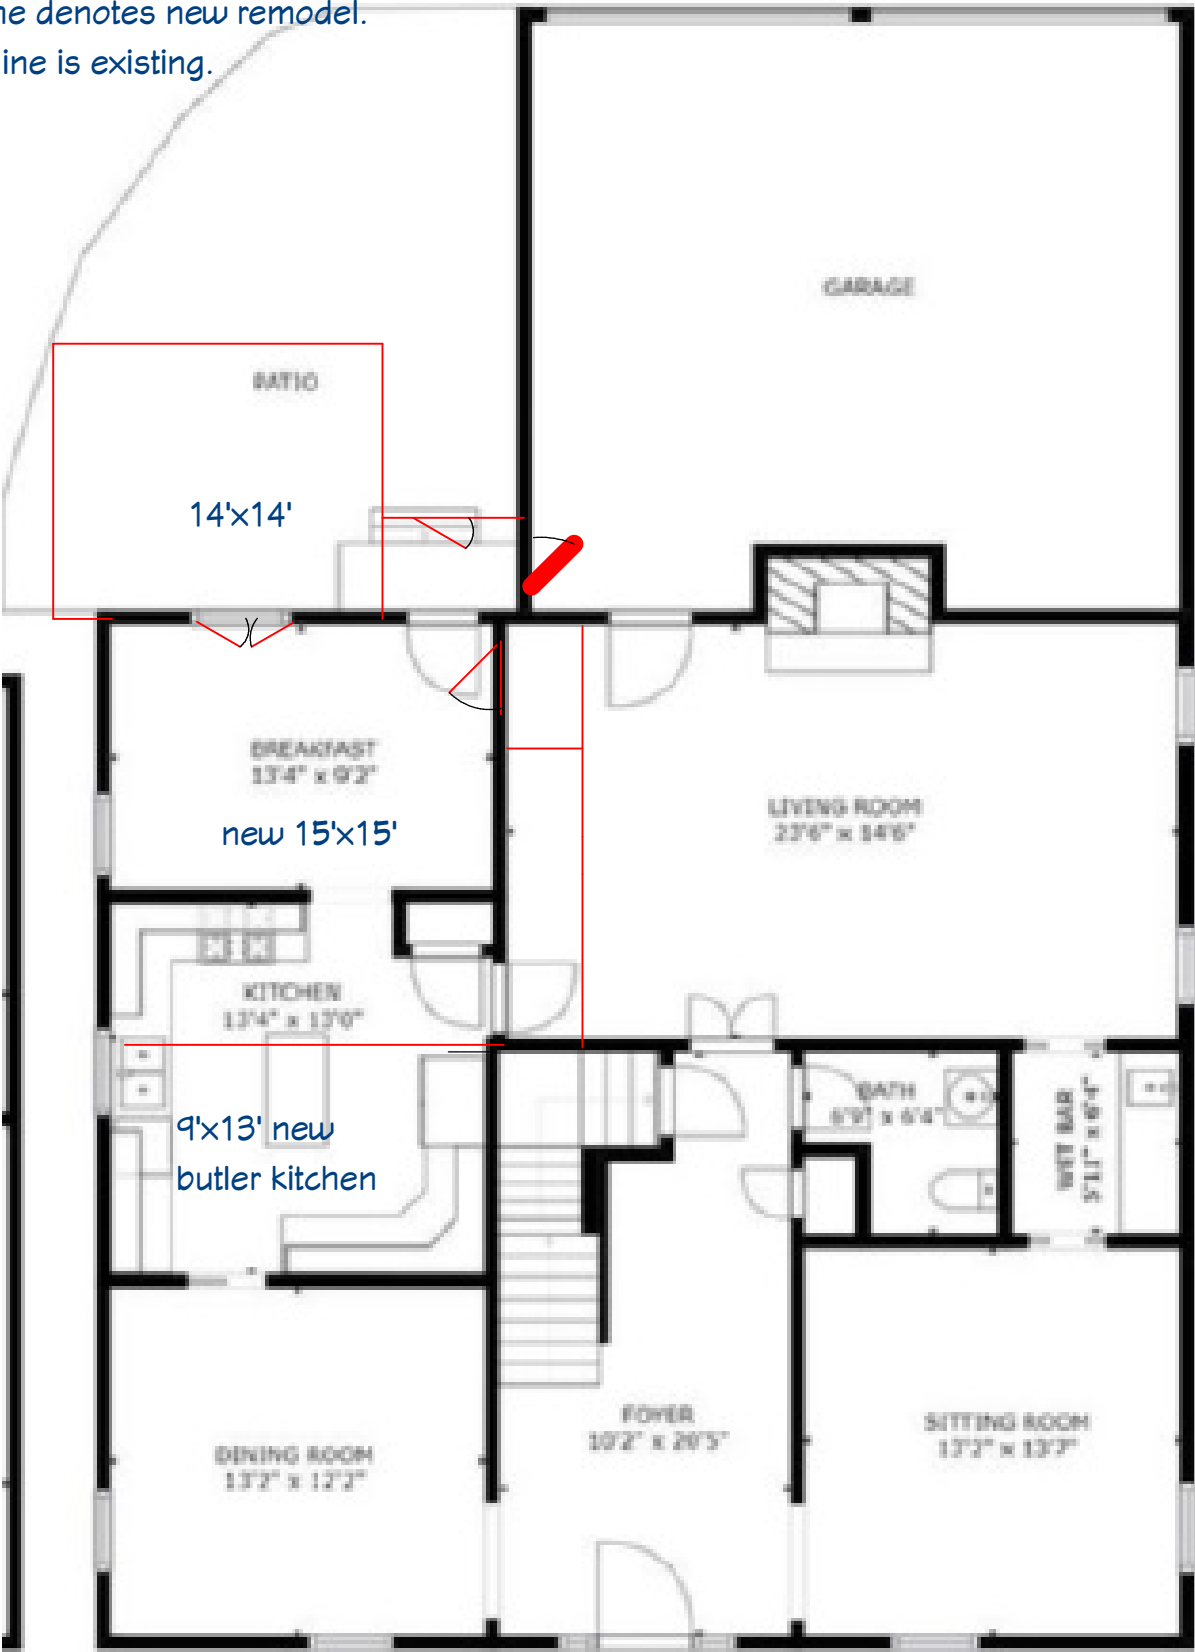

Existing first floor layout

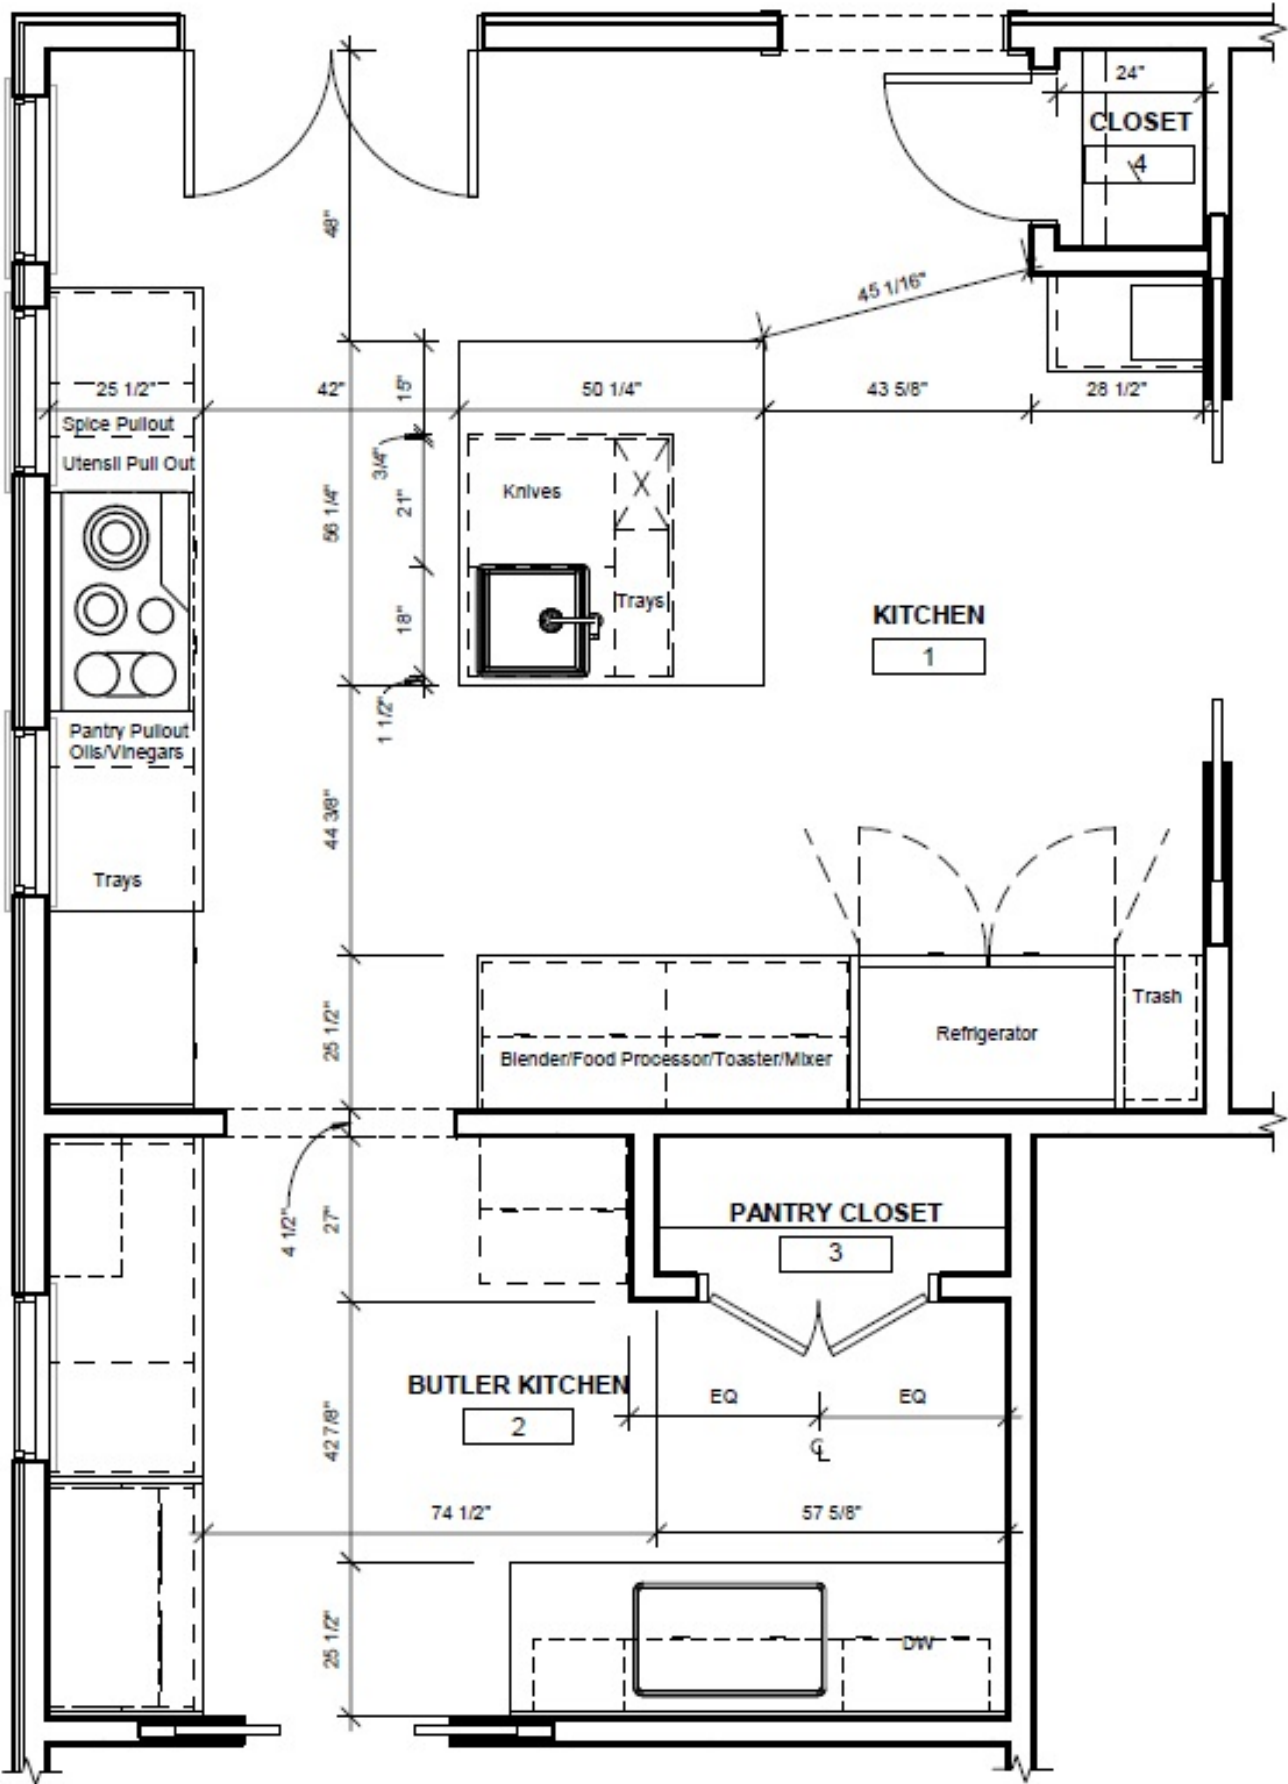

New kitchen breakfast area layout


REVISION TABLE	
NUMBER	DATE

DATE:
7/16/2024



SCALE:

SHEET:
1

DRAWINGS PROVIDED BY:
Cornerstone Home Solutions
6713 Huntland Dr
Beaeton, VA, 22712

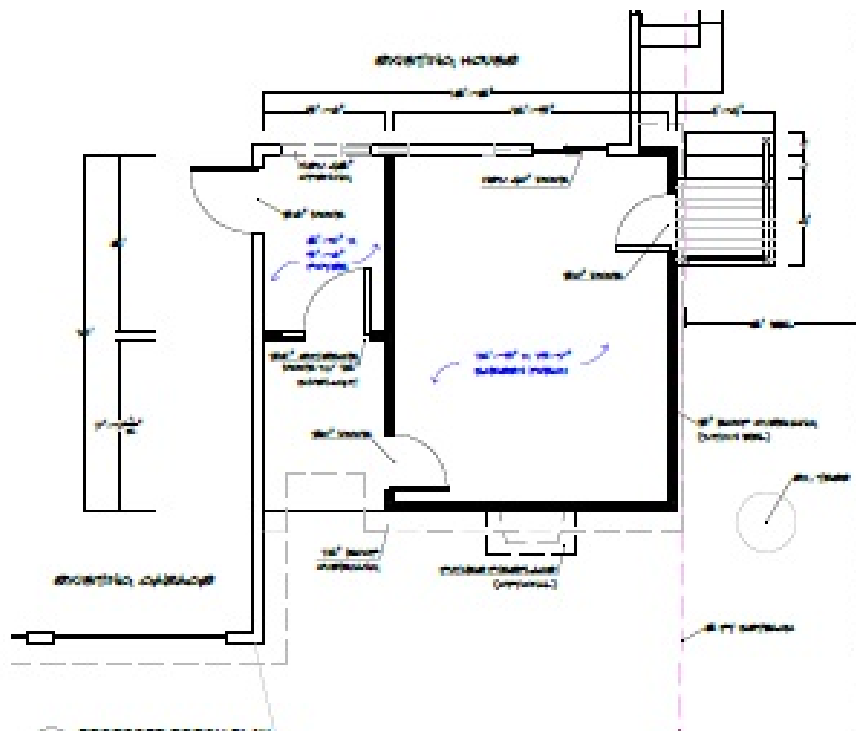


3 PROPOSED PORCH PLAN
A1 Scale: 1/4" = 1'-0"

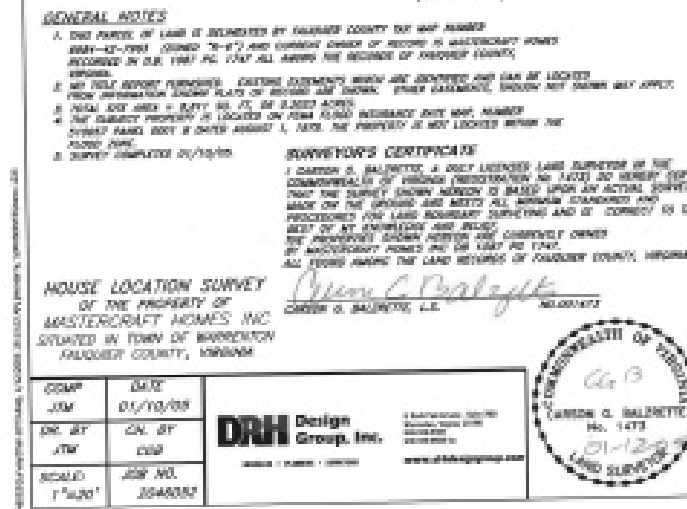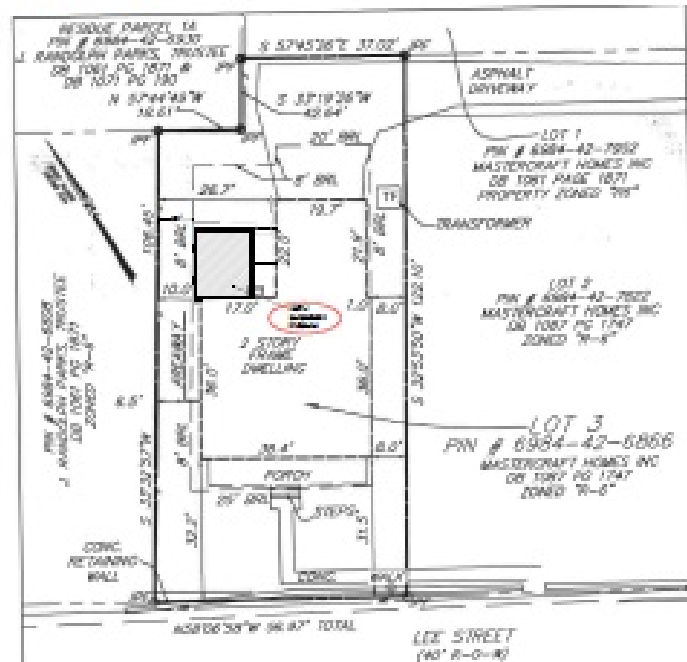


3 PLAT OVERLAY FOR ZONING
A1 Scale: 1" = 20'




3 PROPOSED PORCH FRONT ELEVATION
A1 Scale: 1/4" = 1'-0"

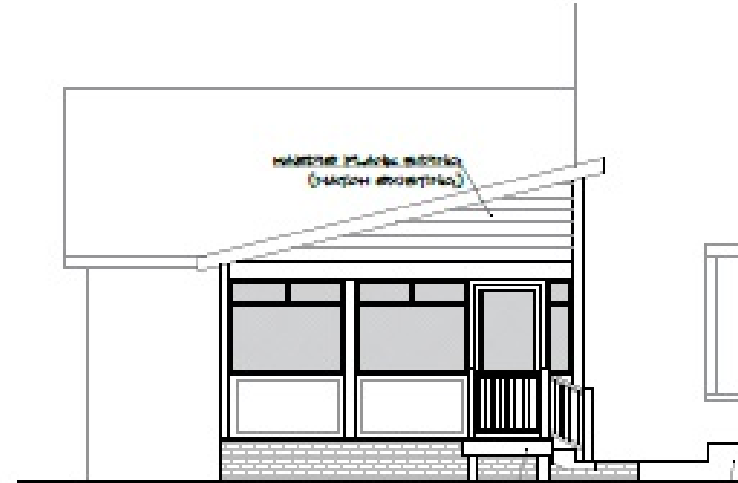

4 PROPOSED PORCH SIDE ELEVATION A
A1 Scale: 1/4" = 1'-0"

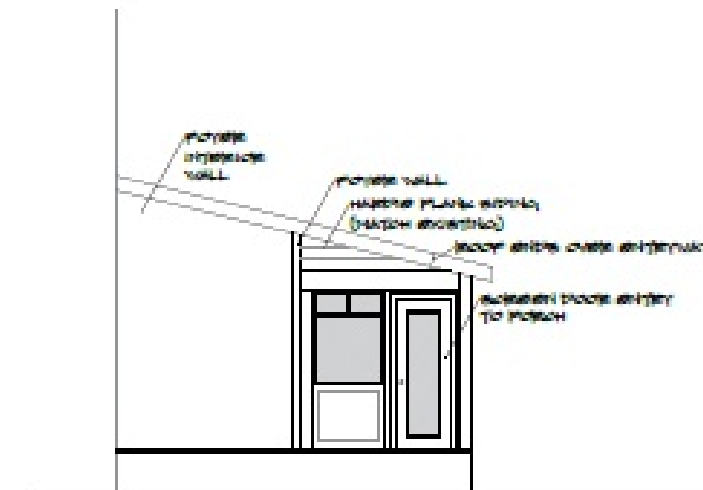

5 PROPOSED SIDE ELEVATION B
A1 Scale: 1/4" = 1'-0"

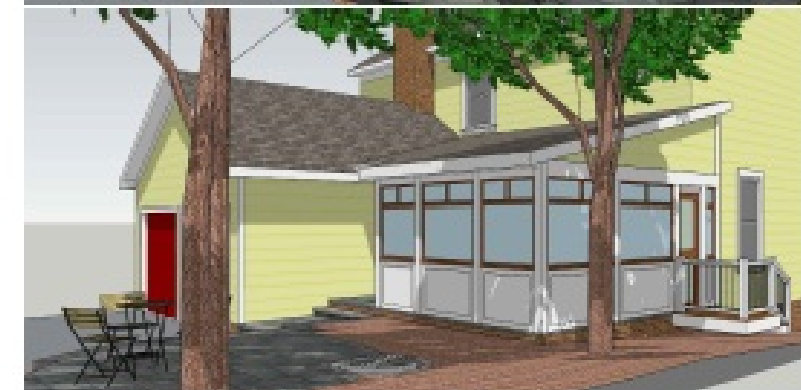

Railing to be iron railing to match existing basement railing.

6 3D RENDERINGS
A1 Scale: not to scale

REVISION TABLE	
NUMBER	DATE

DRAWINGS PROVIDED BY:
Cornerstone Home Solutions
6713 Huntland Dr
Beaeton, VA 22712

DATE:

7/16/2024

SCALE:

SHEET:

1