

STREET AND UTILITY CONSTRUCTION

FOR THE


CITY OF WHITEWATER, WISCONSIN

JEFFERSON\WALWORTH COUNTIES

JULY 1998


STANDARD SYMBOLS

	AREA OF SITE		EXISTING CONTOUR LINES
	CORPORATE LIMITS		NEW CONTOUR LINES
	PROPERTY LINE AND/OR RIGHT OF WAY		EXISTING DEPRESSION
	RIGHT-OF-WAY MARKERS		TOP OF CUT OR BERM
	CONSTRUCTION EASEMENT ON SEWER AND WATER PLANS		SPOT ELEVATION
	PERMANENT EASEMENT ON SEWER AND WATER PLANS		FINISH SPOT ELEVATION
	SECTION LINE		EXISTING WATER MAIN AND VALVE MANHOLE
	CENTER LINE		NEW WATER MAIN AND VALVE MANHOLE
	SOIL BORING		EXISTING WATER MAIN AND VALVE IN ROAD BOX
	BENCH MARK		NEW WATER MAIN AND VALVE IN ROAD BOX
	PROPERTY STAKE		EXISTING WATER MAIN AND FIRE HYDRANT
	PRIVATE WELL		NEW WATER MAIN AND FIRE HYDRANT WITH AUXILIARY VALVE
	GAS PUMP		EXISTING SANITARY SEWER AND MANHOLE
	EXISTING UTILITY POLE		NEW SANITARY SEWER AND MANHOLE
	NEW UTILITY POLE		EXISTING STORM SEWER AND MANHOLE
	BURIED TELEPHONE CABLE PEDESTAL		NEW STORM SEWER AND MANHOLE
	PRIVATE WASTEWATER DISPOSAL SYSTEM VENT PIPE		EXISTING FORCE MAIN
	SIGN		NEW FORCE MAIN
	LIGHT POLE		VALVE MANHOLE ON FORCE MAIN
	OBJECTS TO BE REMOVED		AIR RELEASE VALVE IN MANHOLE
	DECIDUOUS TREE		WYE BRANCH
	CONIFEROUS TREE		RISER
	DECIDUOUS SHRUBS		MODIFIED RISER
	CONIFEROUS SHRUBS		CASING PIPE
	INTERMITTENT STREAM		TELEPHONE OR TV CABLE AND MANHOLE
	STREAM OR RIVER		GAS MAIN
	WETLAND AREA		UNDERGROUND ELECTRIC CABLE
	LAKE OR POND		EXISTING WATER MAIN, SEWER, MANHOLE, AND FORCE MAIN IN PROFILE
	TRAIL, LOGGING ROAD, ETC.		NEW WATER MAIN, SEWER, MANHOLE, AND FORCE MAIN IN PROFILE
	UNPAVED ROAD		EXISTING CULVERT IN PROFILE
	PAVED ROAD - FLEXIBLE PAVEMENT		NEW CULVERT IN PROFILE
	PAVED ROAD - RIGID PAVEMENT		NEW GRADE LINE
	RAILROAD - LARGE SCALE		SLOPE INTERCEPT
	RAILROAD - SMALL SCALE		ORIGINAL GROUND IN PROFILE
	BRIDGE		ROCK IN PROFILE
	EXISTING CULVERT		SURVEY OR REFERENCE LINE
	FENCE		POINT OF INTERSECTION
	GUARD RAIL		POINT ON REFERENCE LINE
	EXISTING CURB, GUTTER AND INLET		BUILDING IN PROFILE
	NEW CURB, GUTTER AND INLET		DIRECTION OF TRAFFIC
	REJECT CURB		NOTATION FOR COMBUSTIBLE FLUIDS
	TRANSITION CURB		
	BUILDING IN PLAN		

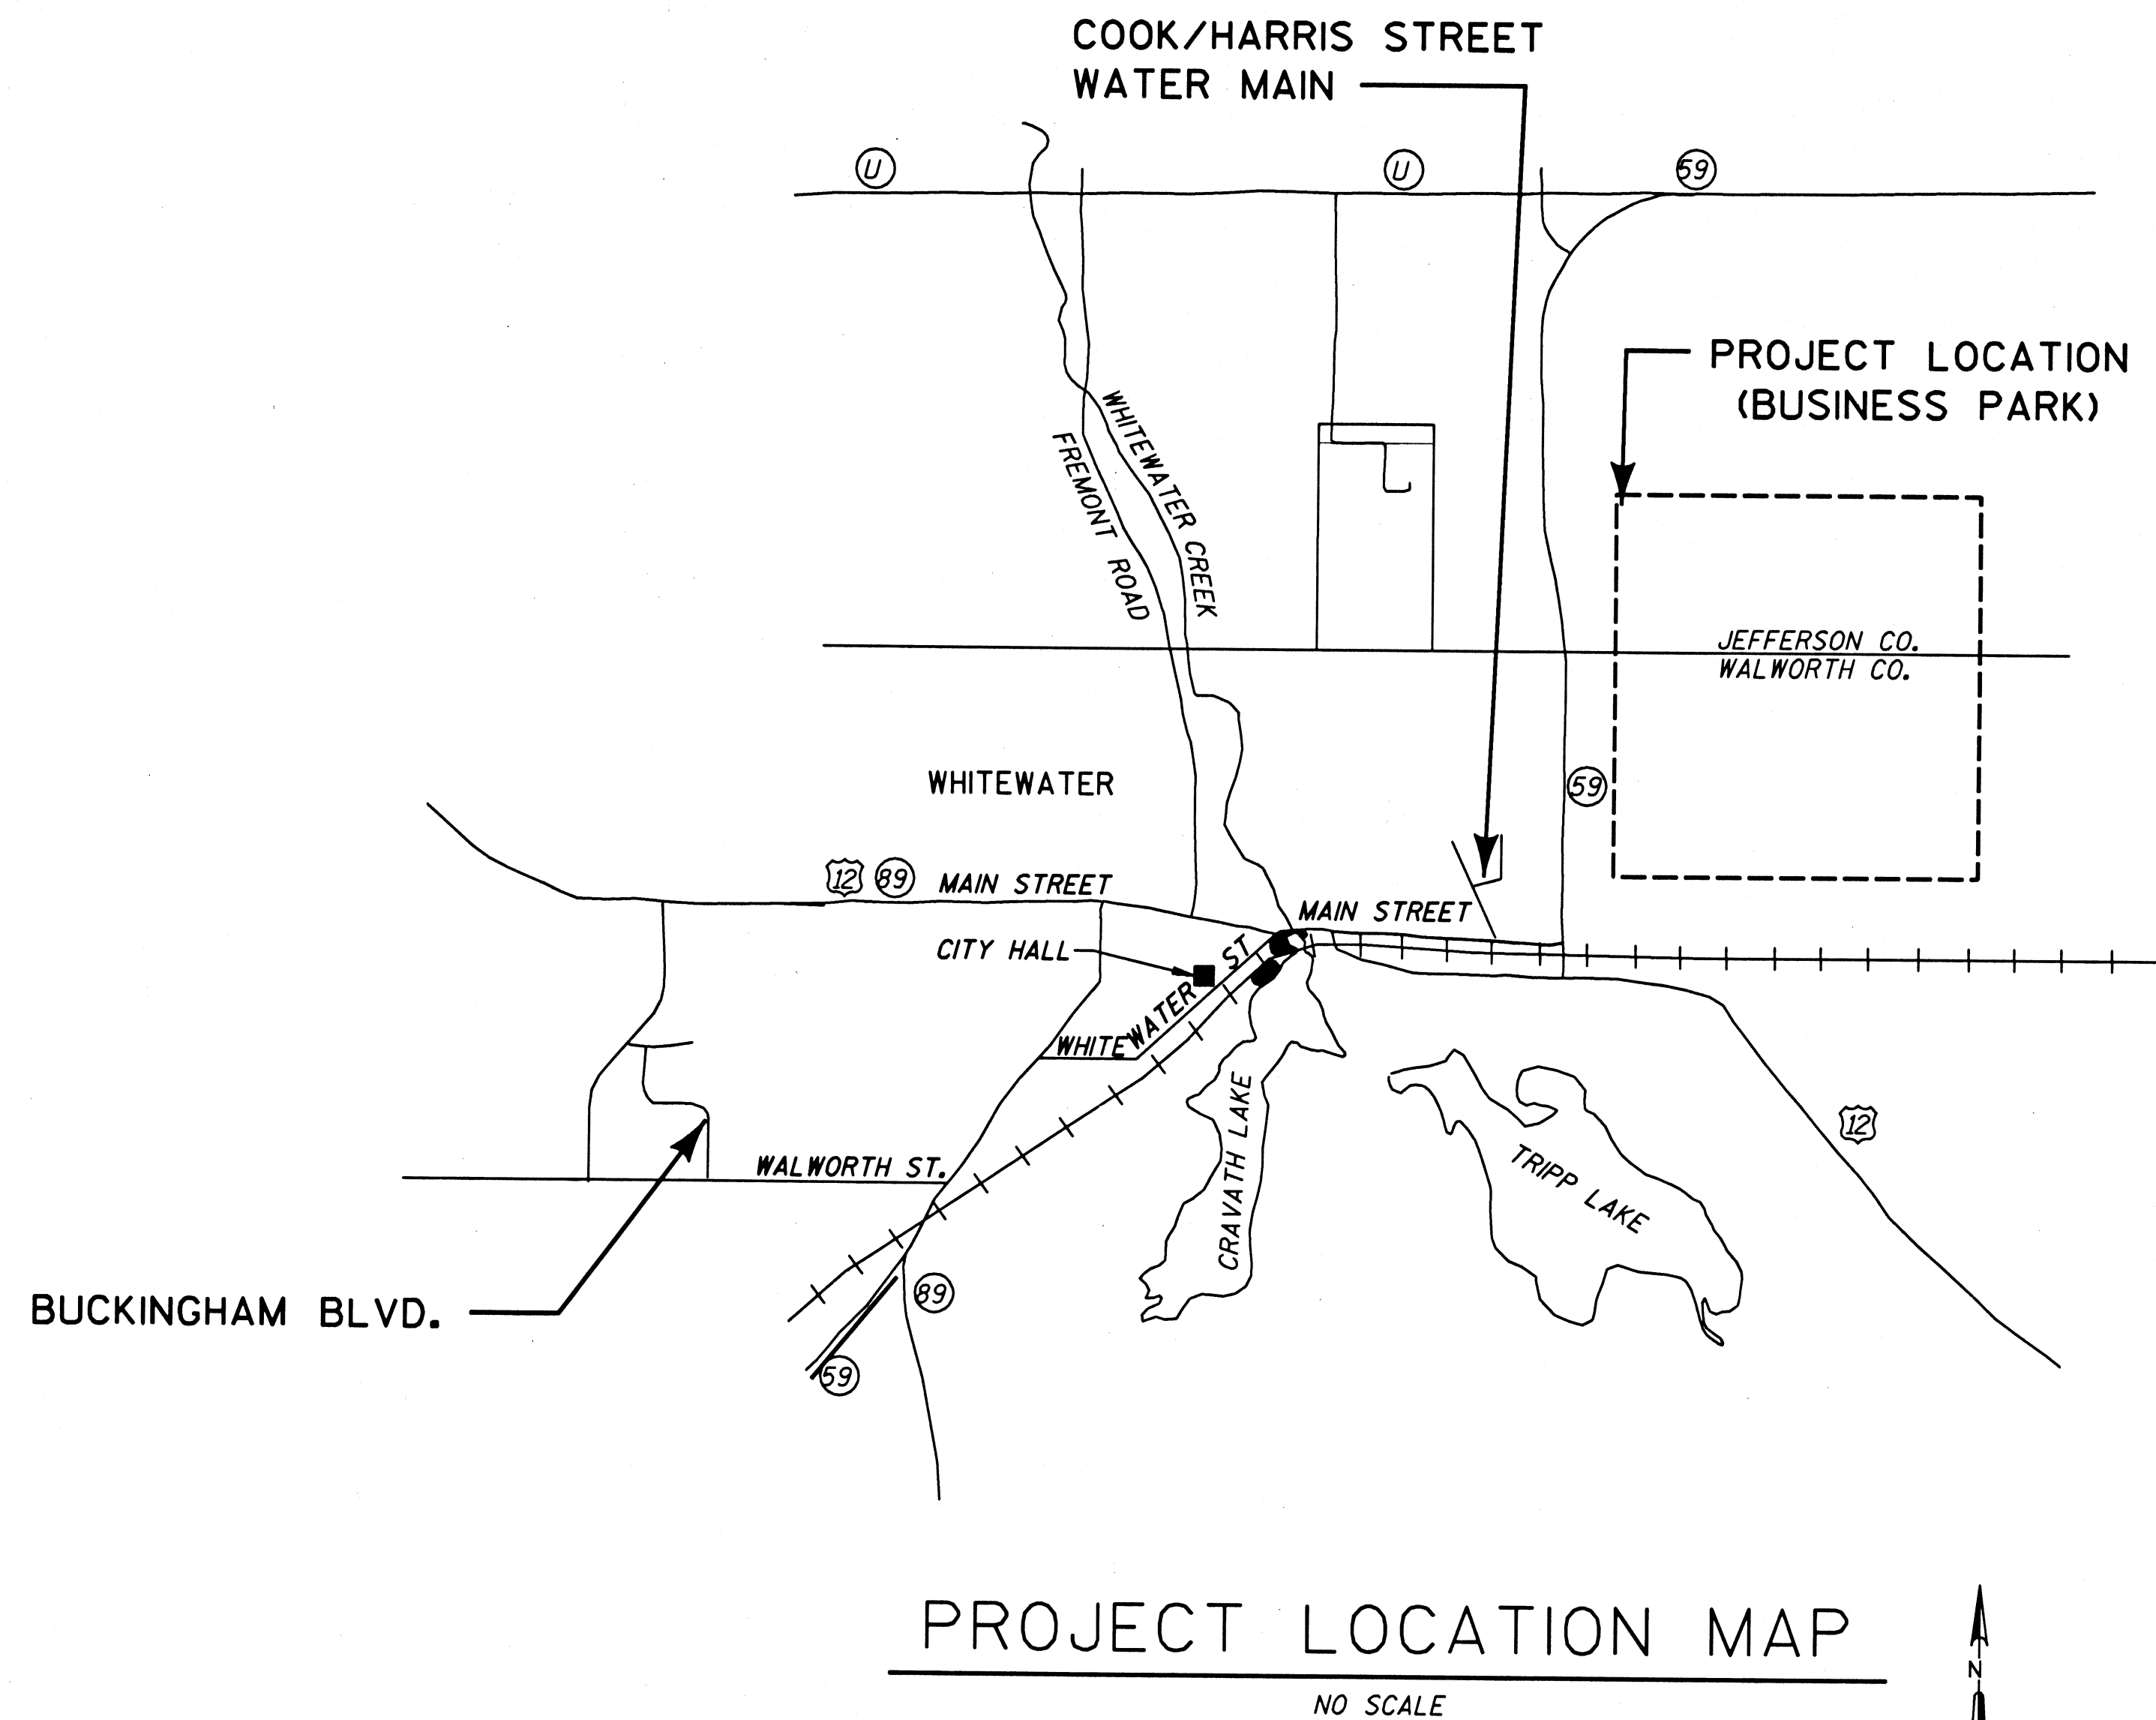

DNR SEWER APPROVAL
NO. 98-1069

CONTRACT NO. 3-98

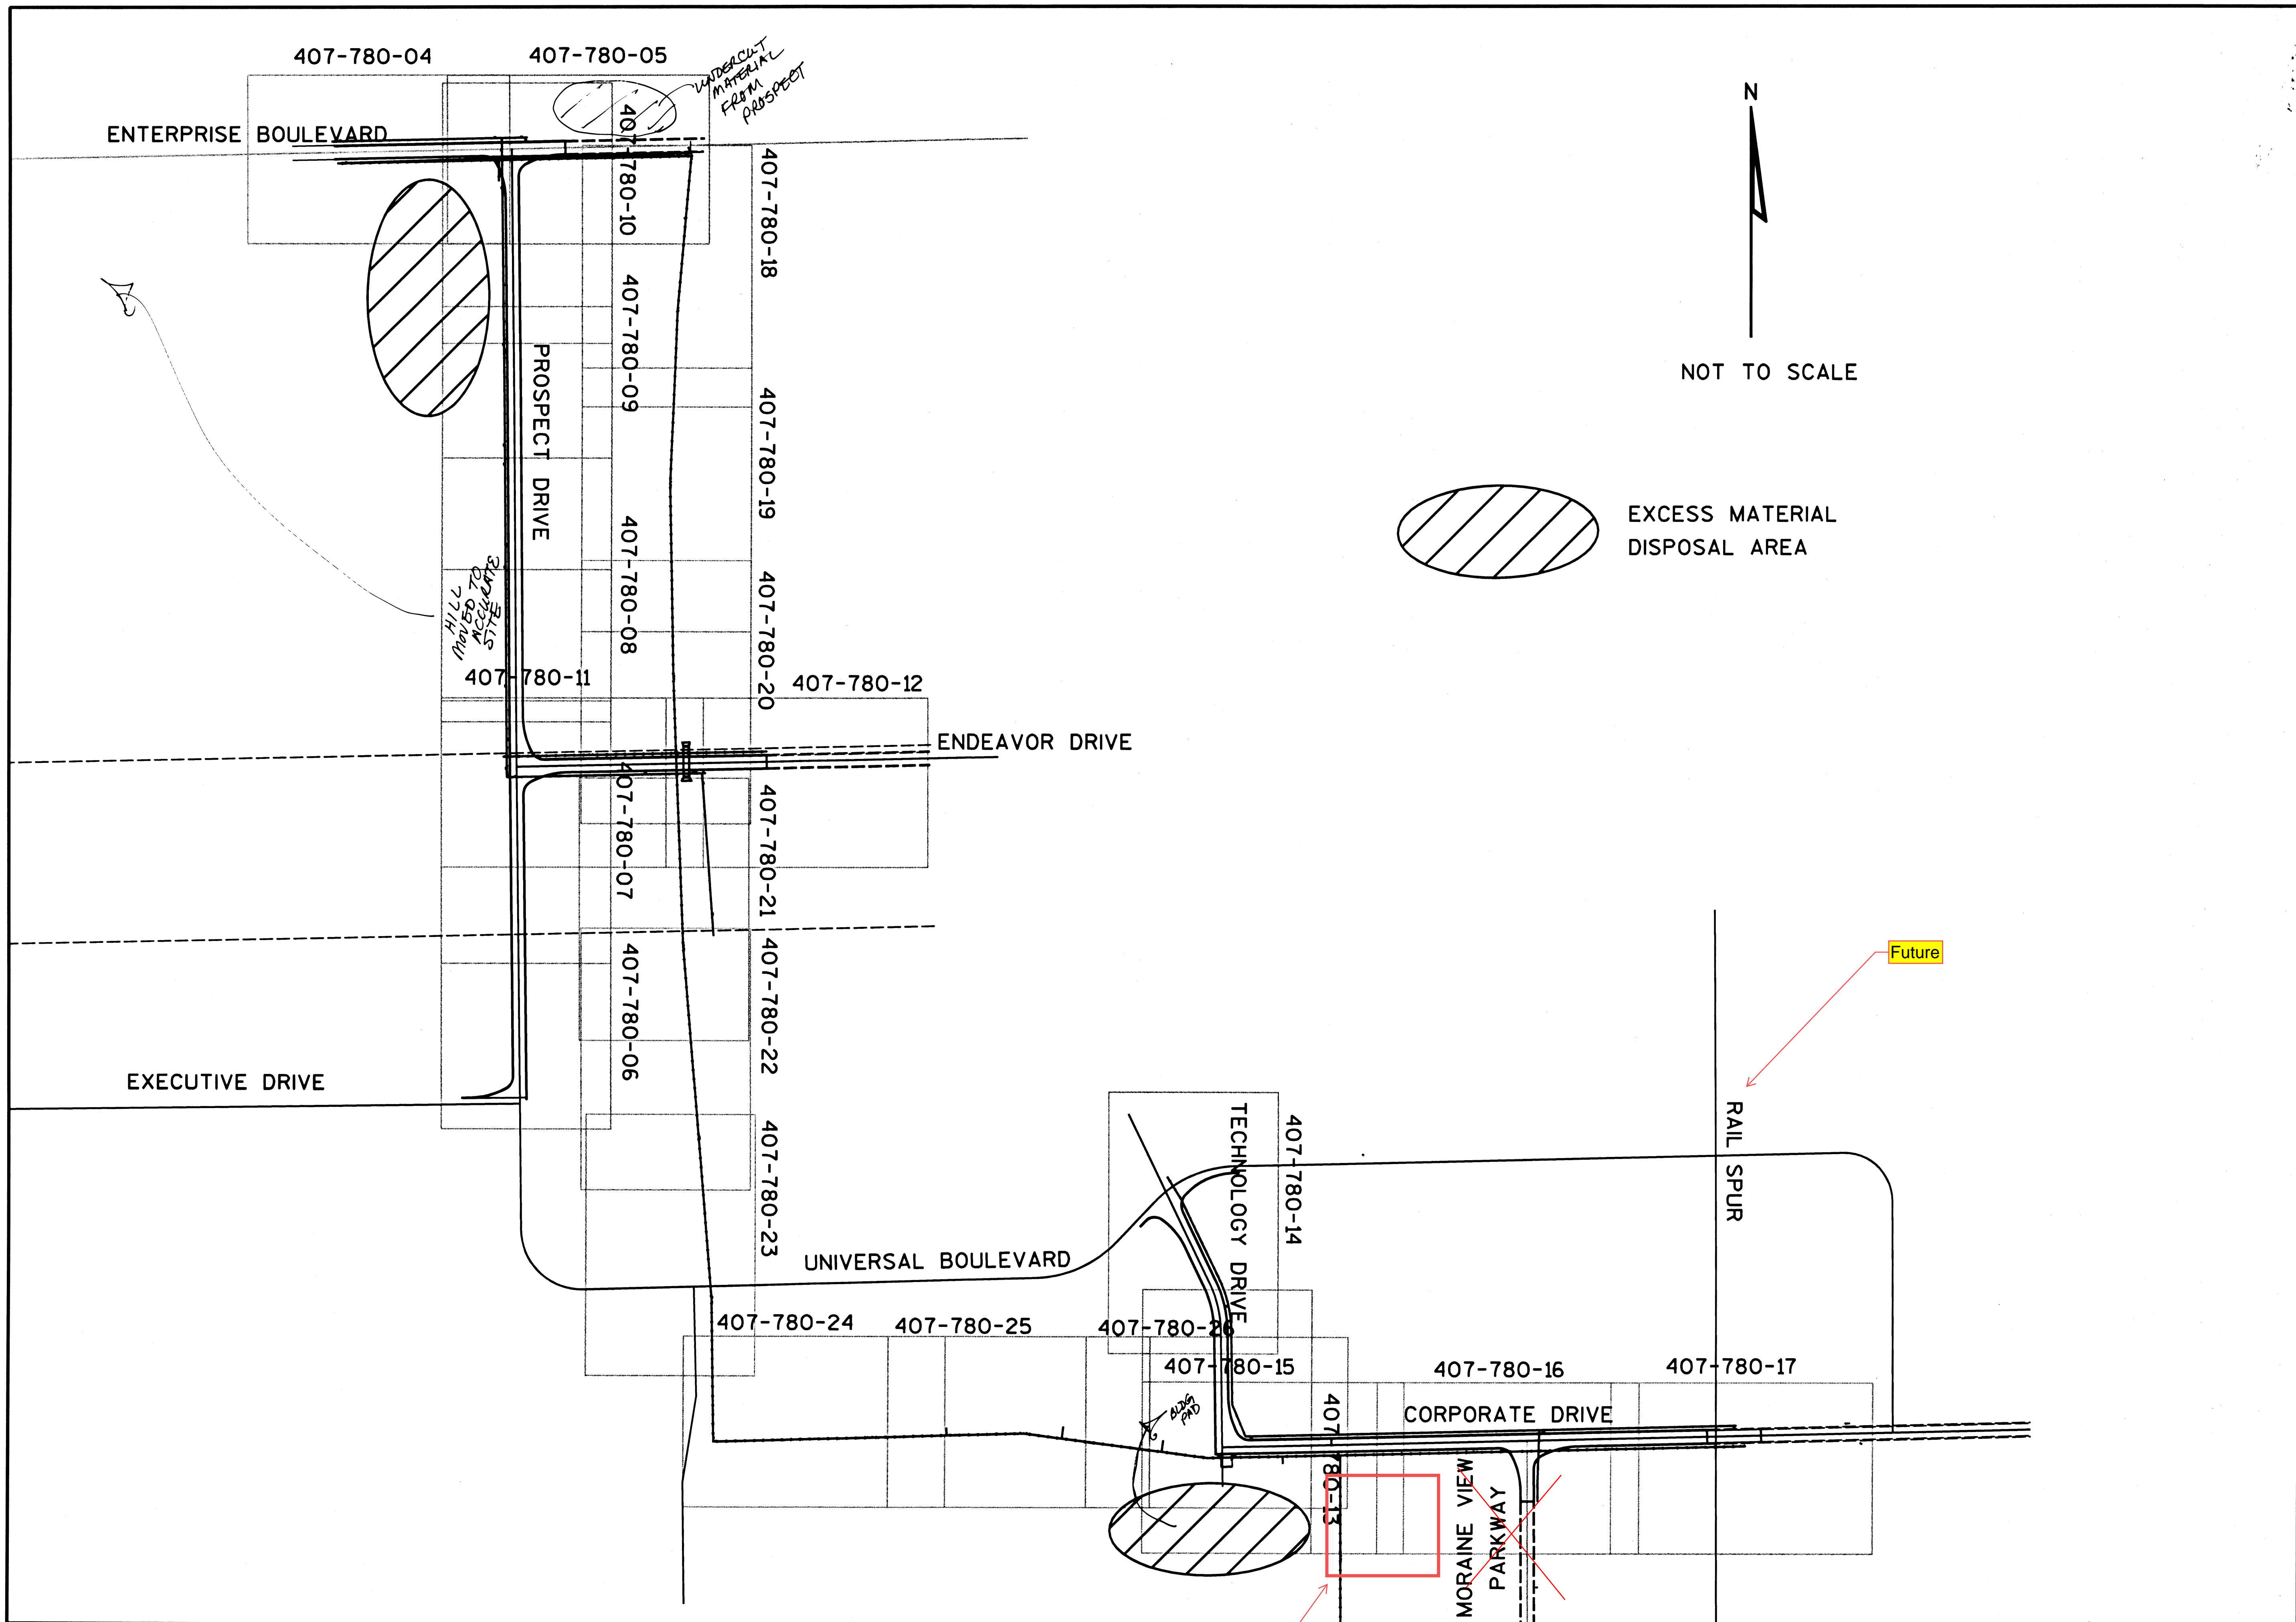

NO.	REVISION	BY	DATE	RECORD DRAWING

SCALE: HOR.	SCALE: VERT.	DATE: JULY 1998	DES BY: JMD/CAK	DWN BY: JMD/CAK	PRINTED:

STREET AND UTILITY CONSTRUCTION
 SHEET INDEX MAP
 CITY OF WHITEWATER
 WALWORTH COUNTY, WISCONSIN

STRAND
 ENGINEERING
 910 WEST WINGRA DRIVE
 MADISON, WISCONSIN 53715
 1608/251-4845

DRAWING NO.
407-780-2.2A

SHEET 3 OF 61
98-3

