



City of Beaumont

550 E. 6th Street
Beaumont, CA 92223
(951) 769-8520
www.ci.beaumont.ca.us

Case No.	<u>16-3770</u>
Receipt No.	<u>6916227</u>
Fee \$	<u>2300.00</u>
Date Paid	<u>7/29/16</u>

BOND EXONERATION APPLICATION

Bond Type: Performance Maintenance Final Monument Inspection Other: _____

1. Contact's Name Michael Jagels Phone 949-939-9564

2. Contact's Address 11870 Pierce St. #250, Riverside, CA 92505
City/State/Zip

6. Contact's E-mail Mikej@woodsidehomes.com

3. Developer Name Woodside OSS LP (Tim McGinnis - U/A) Phone 951-710-1900
(If corporation or partnership application must include names of principal officers or partners)

4. Developer Address 11870 Pierce St. #250, Riverside, CA 92505
City/St/Zip

5. Description of Bonds (including Bond Number, Tract Map/Application number, File number, and description of improvements covered, must use separate application for each Map/Tract):

TR 31462-7, Bond # PB00535000068
Street, sewer, storm drain work (in the first phase of development - see plan - highlighted)
File #'s 2038, 2039, 2040

6. CERTIFICATION OF ACCURACY AND COMPLETENESS: I hereby certify that to the best of my knowledge the information in this application and all attached answers and exhibits are true, complete, and correct.

Michael Jagels Mike Jagels 6-13-16
Print Name and Sign - Contact/Applicant Date

7. Contractor shall indemnify, defend, and hold harmless the City and its officers, officials, employees and volunteers from and against any and all liability, loss, damage, expense, costs (including without limitation costs and fees of litigation) of every nature arising out of or in connection with contractor's performance of work hereunder or its failure to comply with any of its obligations for which this Bond exoneration is requested, except for such loss or damage which was caused by the active negligence of the City.

Michael Jagels Mike Jagels 6-13-16
Print Name and Sign - Contact/Applicant Date



Woodside Homes

B E T T E R B Y D E S I G N

Letter of Transmittal

Date: 6-13-16

To: Gilbert Fausto
Engineering Dept.

From: Michael Jagels
949-939-9564

Company: City of Beaumont

RE: Woodside TR31462-7 Slope Plan Submittal (Mylar Set)

Gilbert,

I am requesting a bond reduction for improvements that have been installed in TR31462-7. The completed improvements are within our first development phase of TR31462-7 and included street, storm, and sewer work.

The requested bond reduction amount is \$883,255.49.

Bond Info:

- Bond #PB00535000068
- Total bond \$2,105,807.55
- Surety- Philadelphia Indemnity Insurance Company

Please see the attached copies of the approved improvement plans that depict the areas of work that have been completed. These areas are highlighted in yellow. These particular areas represent our first phase of development.

Southern California Division

11870 Pierce Street, Suite 250 • Riverside, California 92505

Phone: (951) 710-1900 • Fax: (951) 688-8681

www.woodside-homes.com



Woodside Homes

B E T T E R B Y D E S I G N

I am providing you with the following documents:

- Bond exoneration application (filled out and signed)
- Completed development cost work sheet depicting \$1,139,684.50 in completed work.
- Copies of the original bonds (exhibit A & B)
- Copies of the approved sewer plans, street plans, and storm drain plans.

I am also providing you with the following payments:

- \$300 (ck #50252813) – application fee
- \$2,000 (ck #50252812 – deposit)

Southern California Division

11870 Pierce Street, Suite 250 • Riverside, California 92505

Phone: (951) 710-1900 • Fax: (951) 688-8681

www.woodside-homes.com



April 13, 2020

Woodside Homes
1250 Corona Pointe Court, Suite 500
Corona, CA 92879
Attn: Kory Liston

RE: Bond #PB00535000068 Street, Sewer, and Storm Drain Improvements

Dear Kory,

The City of Beaumont has received your request in regards to a reduction of bonds in the above referenced tract. Upon receipt of a maintenance bond in the amount listed below, the city will return the original Performance bond 45 days after recordation and replace it with the maintenance bond to be in place for no less than one year. The amount is as follows:

Project Name	Maintenance Amount
Street, Sewer, & Storm Drain Improvements	\$473,806.70

If you wish to discuss this matter further please do not hesitate to contact me at (951) 769-8520 ext. 329

Thank you,

Suzanne Foxworth
Public Works Technician

Basic Gov (Sales Foree) # _____
File # _____

Bond Number: PB00535000068

Premium: \$15,794.00 (Initial Term One Year)

EXHIBIT "A"

PERFORMANCE BOND

WHEREAS, the City Council of the City of Beaumont, State of California, and Woodside O5S, LP (hereinafter designated as "Principal") have entered into Agreement To Provide Security For Improvements For Tract Map Or Parcel Map Or Plot Plan, dated April 14, 2015, whereby Principal agrees to install and complete certain designated public improvements itemized and described on Tract Map, Parcel Map or Plot Plan No. 31462-7, which is hereby incorporated herein and made a part hereof; and

WHEREAS, Principal is required under the terms of the said agreement to furnish a bond for the faithful performance of said agreement.

NOW, THEREFORE, we, the Principal and Philadelphia Indemnity Insurance Company, as Surety, are held and firmly bound unto the City of Beaumont (hereinafter called "City"), in the penal sum of Two Million One Hundred Five Thousand Eight Hundred Seven and 55/100 dollars (\$2,105,807.55) lawful money of the United States, for the payment of which sum well and truly to be made, we bind ourselves, our heirs, successors, executors and administrators, jointly and severally, firmly by these presents.

The condition of this obligation is such that if the Principal, his or its heirs, executors, administrators, successors or assigns, shall in all things stand to and abide by, and well and truly keep and perform the covenants, conditions and provisions in the said agreement and any alteration thereof made as therein provided, on his or their part to be kept and performed at the time and in the manner therein specified, and in all respects according to their true intent and meaning, and shall indemnify and save harmless the City, its officers, agents and employees as therein stipulated, then this obligation shall become null and void; otherwise it shall be and remain in full force and effect.

As part of the obligation secured hereby and in addition to the face amount specified therefor, there shall be included costs and reasonable expenses and fees, including reasonable attorney's fees, incurred by the City in successfully enforcing such obligation, all to be taxed as costs and included in any judgment therein rendered.

The Surety hereby stipulates and agrees that no change, extension of time, alteration or addition to the terms of the agreement or to the work to be performed thereunder or the specifications accompanying the same shall in any way affect its obligations on this bond, and it does hereby waive notice of any such change, extension of time, alteration or addition to the terms of the agreement or to the work or to the specifications.

IN WITNESS WHEREOF, this instrument has been duly executed by the Principal and Surety above named, on April 13th, 2015.

PRINCIPAL:


Woodside O5S, LP, a California limited partnership
By: WDS, GP, Inc., a California corporation
Its: General Partner

By 

Title Tim McGinnis, Authorized Signatory

SURETY:

Philadelphia Indemnity Insurance Company

By 

Title Michael J. Perry, Attorney-in-Fact

PHILADELPHIA INDEMNITY INSURANCE COMPANY
231 St Asaph's Rd , Suite 100
Bala Cynwyd, PA 19004-0950

Power of Attorney

KNOW ALL PERSONS BY THESE PRESENTS: that PHILADELPHIA INDEMNITY INSURANCE COMPANY (the Company), a corporation organized and existing under the laws of the Commonwealth of Pennsylvania, does hereby constitute and appoint: DANA L. DOWERS, SANDRA SIKORA, ROBERT RANALLO, MICHAEL J. PERRY AND PAUL A. BLAND OF THE D.L.D. COMPANY DBA D.L.D. INSURANCE BROKERS INC.

Its true and lawful Attorney(s) in fact with full authority to execute on its behalf bonds, undertakings, recognizances and other contracts of indemnity and writings obligatory in the nature thereof, issued in the course of its business and to bind the Company thereby, in an amount not to exceed \$25,000,000.00

This Power of Attorney is granted and is signed and sealed by facsimile under and by the authority of the following Resolution adopted by the Board of Directors of PHILADELPHIA INDEMNITY INSURANCE COMPANY at a meeting duly called the 1st day of July, 2011.

RESOLVED: That the Board of Directors hereby authorizes the President or any Vice President of the Company to: (1) Appoint Attorney(s) in Fact and authorize the Attorney(s) in Fact to execute on behalf of the Company bonds and undertakings, contracts of indemnity and other writings obligatory in the nature thereof and to attach the seal of the Company thereto; and (2) to remove, at any time, any such Attorney-in-Fact and revoke the authority given. And, be it

FURTHER RESOLVED: That the signatures of such officers and the seal of the Company may be affixed to any such Power of Attorney or certificate relating thereto by facsimile, and any such Power of Attorney so executed and certified by facsimile signatures and facsimile seal shall be valid and binding upon the Company in the future with the respect to any bond or undertaking to which it is attached.

IN TESTIMONY WHEREOF, PHILADELPHIA INDEMNITY INSURANCE COMPANY HAS CAUSED THIS INSTRUMENT TO BE SIGNED AND ITS CORPORATE SEAL TO BE AFFIXED BY ITS AUTHORIZED OFFICE THIS 7TH DAY OF FEBRUARY 2013.



(Seal)

Robert D. O'Leary Jr., President & CEO
Philadelphia Indemnity Insurance Company

On this 7th day of February 2013, before me came the individual who executed the preceding instrument, to me personally known, and being by me duly sworn said that he is the therein described and authorized officer of the PHILADELPHIA INDEMNITY INSURANCE COMPANY, that the seal affixed to said instrument is the Corporate seal of said Company; that the said Corporate Seal and his signature were duly affixed.



(Notary Seal)

Notary Public:

residing at:

Bala Cynwyd, PA

My commission expires:

March 22, 2016

I, Craig P. Keller, Executive Vice President, Chief Financial Officer and Secretary of PHILADELPHIA INDEMNITY INSURANCE COMPANY, do hereby certify that the foregoing resolution of the Board of Directors and this Power of Attorney issued pursuant thereto are true and correct and are still in full force and effect. I do further certify that Robert D. O'Leary Jr., who executed the Power of Attorney as President, was on the date of execution of the attached Power of Attorney the duly elected President of PHILADELPHIA INDEMNITY INSURANCE COMPANY,

In Testimony Whereof I have subscribed my name and affixed the facsimile seal of each Company this 13th day of April, 2015.


Craig P. Keller, Executive Vice President, Chief Financial Officer & Secretary
PHILADELPHIA INDEMNITY INSURANCE COMPANY

CALIFORNIA ALL-PURPOSE CERTIFICATE OF ACKNOWLEDGMENT

A notary public or other officer completing this certificate verifies only the identity of the individual who signed the document to which this certificate is attached, and not the truthfulness, accuracy, or validity of that document.

State of California

County of Orange

On 4/13/15 before me, Brandy Novak, Notary Public, Notary Public,
(Here insert name and title of the officer)

personally appeared Michael J. Perry


who proved to me on the basis of satisfactory evidence to be the person whose name is subscribed to the within instrument and acknowledged to me that he/ executed the same in his authorized capacity, and that by his signature on the instrument the person, or the entity upon behalf of which the person acted, executed the instrument.

I certify under PENALTY OF PERJURY under the laws of the State of California that the foregoing paragraph is true and correct.

WITNESS my hand and official seal.

Signature of Notary Public

(Notary Seal)

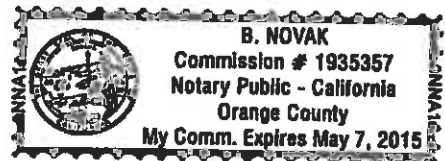

ADDITIONAL OPTIONAL INFORMATION

DESCRIPTION OF THE ATTACHED DOCUMENT

Performance Bond PB00535000068

(Title or description of attached document)

Fairway Canyon Tract 31462-7

(Title or description of attached document continued)

Number of Pages 1 Document Date 4/13/15

(Additional information)

CAPACITY CLAIMED BY THE SIGNER

- Individual (s)
 Corporate Officer

(Title)

- Partner(s)
 Attorney-in-Fact
 Trustee(s)
 Other

INSTRUCTIONS FOR COMPLETING THIS FORM

Any acknowledgment completed in California must contain verbiage exactly as appears above in the notary section or a separate acknowledgment form must be properly completed and attached to that document. The only exception is if a document is to be recorded outside of California. In such instances, any alternative acknowledgment verbiage as may be printed on such a document so long as the verbiage does not require the notary to do something that is illegal for a notary in California (i.e. certifying the authorized capacity of the signer). Please check the document carefully for proper notarial wording and attach this form if required.

- State and County information must be the State and County where the document signer(s) personally appeared before the notary public for acknowledgment.
- Date of notarization must be the date that the signer(s) personally appeared which must also be the same date the acknowledgment is completed.
- The notary public must print his or her name as it appears within his or her commission followed by a comma and then your title (notary public).
- Print the name(s) of document signer(s) who personally appear at the time of notarization.
- Indicate the correct singular or plural forms by crossing off incorrect forms (i.e. he/she/they, is /are) or circling the correct forms. Failure to correctly indicate this information may lead to rejection of document recording.
- The notary seal impression must be clear and photographically reproducible. Impression must not cover text or lines. If seal impression smudges, re-seal if a sufficient area permits, otherwise complete a different acknowledgment form.
- Signature of the notary public must match the signature on file with the office of the county clerk.
 - ❖ Additional information is not required but could help to ensure this acknowledgment is not misused or attached to a different document.
 - ❖ Indicate title or type of attached document, number of pages and date.
 - ❖ Indicate the capacity claimed by the signer. If the claimed capacity is a corporate officer, indicate the title (i.e. CEO, CFO, Secretary).
- Securely attach this document to the signed document

CALIFORNIA ALL-PURPOSE ACKNOWLEDGMENT

CIVIL CODE § 1189

A notary public or other officer completing this certificate verifies only the identity of the individual who signed the document to which this certificate is attached, and not the truthfulness, accuracy, or validity of that document.

State of California
County of Riverside
On April 14, 2015 before me, Rochelle M. Sromalla, Notary Public
Date Here Insert Name and Title of the Officer
personally appeared Tim McInnis
Name(s) of Signer(s)

who proved to me on the basis of satisfactory evidence to be the person(s) whose name(s) is/are subscribed to the within instrument and acknowledged to me that he/she/they executed the same in his/her/their authorized capacity(ies), and that by his/her/their signature(s) on the instrument the person(s), or the entity upon behalf of which the person(s) acted, executed the instrument.

I certify under PENALTY OF PERJURY under the laws of the State of California that the foregoing paragraph is true and correct.

WITNESS my hand and official seal.



Signature Rochelle M. Sromalla
Signature of Notary Public

Place Notary Seal Above

OPTIONAL

Though this section is optional, completing this information can deter alteration of the document or fraudulent reattachment of this form to an unintended document.

Description of Attached Document

Title or Type of Document: _____ Document Date: _____
Number of Pages: _____ Signer(s) Other Than Named Above: _____

Capacity(ies) Claimed by Signer(s)

Signer's Name: _____
 Corporate Officer — Title(s): _____
 Partner — Limited General
 Individual Attorney in Fact
 Trustee Guardian or Conservator
 Other: _____
Signer Is Representing: _____

Signer's Name: _____
 Corporate Officer — Title(s): _____
 Partner — Limited General
 Individual Attorney in Fact
 Trustee Guardian or Conservator
 Other: _____
Signer Is Representing: _____

EXHIBIT "B"

Bond Number: PB00535000068
Premium: Included in Performance Bond

PAYMENT BOND

WHEREAS, the City Council of the City of Beaumont, State of California, and Woodside 05S, LP (hereafter designated as "the Principal") have entered into Agreement To Provide Security For Improvements For Tract Map Or Parcel Map Or Plot Plan, dated April 14, 2015, whereby Principal agrees to install and complete certain designated public improvements itemized and described on Tract Map, Parcel Map or Plot Plan No. 31462-7, which is hereby incorporated herein and made a part hereof; and

WHEREAS, under the terms of the said agreement, the Principal is required before entering upon the performance of the work, to file a good and sufficient payment bond with the City of Beaumont to secure the claims to which reference is made in Section 8000, et seq., of the Civil Code of the State of California.

NOW, THEREFORE, the Principal and the undersigned as corporate surety, are held firmly bound unto the City of Beaumont and all contractors, subcontractors, laborers, materialmen, and other persons employed in the performance of the said agreement and referred to at Section 8000, et seq., of the Civil Code in the sum of Two Million One Hundred Five Thousand Eight Hundred Seven and 55/100 dollars (\$2,105,807.55), for materials furnished or labor thereon of any kind, or for amounts due under the Unemployment Insurance Act with respect to this work or labor, that the Surety will pay the same in an amount not exceeding the amount hereinabove set forth, and also in case suit is brought upon this bond, will pay, in addition to the face amount thereof, costs and reasonable expenses and fees, including reasonable attorney's fees, incurred by the City in successfully enforcing this obligation, to be awarded and fixed by the court, and to be taxed as costs and to be included in the judgment therein rendered.

It is hereby expressly stipulated and agreed that this bond shall inure to the benefit of any and all persons, companies, and corporations entitled to file claims under Section 8000, et seq., of the Civil Code, so as to give a right of action to them or their assigns in any suit brought upon this bond.

Should the condition of this bond be fully performed, then this obligation shall become null and void, otherwise it shall be and remain in full force and effect.

The Surety hereby stipulates and agrees that no change, extension of time, alteration, or addition to the terms of the agreement or the specifications accompanying the same shall in any manner affect its obligations on this bond, and it does hereby waive notice of any such change, extension, alteration, or addition.

IN WITNESS WHEREOF, this instrument has been duly executed by the Principal and Surety above named, on April 13th, 2015.

PRINCIPAL:

Woodside 05S, LP, a California limited partnership
By: WDS, GP, Inc., a California corporation
Its: General Partner

By

Tim McInnis
Title Tim McInnis, Authorized Signatory

SURETY:

Philadelphia Indemnity Insurance Company

By

Michael J. Perry
Title Michael J. Perry, Attorney-in-Fact

PHILADELPHIA INDEMNITY INSURANCE COMPANY
231 St Asaph's Rd , Suite 100
Bala Cynwyd, PA 19004-0950

Power of Attorney

KNOW ALL PERSONS BY THESE PRESENTS that PHILADELPHIA INDEMNITY INSURANCE COMPANY (the Company), a corporation organized and existing under the laws of the Commonwealth of Pennsylvania, does hereby constitute and appoint DANA L DOWERS, SANDRA SIKORA, ROBERT RANALLO, MICHAEL J PERRY AND PAUL A BLAND OF THE D L D COMPANY DBA D I D INSURANCE BROKERS INC

Its true and lawful Attorney(s) in fact with full authority to execute on its behalf bonds, undertakings, recognizances and other contracts of indemnity and writings obligatory in the nature thereof, issued in the course of its business and to bind the Company thereby, in an amount not to exceed \$25,000,000.00

This Power of Attorney is granted and is signed and sealed by facsimile under and by the authority of the following Resolution adopted by the Board of Directors of PHILADELPHIA INDEMNITY INSURANCE COMPANY at a meeting duly called the 1st day of July, 2011

RESOLVED: That the Board of Directors hereby authorizes the President or any Vice President of the Company to (1) Appoint Attorney(s) in Fact and authorize the Attorney(s) in Fact to execute on behalf of the Company bonds and undertakings, contracts of indemnity and other writings obligatory in the nature thereof and to attach the seal of the Company thereto, and (2) to remove, at any time, any such Attorney-in-Fact and revoke the authority given And, be it

FURTHER RESOLVED: That the signatures of such officers and the seal of the Company may be affixed to any such Power of Attorney or certificate relating thereto by facsimile, and any such Power of Attorney so executed and certified by facsimile signatures and facsimile seal shall be valid and binding upon the Company in the future with the respect to any bond or undertaking to which it is attached.

IN TESTIMONY WHEREOF, PHILADELPHIA INDEMNITY INSURANCE COMPANY HAS CAUSED THIS INSTRUMENT TO BE SIGNED AND ITS CORPORATE SEAL TO BE AFFIXED BY ITS AUTHORIZED OFFICE THIS 7TH DAY OF FEBRUARY 2013



(Seal)

Robert D. O'Leary Jr., President & CEO
Philadelphia Indemnity Insurance Company

On this 7th day of February 2013, before me came the individual who executed the preceding instrument, to me personally known, and being by me duly sworn said that he is the therein described and authorized officer of the PHILADELPHIA INDEMNITY INSURANCE COMPANY; that the seal affixed to said instrument is the Corporate seal of said Company; that the said Corporate Seal and his signature were duly affixed.



Notary Public:

residing at:

Bala Cynwyd, PA

(Notary Seal)

My commission expires:

March 22, 2016

I, Craig P. Keller, Executive Vice President, Chief Financial Officer and Secretary of PHILADELPHIA INDEMNITY INSURANCE COMPANY, do hereby certify that the foregoing resolution of the Board of Directors and this Power of Attorney issued pursuant thereto are true and correct and are still in full force and effect. I do further certify that Robert D O'Leary Jr., who executed the Power of Attorney as President, was on the date of execution of the attached Power of Attorney the duly elected President of PHILADELPHIA INDEMNITY INSURANCE COMPANY,

In Testimony Whereof I have subscribed my name and affixed the facsimile seal of each Company this 13th day of April, 2015.



Craig P. Keller, Executive Vice President, Chief Financial Officer & Secretary
PHILADELPHIA INDEMNITY INSURANCE COMPANY

CALIFORNIA ALL-PURPOSE CERTIFICATE OF ACKNOWLEDGMENT

A notary public or other officer completing this certificate verifies only the identity of the individual who signed the document to which this certificate is attached, and not the truthfulness, accuracy, or validity of that document.

State of California

County of Orange

On 4/13/15 before me, Brandy Novak, Notary Public, Notary Public,
(Here insert name and title of the officer)

personally appeared Michael J. Perry


who proved to me on the basis of satisfactory evidence to be the person whose name is subscribed to the within instrument and acknowledged to me that he executed the same in his authorized capacity, and that by his signature on the instrument the person, or the entity upon behalf of which the person acted, executed the instrument.

I certify under PENALTY OF PERJURY under the laws of the State of California that the foregoing paragraph is true and correct.

WITNESS my hand and official seal.

Signature of Notary Public

(Notary Seal)

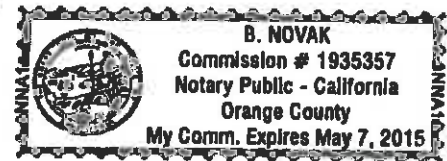

ADDITIONAL OPTIONAL INFORMATION

DESCRIPTION OF THE ATTACHED DOCUMENT

Payment Bond PB00535000068

(Title or description of attached document)

Fairway Canyon Tract 31462-7

(Title or description of attached document continued)

Number of Pages 1 Document Date 4/13/15

(Additional information)

CAPACITY CLAIMED BY THE SIGNER

- Individual(s)
 Corporate Officer

(Title)

- Partner(s)
 Attorney-in-Fact
 Trustee(s)
 Other

INSTRUCTIONS FOR COMPLETING THIS FORM

Any acknowledgment completed in California must contain verbiage exactly as appears above in the notary section or a separate acknowledgment form must be properly completed and attached to that document. The only exception is if a document is to be recorded outside of California. In such instances, any alternative acknowledgment verbiage as may be printed on such a document so long as the verbiage does not require the notary to do something that is illegal for a notary in California (i.e. certifying the authorized capacity of the signer). Please check the document carefully for proper notarial wording and attach this form if required.

- State and County information must be the State and County where the document signer(s) personally appeared before the notary public for acknowledgment.
- Date of notarization must be the date that the signer(s) personally appeared which must also be the same date the acknowledgment is completed.
- The notary public must print his or her name as it appears within his or her commission followed by a comma and then your title (notary public).
- Print the name(s) of document signer(s) who personally appear at the time of notarization.
- Indicate the correct singular or plural forms by crossing off incorrect forms (i.e. he/she/they- is/are) or circling the correct forms. Failure to correctly indicate this information may lead to rejection of document recording.
- The notary seal impression must be clear and photographically reproducible. Impression must not cover text or lines. If seal impression smudges, re-seal if a sufficient area permits, otherwise complete a different acknowledgment form.
- Signature of the notary public must match the signature on file with the office of the county clerk.
 - ❖ Additional information is not required but could help to ensure this acknowledgment is not misused or attached to a different document.
 - ❖ Indicate title or type of attached document, number of pages and date.
 - ❖ Indicate the capacity claimed by the signer. If the claimed capacity is a corporate officer, indicate the title (i.e. CEO, CFO, Secretary).
- Securely attach this document to the signed document

CALIFORNIA ALL-PURPOSE ACKNOWLEDGMENT

CIVIL CODE § 1189

A notary public or other officer completing this certificate verifies only the identity of the individual who signed the document to which this certificate is attached, and not the truthfulness, accuracy, or validity of that document.

State of California

County of Riverside

On April 14, 2015

Date

before me,

Rochelle M. Sromalla, Notary Public
Here Insert Name and Title of the Officer

personally appeared Tim McGowan

Name(s) of Signer(s)

who proved to me on the basis of satisfactory evidence to be the person(s) whose name(s) is/are subscribed to the within instrument and acknowledged to me that he/she/they executed the same in his/her/their authorized capacity(ies), and that by his/her/their signature(s) on the instrument the person(s), or the entity upon behalf of which the person(s) acted, executed the instrument.

I certify under PENALTY OF PERJURY under the laws of the State of California that the foregoing paragraph is true and correct.

WITNESS my hand and official seal.



Signature Rochelle M. Sromalla

Signature of Notary Public

Place Notary Seal Above

OPTIONAL

Though this section is optional, completing this information can deter alteration of the document or fraudulent reattachment of this form to an unintended document.

Description of Attached Document

Title or Type of Document: _____ Document Date: _____

Number of Pages: _____ Signer(s) Other Than Named Above: _____

Capacity(ies) Claimed by Signer(s)

Signer's Name: _____

Corporate Officer — Title(s): _____

Partner — Limited General

Individual Attorney in Fact

Trustee Guardian or Conservator

Other: _____

Signer Is Representing: _____

Signer's Name: _____

Corporate Officer — Title(s): _____

Partner — Limited General

Individual Attorney in Fact

Trustee Guardian or Conservator

Other: _____

Signer Is Representing: _____

Basic Gov (Sales Force) # _____
File # _____

**AGREEMENT TO PROVIDE SECURITY FOR IMPROVEMENTS
FOR TRACT MAP OR PARCEL MAP OR PLOT PLAN
(Tract Map/Parcel Map/Plot Plan No. 31462-7)**

THIS SECURITY AGREEMENT is made by and between CITY OF BEAUMONT ("CITY") and Woodside OSS, LP, a California company ("DEVELOPER").

RECITALS

A. DEVELOPER has applied to the CITY for permission to develop certain real property, pursuant to Tract Map/Parcel Map/Plot Plan #31462-7 ("Map"). DEVELOPER has also asked the CITY to accept the dedication of the street or streets and other proposed public rights-of-way, parks and recreation facilities, and easements as depicted on the Map and to otherwise approve the Map so that it may be recorded as required by law; and

B. The CITY requires, as a condition precedent to the acceptance and approval of the Map and the dedication of the public rights-of-way and easements depicted thereon, that such rights-of-way be improved with (for example) grading, paving, curbs, gutters, sidewalks, street lights, stormdrains, sanitary sewers and appurtenances thereto, street name signs, survey monuments, electrical and telecommunications, water pipes, water mains, fire hydrants and appurtenances thereto, and landscaping, including any warranty work for all such improvements (collectively, "Improvements"); and

C. The Improvements have not yet been constructed and completed and it is the purpose of this Security Agreement to set forth the terms and conditions by which the DEVELOPER shall guarantee that such Improvements shall be constructed and completed within the time set forth herein.

AGREEMENT

NOW, THEREFORE, in consideration of the acceptance of the DEVELOPER's offer of dedication and the approval of the Map for filing and recording as provided and required by law, the CITY and the DEVELOPER hereby agree as follows:

1. Provision of Improvements. DEVELOPER shall provide, at the DEVELOPER's sole cost and expense, all necessary labor and materials to complete the construction of the Improvements depicted on the Map and described in the conditions of approval of the Map within one (1) year of the date of this Security Agreement.

2. Inspection by the CITY. The CITY shall inspect, at the DEVELOPER's sole cost and expense, all of the work, labor and materials performed and provided by the DEVELOPER in connection with the Improvements.

3. Compliance with Plans and Specifications. The Improvements shall be constructed and installed in strict accordance with the CITY-approved plans and specifications.

4. Security for Performance. Concurrently with the execution of this Security Agreement by DEVELOPER, DEVELOPER shall deliver to the CITY a performance bond issued by a corporate surety in substantially the form attached hereto as **Exhibit "A"**, in an amount that is not less than 100% of the total estimated cost of the Improvements and any warranty therefor. The performance bond shall be issued by an "admitted" corporate surety insurer authorized to do business in the State of California and the surety insurer shall have an A.M. Best rating of at least "A, XV". The surety insurer shall have assets exceeding its liabilities in the amount equal to or in excess of the amount of the bond, and the bond shall not be in excess of 10% of the surety insurer's assets. The security or bond shall also insure against any and all defects in the Improvements for a period of not less than one full year after the date of acceptance thereof by the CITY. The bond shall be duly executed and shall meet all the requirements of Section 995.660 of the California Code of Civil Procedure.

5. Security for Contractors, Subcontractors, Laborers and Materialmen. The DEVELOPER shall also provide a payment bond issued by a corporate surety for the security of laborers and materialmen, which bond or bonds shall be in substantially the form attached hereto as **Exhibit "B"** and made a part hereof. The amount of the bond(s) shall be no less than 100% of the total estimated amount needed to secure payment to the contractor, to the subcontractors, and to the persons furnishing labor, materials, or equipment to them for the Improvements. The laborers and materialmen bond shall be provided by an "admitted" corporate surety insurer authorized to transact surety insurance in the State of California with an A.M. Best rating of "A, XV", and with assets exceeding its liabilities in the amount equal to or in excess of the amount of the bond, and the bond shall not be in excess of 10% of the surety insurer's assets. The bond shall be duly executed and shall meet all the requirements of Section 995.660 of the California Code of Civil Procedure.

6. General Liability and Worker's Compensation Insurance. The DEVELOPER shall, before commencing any work, obtain commercial general liability insurance (primary) of not less than \$2,000,000.00 per occurrence for all coverages and \$2,000,000.00 general aggregate. The CITY and its employees and agents shall be added as additional insureds. Coverage shall apply on a primary non-contributing basis in relation to any other insurance or self-insurance, primary or excess, available to the CITY or any employee or agent of the CITY. Coverage shall not be limited to the vicarious liability or supervisory role of any additional insured. Coverage shall contain no contractors' limitation endorsement. There shall be no endorsement or modification limiting the scope of coverage for liability arising from pollution, explosion, collapse, underground property damage or employment-related practices. Such insurance shall not prohibit the DEVELOPER, and its employees or agents, from waiving the right of subrogation prior to a loss. The DEVELOPER waives its right of subrogation against the CITY. Unless otherwise approved by the CITY, the DEVELOPER's insurance shall be written by insurers authorized to do business in the State of California and with a minimum A.M. Best rating of "A, XV." Self-insurance shall not be considered to comply with these insurance specifications. The DEVELOPER agrees to require all contractors, subcontractors and other parties hired for the Improvements to purchase and maintain insurance of the types specified

herein, naming as additional insureds all of the parties to this Security Agreement. The DEVELOPER shall, before commencing any work, obtain Worker's Compensation Insurance in an amount required by law and, failing to do so, the CITY may procure such insurance at the cost of the DEVELOPER.

7. Comprehensive Commercial General and Automobile Liability Insurance. The DEVELOPER, before commencing any work shall, at its own expense, maintain comprehensive commercial general and automobile liability insurance issued by a California-admitted surety company with an A.M. Best rating of no less than "A, XV" for \$2,000,000 per occurrence. Coverage shall be for the entire duration of the permitted activities. Such liability insurance policy shall name, by endorsement, the City as an additional insured.

8. Indemnification. Notwithstanding the provisions of Government Code, Section 66474.9 or any other statutes of similar import, and to the full extent permitted by law, the DEVELOPER shall defend, indemnify and hold harmless the CITY, its employees, agents, officials and attorneys, from and against any liability, claims, suits, actions, arbitration proceedings, administrative proceedings, regulatory proceedings, losses, expenses or costs of any kind or nature, whether actual, alleged or threatened, reasonable attorneys' fees, court costs, interest, expert witness fees and any other costs or expenses of any kind whatsoever, without restriction or limitation, incurred in relation to, as a consequence of, or arising out of or in any way attributable actually, allegedly or impliedly, in whole or in part, to the Map, the Improvements, this Agreement, or any matter related to the same; provided, however, that the indemnification to be provided by DEVELOPER to the CITY pursuant to the terms of this paragraph shall not be applicable where the aforementioned liability, claim, suit, action, etcetera, is the result of the sole negligence or sole willful misconduct of the CITY.

9. Procedure for Release of Performance Bond Security. The security furnished by the DEVELOPER shall be released in whole or in part in the following manner:

a. Security shall be released upon final completion and acceptance of the Improvements. If the security furnished by the DEVELOPER is a documentary evidence of security, such as a surety bond, the CITY shall release the documentary evidence and return the original to the Surety upon final completion and acceptance of the Improvements. In the event the CITY is unable to return the original documentary evidence to the Surety, the security shall be released by written notice sent by certified mail to the DEVELOPER and to the Surety within 30 days of the City's acceptance of the Improvements. The written notice shall contain a statement that the work for which security was furnished has been completed and accepted, a description of the Improvements, and the notarized signature of an authorized CITY official.

b. At such time as the DEVELOPER believes that the work for which the security was required is complete and makes payment of a partial exoneration fee of \$350 to the CITY, the DEVELOPER shall notify the CITY in writing of the completed work, including a list of work completed. Upon receipt of the written notice, the CITY shall have 45 days to review and comment or approve the completion of the Improvements. If the CITY does not agree that all work has been completed in accordance with the plans

and specifications for the Improvements, it shall supply a list of all remaining work to be completed.

c. Within 45 days of receipt of the CITY's list of remaining work, the DEVELOPER may then provide cost estimates for all remaining work for review and approval by the CITY.

d. Upon receipt of the cost estimates, the CITY shall then have 45 days to review, comment, and approve, modify or disapprove those cost estimates. The CITY shall not be required to engage in this process of partial release more than once between the start of work and the completion and acceptance of all work.

e. The DEVELOPER shall complete the works of Improvement until all remaining items are accepted by the CITY. Upon completion of the Improvements, the DEVELOPER shall be notified in writing by the CITY within 45 days and, within 45 days of the date of the CITY's notice, the release of any remaining performance security shall be made within 60 days of the recording of the Notice of Completion.

10. Procedure for Release of Payment Bond Security. Security securing the payment to the contractor, his or her subcontractors and persons furnishing labor, materials or equipment may, after passage of the time within which mechanic's liens and stop notices are required to be recorded and after acceptance of the Improvements, be reduced by Surety to an amount equal to the total claimed by all claimants for whom mechanic's liens and stop notices have been recorded and notice thereof given in writing to the CITY, and if no claims have been recorded, the security may be released in full.

11. Security for One-Year Warranty Period. The release procedures described in paragraphs 9 and 10 above shall not apply to any required guarantee and warranty period nor to the amount of the performance bond security deemed necessary by the CITY for the guarantee and warranty period nor to costs and reasonable expenses and fees, including reasonable attorneys' fees.

12. Binding Effect. This Security Agreement shall be binding upon and shall inure to the benefit of the parties hereto, their legal representatives and their successors and assigns.

13. Authority to Execute. The DEVELOPER hereby warrants and represents to the CITY that the individual signing this Security Agreement on behalf of the DEVELOPER is vested with the unconditional authority to do so pursuant to, and in accordance with, all applicable legal requirements, and has the authority bind the DEVELOPER hereto.

14. No Assignment. The DEVELOPER may not assign this Security Agreement, or any part thereof, to another without the prior written consent of the CITY.

15. Attorneys' Fees. In the event of legal action to enforce or interpret this Agreement or any of its provisions, the prevailing party shall be entitled, in addition to any other form of relief, to recover its reasonable attorneys' fees and costs of suit.

16. Execution in Counterparts. This Agreement may be executed in counterparts, each of which shall be deemed an original, but which together shall constitute a single agreement.

IN WITNESS WHEREOF, the parties have caused this Agreement to be executed on the dates listed below.

CITY OF BEAUMONT

By _____
Mayor

Date

DEVELOPER Woodside OES, LP a California Limited Partner
By: WDS, GP, Inc. a California Corporation
Its: General Partner
By: [Signature]
TIM McCHANE

4-14-15

Date

Title: Authorized Signatory

Address: 11870 Pierce St. #250
Riverside, CA 92505

- Reduced Bond Amount
 - What has been installed

CITY OF BEAUMONT PUBLIC WORKS DEPARTMENT
 CONSTRUCTION COST WORKSHEET

PARCEL MAP OR TRACT NO.: Tract No. 31462-7 Phase 1 Street, Sewer & Storm Drain Improvements
 DATE: 27-Apr-16

PP, CUP NO.: _____ BY: George A. Lenfestey

IMPROVEMENTS	FAITHFUL PERFORMANCE	100%
	LABOR & MATERIALS SECURITY	100%

Construction Costs)	
Streets/Drainage	\$ 864,035.25
Sewer	\$ 275,649.25
Total	\$ 1,139,684.50
Warranty Retention (22.5%)	\$ 256,429.01
Street/Drainage Plan Check Fees =	\$ 17,280.71
Sewer Plan Check Fees =	\$ 6,891.23
Street Inspection Fees =	\$ 25,921.06
Sewer Inspection Fees =	\$ 11,025.97

DESIGN ENGINEERS CALCULATIONS OF IMPROVEMENT BONDING COSTS

Construction items and their quantities as shown on attached sheets are accurate for the improvements required to construct the above project and the mathematical extensions using City's unit costs are accurate for determining bonding, plan check and inspection costs.

Above amounts do include additional 20% for recordation prior to having signed plans

Above amounts do not include additional 20% for recordation prior to having signed plans

 Engineer's Signature Date 04.27.16

George A. Lenfestey
 Name typed or printed

 Civil Engineer's Stamp

FORM \$ UNIT COSTS REVISED 09/06

*****PLEASE READ INSTRUCTIONS BELOW*****

- Quantities to be taken from improvement plans, Unit costs to be as provided on "City of Beaumont Construction Cost Worksheet".
- Show Bond Amounts to the nearest \$500.
- For construction items not covered by the Construction Cost Worksheet", Design Engineer is to provide his opinion of construction cost and use of that cost. If City of Beaumont unit costs are determined to be too low in the opinion of the Design Engineer, the higher costs as provided by the Design Engineer should be used.

CITY OF BEAUMONT PUBLIC WORKS DEPARTMENT
IMPROVEMENT REQUIREMENT WORKSHEET

PROJECT: Tract No. 31462-7 Phase 1 Street, Sewer & Storm Drain Improvements

DATE: 27-Apr-16

STREET IMPROVEMENTS				
QTY.	UNIT	ITEM	UNIT COST	AMOUNT
		Roadway Excavation		
2,332	C.Y.	1. Projects with a grading plan area x 0.50' (hinge point to hinge point)(125,939 sf)	\$ 15.00	\$ 34,980
		2. Projects without a grading plan (road area and side slopes to daylight Cut (C) = Fill (f) =		
	C.Y. (c or f)	(a.) Excavate and Fill	\$ 0.40	\$ -
	C.Y. (f - c)	(b.) Excavate and Export	\$ 1.10	\$ -
		(c.) Import and Fill	\$ 2.80	\$ -
		If balance, provide (a.) only, either cut or fill		
		If export, provide (a.) & (b.), a = fill, b = cut - fill		
		If import, provide (a.) & (c.), a = cut, c= fill - cut		
		(Unit costs for (a.), (b.) & (c.) are 20% of actual costs to assure that work will be corrected to eliminate hazardous conditions.)		\$ -
	S.F.	Remove A.C. Pavement	\$ 1.00	\$ -
	L.F.	Remove Curb and Gutter	\$ 4.00	\$ -
	L.F.	Remove A.C. Dike	\$ 3.00	\$ -
	S.F.	Remove Sidewalk	\$ 3.00	\$ -
	L.F.	Sawcut & Remove Exist. A.C. Pavement	\$ 2.00	\$ -
				\$ -
				\$ -
\$ 34,980

6/13/2016

CITY OF BEAUMONT PUBLIC WORKS DEPARTMENT
IMPROVEMENT REQUIREMENT WORKSHEET

PROJECT: Tract No. 31462-7 Phase 1 Street, Sewer & Storm Drain Improvements

DATE: 27-Apr-16

STREET IMPROVEMENTS (Cont'd.)				
QTY.	UNIT	ITEM	UNIT COST	AMOUNT
	L.F.	Remove Chain Link Fence	\$ 2.50	\$ -
	EA.	Remove Barricade	\$ 200.00	\$ -
2,267	TON	Asphalt Concrete - 144 lbs/cu. Ft. (125,939 SF @ 0.25')	\$ 90.00	\$ 204,030
2,332	C.Y.	Aggregate Base Class II (125,939 SF@0.50')	\$ 50.00	\$ 116,600
1	TON	Asphalt Emulsion (Fog Seal/Paint Binder) (1 ton = 240 gals) (125,939 SF)	\$ 600.00	\$ 540
		apply at 0.05 + 0.03 = 0.08 gal/SY		\$ -
	S.F.	AC overlay (min. 0.10') If export, provide (a) & (b), a=fill, b=cut-fill If import, provide (a)&(C), a=cut, c=fill-cut (Unit costs for (a), (b) & (C) are 20% of actual costs to assure that work will be corrected to eliminate hazardous conditions.)	\$ 0.90	\$ -
	S.F.	Remove A.C. Pavement	\$ 0.50	\$ -
	L.F.	Curb and Gutter (Wedge Curb)	\$ 8.00	\$ -
7,722	L.F.	Curb and Gutter (Type A-6)	\$ 10.00	\$ 77,220
	L.F.	Curb and Gutter (Type A-8)	\$ 12.00	\$ -
	L.F.	Type "C" Curb	\$ 10.00	\$ -
	L.F.	Type "D" Curb	\$ 15.00	\$ -
	L.F.	A.C. Dike (6") (incl. material & labor)	\$ 8.00	\$ -
	L.F.	A.C. Dike (8") (incl. Material & labor)	\$ 10.00	\$ -
3,060	S.F.	P.C.C. Cross Gutter and Spandrels	\$ 10.00	\$ 30,600
	S.F.	P.C.C. Sidewalk	\$ 6.00	\$ -
	SF	P.C.C. Drive Approach	\$ 8.00	\$ -
4	EA.	Handicapped Access Ramp	\$ 1,500.00	\$ 6,000
88	EA.	P.C.C. Drive Approach (individual lot driveway approach per finished grading plan)	\$ 8.00	\$ 704
	S.F.	Cold Plane & Overlay Exist. A.C. Paving	\$ 4.00	\$ -
				\$ -
				\$ -
				\$ -

SUBTOTAL = \$ 435,694.00

CITY OF BEAUMONT PUBLIC WORKS DEPARTMENT
IMPROVEMENT REQUIREMENT WORKSHEET

PROJECT: Tract No. 31462-7 Phase 1 Street, Sewer & Storm Drain Improvements

DATE: 27-Apr-16

STREET IMPROVEMENTS (Cont'd.)				
QTY.	UNIT	ITEM	UNIT COST	AMOUNT
7	EA.	Street Name Sign	\$ 250.00	\$ 1,750
	EA.	Delineators-per Caltrans Std. A73C, Class 1, Type F	\$ 40.00	\$ -
	EA.	Object Markers - Modified Type F Delineators, Riverside County	\$ 40.00	\$ -
32	L.F.	Barricades	\$ 28.00	\$ 896
3,956	L.F.	Utility Trench, one side (Edison, Telephone, Cable) (Total length of streets)	\$ 10.00	\$ 39,560
	L.F.	Chain Link Fence (6')	\$ 12.00	\$ -
	L.F.	Remove Fence	\$ 4.00	\$ -
	EA.	Remove Power Pole	\$ 1,200.00	\$ -
-	EA.	Street Lights (including conduit)	\$ 5,000.00	\$ -
95	EA.	Street Trees (15 gallon)	\$ 150.00	\$ 14,250
	L.S.	Landscape and Irrigation	\$ -	\$ -
	EA.	Concrete Bulkhead	\$ 200.00	\$ -
	C.Y.	Structural Reinforced Concrete	\$ 400.00	\$ -
	EA.	Slope Anchors for Pipes	\$ 300.00	\$ -
	L.F.	Cut Off Wall (Std. 2')	\$ 5.50	\$ -
	EA.	A.C. Overside Drain	\$ 500.00	\$ -
	EA.	Under Sidewalk Drain	\$ 1,800.00	\$ -
	S.F.	Terrace Drains and Down Drains	\$ 6.50	\$ -
	S.F.	Interceptor Drains	\$ 6.50	\$ -
9	EA.	Gutter Depression for Curb Opening Catch Basin	\$ 1,500.00	\$ 13,500
1	EA.	Access Driveway for Storm Drain at Cul-de-Sac	\$ 640.00	\$ 640
3	EA.	"STOP" Pavement Marking	\$ 200.00	\$ 600
3	EA.	Limit Line	\$ 75.00	\$ 225
6	EA.	R1 "STOP SIGN"	\$ 250.00	\$ 1,500
1	EA.	W53 "NOT A THROUGH STREET" Sign	\$ 250.00	\$ 250
				\$ -
				\$ -
				\$ -
				\$ -

SUBTOTAL = \$ 73,171.00

6/13/2016

CITY OF BEAUMONT PUBLIC WORKS DEPARTMENT
IMPROVEMENT REQUIREMENT WORKSHEET

PROJECT: Tract No. 31462-7 Phase 1 Street, Sewer & Storm Drain Improvements

DATE: 27-Apr-16

STREET IMPROVEMENTS (Cont'd.)				
QTY.	UNIT	ITEM	UNIT COST	AMOUNT
	C.Y.	Rip Rap (1/4 Ton) Method B	\$ 35.00	\$ -
	C.Y.	Rip Rap (1/2 Ton) Method B	\$ 40.00	\$ -
	C.Y.	Rip Rap (1 Ton) Method B	\$ 45.00	\$ -
	C.Y.	Rip Rap (2 Ton) Method B	\$ 50.00	\$ -
	C.Y.	Grouted Rip Rap (1/4 Ton) Method B	\$ 45.00	\$ -
	C.Y.	Grouted Rip Rap (1/2 Ton) Method B	\$ 55.00	\$ -
	C.Y.	Grouted Rip Rap (1Ton) Method B	\$ 60.00	\$ -
	C.Y.	Grouted Rip Rap (2 Ton) Method B	\$ 65.00	\$ -
118	L.F.	18" R.C.P.	\$ 60.00	\$ 7,080
166	L.F.	24" R.C.P.	\$ 70.00	\$ 11,620
63	L.F.	30" R.C.P.	\$ 80.00	\$ 5,040
990	L.F.	36" R.C.P.	\$ 90.00	\$ 89,100
	L.F.	42" R.C.P.	\$ 100.00	\$ -
	L.F.	48 " RCP	\$ 110.00	\$ -
	L.F.	54" RCP	\$ 135.00	\$ -
	L.F.	60" RCP	\$ 160.00	\$ -
	L.F.	72" RCP	\$ 200.00	\$ -
	L.F.		\$ 1.00	\$ -
	L.F.		\$ 1.00	\$ -
	EA.	H.D.P.E. Clean Out	\$ 400.00	\$ -
1	EA.	Drain Basin	\$ 400.00	\$ 400
1	EA.	Curb Outlet	\$ 3,000.00	\$ 3,000
	EA.	Fossil Filters	\$ 500.00	\$ -
	EA.	18" C.M.P. Wye	\$ 500.00	\$ -
	EA.	Riprap Headwall	\$ 1,000.00	\$ -
1	EA.	Concrete Collar	\$ 250.00	\$ 250
	EA.	Outlet Structure	\$ 10,000.00	\$ -
	EA.	Concrete Pipe Anchor & Stabilizer	\$ 250.00	\$ -
	L.F.	12" HDPE. Pipe	\$ 31.00	\$ -
	L.F.	36" HDPE. Pipe	\$ 75.00	\$ -

SUBTOTAL = \$ 116,490.00

CITY OF BEAUMONT PUBLIC WORKS DEPARTMENT
IMPROVEMENT REQUIREMENT WORKSHEET

PROJECT: Tract No. 31462-7 Phase 1 Street, Sewer & Storm Drain Improvements

DATE: 27-Apr-16

STREET IMPROVEMENTS (Cont'd.)				
QTY.	UNIT	ITEM	UNIT COST	AMOUNT
	L.F.	60" C.S.P.	\$ 115.00	\$ -
	EA.	Catch Basin W = 4'	\$ 1,700.00	\$ -
1	EA.	Catch Basin W = 7'	\$ 3,000.00	\$ 3,000
2	EA.	Catch Basin W = 10'	\$ 4,000.00	\$ 8,000
3	EA.	Catch Basin W = 14'	\$ 5,500.00	\$ 16,500
3	EA.	Catch Basin W = 21'	\$ 9,000.00	\$ 27,000
	EA.	Type IX Inlet	\$ 2,500.00	\$ -
	EA.	Type X Inlet	\$ 2,500.00	\$ -
	EA.	Junction Structure No. 1	\$ 3,000.00	\$ -
	EA.	Junction Structure No. 2	\$ 2,500.00	\$ -
	EA.	Junction Structure No. 6	\$ 3,700.00	\$ -
	EA.	Transition Structure No. 1	\$ 2,000.00	\$ -
	EA.	Transition Structure No. 3	\$ 2,700.00	\$ -
8	EA.	Manhole No. 1	\$ 2,700.00	\$ 21,600
2	EA.	Manhole No. 2	\$ 3,300.00	\$ 6,600
	EA.	Manhole No. 3	\$ 2,700.00	\$ -
1	EA.	Manhole No. 4	\$ 5,000.00	\$ 5,000
	EA.	Adjust Water Valve (if no water plan)	\$ 150.00	\$ -
	EA.	Adjust MH to grade (if no sewer plan)	\$ 400.00	\$ -
	EA.	Headwall	\$ 5,000.00	\$ -
		Remove & Dispose of Interferring 30" Storm Drain		
	L.S.	and 36" Riser	\$ 500.00	\$ -
	EA.	Remove & Dispose of RCB Headwall & Wingwall	\$ 10,000.00	\$ -
	L.F.	and Concrete Bulkhead	\$ 25.00	\$ -
	EA.	Outlet Structure (Line A & B)	\$ 5,000.00	\$ -
	EA.	Remove Existing Headwall	\$ 1,000.00	\$ -
132	L.F.	Catch Basin Trash Rack	\$ 25.00	\$ 3,300
				\$ -
				\$ -
				\$ -
				\$ -
				\$ -
SUBTOTAL =			\$	91,000

CITY OF BEAUMONT PUBLIC WORKS DEPARTMENT
IMPROVEMENT REQUIREMENT WORKSHEET

PROJECT: Tract No. 31462-7 Phase 1 Street, Sewer & Storm Drain Improvements

DATE: 27-Apr-16

STREET IMPROVEMENTS (Cont'd.)				
QTY.	UNIT	ITEM	UNIT COST	AMOUNT
	EA.	Water Quality Structure	\$ 2,500.00	\$ -
	LS	Concrete Inlet Apron	\$ 11,000.00	\$ -
	LS	Emergency Spillway	\$ 27,000.00	\$ -
	LS	84" Storm Drain Grate	\$ 8,500.00	\$ -
	SF	3' Wide V-Gutter (945 LF)	\$ 4.00	\$ -
				\$ -
				\$ -
				\$ -
				\$ -
				\$ -

Subtotal: \$ -

A.	Subtotal		\$	751,335
B.	Contingency (15%)		\$	112,700
C.	Streets/Drainage Total (A + B)		\$	864,035

CITY OF BEAUMONT PUBLIC WORKS DEPARTMENT
IMPROVEMENT REQUIREMENT WORKSHEET

PROJECT: Tract No. 31462-7 Phase 1 Street, Sewer & Storm Drain Improvements


DATE: 27-Apr-16

SEWER IMPROVEMENTS

Show quantities on this sheet only if project has a sewer plan. If no water plan, then show applicable quantities as part of street improvements.

QTY.	UNIT	ITEM	UNIT COST	AMOUNT
2,271	L.F.	4" PVC. (148 Lots @ 25' Avg. Length & 5' for cleanout)	\$ 15.00	\$ 34,065
	L.F.	4" P.V.C. Force Main & Fittings	\$ 26.00	\$ -
3,733	L.F.	8" PVC	\$ 30.00	\$ 111,990
	L.F.	10" V.C.P.	\$ 35.00	\$ -
	L.F.	12" V.C.P.	\$ 40.00	\$ -
	L.F.	15" V.C.P.	\$ 50.00	\$ -
15	EA.	Standard or Terminus Manholes	\$ 2,500.00	\$ 37,500
	EA.	Drop Manholes	\$ 4,000.00	\$ -
88	EA.	Cleanouts	\$ 500.00	\$ 44,000
88	EA.	Sewer Y's	\$ 25.00	\$ 2,200
	EA.	Chimneys	\$ 300.00	\$ -
	EA.	Adjust M.H. to grade	\$ 340.00	\$ -
	L.F.	Concrete Encasement	\$ 20.00	\$ -
-	EA.	4" P.V.C. Misc. Fittings	\$ 120.00	\$ -
-	L.F.	Sewer Pipe Sleeving	\$ 36.00	\$ -
	EA.	Sewer Lift Station		\$ -
39	EA.	Backflow prevention device	\$ 250.00	\$ 9,750
1	EA.	8" P.V.C. Misc. Fittings & Plugs	\$ 190.00	\$ 190
				\$ -

A.	Subtotal	\$ 239,695
B.	Contingency (15% x A)	\$ 35,954
C.	Sewer Total (A + B)	\$ 275,649

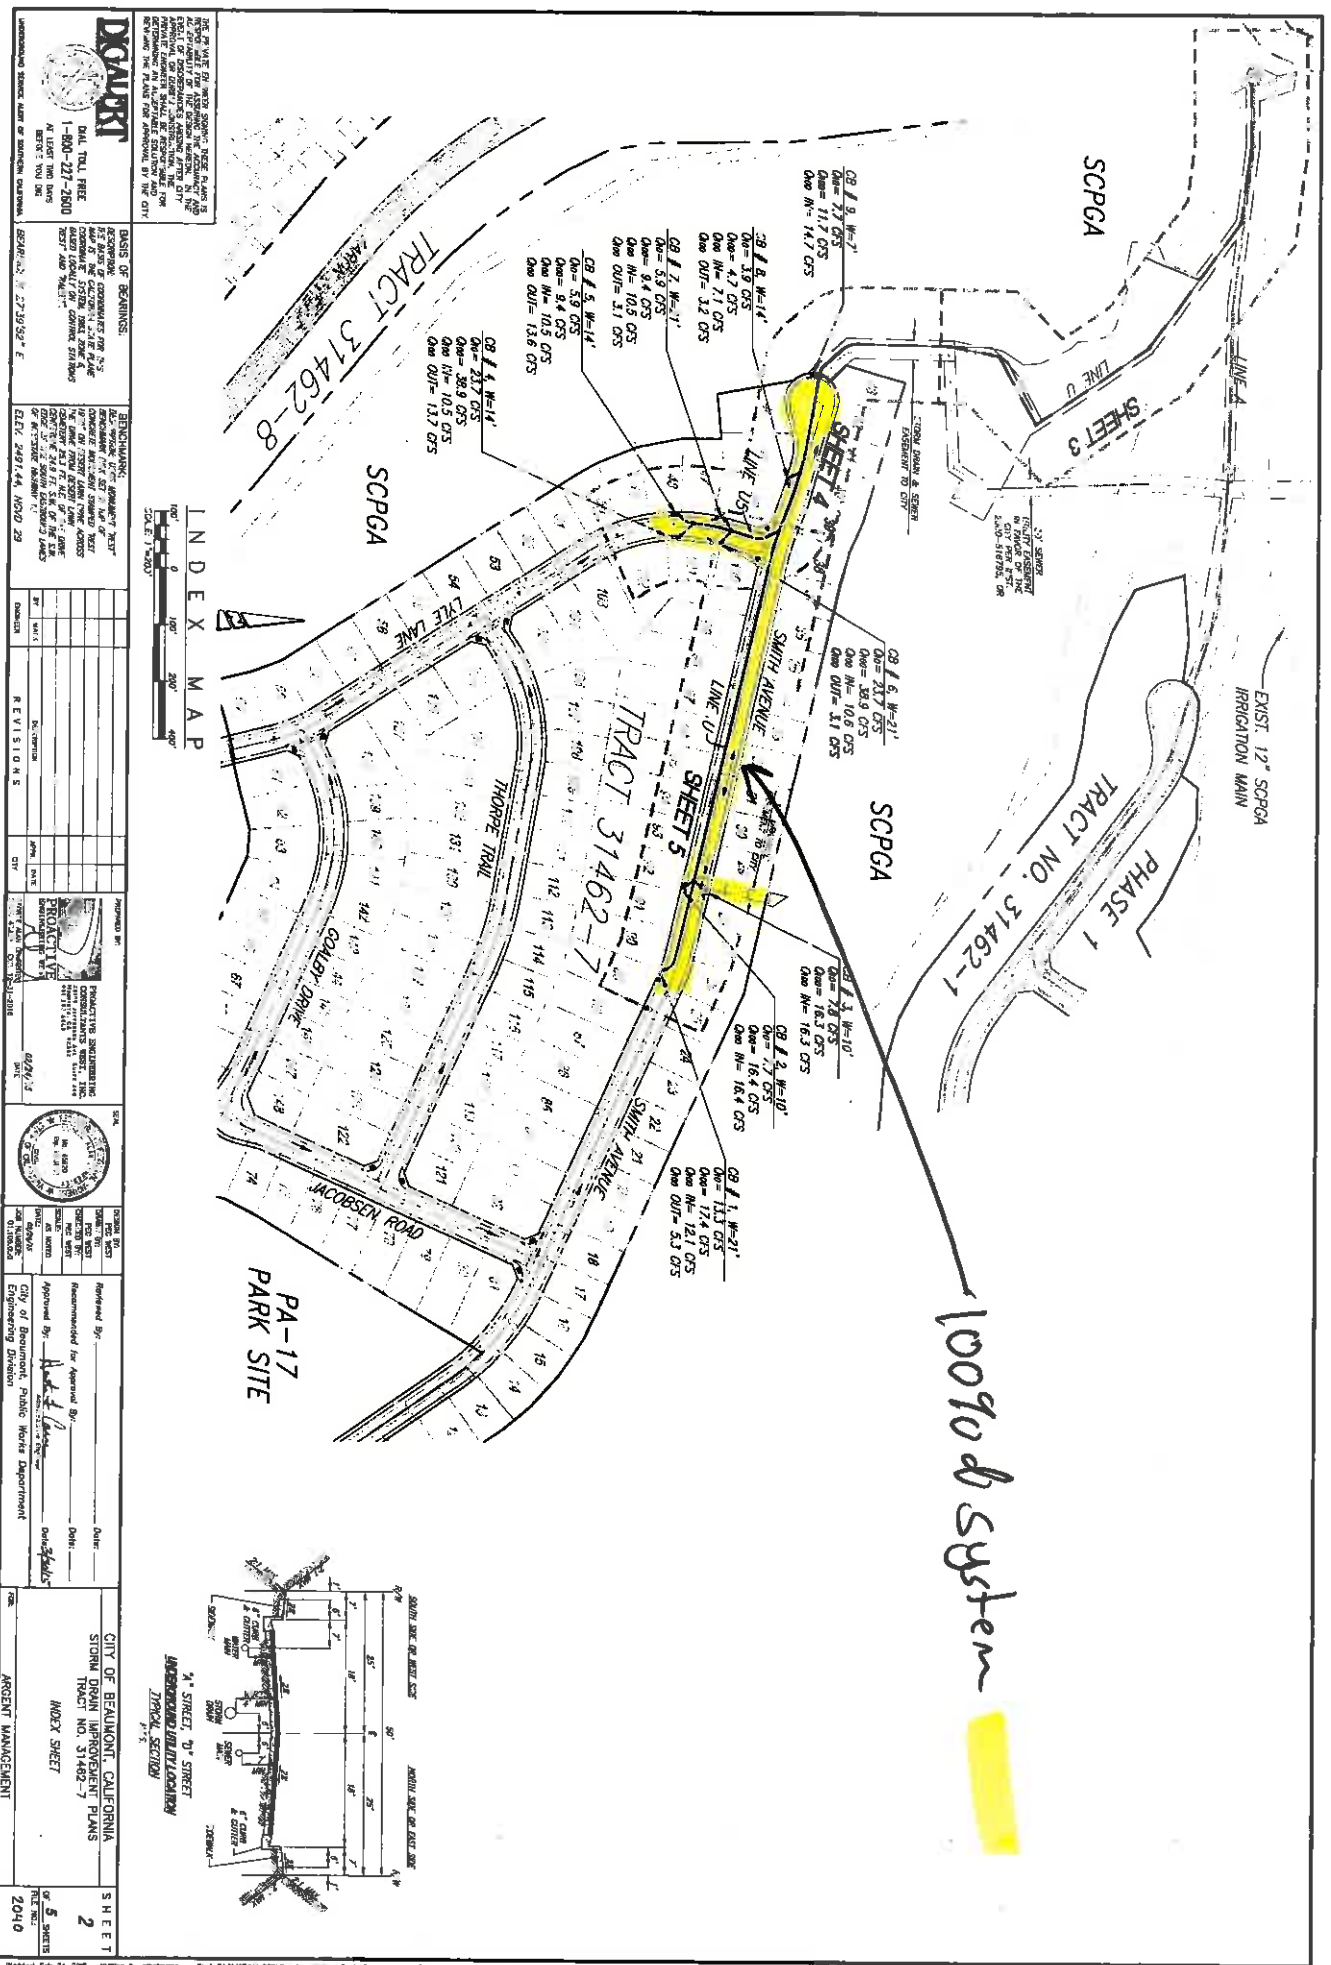

DCALBERT
 DIAL TOLL FREE
 1-800-271-2000
 AT LEAST TWO DAYS BEFORE THE PLAN FOR APPROVAL BY THE CITY ENGINEERING DIVISION.


DATE OF BEARING:



INDEX MAP
 SCALE: 1"=200'

NO.	DATE	REVISIONS

APPROVED BY:	DATE:
RECOMMENDED BY:	DATE:
APPROVED BY:	DATE:
RECOMMENDED BY:	DATE:

CITY OF BEALMONT, CALIFORNIA
 STORM DRAIN IMPROVEMENT PLANS
 TRACT NO. 31462-7
 INDEX SHEET
 SHEET 2
 OF 5 SHEETS
 2010

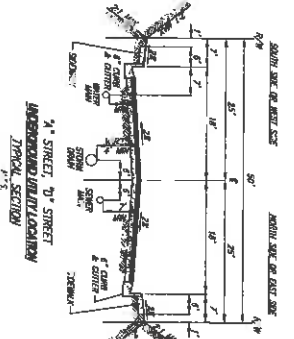

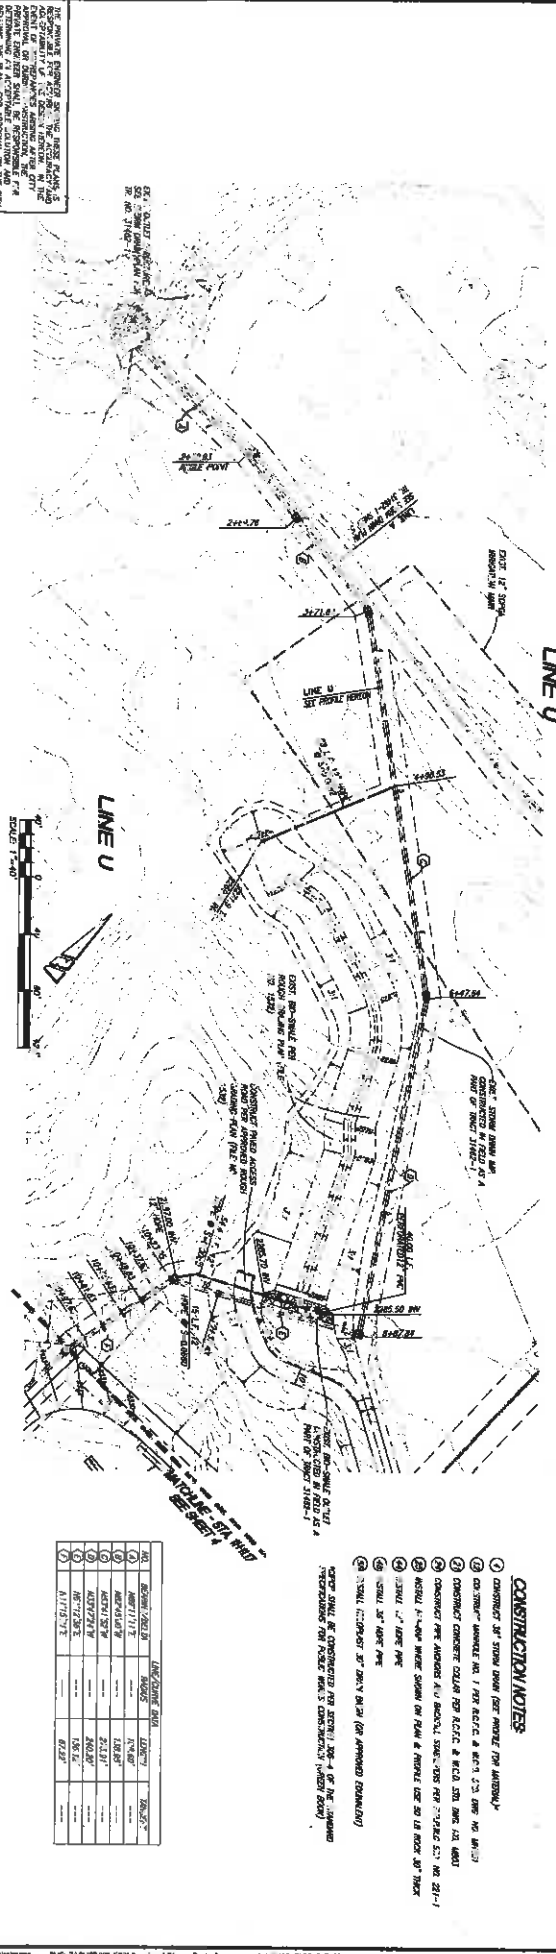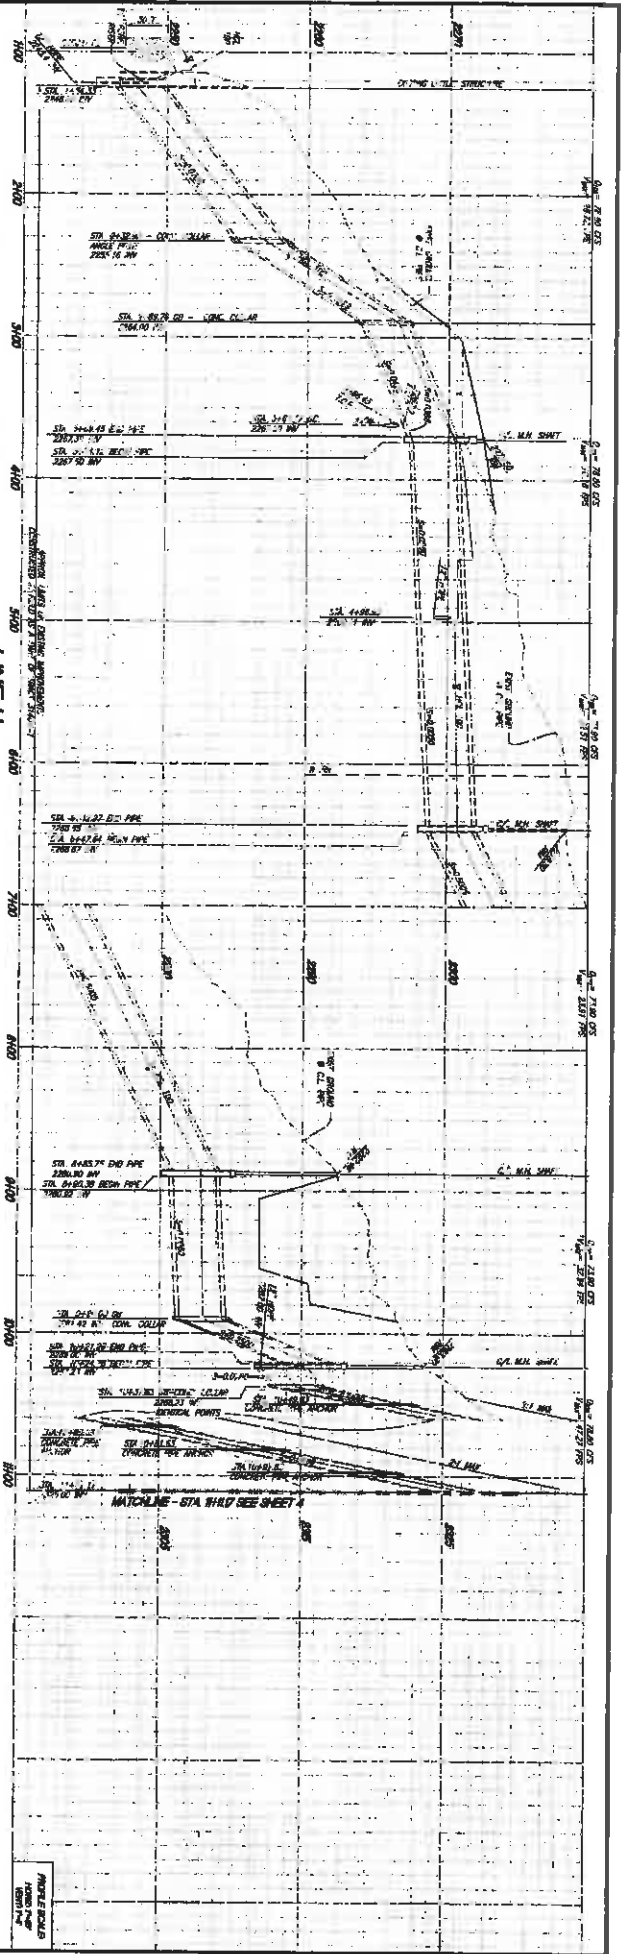

CONSTRUCTION NOTES

- 1. CONTRACTOR TO VERIFY ALL EXISTING CONDITIONS AND RECORD THEM ACCURATELY.
NO.	REVISION	DATE	BY	CHKD.



DEPART
 DATE: TOLL FREE
 1-800-227-2600

REVISIONS

NO.	DATE	DESCRIPTION

BENCHMARKS


REVISIONS

NO.	DATE	DESCRIPTION

REVISIONS

NO.	DATE	DESCRIPTION

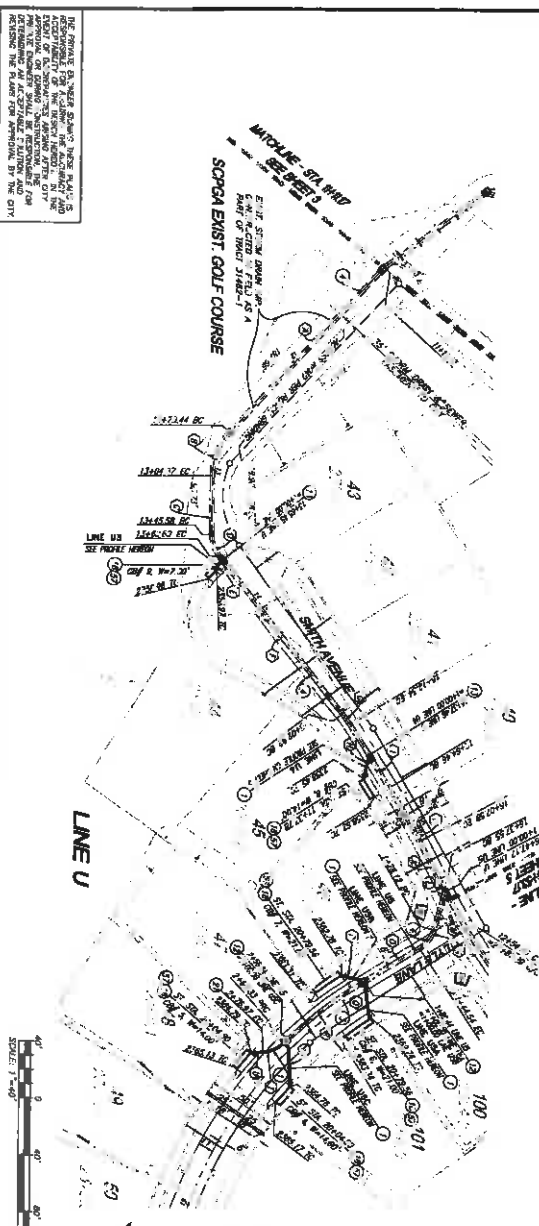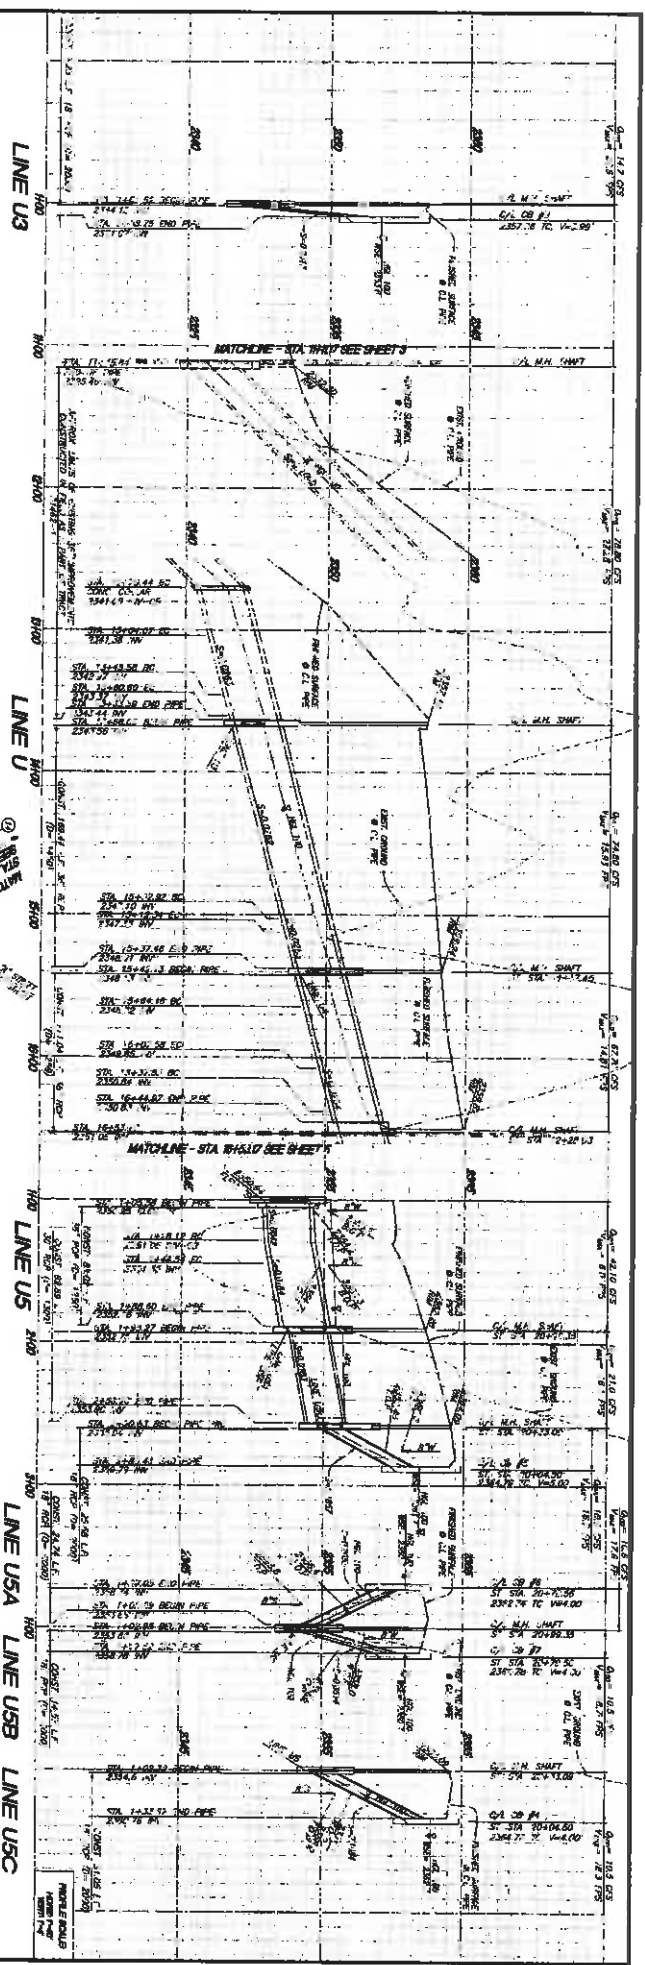

- CONSTRUCTION NOTES**
MANHOLE STRUCTURE DATA TABLE

STATIONING	MANHOLE	DIAMETER	DEPTH	INVERT	CONCRETE	PIPE	PIPE SIZE	PIPE MATERIAL	PIPE SLOPE	PIPE LENGTH	PIPE START	PIPE END	PIPE INVERT	PIPE MANHOLE

PROPOSED


DATE: 10/15/10

SCALE: 1" = 40'

REVISIONS

NO.	DATE	DESCRIPTION
1	10/15/10	ISSUED FOR PERMIT

APPROVED BY: [Signature]

DATE: 10/15/10

APPROVED BY: [Signature]

DATE: 10/15/10

CITY OF BEAUNONT, CALIFORNIA


TRACT NO. 31462-7


SHEET

4

OF 5 SHEETS

ARGENT MANAGEMENT

2040

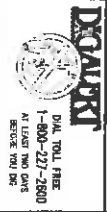


DCA/ART
 DIA TOLL FREE
 1-800-227-2600
 AT LEAST TWO DAYS
 BEFORE THE BIDS

BASES OF BEARINGS:

BENCHMARK:
 REVISIONS
 NO. DATE REVISION



APPROVED BY: [Signature]
 DATE: [Date]

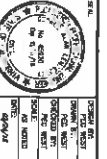

REVISIONS


CITY OF BEAUMONT, CALIFORNIA
 STORM DRAIN IMPROVEMENT PLANS
 TRACT NO. 31482-7
 LINE 11 (VA 1) + 12
 SHEET 5
 PREPARED BY: [Signature]
 DATE: [Date]

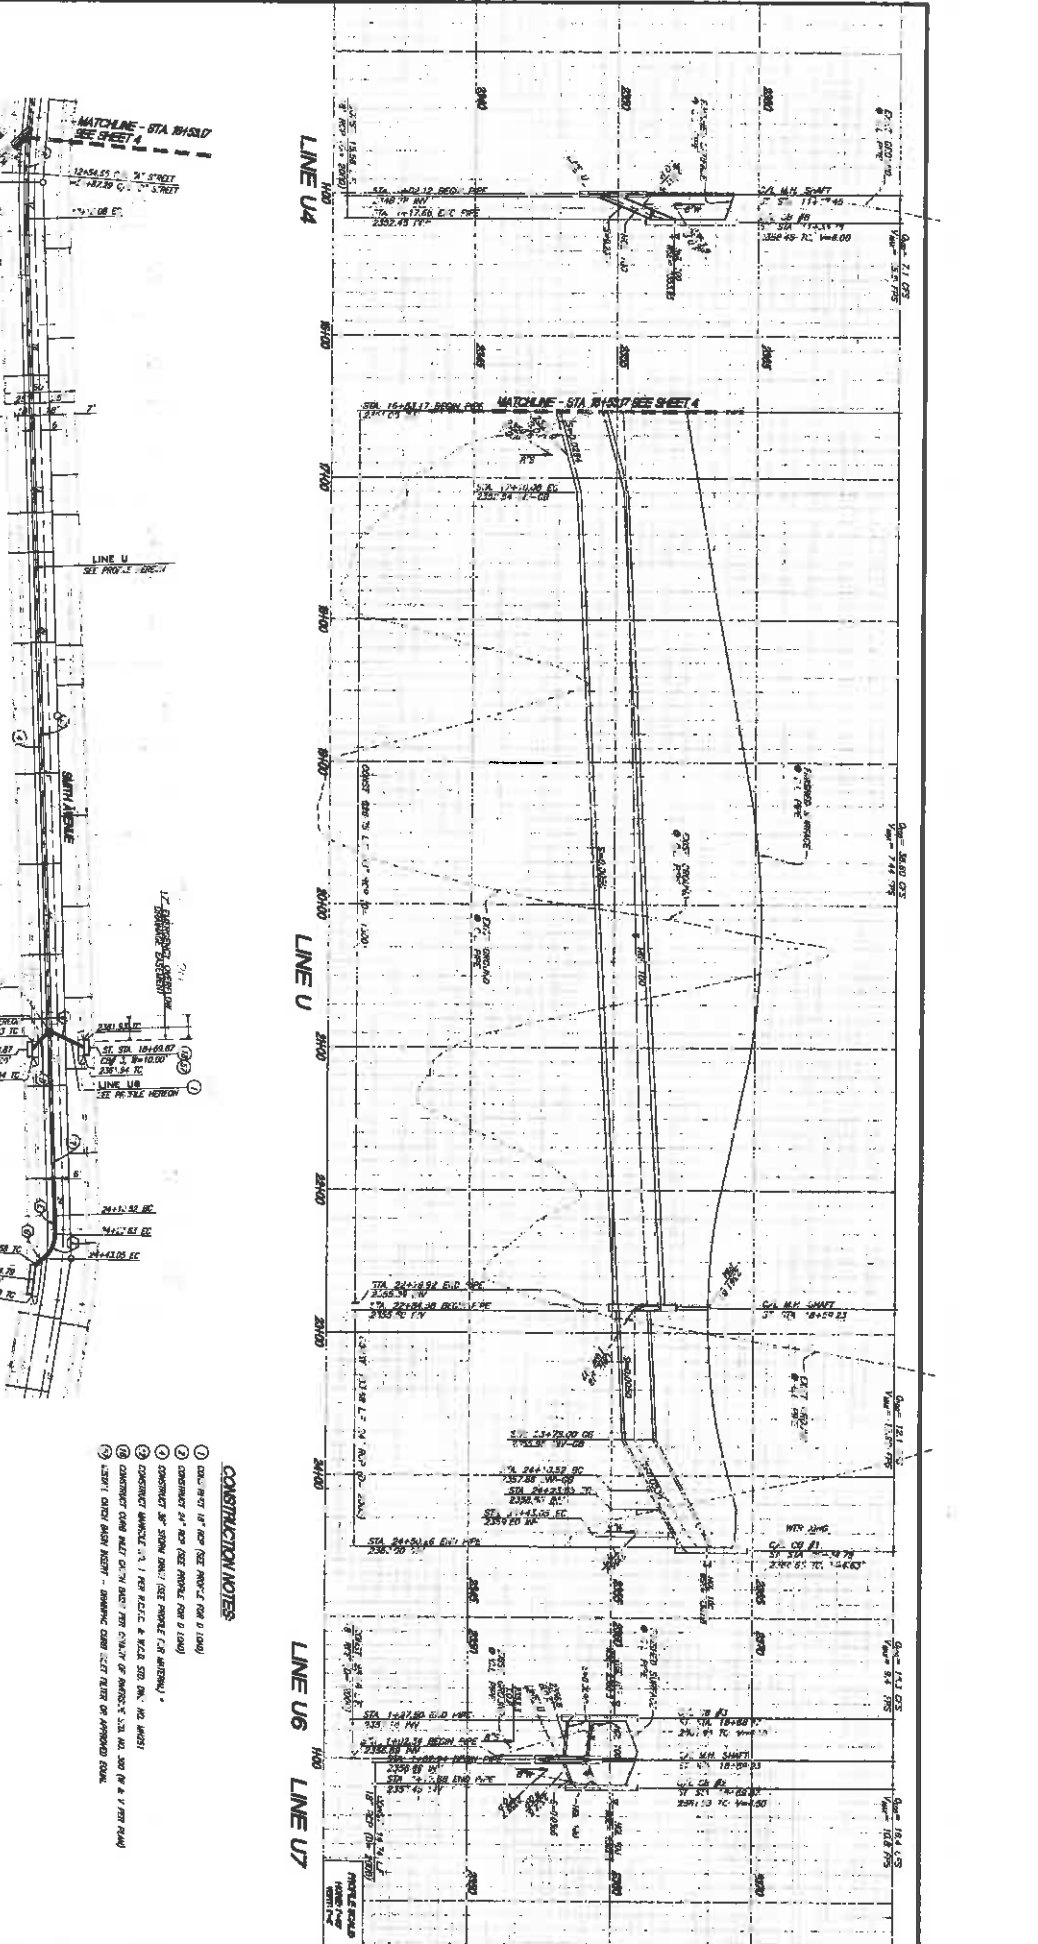
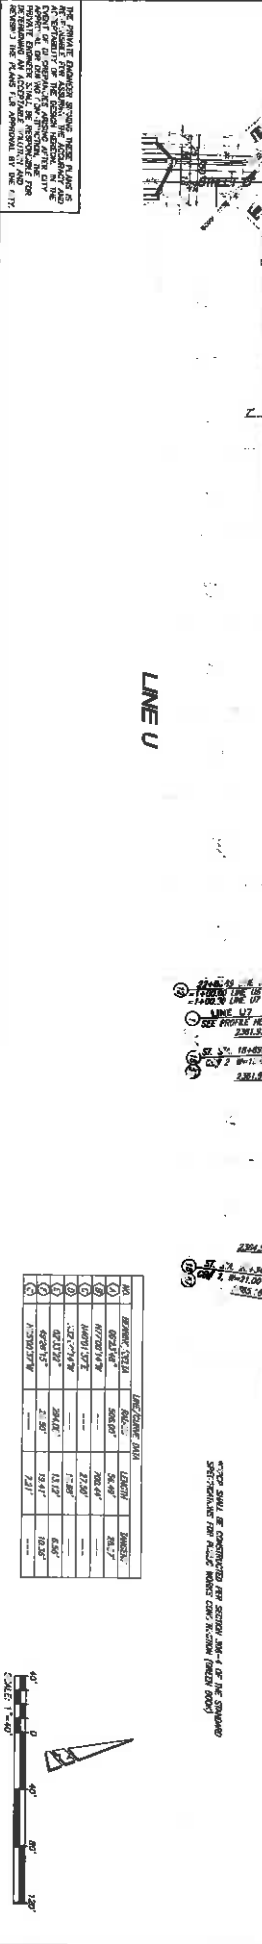


CONSTRUCTION NOTES


*FOR SHALL BE CONSTRUCTED PER SECTION 04-1.0 OF THE STANDARD SPECIFICATIONS FOR PUBLIC WORKS (MCDOT 2013)

CITY OF BEAUMONT, CALIFORNIA
SEWER IMPROVEMENT PLANS
TRACT NO. 31462-7

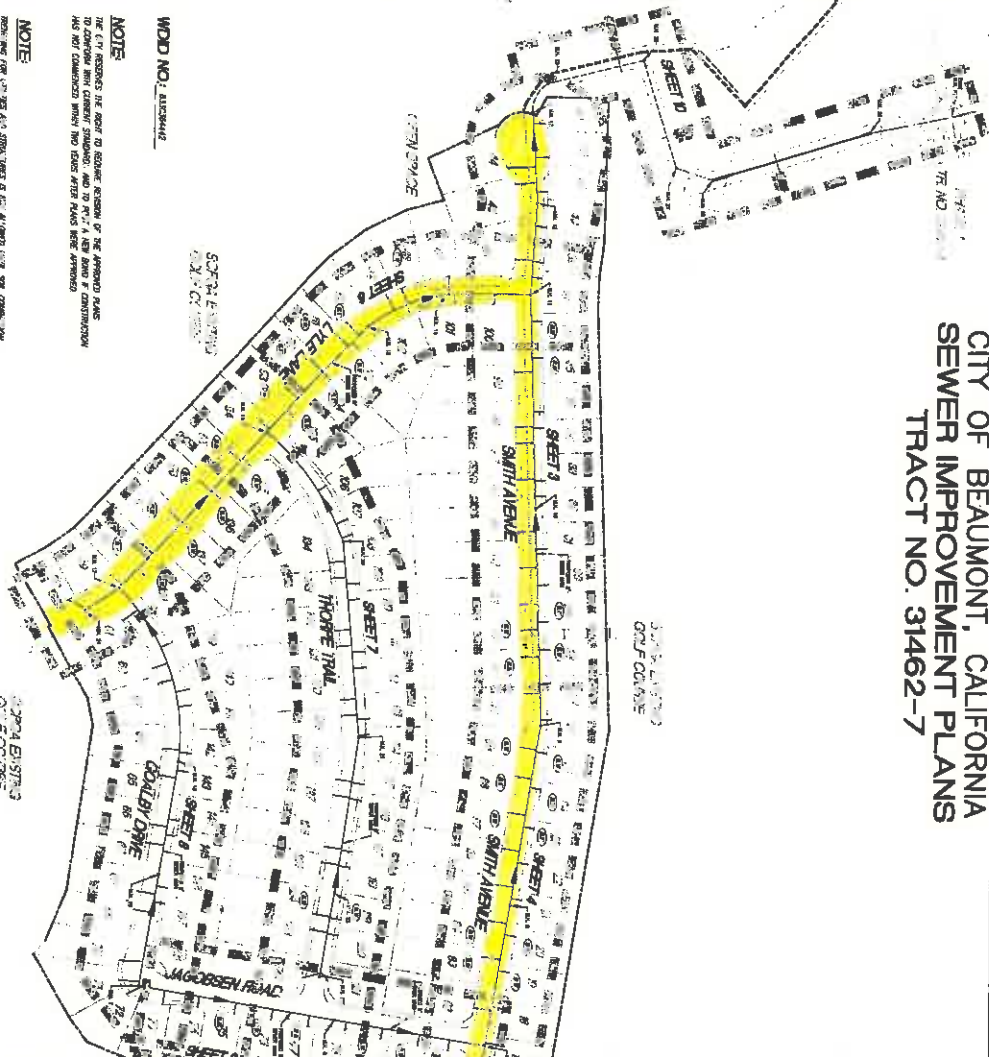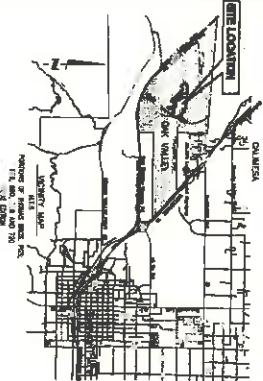



LEGEND
























DISTRICT

DISTRICT NO. 1
CITY OF BEAUMONT, CALIFORNIA








APPLICANT/BORROWER

CITY OF BEAUMONT, CALIFORNIA
SEWER IMPROVEMENT PLANS
TRACT NO. 31462-7
WARRANTY AND NOTES





CITY OF BEAUMONT, CALIFORNIA
SEWER IMPROVEMENT PLANS
TRACT NO. 31462-7
WARRANTY AND NOTES




TYPICAL SECTION
SOUTH AVE. FORD STREET, JACOBSEN ROAD
LINEAR MANHOLE TYPICAL AND GOALBY DRIVE
 48" DIA. MANHOLE SPANNING 1.5' W/ 48" CORR.
 FROM 18" DIA. TO 36" DIA. OF PIPE

CONSTRUCTION NOTES AND ESTIMATED QUANTITIES

- ITEM**

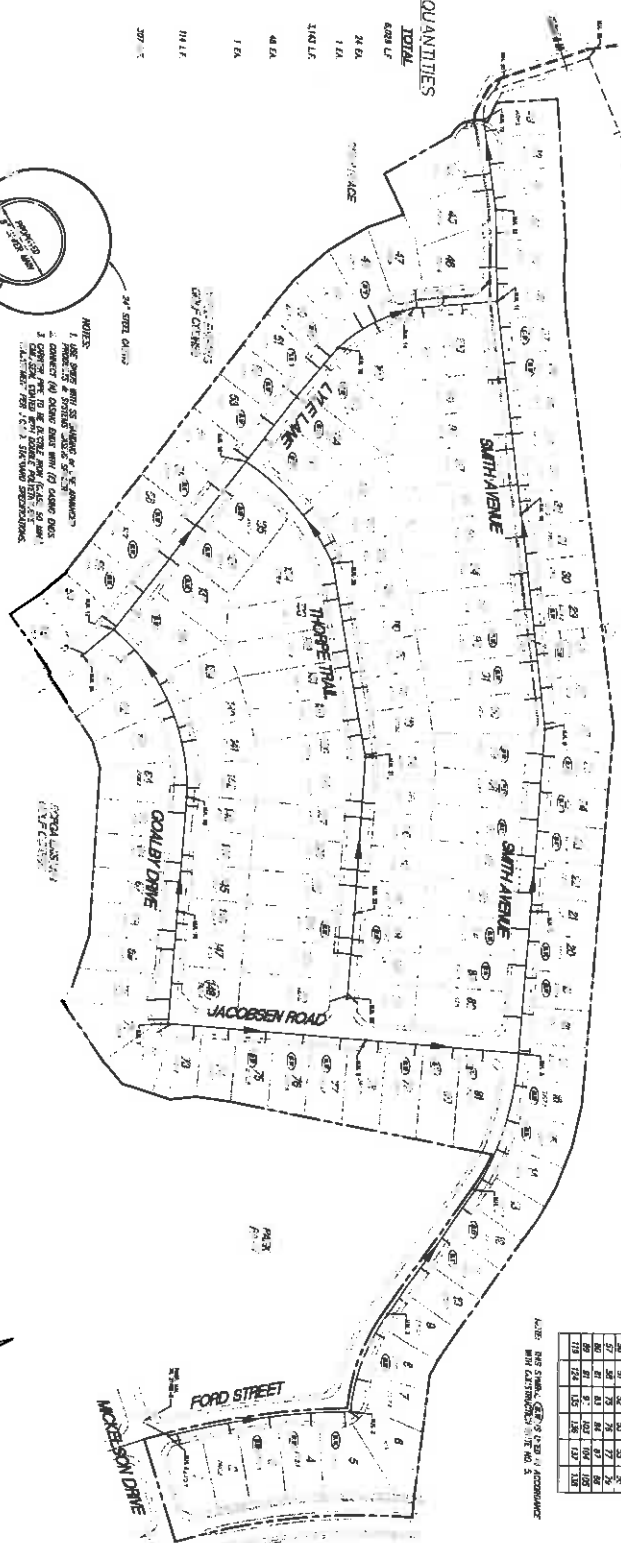




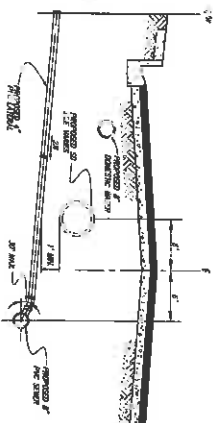

DETAIL A - TYPICAL MANHOLE CROSS SECTION
 NOT TO SCALE
 SHOWS CONSTRUCTION OF MANHOLE AT 24\"/>

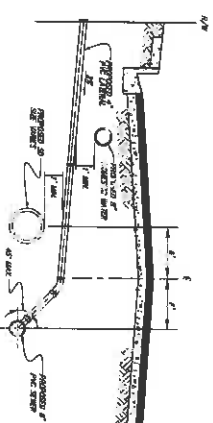

DETAIL B - TYPICAL MANHOLE CROSS SECTION
 NOT TO SCALE
 SHOWS CONSTRUCTION OF MANHOLE AT 24\"/>

DEWBERT
 1-800-277-1800
 AT LEAST TWO DAYS
 BEFORE THE JOB



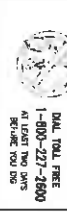



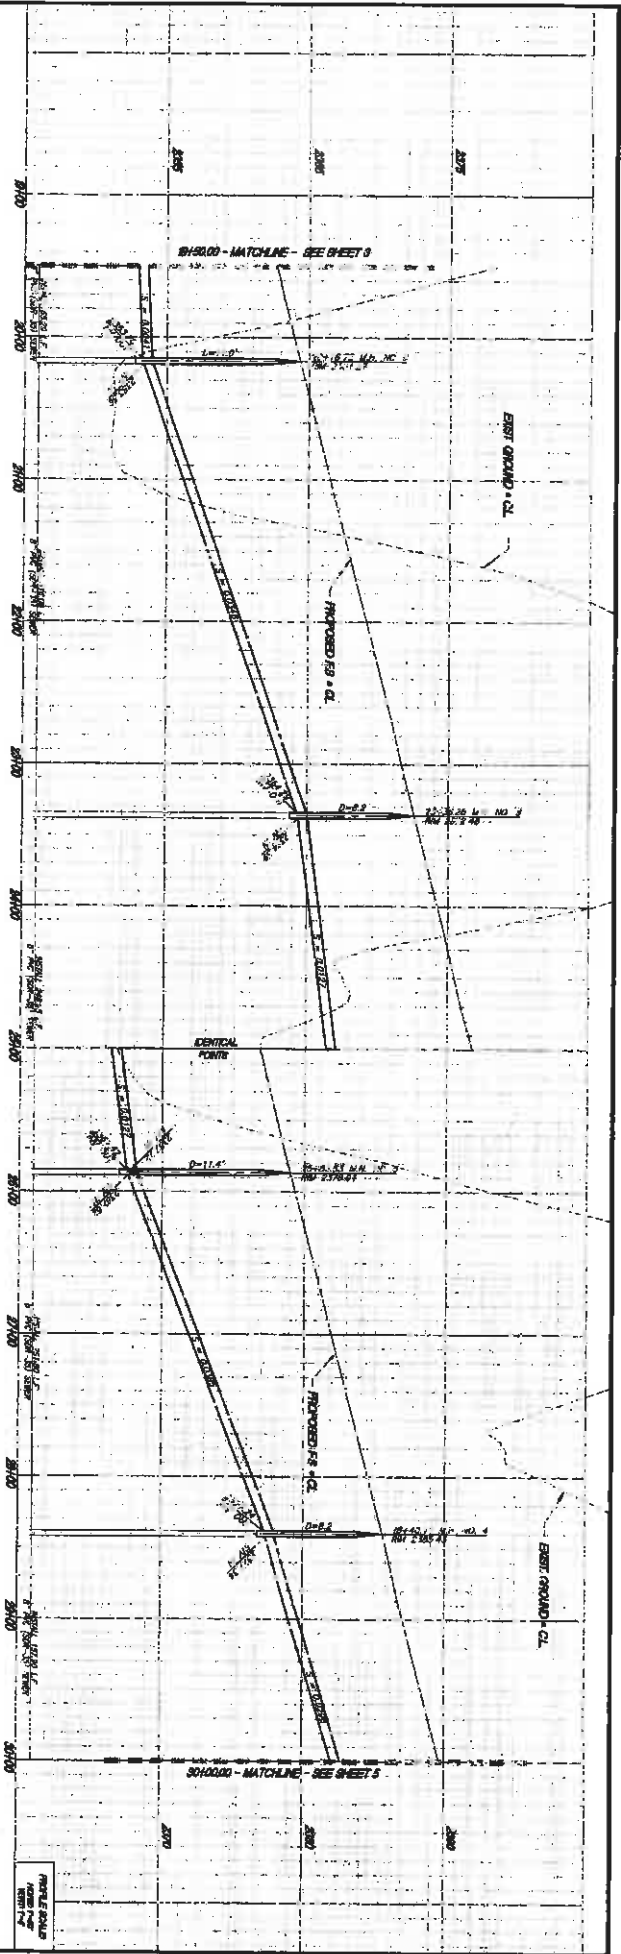

SMITH AVENUE


- CONSTRUCTION NOTES**
- INSTALL 4" PVC (SM-20) SEWER MAIN
 - INSTALL MANHOLE # 17 CONCRETE MANHOLE V/CUT
 - INSTALL 4" PVC SEWER LATERAL FOR CONCRETE MANHOLE # 17
 - INSTALL 4" PVC SEWER LATERAL FOR CONCRETE MANHOLE # 18
BEAULT
 1041 TOLL FREE
 1-800-277-2600
 AT LEAST TWO DAYS
 BEFORE 100:00

DESIGNER: *[Signature]*
CHECKED: *[Signature]*
DATE: 1/12/20

PROJECT: SEWER IMPROVEMENT PLANS
TRACT: SMITH AVENUE
NO.: 31462-7

CITY OF BEAULONT, CALIFORNIA
SEWER IMPROVEMENT PLANS
TRACT NO. 31462-7
SMITH AVENUE
SH. 15450.00 TO SH. 30450.00

ARGENT MANAGEMENT




SHEET
4
OF 10 SHEETS
2039

CONSTRUCTION NOTES

APPROVED BY: *[Signature]*
DATE: 1/12/20

CITY OF BEAULONT, CALIFORNIA
SEWER IMPROVEMENT PLANS
TRACT NO. 31462-7
SMITH AVENUE
SH. 15450.00 TO SH. 30450.00

ARGENT MANAGEMENT

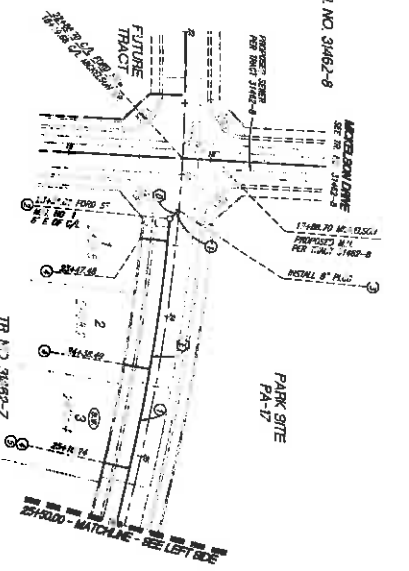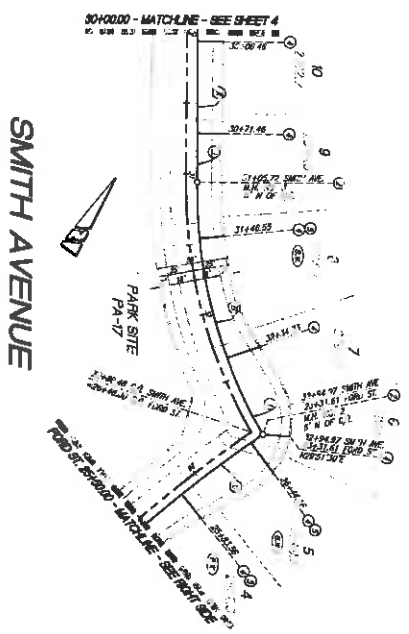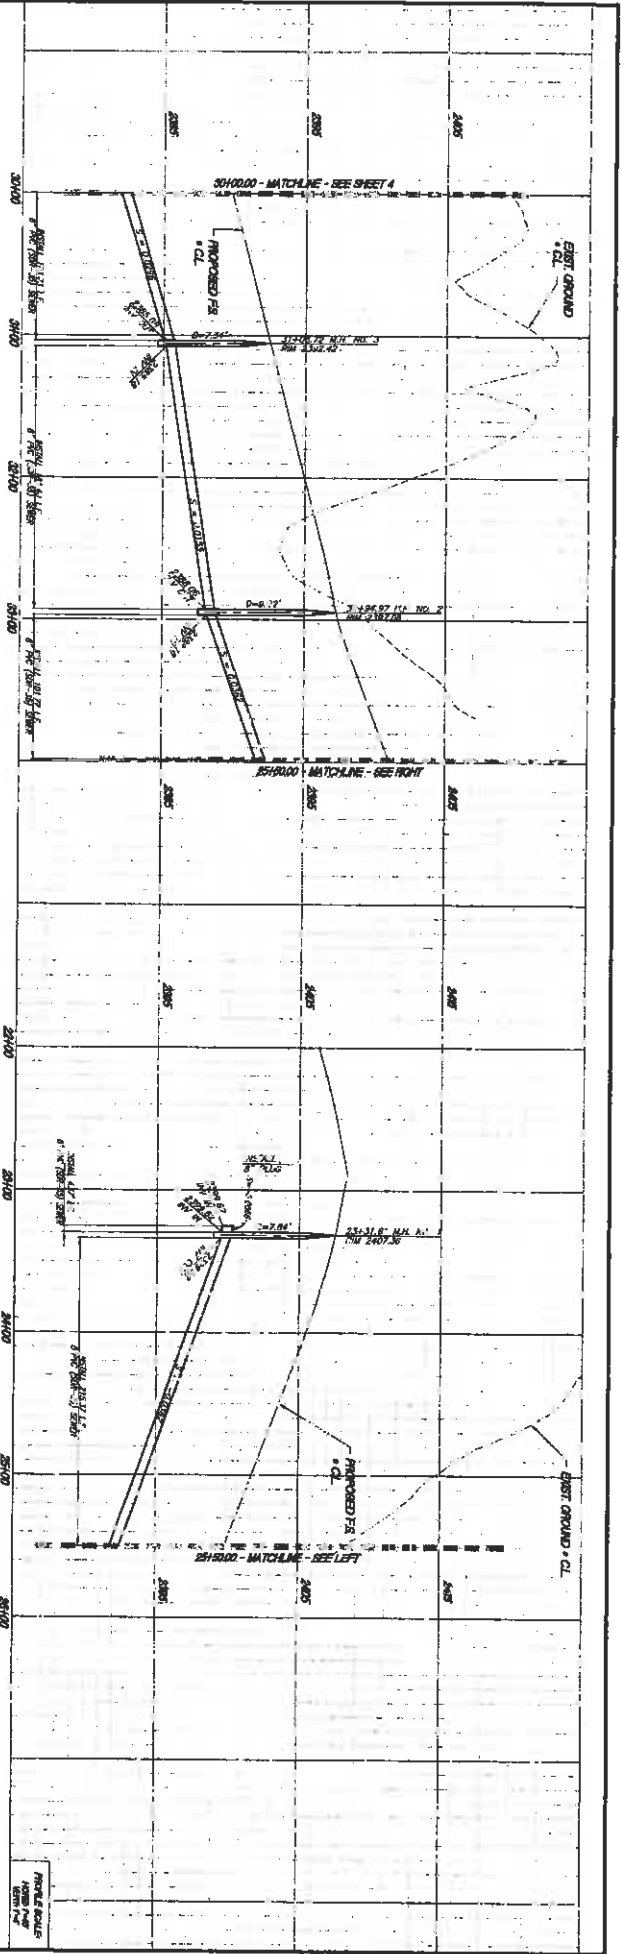














CITY OF BEAUMONT, CALIFORNIA
SEWER IMPROVEMENT PLANS
TRACT NO. 31462-7
SMITH AVENUE
FORD STREET
ARGENT MANAGEMENT



DAARB
DAVID J. DEARB
REGISTERED PROFESSIONAL ENGINEER
NO. 14883
STATE OF CALIFORNIA

SMITH AVENUE IMPROVEMENT PLANS
TRACT NO. 31462-7
FORD STREET
ARGENT MANAGEMENT









CITY OF BEAUMONT, CALIFORNIA
SEWER IMPROVEMENT PLANS
TRACT NO. 31462-7
SMITH AVENUE
FORD STREET
ARGENT MANAGEMENT

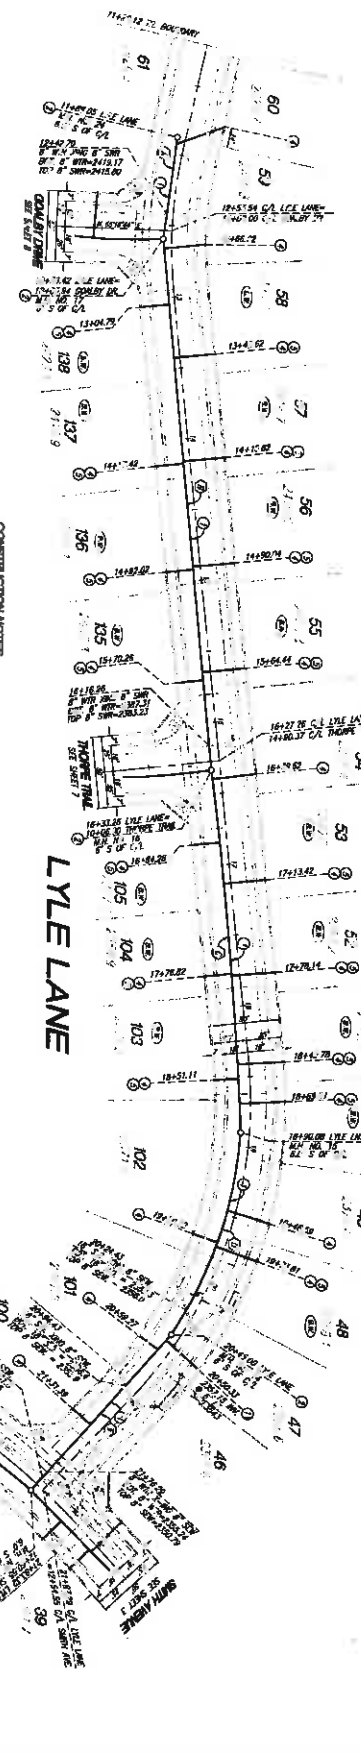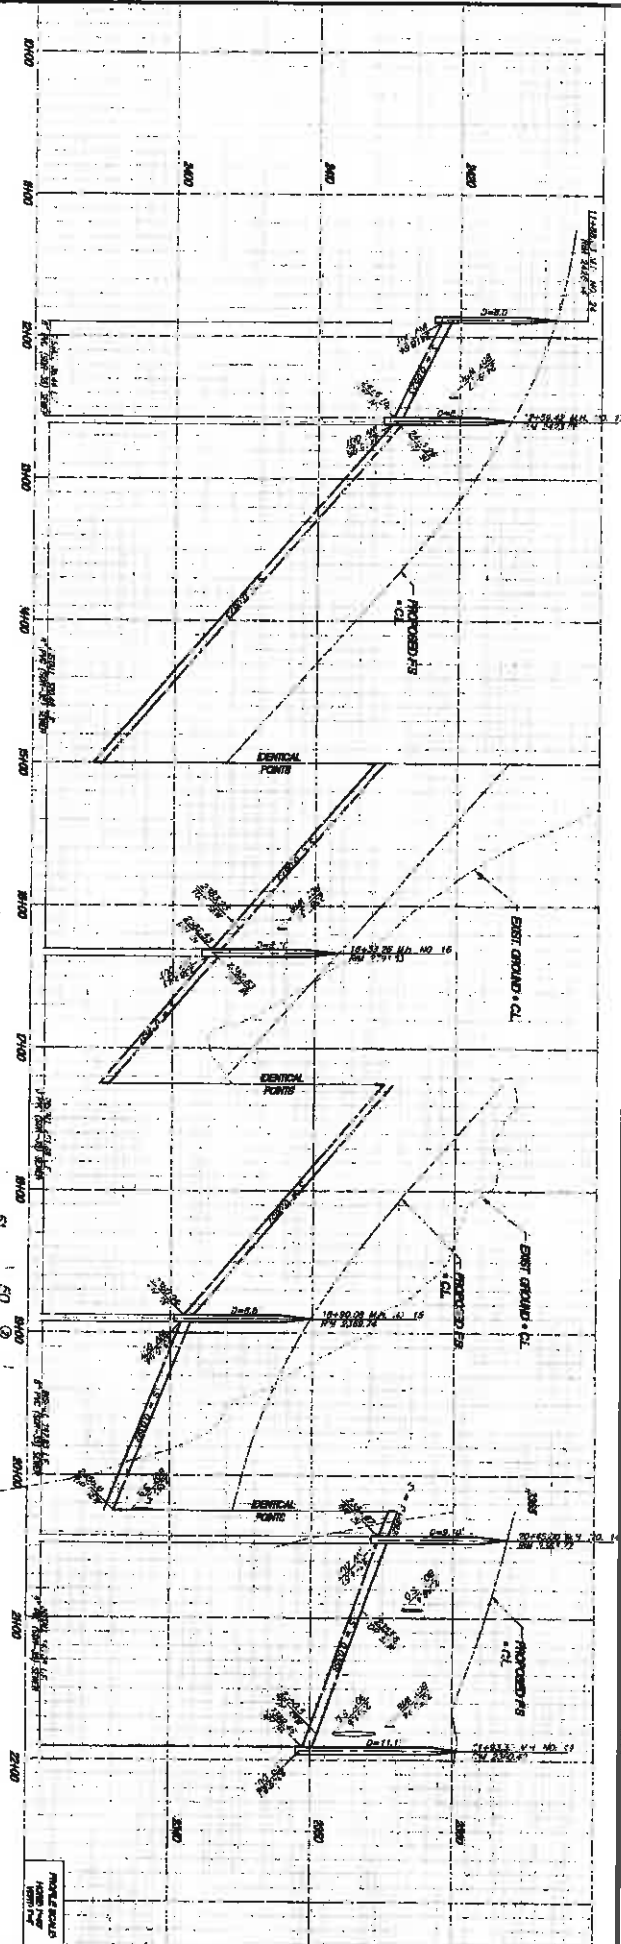

- CONSTRUCTION NOTES**
1. INSTALL 4" PVC (SM-20) SEWER MAIN
 2. CONSTRUCT MANHOLE AT EACH POINT
 3. CONSTRUCT 15" DIA. CONCRETE RINGS AT EACH POINT
 4. CONSTRUCT 15" DIA. CONCRETE RINGS AT EACH POINT
NOTICE:












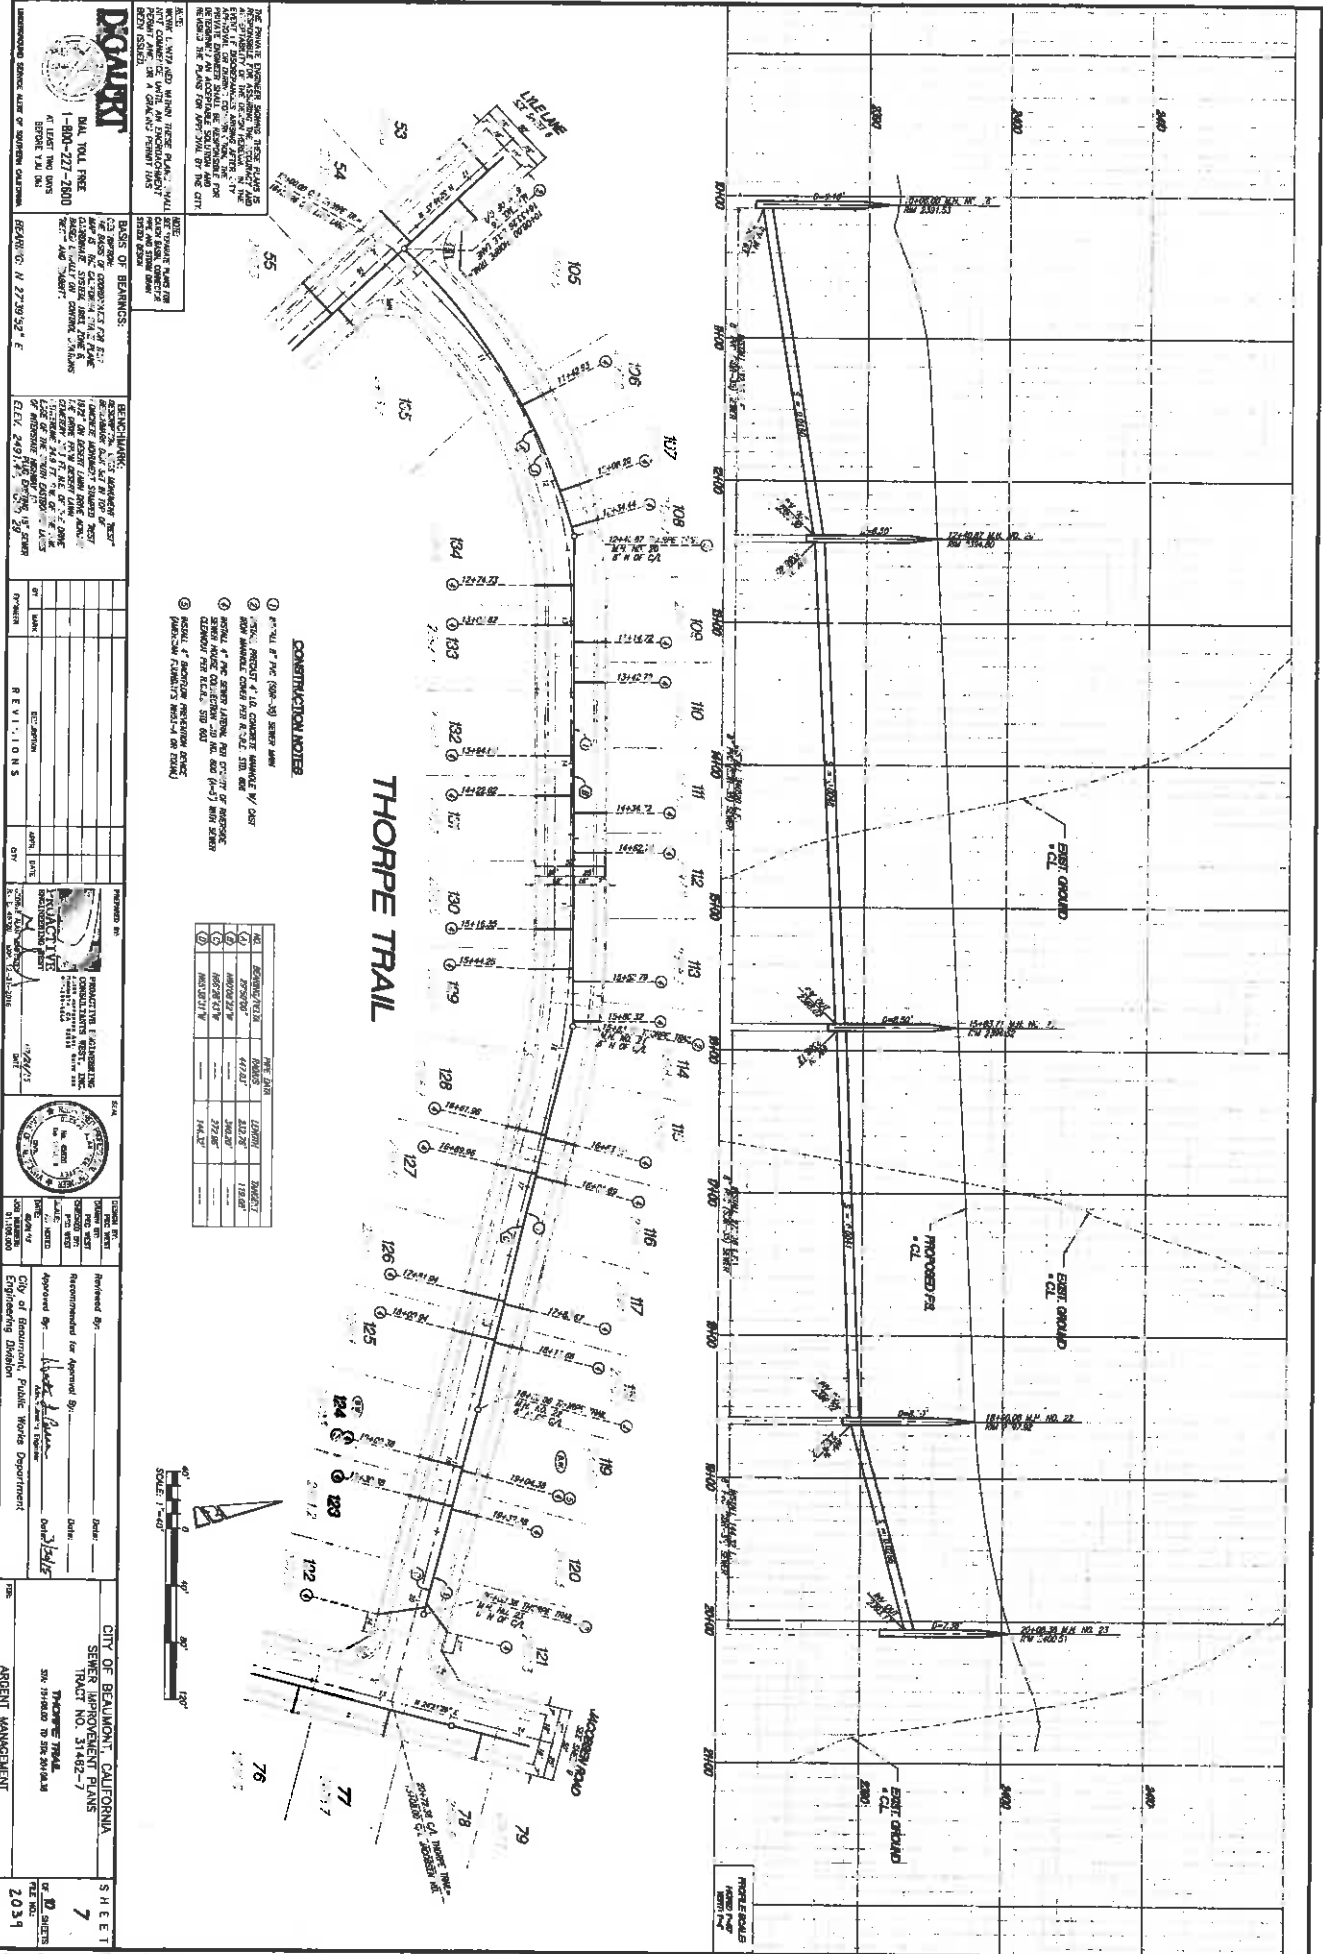

- CONSTRUCTION NOTES**













CITY OF BEAUMONT, CALIFORNIA
SEWER IMPROVEMENT PLANS
TRACT NO. 31482-7
THORPE TRAIL




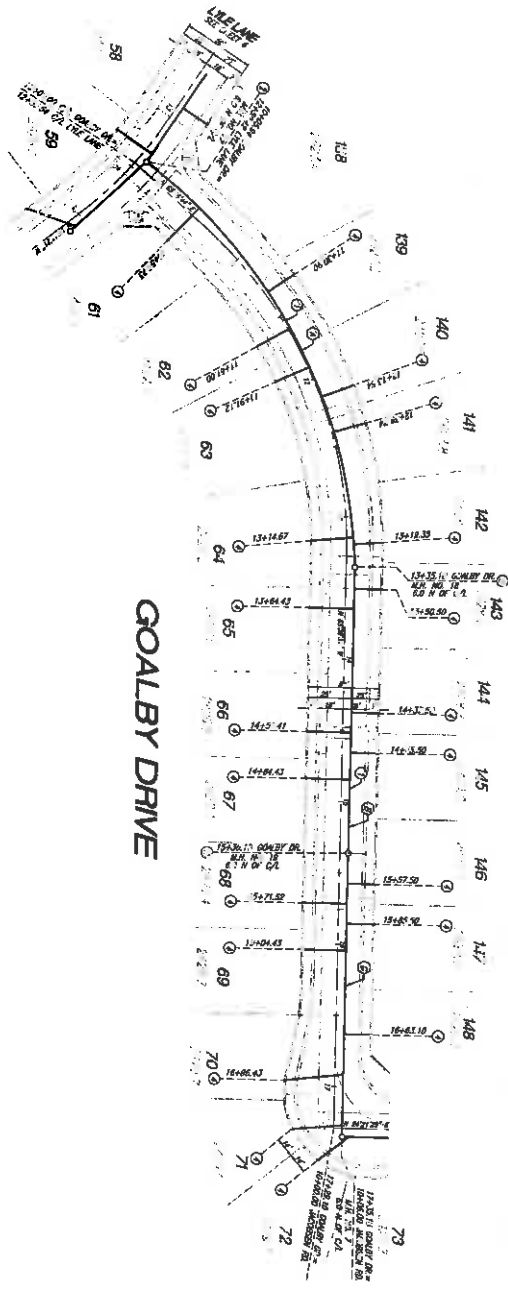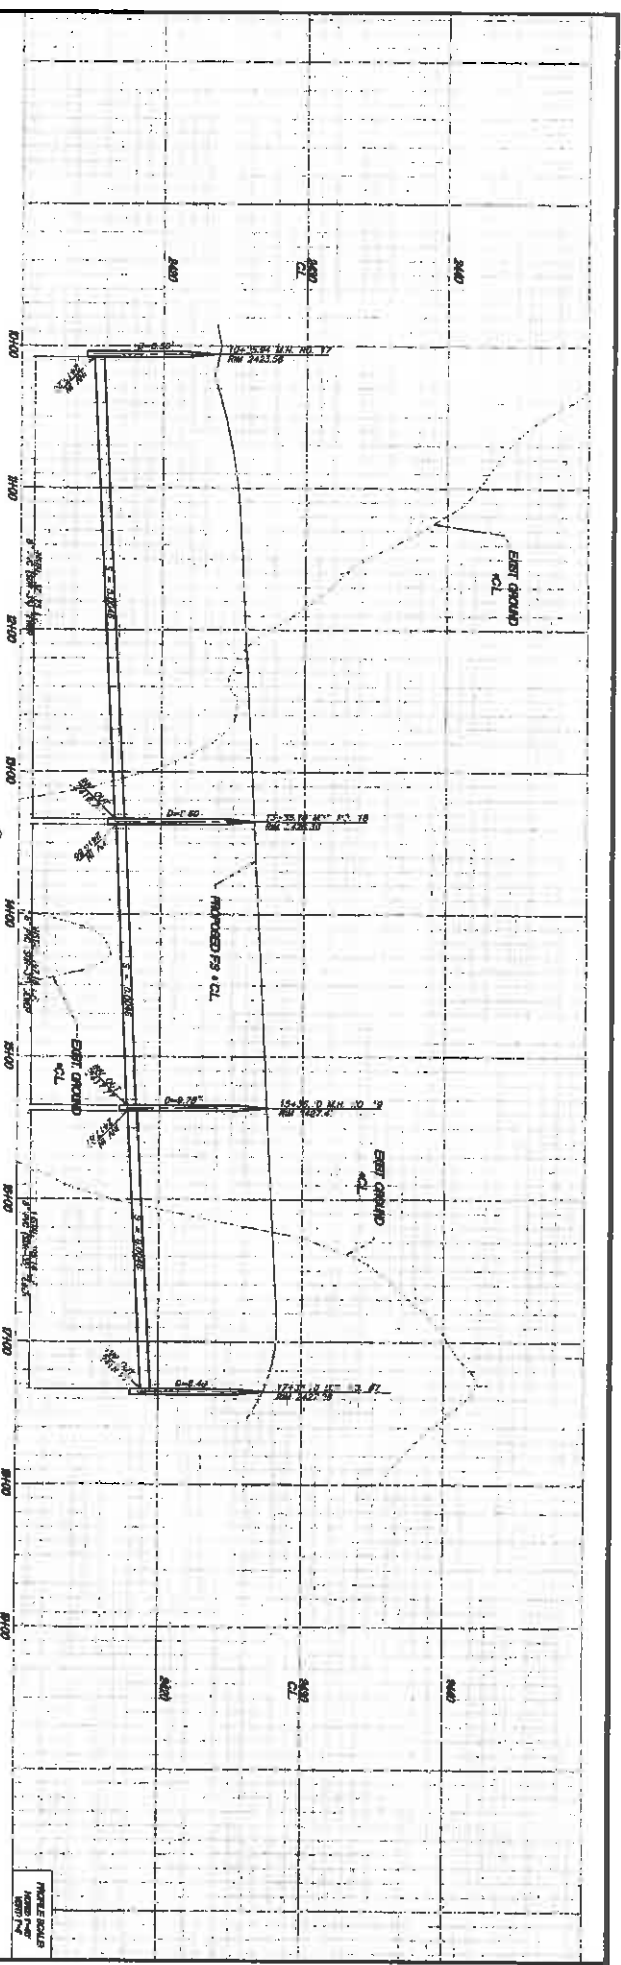

CONSTRUCTION NOTES



GOALBY DRIVE



PROFESSIONAL SEAL

DESIGNER: [Signature]

CITY OF BEAUMONT, PUBLIC WORKS DEPARTMENT

APPROVED BY: [Signature]

ENGINEERING DIVISION

PROJECT INFORMATION:

CITY OF BEAUMONT, CALIFORNIA

SEWER IMPROVEMENT PLANS

TRACT NO. 31482-7

GOALBY DRIVE

SUB DIVISION IN SR 81414

SHEET NO. 2039

DATE: 11/20/11

GOALBY DRIVE

SCALE: 1"=40'

DATE: 11/20/11




DESIGNING: N 2729327 E
 BEAUMONT, CA 94705
 CIVIL ENGINEER
 LICENSE NO. 60138

DESIGNED BY: [Signature]
 DATE: 12/15/15

REVISIONS

NO.	DATE	BY	DESCRIPTION
1	12/15/15	[Signature]	ISSUE FOR PERMITS

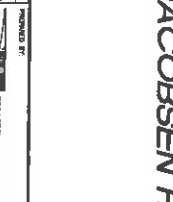


APPROVED BY: [Signature]
 DATE: 12/15/15



City of Beaumont Public Works Department
 Engineering Division

CITY OF BEAUMONT, CALIFORNIA
 SEWER IMPROVEMENT PLANS
 TRACT NO. 31452-7
JACOBSEN ROAD
 SHEET NO. 2039

JACOBSEN ROAD

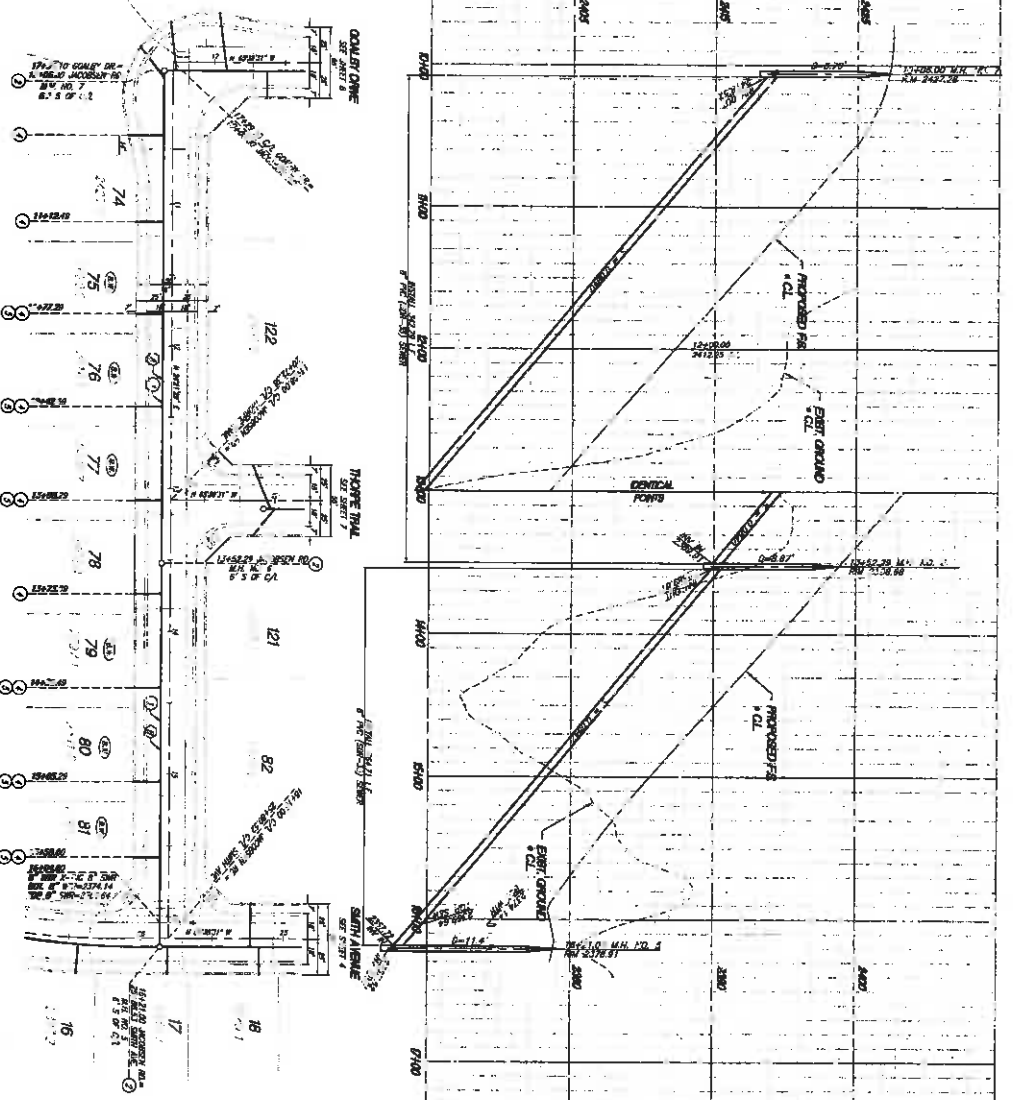

- CONSTRUCTION NOTES**
- INSTALL 12\"/>

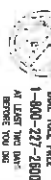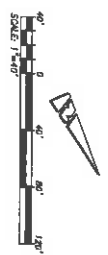

DCA
 DIAL TOLL FREE
 1-800-271-2800




DESIGNING: N 2729327 E
 BEAUMONT, CA 94705
 CIVIL ENGINEER
 LICENSE NO. 60138

DESIGNED BY: [Signature]
 DATE: 12/15/15

REVISIONS




NO.	DATE	BY	DESCRIPTION
1	12/15/15	[Signature]	ISSUE FOR PERMITS

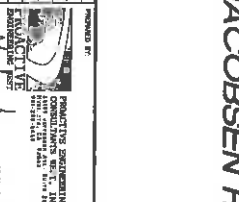


APPROVED BY: [Signature]
 DATE: 12/15/15

City of Beaumont Public Works Department
 Engineering Division

CITY OF BEAUMONT, CALIFORNIA
 SEWER IMPROVEMENT PLANS
 TRACT NO. 31452-7
JACOBSEN ROAD
 SHEET NO. 2039

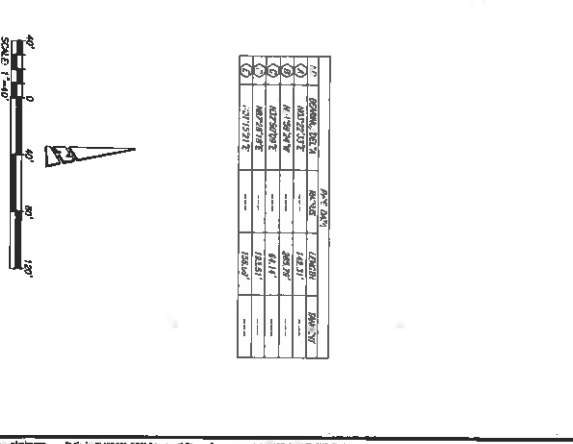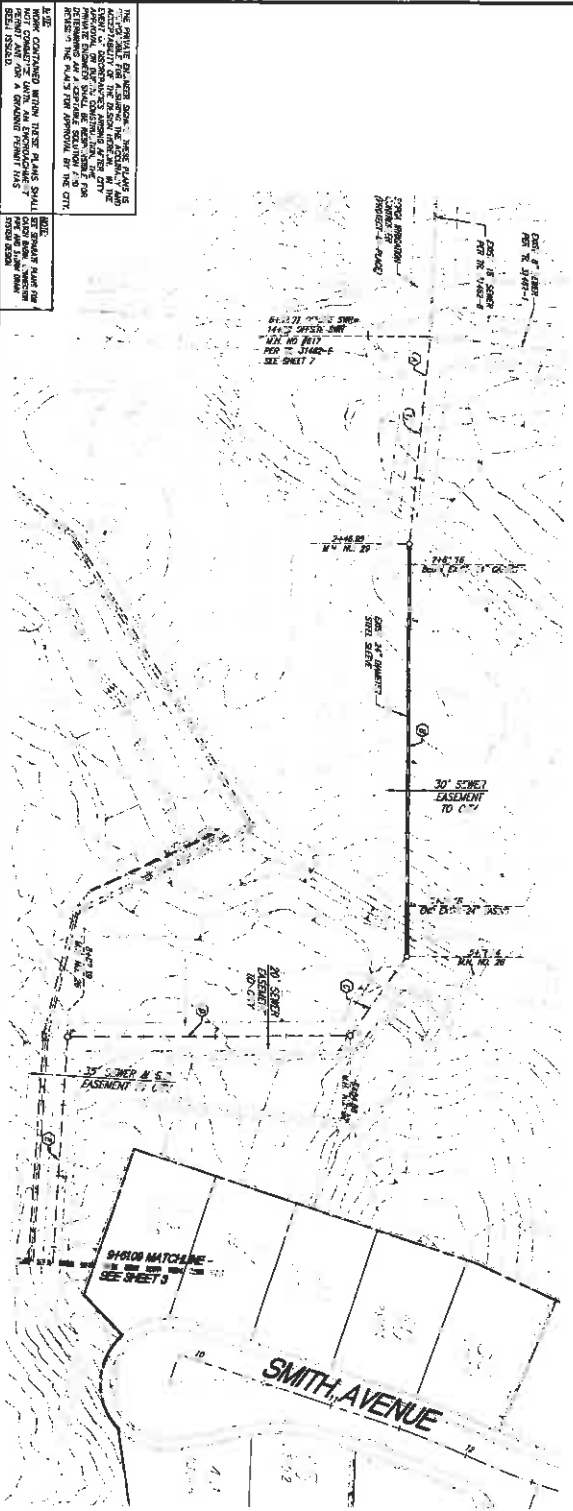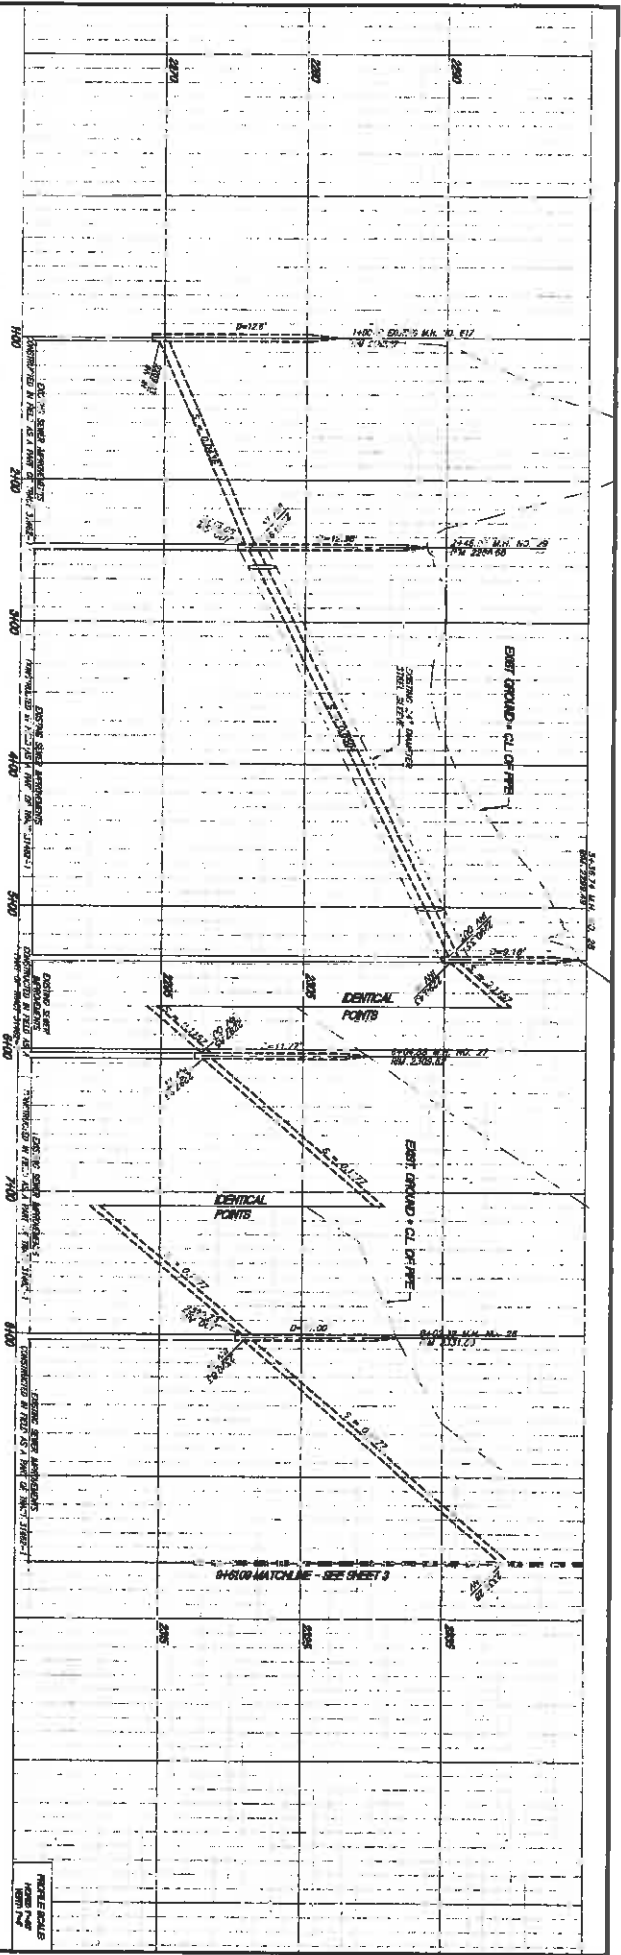


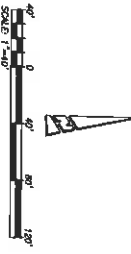

DECAERT

MAIL TOLL FREE
1-800-221-2500


ARGENT MANAGEMENT

CITY OF BEAUMONT, CALIFORNIA
SEWER IMPROVEMENT PLANS
TRACT NO. 31482-7

DATE: _____
APPROVED BY: _____
CITY OF BEAUMONT PUBLIC WORKS DEPARTMENT

REVISIONS

NO.	DATE	DESCRIPTION

BASES OF BEAUMONT

BEAUMONT, CALIFORNIA
N 27°29'30" E
ELEV. 2491.44 MVD 29



PROJECT INFORMATION

PROJECT NO. 31482-7
TRACT NO. 31482-7
SHEET NO. 2034


TOTAL		



LINE LANE
TYPICAL SP SECTION

DATE: 10/15/08

DO NOT SCALE

DATE: 10/15/08
1-800-277-2800


REVISIONS

NO.	DATE	DESCRIPTION
1	10/15/08	ISSUED FOR BIDDING

REVISIONS

NO.	DATE	DESCRIPTION

REVISIONS

NO.	DATE	DESCRIPTION

CITY OF BEAUMONT, CALIFORNIA
STREET IMPROVEMENT PLANS
TRACT NO. 31482-7
COMMERCIAL -
DRAINAGE - TYPICAL SECTION

APPROVED BY: [Signature]
CITY ENGINEER
EQUIPMENT DIVISION

DATE: 10/15/08

PROJECT NO. 08-001


SHEET 2 OF 2 SHEETS
2038

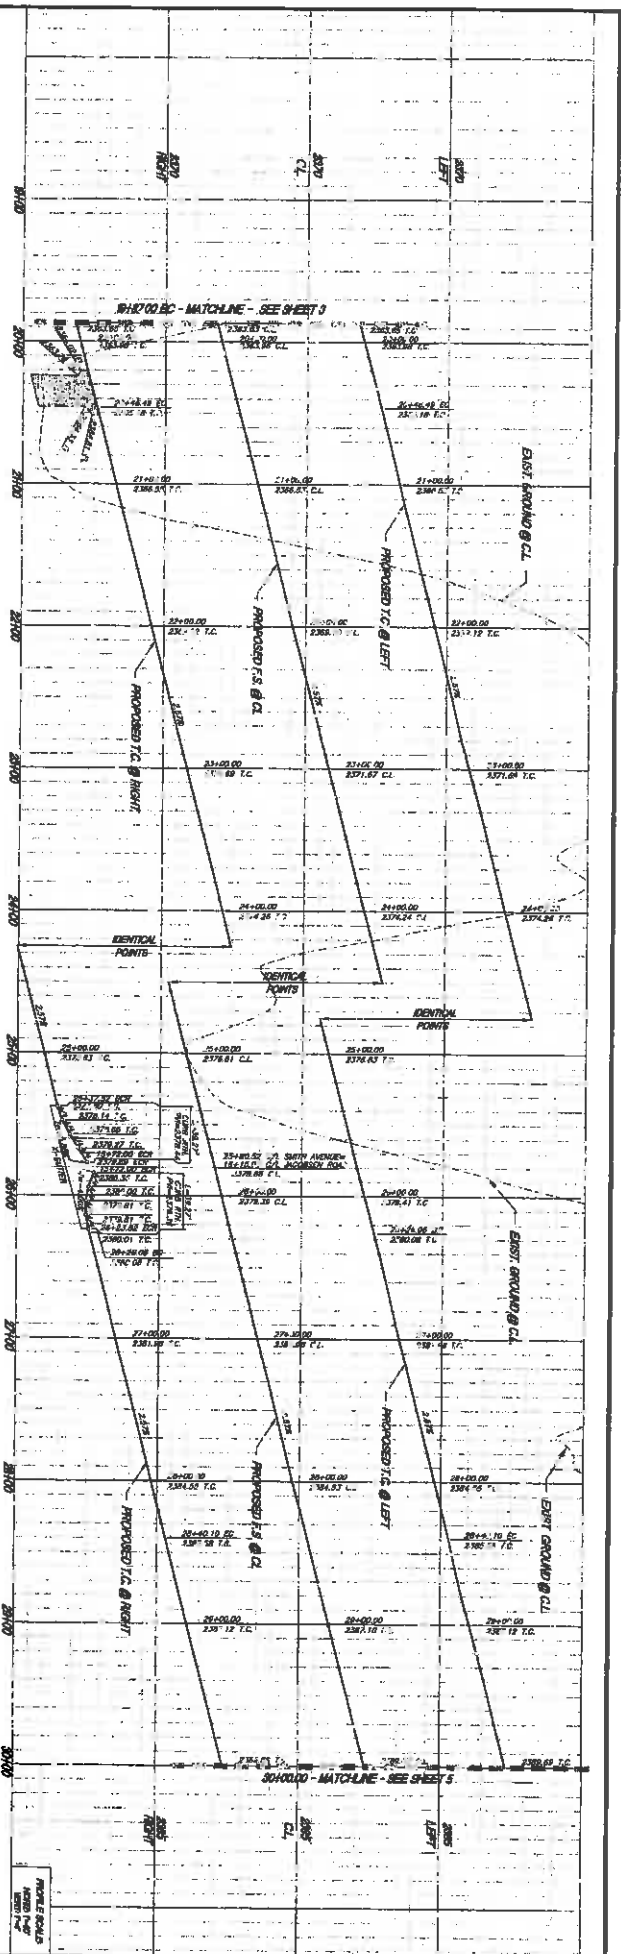

SMITH AVENUE



DATE: 08/21/14
 DRAWN BY: [Signature]
 CHECKED BY: [Signature]
 APPROVED BY: [Signature]

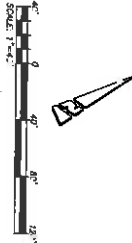

NO.	REVISION	DATE	BY	DESCRIPTION

APPROVED BY: [Signature]
 DATE: 08/21/14
 CITY OF BEAUMONT, CALIFORNIA

CITY OF BEAUMONT, CALIFORNIA
 STREET IMPROVEMENT PLANS
 TRACT NO. 31482-7
 SMITH AVENUE
 SEE SHEET NO. TO THE RIGHT



DEPART





2014

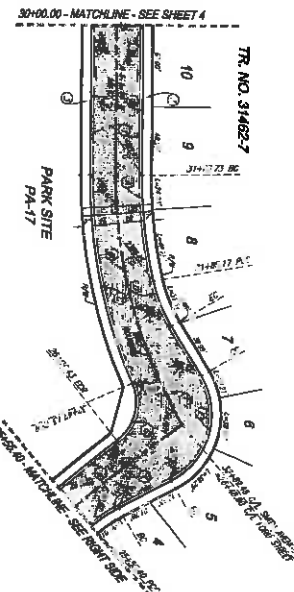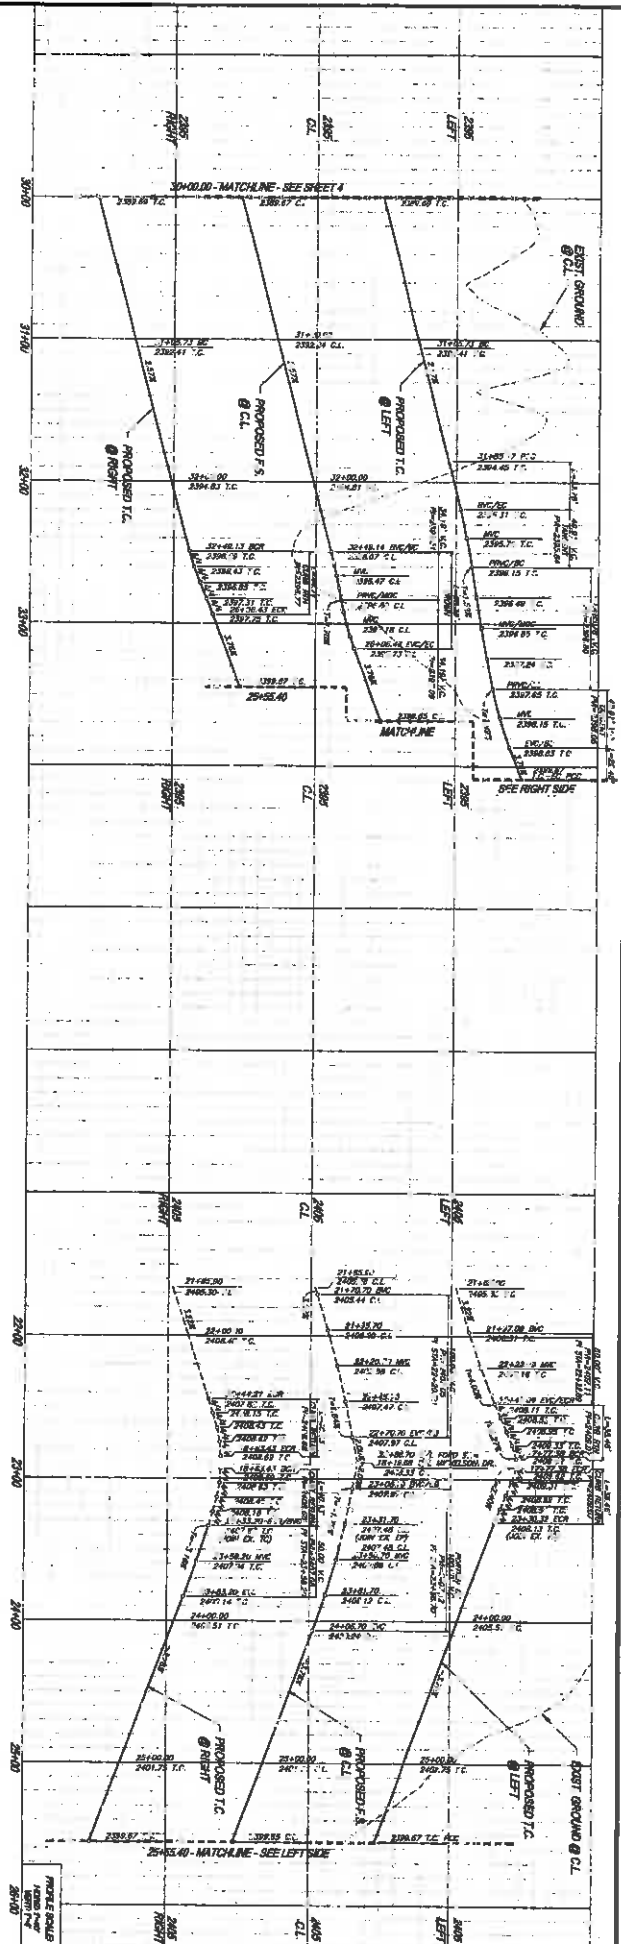

NO.	DESCRIPTION	DATE	BY	CHECKED

- CONSTRUCTION NOTES**

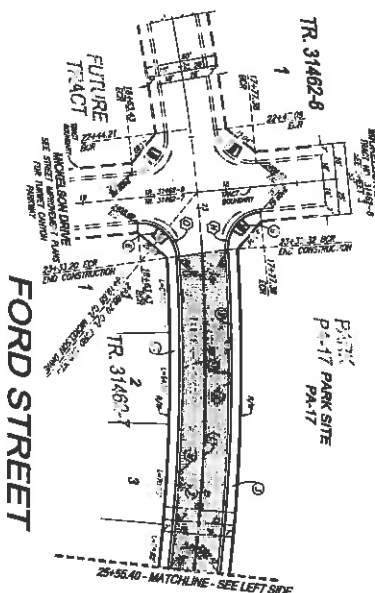



SMITH AVENUE

PARK SITE PA-17

FORD STREET



TR NO. 31462-7

30+00.00 - MATCHLINE - SEE SHEET 4

25+55.40 - MATCHLINE - SEE LEFT SIDE

CONTRACTOR'S NOTES


DESIGN


DESIGNED BY: [Signature]

CHECKED BY: [Signature]

APPROVED BY: [Signature]

CITY OF BEAUMONT, CALIFORNIA

STREET IMPROVEMENT PLANS

TRACT NO. 31462-7

31462-8, 31463-1, 31463-2, 31463-3, 31463-99, 31463-100.

DATE: 10/20/21

SCALE: 1" = 40'

PROJECT NO.: 2036

SHEET: 5

DO NOT


DATE: 02/24/15
SCALE: 1" = 40'




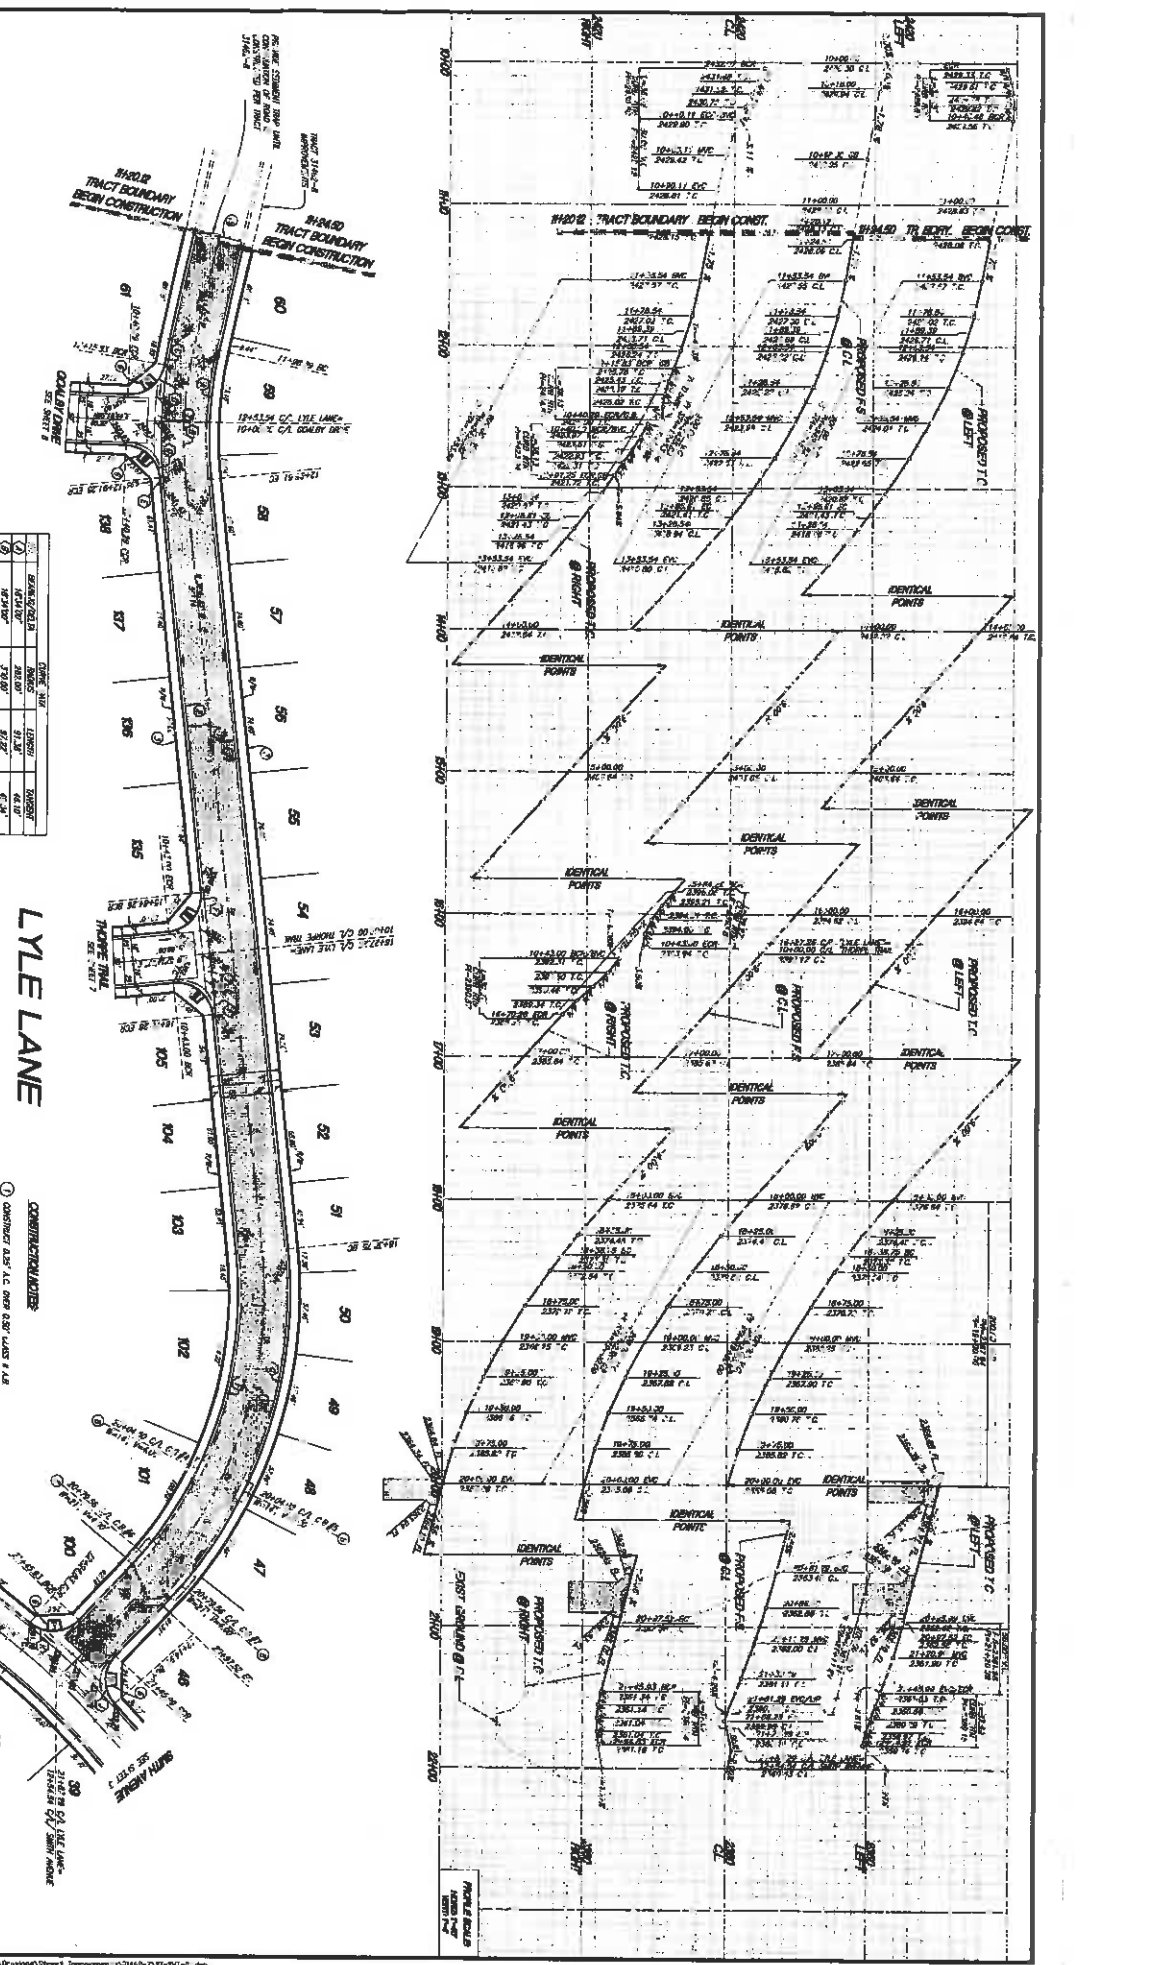

LYLE LANE

- CONSTRUCTION NOTES:**
CITY OF BEAUMONT, CALIFORNIA
 STREET IMPROVEMENT PLANS
 TRACT NO. 31482-7
 38011/141/15/16/17/99/100



DATE: 02/24/15
SCALE: 1" = 40'










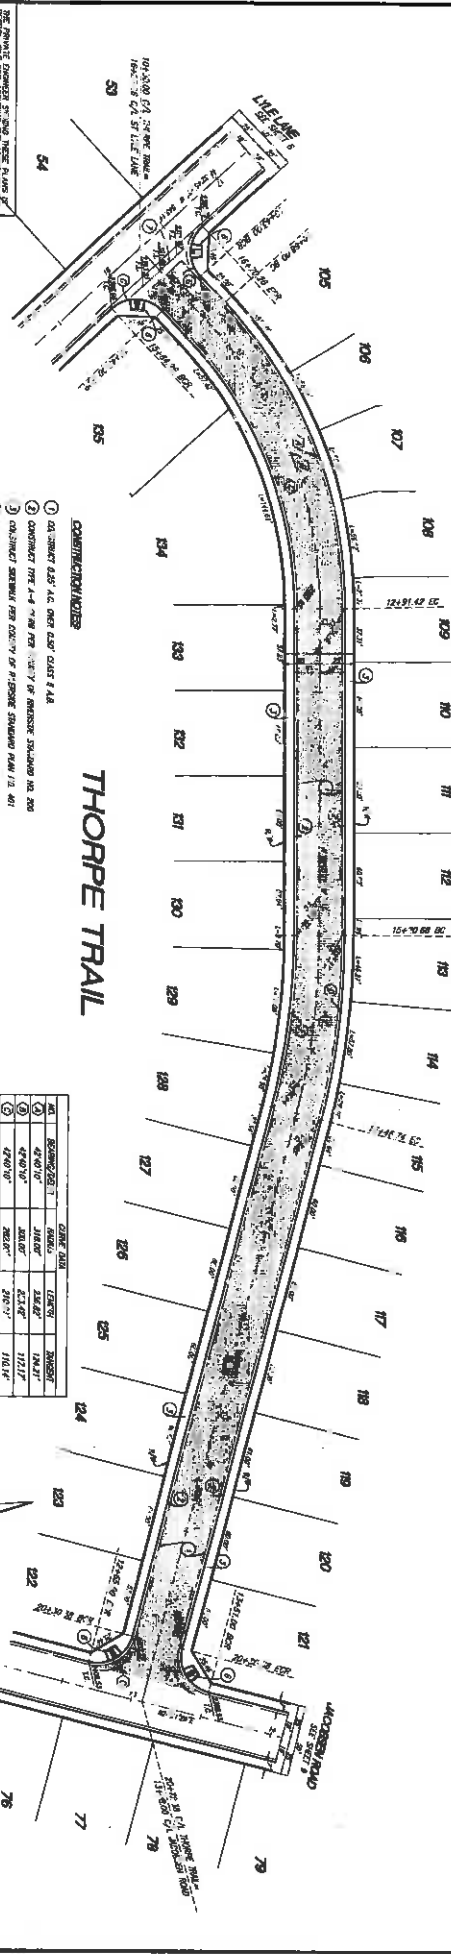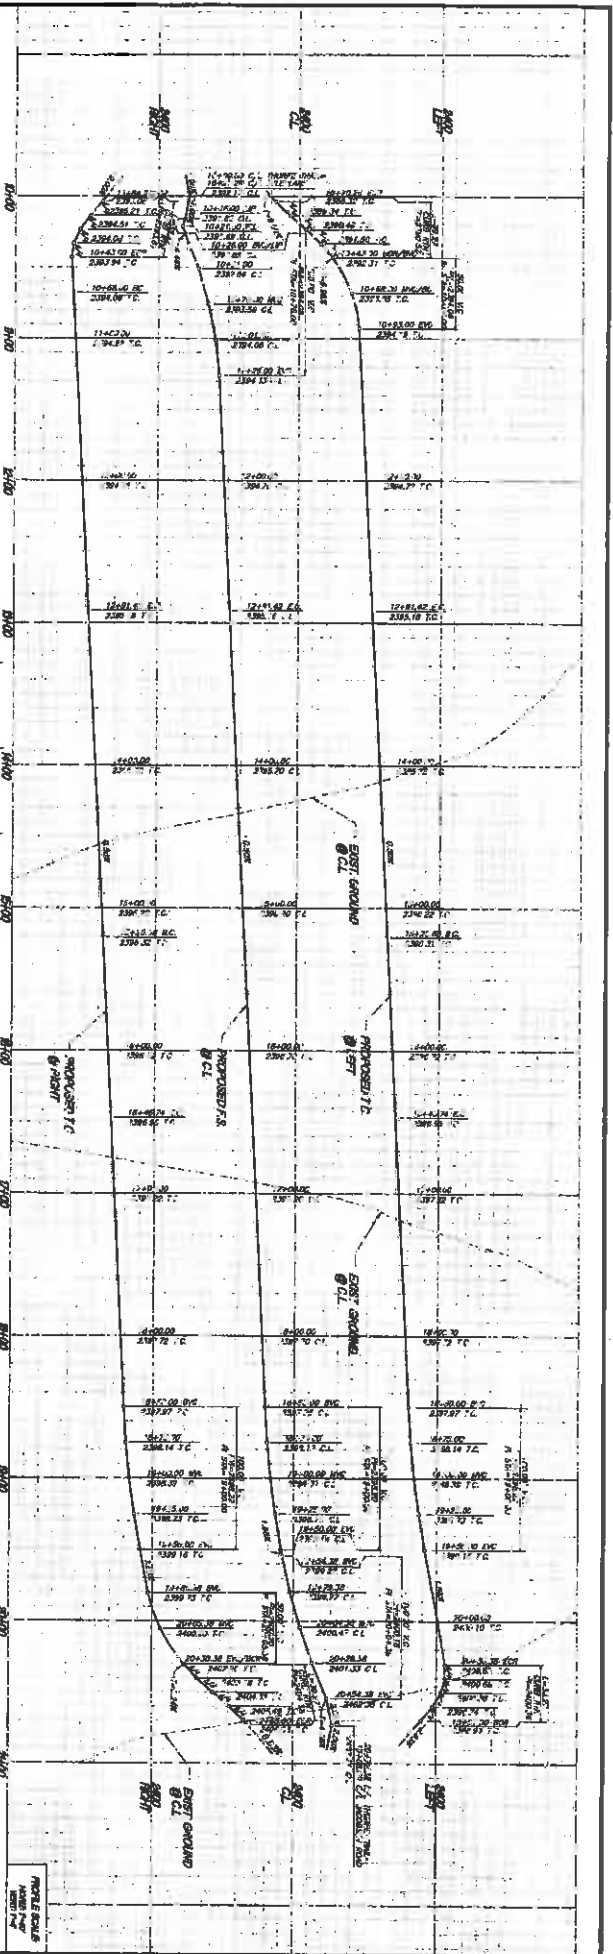

- CONSTRUCTION NOTES:**
1. CONTRACT CLASS A.C. OVER CLASS 1 A.B.

NO.	DESCRIPTION	DATE	BY	CHECKED

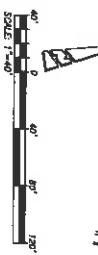


































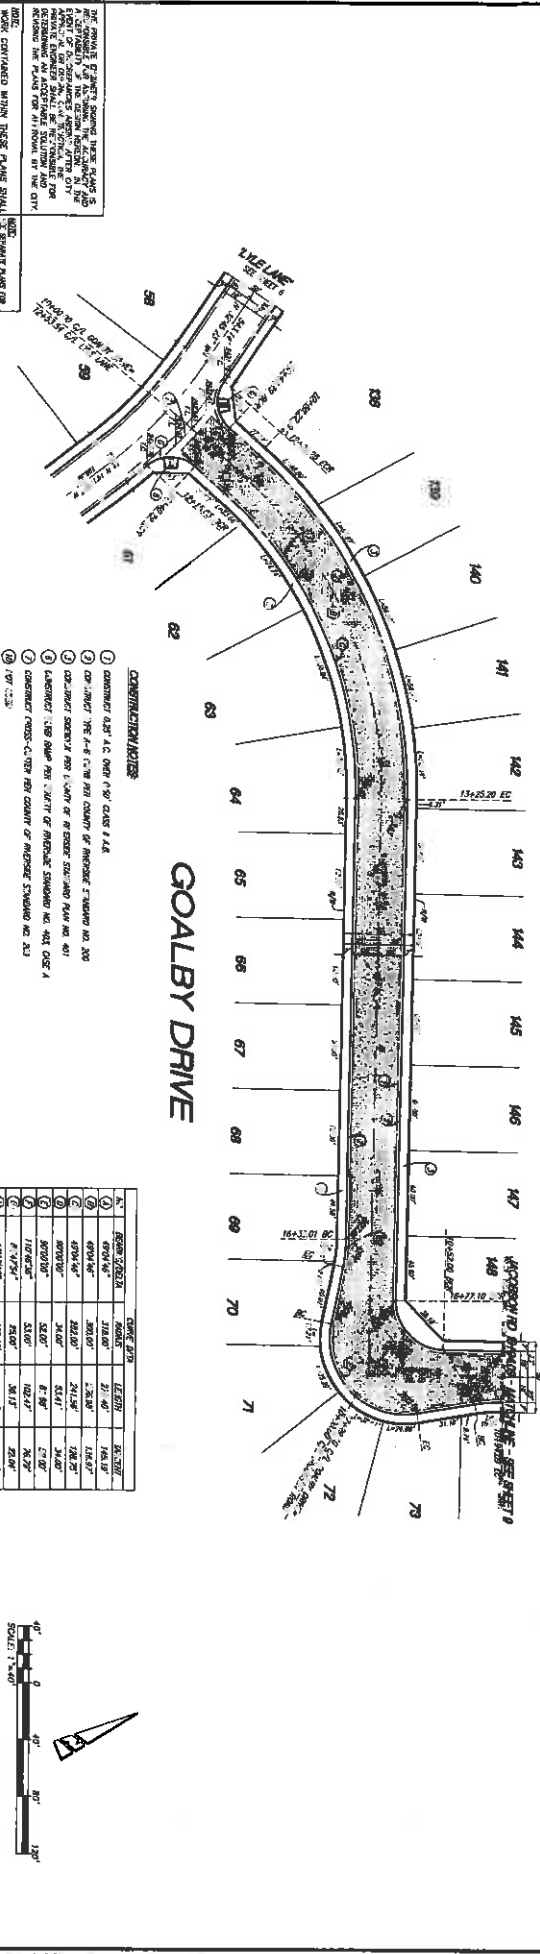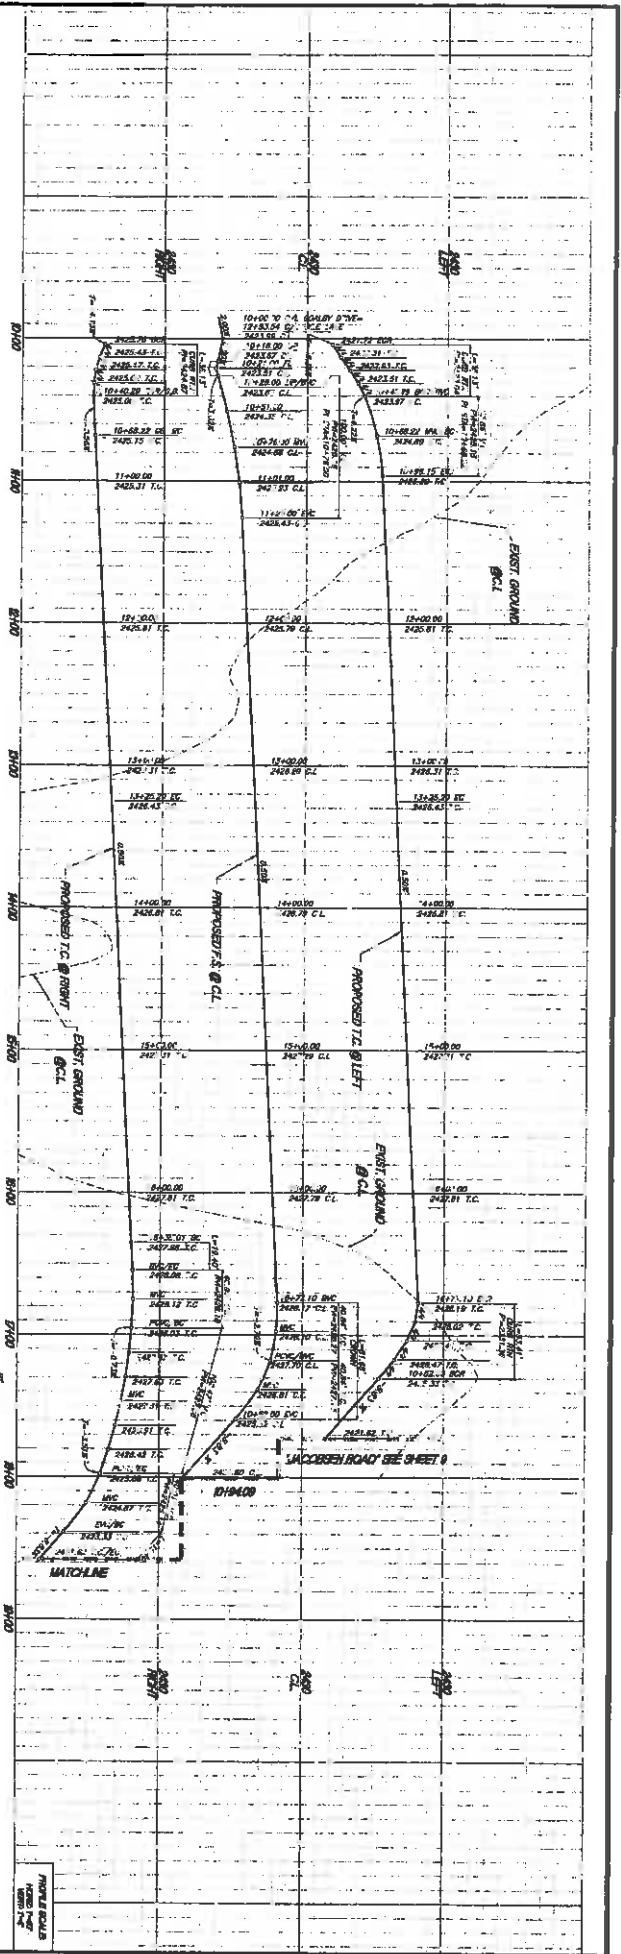


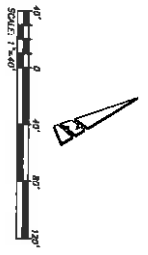


 GOALBY DRIVE
 TRACT NO. 31482-7
 SR. ROAD NO. 28 (14848)

ARGENT MANAGEMENT








CITY OF BEALMONT, CALIFORNIA
 STREET IMPROVEMENT PLANS
 TRACT NO. 31482-7
 GOALBY DRIVE
 SR. ROAD NO. 28 (14848)
 SR. ROAD NO. 28 (14848)

SHEET 8
 OF 8 SHEETS
 DATE: 11/18/07

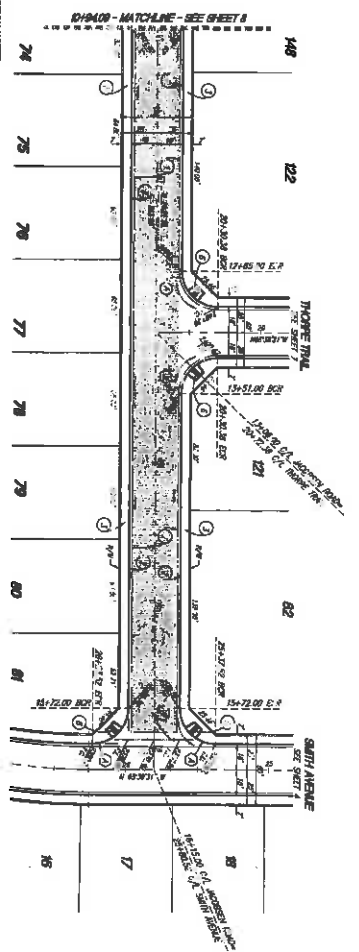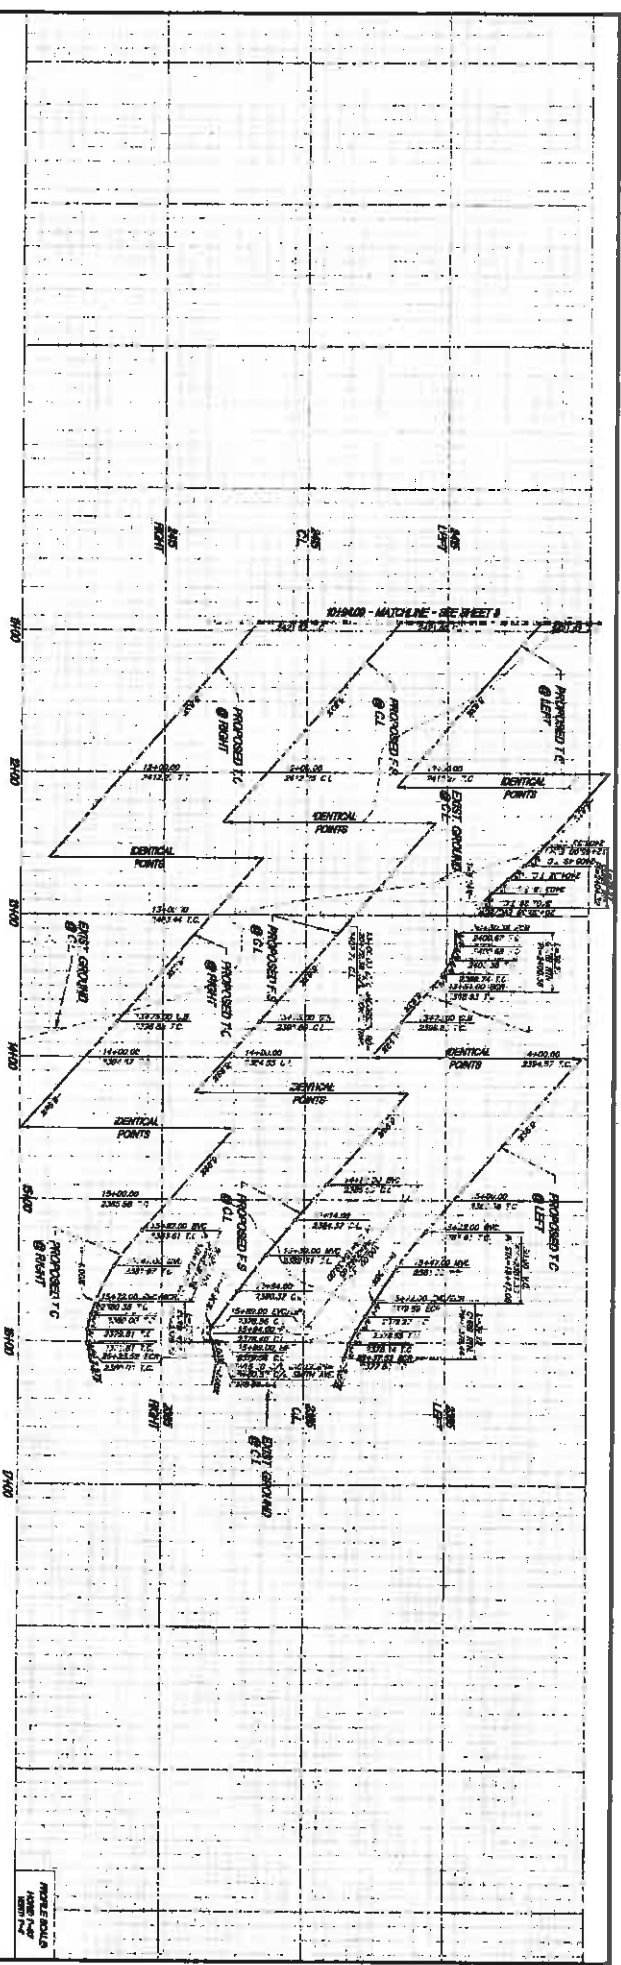

JACOBSEN ROAD





TRACT NO. 31482-7
328 INDEKS TO PG. 014800




CITY OF BEAUMONT, CALIFORNIA
STREET IMPROVEMENT PLANS
TRACT NO. 31482-7
328 INDEKS TO PG. 014800

ARBENT MANAGEMENT

SHEET 9
OF 10 SHEETS
2018

MAINTENANCE BOND

WHEREAS, the City of Beaumont ("City"), a municipal corporation, and Woodside 05S, LP (hereinafter "principal"), have entered into an agreement by which Principal agrees to install and complete certain designated public improvements and to guarantee and warrant the work for the period of one year following its completion and acceptance, which said agreement, dated May 1, 2020, and identified as _____ is hereby referred to and made a part hereof; and:

WHEREAS, Principal is required under the terms of the agreement to furnish a bond to guarantee and warrant the work for a period of one year following its completion and acceptance against any defective work or labor done, or defective materials furnished, to comply with the terms of the agreement.

NOW, THEREFORE, we, the principal and Philadelphia Indemnity Insurance Company surety admitted and duly authorized to transact business under the laws of the State of California as surety, are held and firmly bound unto the City of Beaumont as obligee, in the penal sum of ^{Four Hundred seventy three thousand eight} ~~hundred six dls & 70/100~~ 473,806.70 dollars (\$ 473,806.70) lawful money of the United States, for the payment of which sum well and truly to be made, we bind ourselves, our heirs, successors, executors, and administrators, jointly and severally, firmly by these presents.

The condition of this obligation is such that if the above bounded principal, his or its heirs, executors, administrators, successors or assigns, shall in all things stand to and abide by, provisions in the agreement and any alteration thereof made as therein provided, on his or its part to be kept and performed at the time and in the manner therein specified, and in all respects according to their true intent and meaning, and shall indemnify and save harmless the City of Beaumont, its officers, agents and employees, as therein stipulated, then this obligation shall become null and void; otherwise it shall be and remain in full force and effect.

As a condition precedent to the satisfactory completion of the agreement, the obligation of the Principal and surety under this bond shall remain in effect for a period of one (1) year after the completion and acceptance of the work. During that time, if the Principal or the Principal's, his or its heirs, executors, administrators, successors or assigns, fails to make full, complete and satisfactory repair and replacement or totally protect the City from any loss or damage made evident during that year which results from or is caused by either defective materials or faulty workmanship in the prosecution of the work, then the obligation shall remain in full force and effect. However, anything in this paragraph to the contrary notwithstanding, the obligation of the Surety shall continue so long as any obligation of the Principal remains.

As a part of the obligation secured hereby and in addition to the face amount specified therefor, there shall be included costs and reasonable expenses and fees, including reasonable attorney's fees, incurred by the City of Beaumont in successfully enforcing such obligation, all to be taxed as costs and included in any judgment rendered.

The surety hereby stipulates and agrees that no change, extension of time, alteration of addition to the terms of the agreement or to the work to be performed there under or the specifications accompanying the same shall in anywise affect its obligations of this bond, and it does hereby waive notice of any such change, extension of time, alteration or addition to the terms of the agreement or to the work or to the specifications. The surety waives all rights of subrogation against the City or any person employed by the City.

SIGNED AND SEALED THIS 1st DAY OF May 2020.

(Seal)


(Seal)

SURETY

By: 

Heather Valtier, Attorney-in-Fact

PRINCIPAL

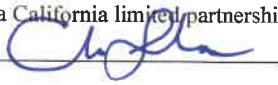Woodside 05S, LP
By: WDS, GP, Inc. a California limited partnership
By: Its General Partner 

CHRISTOPHER STANICK, Assistant Secretary

(Name)

(Name)

(Address)

(Title)

(Address)

By:

(Name)

(Title)

(Address)

ALL SIGNATURES MUST BE ACKNOWLEDGED BY A NOTARY PUBLIC


CALIFORNIA ALL-PURPOSE ACKNOWLEDGMENT

CIVIL CODE § 1189

A notary public or other officer completing this certificate verifies only the identity of the individual who signed the document to which this certificate is attached, and not the truthfulness, accuracy, or validity of that document.

State of California }
County of Riverside }
On May 27, 2020 before me, Rochelle M. Sromalla, Notary Public
Date Here Insert Name and Title of the Officer
personally appeared Christopher Stanicek
Name(s) of Signer(s)

who proved to me on the basis of satisfactory evidence to be the person(s) whose name(s) is/are subscribed to the within instrument and acknowledged to me that he/she/they executed the same in his/her/their authorized capacity(ies), and that by his/her/their signature(s) on the instrument the person(s), or the entity upon behalf of which the person(s) acted, executed the instrument.

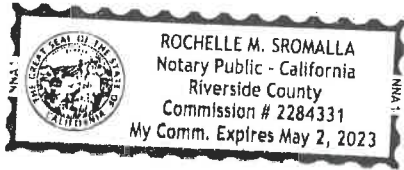

I certify under PENALTY OF PERJURY under the laws of the State of California that the foregoing paragraph is true and correct.

WITNESS my hand and official seal.

Signature Rochelle M. Sromalla
Signature of Notary Public

Place Notary Seal and/or Stamp Above

OPTIONAL

Completing this information can deter alteration of the document or fraudulent reattachment of this form to an unintended document.

Description of Attached Document

Title or Type of Document: _____

Document Date: _____ Number of Pages: _____

Signer(s) Other Than Named Above: _____

Capacity(ies) Claimed by Signer(s)

Signer's Name: _____

- Corporate Officer – Title(s): _____
- Partner – Limited General
- Individual Attorney in Fact
- Trustee Guardian of Conservator
- Other: _____

Signer is Representing: _____

Signer's Name: _____

- Corporate Officer – Title(s): _____
- Partner – Limited General
- Individual Attorney in Fact
- Trustee Guardian of Conservator
- Other: _____

Signer is Representing: _____

PHILADELPHIA INDEMNITY INSURANCE COMPANY

231 St. Asaph's Rd., Suite 100
Bala Cynwyd, PA 19004-0950

Power of Attorney

KNOW ALL PERSONS BY THESE PRESENTS: That **PHILADELPHIA INDEMNITY INSURANCE COMPANY** (the Company), a corporation organized and existing under the laws of the Commonwealth of Pennsylvania, does hereby constitute and appoint HEATHER VALTIER, DANA L. DOWERS, SANDRA SIKORA, ROBERT RANALLO, MICHAEL J. PERRY AND PAUL A. BLAND OF THE D.L.D. COMPANY DBA D.L.D. INSURANCE BROKERS INC., its true and lawful Attorney-in-fact with full authority to execute on its behalf bonds, undertakings, recognizances and other contracts of indemnity and writings obligatory in the nature thereof, issued in the course of its business and to bind the Company thereby, in an amount not to exceed \$25,000,000.00.

This Power of Attorney is granted and is signed and sealed by facsimile under and by the authority of the following Resolution adopted by the Board of Directors of PHILADELPHIA INDEMNITY INSURANCE COMPANY at a meeting duly called the 1st day of July, 2011.

RESOLVED: That the Board of Directors hereby authorizes the President or any Vice President of the Company to: (1) Appoint Attorney(s) in Fact and authorize the Attorney(s) in Fact to execute on behalf of the Company bonds and undertakings, contracts of indemnity and other writings obligatory in the nature thereof and to attach the seal of the Company thereto; and (2) to remove, at any time, any such Attorney-in-Fact and revoke the authority given. And, be it

FURTHER RESOLVED: That the signatures of such officers and the seal of the Company may be affixed to any such Power of Attorney or certificate relating thereto by facsimile, and any such Power of Attorney so executed and certified by facsimile signatures and facsimile seal shall be valid and binding upon the Company in the future with the respect to any bond or undertaking to which it is attached.


IN TESTIMONY WHEREOF, PHILADELPHIA INDEMNITY INSURANCE COMPANY HAS CAUSED THIS INSTRUMENT TO BE SIGNED AND ITS CORPORATE SEAL TO BE AFFIXED BY ITS AUTHORIZED OFFICE THIS 10TH DAY OF JUNE 2013.



(Seal)

Robert D. O'Leary Jr., President & CEO
Philadelphia Indemnity Insurance Company

On this 10th day of June 2013, before me came the individual who executed the preceding instrument, to me personally known, and being by me duly sworn said that he is the therein described and authorized officer of the **PHILADELPHIA INDEMNITY INSURANCE COMPANY**; that the seal affixed to said instrument is the Corporate seal of said Company; that the said Corporate Seal and his signature were duly affixed.

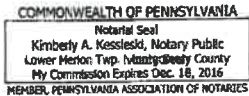

(Notary Seal)

Notary Public: _____
residing at: Bala Cynwyd, PA
My commission expires: December 18, 2016

I, Edward Sayago, Corporate Secretary of PHILADELPHIA INDEMNITY INSURANCE COMPANY, do hereby certify that the foregoing resolution of the Board of Directors and this Power of Attorney issued pursuant thereto on this 10th day of June 2013 true and correct and are still in full force and effect. I do further certify that Robert D. O'Leary Jr., who executed the Power of Attorney as President, was on the date of execution of the attached Power of Attorney the duly elected President of PHILADELPHIA INDEMNITY INSURANCE COMPANY,

In Testimony Whereof I have subscribed my name and affixed the facsimile seal of each Company this 15th day of May, 20 20.



Edward Sayago, Corporate Secretary
PHILADELPHIA INDEMNITY INSURANCE COMPANY

CALIFORNIA ALL-PURPOSE CERTIFICATE OF ACKNOWLEDGMENT

A notary public or other officer completing this certificate verifies only the identity of the individual who signed the document to which this certificate is attached, and not the truthfulness, accuracy, or validity of that document.

State of California

County of Orange

On _____ before me, Megan Elizabeth Graham, Notary Public,
(Here insert name and title of the officer)
personally appeared Heather M. Valtier,

who proved to me on the basis of satisfactory evidence to be the person(s) whose name(s) is/are subscribed to the within instrument and acknowledged to me that he/she/they executed the same in his/her/their authorized capacity(ies), and that by his/her/their signature(s) on the instrument the person(s), or the entity upon behalf of which the person(s) acted, executed the instrument.

I certify under PENALTY OF PERJURY under the laws of the State of California that the foregoing paragraph is true and correct.

WITNESS my hand and official seal.

[Handwritten Signature]
Signature of Notary Public

(Notary Seal)



ADDITIONAL OPTIONAL INFORMATION

INSTRUCTIONS FOR COMPLETING THIS FORM

Any acknowledgment completed in California must contain verbiage exactly as appears above in the notary section or a separate acknowledgment form must be properly completed and attached to that document. The only exception is if a document is to be recorded outside of California. In such instances, any alternative acknowledgment verbiage as may be printed on such a document so long as the verbiage does not require the notary to do something that is illegal for a notary in California (i.e. certifying the authorized capacity of the signer). Please check the document carefully for proper notarial wording and attach this form if required.

- State and County information must be the State and County where the document signer(s) personally appeared before the notary public for acknowledgment.
- Date of notarization must be the date that the signer(s) personally appeared which must also be the same date the acknowledgment is completed.
- The notary public must print his or her name as it appears within his or her commission followed by a comma and then your title (notary public).
- Print the name(s) of document signer(s) who personally appear at the time of notarization.
- Indicate the correct singular or plural forms by crossing off incorrect forms (i.e. ~~he/she/they~~, is /are) or circling the correct forms. Failure to correctly indicate this information may lead to rejection of document recording.
- The notary seal impression must be clear and photographically reproducible. Impression must not cover text or lines. If seal impression smudges, re-seal if a sufficient area permits, otherwise complete a different acknowledgment form.
- Signature of the notary public must match the signature on file with the office of the county clerk.
 - ❖ Additional information is not required but could help to ensure this acknowledgment is not misused or attached to a different document.
 - ❖ Indicate title or type of attached document, number of pages and date.
 - ❖ Indicate the capacity claimed by the signer. If the claimed capacity is a corporate officer, indicate the title (i.e. CEO, CFO, Secretary).
- Securely attach this document to the signed document

DESCRIPTION OF THE ATTACHED DOCUMENT

Maintenance Bond
(Title or description of attached document)

(Title or description of attached document continued)

Number of Pages 3 Document Date 5/1/2020

(Additional information)

CAPACITY CLAIMED BY THE SIGNER

- Individual (s)
- Corporate Officer
- _____ (Title)
- Partner(s)
- Attorney-in-Fact
- Trustee(s)
- Other _____