



City of Beaumont Wastewater Treatment Plant Salt Mitigation Upgrade Project Change Order No. 16

May 28, 2020

Contractor: W.M. Lyles Co.	Original Contract: \$ 53,312,000.00	Amount	Calendar Days	Comp. Date
Project Name: Wastewater Treatment Plant Salt Mitigation Upgrade Project	Previous Approved Changes: \$1,720,431.30			820 1/26/2021
Contract No.: C188	This Change: Amount \$667,487.82			95 5/1/2021
CO Number: 16	Revised Contract: \$55,699,919.12			0 4/26/2020
	Previous Phase 1 Completion Date			915 5/1/2021
	Revised Phase 1 Completion Date			4/26/2020

This change order covers changes to the subject contract as described herein. The Contractor shall supply all labor, equipment and materials to complete the Change Order items for the lump sum price agreed upon herein. All Change Order items must be submitted to the City for approval prior to fabrication.

Item No.	PCO No.	Description of Changes	Amount	Phase 1 Time Extension (CD*)	Phase 2 / Project Completion Time Extension (CD*)
1	33	Wastewater Treatment Plant Salt Mitigation Upgrade Project - OP-036R2 / CLAR-23 EQ Basin Mitigation & Solid Handling Elect. Changes	\$667,487.82	0	0
2					
3					
4					
NET CHANGE IN CONTRACT AMOUNT – INCREASE (OR-DECREASE)			\$667,487.82	0	0

*Calendar Days

The amount of the Contract will be increased/decreased by the amount of Six Hundred Sixty-seven Thousand Four Hundred Eighty-seven Dollars and eighty-two cents (\$667,487.82). The Contract Time will be increased by zero (0) calendar days.

The Contractor agrees to furnish all labor, equipment and materials and to perform all other necessary work, inclusive of the directly or indirectly related work, within the approved time extension required to complete the above Change Order items. The undersigned Contractor approves the foregoing Change Order as to the changes, if any, in the Contract Price specified for each item including any and all supervision costs and other miscellaneous costs relating to the change in Work, and as to the extension of time allowed, if any, for the completion of the entire Work on account of said Change Order. The City and the Contractor hereby agree that this Change Order constitutes full mutual accord and satisfaction for all time, all costs, and all impacts related directly or indirectly to this Change Order. The Contractor hereby agrees that this Change Order represents the full equitable adjustment owed under the Contract, and further agrees on behalf of himself and all subcontractors to waive all right to file any further claims or request for equitable adjustment arising out of or as a result of this Change Order or the cumulative effect of this Change Order on the performance of the overall Work under the Contract. This document will become a supplement of the contract and all provisions will apply hereto. It is understood that the Change Order shall be effective when approved by the City.

Recommended: Charles Bond, MWH Constructors, Senior Resident Engineer **Date:** 5-28-2020

Accepted: W.M. Lyles Co., Contractor **Date:** 5/29/20

Approved: _____ **Date:** 6/1/2020
Albert A. Webb Associates, Program Manager

Approved: _____ **Date:** _____
City of Beaumont, City Manager



**City of Beaumont
Wastewater Treatment Plant Salt Mitigation
Upgrade Project**

Technical Justification:

PCO-33	
Design Adjustment: WML COP-036R2	CLAR – 24 Modifications to Equalization Basin and Solid Handling Building

Reason for Design Changes:

Owner Requested Change: To eliminates the possibility of flooding the Influent Pump Station in the event that the discharge EQ Valve fails in the open position, it is imperative to modify the discharge system from the Equalization (EQ) Basin by deleting the valve vault (as detailed on C-34) and adding a pump station and flow meter to the EQ Basin that discharges directly to the Fine Screens structure.

With the EQ Basin being a critical system for plant operation and the addition of pumps, receiving power and control from the Solids Handling Building emergency power for the electrical gear is now required. Provision for an emergency generator hook up and monitoring will be added as well.

The attached drawings show the extent of the required changes. The design and scope changes are summarized as follows:

- The EQ basin will be rotated such that the tipping buckets are located on the south end and the (formerly) south wall and interior wall will be raised to the same elevation as the remaining walls. A new EQ Pump Station will be located on the north end of the basin.
- The site grading is to be modified to bring the grade to within 42" + of the top of wall of the EQ basin on all sides. The grading to the north is also modified to promote better drainage.
- The piping from the EQ basin to the valve vault, and from the valve vault to Manhole #5, as well as the vault itself are to be deleted. A new 16" line from the EQ Pump Station to the Fine Screens is to be installed (the same pipe number, #6, is to be reused for this pipeline).
- The electrical feed for the new EQ Pump Station will originate in the electrical room of the Solids Handling Building. A manual transfer switch, generator receptacle and MCC-EQ have been added to the electrical design. Several site duct banks are modified.
- The attached drawings also show changes related to RFC 12 and RFIs 69 and 76, which have already been addressed but did not have updated drawings included.

Cost Impact:

MWHC/Aqua/Webb/SKM evaluated the contractor's cost proposal, WML COP-036, for a contract increase of \$699,425.74.

After review and comments returned to the contractor, the contractor revised its cost proposal and resubmitted it with a revised extra cost in the amount of \$677,403.50. After a second round of review and a recommendation from the contractor to change one of the vendors the cost proposal was then revised (WML COP-036.2) reducing the proposal to \$667,487.82.

Accordingly, MWHC recommends a change order increasing the contract in the amount of \$667,487.82 to compensate W. M. Lyle for all costs associated with the changes described above.

CITY OF BEAUMONT WWTP SALT MITIGATION UPGRADE PROJECT

**CHANGE ORDER PROPOSAL (COP) # 036.2
(By Contractor)**

To (Engineer/CM): MWH Constructors Attention: Charles Reynolds Phone: 702-497-8024 Email: Charles.w.reynolds@stantec.com	From (Contractor): W.M. Lyles Co. Attention: Oscar Mendoza Phone: 619-565-6064 Email: omendoza@wmlylesco.com
PCO/DCM No.: DCM-018/CLAR-024	
Subject: EQ Basin Modifications	
Reference Documents: Reference Drawings Attached	
DESCRIPTION	
<p>Please see additional responses/clarifications.</p> <p>Comment 1a: There is ~25 feet of 10" pipe. There is a net increase of ~30 hours of labor. This seems excessive for this 10" pipe.</p> <ul style="list-style-type: none"> Response: The added BG pipe install is for the four (4) 10" lines going from the EQ basin to the transition coupling above grade. This added labor is for 107 LF of 10" horizontal and vertical piping along with four 10" restrained mechanical joint 90's. The labor amount for this 10" pipe is reasonable if not lean. <p>Comment 1b: An open cut for a 20' deep pipe is a considerable amount of labor/equipment cost. The credit vs addition still does not seem proportional. Also note that the majority of the 10" pipe will be in the excavation for the EQ basin and will likely not require additional excavation. Also note that the average bury depth of the 16" pipe is 5-6 feet, not 8 feet.</p> <ul style="list-style-type: none"> Response: The backfill of the EQ basin was not estimated as if we were to halt operations in order to install the 16" EQ basin return (it was not shown on the original design). It is possible to install the pipe within the excavation but we would need to add increased costs for the lost production and remobilization to the backfill process before we reduced the costs for the pipeline excavation. Updated drawings C-4 shows a finished grade on the west side of the EQ around 2548.50'-2548.25'. Drawing C-4 shows the grade break of 2548.25' being 6'-0" away from the structure. The man run of the pipe is 4'-6" away from the face of the structure. With a finished grade of 2548.50' and an pipe invert of 2543.00' (coordinate 44 on C-23) to 2540.25' (coordinates 53 & 14 on C-20) the excavation depth varies from 5'-11" to 8'-8". <p>Comment 2a: This does not explain why the concrete cost is \$1,600.</p> <ul style="list-style-type: none"> Response: It's unclear how the \$1,600/cy value was obtained. See attached WML breakdown with detailed descriptions and quantities for the concrete scope of work. <p>Comment 2b: Attached is the quote. Keep in mind that this quote is for a larger and taller structure.</p> <ul style="list-style-type: none"> Response: American Buildings stands firm with their estimate; however, an alternative cost estimate/quote from Star Building is included in this COP. 	
COST ESTIMATE	

Total Cost : \$ 667,487.82 – see attached breakdown

SCHEDULE IMPACT

None

Received by MWH Constructors (Date):

RESPONSE

Response By:

Date:

Final Distribution: Juan C. Ahumada, W.M. Lyles Co.
Brian Knoll, Webb Associates
MWH Inspector

W. M. Lyles Co.
 42142 Roick Drive
 Temecula, CA 92590

Date: 14-Apr-20

Reference #: CLAR - 024

Attention: Charles W. Reynolds

JOB LOCATION: City of Beaumont WWTP Salt Mitigation Upgrade Project

DESCRIPTION: EQ Basin Modifications

Item:		Unit	Total MH	Total MH Cost	Eq. Cost	Material	Subcont.	Total Cost
1	Pipe & Equipment Installation	1 LS	207.5	\$ 19,384.65	\$ 2,080.97	\$ 195,396.71	\$ -	\$ 216,862.33
2	Structural Modifications	1 LS	305	\$ 25,022.03	\$ 7,957.12	\$ 13,164.36	\$292,950.41	\$ 339,093.92
3	Site Grading Modifications	1 LS	308	\$ 26,944.65	\$ 13,125.80	\$ 4,124.67	\$ -	\$ 44,195.12
		1 LS	0	\$ -	\$ -	\$ -	\$ -	\$ -
		1 LS	0	\$ -	\$ -	\$ -	\$ -	\$ -
		1 LS	0	\$ -	\$ -	\$ -	\$ -	\$ -
Total Costs			820.5	\$ 71,351.33	\$ 23,163.89	\$ 212,685.74	\$292,950.41	\$ 600,151.37

Subtotal		\$ 600,151.37
Mark-up - Labor	15%	\$ 10,702.70
Mark-up - Equipment	15%	\$ 3,474.58
Mark-up - Materials	15%	\$ 31,902.86
Mark-up - Subcontractor	5%	\$ 14,647.52
Bond	1.0%	\$ 6,608.79
Total This Change Order		\$ 667,487.82

Comments:

CITY OF BEAUMONT WWTP SALT MITIGATION UPGRADE PROJECT

**CHANGE ORDER PROPOSAL (COP) # 036.1
(By Contractor)**

To (Engineer/CM): MWH Constructors Attention: Charles Reynolds Phone: 702-497-8024 Email: Charles.w.reynolds@stantec.com	From (Contractor): W.M. Lyles Co. Attention: Oscar Mendoza Phone: 619-565-6064 Email: omendoza@wmlylesco.com
PCO/DCM No.: DCM-018/CLAR-024	
Subject: EQ Basin Modifications	
Reference Documents: Reference Drawings Attached	
DESCRIPTION	
Please see responses to DCM-18 comments. Comment 1: <ol style="list-style-type: none"> a. The labor credit is only for the reduction in t installation (Laying) of the pipe which has been reduced. The added labor is for the installation of additional 10" pipe fittings and labor and includes a credit for the reduction of laying of the 16" pipe. The labor for the installation of the additional 10" pipe & fittings was greater than the reduction in the labor associated with the linear footage of pipe b. The original trench was estimated as being op it without shoring. Excavation, sloping and backfill are included in the credit hours. Additional labor for excavation and backfill includes the four pipes from the EQ Basin to the Pump Station which are approx. 18' deep, along with the 16" pipe from the pump station to the fine screens which is approx. 8' deep *open cut* (2540.25 inv, 2548.00 +/- FS). c. The additional labor is for the following penetrations (1) wall pen @ fine screen w/link seal (1) floor pen at fine screens w/sealant (3) floor pen at pump station w/sealant & (4) wall pen at eq w/link seal. This comes out to an average total 4.6 man hours (1.53 crew hours) per penetration to install and seal. The floor penetration deleted is not a wall spool or sleeve which required separate installation and sealant. This would have been a pipe spool bolted to the MJ 90 below grade. The credit for the deletion of this spool is included in the pipe install credit labor. d. Checked labor for equipment and we feel no changes are needed e. Adjustment made. f. Material for below grade site was ordered and delivered to the jobsite prior to the clarification being issued. This material is non-returnable and no credit can be given. Material can be handed over to the plant staff or city if they would like. g. Labor for encasement at fine screens has been reduced and a credit for the EQ has been added. We come up with a difference of 2 cy. Concrete material quantity has been reduced. h. The labor for the reused below grade 16" fittings are not included in the labor hours for the additional pipe and fittings. The labor hours included are the additional hours required for the additional 16" & 10" below grade fittings. Originally there were (5) 16" MJ fittings and 190 LF of 16" pipe. In the change order there are (5 ea) 16" MJ fittings, (145 lf) 16" pipe, (4 ea) 10" MJ Fittings & (100 lf) 10" pipe. The additional labor hours in the "Added BG Pipe Install" include the credit for the reduction of the (45 lf) of 16" pipe and the addition of the (4 ea) 10" MJ fittings and (100 lf) of 10" pipe. The labor hours for the below grade fittings were already "reused" as requested in this comment. Comment 2: <ol style="list-style-type: none"> a. Wall extra work was the same crew size for the flatwork was reduced to provide extra savings. b. See attached email from G&W explaining the canopy cost. Comment 3: <ol style="list-style-type: none"> a. Per our calculations, the overall fill for this section of the job is close to the original fill. Please provide backup for the 3000 yards stated if credit is needed. b. The labor and equipment shown is for the extra time required to maintain a proper flow/slope into the added gravel swales. c. Construction Note 113 calls for Gravel Swales per 130/CD-4. There are new swales that run from the north side of the EQ basin to the southeast wall. d. The concrete was mislabel as 4000 psi. This is 2500 psi ductbank concrete. 	
COST ESTIMATE	



www.ewsinc.org

SCOPE OF SUPPLY

Date: November 15, 2019 **pages**

To: **Juan C. Ahumada - Project Executive**
W. M. LYLES CO. | Southern Division

From: **David Sperber** **P-714-932-2002**

Reference: **Salt Mitigation WWTP Upgrade – City of Beaumont**

EWS Ref #: **A-036-E01**

Gentlemen:

We are pleased to present the equipment listed below for the above referenced project. Attached to our general scope, please find specific descriptions and terms and conditions. Prices quoted are based on these descriptions. We look forward to working with you on this project.

Salt Mitigation WWTP Upgrade – City of Beaumont

Gorman Rupp Triplex Pump Station per Drawing EQM-4

Complete packaged pump station including three (3) Gorman Rupp T8A3S-B /WW pumps in a triplex configuration. The Triplex base will have all three (3) pumps on the same base with a vertical v-belt base arrangement connected to a 40 hp TEFC motor. The unit base shall be comprised of a base plate, perimeter flange, and reinforcements. Base plate will be fabricated of steel not less than 1/4" thick and will incorporate openings for access to all internal cavities to permit complete grouting of the unit base after installation. Perimeter flange and reinforcements will be designed to prevent flexing or warping under operating conditions. Base plate and/or flanges will be drilled for hardware used to secure unit base to concrete pad. Unit base will contain provisions for lifting the complete pump unit during shipping and handling.

Anchor Bolt Design Calculations and Non-Witnessed Factory testing as required by the specification are included. Field Service is included with each of the site visits will have one day on site for a total of Two (2) trips and Two (2) days onsite

Exception to Section 2.2 Anchor Bolts – Anchor Bolts by others
Not included – Controls, Piping, Fittings

Gorman Rupp Triplex T8A3S -B common base pump package	\$88,800 USD
Freight (estimated)	\$3,000 USD
Start-up Two (2) trips and Two (2) days onsite	\$5,000 USD
TOTAL PRICE	\$96,800 USD

1162 E Dominguez St
Carson, CA 90746
310-667-4390 310-667-4395 Fax

Estimated Submittals	2-3 weeks
Estimated Resubmittals	1-2 weeks
Estimated Production Time (based on release and approval)	8-10 weeks

Please note that a Class H motor currently has a 14-week lead time. If this is required by the engineer, the production time will increase accordingly

Comments, Clarifications, Exceptions

All prices are quoted FOB Factory
 Payment Terms are to be negotiated
 Standard Terms and Conditions attached are part of our proposal
 This proposal is not a binding contract unless specifically accepted by EWS
 Exception to Section 2.2 Anchor Bolts – Anchor Bolts by others
 Not included – Controls, Piping, Fittings

Not included unless otherwise noted:

- Sales Tax (provide resale card if not applicable)**
- Interconnecting piping or wiring unless otherwise specified**
- Finish paint**
- Storage**
- Accountability for delivered materials or equipment (you must notify us within 48 hours of delivery of any shortage)**
- Transit damage (you must notify the freight -carrier at the time of delivery, and us within 48 hours of any damage)**
- Field Vibration or sound level testing**
- Seismic Calculations (except Anchor Bolt Calculations)**
- Factory witness, including travel**
- Lubricant**
- Spare parts**
- Any accessories unless noted specifically by the manufacturer**

Thank you for the opportunity to be of service.

Submitted for: ENVIRONMENTAL WATER SOLUTIONS, INC

By: _____ FOR _____

Accepted for _____

By: _____

Accepted for: ENVIRONMENTAL WATER SOLUTIONS, INC.

By: _____

STANDARD TERMS AND CONDITIONS OF SALE FOR UNITS, PACKAGES, SYSTEMS, & PARTS

Effective 7/1/2014

The foregoing quotation ("quotation") is subject to the following Environmental Water Solutions, Inc. [Seller] Standard Terms and Conditions which supersedes Buyer's [Buyer] proposed terms and conditions, if any. The quotation and these standard terms and conditions shall be referred to hereinafter collectively as the "quotation."

This quotation contains the entire agreement of the parties and all proposals, negotiations, representations, or agreements made or entered into prior to or contemporaneously with this quotation are excluded whether oral or in writing. Prices and specifications set forth in this quotation are based upon the terms and conditions set forth herein.

ANY TERMS PROPOSED IN BUYER'S ACCEPTANCE OF THIS QUOTATION WHICH ADD TO, VARY FROM, OR CONFLICT WITH THE TERMS HEREOF ARE HEREBY OBJECTED TO AND REJECTED AND SHALL NOT CONSTITUTE ANY PART OF ANY CONTRACT RESULTING FROM THIS QUOTATION. ANY SUCH PROPOSED TERMS SHALL HAVE NO FORCE OR EFFECT AND THE TERMS HEREIN SHALL CONSTITUTE THE COMPLETE AND EXCLUSIVE STATEMENT OF THE TERMS AND CONDITIONS OF ANY CONTRACT RESULTING FROM THIS QUOTATION AND MAY BE MODIFIED ONLY BY WRITTEN INSTRUMENT EXECUTED BY THE AUTHORIZED REPRESENTATIVES OF BOTH PARTIES.

1. Prices are EXW (Ex Works Incoterms) unless otherwise specified. Freight charges are not included in the quoted price, unless so stated. If order is not picked up by the Buyer, Seller may, in its discretion, select the carrier unless specified in advance by the Buyer. Purchase prices are stated in United States Dollars and payment shall be in United States currency.
 2. Invoice terms are net 20 days unless otherwise specified. If Buyer fails to fulfill the terms of payment, Seller at its option may defer further shipment. Account past due shall bear interest at the rate of 1 ½% per month or at the highest rate permitted by law until paid. In addition to such late payment charges, Buyer shall pay Seller any and all costs associated with collection thereof, including reasonable attorneys' fees. Seller reserves the right to modify or withdraw credit terms at any time without notice and may require down payments, C.O.D., payment in advance, progress payments, or payment guarantees.
 3. Prices do not include sales, use, excise or any similar tax. Any tax or other governmental charge upon the production, sales, shipment, or use of the product which Seller is required to pay or collect from Buyer shall be paid by Buyer to Seller unless Buyer furnishes Seller with a tax exemption certificate acceptable to the applicable taxing authority. Buyer shall be responsible for obtaining any necessary governmental clearances, including import and foreign exchange licenses, which may be required by any government other than the government of the United States.
 4. Seller shall not be liable for any failure to perform its obligations under any contract resulting from this quotation when such failure arises directly or indirectly from or is contributed to by any act of God, acts of Buyer, acts of civil or military authority, terrorism, priorities, fire, strikes or other labor disputes, accidents, floods, epidemics, war, riot, delays in transportation, lack of or inability to obtain raw materials, components, labor, fuel or supplies, or other circumstances beyond Seller's reasonable control whether similar or dissimilar to the foregoing.
 5. Shipping dates are given to the best of Seller's knowledge based upon conditions existing at the time any contract resulting from this quotation is entered into and specifications contained therein but are not of the essence of or in any way terms of the contract or representation of fact. Seller will, in good faith, endeavor to ship by the estimated shipping date, but shall not be responsible for any delay or any damage arising from failure to ship on the estimated shipping date. If Seller's completion of an order/contract is delayed by Buyer, that portion of the order/contract that is completed or ready for shipment, will be invoiced at that time, to be paid per the payment terms of the order/contract. Equipment held for the Buyer will be at the risk and expense of the Buyer, including applicable storage charges.
 6. Any order resulting from this quotation cannot be cancelled, altered, or rescheduled except with the written consent of the Seller and upon terms which will indemnify the Seller against all loss associated thereby. All additional costs incurred by the Seller due to changes to the order by Buyer shall be paid by the Buyer. Goods may be returned only when specifically authorized by the Seller. Seller's Cancellation Terms will apply for order or goods cancelled or returned by the Buyer.
 7. Title to the products and risk of loss with respect thereto shall pass to Buyer upon release thereof by Seller to a common carrier or upon tender of the products to an agent, employee, or representative of Buyer.
 8. If Buyer has not made a claim to Seller within thirty (30) days after receipt of the products, the products shall be considered accepted and conforming to contract requirements.
 9. Installation, startup of equipment, factory inspection or testing, and any materials or services shall be the responsibility of the Buyer unless otherwise specifically included in the Seller's quotation or contract
 10. Seller warrants to Buyer for a period of 18 months from the date of shipment or 12 months from placement into service, whichever first occurs, that any product delivered under any contract resulting from this quotation will at the time of shipment be free from defects in material and workmanship. If, within said warranty period, any such product is found, by Seller following its examination, to be defective in material or workmanship, Seller's sole obligation under this warranty will be to repair or replace such defective product at its option and expense, when received Freight Prepaid at the business establishment of Seller, or a repair facility authorized by Seller during regular working hours. Seller's obligation under this warranty shall not include any transportation charges, cost of removal and reinstallation, duty, taxes or any other charges whatsoever which will be paid by the Buyer. No goods may be returned by the Buyer without Seller's prior written consent. Seller does not warrant any products, accessories, or components not manufactured by Seller, but to the extent possible agrees to provide Buyer with the benefits of the manufacturer's warranty, if any. Seller shall not be liable for damage to or wear of products caused in whole or in part by abnormal conditions, improper application; maintenance; or use, failure to provide proper inlet conditions or flow, corrosives, abrasives or foreign objects, or other external causes.
- THE FOREGOING WARRANTY IS EXCLUSIVE AND IN LIEU OF ALL OTHER WARRANTIES, WHETHER EXPRESS, IMPLIED, OR STATUTORY INCLUDING BUT NOT LIMITED TO ANY WARRANTIES OF MERCHANTABILITY OR FITNESS FOR ANY PARTICULAR PURPOSE.
11. Neither party shall disclose to third parties nor use for its own purposes any confidential information or trade secrets of the other party.
 12. The rights of the Buyer herein shall neither be assignable or transferable without written consent from the Seller. If bankruptcy or insolvency proceedings are instituted by or against the Buyer, or if Buyer makes an assignment for the benefit of creditors, Buyer will be deemed in default and Seller will have the right to terminate its obligations by written notice to the Buyer, but such termination will not affect Buyer's obligation to pay for items delivered and work in progress.
 13. In the event Buyer claims that Seller has breached any of its obligations under any contract resulting from this quotation, whether in warranty or otherwise, Seller may request and require return of the product and refund the Buyer's purchase price (if product is in same condition as when shipped by Seller) upon Seller's receipt of returned product. If Seller so requests the return of the product, the product shall be redelivered to Seller in accordance with Seller's instructions. Redelivered freight charges will be to Seller's account. In the event Seller elects to require return of the product, Seller shall absolutely have no further obligation to Buyer under any contract resulting from this quotation except to refund such purchase price upon redelivery of the product and Buyer will be deemed to have waived any and all claims arising from such contracts.

THE REMEDIES PROVIDED FOR IN THIS AND THE PRECEDING PARAGRAPH SHALL CONSTITUTE THE SOLE RECOURSE OF BUYER AGAINST SELLER FOR BREACH OF ANY OF SELLER'S OBLIGATIONS UNDER ANY CONTRACT RESULTING FROM THIS QUOTATION, WHETHER THE CLAIM IS MADE IN TORT, CONTRACT, OR IN ADMIRALTY, INCLUDING CLAIMS BASED ON WARRANTY, NEGLIGENCE, OR OTHERWISE. NOTWITHSTANDING ANY OTHER PROVISION OF THIS AGREEMENT, IN NO EVENT SHALL SELLER BE LIABLE FOR INCIDENTAL OR CONSEQUENTIAL DAMAGES, NOR SHALL SELLER'S LIABILITY FOR ANY CLAIMS OR DAMAGE ARISING OUT OF OR CONNECTED WITH ANY CONTRACT RESULTING FROM THIS QUOTATION, OR THE MANUFACTURE, SALE, DELIVERY OR USE OF THE PRODUCT, EXCEED THE PURCHASE PRICE OF THE PRODUCT.

14. In the event (1) Buyer modifies any product sold pursuant to any contract resulting from this quotation without the express written consent of Seller or (2) Buyer fails to implement any changes in the product directed by Seller or (3) any product to be furnished under any contract resulting from this quotation is made in accordance with drawings, samples, or manufacturing specifications provided or designated by Buyer, Buyer agrees to defend, indemnify and hold harmless Seller from any and all claims, demands, actions, or causes of action or costs or expenses however incurred.

1162 E Dominguez St
Carson, CA 90746
310-667-4390 310-667-4395 Fax

15. In the event any product to be furnished under any contract resulting from this quotation is to be made in accordance with drawings, samples or manufacturing specifications provided or designated by Buyer, Buyer agrees to indemnify and hold Seller harmless from any and all damages, costs and expenses arising from a claim that such product furnished to Buyer by Seller or the use thereof, infringes any Letters Patent, foreign or domestic, and Buyer agrees at its own expense to undertake the defense of any suit against Seller brought upon such claim or claims. In the event any product to be furnished under any contract resulting from this quotation is not for a U.S. Government application and is not to be made in accordance with drawings, samples or manufacturing specifications provided or designated by Buyer, but rather is the design of Seller, Seller agrees to hold Buyer and its customers harmless against any damages awarded by a court of final jurisdiction in any suit for infringement of any United States Letters Patent by reason of the sale or use of such product as furnished by Seller under any contract resulting from this quotation. In the event any claim is asserted or threatened, as to which Buyer may seek indemnification hereunder, Seller shall have the sole right to contest, compromise, litigate, or otherwise dispose of said claim, including the right to substitute non-infringing products, and Buyer agrees to cooperate fully with Seller with respect thereto. The foregoing undertaking of Seller shall not apply unless Seller shall have been informed in writing immediately by Buyer of any charge or suit alleging such infringement and shall have been given the opportunity to assume the defense thereof with counsel of its choosing, and further, such undertaking shall not apply if (i) the claimed infringement is settled without the consent of Seller, or (ii) the infringement results from the use of a product delivered hereunder which is modified by Buyer or others without authorization by Seller or (iii) used in combination with a product not delivered by Seller where such infringement would not have occurred from the lone use of the product delivered under any contract resulting from this quotation.
16. The parties agree that should any provision contained in this Agreement be unenforceable under present or future laws or in a court of with jurisdiction over this agreement, the unenforceable provision will be replaced by a provision which lawfully enforces the parties' intention underlying the unenforceable provision, and the remaining provisions of this Agreement will remain in full force and effect.
17. No provision of this Agreement is waived by any act or knowledge on the part of either party, except by a written instrument signed by an authorized representative of that party. The waiver by either party of any right or a party's failure to enforce a provision of this Agreement is not a continuing waiver or a waiver of any other rights or of any material breach or failure of performance of the other party.
18. All articles herein will survive the termination or expiration of this Agreement or completion of any order.
19. Any contract resulting from this quotation shall be governed by the Uniform Commercial Code as adopted in the State of California as effective and in force on the date hereof. Wherever a term defined by said Uniform Commercial Code is used herein, the definition contained in the Uniform Commercial Code is to control, provided, however, the term "Ex Works" shall be as defined in the Incoterms. No action for breach of sale, any contract resulting from this quotation or any covenant or warranty arising therefrom shall be brought more than one year after the cause of action has accrued.
20. Dispute Resolution. It is the intent of the parties hereto to use alternative dispute resolution proceedings ("ADR"), by first requiring participation in mediation and then requiring mandatory binding arbitration.
- Arbitration: Subject to the mediation provision below, any dispute, claim or controversy arising out of or relating to this Agreement or the breach, termination, enforcement, interpretation or validity thereof, including the determination of the scope or applicability of this agreement to arbitrate, shall be determined by arbitration in Los Angeles County, California, before one arbitrator. At the option of the first to commence an arbitration, the arbitration shall be administered either by JAMS pursuant to its Streamlined Arbitration Rules and Procedures, or by the American Arbitration Association ("AAA") pursuant to its Commercial Arbitration Rules. Judgment on the Award may be entered in any court having jurisdiction. This clause shall not preclude parties from seeking provisional remedies in aid of arbitration from a court of appropriate jurisdiction.
 - Allocation of Fees and Costs: The arbitrator may, in the Award, allocate all or part of the costs of the arbitration, including the fees of the arbitrator and the reasonable attorneys' fees of the prevailing party.
 - Mediation Before Arbitration: The parties agree that any and all disputes, claims or controversies arising out of or relating to this Agreement shall be submitted to JAMS or AAA, or its successor, for mediation, and if the matter is not resolved through mediation, then it shall be submitted to final and binding arbitration pursuant to the arbitration clause set forth above. Either party may commence mediation by providing to JAMS or AAA and the other party a written request for mediation, setting forth the subject of the dispute and the relief requested. The parties will cooperate with JAMS or AAA and with one another in selecting a mediator from JAMS' or AAA's panel of neutrals, and in scheduling the mediation proceedings. The parties covenant that they will participate in the mediation in good faith, and that they will share equally in its costs. All offers, promises, conduct and statements, whether oral or written, made in the course of the mediation by any of the parties, their agents, employees, experts and attorneys, and by the mediator or any JAMS or AAA employees, are confidential, privileged and inadmissible for any purpose, including impeachment, in any arbitration or other proceeding involving the parties, provided that evidence that is otherwise admissible or discoverable shall not be rendered inadmissible or non-discoverable as a result of its use in the mediation. Either party may initiate arbitration with respect to the matters submitted to mediation by filing a written demand for arbitration at any time following the initial mediation session or 45 days after the date of filing the written request for mediation, whichever occurs first. The mediation may continue after the commencement of arbitration if the parties so desire. Unless otherwise agreed by the parties, the mediator shall be disqualified from serving as arbitrator in the case. The provisions of this Clause may be enforced by any Court of competent jurisdiction, and the party seeking enforcement shall be entitled to an award of all costs, fees and expenses, including attorneys' fees, to be paid by the party against whom enforcement is ordered.
 - Not a Condition of Employment. Employee and Company both acknowledge and agree that the decision to use ADR including arbitration was for each party's benefit and convenience and that use of arbitration or other form of ADR was not a condition of employment of Employee by Company. Employee understands and acknowledges that by agreeing to mandatory arbitration he relinquishes his right to have his claims or defense heard by a judge and jury.
21. BOTH SELLER AND BUYER AGREE TO INDEMNIFY, DEFEND AND HOLD THE OTHER PARTY HARMLESS FROM ANY AND ALL LOSSES, LIABILITIES, DAMAGES, CLAIMS (INCLUDING, WITHOUT LIMITATION, CLAIMS FOR PERSONAL INJURY, BODILY INJURY, ILLNESS, DEATH OR PROPERTY DAMAGE), COSTS, EXPENSES (INCLUDING, WITHOUT LIMITATION, REASONABLE ATTORNEY'S FEES), PENALTIES, FINES AND JUDGMENTS OF ANY NATURE WHATSOEVER (COLLECTIVELY "LOSSES"), CAUSED BY OR ARISING OUT OF ANY NEGLIGENT ACTION, OR OMISSION, OR WILLFUL MISCONDUCT, OR ENVIRONMENTAL LIABILITY OF THE INDEMNIFYING PARTY, OR ANY OTHER BREACH OF THIS AGREEMENT BY THE INDEMNIFYING PARTY.
NOT WITHSTANDING THE ABOVE, IN NO EVENT SHALL BUYER OR SELLER IS LIABLE TO EACH OTHER FOR INDIRECT, SPECIAL OR CONSEQUENTIAL DAMAGES OR FOR LOSS OF ORDERS.
Where Services provided to or on behalf of the Buyer are sold, resold, or otherwise transferred to a third party, the third party, and its customers, assignees, and other successors in interest to these Services, shall have no rights greater than those granted Buyer herein. Buyer shall defend, indemnify and hold Seller harmless, its officers, directors, and employees, from and against any and all claims, losses, liabilities or expenses of third parties (including without limitation attorney's fees) which Buyer could not itself recover hereunder.

Oscar Mendoza

From: Stephen Crump <crumpco@pacbell.net>
Sent: Wednesday, January 8, 2020 12:34 PM
To: Michael Bonser
Subject: Re: Beaumont Change Order Quote

Five (5) 8" Val Matic **100% Port** ANSI Class 125 Flanged Cam-Centric Plug Valves with BS Worm Gear Act, fusion epoxy in/out, model # 5708F/6A02XF @ \$2,306.00 ea

Three (3) 8" Val Matic Swing-Flex Check Valve, fusion epoxy in/out @ \$1,618.00 ea

+ freight

+ sales taxes.

CRUMP & CO, INC.

Stephen A. Crump
PO 94836, Pasadena, Ca. 91109
(Phone) 626-794-1685
(Fax) 626-577-4488
(Cell) 626-893-7207

A Manufactures Representative Firm

Leaving Green Footprints - Think before you print.

On Wednesday, January 8, 2020, 7:11:52 AM PST, Michael Bonser <mbonser@wmlylesco.com> wrote:

Stephen,

I'm working on a change order for the Beaumont project. Attached is the PO.

We will need pricing for the following:

Five (5) 8" Val Matic 100% Port ANSI Class 125 Flanged Cam-Centric Plug Valves with BS Worm Gear Act

Three (3) 8" Val Matic Swing-Flex Check Valve

I can send you copies of the approved submittals if you would like.

Can you have please pricing to us by Tuesday January 14th?

Thanks,

Michael Bonser | Project Manager/Estimator

W. M. LYLES CO. | Southern Division

42142 Roick Dr. | Temecula, CA 92590

O 951-973-7393 | C 951-757-2330

www.wmlyles.com

Please access the hyperlink below for an important electronic communications disclaimer:

http://www.lylesgroup.com/disclaimer_lsc.html

Oscar Mendoza

From: Oscar Mendoza
Sent: Friday, January 31, 2020 3:34 PM
To: Oscar Mendoza
Subject: FW: Beaumont Salt Mitigation Project - Change order request for proposal

From: Juan Ahumada <jahumada@wmlylesco.com>
Date: January 31, 2020 at 3:05:56 PM PST
To: Michael Bonser <mbonser@wmlylesco.com>
Subject: FW: Beaumont Salt Mitigation Project - Change order request for proposal

Juan C. Ahumada | Project Executive
W. M. LYLES CO. | Southern Division
42142 Roick Dr. | Temecula, CA 92590
O 951-973-7393 | C 951-972-2056
www.wmlyles.com

From: Stephen Crump <crumpco@pacbell.net>
Sent: Tuesday, November 5, 2019 9:40 AM
To: Juan Ahumada <jahumada@wmlylesco.com>
Subject: Beaumont Salt Mitigation Project - Change order request for proposal

Juan:

1-3", sewage combo air valve, # 803AXF (does not include optional backwash kit): \$1,421.00 each

-Delivery is based on current material availability and is subject to prior sales

-Pricing is valid for 30 days

-Quotation above is based on model numbers and quantities shown. Any deviation from this quotation can result in a change of price and availability for the items listed herein.

All sales are subject to the Val-Matic Valve & Manufacturing Corp. (Val-Matic), Terms of Sale effective on receipt of the purchase order, which are incorporated in full by this reference. The Terms of Sale are available at <http://www.valmatic.com/terms.html>, and can be provided to the purchaser upon request.

CRUMP & CO, INC.

Stephen A. Crump

PO 94836, Pasadena, Ca. 91109

(Phone) 626-794-1685

(Fax) 626-577-4488

(Cell) 626-893-7207

A Manufactures Representative Firm

Leaving Green Footprints - Think before you print.

SOLD TO:
 WM LYLES COMPANY
 PO BOX 4377
 FRESNO, CA. 93744-4377



JOB ADDRESS:
 W.M. LYLES CO.
 715 W. 4TH STREET
 BEAUMONT, CA 92223

Quote

Date
 1/8/2020

www.WestPacProducts.com
 Bolts-Gaskets-Strut/Fittings-PipeSupports

Quote #	CO-MIKE	Rep	SP	FOB	Chino Ca.
Description	Qty	U/M	Cost	Total	
150#					
8" A307B BOLT SET STEEL PLAIN	14	ea	12.00	168.00T	
10" A307B BOLT SET STEEL PLAIN	6	ea	28.00	168.00T	
16" A307B BOLT SET STEEL PLAIN	17	ea	69.00	1,173.00T	
8" 150# FF 1/8" EPDM GASKETS	14	ea	6.00	84.00T	
10" 150# FF 1/8" EPDM GASKETS	6	ea	9.00	54.00T	
16" 150# FF 1/8" EPDM GASKETS	17	ea	18.00	306.00T	
1 1/8-7 HEAVY HEX NUT STEEL PLAIN	1	ea	1.02	1.02T	
SanBerdo-new7.75			7.75%	151.44	
				Total	\$2,105.46

SOLD TO:
 WM LYLES COMPANY
 PO BOX 4377
 FRESNO, CA. 93744-4377



JOB ADDRESS:
 W.M. LYLES CO.
 715 W. 4TH STREET
 BEAUMONT, CA 92223

Quote

Date
 1/8/2020

www.WestPacProducts.com
 Bolts-Gaskets-Strut/Fittings-PipeSupports

Quote #	CO-MIKE	Rep	SP	FOB	Chino Ca.
Description		Qty	U/M	Cost	Total
150#					
8" A307B BOLT SET STEEL PLAIN		14	ea	12.00	168.00T
10" A307B BOLT SET STEEL PLAIN		6	ea	28.00	168.00T
16" A307B BOLT SET STEEL PLAIN		17	ea	69.00	1,173.00T
8" 150# FF 1/8" EPDM GASKETS		14	ea	6.00	84.00T
10" 150# FF 1/8" EPDM GASKETS		6	ea	9.00	54.00T
16" 150# FF 1/8" EPDM GASKETS		17	ea	18.00	306.00T
1 1/8-7 HEAVY HEX NUT STEEL PLAIN		1	ea	1.02	1.02T
8" FLANGE ADJUSTABLE GALVANIZED PIPE SUPPORTS-34" TALL		3	ea	366.00	1,098.00T
10" ADJUSTABLE GALVANIZED PIPE SUPPORTS-3" TALL W/UBOLT		1	ea	389.00	389.00T
16" ADJUSTABLE GALVANIZED PIPE SUPPORTS-52" TALL W/UBOLT		3	ea	588.00	1,764.00T
8" CLEVIS HANGER HDG-44"C/L W/EYE-BOLTS		3	ea	210.00	630.00T
3/4-10 HEX NUT GALVANIZED		12	ea	0.35	4.20T
SanBerdo-new7.75				7.75%	452.54
				Total	\$6,291.76



Southern Contracting Company
P.O. Box 445 San Marcos, CA 92079-0445
Tel 760-744-0760 Fax 760-744-6475
website: www.southerncontracting.com
email: info@southerncontracting.com

Change Order Request

103801 — Wastewater Treatment Plant Salt Mitigation Upgrade COR Subject: CLAR 024 DCM 018

To Juan C. Ahumada
W.M. Lyles
42142 Roick Drive
Temecula, CA 92590
951-973-7393

Contract No: 55.1173
COR Number: 103801-COR#016
COR Revision Number: 0
COR Date: 1/16/2020
Work Type: Price / Do Not Proceed
Owner COR No: CLAR 024 DCM 018
Days Valid: 5

Return To Dan Alcantar
Southern Contracting Company
760-744-0760x621
619-778-0681
DAlcantar@southerncontracting.com

Scope Of Work / Time Extension Request

The work associated with DCM18 CLAR 24 is a change to Southern Contracting Company's scope of work in which a change in Contract Price and Time is to be considered.

Accordingly, Southern Contracting Company requests a Contract Change Order in the amount of \$201,987.41

Scope of Work is as follows:

- Provide labor and materials to address electrical changes associated with the EQ Basin Changes, it has been determined to modify the discharge system from the Equalization Basin.

Station will be located on the north end of the basin.

The electrical feed for the new EQ Pump Station will originate in the electrical room of the Solids Handling Building. A manual transfer switch, generator receptacle and MCC-EQ have been added to the electrical design. Several site ductbanks are modified. Instrumentation and Controls changes.

Exclusions:

-Digging, backfill, concrete formed or poured, dry packing, surface restoration, permits, inspections.

Change in time: NA

Southern Contracting reserves all rights to additional costs and time for changes not identified in the documents furnished, and is not responsible for additional costs or time for work which is not part of our contract scope of work, unless stipulated above. Should additional information or clarification be required, please contact me at your convenience.

Summary

Total: \$201,987.41

Reservation of Rights

This COR does not include any amount for impacts such as interference, disruptions, rescheduling, changes in the sequence of work, delays and/or associated acceleration. We expressly reserve the right to submit our request for any of these items.

Signed By:



Daniel Alcantar

PM

Dated: 1/16/2020

Bid Summary Report

103801 Beaumont Chang Orders Estimator: Dan Alcantar

Job #2336

Job Name: 103801 Beaumont Chang Orders

Contractor:

Estimator: Dan Alcantar

Notes:

Bid Date:

Summary Description	Material			Labor		
	Extended	%	Adjusted	Extended	%	Adjusted
COR#016 DCM 18 CLAR 024 rev1	\$25,926.62	100.00%	\$25,926.62	735.97	100.00%	735.97

Top Sheet

Raw Cost	\$178,977.15	Sales per Month	\$0.00
Tax	\$2,009.31	Return per Month	\$0.00
Raw Cost with Tax	\$180,986.46	Price per Square Foot	\$0.00
Overhead	\$19,001.07	Hours per Square Foot	0.00
Profit	\$0.00	Square Feet	0.00
Total Return Amount	\$19,001.07	Job Months	0.00
Total Return %	9.41%	Hours per Week	0.00
Price	\$199,987.53	Workers per Day	0.00
Bond	\$1,999.88	Total Hours	735.97
Sell Price	\$201,987.41	Mark Up Sales Tax	Yes
Adjusted Sell ()	\$0.00	Use Bond Table	Yes
Adjusted Sell Return 0.00 %	\$0.00		

Labor

Class Description	Percent of Total	Hours Distributed	Hourly Rate	Burden		Labor Cost
				Rate	Percent	
General Foreman	10.00%	73.60	\$94.89	\$0.00	0.00%	\$6,983.59
Foreman	25.00%	183.99	\$88.33	\$0.00	0.00%	\$16,252.00
Journeyman	40.00%	294.39	\$81.76	\$0.00	0.00%	\$24,069.08
Appr-85%	25.00%	183.99	\$71.01	\$0.00	0.00%	\$13,065.26
Totals	100.00%	735.97	\$82.03	\$0.00	0.00%	\$60,369.93

Mark Ups

	OVERHEAD			PROFIT		
	Total	%	Amount	%	Amount	
Materials	\$25,926.62	+ 15.00%	\$29,815.61	+ 0.00%	\$29,815.61	
Labor	\$60,369.93	+ 15.00%	\$69,425.42	+ 0.00%	\$69,425.42	

Bid Summary Report

103801 Beaumont Chang Orders Estimator: Dan Alcantar

Job #2336

Supplier Quotes	\$78,455.00	+	5.00%	\$82,377.75	+	0.00%	\$82,377.75
SubContractors	\$0.00	+	15.00%	\$0.00	+	0.00%	\$0.00
Direct Job Expense	\$14,225.60	+	15.00%	\$16,359.44	+	0.00%	\$16,359.44
Equipment Rental	\$0.00	+	15.00%	\$0.00	+	0.00%	\$0.00
Totals	\$178,977.15		10.62%	\$197,978.22		0.00%	\$197,978.22

Tax Report

	Taxed Amount	Tax Rate %	Tax Amount
Materials	\$25,926.62	7.75%	\$2,009.31
Labor	\$60,369.93	0.00%	\$0.00
Supplier Quotes	\$62,415.00	0.00%	\$0.00
SubContractors	\$0.00	0.00%	\$0.00
Direct Job Expense	\$0.00	0.00%	\$0.00
Equipment Rental	\$0.00	0.00%	\$0.00
		Total Tax:	\$2,009.31

Supplier Quotes

Name	Supplier	Tax (0.0 %)	Unit Cost	Multiplier	Amount
Intrumentation and controls		No	\$16,040.00	1.00	\$16,040.00
MCC- Switchgear		Yes	\$62,415.00	1.00	\$62,415.00
			Total:		\$78,455.00

Direct Job Expense

Name	Supplier	Tax (0.0 %)	Unit Cost	Multiplier	Amount
Site Truck		No	\$26.15	472.00	\$12,342.80
FM Truck		No	\$26.15	72.00	\$1,882.80
				Total:	\$14,225.60

Job Name: 103801 Beaumont Chang Orders
 Job Number: 2336
 Extension Name: COR#016 DCM 18 CLAR 024 rev1

Material Filter: <None>
 Report: COR - 2

[Items and ByProducts]

Item #	Item Name	Quantity	Ext Price	Ext Labor
Label Set: Combined, Combined, Combined, Combined, Combined, Combined, Combined				
Cost Code: 010 - Conduit/Raceway				
2,598	1/4" SS WEDGE ANCHOR	20.00	\$46.00	4.02
2,600	1/2" SS WEDGE ANCHOR	26.00	\$299.00	6.53
2,614	1/4x1" SS SCREWS	30.00	\$10.19	5.28
2,621	1/4" SS SADDLE WASHER	20.00	\$5.09	0.00
2,624	1/4" SS WASHER	40.00	\$4.40	0.00
2,631	1/4" SS NUT	30.00	\$4.02	0.00
2,658	1 5/8 STRUT-STAINLESS	4.00	\$47.50	0.75
2,684	3/4 GRC/PVC COATED	65.00	\$282.74	6.53
2,685	1 GRC/PVC COATED	290.00	\$1,633.09	36.42
2,687	1 1/2 GRC/PVC COATED	10.00	\$86.67	1.88
2,692	4 GRC/PVC COATED	10.00	\$311.53	4.77
2,697	3/4 GRC/PVC COUP	24.00	\$108.62	2.71
2,711	3/4 GRC/PVC ELBOW	8.00	\$128.98	5.53
2,712	1 GRC/PVC ELBOW	4.00	\$73.97	3.27
2,765	1 GRC/PVC HUB	10.00	\$514.34	6.28
2,772	4 GRC/PVC HUB	1.00	\$331.61	1.76
2,822	3/4 GRC/PVC LB BODY	4.00	\$215.75	3.27
2,860	1G OCAL FD BOX -3/4"	1.00	\$60.96	0.88
2,971	3/4 GRC/PVC CLAMP BAK	20.00	\$232.44	1.26
2,972	1 GRC/PVC CLAMP BAK	30.00	\$454.54	2.26
3,000	1 GRC/PVC CLAMP	30.00	\$289.57	7.91
60,040	Stanchion Installation	1.00	\$311.18	1.50
60,041	Aluminium Back Board by section	1.00	\$137.00	1.00
Cost Code: 020 - Wire/Cable				
4	16 TSP - SHIELDED CABLE BELDEN	230.00	\$165.60	2.89
74	12 XHHW CU STRANDED	1,800.00	\$274.86	13.56
75	10 XHHW CU STRANDED	7,500.00	\$1,716.53	75.36
76	8 XHHW CU STRANDED	1,800.00	\$596.14	22.61
			<u>\$25,926.62</u>	<u>735.97</u>
			<u>\$5,589.19</u>	<u>103.81</u>

Job Name: 103801 Beaumont Chang Orders

Job Number: 2336

Extension Name: COR#016 DCM 18 CLAR 024 rev1

Material Filter: <None>
Report: COR - 2

[Items and ByProducts]

Item #	Item Name	Quantity	Ext Price	Ext Labor
78	4 XHHW CU STRANDED	5,500.00	\$4,012.63	96.71
82	1/0 XHHW CU STRANDED	100.00	\$194.82	2.76
91	600 XHHW CU STRANDED	350.00	\$3,538.57	21.10
4,082	10 GA TERMINATION	24.00	\$26.40	5.43
4,083	8 GA TERMINATION	6.00	\$6.60	1.88
4,085	4 GA TERMINATION	18.00	\$22.50	7.91
4,089	1/0 TERMINATION	2.00	\$3.00	1.51
4,098	600 MCM TERMINATION	18.00	\$45.00	32.78
60,050	Wire Tags Tube Style	68.00	\$170.00	0.68
Cost Code: 030 - Power Distribution			<u>\$5,995.00</u>	<u>88.38</u>
7,704	4 SECTION MCC	1.00	\$0.00	60.29
8,909	400 AMP XFER SWITCH	1.00	\$0.00	20.10
60,052	Generator Recept 400 AMP	1.00	\$3,998.00	6.00
60,053	400 amp plug	1.00	\$1,997.00	2.00
Cost Code: 040 - Lighting			<u>\$660.00</u>	<u>7.79</u>
10,531	WALL PACK 50W	4.00	\$0.00	7.79
60,051	Type 10 fixture	4.00	\$660.00	0.00
Cost Code: 050 - Wiring Devices			<u>\$7.40</u>	<u>11.74</u>
13,151	DPLX 20/3 GFCI	1.00	\$7.40	0.44
13,214	RCPT 400A 4W-4P	1.00	\$0.00	11.30
Cost Code: 080 - Grounding Systems			<u>\$142.33</u>	<u>2.83</u>
187	3/0 BARE CU STRANDED	50.00	\$142.33	2.83
Cost Code: 110 - Underground			<u>\$2,760.05</u>	<u>236.23</u>
3,188	1 PVC 40 (TRENCH)	3,100.00	\$1,419.97	155.74
3,190	1 1/2 PVC 40 (TRENCH)	600.00	\$445.42	32.03
3,191	2 PVC 40 (TRENCH)	480.00	\$424.48	27.13
3,195	4 PVC 40 (TRENCH)	100.00	\$242.12	6.91
3,217	1 PVC ELBOW	6.00	\$25.05	2.64
3,219	1 1/2 PVC ELBOW	2.00	\$11.45	1.26
3,224	4 PVC ELBOW	4.00	\$182.54	7.54

Job Name: 103801 Beaumont Chang Orders

Job Number: 2336

Extension Name: COR#016 DCM 18 CLAR 024 rev1

Material Filter: <None>

Report: COR - 2

[Items and ByProducts]

Item #	Item Name	Quantity
3,461	1 PVC FEMALE ADPT	6.00
3,463	1 1/2 PVC FEMALE ADPT	2.00
3,468	4 PVC FEMALE ADPT	1.00

[Items and ByProducts] Total:

Ext Price
\$3.30
\$1.75
\$3.97
<u>\$25,926.62</u>

Ext Labor
1.36
0.63
1.00
<u>735.97</u>

**CITY OF BEAUMONT WASTE WATER TREATMENT PLANT
SALT MITIGATION UPGRADE PROJECT**

CLARIFICATION 24

To (Construction Manager): Stantec Attention: Charles Reynolds Phone: 702-497-8024 Email: Charles.w.reynolds@stantec.com	
From (Engineer): AQUA/SKM Engineering Attention: Dallin Stephens Phone: 801-683-3746 Email: dallin.stephens@aquaeeng.com	
Subject: EQ Basin Modifications	Location: Civil and EQ Basin
Reference Documents: Multiple Drawings (see attached table), Specification Sections 432313, 262816	
CLARIFICATION	
<p>Note the following:</p> <p>After discussion with the City, it has been determined to modify the discharge system from the Equalization Basin by deleting the valve vault (as detailed on C-34) and adding a pump station to the Equalization Basin that discharges directly to the Fine Screens structure. This change eliminates the possibility of flooding the Influent Pump Station in the event that the valve in the Valve Vault were to fail open. The attached drawings show the extent of the required changes, but in general, the changes are summarized as follows:</p> <ol style="list-style-type: none"> 1. The EQ basin will be rotated such that the tipping buckets are located on the south end and the (formerly) south wall and interior wall will be raised to the same elevation as the remaining walls. The new EQ Pump Station will be located on the north end of the basin. 2. The site grading is to be modified to bring the grade to within 42" ± of the top of wall of the EQ basin on all sides. The grading to the north is also modified to promote better drainage. 3. The piping from the EQ basin to the valve vault, and from the valve vault to Manhole #5, as well as the vault itself are to be deleted. A new 16" line from the EQ Pump Station to the Fine Screens is to be installed (the same pipe number, #6, is to be reused for this pipeline). 4. The electrical feed for the new EQ Pump Station will originate in the electrical room of the Solids Handling Building. A manual transfer switch, generator receptacle and MCC-EQ have been added to the electrical design. Several site ductbanks are modified. 5. The attached drawings also show changes related to RFC 12 and RFIs 69 and 76, which have already been addressed but did not have updated drawings included. <p>A specification for the new EQ pumps (Section 432313) and manual transfer switches (Section 262816) is also included as part of this clarification.</p>	
Prepared By (Name): Dallin Stephens, AQUA Engineering	Date: 10/21/19
Distributed By:	Date:

Drawing	Modifications
C-4	Point #115 was added to the drawing and coordinate table; grading was updated
C-5	Grading by the eq. basin was updated.
C-6	Point #145 and #146 was updated on the coordinate table and drawing; grading was updated.
C-7	Added gravel swales; grading was updated.
C-20	Line 6 was updated; NPW piping was adjusted; valve vault was deleted
C-23	EQ pump Station added to the drawing
EQS-1	Basin was rotated; pump station pad added; wall heights adjusted.
EQS-3	Wall heights adjusted and wall reinforcing adjusted.
EQS-4	Wall heights adjusted
EQS-5	Grout elevations updated. Corner wall reinf detail and wall intersection detail added.
EQS-6	New sheet added.
EQS-7	New sheet added.
EQS-8	New sheet added.
EQM-1	Pump station and 16" pipe added. 20" pipe from influent pump station location updated; 16" drain pipe deleted
EQM-2	Grout dimension added. 24" pipe location updated; detail added for 20" influent pipe
EQM-3	New sheet added.
EQM-4	New sheet added.
EQM-5	New sheet added.
FSS-1	Updated 24" pipe to 30" pipe. Added 16" pipe.
FSS-2	Updated 24" pipe to 30" pipe. Added 16" pipe.
FSS-5	Updated grating support dimensions.
FSM-1	Updated manhole and drain lines locations. Added 16" line from eq basin.
FSM-3	Added pipe numbers to the Pipe Schedule
FSM-4	New sheet added showing 16" pipe from EQ basin
SCH-19	Schedule updated with additional valves
SCH-24	Schedule updated with additional meter
SCH-26	Schedule updated with additional pumps
PI-04	Removed valve vault and associated equipment removed. Routed Equalization Basin communications through RIO-SH, instead of RIO-HW
PI-04A	Added sheet to show EQ Basin Pumps
PI-05	Added piping from Equalization Basin to Fine Screens
I-14	Removed inputs/outputs from valve vault. Relocated EQ Basin level alarms.
I-18	Feedback added for EQ Basin Flow and Odor Control instrumentation. Added inputs/outputs for Equalization Basin instrumentation.
SE-01	Renamed and relocated handholes HH-106 and HH-106A to HH-303 and HH-303A.
SE-02	Removed HH-106 and HH-106A, ductbanks DB-101.1 and DB-50, and valve vault. Relocated ductbanks DB-104 and DB-104.1 and handhole HH-104. Added handhole HH-104A and ductbanks DB-104.4 and DB-104.5.
SE-04	Rotated Equalization Basin. Added EQ Basin Pump Station, handholes HH-303, HH-303A, and ductbanks DB-303.3, and DB-303.2. Removed DB-106.
LE-02	Removed handhole HH-50A. Relocated handhole HH-104. Added handhole HH-104A.
LE-03	Relocated handhole HH-104. Added handhole HH-104A.
LE-06	Removed valve vault and handholes HH-106 and HH-106A. Rotated Equalization Basin. Added EQ Basin Pump Station and handholes HH-303 and HH-303A.
LE-20	Updated MCC-SH layout. Added MCC-EQ, Generator Receptacle Enclosure and MTS-SH.
E-03	Removed valve FV-1533.
E-10	Relocated LP-SH from SWBD-SH. Added connection to MCC-EQ from SWBD-SH.
E-11	Updated MCC-SH layout. Added MCC-EQ. Relocated LP-SH to MCC-EQ.
E-12	Removed valve FV-1533. Updated loads for SWGR-HW and DP-HW1.
E-13	Removed LIT-1501 and LIT-1502. Updated loads at LP-HW1, LP-HW2 and MVSWGR.
E-16	Added loads for MCC-EQ. Added EQ Basin Pump Station equipment to LP-SH load. Removed load for solids building lighting from SWBD-SH.
E-17	Updated drawing reference for level sensors and switches at Equalization Basin. Removed valve vault instrumentation. Added flow meter for equalization basin pumps.
E-19	Added filter to VFD Control Schematic for EQ Basin Pumps P-1531, P-1532 and P-1533
CE-01	Conduit P0301 rerouted through MCC-EQ. Added conduits P0304 and P1171. Updated ductbank references for conduits P300A, P1101, P1102, P1111, P1112A, P1112B, P1113, P1122A, P1151, P1152, P1161, P1172A, P1172B, P1181, P1182A, P1202, P1212, P1231A, P1241 and P1251.
CE-02	Conduits P1501, P1502, P1511 and P1514 routed through LP-SH, instead of LP-HW. Updated ductbank reference for conduit P1611. Removed conduit P1533 to FV-1533. Added conduits P1531, P1532, P1533 and P1541 to EQ basin pumps and flow meter.
CE-04	Updated handhole and ductbank routing for conduits C1112, C1112A, C1122, C1122A, C1172, C1182, C1202, C1212, C1231, C1241 and C1251.
CE-05	Updated conduit C1503, C1504, C1511 and C1514 to route through RIO-SH. Removed conduit C1534. Added conduit C1531. Updated ductbank routing for conduit C1611.
CE-07	Removed conduit S1533. Updated conduits S1501 and S1502 to route through RIO-SH. Added conduits S1541 and S1541A. Updated handhole and ductbank routing for conduit S1114, S1124 and S1161.
CE-09	Updated ductbank routing for conduit F1161.
CE-10	Removed conduit SP1533. Updated conduits SP1501 and SP1503 to route through RIO-SH. Updated handhole and ductbank routing for conduits SP1101, SP1112, SP1114, SP1161, SP1511 and SP1514. Added conduits SP0303 and SP0304.
CE-11	Removed conduit S1533+. Updated combined conduit P1501+ to include P1541 and route through LP-SH. Updated combined conduit C1503+ to route through RIO-SH. Updated combined conduit S1501+ to include S1541 and route through RIO-SH. Updated ductbank routing for conduit P1101+.
CE-13	Removed HH-50A and rerouted conduits to HH-104 and HH-104A. Updated routing to handholes HH-104 and HH-104A.
CE-14	Updated routing for handholes HH-104 and HH-104A. Removed HH-50 routing.
CE-18	Removed EQ return valve vault conduits and equipment. Removed handholes HH-106 and HH-106A. Relocated EQ basin level sensors and level switches.
CE-26	Added MCC-EQ. Updated HH-303 and added HH-303A to show conduit routing for equipment in EQ Basin Pump Station and relocated level sensors and switches.
CE-28	Removed ductbanks DB-101.1 and DB-50.
CE-29	Removed ductbank DB-106. Updated ductbanks DB-104, DB-104.1, DB-104.2 and DB-104.3. Added ductbanks DB-104.4 and DB-104.5.
CE-30	Updated DB-303.1 to add new conduits. Added DB-303.2 and DB-303.3.

NO.	DATE	DESIGN	CHECKED
C	7/3/18	ASB	BPK
1	7/2/19	ASB	SLB
2	10/1/19	ASB	SLB

CITY OF BEAUMONT
SALT MITIGATION WWTW UPGRADE
CIVIL
AREA 2 GRADING AND PAVING PLAN







ALBERT A. WEBB & ASSOCIATES
CIVIL ENGINEERS

SHEET
C-4

- CONSTRUCTION NOTES
- (10) CONSTRUCT 4" AC PAVEMENT OVER 6" AB-CLASS II BASE AND DETAIL 124 ON SHEET NO. CD-3.
 - (102) CONSTRUCT 8" CONCRETE OVER 6" AB-CLASS II BASE AND DETAIL 122 ON SHEET NO. CD-3.
 - (103) INSTALL 3" OF 3/4" CRUSHED ROCK OVER COMPACTED NATIVE CD-4.
 - (104) SAWCUT EXISTING AC PAVEMENT AND JOIN PER DETAIL 131 ON SHEET NO. CD-4.
 - (105) CONSTRUCT 6" CURB & GUTTER PER COUNTY OF RIVERSIDE STD. DWG. 200
 - (106) CONSTRUCT 6" "D" CURB PER COUNTY OF RIVERSIDE STD. DWG. 204
 - (107) CONSTRUCT DRAINWAY APPROACH PER COUNTY OF RIVERSIDE STD. DWG. 207
 - (109) CONSTRUCT 2" CROSS GUTTER PER DETAIL 129 ON SHEET NO. CD-4.
 - (11) CONSTRUCT 4" CROSS GUTTER PER DETAIL 128 ON SHEET NO. CD-4.
 - (11) CONSTRUCT REDWOOD HEADER PER DETAIL 128 ON SHEET NO. CD-4.
 - (12) CONSTRUCT RETAINING WALL TYPE 1 (CASE 1) PER CALTRANS STANDARD 83-1A
 - (15) INSTALL CATCH BASIN PER DETAIL 112 AND 113 ON SHEET NO. CD-2.
 - (19) CONSTRUCT STANDARD PIPE BOLLARD PER DETAIL 120 ON SHEET NO. CD-3.
 - (25) CONSTRUCT CONCRETE LANDING PER DETAIL 122 ON SHEET NO. CD-3.
 - (50) EXISTING AC PAVEMENT
 - (54) EXISTING UTILITY VAULT, PROTECT IN PLACE UNLESS A TRAFFIC RATED CONVERSION IS NEEDED, TO BE ASSESSED ON SITE.
 - (55) EXISTING MANHOLE, PROTECT IN PLACE, ADJUST TO GRADE AS REQUIRED.
 - (58) EXISTING CURB

COORDINATE TABLE


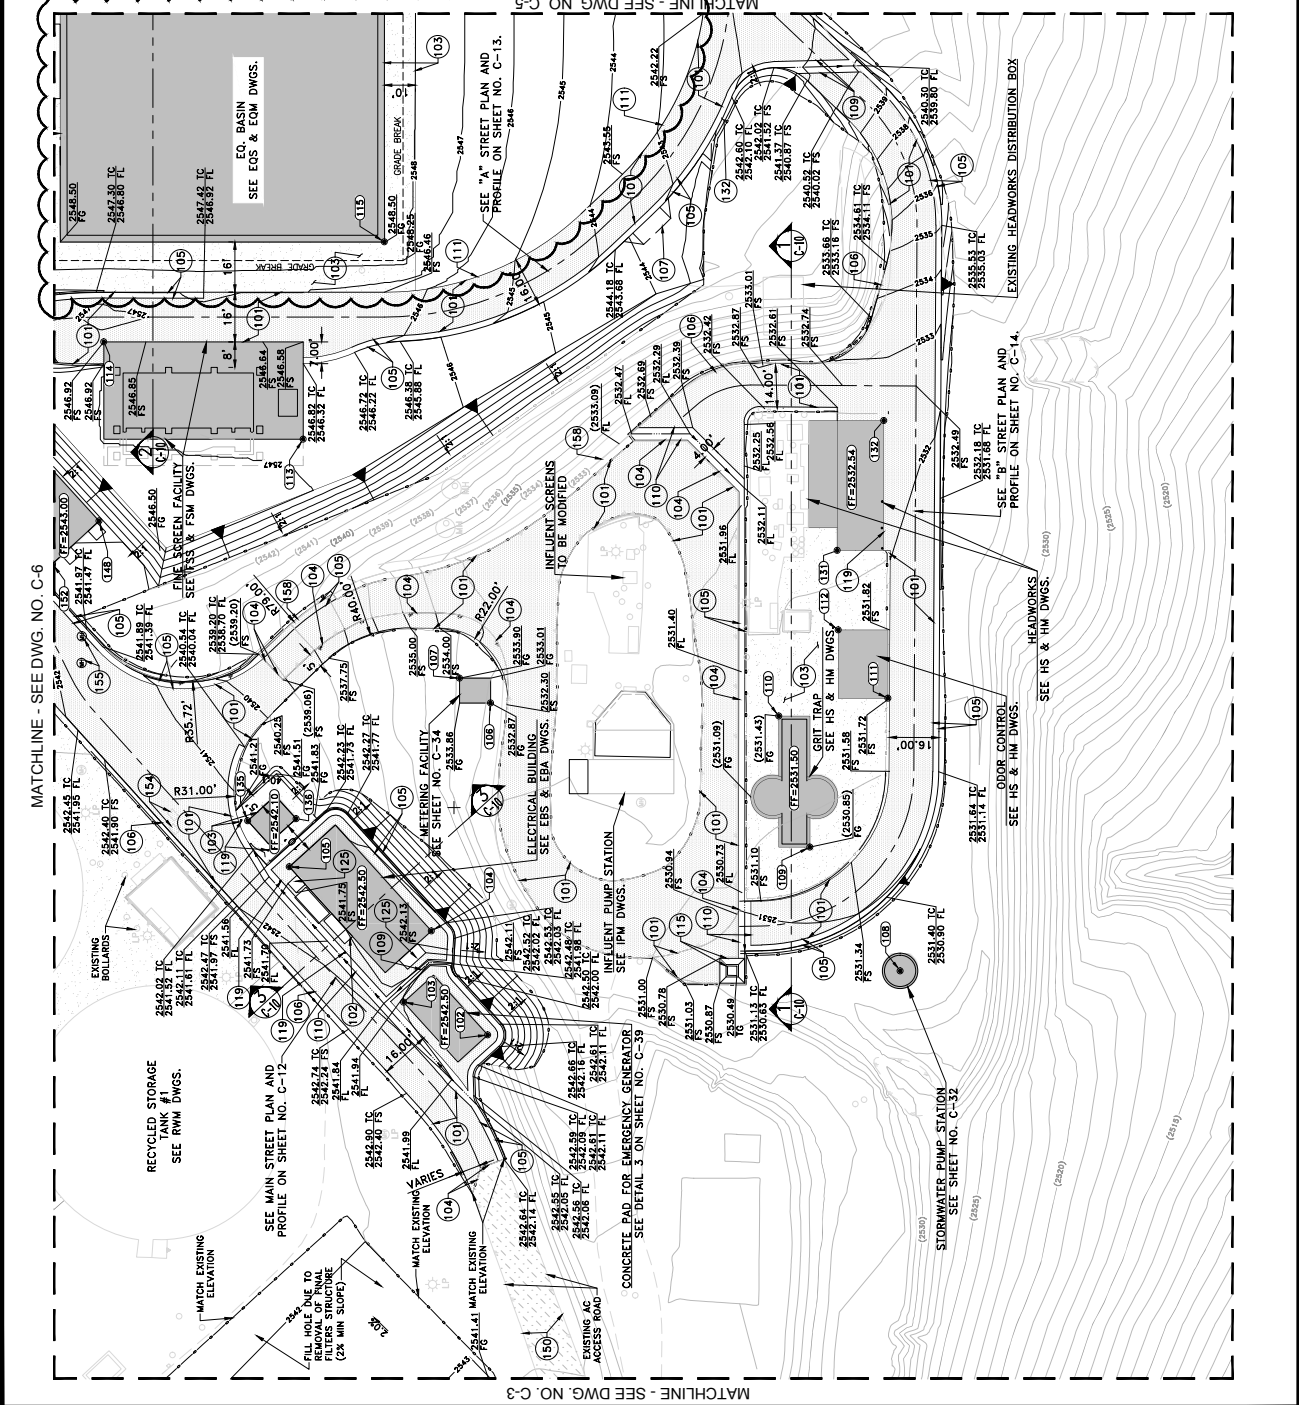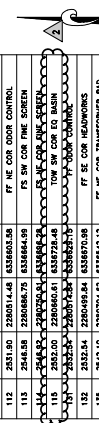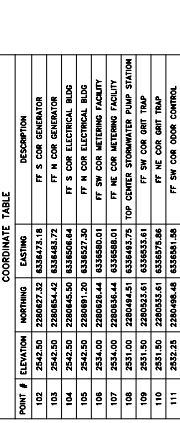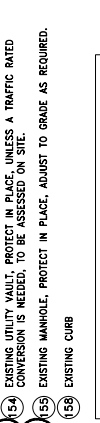

MATCHLINE - SEE DWG. NO. C-6

MATCHLINE - SEE DWG. NO. C-3

MATCHLINE - SEE DWG. NO. C-3

NO.	DATE	DESIGN	CHECKED
C	8/9/18	ASB	BRK
1	10/11/19	ASB	SLB

CITY OF BEAUMONT
SALT MITIGATION W/TP UPGRADE
CIVIL
AREA 3 GRADING AND PAVING PLAN




ALBERT A. WEBB & ASSOCIATES
ENGINEERING CONSULTANTS
CIVIL ENGINEERS
3788 McCLAY STREET

SHEET
C-5

CONSTRUCTION NOTES

- (10) CONSTRUCT 4" AC PAVEMENT OVER 6" AB-CLASS II BASE AND DETAIL 124 ON SHEET NO. CD-3.
- (11) INSTALL 3" OF 3/4" CRUSHED ROCK OVER COMPACTED NATIVE DWG. 200
- (12) CONSTRUCT 6" CURB & GUTTER PER COUNTY OF RIVERSIDE STD. DWG. 200
- (13) CONSTRUCT 6" "D" CURB PER COUNTY OF RIVERSIDE STD. DWG. 204
- (14) CONSTRUCT 4" CROSS GUTTER PER DETAIL 128 ON SHEET NO. CD-4.
- (15) CONSTRUCT REDWOOD HEADER PER DETAIL 125 ON SHEET NO. CD-3.
- (16) INSTALL GRAVEL SWALE PER DETAIL 130 ON SHEET NO. CD-4.
- (17) CONSTRUCT CATCH BASIN NO. 1 PER RCFORMED STD. DWG. NO. CR100 AND LOCAL DEPRESSION PER LD201 CASE "B".
- (18) CONSTRUCT SWALE TO CURB TRANSITION PER DETAIL 134 ON SHEET NO. CD-4.
- (19) EXISTING RETAINING WALL
- (20) EXISTING Y-DITCH
- (21) EXISTING FENCE

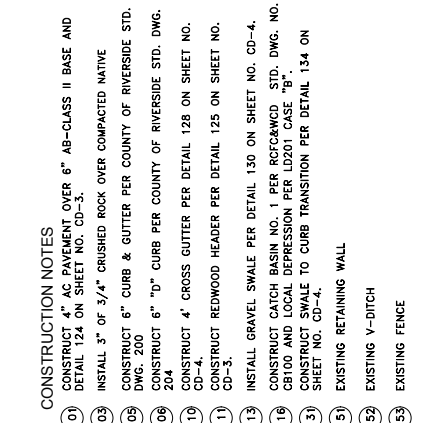

COORDINATE TABLE

POINT #	ELEVATION	NORTHING	EASTING	DESCRIPTION
118	2532.00	2280765.11	8338864.64	TOW NE COR E2 BASIN



MATCHLINE - SEE DWG. NO. C-7

SEE "E" STREET PLAN AND PROFILE ON DWG. NO. C-15.


SEE "A" STREET PLAN AND PROFILE ON DWG. NO. C-13.

SEE "B" STREET PLAN AND PROFILE ON DWG. NO. C-14.

CO. BASIN
SEE EGS & EOM DWGS.

GRADE BREAK

GRADE BREAK

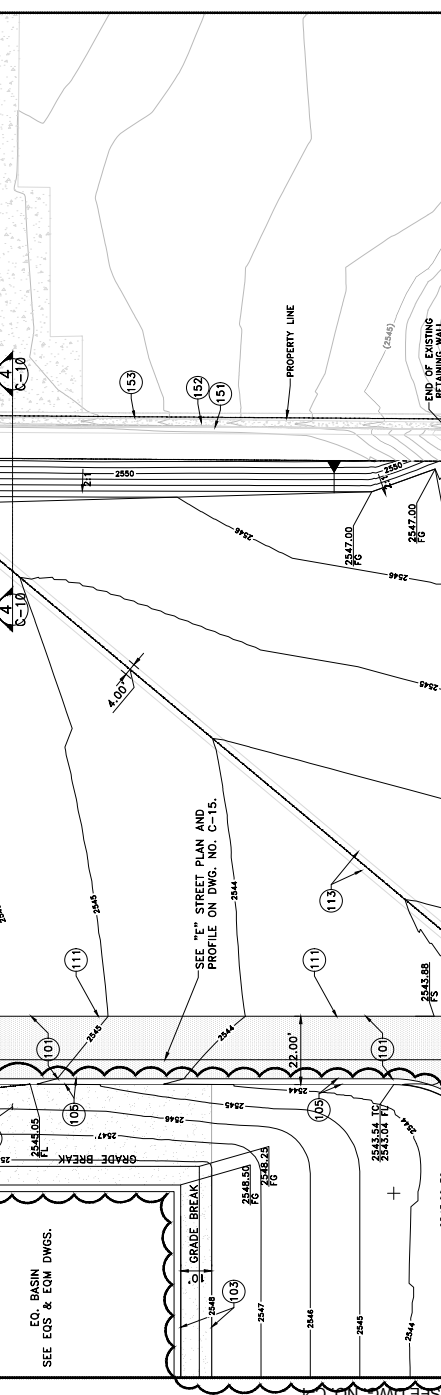


MATCHLINE - SEE DWG. NO. C-4


NO.	DATE	DESIGN	DRAWN	CHECKED	REVISIONS
C	9/2/18	SLB	ASB	BRP	
1	2/11/19	ASB	ASB	SLB	
2	7/26/19	ASB	ASB	SLB	
3	10/11/19	ASB	ASB	SLB	

CONSTRUCTION NOTES

101. CONSTRUCT 4" AC PAVEMENT OVER 6" AB-CLASS II BASE AND DETAIL 124 ON SHEET NO. CD-3.
102. INSTALL 3" OF 3/4" CRUSHED ROCK OVER COMPACTED NATIVE STD. DWG. 204.
103. CONSTRUCT 6" CURB & GUTTER PER COUNTY OF RIVERSIDE STD. DWG. 204.
104. CONSTRUCT 6" "D" CURB PER COUNTY OF RIVERSIDE STD. DWG. NO. 207.
105. CONSTRUCT DRIVEWAY APPROACH PER COUNTY OF RIVERSIDE STD. DWG. NO. 207.
106. CONSTRUCT 4" CROSS GUTTER PER DETAIL 128 ON SHEET NO. CD-4.
107. CONSTRUCT REDWOOD HEADER PER DETAIL 125 ON SHEET NO. CD-3.
108. CONSTRUCT RETAINING WALL TYPE 1 (CASE 1) PER CALTRANS STANDARD B3-1A.
109. INSTALL GRAVEL SWALE PER DETAIL 130 ON SHEET NO. CD-4.
110. INSTALL CATCH BASIN PER DETAIL 112 AND 113 ON SHEET NO. CD-2.
111. CONSTRUCT CATCH BASIN NO. 1 PER RCFCAWCD STD. DWG. NO. C8100 AND LOCAL DEPRESSION PER LD201 CASE "B".
112. CONSTRUCT STANDARD PIPE BOLLARD PER DETAIL 120 ON SHEET NO. CD-3.
113. CONSTRUCT 5" EXTENDED SIDEWALK PER DETAIL 127 ON SHEET NO. CD-3.
114. CONSTRUCT SIDEWALK PER DETAIL 128 ON SHEET. NO. CD-3.
115. CONSTRUCT CONCRETE APPROACH PER DETAIL PER DETAIL 121 ON SHEET NO. CD-3.
116. CONSTRUCT CONCRETE LANDING PER DETAIL 122 ON SHEET NO. CD-3.
117. INSTALL HANDICAPPED STALL PER DETAIL 132 ON SHEET NO. CD-4.
118. EXISTING AC PAVEMENT.
119. EXISTING V-DITCH.
120. EXISTING FENCE.
121. EXISTING MANHOLE, PROTECT IN PLACE, ADJUST TO GRADE AS REQUIRED.
122. EXISTING UTILITY VAULT, TO BE RELOCATED.

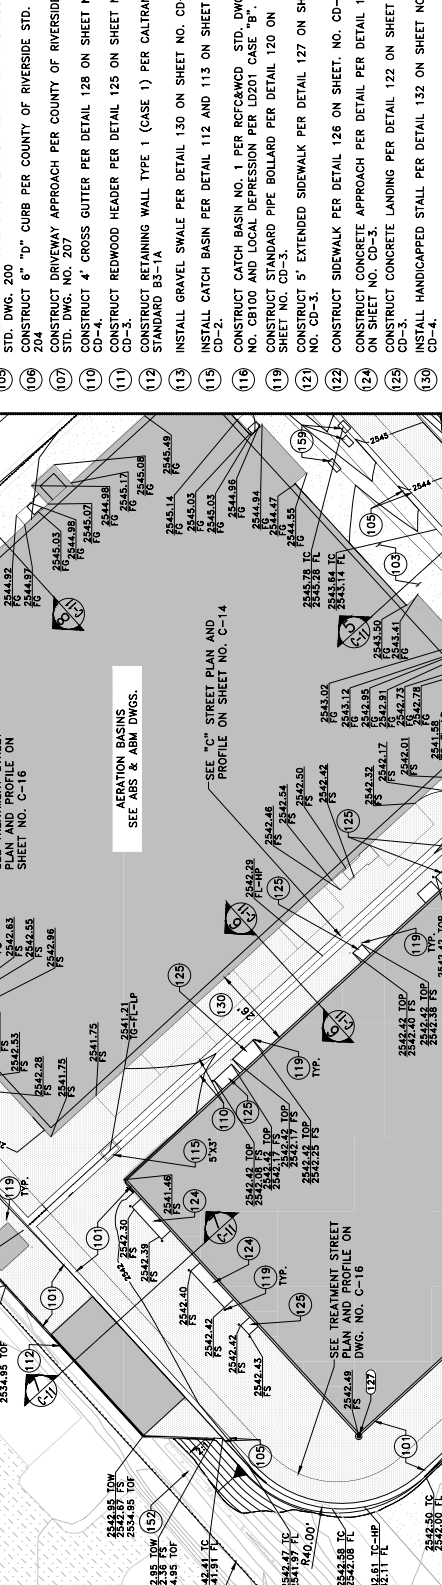


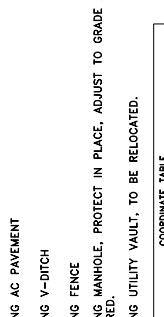



AREA 1
AREA 2
AREA 3
AREA 4
AREA 5
AREA 6
AREA 7
AREA 8

SCALE: 1" = 20'

DRAWING IS TO SCALE
1" = 10' HORIZONTAL
1/2" = 10' VERTICAL

MATCHLINE - SEE DWG. NO. C-4

NO.	DATE	DESIGN	DRAWN	CHECKED
C	9/3/18	SLB	ASB	BRK
1	10/11/19	ASB	ASB	SLB

CITY OF BEAUMONT
SALT MITIGATION W/TP UPGRADE
CIVIL
AREA 6 GRADING AND PAVING PLAN



ALBERT A. WEBB ASSOCIATES
ENGINEERING CONSULTANTS
CIVIL ENGINEERS
533 W 2600 S, SUITE 275, BOUNTIFUL, UT 84010



SHEET
C-7

CONSTRUCTION NOTES

- (10) CONSTRUCT 4" AC PAVEMENT OVER 6" AB-CLASS II BASE AND DETAIL 124 ON SHEET NO. CD-5.
- (101) INSTALL 3" OF 3/4" CRUSHED ROCK OVER COMPACTED NATIVE
- (105) CONSTRUCT 6" CURB & GUTTER PER COUNTY OF RIVERSIDE STD. DWG. 200
- (106) CONSTRUCT 6" "D" CURB PER COUNTY OF RIVERSIDE STD. DWG. 204
- (11) CONSTRUCT 4" CROSS GUTTER PER DETAIL 128 ON SHEET NO. CD-4.
- (111) CONSTRUCT REDWOOD HEADER PER DETAIL 125 ON SHEET NO. CD-3.
- (113) INSTALL GRAVEL SWALE PER DETAIL 130 ON SHEET NO. CD-4.
- (116) CONSTRUCT CATCH BASIN NO. 1 PER R/CRAWCD STD. DWG. NO. CB100 AND LOCAL DEPRESSION PER LD201 CASE "B".
- (122) CONSTRUCT SIDEWALK PER DETAIL 126 ON SHEET NO. CD-3.
- (124) CONSTRUCT CONCRETE APPROACH PER DETAIL PER DETAIL 121 ON SHEET NO. CD-5.
- (152) EXISTING RETAINING WALL
- (153) EXISTING V-DITCH
- (155) EXISTING FENCE
- (155) EXISTING MANHOLE, PROTECT IN PLACE, ADJUST TO GRADE AS REQUIRED.

COORDINATE TABLE

POINT #	ELEVATION	NORTHING	EASTING	DESCRIPTION
121	2548.88	2285925.01	6338818.51	FF NW COR SOLIDS HANDLING BUILDING
122	2548.88	2285973.01	6338974.35	FF SE COR SOLIDS HANDLING BUILDING
123	2548.88	2285883.35	6338974.35	FF SW COR SOLIDS HANDLING FACILITY
124	2548.88	2285925.01	6338818.51	FF NE COR SOLIDS HANDLING BUILDING
125	2548.78	2285913.79	6338803.51	TOP NW COR TRANSFORMER VAULT
126	2548.78	2285907.79	6338813.51	TOP SE COR TRANSFORMER VAULT

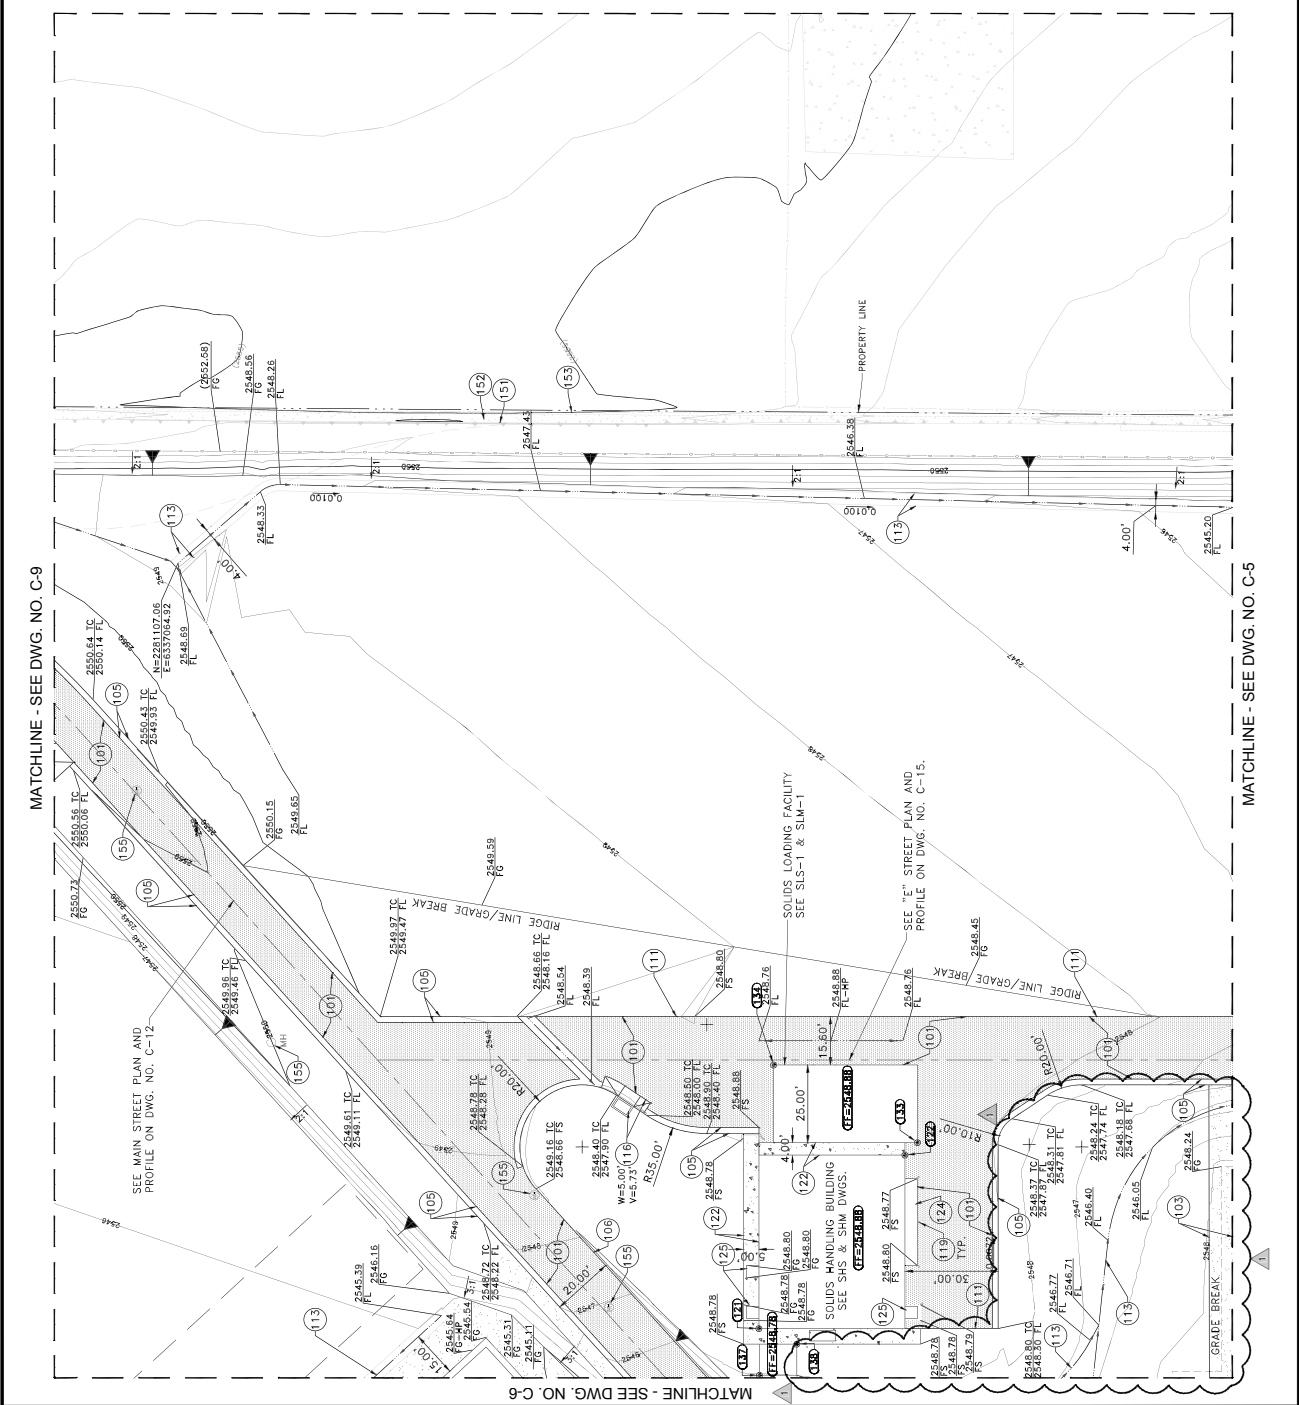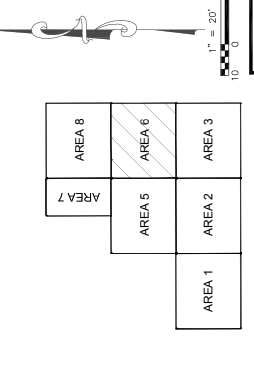

MATCHLINE - SEE DWG. NO. C-6
MATCHLINE - SEE DWG. NO. C-9
MATCHLINE - SEE DWG. NO. C-12
MATCHLINE - SEE DWG. NO. C-15


NO.	DATE	DESIGN	DRAWN	CHECKED
C	9/2/18	SLB	SLB	BRK
1	10/11/19	SLB	SLB	BRK

CITY OF BEAUMONT
SALT MITIGATION WWTP UPGRADE
CIVIL
AREA 2 YARD PIPING PLAN





C-20
SHEET/SUB

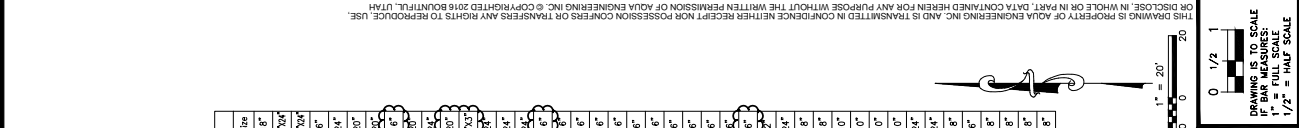

Point No.	N	E	Inv. Elev.	Fitting	Size
7	2280739.48	6338773.83	2536.50	WE	18"
8	2280738.58	6338391.48	2536.50	REDUCER	18"
9	2280746.34	6338381.43	2536.50	REDUCER	18"
10	2280618.43	6338504.96	2535.50	45° BEND	6"
11	2280635.52	6338502.67	2527.46	45° BEND	24"
12	2280669.89	6338591.86	2529.83	45° BEND	20"
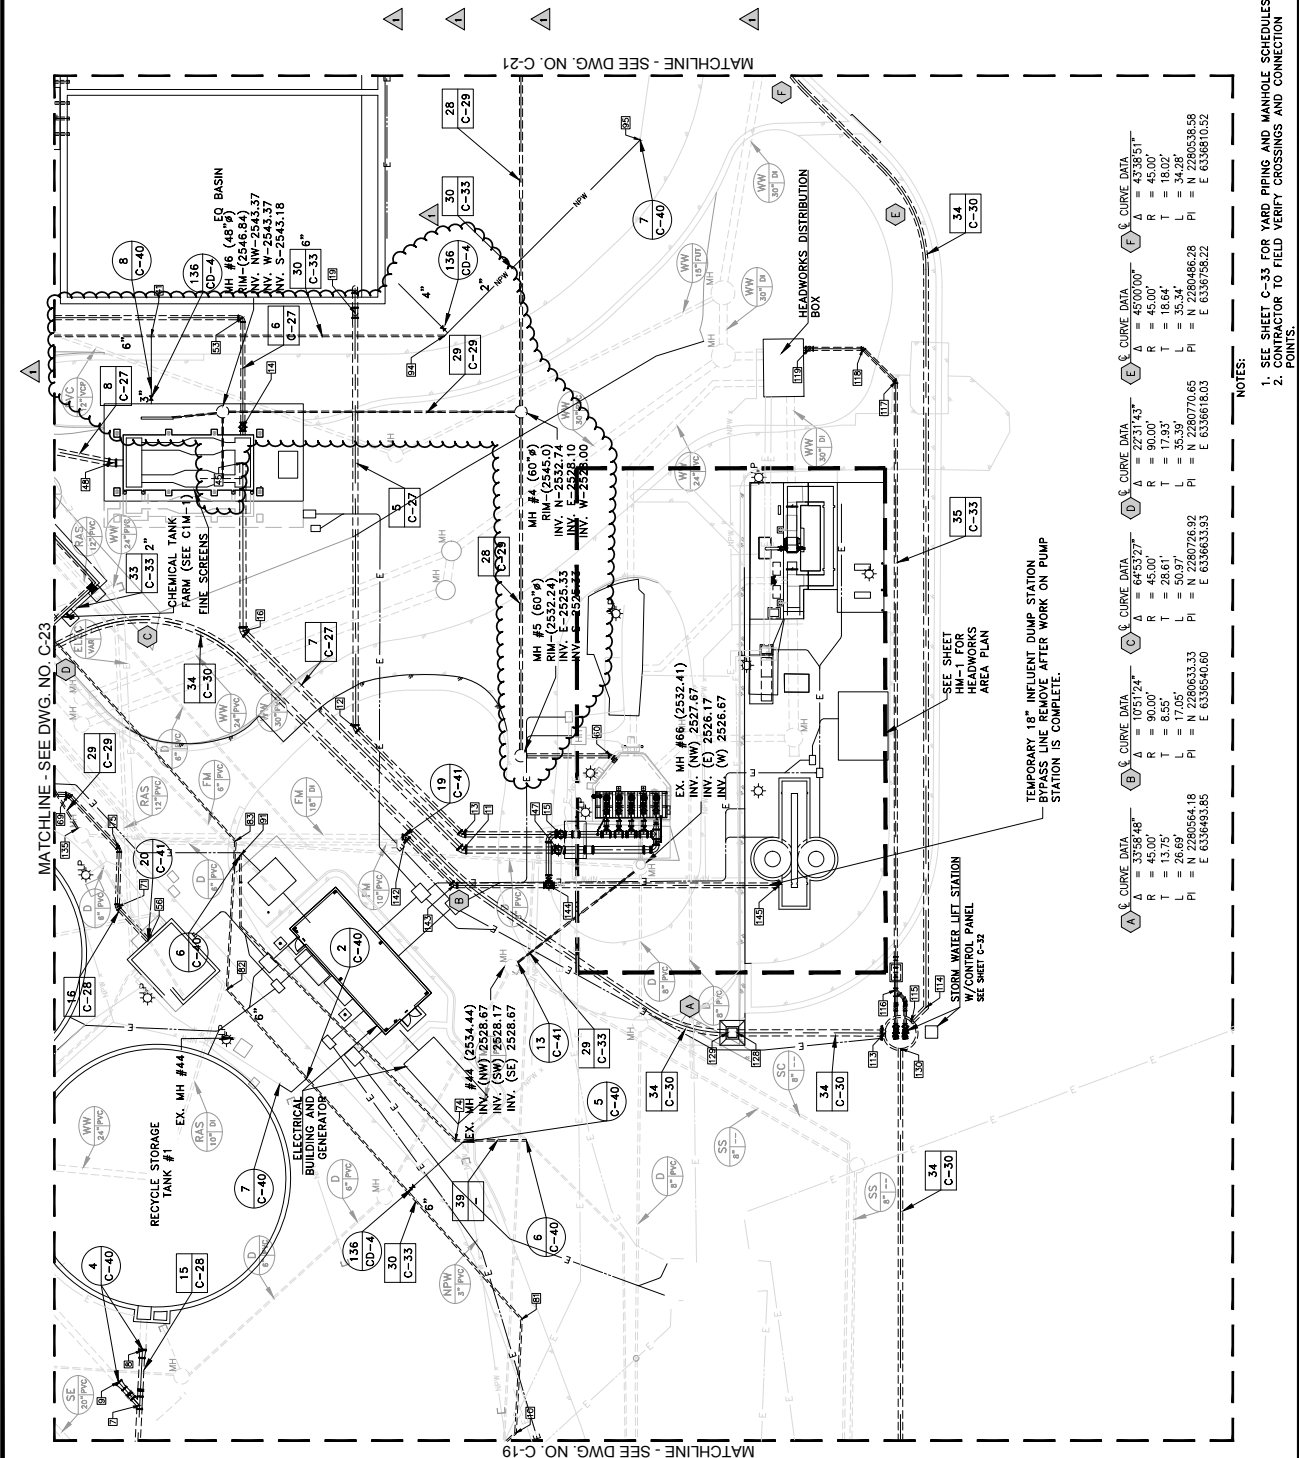

Curve Data	Curve Data	Curve Data	Curve Data	Curve Data	Curve Data


NOTES:
2. CONTACT FACTOR TO FIELD VERIFY CROSSINGS AND CONNECTION POINTS.


NO.	DATE	DESIGN	CHECKED
C	9/5/18	SLB	BPk
REVISIONS			
1	2/15/19	SLB	BPk
2	7/27/19	SLB	BPk
3	7/31/19	SLB	BPk
4	10/11/19	SLB	BPk



Point No.	N	E	Inv. Elev.	Fitting	Size
17	2280946.69	6336743.01	2537.00	90° BEND	8"
18	2280928.06	6336743.32	2536.32	45° BEND	8"
19	2280908.93	6336443.81	2535.32	45° BEND	8"
20	2280893.34	6336411.42	2535.25	—	4"
21	2280891.98	6336496.40	2537.00	TEE	8"
22	2280885.25	6336532.31	2537.00	90° BEND	8"
23	2280880.03	6336471.48	2537.00	90° BEND	8"
24	2280878.56	6336694.71	2535.29	45° BEND	8"
25	2280874.45	6336510.36	2535.00	—	24"
26	2280869.76	6336621.36	2535.50	—	12"
27	2280869.16	6336495.34	2526.00	90° BEND	48"
28	2281073.33	6336587.20	2526.00	—	48"
29	2281087.64	6336621.36	2526.00	—	48"
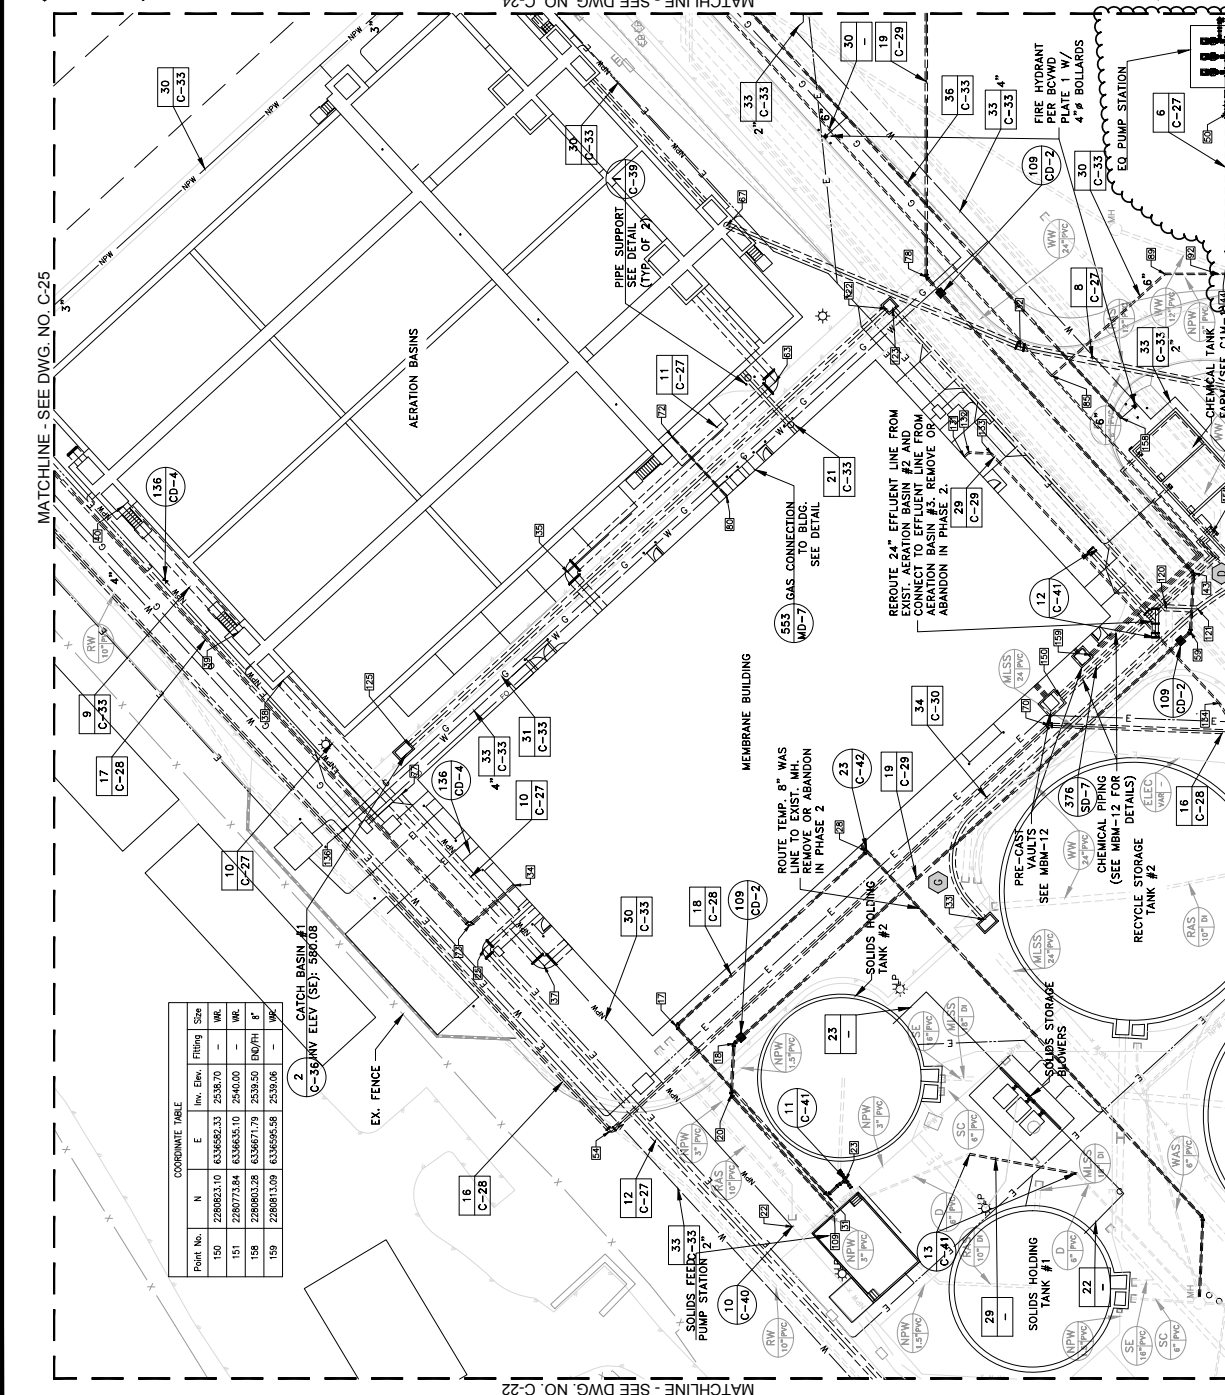

NOTES:
 1. SEE SHEET C-35 FOR YARD PIPING AND MANHOLE SCHEDULES.
 2. DRAIN AND AIR PURGE ALL SULFURIC ACID PIPING FOLLOWING HYDRO TESTING.
 3. FACTOR TO FIELD VERIFY CROSSINGS AND CONNECTION POINTS.

NO.	DATE	DESIGN	DRAWN	CHECKED
C	09/05/18	CM	SML	EN
REVISIONS				
10/11/19	CM	SML	EN	


CITY OF BAUMONT
SALT MITIGATION WWTFF UPGRADE
EQUILIZATION BASIN
STRUCTURAL PLAN




EQS-1
SHEET

THIS DRAWING IS PROPERTY OF AQUA ENGINEERING INC. AND IS TRANSMITTED IN CONFIDENCE NEITHER RECEIPT NOR POSSESSION CONFERS OR TRANSFERS ANY RIGHTS TO REPRODUCE, USE, OR DISCLOSE, IN WHOLE OR IN PART, DATA CONTAINED HEREIN FOR ANY PURPOSE WITHOUT THE WRITTEN PERMISSION OF AQUA ENGINEERING INC. © COPYRIGHTED 2018 BAUMONT, UTAH

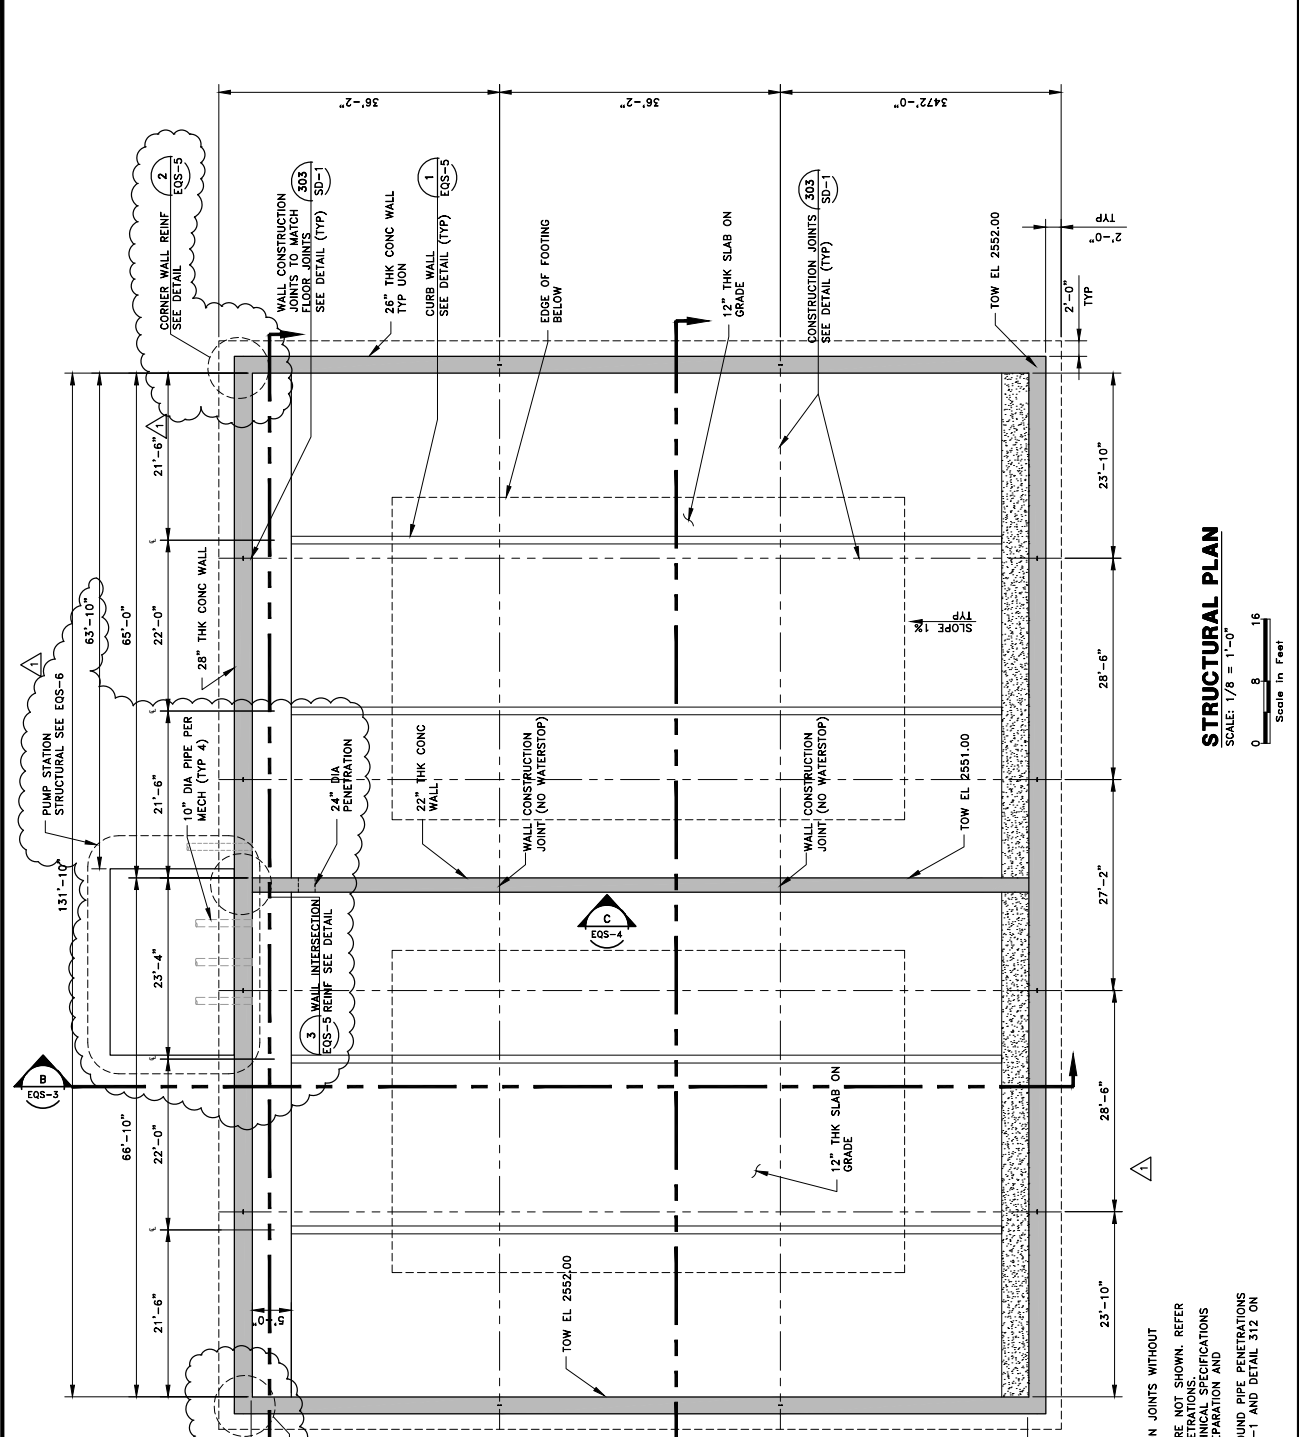

NOTES:

- DO NOT ADD OR ELIMINATE CONSTRUCTION JOINTS WITHOUT APPROVAL OF ENGINEER.
- PIPE PENETRATIONS SMALLER THAN 4" ARE NOT SHOWN. REFER TO MECHANICAL DRAWINGS FOR ALL PENETRATIONS.
- REFER TO SECTION 312000 OF THE TECHNICAL SPECIFICATIONS FOR DETAILS REGARDING SUB-GRADE PREPARATION AND REQUIREMENTS.
- PROVIDE ADDITIONAL REINFORCEMENT AROUND PIPE PENETRATIONS AS SHOWN IN DETAIL 305 ON SHEET SD-1 AND DETAIL 312 ON SHEET SD-2.


NO.	DATE	DESIGN	DRAWN	CHECKED
C	09/05/18	CM	SML	EM
REVISIONS				
10/11/19	CM	SML	EM	

CITY OF BEAUMONT
SALT MITIGATION WWT/P UPGRADE
EQUALIZATION BASIN
STRUCTURAL SECTION



EQS-3
 SHEET

THIS DRAWING IS PROPERTY OF AQUA ENGINEERING INC. AND IS TRANSMITTED IN CONFIDENCE. NEITHER RECEIPT NOR POSSESSION CONFERS OR TRANSFERS ANY RIGHTS TO REPRODUCE, USE, OR DISCLOSE, IN WHOLE OR IN PART, DATA CONTAINED HEREIN FOR ANY PURPOSE WITHOUT THE WRITTEN PERMISSION OF AQUA ENGINEERING INC. © COPYRIGHTED 2018 BOUNTIFUL, UT.

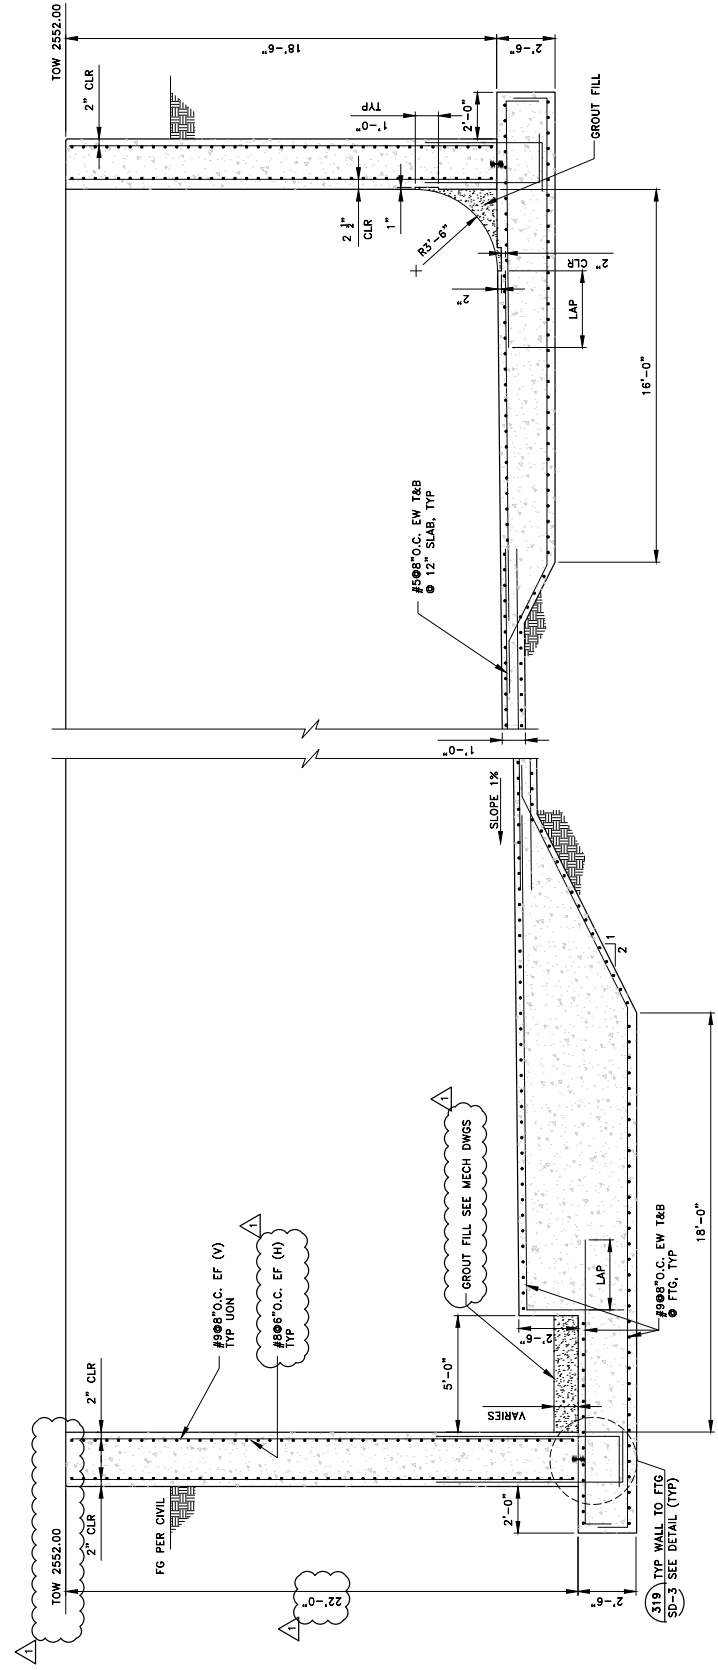

SEE **A** EQS-2 FOR INFO NOT SHOWN

SECTION B
 SCALE: 3/8" = 1'-0"
 EQS-1
 Scale in Feet

NO.	DATE	DESIGN	DRAWN	CHECKED
C	09/05/18	CM	SML	EN
REVISIONS				
△	10/11/19	CM	SML	EN


CITY OF BEAUMONT
SALT MITIGATION WWTP UPGRADE
EQUALIZATION BASIN
STRUCTURAL ELEVATION




EQS-4
 SHEET

THIS DRAWING IS PROPERTY OF AQUA ENGINEERING INC. AND IS TRANSMITTED IN CONFIDENCE. NEITHER RECEIPT NOR POSSESSION CONFERS OR TRANSFERS ANY RIGHTS TO REPRODUCE, USE, OR DISCLOSE, IN WHOLE OR IN PART, DATA CONTAINED HEREIN FOR ANY PURPOSE WITHOUT THE WRITTEN PERMISSION OF AQUA ENGINEERING INC. © COPYRIGHTED 2018 BOUNTIFUL, UT.

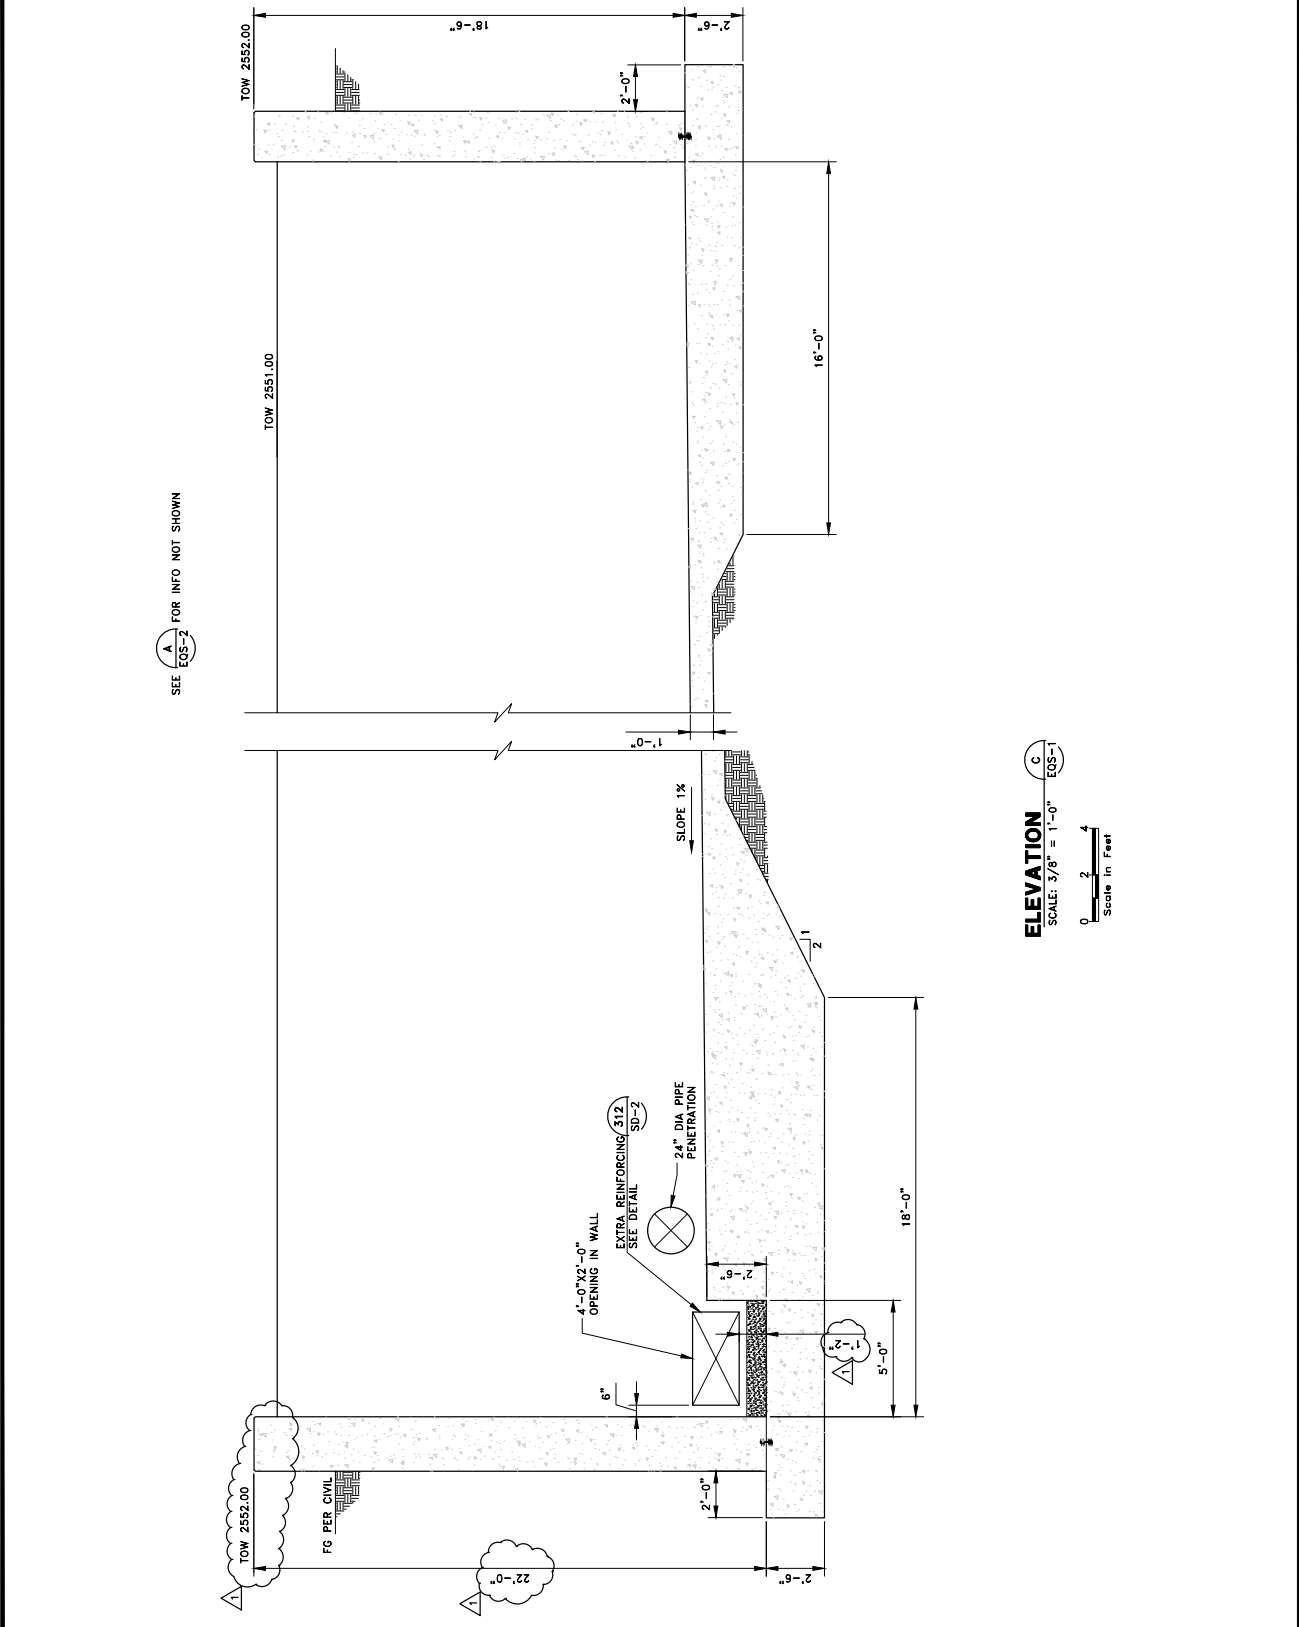

SEE **A** EQS-2 FOR INFO NOT SHOWN

ELEVATION
 SCALE: 3/8" = 1'-0" EQS-1
 Scale in Feet

NO.	DATE	DESIGN	DRAWN	CHECKED
C	09/05/18	CM	SML	EN
REVISIONS				
10/11/19	CM	SML	EN	

CITY OF BEAUMONT
SALT MITIGATION WWTP UPGRADE
EQUALIZATION BASIN
STRUCTURAL SECTION AND DETAIL




533 W. 2600 S. SUITE 275, BOUNTIFUL, UT 84010
 PHONE (801) 299-1237 FAX (801) 299-0153

ALBERT A. WEBB & ASSOCIATES
 CIVIL ENGINEERS


ENGINEERING CONSULTANTS

SHEET
EQS-5


THIS DRAWING IS PROPERTY OF AQUA ENGINEERING INC. AND IS TRANSMITTED IN CONFIDENCE. NEITHER RECEIPT NOR POSSESSION CONFERS OR TRANSFERS ANY RIGHTS TO REPRODUCE, USE, OR DISCLOSE, IN WHOLE OR IN PART, DATA CONTAINED HEREIN FOR ANY PURPOSE WITHOUT THE WRITTEN PERMISSION OF AQUA ENGINEERING INC. © COPYRIGHTED 2018 BOUNTIFUL, UT.

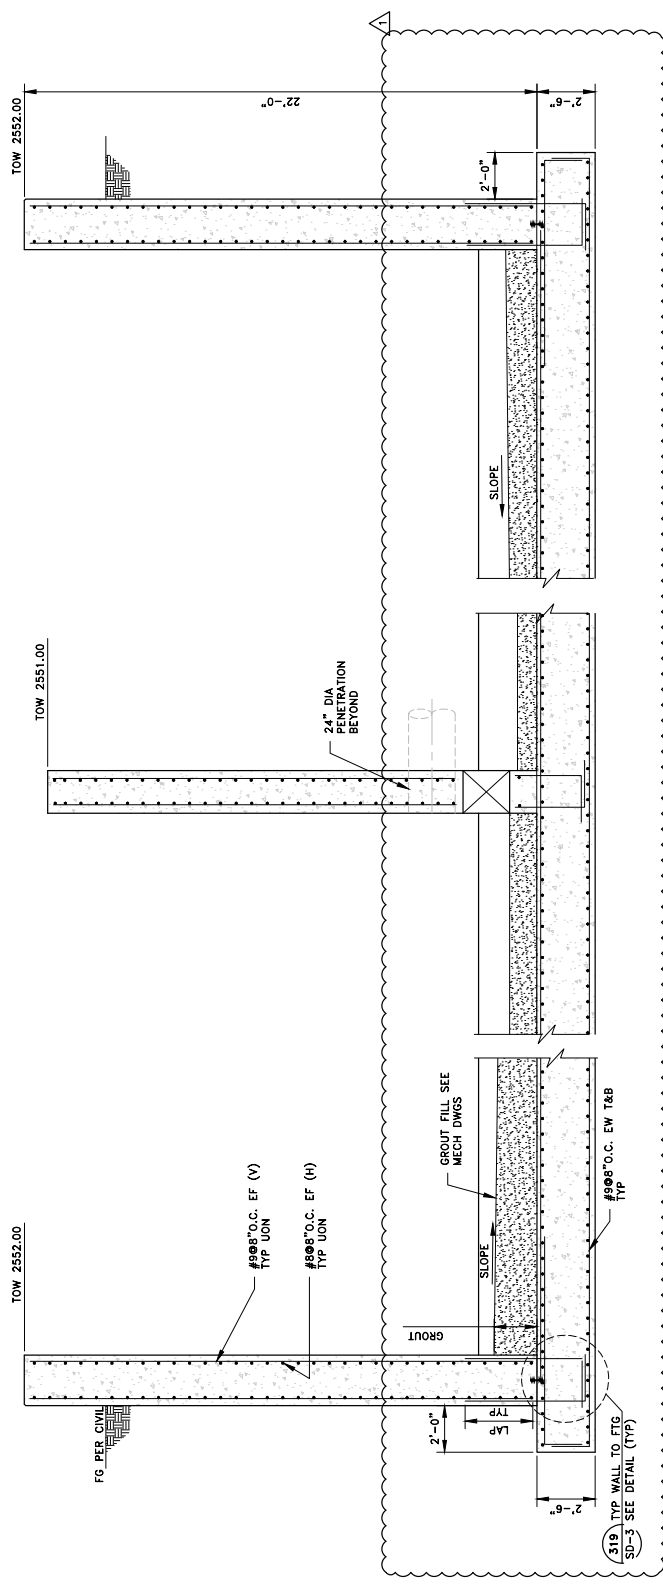


SECTION
 SCALE: 3/8" = 1'-0"
 Scale in Feet

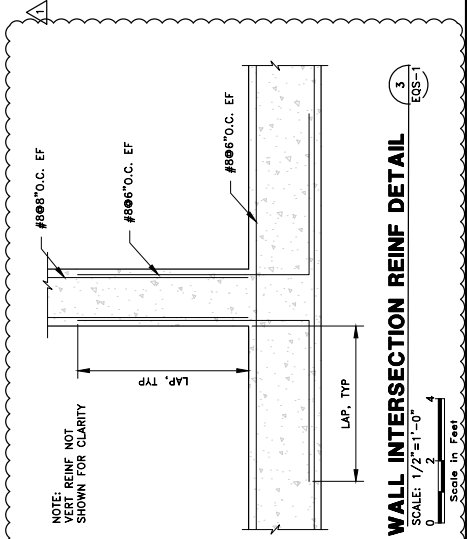

WALL INTERSECTION REINF DETAIL
 SCALE: 1/2" = 1'-0"
 Scale in Feet

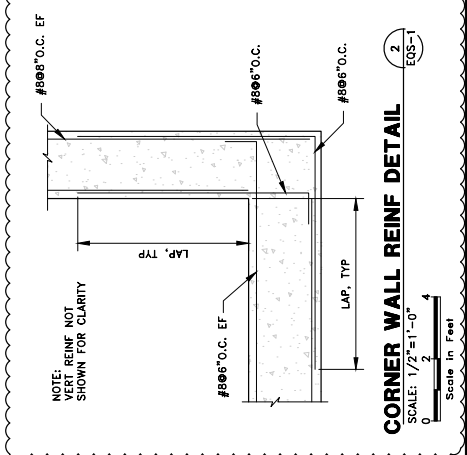

CORNER WALL REINF DETAIL
 SCALE: 1/2" = 1'-0"
 Scale in Feet

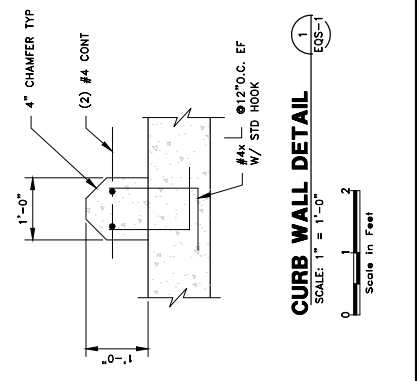

CURB WALL DETAIL
 SCALE: 1" = 1'-0"
 Scale in Feet

 SD-3 SEE DETAIL (TYP)

NO.	DATE	DESIGN	CHECKED
C	09/05/18	SML	EM
REVISIONS			
10/11/19	CM	SML	EM

CITY OF BEAUMONT
SALT MITIGATION WWT/P UPGRADE
EQUALIZATION BASIN
PUMP STATION STRUCTURAL PLAN

AQUA ENGINEERING

533 W. 2600 S. SUITE 275, BOUNTIFUL, UT 84010
 PHONE (801) 299-1227 FAX (801) 299-0153


ALBERT A. WEBB ASSOCIATES
ENGINEERING CONSULTANTS

4288 McCAW STREET
 BEAUMONT, CA 92506
 TEL (951) 966-1070
 FAX (951) 788-1256

EQS-6

SHEET

THIS SHEET ADDED FOR REVISION

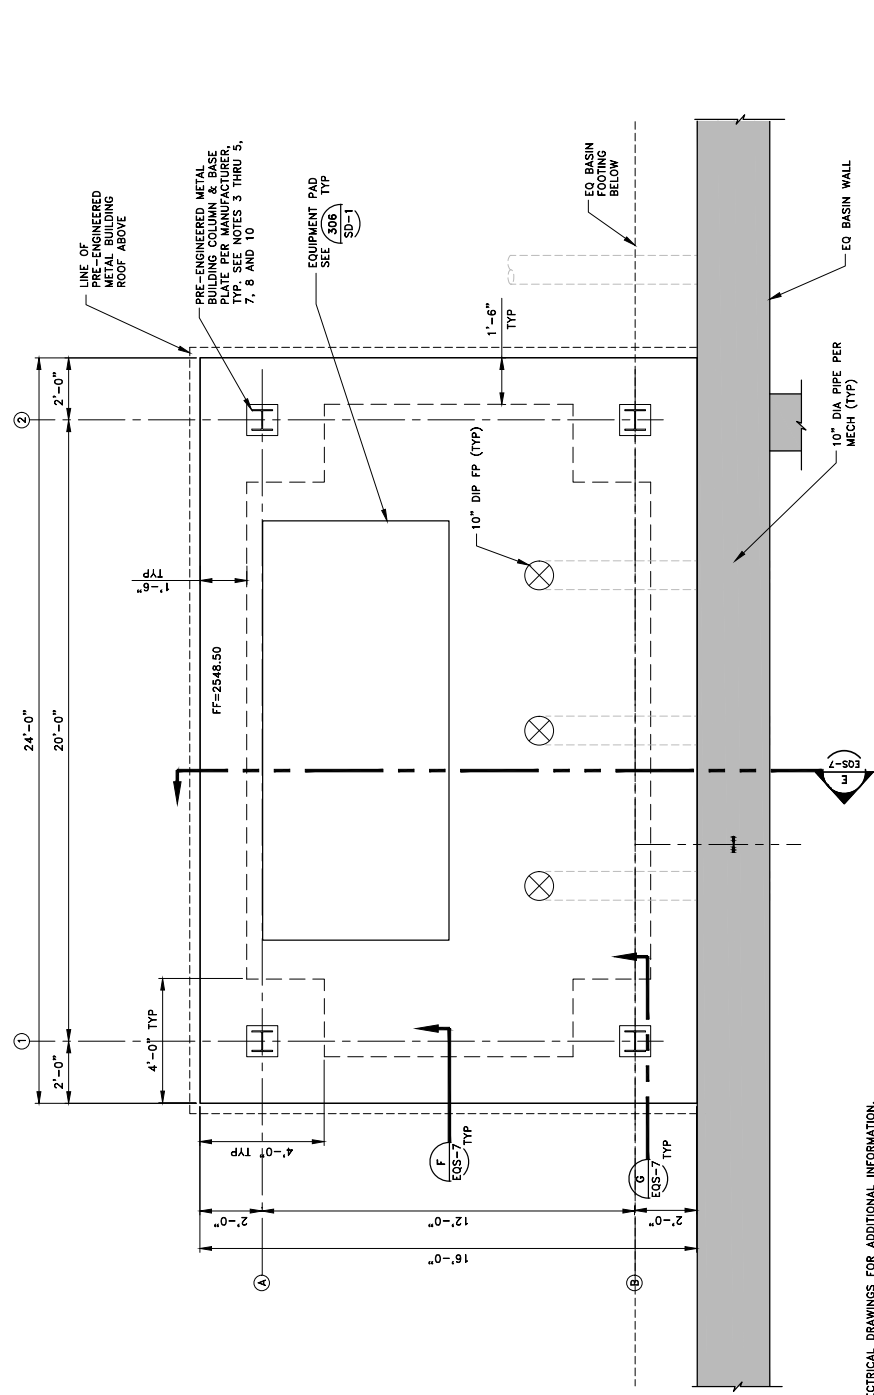

STRUCTURAL PLAN

SCALE: 1/2" = 1'-0"
 Scale in Feet

- NOTES:**
- SEE ARCHITECTURAL, MECHANICAL AND ELECTRICAL DRAWINGS FOR ADDITIONAL INFORMATION.
 - SEE MECHANICAL DRAWINGS FOR LOCATION, SIZE, AND ADDITIONAL INFORMATION REGARDING EQUIPMENT.
 - ALL STRUCTURAL MEMBERS OF THE PRE-ENGINEERED METAL BUILDING SHALL BE HOT-DIPPED GALVANIZED.
 - PRE-ENGINEERED METAL BUILDING COLUMN FOOTING DESIGN IS BASED ON PRELIMINARY LOADS. FINAL COLUMN FOOTING SIZES WILL BE VERIFIED BY THE SECOR AFTER THE RECEIPT OF OTHER PRE-ENGINEERED METAL BUILDING DEFERRED SUBMITTAL. FOOTING REVISIONS (IF ANY WILL BE ADDRESSED BY ADDENDUM OR REVISION).
 - NO COLUMNS FOR THE PRE-ENGINEERED METAL BUILDING SHALL BE MANUFACTURED OR SUBMITTED PRIOR TO SECOR REVIEW AND APPROVAL OF PRE-ENGINEERED BUILDING DEFERRED SUBMITTAL.
 - CONTRACTOR SHALL VERIFY ALL EQUIPMENT PAD SIZE, LOCATIONS, AND ANCHORING REQUIREMENTS WITH THE MANUFACTURER OR SUPPLIER.
 - ANCHOR BOLTS FOR PRE-ENGINEERED BUILDING AND EQUIPMENT SHALL BE:
 - DESIGNED, SEALED, AND SIGNED BY A CALIFORNIA LICENSED CIVIL OR STRUCTURAL ENGINEER. DESIGN SHALL BE SUBMITTED TO SECOR FOR REVIEW AND APPROVAL PRIOR TO INSTALLATION.
 - THE CONTRACTOR.
 - DESIGNER SHALL COORDINATE ANCHOR BOLT SIZE, SPACING, AND EMBEDMENT DEPTH WITH SUPPLIER REQUIREMENTS AND BASE MATERIAL & CONFIGURATION PER THESE DRAWINGS.
 - SEE SPECIFICATION SECTION 133400 FOR PRE-ENGINEERED METAL BUILDING REQUIREMENTS.
 - FOR SUBGRADE PREPARATION REQUIREMENTS SEE SPECIFICATION SECTION 312000.
 - FOR SUBGRADE PREPARATION REQUIREMENTS SEE SPECIFICATION SECTION 312000. PRE-ENGINEERED METAL BUILDING SHALL BE DESIGNED TO HAVE ALL OPEN BAYS, I.E. NO CROSS-BRACING ALLOWED.



THIS DRAWING IS PROPERTY OF AQUA ENGINEERING INC. AND IS TRANSMITTED IN CONFIDENCE NEITHER RECEIPT NOR POSSESSION CONFERS OR TRANSFERS ANY RIGHTS TO REPRODUCE, USE, OR DISCLOSE, IN WHOLE OR IN PART, DATA CONTAINED HEREIN FOR ANY PURPOSE WITHOUT THE WRITTEN PERMISSION OF AQUA ENGINEERING INC. © COPYRIGHTED 2018 BOUNTIFUL, UT, USA

NO.	DATE	DESIGN	DRAWN	CHECKED
C	09/05/18	CM	SML	EN
REVISIONS				
Δ	10/11/19	CM	SML	EN

CITY OF BEAUMONT
SALT MITIGATION WWT/P UPGRADE
EQUALIZATION BASIN
PUMP STATION STRUCTURAL SECTIONS




ALBERT A. WEBB ASSOCIATES
ENGINEERING CONSULTANTS
 CIVIL ENGINEERS
 1788 McCRAW STREET

SHEET
EQS-7


THIS DRAWING IS PROPERTY OF AQUA ENGINEERING INC. AND IS TRANSMITTED IN CONFIDENCE. NEITHER RECEIPT NOR POSSESSION CONFERS OR TRANSFERS ANY RIGHTS TO REPRODUCE, USE, OR DISCLOSE, IN WHOLE OR IN PART, DATA CONTAINED HEREIN FOR ANY PURPOSE WITHOUT THE WRITTEN PERMISSION OF AQUA ENGINEERING INC. © COPYRIGHTED 2018 BOUNTIFUL, UT.

THIS SHEET ADDED FOR REVISION


- NOTES:**
- SEE NOTES ON SHEET EQS-6.

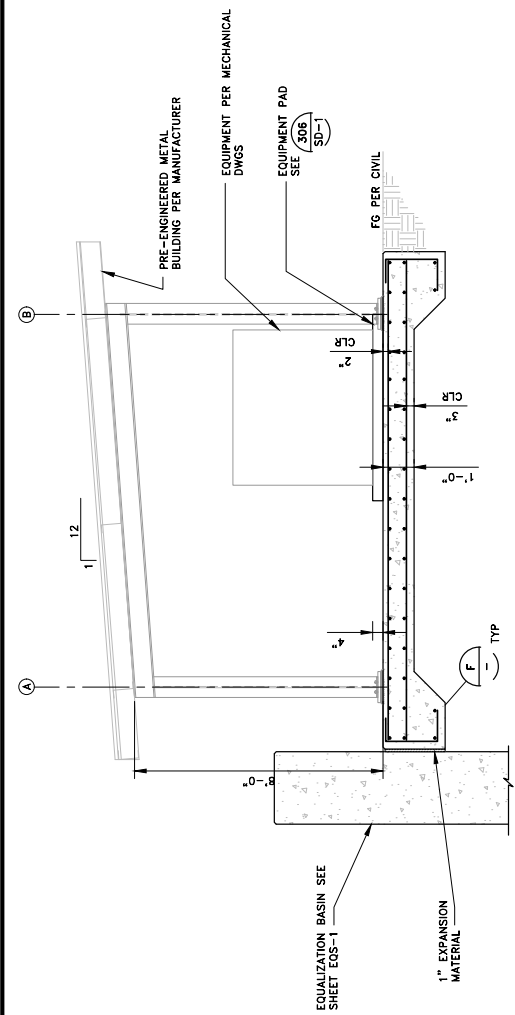

SECTION E
EQS-6
 SCALE: 1/2" = 1'-0"
 0 2 4
 Scale In Feet

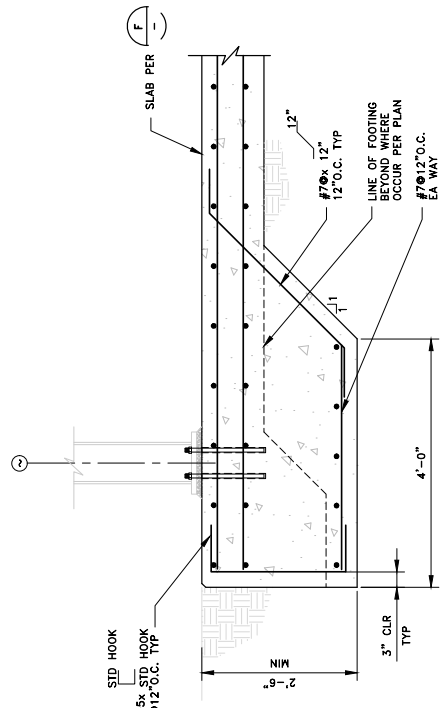

SECTION G
EQS-6
TYP COLUMN FOOTING SECTION
 SCALE: 1" = 1'-0"
 0 1 2
 Scale In Feet

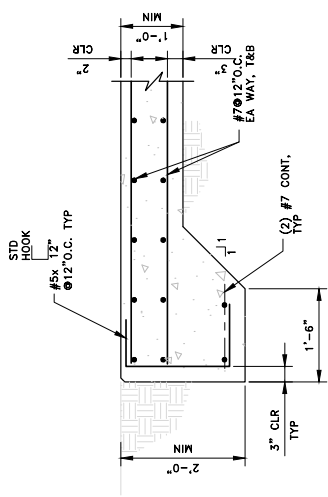

SECTION F
EQS-6
TYP TURN DOWN FOOTING SECTION
 SCALE: 1" = 1'-0"
 0 1 2
 Scale In Feet

DRAWING IS TO SCALE
 UNLESS NOTED OTHERWISE:
 1" = FULL SCALE
 1/2" = HALF SCALE



NO.	DATE	DESIGN	DRAWN	CHECKED
C	10/11/19	DPS	HCH	JRL
REVISIONS				

CITY OF BEAUMONT
 SALT MITIGATION WWTU UPGRADE
 EQUALIZATION BASIN
 PUMP STATION ROOF PLAN

533 W 2800 S, SUITE 275, BOUNTIFUL, UT 84010
 PHONE (801) 299-1227 FAX (801) 299-0153

ALBERT A. WEBB ASSOCIATES
 ENGINEERING CONSULTANTS
 CIVIL ENGINEERS
 1788 MCKAY STREET
 PH (951) 886-1070
 FX (951) 786-1256

EQS-8
 SHEET

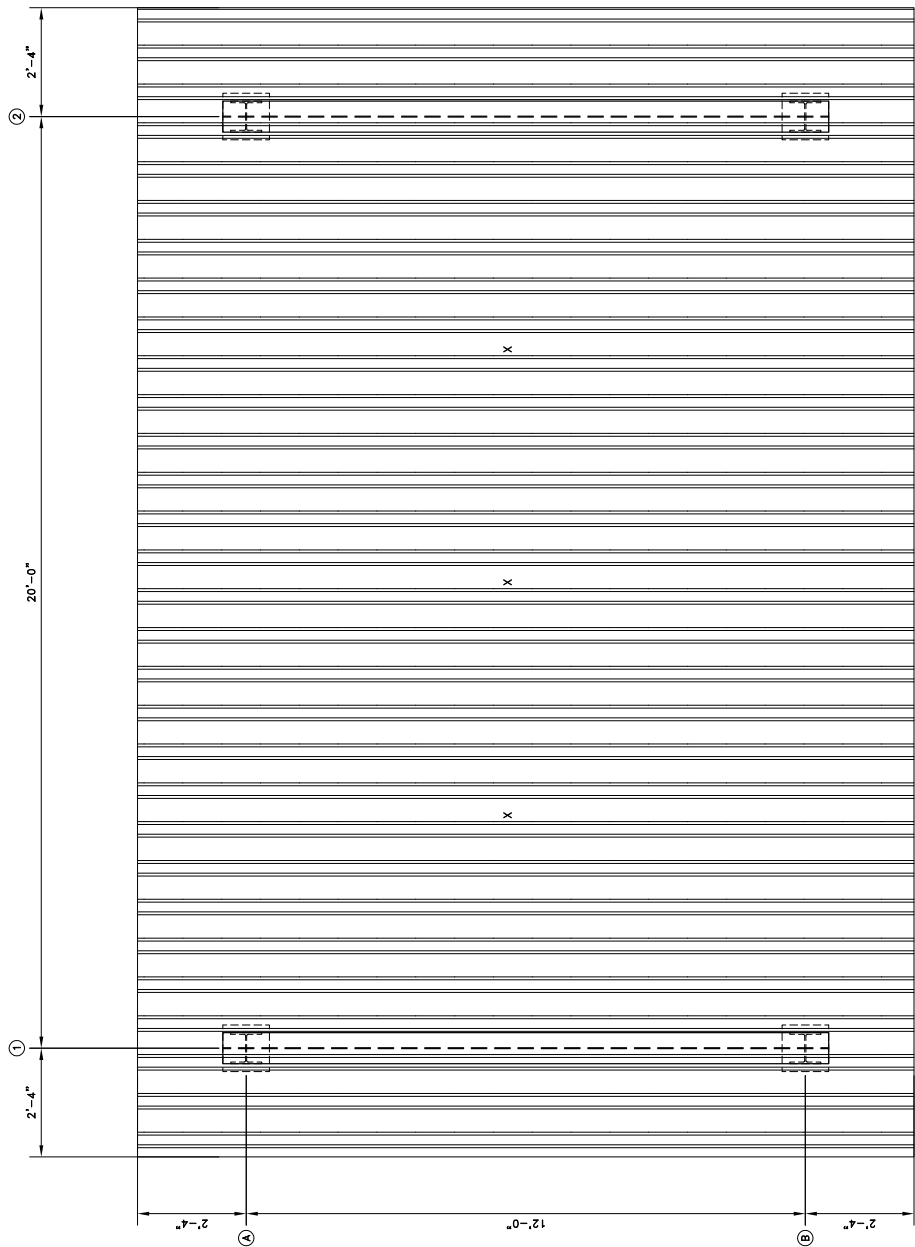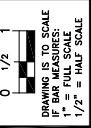

THIS SHEET HAS BEEN
 ADDED TO THE SET

NOTES:
 1. APPROXIMATE PIPE HANGER LOCATIONS ARE INDICATED WITH AN "X". POINT LOADS ARE ESTIMATED TO BE 1,000 LBS. CONTRACTOR SHALL COORDINATE FINAL LOCATIONS AND LOADS WITH PRE-ENGINEERED METAL BUILDING SUPPLIER.

ROOF PLAN
 SCALE: 3/4"=1'-0"
 0 1 2
 Scale in Feet



NO.	DATE	DESIGN	DRAWN	CHECKED
C	03/05/18	DPS	MSW	JRL
ORIGINAL				
REVISIONS				
1	10/11/19	DPS	DMS	JRL

CITY OF BEAUMONT
SALT MITIGATION WWTUP UPGRADE
EQUILIZATION BASIN
MECHANICAL PLAN

ENGINEERING
AQUA



533 W. 2600 S. SUITE 275, BOUNTIFUL, UT 84010
PHONE (801) 299-1227 FAX (801) 299-0153

ALBERT A. WEBB & ASSOCIATES
CIVIL ENGINEERS
3786 MCCRAY STREET
PHONE (951) 786-1256
FAX (951) 786-1256

ENGINEERING CONSULTANTS

SHEET
EQM-1

THIS DRAWING IS PROPERTY OF AQUA ENGINEERING INC. AND IS TRANSMITTED IN CONFIDENCE. NEITHER RECEIPT NOR POSSESSION CONFERES OR TRANSFERS ANY RIGHTS TO REPRODUCE, USE, OR DISCLOSE, IN WHOLE OR IN PART, DATA CONTAINED HEREIN FOR ANY PURPOSE WITHOUT THE WRITTEN PERMISSION OF AQUA ENGINEERING INC. © COPYRIGHTED 2018 BOUNTIFUL, UT

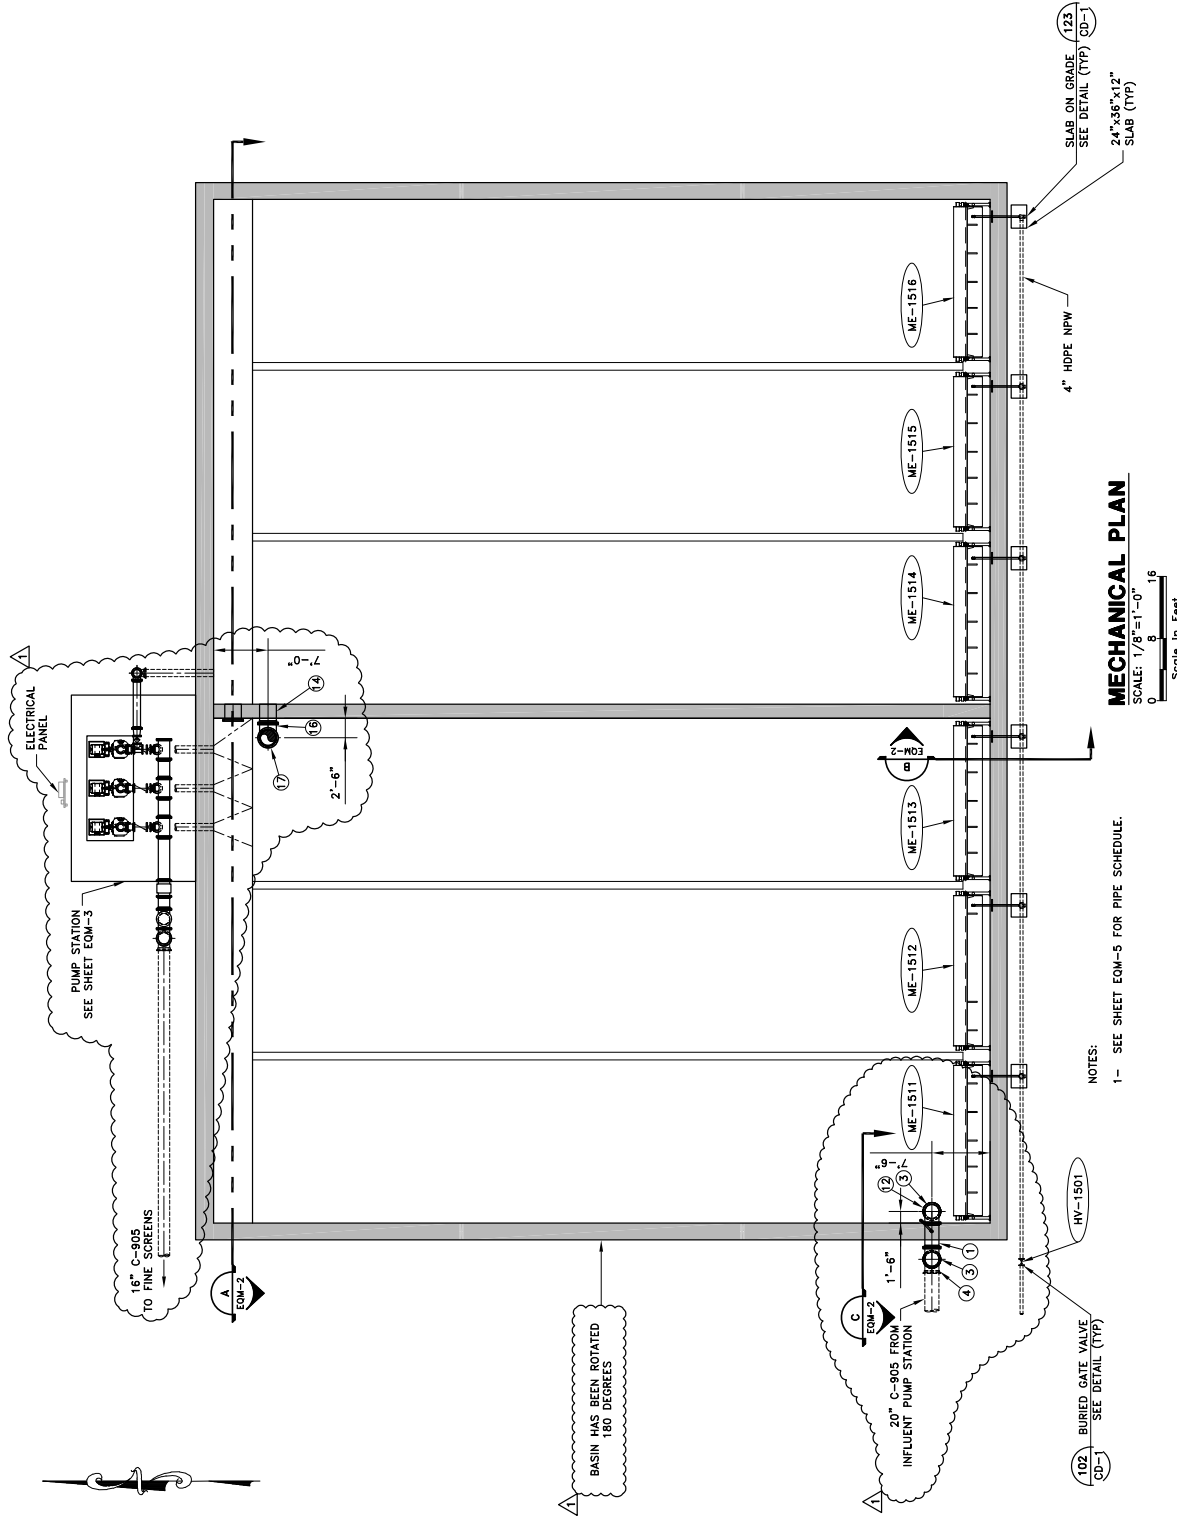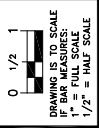

MECHANICAL PLAN
SCALE: 1/8"=1'-0"
0 8 16
Scale in Feet

NOTES:
1- SEE SHEET EQM-5 FOR PIPE SCHEDULE.

102 BURIED GATE VALVE
SEE DETAIL (TYP)

BASIN HAS BEEN ROTATED
180 DEGREES

NO.	DATE	DESIGN	DRAWN	CHECKED
C	09/05/18	DPS	BJP	JRL
ORIGINAL				
REVISIONS				
1	10/11/19	DPS	DNS	JRL


CITY OF BEAUMONT
SALT MITIGATION WWTUP UPGRADE
EQUIALIZATION BASIN
MECHANICAL SECTIONS




533 W 2600 S, SUITE 275, BOUNTIFUL, UT 84010
PHONE (801) 299-1237 FAX (801) 299-0153
ALBERT A. WEBB & ASSOCIATES
CIVIL ENGINEERS
PHONE (951) 886-1070
FAX (951) 786-1256
ENGINEERING CONSULTANTS

SHEET
EQM-2


THIS DRAWING IS PROPERTY OF AQUA ENGINEERING INC. AND IS TRANSMITTED IN CONFIDENCE. NEITHER RECEIPT NOR POSSESSION CONVEYS OR TRANSFERS ANY RIGHTS TO REPRODUCE, USE, OR DISCLOSE, IN WHOLE OR IN PART, DATA CONTAINED HEREIN FOR ANY PURPOSE WITHOUT THE WRITTEN PERMISSION OF AQUA ENGINEERING INC. © COPYRIGHTED 2018 BOUNTIFUL, UT

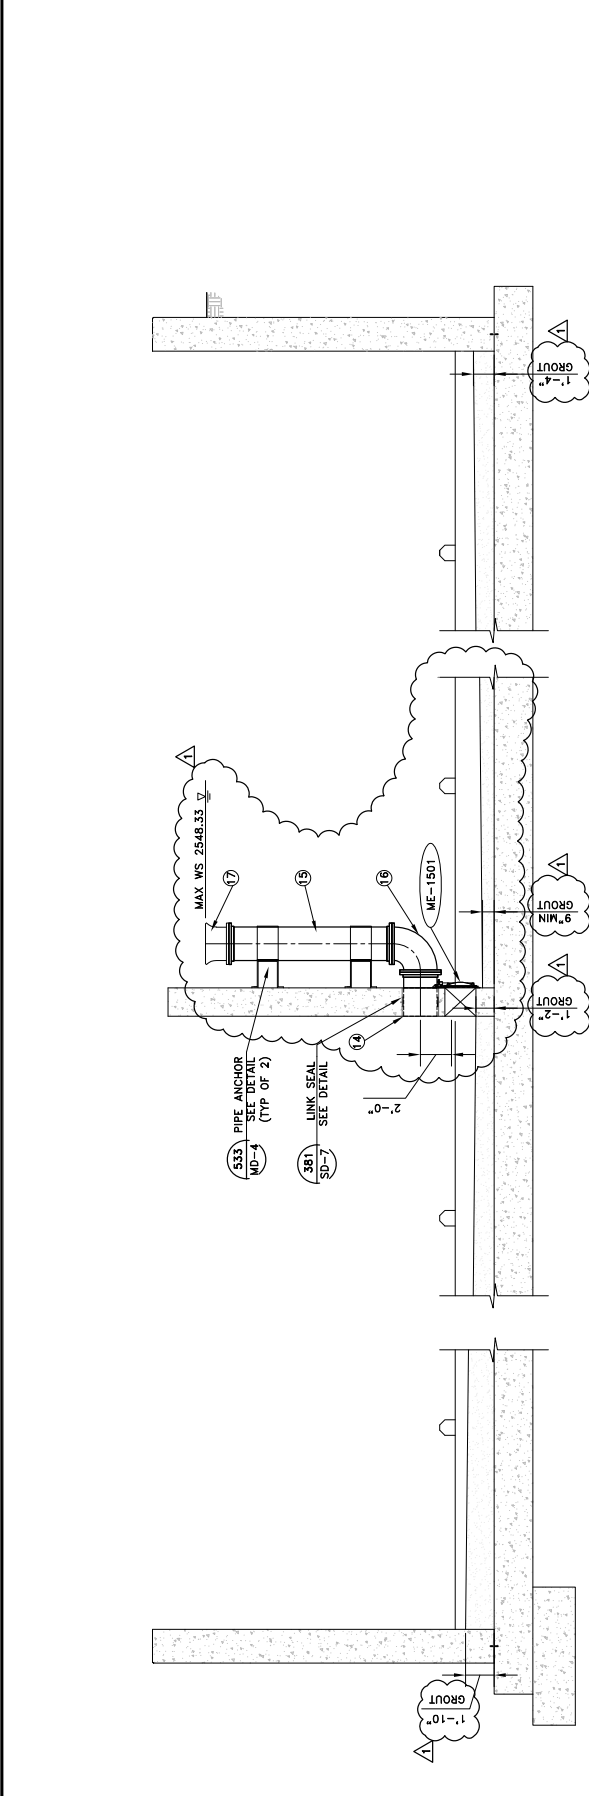

SECTION A-A
SCALE: 1/4"=1'-0"
Scale in Feet

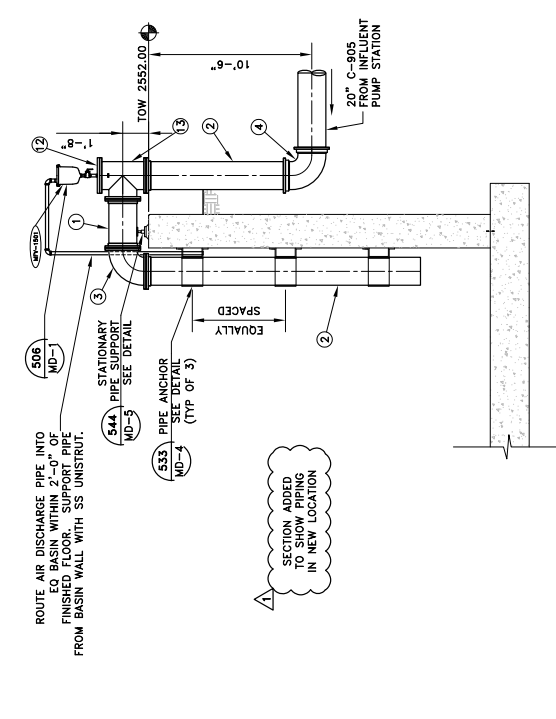

SECTION B-B
SCALE: 1/4"=1'-0"
Scale in Feet

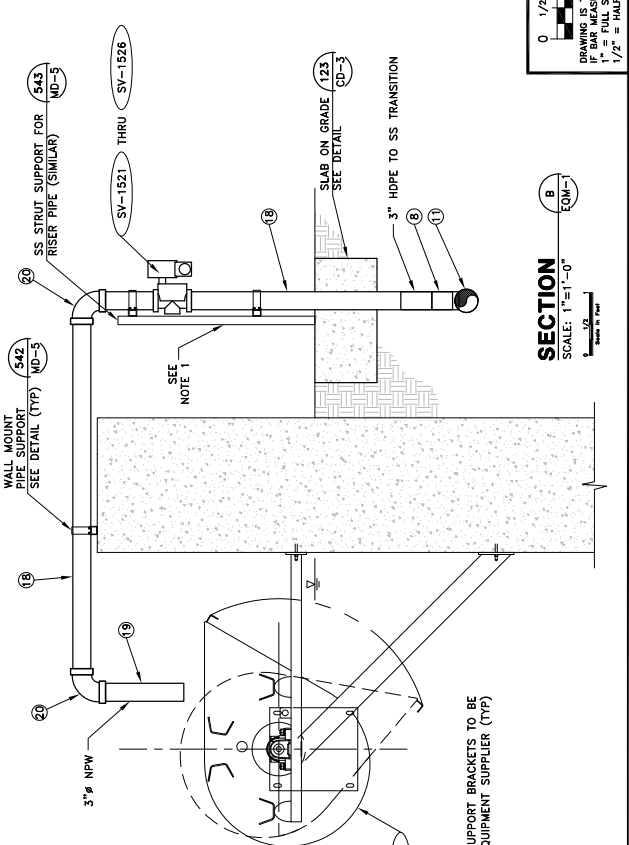


SECTION C-C
SCALE: 1"=1'-0"
Scale in Feet

NOTES:
1 - SEE SHEET EQM-5 FOR PIPE SCHEDULE.
SS SUPPORT BRACKETS TO BE PROVIDED BY EQUIPMENT SUPPLIER (TYP)

INSTALL AND ANCHOR EQUIPMENT AS PER MANUFACTURERS RECOMMENDATIONS
ME-1511 THRU ME-1516

3" HOPE TO SS TRANSITION
SLAB ON GRADE SEE DETAIL CD-3

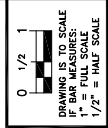

DRAWING IS TO SCALE
1" = FULL SCALE
1/2" = HALF SCALE

NO.	DATE	DESIGN	DRAWN	CHECKED
C	10/11/19	DPS	NMS	JRL
REVISIONS				
ORIGINAL				



CITY OF BEAUMONT
SALT MITIGATION WWTFF UPGRADE
EQUALIZATION BASIN
PUMP STATION MECHANICAL UPPER PLAN



ALBERT A. WEBB & ASSOCIATES
CIVIL ENGINEERS
3786 McCRAY STREET
PHONE (801) 299-1227 FAX (801) 299-0153

SHEET
EQM-3


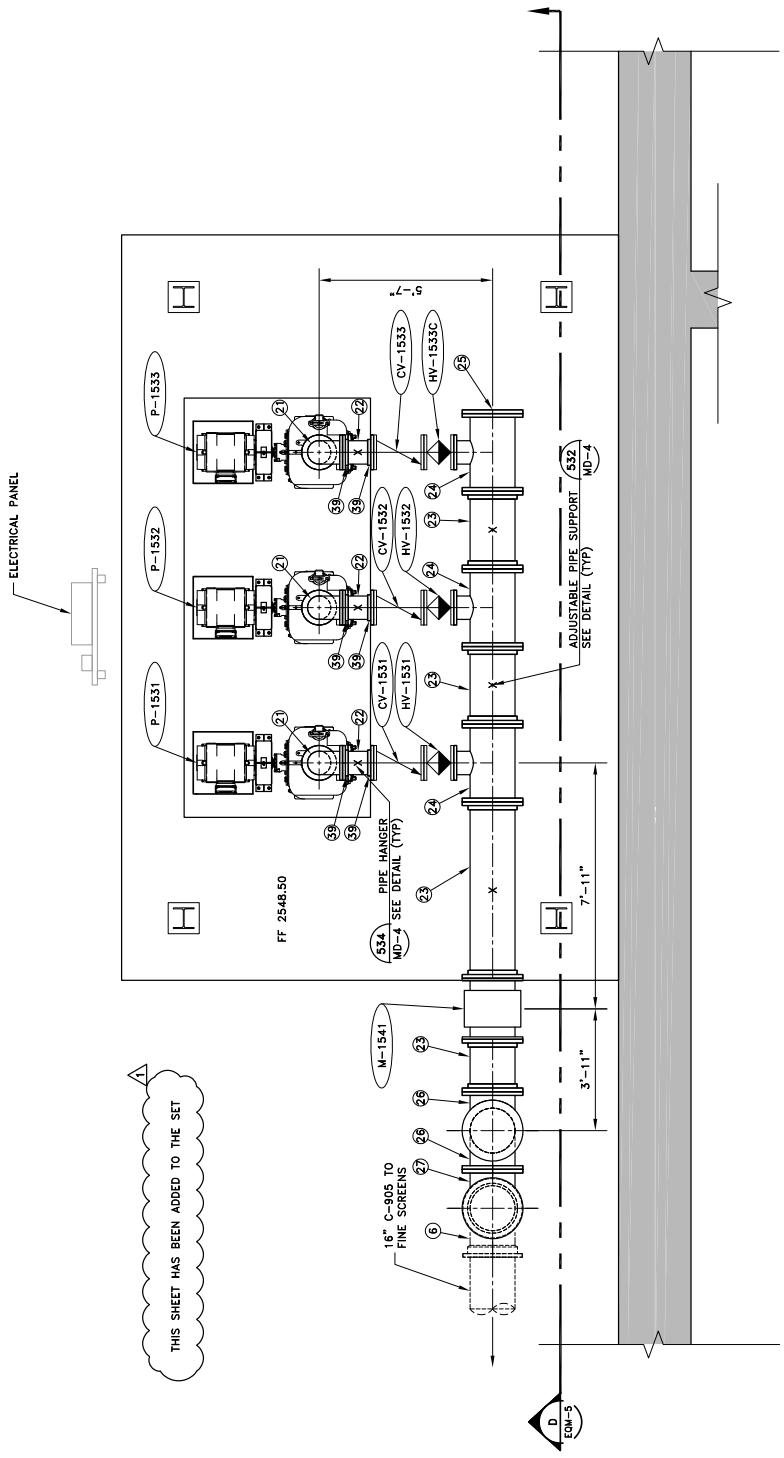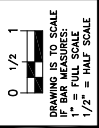

- NOTES:
- 1- PROVIDE PIPE SUPPORTS OR HANGERS AS SHOWN IN DETAILS 532 MD-4 & 534 MD-4 IN LOCATIONS SHOWN WITH AN "X".
 - 2- COORDINATE EQUIPMENT INSTALLATION REQUIREMENTS WITH MANUFACTURER. VERIFY DIMENSIONS, CONNECTIONS, SUPPORTS, WEIGHTS AND DETAILS.
 - 3- SEE ELECTRICAL DRAWINGS FOR CONTROL AND INSTRUMENT DETAILS AND REQUIREMENTS.
 - 4- COATINGS SHALL MEET THE REQUIREMENTS OF SECTION 098000.
 - 5- SEE SHEET EQM-5 FOR PIPE SCHEDULE.

UPPER PLAN
SCALE: 1/2"=1'-0"
0 2 4
Scale in Feet

THIS SHEET HAS BEEN ADDED TO THE SET

NO.	DATE	DESIGN	DRAWN	CHECKED
C	10/11/19	DPS	MSW	JRL
REVISIONS				
ORIGINAL				


CITY OF BEAUMONT
SALT MITIGATION WWTFF UPGRADE
EQUIALIZATION BASIN
PUMP STATION MECHANICAL LOWER PLAN



ALBERT A. WEBB & ASSOCIATES
ENGINEERING CONSULTANTS
CIVIL ENGINEERS
FAX (951) 788-1256

SHEET
EQM-4



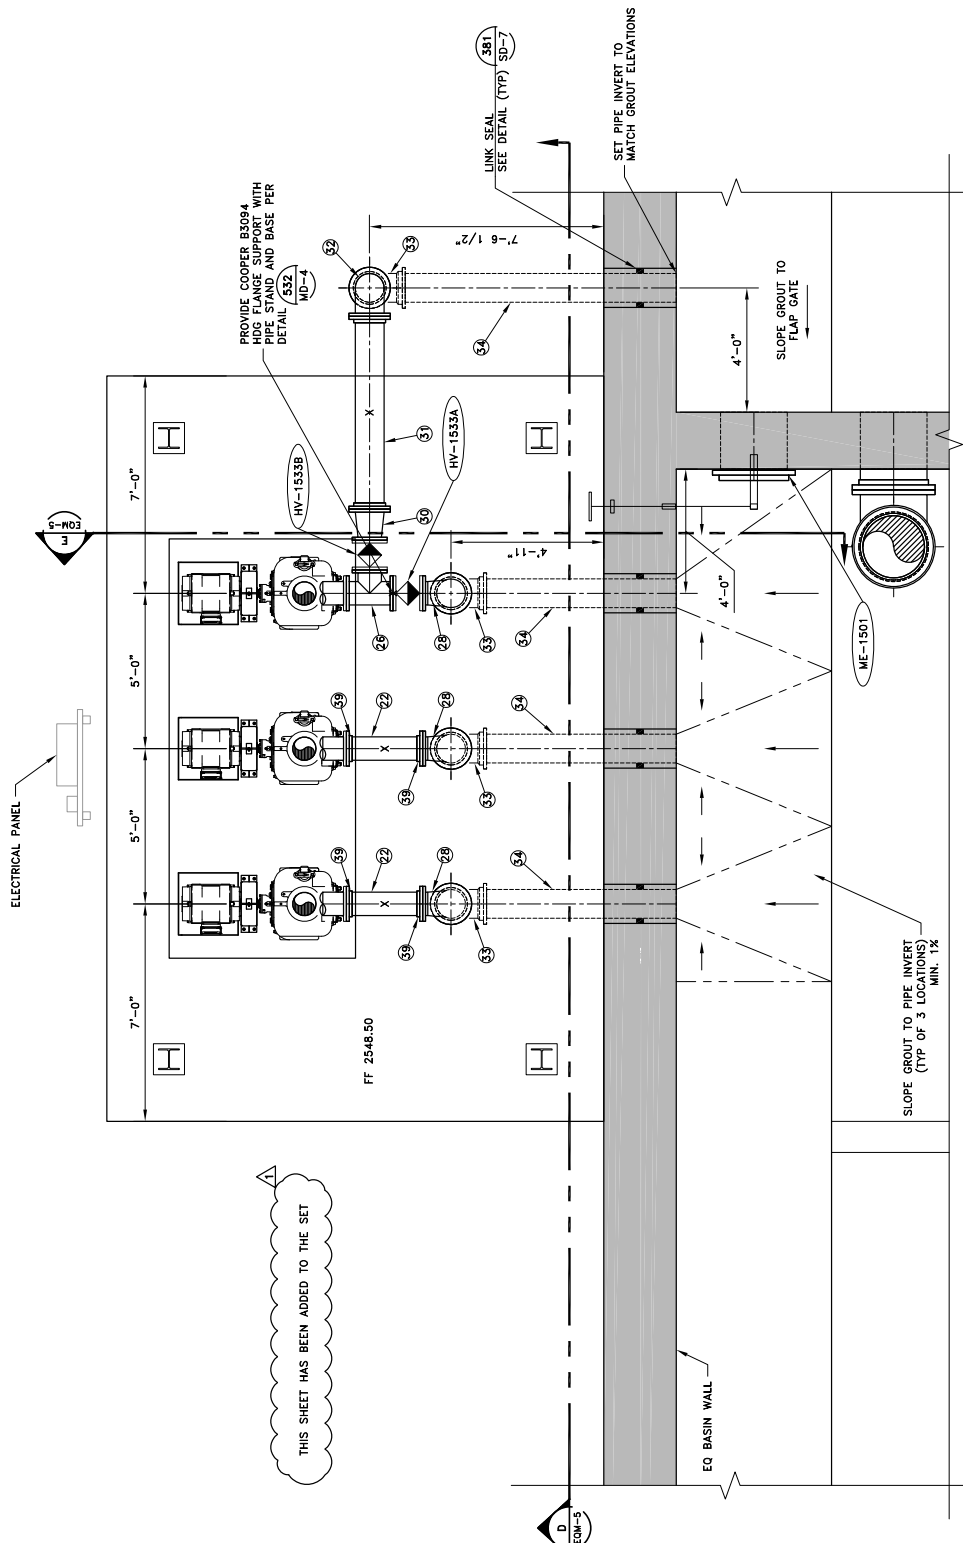

LOWER PLAN
SCALE: 1/2"=1'-0"
0 2 4
Scale in Feet

- NOTES:
- 1- PROVIDE PIPE SUPPORTS OR HANGERS AS SHOWN IN DETAILS (534) & (534) MD-4 IN LOCATIONS SHOWN WITH AN "X".
 - 2- COORDINATE EQUIPMENT INSTALLATION REQUIREMENTS WITH MANUFACTURER. VERIFY DIMENSIONS, CONNECTIONS, SUPPORTS, WEIGHTS AND DETAILS.
 - 3- SEE ELECTRICAL DRAWINGS FOR CONTROL AND INSTRUMENT DETAILS AND REQUIREMENTS.
 - 4- COATINGS SHALL MEET THE REQUIREMENTS OF SECTION 088000.
 - 5- SEE SHEET EQM-5 FOR PIPE SCHEDULE.

THIS SHEET HAS BEEN ADDED TO THE SET

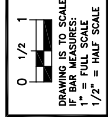

NO.	DATE	DESIGN	DRAWN	CHECKED
C	10/11/19	DPS	NMS	JRL
REVISIONS				
ORIGINAL				



CITY OF BEAUMONT
SALT MITIGATION WWT/P UPGRADE
EQUILIZATION BASIN
PUMP STATION MECHANICAL SECTIONS



ALBERT A. WEBB & ASSOCIATES
CIVIL ENGINEERS


SHEET
EQM-5

THIS DRAWING IS THE PROPERTY OF AQUA ENGINEERING INC. AND IS TRANSMITTED IN CONFIDENCE. NEITHER RECEIPT NOR POSSESSION CONVEYS OR TRANSFERS ANY RIGHTS TO REPRODUCE, USE, OR DISCLOSE. IN WHOLE OR IN PART. DATA CONTAINED HEREIN IS FOR THE EXCLUSIVE USE OF THE CLIENT AND IS NOT TO BE USED FOR ANY OTHER PROJECT WITHOUT THE WRITTEN PERMISSION OF AQUA ENGINEERING INC. © COPYRIGHTED 2019 BOUNTIFUL UTAH

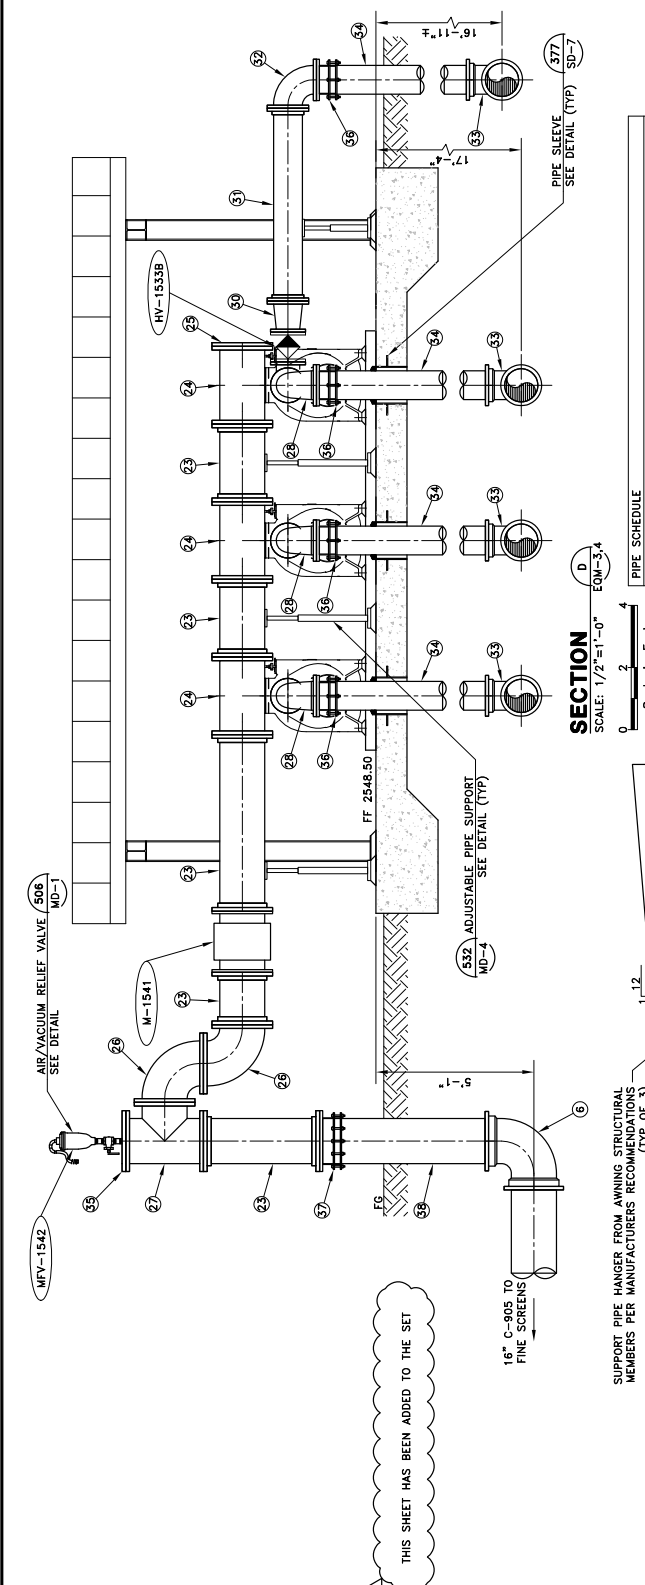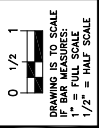

PIPE SCHEDULE

NO.	DESCRIPTION	SIZE	JOINT	MATERIAL
1	SPOOL	20"	FLG	DIP
2	SPOOL	20"	FLG	DIP
3	90° BEND	20"	FLG	DIP
4	90° BEND	20"	MJ	DIP
5	SPOOL	16"	PE	DIP
6	90° BEND	16"	MJ	DIP
7	SLEEVE	16"	MJ	DIP
8	90° BEND	4"	PE	HDPE
9	90° BEND	4"	PE	HDPE
10	CONCENTRIC REDUCER	4"x3"	PE	HDPE
11	REDUCING TEE	4"x3"	PE	HDPE
12	COMPANION FLANGE W/ 2" TAP	20"	FLG	DIP
13	TEE	20"	FLG	DIP
14	SPOOL	24"	FLG	DIP
15	SPOOL	24"	FLG	DIP
16	90° BEND	24"	FLG	DIP
17	FLARE	24"	FLG	DIP
18	SPOOL	3"	THD	SCH 40 SS
19	SPOOL	3"	THD	SCH 40 SS
20	90° BEND	8"	FLG	DIP
21	90° BEND	8"	FLG	DIP
22	SPOOL	8"	VIC	DIP
23	SPOOL	16"	FLG	DIP
24	REDUCING TEE	8"x16"	FLG	DIP
25	BLIND FLANGE	16"	FLG	DIP
26	90° BEND	16"	FLG	DIP
27	TEE	16"	FLG	DIP
28	90° REDUCING BEND	8"x10"	FLG	DIP
29	TEE	8"	FLG	DIP
30	REDUCER	8"x10"	FLG	DIP
31	SPOOL	10"	FLG	DIP
32	90° BEND	10"	FLG	DIP
33	SPOOL	10"	PE	DIP
34	SPOOL	10"	PE	DIP
35	COMPANION FLANGE W/ 2" TAP	16"	FLG	DIP
36	FLANGE ADAPTER	10"	FLG	DIP
37	FLANGE ADAPTER	16"	FLG	DIP
38	SPOOL	16"	PE	DIP
39	FLANGE	8"	VIC	DIP

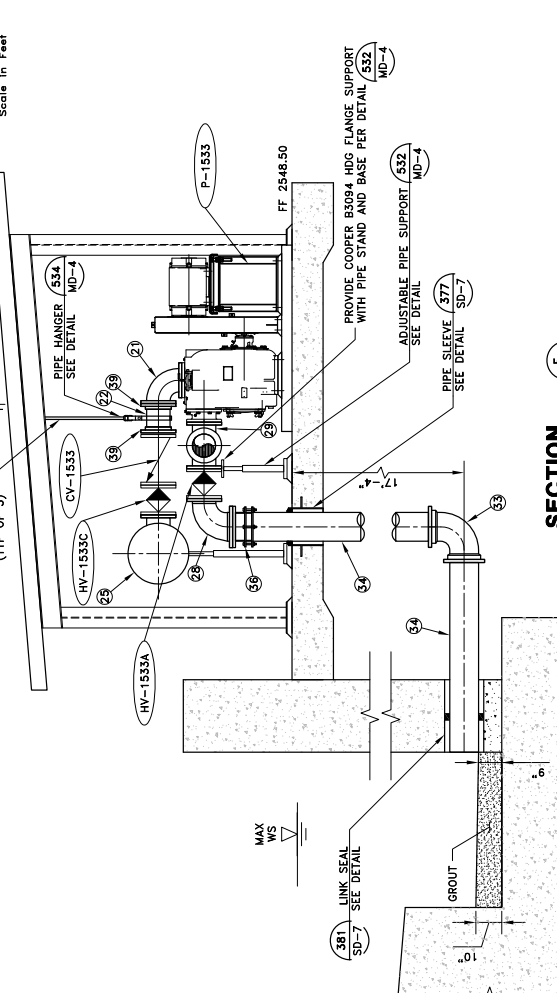

THIS SHEET HAS BEEN ADDED TO THE SET

SUPPORT PIPE HANGER FROM AWNING STRUCTURAL MEMBERS PER MANUFACTURERS RECOMMENDATIONS (TYP OF 3)

SCALE: 1/2"=1'-0" EQM-3.4

NO.	DATE	DESIGN	DRAWN	CHECKED
C	09/05/18	CM	SML	EN
REVISIONS				
10/11/19	CM	SML	EN	EN
11/29/18	CM	SML	EN	EN


CITY OF BEAUMONT
SALT MITIGATION WWT/P UPGRADE
FINE SCREEN
STRUCTURAL PLAN



ALBERT A. WEBB & ASSOCIATES
CIVIL ENGINEERS
PHONE (801) 299-1237 FAX (801) 299-0153

FSS-1
SHEET

THIS DRAWING IS PROPERTY OF AQUA ENGINEERING INC. AND IS TRANSMITTED IN CONFIDENCE. NEITHER RECEIPT NOR POSSESSION CONVEYS OR TRANSFERS ANY RIGHTS TO REPRODUCE, USE, OR DISCLOSE IN WHOLE OR IN PART. DATA CONTAINED HEREIN IS FOR YOUR USE ONLY. ANY REVISIONS TO THIS DRAWING SHALL BE MADE BY A REGISTERED PROFESSIONAL ENGINEER.

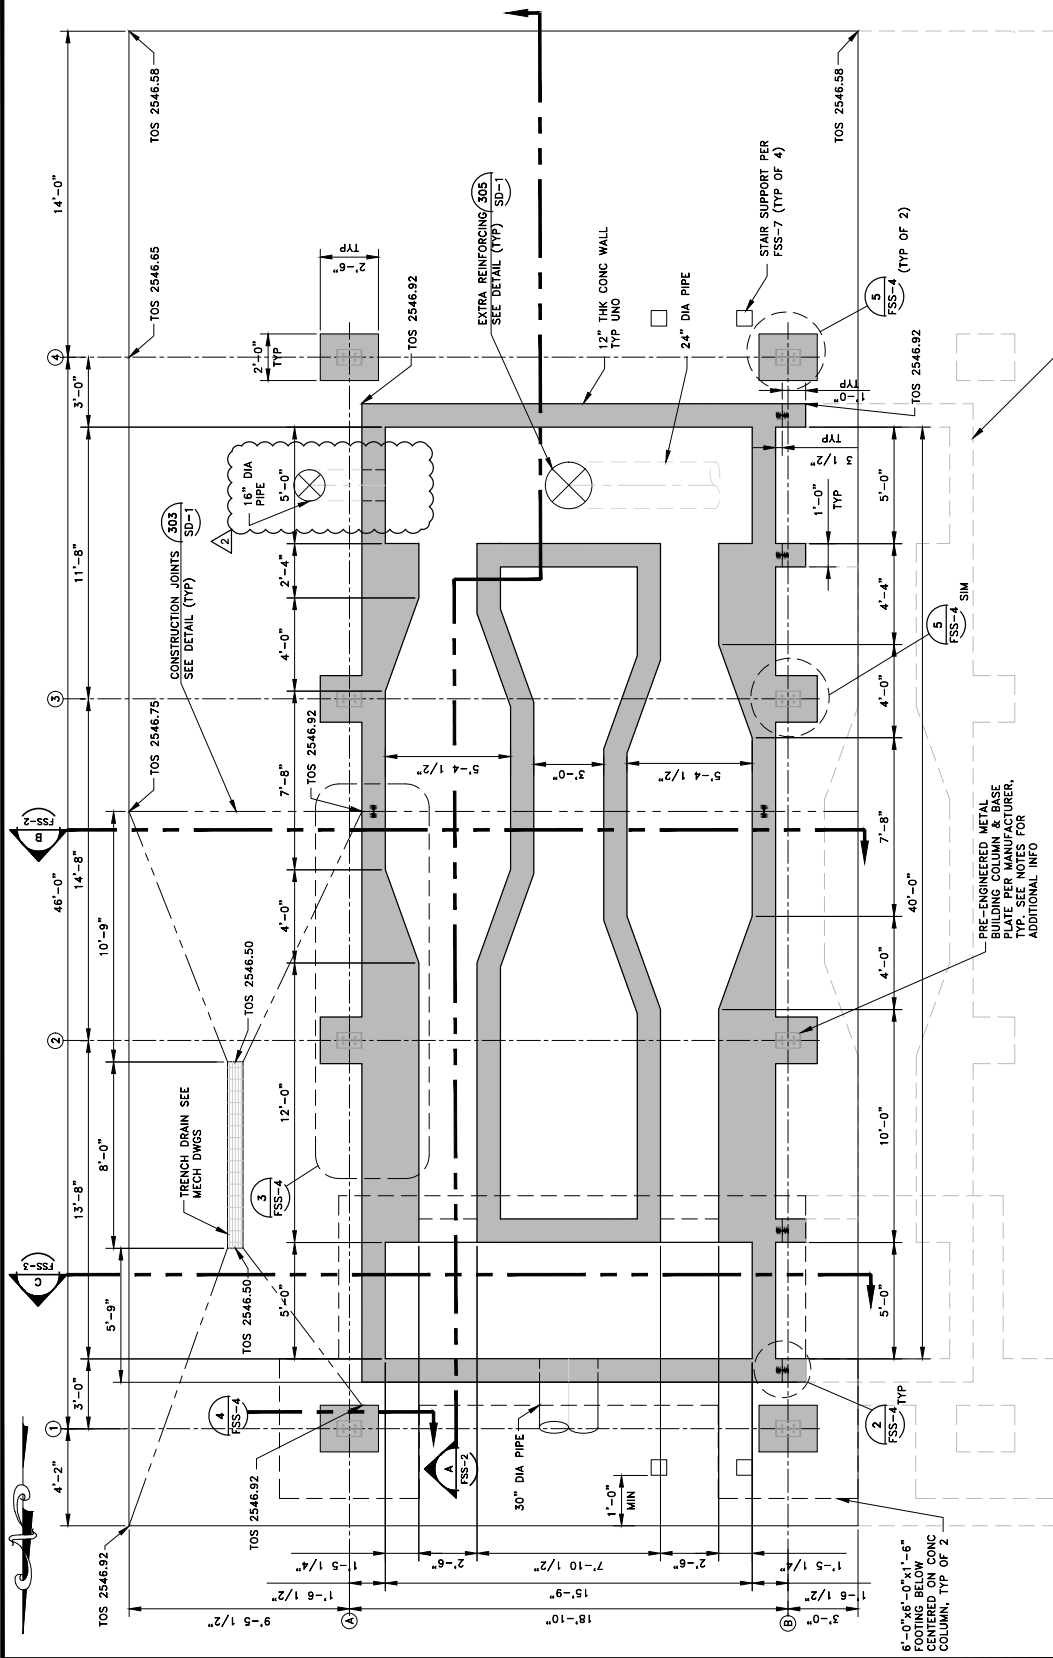

STRUCTURAL PLAN

SCALE: 3/8"=1'-0"
0 2 4
Scale in Feet

- NOTES:**
- REFER TO SECTION 312000 OF THE TECHNICAL SPECIFICATIONS FOR DETAILS REGARDING SUB-GRADE PREPARATION AND REQUIREMENTS.
 - PRE-ENGINEERED METAL BUILDING COLUMN/FOOTING DESIGN IS TO BE PROVIDED BY THE MANUFACTURER. THE MANUFACTURER'S DESIGN SHALL BE VERIFIED BY THE STRUCTURAL ENGINEER AFTER THE RECEIPT OF PRE-ENGINEERED METAL BUILDING DEFERRED SUBMITTAL. FOOTING/COLUMN REVISIONS (IF ANY) WILL BE ADDRESSED BY ADDENDUM OR REVISION.
 - FOOTING/COLUMN REVISIONS (IF ANY) WILL BE ADDRESSED BY ADDENDUM OR REVISION. PRE-ENGINEERED METAL BUILDING SHALL BE PLACED UNTIL REVIEW AND APPROVAL OF THE MANUFACTURER'S DESIGN IS RECEIVED. REFER TO SPECIFICATION SECTION 133400 FOR PRE-ENGINEERED BUILDING REQUIREMENTS. APPROPRIATE ANCHOR BOLT DESIGN AND EMBEDMENT DEPTH WITH PRE-ENGINEERED METAL BUILDING SUPPLIER.
 - PROVIDE ADDITIONAL REINFORCEMENT AROUND PIPE PENETRATIONS AS SHOWN IN DETAIL 305 ON SHEET SD-1 AND DETAIL 312 ON SHEET SD-1. PROVIDE CORNER AND INTERSECTION REINFORCEMENT FOR WALL CORNER AND INTERSECTION REINFORCEMENT REQUIREMENTS. SEE DETAILS 302 ON SHEET SD-1.
 - SEE ARCHITECTURAL, MECHANICAL, AND ELECTRICAL DRAWINGS FOR SIZE AND LOCATION OF ADDITIONAL OPENINGS NOT SHOWN ON THE DRAWING. CONTRACTOR SHALL VERIFY ALL EQUIPMENT PAD SIZE, LOCATIONS, AND ANCHORING REQUIREMENTS WITH THE MANUFACTURER OR SUPPLIER.
 - PRE-ENGINEERED METAL BUILDING SHALL BE DESIGNED TO HAVE ALL OPEN BAYS BE NO CROSS-BRACING ALLOWED.
 - DO NOT ADD OR ELIMINATE C.J.'S WITHOUT APPROVAL OF ENGINEER.
 - PIPE PENETRATIONS SMALLER THAN 4" ARE NOT SHOWN. REFER TO MECHANICAL DRAWINGS FOR ALL PENETRATIONS.


NO.	DATE	DESIGN	CHECKED
C	09/05/18	TML	EN
REVISIONS			
11/22/18	10/11/19	CM	EN
11/22/18	10/11/19	CM	EN
11/22/18	10/11/19	CM	EN
ORIGINAL			

CITY OF BEAUMONT
SALT MITIGATION WWT/P UPGRADE
FINE SCREEN
STRUCTURAL SECTIONS

AQUA ENGINEERING
533 W. 2600 S. SUITE 275, BOUNTIFUL, UT 84010
PHONE (801) 299-1237 FAX (801) 299-0153

ALBERT A. WEBB ENGINEERING CONSULTANTS
CIVIL ENGINEERS
PHONE (951) 966-1070
FAX (951) 788-1256

SHEET
FSS-2

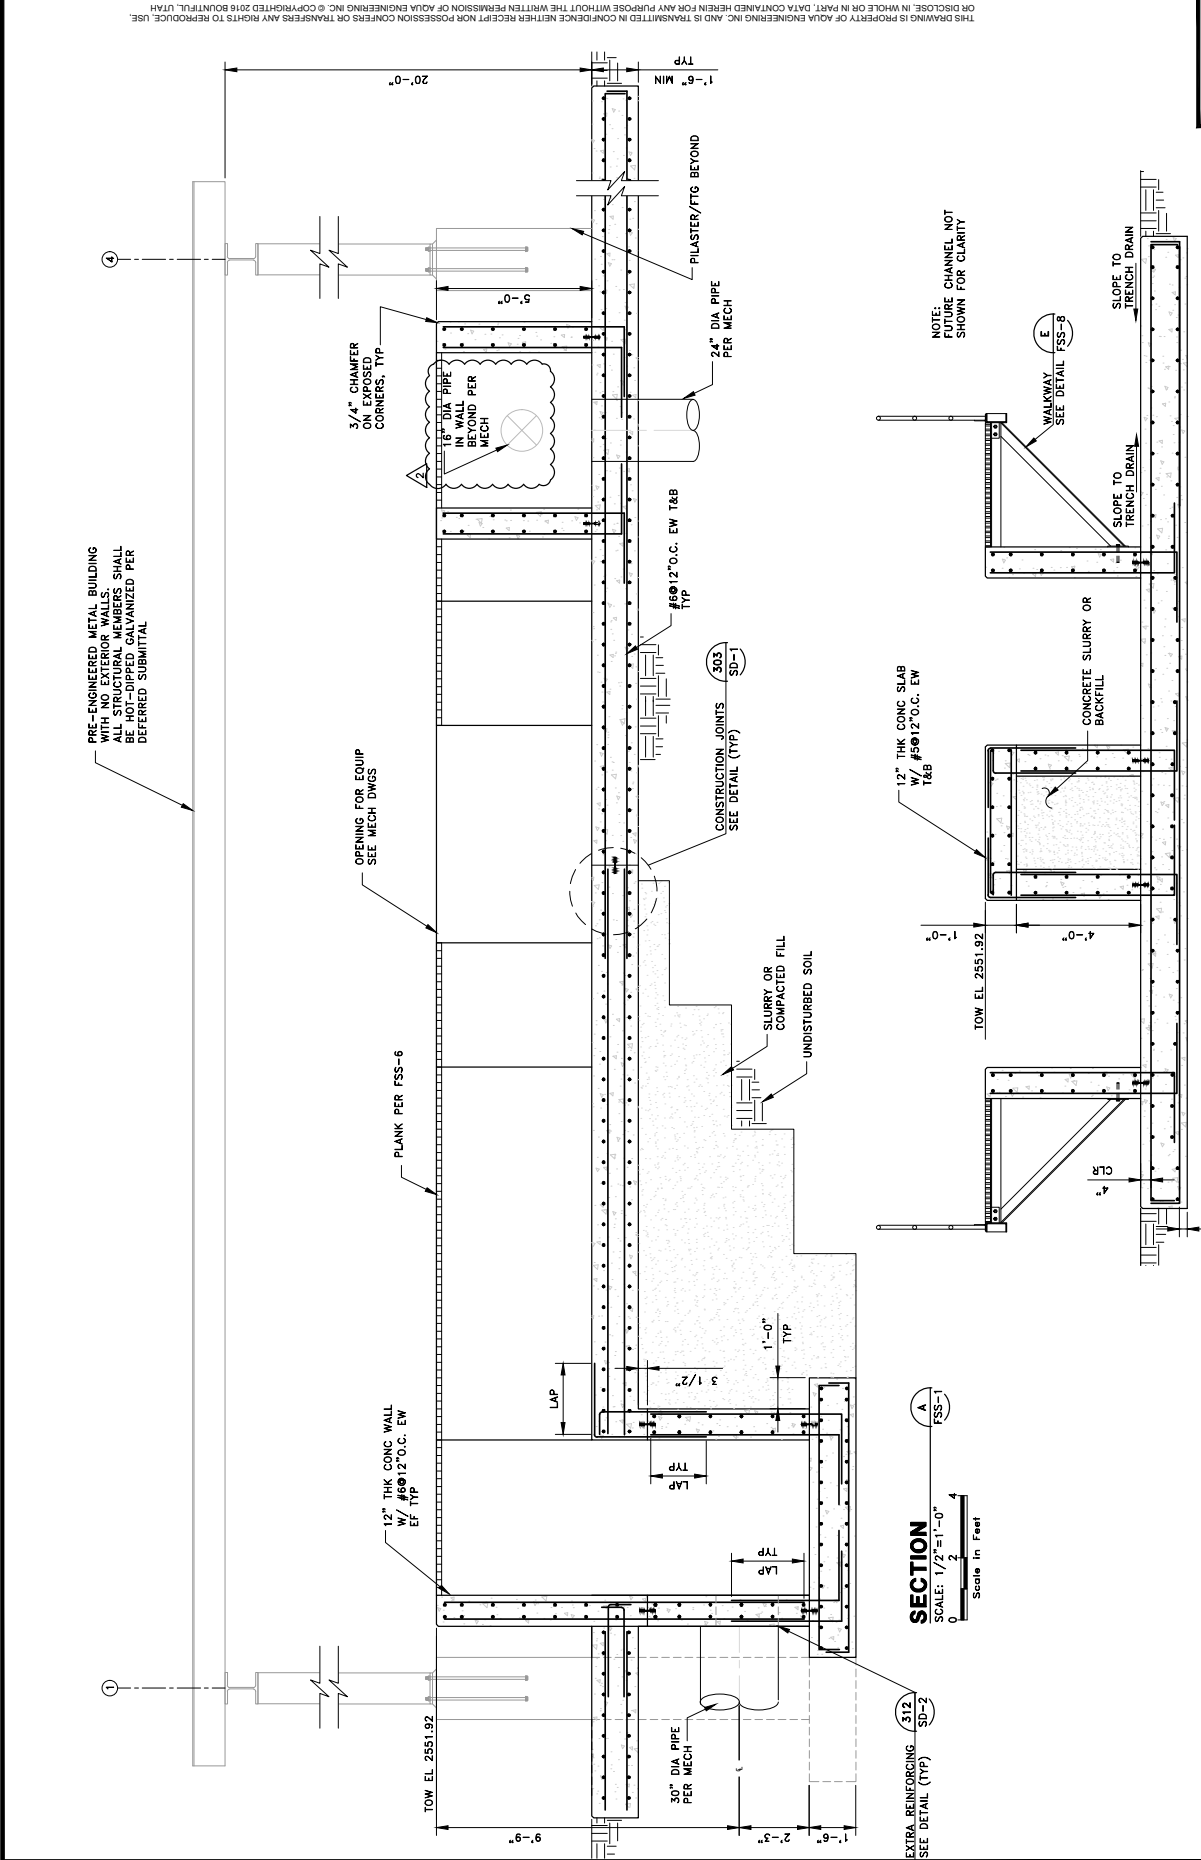

PRE-ENGINEERED METAL BUILDING WITH NO EXTERIOR WALLS. ALL STRUCTURAL MEMBERS SHALL BE HOT-DIPPED GALVANIZED PER DEFERRED SUBMITTAL

OPENING FOR EQUIP SEE MECH DWGS

PLANK PER FSS-6


30" DIA PIPE PER MECH

3/4" CHAMFERED CORNERS, TYP

24" DIA PIPE PER MECH

PILASTER/FTG BEYOND

CONSTRUCTION JOINTS SEE DETAIL (TYP)

SLURRY OR COMPACTED FILL UNDISTURBED SOIL

EXTRA REINFORCING SEE DETAIL (TYP)

NOTE: FUTURE CHANNEL NOT SHOWN FOR CLARITY

WALKWAY SEE DETAIL FSS-8

SLOPE TO TRENCH DRAIN

SLOPE TO TRENCH DRAIN

CONCRETE SLURRY OR BACKFILL












SECTION A
SCALE: 1/2"=1'-0"
0 2 4
Scale in Feet


0 1/2 1
DRAWING IS TO SCALE
SCALE: 1/2"=1'-0"
1" = FULL SCALE
1/2" = HALF SCALE

THIS DRAWING IS PROPERTY OF AQUA ENGINEERING, INC. AND IS TRANSMITTED IN CONFIDENCE. NEITHER THIS DRAWING NOR ANY INFORMATION CONTAINED HEREIN IS TO BE REPRODUCED, COPIED, OR DISCLOSED IN WHOLE OR IN PART, OR IN ANY MANNER, WITHOUT THE WRITTEN PERMISSION OF AQUA ENGINEERING, INC. © COPYRIGHTED 2018 BOUNTIFUL, UT.



NO.	DATE	DESIGN	DRAWN	CHECKED
C	09/05/18	DPS	BDP	JRL
REVISIONS				
2	11/15/18	DPS	KRB	JRL
1	11/15/18	DPS	KRB	JRL

CITY OF BEAUMONT
SALT MITIGATION WWTUP UPGRADE
FINE SCREENS
GRATING/PLANK FRAMING PLAN



ALBERT A. WEBB & ASSOCIATES
CIVIL ENGINEERS
PHONE (801) 299-1237 FAX (801) 299-0133

SHEET
FSS-5

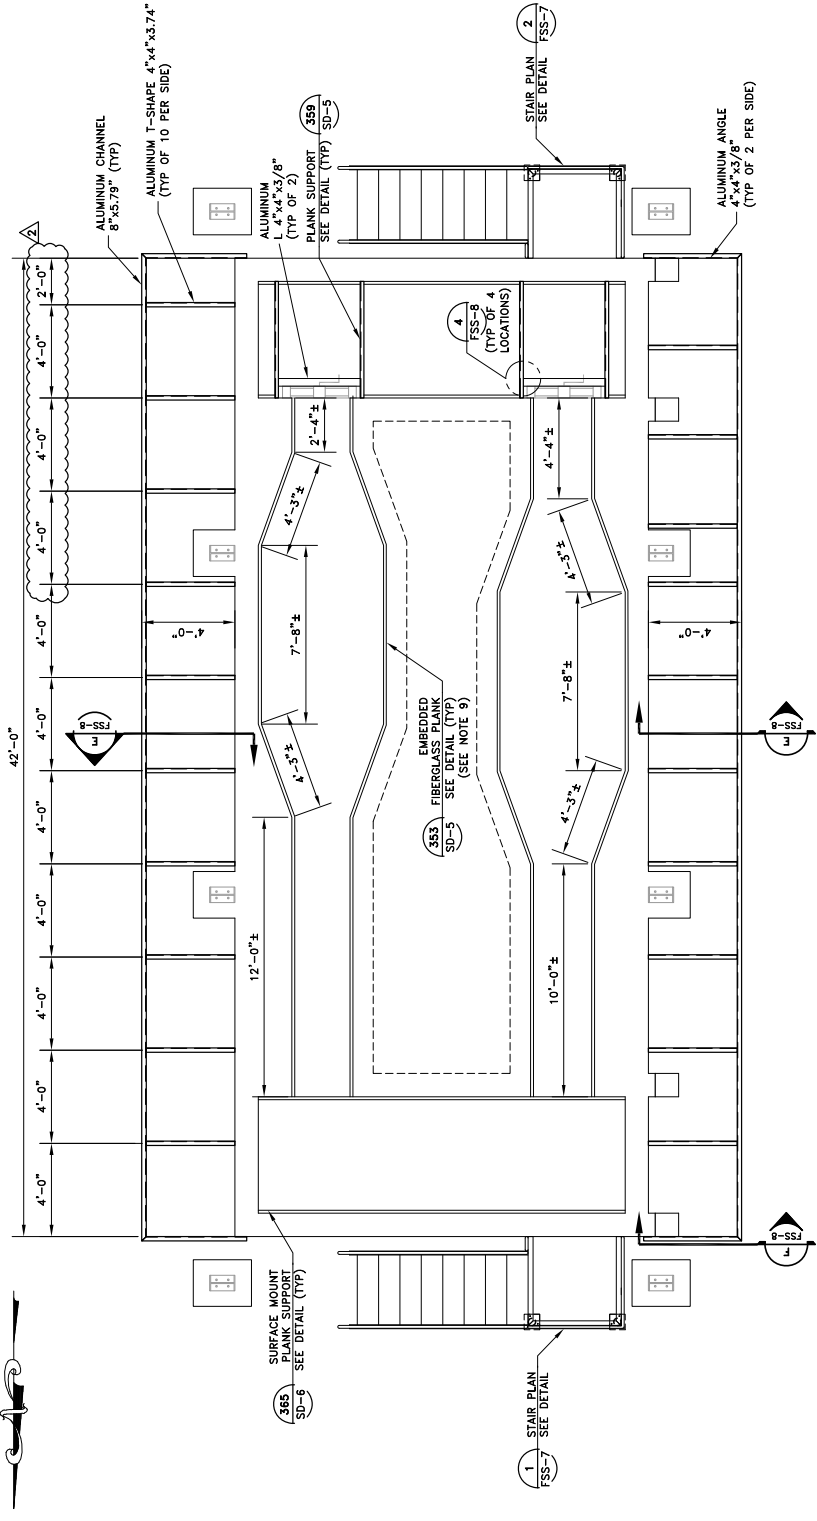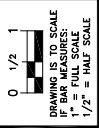

GRATING/PLANK FRAMING PLAN

SCALE: 3/8"=1'-0"
0 2 4
Scale in Feet

- NOTES:
- 1- WALKWAY DESIGN DETAILS ARE PROVIDED AS GUIDANCE ONLY.
 - 2- WALKWAY DESIGN SHALL BE A DEFERRED SUBMITTAL AND SHALL BE THE RESPONSIBILITY OF THE CONTRACTOR.
 - 3- WALKWAY, ALUMINUM HANDRAIL, GRATING, AND PLANK DESIGN SHALL BE IN ACCORDANCE WITH THE FOLLOWING SECTIONS:
051200 (STRUCTURAL STEEL)
051400 (STRUCTURAL ALUMINUM)
055213 (PIPE AND TUBE RAILINGS)
055300 (METAL GRATINGS)
065500 (FIBERGLASS PLANK)
 - 4- WALKWAY DESIGN SHALL BE IN ACCORDANCE WITH CBC AND OSHA AND SHALL BE PREPARED, STAMPED AND SEALED BY A REGISTERED PROFESSIONAL ENGINEER IN THE STATE OF CALIFORNIA.
 - 5- WALKWAY DESIGN MUST PRESERVE INDICATED WALKWAY WIDTHS AND CLEARANCES MINOR ADJUSTMENTS MAY BE ALLOWED FOLLOWING THE ENGINEER'S APPROVAL.
 - 6- THE CONTRACTOR SHALL SUBMIT SHOP DRAWINGS FROM METAL FABRICATOR FOR ALL MISCELLANEOUS METALS, WALKWAY, SUPPORTS, ETC.
 - 7- ALUMINUM IN CONTACT WITH OTHER METALS AND/OR CONCRETE SHALL BE COATED PER SPECIFICATION SECTION 088000.
 - 8- ALL ANCHOR BOLTS AND BOLTS IN CONTACT WITH ALUMINUM SHALL BE 304 STAINLESS STEEL.
 - 9- ALL PLANK SUPPORT ANGLE IN SCREEN CHANNELS TO BE EMBEDDED.


NO.	DATE	DESIGN	CHECKED
C	09/05/18	DPS	JRL
1	11/15/18	DPS	KRB
2	11/15/18	DPS	BDF
REVISIONS			
ORIGINAL			

CITY OF BEAUMONT
SALT MITIGATION WWTUP UPGRADE
FINE SCREENS
MECHANICAL PLAN

AQUA ENGINEERING
533 W 2800 S, SUITE 275, BOUNTIFUL, UT 84010
PHONE (801) 293-1237 FAX (801) 293-0133

ALBERT A. WEBB ASSOCIATES
ENGINEERING CONSULTANTS
PHONE (951) 788-1256 FAX (951) 788-1256

SHEET
FSM-1

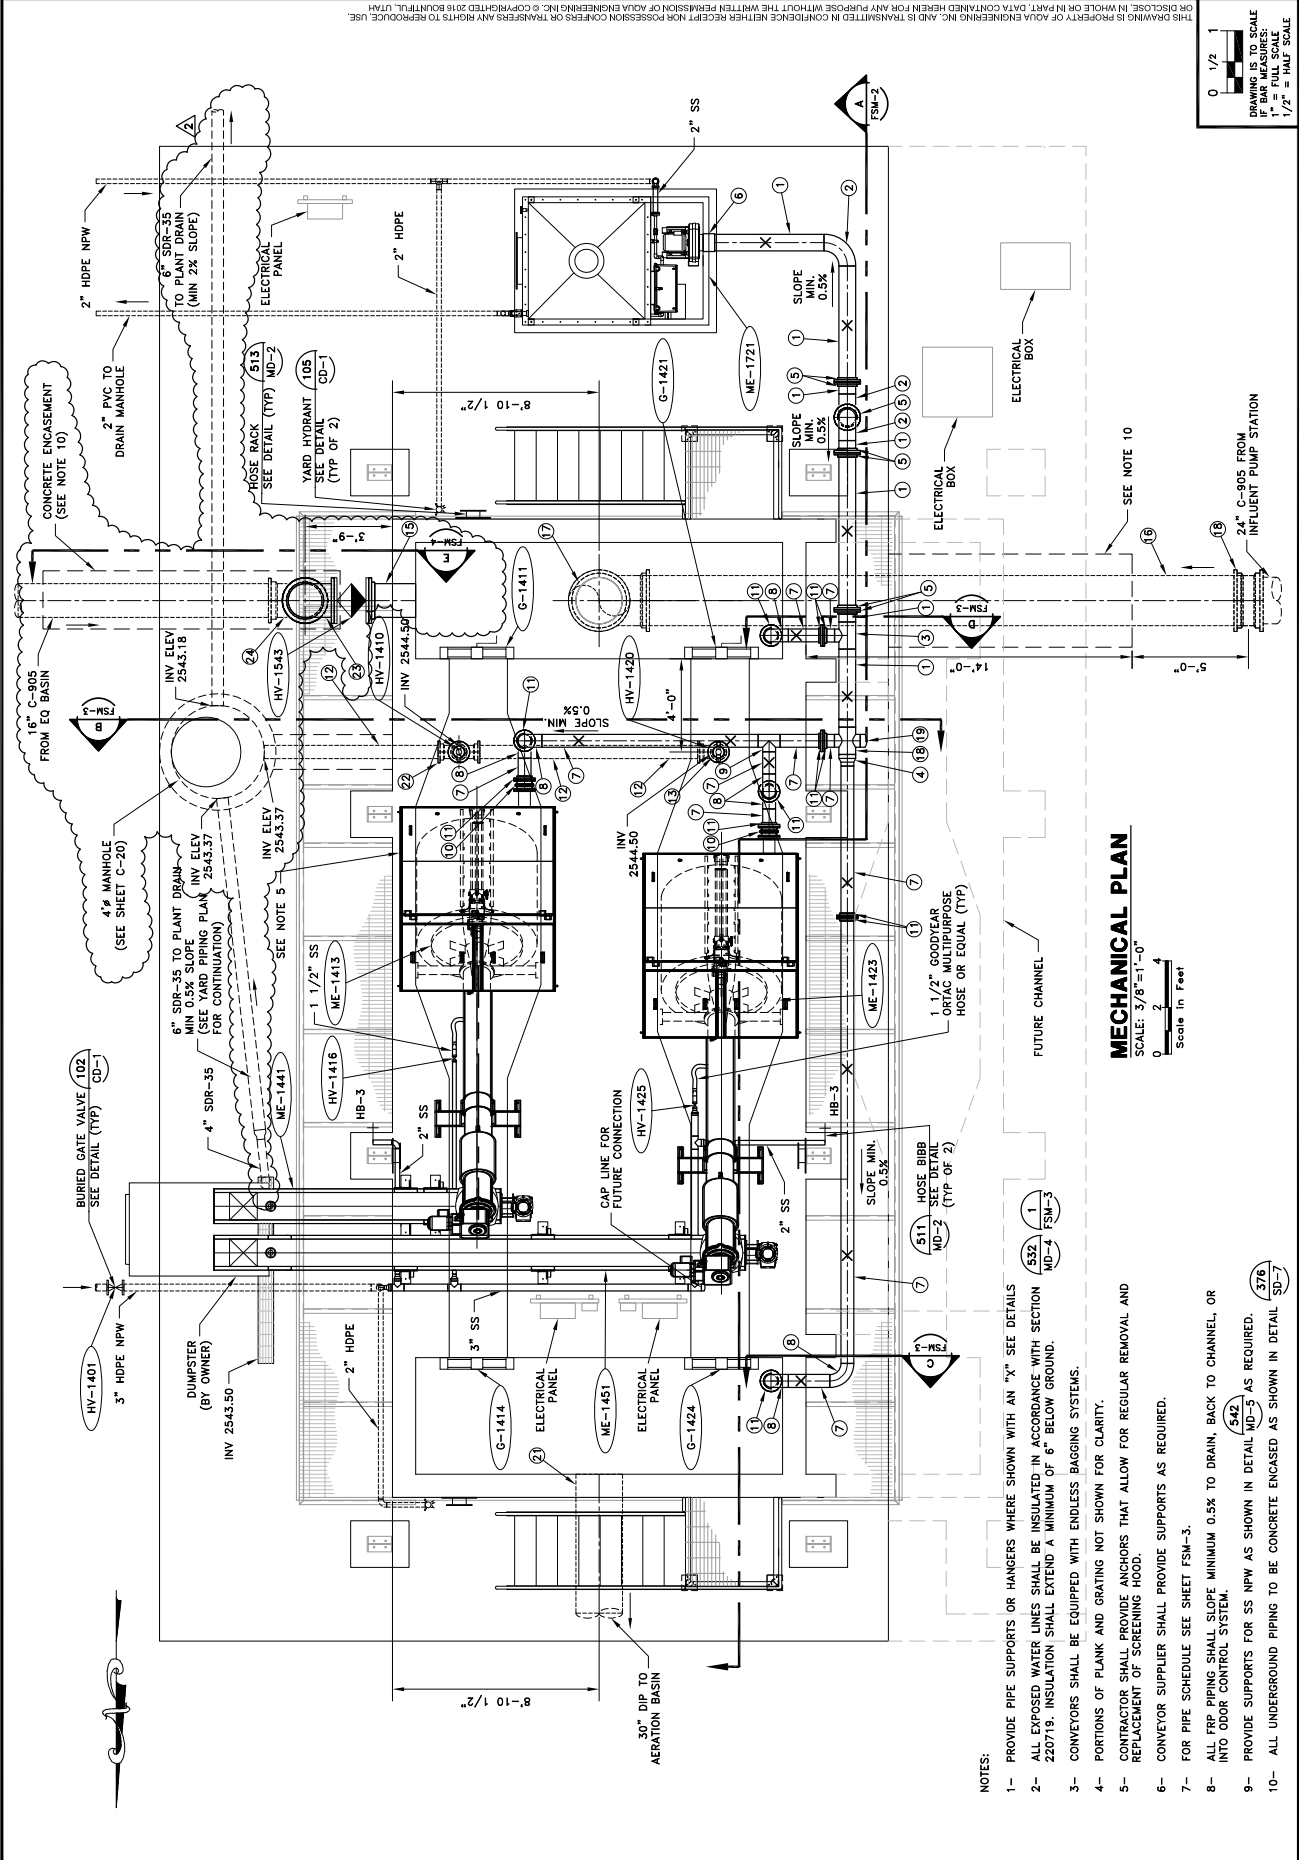

MECHANICAL PLAN
SCALE: 3/8"=1'-0"

Scale in Feet
0 2 4

- NOTES:
- 1- PROVIDE PIPE SUPPORTS OR HANGERS WHERE SHOWN WITH AN "X". SEE DETAILS 532 AND 537.
 - 2- ALL EXPOSED WATER LINES SHALL BE INSULATED IN ACCORDANCE WITH SECTION 220719. INSULATION SHALL EXTEND A MINIMUM OF 6" BELOW GROUND.
 - 3- CONVEYORS SHALL BE EQUIPPED WITH ENDLESS BAGGING SYSTEMS.
 - 4- PORTIONS OF PLANK AND GRATING NOT SHOWN FOR CLARITY.
 - 5- CONTRACTOR SHALL PROVIDE ANCHORS THAT ALLOW FOR REGULAR REMOVAL AND REPLACEMENT OF SCREENING HOOD.
 - 6- CONVEYOR SUPPLIER SHALL PROVIDE SUPPORTS AS REQUIRED.
 - 7- FOR PIPE SCHEDULE SEE SHEET FSM-3.
 - 8- ALL FRP PIPING SHALL HAVE SLOPE MINIMUM 0.5% TO DRAIN, BACK TO CHANNEL, OR INTO ODOR CONTROL SYSTEM.
 - 9- PROVIDE SUPPORTS FOR SS NPW AS SHOWN IN DETAIL ND-5 AS REQUIRED. 542
 - 10- ALL UNDERGROUND PIPING TO BE CONCRETE ENCASED AS SHOWN IN DETAIL SD-7.

THIS DRAWING IS PROPERTY OF AQUA ENGINEERING INC. AND IS TRANSMITTED IN CONFIDENCE. IT IS NOT TO BE REPRODUCED, COPIED, OR DISCLOSED IN WHOLE OR IN PART. DATA CONTAINED HEREIN IS FOR THE WRITTEN PERMITS OF AQUA ENGINEERING INC. © COPYRIGHTED 2018 BOUNTIFUL, UT. ALL RIGHTS RESERVED.

NO.	DATE	DESIGN	DRAWN	CHECKED
C	03/05/18	DPS	BDP	JRL
REVISIONS				
1	11/15/18	DPS	KRB	JRL
2	10/11/19	DPS	BDP	JRL


CITY OF BEAUMONT
SALT MITIGATION WWTUP UPGRADE
FINE SCREENS
MECHANICAL SECTIONS

AQUA ENGINEERING
533 W. 2600 S. SUITE 275, BOUNTIFUL, UT 84010
PHONE (801) 299-1237 FAX (801) 299-0153

WEBB ASSOCIATES
CIVIL ENGINEERS

SHEET
FSM-3

DRAWING IS TO SCALE
IF NOT SPECIFIED:
1" = FULL SCALE
1/2" = HALF SCALE

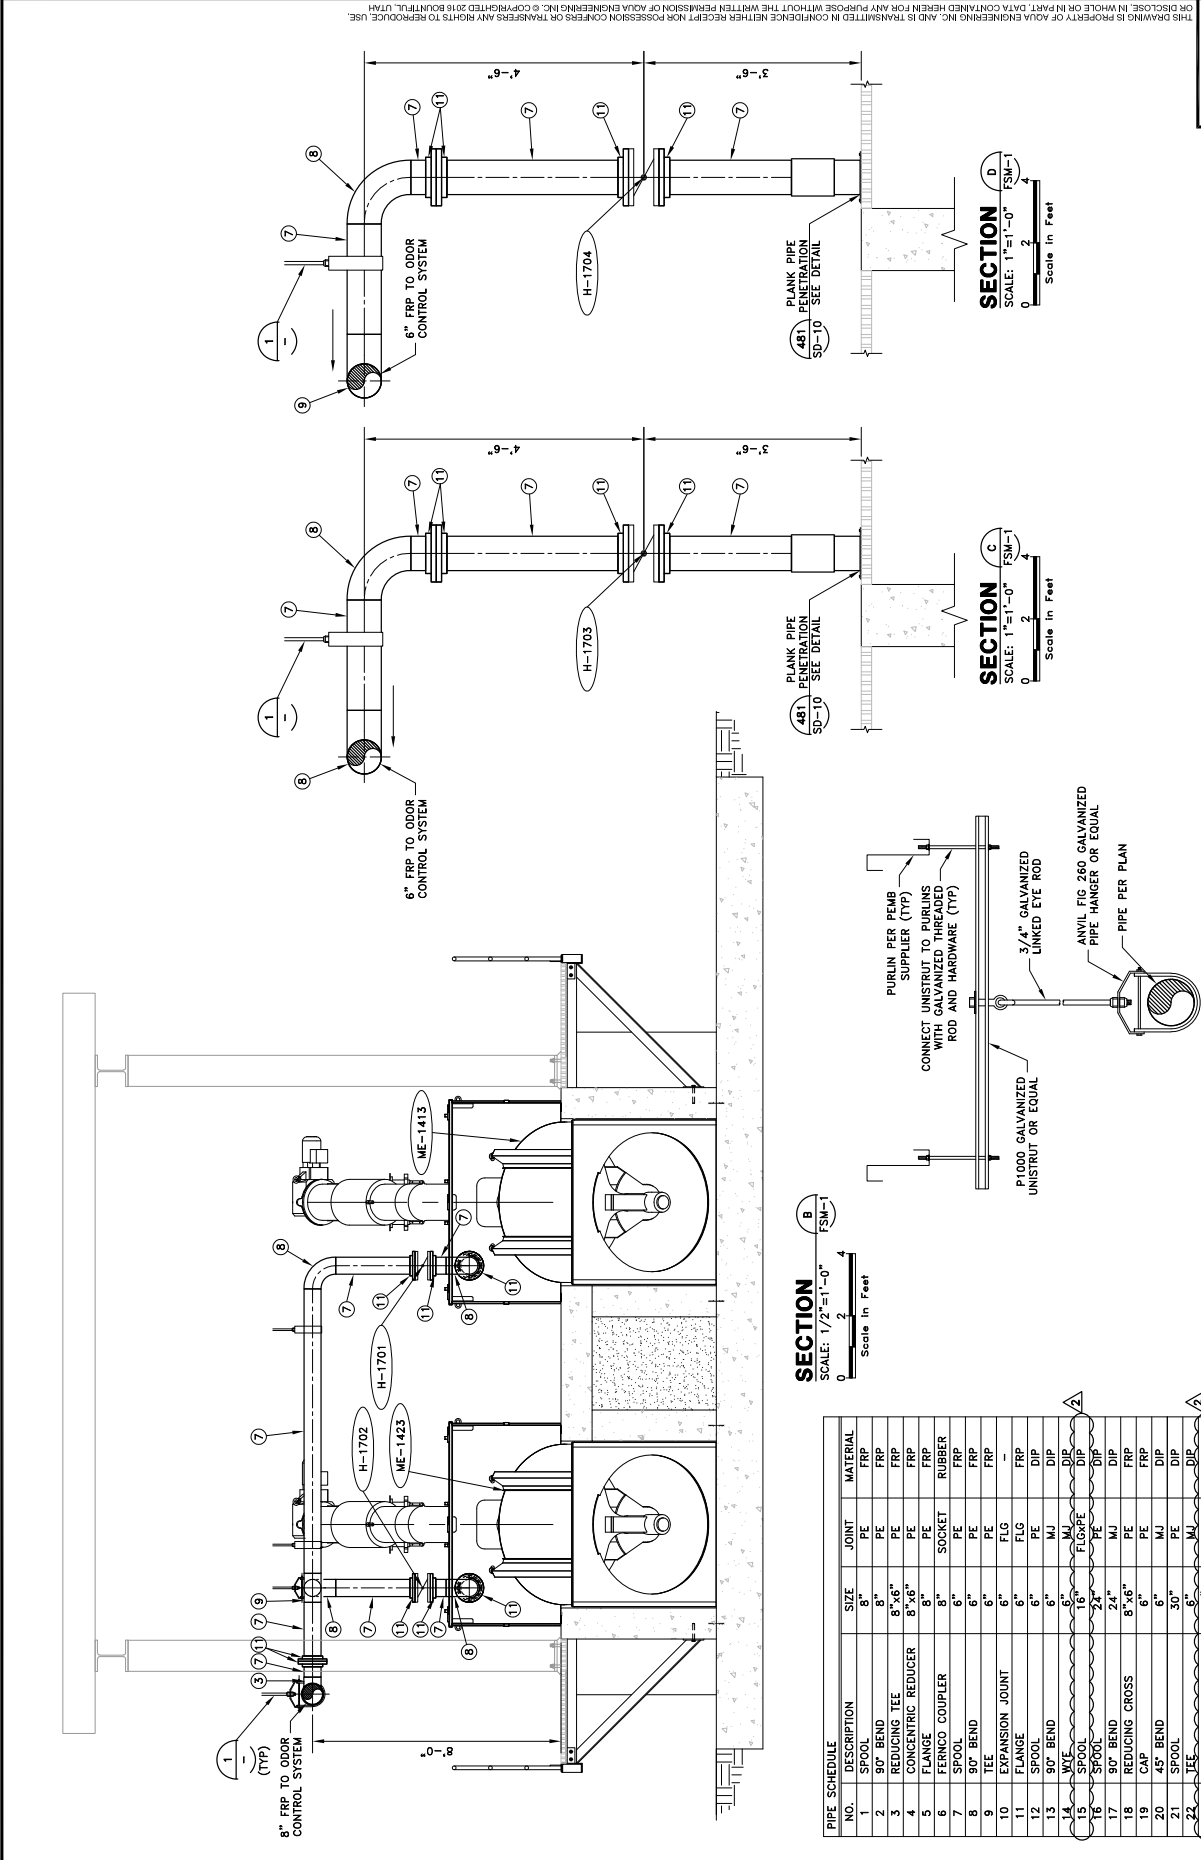

SECTION B
SCALE: 1/2"=1'-0"
Scale in Feet

SECTION C
SCALE: 1"=1'-0"
Scale in Feet

SECTION D
SCALE: 1"=1'-0"
Scale in Feet

NO.	DESCRIPTION	SIZE	JOINT	MATERIAL
1	SPOOL	8"	FRP	FRP
2	90° BEND	8"	PE	FRP
3	REDUCING TEE	8"x8"	PE	FRP
4	CONCENTRIC REDUCER	8"x8"	PE	FRP
5	FLANGE	8"	PE	FRP
6	FLANGE COUPLER	8"	SOCKET	RUBBER
7	SPOOL	6"	FRP	FRP
8	90° BEND	6"	PE	FRP
9	TEE	6"	PE	FRP
10	EXPANSION JOINT	6"	FLG	FRP
11	FLANGE	6"	FLG	FRP
12	SPOOL	6"	PE	DIP
13	90° BEND	6"	MJ	DIP
14	WYE	6"	MJ	DIP
15	SPOOL	16"	FLG	DIP
16	90° BEND	24"	PE	DIP
17	90° BEND	24"	MJ	DIP
18	REDUCING CROSS	8"x6"	PE	FRP
19	CAP	6"	PE	FRP
20	45° BEND	6"	MJ	DIP
21	SPOOL	30"	PE	DIP
22	TEE	6"	MJ	DIP
23	90° BEND	16"	FLG	DIP
24	90° BEND	16"	MJ	DIP
25	SPOOL	16"	PEVIC	DIP
26	FLANGE	16"	WIC	DIP

PIPE HANGER
SCALE: NTS

NO.	DATE	DESIGN	DRAWN	CHECKED
C	03/05/18	DPS	BDP	JRL
REVISIONS				
1	10/11/19	DPS	BDP	JRL
ORIGINAL				


CITY OF BEAUMONT
SALT MITIGATION WWTP UPGRADE
FINE SCREENS
MECHANICAL SECTION



ALBERT A. WEBB ASSOCIATES
ENGINEERING CONSULTANTS
CIVIL ENGINEERS
3788 MCKAY STREET
PHONE (951) 886-1070
FAX (951) 786-1256

SHEET
FSM-4

THIS DRAWING IS PROPERTY OF AQUA ENGINEERING INC. AND IS TRANSMITTED IN CONFIDENCE NEITHER RECEIPT NOR POSSESSION CONFERS OR TRANSFERS ANY RIGHTS TO REPRODUCE, USE, OR DISCLOSE, IN WHOLE OR IN PART, DATA CONTAINED HEREIN FOR ANY PURPOSE WITHOUT THE WRITTEN PERMISSION OF AQUA ENGINEERING INC. © COPYRIGHTED 2018 BOUNTIFUL, UT, USA.

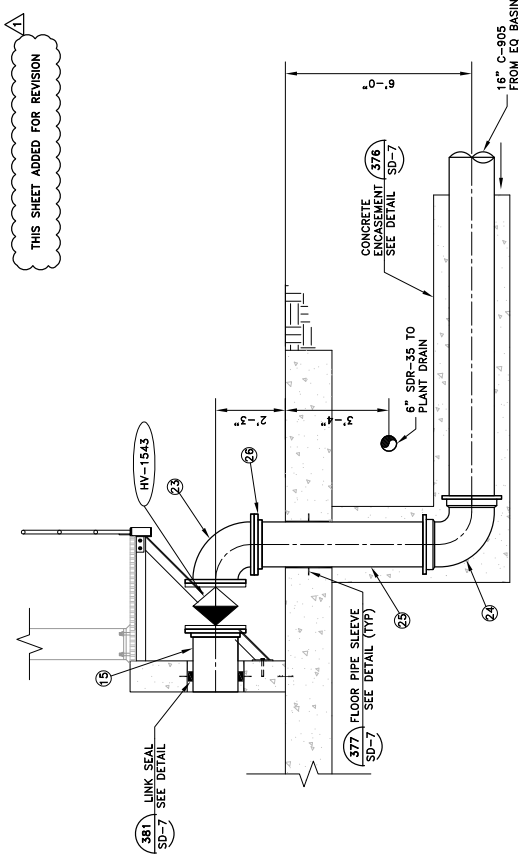

THIS SHEET ADDED FOR REVISION A

SECTION
SCALE: 1/2"=1'-0"
0 2 4
Scale in Feet



ALBERT A. WEBB & ASSOCIATES
CIVIL ENGINEERS
ENGINEERING CONSULTANTS
200 W. 200 S. SUITE 275, BOUNTIFUL, UT 84010
PHONE (801) 299-1227 FAX (801) 299-0153



CITY OF BEAUMONT
SALT MITIGATION WWTFF UPGRADE
SCHEDULES
METER

NO.	DATE	DESIGN CHECKED
C	09/05/18	JRL
REV.	DESCRIPTION	BY
1	07/26/19	JRL
2	10/14/19	BDP

METER SCHEDULE #	LOCATION	SERVICE	TYPE	SIZE	REMARKS
M-1332	INFLUENT PUMP STATION	FINE SCREEN FEED FLOW METER	MAGNETER	24"	SEE INSTRUMENTATION SCHEDULE
M-1342	INFLUENT PUMP STATION	EQUALIZATION BASIN FEED FLOW METER	MAGNETER	20"	SEE INSTRUMENTATION SCHEDULE
M-1522	EQUALIZATION BASIN	EQUALIZATION BASIN RETURN FLOW METER	MAGNETER	16"	SEE INSTRUMENTATION SCHEDULE
M-1541	EQUALIZATION BASIN	FINE SCREENS FLOW METER	MAGNETER	16"	SEE INSTRUMENTATION SCHEDULE
M-1532	REACTION BASIN #1	PROCESS AIR FLOW METER	MASS FLOW INSERTION	N/A	SEE INSTRUMENTATION SCHEDULE
M-2232	REACTION BASIN #2	PROCESS AIR FLOW METER	MASS FLOW INSERTION	N/A	SEE INSTRUMENTATION SCHEDULE
M-2332	REACTION BASIN #3	PROCESS AIR FLOW METER	MASS FLOW INSERTION	N/A	SEE INSTRUMENTATION SCHEDULE
M-2432	REACTION BASIN #4	PROCESS AIR FLOW METER	MASS FLOW INSERTION	N/A	SEE INSTRUMENTATION SCHEDULE
M-3122	MEMBRANE BUILDING	MEMBRANE TRAIN #1 SCOUR AIR FLOW	MASS FLOW INSERTION	N/A	SEE INSTRUMENTATION SCHEDULE
M-3182	MEMBRANE BUILDING	PERMEATE PUMP #1 FLOW METER	MAGNETER	12"	PROVIDED WITH MBR EQUIPMENT
M-3222	MEMBRANE BUILDING	MEMBRANE TRAIN #2 SCOUR AIR FLOW	MASS FLOW INSERTION	N/A	SEE INSTRUMENTATION SCHEDULE
M-3282	MEMBRANE BUILDING	PERMEATE PUMP #2 FLOW METER	MAGNETER	12"	PROVIDED WITH MBR EQUIPMENT
M-3322	MEMBRANE BUILDING	MEMBRANE TRAIN #3 SCOUR AIR FLOW	MASS FLOW INSERTION	N/A	SEE INSTRUMENTATION SCHEDULE
M-3382	MEMBRANE BUILDING	PERMEATE PUMP #3 FLOW METER	MAGNETER	12"	PROVIDED WITH MBR EQUIPMENT
M-3422	MEMBRANE BUILDING	MEMBRANE TRAIN #4 SCOUR AIR FLOW	MASS FLOW INSERTION	N/A	SEE INSTRUMENTATION SCHEDULE
M-3482	MEMBRANE BUILDING	PERMEATE PUMP #4 FLOW METER	MAGNETER	12"	PROVIDED WITH MBR EQUIPMENT
M-3661	MEMBRANE BUILDING	MBR FEED PUMPS FLOW METER	MAGNETER	42"	SEE INSTRUMENTATION SCHEDULE
M-3893	MEMBRANE BUILDING	WAS/SCUM PUMPING FLOW METER	MAGNETER	8"	SEE INSTRUMENTATION SCHEDULE
M-30074	MEMBRANE BUILDING	RO FORWARDING PUMPS FLOW METER	MAGNETER	8"	PROVIDED WITH RO EQUIPMENT
M-17474	MEMBRANE BUILDING	RO CP PUMP FLOW METER	MAGNETER	4"	PROVIDED WITH RO EQUIPMENT
M-5072	MEMBRANE BUILDING	SODIUM HYPOCHLORITE RECIRCULATION LINE	MAGNETER	1"	SEE INSTRUMENTATION SCHEDULE
M-6420	RECYCLED WATER LIFT STATION	NON-POTABLE WATER FLOW METER	MAGNETER	6"	SEE INSTRUMENTATION SCHEDULE
M-7122	RECYCLED WATER LIFT STATION	RECYCLED WATER FLOW METER	MAGNETER	18"	SEE INSTRUMENTATION SCHEDULE
M-8433	SOLIDS HOLDING BLOWERS	MIXING AIR FLOW METER	MASS FLOW INSERTION	8"	SEE INSTRUMENTATION SCHEDULE
M-8443	SOLIDS HOLDING BLOWERS	MIXING AIR FLOW METER	MASS FLOW INSERTION	8"	SEE INSTRUMENTATION SCHEDULE
M-8502	SOLIDS HANDLING BUILDING	CENTRIFUGE #1 FEED FLOW METER	MAGNETER	3"	SEE INSTRUMENTATION SCHEDULE
M-8552	SOLIDS HANDLING BUILDING	CENTRIFUGE #2 FEED FLOW METER	MAGNETER	3"	SEE INSTRUMENTATION SCHEDULE
M-8562	SOLIDS HANDLING BUILDING	CENTRIFUGE #3 FEED FLOW METER	MAGNETER	3"	SEE INSTRUMENTATION SCHEDULE

PH	LOCATION	SERVICE	TYPE	HP (KW)	FLOW	TDH	REMARKS
P-8101	SOLIDS FEED PUMP STATION	WAS FEED TO DEWATERING CENTRIFUGES	PROGRESSIVE CAVITY	20	250 GPM	116 FT	NETZSCH MODEL NM060SY01L07V4.3 FSIP OR EQUAL
P-8102	SOLIDS FEED PUMP STATION	WAS FEED TO DEWATERING CENTRIFUGES	PROGRESSIVE CAVITY	20	250 GPM	116 FT	NETZSCH MODEL NM060SY01L07V4.3 FSIP OR EQUAL
P-8103	SOLIDS FEED PUMP STATION	WAS FEED TO DEWATERING CENTRIFUGES	PROGRESSIVE CAVITY	20	250 GPM	116 FT	NETZSCH MODEL NM060SY01L07V4.3 FSIP OR EQUAL
P-8894	SOLIDS HANDLING BUILDING	SOLIDS HANDLING RECIRCULATION	PROGRESSIVE CAVITY	30	55 GPM	5 FT	NETZSCH MODEL NM060SY01L07V4.3 FSIP OR EQUAL
P-1531	EQUALIZATION BASIN	EQUALIZATION BASIN RETURN PUMPING	SELF-PRIMING CENTRIFUGAL	30	1960 GPM	35 FT	GORMAN RUPP MODEL T8A8-3 (MIN 60% EFFICIENCY @ DESIGN POINT)
P-1532	EQUALIZATION BASIN	EQUALIZATION BASIN RETURN PUMPING	SELF-PRIMING CENTRIFUGAL	30	1960 GPM	35 FT	GORMAN RUPP MODEL T8A8-3 (MIN 60% EFFICIENCY @ DESIGN POINT)
P-1533	EQUALIZATION BASIN	EQUALIZATION BASIN RETURN PUMPING	SELF-PRIMING CENTRIFUGAL	30	1960 GPM	35 FT	GORMAN RUPP MODEL T8A8-3 (MIN 60% EFFICIENCY @ DESIGN POINT)

▲


NO.	DATE	DESIGN	CHECKED
C	09/05/18	BP	JRL
REVISIONS			
1	09/16/19	EIT	BDP
2	10/14/19	EIT	BDP
JRL			

CITY OF BEAUMONT
SALT MITIGATION WWTFF UPGRADE
SCHEDULES
PUMP



ALBERT A. WEBB & ASSOCIATES
CIVIL ENGINEERS
ENGINEERING CONSULTANTS
539 W. 2600 S. SUITE 275, BOUNTIFUL, UT 84010
PHONE (801) 299-1227 FAX (801) 299-0153

SHEET
SCH-26

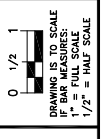

THIS DRAWING IS PROPERTY OF AQUA ENGINEERING INC. AND IS TRANSMITTED IN CONFIDENCE. NEITHER RECEIPT NOR POSSESSION CONFERES OR TRANSFERS ANY RIGHTS TO REPRODUCE, USE, OR DISCLOSE, IN WHOLE OR IN PART, DATA CONTAINED HEREIN FOR ANY PURPOSE WITHOUT THE WRITTEN PERMISSION OF AQUA ENGINEERING INC. © COPYRIGHTED 2018 BOUNTIFUL, UT, USA

ALBERT A. WEBB & ASSOCIATES
CIVIL ENGINEERS
 3788 MCCARY STREET
 WWW.SKMG.COM


skm
 533 W 2600 S, Suite 25
 Bountiful, Utah 84010
 Phone: (801) 677-0011
 WWW.SKMG.COM

DRAWING IS TO SCALE
 1" = FULL SCALE
 1/2" = HALF SCALE

CITY OF BEAUMONT
SALT MITIGATION WWTP UPGRADE
INSTRUMENTATION - P&IDs
INFLUENT PUMP STATION & EQ BASIN

AQUA ENGINEERING
 633 W 2900 S, SUITE 275, BOUNTIFUL, UT 84010
 PHONE (801) 288-1327 FAX (801) 288-0183

NO.	DATE	DESIGN	DRAWN	CHECKED
C	09/05/18	MPJ	DCL	MPJ
I	10/11/19	MPJ	DCL	MPJ

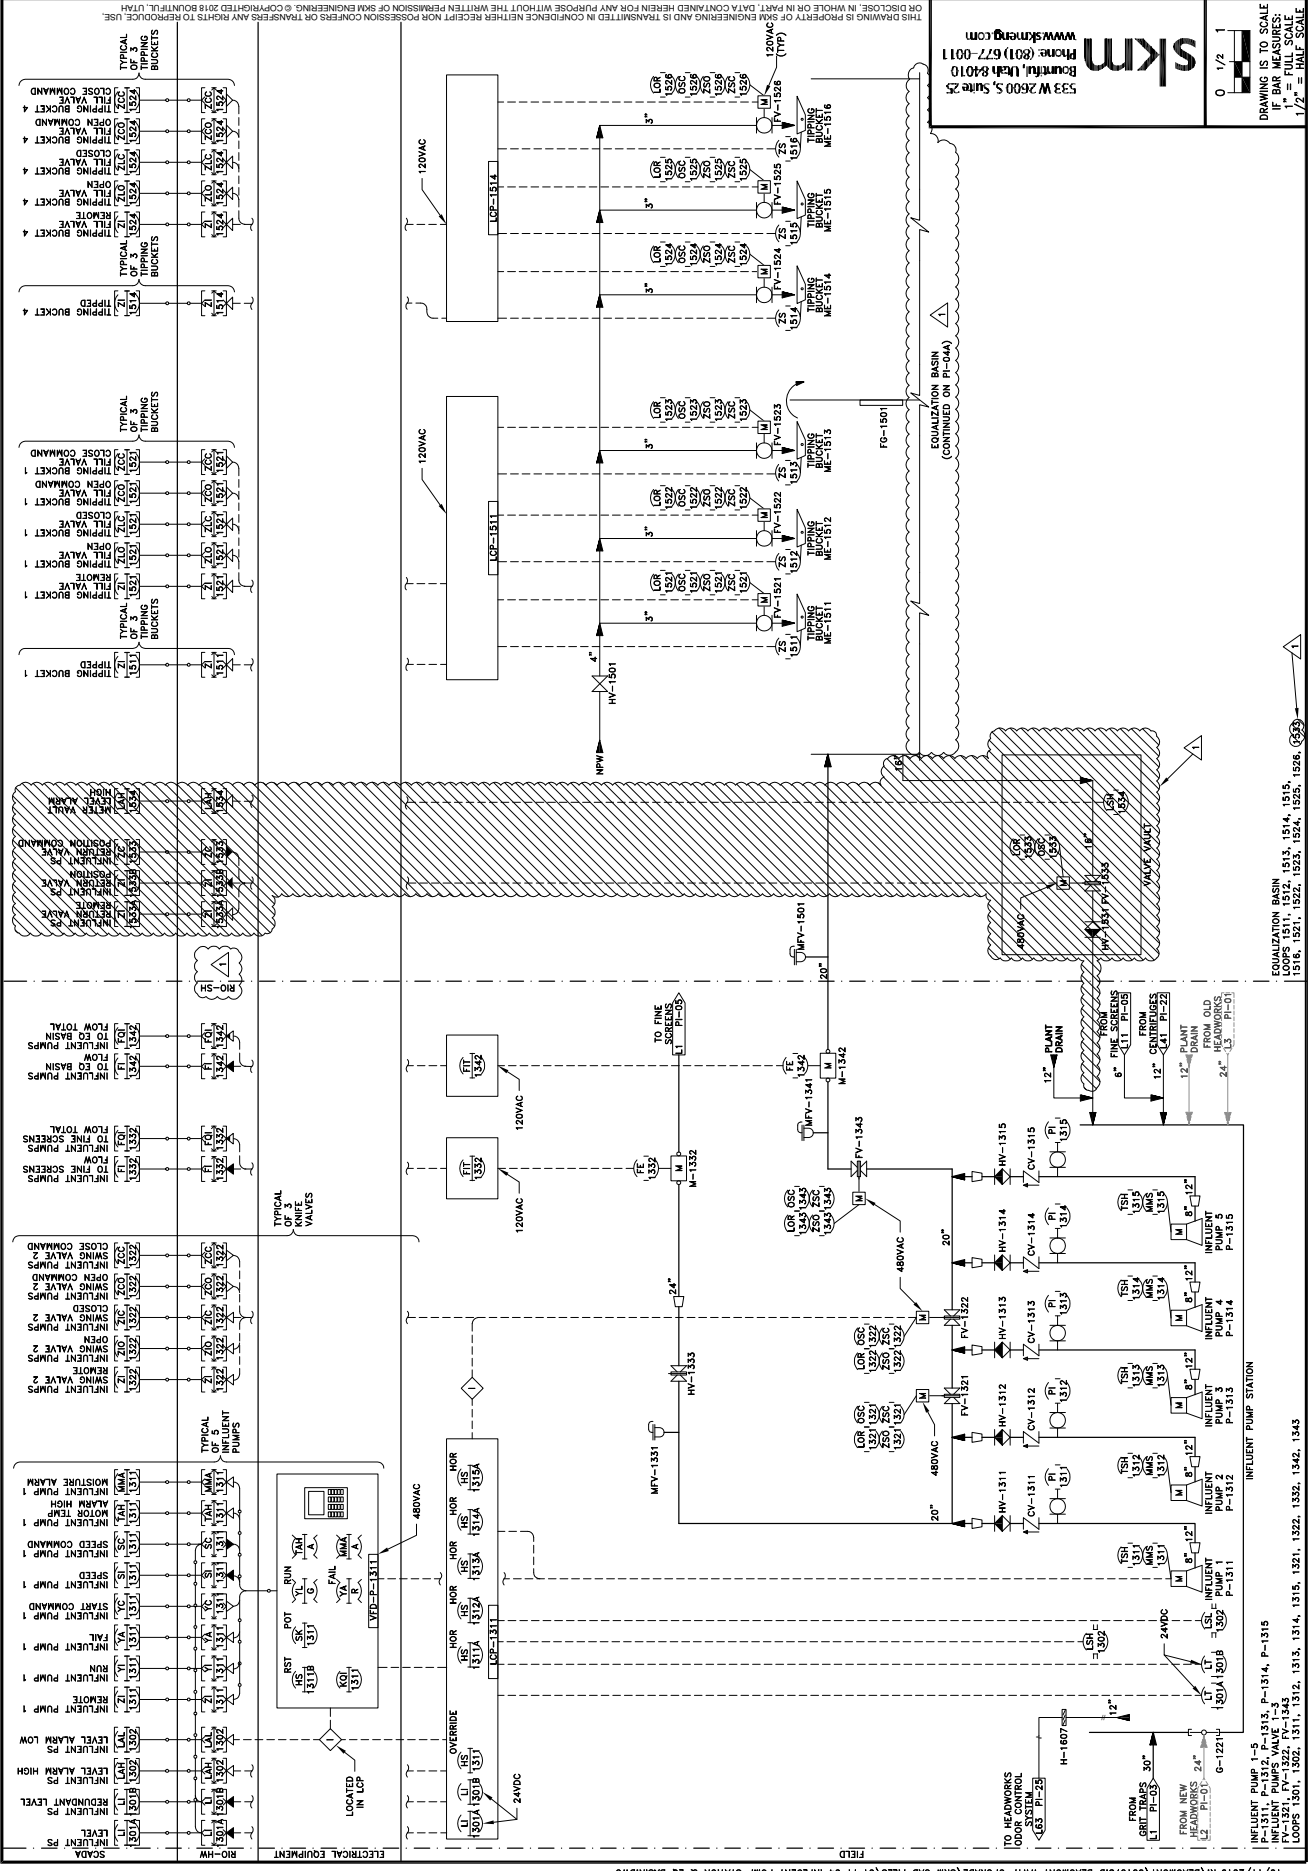

EQUALIZATION BASIN

INFLUENT PUMP STATION

10/11/2019 10:00:00 AM C:\PROJECTS\BEAUMONT\PI-04\INFLUENT PUMP STATION & EQ BASIN.DWG

NO.	DATE	DESIGN	DRAWN	CHECKED
C	09/05/18	MPJ	DCL	MPJ
1	10/11/19	MPJ	DCL	MPJ

CITY OF BEAUMONT
SALT MITIGATION WWTP UPGRADE
INSTRUMENTATION - P&IDs
EQUALIZATION BASIN PUMP STATION




ALBERT A. WEBB & ASSOCIATES
ENGINEERING CONSULTANTS
3788 MCCRAY STREET
PHONE (951) 288-1256
FAX (951) 768-1256

PI-04A
SHEET 8A OF 172

skm
533 W 2600 S, Suite 25
Bountiful, Utah 84010
Phone: (801) 677-0011
www.skmeng.com

0 1/2 1
DRAWING IS TO SCALE
1" = FULL SCALE
1/2" = HALF SCALE

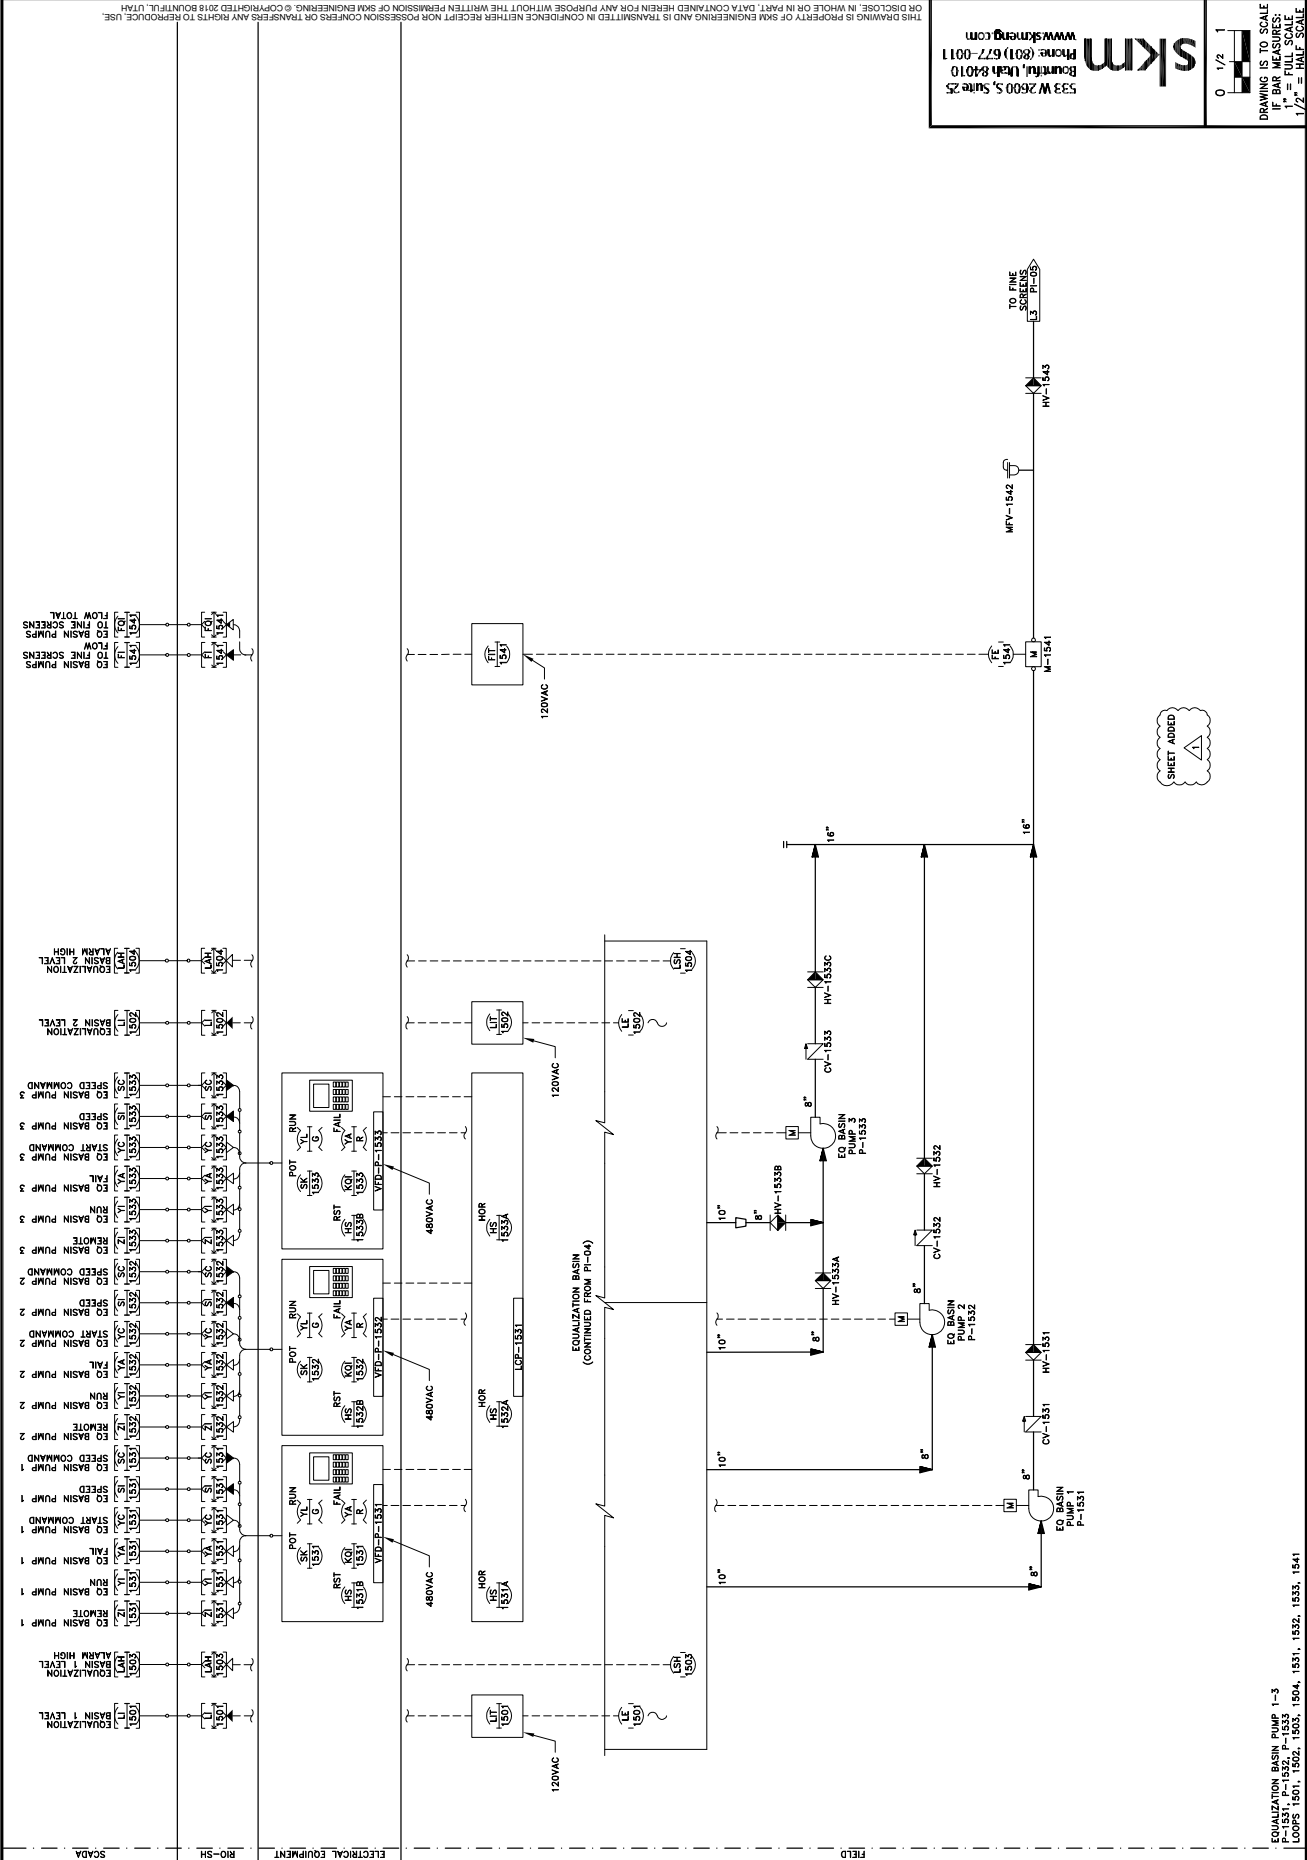

skm
533 W 2600 S, Suite 25
Phone: (801) 677-0011
www.skmeng.com

ALBERT A WEBB
CIVIL ENGINEERS
3788 MCCRAY STREET
PHONE (951) 768-1256
FAX (951) 686-1070

ASSOCIATES
ENGINEERING CONSULTANTS

AQUA
ENGINEERING


633 W 2600 S, SUITE 2725, BOULDER, UT 84010
PHONE (801) 288-1277, FAX (801) 288-0783

CITY OF BEAUMONT
SALT MITIGATION WWP UPGRADE
INSTRUMENTATION - P&IDs
FINE SCREENS

NO. DATE DESIGN DRAWN CHECKED
C 09/05/18 MPJ DCL MPJ

REVISIONS
2 10/11/19 MPJ DCL MPJ
1 11/26/18 MPJ DCL MPJ

ORIGINAL

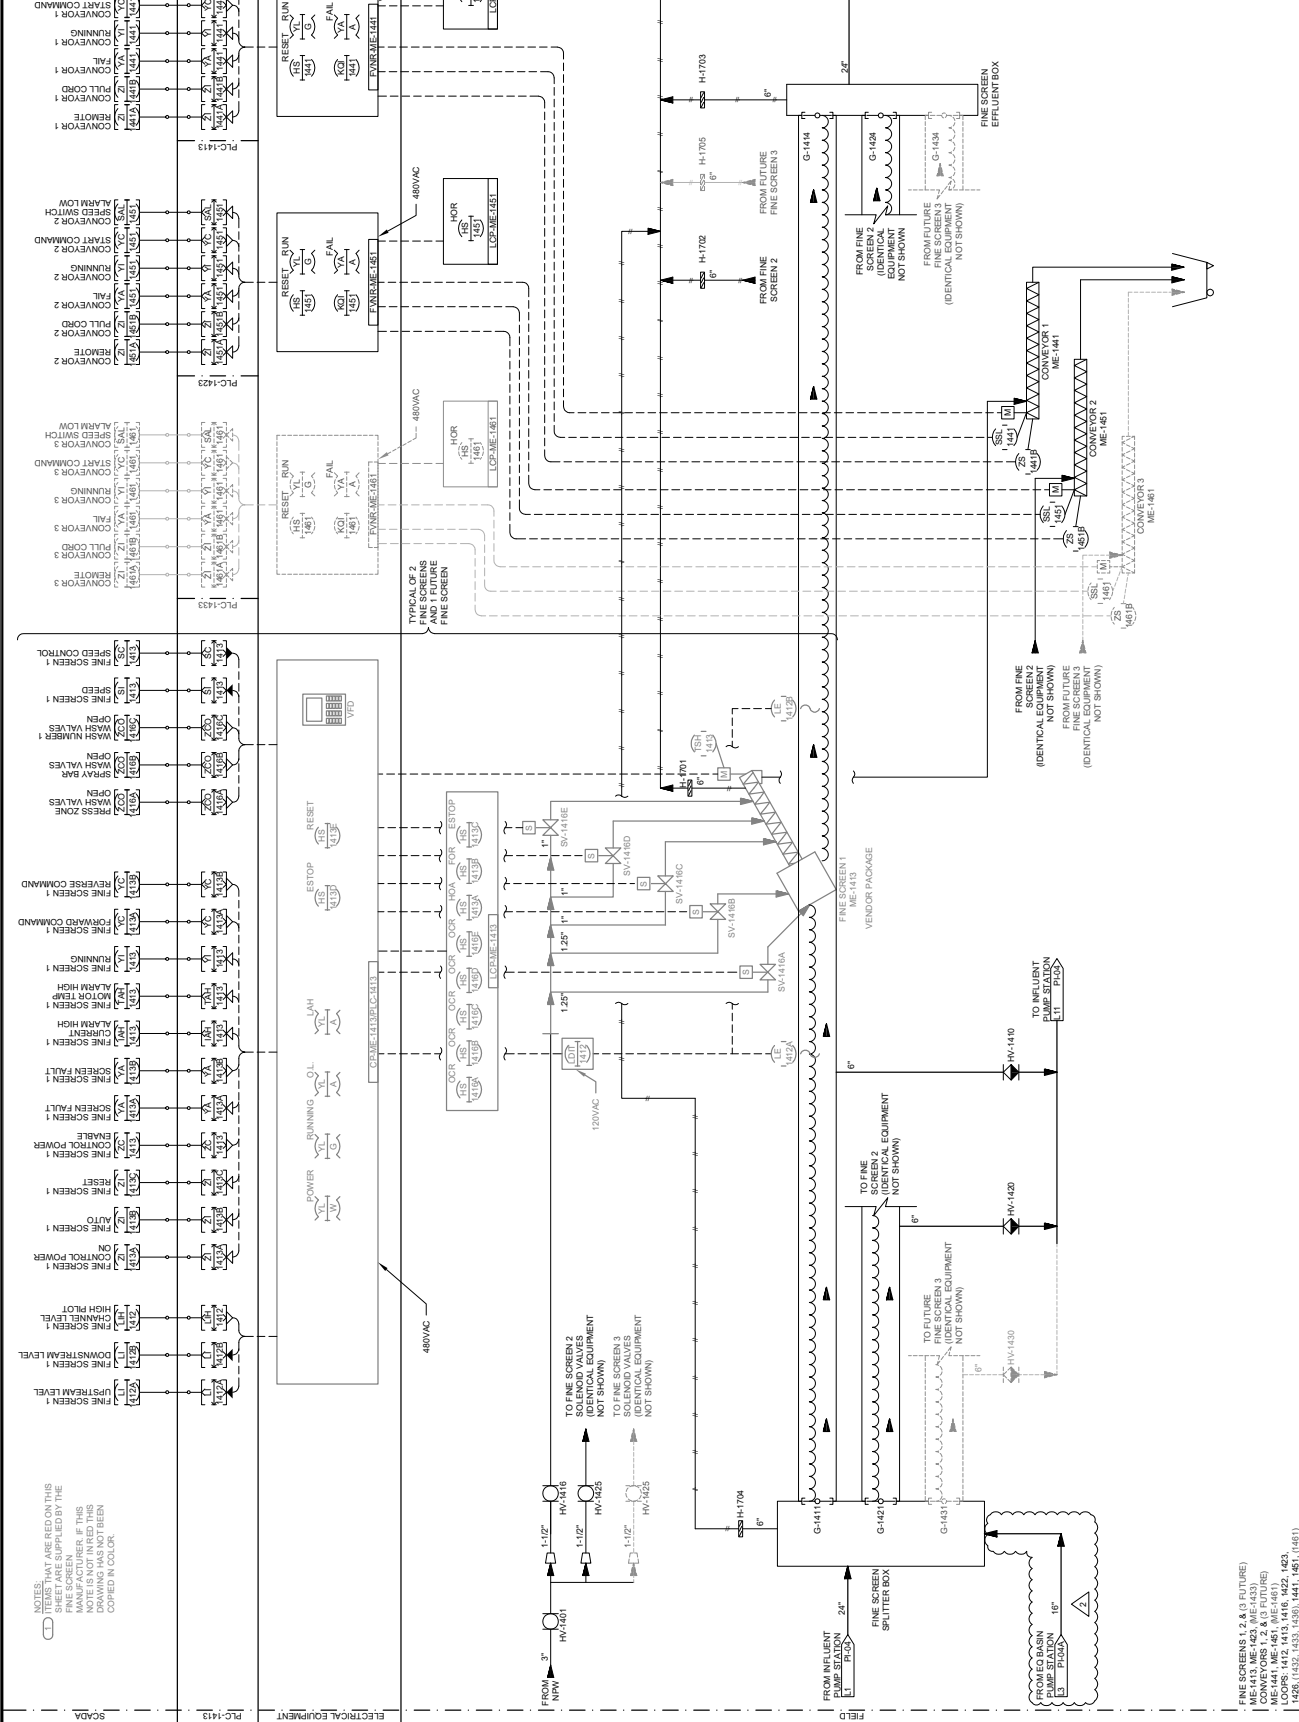

NO.	DATE	DESIGN	CHECKED
C	09/05/18	MPJ	DCL
1	12/18/18	MPJ	MCL
2	08/15/19	MPJ	DCL
3	10/11/19	MPJ	DCL

REVISIONS

CITY OF BEAUMONT
SALT MITIGATION WWTP UPGRADE
ELECTRICAL - SITE
OVERALL SITE PLAN




PHONE (801) 288-1327 FAX (801) 288-0783



ALBERT A
CIVIL ENGINEERS
3788 MCCRAY STREET
PHONE (951) 768-1256
WWW.SKMECH.COM

SHEET 90 OF 172
SE-01

0 1/2 1
DRAWING IS TO SCALE
IF RAS UP ASSES
1" = FULL SCALE
1/2" = HALF SCALE

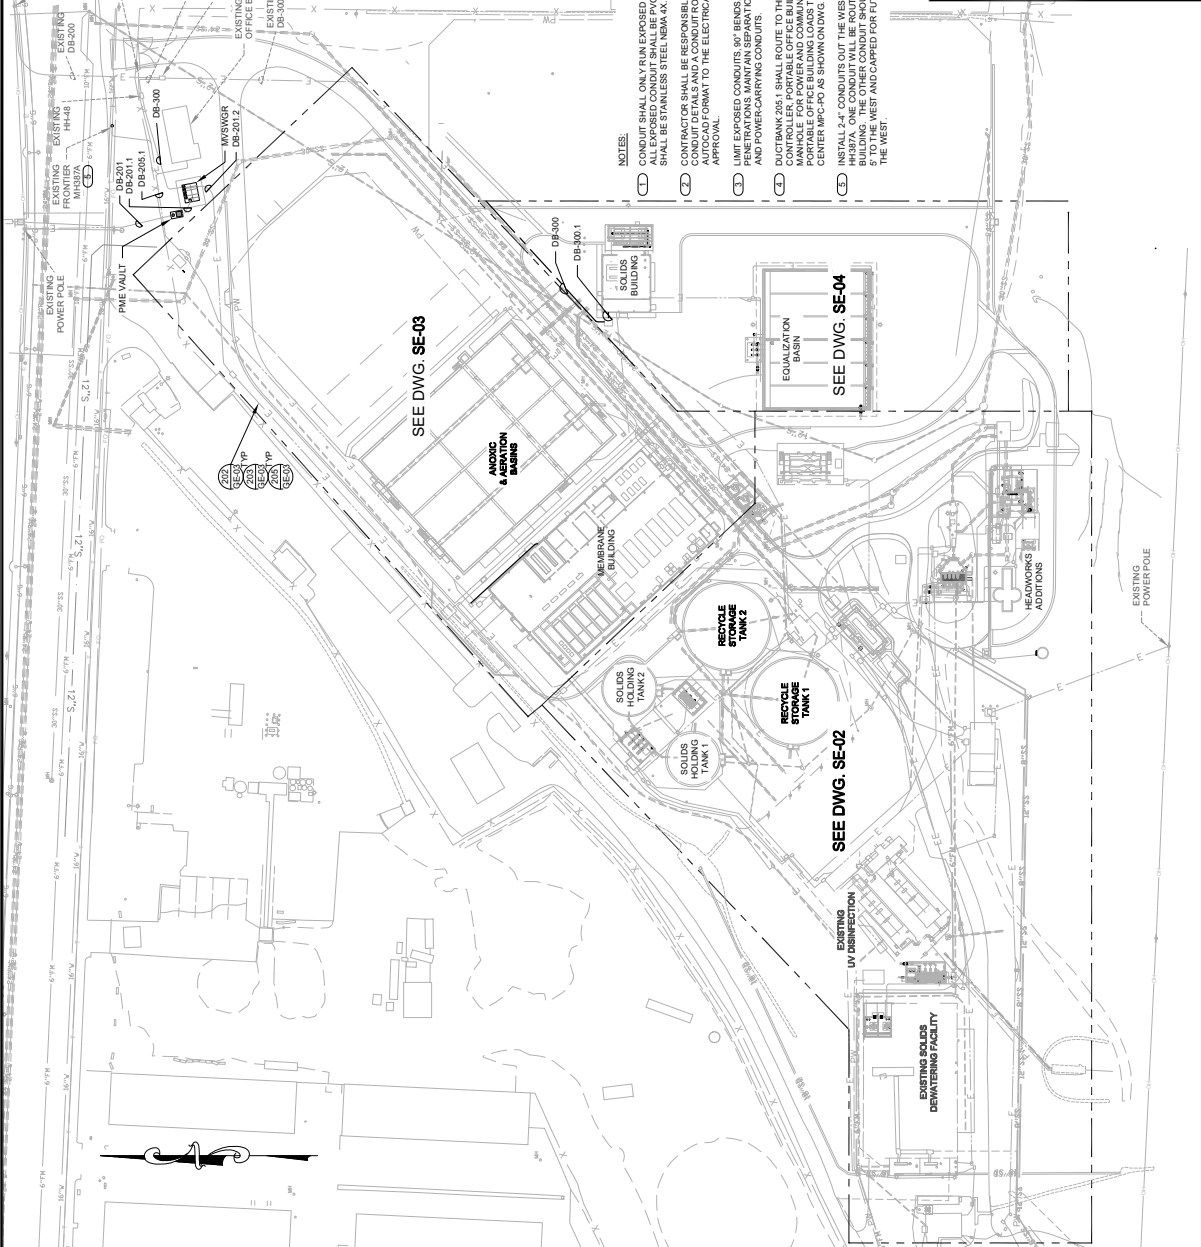

NOTES:

- CONDUIT SHALL ONLY RUN EXPOSED WHERE NECESSARY. ALL CONDUITS SHALL BE STAINLESS STEEL NEMA 4.
- CONTRACTOR SHALL BE RESPONSIBLE FOR SUBMITTING CONDUIT DETAILS AND A CONDUIT ROUTING PLAN IN APPROVED FORMAT TO THE ELECTRICAL ENGINEER FOR APPROVAL.
- INSTALL 2" CONDUIT OUT THE WEST SIDE OF FRONTER HH38A. ONE CONDUIT WILL BE ROUTED TO THE MEMBRANE BUILDING AND THE OTHER WILL BE ROUTED TO THE CENTER OFFICE BUILDING LOADS TO THE WEST.



ITEM	MTL	LOCATION	TYPE	SERVES	NOTES
HH-1	6x3	EXISTING SWGR-HW	POWER	MAIN FEEDERS, HEADWORKS	CLEANOUT AND REUSE
HH-2	4x3	EXISTING SWGR-HW	POWER	EXISTING HEADWORKS	CLEANOUT AND REUSE
HH-3	4x3	EXISTING SWGR-HW	POWER	EXISTING HEADWORKS	CLEANOUT AND REUSE

HANDHOLE SCHEDULE

HANDHOLE H41, H42 & H43 HAVE BEEN RENAMED TO HH-303, HH-304 & HH-305 RESPECTIVELY. THESE HANDHOLES HAVE BEEN RELOCATED SEEDWEG SE-4.

NO.	DATE	DESIGN	DRAWN	CHECKED
C	09/05/18	MPJ	DCL	MPJ
REVISIONS				
1	08/14/19	MPJ	DCL	MPJ
2	10/11/19	MPJ	DCL	MPJ

CITY OF BEAUMONT
 SALT MITIGATION WWTP UPGRADE
 ELECTRICAL - SITE
 SITE PLAN 1




ALBERT A
WEBB
 CIVIL ENGINEERS
 3788 MCCRAY STREET
 PHONE (951) 686-1070
 FAX (951) 768-1256

SHEET 91 OF 172
SE-02

skm
 Phone: (801) 677-0011
 www.skmeng.com

0 1/2" 1"
 DRAWING IS TO SCALE
 IF RING UP SHEETS
 1" = FULL SCALE
 1/2" = HALF SCALE

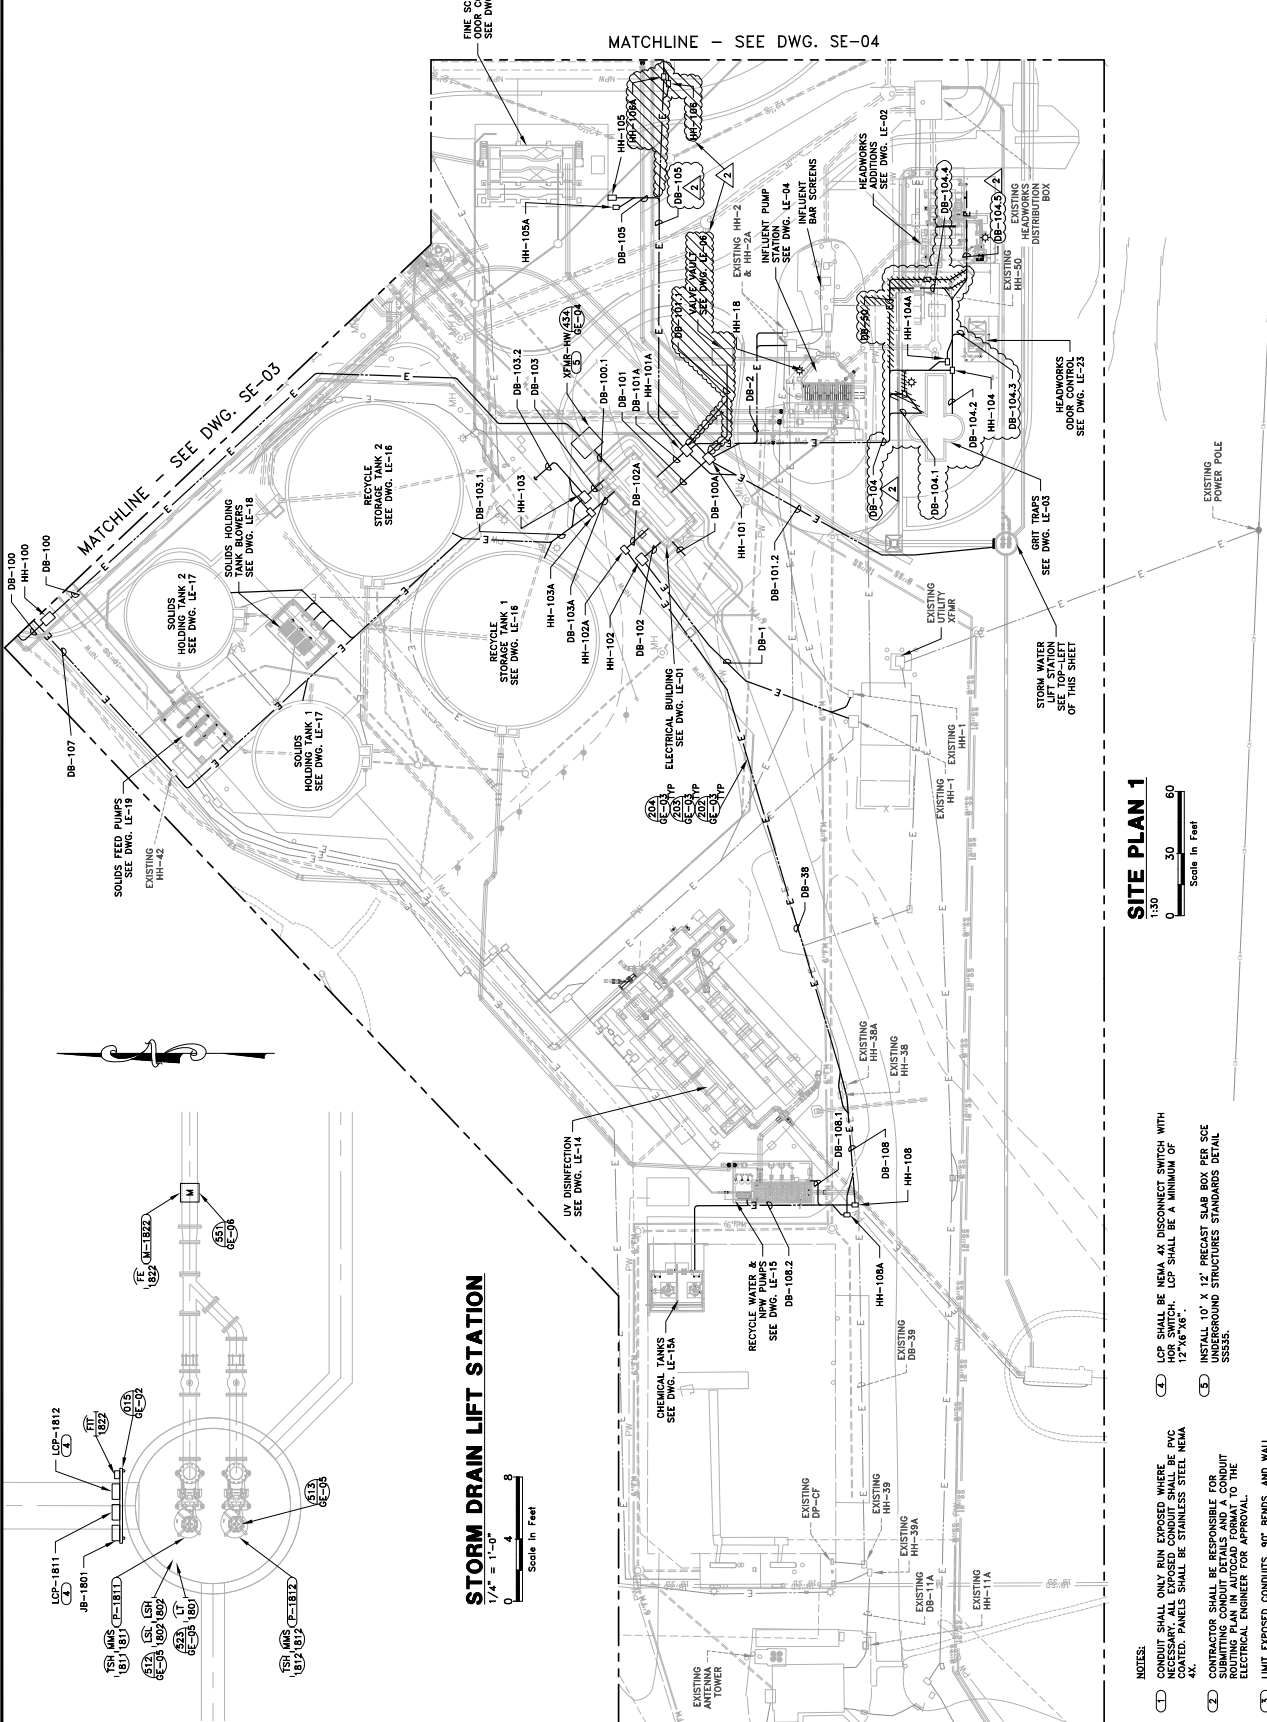

STORM DRAIN LIFT STATION
 1/4" = 1'-0"
 Scale in Feet

SITE PLAN 1
 1:30
 Scale in Feet

- NOTES:**
- CONDUIT SHALL ONLY RUN EXPOSED WHERE NECESSARY. ALL EXPOSED CONDUIT SHALL BE PVC 4X. CONDUIT PANELS SHALL BE STAINLESS STEEL NEMA 4X.
 - CONTRACTOR SHALL BE RESPONSIBLE FOR SUBMITTING CONDUIT DETAILS AND A CONDUIT ERECTING PLAN TO THE PROJECT ENGINEER FOR APPROVAL.
 - ELECTRICAL ENGINEER FOR APPROVAL SHALL PENETRATE CONDUIT SEPARATIONS BETWEEN SIGNAL AND POWER-CARRYING CONDUITS.
 - LCP SHALL BE NEMA 4X DISCONNECT SWITCH WITH HOR SWITCH. LCP SHALL BE A MINIMUM OF 12" X 36" X 6".
 - INSTALL 10" X 12" PRECAST SLAB BOX PER SEE BACKGROUND STRUCTURES STANDARDS DETAIL S3532.

NO.	DATE	DESIGN	DRAWN	CHECKED
C	09/05/18	MJD	DCL	MJD
REVISIONS				
1	12/19/18	MJD	DCL	MJD
2	10/11/19	MJD	DCL	MJD

CITY OF BEAUMONT
SALT MITIGATION WWTP UPGRADE
ELECTRICAL - SITE
SITE PLAN 3





SHEET 93 OF 172
SE-04



0 1/2 1
 DRAWING IS TO SCALE
 IF BAR IS ASSESSED
 1" = FULL SCALE
 1/2" = HALF SCALE

THIS DRAWING IS PROPERTY OF SKM ENGINEERING AND IS TRANSMITTED IN CONFIDENCE NEITHER RECEIPT NOR POSSESSION CONFERS OR TRANSFERS ANY RIGHTS TO REPRODUCE, USE OR DISCLOSE, IN WHOLE OR IN PART, DATA CONTAINED HEREIN FOR ANY PURPOSE WITHOUT THE WRITTEN PERMISSION OF SKM ENGINEERING. © COPYRIGHTED 2018 BOUNTIFUL, UT. A

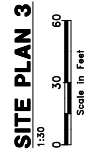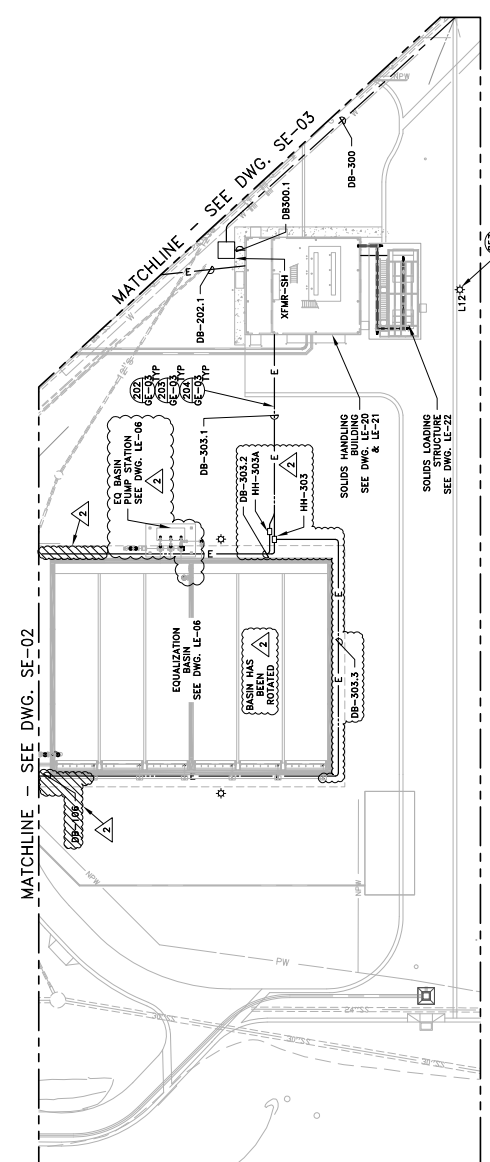

SITE PLAN 3

- NOTES:**
- 1. CONDUIT SHALL ONLY RUN EXPOSED WHERE NECESSARY. ALL EXPOSED CONDUIT SHALL BE PVC UNLESS OTHERWISE NOTED. PANELS SHALL BE STAINLESS STEEL NEMA 4X.
 - 2. CONTRACTOR SHALL BE RESPONSIBLE FOR SUBMITTING CONDUIT DETAILS AND A CONDUIT ROUTING PLAN IN CONDUIT FORMAT TO THE ELECTRICAL ENGINEER FOR APPROVAL.
 - 3. UNLESS OTHERWISE NOTED, ALL PENETRATIONS SHALL MAINTAIN SEPARATION BETWEEN SIGNAL AND POWER-CARRYING CONDUITS.

GE EVOLVE SERIES LED COBRA HEAD
 MODEL FES-0-72-01-5-40-2-08M-F
 WITH 2 HEADS, OR APPROVED EQUAL.



NO.	DATE	DESIGN	DRAWN	CHECKED
C	09/05/18	MPJ	DCL	MPJ
I	10/11/19	MPJ	DCL	MPJ
REVISIONS				

CITY OF BEAUMONT
SALT MITIGATION WWTP UPGRADE
ELECTRICAL - LAYOUT
GRIT TRAPS ELECTRICAL PLAN

AQUA ENGINEERING
 639 W. 2900 S., SUITE 275, BOUNTIFUL, UT 84010
 PHONE (801) 288-1327 FAX (801) 288-0183


ALBERT A. WEBB ASSOCIATES
CIVIL ENGINEERS
 3788 MCCRAY STREET
 RIVERSIDE, CA 92508
 PH: (951) 686-1070
 FAX: (951) 788-1256

SHEET 96 OF 172
LE-03

skm
 533 W. 2600 S., Suite 25
 Bountiful, Utah 84010
 Phone: (801) 677-0011
 www.skmeng.com

DRAWING IS TO SCALE
 IF NOT OTHERWISE NOTED
 1" = FULL SCALE
 1/2" = HALF SCALE

THIS DRAWING IS PROPERTY OF SKM ENGINEERING AND IS TRANSMITTED IN CONFIDENCE NEITHER RECEIPT NOR POSSESSION CONFERS OR TRANSFERS ANY RIGHTS TO REPRODUCE, USE OR DISCLOSE, IN WHOLE OR IN PART, DATA CONTAINED HEREIN FOR ANY PURPOSE WITHOUT THE WRITTEN PERMISSION OF SKM ENGINEERING. © COPYRIGHTED 2019 BOUNTIFUL, UT. ORIGINAL

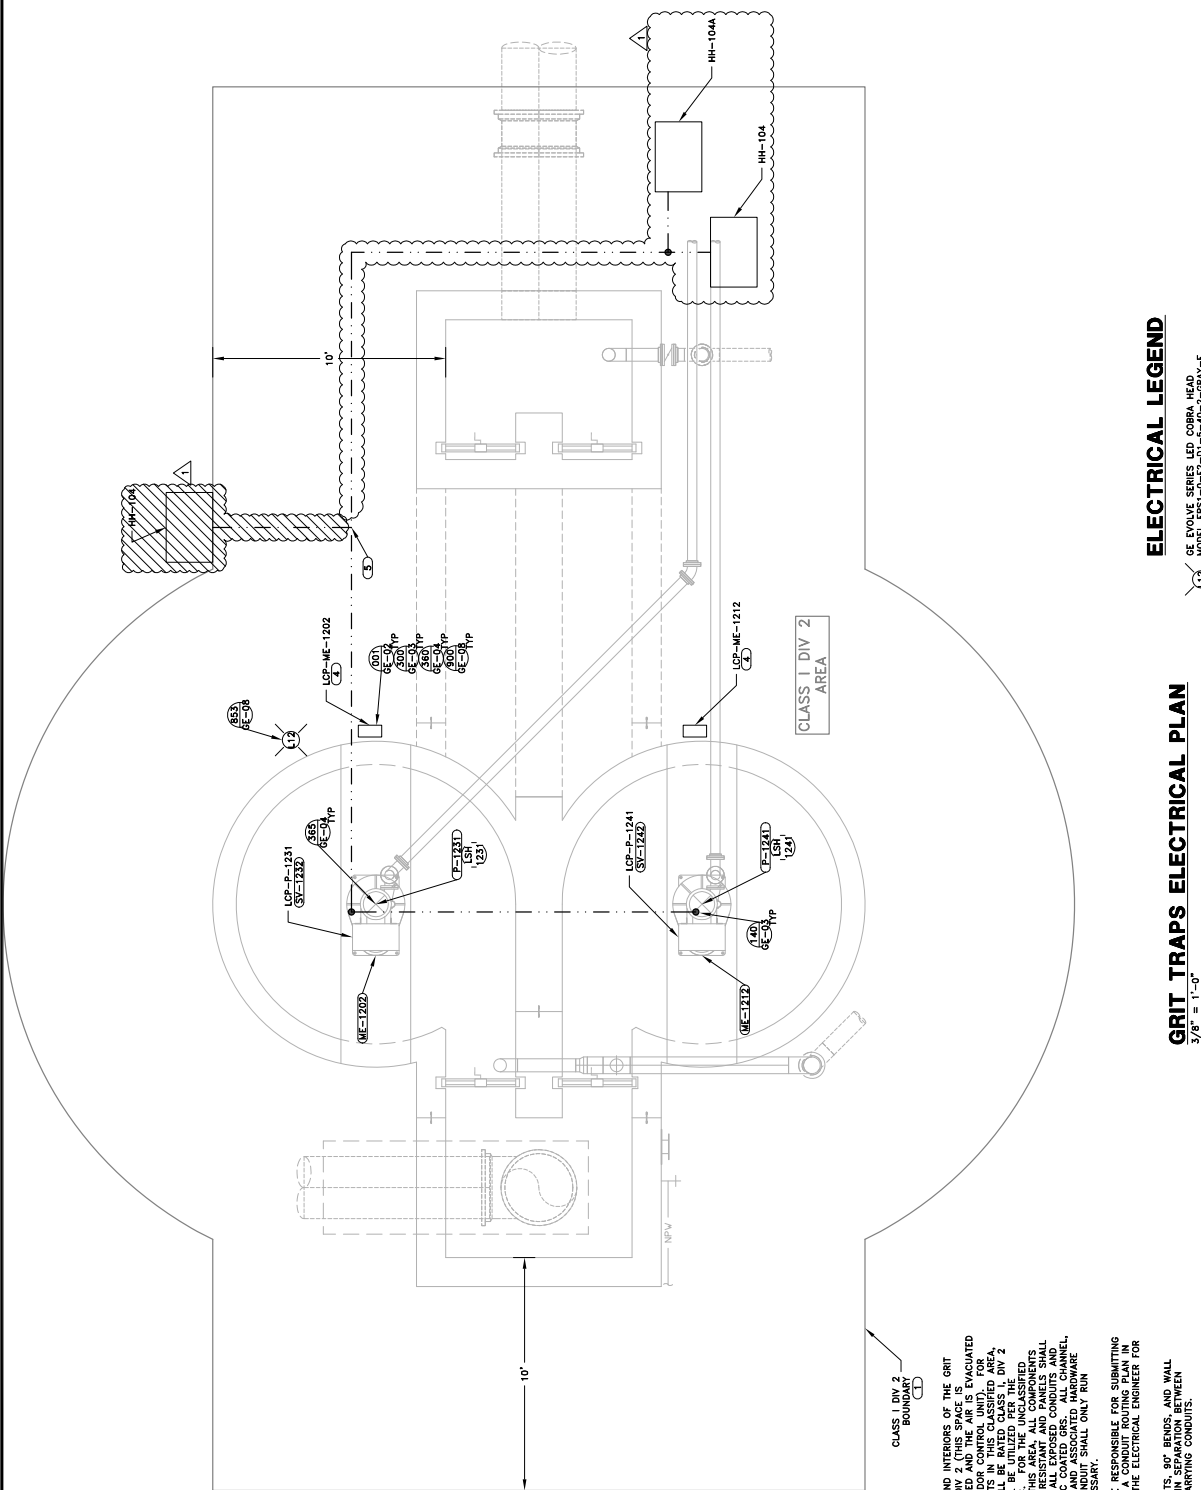

ELECTRICAL LEGEND

- ⊗ GE EVOLVE SERIES LED COBRA HEAD WITH 2 HEADS, OR APPROVED EQUAL
- ⊕ SUPPLY OUTLET
- ⊖ GFCI PROTECTED OUTLET
- ⊖ WP: WEATHER-PROOF OUTLET GFCI PROTECTED.

GRIT TRAPS ELECTRICAL PLAN

3/8" = 1'-0"
 0 2 4
 Scale in Feet

- NOTES:**
1. THE GRIT CHANNELS AND INTERIORS OF THE GRIT TRAPS SHALL BE NEGATIVELY PRESSURIZED AND THE AIR IS EVACUATED TO THE HEADWORKS ODOOR CONTROL UNIT. FOR ALL COMPONENTS SHALL BE RATED CLASS 1, DIV 2 AND SEAL OFFS SHALL BE UTILIZED PER THE SPACE SURROUNDING THIS AREA. ALL COMPONENTS SHALL BE CORROSION RESISTANT AND PANELS SHALL FITTINGS SHALL BE PVC COATED GRS. ALL CHANNEL, SHALL BE STRESS ANCHORED TO STRUCTURAL HARDWARE EXPOSED WHERE NECESSARY.
 2. CONTRACTOR SHALL BE RESPONSIBLE FOR SUBMITTING CONDUIT DETAILS AND A CONDUIT ROUTING PLAN IN APPROVAL.
 3. UNITE EXPOSED CONDUITS, RP7 BRUS AND WALL PENETRATIONS, MAINTAIN SEPARATION BETWEEN SIGNAL AND POWER-CARRYING CONDUITS.
 4. LCP SHALL BE NEMA 4X DISCONNECT SWITCH WITH 12 AS 26".
 5. GROUND GRID SHALL BE CONNECTED TO MAIN GROUND GRID THROUGH DUCT BANK SYSTEM.



NO.	DATE	DESIGN	CHECKED
1	08/14/19	MPJ	CCL
2	10/11/19	MPJ	CCL
REVISIONS			
C	09/05/18	MPJ	CCL
ORIGINAL			

CITY OF BEAUMONT
SALT MITIGATION WWTP UPGRADE
ELECTRICAL - POWER DISTRIBUTION
MCC-HW1 ONELINE


AQUA ENGINEERING
PHONE (801) 288-1327 FAX (801) 288-0183

WEBB ASSOCIATES
ALBERT A. CIVIL ENGINEERS
3788 MCCRAY STREET
RIVERSIDE, CA 92508
PHONE (951) 788-1256
FAX (951) 788-1256


SHEET 119 OF 172
E-03

skm
533 W 2600 S, Suite 25
Phone: (801) 677-0011
www.skmeng.com

0 1/2" = 1'
DRAWING IS TO SCALE
IF RING UP SIZES
1" = FULL SCALE
1/2" = HALF SCALE

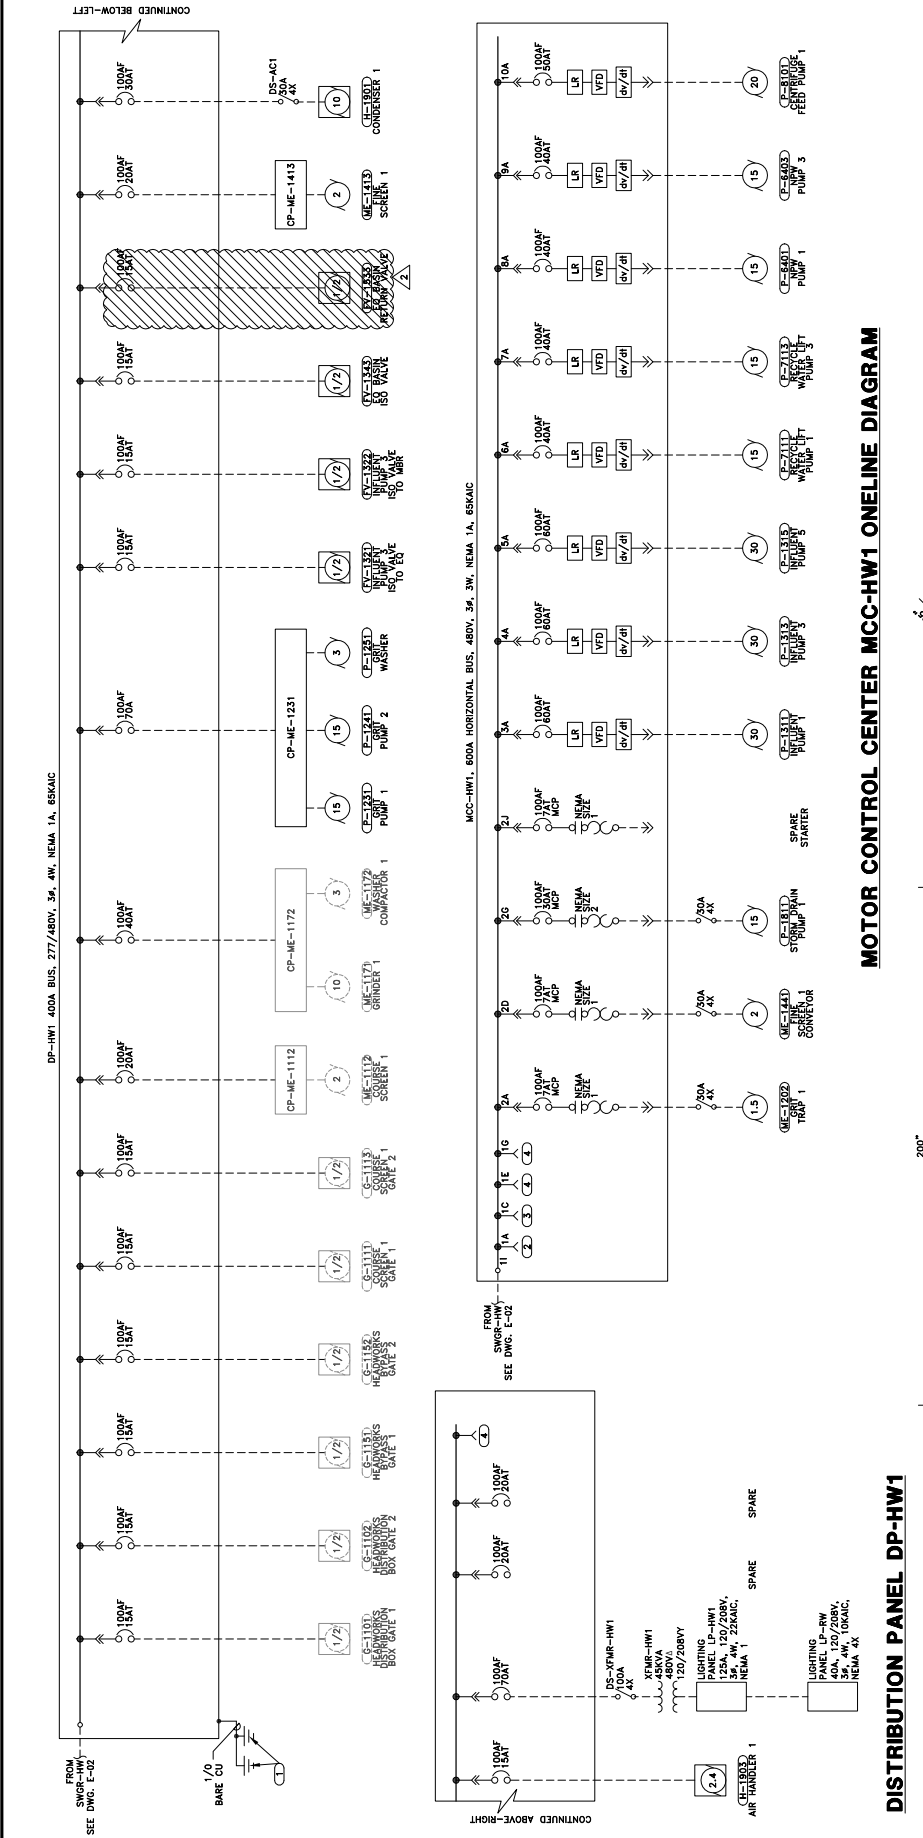

DP-HW1 ELEVATION
SCALE: 1/2" = 1'-0"

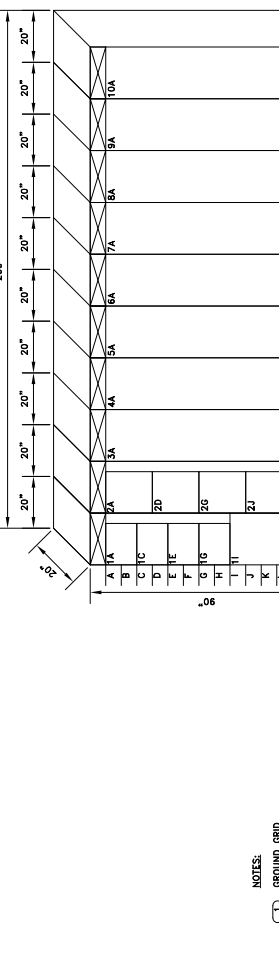

MCC-HW1 ELEVATION
SCALE: 1/2" = 1'-0"

MOTOR CONTROL CENTER MCC-HW1 ONELINE DIAGRAM

DISTRIBUTION PANEL DP-HW1


NOTES:
 (G) GROUND GRID
 (E) ETHERNET SWITCH
 (P) ETHERNET POWER SUPPLY
 (S) SPACE FOR FUTURE VFD, STARTER OR FEDER BREAKER.

NO.	DATE	DESIGN	DRAWN	CHECKED
C	09/05/18	MJD	DCL	MJD
REVISIONS				
2	05/24/19	MJD	DCL	MJD
1	10/11/19	MJD	DCL	MJD


CITY OF BEAUMONT
SALT MITIGATION WWTFF UPGRADE
ELECTRICAL - POWER DISTRIBUTION
SWBD-SH ON LINE

skm
 533 W 2600 S, Suite 25
 Bountiful, Utah 84010
 Phone: (801) 677-0011
 www.skmeng.com

0 1/2" 1"
 DRAWING IS TO SCALE
 IF DIMENSIONS
 1" = FULL SCALE
 1/2" = HALF SCALE

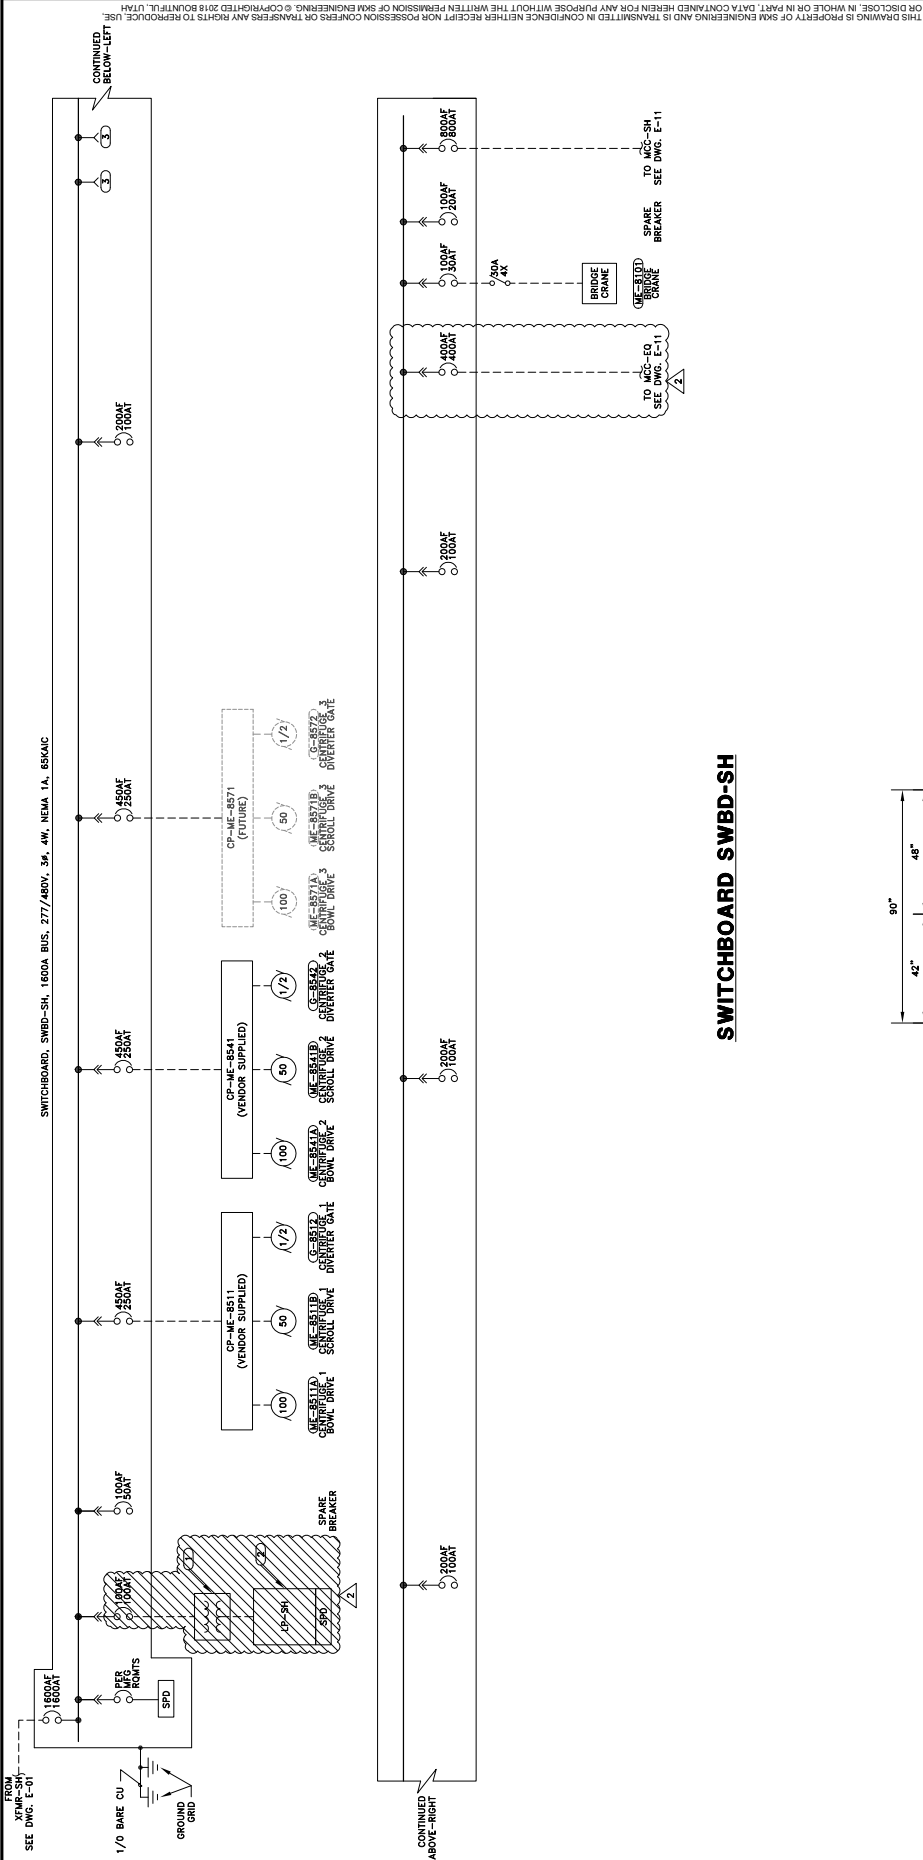

SWITCHBOARD SWBD-SH

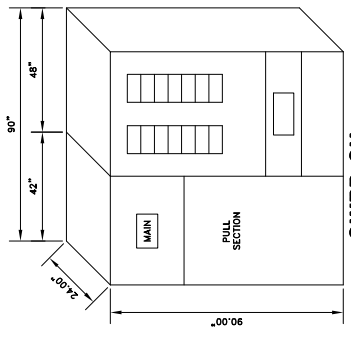


- NOTES:
- 75KVA TRANSFORMER, 120V/208V, 480V FLOOR MOUNTED NEMA 3R SECONDARY
 - LIGHTING PANEL LP-SH, 120V/208V, 3# 4W, 200A, NEMA 1, 22KAIC.
 - SPACE FOR FUTURE FEEDER BREAKER.

NO.	DATE	DESIGN	DRAWN	CHECKED
C	09/05/18	MPJ	DCL	MPJ
REVISIONS				
1	09/16/19	MPJ	DCL	MPJ
2	10/11/19	MPJ	DCL	MPJ

CITY OF BEAUMONT
SALT MITIGATION WWTP UPGRADE
ELECTRICAL - POWER DISTRIBUTION
MCC-SH ONELINE







SHEET 127 OF 172
E-11

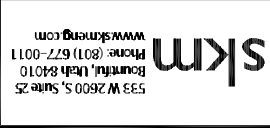

0 1/2" 1"
DRAWING IS TO SCALE
IF DIM. UNLESS
1" = FULL SCALE
1/2" = HALF SCALE

THIS DRAWING IS PROPERTY OF SKM ENGINEERING AND IS TRANSMITTED IN CONFIDENCE. NEITHER RECEIPT NOR POSSESSION CONFERS OR TRANSFERS ANY RIGHTS TO REPRODUCE, USE OR DISCLOSE, IN WHOLE OR IN PART, DATA CONTAINED HEREIN FOR ANY PURPOSES WITHOUT THE WRITTEN PERMISSION OF SKM ENGINEERING. © COPYRIGHTED 2018 BOUNTIFUL, UT. ORIGINAL

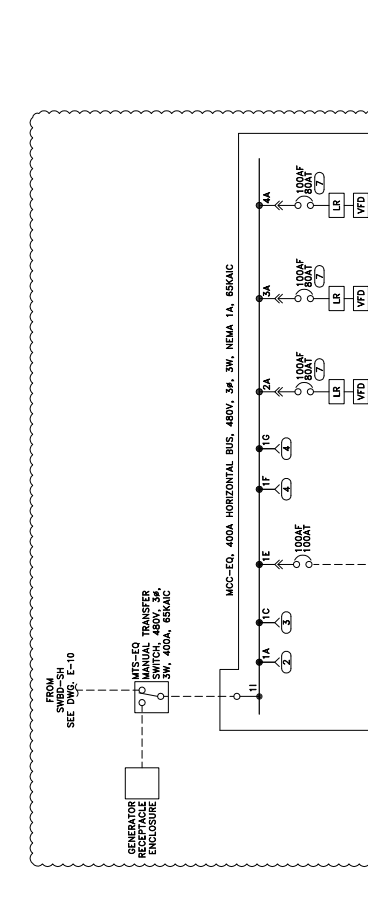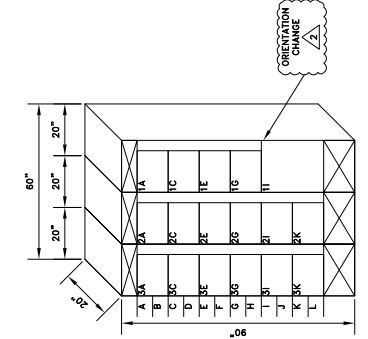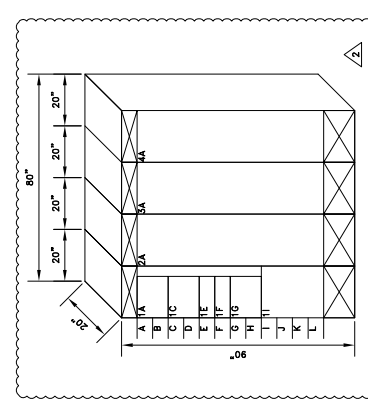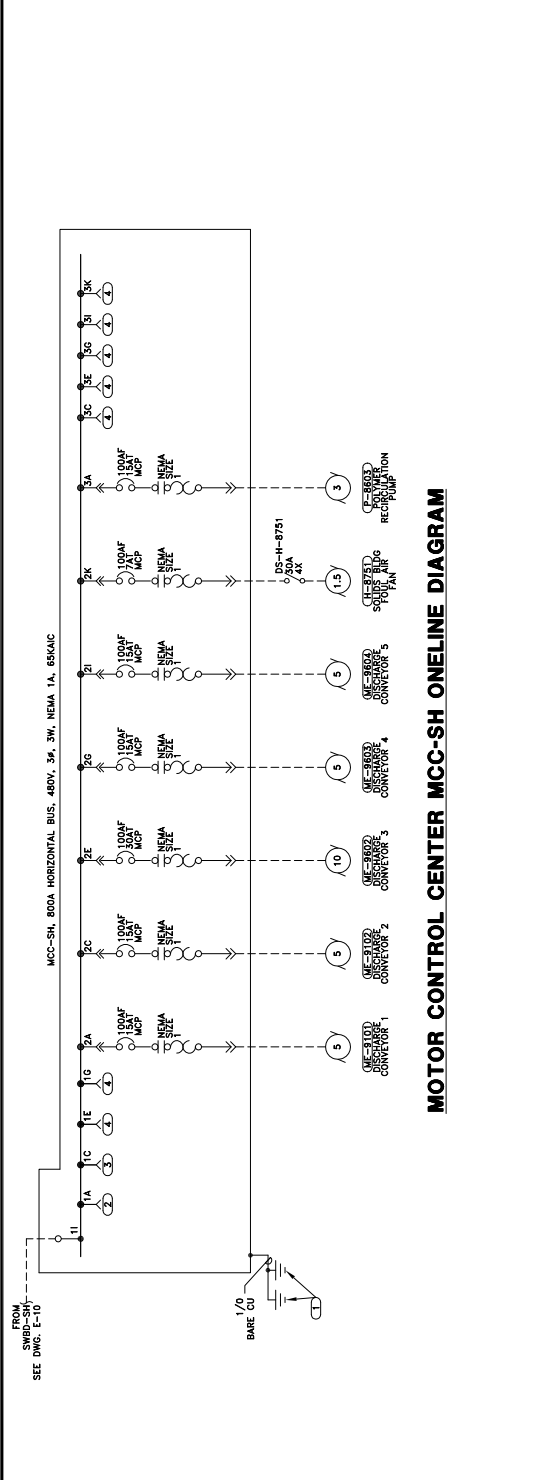

- NOTES:**
- 1. GROUND GRID
 - 2. ETHERNET POWER SUPPLY
 - 3. SPACE FOR FUTURE VFD, STARTER OR FEEDER BREAKER.
 - 4. 78KVA TRANSFORMER XFMR-LP-SH, 480V, 120V/208V Y
 - 5. FLOOR MOUNTED NEMA 3R, 3Ø HW, 200A, NEMA 1, 22KAC.
 - 6. LIGHTING PANEL LP-SH, 120V/208V, 3Ø HW, 200A, NEMA 1, 22KAC.
 - 7. BREAKER AND VFD SHALL BE SIZED FOR FUTURE AOP PUMPS.

NO.	DATE	DESIGN	CHECKED
1	05/08/18	MPJ	MPJ
2	10/11/19	MPJ	MPJ



CIRCUIT DESCRIPTION	KVA	HP	FLA
MOTOR LOADS			
SHUTTER 2 ME-124	3.0	1.5	3.0
MFLUENT PUMP 1 P-1311	30.0	30.0	40.0
MFLUENT PUMP 2 P-1312	30.0	30.0	40.0
MFLUENT PUMP 3 P-1313	30.0	30.0	40.0
MFLUENT PUMP 4 P-1314	30.0	30.0	40.0
FINE SCREEN 2 CONVEYOR ME-1451	2.0	2.0	3.4
FINE SCREEN 2 CONVEYOR ME-1452	2.0	2.0	3.4
MFLUENT PUMP 5 P-1315	15.0	15.0	21.0
MFLUENT PUMP 6 P-1316	15.0	15.0	21.0
RECYCLED WATER LIFT PUMP 2 P-7112	15.0	15.0	21.0
SEWERAGE FEED PUMP 2 P-8102	30.0	30.0	27.0
SEWERAGE FEED PUMP 3 P-8103	30.0	30.0	27.0
SUBTOTAL	165.4	13.0	165.4
+ 25% OF LARGEST MOTOR	19.0	19.0	28.4
TOTAL AMPS @ 480V/PHASE	166.4		166.4
SERVICE SIZE (AMPS)	400.0		400.0

CIRCUIT DESCRIPTION	KVA	HP	FLA
MOTOR LOADS			
SHUTTER 2 ME-124	3.0	1.5	3.0
MFLUENT PUMP 1 P-1311	30.0	30.0	40.0
MFLUENT PUMP 2 P-1312	30.0	30.0	40.0
MFLUENT PUMP 3 P-1313	30.0	30.0	40.0
MFLUENT PUMP 4 P-1314	30.0	30.0	40.0
MFLUENT PUMP 5 P-1315	15.0	15.0	21.0
MFLUENT PUMP 6 P-1316	15.0	15.0	21.0
RECYCLED WATER LIFT PUMP 2 P-7112	15.0	15.0	21.0
SEWERAGE FEED PUMP 2 P-8102	30.0	30.0	27.0
SEWERAGE FEED PUMP 3 P-8103	30.0	30.0	27.0
SUBTOTAL	165.4	13.0	165.4
+ 25% OF LARGEST MOTOR	19.0	19.0	28.4
TOTAL AMPS @ 480V/PHASE	166.4		166.4
SERVICE SIZE (AMPS)	400.0		400.0

MCC-HW2 LOAD CALCULATIONS


MCC-HW1 LOAD CALCULATIONS

SWGR-HW LOAD CALCULATIONS


NO.	DATE	DESIGN	CHECKED
1	08/14/19	MPL	MPL
2	09/10/19	MPL	MPL
3	09/16/19	MPL	MPL
4	10/11/19	MPL	MPL

CITY OF BEAUMONT
SALT MITIGATION WWTUP UPGRADE
ELECTRICAL - POWER DISTRIBUTION
CALCULATIONS 5

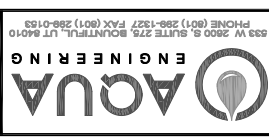

ALBERT A
WEBB
CIVIL ENGINEERS
3788 MCARY STREET

E-16
SHEET 132 OF 172

skm
533 W 2600 S, Suite 25
Phone: (801) 677-0011
www.skmeng.com

0 1/2 1
DRAWING IS TO SCALE
IF DIM. IN PARENTS
1" = FULL SCALE
1/2" = HALF SCALE

THIS DRAWING IS PROPERTY OF SKM ENGINEERING AND IS TRANSMITTED IN CONFIDENCE. NEITHER RECEIPT NOR POSSESSION CONFERES OR TRANSFERS ANY RIGHTS TO REPRODUCE, USE OR DISCLOSE, IN WHOLE OR IN PART, DATA CONTAINED HEREIN FOR ANY PURPOSES WITHOUT THE WRITTEN PERMISSION OF SKM ENGINEERING. © COPYRIGHTED 2019 BY SKM ENGINEERING. ALL RIGHTS RESERVED.

LP-SH LOAD CALCULATIONS

CIRCUIT DESCRIPTION	KVA	HP	FLA
MOTOR LOADS	150.0	180.0	180.0
CENTRIFUGE 1 ME 9511	150.0	180.0	180.0
CENTRIFUGE 2 ME 9541	150.0	180.0	180.0
MCC-SH	34.3	92.2	92.2
AC COMPRESSOR 1 M4809	5.0	7.6	7.6
AC COMPRESSOR 2 M4871	5.0	7.6	7.6
BRIDGE CRANE	10.0	21.0	21.0
CONVERTER LOADS			
SALARIS BALLMILL ANCHOR	46.8	64.2	64.2
TRUCK LOAD OUT FACILITY	15.0	18.1	18.1
MCC-EQ	45.0	174.2	174.2
SUBTOTAL	366.1	560.1	560.1
25% OF LARGEST MOTOR	25.0	25.0	25.0
TOTAL	391.1	585.1	585.1
SERVICE SIZE (AMPS)	600.0		

SWBD-SH LOAD CALCULATIONS

CIRCUIT DESCRIPTION	KVA	HP	FLA
MOTOR LOADS	4.0	7.6	7.6
DISCHARGE CONVERTER ME 8101	4.0	7.6	7.6
DISCHARGE CONVERTER ME 8102	4.0	7.6	7.6
DISCHARGE CONVERTER ME 8625	4.0	7.6	7.6
DISCHARGE CONVERTER ME 8624	4.0	7.6	7.6
SOLIDS BUILDING FAN AIR FAN 1 8851	1.5	3.0	3.0
SOLIDS RECYCLATION FAN 1 8852	3.0	4.5	4.5
NON-MOTOR LOADS			
SUBTOTAL	26.0	52.2	52.2
25% OF LARGEST MOTOR	2.5	2.5	2.5
TOTAL	28.5	54.7	54.7
SERVICE SIZE (AMPS)	80.0		

MCC-SH LOAD CALCULATIONS

CIRCUIT DESCRIPTION	KVA	HP	FLA
MOTOR LOADS	30.0	40.0	40.0
EG BASIN PUMP 3 P-1532	30.0	40.0	40.0
EG BASIN PUMP 3 P-1532	30.0	40.0	40.0
NON-MOTOR LOADS			
SOLIDS BUILDING LIGHTING TRANSFORMER	45.0	54.2	54.2
SUBTOTAL	105.0	174.2	174.2
25% OF LARGEST MOTOR	13.0	13.0	13.0
TOTAL	118.0	187.2	187.2
SERVICE SIZE (AMPS)	400.0		


MCC-EQ LOAD CALCULATIONS


NO.	DATE	DESIGN	CHECKED
C	09/05/18	MPJ	DCL
1	10/09/18	MPJ	DCL
2	12/10/18	MPJ	DCL
3	10/11/19	MPJ	DCL

REVISIONS

CITY OF BEAUMONT
SALT MITIGATION WATER UPGRADE
ELECTRICAL - POWER DISTRIBUTION
VFD SCHEMATIC 1

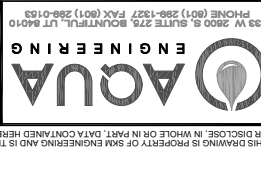


PHONE (801) 288-1377 FAX (801) 288-0125
WWW.SKMECH.COM


ALBERT A. WEBB & ASSOCIATES
CIVIL ENGINEERS
3788 MCCRAY STREET

E-19
SHEET 135 OF 172

VFD CONTROL DESCRIPTION
WHEN THE HOR SWITCH IS IN THE HAND POSITION, THE MOTOR SHOULD RUN, AND WHEN THE HOR SWITCH IS IN THE REMOTE POSITION, THE MOTOR IS CONTROLLED BY THE PLC THROUGH THE ETHERNET NETWORK. THE PLC WILL BE ABLE TO MONITOR WHETHER THE HOR IS IN THE HAND OR REMOTE POSITION.
WHEN THE HOR SWITCH IS IN THE HAND POSITION, THE SPEED COMMAND COMES FROM THE PLC THROUGH THE ETHERNET NETWORK.

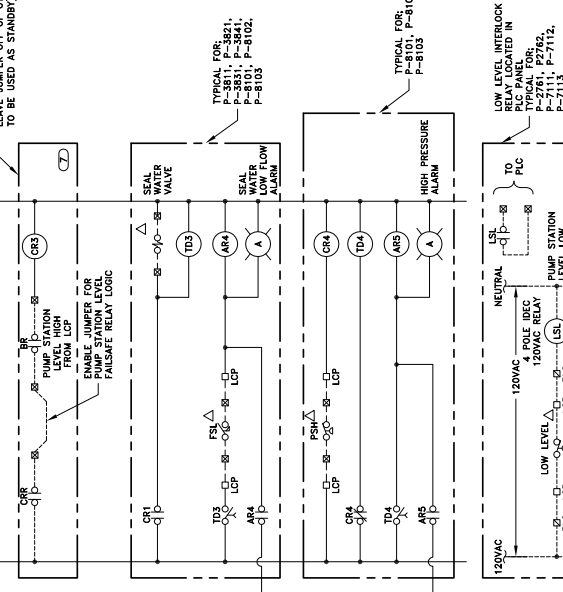

FROM BOTTOM LEFT

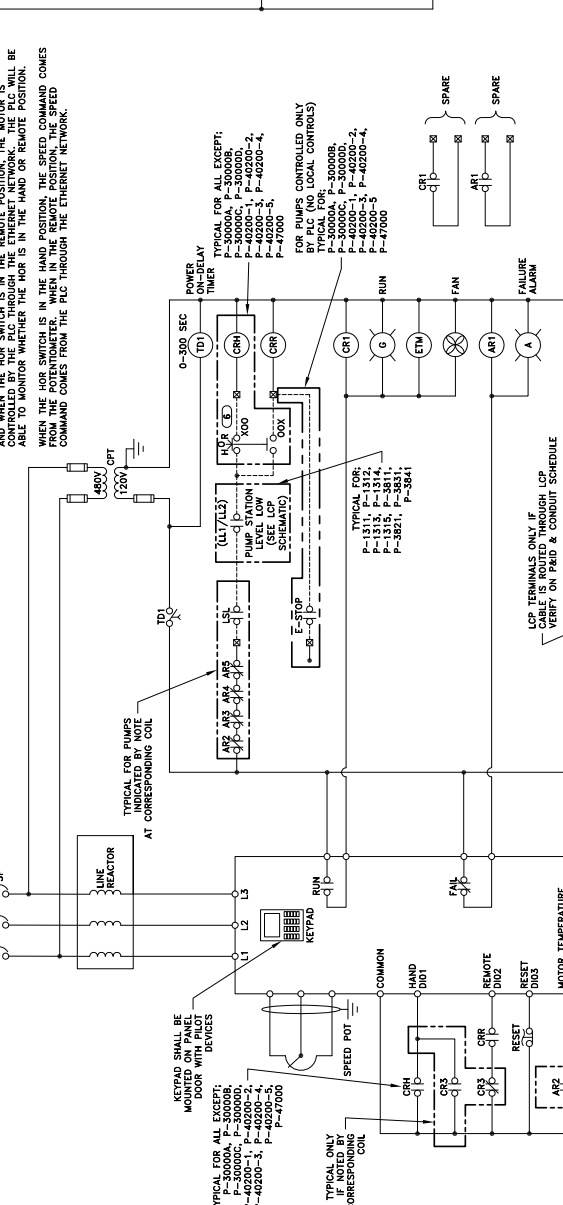

LOW LEVEL INTERLOCK RELAY LOCATED IN TYPICAL FOR: P-2761, P-2762, P-7111, P-7112, P-7113




NOTES:
1. TYPICAL SCHEMATIC DIAGRAMS ARE INTENDED TO REFLECT THE GENERAL CONTROL STRATEGY. ACTUAL CIRCUITRY MAY VARY FOR SPECIFIC EQUIPMENT SUPPLIED. THE OPERATION OF THE EQUIPMENT SHALL BE FURNISHED AS REQUIRED FOR PROPER OPERATION.
2. CONTROL POWER TRANSFORMERS (CPT) SHALL BE ADEQUATELY SIZED AND SHALL BE PROVIDED WITH PROPERLY SIZED FUSES FOR BOTH THE PRIMARY AND SECONDARY WINDINGS.
3. FUSES SHALL BE ADEQUATELY SIZED PER THE EQUIPMENT MANUFACTURER'S RECOMMENDATIONS.
4. ADJUST THE DELAY RELAYS PRIOR TO STARTUP. STAGGER TIMER SETTINGS FOR POWER ON-DELAY RELAYS.
5. CONTROL SWITCHES SHALL BE DOOR MOUNTED ON THEIR RESPECTIVE PANELS. DEVICES SHALL BE RATED FOR LINE VOLTAGE AND 125% OF LOAD CURRENT.
6. LOCAL CONTROLS SHALL BE INSTALLED ACCORDING TO PARO'S AND NOT NECESSARILY AS SHOWN ON SCHEMATICS. SEE LCP SCHEMATICS AND CONDUIT SCHEDULE FOR EXACT WIRING.
7. AS A BACKUP, TO PREVENT PUMP STATION OVER FILL, THIS HARD WIRED FEATURE WILL BE INSTALLED TO PREVENT PUMP STATION OVER FILL TO CAPACITY. TO CONTROL WHICH PUMPS ARE DESIGNATED, INSERT THE JUMPER TO ENABLE AS A DESIGNATED PUMP, OR REMOVE THE JUMPER TO DISABLE DESIGNATION.

FOR PUMPS CONTROLLED ONLY TYPICAL FOR: P-30000A, P-30000B, P-30000C, P-30000D, P-40200-1, P-40200-2, P-40200-3, P-40200-4, P-40200-5, P-47000

FOR PUMPS CONTROLLED ONLY TYPICAL FOR: P-30000A, P-30000B, P-30000C, P-30000D, P-40200-1, P-40200-2, P-40200-3, P-40200-4, P-40200-5, P-47000

9/19/2019 K:\BEAUMONT\001073.03.BEAUMONT.WVF.UPGRADE\SKM CAD FILES\14 E-19 VFD SCHEMATIC 1.DWG


ALBERT ASSOCIATES ENGINEERING CONSULTANTS
 CIVIL ENGINEERS
 3788 MCCRAY STREET
 533 W 2600 S, SUITE 25, BOUNTIFUL UT 84010
 WWW.SKMECH.COM
 Phone: (801) 677-0011

CE-02
 SHEET 144 OF 172
 DRAWING IS TO SCALE
 IF BARS UP ASURES
 1" = FULL SCALE
 1/2" = HALF SCALE

CITY OF BEAUMONT
SALT MITIGATION WWTU UPGRADE
ELECTRICAL - CONDUITS AND DUCTBANKS
CONDUIT SCHEDULE 2

NO. DATE DESIGN DRAWN CHECKED
 C 09/05/18 MPJ DCL
 REVISIONS
 1 01/18/19 MPJ DCL
 2 06/24/19 MPJ DCL
 3 10/11/19 MPJ DCL

THIS DRAWING IS PROPERTY OF SKM ENGINEERING AND IS TRANSMITTED IN CONFIDENCE. NEITHER THIS DRAWING NOR ANY PART THEREOF SHALL BE REPRODUCED, COPIED, DISCLOSED, IN WHOLE OR IN PART, OR TRANSMITTED IN ANY MANNER WITHOUT THE WRITTEN PERMISSION OF SKM ENGINEERING. © COPYRIGHTED 2019 SKM ENGINEERING.

NOTES:
 (1) CONDUITS THAT ARE COMBINED BETWEEN PULL POINTS ARE DENOTED WITH A + (+) SYMBOL. SEE THE COMBINED CONDUITS SCHEDULE ON SHEET 143 FOR DETAILS. EACH CONDUIT SHALL BE IDENTIFIED WITH MULTIPLE CONDUIT TAGS, ONE FOR EACH CONDUIT THAT HAS BEEN COMBINED.
 (2) THE CONDUIT DEVELOPER AND SCHEDULE DOES NOT SHOW CONDUIT AND CONDUCTORS FOR LIGHTS, RECEPTACLES AND DATA JACKS. IT ALSO DOES NOT SHOW CONDUIT AND CONDUCTORS FOR THE CONTROL ROOM, MECHANICAL ROOM AND RESTROOMS. THE CONTRACTOR IS RESPONSIBLE FOR PROVIDING THE CONDUIT AND CONDUCTORS IN THEIR WORK AND IN THEIR SUBMITTED CONDUIT ROUTING PLAN.

(3) STUB UP AND CAP
 (4) STUB UP AND CAP NEAR FUTURE PUMP LOCATION

(5) ROUTE POWER THROUGH A 20A 120VAC DISCONNECT SWITCH



CONDUIT UPGRADES
 P1501, P1514,
 P1511, P1517,
 P1512, P1513,
 P1514, P1515,
 P1516, P1517,
 P2746, P2747,
 P2748, P2749



533 W 2600 S, Suite 25
Phone: (801) 677-0011
www.skmeng.com



ALBERT A
WEBB ASSOCIATES
ENGINEERING CONSULTANTS





CITY OF BEAUMONT		SALT MITIGATION WTRP UPGRADE		ELECTRICAL - CONDUITS AND DUCTBANKS		CONDUIT SCHEDULE 4	
NO.	DATE	DESIGN	DRAWN	CHECKED	MPJ		
REVISIONS							
1	10/09/18	MPJ					
2	06/24/19	MPJ					
3	10/11/19	MPJ					
ORIGINAL							

CONDUITS THAT ARE COMBINED BETWEEN PULL POINTS ARE DENOTED WITH A "+" (PLUS) SYMBOL. SEE THE COMBINED CONDUITS SCHEDULE ON SHEET CE-11. CONDUITS THAT HAVE BEEN COMBINED SHALL BE LABELLED WITH MULTIPLE CONDUIT TAGS, ONE FOR EACH CONDUIT THAT HAS BEEN COMBINED.

CONDUIT DEVELOPMENT AND SCHEDULE DOES NOT SHOW CONDUIT AND CONDUCTORS FOR LIGHTS, RECEPTACLES AND DATA JACKS. IT ALSO DOESN'T SHOW CONDUIT AND CONDUCTORS FOR THE NER BUILDING'S MECHANICAL ROOM, ELECTRICAL CONTROL ROOM, MECHANICAL ROOM, LAB, MECHANICAL ROOM AND RESTROOMS. THE CONTRACTOR IS RESPONSIBLE TO INCLUDE THESE CONDUITS AND CONDUCTORS IN THEIR WORK AND IN THEIR SUBMITTED CONDUIT ROUTING PLAN.

CONDUIT ID	SIZE	CONDUCTIONS	SERVICE	FROM	TO	COMBINED	DUCTBANKS	NOTES
P9602	1"	3#10 WF#12 GND	48VAC	MCC-SH	NE-B002		301, 301.2	
P9603	1"	3#10 WF#12 GND	48VAC	MCC-SH	NE-B003		301, 301.2	
P9604	1"	3#10 WF#12 GND	48VAC	MCC-SH	NE-B004		301, 301.2	
P9611	1"	3#12 WF#2 GND	120VAC	LP-SH	LP-SH			THRU 48VAC CABLE TRAY
P9605	1"	3#12 WF#2 GND	120VAC	LP-SH	MIT-B001			THRU 48VAC CABLE TRAY
P30008	2"	3#12 WF#2 GND	48VAC	MCC-AB2	P-30008			THRU 48VAC CABLE TRAY

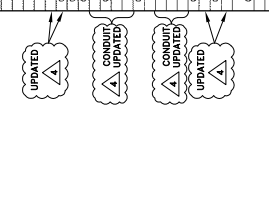

UPDATED
CONDUIT ADDED
CONDUIT ADDED
UPDATED

2
CONDUIT
UPDATED

CONDUIT #	SIZE	CONDUCTIONS	SERVICE	FROM	TO	COMBINED	DUCTBANKS	NOTES
F0101	2"	SHIELDED CAB	COMMS	SMGR-HW	CIC-HW			
F1002	1"	SHIELDED CAB	COMMS	MCC-HW	CIC-HW			
F1003	1"	SHIELDED CAB	COMMS	MCC-HW	CIC-HW			
F1004	2"	SHIELDED CAB	COMMS	RO-HW	CIC-HW			
F1005	2"	24.5 TRAND FIBER SW	COMMS	CIC-HW	CIC-HW			
F1006	2"	24.5 TRAND FIBER SW	COMMS	CIC-HW	CIC-HW			
F1007	1"	SHIELDED CAB	COMMS	SMGR-HW	CIC-HW			
F1008	1"	SHIELDED CAB	COMMS	MCC-HW	CIC-HW			
F1009	2"	SHIELDED CAB	COMMS	RO-HW	CIC-HW			
F1010	2"	SHIELDED CAB	COMMS	PLC-RD	CIC-HW			
F1011	2"	SHIELDED CAB	COMMS	CIC-CAB	RO-SH			
F1012	2"	SHIELDED CAB	COMMS	CIC-CAB	RO-SH			
NOTES:
 (1) CONDUITS THAT ARE COMBINED BETWEEN FULL POINTS ARE DENOTED WITH A + (+) SYMBOL. SEE THE COMBINED CONDUITS SCHEDULE ON SHEET 151 OF 172 FOR THE COMBINED CONDUIT THAT HAS BEEN COMBINED.
 (2) THE CONDUIT DEVELOPMENT AND SCHEDULE DOES NOT SHOW CONDUIT AND CONDUCTORS FOR LIGHTS, RECEPTACLES AND DATA JACKS. IT ALSO DOES NOT SHOW CONDUIT AND CONDUCTORS FOR MECHANICAL ROOM, LAB, MECHANICAL ROOM AND RESTROOMS. THE CONTRACTOR IS RESPONSIBLE FOR PROVIDING THE CONDUIT AND CONDUCTORS IN THEIR WORK AND IN THEIR SUBMITTED CONDUIT ROUTING PLAN.

skm
 533 W 2600 S, Suite 25
 Bountiful, Utah 84010
 Phone: (801) 677-0011
 www.skmeng.com

DRAWING IS TO SCALE
 UNLESS OTHERWISE NOTED
 1" = FULL SCALE
 1/2" = HALF SCALE

CE-09
 SHEET 151 OF 172

ALBERT A
WEBB
 CIVIL ENGINEERS
 3788 MCCRAY STREET
 ENGINEERING CONSULTANTS
 ASSOCIATES

AQUA
 ENGINEERING
 633 W 2900 S, SUITE 272, BOUNTIFUL, UT 84010
 PHONE (801) 288-1327 FAX (801) 288-0123

CITY OF BEAUMONT
 SALT MITIGATION WITH UPGRADE
 ELECTRICAL - CONDUITS AND DUCTBANKS
 CONDUIT SCHEDULE 9

NO.	DATE	DESIGN	CHECKED
C	09/05/18	MPJ	MPJ
1	08/14/19	MPJ	MPJ
2	11/19/19	MPJ	MPJ

NO.	DATE	DESIGN	DRAWN	CHECKED
1	08/14/19	MPJ	DCL	MPJ
2	10/11/19	MPJ	DCL	MPJ

CITY OF BEAUMONT
SALT MITIGATION WTRP UPGRADE
ELECTRICAL - CONDUITS AND DUCTBANKS
CONDUIT SCHEDULE 10



ALBERT A. WEBB & ASSOCIATES
ENGINEERING CONSULTANTS
3788 MCCRAY STREET

CE-10
SHEET 152 OF 172

skm
533 W 2600 S, Suite 25
Phone: (801) 677-0011
www.skmeng.com

0 1/2" = 1'
DRAWING IS TO SCALE
IF DIMENSIONS
1" = FULL SCALE
1/2" = HALF SCALE

THIS DRAWING IS THE PROPERTY OF SKM ENGINEERING AND IS TRANSMITTED IN CONFIDENCE. NEITHER RECEIPT NOR POSSESSION CONFERES OR TRANSFERS ANY RIGHTS TO REPRODUCE, USE OR DISCLOSE, IN WHOLE OR IN PART, DATA CONTAINED HEREIN FOR ANY PURPOSES WITHOUT THE WRITTEN PERMISSION OF SKM ENGINEERING. © COPYRIGHTED 2019 SKM ENGINEERING, UT 04-010

CONDUITS THAT ARE COMBINED BETWEEN FULL PRINTS ARE REMOVED WITH CONDUIT (PLUS) SYMBOLS. SEE THE COMBINED CONDUITS SCHEDULE AND SHEET CE-11. CONDUITS THAT HAVE BEEN COMBINED SHALL BE LABELED MULTIPLE CONDUIT TAGS, ONE FOR EACH CONDUIT THAT HAS BEEN COMBINED.

THE CONDUIT DEVELOPMENT AND SCHEDULE DOES NOT SHOW CONDUIT AND CONDUCTORS FOR LIGHTS, RECEPTACLES AND DATA JACKS. IT ALSO DOESN'T SHOW CONDUIT AND CONDUCTORS FOR THE MBR BUILDING'S MECHANICAL ROOM AND RESTROOMS. THE CONTRACTOR IS RESPONSIBLE TO INCLUDE THESE CONDUITS AND CONDUCTORS IN THEIR WORK AND IN THEIR SUBMITTED CONDUIT ROUTING PLAN.

CONDUIT	SIZE	CONDUCTORS	SERVICE	MARKER	CONDUIT	COMBINED	DUCTBANKS	NOTES
SP102	4"	PULL STRING	12WAC	STANBY GENERATOR	RO-D24W		202, 202.1	
SP103	4"	PULL STRING	48WAC	STANBY GENERATOR	SWGR-HW		105	
SP104	4"	PULL STRING	48WAC	STANBY GENERATOR	RO-D24W		105	
SP105	4"	PULL STRING	48WAC	STANBY GENERATOR	RO-D24W		105	
CONDUIT ADDED
CONDUIT UPDATED
CONDUIT UPDATED
CONDUIT ADDED

NO.	DATE	DESIGN	DRAWN	CHECKED
C	09/05/18	MPJ	DCL	MPJ
REVISIONS				
I	10/11/19	MPJ	DCL	MPJ

CITY OF BEAUMONT
SALT MITIGATION WTRP UPGRADE
ELECTRICAL - CONDUITS AND DUCTBANKS
CONDUIT DEVELOPMENT 2




633 W. 2800 S. SUITE 275, BOUNTIFUL, UT 84010
 PHONE (801) 288-1327 FAX (801) 288-0123

WEBB ASSOCIATES
 CIVIL ENGINEERS
 3788 MCCRAY STREET
 RIVERSIDE, CA 92508
 PH (951) 686-1070
 FX (951) 788-1256

SHEET 155 OF 172
CE-13

skm
 533 W. 2600 S. SUITE 25
 BOUNTIFUL, UTAH 84010
 Phone: (801) 677-0011
 www.skmeng.com

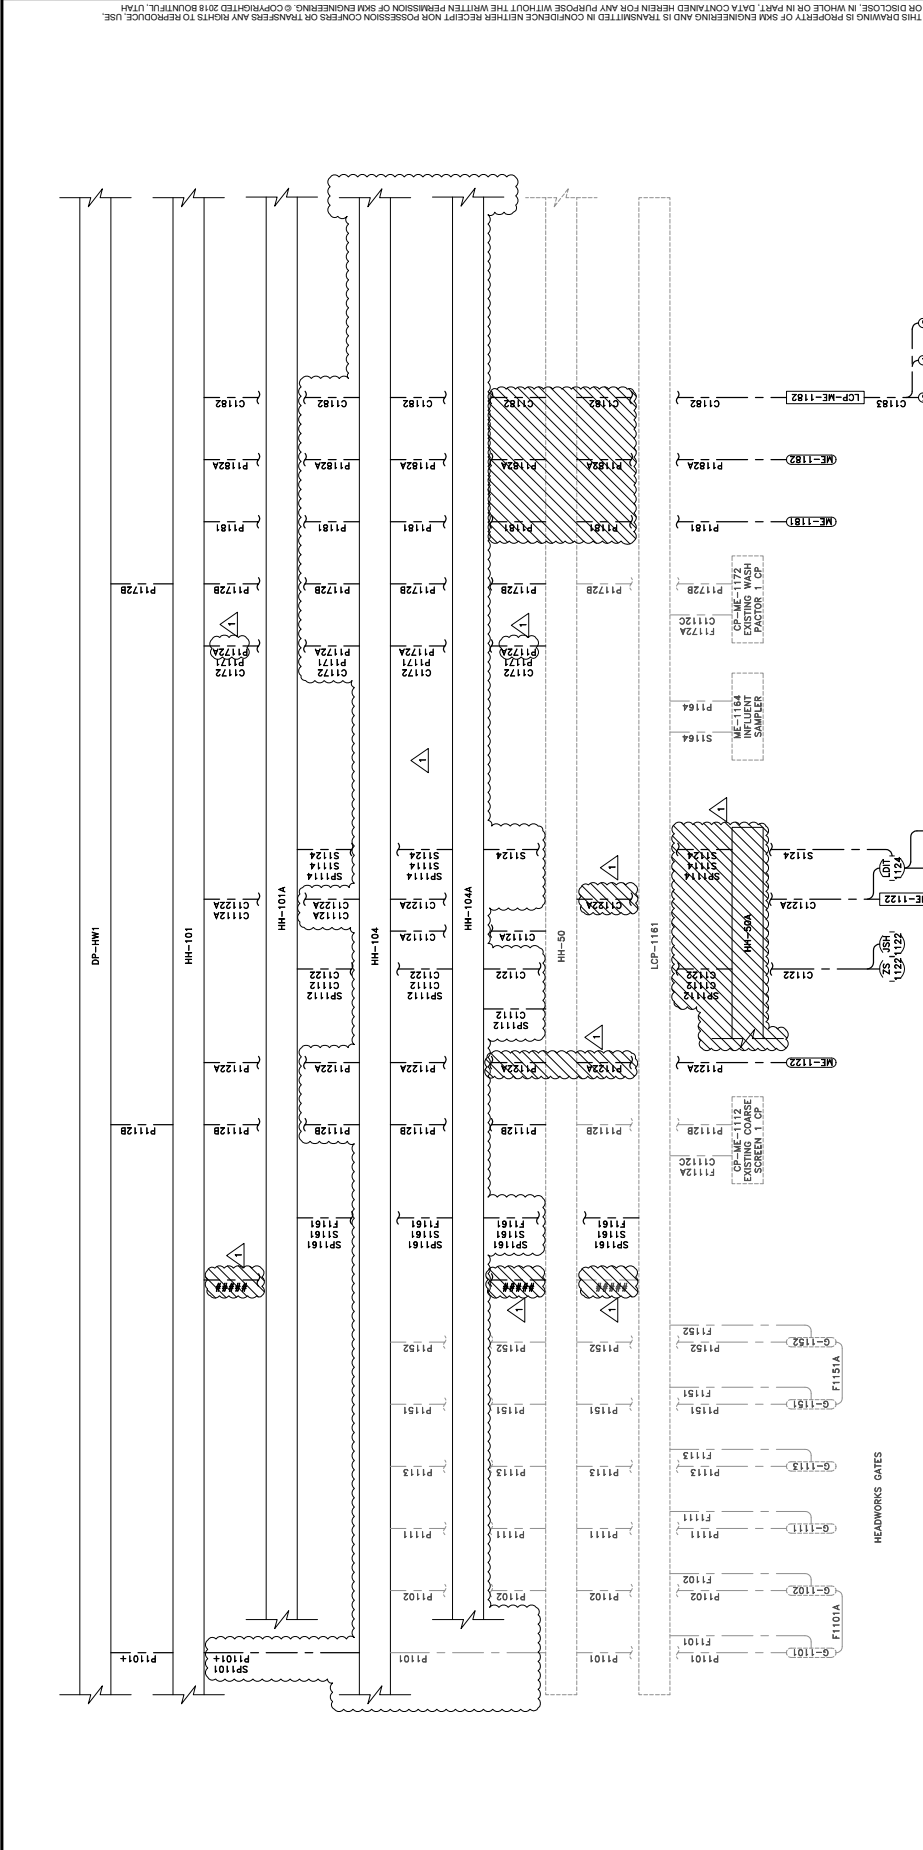

THIS DRAWING IS PROPERTY OF SKM ENGINEERING AND IS TRANSMITTED IN CONFIDENCE NEITHER RECEIPT NOR POSSESSION CONFERS OR TRANSFERS ANY RIGHTS TO REPRODUCE, USE OR DISCLOSE, IN WHOLE OR IN PART, DATA CONTAINED HEREIN FOR ANY PURPOSE WITHOUT THE WRITTEN PERMISSION OF SKM ENGINEERING. © COPYRIGHTED 2018 BOUNTIFUL, UTAH.

- NOTES:**
- CONDUITS THAT ARE COMBINED BETWEEN PULL POINTS ARE DENOTED WITH (PLUS) SYMBOL. SEE COMBINED CONDUITS SCHEDULE ON SHEET 154. CONDUITS WITH MULTIPLE TAGS SHALL BE IDENTIFIED WITH MULTIPLE CONDUIT TAGS, ONE FOR EACH CONDUIT THAT HAS BEEN COMBINED.
 - THE CONDUIT DEVELOPMENT AND SCHEDULE DOES NOT SHOW CONDUIT AND CONDUCTORS FOR THE MFR BUILDINGS. ALSO DOESN'T SHOW CONDUIT AND CONDUCTORS FOR THE MFR BUILDINGS, HVAC AND APPLIANCES FOR THE OFFICE, BREAK ROOM, CONTROL ROOM, AND STORAGE ROOMS. THE CONTRACTOR SHALL BE RESPONSIBLE TO INCLUDE THESE CONDUITS AND CONDUCTORS IN THEIR WORK AND IN THEIR SUBMITTED CONDUIT ROUTING PLAN.



639 W. 2900 S., SUITE 275, BOUNTIFUL, UT 84010
 PHONE (801) 288-1327 FAX (801) 288-0183



ALBERT A CIVIL ENGINEERS
 3788 MCCRAY STREET


CE-18
 SHEET 160 OF 172

NO.	DATE	DESIGN	DRAWN	CHECKED
C	09/05/18	MPJ	DCL	MPJ
I	11/26/18	MPJ	BB	MPJ
Z	10/11/19	MPJ	DCL	MPJ

CITY OF BEAUMONT
 SALT MITIGATION WWTP UPGRADE
 ELECTRICAL - CONDUITS AND DUCTBANKS
 CONDUIT DEVELOPMENT 7

skm
 533 W 2600 S, Suite 25
 Bountiful, Utah 84010
 Phone: (801) 677-0011
 www.skmeng.com

0 1/2" = 1'
 DRAWING IS TO SCALE
 1" = FULL SCALE
 1/2" = HALF SCALE

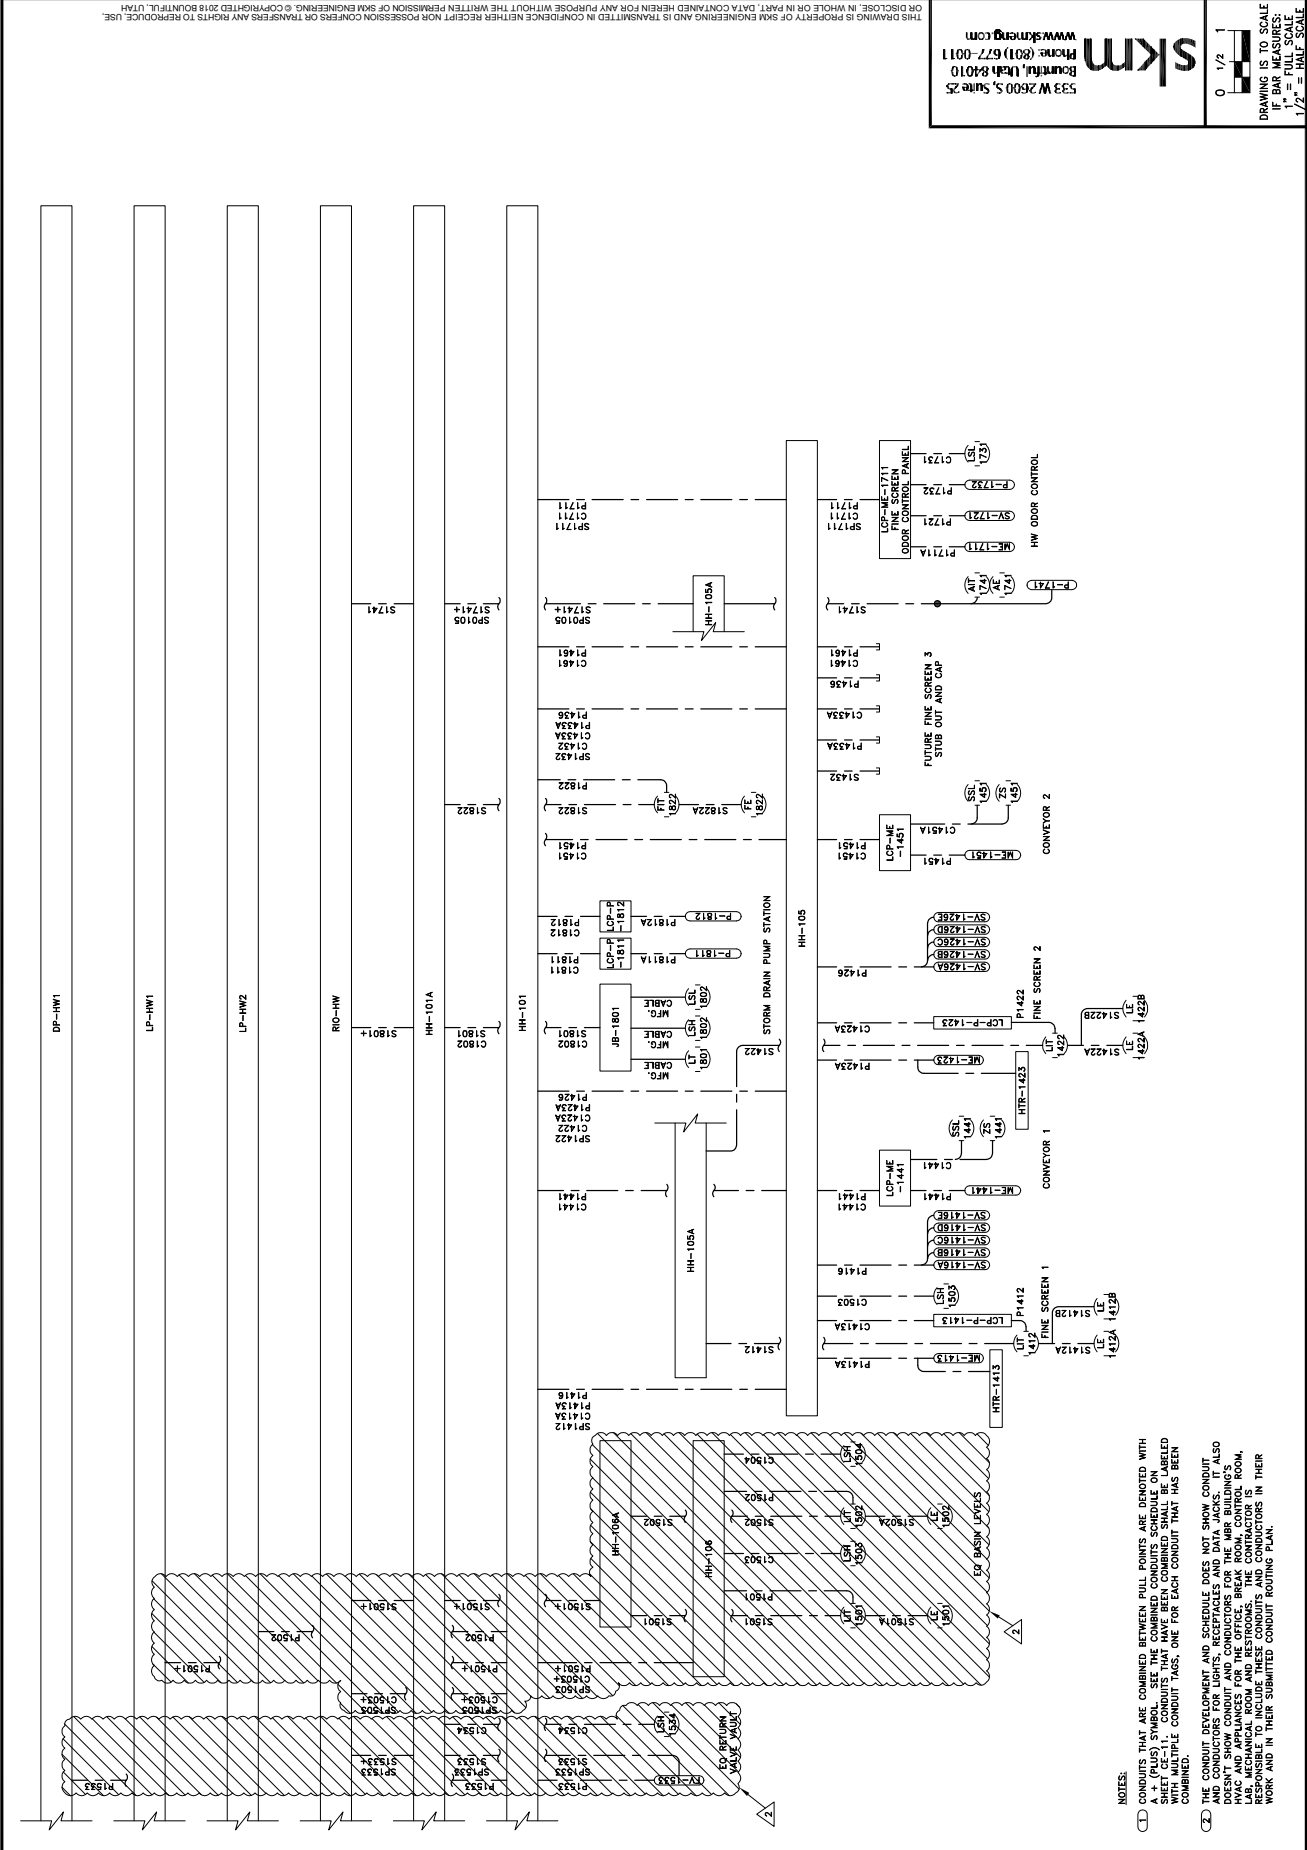

NOTES:
 1. CONDUITS THAT ARE COMBINED BETWEEN PULL POINTS ARE DENOTED WITH (PLUS) SYMBOLS. SEE COMBINED CONDUITS SCHEDULE ON SHEET 159 FOR DETAILS. ALL CONDUITS MUST BE LABELED WITH MULTIPLE CONDUIT TAGS, ONE FOR EACH CONDUIT THAT HAS BEEN COMBINED.
 2. THE CONDUIT DEVELOPMENT AND SCHEDULE DOES NOT SHOW CONDUIT AND CONDUITORS FOR THE MGR BUILDINGS, ALSO DOES NOT SHOW CONDUIT AND CONDUITORS FOR THE MGR BUILDINGS, HVAC AND APPLIANCES FOR THE OFFICE, BREAK ROOM, CONTROL ROOM, AND STORAGE ROOM. THE CONTRACTOR SHALL BE RESPONSIBLE TO INCLUDE THESE CONDUITS AND CONDUITORS IN THEIR WORK AND IN THEIR SUBMITTED CONDUIT ROUTING PLAN.

NO.	DATE	DESIGN	DRAWN	CHECKED
C	09/05/18	MPJ	DCL	MPJ
REVISIONS				
1	09/16/19	MPJ	DCL	MPJ
2	10/11/19	MPJ	DCL	MPJ

CITY OF BEAUMONT
SALT MITIGATION WWTUP UPGRADE
ELECTRICAL - CONDUITS AND DUCTBANKS
CONDUIT DEVELOPMENT 15




ALBERT A. WEBB & ASSOCIATES
CIVIL ENGINEERS
3788 MCCRAY STREET

CE-26
SHEET 168 OF 172

skm
533 W 2600 S, Suite 25
Phone: (801) 677-0011
www.skmeng.com

0 1/2" = 1'
DRAWING IS TO SCALE
1" = FULL SCALE
1/2" = HALF SCALE

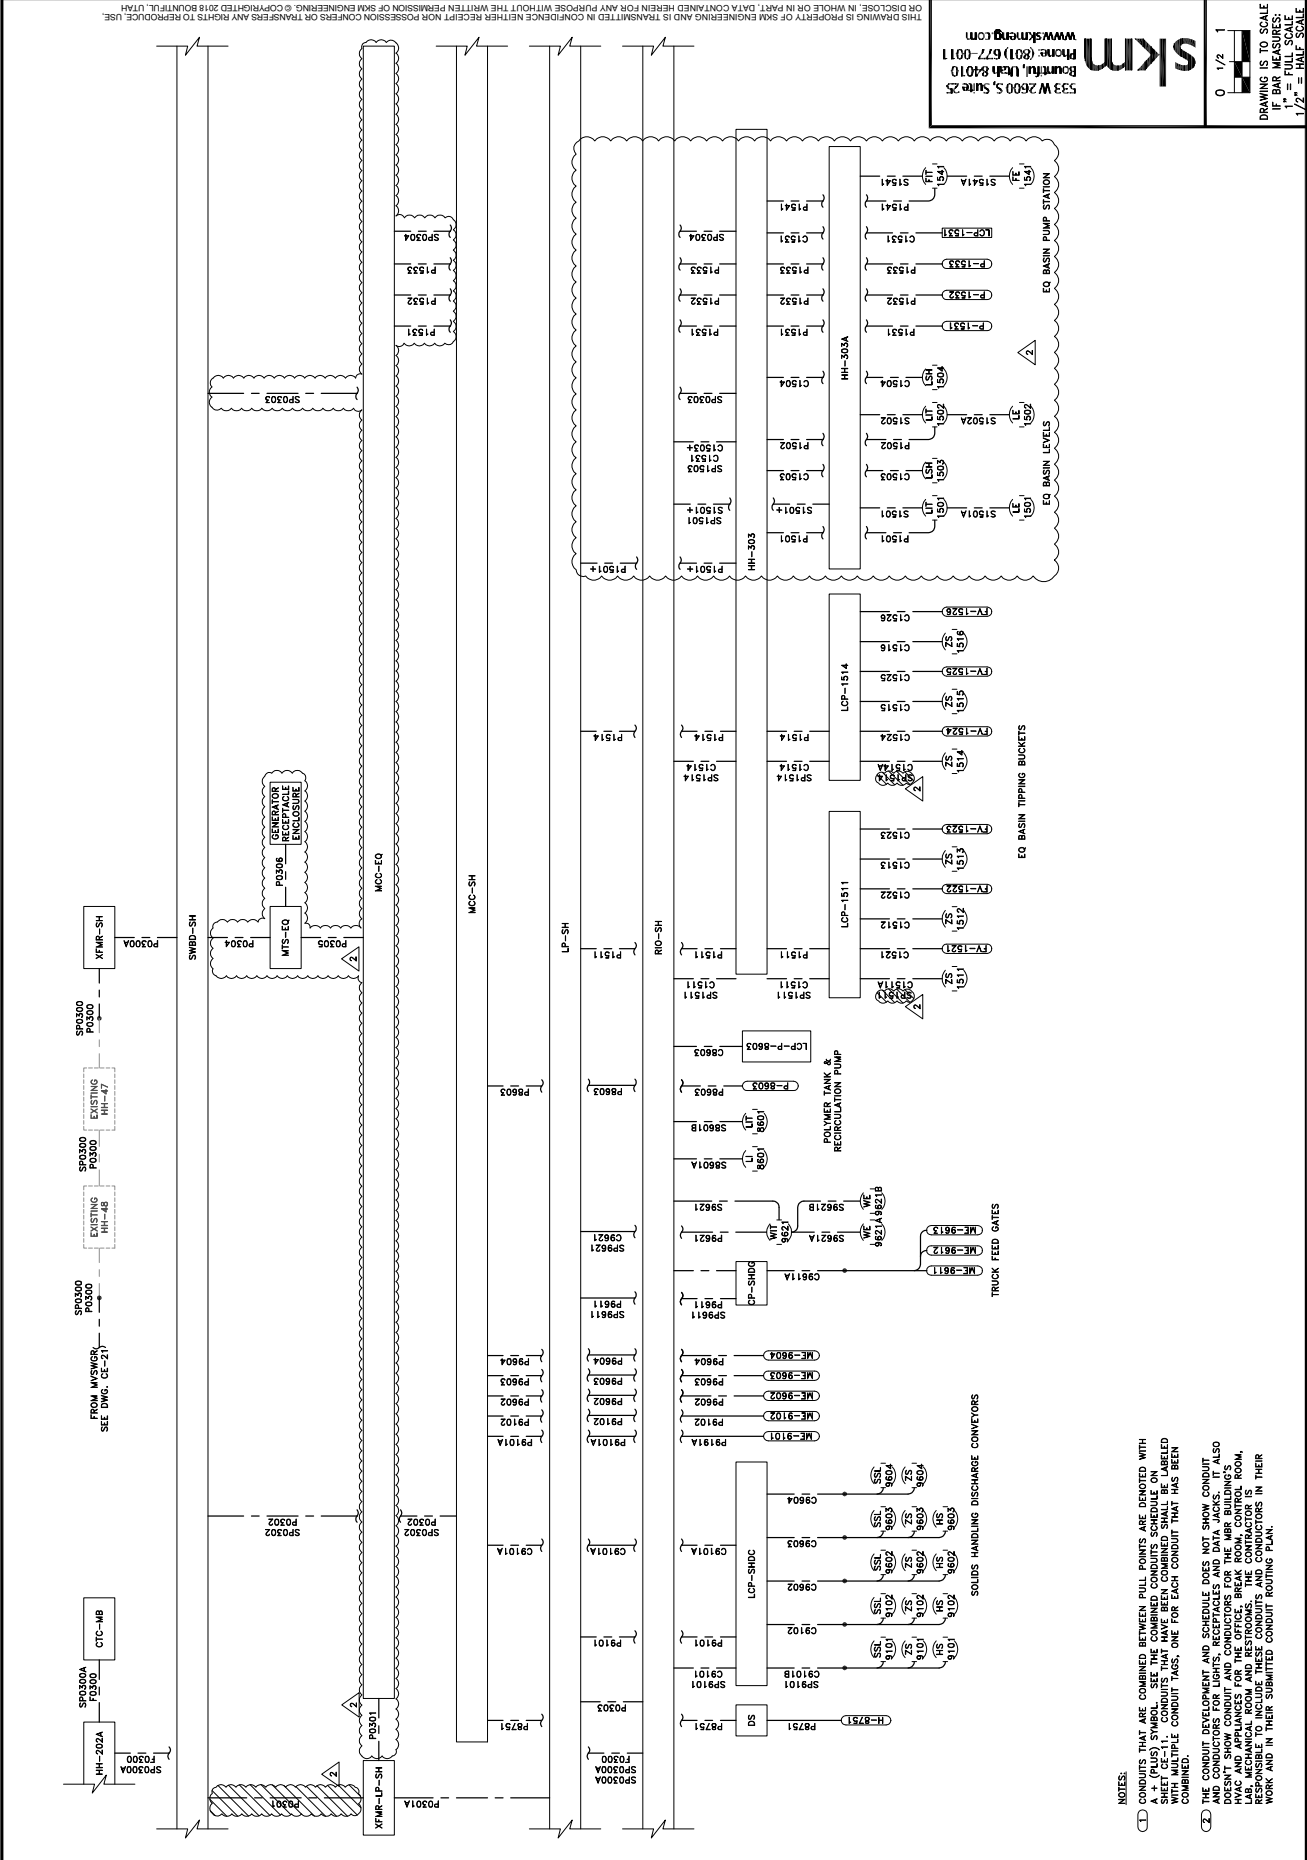

THIS DRAWING IS PROPERTY OF SKM ENGINEERING AND IS TRANSMITTED IN CONFIDENCE NEITHER RECEIPT NOR POSSESSION CONFERS OR TRANSFERS ANY RIGHTS TO REPRODUCE, USE OR DISCLOSE, IN WHOLE OR IN PART, DATA CONTAINED HEREIN FOR ANY PURPOSE WITHOUT THE WRITTEN PERMISSION OF SKM ENGINEERING. © COPYRIGHTED 2019 UNCONTROL, UTVAH

NOTES:
 1. CONDUITS THAT ARE COMBINED BETWEEN PULL POINTS ARE DENOTED WITH (PLUS) SYMBOLS. SEE THE COMBINED CONDUITS SCHEDULE ON SHEET 167 FOR THE COMBINED CONDUIT TAGS. CONDUITS LABELED WITH MULTIPLE CONDUIT TAGS, ONE FOR EACH CONDUIT THAT HAS BEEN COMBINED.
 2. THE CONDUIT DEVELOPMENT AND SCHEDULE DOES NOT SHOW CONDUIT DOES NOT SHOW CONDUIT AND CONDUITORS FOR THE LAB BUILDINGS, HVAC AND APPLIANCES FOR THE OFFICE, BREAK ROOM, CONTROL ROOM, AND STORAGE ROOMS. THE CONTRACTOR SHALL BE RESPONSIBLE TO INCLUDE THESE CONDUITS AND CONDUITORS IN THEIR WORK AND IN THEIR SUBMITTED CONDUIT ROUTING PLAN.

NO.	DATE	DESIGN	DRAWN	CHECKED
C	09/05/18	MPJ	DCL	MPJ
REVISIONS				
1	08/14/19	MPJ	DCL	MPJ
2	10/11/19	MPJ	DCL	MPJ

CITY OF BEAUMONT
SALT MITIGATION WWTFF UPGRADE
ELECTRICAL - CONDUITS AND DUCTBANKS
DUCTBANK CROSS SECTIONS 1




ALBERT A. WEBB ASSOCIATES
ENGINEERING CONSULTANTS
3788 MCCRAY STREET
PHONE (801) 288-1256
FAX (951) 768-1256

SHEET 170 OF 172
CE-28

skm
533 W 2600 S, Suite 25
Bountiful, Utah 84010
Phone: (801) 677-0011
www.skmeng.com

0 1/2" 1"
DRAWING IS TO SCALE
IF BAR MEASURES
1" = FULL SCALE
1/2" = HALF SCALE

THIS DRAWING IS PROPERTY OF SKM ENGINEERING AND IS TRANSMITTED IN CONFIDENCE NEITHER RECEIPT NOR POSSESSION CONFERS OR TRANSFERS ANY RIGHTS IN THIS DRAWING. USE OR DISCLOSE, IN WHOLE OR IN PART, DATA CONTAINED HEREIN FOR ANY PURPOSE WITHOUT THE WRITTEN PERMISSION OF SKM ENGINEERING. © COPYRIGHTED 2018 BOUNTIFUL, UTAH

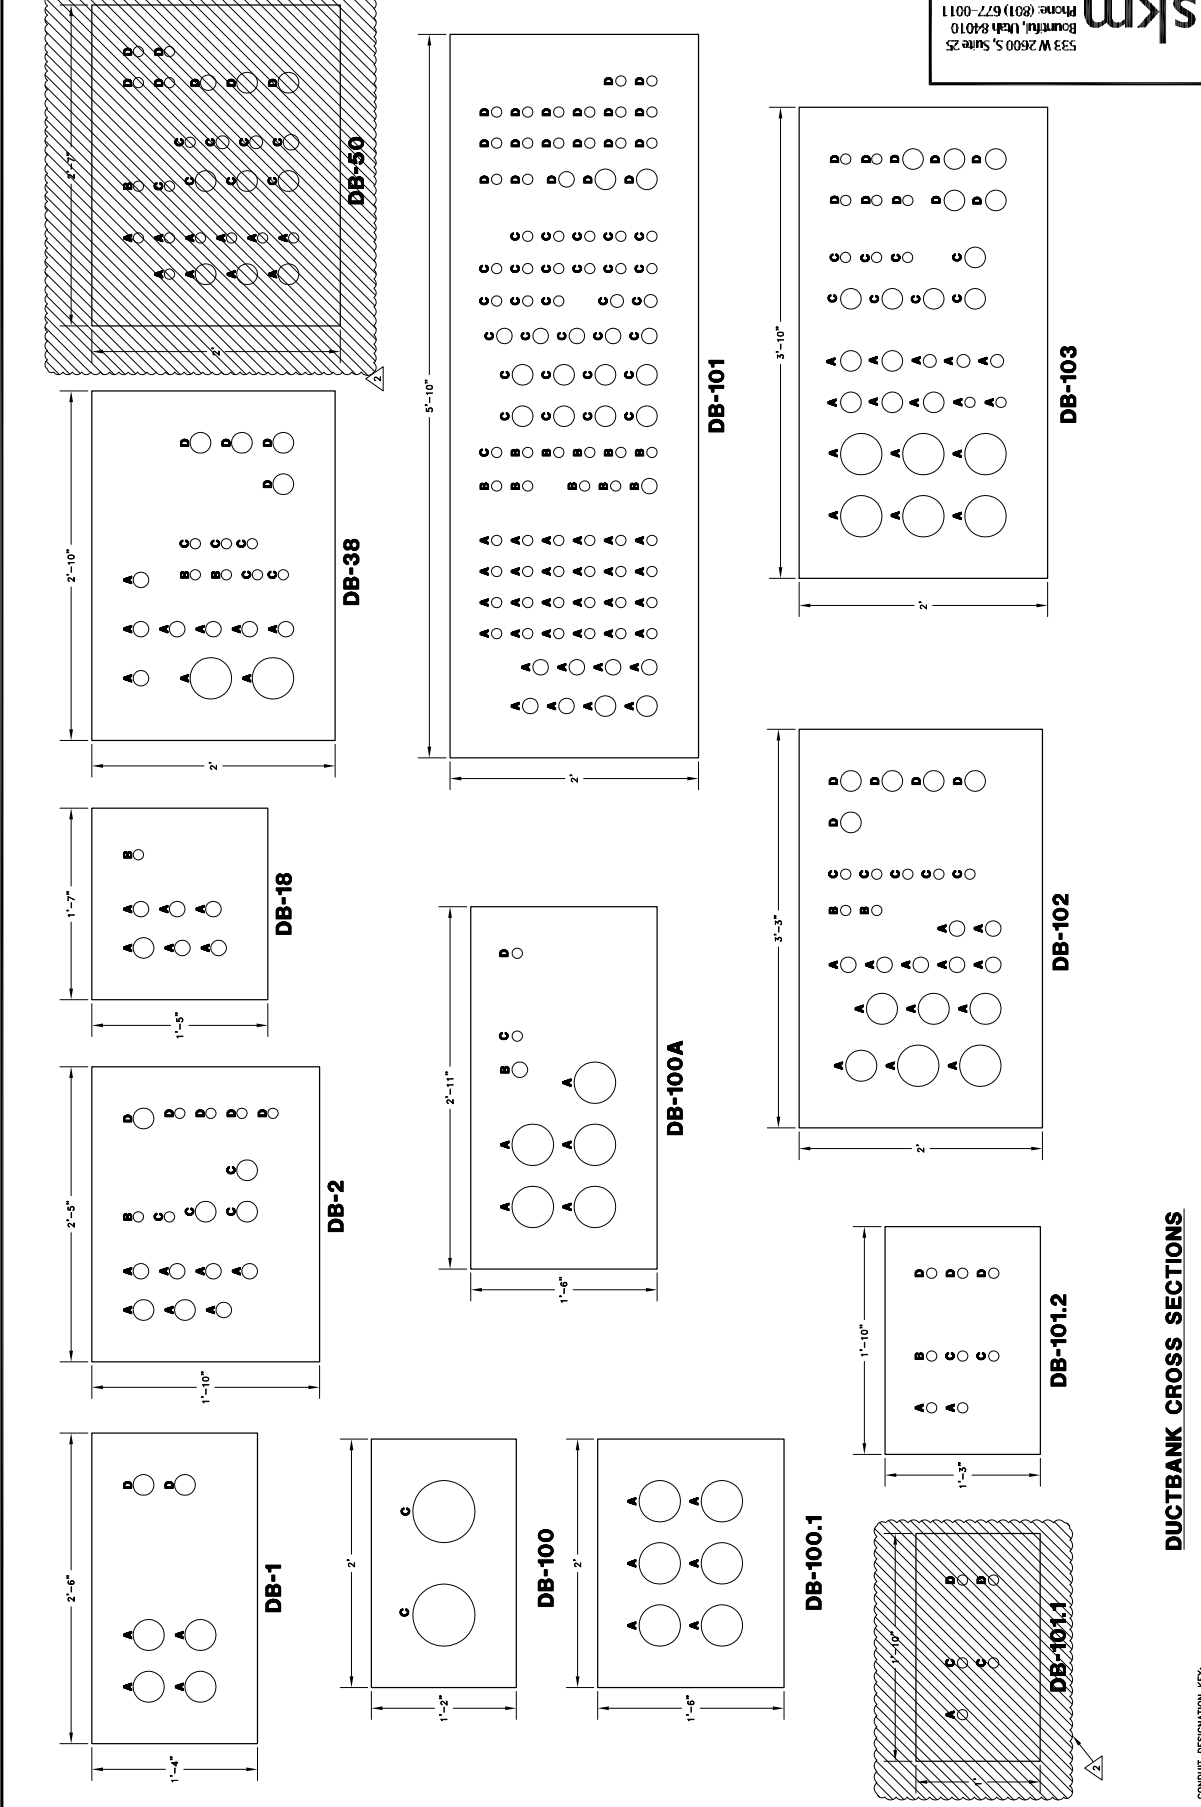

NOTES:
DUCTBANK CROSS SECTION DRAWING
CONDUITS FOR LIGHTING AND RECEPTACLES
ARE NOT SHOWN IN DUCTBANK CROSS SECTIONS

DISTANCES BETWEEN CONDUITS IN DUCTBANKS				
480VAC	120VAC	120VAC CONTROL	SIGNAL	EDGE OF CONCRETE DB
2"	4"	12"	4"	4"
12"/24"/36"/48"	4"	2"	6"	4"
SIGNAL/COMM/SIGNAL	12"	6"	2"	4"
EDGE OF CONCRETE DB	4"	4"	0"	N/A

CONDUIT DESIGNATION - SET:	
A	480VAC
B	120/208/240VAC
C	120VAC CONTROL
D	SIGNAL, COMMUNICATION, OR 50VDC

NO.	DATE	DESIGN	DRAWN	CHECKED
C	09/05/18	MPJ	DCL	MPJ
1	08/14/19	MPJ	DCL	MPJ


CITY OF BEAUMONT
SALT MITIGATION WTRF UPGRADE
ELECTRICAL CONDUITS AND DUCTBANKS
DUCTBANK CROSS SECTIONS 2



533 W 2600 S, Suite 25
Bountiful, Utah 84010
Phone: (801) 677-0011
www.skmeng.com

ALBERT A. WEBB & ASSOCIATES
ENGINEERING CONSULTANTS
3788 MCCARTY STREET
PH: (951) 686-1070
FAX: (951) 768-1256

SHEET 171 OF 172
CE-29
DRAWING IS TO SCALE
IF FIG. DIMENSIONS
1" = FULL SCALE
1/2" = HALF SCALE

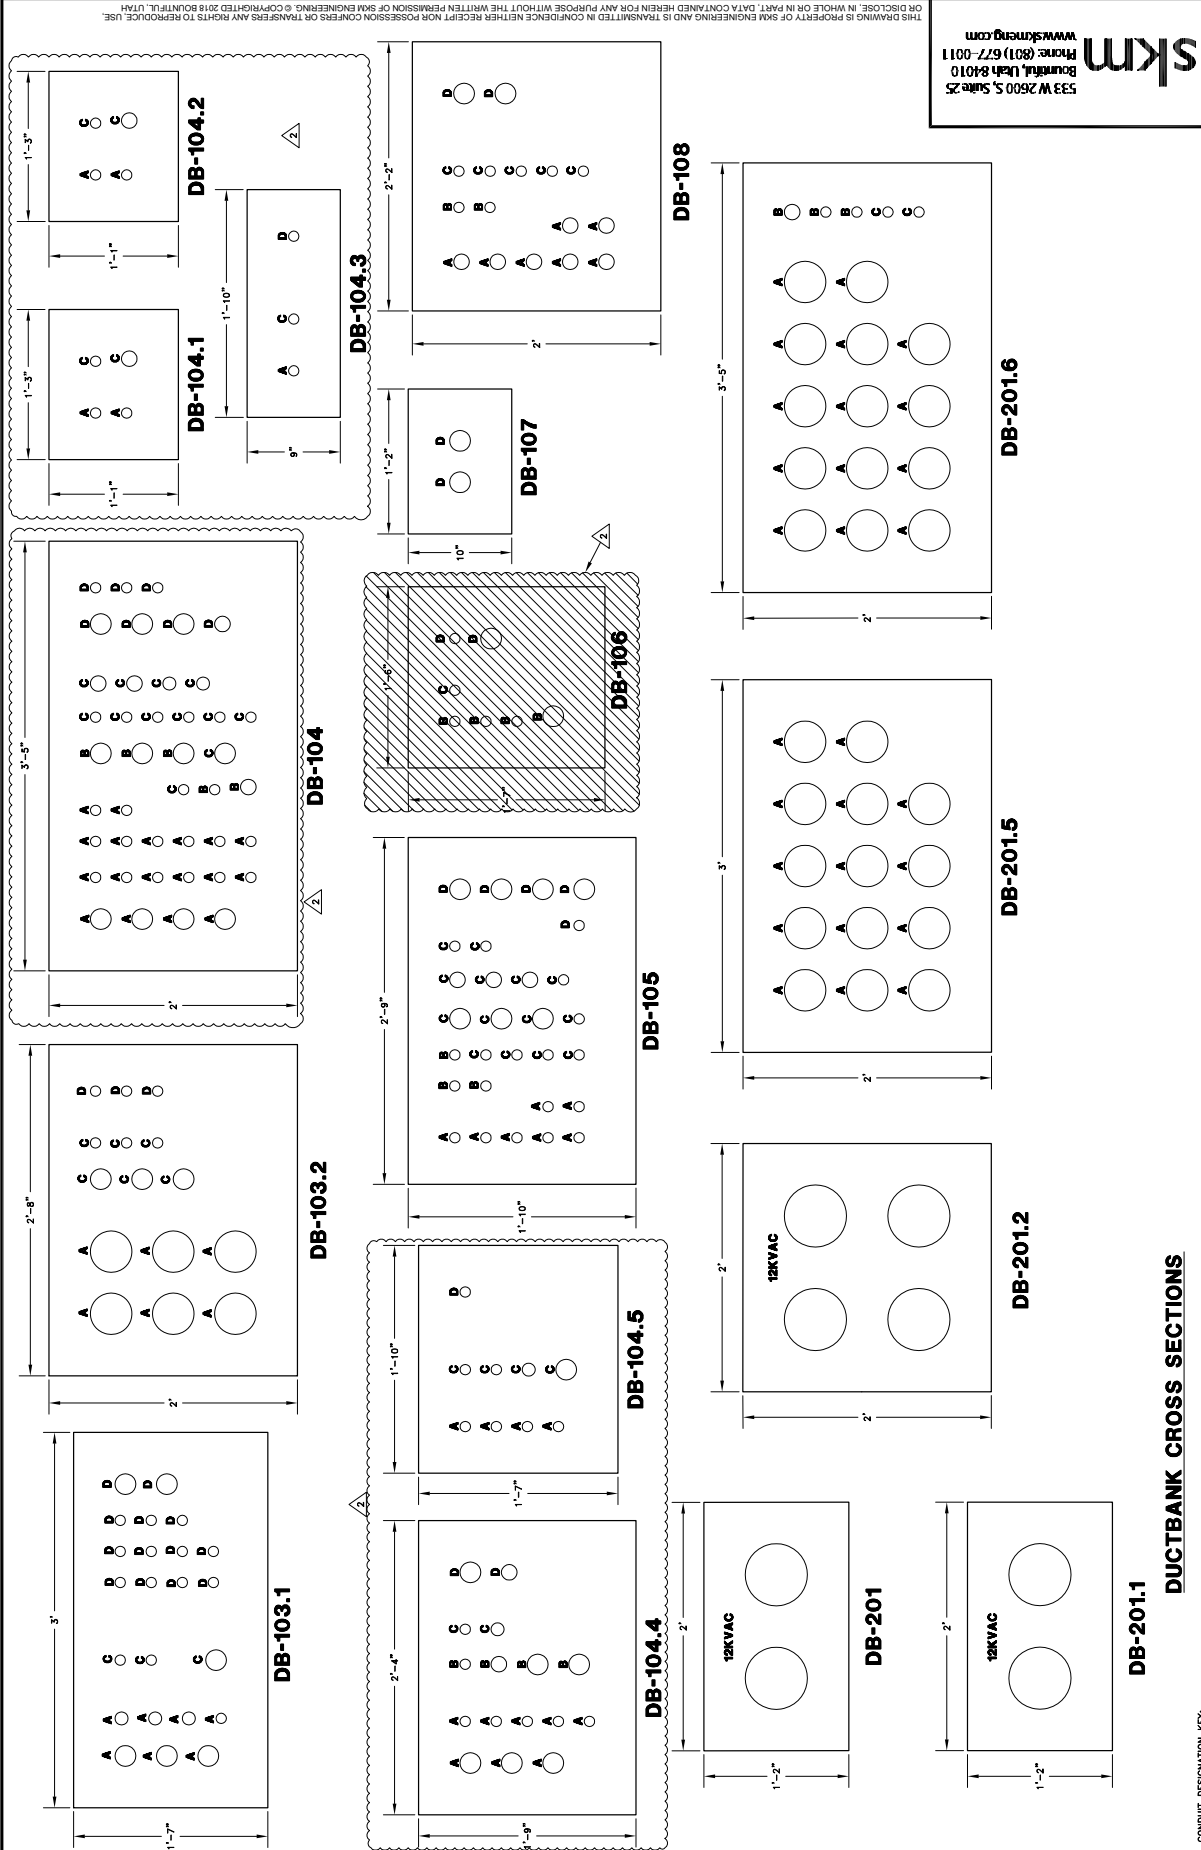

NOTES:

DUCTBANK CROSS SECTION DRAWING
CONDUITS FOR LIGHTING AND RECEPTACLES
ARE NOT SHOWN IN DUCTBANK CROSS SECTIONS

CONDUIT DESIGNATION - SEE:	DISTANCES BETWEEN CONDUITS IN DUCTBANKS			
	480VAC	120VAC	120VAC CONTROL	SIGNAL EDGE OF CONCRETE DB
A 480VAC	2"	4"	12"	4"

DUCTBANK CROSS SECTIONS


NO.	DATE	DESIGN	DRAWN	CHECKED
1	08/24/18	MPJ	MPJ	MPJ
2	10/11/19	MPJ	DCL	MPJ

CITY OF BEAUMONT
SALT MITIGATION WTRP UPGRADE
ELECTRICAL CONDUITS AND DUCTBANKS
DUCTBANK CROSS SECTIONS 3



WEBB ASSOCIATES
 CIVIL ENGINEERS
 3788 MCCRAY STREET
 RIVERSIDE, CA 92508
 PHONE (951) 788-1256
 FAX (951) 686-1070

ALBERT A. WEBB
CE-30
 SHEET 172 OF 172

skm
 533 W. 2600 S., SUITE 25
 BOUNTAUFULL, UT 84010
 PHONE: (801) 677-0011
 WWW.SKMENGINEERING.COM

0 1/2 1
 DRAWING IS TO SCALE
 IF DIMENSIONS
 1" = FULL SCALE
 1/2" = HALF SCALE

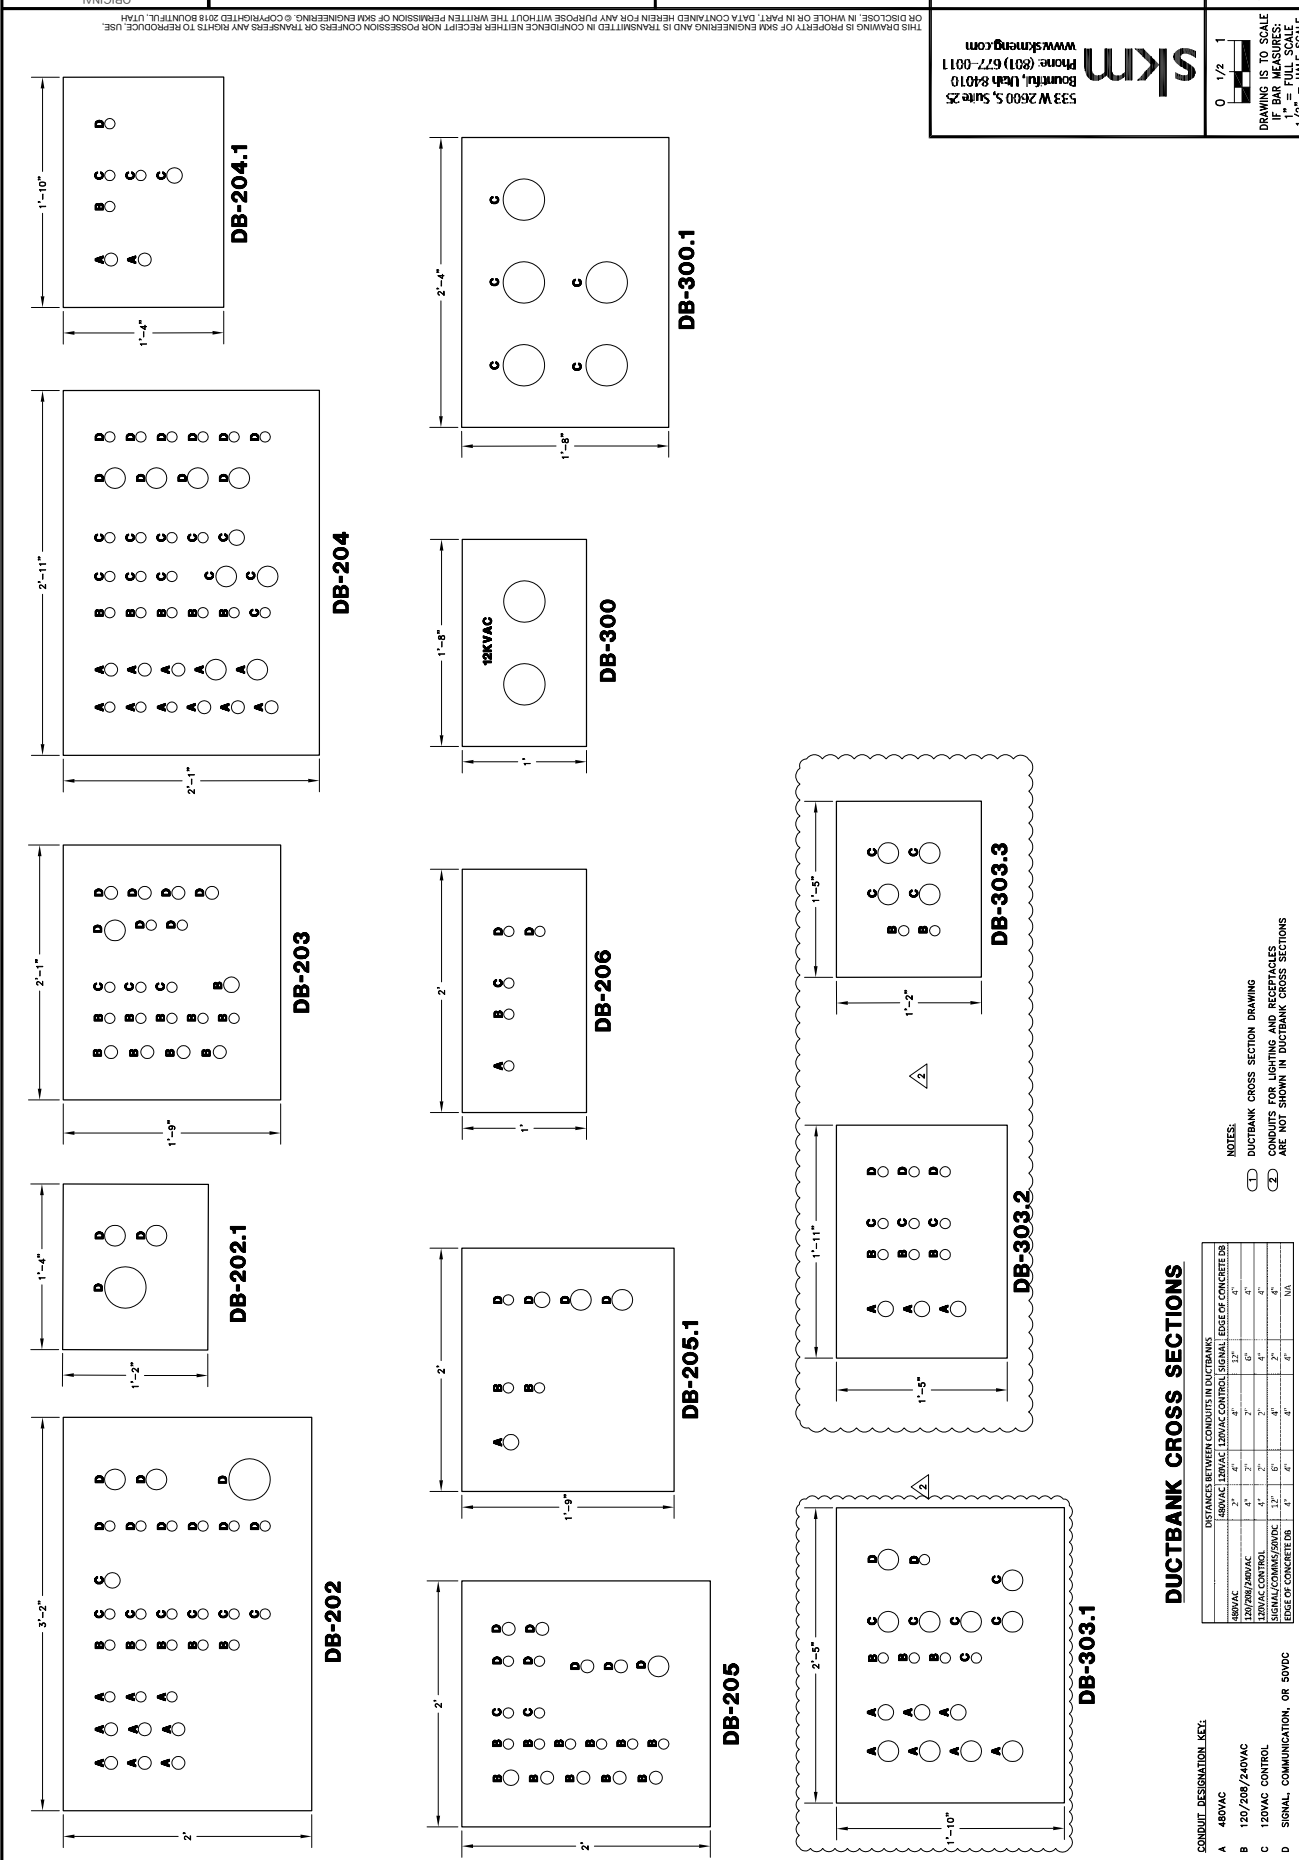

DUCTBANK CROSS SECTIONS

DISTANCES BETWEEN CONDUITS IN DUCTBANKS					
	48VAC	120VAC	120VAC CONTROL	SIGNAL	EDGE OF CONCRETE DB
48VAC	2"	4"	4"	12"	4"
120VAC	2"	4"	4"	6"	4"
120VAC CONTROL	4"	2"	2"	6"	4"
SIGNAL/COMM/SIGNAL	12"	6"	6"	2"	6"
EDGE OF CONCRETE DB	4"	4"	4"	6"	N/A

CONDUIT DESIGNATION: SEE:

A	48VAC
B	120/208/240VAC
C	120VAC CONTROL
D	SIGNAL, COMMUNICATION, OR 50VDC

- NOTES:
- DUCTBANK CROSS SECTION DRAWING CONDUITS FOR LIGHTING AND RECEPTACLES ARE NOT SHOWN IN DUCTBANK CROSS SECTIONS

THIS DRAWING IS PROPERTY OF SKM ENGINEERING AND IS TRANSMITTED IN CONFIDENCE NEITHER RECEIPT NOR POSSESSION CONFERS OR TRANSFERS ANY RIGHTS TO REPRODUCE, USE OR DISCLOSE, IN WHOLE OR IN PART, DATA CONTAINED HEREIN FOR ANY PURPOSE WITHOUT THE WRITTEN PERMISSION OF SKM ENGINEERING. © COPYRIGHTED 2018 BOUNTAUFULL, UT. ORIGINAL

SECTION 262816 – ENCLOSED SWITCHES

PART 1 - GENERAL

1.1 SUMMARY

- A. This Section includes the following:
 - 1. Manual Transfer Switches
 - 2. Generator Connection Enclosures

1.2 PERFORMANCE REQUIREMENTS

- A. Seismic Performance: Enclosed switches shall withstand the effects of earthquake motions determined according to ASCE.
 - 1. The term "withstand" means "the unit will remain in place without separation of any parts from the device when subjected to the seismic forces specified."

1.3 ACTION SUBMITTALS

- A. Product Data: For each type of enclosed switch, circuit breaker, accessory, and component indicated.
- B. Shop Drawings: For enclosed switches and circuit breakers. Include plans, elevations, sections, details, and attachments to other work.
 - 1. Wiring Diagrams: For power, signal, and control wiring.

1.4 INFORMATIONAL SUBMITTALS

- A. Seismic Qualification Certificates: For enclosed switches and circuit breakers, accessories, and components, from manufacturer.
- B. Field quality-control reports.

1.5 CLOSEOUT SUBMITTALS

- A. Operation and maintenance data.

1.6 QUALITY ASSURANCE

- A. Electrical Components, Devices, and Accessories: Listed and labeled as defined in NFPA 70, by a qualified testing agency, and marked for intended location and application.
- B. Comply with NFPA 70.

PART 2 - PRODUCTS

2.1 MANUAL TRANSFER SWITCHES

- A. The manual transfer switch shall be open transition, break-before-make type double throw safety switch. The manual transfer switch shall be heavy duty with a quick make, quick break operating mechanism, with full cover interlock, and indicator handle.
- B. The switch shall be rated for the voltage and current and shall have the number of poles indicated on the Plans. Lugs shall be able to accommodate up to 600MCM cabling.
- C. The transfer switch shall be listed by UL.
- D. Enclosures shall be rated NEMA 12 for indoor use, and NEMA 3R for outdoor use, unless otherwise indicated on the Plans.
- E. The manual transfer switch handle shall be padlockable.
- F. Manual transfer switches shall be as manufactured by Square D, Eaton, Allen-Bradley, or approved equal.

2.2 GENERATOR CONNECTION ENCLOSURES

- A. Provide a 480V, 3-Phase 3-Wire 400A, NEMA 3R enclosure fabricated from galvanized steel and power coated ANSI gray. The enclosure shall have mounting tabs for surface mounting and a drip shield above the door opening. The enclosure shall have a hinged front door provided with a latch that is padlockable.
- B. The bottom of the enclosure shall contain a hinged door for the entry of portable cable. The door shall be secured by a latch accessible only from the inside of the enclosure.
- C. The conduit entrance shall be through the top or back of the enclosure. Wire terminations for the building wire shall be to mechanical lugs sized for 400A and large enough to accommodate up to 600MCM cabling.
- D. A dead front cover shall prevent access to the internal electrical components when the main access door is open.
- E. Series 16 Cam inlets shall be mounted on an internal dead front inlet panel and shall accept standard E1016 type connectors. One set of cam inlets rated for up to 400A shall be provided. Cam inlets shall be color coded for phase (brown, orange and yellow) and ground (green).

- F. The ground inlet shall be wired to the enclosure frame and a ground connection lug shall be provided for contractor termination of the building ground wire.
- G. The internal dead front inlet panel shall contain slots between inlets to eliminate hysteresis, as required by the NEC.
- H. A warning label to specify the proper sequence for connection and removal of portable cable as shall be mechanically fastened to front cover of the enclosure.
- I. The Generator Connection Box shall meet or exceed all applicable NEC standards and shall be UL Listed. A label denoting the UL Listing shall be permanently affixed to the unit.
- J. Generator connection enclosures shall be as manufactured by Union Connector, Lex, or approved equal.

PART 3 - EXECUTION

3.1 INSTALLATION

- A. Enclosed switches and generator connection enclosures shall be installed, in accordance with the manufacturers' recommendations.
- B. The enclosed switches and generator connection enclosures shall be installed as indicated on the Plans.
- C. Provide grounding per NEC.

END OF SECTION 262816

SECTION 432313 – SELF-PRIMING CENTRIFUGAL PUMPS

PART 1 - GENERAL

1.1 SUMMARY

- A. This specification covers the furnishing of self-priming centrifugal pump units as required and to the expectation of the Engineer with regard to the manufacture of the equipment.
- B. All equipment must be supplied by the same pump Manufacturer including bowls, impellers, seals, and motors. Equipment furnished under this section shall be fabricated and assembled in full conformity with drawings, specifications, engineering data, instructions, and recommendations of the equipment manufacturer, unless exceptions are noted by Engineer.
- C. The pump manufacturer must be ISO 9011:2008 revision certified.
- D. The pumps shall be of the horizontal self-priming centrifugal type, equal in construction and performance to the “Super T” Series self-priming sewage pumps as manufactured by the Gorman-Rupp Company of Mansfield, Ohio, specifically designed for the handling of raw, unscreened sanitary domestic sewage.

1.2 RELATED SECTIONS

- A. Common Motor Requirements for Equipment, Section 220513.
- B. Pumps, General, Section 432010.

1.3 CONDITIONS OF OPERATION

- A. Each pump must have the necessary characteristics and be properly selected to perform under the operating conditions shown in the pump schedule.
- B. All internal passages, impeller vanes, and recirculation ports shall pass a 3” spherical solid.
- C. Each pump at its rated speed shall be designed to retain adequate liquid in the pump casing to insure unattended automatic re-priming in a complete open system without suction or discharge check valves and with a dry suction leg. Upon completion of re-priming cycle, pumps shall deliver full rated capacity at rated TDH at the designed total dynamic suction lift.

1.4 SUBMITTALS

- A. Provide complete fabrication and assembly drawings together with detailed specifications and data covering materials, parts, devices and accessories forming a part of the equipment furnished, shall be submitted in accordance with the submittals section. Information and submittals shall conform to the requirements of Section 013300 – Contractor Submittals. The data and specifications for each pumping unit shall not be limited to the following:

1. Name of manufacturer.
2. Type and model of pump including design rotative speed.
3. Dimensions including size, location and size of suction and discharge outlet connections, weight, and max overall dimensions.
4. Submit pump and motor performance data, pump curves showing operation points, NPSH, curve, submergence requirements, efficiency, bhp, pump range operating on a VFD and system head curves for each flow scenario.
5. Also provide diagrams showing installation requirements including minimum clearances from nearby walls, adjacent pump units, and all other pertinent information required to review the pump unit for performance and installation for each application.

B. Anchor Bolt Design Calculations.

C. Provide operation and maintenance manuals and information in accordance with the requirements of Section 017823 – Operation and Maintenance Data.

1.5 WARRANTY

- A. The minimum warranty period shall be warranted for sixty (60) months excepting only those items that are normally consumed in service such as oils, grease, packing, gaskets, O-rings, etc. The pump manufacturer shall be solely responsible for warranty of the pump equipment and components. The warranty shall become effective 60 days after installation (verified by pump manufacturer's representative) or ninety (90) days after shipment from the factory whichever occurs first.

1.6 QUALITY ASSURANCE

- A. The pump manufacturer shall have at least ten (10) similar installations in the US with a minimum of five (5) years of continuous operation.

1.7 SEQUENCE OF OPERATION

- A. The pump manufacturer shall provide a detailed control narrative describing the pump startup, running and shutdown sequence of operation. As the pumps are required to pull suction from the EQ basin, the narrative shall include a written strategy for priming each pump during the startup sequence.

PART 2 - PRODUCTS

2.1 PUMP DESIGN

- A. Pumps shall be horizontal, self-priming centrifugal type, designed specifically for handling raw, unscreened, domestic sanitary sewage.

B. Materials and Construction Features:

1. Pump casing shall be cast iron Class 30 with integral volute scroll. Casing shall incorporate following features:
 - a. Mounting feet sized to prevent tipping or binding when pump is completely disassembled for maintenance.
 - b. Fill port cover plate, 3 1/2" diameter, shall be opened after loosening a hand nut/clamp bar assembly. In consideration for safety, a clamp bar screw must provide slow release of pressure, and the clamp bar shall be retained by detente lugs. A Teflon gasket shall prevent adhesion of the fill port cover to the casing.
 - c. Casing drain plug shall be at least 1 1/4" NPT to insure complete and rapid draining.
 - d. Liquid volume and recirculation port design shall be consistent with performance criteria listed under PART 1 - GENERAL of this section.

C. Suction Head shall be Class 30 cast iron. Its design must incorporate following maintenance features:

1. The suction head will be secured to the pump casing by using hex head cap screws and lock washers. Access to the impeller and mechanical seal shall be accomplished by removing the suction head.
2. Removal of any blockages in the impeller shall be accomplished by removing the suction head, or through a cleanout cover on the suction head. In consideration of safety, two clamp bar screws must provide slow release of pressure on two clamp bars securing the cleanout cover. A Teflon gasket shall prevent adhesion of the cleanout cover to the suction head casing.
3. Removal of the suction check valve shall be accomplished through the removable cleanout cover on the suction head.
4. In consideration for safety, a pressure relief valve shall be supplied in the suction head.
5. A replaceable Grey Iron 30 wear plate shall be secured up against the pump casing by the suction head. Measurement of the clearance between this wear plate and impeller shall be accomplished through the cleanout cover plate.

D. Rotating assembly, which includes impeller, shaft, mechanical shaft seal, lip seals, bearings, seal plate and bearing housing, must be removable as a single unit without disturbing the pump casing or piping. Design shall incorporate following features:

1. Seal plate and bearing housing shall be cast iron Class 30. Separate oil filled cavities, vented to atmosphere, shall be provided for shaft seal and bearings. Cavities must be cooled by the liquid pumped. Three lip seals will prevent leakage of oil.
 - a. The bearing cavity shall have an oil level sight gauge and fill plug check valve. The clear sight gauge shall provide easy monitoring of the bearing cavity oil level and condition of oil without removal of the fill plug check valve. The check valve shall

vent the cavity but prevent introduction of moist air to the bearings.

- b. The seal cavity shall have an oil level sight gauge and fill/vent plug. The clear sight gauge shall provide easy monitoring of the seal cavity oil level and condition of oil without removal of the fill/vent plug.
 - c. Double lip seal shall provide an atmospheric path providing positive protection of bearings, with capability for external drainage monitoring.
2. Impeller shall be ductile iron 65-45-12, two-vane, semi-open, non-clog, with integral pump out vanes on the back shroud. Impeller shall thread onto the pump shaft and be secured with a lock screw and conical washer.
 3. Impeller shaft shall be 4150 Alloy Steel.
 4. Bearings shall be anti-friction ball type of proper size and design to withstand all radial and thrust loads expected during normal operation. Bearings shall be oil lubricated from a dedicated reservoir. Pump designs which use the same oil to lubricate the bearings and shaft seal shall not be acceptable.
 5. Shaft seal shall be cartridge type, mechanical, oil-lubricated, double floating, self-aligning. The stationary and rotating seal faces shall be tungsten titanium carbide alloy. Stainless steel 316 stationary seat. Fluorocarbon elastomers (DuPont Viton or equal). Stainless steel 18-8 cage and spring. Maximum temperature of liquid pumped, 160° F (71° C).
 6. Pusher bolt capability to assist in removal of rotating assembly. Pusher bolt threaded holes shall be sized to accept same cap screws as used for retaining rotating assembly.
- E. Adjustment of the impeller face clearance (distance between impeller and wear plate) shall be accomplished by external means.
1. Clearances shall be maintained by using external shims between the casing ring of the rotation assembly and the pump casing itself. Shims will be of various sizes to allow precise adjustment of this clearance. The clearance can be measured by removing the cleanout cover on the suction head.
 2. Clearance adjustment which requires movement of the shaft only, thereby adversely affecting seal working length or impeller back clearance, shall not be acceptable.
- F. Suction check valve shall be molded Neoprene with integral steel and nylon reinforcement.
- G. Removal of the rotating assembly will be accomplished through the front or the back of the pump casing.
- H. The motor shall be mounted using the standard V-Belt base.
- I. The motor shall be driven by a VFD and shall meet the requirements of Common Motor Requirements for Equipment, Section 220513.
- J. The motor shall be equipped with an anti-condensation space heater that shall be energized while the motor is not running.

- K. The motor shall be equipped with normally closed contacts in each motor winding wired together in series to provide a shutdown condition should the motor get too hot.

2.2 ANCHOR BOLTS

- A. Equipment manufacturer shall furnish all anchor bolts of ample size and strength required to securely anchor each item of equipment. Anchor bolts, hex nuts, and washers shall be # T-316 stainless steel unless noted otherwise. Anchor bolts shall be threaded rods with washers and nuts embedded. Expansion-type anchors will not be acceptable. Anchor bolt design shall be completed by a professional engineer licensed in the State of California and shall be included in the submittal.
- B. Anchor bolts shall be set by the CONTRACTOR. Equipment shall be placed on the foundations, leveled, shimmed, bolted down, and grouted with a non-shrinking grout

PART 3 - EXECUTION

- A. EXPERIENCE AND WORKMANSHIP
- B. Pumps shall be the product of a manufacturer with a minimum of 5 years' experience in design and manufacture of self-priming centrifugal pumps handling sewage.
- C. INSTALLATION
- D. Pumps shall be installed per manufacturer's recommendations including all auxiliary devices and accessories to minimize vibration, vortexing, cavitation, and otherwise facilitate and maximize the performance and reliable life of the pump unit.
- E. Contractor shall coordinate electrical and controls requirement with the pump manufacturer to ensure a properly installed and operating pump system. Contractor is responsible to provide all wiring, conduit, controls, and other aspects to complete the installation of the pumps. All electrical components shall comply with the requirements outlined in Division 26 and Section 220513 – Common Motor Requirements for Equipment.
- F. All exterior installed items, including pumps, motors, valves, piping, wiring, and other components shall be suitable for exposed, outdoor installation including high ambient operating temperatures for the pump motors and exposure to direct sunlight.
- G. Factory non-witnessed pump test head shall be performed. Each pumping unit to be supplied in the field shall be non-witness tested at the factory for capacity, power requirement, and efficiency at minimum head, rated head, shutoff head or point of discontinuity, and at as many other points as necessary for accurate performance curve plotting. Pump OEM can use a calibrated lab motor for these tests. All tests and test reports shall conform to the requirements and recommendations of the Hydraulic Institute Standards. If the pump fails to operate properly or fails to meet the specified conditions or requirements during shop testing, the pump manufacturer shall modify the pumping unit and perform additional tests. The pump manufacturer shall submit complete pump test reports, including test arrangement, instrumentation calibration data, test procedures, & test data in curve format. All test data shall be submitted to the engineer at least 5 days prior to

shipment.

- H. Pump shall be furnished with all typical spare parts (or spare parts kit) and any specialty tools as typically supplied and recommended by the pump manufacturer. Submittals shall provide a detailed list of all included spare parts, including part numbers and quantities of each item.
- I. Pump supplier shall include services of a qualified representative to oversee the installation, startup, testing, and training of operator personnel. A minimum of two (2) trips and two (2) days on site shall be included. Refer to Section 017900 – Demonstration and Training for details on startup requirements. The representative shall be present when the equipment is placed in operation, and shall revisit the job site as often as necessary until all trouble is corrected and the equipment installation and operation are satisfactory in the opinion of ENGINEER.
- J. The manufacturer’s representative shall furnish a written report certifying that the equipment has been properly installed and lubricated; is in accurate alignment; is free from any undue stress imposed by connecting piping or anchor bolts; and has been operated under full load conditions and that it operated satisfactorily.
- K. All costs of these services shall be included in the contract price for the number of days and round trips to the site as required.

END OF SECTION

STANDARD LEAD TIME PRICE PER THE ATTACHED: \$57,915.00

ADDER FOR VFD STARTUP: \$4,500.00

Note that with power system short circuit and coordination studies and EESS site acceptance testing per EESS or NETA standard work scopes only, an extra year of warranty is provided by the factory to the customer at no extra cost.

Eaton's engineering services meets the ANSI/NETA Acceptance Testing Specifications testing organization qualification criteria to perform NETA testing. Eaton's engineering services utilizes the Electrical Power Testing Certification Program from the National Institute for Certification in Engineering Technologies (NICET), to certify field personnel in testing electrical power distribution equipment per ANSI/NETA standards.

GENERAL COMMENTS, CLARIFICATIONS, SPECIAL CONDITIONS

1. BOM attached - This bid is based upon our interpretation of any specifications, drawings, and/or other information provided. Any items or features not listed in the attached bill of material are not included.
2. Cable terminations use mechanical type lugs, not compression type lugs, unless shown in the description of the equipment. Mechanical lugs will accept either copper or aluminum cables. Standard termination lugs are provided based on the ampacity of each circuit. Optional lugs are available that generally allow for the next larger standard cable size. Oversized lugs and/or additional quantities of parallel cables must be accommodated by the contractor's installation method (e.g. insulated cable splices in the equipment gutter, power terminal blocks, etc.) and are not part of this quotation.
3. Not included unless shown as a separate item within this bill of materials: safety switches, enclosed circuit breakers, starters meter sockets, spare parts / renewal parts and other miscellaneous equipment, 600 Volt or 250V fuses (others supplied only if noted specifically), extended warranty, seismic calculations, and selective coordination.
4. Dry type transformers (DOE 2016) - primary or secondary terminal lugs are not included. DTDI supplied with factory standard impedance and reactance levels unless shown otherwise.
5. Panels and switchboards- Eaton is not responsible for Title 24 design compliance unless Title 24 requirements are an integral part of the design. SPD and customer metering is only included where shown on single line or panel schedules.
6. Regarding NEC/CEC article 240.87(B) – To comply with code requirements, Eaton will provide the arc reduction method for circuit breakers that are rated or can be adjusted to 1200A or higher.
7. Eaton not responsible for utility meter maximum centerline height or CEC/NEC 6'-7" center of OCPD handle violation if the surface for electrical equipment supplied by Eaton – enclosed control, fused or MCCB switching devices, panelboards, switchboards, LV switchgear, MV switchgear, etc. - is installed on a surface more than 1" (i.e. housekeeping pads) above the level plane in front of the equipment as required by utilities and NEC/CEC.
8. Order Entry- Eaton does not send utility approval drawings unless requested by customer. Customer to provide utility contact information. Lift gate truck requirement for switchboard delivery must be requested at or before time of order entry. Liquidated damages will not be accepted.
9. Shipment is FOB – point of shipment unless otherwise noted.
10. Sales tax is not included in above pricing.

PROJECT SPECIFIC COMMENTS AND CLARIFICATIONS

1. Change order includes comments/clarifications of original quote document..
2. No specifications provided for manual transfer switches. MTS-EQ' quoted per BOM.
3. Standard warranty included. Items started up by Eaton include additional year of warranty at no additional cost.
4. VFDs internal to MCC quoted per schematic on E-19 with only options specifically noted for 'P-1531, P-1532, P-1533'..

Project Name: City of Beaumont Salt Mitigation
General Order No: MLA0009343

Negotiation No: LA280626X8K2
Alternate No: R006
CLAR-24 C.O.

Bill of Materials

Item No.	Qty	Product	Description
	1	Switchboards	RUGTB

Catalog No GTB08MAMA
Designation Generator Receptacle Enclosure

Item No.	Qty	Product	Description
	1	Automatic Transfer Switches	Quote Date: 11/20/2019

Product Family: Wall Mount
Switch Type: Non Automatic Molded Case Switch 30A thru 1000A
480v, 60hz, 3 Phase, 3 Wire, 3 poles
Transition Mode: Open
Controller Type: Electromechanical
Continuous Current: 400 Amps
Withstand: 65kA
Normal Source Terminals: (1) 4/0-600 CU/AL
Emergency Source Terminals: (1) 4/0-600 CU/AL
Load Side Terminals: (2) #1-500 CU/AL
Neutral Terminals: No Neutral Bar

Standard Features: 12c, 12d, 12g, 12h, 15e, 15f, 32e, 42, 49c,
Optional Features: No Optional Features Selected

Catalog No NTVELDA30400XSU
Designation MTS-EQ

Item No.	Qty	Product	Description
	1	Motor Control Centers	60 Hz, Class 2B wiring, 480V 3-Phase Service, 65,000 Bracing, Short Circuit Rating, Bottom Incoming, NEMA 1 Gasketed 21" Front Mt Only enclosure, 600A Copper Main Horizontal Bus, ANeutral, Main Lugs. Used X-Space: 28, Blank X-Space: 20, Future X-Space: 0, MCC Lead Time Code: U.

Designation MCC-EQ

Eaton Selling Policy 25-000 applies.

All orders must be released for manufacture within 90 days of date of order entry. If approval drawings are required, drawings must be returned approved for release within 60 days of mailing. If drawings are not returned accordingly, and/or if shipment is delayed for any reason, the price of the order will increase by 1.0% per month or fraction thereof for the time the shipment is delayed.

Project Name: City of Beaumont Salt Mitigation
General Order No: MLA0009343

Negotiation No: LA280626X8K2
Alternate No: R006
CLAR-24 C.O.

Item No.	Qty	Product	Description
	1	Dry Type Transformers	Transformer Type: General Purpose Vented
			3 Phase, 75 KVA, 1 K-Factor 480 Primary Volts 208Y/120 Secondary Volts Temperature Rise 150C with 220C Insulation System Copper Winding Material Sound Reduction : 0 NEMA ST-20 Audible Sound Level: 50 Efficiency : DOE 10 CFR Part 431 (2016) UL Listed : Y Enclosure Type: NEMA 2 Operating Frequency: 60 HZ Electrostatically Shielded
		Catalog No	V48M28T7516CUES
		Designation	XFMR-LP-SH

Eaton Selling Policy 25-000 applies.

All orders must be released for manufacture within 90 days of date of order entry. If approval drawings are required, drawings must be returned approved for release within 60 days of mailing. If drawings are not returned accordingly, and/or if shipment is delayed for any reason, the price of the order will increase by 1.0% per month or fraction thereof for the time the shipment is delayed.

Scope Letter: 2 pages

Technical
Systems
Incorporated

January 27, 2020

Quote Number: CO#05

To: Southern Contracting
Attn: Dan Alcantar

Project: Beaumont WWTP Salt Mitigation
Beaumont Wastewater Treatment Plant

Reference: **CLAR-24 EQ Basin Modifications**

2303 196th Street SW
Lynnwood, WA 98036
Tel: (425) 775-5696
Fax: (425) 775-9074
info@tsicontrols.com

Bid Date: N/A

Bid Time: N/A

Technical Systems, Inc. (TSI) is pleased to provide a quote for the above referenced project. Material for this project will be shipped FOB Lynnwood WA, complete, ready for field termination by others. TSI's price includes CA sales tax and does not include the cost to bond TSI's portion of the project.

TSI's price for the scope of work detailed on the following pages:

Change Order Proposal Pricing:**\$16,040.00****Change Scope as Follows:**

- Supply new 16" Mag Flow Meter FE/FIT 1511
 - o Remote Mount Transmitter, 30' Cable
 - o ABB Watermaster Similar to other flow meters provided
 - o Flow Tube in Class 1 Div 2 Area
 - o Add Sunshield similar to other flow meters
 - o Estimated 6 week lead time
- LSH-1534 Gems Pressure Switch – Deleted, purchased unit to be provided as spare
- Level Transmitters LE/LIT-1502 & 1502, Level Switches LSH 1503 & 1504
 - o Already in scope, so be supplied as shown on updated drawings
 - o Update Mounting as Necessary
- Incorporate IO changes for RIO-HW and RIO-SH
- Supply New Pump HOR Local Control Panel LCP-1531
 - o Approximately 12x12x6", 316SS, NEMA 4X
 - o (3) 3-position operator switches, NEMA 4X
 - o Local HOR operation only, all pump control to be in respective MCC buckets

Terms: Net 30
FOB: Lynnwood WA
Freight: Prepaid

This quote is valid for 90 days.

Please call with any questions you may have concerning pricing or any technical questions.

Sincerely,

Colin Dightman-Kovak

Colin Dightman-Kovak
Technical Systems, Inc.
1-425-678-4116

Scope of Work

Misc Equipment:

Including:

1. Hardware Procurement
2. Required Testing
3. O&M, drawings updates

GENERAL

1. TSI supplies a bill of materials, CAD-based drawings, and Operations and Maintenance Manuals for all equipment furnished by TSI.
2. TSI supplies the required field startup services for this project.
3. Panels fabricated by TSI are UL 508 labeled.

STANDARD INCLUSIONS

We provide the following unless specifically excluded on our bill of material:

- 1) Equipment shipped FOB factory with freight allowed, tailgate, destination.
- 2) Field wiring diagrams showing interconnection of field instruments and instrumentation panels.
- 3) Instruction manuals as required.
- 4) All necessary field start-up and calibration of the equipment we supply.

STANDARD EXCLUSIONS

We do NOT include the following unless specifically included in our bill of material:

- 1) Pipe, tubing, valves or fittings between the instrument and the process.
- 2) Conduit, wire or cable not an integral part of the instrument.
- 3) Mounting brackets, stanchions, supports or mounting pads not an integral part of the instrument.
- 4) Labor to install the equipment.
- 5) The Cost, (if due to local union regulations), to have local craftsman make adjustments or wiring modifications to our equipment during start-up and calibration.
- 6) Any material or services not in our quoted sections.

- 7) This proposal is based on award of a supply purchase order and does not include any of the costs associated with bonding or subcontract administration. If bonding or a subcontract is required they can be provided for additional cost.

SPECIFIC EXCLUSIONS

- 1) Installation of Panels and Instruments.

Dan Alcantar

From: Colin Dightman-Kovak [colind@tsicontrols.com]
Sent: Monday, January 27, 2020 2:21 PM
To: Dan Alcantar
Cc: Mike Long
Subject: CLAR-24 Pricing
Attachments: 7781 CO-05 CLAR-24 EQ Basin Mods.pdf

Good Afternoon Dan,

Please see attached pricing for CLAR-24. Main components

- new 16" flow meter and sun shade
- new LCP for pump HOR control
- some modification of instruments in our scope already
- engineering/drawing for IO changes (but no new cards) in RIO panels

Thanks,

Colin Dightman-Kovak
Project Manager
Technical Systems, Inc.
Direct: (425) 678-4116

Privileged/Confidential Information may be contained in this message. If you are not the addressee indicated in this message (or responsible for delivery of the message to such person), you may not copy or deliver this message to anyone. In such case, you should destroy this message and kindly notify the sender by reply e-mail.



PACIFIC STEEL GROUP

Contractor: WM Lyles

Date: 1/31/2020

Job Name: Salt Mitigation WWTP Upgrades

PSG Job #: L18161

Extra No.: 14R

Description: Add Material and Labor for revisions to the Equalization Basin per Clar-24-EQ.

North Wall is 12" Taller
 North Wall Verticals revised from #8 @ 8"o.c. to #8 @ 6"o.c. - Added 11,680 Lbs.
 New Pump Station - Added 4,768 Lbs.
 Added Duct Banks - Added 1,880 Lbs.

Material:	Quantity:	Unit:	Unit Price:	Comments:	Extended Price:
Rebar	18,328	LB	\$ 0.60		\$ 10,997.00
Specialty Rebar	-	LB	\$ 1.50		\$ -
Mesh	-	SQFT	\$ 0.35		\$ -
Couplers	-	Each	\$ 1.75		\$ -
Other	-	Each	\$ -		\$ -
					\$ 10,997.00

Labor Impact:	Quantity:	Unit:	Unit Price:	Comments:	Extended Price:
Rebar	156	Hours	\$ 93.04		\$ 14,514.00
Specialty Rebar	-	Hours	\$ 93.04		\$ -
Mesh	-	Hours	\$ 93.04		\$ -
Couplers	-	Hours	\$ 93.04		\$ -
Other	-	Hours	\$ 93.04		\$ -
					\$ 14,514.00

FWA Labor:	Quantity:	Unit:	Unit Price:	Comments:	Extended Price:
Ironworker	-	Hours	\$ 93.04	Regular Base Pay	\$ -
Overtime	-	Hours	\$ 53.90	Premium Portion Only	\$ -
Doubletime	-	Hours	\$ 83.80	Premium Portion Only	\$ -
					\$ -

Other:	Quantity:	Unit:	Unit Price:	Comments:	Extended Price:
Engineering	10.00	Hours	\$ 85.00		\$ 850.00
Crane	-	Hours	\$ 300.00		\$ -
Delivery	1.00	Each	\$ 550.00		\$ 550.00
Other	-	Each	\$ -		\$ -
					\$ 1,400.00

Sub Total = \$ 26,911.00

Overhead & Profit @ 10% & 5% = \$ 4,171.00

Sub Total = \$ 31,082.00

Bond Fee = \$ 311.00

Total Extra To Contract = **\$ 31,393.00**

Oscar Mendoza

From: david parada <davidparadajr@yahoo.com>
Sent: Wednesday, January 29, 2020 12:55 PM
To: Oscar Mendoza
Cc: Lisa Greenelsh
Subject: Re: Emailing: CLAR-24- EQ Basin Modifications
Attachments: CLAR-24- EQ Basin Modifications.pdf

Lisa please send Oscar a scope letter for \$8300 to coat additional mechanical at eq pump station and fine screen. coat additional concrete roughly 132 sq feet.

Lisa if you have any questions please ask Oscar with Lyles. this is for the Beaumont project

Thank you

David Parada Jr.

858 602 6037

On Wednesday, January 29, 2020, 11:10:35 AM EST, Oscar Mendoza <omendoza@wmlylesco.com> wrote:

Your message is ready to be sent with the following file or link attachments:

CLAR-24- EQ Basin Modifications

Note: To protect against computer viruses, e-mail programs may prevent sending or receiving certain types of file attachments. Check your e-mail security settings to determine how attachments are handled.

Oscar Mendoza

From: Bill Greer <bill@gwbuilders.com>
Sent: Tuesday, April 7, 2020 12:50 PM
To: Oscar Mendoza
Subject: RE: Pages from COP No. 036.1 EQ Basin Modifications CLAR-24 (003).pdf

Hello Oscar,

So I looked at this a little closer and have the following response.

1. The price is the price we have, I can't control Americans pricing and I can not hold them responsible for a quote a year old for a project in a different location. Per our conversation, I would be happy to see if Star can shave some cost off this if the owner willing to entertain a different supplier. We have been a Star dealer for over 35 years and even have in our scope at Imperial to modify an existing Star Canopy. They are more than capable of providing this canopy at the same quality as American. I can't guarantee their will be a significant savings, but I'm willing to find out for you. Please also see my additional comments because they do also affect the building.
2. Differences that also affect the price Between Beaumont EQ and Imperial Headworks Quote dated March of 2019
 - a. Support beam holding three (3) 1,000 pound point loads. This has a material and labor impact.
 - b. Wind speed in Beaumont is 20 mph more than in imperial city. This has an affect on the weight of steel, which affects the price.
 - c. Beaumont has a 5.5 psf roof snow load While imperial city had none. Again affecting the weight of the steel.

Those items combined with the Market changes over the last year, give you the price we currently have.

Thank you,

Bill Greer
Vice President
G&W Builders
557 Mercury Lane
Brea CA 92821
714-529-9935

From: Oscar Mendoza <omendoza@wmlylesco.com>
Sent: Tuesday, April 07, 2020 9:51 AM
To: Bill Greer <bill@gwbuilders.com>
Subject: Pages from COP No. 036.1 EQ Basin Modifications CLAR-24 (003).pdf

Please see owner's note to comment 2B. I sent the your email explaining the cost and they sent me this quote from Imperial. Can you please provide me with a response back. Thanks,

G&W BUILDERS, INC.

QUOTE

A & B License Number 457076
557 MERCURY LANE BREA, CALIFORNIA 92821

Bill M. Greer. Vice President
(714) 529-9935 FAX (714) 529-0795

Brine WWTP Beaumont

WM Lyles Co.

April 13, 2020

Ph: 714-962-6828

Attn: Juan Ahumada

CODES AND LOADS:

- 2016 CALIFORNIA BUILDING CODE
- ADDITIONAL 5 POUND COLLATERAL LOAD ADDED TO ROOF FRAMING
- WIND SPEED: 135 MPH
- WIND EXPOSURE "C"
- LIVE LOAD: 20 PSF NON REDUCABLE
- Ss: 1.525 / S1: .653
- OCCUPANCY CLASSIFICATION III – HIGH HAZARD
- ROOF SNOW LOAD 5.5 PSF

EQ BASIN CANOPY

STAR CANOPY

- Width: TOTAL WIDTH WITH OVERHANGS 16'-8"
 - 12' CENTER TO CENTER OF COLUMN.
- Length: TOTAL LENGTH WITH OVERHANGS 24'-8"
 - 20' CENTER TO CENTER OF COLUMNS.
- HEIGHT: 10' AT LOW SIDE ROOF LINE/ 11'-4 11/16" HIGH SIDE ROOF LINE
 - 1:12 PITCH.

FRAMING:

- COLUMNS ARE STRAIGHT
- MAIN FRAMES TO BE GALVANIZED
- SECONDARY TO BE PRE-GALVANIZED
- X-ROD BRACING IN ROOF
- COLUMNS TO BE FIXED WITH NO WALL BRACING.
- ALL WALLS OPEN TO REMAIN OPEN
- SUPPORT FOR THREE (3) 1,000 POUND POINT LOADS LOCATED IN THE CENTER OF THE CANOPY.

COVERING:

- 24 GAUGE DOUBE-LOK (SINGLE SKIN STANDING SEAM)
 - KYNAR FINISH
 - EXACT COLOR TO BE CHOSEN BY OWNER FROM MANUFACTURERS STANDARD COLOR CHART
- HIGH SIDE AND LOW SIDE STANDARD METAL BUILDING EAVE TRIM.
 - KYNAR FINISH
 - EXACT COLOR TO BE CHOSEN BY OWNER FROM MANUFACTURERS STANDARD COLOR CHART.

GENERAL:

- ALL NECESSARY TAX AND FREIGHT
- ALL NECESSARY PLANS AND CALCULATIONS STAMPED BY CALIFORNIA LICENSED ENGINEER
- ALL NECESSARY LABOR AND EQUIPMENT TO PERFORM DESCRIBED WORK.
- PRICE IS BASED OFF PREVAILING WAGES AND REGULAR BUSINESS HOURS.
- PRICE ASSUMED 15' OFF ACCESS ON ALL SIDES OF THE CANOPY.

QUOTE LUMP SUM = \$42,500.00

EXCLUSIONS

1. FOUNDATION/CONCRETE	9. BONDS	15.
2. PROTECTIVE COATING	10. FIRE SPRINKLERS	16.
3. GUTTERS AND DOWNSPOUTS	11. Electrical	17.
4. GRADING	12. Mechanical	18. ROOF PENETRATION
5. Finish Painting of Structural Steel	13	19.
6. ANCHOR BOLTS	14.	20. ANYTHING NOT LISTED.

GRAND TOTAL: \$ 42,500 + 10% Escalation = \$ 46,750.00

Labor - Concrete

Item Number:	CLAR-24
Description:	Labor - Concrete Summary
Item Number:	1
Bid Item:	1
Description:	EQ Basin Changes
Sheet:	EQS 1-5

Labor Item Description	Qty	Unit	Labor & Equipment	Material	Subcontractor	Total Cost
			Total Cost	Total Cost	Total Cost	Total Cost
Form & Strip Edge Form - Slab	239	SF	\$ 3,976	\$ 837	\$ -	\$ 4,813
Form & Strip Walls	272	SF	\$ 5,965	\$ 953	\$ -	\$ 6,918
Fab Wall Forms	100%	272	SF	\$ 1,965	\$ -	\$ 1,965
Place - Slab	27	CY	\$ 2,710	\$ -	\$ -	\$ 2,710
Place - Walls	11	CY	\$ 763	\$ -	\$ -	\$ 763
Purchase - Slab	30	CY	\$ -	\$ 4,500	\$ -	\$ 4,500
Purchase - Walls	12	CY	\$ -	\$ 1,800	\$ -	\$ 1,800
Finish - Slab	501	SF	\$ 1,249	\$ 501	\$ -	\$ 1,750
Cure - Slab	501	SF	\$ 430	\$ 50	\$ -	\$ 480
Cure - Walls	272	SF	\$ 143	\$ 27	\$ -	\$ 170
Point & Patch - Walls	100%	272	SF	\$ 624	\$ 27	\$ 651
Sack & Patch - Walls	100%	272	SF	\$ 850	\$ 27	\$ 877
			\$ -	\$ -	\$ -	\$ -
Install Chamfer	207	LF	\$ 324	\$ 311	\$ -	\$ 635
Install Waterstop	4	LF	\$ 162	\$ 20	\$ -	\$ 182
Install Wall Penetrations	7	EA	\$ 227	\$ 105	\$ -	\$ 332
Install Dowels	39	EA	\$ 649	\$ 585	\$ -	\$ 1,234
Install Sealant	8	LF	\$ 156	\$ 12	\$ -	\$ 168
Install Expansion Joint	60	SF	\$ 162	\$ 210	\$ -	\$ 372
Sandblast 2	81	SF	\$ 574	\$ -	\$ -	\$ 574
Install Anchors	16	EA	\$ 1,622	\$ 160	\$ -	\$ 1,782
Grout Supports	29	EA	\$ 1,538	\$ 145	\$ -	\$ 1,683
Place Grout	7	CY	\$ 1,538	\$ -	\$ -	\$ 1,538
Foreman Truck	100%	49.0	HR	\$ 1,450	\$ -	\$ 1,450
Scissor Lift (% FORM)	100%	2.0	DAY	\$ 320	\$ -	\$ 320
Reach Lift (% FORM)	100%	2.0	DAY	\$ 936	\$ -	\$ 936
Crane - 80 Ton (% FORM)	100%	4.0	DAY	\$ 5,240	\$ -	\$ 5,240
Concrete Pumping	28 Meter Pump	49.0	CY	\$ -	\$ -	\$ 980
BI 1 - EQ Basin Changes	49	CY	\$ 33,573	\$ 10,270	\$ 980	\$ 44,823