GENERAL NOTES:

1. CODE COMPLIANCE: All work is to be performed in accordance with all governing Codes, Ordinances and Regulations. The designs herein are based on the 2019 C.B.C., 2019 C.M.C., 2019 C.E.C., 2019 C.F.P.C., 2019 C.F.P.C., 2019 C. Energy C.

2. JOB COORDINATION & SAFETY: Contractor shall be responsible for the development, coordination and execution of construction methods and procedures. The Contractor shall also be responsible for initiating, maintaining and supervising all safety precautions and programs in connection with his work.

3. JOB CLEANLINESS: Contractor shall on a daily basis leave the construction site "broom clean" at the end of the work day. At substantial completion, the Contractor shall turn to the Owner a spotlessly clean house, including clean mirrors, glass, light bulbs, walls, floors, cabinetry inside and out, bathroom fixtures, tiles and appliances.

4. CONSTRUCTION QUALITY: No guarantee for quality of construction is implied or intended by the architectural documents, and the Contractor shall assume full responsibility for any or all construction deficiencie

5. CONTRACT DOCUMENT REVIEW: Contractor shall review all Contract Documents. If fifteen days elapse from the time the Contractor receives the plans and signs to perform the work, and the Owners have not been notified of any errors, omissions or objet the Owners will consider the documents approved by the Contractor for the performance of his/her work.

6. DISCREPANCIES: In case of any discrepancy notify the Owners before proceeding. Contractor shall be responsible for correction of work at his/her own expense for work installed in conflict with the Contract Documents.

7. DIMENSIONS: All dimensions shown on plans are to face of stud, unless otherwise noted. All dimensions shown on interior elevations are finish dimensions. No dimensions shall be taken by measuring from the drawings. Details take precedence over general sections or plans. Written dimensions take precedence over scale. All dimensions shall be verified in the field for coordination with existing and new

8. SUBSTITUTIONS: The Contractor will be held to furnish under his Proposal all work described herein. All materials and articles of any kind necessary for this work are subject to the approval of the Owners.

9. MANUFACTURED ITEMS: Transport, handle, store, protect and install manufactured items in strict accordance with manufacturer's recommendations. Should conflict exist between construction documents and manufacturer's instructions, consult with Designer.

10. ASBESTOS: Asbestos removal is not intended to be covered by this contract. If Asbestos is suspected, a testing agency must be hired to verify, and special procedures must be used for removal and disposal. Friable asbestos is the dangerous type and was used extensively for pipe insulation, fireproofing and certain building materials up to 1970.

11. CUTTING AND PATCHING: Cut and fit components as required; patch disturbed areas to match adjacent materials and finishes

12. ATTIC VENTILATION: Ventilating area shall not be less than 1/150th of the net area of the space ventilated. If at least 50% of required ventilation is provided in the upper portion of the space, then ventilating area may be 1/300th of the attic space per section 2016 CBC 1203.2.

13. BLOCKING: Provide solid blocking as necessary for all wall mounted shelves, fixtures and fittings. See interior elevations, where

14.WATER TIGHTNESS: Contractor shall verify that all work on the exterior of the project is watertight. All joints and surfaces exposed to the elements shall be tested for water tightness prior to substantial completion.

15.WATERPROOF MEMBRANE: Install a waterproof membrane under the Master Shower floor @ the Master Bath. Wrap the membrane

16. GLAZING: Tempered glazing is required as per 2016CBC. Glazing to be tempered includes but is not limited to: glazing that is less than 18" above finish floor; within 24" radius of doors; Glass door and panels of shower and bathtub enclosures and adjacent glazed openings within 60" above a standing surface and drain inlet shall be fully tempered, laminated safety glass as per UBC 2406.3 & 4; skylights; etc...

17. DRYWALL: All drywall to be 5/8" thick. Install metal corner beads at all outside corners. Fasten drywall to framing with drywall screws. All drywall is to be sanded three times to produce a smooth finish for all walls and ceilings. All drywall shall be finished so that it is smooth, with no bumps or craters. All joints to be taped and sanded so that there is no distinguishable transition. Contractor shall deliver all new or repaired walls perfectly even. The owners' and designer's criteria will be the sole measure for approval of the finished work.

18. HANDRAILS AND GUARDRAILS: All handrails at stairs are 34" above tread nosing. All guardrails are 42" minimum to finish floor, U.O.N. See interior elevations or details, as applicable, for guardrail design.

19. SHOWER AND TUB W/ SHOWER: Provide ceramic tile or stone finish at all shower and tub w/ shower areas to a minimum height of 72" above the drain inlet AS PER 2016 CBC 1210.2.2; over a moisture resistant underlayment (typical). Verify with interior elevations, if applicable. All showers & shower/tub combinations to have pressure balance mixing valves as per UPC section 410.7

20. PLUMBING:All work is design/build by the Plumbing contractor and is to meet required codes and Title 24 requirements. Low flow plumbing fixtures & fittings will be used in all bathrooms, etc... Toilets to have a max. allowable flush of 1.28 gal. When there are fixtures @ three levels, cast iron or other approved non-plastic materials for drain, waste, & vents is to be used.

21. TITLE 24 RESIDENTIAL LIGHTING REQUIREMENTS

A) All residential lighting to be high efficacy as per Table 150.0-A

B) At least one fixture in bathrooms, garages laundry room and utility rooms must be controlled by a vacancy sensor.

C) Lighting in kitchens, bathrooms, garages, laundry room and utility rooms shall be high efficacy or either controlled by a dimmer switch or

D) Recessed lights in insulated ceilings must be ic and at(air tight) rated, recessed lights within 5'-0" of a common prop. line to have 1hr rated

enclosure.

E) Exterior building mounted lighting must be high efficacy and must include manual on/off switchand one of the following: photocontrol & motion sensor - photocontrol & automatic time switch control - astronomical time switch control or energy management control system.

F) Common areas of low-rise residential buildings with four or more units must be high efficacy or controlled by a title 24 compliant

occupant sensor.

G) Under cabinet lighting (including kitchen) must be switched seperatly from other lighting systems.

H) All nonlocking-type 125 volt, 15- and 20-ampere receptacle outlets shall be listed tamper-resistant receptacles, as per Electrical Code

400.12 (A)

J All 120-volt, single phase, 15- and 20-ampere outlets or devices installed in dwelling unit kitchens.family rooms.dining rooms.living rooms, bedrooms, closets,hallways, laundry or similar rooms or areas shall be arc-fault circuit-interrupter protected as per Electrical Code

21. TITLE 24 RESIDENTIAL LIGHTING REQUIREMENTS
A) All residential lighting to be high efficacy as per Table 150.0-A
B) At least one fixture in bathrooms, garages laundry room and utility rooms must be controlled by a vacancy sensor.
C) Lighting in kitchens, bathrooms, garages, laundry room and utility rooms shall be high efficacy or either controlled by a dimmer switch or

D) Recessed lights in insulated ceilings must be ic and at(air tight) rated, recessed lights within 5'-0" of a common prop. line to have 1hr rated

encrosure.
E) Exterior building mounted lighting must be high efficacy and must include manual on/off switchand one of the following: photocontrol &

E) Exterior building mounted lighting must be high efficacy and must include manual on/off switchand one of the following: photocontrol motion sensor - photocontrol & automatic time switch control - astronomical time switch control or energy management control system.
F) Common areas of low-rise residential buildings with four or more units must be high efficacy or controlled by a title 24 compliant occupant sensor.
G) Under cabined lighting (including kitchen) must be switched seperatly from other lighting systems.
H) All nonlocking-type 125 volt, 15- and 20-ampere receptacle outlets shall be listed tamper-resistant receptacles, as per Electrical Code 162 (A).

I) All 120-volt, single phase, 15- and 20-ampere outlets or devices installed in dwelling unit kitchens, family rooms, dining rooms, living sets hallways, laundry or similar rooms or areas shall be arc-fault circuit-interrupter protected as per Electrical Code rooms, bedrooms, clos 210.12 (A).

DRAWING SYMBOL LEGEND

Existing Partition/wall

Fittings/fixtures to be removed



- Sheet Number [typical]

- Flevation Number [typical]

- Elevation Number [typical]

Sheet Number [typical]

Building Section

Sheet Number [typical]

Indicates walls elevated

Elevation



Center Line Elevation Level

Window Type

Door Number

KN - 15 Keynote
Note number [typical]

1'-2" Dimension Line



 $\langle \mathsf{D} \rangle$

(14)

Clouded area indicates revised are



ARCHITECTURAL SHEETS:

A1.0 PROJECT INFO., DRAWING INDEX & LEGENDS

A1.1 PROP. & EXIST. SITE PLAN

A2.0 PROPOSED FIRST & SECOND FLOOR PLANS

PROPOSED THIRD FLOOR & ROOF PLAN A2.1

G 1.0 SITE SURVEY

L 1.0 CONCEPTUAL LANDSCAPE PLAN

A3.0 BUILDING SECTIONS

A4.0 PROPOSED NORTH & WEST ELEVATIONS

A4.1 PROPOSED SOUTH & EAST ELEVATIONS

& STORM WATER CHECKLIST

STRUCTURAL SHEETS [TBD]

PROPOSED BUILDING AREA:

VIEW FROM VISITACION AVENUE

PROJECT DESCRIPTIONATTACHMENT H

THE SCOPE OF WORK INCLUDES THE CONSTRUCTION OF A NEW THREE STORY MIXED USE STRUCTURE WITH FOUR RESIDENTIAL UNITS, GROUND FLOOR COMMERCIAL SPACE AND PRIVATE PARKING GARAGE FOR FOUR CARS. THE RESIDENTIAL UNITS WILL CONSIST OF LIVING/DINING/KITCHEN AREAS, ONE OR TWO BEDROOM, STUDY AND ONE OR TWO BATHS.

PROJECT DATA

EXISTING PROPOSED ZONING: NCRO HEIGHT LIMIT: 35'-0" BUILDING OCCUPANCY: R-3 NCRO-2 NCRO-2 CONSTRUCTION: STORIES: TYPF V-B TYPE V-A W/ SPRINKI ERS 14'-0" @ FRONT 34'-10" @ FRONT

EXISTING AREA:

SPRINKLERS:

LOT SIZE: 2,708 sq.ft. LOT COVERAGE: 2.437 sq.ft. [90% OF LOT OPEN YARD:

NON SPRINKLERED

EXISTING HOUSE [TO BE DEMOLISHED]:

FIRST FLOOR: GROSS FLOOR AREA:

890 sq.ft. sq.ft. **sq.ft.**

SPRINKLERS THROUGHOUT

TOTAL EXIST GROSS SQ.FT.: 890 sa.ft.

FIRST FLOOR: 283 sq.ft. 762 sq.ft. 248 sq.ft. 974 sq.ft. COMMERCIAL AREA: PRIVATE GARAGE RESIDENTIAL/UNIT A: COMMON SPACE: GROSS FLOOR AREA: 2,267 sq.ft.

SECOND FLOOR UNIT A [TWO BEDROOM] UNIT B [ONE BEDROOM] 1,036 sq.ft. 899 sq.ft. UNCONDITIONED 249 sq.ft GROSS FLOOR AREA: 2.174 sq.ft.

THIRD FLOOR UNIT C [TWO BEDROOM] UNIT D [ONE BEDROOM] 970 sq.ft. 899 sq.ft. UNCONDITIONED GROSS FLOOR AREA: 206 sq.ft. 2.075 sq.ft. TOTAL PROP. GROSS SQ.FT.:

6,516sq.ft. TOTAL PROP. CONDITIONED AREA: 4.463 sq.ft. TOTAL PROP. UNCONDITIONED AREA: 2,134 sq.ft.

OPEN SPACE AREA

COMMON AREA YARD 271 sq.ft. 271 sq.ft 413 sq.ft PRIVATE ROOFDECKS

TOTAL OPEN SPACE AREA:

684 sa.ft.

RESIDENTIAL UNIT AREAS (CONDITIONED & EXTERIOR) UNIT A YARD AREA [COMMON] 1,393 sq.ft. UNIT B
PRIVATE ROOFDECK 899sa.ft

UNIT C PRIVATE ROOFDECK **970 sq.ft**. 87 sq.ft. UNIT D PRIVATE ROOFDECK 899 sq.ft.

TOTAL UNIT AREA:

4.161 sa.ft.

TOPETCHER ARCHITECTURE INC 828 DIVISADERO SAN FRANCISCO CALIFORNIA 941 TEL 415 359 9997 FAX 415 359 9986

toparchitecture.com

PRINTING RECORD DATE ACTION UNE 3, 2020 PERMIT SUBMITTAL IULY 24, 2020 0702_NOI_DP-2-20 REVISION CT. 15. 2020 DESIGN REVISION DV. 10. 2020 DESIGN REVISION2 FNL. CM

Il drawings and written material appearing herein constitute the original an inpublished work of TOP etcher ARCHITECTURE INC. and the same may of be duplicated. used or disclosed without written consent.

94005 283-080 CA. 007

RESIDENCES SITACION AVENUE V-213 RESIDE 213 VISITACION A BRISBANE, CA.

SHEET TITLE PROJECT INFO,

SCALE: AS NOTED

19.20










1 LOOKING SOUTH WEST




2 LOOKING EAST

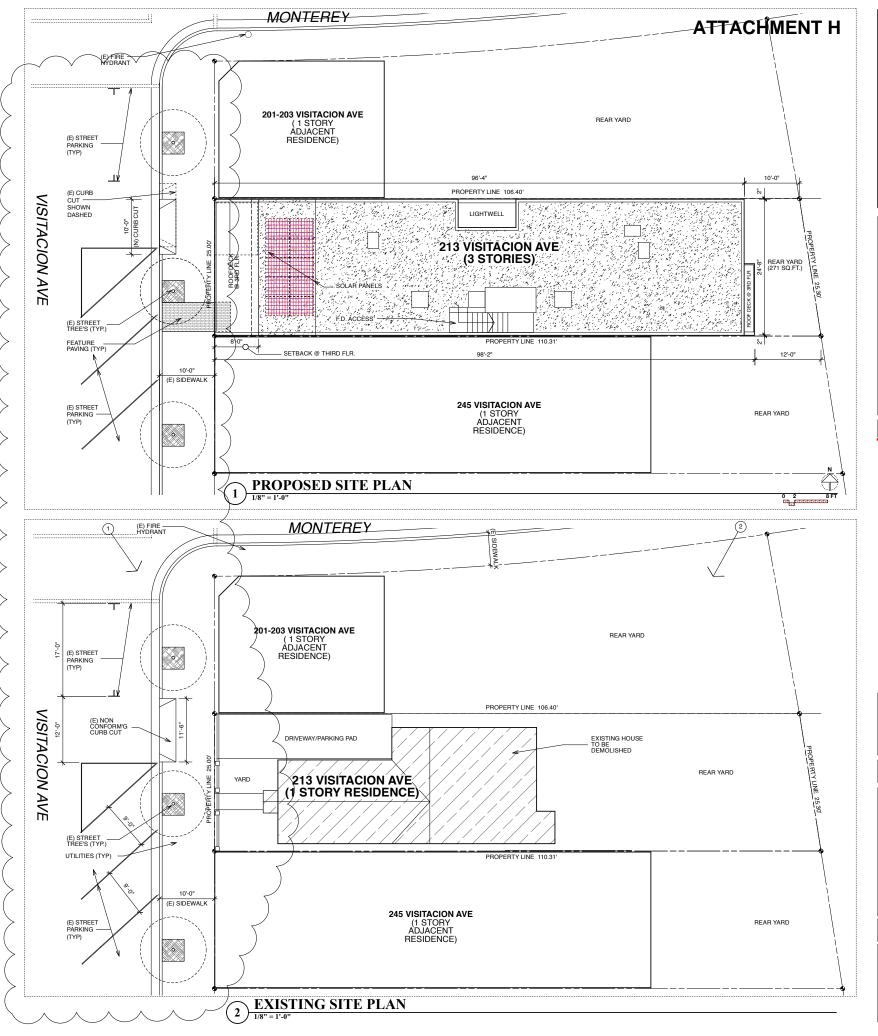



toparchitecture.com


ACTION ERMIT SUBMITTAL 102_NOI_DP-2-20 REVISION ESIGN REVISION 2.1 FNL. CMN
02_NOI_DP-2-20 REVISION SIGN REVISION
SIGN REVISION
S. REVISION2.1 FNL. CMN

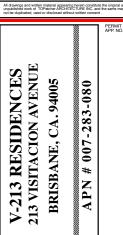

SCALE: AS NOTED

јов NO. 19.20



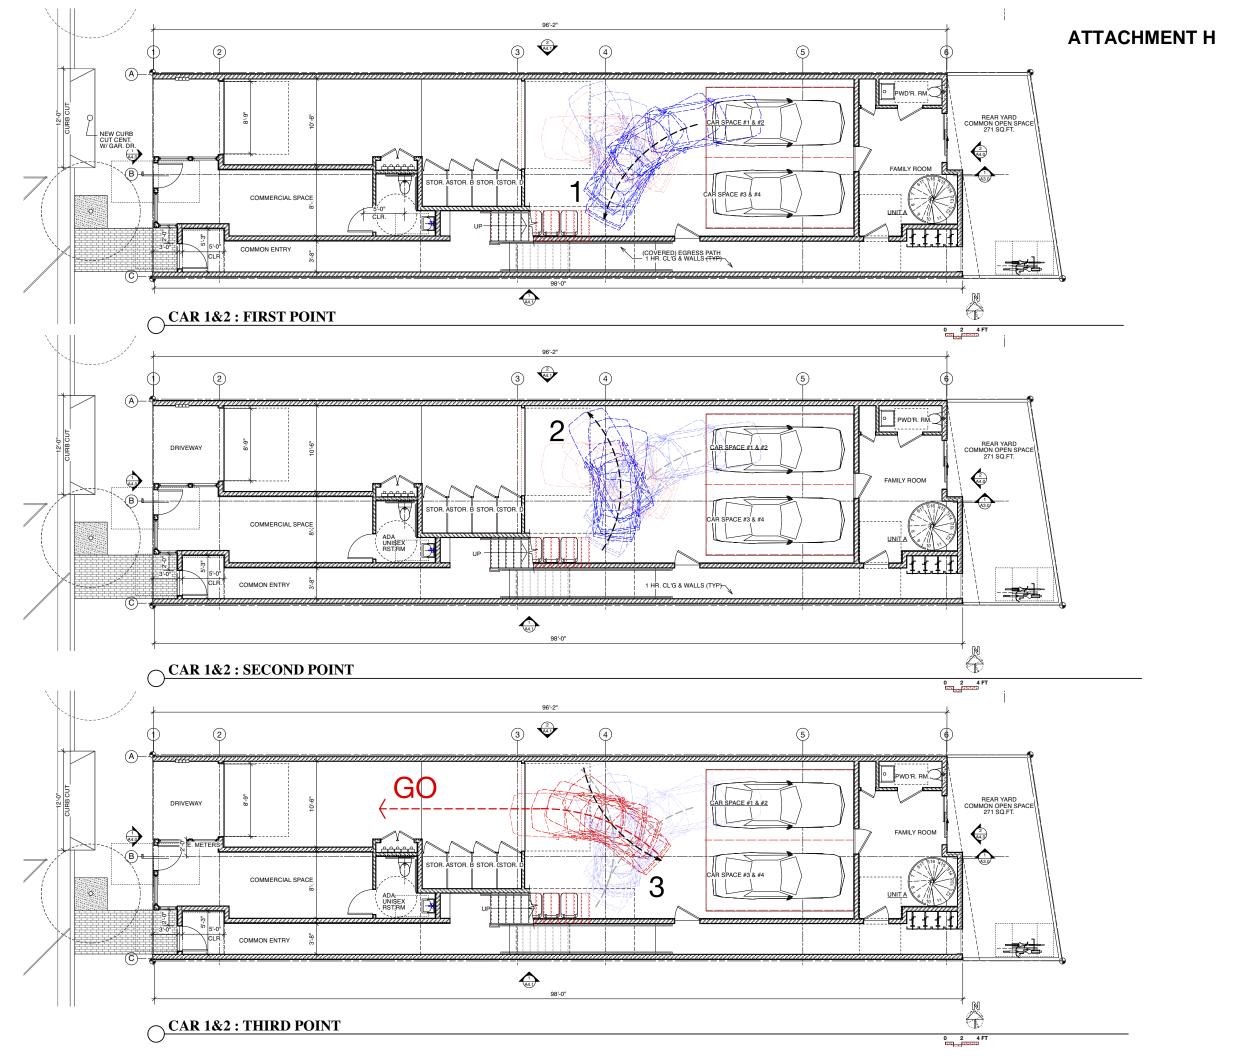



828 DIVISADERO SAN FRANCISCO CALIFORNIA 94117 TEL 415 359 9997 FAX 415 359 9986 toparchitecture.com

PRINTING RECORD			
DATE	ACTION		
JUNE 3, 2020	PERMIT SUBMITTAL		
JULY 24, 2020	0702_NOI_DP-2-20 REVISION		
OCT. 15, 2020	DESIGN REVISION		
OCT. 23, 2020	DESIGN REVISION2 CMNTS.		

All drawings and written material appearing herein constitute the original an unpublished work of TOPetcher ARCHITECTURE INC. and the same may not be duplicated, used or disclosed without written consent.

APN # 007-283-080


V-213 RESIDENCES 213 VISITACION AVENUE BRISBANE, CA. 94005

SHEET TITLE 3 POINT TURN DIAGRAMS / CARS 1 & 2

SCALE: 3/16"= 1'-0"

јов NO. 19.20

SH (200 A) (100 A) (10

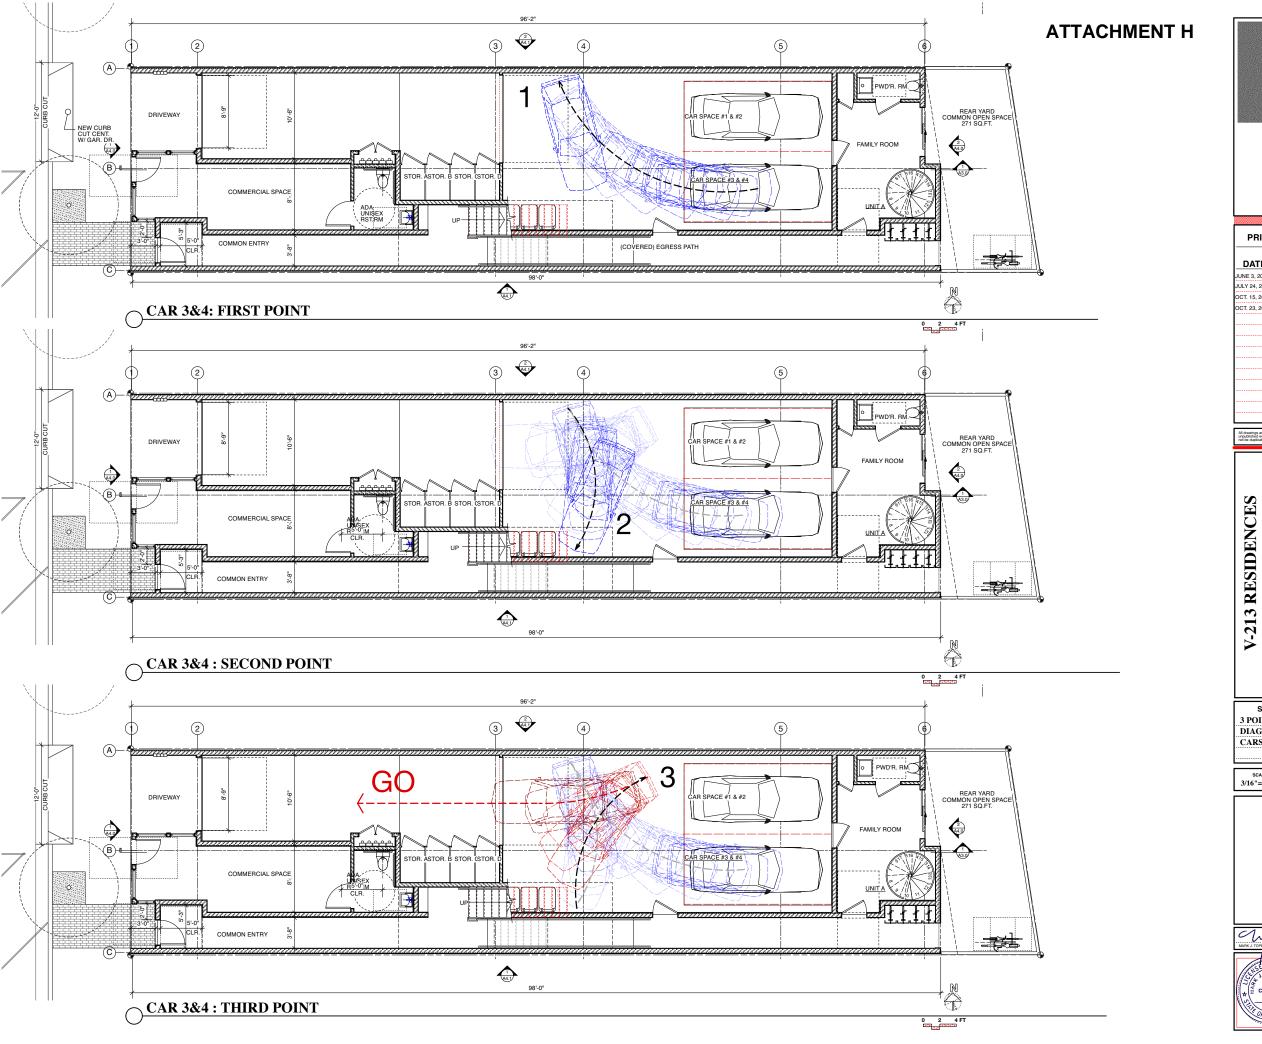



828 DIVISADERO SAN FRANCISCO CALIFORNIA 94117 TEL 415 359 9997 FAX 415 359 9986 toparchitecture.com

PRINTING RECORD			
DATE	ACTION		
JUNE 3, 2020	PERMIT SUBMITTAL		
JULY 24, 2020	0702_NOI_DP-2-20 REVISION		
OCT. 15, 2020	DESIGN REVISION		
OCT. 23, 2020	DESIGN REVISION2 CMNTS.		

All drawings and written material appearing herein constitute the original and unpublished work of TOPetcher ARCHITECTURE INC. and the same may not be duplicated, used or disclosed without written consent.

V-213 RESIDENCES
213 VISITACION AVENUE
BRISBANE, CA. 94005


APN # 007-283-080


3 POINT TURN DIAGRAMS / CARS 3 & 4

SCALE: 3/16"= 1'-0"

јов NO. 19.20

A 1.3

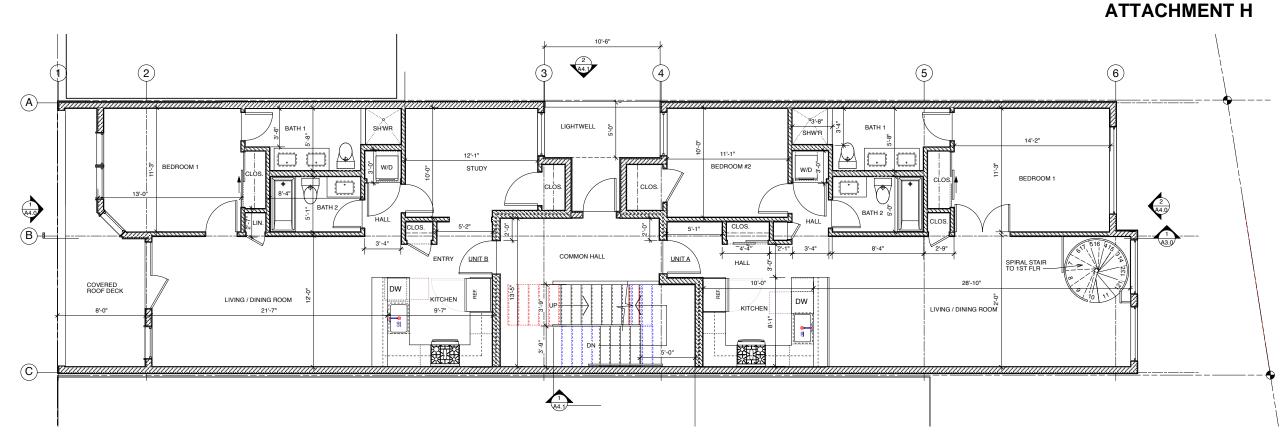

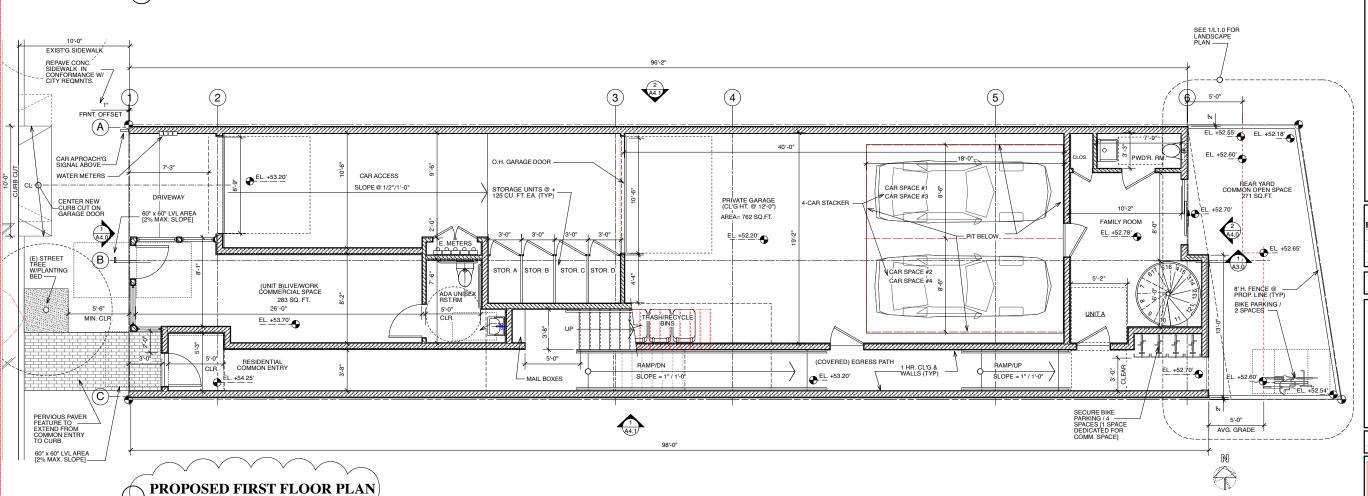


PROPOSED SECOND FLOOR PLAN



toparchitecture.com


PRINTING RECORD			
DATE	ACTION		
JUNE 3, 2020	PERMIT SUBMITTAL		
JULY 24, 2020	0702_NOI_DP-2-20 REVISION		
OCT. 15, 2020	DESIGN REVISION		
NOV. 18, 2020	DES. REVISION2.1 FNL. CMNT		

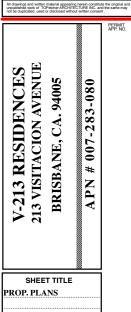








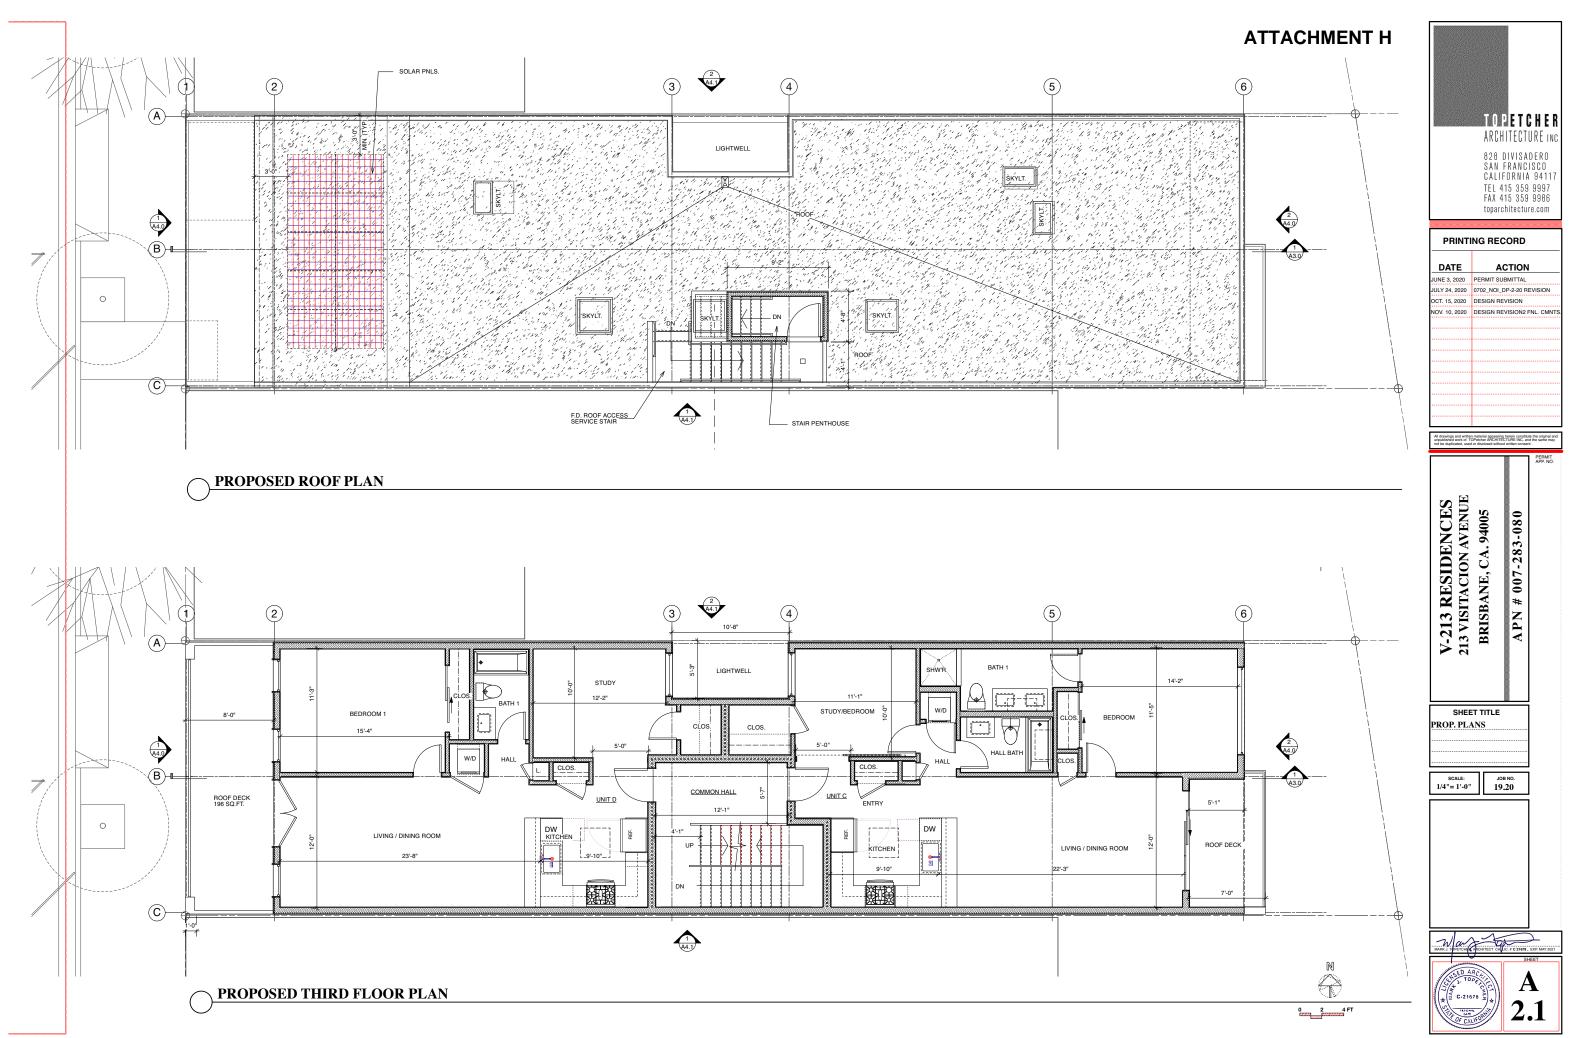

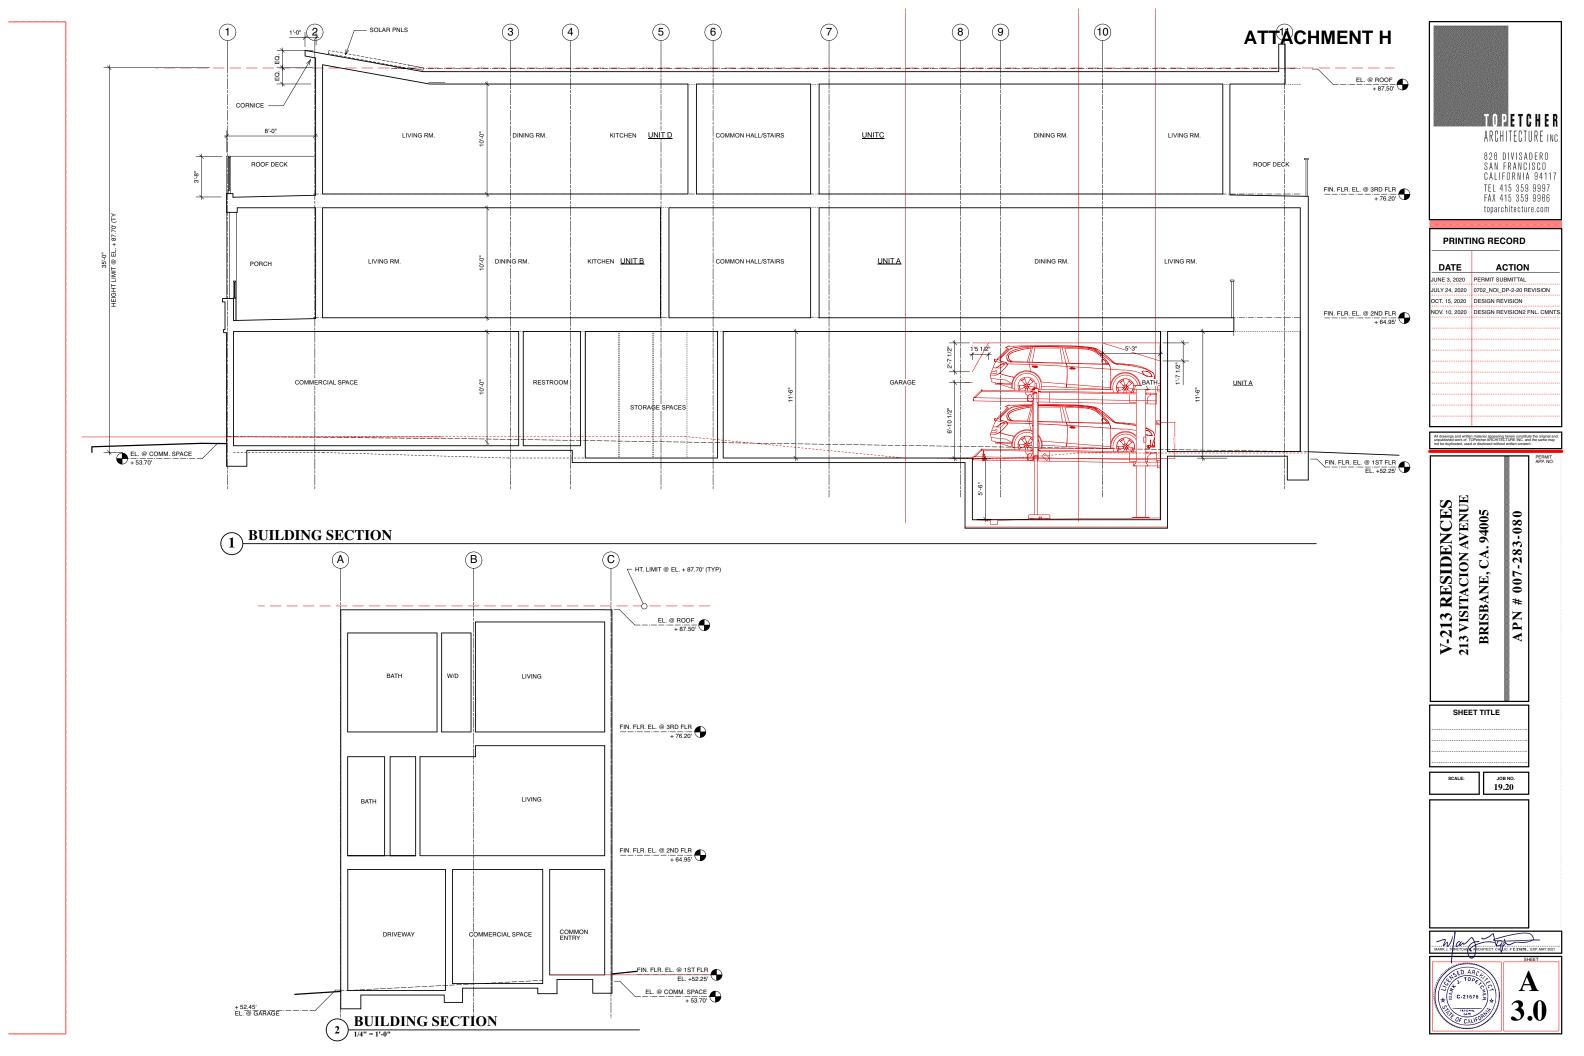




TOPETCHER ARCHITECTURE INC 828 DIVISADERO SAN FRANCISCO CALIFORNIA 9411 TEL 415 359 9997 FAX 415 359 9986

PRINTING RECORD				
DATE	ACTION			
JUNE 3, 2020	PERMIT SUBMITTAL			
JULY 24, 2020	0702_NOI_DP-2-20 REVISION			
OCT. 15, 2020	DESIGN REVISION			
NOV. 10, 2020	DESIGN REVISION2 FNL. CMNTS			



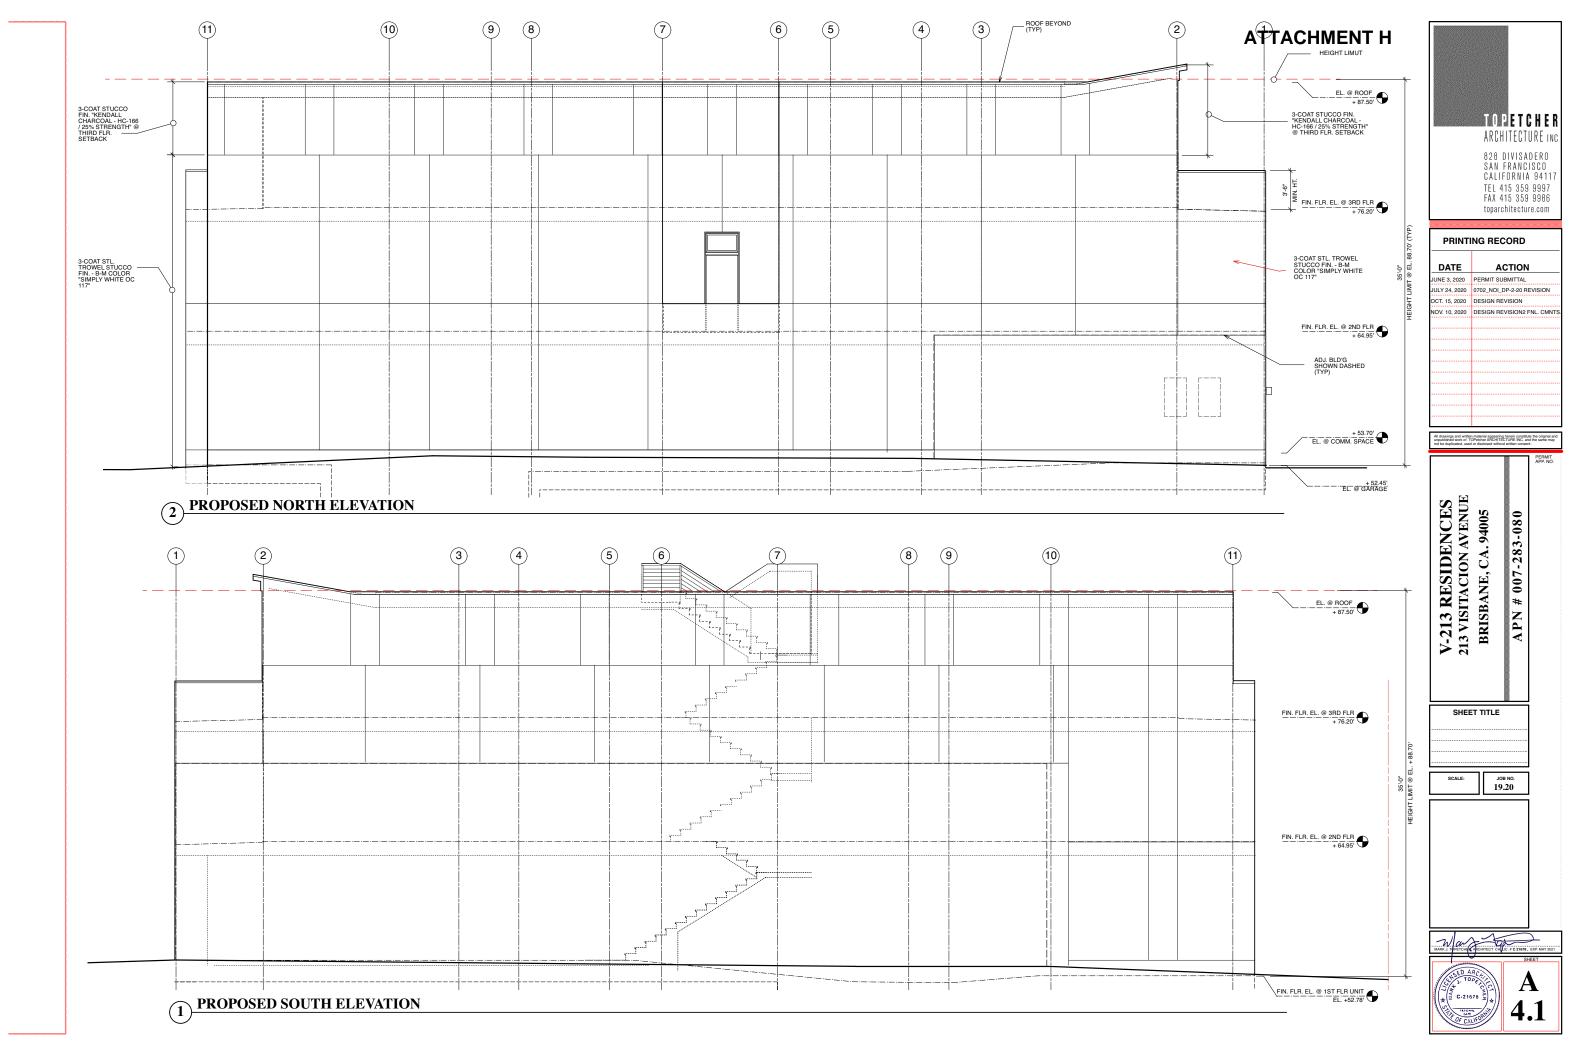



Stormwater Checklist for Small Projects



Complete this form for stand-alone single family home projects of any size that are not part of a larger project; or for projects in the following categories that create and/or replace less than 5,000 square feet of impervious surface: restaurants, retail gasoline outlets, and oservice facilities' and parking lots (stand-alone or part of another use); or for any other type of project that creates and/or replaces less than 10,000 square feet of impervious surface.

Δ	Project	Information

A. Proj	ect Information	
A.1	Project Name:	213 V RESIDENCES
A.2	Project Address:	213 VISITACION AVE.
A.3	Project APN:	007 283 080
A.4	Project Description: (also note any past or future phases of the project)	Scope includes the construction of a new three story mixed use structure will four residential units, ground floor commercial space and private parking garage for two cars. The residential will consist of (3) One-bedroom units & (1) Two-bedroom unit
A.5	Slope on Site:	%
A.6	Total Area of land disturbed	

B. Select Appropriate Site Design Measures

B.1 Does the project create and/or replace 2,500 square feet or more of impervious surface²? Yes 🛭 No

- If yes, and the project received final discretionary approval on or after December 1, 2012, the project must include at least one of the Site Design Measures listed below in section a through f. Pact sheets regarding site design measures a through f may be downloaded at <a href="https://www.neuron.com/measures/mea
- If no, or the project received final discretionary approval before December 1, 2012, the project applicant shall be encouraged to implement appropriate site design measures' from the list below, which may be required at municipality discretion. Consult with municipal staff about requirements for your project.
- B.2 On the list below, indicate whether each site design measure is included in the project plans and the plan sheet number:

Yes	No	Plan Sheet No.
	\square	 Direct roof runoff into cisterns or rain barrels and use rainwater for irrigation or other non-potable use.
		b. Direct roof runoff onto vegetated areas.
	\square	c. Direct runoff from sidewalks, walkways, and/or patios onto vegetated areas.
	Ø	d. Direct runoff from driveways and/or uncovered parking lots onto vegetated areas.
V		A1.1 & A2.0 e. Construct sidewalks, walkways, and/or patios with permeable surfaces.
	Ø	 Construct bike lanes, driveways, and/or uncovered parking lots with permeable surfaces.
	\square	g. Minimize land disturbance and impervious surface (especially parking lots).
Ø		h. Maximize permeability by clustering development and preserving open space.
	\square	Use micro-detention, including distributed landscape-based detention.

Ø	 Protect sensitive areas, including wetland and riparian areas, and minimize changes to the natural topography.
Ø	k. Self-treating area (see Section 4.2 of the C.3 Technical Guidance)
☑	I. Self-retaining area (see Section 4.3 of the C.3 Technical Guidance)
Ø	m. Plant or preserve interceptor trees (Section 4.1, C.3 Technical Guidance)

features in control		Features that require source control measures	Source control measures (Pofor to Local Source Control List for detailed requirements) meas		ource control sure included roject plans?	
Yes	No			Yes	No	Plan Sheet No.
	Z	Storm Drain	Mark on-site inlets with the words "No Dumping! Flows to Bay" or equivalent.			
Ø		Floor Drains	Plumb interior floor drains to sanitary sewer [or prohibit].		Z	
\square		Parking garage	 Plumb interior parking garage floor drains to sanitary sewer.⁶ 		Z	
Ø		Landscaping	Retain existing vegetation as practicable. Select diverse species appropriate to site. Include plants that are pest-and/or disease-resistant, drought-tolerant, and/or attract beneficial insects. Minimize use of pesticides and quick-release fertilizers. Use efficient imgalon system, design to minimize runoff.			
	V	Pool/Spa/Fountain	Provide connection to the sanitary sewer to facilitate draining. ⁶			
		Food Service Equipment (non- residential)	Provide sink or other area for equipment cleaning, which is: Connected to a grease interceptor prior to sanitary sewer discharge. Large enough for the largest mat or piece of equipment to be cleaned. Indoors or in an outdoor roofed area designed to prevent stormwater run-on and run-off, and signed to require equipment washing in this area.			
Z		Refuse Areas	Provide a roofed and enclosed area for dumpsters, recycling containers, etc., designed to prevent stormwater run-on and runoff. Connect any drains in or beneath dumpsters, compactors, and tallow bin areas serving food service facilities to the sanitary sewer. ⁶		Ø	
	Ø	Outdoor Process Activities ⁷	 Perform process activities either indoors or in roofed outdoor area, designed to prevent stormwater run-on and runoff, and to drain to the sanitary sewer.⁶ 			
	Ø	Outdoor Equipment/ Materials Storage	Cover the area or design to avoid pollutant contact with stormwater runoff. Locate area only on paved and contained areas. Roof storage areas that will contain non-hazardous liquids, drain to sanitary sewer ⁶ , and contain by berms or similar.			
	Ø	Vehicle/ Equipment Cleaning	Roofed, pave and berm wash area to prevent stormwater run-on and runoff, plumb to the sanitary sewer. and sign as a designated wash area. Commercial car wash facilities shall discharge to the sanitary sewer.			
	Ø	Vehicle/ Equipment Repair and Maintenance	Designate repair/imaintenance area indoors, or an outdoors area designed to prevent stormwater run-on and runoff and provide secondary containment. Do not install drains in the secondary containment areas. No floor drains unless pretreated prior to discharge to the sanitary sever. ⁶ Connect containers or shirks used for parts cleaning to the sanitary sever. ⁶			
	Ø	Fuel Dispensing Areas	Fueling areas shall have impermeable surface that is a) minimally graded to prevent ponding and b) separated from the rest of the site by a grade break. Canopy shall extend at least 10 ft. in each direction from each pump and drain away from fueling area.			

⁵ See MRP Provision C.3.a.i(7).

1/1/16 v.2

Stormwater Checklist for Small Projects

		Loading Docks	Cover and/or grade to minimize run-on to and runoff from the loading area. Position downspouts to direct stormwater away from the loading area. Drain water from loading dock areas to the sanitary sewer. ⁶ Install door skirts between the trailers and the building.		
Z		Fire Sprinklers	Design for discharge of fire sprinkler test water to landscape or sanitary sewer ⁶	V	
	Ø	Miscellaneous Drain or Wash Water	Drain condensate of air conditioning units to landscaping. Large air conditioning units may connect to the sanitary sewer.* Roof drains shall drain to unpaved area where practicable. Drain boiler drain lines, roof top equipment, all washwater to sanitary sewer.6.		
	Z	Architectural	Drain rinse water to landscaping, discharge to sanitary sewer ⁶ , or collect and dispose property offsite. See fiver "Paguirements for Architectural Copper".		

D. Implement construction Best Management Practices (BMPs) (Required for all projects.)

D.1 Is the site a "High Priority Site"? (Municipal staff will make this determination; if the enswer is yes, the project will be referred to construction site inspection staff for monthly stormwater inspections during the wet season - October 1 through April 30.) ("High Priority Sites" require a grading permit, are "hillside projects" (defined starting 7/1/16 as disturbing >= 5.000 sq.ft. of land area and a slope based on municipal criteria or map or == 16%) are adjacent to a creek, or are otherwise high priority for stormwater protection during construction per MRP Provision C.6.e.ii(2).)

D.2 All projects require appropriate stormwater BMPs during construction - indicate which BMPs are included in the project, below

Yes	No	Best Management Practice (BMP)
	Ø	Attach the San Mateo Countywide Water Pollution Prevention Program's construction BMP plan sheet to project plans and require contractor to implement the applicable BMPs on the plan sheet.
	V	Temporary erosion controls to stabilize all denuded areas until permanent erosion controls are established.
	Ø	Delineate with field markers the following areas: clearing limits, easements, setbacks, sensitive or critical areas, buffer zones, trees to be protected and retained, and drainage courses.

 - Provisions for temporary and/or permanent irrigation.
- ☐ ☑ Perform clearing and earth moving activities only during dry weather.
- ☐ ☑ Use sediment controls or filtration to remove sediment when dewatering and obtain all necessary permits.
- ☑
 Protect all storm drain inlets in vicinity of site using sediment controls (e.g., berns, socks, fiber rolls, or filters.)

 ☑
 Trap sediment on-site, using BMPs such as sediment basins or traps, earthen dikes or berms, silt fences, check dams, compost blankets or jute mats, covers for soil stock piles, etc.
- ☐ ☐ Divert on-site runoff around exposed areas; divert off-site runoff around the site (e.g., swales and dikes). ☐ ☑ Protect adjacent properties and undisturbed areas from construction impacts using vegetative buffer strips, sediment barriers or filters, dikes, mulching, or other measures as appropriate.
- ☐ ☑ Limit construction access routes and stabilize designated access points. □ ☑ No cleaning, fueling, or maintaining vehicles on-site, except in a designated area where washwater is contained and treated.
- □ ☑ Store, handle, and dispose of construction materials/wastes properly to prevent contact with stormwater.
- □ ☑ Contractor shall train and provide instruction to all employees/subcontractors re: construction BMPs.
 □ ☑ Control and prevent the discharge of all potential pollutants, including pavement cutting wastes, paints, concrete, petroleum products, chemicals, washwater or sediments, rinse water from architectural copper, and non-stormwater discharges to storm drains and watercourses.

ame of applicant completing the form:		
	3	

Stormwater Checklist for Small Projects

1/1/16 v.2

Signature:_	Margas	Date:	7/21/2020	
	/ "			


E. Comments (for municipal staff use only):

OTES (for municipal	aff use only):		
Section A Notes:			
Section B Notes:			

ATTACHMENT H

PLANTING LIST					
LATIN NAME	COMMON NAME	WATER USE	CLASSIFICATION		
BANKSIA VICTORIAE	WOOLY ORANGE BANKSIA	LOW	FLOWERING SHRUB		
GREVELLIA 'SUNSET BRONZE'	SUNSET BRONZE GREVILLEA	LOW	FLOWERING SHRUB		
LEUCOSPERMUM CORDIFOLIUM	PIN CUSHION PROTEA	LOW	FLOWERING SHRUB		
LEONITUS LEONURUS	LION'S TAIL	LOW	PERRENIAL HERB		
MELIANTHUS MAJOR 'ANTONOW'S BLUE'	ANTONOW'S BLUE HONEYBUSH	LOW	PERRENIAL HERB		

NOTE: LOW WATER USE CALIFORNIA NATIVE SPECIES PREFFERED FOR LANDSCAPING

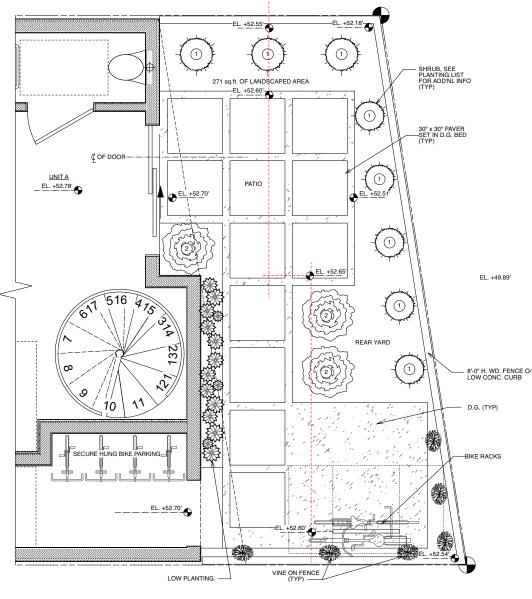








CALIFORNIA 9411 TEL 415 359 9997 FAX 415 359 9986 toparchitecture.com DRINTING BECORD

DATE	ACTION				
JUNE 3, 2020	PERMIT SUBMITTAL				
JULY 24, 2020	0702_NOI_DP-2-20 REVISION				
OCT. 15, 2020	DESIGN REVISION				
NOV. 10, 2020	DESIGN REVISION2 FNL. CMNTS				

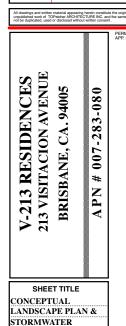

CHECKLIST

јов NO. 19.20 1/2"= 1'-0"



<sup>See Standard Industrial Classification (SIC) codes https://doi.org/10.10 Complete the C.3/C.6 Development Review Checklist if the project is not an individual single family home, and it creates and/or replaces 10,000 square feor or more of imperious surface, or if it is a restaurant, retail gasoline outlet, auto service facility, or parking lot project that creates and/or replaces 5,000 square feet or more of impervious surface.
See MRP Provision C.3.1.</sup>

See MRP Provision C.3.a.i.(6).

Inch Provision C.3.a.((7).

nonections to the sanitary sewer system is subject to sanitary district approval.
sesses that may have outdoor process activities/equipment include machine st

2



2 VISTACION AVENUE LOOKING SOUTH







1 VISTACION AVENUE VIEW



