ZONING ADMINISTRATOR AGENDA REPORT



Meeting Date: February 16, 2023

From: Julia Ayres, Senior Planner

Subject: 77 Golden Aster Ct.; 2022-MM-1; PD Planned Development; A minor modification to the Design Permit for the Northeast Ridge to allow landscaping and other minor alterations in the backyard, including construction of a covered patio increasing the site's lot coverage by

138 sq ft.; and finding the project to be exempt from CEQA per CEQA Guidelines Sections 15303(e) and 15304(b) and (c); Sanem Surel,

applicant; Raymond Liu & Lori Schnitzer Trust, owner.

REQUEST: The applicant requests approval of the above-referenced permit to allow improvements to the rear yard of the subject property, including a new covered patio that would increase lot coverage on the site by 138 sq ft..

RECOMMENDATION: Approve 2022-MM-1 2022-MM-1 per the staff memorandum with attachments, including the findings and conditions of approval.

ENVIRONMENTAL DETERMINATION: The project is categorically exempt from the provisions of the California Environmental Quality Act (CEQA) per Section 15303(e) and 15304(b) and (c) - this project falls within classes of projects which the State has determined not to have a significant effect on the environment. The exceptions to this categorical exemption referenced in Section 15300.2 of the CEQA Guidelines do not apply.

APPLICABLE CODE SECTIONS: Brisbane Municipal Code (BMC) §17.28.120, 17.42.070, and 17.56.090. Additionally, the Vesting Tentative Map Resolution VTM-1-03, for the planned development, Condition "f" provides that minor modifications may be approved by the Planning Director, who acts as the Zoning Administrator

ANALYSIS AND FINDINGS:

Project Description

The subject property is a downslope lot at the western end of the Golden Aster Ct. cul-de-sac and is just under 10,000 sq ft in size. The upper extent of the rear yard closest to the home features limited hardscape and pathways, while the majority of the rear yard is sloped and landscaped. The proposed project would expand the property's outdoor living space by eliminating approximately 200 sq ft of landscape area and adding 416 sq ft (net) in hardscape through a combination of paved patios and synthetic turf. The project requires 16 CY of fill to create level patio areas on the sloped rear yard. Condition of Approval 3 requires the applicant to obtain a grading permit from the City Engineer to allow the proposed grading before the building permit is issued. The filled areas would be retained by a concrete masonry block wall

2022-MM-1 Page **1** of **3**

2022-MM-1 2/16/2023 Meeting

finished with stucco, varying in height from 18" to 3' above grade and featuring a black metal guardrail 42" with white wood caps.

The proposed covered pergola, approximately 10' high, would create an additional 138 sq ft of lot coverage. The project would also improve existing covered space under the second floor balcony to provide bench seating (no increase in lot coverage).

The applicant's plans indicate a contemplated increase in landscape area under future permit. Condition of approval 2.b would require building permit to include plans compliant with BMC Ch. 15.70 should the 1,000 sq ft threshold of permanently irrigated replacement landscaping be triggered.

Findings

The findings required for issuance of a design permit are provided in BMC §17.42.040. A summary of how the proposal meets each applicable finding follows. A detailed analysis is provided in Attachment A.

A. The proposal's scale, form and proportion, are harmonious, and the materials and colors used complement the project.

The project is limited to exterior site improvements and would not alter the architectural style or scale of the home. The color palette is complementary to the existing painted (green) wood exterior of the home. The proposed pergola, the only new structure proposed, would be finished in exterior materials and paint color that match the existing home. Natural stone patio and pathway materials in shades of gray, brown, and gold, and smooth green stucco-finished landscaping walls.

The homeowners association has approved the proposed plans, as indicated on the attached letter.

B. The orientation and location of buildings, structures, open spaces and other features integrate well with each other and maintain a compatible relationship to adjacent development.

The site improvements would create useable outdoor living spaces that are compatible with adjacent development. The proposed patios would be setback more than seven feet from the adjacent property to the east at 75 Golden Aster Ct., and just under 10 feet from the rear yards of adjacent downslope properties at 26 and 28 Huckleberry Ct. As a comparison, patios and other on-grade flatwork in the R-1, R-2, and R-3 Residential districts in Central Brisbane may encroach anywhere within the setback area.

C. Proposed buildings and structures are designed and located to mitigate potential impacts to adjacent land uses.

2022-MM-1 2/16/2023 Meeting

As discussed above, the project is compatible with adjacent residential land uses to the east and south.

E. For hillside development, the proposal respects the topography of the site and is designed to minimize its visual impact. Significant public views of San Francisco Bay, the Brisbane Lagoon and San Bruno Mountain State and County Park are preserved.

The minor grading on the site does not change the overall topography of the site or site slope calculation, and the on-grade improvements and pergola, which would be well below the existing roofline of the home, will not alter public views of San Bruno Mountain State and County Park to the north and west.

G. The site provides open areas and landscaping to complement the buildings and structures. Landscaping is also used to separate and screen service and storage areas, break up expanses of paved area and define areas for usability and privacy. Landscaping is generally water conserving and is appropriate to the location. Attention is given to habitat protection and wildland fire hazard as appropriate.

The project would not impact the overall relationship and proportion between outdoor living areas, both landscaped and hardscaped, with the existing single-family home. Existing trees at the lower extent of the rear yard would remain and would assist in screening the expanded patio areas from neighboring homes below. There is no expansion of landscaping or hardscaping proposed beyond the property boundary and therefore no impact to adjacent conserved Habitat Conservation Plan habitat or established wildland fire buffer areas incorporated into the Northeast Ridge's built environment.

I. Consideration has been given to avoiding off-site glare from lighting and reflective building materials.

Proposed building materials consist of wood and stone, with no reflective elements. Any exterior lighting must be downlit and fully shielded per condition of approval 2.a.

ATTACHMENTS

- A. Draft findings and conditions of approval
- B. Aerial vicinity map
- C. Project data table
- D. HOA approval letter
- E. Applicant's plans

Julía Ayres, Senior Planner

2022-MM-1

77 Golden Aster Ct.

Action Taken: Conditionally approve 2022-MM-1 per the staff memorandum for the Zoning Administrator hearing of February 16, 2023 subject to the following findings and conditions of approval.

2022-MM-1 Findings of Approval:


- A. As no land use changes are proposed, the project is consistent with the general plan and governing Planned Development permit for the Northeast Ridge.
- B. The proposal's scale, form and proportion, are harmonious, and the materials and colors used complement the project. The project is limited to exterior site improvements and would not alter the architectural style or scale of the home. The color palette is complementary to the existing painted (green) wood exterior of the home. The proposed pergola, the only new structure proposed, would be finished in exterior materials and paint color that match the existing home. Natural stone patio and pathway materials in shades of gray, brown, and gold, and smooth green stucco-finished landscaping walls. The homeowners association has approved the proposed plans, as indicated on the attached letter.
- C. The orientation and location of buildings, structures, open spaces and other features integrate well with each other and maintain a compatible relationship to adjacent development. The proposed site improvements would create useable outdoor living spaces that are compatible with adjacent development. The proposed patios would be setback more than seven feet from the adjacent property to the east at 75 Golden Aster Ct., and just under 10 feet from the rear yards of adjacent downslope properties at 26 and 28 Huckleberry Ct. As a comparison, patios and other on-grade flatwork in the R-1, R-2, and R-3 Residential districts in Central Brisbane may encroach anywhere within the setback area.
- D. The proposed pergola and patio areas are designed and located to mitigate potential impacts to adjacent land uses through use of setbacks from the side and rear property lines, with further screening provided by existing trees to be retained on the site. These features ensure the project is compatible with adjacent residential land uses to the east and south, as described in more detail in Finding C.
- E. Because the project is limited to exterior site improvements and does not include any change in use or additions to the existing structure, this finding is inapplicable.
- F. The proposal respects the topography of the site and is designed to minimize its visual impact. The minor grading on the site does not change the overall topography of the site or site slope calculation, and the on-grade improvements and pergola, which would be well below the existing roofline of the home, will not alter public views of San Bruno Mountain State and County Park to the north and west.

- G. Because the project is limited to exterior landscaping and hardscaping improvements of the existing rear yard, there is no impact to adjacent streets, traffic, or circulation generally to the site or within the Northeast Ridge development.
- H. Because the project is limited to exterior landscaping and hardscaping improvements of the existing rear yard, there is no impact to site access.
- I. The site provides open areas and landscaping to complement the existing single-family dwelling. Landscaping is also used to define areas for usability and privacy. Existing trees at the lower extent of the rear yard would remain and would assist in screening the expanded patio areas from neighboring homes below. Per condition of approval 2.a, any future relandscaping must be water conserving and appropriate to the location. There is no expansion of landscaping or hardscaping proposed beyond the property boundary and therefore no impact to adjacent conserved Habitat Conservation Plan habitat or established wildland fire buffer areas incorporated into the Northeast Ridge's built environment.
- J. Because the project is limited to improvement of existing outdoor living areas in an established residential district, there is no impact to existing interior or exterior noise levels. Project construction shall conform to the noise limits and allowable days and times established in BMC Chapter 8.28.
- K. Consideration has been given to avoiding off-site glare from lighting and reflective building materials. Proposed building materials consist of wood and stone, with no reflective elements. Any exterior lighting must be downlit and fully shielded per condition of approval 2.a.
- L. New mechanical equipment is limited to the proposed hot tub, which is located in excess of 20 ft from adjacent property lines underneath the existing structure balcony, and will be screened at ground level as shown in the applicant's plans.
- M. There is no signage associated with this project and this finding is inapplicable.
- N. There are no employees on this residential property and this finding is inapplicable.

2022-MM-1 Conditions of Approval:

- 1. Homeowner's Association approval is required. Any substantive deviations from the plans approved in this application shall be accompanied by Homeowner's Association authorization submitted with the building permit.
- 2. A Building Permit shall be obtained from the City of Brisbane and shall address the following:
 - a. All exterior lighting shall be downlit and fully shielded to prevent off-site light trespass and glare.
 - b. Any relandscaping involving 1,000 sq f or more of permanently irrigated landscape area shall comply with BMC Chapter 15.70 for water conservation in landscaping. Plans submitted with the building permit shall demonstrate compliance with BMC Chapter 15.70.

- c. Illustrations, cut sheets and/or materials samples will be required by the Community Development Director, at his discretion.
- 3. A Grading permit shall be obtained from the City Engineer prior to building permit issuance.
- 4. This Minor Modification shall expire two years from its effective date (at the end of the appeal period) if a Building Permit has not been issued for the approved project or if the Building Permit, once issued, is allowed to expire prior to final inspection.
- 5. Minor modifications may be approved by the Community Development Director in conformance will all requirements of the Municipal Code.

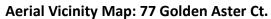



Project Data

Development Standard	Existing	Proposed	
Lot Size	9,945 sq ft	n/a	
Lot Coverage		(138 sq ft increase)	
Floor Area Ratio	4,359 sq ft/0.44 FAR	n/c	
Setbacks	-	Covered patio:	
		Rear: 23'	
		Side: 18'	
Height	-	Covered patio: 10'	

LANDMARK AT THE RIDGE OWNER'S ASSOCIATION

October 14, 2020

Lori and Raymond Liu 77 Golden Aster Brisbane, CA 94005

Re: Backyard Landscaping

Dear Homeowner:

The Landmark at the Ridge Owner's Association Board of Directors has reviewed a set of plans submitted by you for the following improvement at your home:

Backyard Landscaping.

Based on the plans submitted and other information, the above improvement was **approved** by this association. This approval is contingent on the following additional conditions:

- Any required city approvals and permits will be obtained in advance of construction and;
- A licensed and insured contractor will perform the work.
- Plants must be in the City approved plant list.

Please submit a copy of this letter with any application you submit to the city. If you have any questions about this action, please contact me at 650-637-1616 ext. 502 or by email at prallonza@manorinc.com.

Regards,

Paul Rallonza, CCAM Community Association Manager The Manor Association

cc: The Landmark at the Ridge Owner's Association Board of Directors
Unit file

PROJECT INFORMATION



CLIENT NAME: LIU RESIDENCE

ADDRESS: 77 GOLDEN ASTER CT, BRISBANE, CA 94005

COVERAGE CALCULATION:

AREA	LANDSCAPE	HARDSCAPE	
EXISTING TO BE REMOVED	1479 sqf 210 sqf	566 sqf 499 sqf	
TOTAL	10 sqf 	915 sqf 982 sqf	

GENERAL NOTES

- THESE DRAWINGS ARE FOR INFORMATION ONLY. THE LANDSCAPE CONTRACTOR SHALL CHECK AND VERIFY ALL DIMENSIONS AND EXISTING CONDITIONS, INCLUDING STRUCTURES, SURFACE AND SUBSURFACE UTILITIES, PAVEMENT, AND LANDSCAPING AT SITE PRIOR TO COMMENCEMENT OF WORK, ANY DISCREPANCIES IN DRAWINGS SHALL BE BROUGHT TO THE ATTENTION OF THE OWNER. NO WORK SHALL PROCEED UNTIL A RESOLUTION HAS BEEN AGREED UPON TO THE SATISFACTION OF THE OWNER
- 2. IT IS THE RESPONSIBILITY OF THE LANDSCAPE CONTRACTOR AND THE SUBCONTRACTORS TO REVIEW ALL DRAWINGS, PROJECT MANUAL, ADDENDA, ETC. IN ORDER TO ENSURE THE COORDINATION OF ALL WORK AFFECTING EACH TRADE. FAILURE TO REVIEW AND COORDINATE ALL CONTRACT DOCUMENTS BY THE LANDSCAPE CONTRACTOR WITH ALL THE SUBCONTRACTORS FOR APPLICABLE ITEMS OF THE WORK SHALL NOT RELIEVE THE RESPONSIBLE PARTY FROM PERFORMING ALL THE WORK AS REQUIRED AS PART OF THE
- 3. THE LANDSCAPE CONTRACTOR AND ALL SUBCONTRACTORS SHALL VISIT THE SITE TO FAMILIARIZE THEMSELVES WITH THE EXISTING CONDITIONS AND THE IMPACT OF THE PROPOSED NEW WORK INDICATED ON THE DRAWINGS FOR THESE CONDITIONS. ANY QUESTIONS REGARDING THE COORDINATION OF NEW WORK OR EXISTING CONDITIONS MUST BE SUBMITTED TO THE OWNER'S REPRESENTATIVE IN WRITING PRIOR TO COMMENCEMENT OF WORK.
- THE LANDSCAPE CONTRACTOR SHALL, PRIOR TO THE START OF CONSTRUCTION, VERIFY ALL EXISTING CONDITIONS, PROVIDE A COMPLETE FIELD LAYOUT ON THE JOB SITE AND NOTIFY THE OWNER'S REPRESENTATIVE OF ANY DEVIATIONS OR CONFLICTS WITH THESE DRAWINGS
- 5. THE DRAWINGS SHALL NOT BE SCALED. THE LANDSCAPE CONTRACTOR SHALL REFER TO THE DIMENSIONS INDICATED OR THE ACTUAL SIZE OF THE CONSTRUCTION ITEMS. WHERE NO DIMENSION OR METHOD OF DETERMINING A LOCATION IS GIVEN. VERIFY THE CORRECT DIMENSION OR LOCATION WITH THE OWNER PRIOR TO INSTALLATION.
- 6. THE DRAWINGS AND REFERENCED DETAILS HAVE BEEN DIMENSIONED IN ORDER TO ESTABLISH THE CONTROL AND GUIDELINES FOR FIELD LAYOUT. WHERE DISCREPANCY EXISTS BETWEEN THE DRAWING AND THE DETAIL THE LANDSCAPE CONTRACTOR SHALL NOTIFY THE OWNER PRIOR TO INSTALLATION.
- WHERE DIMENSIONS ARE NOTED TO BE VERIFIED IN FIELD (V.I.F.) THE DIMENSION SHOWN IS THE DESIGN BASIS BUT MAY DIFFER FROM ACTUAL CONDITIONS. THE LANDSCAPE CONTRACTOR SHALL VERIFY THESE DIMENSIONS WHILE LAYING OUT THE WORK AND REPORT ANY DISCREPANCIES BETWEEN THE DESIGN BASIS AND ACTUAL DIMENSIONS TO THE OWNER PRIOR TO PROCEEDING WITH THE WORK. WHERE DIMENSIONS ARE NOTED +/- FIELD DIMENSIONS MAY VARY FROM THE NOTED DIMENSIONS BY MINOR AMOUNTS.
- 8. ALL WORK AND MATERIALS SHALL BE IN FULL ACCORDANCE WITH ALL APPLICABLE FEDERAL, STATE, AND LOCAL LAWS OR REGULATIONS, AND WITH CURRENT ACCEPTED INDUSTRY CODES, STANDARDS, AND PRACTICES. NOTHING IN THESE DRAWINGS SHALL BE CONSTRUED TO PERMIT WORK NOT CONFORMING TO ANY LAWS, REGULATIONS, CODES, STANDARDS, OR PRACTICES.
- 9. ALL 'OR EQUAL' SUBSTITUTIONS MUST BE SUBMITTED TO AND APPROVED BY THE BUILDING OFFICIAL PRIOR TO INSTALLATION OF THE ITEM.



DESIGN + BUILD

535 MISSION ST. SAN FRANCISCO, CA 94105

PROJECT TEAM

SHEET INDEX:

L 1.01 SITE IMAGES | BEFORE

L 2.02 SITE IMAGES | AFTER L 3.00 ELEVATIONS L'3.01 ELEVATIONS

L 1.00 EXISTING CONDITION & DEMOLITION PLAN

L 4.00 PROPOSED COVER PATIO | SET BACK L 4.01 PROPOSED COVER PATIO | LAYOUT L 4.02 PROPOSED COVER PATIO | ELEVATIONS L 5.00 PROPOSED GUARDRAIL | LAYOUT L 5.01 PROPOSED GUARDRAIL | ELEVATIONS

LANDSCAPE:

2 L 0.00 COVER PAGE

L 2.00 SITE PLAN L 2.00 SITE FLAN L 2.01 MATERIAL SCHEDULE

> LANDSCAPE DESIGNER: TOOLBOX DESIGN LLC. 650 CALIFORNIA ST. #05-119 SAN FRANCISCO, CA 94108 CONTACT: SANÉM SUREL (415)676-8107

STRUCTURAL ENGINEER: STRUCTICA, INC. 530 ALAMEDA EL PRADO #183C NOVATO, CA 94949 CONTACT: BABAK MAMAGHANI (415)578-0707

OWNER: RAYMOND & LORI LIU 77 GOLDEN ASTER CT. BRISBANE, CA 94005 CONTACT: RAYMOND LIU

2 STRUCTURAL V

S 1.00 NOTES

S 2.00 PLANS S 3.00 DETAILS

(415)696-6928

ABBREVIATIONS

A B C C C C C C C C C C C C C C C C C C	:G :J	AREA DRAIN APPROXIMATELY BOTTOM OF WALL CAST IN PLACE CENTERLINE CONTROL JOINT CONCRETE CONTINUOUS CENTER DIMENSION DIAMETER DIMENSION DRAWING EXISTING EXISTING EXISTING EXISTING EXISTING EXISTING EXPANSION JOINT	PA PT R REF RET REV R-O-W SAD SCD SF SHT SH	PLANTING AREA PRESSURE TREAT RADIUS REFERENCE RETAINING REVISION RIGHT OF WAY SEE ARCHITECTU SEE CIVIL DWG SOUARE FEET SHEET STEEL HEADER	-	SPD SSD STAG SIM SPEC SQ TC TC TOC TW TYP UON	SEE POOL DWG SEE STRUCTURAL DWG STAGGERED SIMILAR SPECIFICATION SQUARE TOP OF CURB TOP OF CURB TOP OF WALL TYPICAL UNLESS OTHERWISE NOTED
E	ELEC EMBED EQ	ELEVATION ELECTRICAL EMBEDMENT EQUAL		•	ALIGN		
E F	EXP FE G	EXPANSION FINISH FLOOR ELEVATION FINISH GRADE	 1-		BREAKLINE		
F G	IN SLM SR	FINISH GLUED LAMINATED BEAM GRADE			CENTERLINE		
Н	IC IP	HANDICAP ACCESSIBLE HIGH POINT INSIDE DIAMETER	+		CENTER POINT OF	RADIUS	
IN L	N P	INCH LOW PIONT LIMIT OF WORK			LIMIT OF WORK		
N	MAX MIN	MAXIMUM MINIMUM NEW	5'	32 ROS MEI O.C. 15 GAL	PLANT CALLOUT		
N N	I.I.C. ITS D.C.	NOT IN CONTRACT NOT TO SCALE ON CENTER	⊕ P.	O.B.	POINT OF BEGINN	ING	
Ċ	DD DPP	OUTSIDE DIAMETER OPPOSITE			DRAWING NUMBE SHEET NUMBER	R	


ANDSCAPE IMPROVEMENT PROJECT \exists PROJECT: 1

DATE: 09/15/2022 1 REV 03 | DATE : 04/15/2022 2 REV 04 I DATE: 09.15.2022

APPROVAL

CP



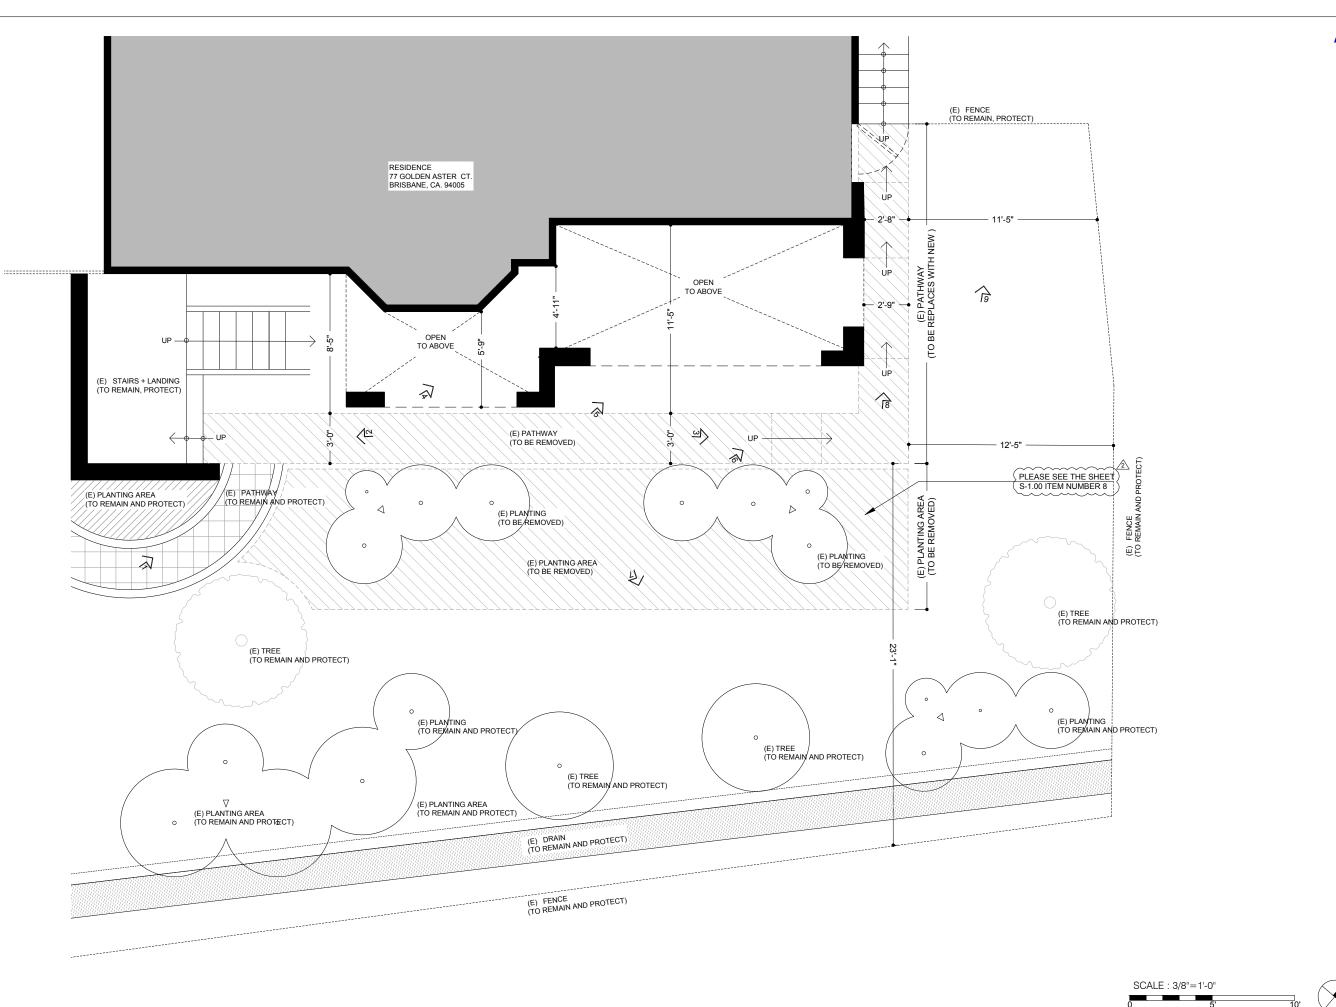



DESIGN + BUILD

535 MISSION ST, SAN FRANCISCO, CA 94105


LANDSCAPE IMPROVEMENT PROJECT

ISSUED

DATE: 12.28.2022

REV 01 | DATE: 09.22.2021

REV 02 | DATE: 02.23.2022

REV 03 | DATE: 04.15.2022

REV 04 | DATE: 09.15.2022

PROJECT: LIU RESIDENCE

3/8"=1'- 0"

DUAGE

APPROVAL

SHEET TITLE :

EXISTING
CONDITIONS
& DEMOLITION
PLAN

SHEET NO:

L1.00

/A HASE ·

APPROVAL

SHEET TITLE :

SITE PICTURES I BEFORE

SHEET N

L1.01

7 EXISTING FENCE & GATE AT SIDE YARD I TO REMAIN & PROTECT IN PLACE



8 EXISTING CONCRETE STEP & ENTRY I REMOVED & REPLACED



7 EXISTING PLANTING AREA I TO REMAIN & PROTECT IN PLACE



6 PROPOSED COVER PATIO LOCATION & PATHWAY



5 PROPOSED COVER PATIO LOCATION



4 PROPOSED HOT-TUB & SPA DECK LOCATION




3 EXISTING CONCRETE PATHWAY I REMOVED & REPLACED



2 EXISTING DECK ENTRY I TO REMAIN & PROTECT IN PLACE



1 EXISTING PATHWAY & PLANTING AREA I TO REMAIN & PROTECT IN PLACE

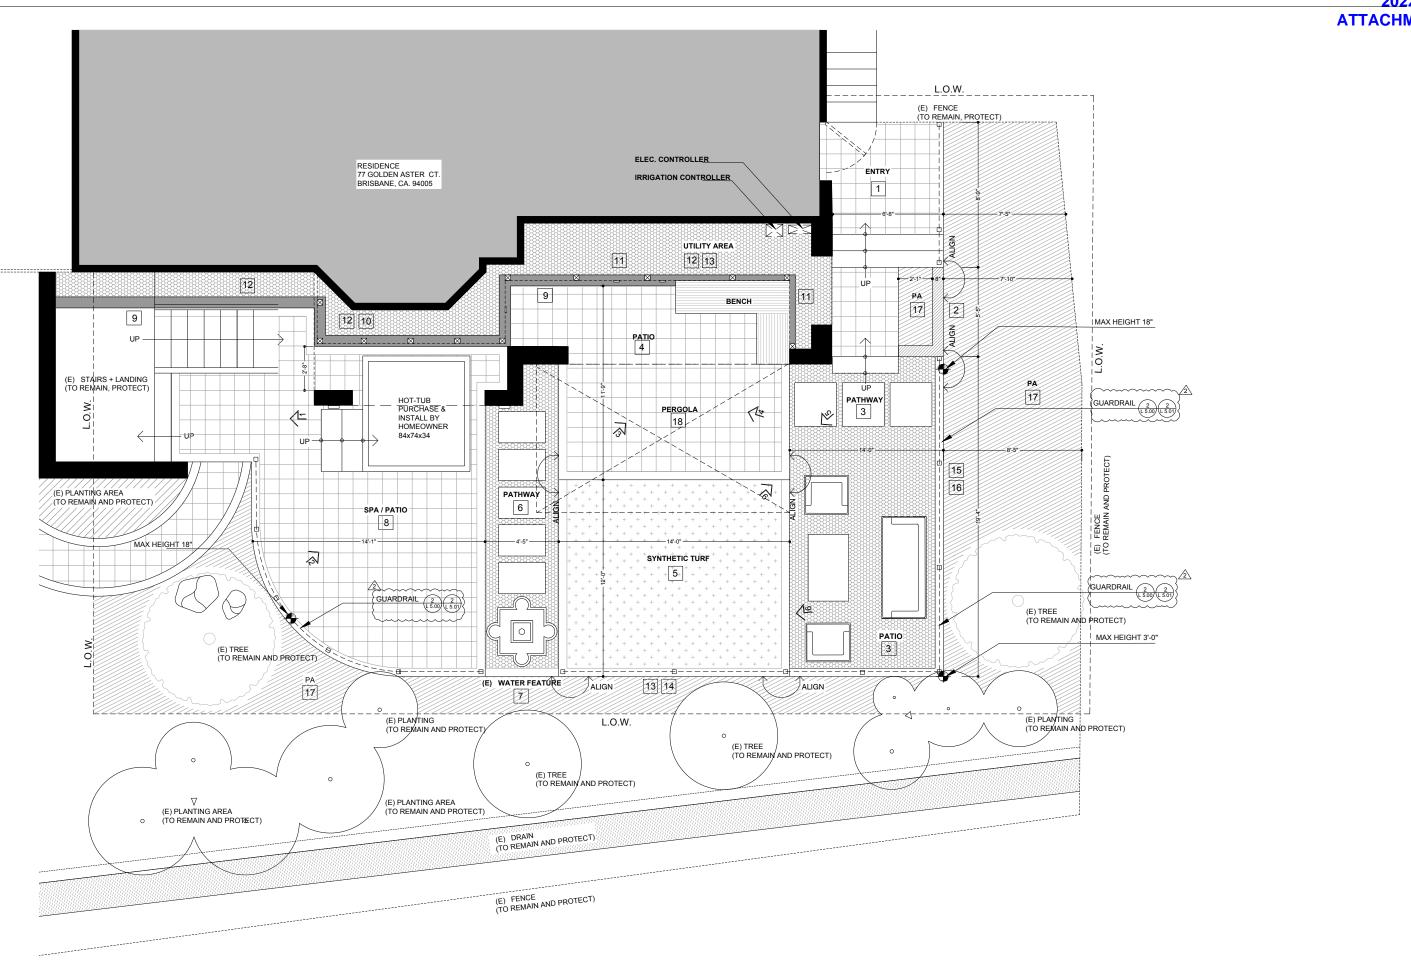



DESIGN+BUILD

535 MISSION ST, SAN FRANCISCO, CA 94105





C. COR ALL COSTS AND DAMAGES INCURRED BY USE OF FREE.

LANDSCAPE IMPROVEMENT PROJECT

DUACE.

APPROVAL

SHEET TITLE :

SITE PLAN

SHEET NO:

SCALE: 3/8"=1'-0"

L2.00

© COPYRIGHT TOOLBOX DESIGN LLC. 2021

AATERIAL CO	LIEDLILE					
IATERIAL SC	HEDULE					
NUMBER	SYMBOL	DESCRIPTION	MATERIAL	SIZE	COLOR FINISH	NOTE
1		ENTRY	MATERIAL I PAVERS : BELGARD CATALINA, PATERN : (3) PIECES	LARGE	COLOR VICTORIAN , FINISH: SMOOTH FACE	
			MATERIAL I BORDER: BELGARD CATALINA	6X9	COLOR VICTORIAN , FINISH: SMOOTH FACE	*
2		RAISED PLANTER @ ENTRY	MATERIAL I WALL : CMU WALL W/ STUCCO	L SHAPE 2'-0" X 5'-0"	COLOR: GRAY, FINISH: STUCCO	
			WALL CAP: NATURAL STONE, COPPING	12X6	COLOR CALIFORNIA GOLD	
3	man man	PATIO & PATHWAY	MATERIAL I CONCRETE : CONCRETE SLABS	4" THK	COLOR NO COLOR , FINISH : BROOM FINISH	NOTE: AS SHOWN AT L 1.00 SITE PLAN
			MATERIAL I DECORATIVE ROCKS: LODI PEBBLES	3/8*	COLOR VARIES, GRAY/BROWN	
4		COVER PATIO	MATERIAL I PAVERS ; BELGARD CATALINA, PATERN ; (3) PIECES	MATERIAL I BORDER : BEL	.G/ COLOR VICTORIAN , FINISH: SMOOTH FACE	-
			MATERIAL I BORDER : BELGARD CATALINA	6X9	COLOR VICTORIAN , FINISH: SMOOTH FACE	
5	3	SYNTHETIC TURF	MATERIAL I SYNTHETIC TURF BLUE GRASS LIGHT WITH 5 INCH I 40DD NAILS & 16 GRITSILICA SAND I 48 OZ FACE WEIGHT	AS SHOWN	H ₁	NOTE: NO RETURNS ON CUT ARTIFICIAL GRASS (NON-REFUNDABLE)
			MATERIAL I BORDER: METAL EDGING	6 H	COLOR BLACK	•
6		PATHWAY @ WATER FEATURE	MATERIAL I NATURAL STONE , SLABS	3-0° L × 2-0° W	COLOR: CALIFORNIA GOLD	NOTE : AS SHOWN AT L 1.00 SITE PLAN
			MATERIAL I DECORATIVE ROCKS: LODI PEBBLES	3/8*	COLOR VARIES , GRAY/BROWN	
7		EXISTING WATER FEATURE				-
8		SPA PATIO	MATERIAL I PAVERS : BELGARD CATALINA, PATERN : (3) PIECES	LARGE	COLOR VICTORIAN , FINISH: SMOOTH FACE	NOTE : AS SHOWN AT L 1.00 SITE PLAN
			MATERIAL I BORDER: BELGARD CATALINA	6X9	COLOR VICTORIAN , FINISH: SMOOTH FACE	*
9		CURB WALL	MATERIAL I WALL : CMU WALL W/ STUCCO	16 H	COLOR GREEN , FINISH STUCCO	~
10		WOODEN SCREEN @ SPA	MATERIAL: 1X6 REDWOOD DECKING		FINISH: STAIN ONLY, COLOR: GREEN	*
11		WOODEN SCREEN @ COVER PATIO	MATERIAL : 1X6 REDWOOD DECKING		COLOR WHITE	*
12		DECORATIVE ROCKS @ UTILITY AREA	MATERIAL I DECORATIVE ROCKS: LODI PEBBLES	3/8*	COLOR VARIES, GRAY/BROWN	z.
13		UTILITY AREA	MATERIAL I DECORATIVE ROCKS: LODI PEBBLES	3/8*	COLOR VARIES, GRAY/BROWN	
14		SEAT BENCH @ COVER PATIO	MATERIAL : 1X6 REDWOOD DECKING WITH 1X6 FRAMING ALL (4) SIDES	18° H	FINISH: STAIN ONLY, COLOR CLEAR	8
15		RETAINING WALL	MATERIAL I WALL : CMU WALL W/ STUCCO	VARIOUS 18"-3"-0"H	COLOR GRAY , FINISH STUCCO	
2 (~~~~~	~~~~~~~~~~~~~~~~~~~~~~~~~~~~~~~~~~~~~~~		~~~~		
16		GUARDRAIL	MATERIAL: METAL FRAMING WITH WOOD CAP	OVERALL 42" H	COLOR BLACK	*
}		CAP	MATERIAL: WHITE WOOD WALNUT	2.5°X1.5°	3	
				~~~~		
17		FUTURE PLANTING AREA	•			-
2 ~		~~~~	~~~~~~~~~~~~~~~~~~~~~~~~~~~~~~~~~~~~~~~	·····	· · · · · · · · · · · · · · · · · · ·	
18	$\rightarrow$	PERGOLA	MATERIAL : PLEASE SEE STRUCTURAL DRWINGS S-2.0 LAYOUT & S-3.0 DETAILS		COLOR MATCHE WITH THE EXISITING HOUSE FACADE	PLEASE SEE SHEET STRUCTURAL DRAWING SHEETS S-2.0 & S-3.0
<del>\</del> .						



# DESIGN + BUILD

LANDSCAPE IMPROVEMENT PROJECT

DATE :	12.28.2022
REV 01 I DATE :	09.22.2021
REV 02 I DATE :	02.23.2022
REV 03 I DATE :	04.15.2022
REV 04 I DATE :	09.15.2022
SCALE:	

# APPROVAL

# MATERIAL SCHEDULE





DESIGN+BUILD

# LANDSCAPE IMPROVEMENT PROJECT

LOCATION: 77 GOLDEN ASTER COURT, BRISBANE CA 94005

**APPROVAL** 

SITE PICTURE I **AFTER** 

1 **L2.02** 




4 PROPOSED COVERED PATIO LOCATION WITH BENCH



3 PROPOSED COVERED PATIO LOCATION WITH BENCH



PROPOSED SPA PATIO & WOOD SCREEN & PATHWAY

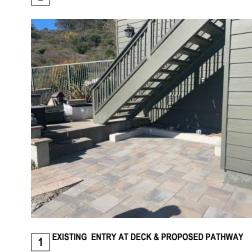




6 RAISED PLANTER & STAIRS & LANDING AT SIDE YARD



PROPOSED SYNTHETIC TURF & PROPOSED PATIO

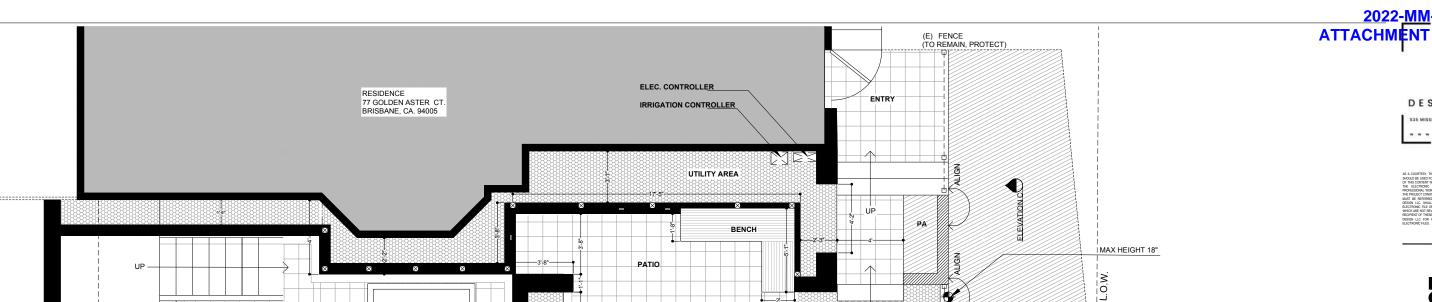

SYNTHETIC TURF

PATHWAY

PATIO

ALIGN

E E

(E) TREE (TO REMAIN AND PROTECT)

(E) PLANTING (TO REMAIN AND PROTECT)

GUARDRAIL 2 2 1.5.00 1.5.01

MAX HEIGHT 3'-0"




LANDSCAPE IMPROVEMENT PROJECT

**APPROVAL** 

**ELEVATIONS** 

L3.00

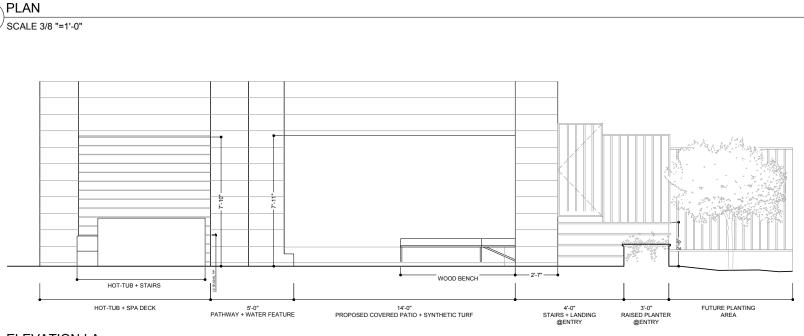

(E) PLANTING (TO REMAIN AND PROTECT)

HOT-TUB PURCHASE & INSTALL BY

HOMEOWNER 84x74x34

SPA / PATIO

PATHWAY

ELEVATION A

(E) WATER FEATURE

ALIGN

L.O.W.

UP -

(E) TREE (TO REMAIN AND PROTECT)

(E) STAIRS + LANDING (TO REMAIN, PROTECT)

(E) PLANTING AREA (TO REMAIN AND PROTECT)



DESIGN + BUILD

535 MISSION ST, SAN FRANCISCO, CA 94105


LANDSCAPE IMPROVEMENT PROJECT

PROJECT : LIU RESIDENCE

SUED : 12.28.2

DATE : 12.28.2

REV 01 | DATE : 09.22.2

SCALE :


AS SHOWN

APPROVAL


SHEET TITLE :


**ELEVATIONS** 


L3.01

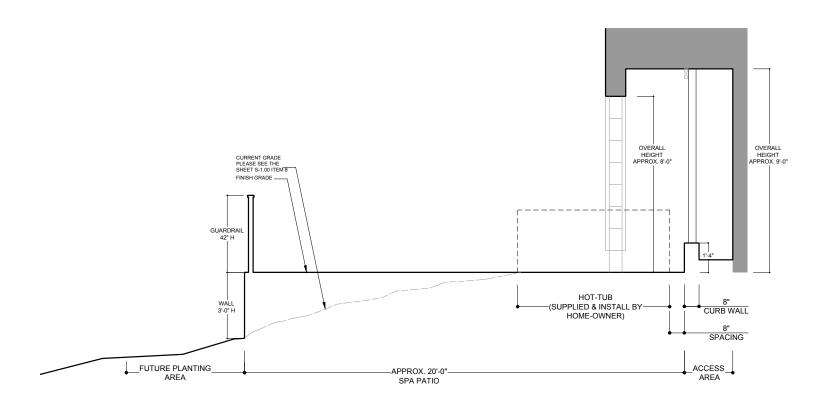

ELEVATION I B
SCALE 1/2 "=1'-0"

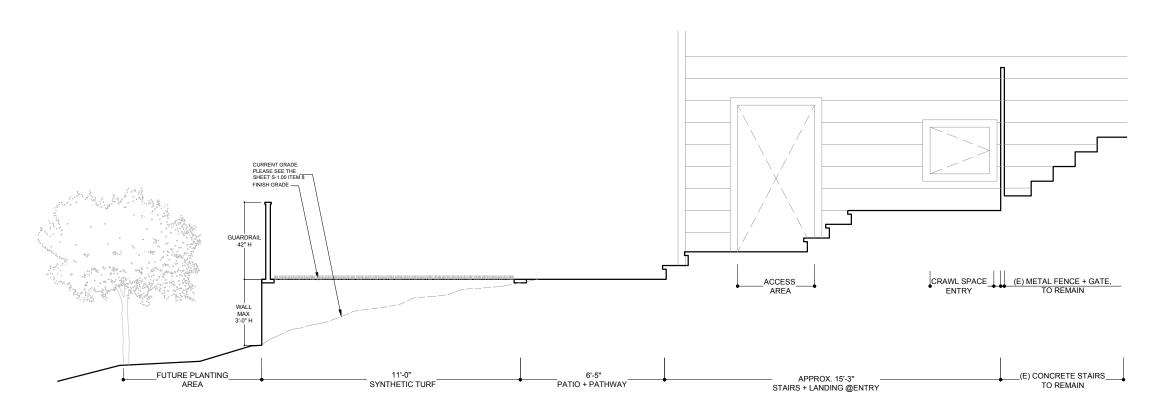

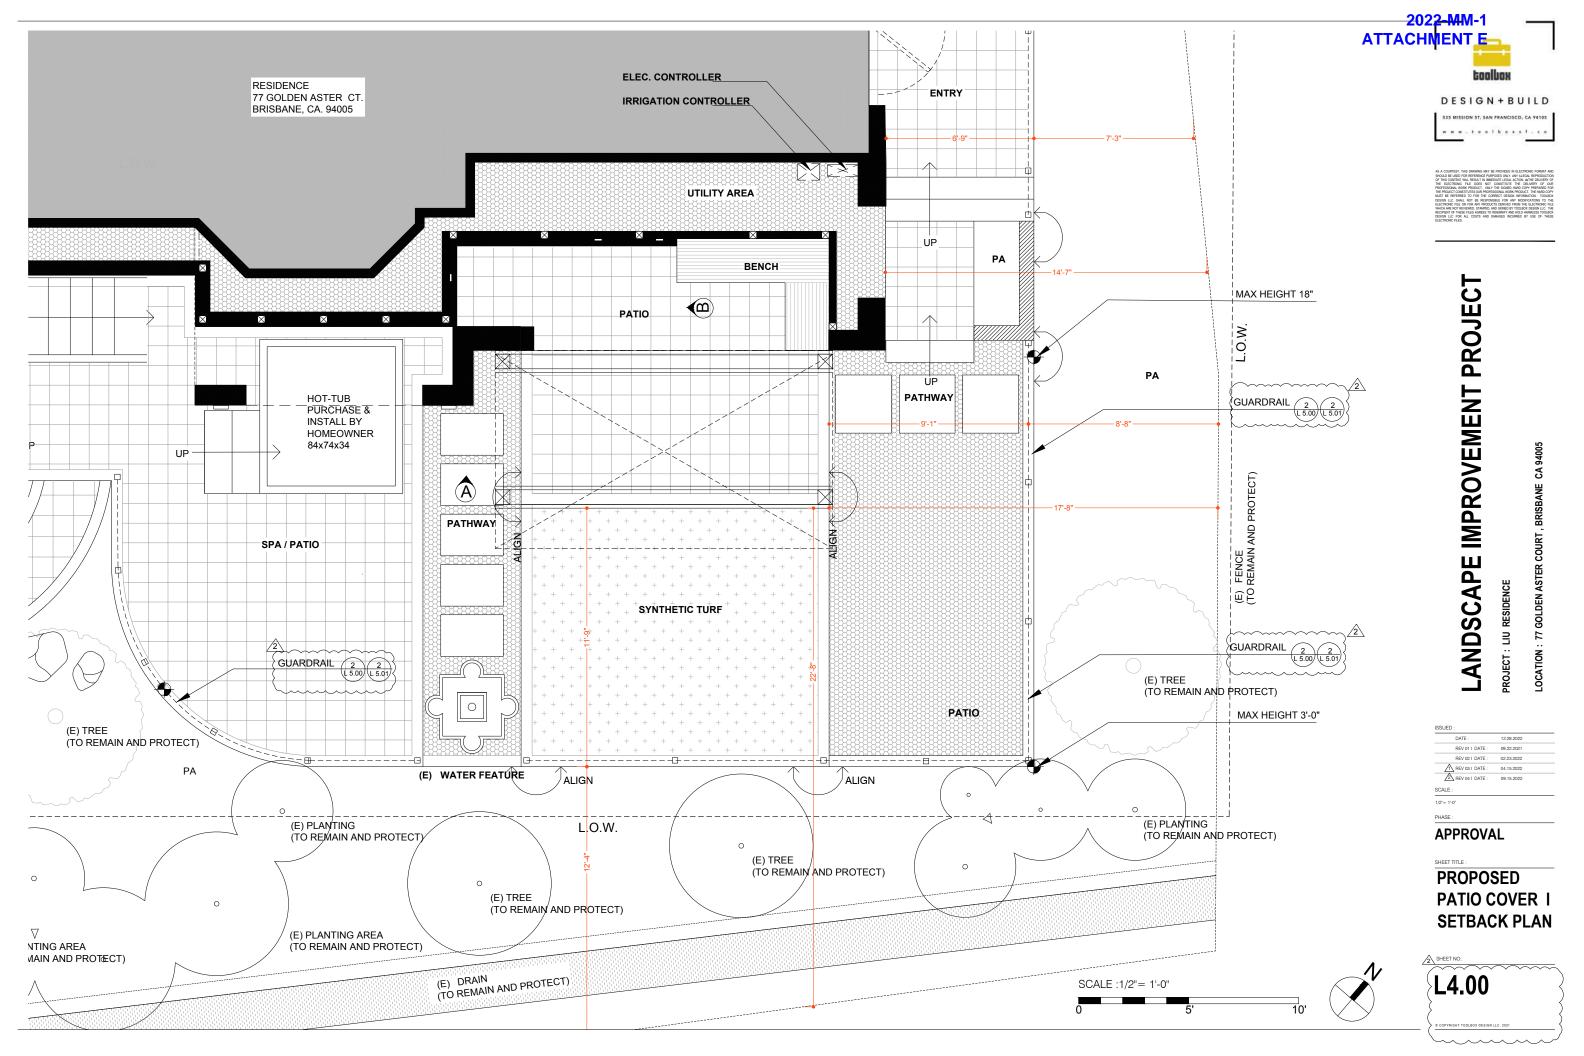

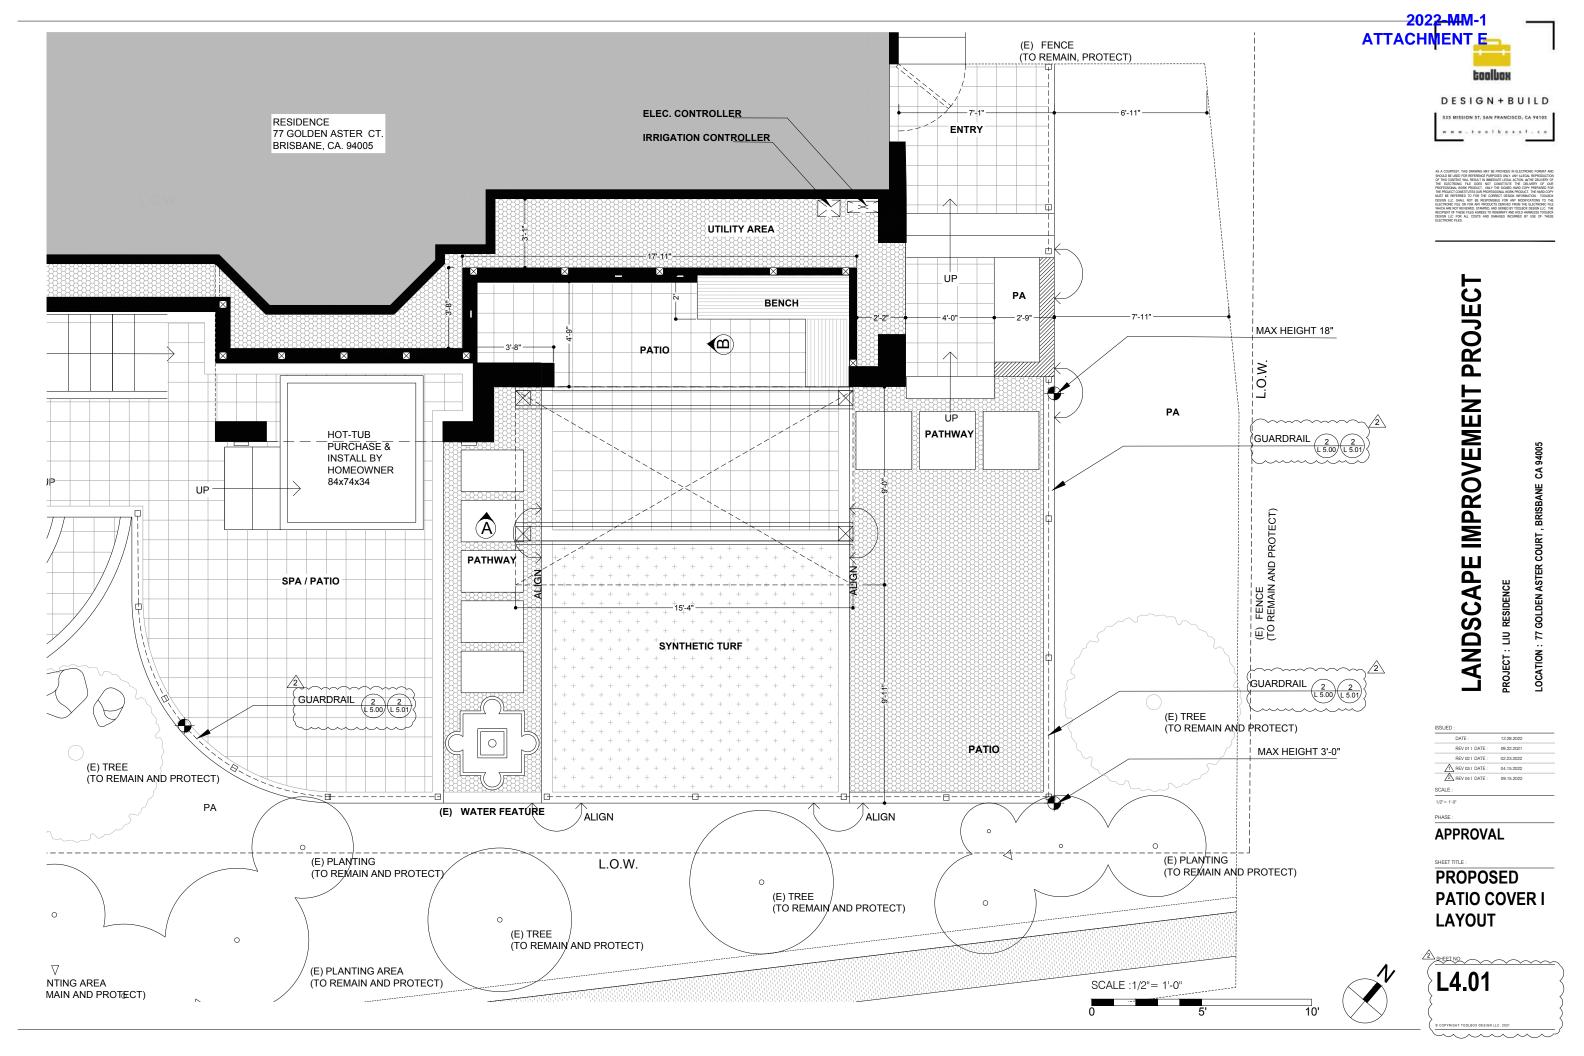



DESIGN + BUILD

535 MISSION ST, SAN FRANCISCO, CA 94105

LANDSCAPE IMPROVEMENT PROJECT PROJECT: LIU RESIDENCE

DATE: 12.28.2022

REV 01 | DATE: 09.22.2021

REV 02 | DATE: 02.23.2022

AREV 03 | DATE: 04.15.2022

REV 04 | DATE: 09.15.2022

**APPROVAL** 


SHEET TITLE :

**PROPOSED** PATIO COVER I **ELEVATIONS** 

L4.02

EDGE NNAIL PYWOOD WITH 8D NAILS @6" O.C. (12" O.C. ELSEWHERE) SIMPSON OR EQUAL POST CAPS OR "T" STRAPS EACH SIDE W/ ½ " DIA. THRU BOLTS TYP. 4X4 POST MIN. SLOPE - FINISH GRADE PAVER PATIO SLOPE %2 FUTURE PLANTING -PATIO + SYNTHETIC TURF @PAVER PATIO

SIDE ELEVATION SCALE 1/2 "=1'-0"

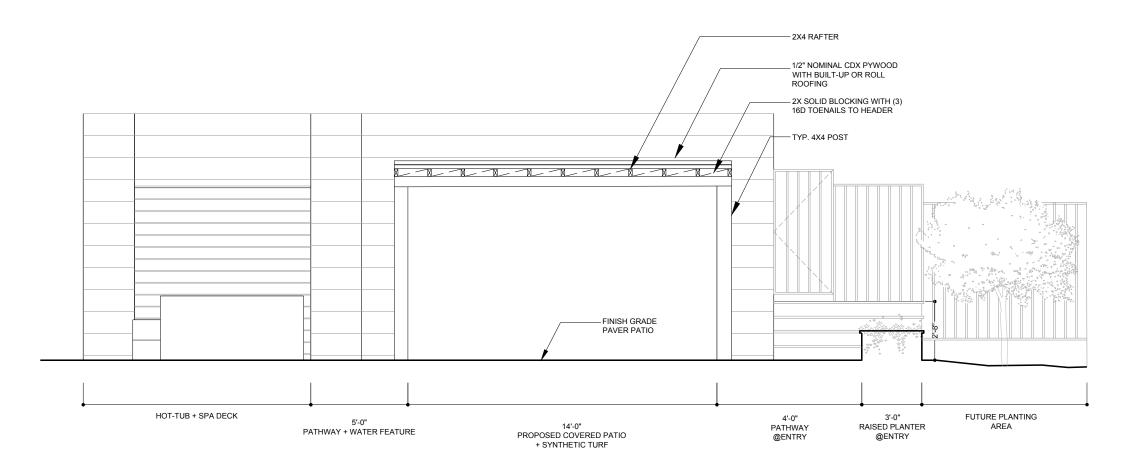

FRONT ELEVATION SCALE 1/2 "=1'-0"



\$35 MISSION ST, SAN FRANCISCO, CA 94105


# LANDSCAPE IMPROVEMENT PROJECT

roject: Liu residence

ISSUED :

DATE: 12 28 2022

REV011 DATE: 09 22 2021

REV 021 DATE: 02 23 2022

⚠ REV 031 DATE: 04.15 2022

⚠ REV 041 DATE: 09.15 2022

3/8"=1"-0"


3/8"=1"-0"

APPROVAL

SHEET TITLE :

PROPOSED GUARDRAIL I LAYOUT

L5.00

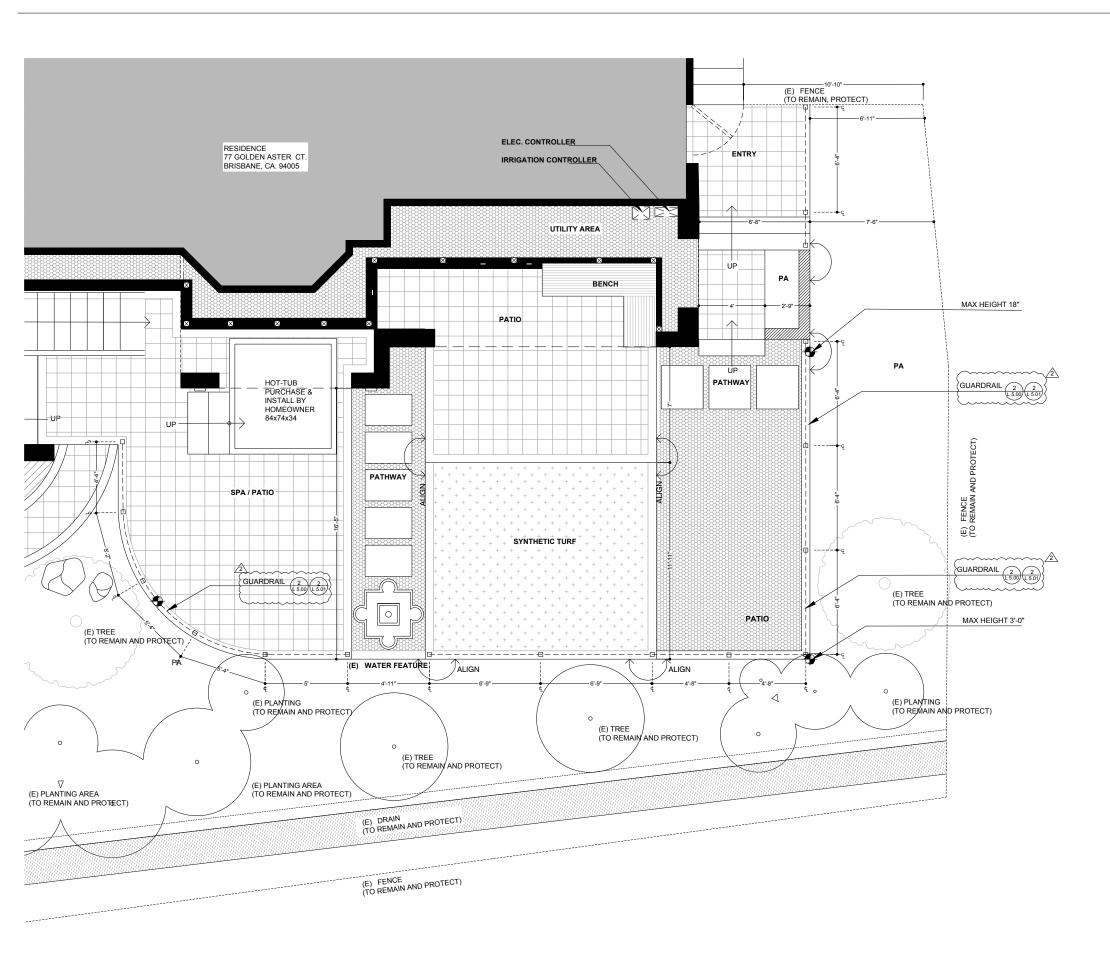





2 CASE STUDY

1 KEY PLAN
SCALE 3/8 "=1'-0"



# LANDSCAPE IMPROVEMENT PROJECT

ISSUE	D:		
	DATE :	12.28.2022	
	REV 01 I DATE :	09.22.2021	
	REV 02 I DATE :	02.23.2022	
	REV 03   DATE :	04.15.2022	
	REV 04 I DATE :	09.15.2022	

APPROVAL


**PROPOSED GUARDRAIL I ELEVATIONS** 

L5.01



ELEVATION I SIDE

SCALE 1/2 "=1'-0"

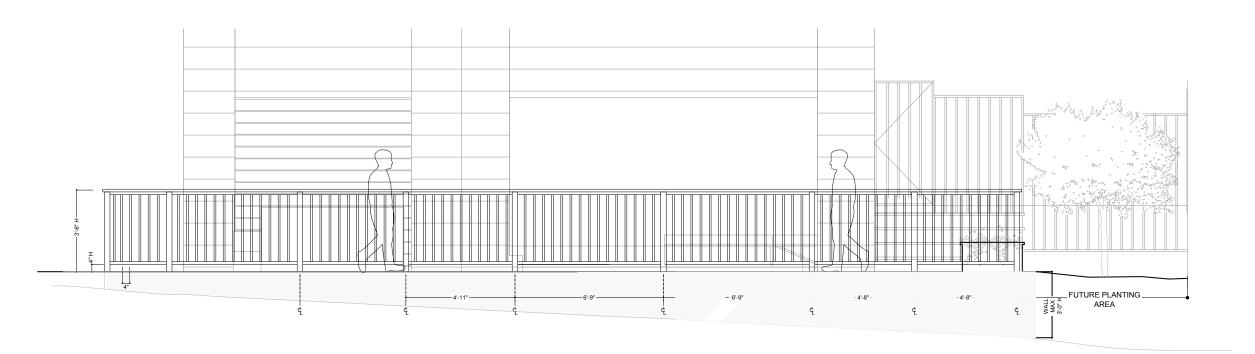

ELEVATION I FRONT SCALE 1/2 "=1'-0"

ADDRESS: 77 GOLDEN ASTER CT., BRISBANE, CA

APN: 005-401-010

SCOPE OF WORK: CONSTRUCTION OF A NEW ENCLOSED PERGOLA

NUMBER OF UNITS: 1

OCCUPANCY CLASSIFICATION: R-3

JOB NO.: 2249/P2275

SHEET INDEX:

S-0.0 **COVER SHEET** NOTES S-1.0 **PLANS** S-2.0 S-3.0 **DETAILS** 

• APPLICABLE CODES:

1. 2019 CALIFORNIA RESIDENTIAL CODE

2. NDS FOR WOOD CONSTRUCTION, 2018 EDITION

3. ASCE 7-16

4. ACI 318-19

• DESIGN DOCUMENTS:

1. LANDSCAPING DRAWINGS PREPARED BY TOOLBOX DATED APRIL 15, 2022.

• ABBREVIATIONS:

BO: **BOTTOM OF** BOW: **BOTTOM OF WALL** 

E: **EXISTING** EG: **EXISTING GRADE** 

EL: **ELEVATION** EMBED: **EMBEDMENT** 

EQ: **EQUAL** 

FG: FINISH GRADE GLB: GLUED LAMINATED BEAM

MAX: MAXIMUM

N: NEW

NTS: NOT TO SCALE

OC: ON CENTER

PT: PRESSURE TREATED

SIM.: SIMILAR SQ: **SQUARE** STAG: STAGGERED


TOP OF TO: TOC: TOP OF CONCRETE

TWO: TOP OF WALL TYP: **TYPICAL** 

UNLESS NOTED OTHERWISE UNO:



# PROJECT VICINITY:

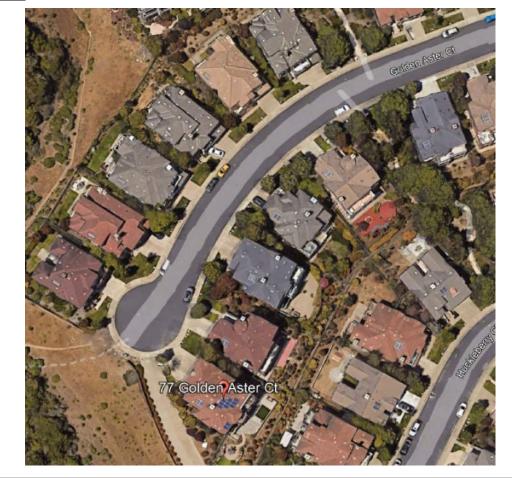

DRAWING TI			SCOPE OF V		
77 GLODEN ASTER CT	BRISBANE, CA	000 404 040	010-104-600		RAYMOND AND LORI LIU
PROJECT ADDRESS:		APN:		OWNER:	
		SIONS			
NO	DESC	RIPTI	ON	D	ATE
H					
H					

PERGOLA

2022-MM-1

S-0.0

CHECKED

REVIEW SET

- 1. ALL CONSTRUCTION SHALL CONFORM TO THE MOST RECENT EDITIONS OF CALIFORNIA BUILDING CODE, INTERNATIONAL RESIDENTIAL CODE FOR ONE- AND TWO-FAMILY DWELLINGS, WOOD FRAME CONSTRUCTION MANUAL FOR ONE- AND TWO-FAMILY DWELLINGS AND OTHER APPLICABLE REGULATING REQUIREMENTS OF
- TID THE BEST OF STRUCTICA, INC. KNOWLEDGE THESE PLANS ARE DRAWN TO COMPLY WITH OWNER'S AND/OR BUILDER'S SPECIFICATIONS AND ANY CHANGES MADE TO THEM AFTER PRINTS ARE MADE WILL BE DONE AT THE OWNER'S AND/OR BUILDER'S RESPONSIBILITY.
- EXCAVATIONS SHALL BE MADE IN COMPLIANCE WITH THE MOST RECENT EDITION OF THE CALIFORNIA CONSTRUCTION SAFETY ORDERS (CAL-DSHA) REGULATIONS. DIMENSIONS, DEFSETS, LINES AND GRADES ELEVATIONS SHOWN ON THESE PLANS ARE FOR REFERENCE ONLY. THE CONTRACTOR IS RESPONSIBLE TO COORDINATE ARE FOR REFERENCE ONLY, THE CONTRACTOR IS RESPONSIBLE TO COORDINATE THEM AT THE SITE AND SHALL ESTABLISH TO INSURE PROPER HORIZONTAL AND VERTICAL ALIGNMENT OF WALLS, WOOD FRAMES, SLAB ON GRADE, FOOTINGS AND LOCATION OF POSTS. THE CONTRACTOR IF RESPONSIBLE TO REPORT ANY DISCREPANCY AND LACK OF COORDINATION BETWEEN THESE DRAWINGS AND SITE CONDITION TO THE ENGINEER (STRUCTICA, INC.) IN A TIMELY MANNER. THE CONTRACTOR OF THE PROJECT MUST CHECK ALL DIMENSIONS AND OTHER DETAILS PRIOR TO CONSTRUCTION AND BE SOLELY RESPONSIBLE THEREAFTER.

  5. STRUCTICA, INC. IS NOT LIABLE FOR ERRORS DNCE THE CONSTRUCTION HAS BEGUN. WHILE EVERY EFFORT HAS BEEN MADE IN THE PREPARATION OF THIS PLAN TO AVOID MISTAKES, THE MAKER CAN NOT GUARANTEE AGAINST HUMAN ERROR.
- THE CONTRACTOR SHALL VERIFY THE LOCATION OF ALL UTILITIES AND OTHER OBSTACLES IN THE FIELD. THE CONTRACTOR IS RESPONSIBLE TO POTHOLE ALL UTILITIES, AS NEEDED, BEFORE WALL CONSTRUCTION IS TO BEGIN AND REPORT ALL INTERFERENCE BETWEEN UTILITIES OR OTHER OBSTACLES WITH THE WALL
- IN THESE DRAWINGS TO THE ENGINEER (STRUCTICA, INC.) IN A TIMELY MANNER.

  7. CONTRACTOR SHALL CALL 811 OR (800) 642–244 PRIOR TO EXCAVATION IN A TIMELY MANNER TO LOCATE UNDERGROUND UTILITIES.
- 8. ITEMS NOT COVERED ON THIS DRAWINGS SHALL MAINTAIN STRICT COMPLIANCE
- 9. ALL WORKD SHALL COMPLY WITH THE REQUIREMENTS OF 2016 SFBC & 2016 CBC. MINIMUM NAILING SHALL BE PER TABLE 2304.9.1 FASTENING SCHEDULE.
- 10. PROFESSIONAL ENGINEER ASSUMES NO RESPONSIBILITY FOR THE SUPERVISION OF THE CONSTRUCTION OR PROPER EXECUTION OF THE WORK SHOWN ON THESE DRAWINGS. SAFETY METHODS AND TECHNIQUES ARE THE SOLE RESPONSIBILITY OF THE CONTRACTOR.
- CONNECTIONS SHALL COMPLY WITH REQUIREMENTS AND RECOMMENDATIONS BY SIMPSON STRONG-TIE.

## DESIGN LOADS:

1. DEAD LOAD 1.1. PERGOLA ROOF: 15 PSF 2. LIVE LOAD 2.1. PERGOLA ROOF: PSF 20 3. ALLOWABLE BEARING CAPACITY: 1,500 PSE 5. SEISMIC COEFFICIENT (Sds)

# MATERIAL

CONCRETE 1.1. PORTLAND CEMENT SHALL CONFORM TO ASTM C-50 TYPE II, LOW ALKALI. IN PURILAND CEMENT SHALL CUNFURM TO ASTM C-SUTTYPE II, LUW ALKALI. IN ADDITION TO THE STANDARD PORTLAND CEMENT, THE THE FOLLOWING SCM SUPPLEMENTARY CEMENTITIOUS MATERIAL) MAY BE USED IN THE MIX DESIGN: FLY ASH, ASTM C618 CLASS F DR GROUND GRANULATED BLAST FURNACE SLAG, ASTM 0989 GRADE 100 DR 120. SCM IS TO MAKE UP 50% MAX. DF THE CEMENTITIOUS MATERIALS WHEN ALL CEMENTITIOUS MATERIALS TOTAL 600#

1.041

- (6.4 SACKS) PER CUBIC YARD PER ACI 318. CONCRETE SHALL BE HARDROCK CONCRETE AND SHALL ATTAIN THE FOLLOWING
- ULTIMATE COMPRESSIVE
  STRENGTHS AT 28 DAYS. (MINIMUM CEMENT CONTENT: (FIVE SACKS/CU. YD.)
  MINIMUM STRENGTH @ 28 DAYS: 2,500 PSI
- MAX. AGGREGATE SIZE: 3 IN. MAX. SLUMP SIZE: 4 IN.
- 3. MAX. SLUMP SIZE: 4 IN.
  CDNCRETE SHALL BE CONTINUOUSLY CURED FOR 10 DAYS AFTER PLACING IN
  ANY APPROVED MANNER, INCLUDING CURING COMPOUND, CURING PAPER, ETC.
  NOTE: FOOTINGS ARE EXCEPTED FROM THIS REQUIREMENT.
  WHEN PLACING NEW CONCRETE OR SHOTCRETE AGAINST EXISTING CONCRETE
  OR MASONRY, ROUGHEN SURFACE OF EXISTING MATERIAL BY EITHER
  SANDBLASTING OR SCRAFFYING TO 1/" AMPLITUDE AND APPLY BONDING AGENT. BONDING AGENT SHALL BE LARSEN PRODUCTS CORPORATION'S WELD-CRETE OR APPROVED EQUIVALENT. AT EXISTING BRICK, ROUGHENING NOT REQUIRED IF EXISTING BRICK HAS A NATURAL ROUGH SURFACE, BONDING AGENT IS NOT REQUIRED AT EXISTING BRICK SURFACE UNLESS OTHERWISE NOTED ON PLANS AND/OR DETAILS.

- SILLED SHAFTS:
  SHAFTS ARE TO BE MACHINE DRILLED.
  PROVIDE PROTECTION AGAINST SLOUGHING OR CAVING AS REQUIRED.
  DRILLED HOLES SHALL NOT BE LEFT OPEN OVER-NIGHT.
  ALL WATER SHOULD BE REMOVED FROM THE SHAFT PRIOR TO FILLING WITH
  CONCRETE, IF POSSIBLE, ALL. IF ALL WATER CANNOT BE REMOVED BY
  PUMPING, CONCRETE SHALL BE CAREFULLY PUMPED INTO THE CIDH PILE
  SHAFT FROM THE BOTTOM UP THROUGH A RIGID PIPE AND DESIGN STRENGTH
  OF CONCRETE SHALL BE INCREASED BY 1000 PSI.
- PROVIDE 3 INCHES MINIMUM CONCRETE COVER OVER ALL STEEL SURFACES.

  DRILL HOLE CIDH PILES ARE TO BE FILLED WITH STRUCTURAL CONCRETE
  WITH MINIMUM COMPRESSIVE STRENGTH OF 2,500 PSI AT 28 DAYS.

- EINFURCEMENT STEEL:

  REINFORCING BAR ASTM A615 GR. 60.
  Ld (DEVELOPMENT LENGTH): COMPLY WITH ACI 318 OR 40* BAR DIA. MIN
  LAP SPLICE: CLASS B SPLICES 1.3*Ld
  CLEAR COVERAGE OF CONCRETE OVER OUTER REINFORCING BARS SHALL BE
- CONCRETE POURED DIRECTLY AGAINST EARTH: 3 INCHES.

- 2. CONCRETE FORMED AGAINST EARTH OR EXPOSED TO WEATHER: 2 INCHES. 3. FORMED CONCRETE NOT INCLUDED ABOVE: 1 INCHES. ALL REINFORCING BAR BENDS SHALL BE MADE COLD. 5.4.3.
- 5.6.
- ALL TIE WIRE SHALL BE ASTM A82 BLACK ANNEALED. ALL HORIZONTAL REINFORCING TO BE SUPPORTED ON GALVANIZED CHAIRS EXCEPT THAT MORTAR BLOCKS OR OTHER APPROVED METHODS OF SUPPORT SHALL BE USED AT FOOTINGS, AND SLABS ON GRADE.

- ALL LUMBER SHALL BE DOUGLAS-FIR GRADE 2 OR REDWOOD GRADE 2, U.N.O. ALL WOOD EXPOSED TO WEATHER SHALL BE PRESSURE TREATED WOOD OR
- REDWOOD (GRADE: CLEAR STRUCTURAL). ALL BOLT AND NAIL HOLES SHALL BE CAULKED AND SEALED WITH
- APPROPRIATE CAULKING MATERIAL.
  ALL PRESSURE TREATED WOOD SHALL USE NAILING, BOLTING AND/OR
- FASTENERS MADE OF STAINLESS STEEL, OR WITH HOT-DIP GALVANIZATION, OR WITH (G185) DZ. OF ZINC PER SQUARE FOOR OF SURFACE GALVANIZED DR WITH (G185) DZ. DE ZINC PER SWOARE FUDR DE SORFACE GALVANIZED PRODUCTS. ALL NAILS, SCREWS, BOLTS, METAL CONNECTORS AND FLASHING EXPOSED TO WEATHER SHALL NOT BE DIPPED GALVANIZED.

  HOLES AND CUTOUTS SHALL NOT BE LARGER THAN \$ OF THE DEPTH PF THE MEMBER FROM TOP NOR BE LOCATED FARTHER THAN 3 TIMES DEPTH OF
- MEMBER FROM SUPPORTS.
- ALL NAILS SHALL BE COMMON NAILS.
- NEW FRAMING SHALL HAVE 19% MAX. MDISTURE CONTENT AT TIME OF INSTALLATION.

7.1. ALL CONNECTIONS, FASTENERS AND HANGERS ARE SIMPSON OR EQUIVALENT.

## 8. EARTHWORK:

8.1. MAX. FILL AMOUNT:

[(3 FT+1 FT)/2]*43 FT * 10 FT/2 = 16 CY

2022-MM-1

ATTACHMENT E



WW TOOL BOXSE CO

SIGNED BY:

STRUCTICA, inc



ō Ш ERG NOT


GLODEN ASTER ( BRISBANE, CA

005-401-010

PEVISIONS DESCRIPTION REVIEW SET


2249/P227 DATE 12/09/202 DESIGN RAWN CHECKED ВМ PROVED:

S-1.0

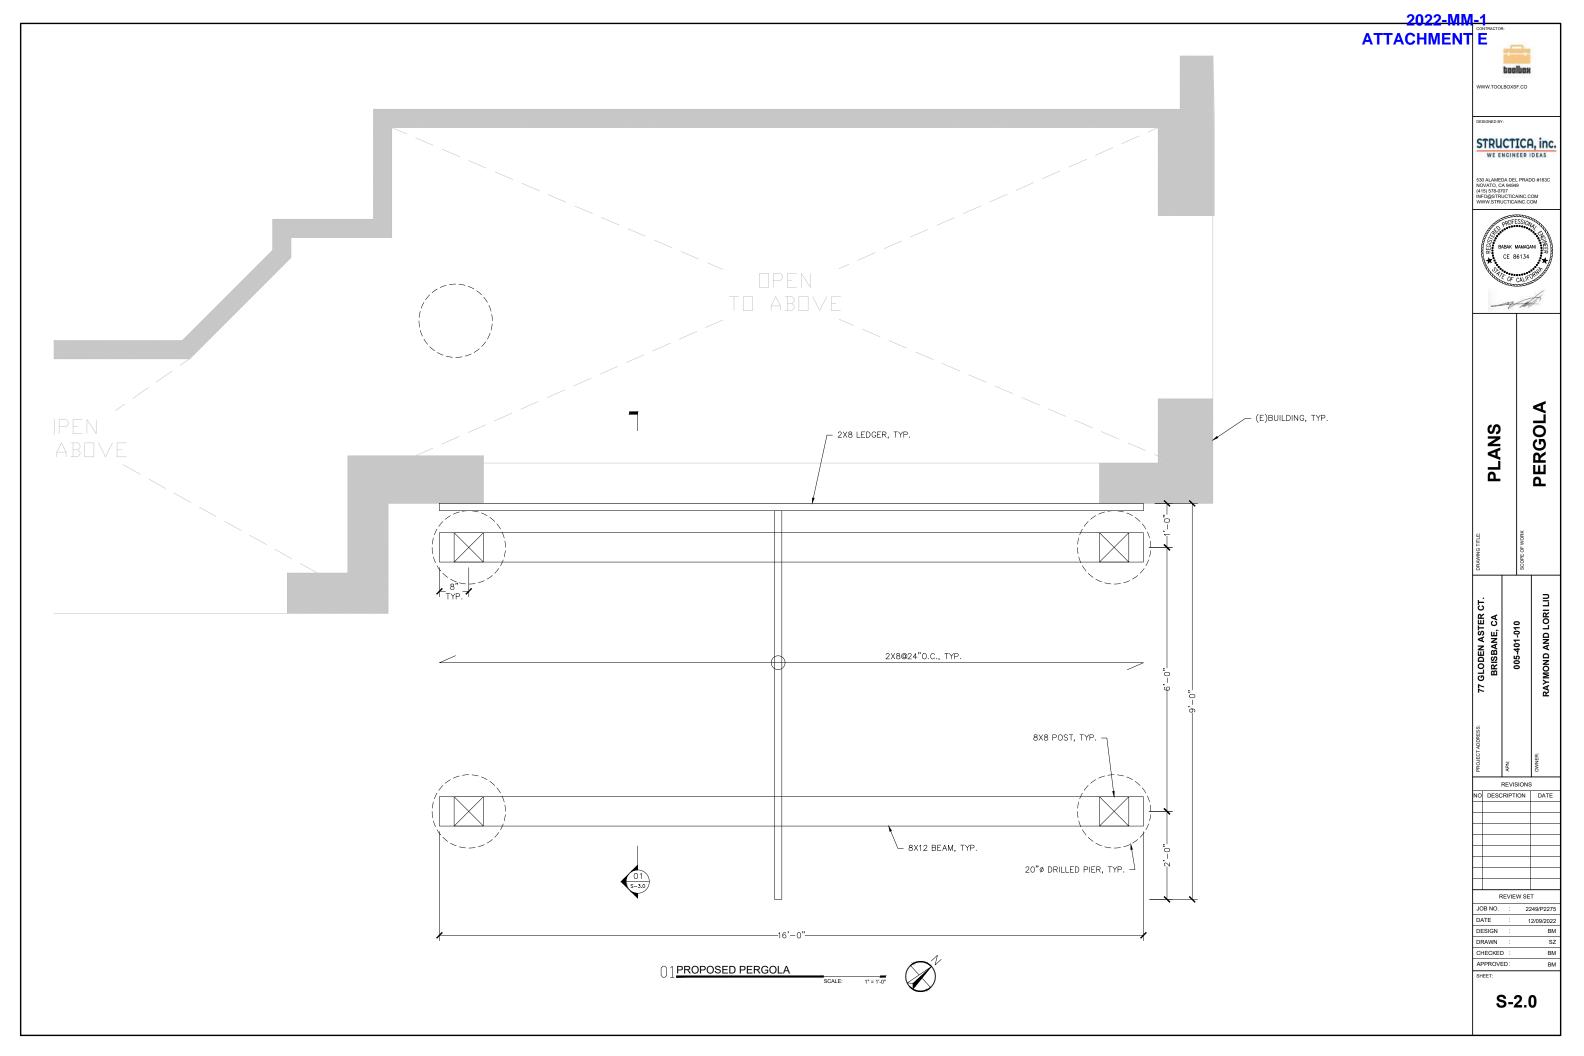


DESIGN :
DRAWN :
CHECKED :
APPROVED :

S-3.0

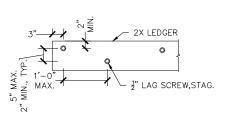

SCALE:

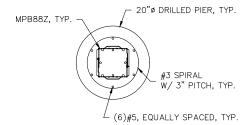

02LEDGER DETAIL

3 FOOTING SECTION

SCALE: 1°=

CCQ88SDS2.5, TYP.

8X8 POST


2X BLOCKING, TYP.

8X BEAM, TYP.

2X6 KNEE BRACING
ATTACHED W/ (2)20d NAILS, TYP.

04 POST TO BEAM DETAIL

SCALE: 1" = 1'-0"

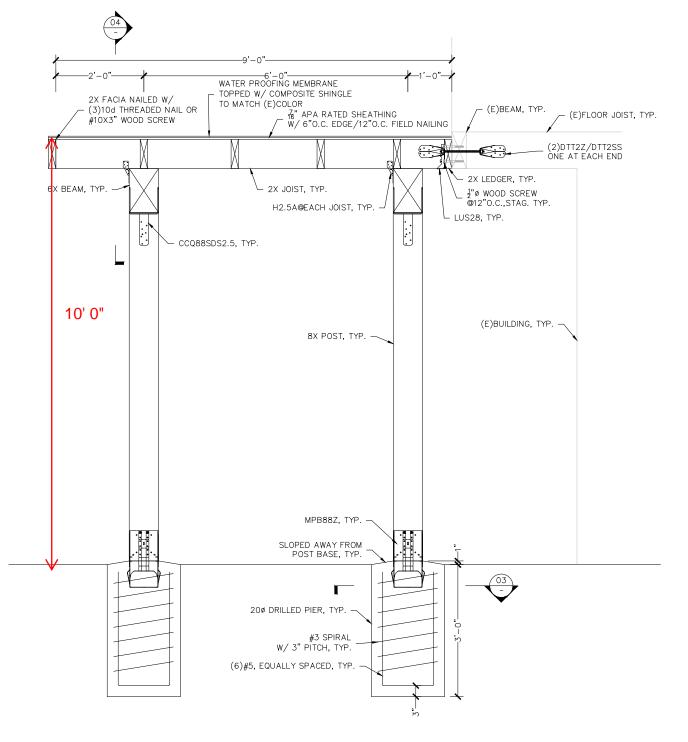

01 SECTION