Change Order No. 7

Date of Issuance:	11/2/2026	Effective Date:	11/5/2026
Owner:	Town of Bristol	Owner's Contract No.:	
Contractor:	Niblock	Contractor's Project No.:	N/A
Engineer:	Jones Petrie Rafinski Corp.	Engineer's Project No.:	2023-0005
Project:	Town of Bristol Water System Improvements	Contract Name:	A

The Contract is modified as follows upon execution of this Change Order:

Description:

Nnew water main, valves, services and connections at the intersection of Vistula St. and Division St. installed such that three existing valves within the intersection can be abandoned.
Services Replaced: 101 W Vistula, 105 W Vistula, 106 W Vistula 108 W Vistula, Park Service, 110 S Division St., and 112 S Division St.
Meter Pits Replaced: 101 W Vistula, 105 W Vistula, and 110 S Division St.
Services Abandoned: 101 W Vistula, 105 W Vistula, 106 W Vistula, 108 W Vistula, Both Park Services, 110 S Division St., and 112 S Division St.

Attachments:
1. Change Order Worksheet
2. Revised Plan Sheets C1001, and C1101

Change in Contract Price			**Change in Contract Time**	
Original Contract Price:		**$5,987,307.00**	**Original Contract Times:**	
Previous change orders:				
1	**$**	**56,699.00**	Substantial Completion	7/15/2025
2	**$**	**43,865.50**	Final Completion	8/19/2025
3	**$**	**(113,351.80)**	**Increase/Decrease from Change Orders (days)**	
4	**$**	**522,724.50**	Change Order 4	396
5	**$**	**281,677.00**		
6	**$**	**18,999.50**		
			Total	**396**
Net Change from Previous Change Orders:	$	810,613.70	**Contract times with all approved change orders**	
Contract Price prior to this change order:	**$**	**6,797,920.70**		
Net change from this change order	**$**	**198,500.00**	Substantial Completion	8/15/2026
Contract Price incorporating this change order	**$**	**6,996,420.70**	Final Completion	9/19/2026

Recommended:	**Accepted:**	**Accepted:**
By Engineer:	By Owner:	By Contractor:
Jones Petrie Rafinski Corp	Town of Bristol	Niblock
_____	_____	_____
Signature	*Jeff Beachy*	Signature
	Signature	
Senior Project Engineer	Council President	_____
Title	Title	Title
11/3/2026	_____	_____
Date	Date	Date

Project: Town of Bristol Water System Improvements
Change Order No. 7

Change Order Worksheet
Attachment 1

Contractor: Niblock

ITEM NO.		DESCRIPTION	Previous Contract Quantity	Revised Contract Quantity	Unit	Previous Contract Unit Price	Revised Contract Unit Price	Increase	Decrease	Revised Contract Value
		Mandatory Bid Alternate A1								
A1	1.1	Mobilization & Demobilization, Max 5%	1	1	LSUM	$122,500.00	$122,500.00	$ -	$ -	$122,500.00
A1	2.1	Construction Staking	1	1	LSUM	$25,500.00	$25,500.00	$ -	$ -	$25,500.00
A1	3.1	Erosion Control	1	1	LSUM	$10,000.00	$10,000.00	$ -	$ -	$10,000.00
A1	4.1	Tower & Well Site Clearing	1	1	LSUM	$75,000.00	$75,000.00	$ -	$ -	$75,000.00
A1	5.1	Dewatering	1	1	LSUM	$1.00	$1.00	$ -	$ -	$1.00
A1	6.1	Maintenance of Traffic	1	1	LSUM	$35,000.00	$35,000.00	$ -	$ -	$35,000.00
A1	7.1	10" C900 PVC Water Main	1,629	1,629	LFT	$97.50	$97.50	$ -	$ -	$158,827.50
A1	7.2	8" C900 PVC Water Main	0	0	LFT	$95.00	$95.00	$ -	$ -	$0.00
A1	7.3	6" C900 PVC Water Main	63	63	LFT	$65.50	$65.50	$ -	$ -	$4,126.50
A1	8.1	10" Gate Valve & Box	9	9	EA	$4,775.00	$4,775.00	$ -	$ -	$42,975.00
A1	8.2	8" Gate Valve & Box	0	0	EA	$3,335.00	$3,335.00	$ -	$ -	$0.00
A1	8.3	6" Gate Valve & Box	1	1	EA	$2,435.00	$2,435.00	$ -	$ -	$2,435.00
A1	9.1	2" PE CTS Water Service	313	313	LFT	$45.00	$45.00	$ -	$ -	$14,085.00
A1	9.2	2" Water Service Curb Stop Assembly	2	2	EA	$3,250.00	$3,250.00	$ -	$ -	$6,500.00
A1	9.3	1" PE CTS Water Service	1772	1772	LFT	$41.50	$41.50	$ -	$ -	$73,538.00
A1	9.4	1" Water Service Curb Stop Assembly	5	5	EA	$1,890.00	$1,890.00	$ -	$ -	$9,450.00
A1	9.5	Corp & Connect to Existing	28	28	EA	$1,285.00	$1,285.00	$ -	$ -	$35,980.00
A1	9.6	Meter Pits, installed and connected	28	28	EA	$2,060.00	$2,060.00	$ -	$ -	$57,680.00
A1	10.1	Fire Hydrant Assembly - Type 1	6	6	EA	$10,000.00	$10,000.00	$ -	$ -	$60,000.00
A1	10.2	Fire Hydrant Assembly Removal	4	4	EA	$750.00	$750.00	$ -	$ -	$3,000.00
A1	11.1	10" DI 90 Deg. Bend	1	1	EA	$1,285.00	$1,285.00	$ -	$ -	$1,285.00
A1	11.2	10" DI 45 Deg. Bend	13	13	EA	$1,065.00	$1,065.00	$ -	$ -	$13,845.00
A1	11.3	10" DI 22.5 Deg. Bend	0	0	EA	$1,050.00	$1,050.00	$ -	$ -	$0.00
A1	11.4	12" x 10" Tapping Valve & Sleeve	1	1	EA	$10,000.00	$10,000.00	$ -	$ -	$10,000.00
A1	11.5	10" x 10" Tee Fitting	2	2	EA	$2,375.00	$2,375.00	$ -	$ -	$4,750.00
A1	11.6	10" x 8" Reducer Fitting	0	0	EA	$900.00	$900.00	$ -	$ -	$0.00
A1	11.7	10" x 6" Tee Fitting	2	2	EA	$2,000.00	$2,000.00	$ -	$ -	$4,000.00
A1	11.8	10" Plug	3	3	EA	$630.00	$630.00	$ -	$ -	$1,890.00
A1	11.9	8" x 8" Tee Fitting	0	0	EA	$1,690.00	$1,690.00	$ -	$ -	$0.00
A1	11.10	6" x 6" Tapping Valve & Sleeve	1	1	EA	$6,500.00	$6,500.00	$ -	$ -	$6,500.00
A1	11.11	6" DI 90 Deg. Bend	2	2	EA	$650.00	$650.00	$ -	$ -	$1,300.00
A1	12.1	INDOT Pavement Restoration - HMA Surface	12.46	12.46	TON	$250.00	$250.00	$ -	$ -	$3,115.00
A1	12.2	INDOT Pavement Restoration - HMA Intermediate	11.73	11.73	TON	$200.00	$200.00	$ -	$ -	$2,346.00
A1	12.3	INDOT Pavement Restoration - HMA Base	22.31	22.31	TON	$150.00	$150.00	$ -	$ -	$3,346.50
A1	12.4	INDOT Pavement Restoration - Compacted Subgrade Type 1C	59.22	59.22	TON	$55.00	$55.00	$ -	$ -	$3,257.10
A1	13.1	Local Roadway Pavement Restoration - HMA Surface	1	1	TON	$250.00	$250.00	$ -	$ -	$250.00
A1	13.2	Local Roadway Pavement Restoration - HMA Intermediate	17.13	17.13	TON	$200.00	$200.00	$ -	$ -	$3,426.00
A1	13.3	Local Roadway Pavement Restoration - HMA Base	23.00	23.00	TON	$150.00	$150.00	$ -	$ -	$3,450.00
A1	13.4	Local Roadway Pavement Restoration - Compacted Aggregate No. 53 Base	5.00	5.00	TON	$80.00	$80.00	$ -	$ -	$400.00
A1	14.1	SR 120 Streetscape - 4" Sidewalk	147.20	147.20	SYD	$85.00	$85.00	$ -	$ -	$12,512.00
A1	14.2	SR 120 Streetscape - 9" PCCP	0.00	0.00	SYD	$175.00	$175.00	$ -	$ -	$0.00
A1	14.3	SR 120 Streetscape - INDOT No. 8 Agg. Backfill	0.00	0.00	SYD	$100.00	$100.00	$ -	$ -	$0.00
A1	15.1	SR 120 Streetscape - Curb Ramp Restoration	0.00	0.00	SYD	$300.00	$300.00	$ -	$ -	$0.00
A1	16.1	SR 120 Streetscape - Concrete Curb Restoration	133.00	133.00	LFT	$45.00	$45.00	$ -	$ -	$5,985.00
A1	17.1	Tower Site Temporary Access Road	1,420	1,420	SYD	$17.50	$17.50	$ -	$ -	$24,850.00
A1	17.2	Tower Site Temporary Access Road -Local Roadway Pavement Restoration - HMA Surface	22.15	22.15	TON	$250.00	$250.00	$ -	$ -	$5,537.50
A1	17.3	Tower Site Temporary Access Road - Local Roadway Pavement Restoration - HMA Base	48.82	48.82	TON	$150.00	$150.00	$ -	$ -	$7,323.00
A1	17.4	Tower Site Temporary Access Road – Additional Clearing and Grubbing	1	1	LSUM	$8,975.00	$8,975.00	$ -	$ -	$8,975.00
A1	18.1	Landscape Restoration & Seeding	1	1	LSUM	$7,750.00	$7,750.00	$ -	$ -	$5,812.50
A1	19.1	Water Main Line Stop - 6", Undistributed	0	0	EA	$10,500.00	$10,500.00	$ -	$ -	$0.00
A1	20.1	Flowable Fill, installed, for AC pipe support, as directed by Engineer or Town	16	16	CY	$415.00	$415.00	$ -	$ -	$6,640.00
A1	21.1	Storm Piping Repairs, unforeseen conditions	4	4	EA	$1,895.00	$1,895.00	$ -	$ -	$7,580.00
A1	22.1	Force Main Repairs, unforeseen conditions	1	1	EA	$6,150.00	$6,150.00	$ -	$ -	$6,150.00
A1-CO3	23.1	Asphalt Sidewalk	954	954	SY	$60.65	$60.65	$ -	$ -	$57,860.10
A1-CO3	24.1	Interior Water Service Work	3	3	EA	$775.00	$775.00	$ -	$ -	$2,325.00
A1-CO3	25.1	Additional Maintenance of Traffic Equipment	64	64	DAILY	$205.00	$205.00	$ -	$ -	$13,120.00
		Mandatory Bid Alternate A2								
A2	1.1	Mobilization & Demobilization, Max 5%	1	1	LSUM	$6,500.00	$6,500.00	$ -	$ -	$6,500.00
A2	2.1	Construction Staking	1	1	LSUM	$25,500.00	$25,500.00	$ -	$ -	$25,500.00
A2	3.1	Erosion Control	1	1	LSUM	$8,500.00	$8,500.00	$ -	$ -	$8,500.00
A2	4.1	Tower/Well Site Earthwork & Grading	1	1	LSUM	$133,500.00	$133,500.00	$ -	$ -	$133,500.00
A2	5.1	Dewatering	1	1	LSUM	$3,500.00	$3,500.00	$ -	$ -	$3,500.00
A2	6.1	Landscape Restoration & Seeding	1	1	LSUM	$65,000.00	$65,000.00	$ -	$ -	$65,000.00
A2	7.1	Maintenance of Traffic	1	1	LSUM	$1,500.00	$1,500.00	$ -	$ -	$1,500.00
A2	8.1	12" C900 PVC Water Main	110	110	LFT	$107.50	$107.50	$ -	$ -	$11,825.00
A2	8.2	16" C900 PVC Water Main	0	0	LFT	$315.00	$315.00	$ -	$ -	$0.00
A2- CO6	8.21	16" C900 PVC Water Main	107	107	LFT	$200.00	$200.00	$ -	$ -	$21,400.00
A2	8.3	10" C900 PVC Water Main	150	150	LFT	$97.50	$97.50	$ -	$ -	$14,625.00
A2	8.4	8" C900 PVC Water Main	15	15	LFT	$95.00	$95.00	$ -	$ -	$1,425.00
A2	9.1	12" Gate Valve & Box	3	3	EA	$5,725.00	$5,725.00	$ -	$ -	$17,175.00
A2	9.2	16" Gate Valve & Box	0	0	EA	$17,000.00	$17,000.00	$ -	$ -	$0.00
A2	9.3	10" Gate Valve & Box	1	1	EA	$4,775.00	$4,775.00	$ -	$ -	$4,775.00
A2	10.1	1" PE CTS Water Service	95	95	LFT	$17.50	$17.50	$ -	$ -	$1,662.50
A2	10.2	1" Water Service Curb Stop Assembly	1	1	EA	$1,650.00	$1,650.00	$ -	$ -	$1,650.00
A2	11.1	16" DI 45 Deg. Bend	0	0	EA	$2,790.00	$2,790.00	$ -	$ -	$0.00
A2	11.2	10" DI 45 Deg. Bend	4	4	EA	$1,065.00	$1,065.00	$ -	$ -	$4,260.00
A2	11.3	8" DI 45 Deg. Bend	2	2	EA	$750.00	$750.00	$ -	$ -	$1,500.00

Printed on: 11/3/2026

Project: Town of Bristol Water System Improvements
Change Order No. 7

Change Order Worksheet
Attachment 1

Contractor: Niblock

ITEM NO.		DESCRIPTION	Previous Contract Quantity	Revised Contract Quantity	Unit	Previous Contract Unit Price	Revised Contract Unit Price	Increase	Decrease	Revised Contract Value
A2	11.4	16" x 12" Reducer Fitting	1	1	EA	$2,050.00	$2,050.00	$ -	$ -	$2,050.00
A2	11.5	12" x 10" Reducer Fitting	1	1	EA	$1,135.00	$1,135.00	$ -	$ -	$1,135.00
A2-CO6	11.52	16" x 12" Tee Fitting	1	1	EA	$6,000.00	$6,000.00	$ -	$ -	$6,000.00
A2	11.6	12" x 12" Tee Fitting	1	1	EA	$2,425.00	$2,425.00	$ -	$ -	$2,425.00
A2	11.7	12" x 8" Tee Fitting	1	1	EA	$2,265.00	$2,265.00	$ -	$ -	$2,265.00
A2	11.8	8" x 8" Tapping Valve & Sleeve	1	1	EA	$7,900.00	$7,900.00	$ -	$ -	$7,900.00
A2	12.1	Tower/Well Site 12" PVC Storm Sewer	160	160	LFT	$70.00	$70.00	$ -	$ -	$11,200.00
A2	12.2	Tower/Well Site Storm Inlet	1	1	EA	$1,900.00	$1,900.00	$ -	$ -	$1,900.00
A2	12.3	Tower/Well Site Drywell	2	2	EA	$6,500.00	$6,500.00	$ -	$ -	$13,000.00
A2	12.4	Tower/Well Site 4" PVC Sewer	45	45	LFT	$100.00	$100.00	$ -	$ -	$4,500.00
A2	13.1	Tower Site - INDOT No. 53 Compacted Aggregate	1,040	1,040	TON	$41.00	$41.00	$ -	$ -	$42,640.00
A2	14.1	Wellhouse #6 Structure	1	1	LSUM	$52,500.00	$52,500.00	$ -	$ -	$52,500.00
A2	14.2	Wellhouse #6 Mechanical & Electrical	1	1	LSUM	$94,750.00	$94,750.00	$ -	$ -	$94,750.00
A2	15.1	Water Well No. 6 - Peerless Midwest	1	1	LSUM	$153,000.00	$153,000.00	$ -	$ -	$153,000.00
A2	15.2	Midwest	1	1	LSUM	$93,290.00	$93,290.00	$ -	$ -	$93,290.00
A2	16.1	Chemical Building Structure	1	1	LSUM	$81,500.00	$81,500.00	$ -	$ -	$81,500.00
A2	16.2	Chemical Building Mechanical & Electrical	1	1	LSUM	$235,000.00	$235,000.00	$ -	$ -	$235,000.00
A2-CO6	16.4	Floride Feed Skid, Plumbing and Appurtenances (Credit)	1	1	LSUM	-$10,455.00	-$10,455.00	$ -	$ -	-$10,455.00
A2-CO6	16.5	Water Softener (Credit)	1	1	LSUM	-$600.00	-$600.00	$ -	$ -	-$600.00
A2	17.1	Well Site Electrical	1	1	LSUM	$70,000.00	$70,000.00	$ -	$ -	$70,000.00
A2	18.1	Water Main Line Stop - 8", Undistributed	2	2	EA	$11,500.00	$11,500.00	$ -	$ -	$23,000.00
A2-CO5	19.1	Tower/Well Site Fencing with Gates	1	1	LSUM	$115,455.00	$115,455.00	$ -	$ -	$115,455.00
A2-CO5	19.2	Additional Site Clearing For Fence	1	1	LSUM	$32,635.00	$32,635.00	$ -	$ -	$32,635.00
A2-CO5	19.3	RecPro Pavement Mill & Resurface	1,570	1,570	SY	$16.80	$16.80	$ -	$ -	$26,376.00
		Mandatory Bid Alternate A3								
A3	1.1	Mobilization & Demobilization, Max 5%	1	1	LSUM	$20,000.00	$20,000.00	$ -	$ -	$20,000.00
A3	2.1	Construction Staking	1	1	LSUM	$25,500.00	$25,500.00	$ -	$ -	$25,500.00
A3	3.1	Erosion Control	1	1	LSUM	$12,750.00	$12,750.00	$ -	$ -	$12,750.00
A3	4.1	Tower & Well Site Clearing	1	1	LSUM	$20,000.00	$20,000.00	$ -	$ -	$20,000.00
A3	5.1	Dewatering	1	1	LSUM	$45,000.00	$45,000.00	$ -	$ -	$45,000.00
A3	6.1	Maintenance of Traffic	1	1	LSUM	$5,000.00	$5,000.00	$ -	$ -	$5,000.00
A3	7.1	12" C900 PVC Water Main	1,328	1,328	LFT	$101.50	$101.50	$ -	$ -	$134,792.00
A3	7.2	12" C900 PVC Water Main by HDD	8,563	8,563	LFT	$130.00	$130.00	$ -	$ -	$1,113,190.00
A3	7.3	Railroad Crossing	113	113	LFT	$700.00	$700.00	$ -	$ -	$79,100.00
A3	7.4	12" HDPE Water Main	390	390	LFT	$95.00	$95.00	$ -	$ -	$37,050.00
A3	7.5	12" HDPE Water Main & Casing - SR 120 Crossing	110	110	LFT	$450.00	$450.00	$ -	$ -	$49,500.00
A3	7.6	8" C900 PVC Water Main	35	35	LFT	$95.00	$95.00	$ -	$ -	$3,325.00
A3	7.7	6" C900 PVC Water Main	20	20	LFT	$65.50	$65.50	$ -	$ -	$1,310.00
A3	8.1	12" Gate Valve & Box	29	29	EA	$5,725.00	$5,725.00	$ -	$ -	$166,025.00
A3	8.2	8" Gate Valve & Box	2	2	EA	$3,335.00	$3,335.00	$ -	$ -	$6,670.00
A3	8.3	6" Gate Valve & Box	1	1	EA	$2,435.00	$2,435.00	$ -	$ -	$2,435.00
A3	9.1	2" PE CTS Water Service	40	40	LFT	$45.00	$45.00	$ -	$ -	$1,800.00
A3	9.2	2" Water Service Curb Stop Assembly	2	2	EA	$3,250.00	$3,250.00	$ -	$ -	$6,500.00
A3	10.1	Fire Hydrant Assembly - Type 1	20	20	EA	$10,000.00	$10,000.00	$ -	$ -	$200,000.00
A3	10.2	Fire Hydrant Assembly - Type 2	3	3	EA	$10,000.00	$10,000.00	$ -	$ -	$30,000.00
A3	10.3	Fire Hydrant Assembly Removal	1	1	EA	$750.00	$750.00	$ -	$ -	$750.00
A3	11.1	12" DI 45 Deg. Bend	13	13	EA	$1,400.00	$1,400.00	$ -	$ -	$18,200.00
A3	11.2	12" DI 22.5 Deg. Bend	5	5	EA	$1,300.00	$1,300.00	$ -	$ -	$6,500.00
A3	11.3	12" DI 11.25 Deg. Bend	3	3	EA	$1,265.00	$1,265.00	$ -	$ -	$3,795.00
A3-CO6	11.3	8" DI 45 Deg. Bend	2	2	EA	$750.00	$750.00	$ -	$ -	$1,500.00
A3	11.4	12" x 12" Tapping Valve & Sleeve	1	1	EA	$11,500.00	$11,500.00	$ -	$ -	$11,500.00
A3	11.5	12" x 12" Tee Fitting	6	6	EA	$2,425.00	$2,425.00	$ -	$ -	$14,550.00
A3	11.6	12" x 8" Tee Fitting	0	0	EA	$2,265.00	$2,265.00	$ -	$ -	$0.00
A3	11.7	12" x 8" Reducer Fitting	2	2	EA	$1,030.00	$1,030.00	$ -	$ -	$2,060.00
A3	11.8	12" HDPE/PVC Material Transition Fitting	2	2	EA	$1,785.00	$1,785.00	$ -	$ -	$3,570.00
A3	11.9	12" HDPE Thrust Anchor	2	2	EA	$5,000.00	$5,000.00	$ -	$ -	$10,000.00
A3	11.10	12" Plug	5	5	EA	$825.00	$825.00	$ -	$ -	$4,125.00
A3	11.11	8" x 8" Tapping Valve & Sleeve	1	1	EA	$7,900.00	$7,900.00	$ -	$ -	$7,900.00
A3	12.1	River Crossing Monitoring Structure	1	1	EA	$32,500.00	$32,500.00	$ -	$ -	$32,500.00
A3	13.1	Clean Water Release Valve	1	1	EA	$24,250.00	$24,250.00	$ -	$ -	$24,250.00
A3	14.1	Local Roadway Pavement Restoration - HMA Surface	8	8	TON	$250.00	$250.00	$ -	$ -	$2,000.00
A3	14.2	Intermediate	15	15	TON	$200.00	$200.00	$ -	$ -	$3,000.00
A3	14.3	Local Roadway Pavement Restoration - HMA Base	15	15	TON	$150.00	$150.00	$ -	$ -	$2,250.00
A3	14.4	Aggregate No. 53 Base	30	30	TON	$80.00	$80.00	$ -	$ -	$2,400.00
A3	15.1	Parking Lot Pavement Restoration HMA Surface	2	2	TON	$125.00	$125.00	$ -	$ -	$250.00
A3	15.2	Parking Lot Pavement Restoration HMA Base	3	3	TON	$100.00	$100.00	$ -	$ -	$300.00
A3	15.3	Aggregate No. 53 Base	5	5	TON	$41.50	$41.50	$ -	$ -	$207.50
A3	16.1	Landscape Restoration & Seeding	1	1	LSUM	$23,500.00	$23,500.00	$ -	$ -	$23,500.00
A3	17.1	Water Main Line Stop - 8", Undistributed	1	1	EA	$11,500.00	$11,500.00	$ -	$ -	$11,500.00
A3	17.2	Water Main Line Stop - 12", Undistributed	1	1	EA	$14,500.00	$14,500.00	$ -	$ -	$14,500.00
		Mandatory Bid Alternate A4								
A4	1.1	Mobilization & Demobilization, Max 5%	1	1	LSUM	$12,500.00	$12,500.00	$ -	$ -	$12,500.00
A4	2.1	Construction Staking	1	1	LSUM	$25,500.00	$25,500.00	$ -	$ -	$25,500.00
A4	3.1	Erosion Control	1	1	LSUM	$18,000.00	$18,000.00	$ -	$ -	$18,000.00
A4	4.1	Site Clearing	1	1	LSUM	$4,500.00	$4,500.00	$ -	$ -	$4,500.00
A4	5.1	Dewatering	1	1	LSUM	$1.00	$1.00	$ -	$ -	$1.00
A4	6.1	Maintenance of Traffic	1	1	LSUM	$3,500.00	$3,500.00	$ -	$ -	$3,500.00
A4	7.1	12" C900 PVC Water Main	60	60	LFT	$107.50	$107.50	$ -	$ -	$6,450.00
A4	7.2	12" C900 PVC Water Main by HDD	542	542	LFT	$130.00	$130.00	$ -	$ -	$70,460.00
A4	7.3	12" HDPE Water Main	840	840	LFT	$95.00	$95.00	$ -	$ -	$79,800.00
A4	7.4	10" C900 PVC Water Main	90	90	LFT	$97.50	$97.50	$ -	$ -	$8,775.00
A4	7.5	10" C900 PVC Water Main by HDD	2,940	2,940	LFT	$102.50	$102.50	$ -	$ -	$301,350.00
A4	7.6	8" C900 PVC Water Main	14	14	LFT	$95.00	$95.00	$ -	$ -	$1,330.00
A4	7.7	6" C900 PVC Water Main	230	230	LFT	$52.50	$52.50	$ -	$ -	$12,075.00
A4	8.1	12" Gate Valve & Box	1	1	EA	$5,725.00	$5,725.00	$ -	$ -	$5,725.00

Printed on: 11/3/2026

Project: Town of Bristol Water System Improvements
Change Order No. 7

Change Order Worksheet
Attachment 1

Contractor: Niblock

ITEM NO.		DESCRIPTION	Previous Contract Quantity	Revised Contract Quantity	Unit	Previous Contract Unit Price	Revised Contract Unit Price	Increase	Decrease	Revised Contract Value
A4	8.2	10" Gate Valve & Box	10	10	EA	$4,775.00	$4,775.00	$ -	$ -	$47,750.00
A4	8.3	6" Gate Valve & Box	4	4	EA	$2,435.00	$2,435.00	$ -	$ -	$9,740.00
A4	9.1	Fire Hydrant Assembly - Type 1	9	9	EA	$10,000.00	$10,000.00	$ -	$ -	$90,000.00
A4	9.2	Fire Hydrant Assembly - Type 2	1	1	EA	$10,000.00	$10,000.00	$ -	$ -	$10,000.00
A4	9.3	Fire Hydrant Assembly Removal	1	1	EA	$750.00	$750.00	$ -	$ -	$750.00
A4	10.1	12" DI 45 Deg. Bend	3	3	EA	$1,400.00	$1,400.00	$ -	$ -	$4,200.00
A4	10.2	12" DI 22.5 Deg. Bend	2	2	EA	$1,300.00	$1,300.00	$ -	$ -	$2,600.00
A4	10.3	12" x 10" Reducer Fitting	1	1	EA	$1,135.00	$1,135.00	$ -	$ -	$1,135.00
A4	10.4	12" x 8" Reducer Fitting	1	1	EA	$1,030.00	$1,030.00	$ -	$ -	$1,030.00
A4	10.5	12" HDPE Thrust Anchor	2	2	EA	$5,000.00	$5,000.00	$ -	$ -	$10,000.00
A4	10.6	12" HDPE/PVC Material Transition	2	2	EA	$1,785.00	$1,785.00	$ -	$ -	$3,570.00
A4	10.7	10" x 10" Tee Fitting	2	2	EA	$2,375.00	$2,375.00	$ -	$ -	$4,750.00
A4	10.8	10" x 6" Tee Fitting	4	4	EA	$2,000.00	$2,000.00	$ -	$ -	$8,000.00
A4	10.9	10" x 6" Reducer Fitting	1	1	EA	$760.00	$760.00	$ -	$ -	$760.00
A4	10.10	10" Plug	2	2	EA	$630.00	$630.00	$ -	$ -	$1,260.00
A4	10.11	8" x 8" Tapping Valve, Sleeve & Box	1	1	EA	$7,900.00	$7,900.00	$ -	$ -	$7,900.00
A4	10.12	6" x 6" Tee Fitting	1	1	EA	$1,005.00	$1,005.00	$ -	$ -	$1,005.00
A4	10.13	6" x 6" Tapping Valve, Sleeve & Box	2	2	EA	$6,500.00	$6,500.00	$ -	$ -	$13,000.00
A4	10.14	6" Plug	3	3	EA	$380.00	$380.00	$ -	$ -	$1,140.00
A4	11.1	River Crossing Monitoring Structure	1	1	EA	$32,500.00	$32,500.00	$ -	$ -	$32,500.00
A4	12.1	Local Roadway Pavement Restoration - HMA Surface	15	15	TON	$250.00	$250.00	$ -	$ -	$3,750.00
A4	12.2	Intermediate	25	25	TON	$200.00	$200.00	$ -	$ -	$5,000.00
A4	12.3	Local Roadway Pavement Restoration - HMA Base	25	25	TON	$150.00	$150.00	$ -	$ -	$3,750.00
A4	12.4	Aggregate No. 53 Base	45	45	TON	$80.00	$80.00	$ -	$ -	$3,600.00
A4	13.1	Landscape Restoration & Seeding	1	1	LSUM	$16,850.00	$16,850.00	$ -	$ -	$16,850.00
A4	14.1	Inserta Valve - 8"	1	1	EA	$14,850.00	$14,850.00	$ -	$ -	$14,850.00
A4	15.1	Water Main Line Stop - 8", Undistributed	1	1	EA	$11,500.00	$11,500.00	$ -	$ -	$11,500.00
A4	15.2	Water Main Line Stop - 6", Undistributed	2	2	EA	$10,500.00	$10,500.00	$ -	$ -	$21,000.00
A4-CO5	16.1	2" PE CTS Water Service	20	20	LFT	$45.00	$45.00	$ -	$ -	$900.00
A4-CO5	17.1	Curb Removal and Replacement at Turtle Drive	1	1	LSUM	$1,850.00	$1,850.00	$ -	$ -	$1,850.00
		Mandatory Bid Alternate A5								
A5	1.1	Mobilization & Demobilization, Max 5%	1	1	LSUM	$2,500.00	$2,500.00	$ -	$ -	$2,500.00
A5	2.1	Construction Staking	1	1	LSUM	$6,500.00	$6,500.00	$ -	$ -	$6,500.00
A5	3.1	Erosion Control	1	1	LSUM	$2,500.00	$2,500.00	$ -	$ -	$2,500.00
A5	4.1	Tower/Well Site Final Grading & Cleanup	1	1	LSUM	$12,800.00	$12,800.00	$ -	$ -	$12,800.00
A5	5.1	Tower Site Pavement - HMA Surface	212	212	TON	$135.00	$135.00	$ -	$ -	$28,620.00
A5	5.2	Tower Site Pavement - HMA Intermediate	422	422	TON	$105.00	$105.00	$ -	$ -	$44,310.00
A5	5.3	Tower Site Pavement - HMA Base	422	422	TON	$105.00	$105.00	$ -	$ -	$44,310.00
A5	6.1	Landscape Restoration & Seeding	1	1	LSUM	$75,000.00	$75,000.00	$ -	$ -	$75,000.00
A5	7.1	Water System Control Installation & Integration	1	1	LSUM	$560,000.00	$560,000.00	$ -	$ -	$560,000.00
A5	8.1	Well & Tower System Start-Up	1	1	LSUM	$25,500.00	$25,500.00	$ -	$ -	$25,500.00
A6	1	12" C900 PVC Water Main	32	32	LFT	$122.50	$122.50	$ -	$ -	$3,920.00
A6	2	6" C900 PVC Water Main	2,805	2,805	LFT	$65.50	$65.50	$ -	$ -	$183,727.50
A6	3	4" C900 PVC Water Main	2	2	LFT	$60.00	$60.00	$ -	$ -	$120.00
A6	4	12" Gate Valve & Box	2	2	EA	$5,725.00	$5,725.00	$ -	$ -	$11,450.00
A6	5	6" Gate Valve & Box	9	9	EA	$2,435.00	$2,435.00	$ -	$ -	$21,915.00
A6	6	4" Gate Valve	1	1	EA	$2,400.00	$2,400.00	$ -	$ -	$2,400.00
A6	7	1" PE CTS Water Service	737	737	LFT	$41.50	$41.50	$ -	$ -	$30,585.50
A6	8	1" Water Service Curb Stop Assembly	32	32	EA	$1,890.00	$1,890.00	$ -	$ -	$60,480.00
A6	9	Fire Hydrant Assembly - Type 1	11	11	EA	$10,000.00	$10,000.00	$ -	$ -	$110,000.00
A6	10	Fire Hydrant Assembly Removal	8	8	EA	$750.00	$750.00	$ -	$ -	$6,000.00
A6	11	Fire Hydrant Assembly, Remove & Reconnect	2	2	EA	$3,500.00	$3,500.00	$ -	$ -	$7,000.00
A6	12	6" DI 45 Deg. Bend	17	17	EA	$695.00	$695.00	$ -	$ -	$11,815.00
A6	13	6" DI 11.25 Deg. Bend	1	1	EA	$680.00	$680.00	$ -	$ -	$680.00
A6	14	12" DI 45 Deg. Bend	2	2	EA	$1,735.00	$1,735.00	$ -	$ -	$3,470.00
A6	15	8" x 4" Reducer Fitting	0	0	EA	$710.00	$710.00	$ -	$ -	$0.00
A6	16	12" x 6" Reducer Fitting	1	1	EA	$1,190.00	$1,190.00	$ -	$ -	$1,190.00
A6	17	6" x 6" Tee Fitting	1	1	EA	$1,160.00	$1,160.00	$ -	$ -	$1,160.00
A6	18	12" x 8" Tee Fitting	1	1	EA	$2,525.00	$2,525.00	$ -	$ -	$2,525.00
A6	19	12" x 12" x 8" Tee Fitting	1	1	EA	$2,525.00	$2,525.00	$ -	$ -	$2,525.00
A6	20	12" x 12" x 10" Tee Fitting	2	2	EA	$2,890.00	$2,890.00	$ -	$ -	$5,780.00
A6	21	8" x 6" Tapping Valve & Sleeve on AC Pipe	2	2	EA	$8,825.00	$8,825.00	$ -	$ -	$17,650.00
A6	22	4" x 4" Tapping Valve & Sleeve on AC Pipe	2	2	EA	$7,650.00	$7,650.00	$ -	$ -	$15,300.00
A6	23	Water Main Line Stop - 6", Undistributed	1	1	EA	$10,500.00	$10,500.00	$ -	$ -	$10,500.00
A6	24	Plug, 12"	1	1	EA	$705.00	$705.00	$ -	$ -	$705.00
A6	25	Installing service at Hardings	1	1	EA	$1,890.00	$1,890.00	$ -	$ -	$1,890.00
A6	26	6x6x4 Tee Fitting	1	1	EA	$1,150.00	$1,150.00	$ -	$ -	$1,150.00
A6	27	Water Main and valves Abandonment	1	1	LSUM	$25,000.00	$25,000.00	$ -	$ -	$25,000.00
A6	28	INDOT full depth restoration outside of CCMG work	60	60	SYD	$195.00	$195.00	$ -	$ -	$11,700.00
A6	29	Lawn Restoration	1	1	LSUM	$5,000.00	$5,000.00	$ -	$ -	$5,000.00
A6	30	Maint. of Traffic for Pearl St.	1	1	LSUM	$7,500.00	$7,500.00	$ -	$ -	$7,500.00
A6	31	Mobilization Beyond Contract Area	1	1	LSUM	$8,500.00	$8,500.00	$ -	$ -	$8,500.00
A6-CO5	32	Remove and Replace Concrete Pad at Bailys Auto	1	1	LSUM	$1,950.00	$1,950.00	$ -	$ -	$1,950.00
A6-CO5	33	Flowable Fill	8	8	CY	$3,320.00	$3,320.00	$ -	$ -	$26,560.00
A6-CO5	34	6" Plug	1	1	EA	$380.00	$380.00	$ -	$ -	$380.00
A7-CO7	1.0	12" HDPE DIPS Directional Drill	0	320	LFT	$0.00	$170.00	$ 54,400.00	$ -	$54,400.00
A7-CO7	1.1	10" C900 Open Cut	0	60	LFT	$0.00	$150.00	$ 9,000.00	$ -	$9,000.00
A7-CO7	1.2	8" C900 Open Cut	0	19	LFT	$0.00	$95.00	$ 1,805.00	$ -	$1,805.00
A7-CO7	1.3	6" C900 Open Cut	0	13	LFT	$0.00	$75.00	$ 975.00	$ -	$975.00
A7-CO7	2.0	8x8 Tee	0	1	EA	$0.00	$1,690.00	$ 1,690.00	$ -	$1,690.00
A7-CO7	3.0	Investigation for existing service	0	1	LSUM	$0.00	$3,500.00	$ 3,500.00	$ -	$3,500.00
A7-CO7	4.0	2" PE CTS Water Service, crossing to Gas Station	0	64	LFT	$0.00	$45.00	$ 2,880.00	$ -	$2,880.00
A7-CO7	4.1	2" PE CTS Water Service, to 101 Exist Vault	0	185	LFT	$0.00	$45.00	$ 8,325.00	$ -	$8,325.00
A7-CO7	4.2	2" PE CTS Water Service, south to 110+112 Div	0	236	LFT	$0.00	$45.00	$ 10,620.00	$ -	$10,620.00
A7-CO7	5.0	2" Curb Stops	0	3	EA	$0.00	$3,250.00	$ 9,750.00	$ -	$9,750.00

Printed on: 11/3/2026

Project: Town of Bristol Water System Improvements
Change Order No. 7


Change Order Worksheet
Attachment 1


Contractor: Niblock

ITEM NO.		DESCRIPTION	Previous Contract Quantity	Revised Contract Quantity	Unit	Previous Contract Unit Price	Revised Contract Unit Price	Increase	Decrease	Revised Contract Value
A7-CO7	6.0	1" PE CTS Water Service, Installation	0	7	EA	$0.00	$1,500.00	$ 10,500.00	$ -	$10,500.00
A7-CO7	6.1	1" PE CTS Water Service, materials	0	7	EA	$0.00	$700.00	$ 4,900.00	$ -	$4,900.00
A7-CO7	7.0	1" Curb Stops	0	1	EA	$0.00	$1,890.00	$ 1,890.00	$ -	$1,890.00
A7-CO7	8.0	Water Meter Pit	0	3	EA	$0.00	$2,060.00	$ 6,180.00	$ -	$6,180.00
A7-CO7	9.0	10" Gate Valves	0	2	EA	$0.00	$4,775.00	$ 9,550.00	$ -	$9,550.00
A7-CO7	10.0	12" DI Fitting	0	1	EA	$0.00	$1,400.00	$ 1,400.00	$ -	$1,400.00
A7-CO7	10.1	10" DI Fitting	0	4	EA	$0.00	$1,065.00	$ 4,260.00	$ -	$4,260.00
A7-CO7	10.2	6" 45 Bends	0	2	EA	$0.00	$695.00	$ 1,390.00	$ -	$1,390.00
A7-CO7	11.0	1" Water Service Abandonment	0	9	EA	$0.00	$500.00	$ 4,500.00	$ -	$4,500.00
A7-CO7	12.0	Abandonment of Water Main	0	1	LSUM	$0.00	$2,775.00	$ 2,775.00	$ -	$2,775.00
A7-CO7	13.0	Abandonment of Existing Valves	0	3	EA	$0.00	$2,500.00	$ 7,500.00	$ -	$7,500.00
A7-CO7	14.0	8" Linestop	0	1	EA	$0.00	$11,500.00	$ 11,500.00	$ -	$11,500.00
A7-CO7	14.1	6" Linestop	0	1	EA	$0.00	$10,500.00	$ 10,500.00	$ -	$10,500.00
A7-CO7	15.0	Flowable Fill	0	16	CY	$0.00	$415.00	$ 6,640.00	$ -	$6,640.00
A7-CO7	16.0	MJ Adapters	0	2	EA	$0.00	$1,785.00	$ 3,570.00	$ -	$3,570.00
A7-CO7	17.0	Saw Cut and Removals	0	1	LSUM	$0.00	$2,000.00	$ 2,000.00	$ -	$2,000.00
A7-CO7	18.0	Traffic control	0	1	LSUM	$0.00	$5,000.00	$ 5,000.00	$ -	$5,000.00
A7-CO7	19.0	Restoration (soil and seed)	0	1	LSUM	$0.00	$1,500.00	$ 1,500.00	$ -	$1,500.00
									Total	**$6,996,420.70**
							Total Increase	$ 198,500.00		
							Total Decrease		$ -	
							Net change this change order			$ 198,500.00
							Contract Price prior to this change order			$ 6,797,920.70
							Current Contract Price			**$ 6,996,420.70**

Printed on: 11/3/2026

As-Built Red Line from Field
JPR/Niblock

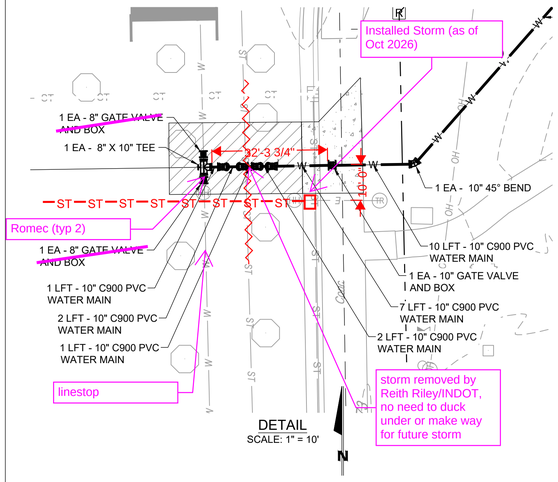

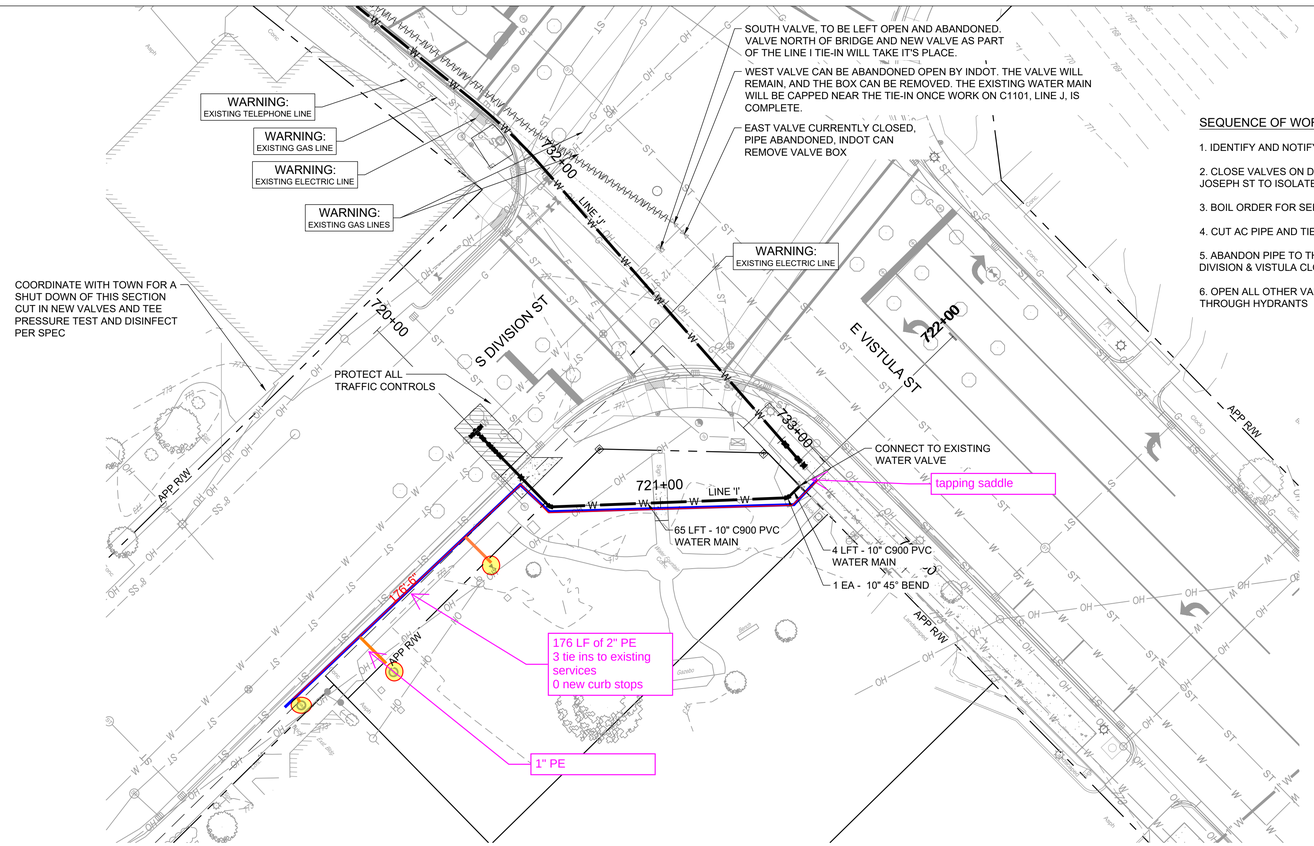


SEQUENCE OF WORK FOR LINE I:

1. IDENTIFY AND NOTIFY CUSTOMERS IN THIS ZONE
2. CLOSE VALVES ON DIVISION AT VISTULA AND AT ST JOSEPH ST TO ISOLATE ZONE (OTHERS AS NECESSARY)
3. BOIL ORDER FOR SERVICES IN THIS ZONE
4. CUT AC PIPE AND TIE IN DIRECTLY
5. ABANDON PIPE TO THE NORTH AND LEAVE VALVE AT DIVISION & VISTULA CLOSED
6. OPEN ALL OTHER VALVES, REFILL AND FLUSH THROUGH HYDRANTS

LEGEND

- (A) FULL COMPACTED BACKFILL AND CUT CLEAN EDGES, RESTORE CONCRETE TO EXISTING DEPTH
- (B) FULL COMPACTED BACKFILL AND CLEAN EDGES, RESTORE ASPHALT TO EXISTING DEPTH
- (C) MILL AND OVERLAY ASPHALT, EDGE TO EDGE
- (D) BACKFILL, RESTORE WITH TOPSOIL AND SEEDING

GRAPHIC SCALE
0 10 20 40
(IN FEET)
1" = 20'

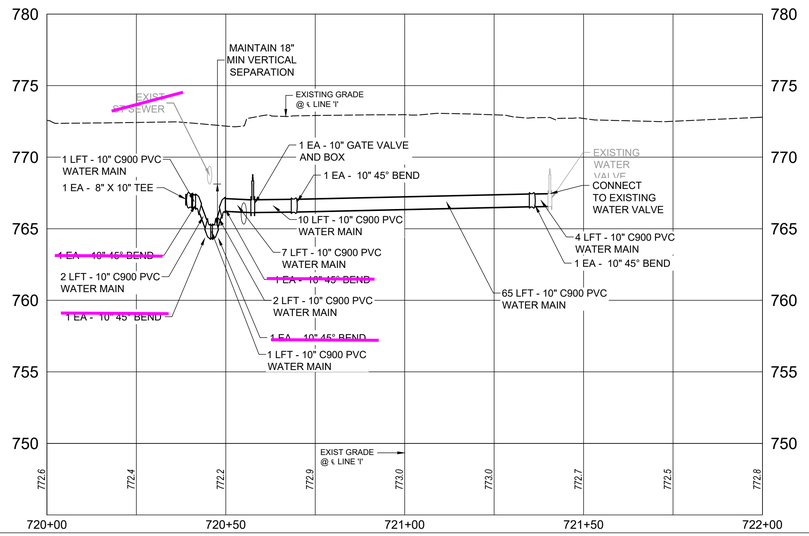

REV	DESCRIPTION	BY	DATE
1	CHANG ORDER 7	JF	6/12/2026

The concepts, designs, plans, details, and other information as shown on this document are the sole property of JPR and are prepared for use on this specific project only. None of the concepts, designs, plans, details or other information hereon shall be used or disseminated without the express written permission of JPR. © 2026 JPR - All Rights Reserved

JONES PETRIE RAFINSKI
Fort Wayne, IN p: 260.422.2522
South Bend, IN p: 574.232.4388

JENNIFER A. FOGLESONG REGISTERED No. 12200587 STATE OF INDIANA PROFESSIONAL ENGINEER
7/31/2026

TOWN OF BRISTOL WATER SYSTEM IMPROVEMENTS PROJECT - CONTRACT A

TOWN OF BRISTOL
303 E VISTULA ST BRISTOL, IN 46507

PLAN & PROFILE
STA. 720+00 TO STA. 722+00 - LINE I

DESIGNED BY:	JF
REVIEWED BY:	JF/JW
DRAWN BY:	DK
REVIEWED BY:	JF
DATE:	JUNE 2026
JOB NUMBER:	2023-0005
HORIZ. SCALE:	1" = 20'H
VERTICAL SCALE:	1" = 5'V

C1001

File: J:\Projects\2023 Projects\2023-0005\07_Design\Engineering\Plans\Contract A - Water Main & Well #6 Plans\Line I Water Main.dwg
Saved By:dkorn Plotted: 2026-09-24 3:39 PM

As-Built Red Line from Field
JPR/Niblock

LOCATE SERVICE AT BACK OF BUILDING
INSTALL NEW CURB STOP AND WATER METER PIT
INSTALL SERVICE INTO BUILDING AS NEEDED
REMOVE EXISTING METER PIT, ABANDON PIPE AS NEEDED

COORDINATE WITH OWNER AND TOWN FOR METER SETTING

Additional coordination needed with business. Planned to be installed during INDOT shut down of this business.

SERVICE CONNECTION

CONNECT EXISTING METER PIT

SEE CROSS SECTION BELOW, THIS PAGE

2" PE Service

TAPPING VALVE CAP AND ABANDON EXISTING

12" valve for future

2 EA - 2" CURB STOPS

SERVICE CONNECTION

Water Meter Pit Replaced per Town direction (typ 3)

INSTALL 2" CURB STOP AND METER PIT. IDENTIFY TIE IN TO EXISTING IRRIGATION SYSTEM RECONNECT SERVICE

service to irrigation meter not installed here

COORDINATE WITH NEW STORM LOCATION AND TOWN, REMOVE AND REPLACE NEW METER PIT ALONG PATH OF EXISTING LINE

LOCATE SERVICE FRONT OF BUILDING
INSTALL NEW CURB STOP AND WATER METER PIT
INSTALL SERVICE INTO BUILDING AS NEEDED
REMOVE EXISTING METER PIT, ABANDON PIPE AS NEEDED

COORDINATE WITH OWNER AND TOWN FOR METER SETTING

730+00
731+00
732+00
733+00
733+50
721+99
721+00
720+00

12" HDPE WATER MAIN

LINE 'J'

WARNING: EXISTING GAS LINES
WARNING: EXISTING TELEPHONE LINE
WARNING: EXISTING GAS LINE
WARNING: EXISTING ELECTRIC LINE
WARNING: EXISTING ELECTRIC LINE

E VISTULA ST

S DIVISION ST

25' X 10' BORING PIT

APP R/W

Catch Basin #6790
Rim 771.72

Catch Basin #6698
Rim 771.82
Inlet Grate #6711
Rim 771.76
Inv 770.23 - 6" PVC NW
Catch Basin #6730
Rim 771.46
Inv 768.48 - 15" RCP W
Inv 768.78 - 12" RCP NE

Inlet Grate #6713
Rim 771.83
Inv 768.60 - 12" RCP N
Inv 768.27 - 15" HDPE S
Inv 768.46 - 12" RCP E
Inv 768.63 - 12" RCP W

CAP

IN COORDINATION WITH TOWN REMOVE AND ABANDON WATER METER ON EAST SIDE OF BUILDING, RETURN METER TO TOWN (NOT SHOWN)


2" PE Service


N

GRAPHIC SCALE
0 10 20 40
(IN FEET)
1" = 20'

LEGEND

(A) FULL COMPACTED BACKFILL AND CUT CLEAN EDGES, RESTORE CONCRETE TO EXISTING DEPTH
(B) FULL COMPACTED BACKFILL AND CLEAN EDGES, RESTORE ASPHALT TO EXISTING DEPTH
(C) MILL AND OVERLAY ASPHALT, EDGE TO EDGE
(D) BACKFILL, RESTORE WITH TOPSOIL AND SEEDING

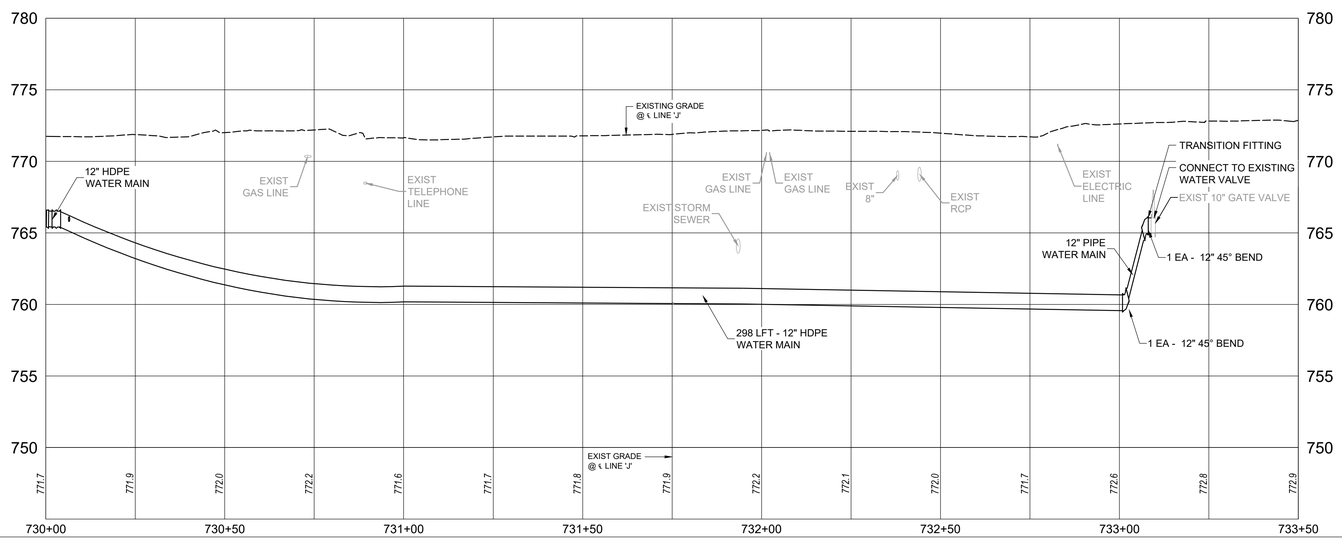

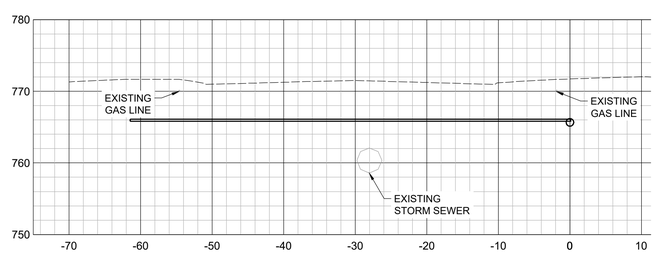

CROSS SECTION - 2" WATER SERVICE
SCALE 1" = 10'

REV	DESCRIPTION	BY	DATE
1	CHANG ORDER 7	JF	6/12/2026

The concepts, designs, plans, details and other information as shown on this document are the sole property of JPR and may not be used or reproduced in whole or in part without the written consent of JPR. None of the concepts, designs, plans, details or other information herein shall be used or disseminated without the expressed written permission of JPR. © 2026 JPR - All Rights Reserved

JONES PETRIE RAFINSKI
Fort Wayne, IN p: 260.422.2522
South Bend, IN p: 574.232.4388

JENNIFER A. FOGLESONG
REGISTERED
No. 12200587
STATE OF INDIANA
PROFESSIONAL ENGINEER
7/31/2026

TOWN OF BRISTOL WATER SYSTEM IMPROVEMENTS PROJECT - CONTRACT A

TOWN OF BRISTOL
303 E VISTULA ST
BRISTOL, IN 46507

PLAN & PROFILE
STA. 730+00 TO STA. 733+50 - LINE J

DESIGNED BY: JF
REVIEWED BY: JF/JW

DRAWN BY: DK
REVIEWED BY: JF

DATE: JUNE 2026

JOB NUMBER: 2023-0005

HORIZ. SCALE: 1" = 20'H
VERTICAL SCALE: 1" = 5'V

C1101

File: I:\Projects\2023 Projects\2023-0005\07_Design\Engineering\Plans\Contract A - Water Main & Well #6 Plans\Line J Water Main.dwg
Saved By:dkim Plotted: 2026-08-28 8:44 AM