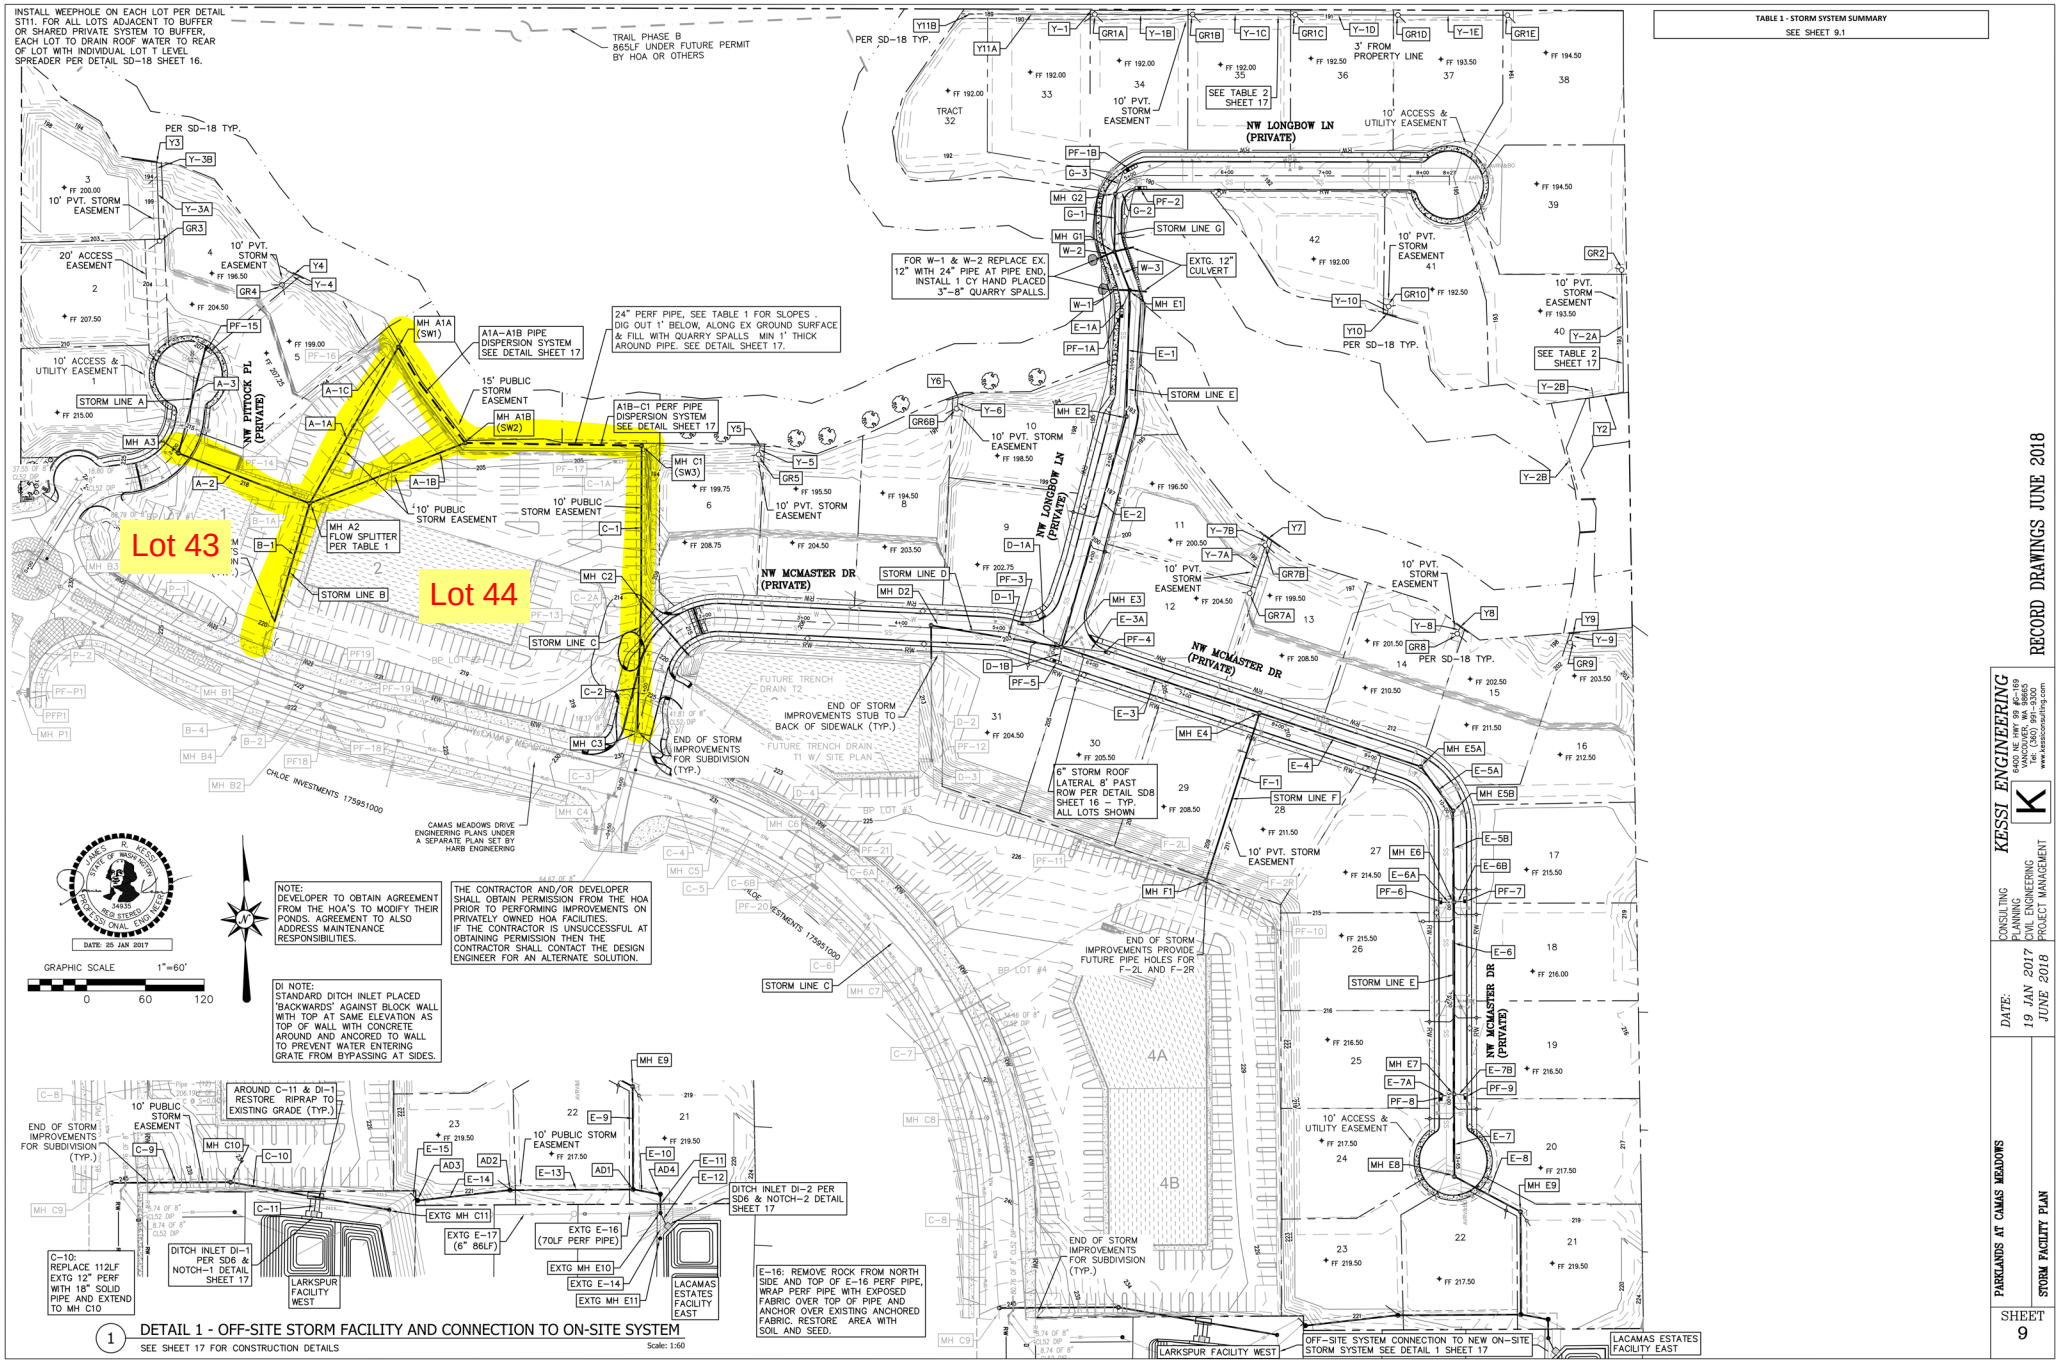


RECORD DRAWINGS JUNE 2018

KBSSI ENGINEERING
CONSULTING PLANNING CIVIL ENGINEERING PROJECT MANAGEMENT
6400 NE HWY 99 #G-150 VANCOUVER, WA 98665

DATE: 19 JAN 2017 JUNE 2018

PARKLANDS AT CAMAS MEADOWS

STORM FACILITY PLAN

SHEET 9