



BIRD OF PARADISE



BANANA TREE




RAINBOW QUEEN










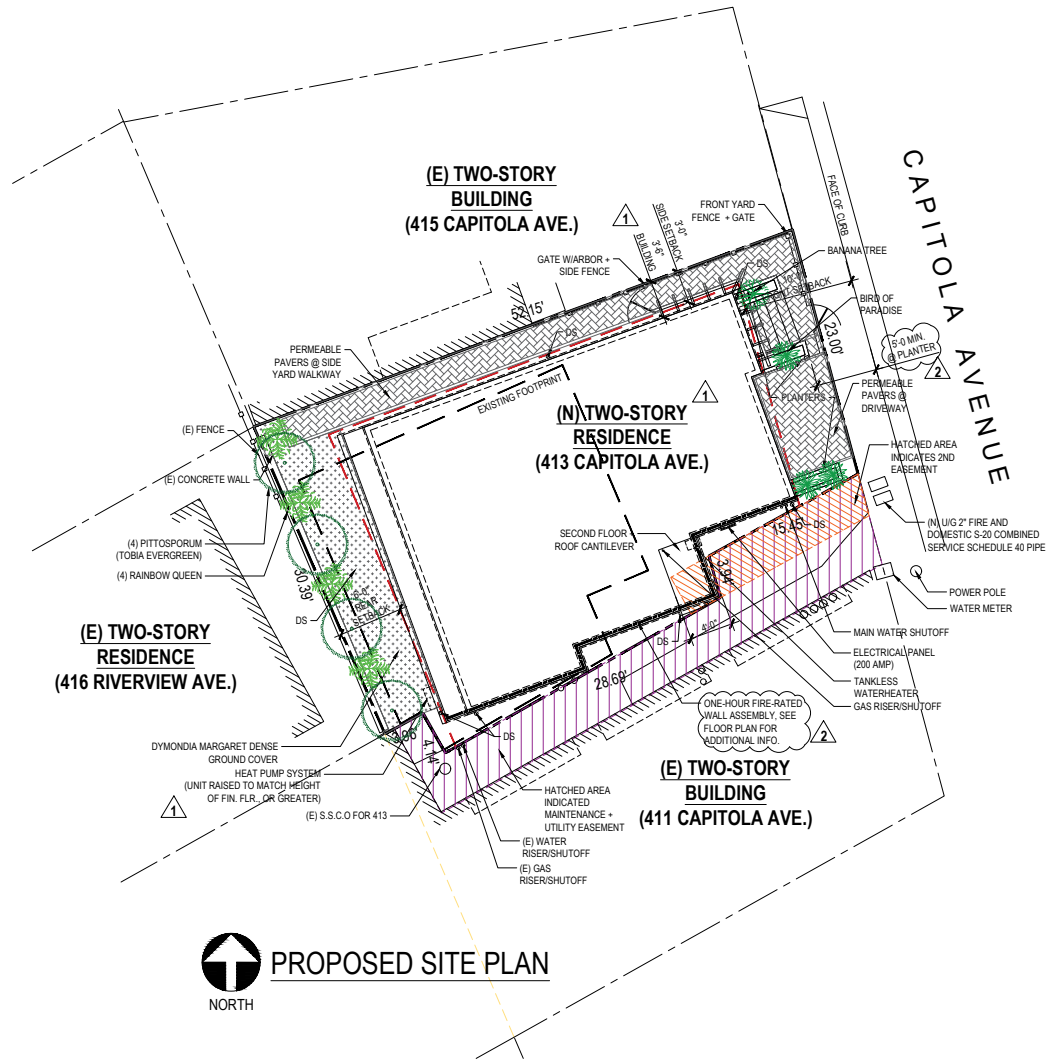



PITTOSPORUM (TREE VARIETY)

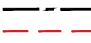

PERMEABLE PAVERS  
BELGARD, CATALINA GRANA



## PROPOSED SITE PLAN

PLANT LEGEND		HATCH LEGEND		LEGEND					
	BIRD OF PARADISE (STRELITZIA NICOLAI) FOUR (4), 5 GALLON MODERATE WATER ALLOWANCE MATURE HT., 4 - 6 FEET		RED ABYSSINIAN BANANA TREE (ENSETE VENTRICOSUM MAURELII) ONE (1), 25 GALLON MODERATE WATER ALLOWANCE MATURE HT., 20 FEET		PERMEABLE PAVERS BELGARD, CATALINA GRANA, COLOR BELLA OR APPROVED EQ.		MAINTENANCE + UTILITY EASEMENT		PROPERTY LINE
	RAINBOW QUEEN (PHORMIUM MACRO QUEEN) FOUR (4), 5 GALLON LOW WATER ALLOWANCE MATURE HT., 3 - 4 FEET		PITTOSPORUM (TOBIA EVERGREEN) FOUR (4), 15 GALLON LOW WATER ALLOWANCE MATURE HT., 15 FEET		2ND EASEMENT		FENCE		ONE HOUR FIRE-RATED WALL ASSEMBLY
					DYMONDIA MARGARET DENSE GROUND COVER, LOW WATER ALLOWANCE, SINGLE SQUARE FLAT (AS MANY FLATS AS NEEDED FOR COVERAGE)				



INTERIORS  
REMODELS +  
ADDITIONS  
NEW CONSTRUCTION  
638 UNIVERSITY AVE  
LOS GATOS  
CALIFORNIA  
95032  
T 408.292.3252  
F 253.399.1125



Reviewed for Code Compliance

08/06/2024

CSG CONSULTANTS, INC.

413 CAPITOLA AVE.  
CAPITOLA  
CALIFORNIA  
95010

A.P.N. 035-131-33

24 AUGUST 2023  
21 NOVEMBER 2023  
PLANNING SUBMITTAL  
06 FEBRUARY 2024  
PLANNING SUBMITTAL II  
19 MARCH 2024  
PLANNING SUBMITTAL III  
10 APRIL 2024  
BUILDING SUBMITTAL

25 JUNE 2024  
BUILDING SUBMITTAL II  
PLAN CHECK  
26 JULY 2024  
BUILDING SUBMITTAL III  
PLAN CHECK

SCALE: 3/8" = 1'-0"

PROPOSED SITE +  
LANDSCAPE PLAN

A1.3