



CONTRACT CHANGE ORDER

CHANGE ORDER NO.: 001

CONTRACT: Dalton Soccer Complex (Synthetic Turf Field Construction Only)

CONTRACTOR: Advanced Sports Group, LLC (ASG)

Contractor (Advanced Sports Group, LLC (ASG) and the City of Dalton mutually agree to add supplemental work to the above referenced project at a Lump Sum pricing as identified in Advanced Sports Group, LLC's Change Order Proposal dated January 7, 2022.

Before fabrication began of the turf fabric for this project, it was determined there was a need for four (4) cross field soccer lines to be added inside the existing main fields line package. This will allow for Youth Soccer to be played.

The Lump Sum contract price increase of **\$21,500.00** is shown on the attached proposal from Advanced Sports Group, LLC. Also attached is the Revised Plan for the additional cross field soccer lines.

Additionally, specifications for how the work is to be completed is shown in the contract proposal.


No additional contract completion time was requested by contractor as part of this Change Order.

Contract Completion Date Remains: Thursday, June 30, 2022

BY:

Benny J. Dunn
Interim Public Works Director

Contractor Representative & Title (Print): MARK HINDMAN - SR. ESTIMATOR

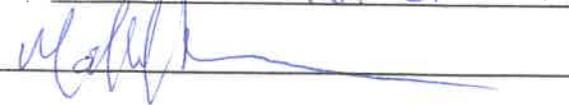Contractor Representative Signature: 

Date: 12 JANUARY 2022

Order #: 001



Change Order

From:

Advanced Sports Group, LLC
2105 Barrett Park Dr.
STE 107
Kennesaw, GA 30144

To:

City of Dalton GA

Project:

Northeast Soccer Complex
Hale Brown Drive
Dalton GA 30720

Change Order Reason:

Add 4 (four) 9v9 soccer fields (tufted and inlaid)

Item Description:**Amount:**

Additional turf, installation sundries for 3,740 LF+/- of inlays	
Additional labor to cut in, glue 3,740 LF+/- of inlays	
TOTAL:	\$ 21,500.00

You hereby are authorized and directed to make the following change(s) in accordance with terms and conditions of the Agreement dated _____.

The time for completion shall be (increased/decreased) by 0 days due to this Change Order. Your acceptance of this Change Order shall constitute a modification to our Agreement and will be performed subject to all the same terms and conditions in our Agreement indicated above, as fully as the same were repeated in this acceptance.

ASG Approval Signature: Mark Hindman Date: 7 January 2022

Print: Mark Hindman Title: Estimator

Owner Signature: _____ Date: _____

Print: _____ Title: _____

Internal use only: Owner

ASG - DALTON SOCCER COMPLEX

SYNTHETIC SPORTS TURF INSTALLATION

MASTER PLAN - TURF LIMITS (PLEASE VERIFY BEFORE APPROVING)



DRAWING INDEX

- TC
TN
1. SOCCER LAYOUT
 2. MINI SOCCER LAYOUT
 3. MID FIELD LOGO SEAMING PLAN
 - 4.

MASTER PLAN NOTES

1. ALL FIELD DIMENSIONS ARE TO BE VERIFIED PRIOR TO FIELD INSTALLATION
2. FIELD COLOR - GREEN (SEE NOTES PAGE FOR MORE INFO)
3. ORDER OF GAME LINE DOMINANCE:
 - 3.1. SOCCER (WHITE LINE PACKAGE)
 - 3.2. MINI SOCCER (YELLOW LINE PACKAGE)

SHOP DRAWING / SUBMITTAL REVIEW

- APPROVED REVISE & RESUBMIT
 APPROVED AS NOTED REJECTED

SUBMITTAL WAS REVIEWED FOR DESIGN CONFORMITY AND GENERAL CONFORMANCE TO CONTRACT DOCUMENTS ONLY. THE SUBCONTRACTOR IS RESPONSIBLE FOR CORRELATING QUANTITIES, FABRICATION PROCESSES, AND TECHNIQUES OF CONSTRUCTION. BY APPROVING THIS DOCUMENT I ACCEPT AND UNDERSTAND THE DESIGN CONCEPT CONTAINED HEREIN SUPERCEDES ALL PREVIOUS VERSIONS.

APPROVED BY: *Caitlin Shapiro* DATE: 1/10/22
 SIGNATURE: *Caitlin Shapiro*

ISSUED FOR APPROVAL



PRODUCT: LG PR 2.0 - 50
AREA: 212,000 SF
INFILL TYPE: RUBB/SAND
INFILL RATIO: TBD
INSTALLER: TBD

ASG-DALTON SOCCER COMPLEX
 SOCCER FIELDS
 DALTON, GA
 COVER PAGE


JOB # -
DATE: 1/17/2022
DRAWN BY: Brandon Ensley

SHEET	T	C	OF
	1	4	4



FIELD COLOR

PLEASE VERIFY THE FIELD COLOR FOR THIS PROJECT BY CIRCILING THE SECTION THAT APPLIES. IF THE PROJECT REQUIRES MULTIPLE FIELD COLORS, PLEASE CIRCLE ALL THAT APPLY.

LEGION FIELD COLOR OPTIONS

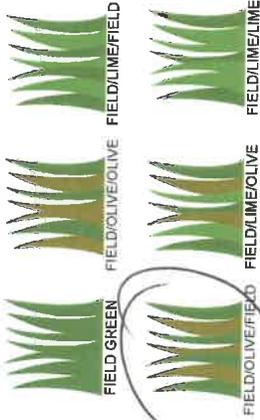


INLAY & DIMENSIONING DETAILS

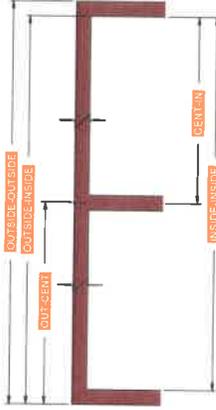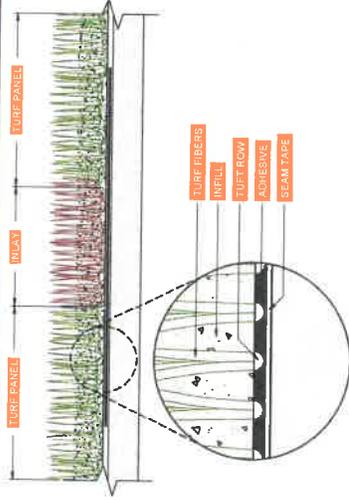

DIMENSIONING WILL VARY FROM SPORT TO SPORT. SHAW SPORTS TURF WILL DIMENSION EACH SPORT ACCORDING TO ITS WRITTEN REGULATIONS TO INSURE INSTALLATION ACCURACY.

STANDARD COLORS

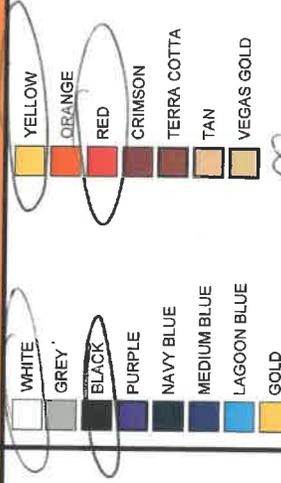

COMMENTS

Blank lines for comments with a handwritten mark.

REFER TO THE SHAW SPORTS TURF COLOR ROLL AND PRODUCT BROCHURE FOR AN ACCURATE REPRESENTATION OF COLORS AND COLOR AVAILABILITY FOR THE PRODUCT CHOSEN. COLORS ARE SUBJECT TO AVAILABILITY AND LEAD TIMES THAT MAY AFFECT THE SHIP DATE.

CUSTOM COLORS WILL REQUIRE LONGER LEAD TIMES AND ARE SUBJECT TO MINIMUM ORDERS. CUSTOM COLORS REQUIRE SWATCH SAMPLE APPROVAL BEFORE MASS PRODUCTION MAY BEGIN.

SHOP DRAWING REVISIONS

DESCRIPTION:	DATE:
1. INITIAL SUBMITTAL (REV-1)	211220
2. REV-2	220107

ASG-DALTON SOCCER COMPLEX
SOCCER FIELDS
DALTON, GA

NOTES

PRODUCT: LG PR 2.0 - 50
AREA: 212,000 SF
INFILL TYPE: RUBB/SAND
INFILL RATIO: TBD
INSTALLER: TBD





JOB # : ---
DATE: 1/7/2022
DRAWN BY:
Brandon Ensley

SHEET
N
OF 4


ISSUED FOR APPROVAL

SOCCER FIELD NOTES


1. SOCCER COLOR: WHITE
2. ENDLINES, HALFWAY LINE, PENALTY BOX LINE, AND TOUCHLINES - TUFTED 4" WIDE
3. ALL OTHER LINES/MARKINGS - INLAID 4" WIDE

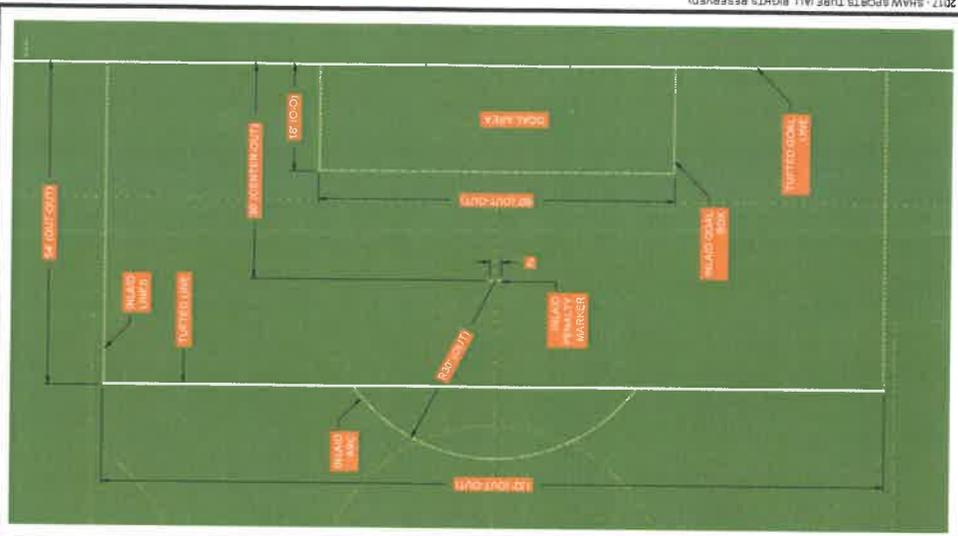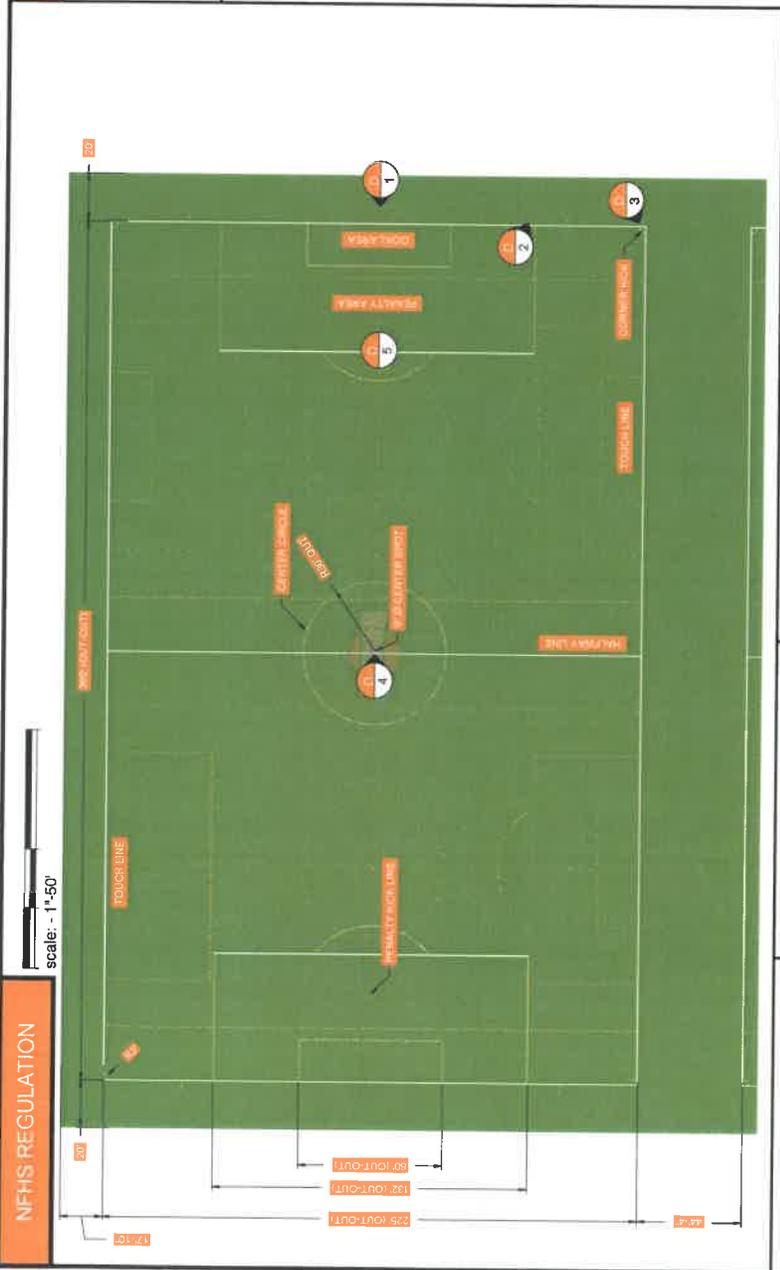


5 SOCCER GOAL AREA DETAIL
SCALE: 1" = 20"

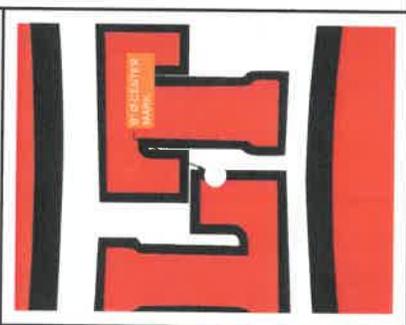


4 CENTER MARK
SCALE: 1/4" = 1'-0"

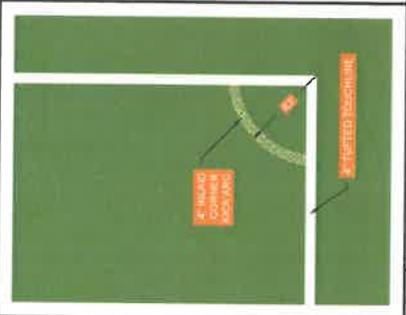

3 CORNER KICK DETAIL
SCALE: 1/4" = 1'-0"

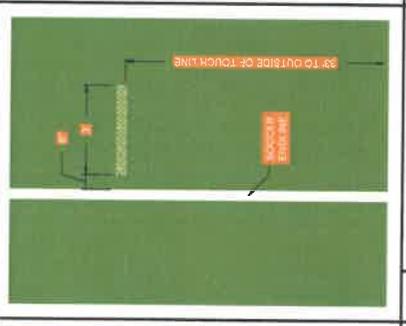

2 HASH DETAIL
SCALE: 1/4" = 1'-0"

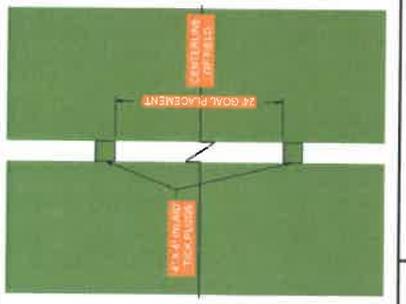

1 GOAL PLACEMENT MARKS
SCALE: 1/2" = 1'-0"

ENDZONE / LOGO / ARTWORK NOTES

LOGO COLORS:

1. BLACK
2. WHITE
3. RED

****PLEASE REFER TO NOTES PAGE (T-N) FOR COLOR SELECTION GUIDELINES****

1. **LOGO DESIGN GUIDELINES:**
 CONTRASTING DECORATIVE MARKINGS INCLUDING CONFERENCE LOGO, COLLEGE, SCHOOL, OR UNIVERSITY NAME AND LOGO, AND TEAM NAME AND LOGO ARE PERMISSIBLE WITHIN THE SIDELINES AND BETWEEN THE GOAL LINES, UNDER THESE CONDITIONS:

- 1.1. THE ENTIRETY OF ALL YARD LINES, GOAL LINES, AND SIDELINES MUST BE CLEARLY VISIBLE. NO PORTION OF ANY SUCH LINE MAY BE OBTURED BY DECORATIVE MARKINGS.
- 1.2. NO SUCH MARKINGS MAY TOUCH OR ENCLOSE THE HASH MARKS.
- 1.3. ADVERTISING IS PROHIBITED ON THE FIELD

EXCEPTION: IF A COMMERCIAL ENTITY HAS PURCHASED NAMING RIGHTS TO THE FACILITY, THAT NAME IS ALLOWED TO BE PAINTED ON THE FIELD. HOWEVER, THE COMMERCIAL LOGO IS NOT ALLOWED TO BE IN THE FIELD OF PLAY.

scale - 1/8"=1'-0"



Shaw
SPORTS TURF
www.shawssportsturf.com

PRODUCT: LG PR 2.0-50
AREA: 212,000 SF
INFILL TYPE: RUBB/SAND
INFILL RATIO: TBD
INSTALLER: TBD

ASG-DALTON SOCCER COMPLEX
SOCCER FIELDS
DALTON, GA
LOGO LAYOUT

JOB # : ---
DATE: 1/17/2022
DRAWN BY: Brandon Ennsley

SHEET	T	3	OF 4
-------	---	---	------

COPYRIGHT © 2017 - SHAW SPORTS TURF (ALL RIGHTS RESERVED)

ISSUED FOR APPROVAL



PRODUCT: LG PR 2.0 - 50
 AREA: 212,000 SF
 INFILL TYPE: RUBB/SAND
 INFILL RATIO: TBD
 INSTALLER: TBD

ASG-DALTON SOCCER COMPLEX
 SOCCER FIELDS
 DALTON, GA
 SEAMING LAYOUT


JOB #:
 DATE: 1/7/2022
 DRAWN BY:
 Brandon Ennsley

SHEET
T 4
 OF 4

SEAMING PLAN NOTES

1. ALL ROLLS ARE 15'-0" WIDE, UNLESS NOTED OTHERWISE
2. ROLLS ARE LAID OUT PER THE DIRECTION OF ARROWS LABELED "PILE LAY"

scale: - 1"=60'

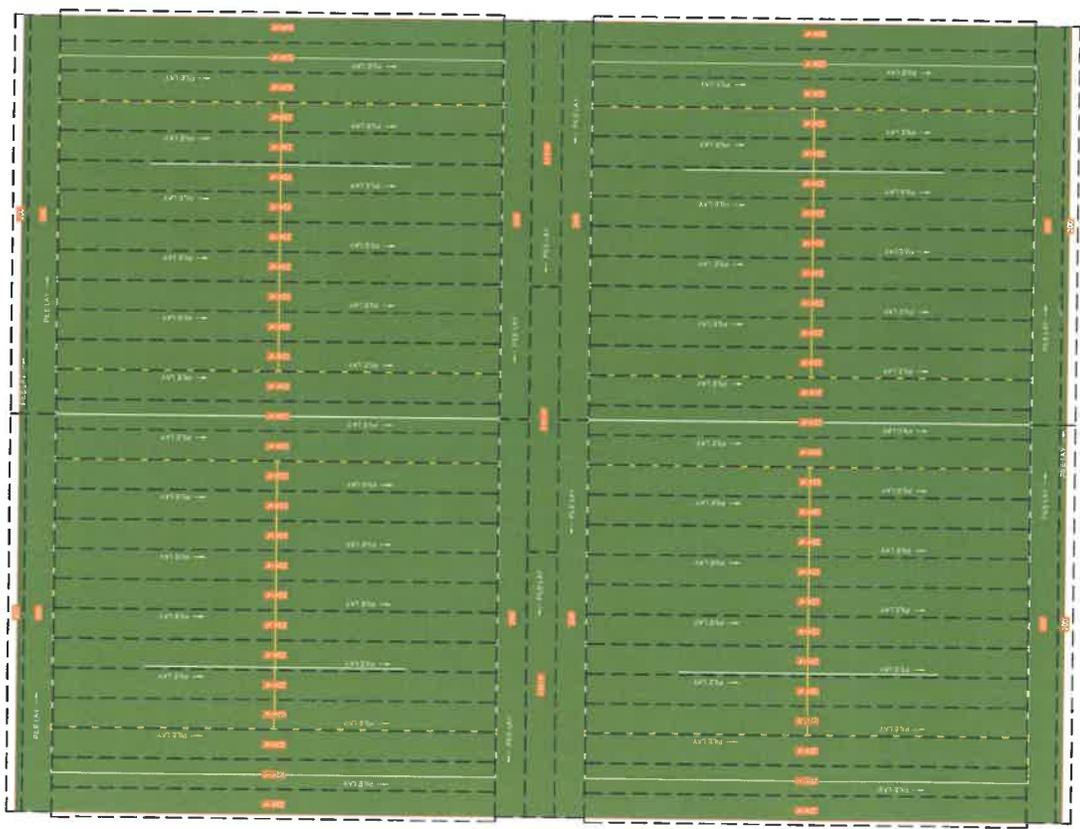

ISSUED FOR APPROVAL

COPYRIGHT © 2017 - SHAW SPORTS TURF (ALL RIGHTS RESERVED)