GENERAL NOTES - EXTERIOR ELEVATIONS

A. ELEVATIONS OF EXISTING FLOORS ARE BASED ON SURVEY INFORMATION AND/OR AS-BUILT DRAWINGS PROVIDED BY THE OWNER. THE SURVEY DATA MAY NOT BE COMPLETE AND THE ACTUAL EXISTING ELEVATIONS MAY VARY IN DIFFERENT PORTIONS OF THE EXISTING BUILDING. ALL INFORMATION MUST BE FIELD VERIFIED AND COORDINATED BETWEEN NEW AND EXISTING CONSTRUCTION TO PROVIDE MATCHING FLOOR ELEVATIONS WHERE REQUIRED.

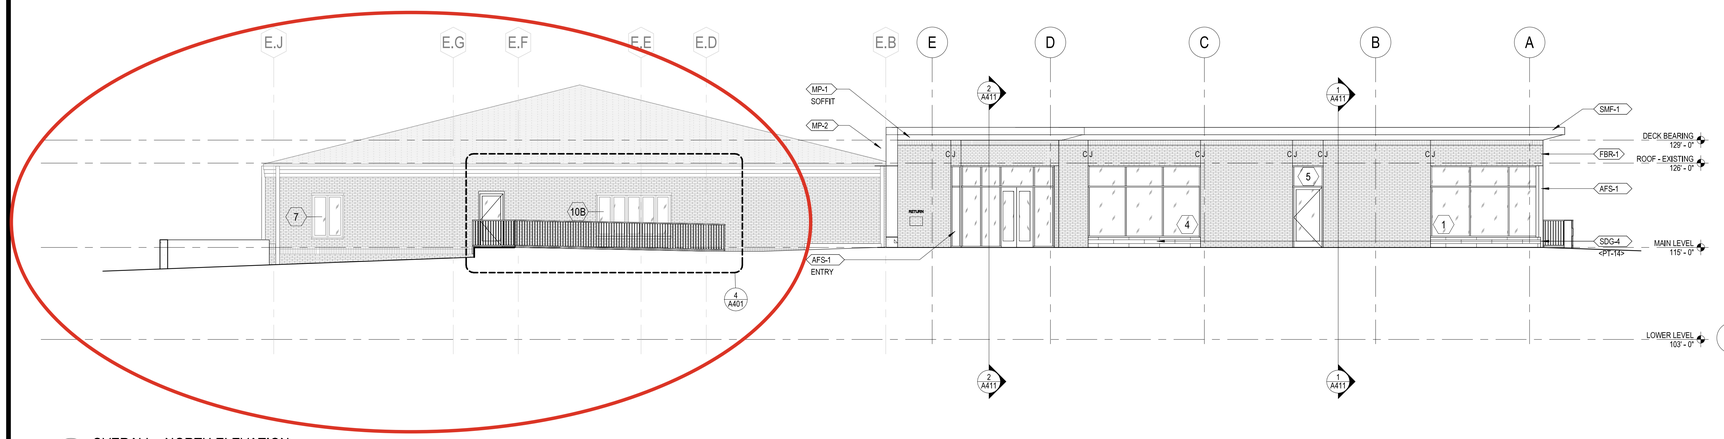

1 OVERALL - NORTH ELEVATION
1/8" = 1'-0"

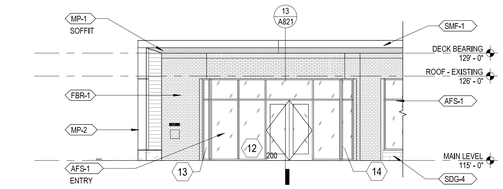

5 ENTRY AT NORTH VESTIBULE
1/8" = 1'-0"

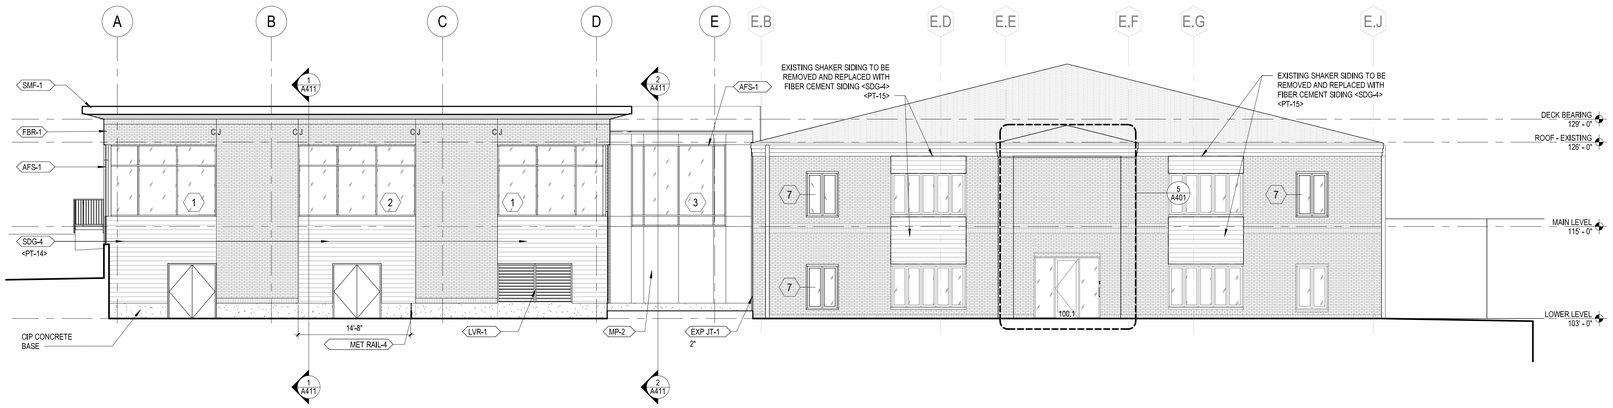

2 OVERALL - SOUTH ELEVATION
1/8" = 1'-0"

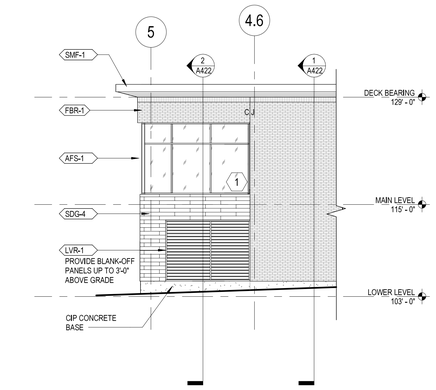

6 EAST ELEVATION - ADDITION
1/8" = 1'-0"

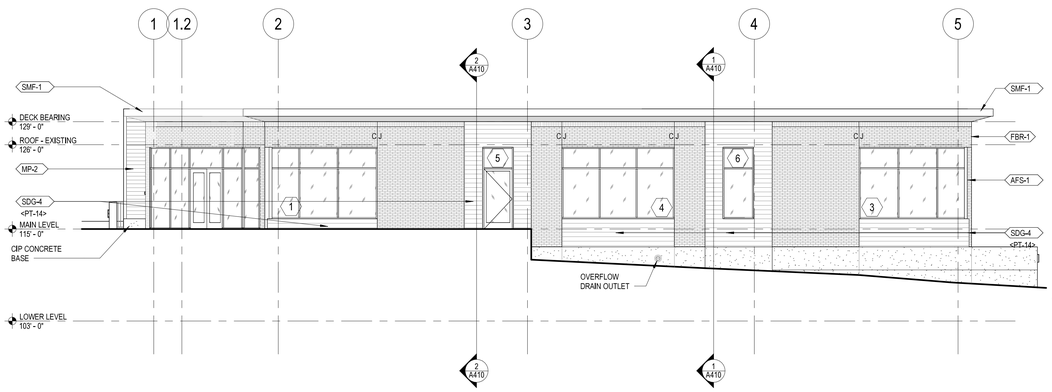

3 OVERALL - WEST ELEVATION
1/8" = 1'-0"

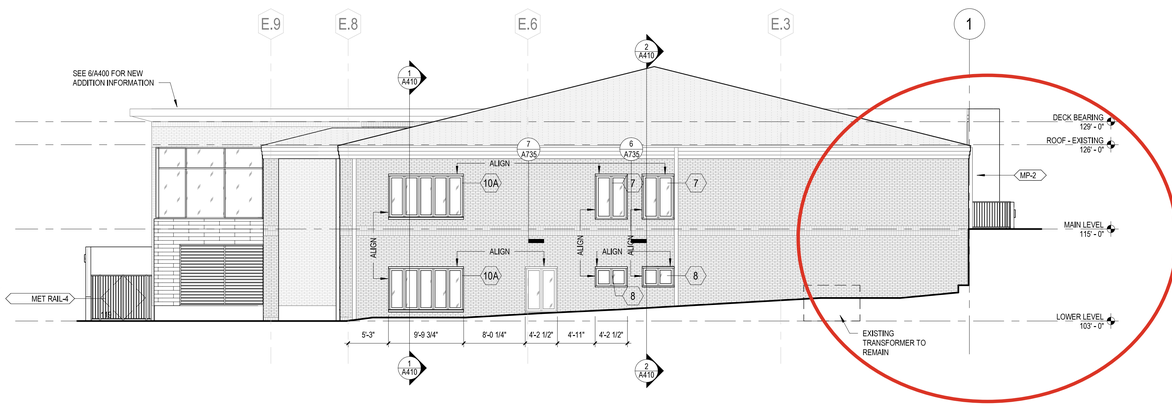

4 OVERALL - EAST ELEVATION
1/8" = 1'-0"

HGA

333 East Erie Street
Milwaukee, Wisconsin 53202
Telephone 414.278.8200

CIVIL ENGINEER

LANDSCAPE ARCHITECT

STRUCTURAL ENGINEER

MECHANICAL/ELECTRICAL/
PLUMBING ENGINEER

DODGEVILLE PUBLIC LIBRARY - RENOVATION

139 S IOWA ST,
DODGEVILLE, WI. 53533

NO	DESCRIPTION	DATE

ISSUANCE HISTORY - THIS SHEET

HGA NO: 3757-004-00

OVERALL EXTERIOR ELEVATIONS

DATE: MARCH 21, 2025

CONSTRUCTION DOCUMENTS

A400

© COPYRIGHT HAMMEL, GREEN AND ABRAHAMSON, INC.

3/21/2025 11:19:41 AM Autodesk Docs://Dodgeville-Public-Library_3757-004-00/324-Dodgeville Library_3757-004-00.rvt