

January 18, 2025

Mr. Sean Homyen Planning & Zoning Administrator City of the Village of Douglas 86 W Center Street Douglas, MI 49406-0757

Re: Golfview Drive Reconstruction
Westshore Condominiums
City of the Village of Douglas, Allegan County

Dear Sean:

Enclosed are the following documentation for the reconstruction of Golfview Drive:

- As-built record plans. These are a revision to the previously published record plans.
- Inspection and testing reports from October 7 thru October 11, 2024, during the course of the field construction work.
- Engineers certificate.

Based on Ken Bosma's email dated February 20, 2024, we provide the following comments:

- Soils and Structures must be on site as note in the Special Conditions 1.
 - Soils & Structures completed all inspection and testing per the approved plans and their initial report dated December 20, 2023.
- An Engineer's Certificate will need to be provided to the City that the complete improvements were completed be the approved specifications and drawings.
 - This is included with this submittal.
- Testing requirements are completed per the report and copies submitted to the City.
 - Soils & Structures completed all inspection and testing per the approved plans and their initial report dated December 20, 2023.
- Drain tiles are installed as noted in the "Drainage Considerations for Pavement Areas" of Soils and Structures report. (We note that the proposal did not include any of this.)
 - The only drain tile that was added was at the existing catchbasin at the end of the road. Based on Soils & Structures inspection and contractor proof rolling on October 8, 2024, no additional drain tiles were necessary.

- If Option 2 Crush and Shape is chosen, any reduction in valley curb due to increase in road height shall be reviewed that drainage is not increased at driveway location.
 - This option was not used. Full depth mill and overlay (Option 3) was implemented.
- All "soft spots", if any, will be addressed as noted per Soils and Structures report. (We note the proposal does not appear to include any of this work.)
 - No soft spots were encounter during the work as documented by the Soils & Structures inspection and testing reports.
- The record drawings will need to be provided to indicate when the road work was completed, include any added drainage items, and submit to the City.
 - As built record plans are included with this submittal.

We request review and approval of the abovementioned documents at your earliest convenience.

If you have any questions or need additional information, please contact me at (616) 575-5190 or via email at jbarr@nederveld.com.

Sincerely,

Jack Barr, P.E.

Director of Engineering

Enclosures

cc: Ken Bosma P.E. - Prein & Newhof

Ric Dyk - BDR



Project Title: Golfview Drive Reconstruction **Project No.:** 2024.2038 **Project Location:** Date: 10/07/2024 Douglas, MI Client: **BDR Inc** Weather: Sunny Inspected By: Marlee Lechner Temperature (°F): 61

Type of Inspection:	Х	Soil	Concrete	Masonry
	Χ	Pavement	Steel	Other: X


Summary of Work Performed, Observations and Recommendations:

Soils & Structures arrived onsite to observe Dykgraaf Excavating remove approximately 18,929 square feet of asphalt. Dykgraaf excavating utilized a CAT D5G XL Bulldozer to remove the asphalt and a Komatsu WA320 Front Loader to haul the asphalt to dump trucks to be hauled offsite. A CAT 304 mini excavator and a CAT 255 skidsteer were also used to aid in the removal of the asphalt.

Soils & Structures performed hand auger depth checks on the aggregate base to verify 8" of aggregate base is present throughout the site. Five hand augers were performed with depths of aggregate base ranging between 9 and 11 inches.



Ann Arbor Muskegon Traverse City Upper Peninsula (800) 933-3959

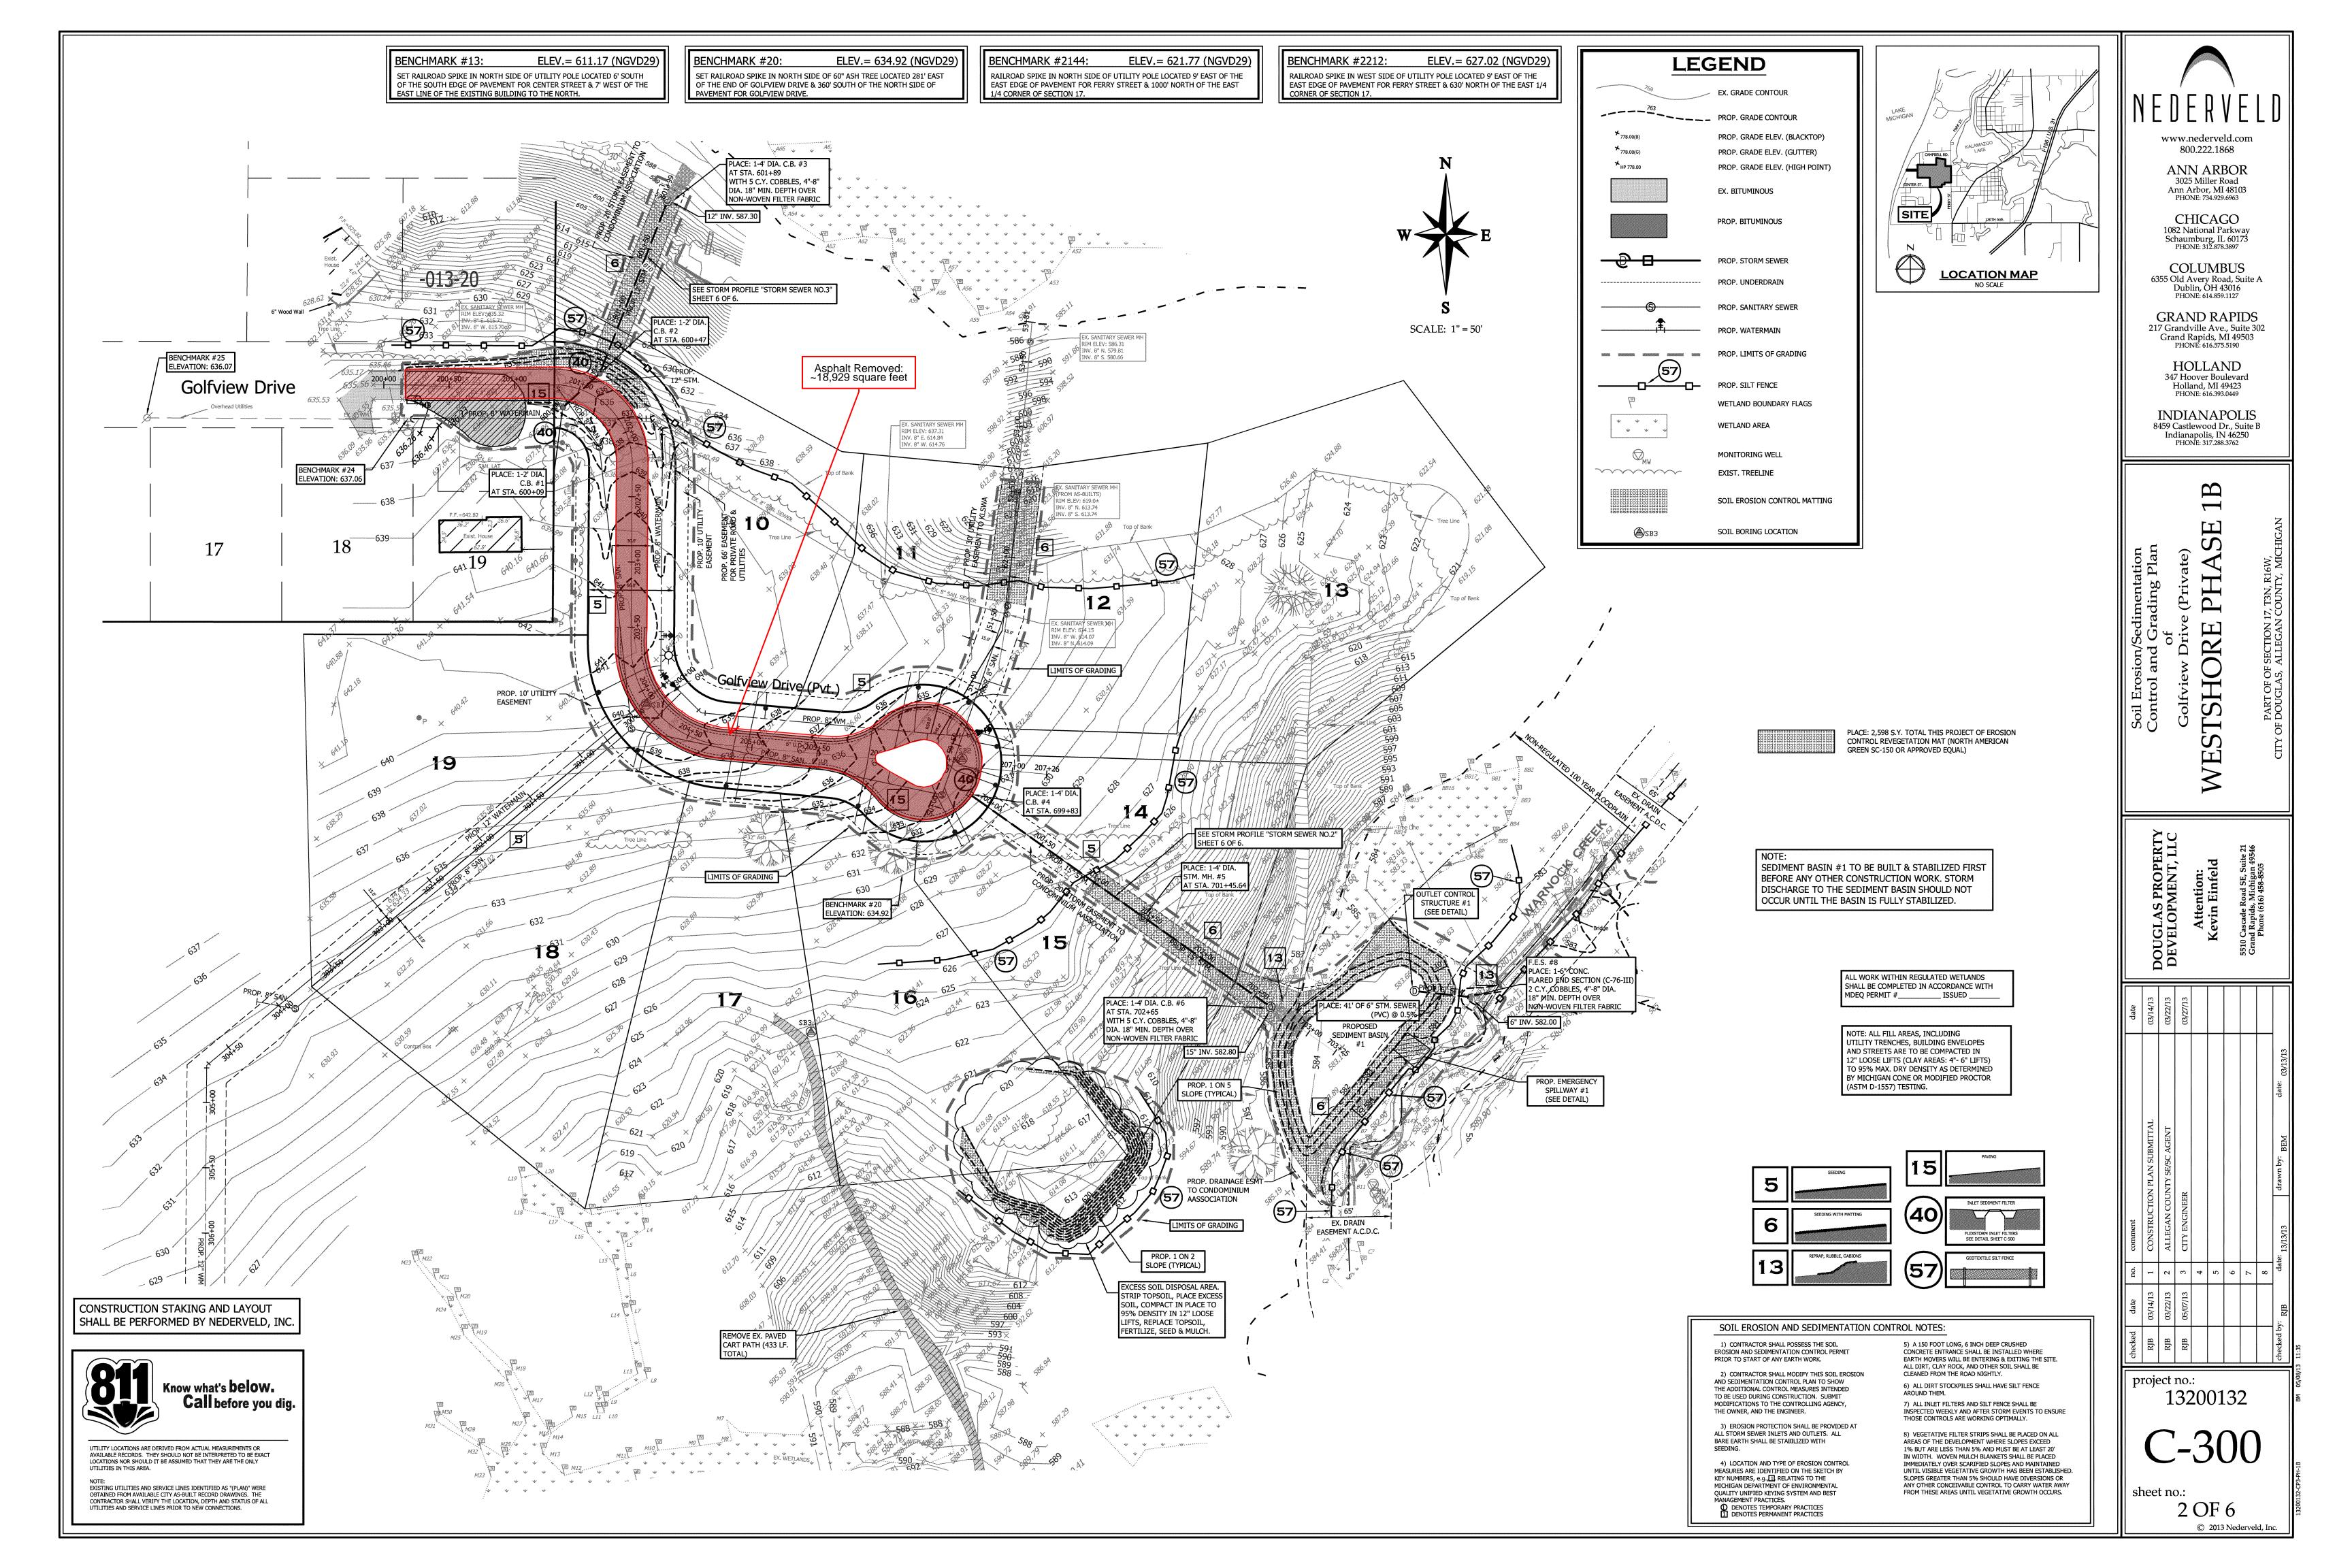



Project Title: Golfview Drive Reconstruction **Project No.:** 2024.2038 **Project Location:** 10/08/2024 Douglas, MI Date: Client: BDR Inc Weather: Sunny Inspected By: Marlee Lechner Temperature (°F): 62

Type of Increation.	Х	Soil	Concrete	Masonry
Type of Inspection:		Pavement	Steel	Other: X

Summary of Work Performed, Observations and Recommendations:

Soils and Structures arrived onsite to observe Dykgraaf Excavating install ring wrap at the catch basin in the easternmost section of the work area. Dykgraaf excavating also rough graded and compacted the site.


Dykgraaf Excavating utilized the CAT 304 mini excavator to dig out the trench for the ring wrap. The trench was lined with nonwoven geotextile fabric. The ring wrap was surrounded by pea stone. The fabric was wrapped around the ring wrap and pea stone before being covered up with the aggregate base. The curb inlet casting was adjusted to lower the finished elevation. Dykgraaf Excavating sealed the ring wrap penetration and the casting to the catch basin with grout. The aggregate base was compacted with a Wacker Neuson plate compactor.

Dykgraaf Excavating used a CAT D5G XL Bulldozer to rough grade the aggregate base and a CAT CS54 vibratory smooth drum roller for compaction.

Dykgraaf Excavating performed a proof roll with a fully loaded dump truck over the aggregate base, no pumping, rutting, or deflection was observed.



Ann Arbor Muskegon Traverse City Upper Peninsula (800) 933-3959

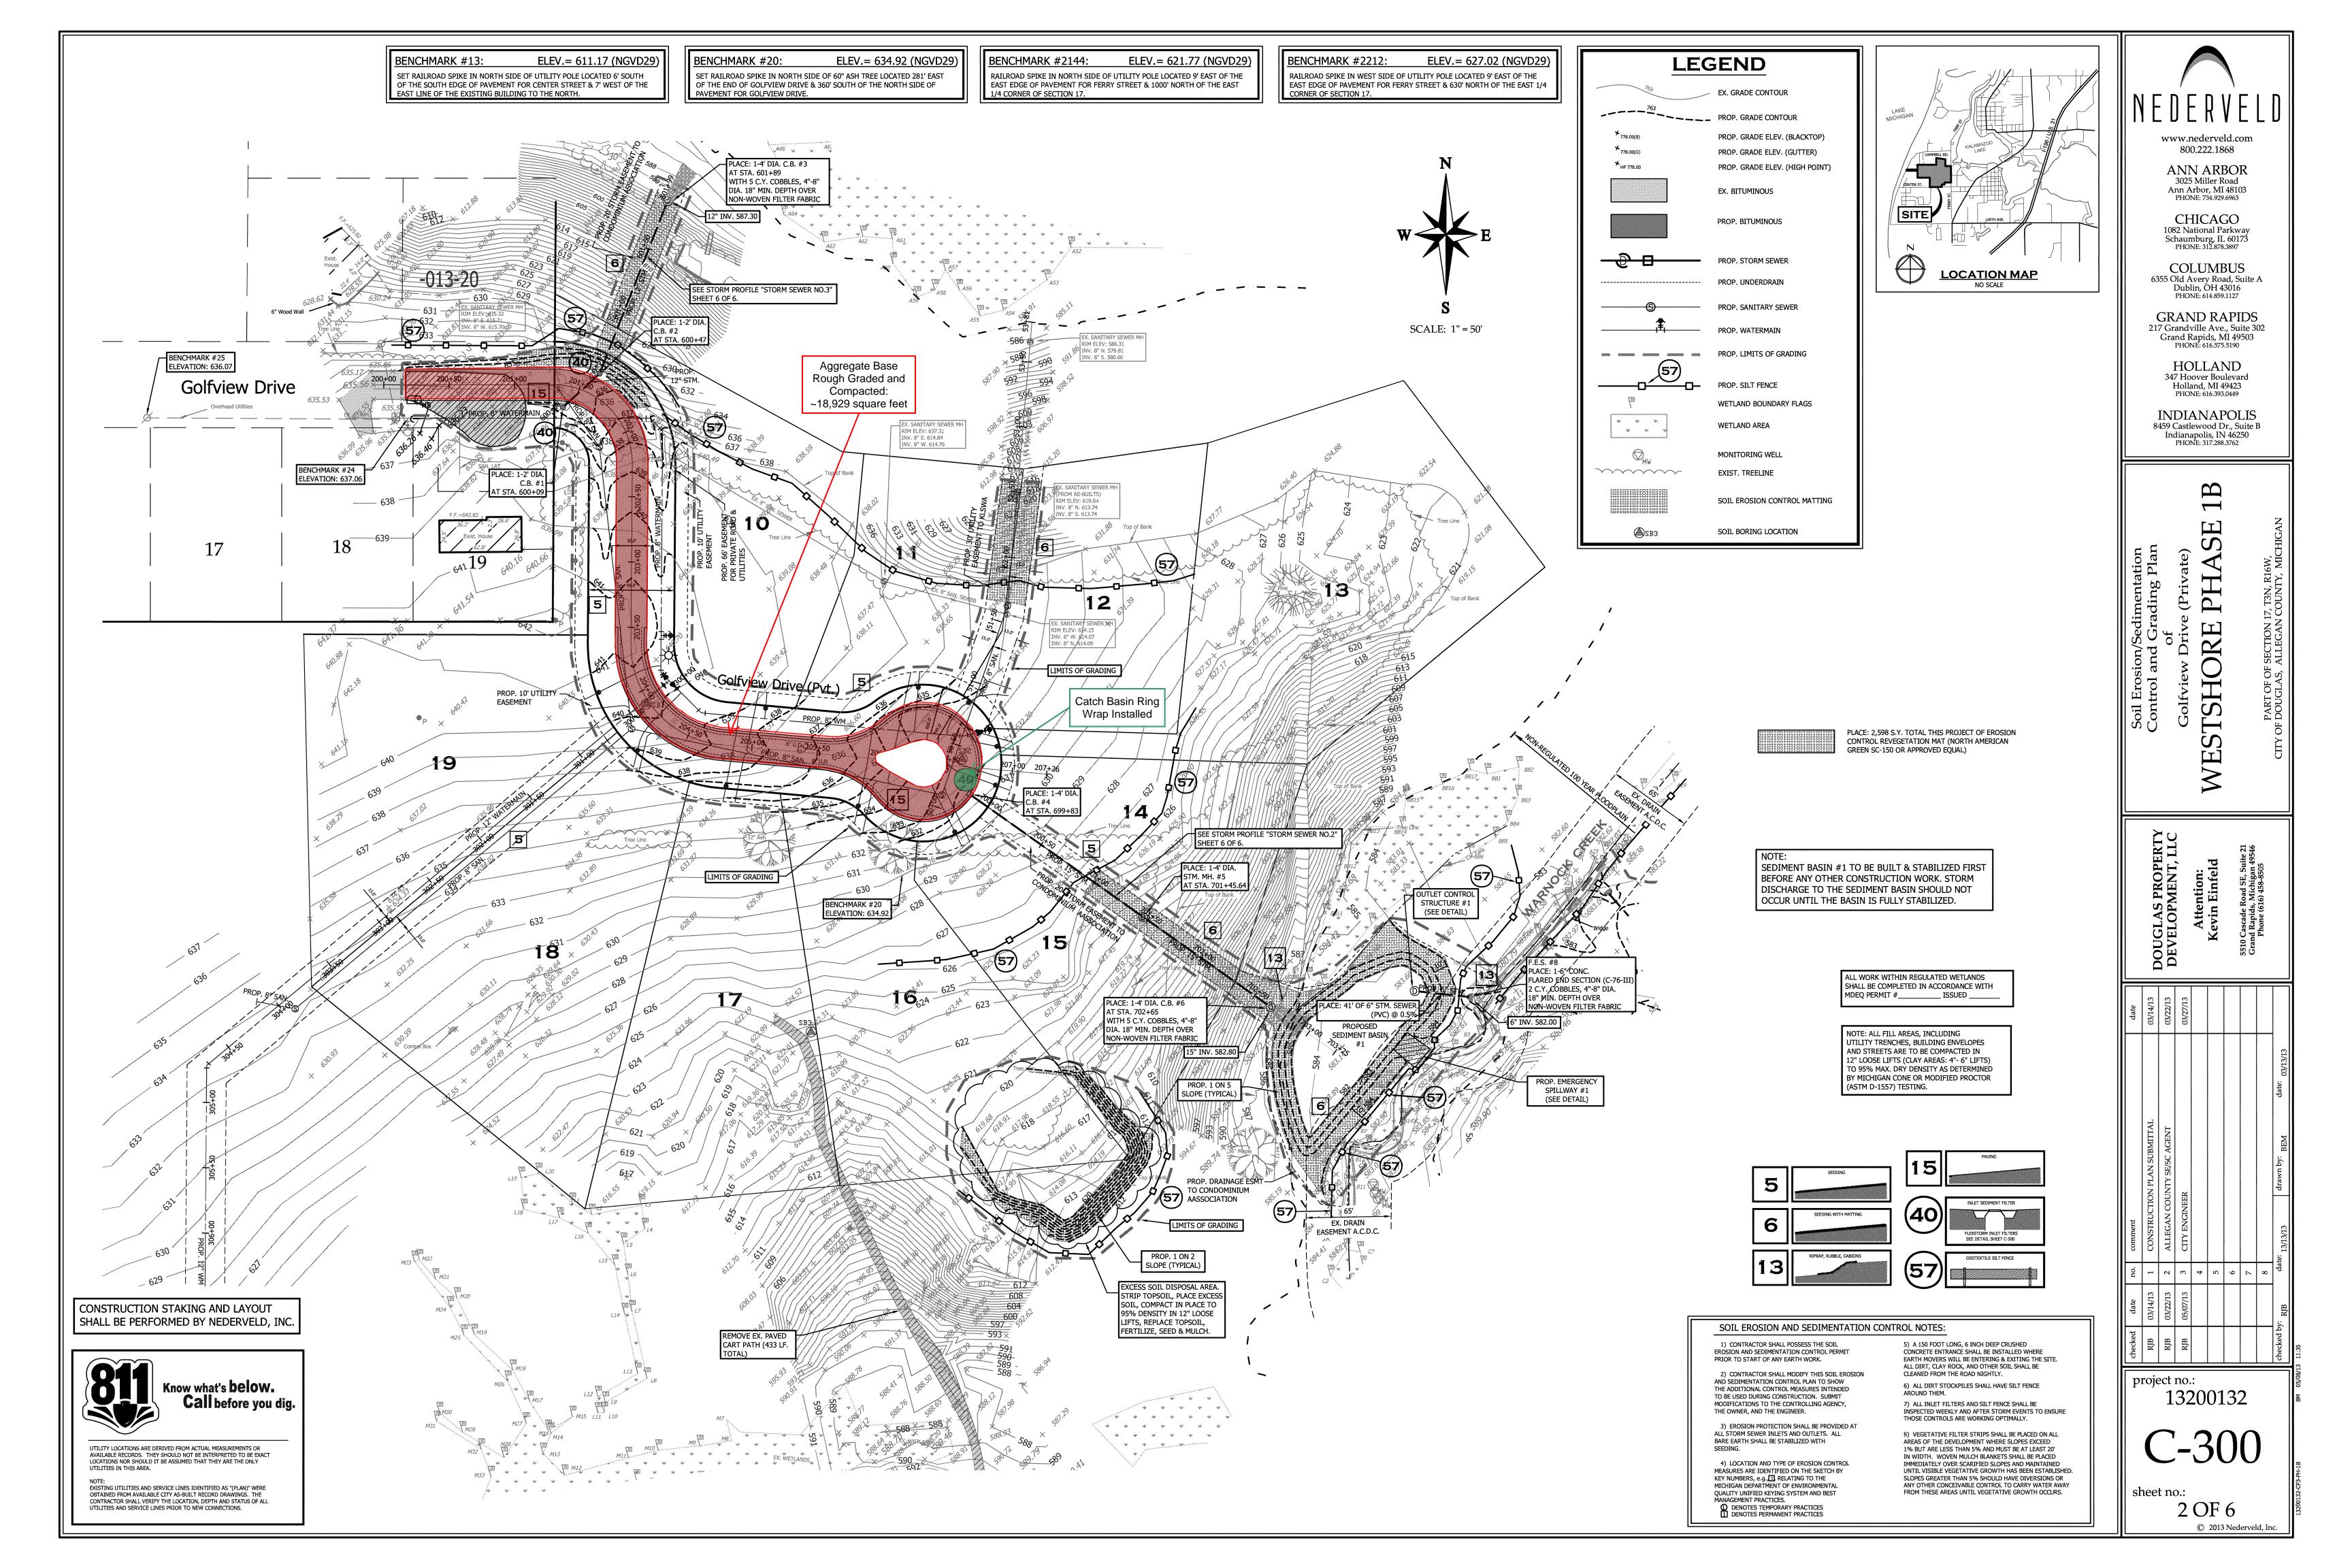



Project Title: Golfview Drive Reconstruction **Project No.:** 2024.2038 **Project Location:** Date: 10/09/2024 Douglas, MI Client: **BDR Inc** Weather: Sunny Inspected By: Marlee Lechner Temperature (°F): 61


Type of Inspection:	Х	Soil	Concrete	Masonry
		Pavement	Steel	Other: X

Summary of Work Performed, Observations and Recommendations:

Soils and Structures arrived onsite to observe Bruce's Blacktop finish grade the aggregate base and Dykgraaf Excavating perform final compaction.

Dykgraaf Excavating supplied a sanitary sewer casting to replace one that was damaged during construction operations near the westernmost section of the work area. Dykgraaf Excavating removed the damaged casting and installed the new casting on the manhole. The casting connection was sealed with grout.

Bruce's Blacktop used a Takeuchi TL230 skidsteer with a grader attachment to finish grade the aggregate base and Dykgraaf Excavating used CAT CS54 vibratory smooth drum roller for compaction. Minimal material was removed from the site to reach final grade.

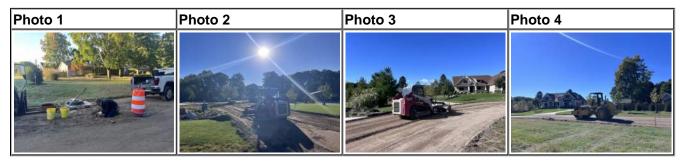

Ann Arbor Muskegon Traverse City Upper Peninsula (800) 933-3959



File No.	2024.2038
Project	Golfview Drive Reconstruction
Date	10/09/2024
Arrival Time	11:10 AM
Tested By	Jalen Salazar
Ordered By	BDR Inc

Test No.	Description of Soil	Max. Density (pcf)	Wet Density (pcf)	Water Content (%)	Dry Density (pcf)	Compaction (%)
1	Gravel : Brown	126.6	137.5	8.9	126.3	99.7
2	Gravel : Brown	126.6	138.1	10.0	125.5	99.2
3	Gravel : Brown	126.6	138.3	9.1	126.8	100.1
4	Gravel : Brown	126.6	134.8	7.7	125.2	98.9
5	Gravel : Brown	126.6	137.4	8.1	127.1	100.4
6	Gravel : Brown	126.6	139.4	7.3	129.9	102.6

—	T 4	D	A D	
Test		Probe	•	Location of Tests
No.	Elevation	Depth		
1	99.7	6	Aggregate Base : Roadway : Eastbound lane. : 723 Golfview Drive.	
2	99.7	6	Aggregate Base : Roadway : Westbound lane. : Next to the WestShore sign.	
3	99.7	6	Aggregate Base : Roadway : Eastbound lane. : 719 Golfview Drive.	ALAMAN .
4	99.7	6	Aggregate Base : Roadway : Westbound lane. : 711 Golfview Drive.	
5	99.7	6	Aggregate Base : Roadway : Eastbound lane. : 798 Golfview Drive.	
6	99.7	6	Aggregate Base : Roadway : Westbound lane. : 699 Golfview Drive.	
Elev	ation Ref.: 1	00.0 = F	- Asphalt	the second
Com	paction Met	t hod: Vil	oratory Roller	
Lift 7	Γhickness (i	nches):	8" If Observed: No	
Wea	ther: Sunny		Temperature (F°): 57	


Test Results Reported To Dykgraaf Excavating

- \boldsymbol{X} Does Meet 98% compaction specifications where tested.
- $\underline{\ }$ Does not meet compaction specifications where tested. Action taken: .

Remarks:

DISCLAIMER: The above tests are only intended to represent the soil and elevation which was tested. They are not a substitute for a complete soil investigation.

Ann Arbor Muskegon Traverse City Upper Peninsula (800) 933-3959

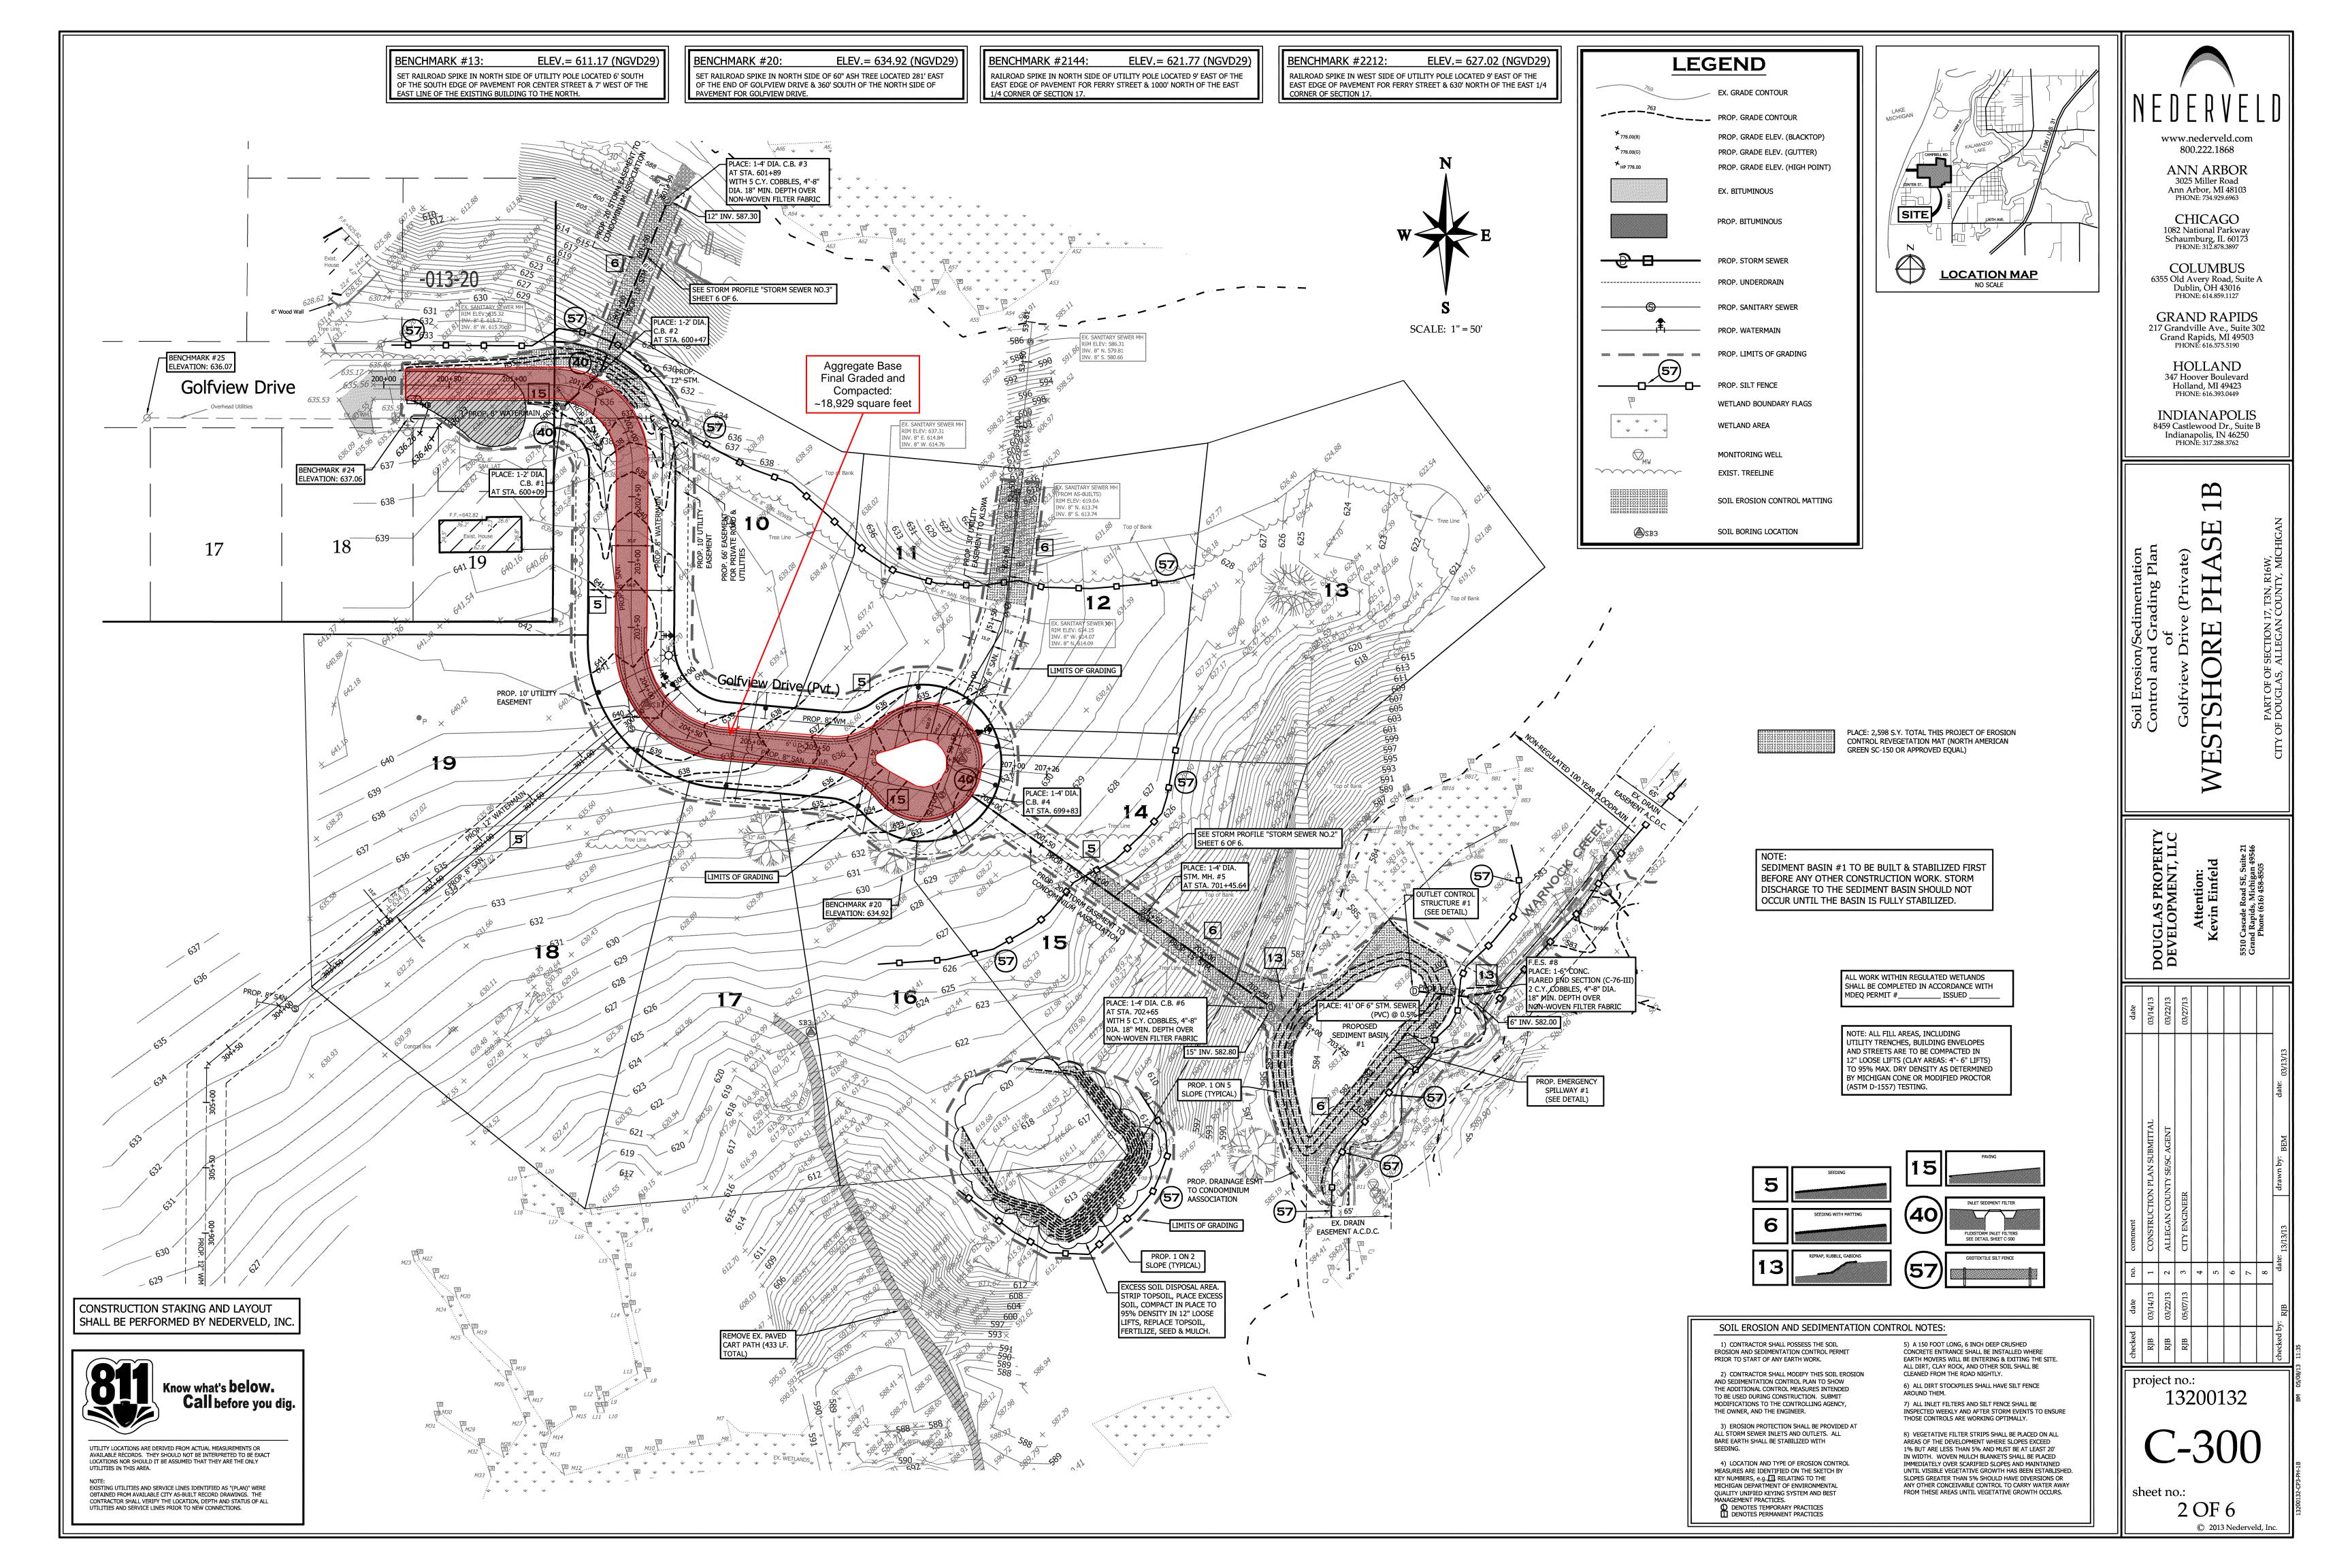



Project Title: Golfview Drive Reconstruction **Project No.:** 2024.2038 **Project Location:** Date: 10/10/2024 Douglas, MI Client: **BDR Inc** Weather: Sunny Inspected By: Jalen Salazar Temperature (°F): 60

Type of Inapportion.		Soil	Concrete	Masonry
Type of Inspection:	Χ	Pavement	Steel	Other:

Summary of Work Performed, Observations and Recommendations:

Soils & Structures arrived onsite to observe Bruce's Blacktop perform paving operations for the asphalt leveling course. The leveling course was installed from 723 Golfview Drive to 702 Golfview Drive - approximately 18,929 square feet . Bruce's Blacktop performed the work using a Carlson CP130 rubber track paver. A Volvo DD30B vibratory roller was used for primary compaction, and a Wacker Neuson RD12 vibratory roller was used for secondary compaction of the hot-mix asphalt. Asphalt temperatures ranged from 280 to 295 degrees Fahrenheit as measured with an infrared thermometer at the hopper of the paver.

Asphalt Material Type: 4EML

Design Thickness: 2 inches

Area: 2,103 Square Yards

Tonnage Placed: 217.44 tons

Calculated Yield: 1.88 inches



Ann Arbor Muskegon Traverse City Upper Peninsula (800) 933-3959



File No.	2024.2038
Project	Golfview Drive Reconstruction
Date	10/10/2024
Arrival Time	12:16 PM
Tested By	Jalen Salazar
Ordered By	BDR Inc

Test No.	Description of Soil	Max. Density (pcf)	Wet Density (pcf)	Water Content (%)	Dry Density (pcf)	Compaction (%)
1	Asphalt : 4EML	157.5	148.2	6.7	138.9	94.1
2	Asphalt : 4EML	157.5	152.4	6.2	143.5	96.8
3	Asphalt : 4EML	157.5	151.1	6.8	141.5	95.9
4	Asphalt : 4EML	157.5	149.0	5.5	141.2	94.6
5	Asphalt : 4EML	157.5	152.7	6.0	144.1	97.0
6	Asphalt : 4EML	157.5	153.4	6.1	144.6	97.4
7	Asphalt : 4EML	157.5	149.8	6.8	140.3	95.1

	1			
Test	Test	Probe	Area Represented	Location of Tests
No.	Elevation	Depth	= = = = = = = = = = = = = = = = = = =	
1	99.8	BS	Asphalt Base : Roadway : 723 Golfview Drive. : Eastbound lane.	
2	99.8	BS	Asphalt Base : Roadway : Next to the West Shore sign. : Eastbound lane.	
3	99.8	BS	Asphalt Base : Roadway : 719 Golfview Drive. : Eastbound lane.	
4	99.8	BS	Asphalt Base : Roadway : 711 Golfview Drive. : Eastbound lane.	
5	99.8	BS	Asphalt Base : Roadway : 707 Golfview Drive. : Eastbound lane.	
6	99.8	BS	Asphalt Base : Roadway : 702 Golfview Drive. : Eastbound lane.	
7	99.8	BS	Asphalt Base : Roadway : 716 Golfview Drive. : Eastbound lane.	
Elev	ation Ref.: 1	00.0 = F	F. Asphalt	
Com	paction Me	t hod: Vil	oratory Roller	
Lift -	Γhickness (i	nches):	2" If Observed: Yes	
Wea	ther: Sunny		Temperature (F°): 60	

Test Results Reported To Bruce's Blacktop

- \boldsymbol{X} Does Meet 94% compaction specifications where tested.
- _ Does not meet compaction specifications where tested. Action taken: .

Remarks:



File No.	2024.2038
Project	Golfview Drive Reconstruction
Date	10/10/2024
Arrival Time	01:26 PM
Tested By	Jalen Salazar
Ordered By	BDR Inc

Test No.	Description of Soil	Max. Density (pcf)	Wet Density (pcf)	Water Content (%)	Dry Density (pcf)	Compaction (%)
1	Asphalt : 4EML	157.5	152.8	6.4	143.6	97.0
2	Asphalt : 4EML	157.5	150.4	7.0	140.6	95.5
3	Asphalt : 4EML	157.5	148.7	6.6	139.5	94.4
4	Asphalt : 4EML	157.5	153.0	6.2	144.1	97.1
5	Asphalt : 4EML	157.5	151.2	5.8	142.9	96.0
6	Asphalt : 4EML	157.5	153.3	6.4	144.1	97.3
7	Asphalt : 4EML	157.5	150.6	5.8	142.3	95.6

Test No.	Test Elevation	Probe Depth		Location of Tests
1	99.8	BS	Asphalt Base: Roadway: 723 Golfview Drive.: Westbound lane.	
2	99.8	BS	Asphalt Base : Roadway : Next to the West Shore sign. : Westbound lane.	
3	99.8	BS	Asphalt Base : Roadway : 719 Golfview Drive. : Westbound lane.	
4	99.8	BS	Asphalt Base : Roadway : 711 Golfview Drive. : Westbound lane.	
5	99.8	BS	Asphalt Base : Roadway : 707 Golfview Drive. : Westbound lane.	
6	99.8	BS	Asphalt Base : Roadway : 702 Golfview Drive : Westbound lane.	
7	99.8	BS	Asphalt Base : Roadway : 716 Golfview Drive. : Westbound lane.	
Elev	ation Ref.: 1	00.0 = F	- Asphalt	
Com	paction Met	t hod: Vil	oratory Roller	
Lift -	Γhickness (i	nches):	2" If Observed: Yes	
Wea	ther: Sunny		Temperature (F°): 60	

Test Results Reported To Bruce's Blacktop

- \boldsymbol{X} Does Meet 94% compaction specifications where tested.
- _ Does not meet compaction specifications where tested. Action taken: .

Remarks:



REPORT OF COMPACTED HMA CORE DENSITY & PERCENT COMPACTION

ONTROL SECTION	JOB NUMBER	PROJECT	LOCATION	١					MIXTURE TYPE	MIX DES	IGN No.	REPORT	NUMBE	
	2024.2038			Golfview	Drive Reco	nstruction			4EML	4EM	4EMLT2B4		1	
ONTRACTOR		•			PLANT NU	JMBER		PLANT LC						
	Bruces Blac	ktop				55-01			Wayland					
ROJECT ENGINEER		NAME OF	TESTER (F	Please Prin	t)	Tester (Sig	nature)	•	QUALIF	FICATION NU	TION NUMBER		MBER	
Nederv	/eld		Matthew N	/IcClendon						0552-022	5	1		
	DATE		10/10/24	10/10/24	10/10/24		10/10/24	10/10/24						
ore Thickness Prior to	Trimming		1 1/2"	1 7/8"	1 7/8"		2"	1 5/8"						
SUBLOT NUM	BER / CORE LETT	ER	1A	1B	1C		JC 1	JC 2						
. WEIGHT OF CORE	(in water), grams		789.2	867.5	876.3		677.2	585.8						
. WEIGHT OF CORE	(surface dry), grar	ns	1380.4	1533.1	1537.3		1247.0	1083.4						
. WEIGHT OF CORE	E & PAN (oven dry)	, grams	1374.4	1522.2	1526.8		1222.8	1061.0						
. WEIGHT OF PAN,	grams													
. WEIGHT OF CORE	(C - D), grams		1374.4	1522.2	1526.8		1222.8	1061.0						
. VOLUME OF CORE	E (B - A), cc		591.2	665.6	661.0		569.8	497.6						
. CORE SPECIFIC G	GRAVITY (E / F)		2.325	2.287	2.310	2.146 2.132								
. SUBLOT Gmm (2)T	TEST RESULTS			2.4	199			2.4	499					
% CORE COMPACT	ΓΙΟΝ (G / H) x 100		93.0%	91.2%	92.4%		85.8%	85.3%						
SUBLOT % CORE (•			•	00/			<u> </u>		
Average of cores) . LOT AVERAGE DE	NSITY ublots in lot)		92	2%			81	6%						


DAILY REPORT OF HMA PLANT INSPECTION



Geotechnical Engineering | Pavement Design Services Structural Steel Detailing | Structural Engineering | Structural Engi

Michigan Departement of Transportation 1903 (09/04)

CONTROL SECTION	CONTROL SECTION			Job Num	ber			JOB LOC	ATION			PROJECT ENGINEER			
					2024	4.2038		G	Solfview	Drive Reconstr	ruction		Neder	veld	
CONTRACTOR						PLANT N	IUMBER		PLANT L	OCATION			Report Number	DATE SAMPLED	
	Bruc	es Bla	cktop				55-01			Wayla	and		1	10/10/2024	
			FIELD	TEST RES	ULTS				1	MATERIAL LAB SAM			PROJECT PRODU	ICTION RECORD	
			PE OF TURE		MIX IGN No.	TYPE OF MIXTURE			MIX IGN No.		TIME TA	AKEN	DAILY TONS	ACCUMULATED TONS	
EXTRACTION NUMBER		4EML		4EM	4EMLT2B4		4EML		LT2B4	BASE LEVELING TOP			75 / 200		
		JMF		DEV.	TOL.	JMF	ACTUAL	DEV.	TOL.	101	<u> </u>				
ASPHALT %		5.30	5.65	0.35	-0.30	5.30	5.58	0.28	-0.30	FILLER					
P. 1-1/2" (37.5 mm) %		100.0	100.0	0.0	±5.0	100.0	100.0	0.0	±5.0	ASPHALT BINDER					
P. 1" (25.0 mm) % 100.0 1			100.0	0.0	±5.0	100.0	100.0	0.0	±5.0	AGGREGATE MOIS	GGREGATE MOISTURE CONTENT		•		
P. 3/4" (19.0 mm) %		100.0	100.0	0.0	±5.0	100.0	100.0	0.0	±5.0	MATERIAL	TIME	%	MINE	MINERAL FILLER	
P. 1/2" (12.5 mm) %			93.7	2.4	±5.0	91.3	94.1	2.8	±5.0				7		
P. 3/8" (9.5 mm) %		85.8	88.0	2.2	±5.0	85.8	89.5	3.7	±5.0				P. No. 30 (600 µm)		
P. No. 4 (4.75 mm) %		66.7	70.2	3.5	±5.0	66.7	70.6	3.9	±5.0				P. No. 200 (75 μm)		
P. No. 8 (2.36 mm) %		51.9	54.1	2.2	±5.0	51.9	54.7	2.8	±5.0	PLANT OPR. START	END		LOST TIME	ACTUAL HRS. OPR.	
P. No. 30 (600 µm) %		28.5	28.2	-0.3	±4.0	28.5	28.3	-0.2	±4.0						
P. No. 200 (75 μm) %		5.3	5.6	0.3	±1.0	5.3	5.4	0.1			•		EXTRACTOR NUMB	ER	
CRUSHED %		97.8	97.2	-1	-10%	97.8 97.3		-1 -10%							
	MIX / AGGRE	GATE BL	END PROPO	ORTIONS		TE	MPERATUR	RE	REMARKS:						
PIT NUMBER			NUFACTUR L, SUPPLIEF		TYPE MIXT	OF URE	TIME TAKEN	MIX	AIR						
49-65	3/4 x 1/2				12.0%	,									
95-05	29A				16.0%	,									
03-1001	2NS				12.0%	,									
92-0035	SLAG SAI	ND			13.0%	,									
75-05	3/32nd SA	ND			22.0%	,									
							X DRI	UM PLANT							
RECLAIMED	RAP / YA	RD (55-0	1)		25.0%	,	BA	TCH PLANT		QUALIFICATION NU	JMBER				
FILLER		`	•				MIX TIME: DR	YWET		0552-0225					
ASPHALT BINDER 58-28 Ma		athon AE	SS 3505		4.13%			SPECTOR'S IcClendon	NAME (PF	RINT)	SIGNATURE			DATE TESTED 10/10/2024	

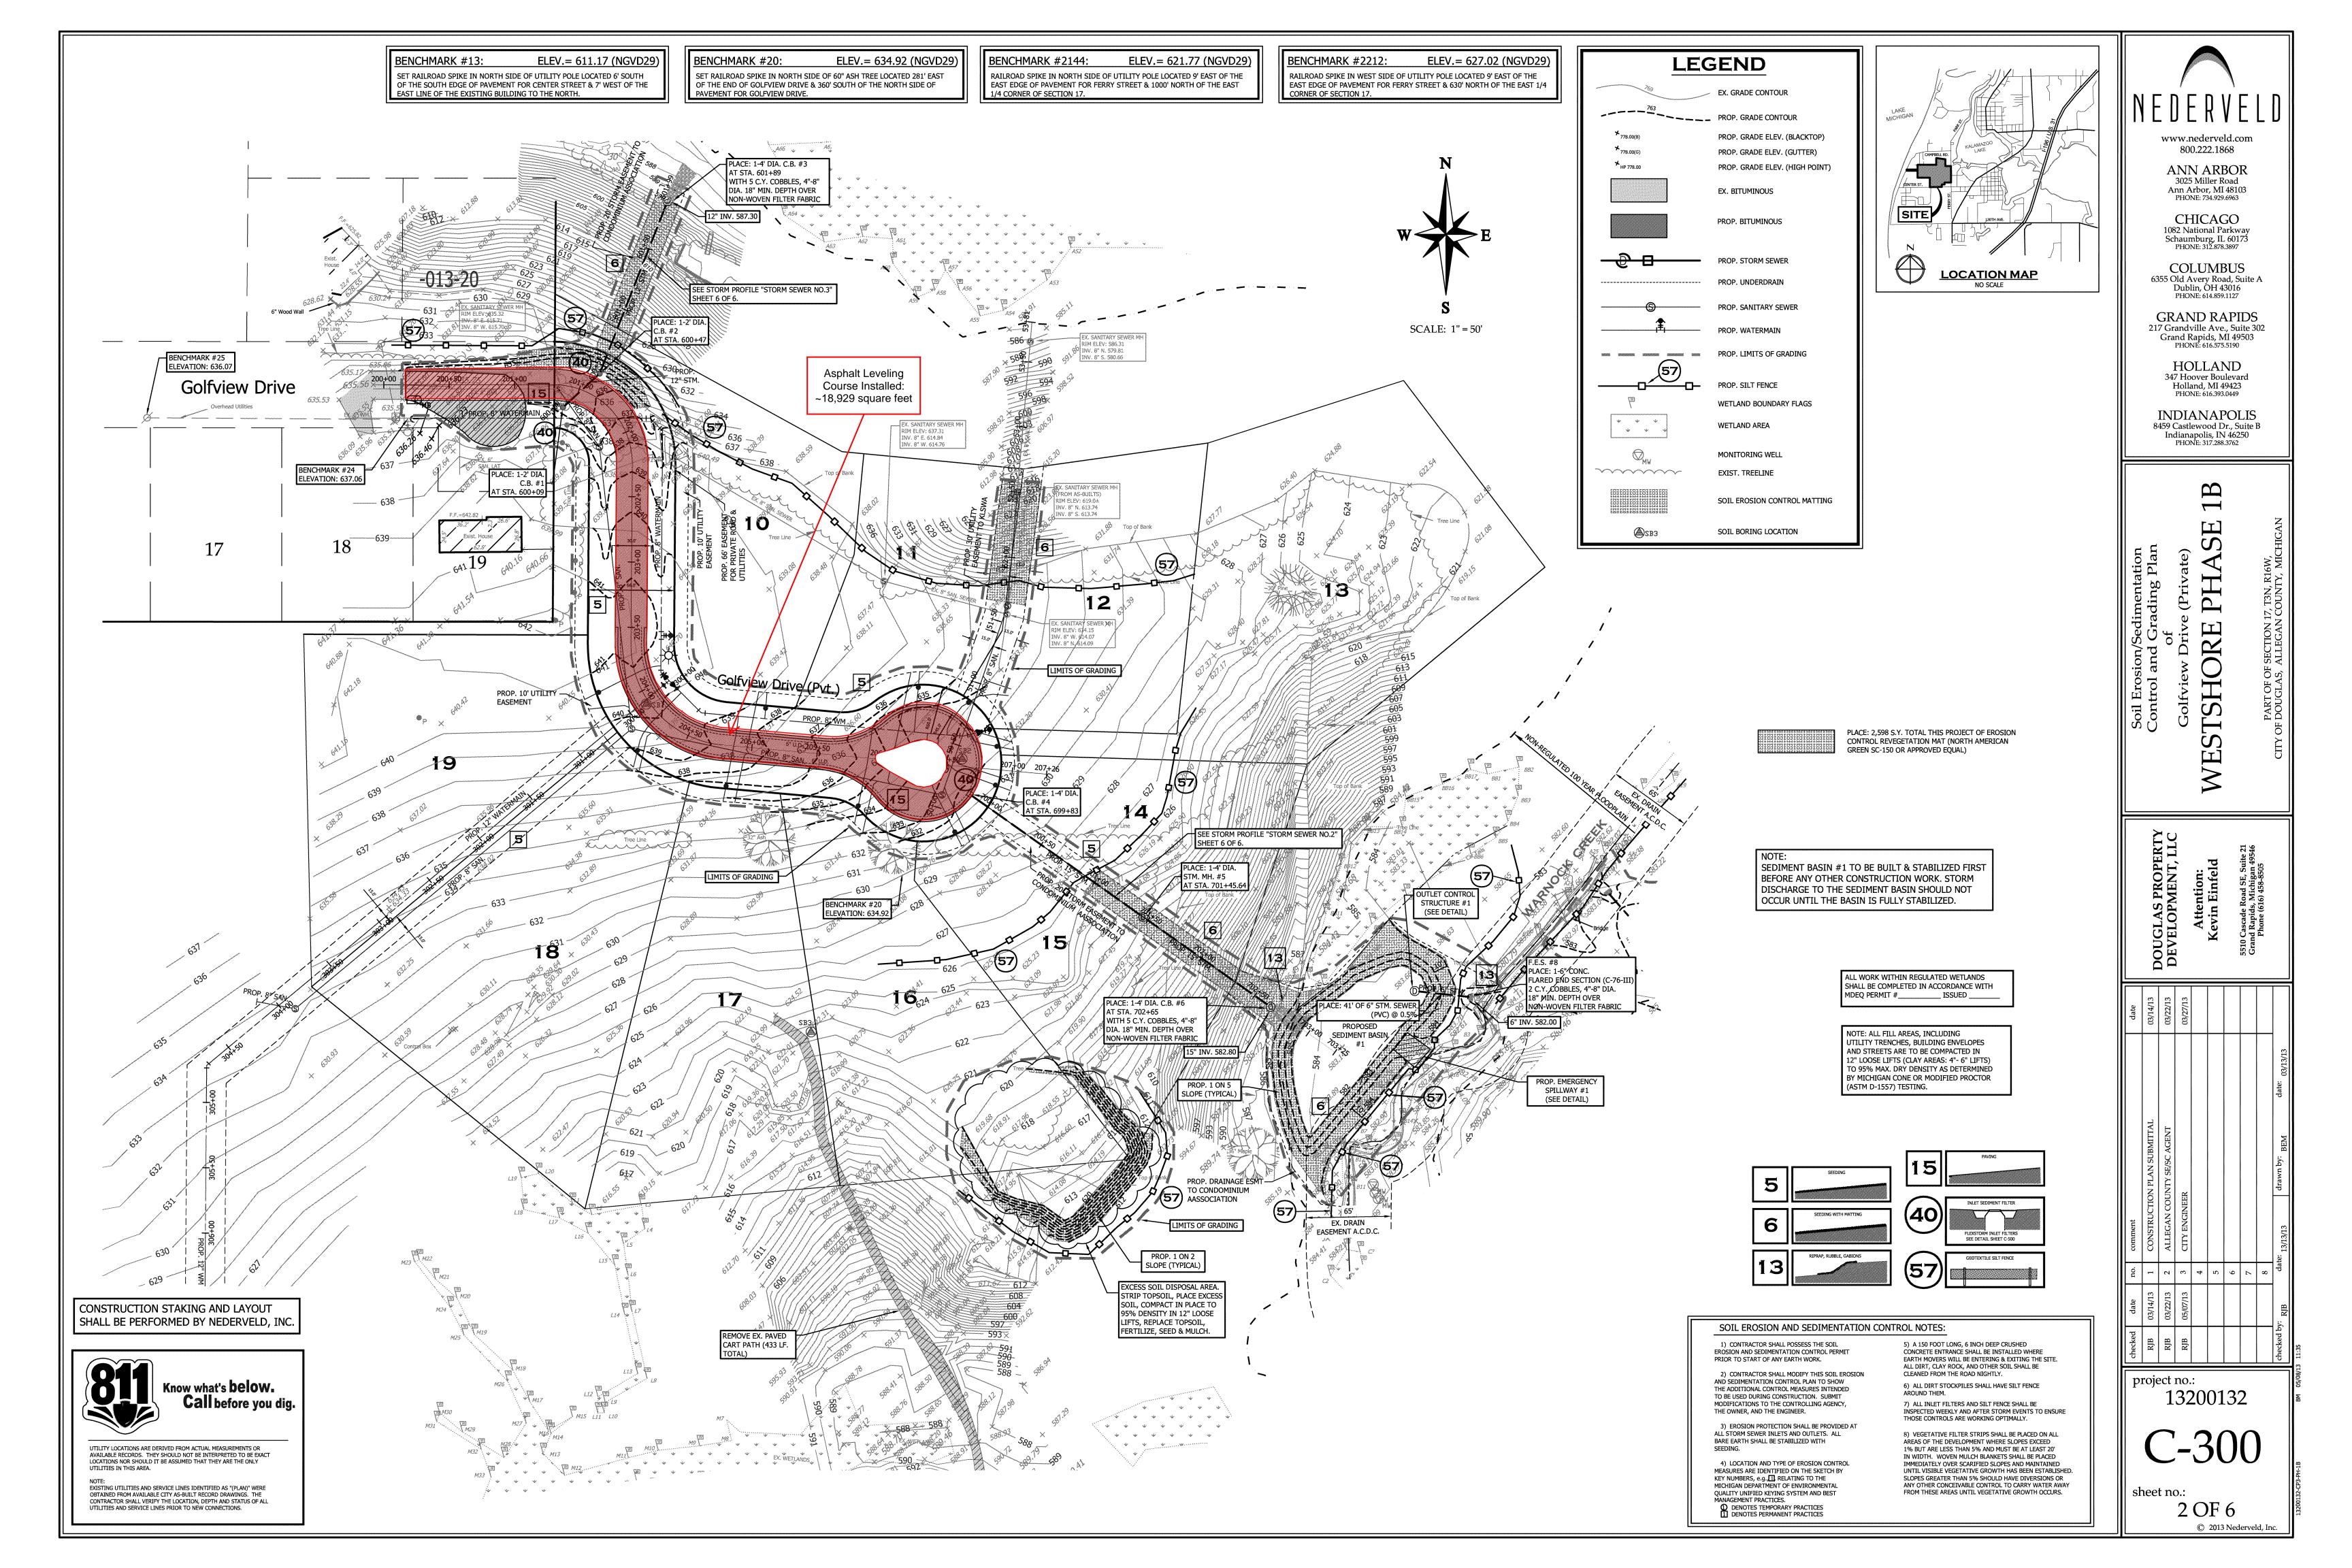



Project Title: Golfview Drive Reconstruction **Project No.:** 2024.2038 **Project Location:** Date: 10/11/2024 Douglas, MI Client: **BDR Inc** Weather: Sunny Inspected By: Jalen Salazar Temperature (°F): 70

Type of Inchestions		Soil	Concrete	Masonry
Type of Inspection:	X	Pavement	Steel	Other:

Summary of Work Performed, Observations and Recommendations:

Soils & Structures arrived on site to observe Bruce's Blacktop perform paving operations for the asphalt wearing course. Prior to the placement of hot mix asphalt, tack was applied to the surface of the asphalt leveling course. The wearing course was installed from 723 Golfview Drive to 702 Golfview drive - approximately 18,929 square feet. Bruce's Blacktop performed the work using a Carlson CP130 rubber track paver. A Volvo DD30B vibratory roller was used for primary compaction, a Wacker Neuson RD12 vibratory roller was used for secondary compaction of the hot-mix asphalt. Asphalt temperatures ranged from 290 to 315 degrees Fahrenheit as measured with an infrared thermometer at the hopper of the paver.

Bruce's Blacktop installed approximately 750 linear feet of 24 inch valley gutter in the easternmost half of the project.

Asphalt Material Type: 5EML

Design Thickness: 1.5 inches

Area: 2,103 Square Yards

Tonnage Placed: 228.5 tons

Calculated Yield: 1.98 inches



Ann Arbor Muskegon Traverse City Upper Peninsula (800) 933-3959



File No.	2024.2038
Project	Golfview Drive Reconstruction
Date	10/11/2024
Arrival Time	03:39 PM
Tested By	Jalen Salazar
Ordered By	BDR Inc

Test No.	Description of Soil	Max. Density (pcf)	Wet Density (pcf)	Water Content (%)	Dry Density (pcf)	Compaction (%)
1	Asphalt : 5EML	156.7	152.5	5.1	145.1	97.3
2	Asphalt : 5EML	156.7	150.4	5.7	142.3	96.0
3	Asphalt : 5EML	156.7	148.5	4.9	141.6	94.8
4	Asphalt : 5EML	156.7	148.5	4.8	141.7	94.8
5	Asphalt : 5EML	156.7	154.7	4.7	147.8	98.7
6	Asphalt : 5EML	156.7	148.4	4.4	142.1	94.7
7	Asphalt : 5EML	156.7	149.8	5.1	142.5	95.6

Test No.	Test Elevation	Probe Depth		Location of Tests
1	100.0	BS	Asphalt Top: Roadway: 723 Golfview Drive.: Eastbound lane.	
2	100.0	BS	Asphalt Top: Roadway: Next to the West Shore sign.: Eastbound lane.	
3	100.0	BS	Asphalt Top: Roadway: 719 Golfview Drive.: Eastbound lane.	
4	100.0	BS	Asphalt Top: Roadway: 711 Golfview Drive.: Eastbound lane.	
5	100.0	BS	Asphalt Top: Roadway: 707 Golfview Drive.: Eastbound lane.	
6	100.0	BS	Asphalt Top: Roadway: 702 Golfview Drive.: Eastbound lane.	
7	100.0	BS	Asphalt Top: Roadway: 716 Golfview Drive.: Eastbound lane.	
Elev	ation Ref.: 1	00.0 = F	F. Asphalt	
Com	paction Me	t hod: Vil	oratory Roller	
Lift	Thickness (i	nches):	1.5" If Observed: Yes	
Wea	ther: Sunny		Temperature (F°): 70	

Test Results Reported To Bruce's Blacktop

- \boldsymbol{X} Does Meet 94% compaction specifications where tested.
- _ Does not meet compaction specifications where tested. Action taken: .

Remarks:



File No.	2024.2038
Project	Golfview Drive Reconstruction
Date	10/11/2024
Arrival Time	04:49 PM
Tested By	Jalen Salazar
Ordered By	BDR Inc

Test No.	Description of Soil	Max. Density (pcf)	Wet Density (pcf)	Water Content (%)	Dry Density (pcf)	Compaction (%)
1	Asphalt : 5EML	156.7	152.1	5.2	144.6	97.1
2	Asphalt : 5EML	156.7	150.8	6.0	142.3	96.2
3	Asphalt : 5EML	156.7	151.0	5.8	142.7	96.4
4	Asphalt : 5EML	156.7	149.9	5.3	142.4	95.7
5	Asphalt : 5EML	156.7	151.4	5.2	143.9	96.6
6	Asphalt : 5EML	156.7	149.5	5.2	142.1	95.4
7	Asphalt : 5EML	156.7	150.4	5.5	142.6	96.0

Test	Test	Probe	Area Represented	Location of Tests
No.	Elevation		·	
1	100.0	BS	Asphalt Top: Roadway: 723 Golfview Drive.: Westbound lane.	
2	100.0	BS	Asphalt Top: Roadway: Next to the West Shore sign.: Westbound lane.	
3	100.0	BS	Asphalt Top : Roadway : 719 Golfview Drive. : Westbound lane.	
4	100.0	BS	Asphalt Top : Roadway : 711 Golfview Drive. : Westbound lane.	
5	100.0	BS	Asphalt Top : Roadway : 707 Golfview Drive. : Westbound lane.	
6	100.0	BS	Asphalt Top: Roadway: 702 Golfview Drive.: Westbound lane.	
7	100.0	BS	Asphalt Top : Roadway : 716 Golfview Drive. : Westbound lane.	
Elev	ation Ref.: 1	00.0 = F	. Asphalt	Marie Marie
Com	paction Met	:hod: Vil	oratory Roller	
Lift 7	Γhickness (i	nches):	1.5" If Observed: Yes	
Wea	ther: Sunny		Temperature (F°): 70	

Test Results Reported To Bruce's Blacktop

- \boldsymbol{X} Does Meet 94% compaction specifications where tested.
- _ Does not meet compaction specifications where tested. Action taken: .

Remarks:



REPORT OF COMPACTED HMA CORE DENSITY & PERCENT COMPACTION

CONTROL SECTION	CONTROL SECTION JOB NUMBER PROJECT LOCATION											GN No.	REPORT NUMBER		
	2024.2038			Golfview	Drive Reco	nstruction				EML	5EMLT2B4		2		
CONTRACTOR					PLANT NU	CATION									
	Bruces Blac	ktop			55-01					Wayland					
PROJECT ENGINEER		NAME OF	TESTER (Please Prin	t)	Tester (Signatu	ıre)			QUALIF	CATION NU	MBER	LOT NUMBER		
Neder	veld		Matthew N	AcClendon	1			1	1		0552-0225	5		1	
	DATE		10/11/24	10/11/24	10/11/24	10/	11/24	10/11/24							
Core Thickness Prior to	Trimming		1 5/8"	2"	1 3/4"	1	7/8"	1 3/4"							
SUBLOT NUM	IBER / CORE LETT	ER	1A	1B	1C	J	IC 1	JC 2							
A. WEIGHT OF CORI	E (in water), grams		909.5	1135.1	1021.5	9	07.4	915.3							
B. WEIGHT OF CORI	E (surface dry), grar	ns	1595.4	1955.5	1822.2	16	651.6	1687.8							
C. WEIGHT OF COR	E & PAN (oven dry)	, grams	1582.7	1950.7	1813.2	16	610.5	1641.0							
D. WEIGHT OF PAN,	grams														
E. WEIGHT OF CORI	E (C - D), grams		1582.7	1950.7	1813.2	16	610.5	1641.0							
F. VOLUME OF COR	E (B - A), cc		685.9	820.4	800.7	7	44.2	772.5							
G. CORE SPECIFIC	GRAVITY (E / F)		2.307	2.378	2.265	2	.146	2.124							
H. SUBLOT Gmm (2)	TEST RESULTS			2.	525			2.	525						
I. % CORE COMPAC			91.4%	94.2%	89.7%	8	5.0%	84.1%							
J. SUBLOT % CORE (Average of cores)	COMPACTION			9:	2%			8!	5%						
K. LOT AVERAGE DE	ENSITY										II .				
(Sum of J / number of s	sublots in lot)														
Average Top Core Thic	kness = 1 3/4"														


DAILY REPORT OF HMA PLANT INSPECTION



Geotechnical Engineering | Pavement Design Services Structural Steel Detailing | Structural Engineering | Structural Engi

Michigan Departement of Transportation 1903 (09/04)

CONTROL SECTION	CONTROL SECTION				Job Number							PROJECT ENGINEER			
					202	4.2038		G	Solfview	Drive Reconstr	uction		Neder	veld	
CONTRACTOR						PLANT N	NUMBER		PLANT L	OCATION		1	Report Number	DATE SAMPLED	
	Bruc	es Bla	cktop				55-01			Wayland			2	10/11/2024	
			FIELD	TEST RES	ULTS					MATERIAL LAB SAM		MPLE PROJECT PRO		DDUCTION RECORD	
			PE OF CTURE		MIX IGN No.	TYPE OF MIXTURE			MIX IGN No.	_	TIME T	AKEN	DAILY TONS	ACCUMULATED TONS	
EXTRACTION NUMBER		5EML		5EM	5EMLT2B4		5EML		LT2B4	BASE LEVELING					
		JMF		DEV.	TOI	JMF	ACTUAL	DEV.	TO	TOP			75 / 100		
ASPHALT %			ACTUAL		TOL.				TOL.	FILLER					
P. 1-1/2" (37.5 mm) %		5.10	4.94 100.0	-0.16	-0.30 ±5.0	5.10	5.08 100.0	-0.02 0.0	-0.30 ±5.0	ASPHALT BINDER					
P. 1" (25.0 mm) %				0.0	±5.0 ±5.0	100.0		0.0		AGGREGATE MOIS	TUDE CONTEN	IT			
P. 3/4" (19.0 mm) %		100.0	100.0	0.0	±5.0	100.0	100.0	0.0	±5.0 ±5.0	MATERIAL		TIME % MINERAL FI		DAI EILLED	
P. 1/2" (12.5 mm) %		100.0	98.9	-1.1	±5.0	100.0	99.4	-0.6	±5.0	1.22		70	IVIIINE	NAL FILLEN	
P. 3/8" (9.5 mm) %		95.9	95.0	-0.9	±5.0	95.9	96.1	0.2	±5.0				P. No. 30 (600 µm)	T	
P. No. 4 (4.75 mm) %		70.2	66.6	-3.6	±5.0	70.2	67.3	-2.9	±5.0				P. No. 200 (75 μm)		
P. No. 8 (2.36 mm) %		49.5	48.5	-3.0	±5.0	49.5	50.0	0.5	±5.0	PLANT OPR. START	END		LOST TIME	ACTUAL HRS. OPR.	
P. No. 30 (600 µm) %		29.9	30.7	0.8	±4.0	29.9	31.4	1.5	±4.0	=					
P. No. 200 (75 µm) %		5.4	5.4	0.0	±4.0	5.4	5.6	0.2	±1.0	KIT NUMBER			EXTRACTOR NUMB	ER .	
CRUSHED %		95.2	95.1	0.0	±1.0 -10%	95.2	95.1 0		±1.0 -10%	- KIT HOMBER			EXTRACTOR NO.		
0.1001.125 //	MIX / AGGRE				1070			MPERATURE		REMARKS:					
	G	RADE. MA	NUFACTUR	ER	TYPE	E OF	TIME	1							
PIT NUMBER			L, SUPPLIE		MIXT	URE	TAKEN	MIX	AIR						
95-05	29A				26.0%	5									
03-1001	2NS				21.0%	5									
92-0035	SLAG SAI	ND			25.0%	5		1	+						
72 0033	SLAC SA	ND						1	+						
							X DRU	M PLANT		2024.2038, 240949	7 2409499				
RECLAIMED	RAP / YA	RD (55-0)1)		28.0%	5		CH PLANT		QUALIFICATION NU	,				
FILLER	1011 / 171	(55 0)				MIX TIME: DRY	/WET		0552-0225					
ASPHALT BINDER	58-28 Mar	athon AE	BS 3505		3.74%	5	PLANT INS		NAME (PF	RINT) S	SIGNATURE			DATE TESTED	
							Matthew Mo	cClendon						10/15/2024	

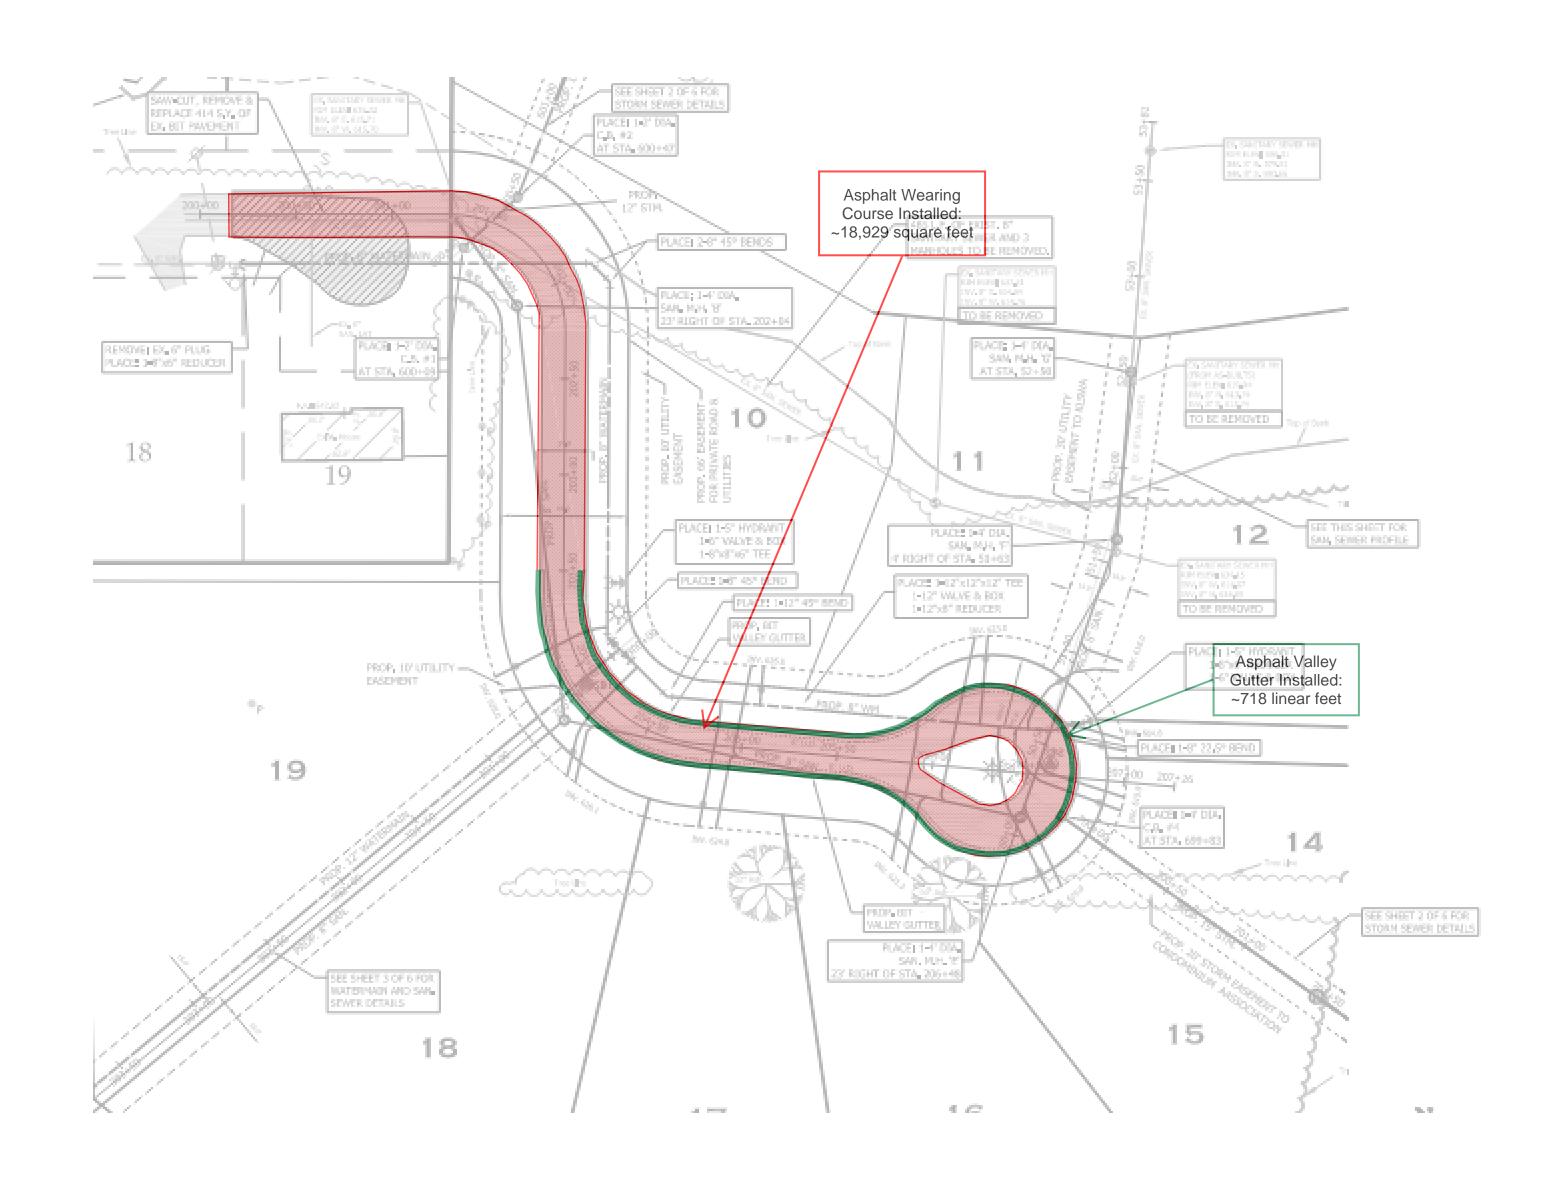



ENGINEER'S CERTIFICATE

DATE: <u>January 18, 2025</u>

PROJECT NAME:Westshore PUD – Golfview Drive R	Reconstruction	
MUNICIPALITY: City of the Village of Douglas		SECTION: <u>17</u>
I hereby certify that the removal and reconstruction of	the road pavement is compl	lete:
Exception(s): None		
And that:		
I have personally directed the supervision and inspection	on of the construction.	
All improvements have been installed in accordance w standards and specifications within the Soils & Structur		•
The construction materials meet the aforementioned s	pecifications.	
ROGER JACK BARR II License No. 6201041990	R. Jack Barr, P.E. Date: January 18, 2025 PE License # 620104199	



Project Title: Golfview Drive Reconstruction **Project No.:** 2024.2038 **Project Location:** Date: 10/07/2024 Douglas, MI Client: **BDR Inc** Weather: Sunny Inspected By: Marlee Lechner Temperature (°F): 61

Type of Inspection:	Х	Soil	Concrete	Masonry
	Χ	Pavement	Steel	Other: X

Summary of Work Performed, Observations and Recommendations:

Soils & Structures arrived onsite to observe Dykgraaf Excavating remove approximately 18,929 square feet of asphalt. Dykgraaf excavating utilized a CAT D5G XL Bulldozer to remove the asphalt and a Komatsu WA320 Front Loader to haul the asphalt to dump trucks to be hauled offsite. A CAT 304 mini excavator and a CAT 255 skidsteer were also used to aid in the removal of the asphalt.

Soils & Structures performed hand auger depth checks on the aggregate base to verify 8" of aggregate base is present throughout the site. Five hand augers were performed with depths of aggregate base ranging between 9 and 11 inches.



Ann Arbor Muskegon Traverse City Upper Peninsula (800) 933-3959



Project Title: Golfview Drive Reconstruction **Project No.:** 2024.2038 **Project Location:** Date: 10/08/2024 Douglas, MI Client: BDR Inc Weather: Sunny Inspected By: Marlee Lechner Temperature (°F): 62

Type of Inspection:	Х	Soil	Concrete	Masonry
		Pavement	Steel	Other: X

Summary of Work Performed, Observations and Recommendations:

Soils and Structures arrived onsite to observe Dykgraaf Excavating install ring wrap at the catch basin in the easternmost section of the work area. Dykgraaf excavating also rough graded and compacted the site.

Dykgraaf Excavating utilized the CAT 304 mini excavator to dig out the trench for the ring wrap. The trench was lined with nonwoven geotextile fabric. The ring wrap was surrounded by pea stone. The fabric was wrapped around the ring wrap and pea stone before being covered up with the aggregate base. The curb inlet casting was adjusted to lower the finished elevation. Dykgraaf Excavating sealed the ring wrap penetration and the casting to the catch basin with grout. The aggregate base was compacted with a Wacker Neuson plate compactor.

Dykgraaf Excavating used a CAT D5G XL Bulldozer to rough grade the aggregate base and a CAT CS54 vibratory smooth drum roller for compaction.

Dykgraaf Excavating performed a proof roll with a fully loaded dump truck over the aggregate base, no pumping, rutting, or deflection was observed.



Ann Arbor Muskegon Traverse City Upper Peninsula (800) 933-3959



Project Title: Golfview Drive Reconstruction **Project No.:** 2024.2038 **Project Location:** Date: 10/09/2024 Douglas, MI Client: **BDR Inc** Weather: Sunny Inspected By: Marlee Lechner Temperature (°F): 61

Type of Inspection:	Х	Soil	Concrete	Masonry
		Pavement	Steel	Other: X

Summary of Work Performed, Observations and Recommendations:

Soils and Structures arrived onsite to observe Bruce's Blacktop finish grade the aggregate base and Dykgraaf Excavating perform final compaction.

Dykgraaf Excavating supplied a sanitary sewer casting to replace one that was damaged during construction operations near the westernmost section of the work area. Dykgraaf Excavating removed the damaged casting and installed the new casting on the manhole. The casting connection was sealed with grout.

Bruce's Blacktop used a Takeuchi TL230 skidsteer with a grader attachment to finish grade the aggregate base and Dykgraaf Excavating used CAT CS54 vibratory smooth drum roller for compaction. Minimal material was removed from the site to reach final grade.



Ann Arbor Muskegon Traverse City Upper Peninsula (800) 933-3959



Project Title: Golfview Drive Reconstruction **Project No.:** 2024.2038 **Project Location:** Date: 10/10/2024 Douglas, MI Client: **BDR Inc** Weather: Sunny Inspected By: Jalen Salazar Temperature (°F): 60

Type of Inspection:		Soil	Concrete	Masonry
	Χ	Pavement	Steel	Other:

Summary of Work Performed, Observations and Recommendations:

Soils & Structures arrived onsite to observe Bruce's Blacktop perform paving operations for the asphalt leveling course. The leveling course was installed from 723 Golfview Drive to 702 Golfview Drive - approximately 18,929 square feet . Bruce's Blacktop performed the work using a Carlson CP130 rubber track paver. A Volvo DD30B vibratory roller was used for primary compaction, and a Wacker Neuson RD12 vibratory roller was used for secondary compaction of the hot-mix asphalt. Asphalt temperatures ranged from 280 to 295 degrees Fahrenheit as measured with an infrared thermometer at the hopper of the paver.

Asphalt Material Type: 4EML

Design Thickness: 2 inches

Area: 2,103 Square Yards

Tonnage Placed: 217.44 tons

Calculated Yield: 1.88 inches



Ann Arbor Muskegon Traverse City Upper Peninsula (800) 933-3959



Project Title: Golfview Drive Reconstruction **Project No.:** 2024.2038 **Project Location:** Date: 10/11/2024 Douglas, MI Client: **BDR Inc** Weather: Sunny Inspected By: Jalen Salazar Temperature (°F): 70

Type of Inchestions		Soil	Concrete	Masonry
Type of Inspection:	Х	Pavement	Steel	Other:

Summary of Work Performed, Observations and Recommendations:

Soils & Structures arrived on site to observe Bruce's Blacktop perform paving operations for the asphalt wearing course. Prior to the placement of hot mix asphalt, tack was applied to the surface of the asphalt leveling course. The wearing course was installed from 723 Golfview Drive to 702 Golfview drive - approximately 18,929 square feet. Bruce's Blacktop performed the work using a Carlson CP130 rubber track paver. A Volvo DD30B vibratory roller was used for primary compaction, a Wacker Neuson RD12 vibratory roller was used for secondary compaction of the hot-mix asphalt. Asphalt temperatures ranged from 290 to 315 degrees Fahrenheit as measured with an infrared thermometer at the hopper of the paver.

Bruce's Blacktop installed approximately 750 linear feet of 24 inch valley gutter in the easternmost half of the project.


Asphalt Material Type: 5EML

Design Thickness: 1.5 inches

Area: 2,103 Square Yards

Tonnage Placed: 228.5 tons

Calculated Yield: 1.98 inches

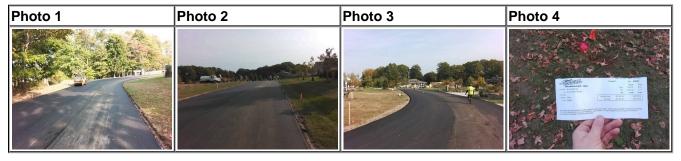

Ann Arbor Muskegon Traverse City Upper Peninsula (800) 933-3959



File No.	2024.2038
Project	Golfview Drive Reconstruction
Date	10/09/2024
Arrival Time	11:10 AM
Tested By	Jalen Salazar
Ordered By	BDR Inc

Test No.	Description of Soil	Max. Density (pcf)	Wet Density (pcf)	Water Content (%)	Dry Density (pcf)	Compaction (%)
1	Gravel : Brown	126.6	137.5	8.9	126.3	99.7
2	Gravel : Brown	126.6	138.1	10.0	125.5	99.2
3	Gravel : Brown	126.6	138.3	9.1	126.8	100.1
4	Gravel : Brown	126.6	134.8	7.7	125.2	98.9
5	Gravel : Brown	126.6	137.4	8.1	127.1	100.4
6	Gravel : Brown	126.6	139.4	7.3	129.9	102.6

Test No.	Test Elevation	Probe Depth	·	Location of Tests
1	99.7	6	Aggregate Base : Roadway : Eastbound lane. : 723 Golfview Drive.	
2	99.7	6	Aggregate Base : Roadway : Westbound lane. : Next to the WestShore sign.	
3	99.7	6	Aggregate Base : Roadway : Eastbound lane. : 719 Golfview Drive.	
4	99.7	6	Aggregate Base : Roadway : Westbound lane. : 711 Golfview Drive.	
5	99.7	6	Aggregate Base : Roadway : Eastbound lane. : 798 Golfview Drive.	
6	99.7	6	Aggregate Base : Roadway : Westbound lane. : 699 Golfview Drive.	
Elev	ation Ref.: 1	00.0 = F	Asphalt	
Com	paction Met	thod: Vil	bratory Roller	
Lift -	Thickness (i	nches):	8" If Observed: No	
Wea	Weather: Sunny Temperature (F°): 57			

Test Results Reported To Dykgraaf Excavating

- \boldsymbol{X} Does Meet 98% compaction specifications where tested.
- _ Does not meet compaction specifications where tested. Action taken: .

Remarks:

DISCLAIMER: The above tests are only intended to represent the soil and elevation which was tested. They are not a substitute for a complete soil investigation.

Ann Arbor Muskegon Traverse City Upper Peninsula (800) 933-3959



File No.	2024.2038
Project	Golfview Drive Reconstruction
Date	10/10/2024
Arrival Time	12:16 PM
Tested By	Jalen Salazar
Ordered By	BDR Inc

Test No.	Description of Soil	Max. Density (pcf)	Wet Density (pcf)	Water Content (%)	Dry Density (pcf)	Compaction (%)
1	Asphalt : 4EML	157.5	148.2	6.7	138.9	94.1
2	Asphalt : 4EML	157.5	152.4	6.2	143.5	96.8
3	Asphalt : 4EML	157.5	151.1	6.8	141.5	95.9
4	Asphalt : 4EML	157.5	149.0	5.5	141.2	94.6
5	Asphalt : 4EML	157.5	152.7	6.0	144.1	97.0
6	Asphalt : 4EML	157.5	153.4	6.1	144.6	97.4
7	Asphalt : 4EML	157.5	149.8	6.8	140.3	95.1

		. .	A B	
Test		Probe	·	Location of Tests
No.	Elevation	Depth		
1	99.8	BS	Asphalt Base : Roadway : 723 Golfview Drive. : Eastbound lane.	
2	99.8	BS	Asphalt Base : Roadway : Next to the West Shore sign. : Eastbound lane.	
3	99.8	BS	Asphalt Base : Roadway : 719 Golfview Drive. : Eastbound lane.	
4	99.8	BS	Asphalt Base : Roadway : 711 Golfview Drive. : Eastbound lane.	
5	99.8	BS	Asphalt Base : Roadway : 707 Golfview Drive. : Eastbound lane.	
6	99.8	BS	Asphalt Base : Roadway : 702 Golfview Drive. : Eastbound lane.	
7	99.8	BS	Asphalt Base : Roadway : 716 Golfview Drive. : Eastbound lane.	
Elev	ation Ref.: 1	00.0 = F	- Asphalt	
Com	paction Met	t hod: Vil	oratory Roller	
Lift -	Γhickness (i	nches):	2" If Observed: Yes	
Wea	ther: Sunny		Temperature (F°): 60	

Test Results Reported To Bruce's Blacktop

- \boldsymbol{X} Does Meet 94% compaction specifications where tested.
- _ Does not meet compaction specifications where tested. Action taken: .

Remarks:



File No.	2024.2038
Project	Golfview Drive Reconstruction
Date	10/10/2024
Arrival Time	01:26 PM
Tested By	Jalen Salazar
Ordered By	BDR Inc

Test No.	Description of Soil	Max. Density (pcf)	Wet Density (pcf)	Water Content (%)	Dry Density (pcf)	Compaction (%)
1	Asphalt : 4EML	157.5	152.8	6.4	143.6	97.0
2	Asphalt : 4EML	157.5	150.4	7.0	140.6	95.5
3	Asphalt : 4EML	157.5	148.7	6.6	139.5	94.4
4	Asphalt : 4EML	157.5	153.0	6.2	144.1	97.1
5	Asphalt : 4EML	157.5	151.2	5.8	142.9	96.0
6	Asphalt : 4EML	157.5	153.3	6.4	144.1	97.3
7	Asphalt : 4EML	157.5	150.6	5.8	142.3	95.6

Test No.	Test Elevation	Probe Depth	•	Location of Tests
1	99.8	BS	Asphalt Base : Roadway : 723 Golfview Drive. : Westbound lane.	
2	99.8	BS	Asphalt Base : Roadway : Next to the West Shore sign. : Westbound lane.	
3	99.8	BS	Asphalt Base : Roadway : 719 Golfview Drive. : Westbound lane.	
4	99.8	BS	Asphalt Base : Roadway : 711 Golfview Drive. : Westbound lane.	
5	99.8	BS	Asphalt Base : Roadway : 707 Golfview Drive. : Westbound lane.	
6	99.8	BS	Asphalt Base : Roadway : 702 Golfview Drive : Westbound lane.	
7	99.8	BS	Asphalt Base: Roadway: 716 Golfview Drive.: Westbound lane.	
Elev	Elevation Ref.: 100.0 = F. Asphalt			
Com	Compaction Method: Vibratory Roller			
Lift -	Lift Thickness (inches): 2" If Observed: Yes		2" If Observed: Yes	
Wea	Weather: Sunny Temperature (F°): 60		Temperature (F°): 60	

Test Results Reported To Bruce's Blacktop

- \boldsymbol{X} Does Meet 94% compaction specifications where tested.
- _ Does not meet compaction specifications where tested. Action taken: .

Remarks:



File No.	2024.2038	
Project	Golfview Drive Reconstruction	
Date	10/11/2024	
Arrival Time	03:39 PM	
Tested By	Jalen Salazar	
Ordered By	BDR Inc	

Test No.	Description of Soil	Max. Density (pcf)	Wet Density (pcf)	Water Content (%)	Dry Density (pcf)	Compaction (%)
1	Asphalt : 5EML	156.7	152.5	5.1	145.1	97.3
2	Asphalt : 5EML	156.7	150.4	5.7	142.3	96.0
3	Asphalt : 5EML	156.7	148.5	4.9	141.6	94.8
4	Asphalt : 5EML	156.7	148.5	4.8	141.7	94.8
5	Asphalt : 5EML	156.7	154.7	4.7	147.8	98.7
6	Asphalt : 5EML	156.7	148.4	4.4	142.1	94.7
7	Asphalt : 5EML	156.7	149.8	5.1	142.5	95.6

Test No.	Test Elevation	Probe Depth		Location of Tests
1	100.0	BS	Asphalt Top: Roadway: 723 Golfview Drive.: Eastbound lane.	
2	100.0	BS	Asphalt Top: Roadway: Next to the West Shore sign.: Eastbound lane.	
3	100.0	BS	Asphalt Top: Roadway: 719 Golfview Drive.: Eastbound lane.	
4	100.0	BS	Asphalt Top: Roadway: 711 Golfview Drive.: Eastbound lane.	
5	100.0	BS	Asphalt Top: Roadway: 707 Golfview Drive.: Eastbound lane.	
6	100.0	BS	Asphalt Top: Roadway: 702 Golfview Drive.: Eastbound lane.	
7	100.0	BS	Asphalt Top: Roadway: 716 Golfview Drive.: Eastbound lane.	
Elev	Elevation Ref.: 100.0 = F. Asphalt			
Com	Compaction Method: Vibratory Roller			
Lift -	Lift Thickness (inches): 1.5" If Observed: Yes		1.5" If Observed: Yes	
Wea	Weather: Sunny Temperature (F°): 70		Temperature (F°): 70	

Test Results Reported To Bruce's Blacktop

- \boldsymbol{X} Does Meet 94% compaction specifications where tested.
- _ Does not meet compaction specifications where tested. Action taken: .

Remarks:



File No.	2024.2038	
Project	Golfview Drive Reconstruction	
Date	10/11/2024	
Arrival Time	04:49 PM	
Tested By	Jalen Salazar	
Ordered By	BDR Inc	

Test No.	Description of Soil	Max. Density (pcf)	Wet Density (pcf)	Water Content (%)	Dry Density (pcf)	Compaction (%)
1	Asphalt : 5EML	156.7	152.1	5.2	144.6	97.1
2	Asphalt : 5EML	156.7	150.8	6.0	142.3	96.2
3	Asphalt : 5EML	156.7	151.0	5.8	142.7	96.4
4	Asphalt : 5EML	156.7	149.9	5.3	142.4	95.7
5	Asphalt : 5EML	156.7	151.4	5.2	143.9	96.6
6	Asphalt : 5EML	156.7	149.5	5.2	142.1	95.4
7	Asphalt : 5EML	156.7	150.4	5.5	142.6	96.0

Test	Test	Probe	Area Represented	Location of Tests
	Elevation			Location of Tests
1	100.0	BS	Asphalt Top: Roadway: 723 Golfview Drive.: Westbound lane.	
2	100.0	BS	Asphalt Top: Roadway: Next to the West Shore sign.: Westbound lane.	
3	100.0	BS	Asphalt Top : Roadway : 719 Golfview Drive. : Westbound lane.	
4	100.0	BS	Asphalt Top: Roadway: 711 Golfview Drive.: Westbound lane.	
5	100.0	BS	Asphalt Top: Roadway: 707 Golfview Drive.: Westbound lane.	
6	100.0	BS	Asphalt Top: Roadway: 702 Golfview Drive.: Westbound lane.	
7	100.0	BS	Asphalt Top : Roadway : 716 Golfview Drive. : Westbound lane.	
Elev	Elevation Ref.: 100.0 = F. Asphalt		F. Asphalt	Marie Marie
Com	Compaction Method: Vibratory Roller			
Lift -	Γhickness (i	nches):	1.5" If Observed: Yes	
Weather: Sunny Temperature (F°		Temperature (F°): 70		

Test Results Reported To Bruce's Blacktop

- \boldsymbol{X} Does Meet 94% compaction specifications where tested.
- _ Does not meet compaction specifications where tested. Action taken: .

Remarks:

DAILY REPORT OF HMA PLANT INSPECTION



Geotechnical Engineering | Pavement Design Services Structural Steel Detailing | Structural Engineering | DISTRIBUTION: ORIGINAL - Testing Lab, Copy - Project Engineer, Copy - Plant Inspector Laboratory Testing | Construction Materials Testing

Michigan Departement of Transportation 1903 (09/04)

				OL SECTION Job Number				1	ATION			PROJECT ENGINEER				
	2024							G	olfview	Drive Reconstru	ıction	n Nederveld				
CONTRACTOR	CONTRACTOR					PLANT N	IT NUMBER PLANT LOCATION					<u> </u>	Report Number	DATE SAMPLED		
Bruces Blacktop					55-01				Waylaı	nd		1	10/10/2024			
	FIELD TEST RESULTS								1	MATERIAL	LAB SAMPLE		PROJECT PRODUCTION RECORD			
	TYPE OF MIXTURE				ИIX GN No.	TYPE OF MIXTURE			MIX IGN No.	1	TIME TA	AKEN	DAILY TONS	ACCUMULATED TONS		
EXTRACTION NUMBER	TRACTION NUMBER 4EML		EML	4EM	LT2B4	4	4EML		LT2B4	BASE LEVELING TOP			75 / 200			
		JMF	ACTUAL	DEV.	TOL.	JMF	ACTUAL	DEV.	TOL.	TOP						
ASPHALT %		5.30	5.65	0.35	-0.30	5.30	5.58	0.28	-0.30	FILLER						
P. 1-1/2" (37.5 mm) %		100.0	100.0	0.0	±5.0	100.0	100.0	0.0	±5.0	ASPHALT BINDER						
P. 1" (25.0 mm) %	1" (25.0 mm) % 100.0 100.0		0.0	±5.0	100.0	100.0	0.0	±5.0	AGGREGATE MOIST	URE CONTEN	Т		•			
P. 3/4" (19.0 mm) %	P. 3/4" (19.0 mm) % 100.0 10		100.0	0.0	±5.0	100.0	100.0	0.0	±5.0	MATERIAL	TIME	%	MINE	RAL FILLER		
P. 1/2" (12.5 mm) %	2" (12.5 mm) % 91.3 93.7		2.4	±5.0	91.3	94.1	2.8	±5.0				7				
P. 3/8" (9.5 mm) %			88.0	2.2	±5.0	85.8	89.5	3.7	±5.0				P. No. 30 (600 µm)			
P. No. 4 (4.75 mm) %		66.7	70.2	3.5	±5.0	66.7	70.6	3.9	±5.0				P. No. 200 (75 μm)			
P. No. 8 (2.36 mm) %	No. 8 (2.36 mm) % 51.9		54.1	2.2	±5.0	51.9	54.7	2.8	±5.0	PLANT OPR. START	END		LOST TIME	ACTUAL HRS. OPR.		
P. No. 30 (600 µm) %		28.5	28.2	-0.3	±4.0	28.5	28.3	-0.2	±4.0							
P. No. 200 (75 µm) %	lo. 200 (75 µm) % 5.3 5.6			0.3	±1.0	5.3	5.4	0.1	±1.0	KIT NUMBER	•		EXTRACTOR NUME	BER		
CRUSHED %			-1	-10%	97.8	97.3	-1	-10%								
MIX / AGGREGATE BLEND PROPORTIONS							/IPERATUR	RE	REMARKS:							
PIT NUMBER					TYPE MIXT		TIME TAKEN	MIX	AIR							
49-65	3/4 x 1/2				12.0%											
95-05	29A				16.0%											
03-1001	2NS				12.0%											
92-0035	SLAG SAN				13.0%											
75-05	3/32nd SAI	ND			22.0%											
							2 \$	M PLANT								
	RAP / YAF	RD (55-0)	1)		25.0%			CH PLANT		QUALIFICATION NUM	MBER					
FILLER							MIX TIME: DRY			0552-0225						
ASPHALT BINDER	HALT BINDER 58-28 Marathon ABS 3505				4.13%		PLANT INS Matthew Mo		S NAME (PR	SIGNATURE				DATE TESTED 10/10/2024		

DAILY REPORT OF HMA PLANT INSPECTION



Geotechnical Engineering | Pavement Design Services Structural Steel Detailing | Structural Engineering | DISTRIBUTION: ORIGINAL - Testing Lab, Copy - Project Engineer, Copy - Plant Inspector Laboratory Testing | Construction Materials Testing

Michigan Departement of Transportation 1903 (09/04)

CONTROL SECTION				Job Num	ber			JOB LOC	ATION			PROJEC	ROJECT ENGINEER				
					202	4.2038		G	Solfview	Drive Reconstru	uction		Nede	veld			
CONTRACTOR	ONTRACTOR				PLANT N	NUMBER		PLANT L	OCATION		1	Report Number	DATE SAMPLED				
	Bruces Blacktop						55-01			Wayla	Wayland			10/11/2024			
			FIELD	TEST RES	ULTS				1	MATERIAL	LAB SAMPLE		PROJECT PRODU	ICTION RECORD			
	TYPE OF MIXTURE EXTRACTION NUMBER 5EML			MIX DESIGN No. 5EMLT2B4		PE OF TURE		MIX IGN No.		TIME T	AKEN	DAILY TONS	ACCUMULATED TONS				
EXTRACTION NUMB			5EML			5EML		LT2B4	BASE LEVELING								
		JMF ACTUAL DEV. TOL. JMF ACTUAL DEV.		DEV.	TO	TOP			75 / 100								
ASPHALT %									TOL.	FILLER							
P. 1-1/2" (37.5 mm) %		5.10	4.94 100.0	-0.16	-0.30 ±5.0	5.10 100.0	5.08 100.0	-0.02 0.0	-0.30 ±5.0	ASPHALT BINDER							
P. 1" (25.0 mm) %		100.0		0.0	_			0.0		AGGREGATE MOIS	TUDE CONTEN	IT					
, ,		100.0	100.0	0.0	±5.0 ±5.0	100.0 100.0	100.0	0.0	±5.0 ±5.0	MATERIAL	TIME	%	MINERAL FILLER				
P. 1/2" (12.5 mm) %	7 100.0 100.0		98.9	-1.1	±5.0	100.0	99.4	-0.6	±5.0	WATERIAL	THVIE	70	WIINE	NAL FILLEN			
P. 3/8" (9.5 mm) %		100.0 95.9	98.9	-0.9	±5.0	95.9	96.1	0.2	±5.0				P. No. 30 (600 µm)	1			
P. No. 4 (4.75 mm) %		70.2	66.6	-3.6	±5.0	70.2	67.3	-2.9	±5.0				P. No. 200 (75 μm)				
P. No. 8 (2.36 mm) %		49.5	48.5	-1.0	±5.0	49.5	50.0	0.5	±5.0	PLANT OPR. START	END		LOST TIME	ACTUAL HRS. OPR.			
P. No. 30 (600 µm) %		29.9	30.7	0.8	±4.0	29.9	31.4	1.5	±4.0	-							
P. No. 200 (75 µm) %		5.4	5.4	0.0	±1.0	5.4	5.6	0.2	±1.0	KIT NUMBER			EXTRACTOR NUMB	ER .			
CRUSHED %		95.2	95.1	0.0	-10%			0 -10%					2,110,101,011,110,112				
	MIX / AGGREGATE BLEND PROPORTIONS						MPERATUR		REMARKS:			1					
	G	RADE, MA	NUFACTUR	ER	TYPE	E OF	TIME										
PIT NUMBER		MATERIA	L, SUPPLIEF	R	MIXT	URE	TAKEN	MIX	AIR								
95-05	29A				26.0%	5											
03-1001	2NS				21.0%	5											
92-0035	SLAG SAI	ND			25.0%	5											
) <u>2</u> 0033	DL/10 D/11	TTD.															
							X DRU	M PLANT		2024.2038, 240949	7 2409499						
RECLAIMED	RAP / YA	RD (55-0)1)		28.0%	5		CH PLANT		QUALIFICATION NU	,						
FILLER	1011 / 171	(55 0)				MIX TIME: DRY	/WET		0552-0225							
ASPHALT BINDER	58-28 Mar	athon AE	BS 3505		3.74%	ò	PLANT INS		NAME (PF	RINT) S	IGNATURE			DATE TESTED			
							Matthew Mo	cClendon						10/15/2024			




REPORT OF COMPACTED HMA CORE DENSITY & PERCENT COMPACTION


	JOB NUMBER	PROJECT	LOCATION	١					MIXTURE TYPE	MIX DESIGN No.		REPORT NUMBE			
	2024.2038			Golfview	Drive Reconstruction				4EML	4EML	4EMLT2B4		1		
ONTRACTOR		•	PLANT NUMBER PLAN						CATION	•					
	Bruces Black	ktop	55-01							Wayland					
ROJECT ENGINEER									ИBER	LOT NUMBER					
Nederveld			Matthew N	/IcClendon						0552-0225		1			
DATE			10/10/24	10/10/24	10/10/24		10/10/24	10/10/24							
ore Thickness Prior to 1	Trimming		1 1/2"	1 7/8"	1 7/8"		2"	1 5/8"							
SUBLOT NUMB	BER / CORE LETT	ER	1A	1B	1C		JC 1	JC 2							
WEIGHT OF CORE	(in water), grams		789.2	867.5	876.3		677.2	585.8							
WEIGHT OF CORE	ns	1380.4	1533.1	1537.3		1247.0	1083.4								
. WEIGHT OF CORE	grams	1374.4	1522.2	1526.8		1222.8	1061.0								
D. WEIGHT OF PAN, grams															
E. WEIGHT OF CORE (C - D), grams			1374.4	1522.2	1526.8		1222.8	1061.0							
F. VOLUME OF CORE (B - A), cc			591.2	665.6	661.0		569.8	497.6							
G. CORE SPECIFIC GRAVITY (E / F)			2.325	2.287	2.310		2.146	2.132							
H. SUBLOT Gmm (2)TEST RESULTS				2.499											
% CORE COMPACTION (G / H) x 100			93.0%	91.2%	92.4%		85.8%	85.3%							
SUBLOT % CORE Coverage of cores)					2%			94	6%				•		
LOT AVERAGE DEN	ISITY blots in lot)			32	. 70	Ш		01	J 76						




REPORT OF COMPACTED HMA CORE DENSITY & PERCENT COMPACTION


CONTROL SECTION	JOB NUMBER	PROJECT	LOCATION	٧					MIXTURE TYPE		MIX DESIGN No.		REPORT NUMBE	
	2024.2038			Golfview	Drive Reconstruction				5EML		5EMLT2B4		2	
CONTRACTOR			PLANT NUMBER PLANT LOCATIO						CATION					
	Bruces Black	ktop	55-01								Wayland			
PROJECT ENGINEER	ROJECT ENGINEER NAME OF				TESTER (Please Print) Tester (Signature) QL					QUALIFIC	QUALIFICATION NUMBER			//BER
Nederv	Nederveld				tthew McClendon 0552-0225					5	1			
	DATE		10/11/24	10/11/24	10/11/24		10/11/24	10/11/24						
Core Thickness Prior to	Trimming		1 5/8"	2"	1 3/4"		1 7/8"	1 3/4"						
SUBLOT NUM	SUBLOT NUMBER / CORE LETTER				1C		JC 1	JC 2						
A. WEIGHT OF CORE	A. WEIGHT OF CORE (in water), grams				1021.5		907.4	915.3						
B. WEIGHT OF CORE	ns	1595.4	1955.5	1822.2		1651.6	1687.8							
C. WEIGHT OF CORE & PAN (oven dry), grams			1582.7	1950.7	1813.2		1610.5	1641.0						
D. WEIGHT OF PAN, grams														
E. WEIGHT OF CORE (C - D), grams			1582.7	1950.7	1813.2		1610.5	1641.0						
F. VOLUME OF CORE (B - A), cc			685.9	820.4	800.7		744.2	772.5						
G. CORE SPECIFIC G	G. CORE SPECIFIC GRAVITY (E / F)			2.378	2.265		2.146	2.124						
H. SUBLOT Gmm (2)T			2.	525			2.525							
. % CORE COMPACTION (G / H) x 100			91.4%	94.2%	89.7%		85.0%	84.1%						
J. SUBLOT % CORE COMPACTION (Average of cores)				92	2%		85					•	·	•
K. LOT AVERAGE DE (Sum of J / number of si														
Average Top Core Thick	kness = 1 3/4"													
7.1.5.5gg 1 op 5515 111101														

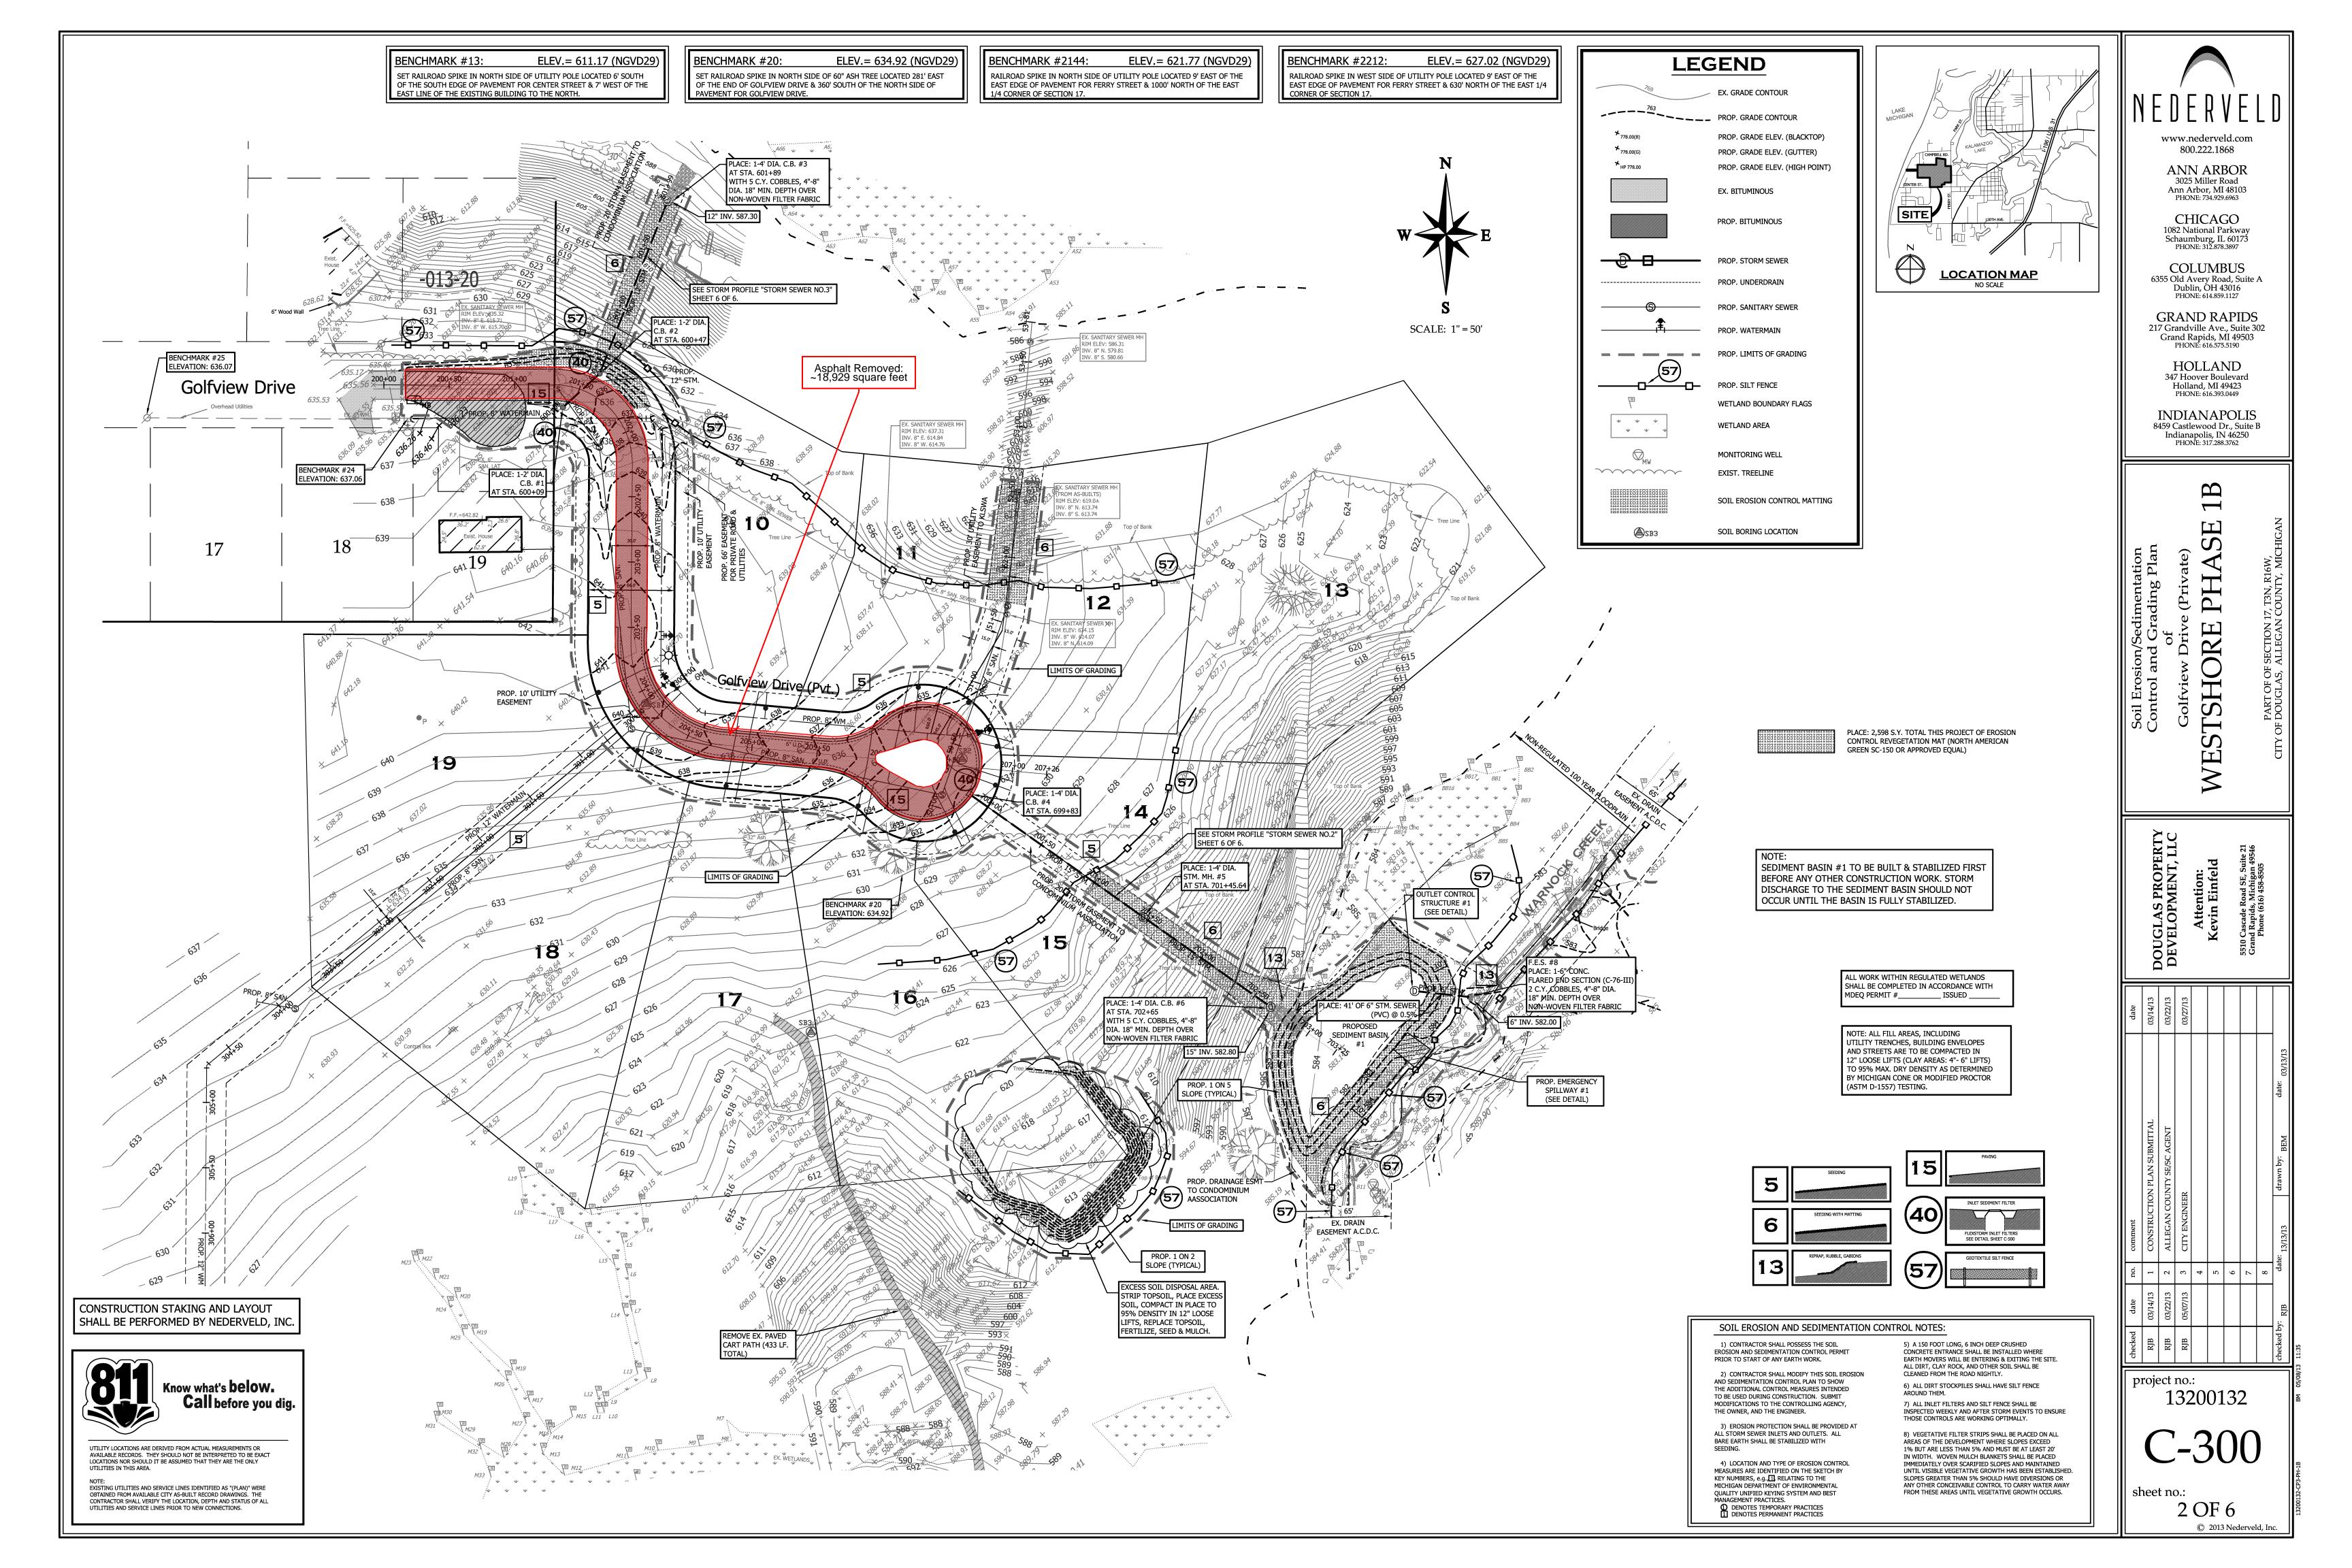


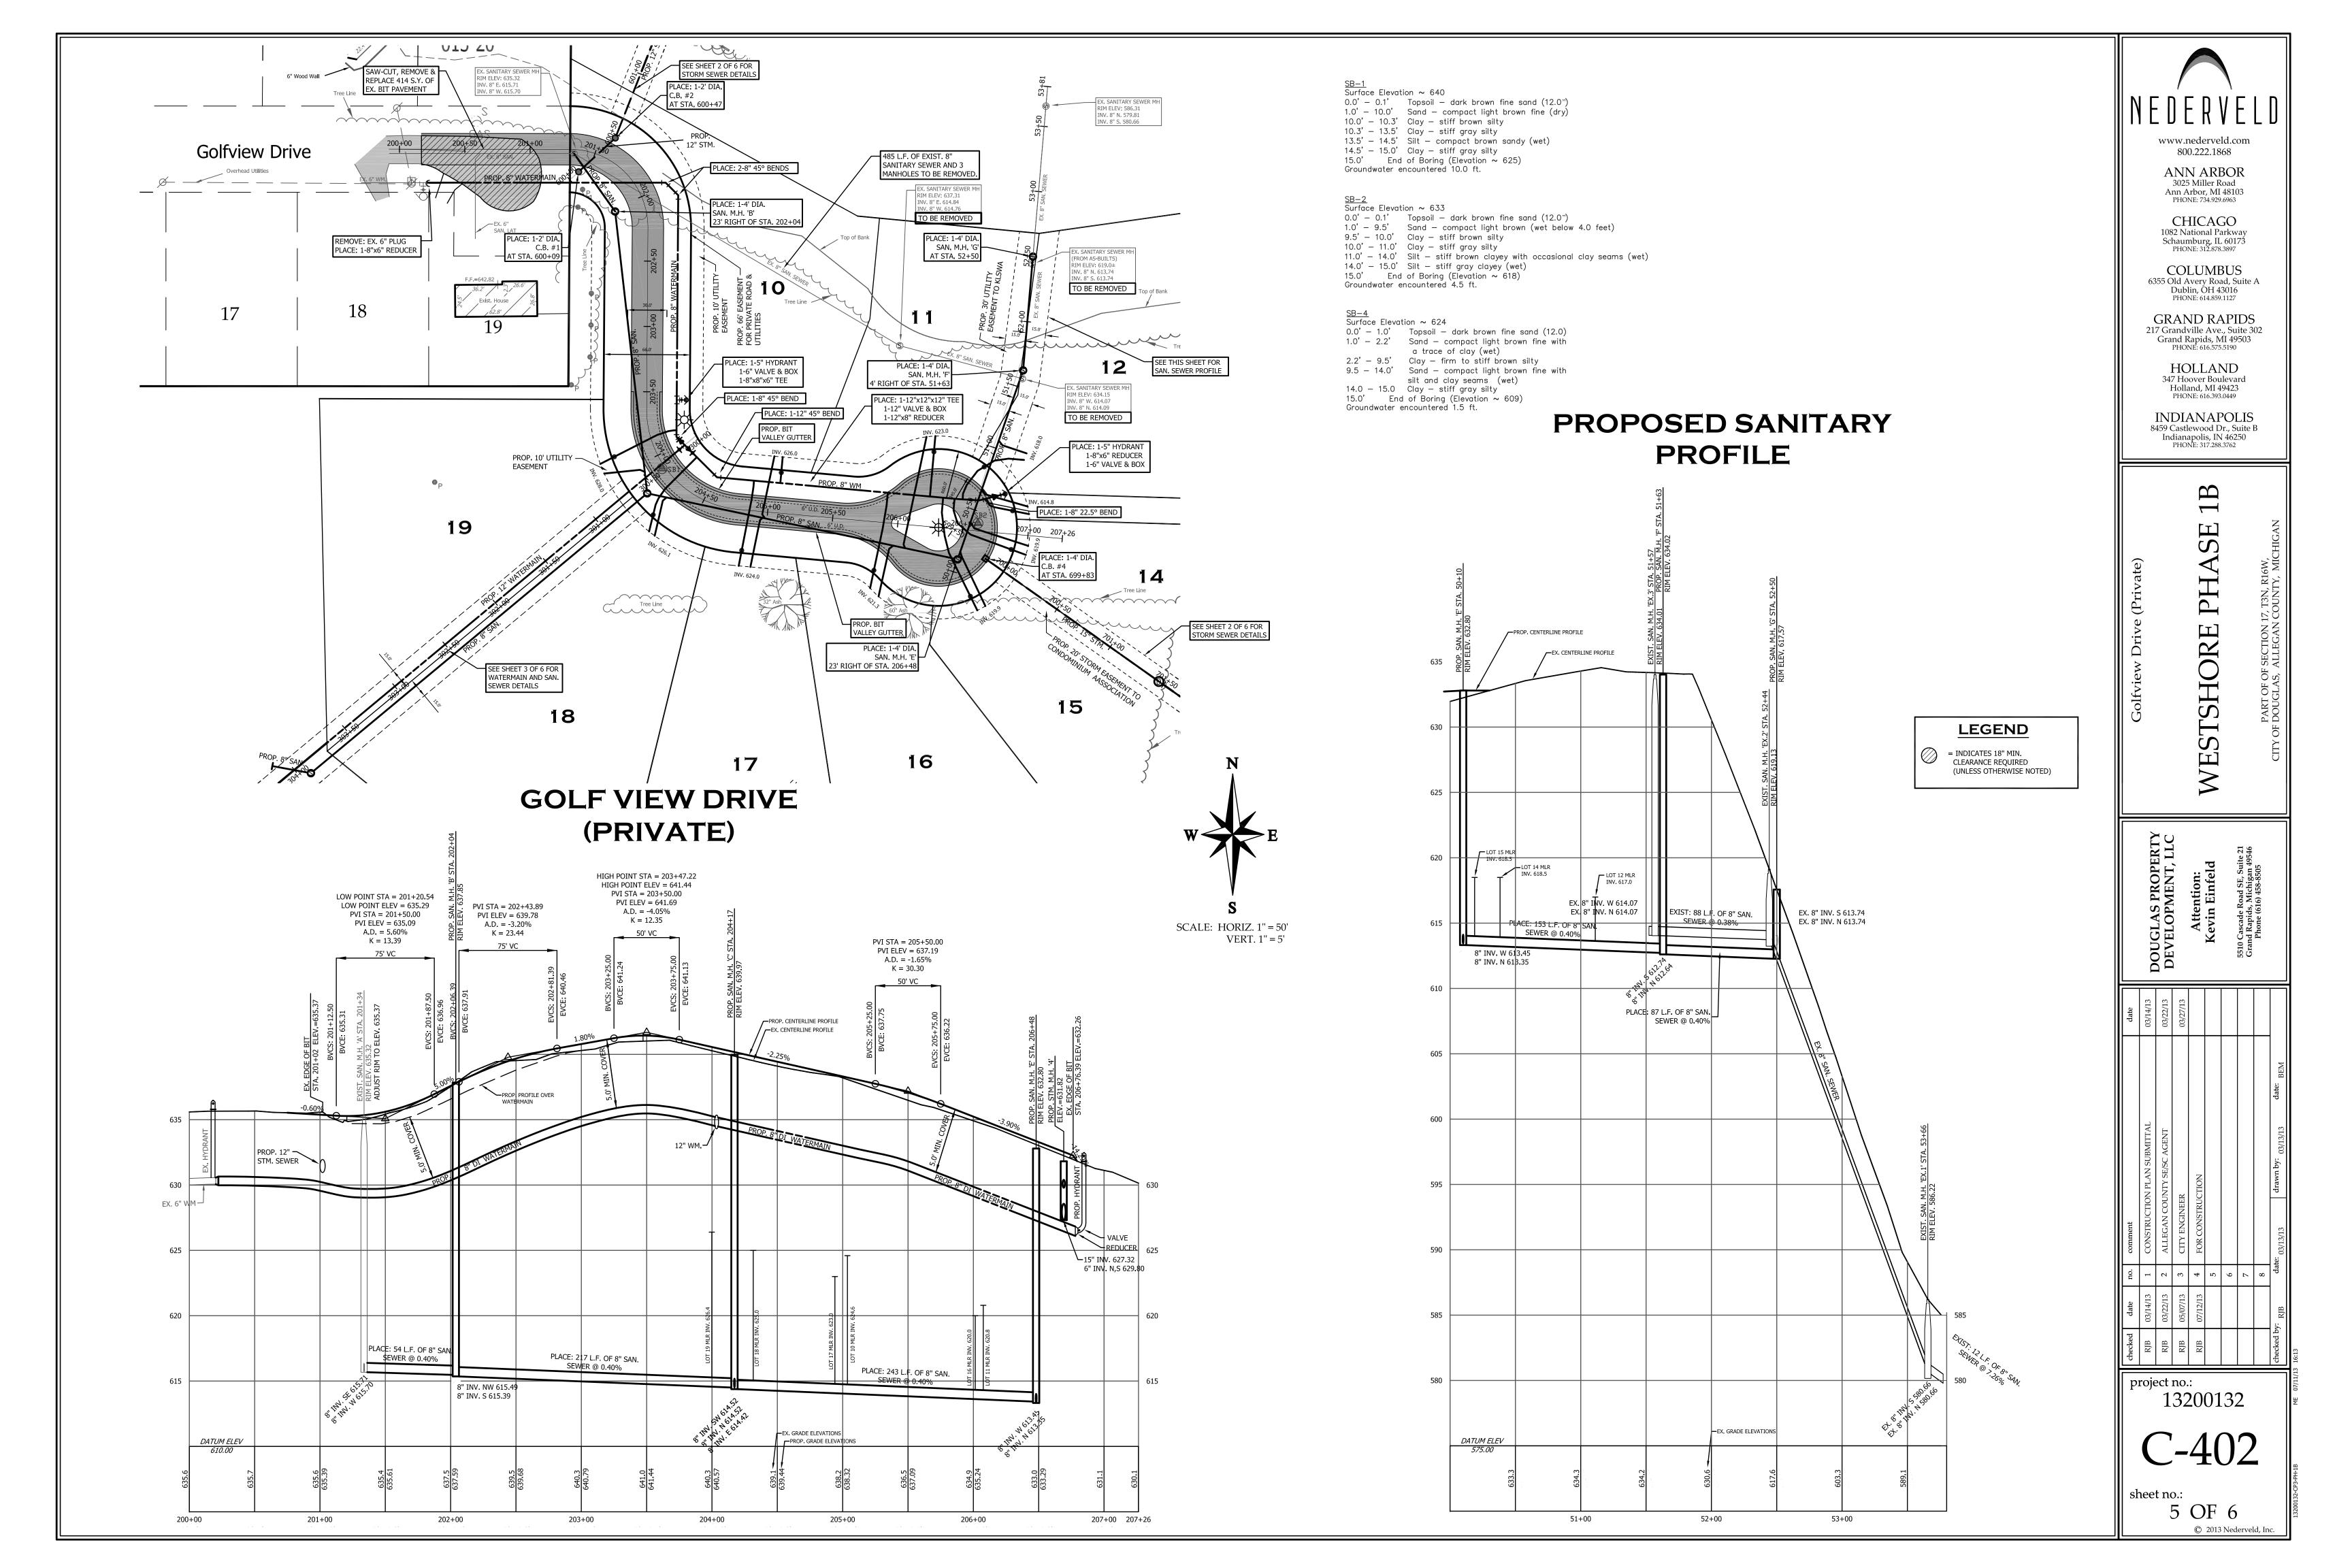


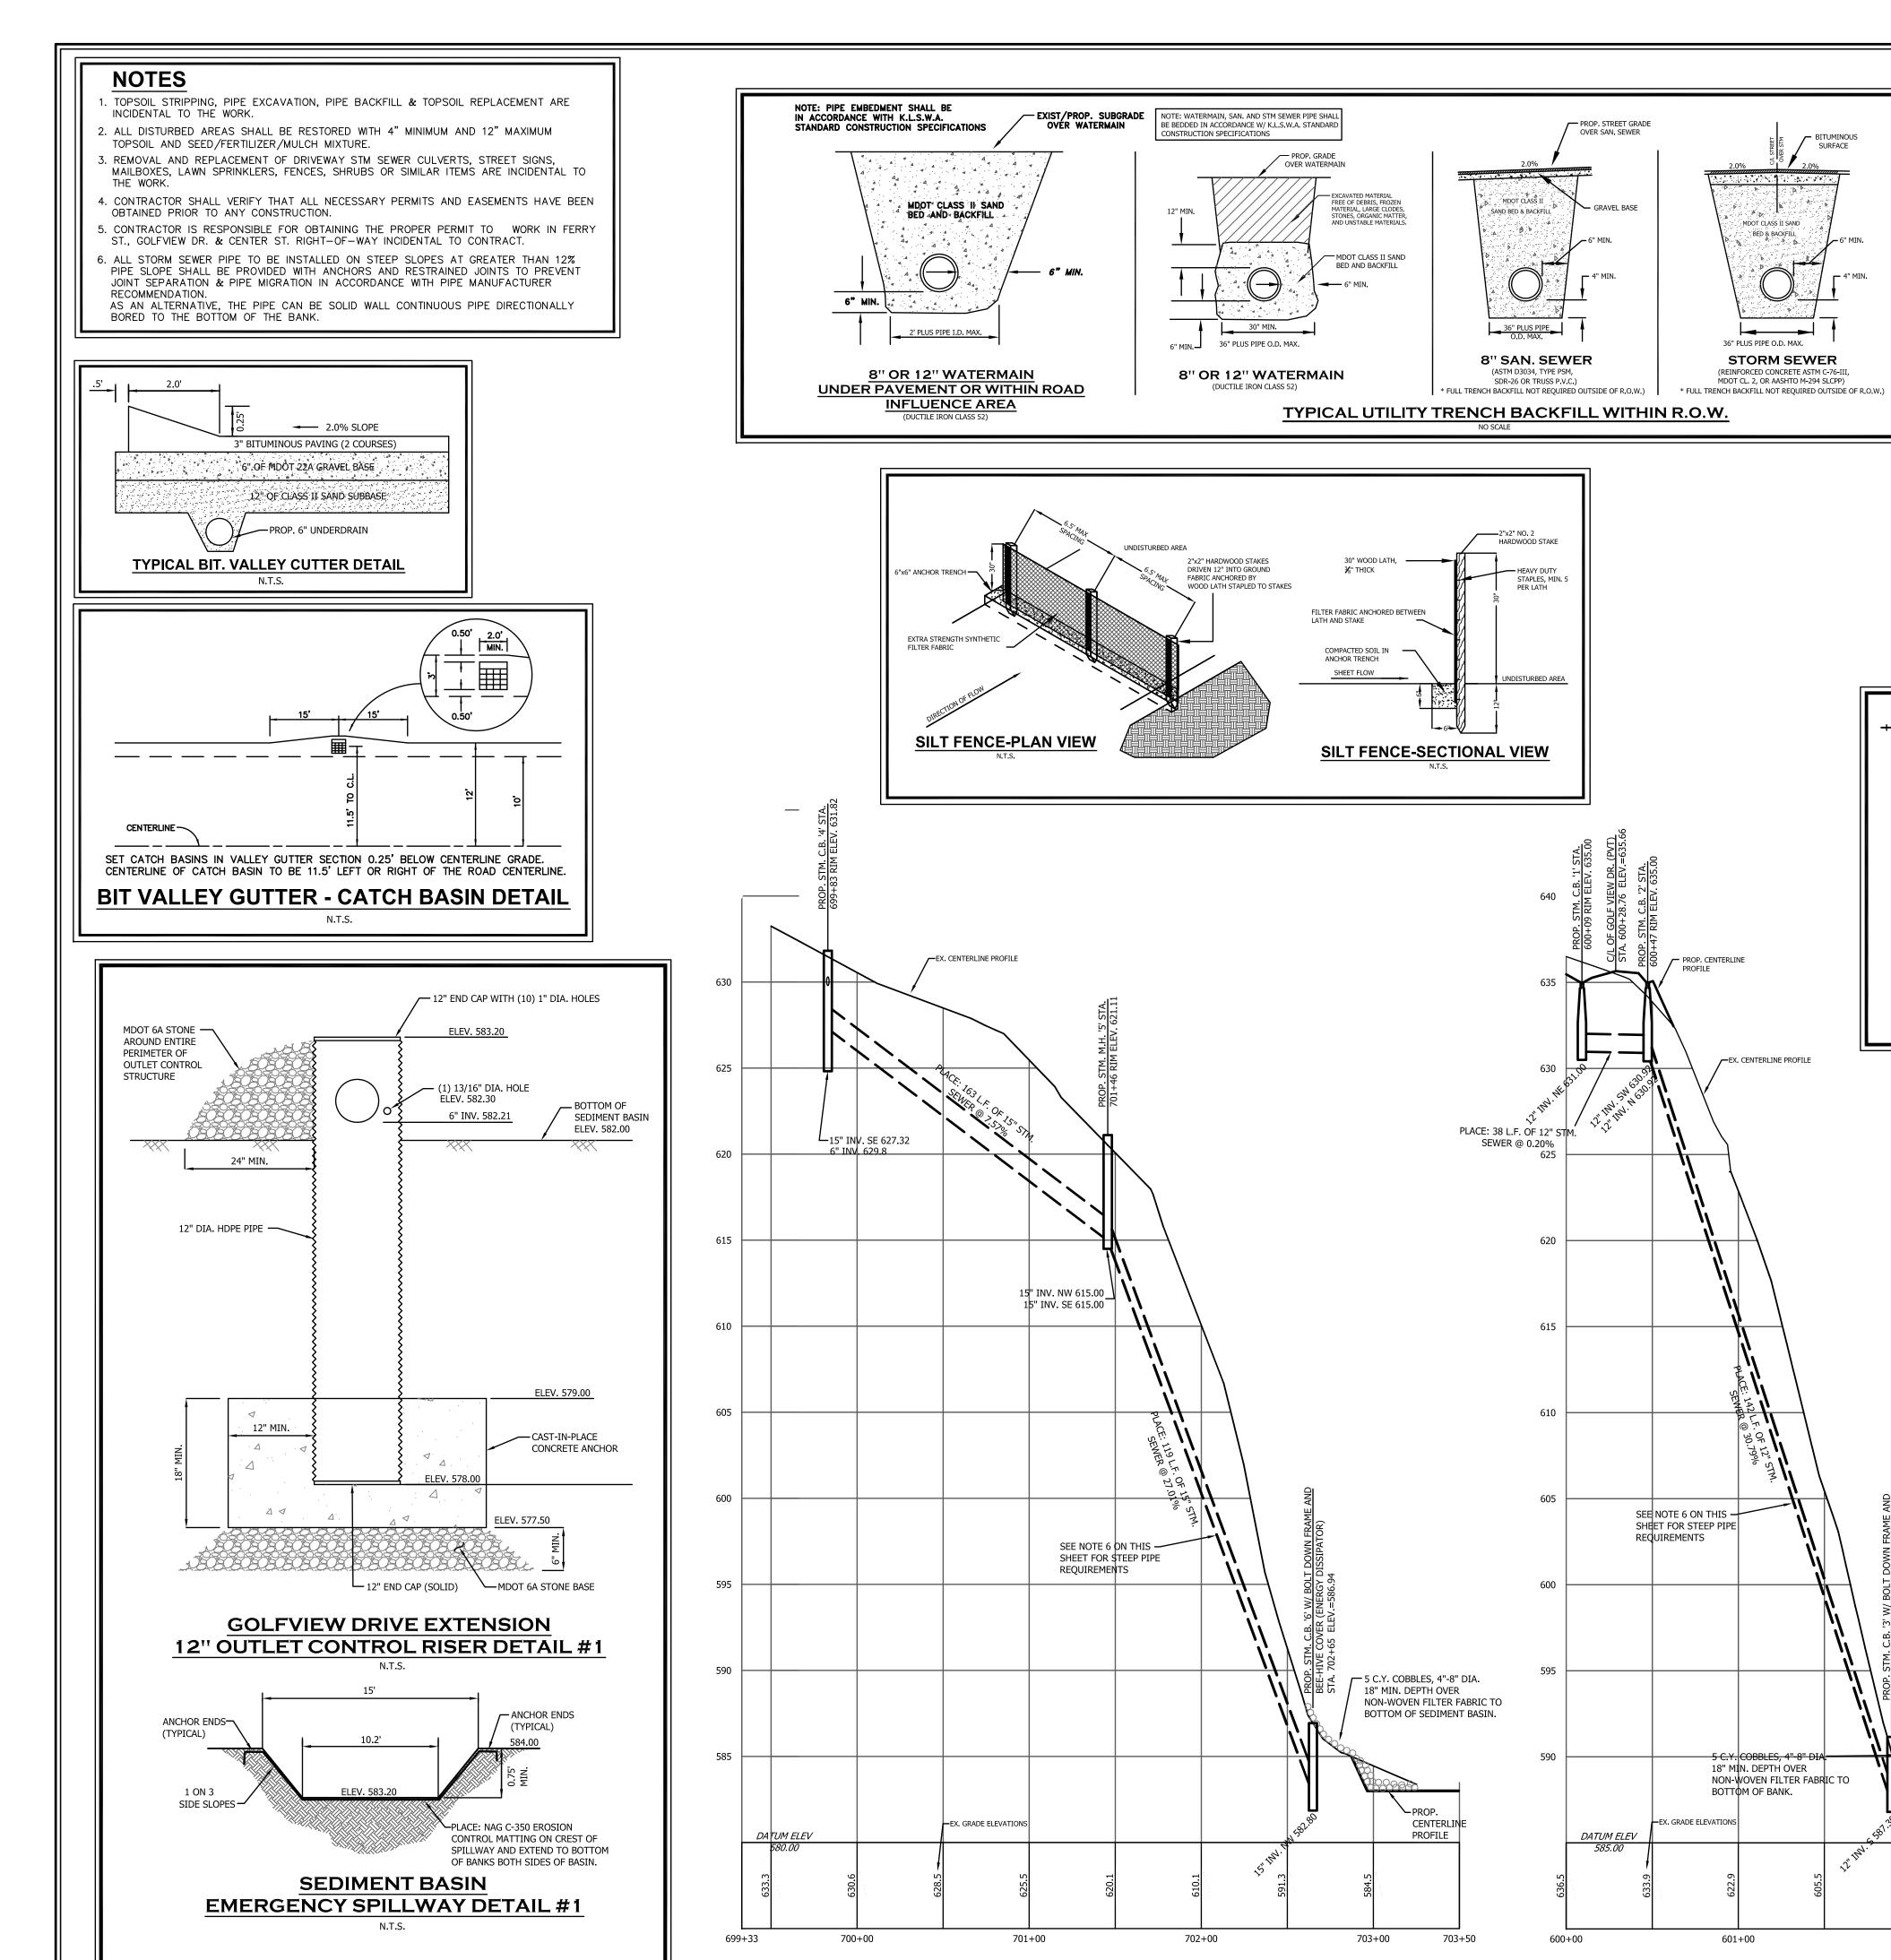



GOLFVIEW DRIVE EXTENSION

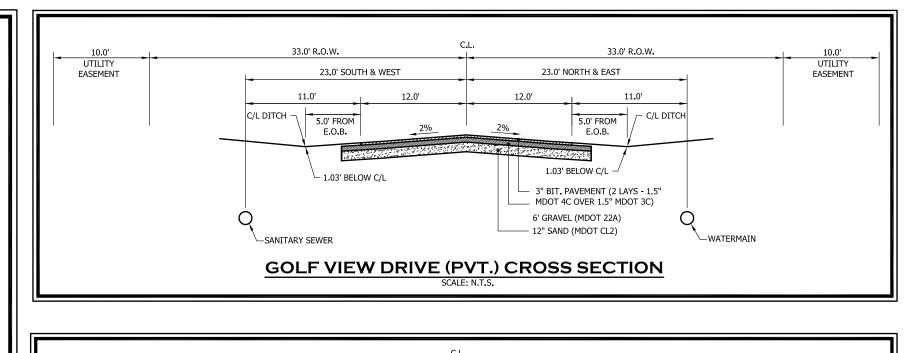


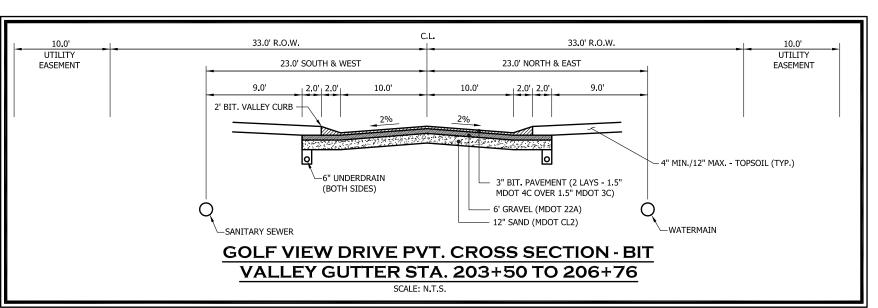

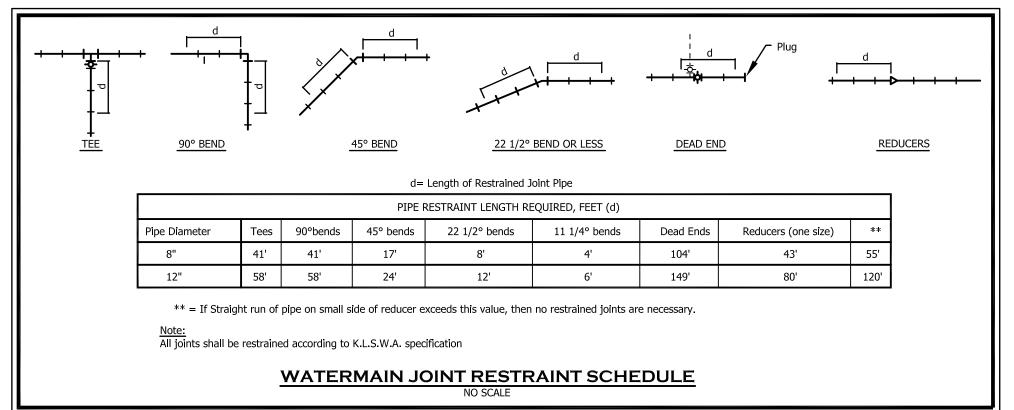

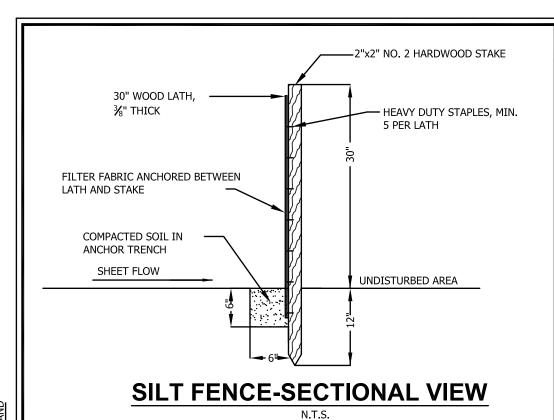

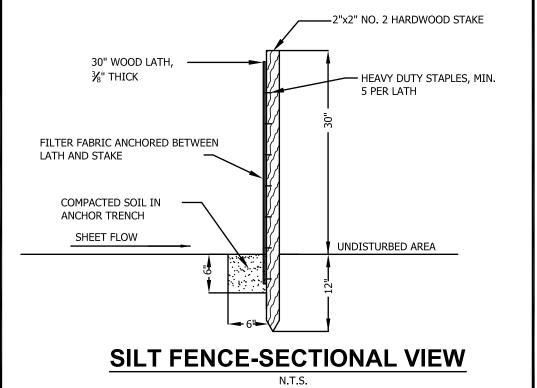

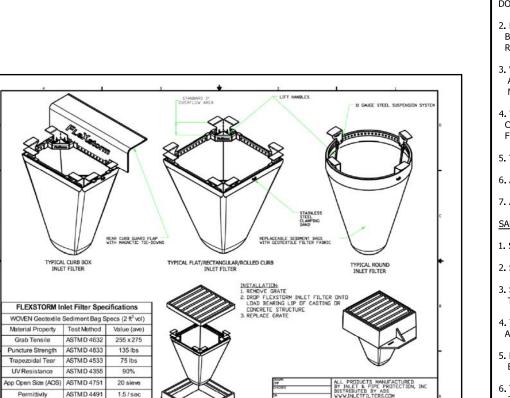

STORM SEWER NO.3



AVAILABLE RECORDS. THEY SHOULD NOT BE INTERPRETED TO BE EXACT LOCATIONS NOR SHOULD IT BE ASSUMED THAT THEY ARE THE ONLY UTILITIES IN THIS AREA.

EXISTING UTILITIES AND SERVICE LINES IDENTIFIED AS "(PLAN)" WERE OBTAINED FROM AVAILABLE CITY AS-BUILT RECORD DRAWINGS. THE CONTRACTOR SHALL VERIFY THE LOCATION, DEPTH AND STATUS OF ALL UTILITIES AND SERVICE LINES PRIOR TO NEW CONNECTIONS.

GENERAL NOTES.
1. CONSTRUCTION OF SANITARY SEWER, WATERMAIN, STORM SEWER AND SIDEWALK IMPROVEMENTS SHALL BE IN ACCORDANCE WITH THE CURRENT VILLAGE OF DOUGLAS & KLSWA STANDARD CONSTRUCTION REQUIREMENTS.
2. PROVIDE SIEVE ANALYSIS ON EXISTING SOILS TO DETERMINE IF THEY MEET CLASS II SPECIFICATIONS FOR BACKFILL.

3. INSTALLATION OF S.L.C.P.P. STORM SEWER MUST COMPLY WITH M.D.O.T. SPECIFICATIONS (INCLUDING MIN. COVER AND 30 DAY

ROADWAY & UTILITY TRENCH BACKFILL MATERIAL SHALL MEET MDOT CLASS II SPECIFICATIONS.

COORDINATE TAP OF THE EXISTING WATERMAIN WITH KLSWA & VILLAGE OF OUGLAS WATER AND SEWER DEPARTMENT. . HYDRANT WEEP HOLES SHALL BE OPEN UNLESS CONSTRUCTED

BELOW WATER TABLE. MEGA LUGS OR RODDING IS REQUIRED FOR REACTION BACKING.

. WATER SERVICES SHALL BE MARKED WITH A SECTION OF PVC PIPE AT THE CURB STOP & BOX (EXTENDING 3' ABOVE GROUND AT A

4. WATER SERVICE FITTINGS SHALL BE COMPRESSION FITTINGS.

CONTRACTORS SHALL PROVIDE ELECTRICAL CONTINUITY ON 5. TESTING SHALL CONFORM TO KLSWA STANDARDS.

6. ALL CURB STOPS SHALL BE FURNISHED WITH STATIONARY RODS. 7. ALL WATERMAIN IS TO BE DUCTILE IRON PIPE CLASS 52. SANITARY SEWER CONSTRUCTION

1. SANITARY SEWER PIPE SHALL BE ASTM 3034, SDR 35 PVC OR SDR 26 PVC AS NOTED ON THE PLANS.

3. SANITARY SEWER CONSTRUCTION SHALL BE IN ACCORDANCE WITH THE STANDARD SPECIFICATIONS OF THE KLSWA. (INCL. TESTING) 4. TEMP. PLUG TO BE PLACED IN EX. SEWER UNTIL NEW SEWER IS

ACCEPTED BY KLSWA. MANHOLES SHALL BE PRECAST, BOOT TYPE WITH OUTER BITUMINOUS COATING.

2"x 2" WOOD STAKE AND A STEEL REROD, COVERED WITH A SECTION OF PVC PIPE EXTENDING 3' ABOVE GRADE.

sheet no.: . A 6" PROPERTY LINE RISER SHALL BE PLACED AT THE END

Attention: Kevin Einfeld

www.nederveld.com

800.222.1868

ANN ARBOR

3025 Miller Road

Ann Arbor, MI 48103

PHONE: 734.929.6963

CHICAGO

1082 National Parkway

Schaumburg, IL 60173

PHONE: 312.878.3897

COLUMBUS

6355 Old Avery Road, Suite A

Dublin, OH 43016

PHONE: 614.859.1127

GRAND RAPIDS

217 Grandville Ave., Suite 302

Grand Rapids, MI 49503 PHONE: 616.575.5190

HOLLAND

347 Hoover Boulevard

Holland, MI 49423 PHONE: 616.393.0449

INDIANAPOLIS


8459 Castlewood Dr., Suite B


PHONE: 317.288.3762


Indianapolis, IN 46250

RE


project no.: 13200132

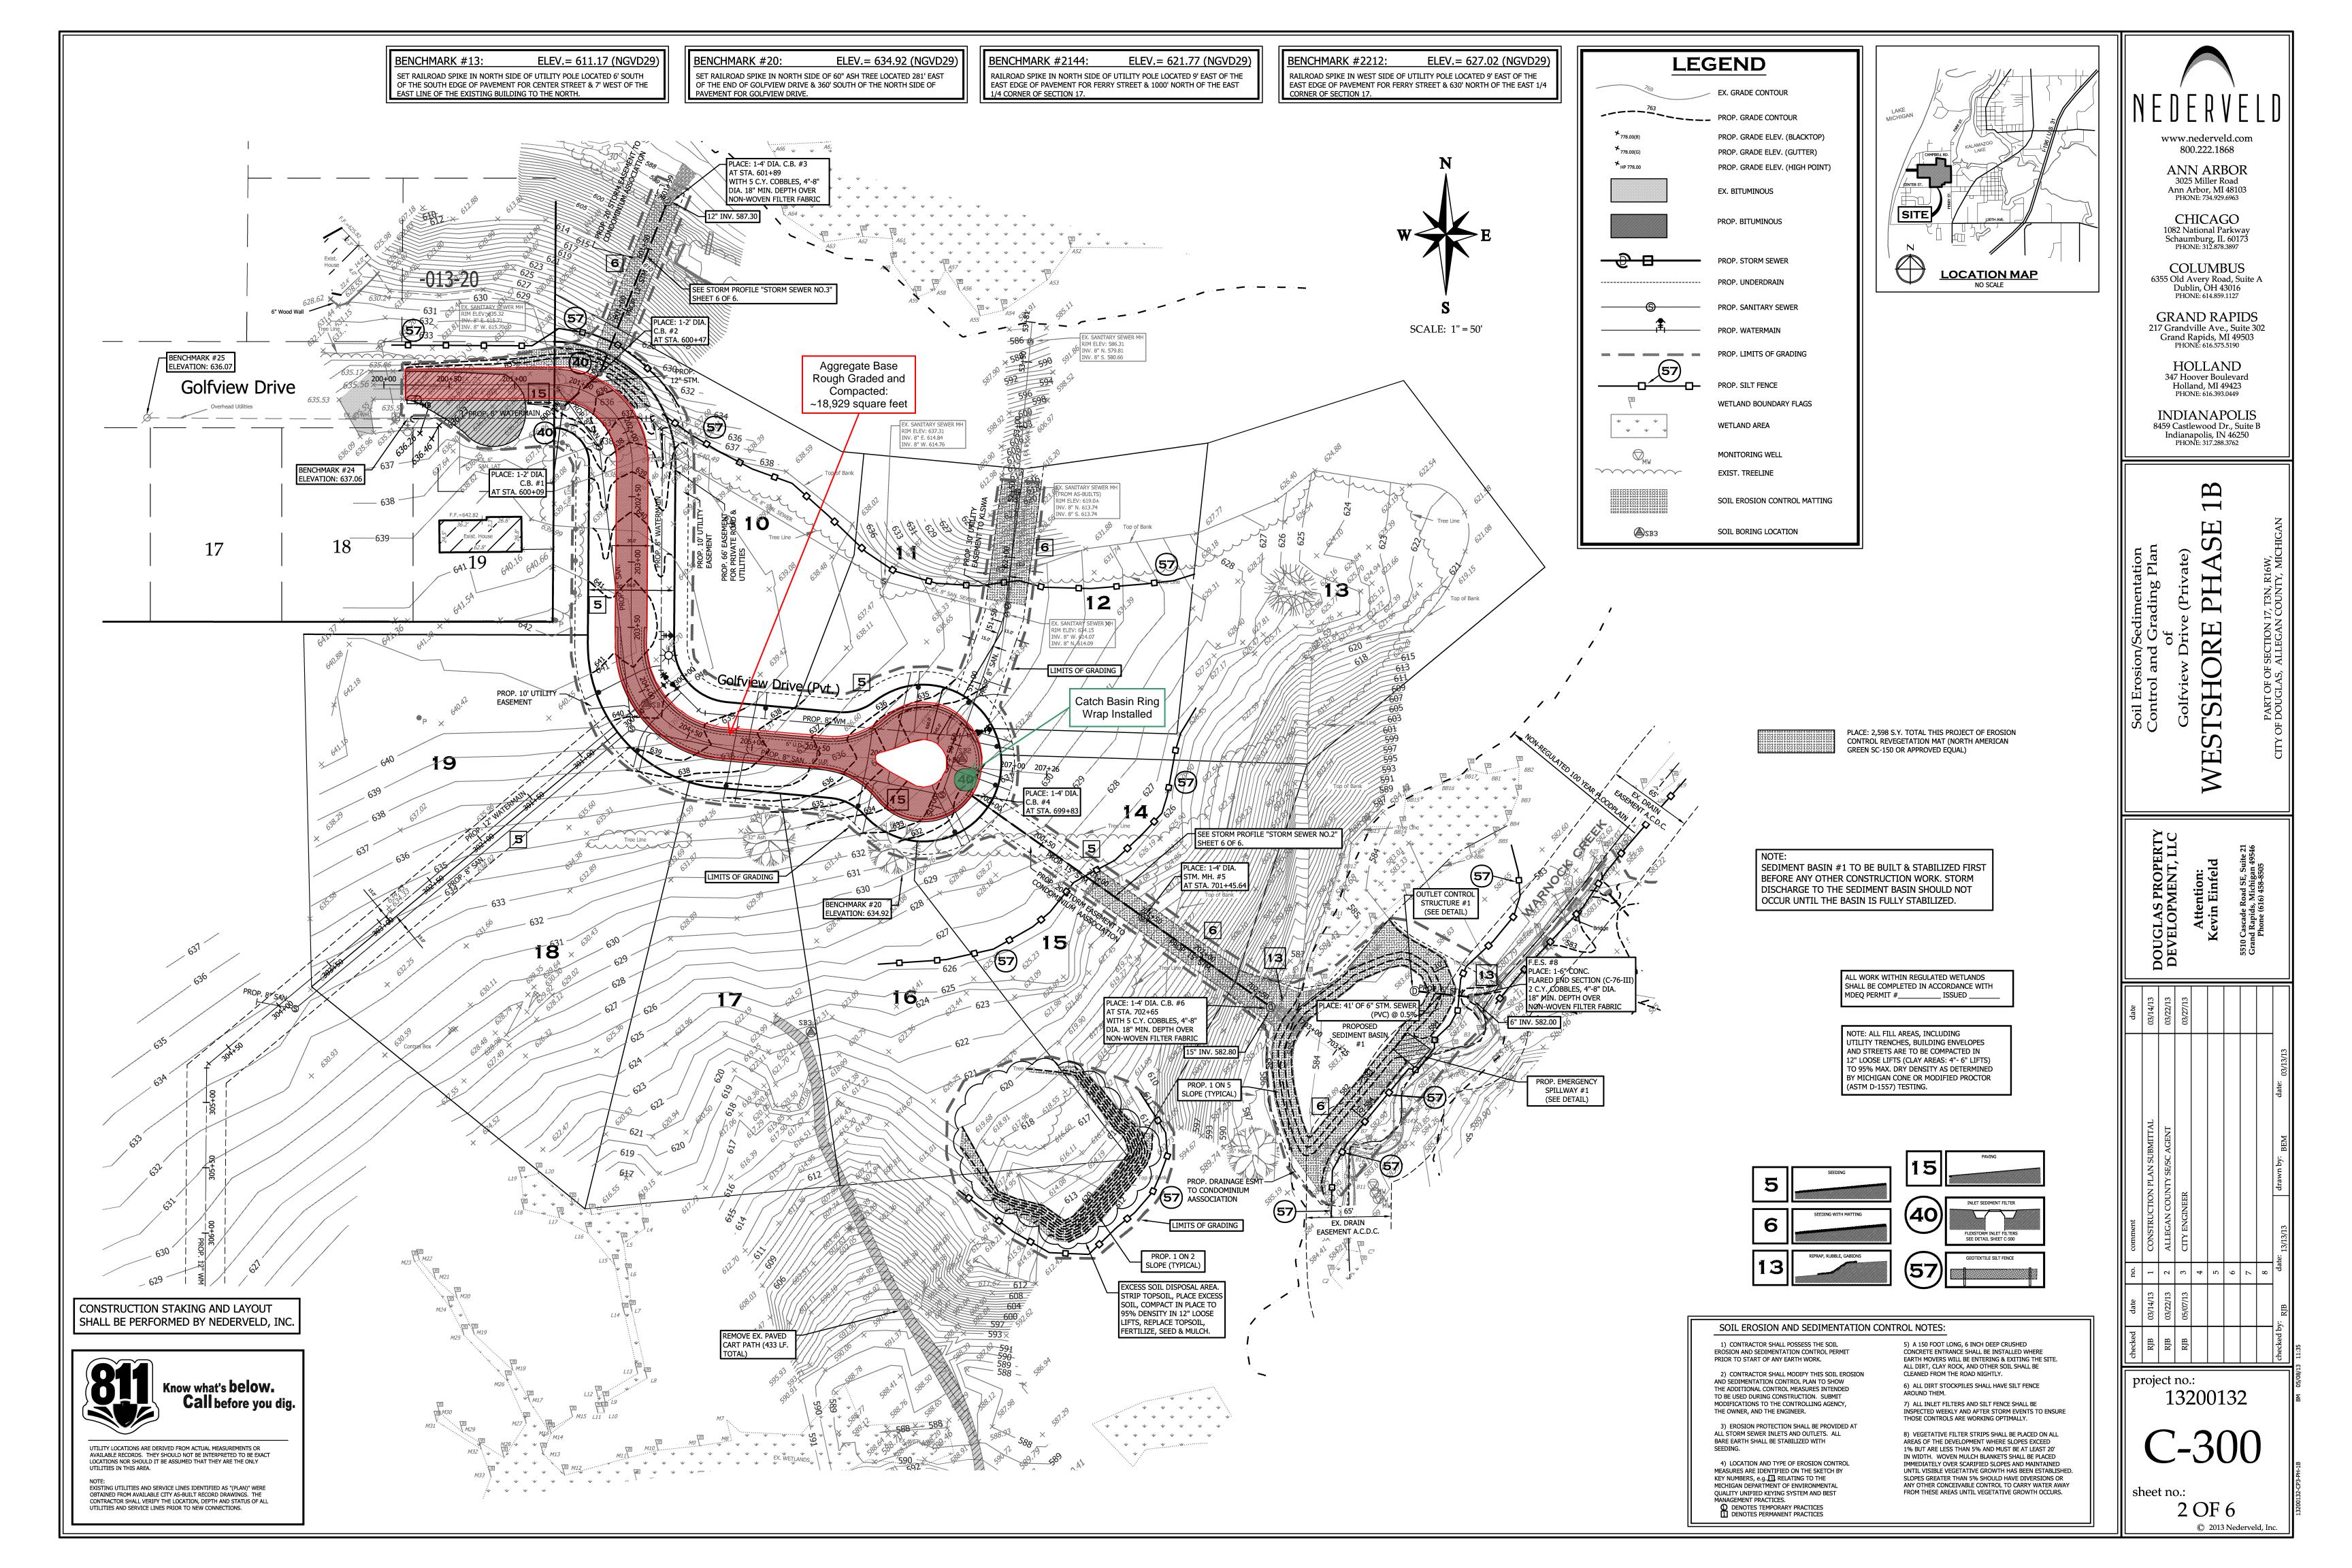


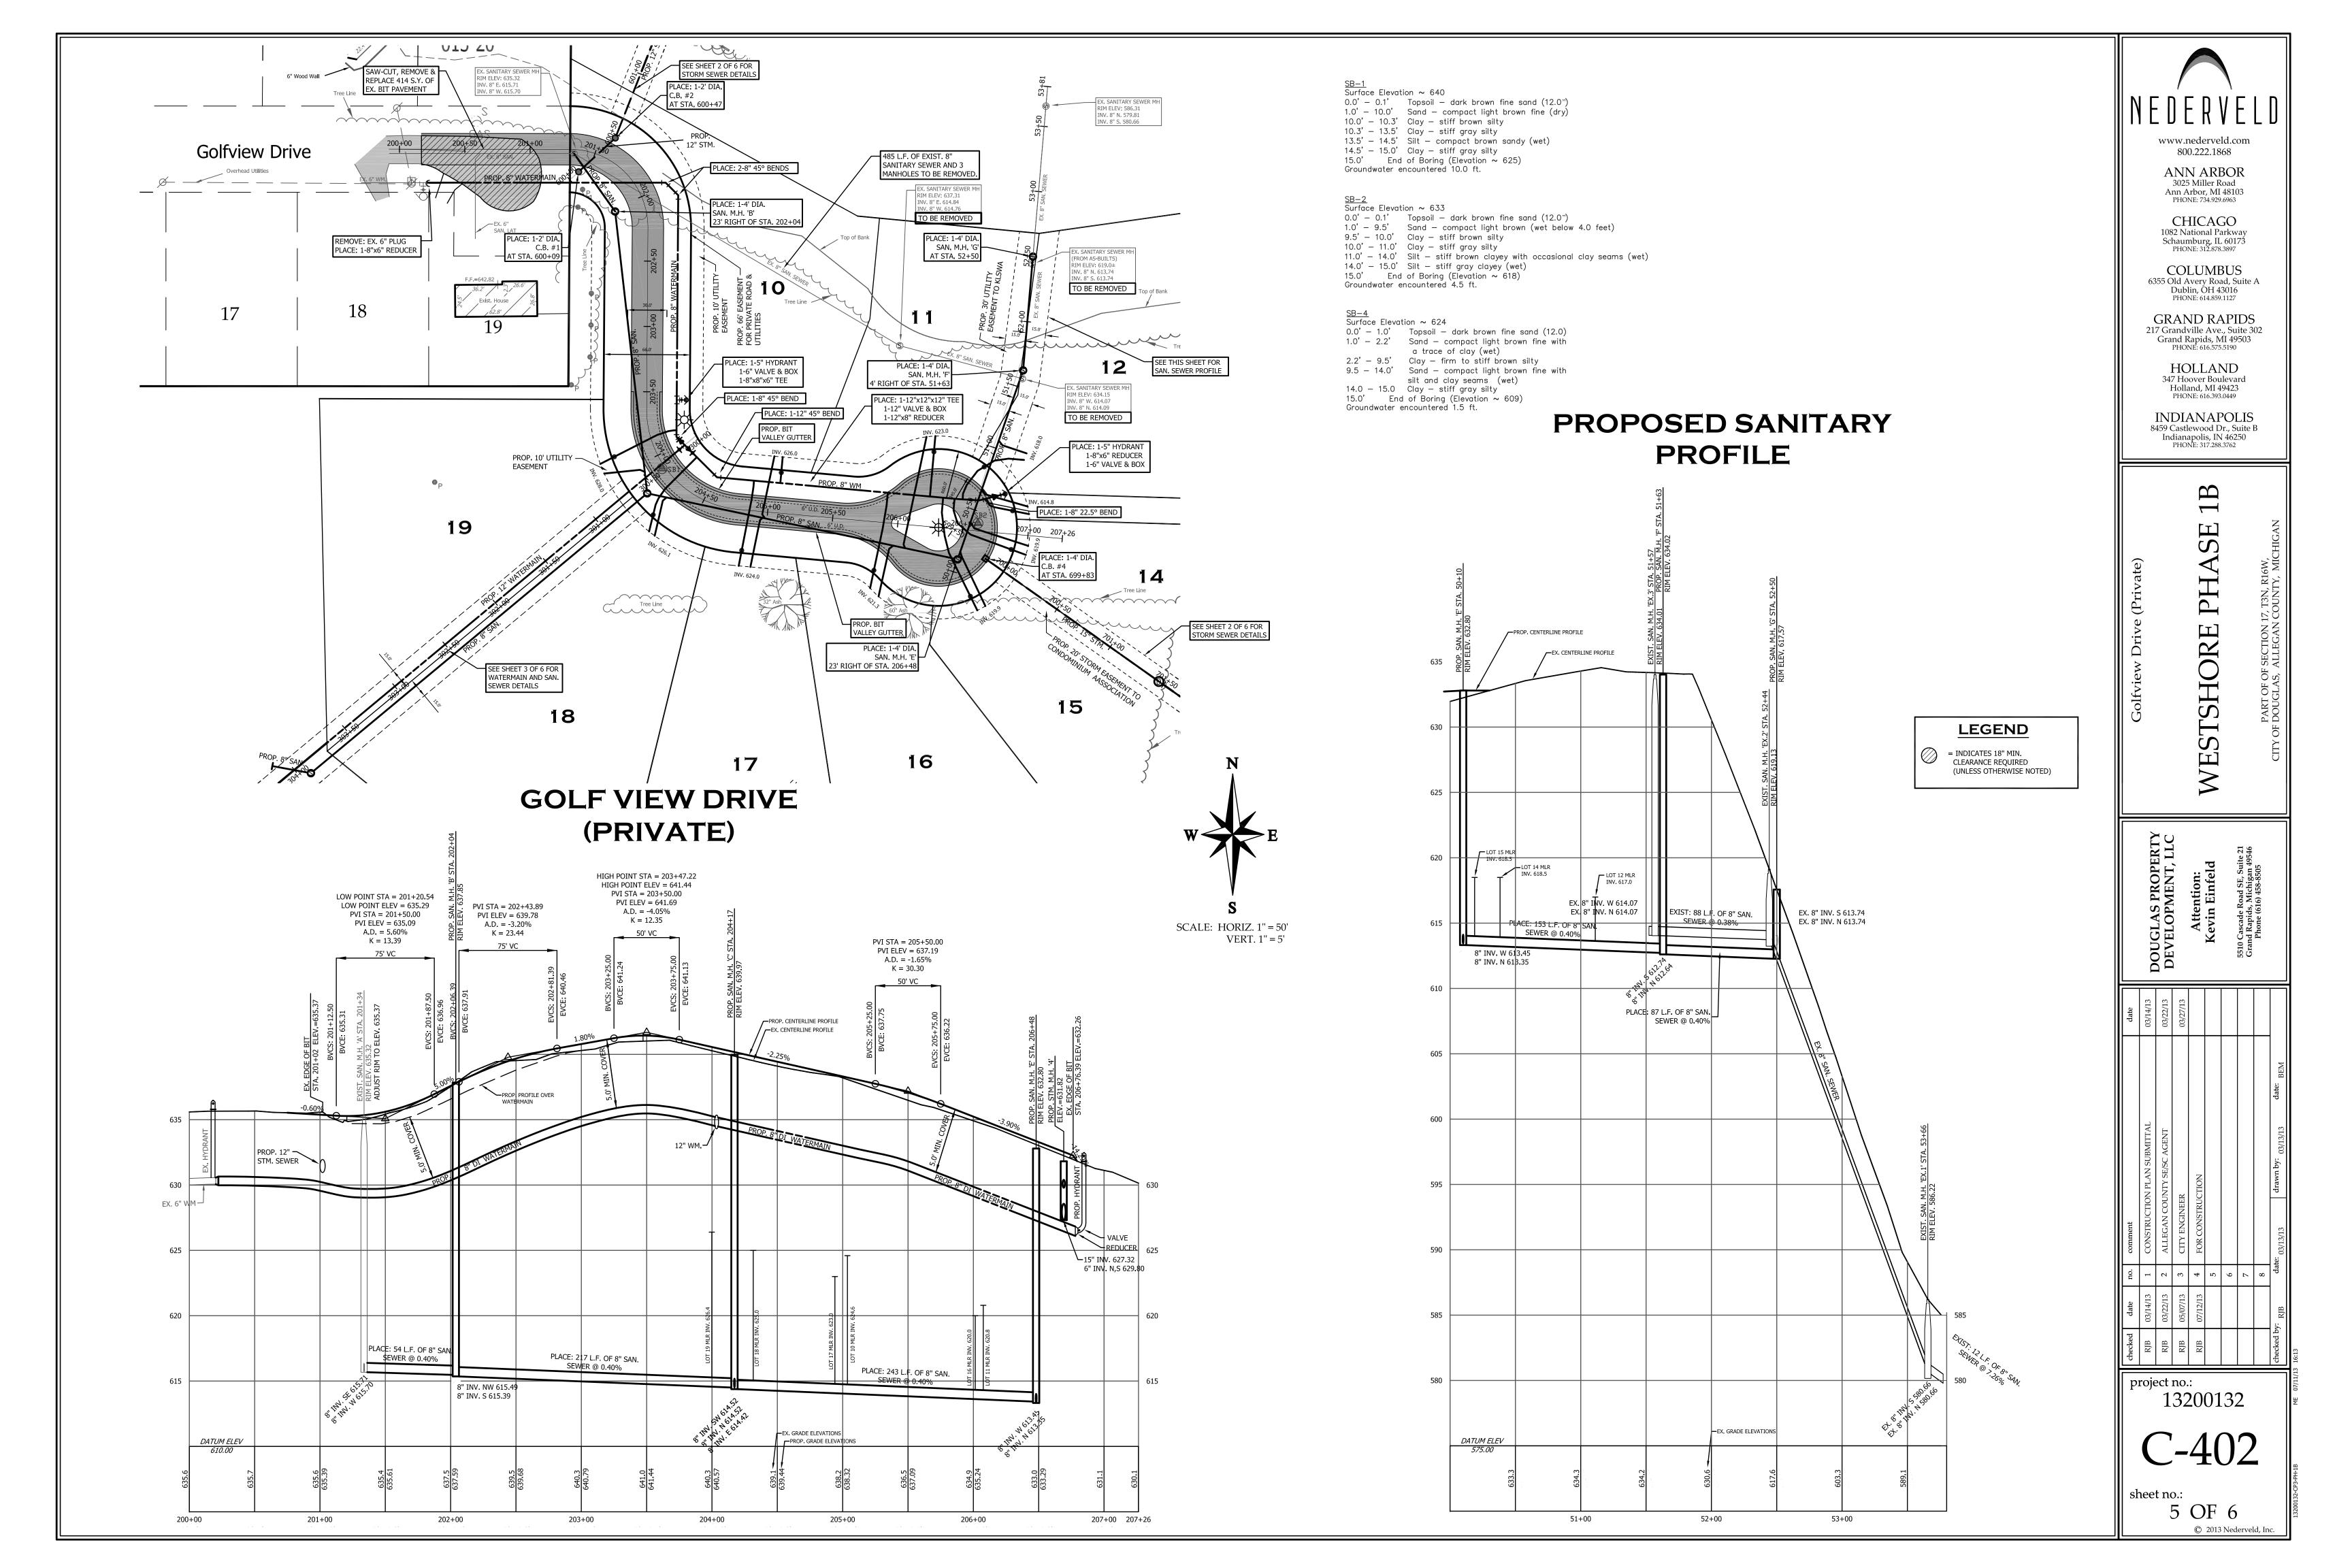


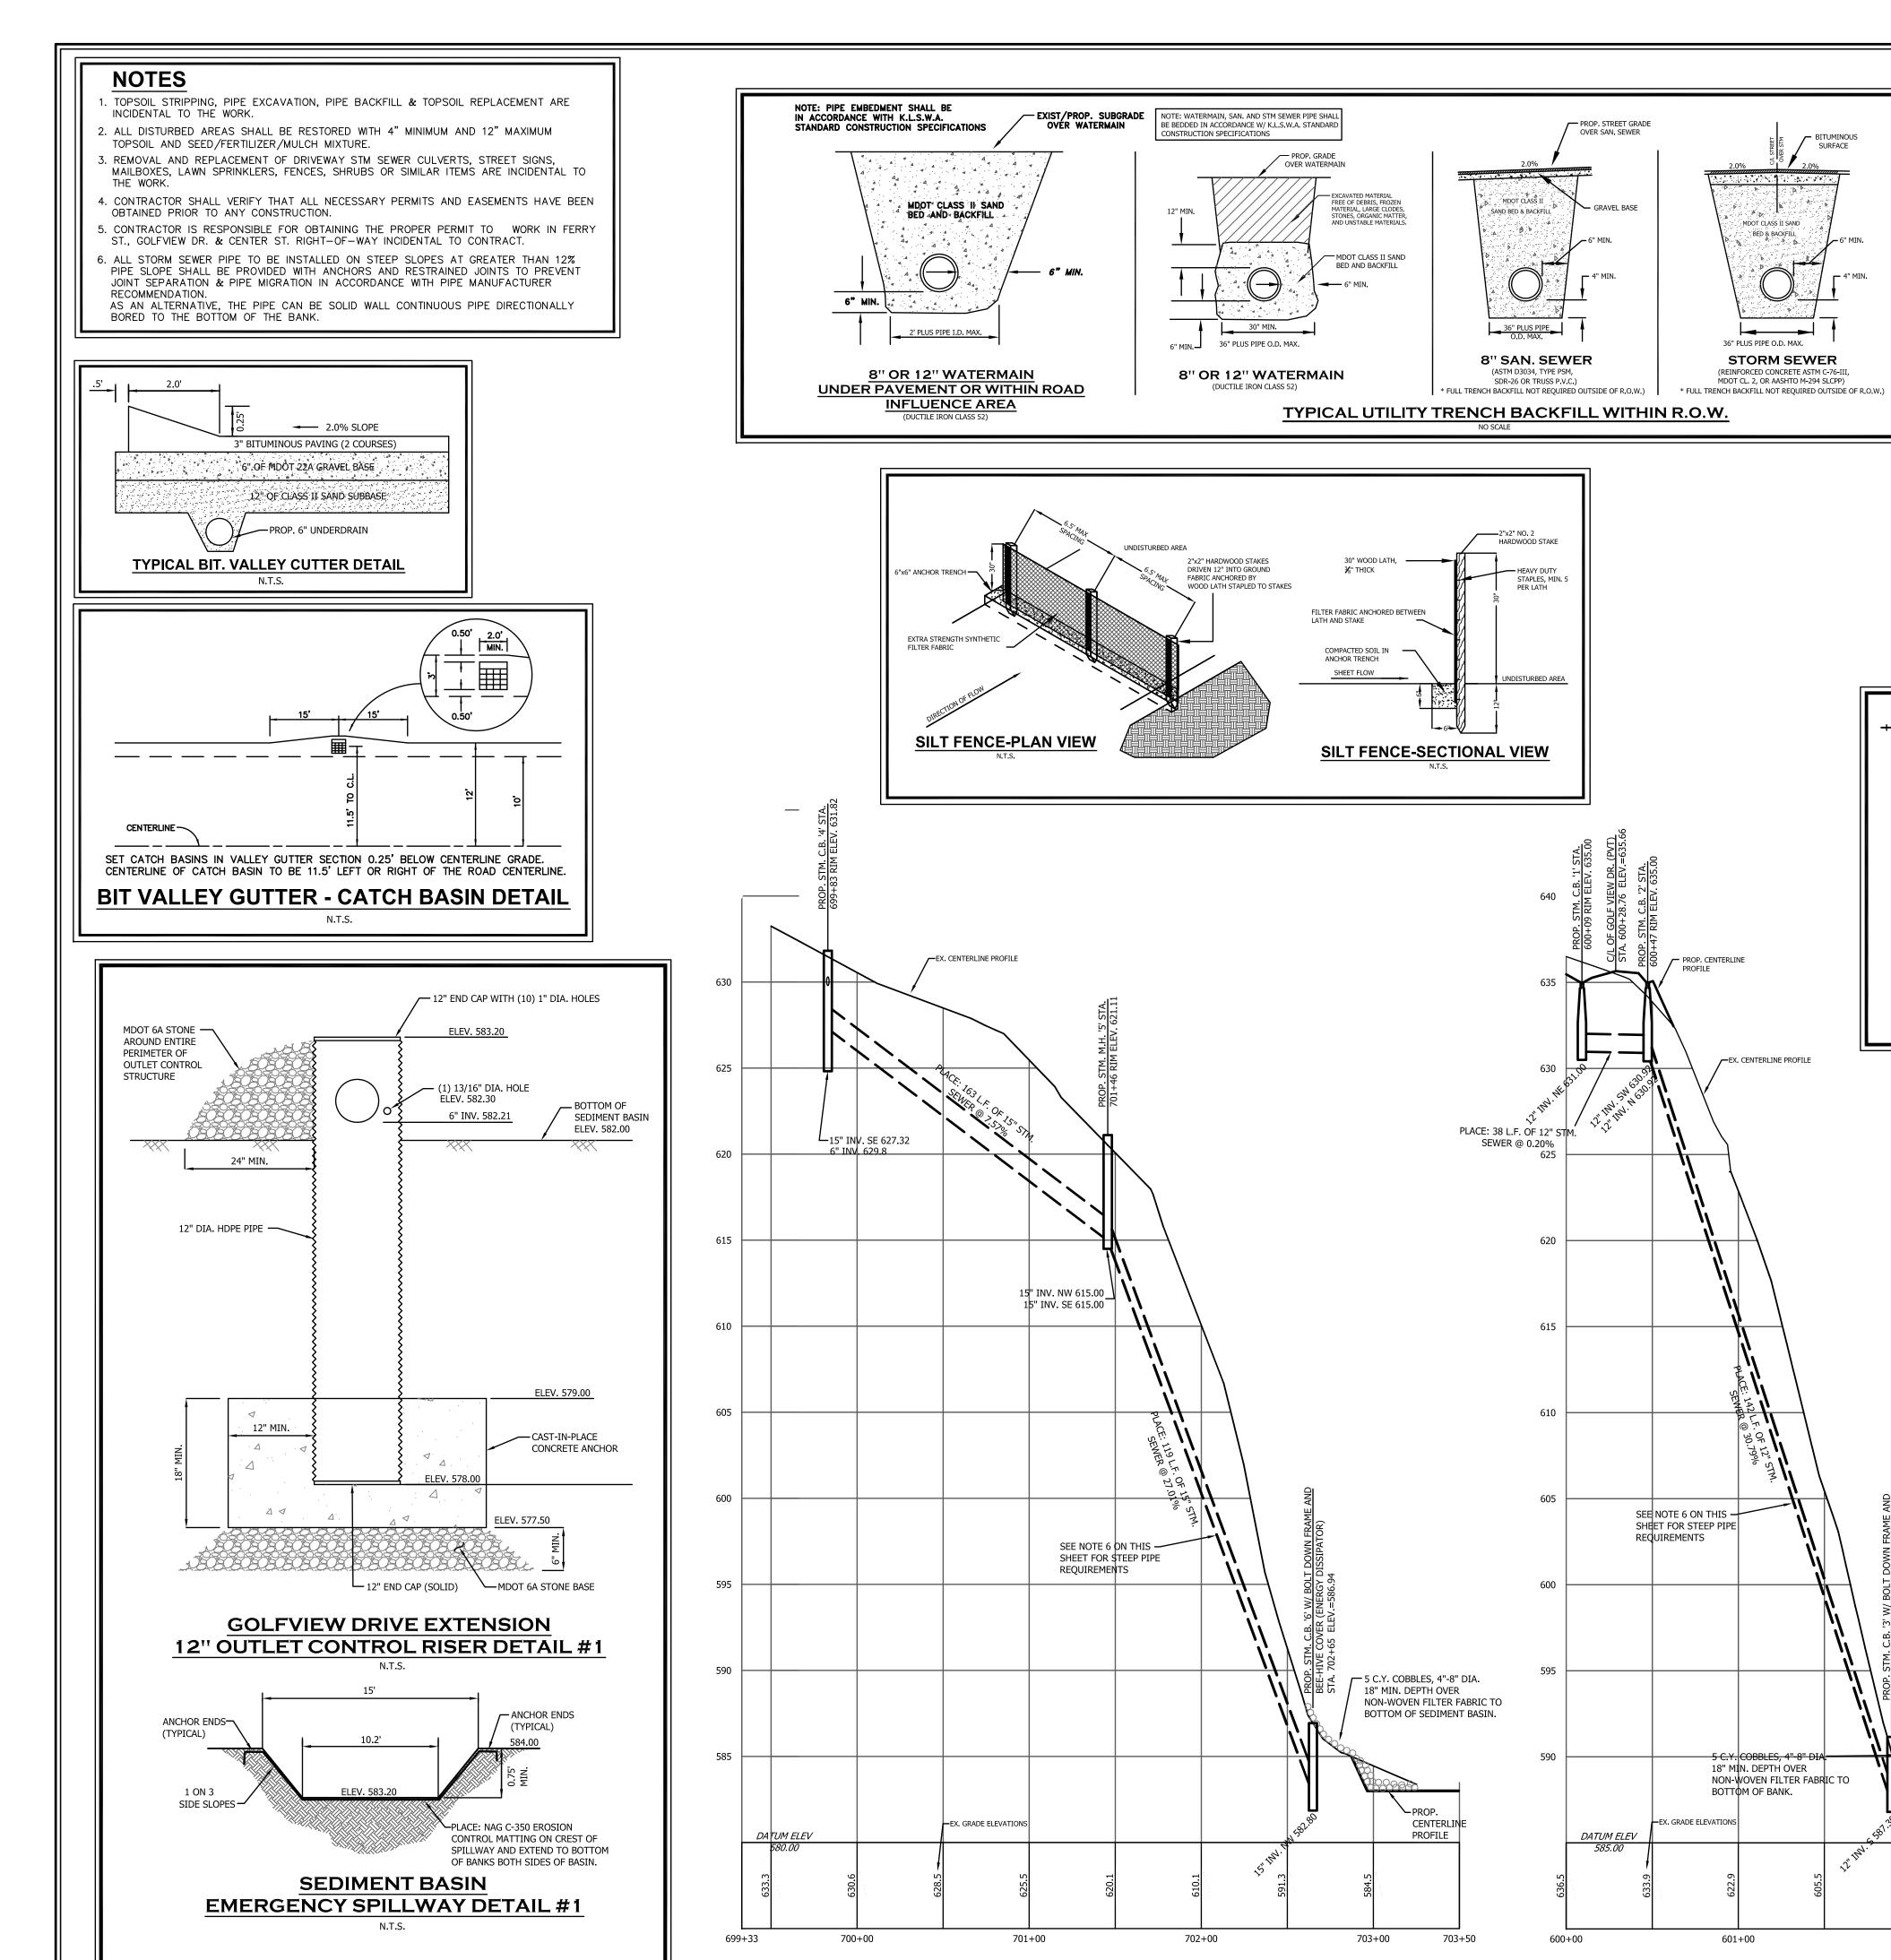



GOLFVIEW DRIVE EXTENSION

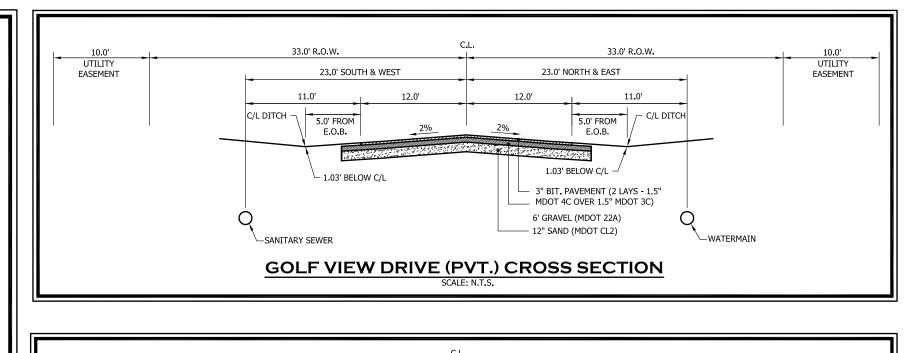


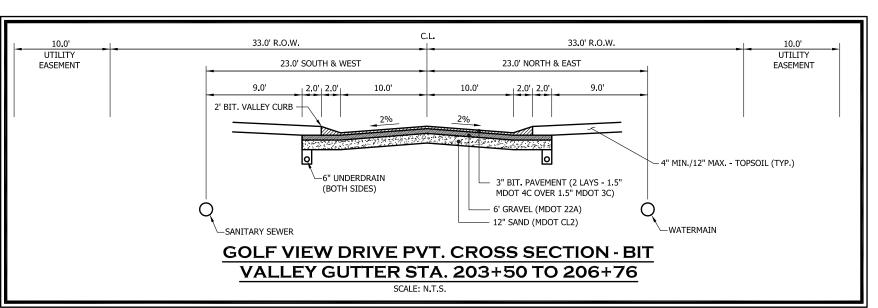

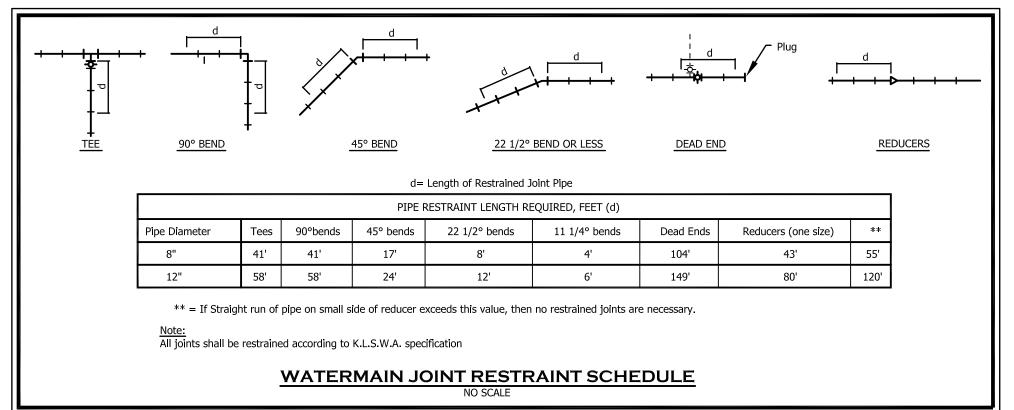

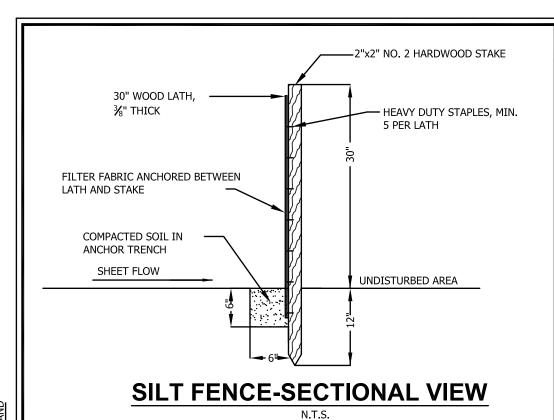

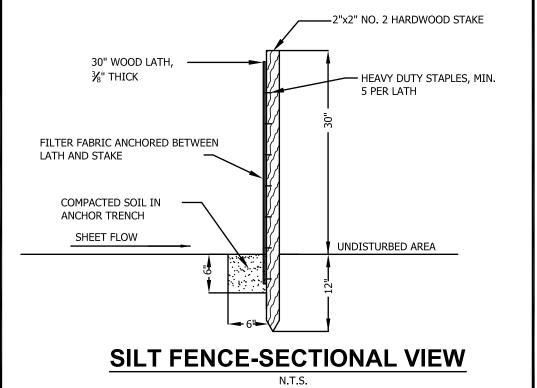

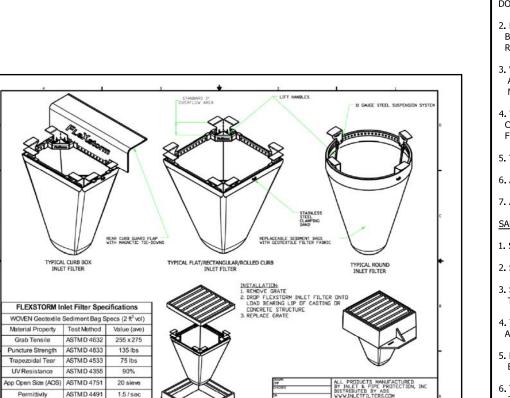

STORM SEWER NO.3



AVAILABLE RECORDS. THEY SHOULD NOT BE INTERPRETED TO BE EXACT LOCATIONS NOR SHOULD IT BE ASSUMED THAT THEY ARE THE ONLY UTILITIES IN THIS AREA.

EXISTING UTILITIES AND SERVICE LINES IDENTIFIED AS "(PLAN)" WERE OBTAINED FROM AVAILABLE CITY AS-BUILT RECORD DRAWINGS. THE CONTRACTOR SHALL VERIFY THE LOCATION, DEPTH AND STATUS OF ALL UTILITIES AND SERVICE LINES PRIOR TO NEW CONNECTIONS.

GENERAL NOTES.
1. CONSTRUCTION OF SANITARY SEWER, WATERMAIN, STORM SEWER AND SIDEWALK IMPROVEMENTS SHALL BE IN ACCORDANCE WITH THE CURRENT VILLAGE OF DOUGLAS & KLSWA STANDARD CONSTRUCTION REQUIREMENTS.
2. PROVIDE SIEVE ANALYSIS ON EXISTING SOILS TO DETERMINE IF THEY MEET CLASS II SPECIFICATIONS FOR BACKFILL.

3. INSTALLATION OF S.L.C.P.P. STORM SEWER MUST COMPLY WITH M.D.O.T. SPECIFICATIONS (INCLUDING MIN. COVER AND 30 DAY

ROADWAY & UTILITY TRENCH BACKFILL MATERIAL SHALL MEET MDOT CLASS II SPECIFICATIONS.

COORDINATE TAP OF THE EXISTING WATERMAIN WITH KLSWA & VILLAGE OF OUGLAS WATER AND SEWER DEPARTMENT. . HYDRANT WEEP HOLES SHALL BE OPEN UNLESS CONSTRUCTED

BELOW WATER TABLE. MEGA LUGS OR RODDING IS REQUIRED FOR REACTION BACKING.

. WATER SERVICES SHALL BE MARKED WITH A SECTION OF PVC PIPE AT THE CURB STOP & BOX (EXTENDING 3' ABOVE GROUND AT A

4. WATER SERVICE FITTINGS SHALL BE COMPRESSION FITTINGS.

CONTRACTORS SHALL PROVIDE ELECTRICAL CONTINUITY ON 5. TESTING SHALL CONFORM TO KLSWA STANDARDS.

6. ALL CURB STOPS SHALL BE FURNISHED WITH STATIONARY RODS. 7. ALL WATERMAIN IS TO BE DUCTILE IRON PIPE CLASS 52. SANITARY SEWER CONSTRUCTION

1. SANITARY SEWER PIPE SHALL BE ASTM 3034, SDR 35 PVC OR SDR 26 PVC AS NOTED ON THE PLANS.

3. SANITARY SEWER CONSTRUCTION SHALL BE IN ACCORDANCE WITH THE STANDARD SPECIFICATIONS OF THE KLSWA. (INCL. TESTING) 4. TEMP. PLUG TO BE PLACED IN EX. SEWER UNTIL NEW SEWER IS

ACCEPTED BY KLSWA. MANHOLES SHALL BE PRECAST, BOOT TYPE WITH OUTER BITUMINOUS COATING.

2"x 2" WOOD STAKE AND A STEEL REROD, COVERED WITH A SECTION OF PVC PIPE EXTENDING 3' ABOVE GRADE.

sheet no.: . A 6" PROPERTY LINE RISER SHALL BE PLACED AT THE END

Attention: Kevin Einfeld

www.nederveld.com

800.222.1868

ANN ARBOR

3025 Miller Road

Ann Arbor, MI 48103

PHONE: 734.929.6963

CHICAGO

1082 National Parkway

Schaumburg, IL 60173

PHONE: 312.878.3897

COLUMBUS

6355 Old Avery Road, Suite A

Dublin, OH 43016

PHONE: 614.859.1127

GRAND RAPIDS

217 Grandville Ave., Suite 302

Grand Rapids, MI 49503 PHONE: 616.575.5190

HOLLAND

347 Hoover Boulevard

Holland, MI 49423 PHONE: 616.393.0449

INDIANAPOLIS


8459 Castlewood Dr., Suite B


PHONE: 317.288.3762


Indianapolis, IN 46250

RE


project no.: 13200132

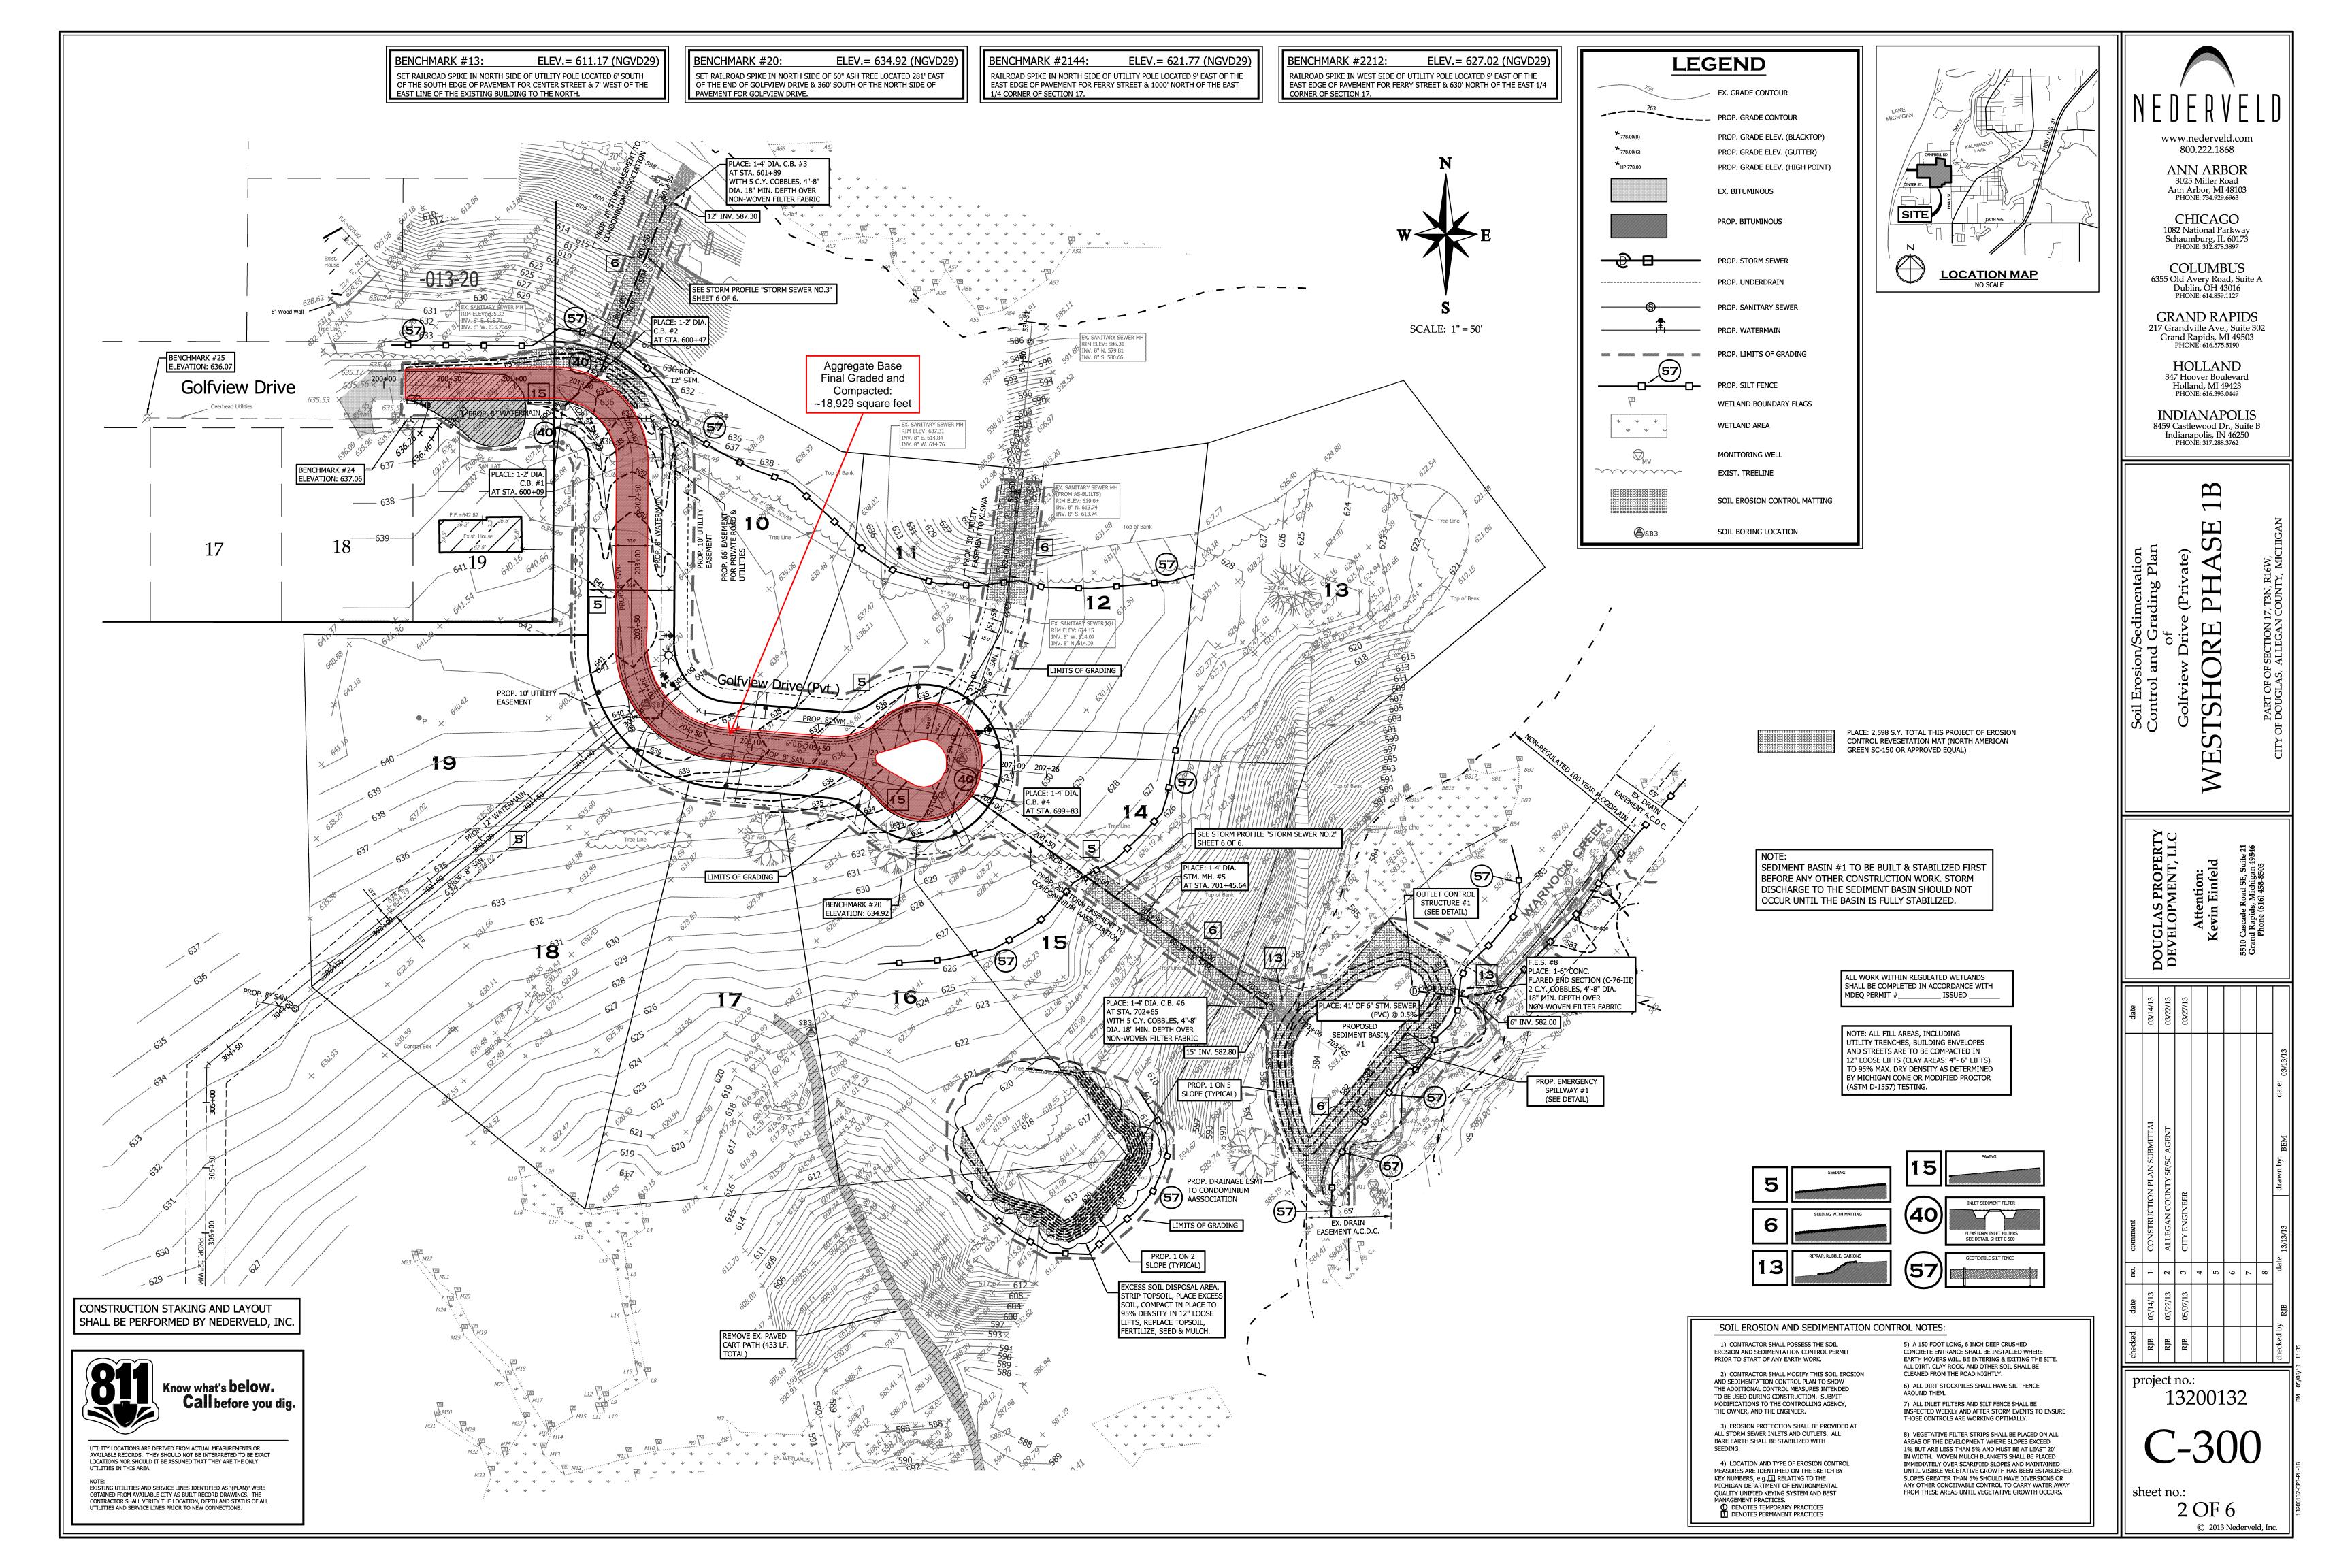


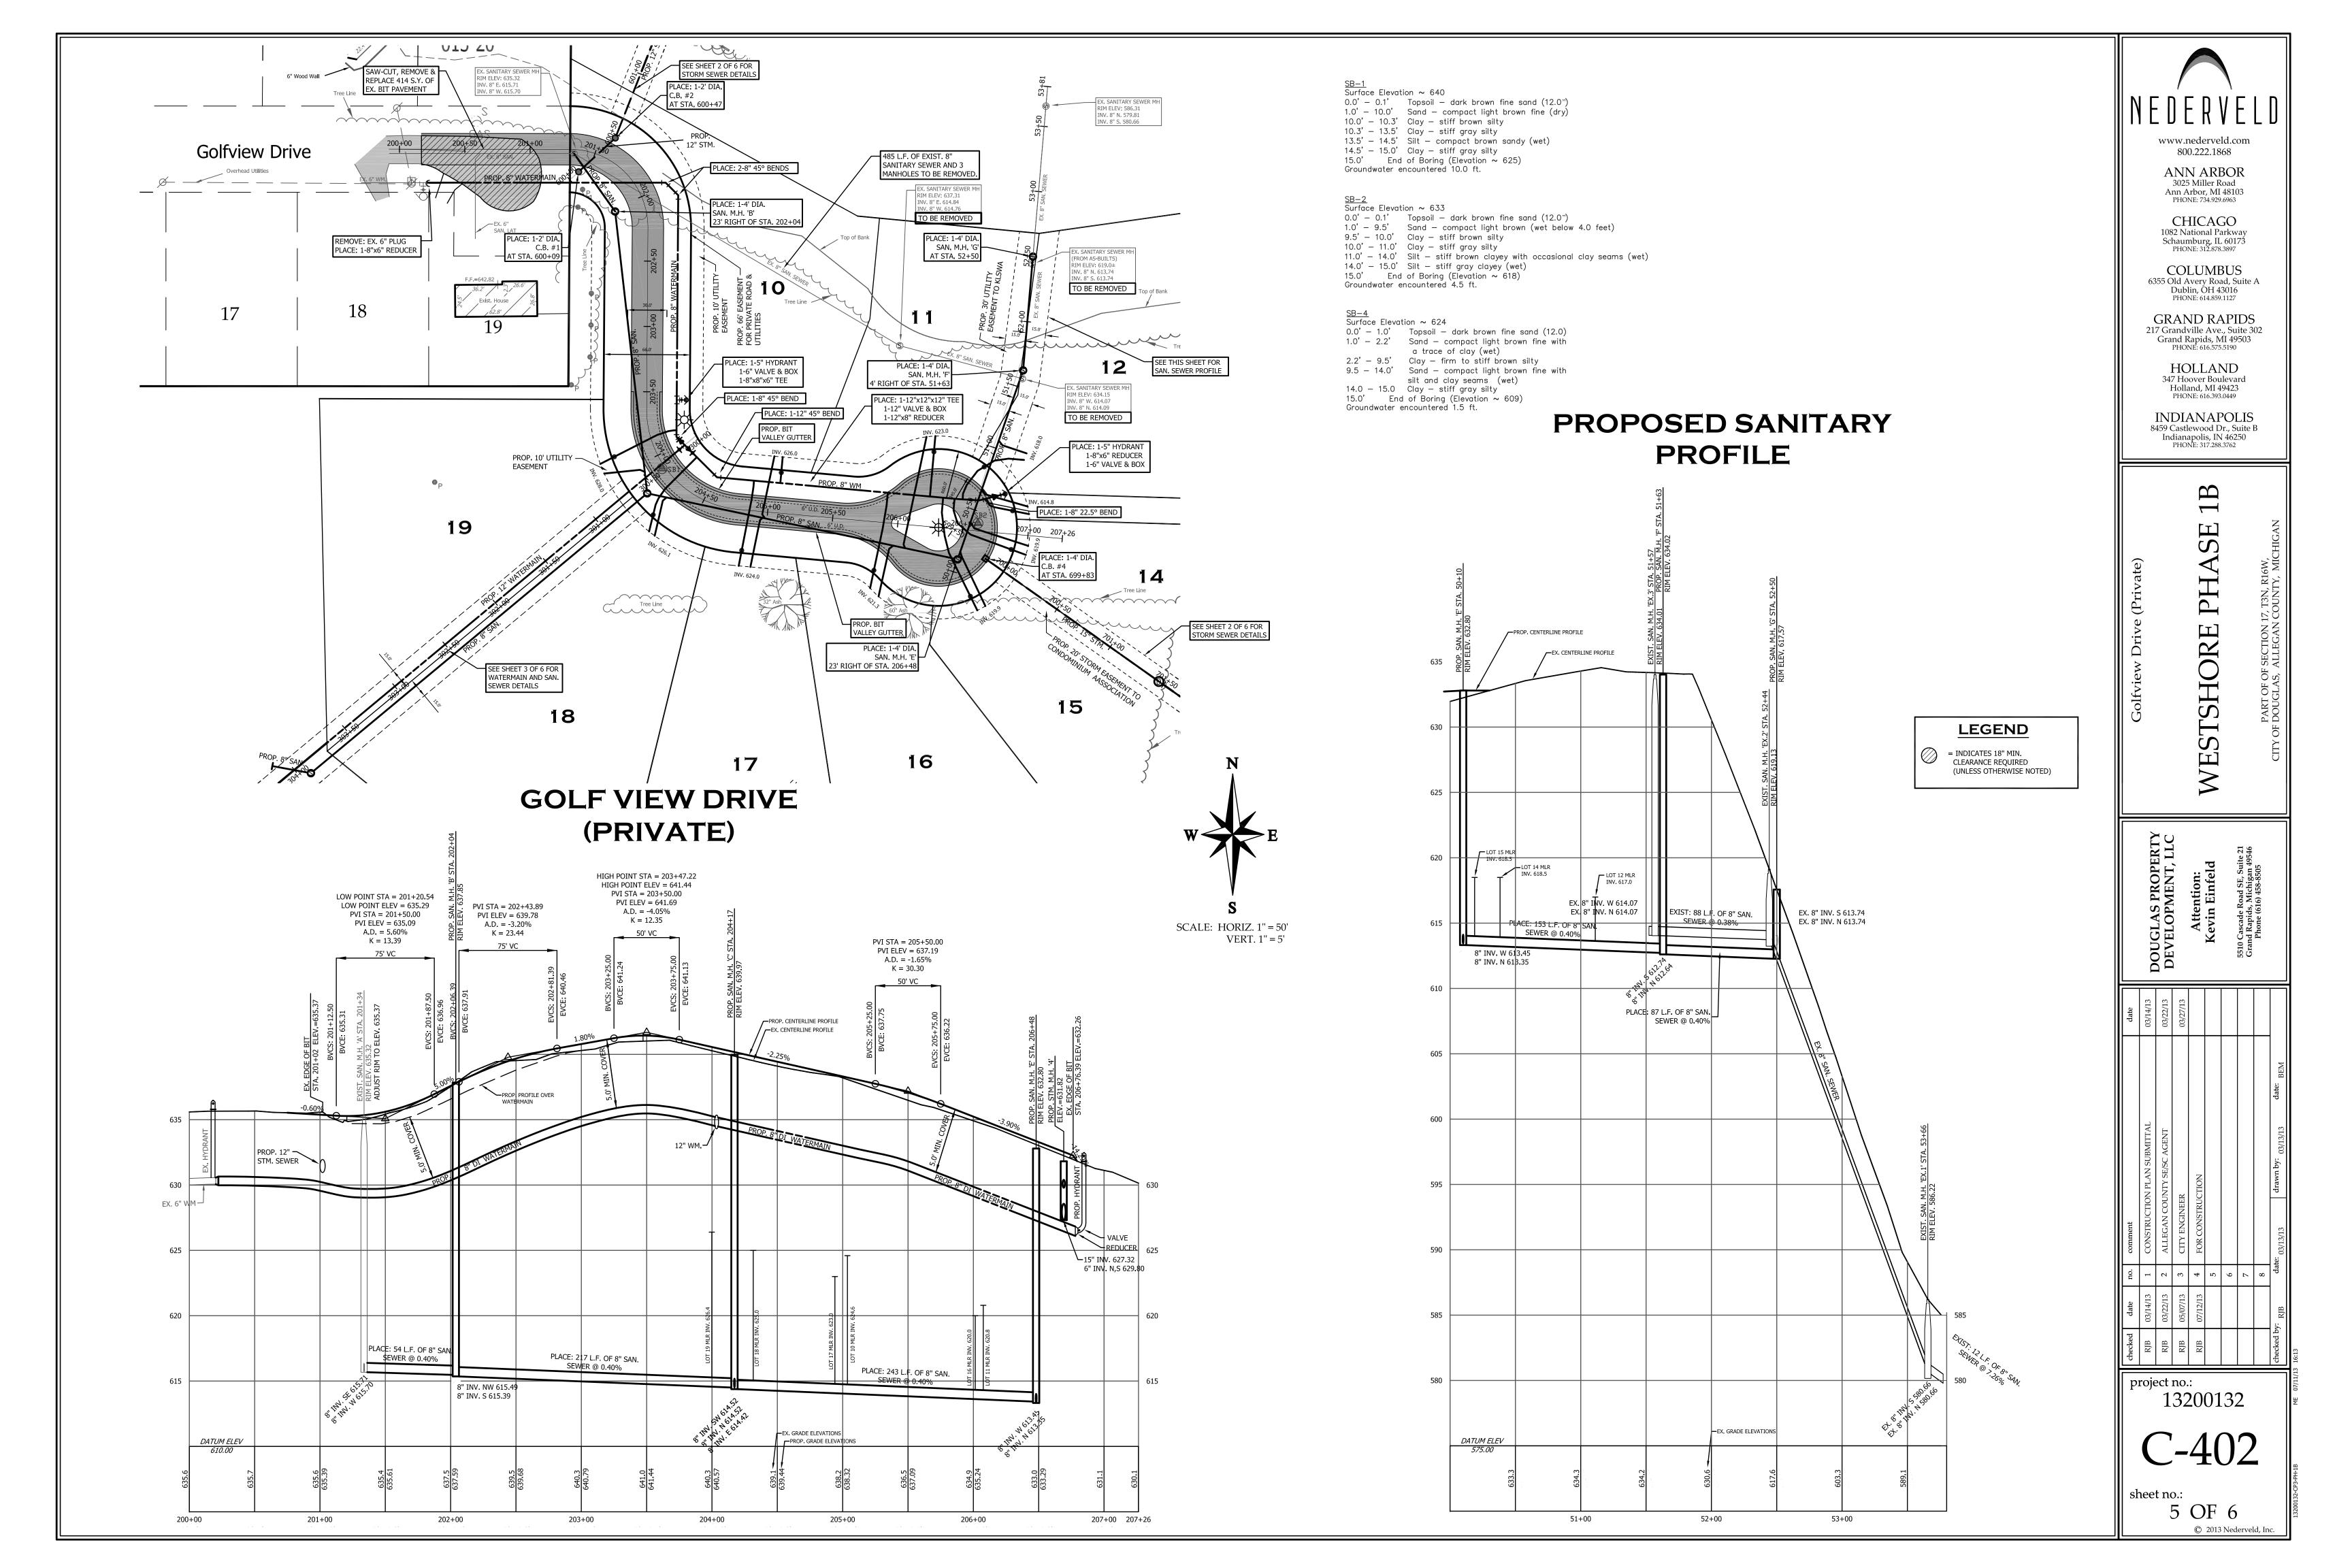


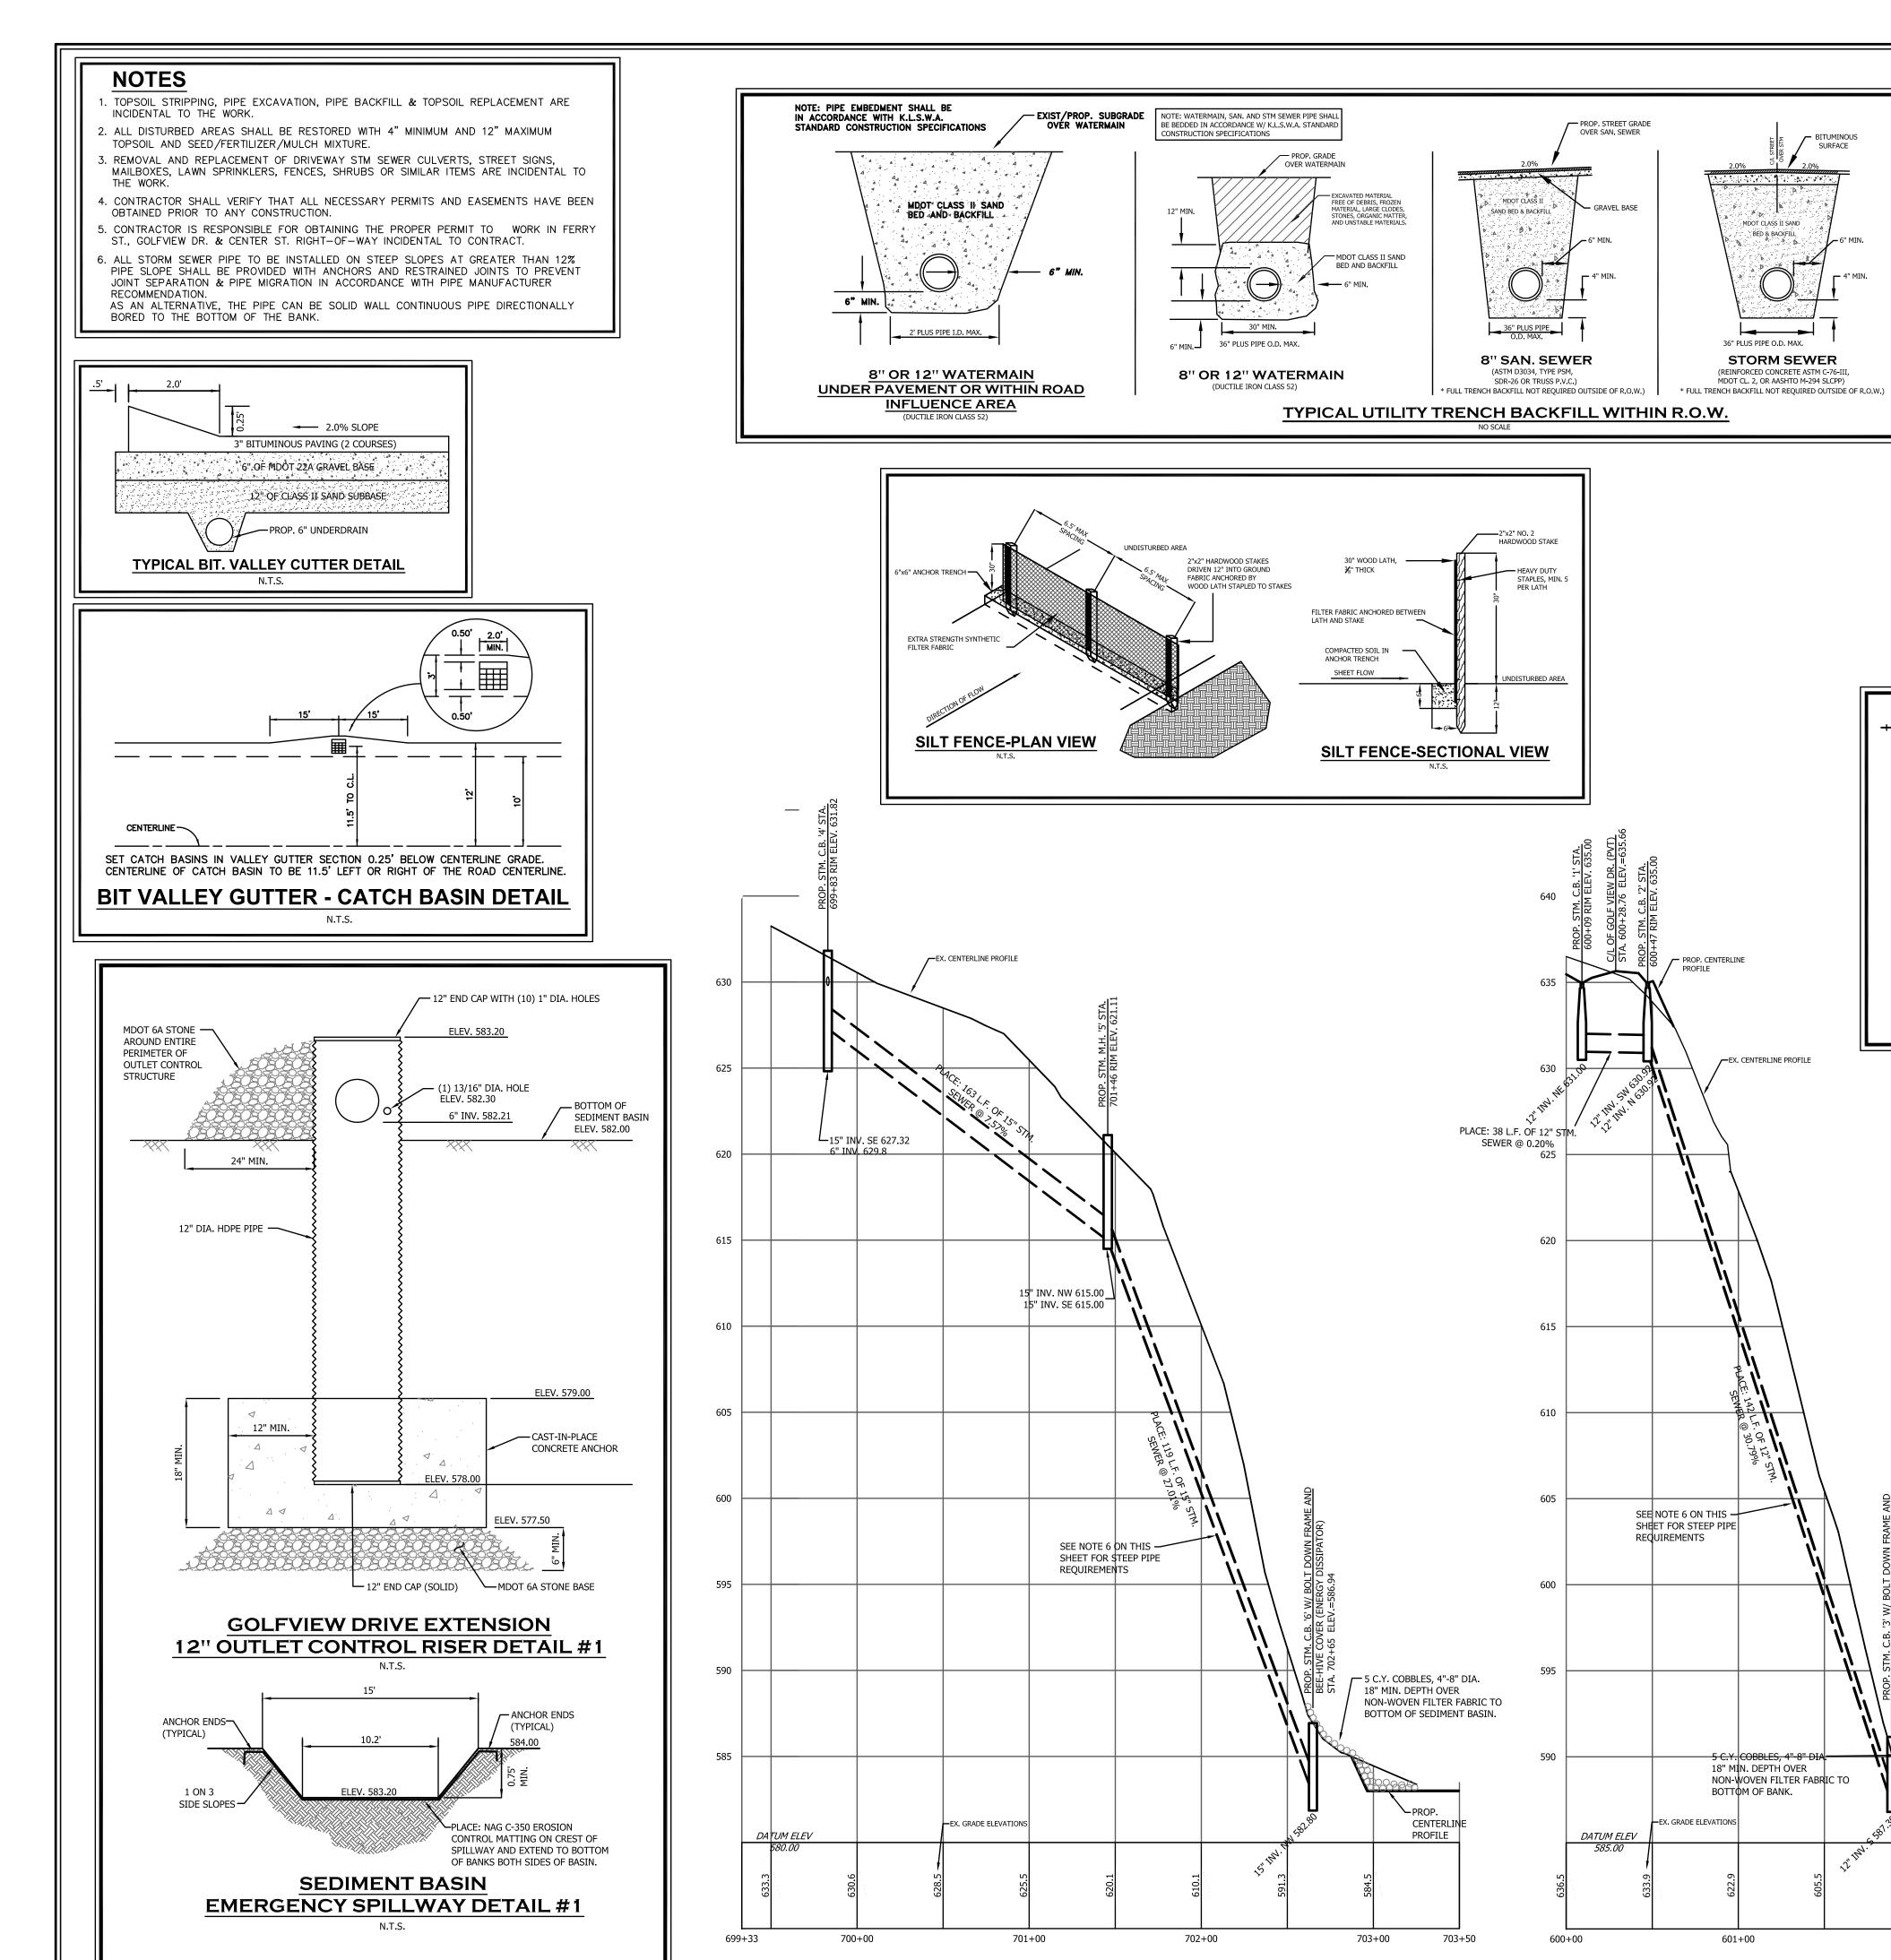



GOLFVIEW DRIVE EXTENSION

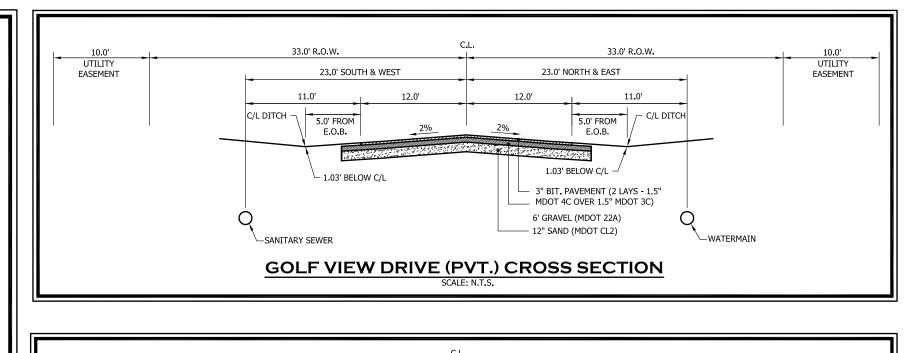


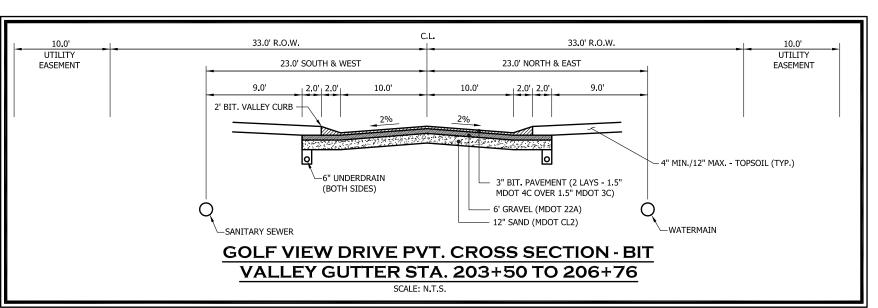

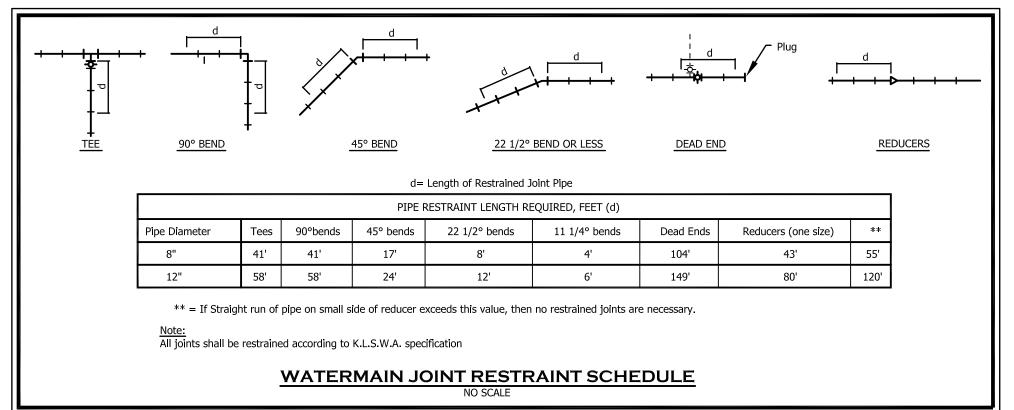

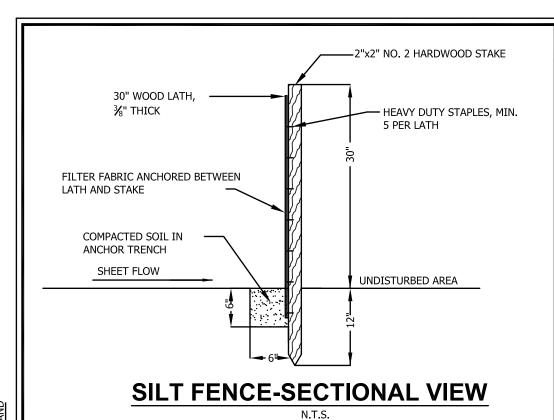

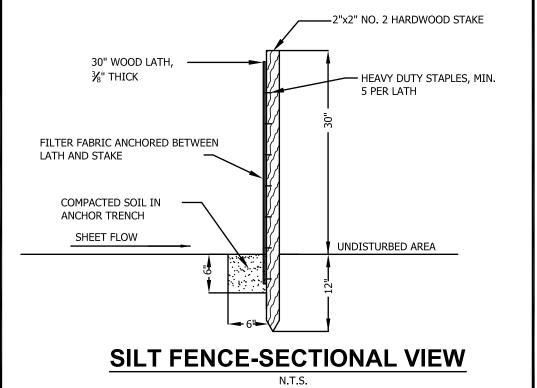

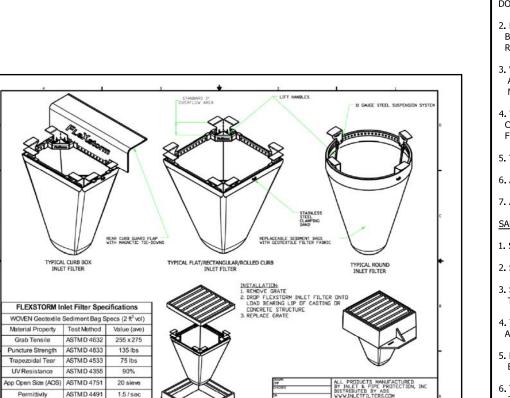

STORM SEWER NO.3



AVAILABLE RECORDS. THEY SHOULD NOT BE INTERPRETED TO BE EXACT LOCATIONS NOR SHOULD IT BE ASSUMED THAT THEY ARE THE ONLY UTILITIES IN THIS AREA.

EXISTING UTILITIES AND SERVICE LINES IDENTIFIED AS "(PLAN)" WERE OBTAINED FROM AVAILABLE CITY AS-BUILT RECORD DRAWINGS. THE CONTRACTOR SHALL VERIFY THE LOCATION, DEPTH AND STATUS OF ALL UTILITIES AND SERVICE LINES PRIOR TO NEW CONNECTIONS.

GENERAL NOTES.
1. CONSTRUCTION OF SANITARY SEWER, WATERMAIN, STORM SEWER AND SIDEWALK IMPROVEMENTS SHALL BE IN ACCORDANCE WITH THE CURRENT VILLAGE OF DOUGLAS & KLSWA STANDARD CONSTRUCTION REQUIREMENTS.
2. PROVIDE SIEVE ANALYSIS ON EXISTING SOILS TO DETERMINE IF THEY MEET CLASS II SPECIFICATIONS FOR BACKFILL.

3. INSTALLATION OF S.L.C.P.P. STORM SEWER MUST COMPLY WITH M.D.O.T. SPECIFICATIONS (INCLUDING MIN. COVER AND 30 DAY

ROADWAY & UTILITY TRENCH BACKFILL MATERIAL SHALL MEET MDOT CLASS II SPECIFICATIONS.

COORDINATE TAP OF THE EXISTING WATERMAIN WITH KLSWA & VILLAGE OF OUGLAS WATER AND SEWER DEPARTMENT. . HYDRANT WEEP HOLES SHALL BE OPEN UNLESS CONSTRUCTED

BELOW WATER TABLE. MEGA LUGS OR RODDING IS REQUIRED FOR REACTION BACKING.

. WATER SERVICES SHALL BE MARKED WITH A SECTION OF PVC PIPE AT THE CURB STOP & BOX (EXTENDING 3' ABOVE GROUND AT A

4. WATER SERVICE FITTINGS SHALL BE COMPRESSION FITTINGS.

CONTRACTORS SHALL PROVIDE ELECTRICAL CONTINUITY ON 5. TESTING SHALL CONFORM TO KLSWA STANDARDS.

6. ALL CURB STOPS SHALL BE FURNISHED WITH STATIONARY RODS. 7. ALL WATERMAIN IS TO BE DUCTILE IRON PIPE CLASS 52. SANITARY SEWER CONSTRUCTION

1. SANITARY SEWER PIPE SHALL BE ASTM 3034, SDR 35 PVC OR SDR 26 PVC AS NOTED ON THE PLANS.

3. SANITARY SEWER CONSTRUCTION SHALL BE IN ACCORDANCE WITH THE STANDARD SPECIFICATIONS OF THE KLSWA. (INCL. TESTING) 4. TEMP. PLUG TO BE PLACED IN EX. SEWER UNTIL NEW SEWER IS

ACCEPTED BY KLSWA. MANHOLES SHALL BE PRECAST, BOOT TYPE WITH OUTER BITUMINOUS COATING.

2"x 2" WOOD STAKE AND A STEEL REROD, COVERED WITH A SECTION OF PVC PIPE EXTENDING 3' ABOVE GRADE.

sheet no.: . A 6" PROPERTY LINE RISER SHALL BE PLACED AT THE END

Attention: Kevin Einfeld

www.nederveld.com

800.222.1868

ANN ARBOR

3025 Miller Road

Ann Arbor, MI 48103

PHONE: 734.929.6963

CHICAGO

1082 National Parkway

Schaumburg, IL 60173

PHONE: 312.878.3897

COLUMBUS

6355 Old Avery Road, Suite A

Dublin, OH 43016

PHONE: 614.859.1127

GRAND RAPIDS

217 Grandville Ave., Suite 302

Grand Rapids, MI 49503 PHONE: 616.575.5190

HOLLAND

347 Hoover Boulevard

Holland, MI 49423 PHONE: 616.393.0449

INDIANAPOLIS


8459 Castlewood Dr., Suite B


PHONE: 317.288.3762


Indianapolis, IN 46250

RE


project no.: 13200132

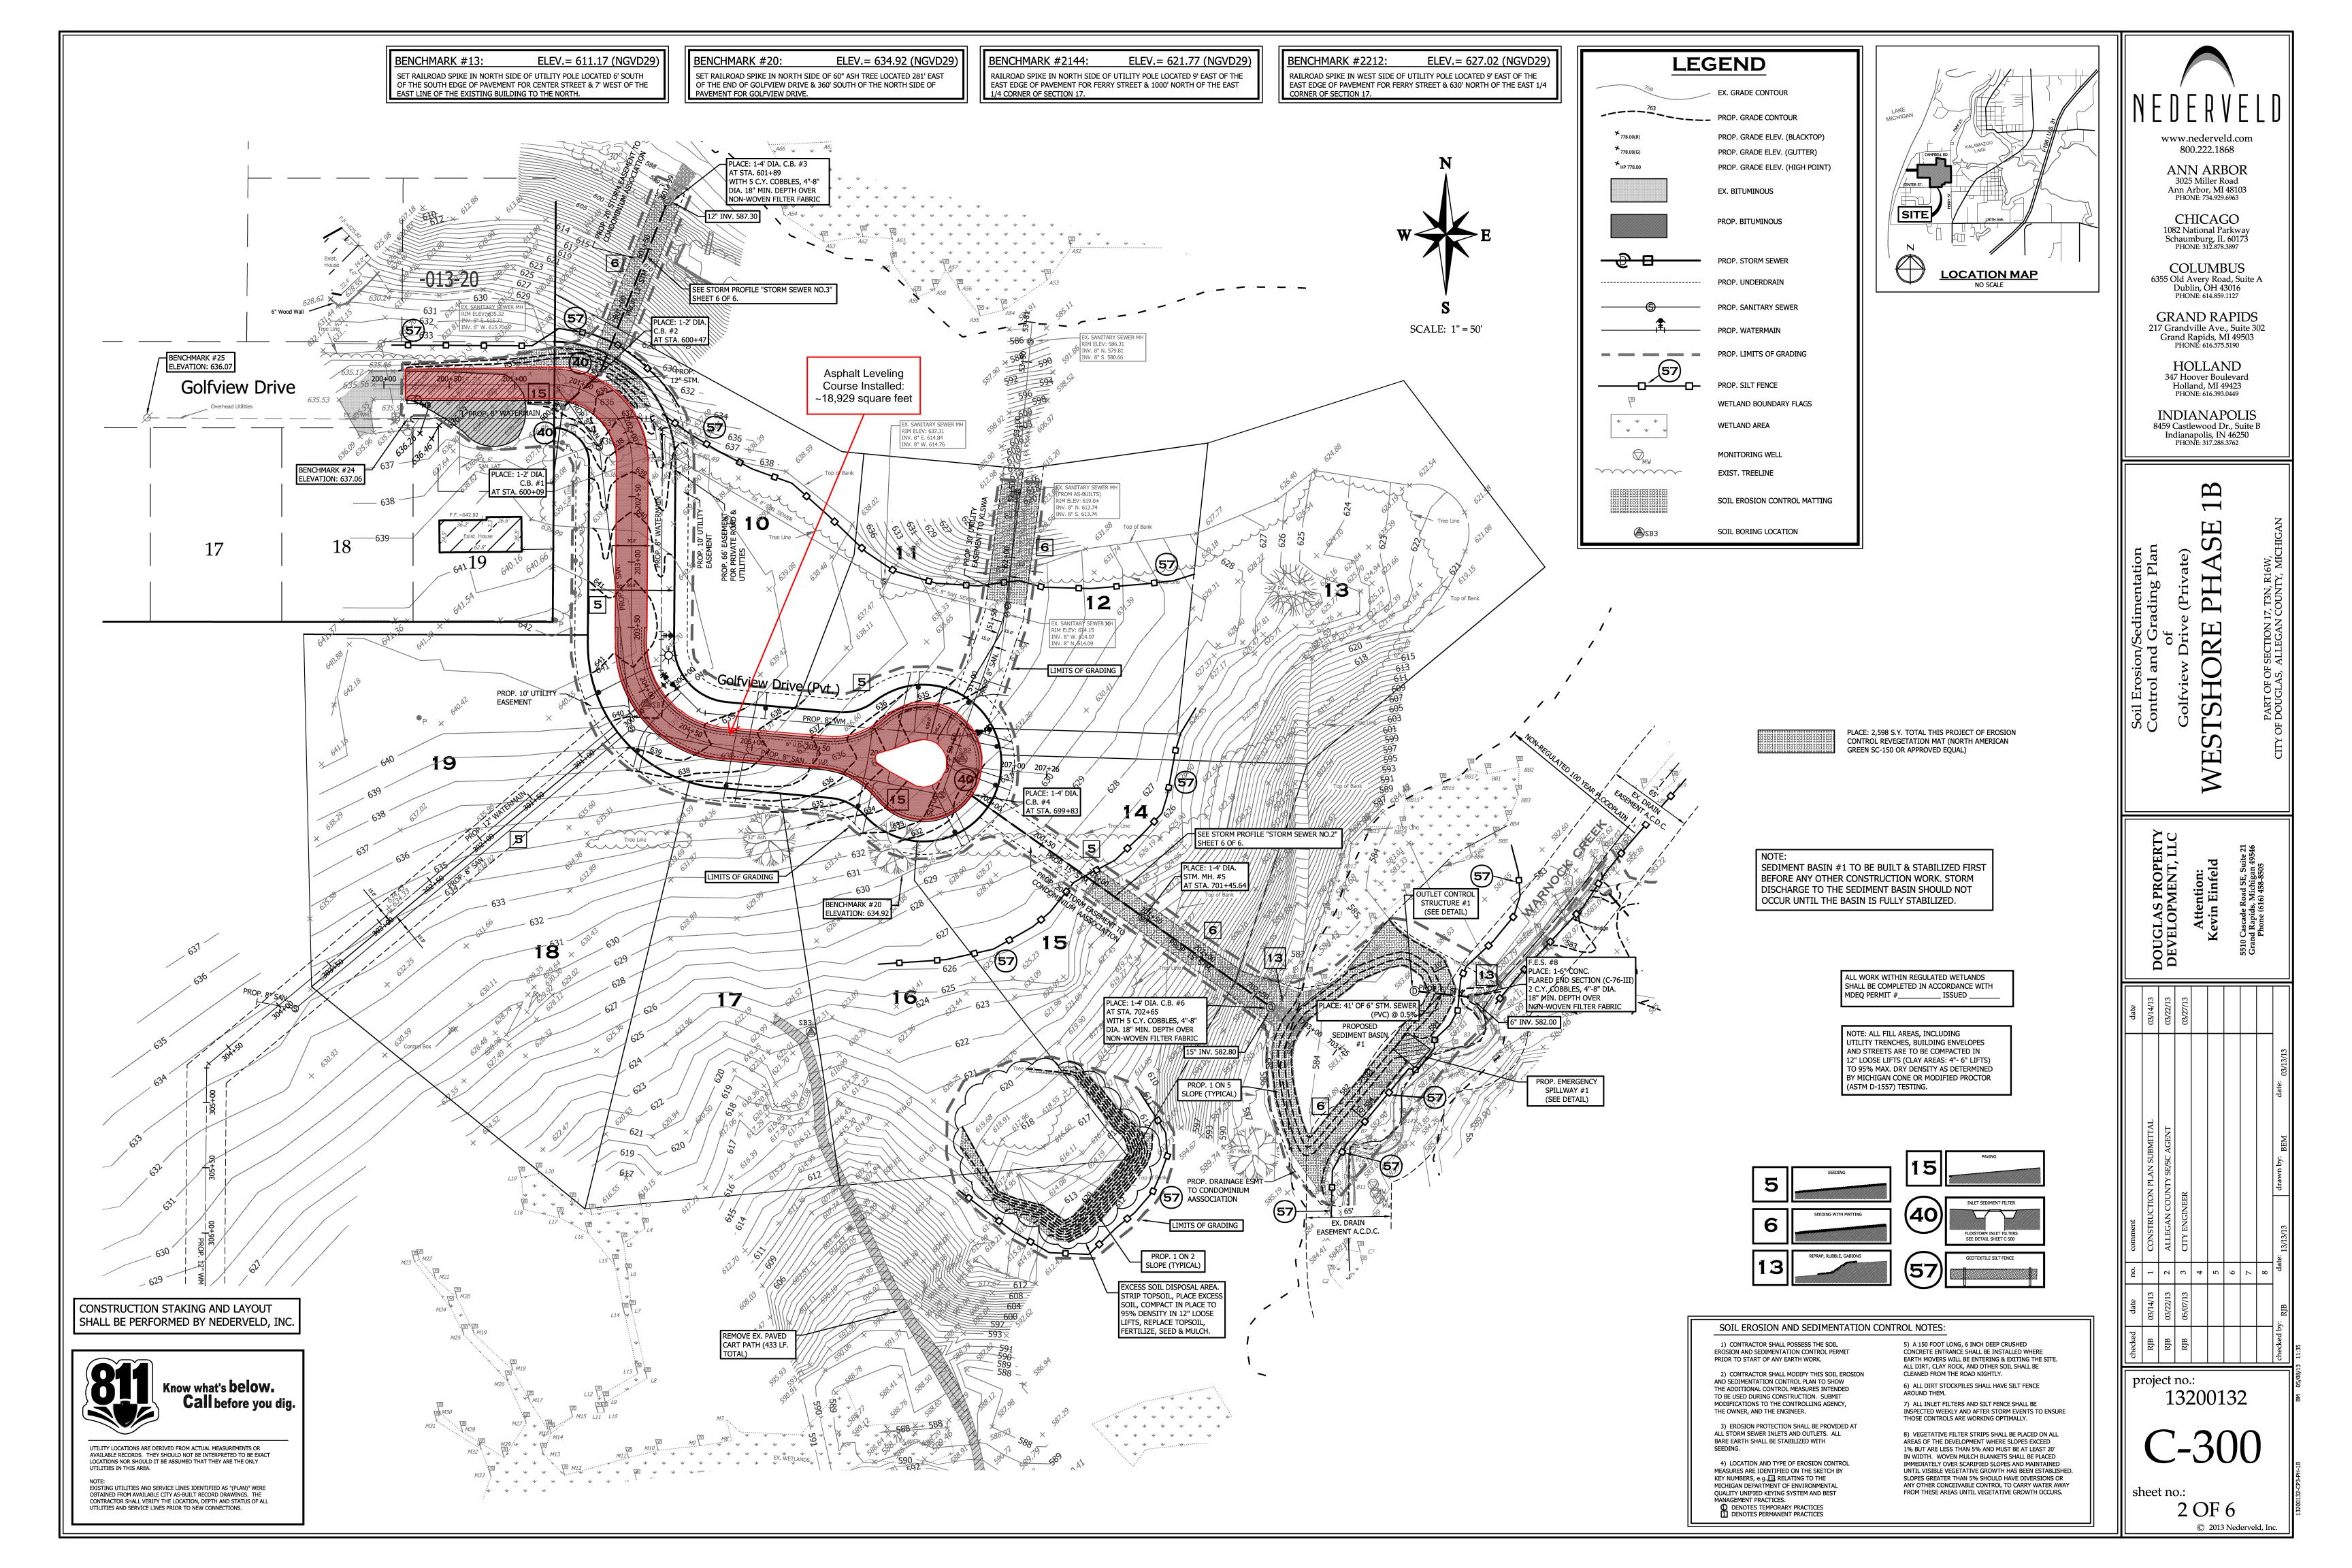


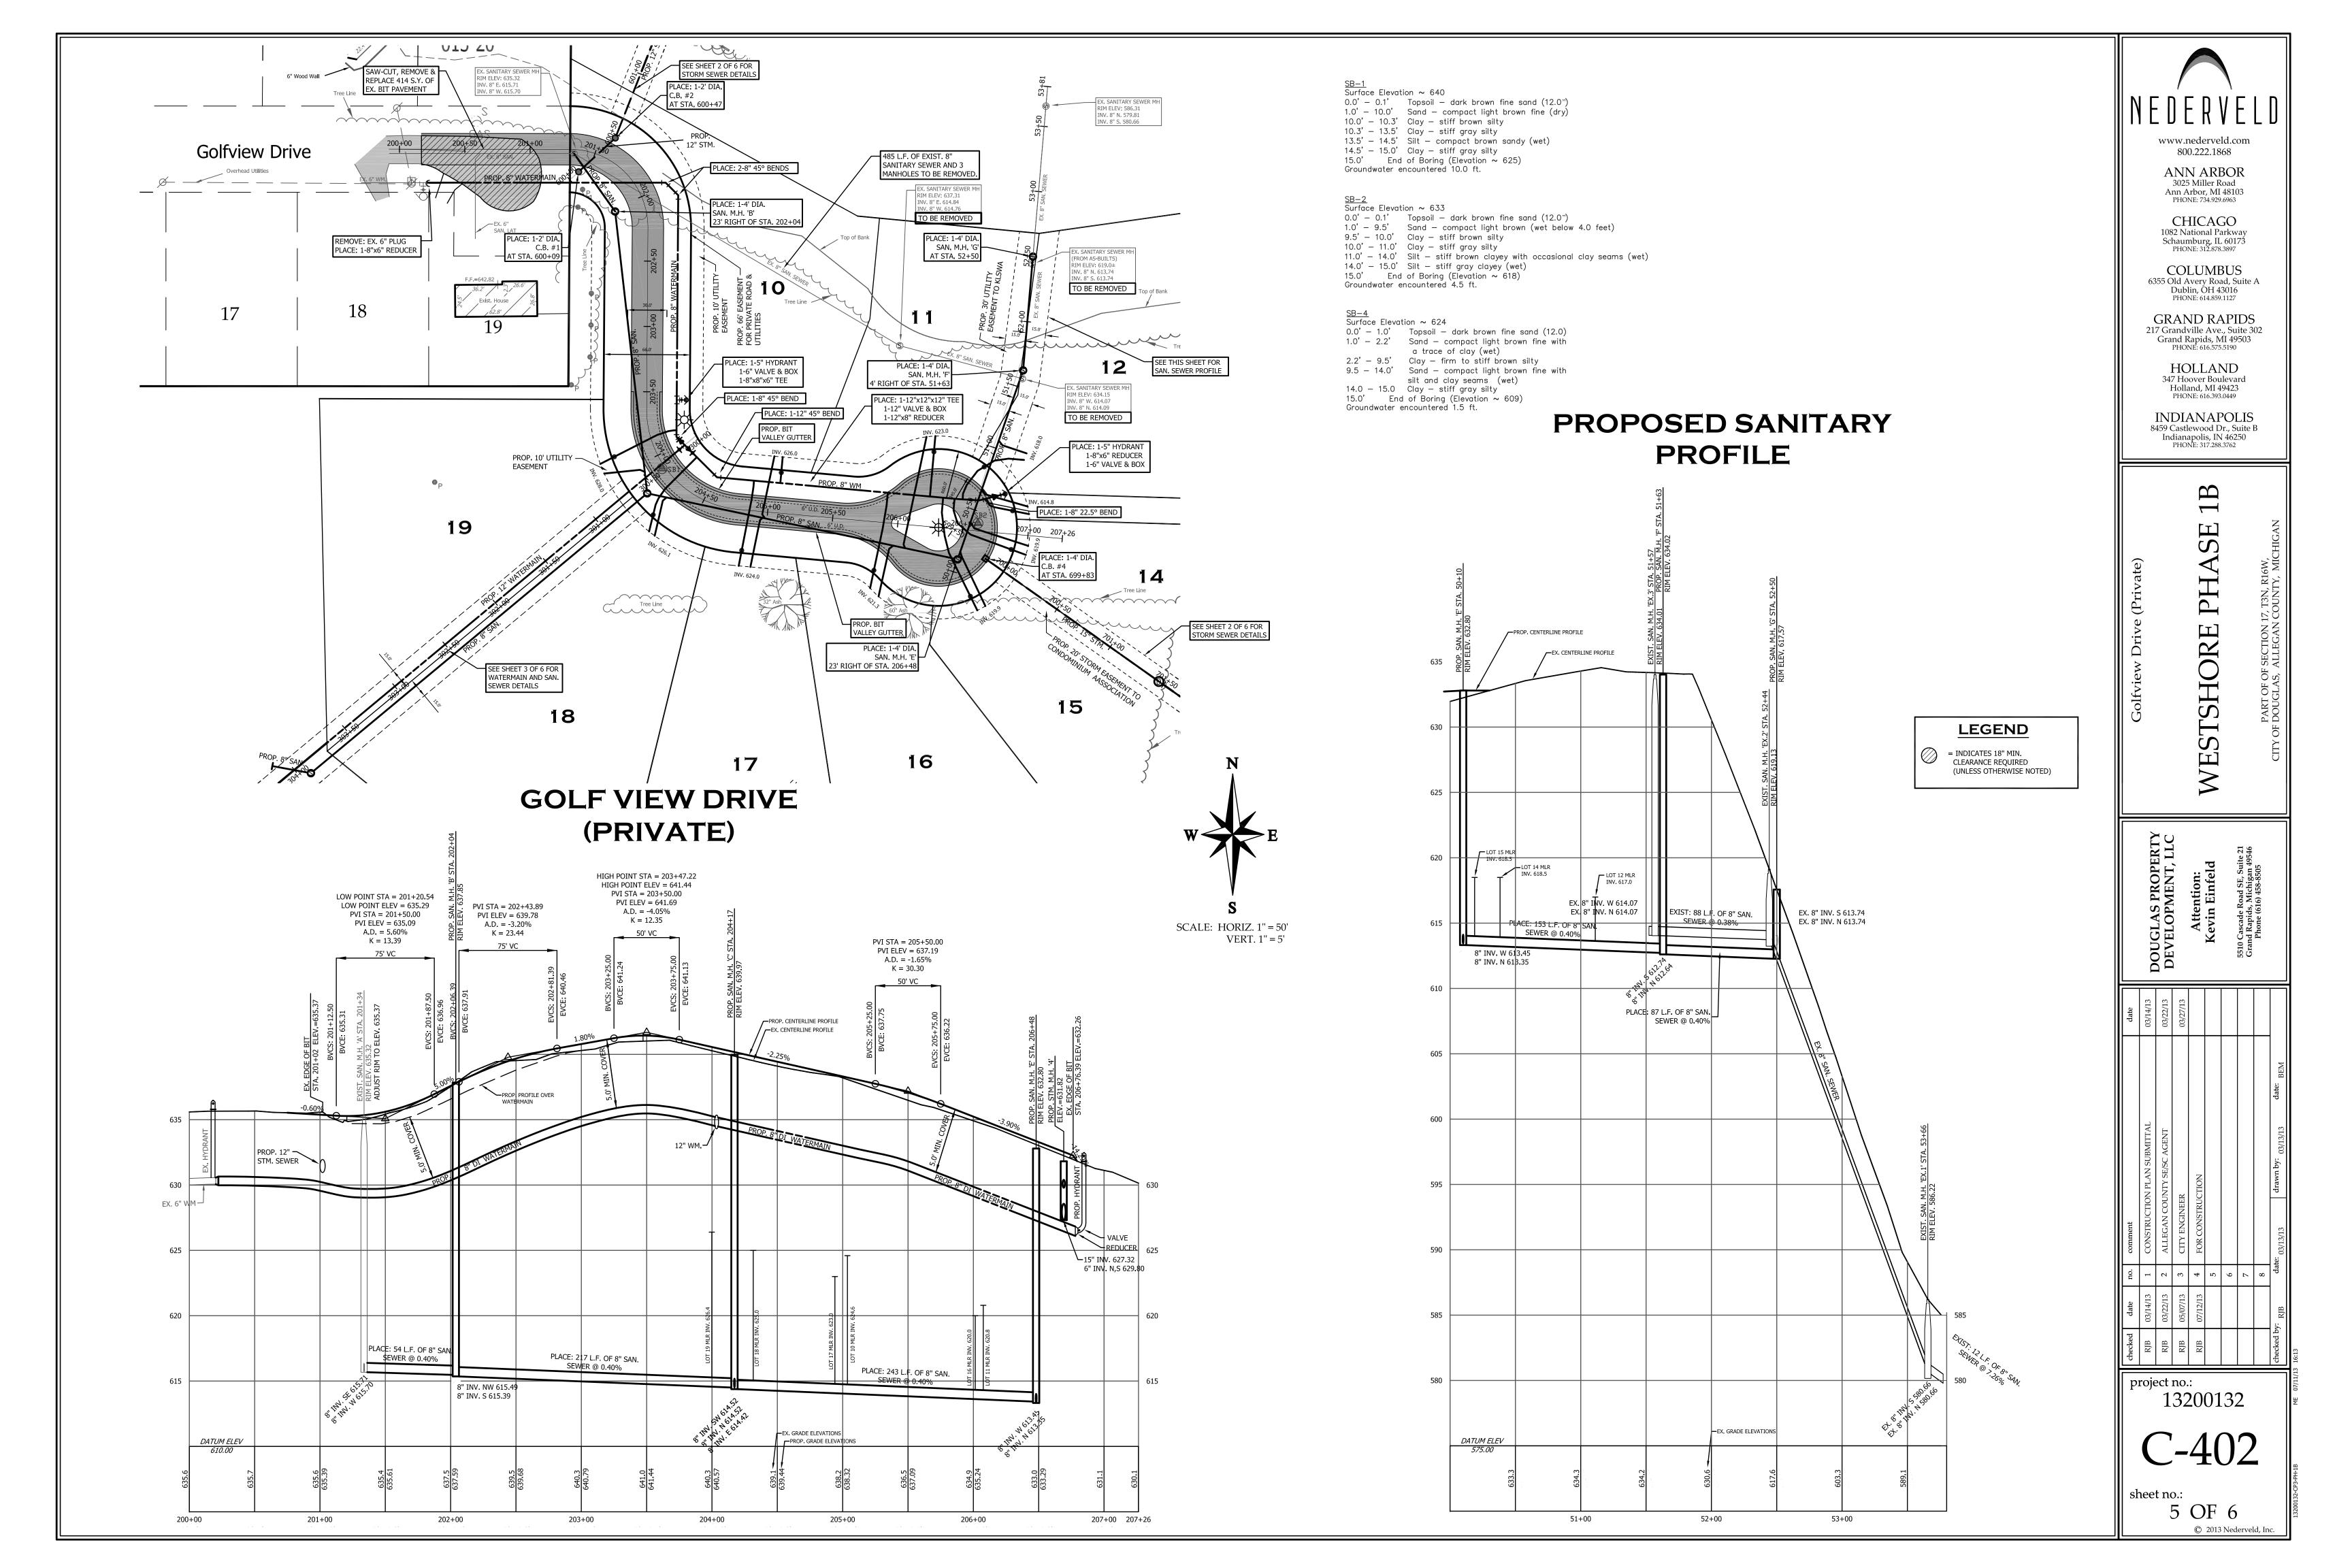


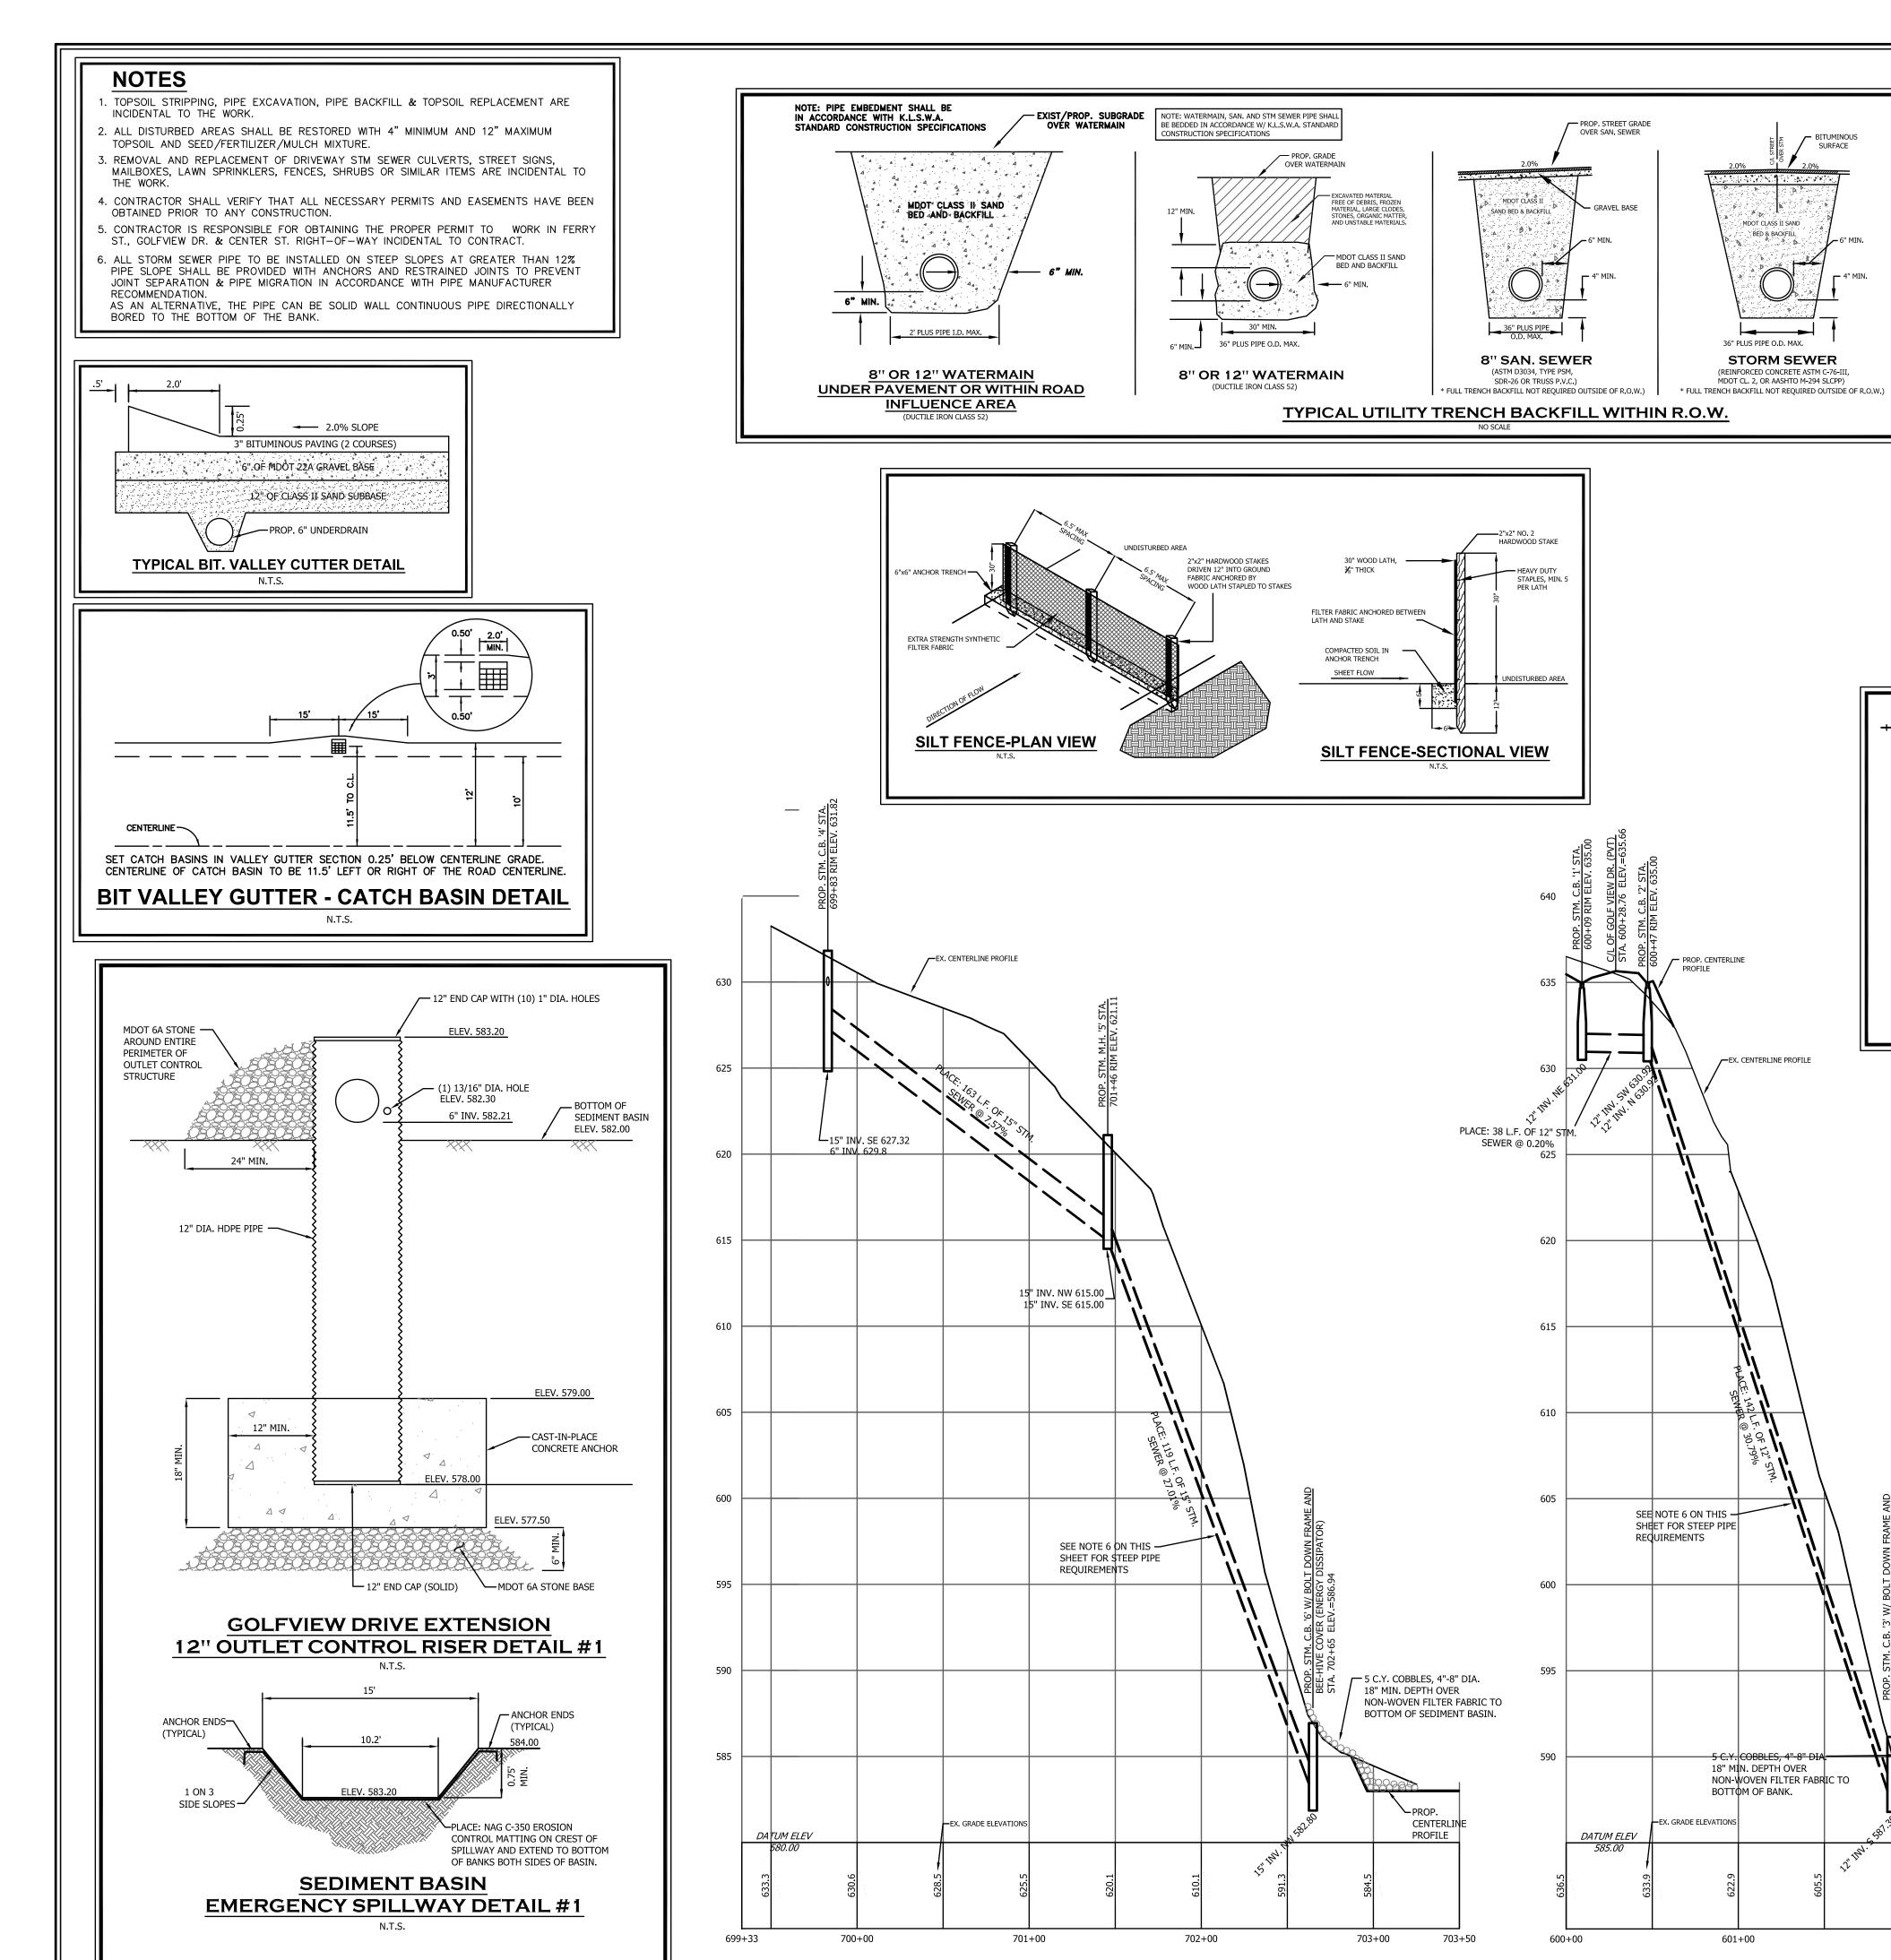



GOLFVIEW DRIVE EXTENSION

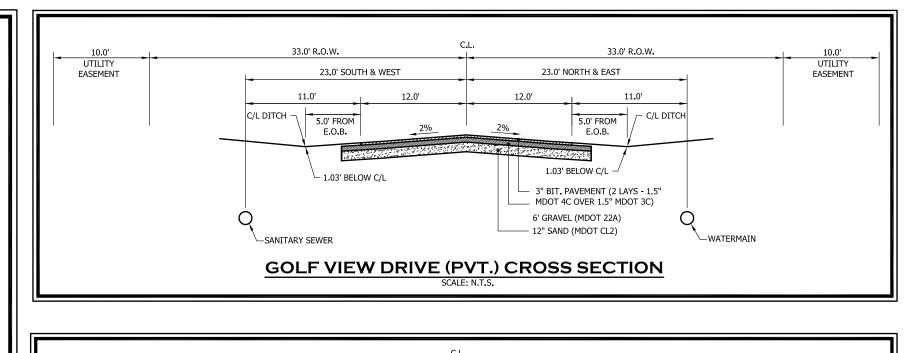


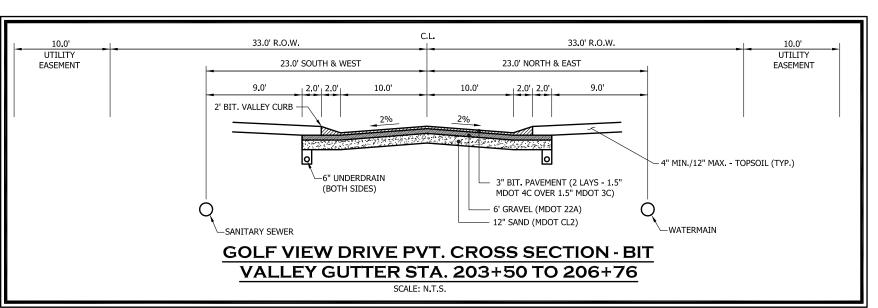

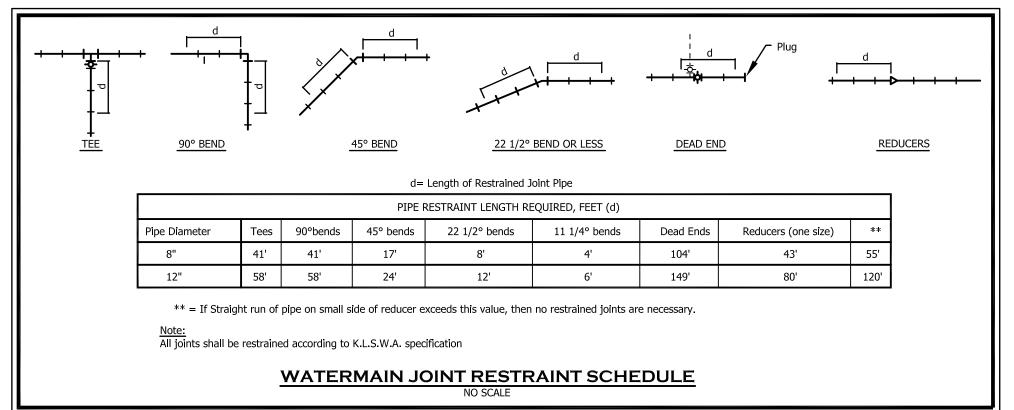

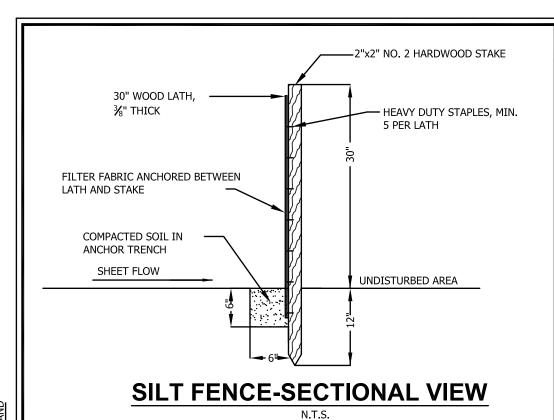

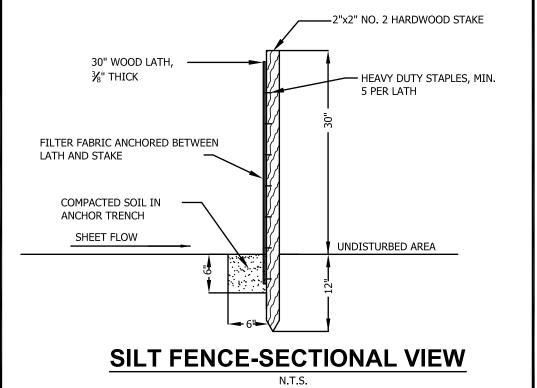

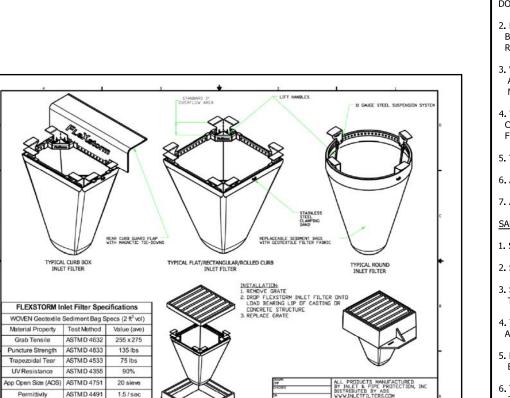

STORM SEWER NO.3



AVAILABLE RECORDS. THEY SHOULD NOT BE INTERPRETED TO BE EXACT LOCATIONS NOR SHOULD IT BE ASSUMED THAT THEY ARE THE ONLY UTILITIES IN THIS AREA.

EXISTING UTILITIES AND SERVICE LINES IDENTIFIED AS "(PLAN)" WERE OBTAINED FROM AVAILABLE CITY AS-BUILT RECORD DRAWINGS. THE CONTRACTOR SHALL VERIFY THE LOCATION, DEPTH AND STATUS OF ALL UTILITIES AND SERVICE LINES PRIOR TO NEW CONNECTIONS.

GENERAL NOTES.
1. CONSTRUCTION OF SANITARY SEWER, WATERMAIN, STORM SEWER AND SIDEWALK IMPROVEMENTS SHALL BE IN ACCORDANCE WITH THE CURRENT VILLAGE OF DOUGLAS & KLSWA STANDARD CONSTRUCTION REQUIREMENTS.
2. PROVIDE SIEVE ANALYSIS ON EXISTING SOILS TO DETERMINE IF THEY MEET CLASS II SPECIFICATIONS FOR BACKFILL.

3. INSTALLATION OF S.L.C.P.P. STORM SEWER MUST COMPLY WITH M.D.O.T. SPECIFICATIONS (INCLUDING MIN. COVER AND 30 DAY

ROADWAY & UTILITY TRENCH BACKFILL MATERIAL SHALL MEET MDOT CLASS II SPECIFICATIONS.

COORDINATE TAP OF THE EXISTING WATERMAIN WITH KLSWA & VILLAGE OF OUGLAS WATER AND SEWER DEPARTMENT. . HYDRANT WEEP HOLES SHALL BE OPEN UNLESS CONSTRUCTED

BELOW WATER TABLE. MEGA LUGS OR RODDING IS REQUIRED FOR REACTION BACKING.

. WATER SERVICES SHALL BE MARKED WITH A SECTION OF PVC PIPE AT THE CURB STOP & BOX (EXTENDING 3' ABOVE GROUND AT A

4. WATER SERVICE FITTINGS SHALL BE COMPRESSION FITTINGS.

CONTRACTORS SHALL PROVIDE ELECTRICAL CONTINUITY ON 5. TESTING SHALL CONFORM TO KLSWA STANDARDS.

6. ALL CURB STOPS SHALL BE FURNISHED WITH STATIONARY RODS. 7. ALL WATERMAIN IS TO BE DUCTILE IRON PIPE CLASS 52. SANITARY SEWER CONSTRUCTION

1. SANITARY SEWER PIPE SHALL BE ASTM 3034, SDR 35 PVC OR SDR 26 PVC AS NOTED ON THE PLANS.

3. SANITARY SEWER CONSTRUCTION SHALL BE IN ACCORDANCE WITH THE STANDARD SPECIFICATIONS OF THE KLSWA. (INCL. TESTING) 4. TEMP. PLUG TO BE PLACED IN EX. SEWER UNTIL NEW SEWER IS

ACCEPTED BY KLSWA. MANHOLES SHALL BE PRECAST, BOOT TYPE WITH OUTER BITUMINOUS COATING.

2"x 2" WOOD STAKE AND A STEEL REROD, COVERED WITH A SECTION OF PVC PIPE EXTENDING 3' ABOVE GRADE.

sheet no.: . A 6" PROPERTY LINE RISER SHALL BE PLACED AT THE END

Attention: Kevin Einfeld

www.nederveld.com

800.222.1868

ANN ARBOR

3025 Miller Road

Ann Arbor, MI 48103

PHONE: 734.929.6963

CHICAGO

1082 National Parkway

Schaumburg, IL 60173

PHONE: 312.878.3897

COLUMBUS

6355 Old Avery Road, Suite A

Dublin, OH 43016

PHONE: 614.859.1127

GRAND RAPIDS

217 Grandville Ave., Suite 302

Grand Rapids, MI 49503 PHONE: 616.575.5190

HOLLAND

347 Hoover Boulevard

Holland, MI 49423 PHONE: 616.393.0449

INDIANAPOLIS


8459 Castlewood Dr., Suite B


PHONE: 317.288.3762


Indianapolis, IN 46250


RE


project no.: 13200132

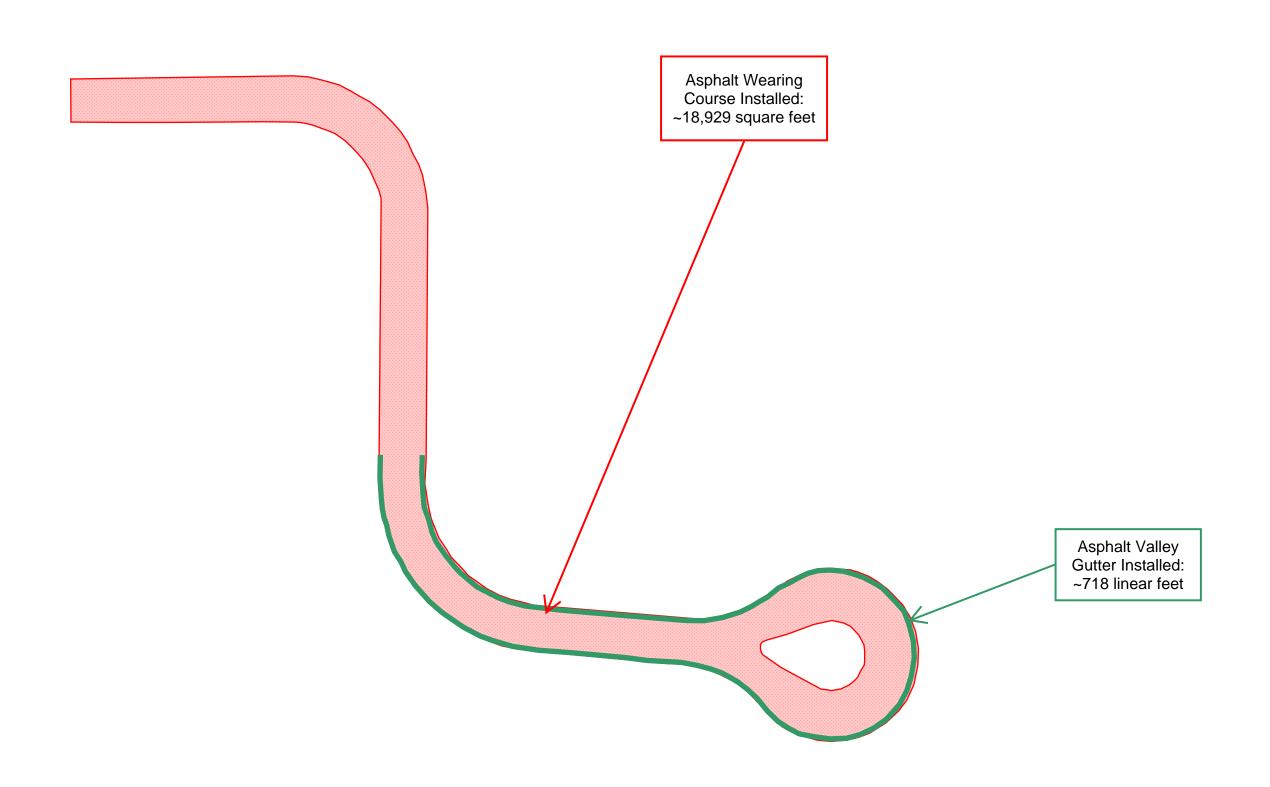


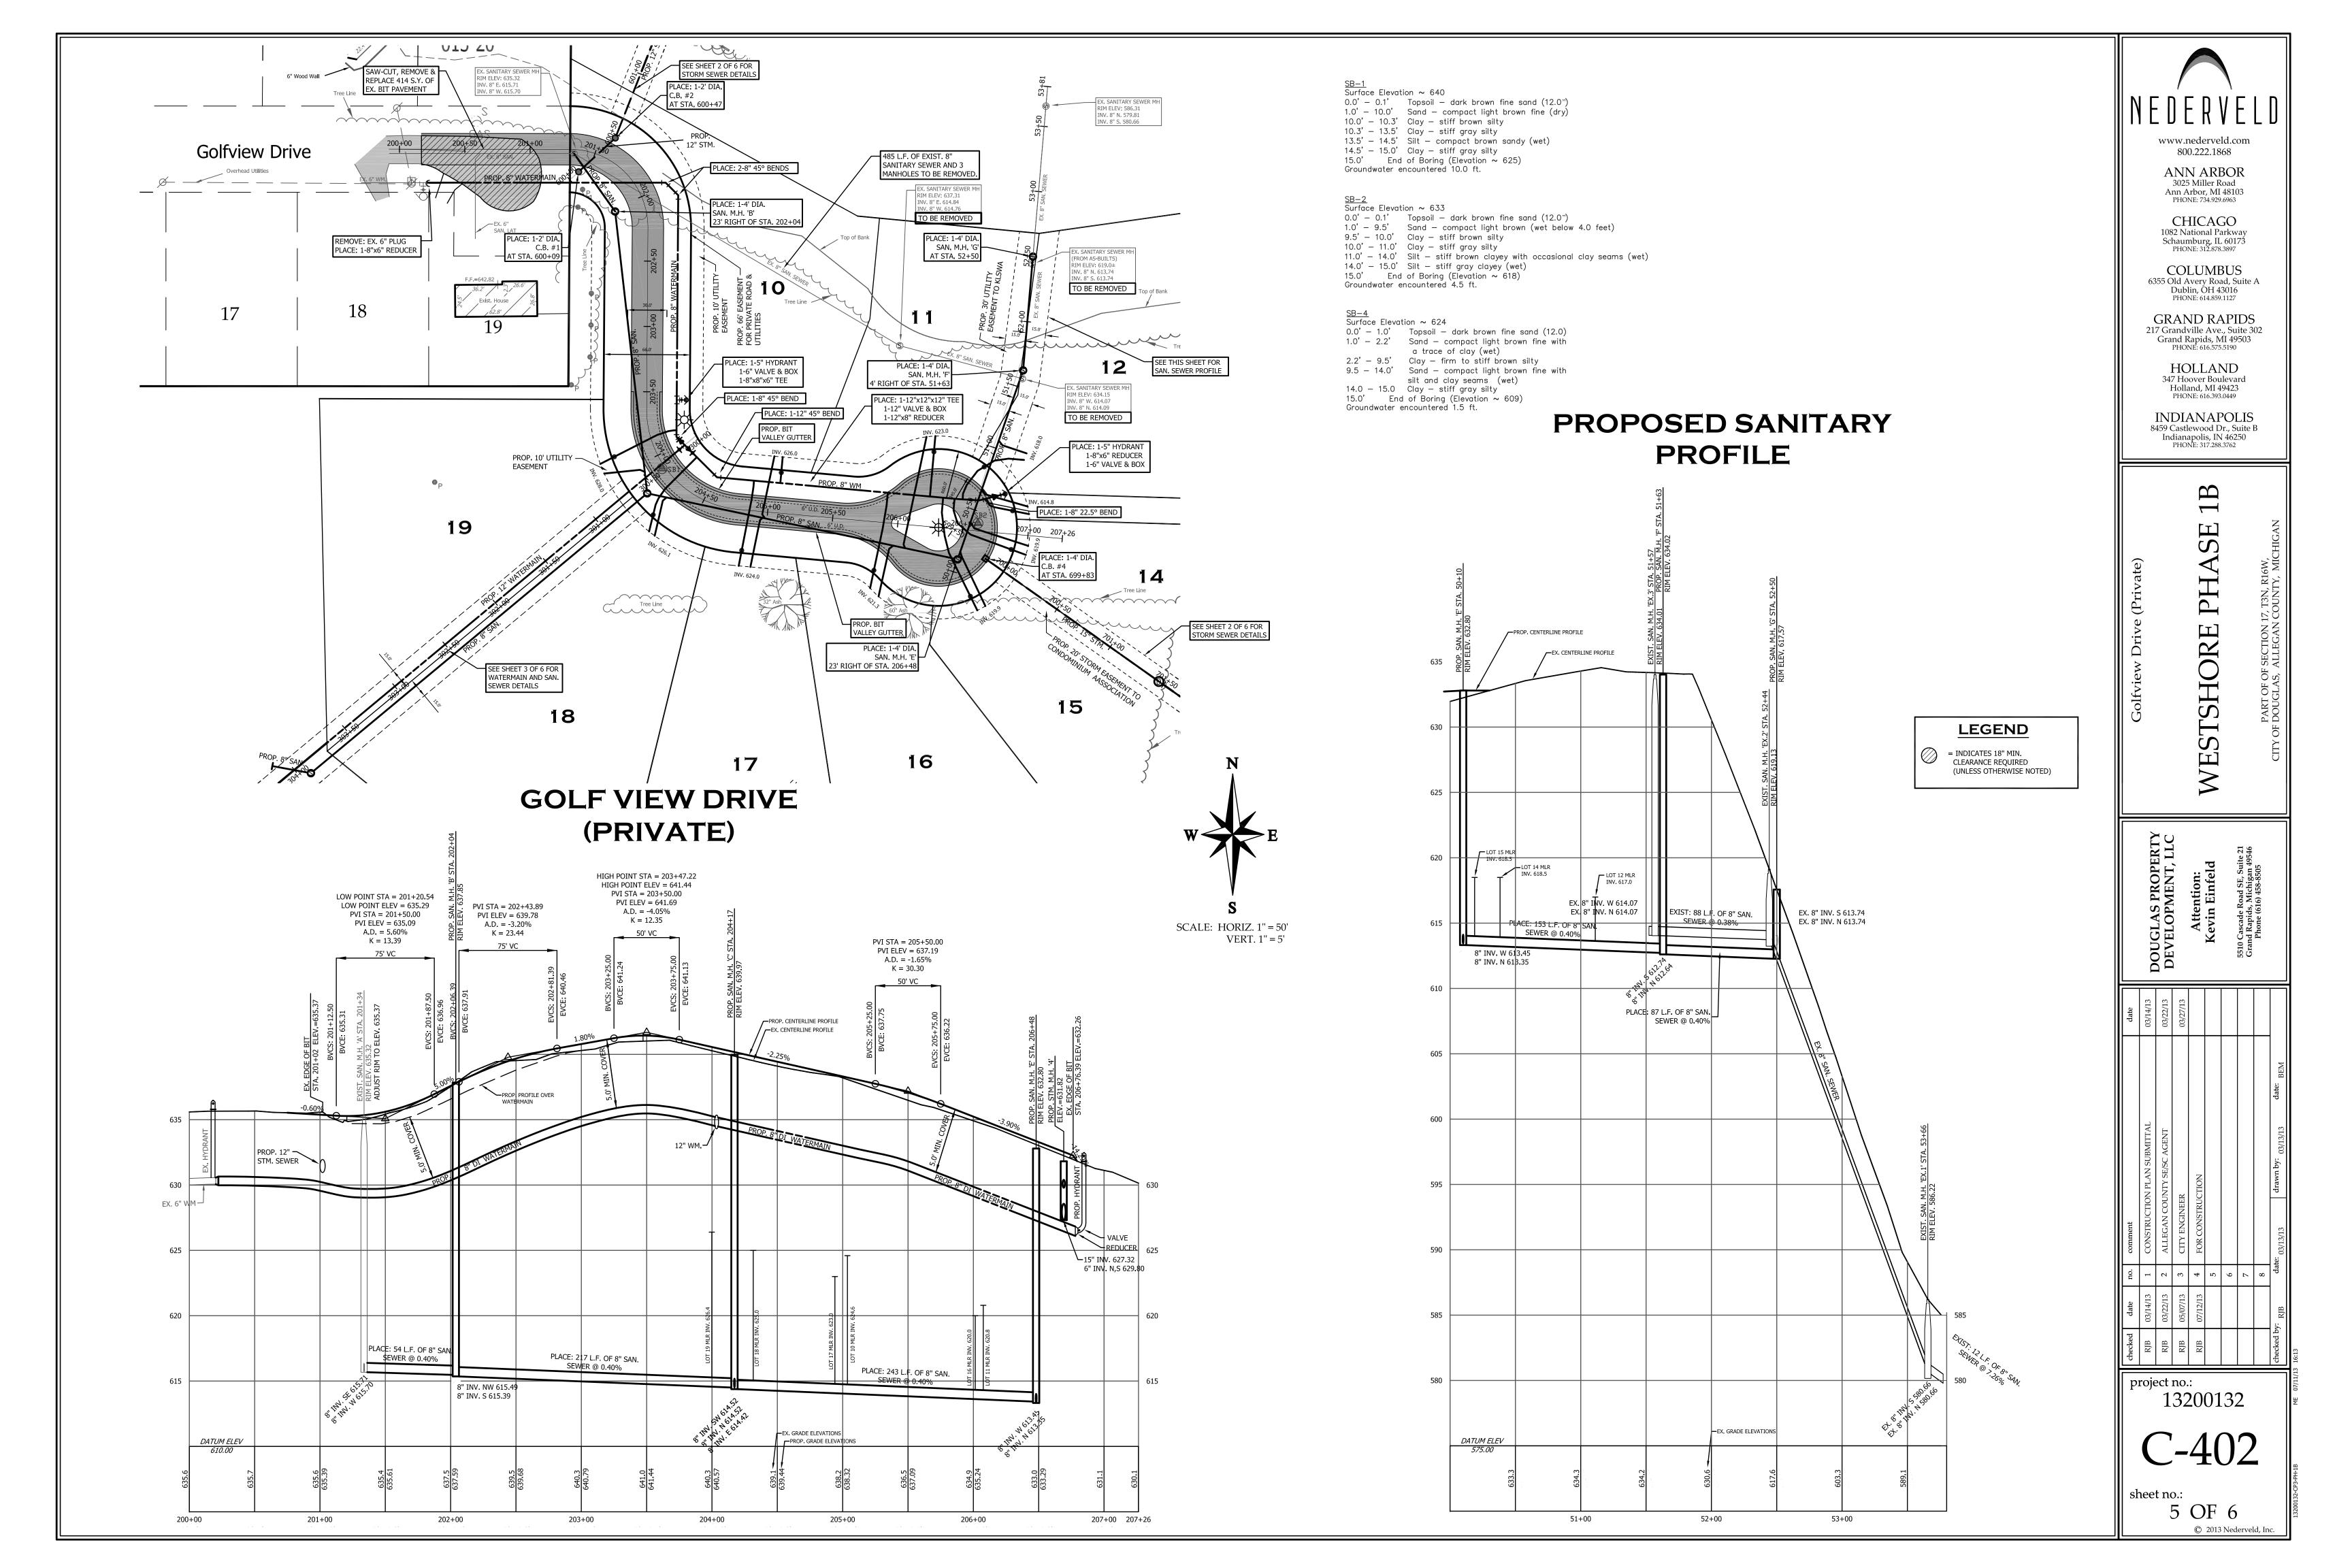


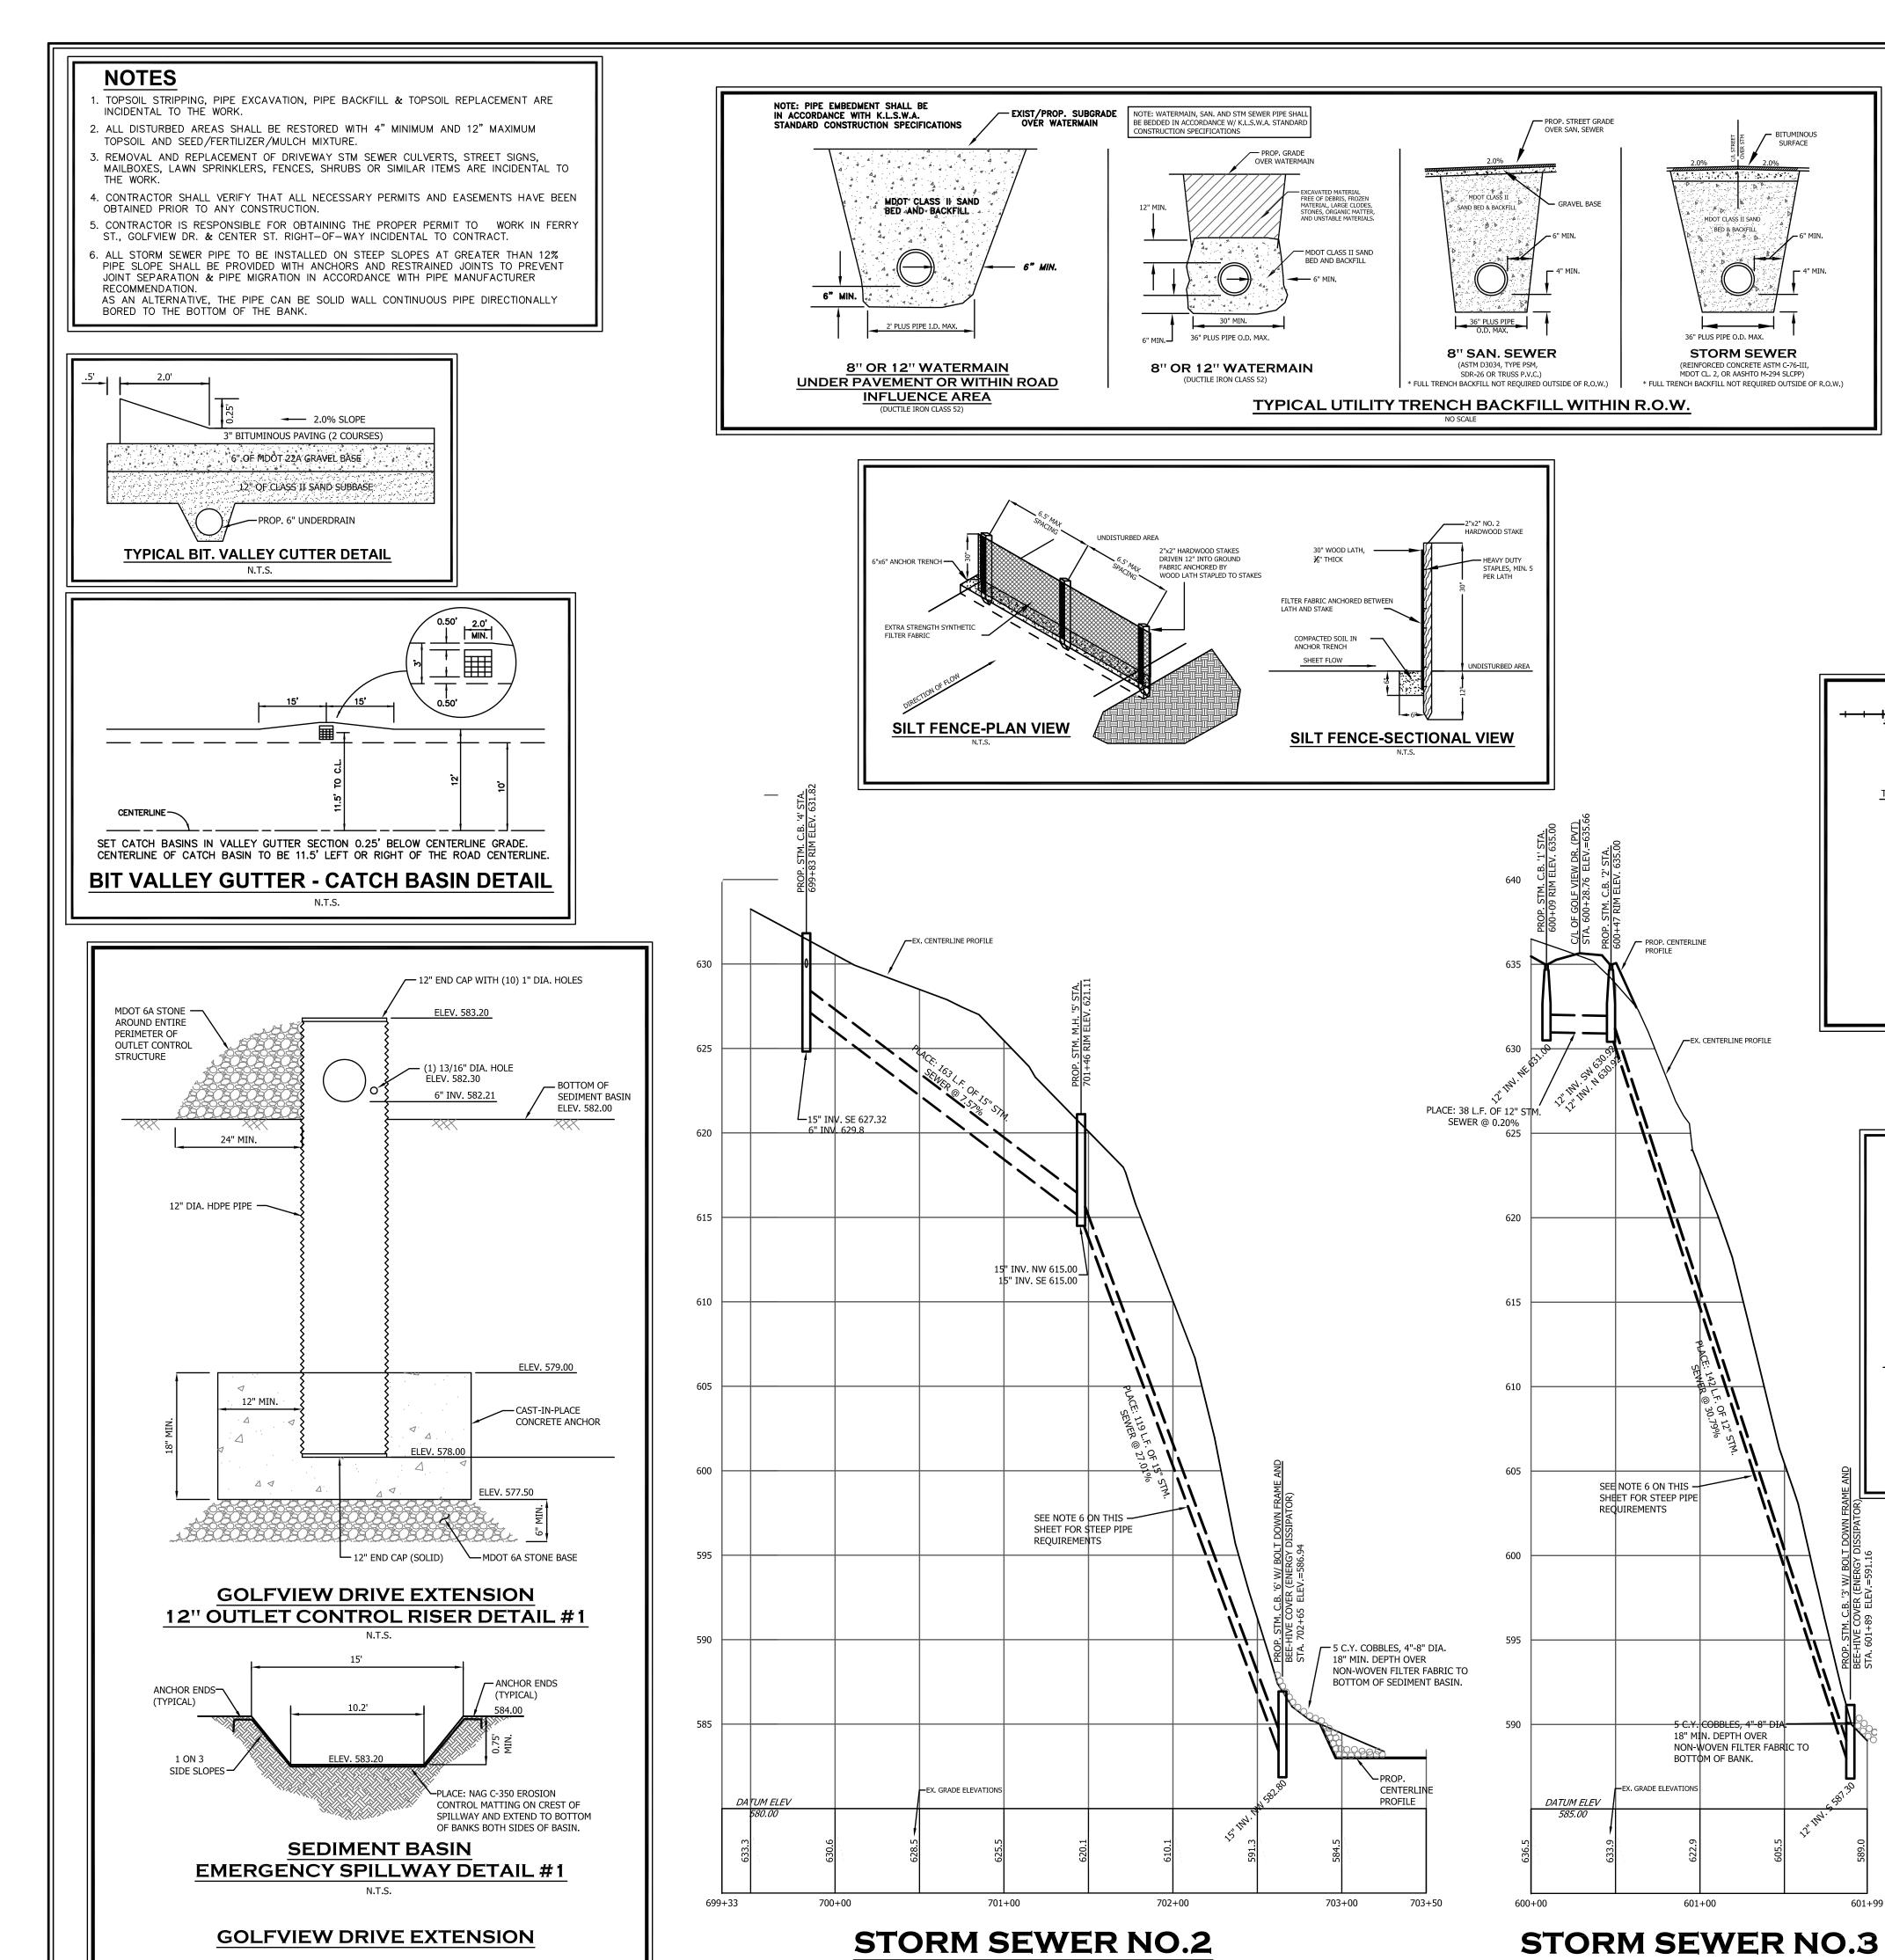


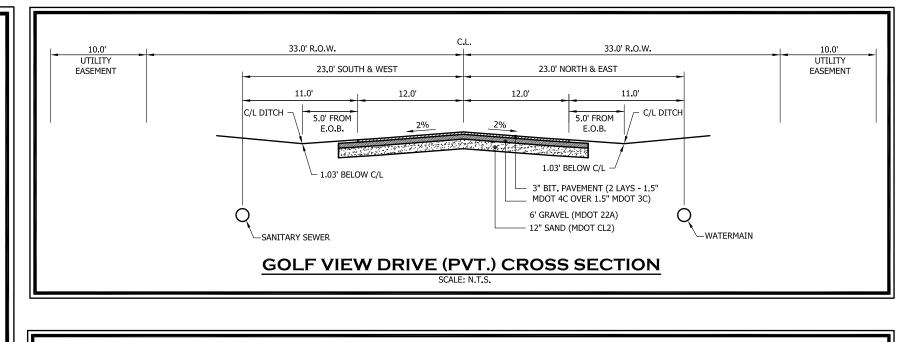


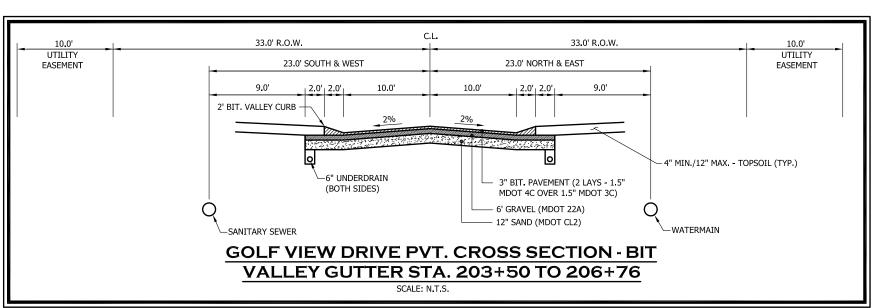

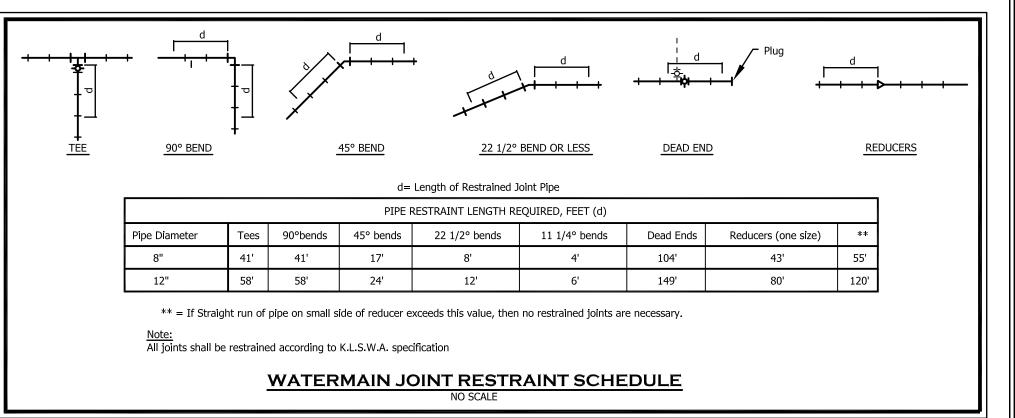

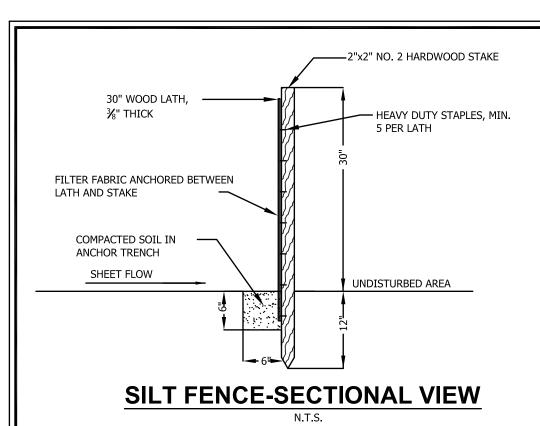

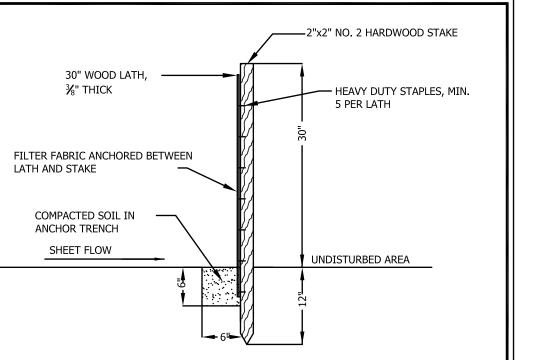

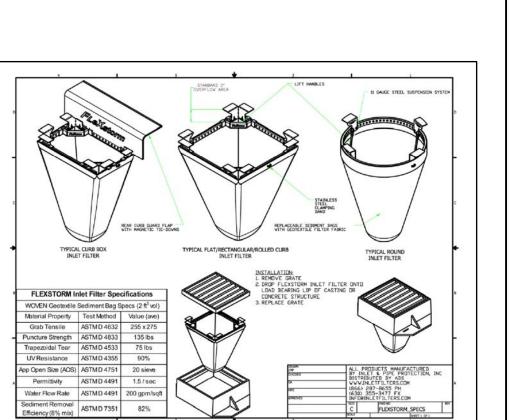



AVAILABLE RECORDS. THEY SHOULD NOT BE INTERPRETED TO BE EXACT LOCATIONS NOR SHOULD IT BE ASSUMED THAT THEY ARE THE ONLY UTILITIES IN THIS AREA.

EXISTING UTILITIES AND SERVICE LINES IDENTIFIED AS "(PLAN)" WERE OBTAINED FROM AVAILABLE CITY AS-BUILT RECORD DRAWINGS. THE CONTRACTOR SHALL VERIFY THE LOCATION, DEPTH AND STATUS OF ALL UTILITIES AND SERVICE LINES PRIOR TO NEW CONNECTIONS.

CONSTRUCTION OF SANITARY SEWER, WATERMAIN, STORM

GENERAL NOTES:

SEWER AND SIDEWALK IMPROVEMENTS SHALL BE IN
ACCORDANCE WITH THE CURRENT VILLAGE OF DOUGLAS
& KLSWA STANDARD CONSTRUCTION REQUIREMENTS.
PROVIDE SIEVE ANALYSIS ON EXISTING SOILS TO DETERMINE IF
THEY MEET CLASS II SPECIFICATIONS FOR BACKFILL.
THET HILL ATTOM OF CLUCK R. CTORM OF WER MUST COMPLY WITH
INSTALLATION OF S.L.C.P.P. STORM SEWER MUST COMPLY WITH
M.D.O.T. SPECIFICATIONS (INCLUDING MIN. COVER AND 30 DAY
MANDRILL, ETC.).
ROADWAY & UTILITY TRENCH BACKFILL MATERIAL SHALL MEET
MDOT CLASS II SPECIFICATIONS.
ATERMAIN CONCEDUCTION
ATERMAIN CONSTRUCTION
COORDINATE TAP OF THE EXISTING WATERMAIN WITH KLSWA & VILLAGE OF
NICLAS WATER AND SEWED DEDARTMENT

DOUGLAS WATER AND SEWER DEPARTMENT 2. HYDRANT WEEP HOLES SHALL BE OPEN UNLESS CONSTRUCTED BELOW WATER TABLE. MEGA LUGS OR RODDING IS REQUIRED FOR REACTION BACKING.

. WATER SERVICES SHALL BE MARKED WITH A SECTION OF PVC PIPE

AT THE CURB STOP & BOX (EXTENDING 3' ABOVE GROUND AT A

4. WATER SERVICE FITTINGS SHALL BE COMPRESSION FITTINGS. CONTRACTORS SHALL PROVIDE ELECTRICAL CONTINUITY ON

5. TESTING SHALL CONFORM TO KLSWA STANDARDS. 6. ALL CURB STOPS SHALL BE FURNISHED WITH STATIONARY RODS.

7. ALL WATERMAIN IS TO BE DUCTILE IRON PIPE CLASS 52. SANITARY SEWER CONSTRUCTION 1. SANITARY SEWER PIPE SHALL BE ASTM 3034, SDR 35 PVC OR

SDR 26 PVC AS NOTED ON THE PLANS. 3. SANITARY SEWER CONSTRUCTION SHALL BE IN ACCORDANCE WITH THE STANDARD SPECIFICATIONS OF THE KLSWA. (INCL. TESTING)

4. TEMP. PLUG TO BE PLACED IN EX. SEWER UNTIL NEW SEWER IS ACCEPTED BY KLSWA. MANHOLES SHALL BE PRECAST, BOOT TYPE WITH OUTER

BITUMINOUS COATING. 2"x 2" WOOD STAKE AND A STEEL REROD, COVERED WITH A SECTION OF PVC PIPE EXTENDING 3' ABOVE GRADE.

sheet no.: . A 6" PROPERTY LINE RISER SHALL BE PLACED AT THE END

6 OF 6

Holland, MI 49423 PHONE: 616.393.0449 **INDIANAPOLIS** 8459 Castlewood Dr., Suite B Indianapolis, IN 46250 PHONE: 317.288.3762 RE

www.nederveld.com

800.222.1868

ANN ARBOR

3025 Miller Road

Ann Arbor, MI 48103

PHONE: 734.929.6963

CHICAGO

1082 National Parkway

Schaumburg, IL 60173

PHONE: 312.878.3897

COLUMBUS

6355 Old Avery Road, Suite A

Dublin, OH 43016

PHONE: 614.859.1127

GRAND RAPIDS

217 Grandville Ave., Suite 302

Grand Rapids, MI 49503 PHONE: 616.575.5190

HOLLAND

347 Hoover Boulevard

Attention: Kevin Einfeld

project no.: 13200132

© 2013 Nederveld, Ir