#### TOWN OF GRAND LAKE PLANNING COMMISSION RESOLUTION NO. 01-2024

#### A RESOLUTION RECOMMENDING APPROVAL OF A VARIANCE TO THE STREAM AND LAKE SETBACK REQUIREMENTS FOR PROPERTY LOCATED AT 210 RAPIDS LANE, WITH CONDITIONS

**WHEREAS,** Tomlynson, Inc., (the "Applicant") is the owner of certain real property located at 210 Rapids Lane, more particularly described as follows:

Sunnyside Addition to Grand Lake Lot: 18 Block: 1 & A Tract East of Lot 18 to Center of North Inlet,

(the "Property"); and

WHEREAS, Municipal Code 12-2-29 Shoreline and Surface Water Regulations provides:
1. In order to help preserve the environmental quality of the water in the Grand Lake, a thirty (30) foot stream and lake setback from the mean identifiable high water mark shall be maintained for buildings, parking, snow storage areas and other improvements to a site. ...

2. When activities are proposed within the 30' setback, a variance may be requested by an *Applicant*.

WHEREAS, Municipal Code 12-2-29 further provides in subpart 4:

4. The first five (5) feet of this setback shall be a non-disturbance zone, except in the cases of bridges, irrigation structures, flood control devices, boathouses, commercial marinas, boat rentals, boat repair and maintenance facilities and walkways and stairways less than four (4) feet in width leading directly from the shoreline to the principal structure; and

WHEREAS, there is no provision in the Municipal Code for variance of the five feet nondisturbance zone; and

WHERES, within the 30-foot setback zone, and to a much lesser extent within the 5-foot nondisturbance zone, the Applicant has constructed a deck along the shore of North Inlet adjacent to the Property (the "Deck"); and

WHEREAS, the Applicant did not obtain a building permit prior to constructing the Deck; and

WHEREAS, the Applicant has submitted a request for a setback variance to allow the Deck to remain, as shown on Exhibit A, attached; and

**WHEREAS,** following proper notice, the Planning Commission reviewed the Application at a Public Hearing on January 17<sup>th</sup>, 20234 and

**WHEREAS**, Section 12-2-29(A)(2) requires that at the hearing it is the burden of the Applicant to establish that the proposed activity conforms to one or more of the following exceptions set forth in Section 12-3-5(A)4(a) through (e) of the Municipal Code:

(a) By reason of exceptional shape, size or topography of lot, or other exceptional situation or condition of the building or land, practical difficulty or unnecessary hardship would result to the owners of said property from a strict enforcement of these Regulations;

(b) Literal interpretation of the provisions of these Regulations would deprive the applicant of rights commonly enjoyed by other properties in the same district under the terms of these Regulations.

- (c)The special conditions and circumstances do not result from the actions of the applicant;
- (d) Granting the variance request will not confer on the applicant any special privilege that is denied by this ordinance to other lands, structures, or buildings in the same district;

(e) That the granting of the variance does not pose a detriment to the public good and does not substantially impair the intent and purpose of the Zone Plan and these Regulations.

**WHEREAS,** Section 12-2-29(A)(2)(b) requires that at the hearing the Planning Commission consider all of the following factors to determine whether to issue a variance to the 30 foot setback requirement:

1. The shape, size, topography, slope, soils, vegetation, and other physical characteristics of the property.

2. The locations of all bodies of water on the property, including along property boundaries.

- 3. The location and extent of the proposed setback intrusion.
- 4. Whether alternative designs are possible which require less intrusion or no intrusion.
- 5. Sensitivity of the body of water and affected critical habitats.

6. Intensity of land use adjacent to the body of water proposed to intrusion.

7. Impact on floodplains and stream functions (a variance shall not be approved when the reduction would result in the setback being narrower than the floodplain);

### FINDINGS OF THE PLANNING COMMISSION

# HAVING CONSIDERED THE MATTERS PRESENTED TO IT AND THE APPLICABLE STANDARDS, THE PLANNING COMMISSION MAKES THE FOLLOWING FINDINGS:

- 1. The Planning Commission considered each of the factors required by Section 12-2-29((2)(b).
- The Applicant established the following exception(s) under Section 12-3-5(a)(4(a) through (e): [Planning Commission must find at least one in order to satisfy this requirement. Select all that apply:]

1. That by reason of exceptional shape, size or topography of lot, or other exceptional situation or condition of the building or land, practical difficulty or unnecessary hardship would result to the owners of said property from a strict enforcement of these Regulations;

2. That literal interpretation of the provisions of these Regulations would deprive the applicant of rights commonly enjoyed by other properties in the same district under the terms of these Regulations.

3. That the special conditions and circumstances do not result from the actions of the applicant;

4. That granting the variance request will not confer on the applicant any special privilege that is denied by this ordinance to other lands, structures, or buildings in the same district;

5. That the granting of the variance does not pose a detriment to the public good and does not substantially impair the intent and purpose of the Zone Plan and these Regulations.

### NOW THEREFORE BE IT RESOLVED BY THE PLANNING COMMISSION OF THE TOWN OF

#### **GRAND LAKE, COLORADO,**

- 1. The Planning Commission recommends to the Board of Trustees that the variance requested by the Applicant to reduce the 30-foot setback requirements provided for in Section 12-29-20(A)(1) of the Municipal Code be granted on the following terms and conditions:
  - a. That the portions of the Deck that encroach into the Non-Disturbance Zone as shown in Areas A, C, and E on Exhibit A be removed. Although Areas B and D encroach into the Non-Disturbance Zone, they are *de minimis* in size(.1 square feet and .7 square feet, respectively), and are measured from an approximate high water line, and therefore need not be removed.
  - b. That the Applicant obtain a building permit for the remaining portions of the Deck, including the submission of construction drawings and other required documentation, and pay the requisite fees for such permit.
  - c. That the Applicant maintain or increase the riparian vegetation to prevent erosion of the shoreline in the areas between the Deck and the stream.
  - d. That the remaining portions of the Deck comply with all other provisions of the Grand Lake Municipal Code, including but not limited to Section 12-2-29(A)(5).
  - e. That the Applicant refrain from further use or occupancy of the Deck until the foregoing conditions have been fulfilled as certified by the Town Manager.

## DULY MOVED, SECONDED AND ADOPTED BY THE PLANNING COMMISSION OF THE TOWN OF GRAND LAKE, COLORADO THIS 17<sup>th</sup> DAY OF JANUARY, 2024


(SEAL)


Votes Approving: Votes Opposed: Absent: Abstained:

ATTEST:

TOWN OF GRAND LAKE

Alayna Carrell Town Clerk James Shockey Planning Commission Chairman

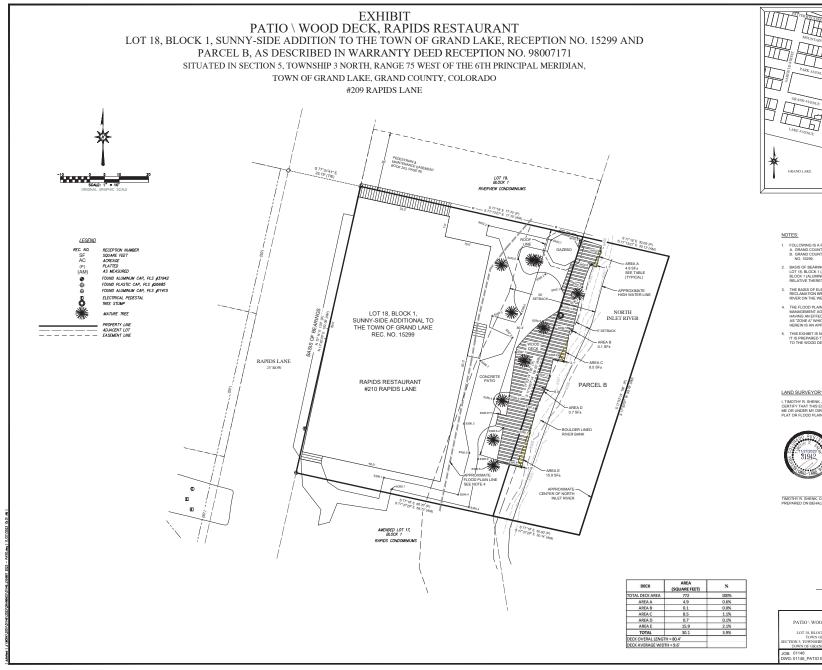

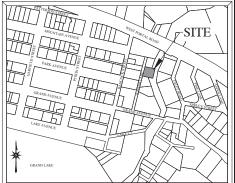

VICINITY MAP SCALE: 1" = 300"

- 1. FOLLOWING IS A PARTIAL LIST OF SURVEY PLATS UTILIZED IN THE PREPARATION OF THIS SURVEY: A GRAND COLIMTY RECORDS, TOWN OF GRAND LAKE, RECEPTION NO. 9086. B. GRAND COLIMTY RECORDS, SUNNY-SIDE ADDITION TO THE TOWN OF GRAND LAKE, RECEPTION NO. 15299.
- BASIS OF BEARING IS N 12'42'05' E (ASSUMED) AS MEASURED FROM THE SOUTHWEST CORNER OF LOT 18, BLOCK 1 (ALUMINUM CAPPED REBAR, PLS#11415) TO THE NORTHWEST CORNER OF LOT 18, BLOCK 1 (ALUMINUM CAPPED REBAR, PLS#11415) WITH ALL BEARINGS SHOWN HEREIN BEING RELATIVE THERETO.
- THE BASIS OF ELEVATION IS 8441.34' (PER NAVD 88 DATUM) AS MEASURED FROM THE BUREAU OI RECLAMATION BRASS CAP T-384' WHICH IS STILATED ON THE BRIDGE OVER THE NORTH INLET RIVER ON THE WEST FORTAL ROAD WITH ALL ELEVATIONS SHOWN HERE NELATIVE THERETO.
- 4. THE FLOOD PLAIN DEPICTED HEREIN IS REFERENCED FROM THE FEDERAL EMERGENCY MANAGEMENT AGENCY (FEMA) FLOOD INSURANCE RATE MAP (FRIIN) NUMBER 08M500314C HAVING AM EFECTIVE DATE OF JUNIARY2, 2008. SAM DAP CLASSIPSE THE NORTH IN LET RIVER AS 700E AV WHICH HAS ... NO BASE FLOOD ELEVATIONS OF ETRAINEDY. CONEQUENTLY, DEPICTED HEREIN IS AN APPROXIMATE LOCATION OF THE VESTERTY LIMIT OF SAN ZONE A.
- 5. THIS EXHIBIT IS NOT A LAND SURVEY PLAT, IMPROVEMENT SURVEY PLAT OR FLOOD PLAIN SURVEY. IT IS PREPARED TO GRAPHICALLY DEPICT THE HIGH WATER MARK OF NORTH INLET RIVER RELATIVE TO THE WOOD DECKING AND CONCRETE PATIO AREA OF RAPIDS RESTAURANT.

#### LAND SURVEYOR'S CERTIFICATE

LIMOTHY R. SHENK, A DULY LICENSED LAND SURVEYOR IN THE STATE OF COLORADO, DO HEREBY CERTIFY THAT THIS EXHILT REPRESENTS THE RESULTS OF FIELD SURVEYING AND DRAFTING MADE BY ME OR UNDER MY DIRECT SUPERVISION. THIS IS NOT AN LAND SURVEY PLAT, IMPROVEMENT SURVEY PLAT OR FLOOD PLAN SURVEY.



TIMOTHY R. SHENK, COLORADO P.L.S. #31942 PREPARED ON BEHALF OF TIM SHENK LAND SURVEYING, INC.

	TIM SHENK SURVEYING, INC. P.O. BOX 1670 GRANBY, CO 80446 (970) 887-1046		
EXHIBIT PATIO \ WOOD DECK RAPIDS RESTAURANT LOT IS, BLOCK I, SUNN'SDE ADDITION TO THE TOWN OF GRAND LAKE AND PARCEL B SECTION 5, TOWNSHIP 3 NORTH, RANCE 75 WEST OF THE GTH P.M. TOWN OF GRAND LAKE GRAND COLMEY, COLORADO			
JOB: 01146 DWG: 01146_PATIO EXHB	SCALE: 1* = 20' CRD: 01146	DATE: 11/27/2023 CHECKED: TRS	DRAWN BY: JAN SHEET: 1 OF 1