




## Attachment C – Wall Demolition Sketch


INTERIOR ELEVATION  
GENERAL NOTES

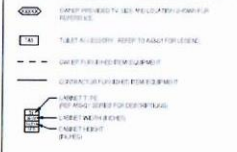


- Visible Mold Growth
- No Visible Mold Growth but Elevated Moisture
- No Visible Mold Growth and No Moisture
- ▨ Perform Drywall Removal Under Containment with Mold Remediation

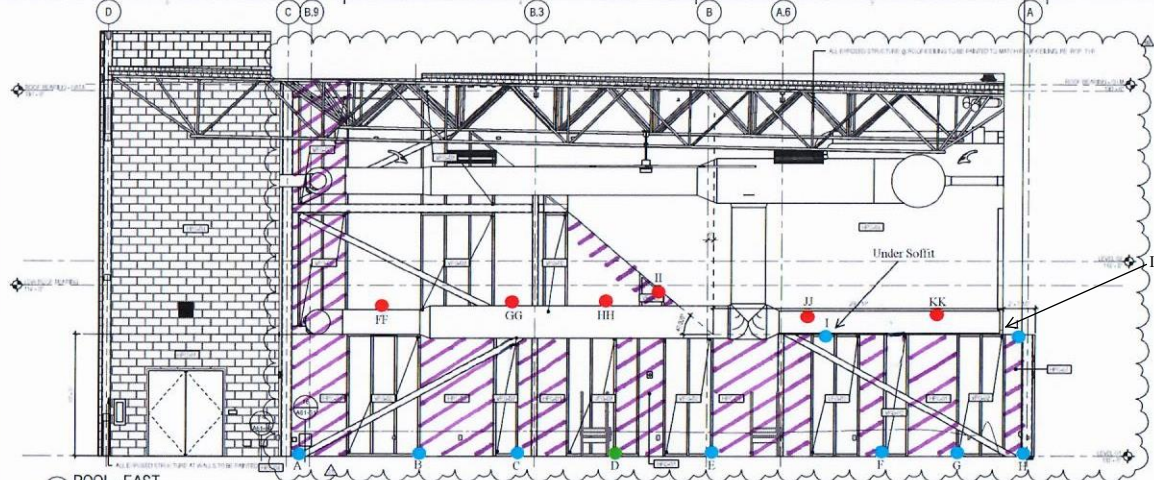


3 POOL - EAST  
1/4" = 1'-0"

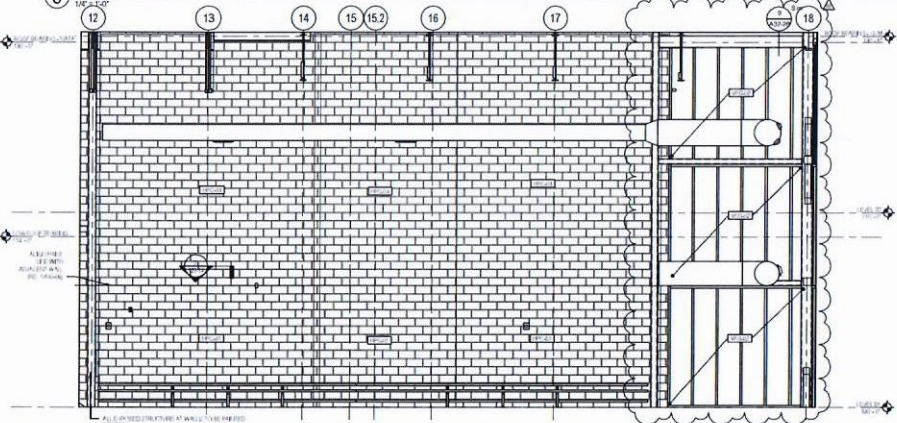


2 POOL - NORTH 2  
1/4" = 1'-0"

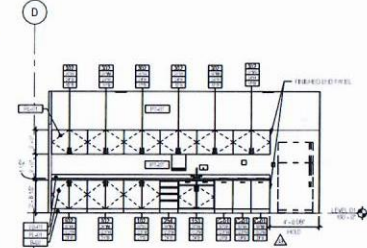


1/4" = 1'-0"

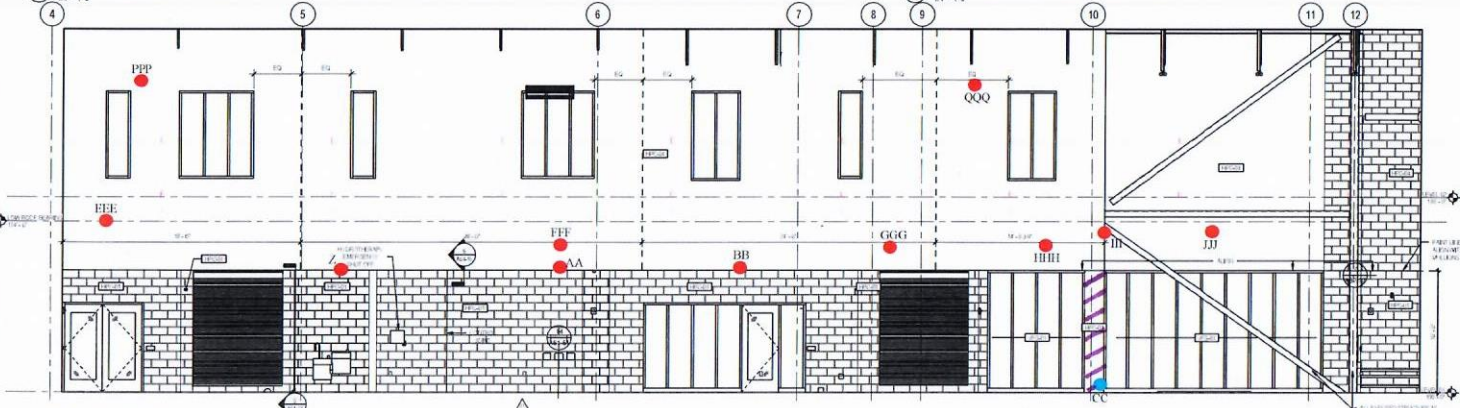

1 POOL - NORTH  
1/4" = 1'-0"

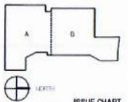

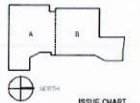




 TITLE


**INTERIOR ELEVATION  
GENERAL NOTES**

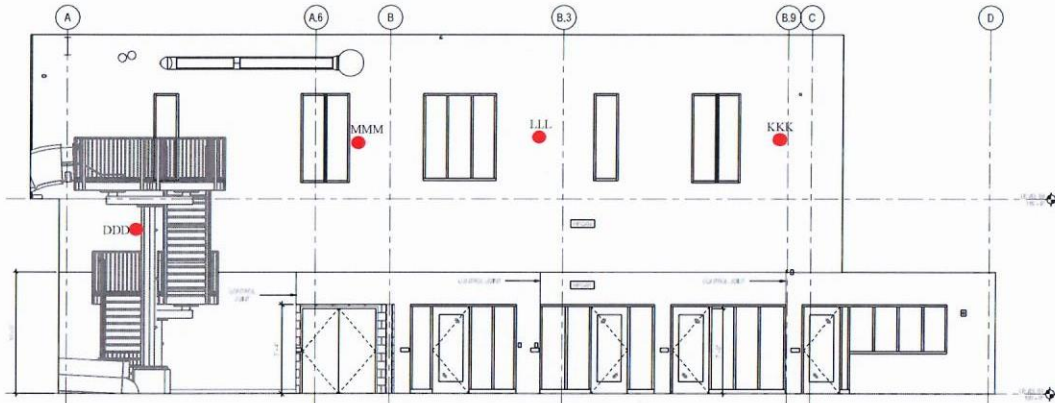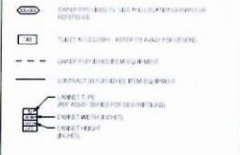


**3 POOL - WEST**  
1/8" = 1'-0"

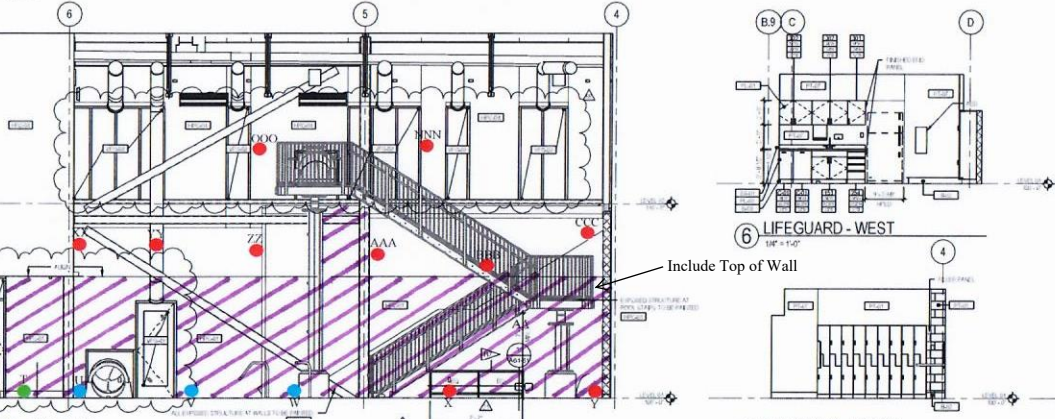


**4 LIFEGUARD - NORTH**  
1/8" = 1'-0"

**5 LIFEGUARD - EAST**  
1/8" = 1'-0"

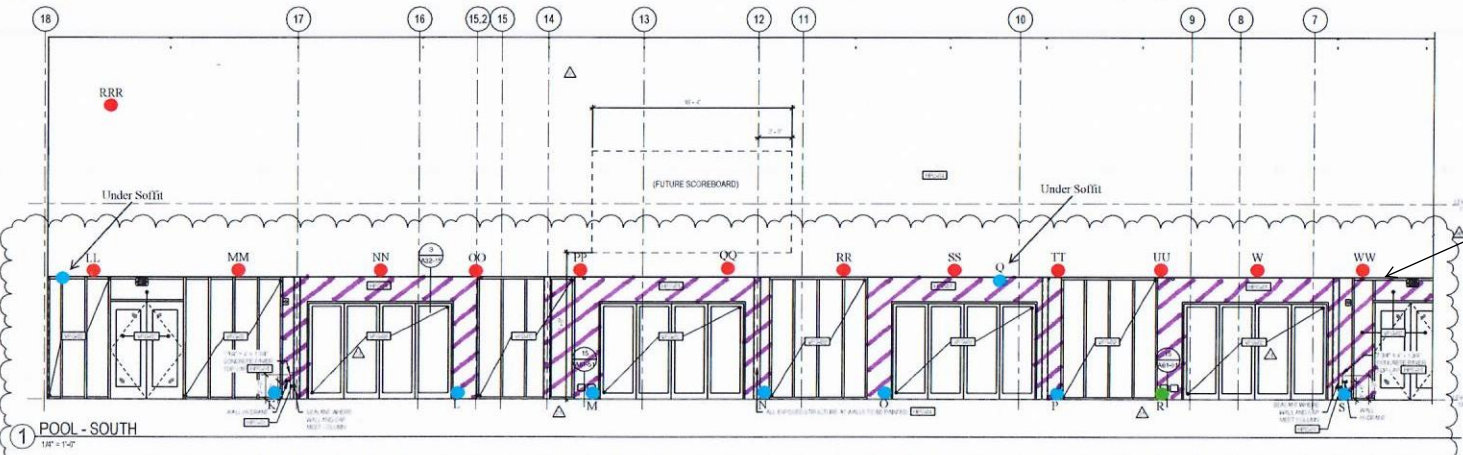

**1 POOL - SOUTH**  
1/8" = 1'-0"

- Visible Mold Growth
- No Visible Mold Growth but Elevated Moisture
- No Visible Mold Growth and No Moisture
- Perform Drywall Removal Under Containment with Mold Remediation

Include Top of Wall

Include Soffit on this Wall