

Ketchum Urban Renewal Agency

P.O. Box 2315 | 480 East Ave. N. | Ketchum, ID 83340

January 21, 2024

Chair and Commissioners Ketchum Urban Renewal Agency Ketchum, Idaho

RECOMMENDATION TO REVIEW AND PROVIDE DIRECTION TO STAFF ON THE REQUEST FROM COREY STREET MASS, LLC, FOR A REIMBURSEMENT AGREEMENT FOR PUBLIC IMPROVEMENTS LOCATED AT 380 N FIRST STREET IN THE AMOUNT OF \$667,828

<u>Summary</u>

Corey Street Mass, LLC, applied to the KURA to enter into a reimbursement agreement for public improvements installed as part of a private development project located at 380 N First Avenue (Attachment A) in the amount of \$667,828. Staff requests Board direction on the request. Should the Board agree to reimburse for the improvements, staff will return to the Board for approval of an Owner Participation Agreement (OPA).

Background

The Board has not entered into a reimbursement agreement for a private development improvements since 2020. Instead, the Board has focused funding of city public infrastructure projects and the First + Washington project. The public improvements as part of the request are identified in the funding application (Attachment A). The improvements are located at the corner of First Avenue and 4th Street as part of the construction of a mixed-use building consisting of 2 market rate residential units and offices. The project was approved by the Planning and Zoning Commission in December 2021 and a building permit was issued in May 2023. A certificate of occupancy has not yet been issued.

In 2022 the KURA amended the funding criteria for reimbursement of improvements associated with private development projects (Attachment B). The criteria for funding applicable to this application are as follows:

• All requests for funding shall be made no later than 30 days after the applicant applies for a building permit.

- Reimbursement for public infrastructure shall commence after the project is generating tax increment to benefit the Agency.
- No more than 50% of the total tax increment generated by the project may be used for reimbursement to the developer.
- KURA may fund 40% of the cost of the following:
 - Cost differential between concrete sidewalks and paver sidewalks, snowmelt systems will not be funded
 - o Installation of street trees
 - o Art or other public amenities in the public right of way
- Mixed use projects are considered commercial projects and may apply for tax increment financing provided they meet all the criteria.

Historically, the KURA has not reimbursed for public improvements that apply to all development projects such as replacement of curbs, gutters, installation of concrete sidewalks and ADA ramps around a project, installation of streetlights, upgrades to water and sewer lines and repair of any damage to public property as a result of the construction project. In this case, with the exception of the sidewalk pavers, street trees, benches and bike racks, the list of improvements provided by the applicant are required improvements for all development projects.

Based on prior reimbursements and the KURA reimbursement policy, the following improvements would be eligible for reimbursement:

 Irrigation systems 	\$1,837
Topsoil	\$4,140
 Landscaping Improvements 	\$1,040
• Trees	\$3,912
Tree grates	\$14,271
Silva cells	\$31,638
Bike racks	\$3,700
 Bench seating 	\$15,761
 Sidewalk pavers 	\$43,611 (need to calculate difference
between concrete sidewalk and	pavers)

Per the KURA funding resolution, KURA would reimburse 40% of the costs which result in a KURA contribution of up to \$47,964 depending on the differential cost between the pavers and concrete sidewalks.

\$119,910

Reimbursement Calculations

Total:

The 2024 taxable value of the property is \$1,137,197. The applicant estimates the taxable value of the property once the project is completed will be \$6,000,000. Using the 2023 applicable tax levy, the current tax increment yield to KURA is \$3,723. If the future taxable value of the property is \$6,000,000, the tax increment yield to KURA is

estimated to be \$19,641 based on the 2023 tax levy. The new net annual amount to KURA is estimated to be \$15,918 (\$19,641 minus \$3,723).

The projected annual reimbursement amount would be 50% of the projected net increment totaling \$7,959 if the taxable value of the property is \$6,000,000. Typically, new construction projects start generating additional tax increment one year after issuance of a certificate of occupancy. Reimbursement calculations are based on the actual taxable value determined by the Blaine County Assessor and verified with documentation. If a certificate of occupancy is issued in 2025, additional tax increment would begin in 2026. Reimbursement would occur 2026-2029, or annually for 4 years. Total reimbursement is projected to be \$31,836.

Requested Funding

The request is for \$667,828, however, based on KURA funding criteria, eligible costs total \$119,910. KURA would reimburse 40% of the costs totaling \$47,764. However, based on the funding calculations, the projected reimbursement amount would be \$31,836.

KURA Financial Impact

KURA revenue projections through 2030 assume no loss in projected revenue due to reimbursement agreements. If this agreement is approved, there will be a revenue loss.

Recommendation and Motion

Staff requests direction from the KURA on the proposed funding request.

Attachments:

Attachment A: Applicant funding request Attachment B: KURA Funding Criteria Attachment A



Ketchum Urban Renewal Agency P.O. Box 2315 | 480 East Ave. N. | Ketchum, ID 83340

APPLICATION FOR PROJECTS REQUESTING FUNDING FROM THE KURA

Applicant and Project Information		
Applicant Name:	Date Submitted:	
Corey Street Mass, LLC	11/18/2024	
Name of Project: 380 First Ave N Mixed Use Building	Estimated Date of 12/15/2025	f Completion:
Project Description: Mixed use building in downtown KEtchum. Public ROW work includes new sidewalks, snow meth		benches.
Project Location: 380 First Ave N Ketchum, ID 83340		
Application Submittal Requirements	Notes	s on Submittals
Brief narrative describing the proposed public benefit of the project		
Map of project location		
Attached professional bids	<u></u>	
Attached preliminary/construction drawings		
Projects Questions: 1. Is this project identified within the Urban Renewal Plan for KURA?	Yes: 🔳	No: 🗆
2. If identified in the Urban Renewal Plan, indicate section and page:	Section: 3.2	Page: <u>6</u>
3. Estimated assessed value of project after completion (taxable value):	\$ 6,000,000.00	
4. Will any KURA board members or staff financially benefit from the project?	Yes: 🗆	No: 🔳
5. New or retained jobs resulting from project:	Full Time: 2	Part Time: 0
	A \$500 000 00	
6. Approximate return on public fund investment. (I.e. Public\$/Private\$)	\$\$500,000.00	

	>
Applicant's Signature	
Property Owner's Signature (if different):	

Date:	11/18/2024	

Date:_


	SSS struction, Inc.	BUDGET ESTIMATE WORKSHEET	380 1st Street Mixed Use Bu of Ketchum right-of-way	ilding. All work ass	ociated with the so	cope of work associa	ted within the City
•	380 1st Street Mixed Use Building	Estimator:	DH	Bid Date:	03/03/22		
	. Ketchum, Idaho			Bid Time:	2:00 PM		
	Williams Partners			Run Date:	03/03/23		
wner	Corey Streey Mass, LLC	Project Duration Work days:	47	Addenda:	0		
Spec.	Systems/Component	Notes	Responsibility	Quantity	UOM	\$/Unit	Total
GENERAL	CONDITIONS:						
01303	Field Labor			31	hr	45.00	1,395
01206	Temporary Site Facilities				day	139.84	6,572
01214	Temporary Construction Facilities			47	day	59.68	2,805
01604	Plan Copies			2	ea	100.00	200
							40.070
	Subtotal General Conditions						10,972
TRAVEL / I	PER DIEM						
01306	Travel/Exp Perdiem	Lodging per IRS Blaine County	Superintendent Travel	47	Day	106.00	4,982
	Subtotal Travel / Per Diem						4,982
01207	Temporary Utilities		Temp Site Power	47	le	36.70	1,725
01207				47	15	30.70	1,725
	Subtotal Utilities						1,725
							.,
Dumpsters	i						
01701	Dumpsters and Debris Hauling			1	ea	795.00	795
	Subtotal Clean UP / Debris						795
SUPERVIS	ION						
01301	Superintendent		CSDI	47	day	278.00	13,066
01401	Project Manager		CSDI		day	326.00	7,172
01410	Project Executive		CSDI		day	381.00	3,810
	Subtotal Supervision						20,238
DIVISION							
01600	Material Testing				ls	3,755.00	3,755
01600	Erosion & Sediment Control				ls	4,500.00	4,500
01600	Traffic Control		Colone Engineering		ls	3,200.00	3,200
01600	Surveying		Galena Engineering	1	ls	3,120.00	3,120
	Division Subtotal			4			14,575
ROW WC	DRK Mobilization		CSDI Construction, Inc.	A	ea	4,386.00	4,386
	Concrete Flatwork		E & J Construction, Inc.	666		4,386.00	4,386 10,496
	Concrete Flatwork prep		E & J Concrete	666		6.91	4,602
	Concrete Vert Curb		E & J Concrete	261		25.49	4,002
	Concrete Wash Out		E & J Concrete		ea	5,200.00	5,200
	Vert Curb Exc/Prep		E & J Concrete	261		20.06	5,236
	Concrete and Paver Snow Melting Systems	Includes Radiant Heating	Thorton Heating & Sheetmetal			68.38	186,472
	Demolition	Includes Landscape, Shrubs, Asphalt, Curb and Sidewalk	Canyon Excavation	2,000		6.70	13,400
26 00 01	Ketchum - Street Lights	Relocation of Existing	Roberts Electric ALLOWANCE		ea	8,208.00	24,624
26 00 01	Ketchum- Light bollards	Provided by City of Ketchum	Roberts Electric ALLOWANCE	4	ea	1,052.00	4,208
26 00 01	Electrical, pipe, wire bollards & lights		Roberts Electric ALLOWANCE	7	ls	1,024.00	7,168
31 00 00	Traffic Control	Utility scope	CSDI Construction, Inc.	1	ea	1,750.00	1,750
32 17 24	Post Mounted Signage		Roberts Electric ALLOWANCE	1	ea	800.00	800
	Drop Inlet Catch Basin	Includes 30" Diameter	Canyon Excavation	1	ea	2,500.00	2,500
33 06 40	•	Includes 30" Diameter	Canyon Excavation		ea	3,500.00	7,000
1	Storm Drain Pipe	Includes 12" ADS N-12	Canyon Excavation	20	lf	75.00	1,500

T:\01 Estimating Department\380 1st Ave Ketchum\Distributed to Owner\380 1st Ave Ketchum - KURA Estimate Worksheet - Distributed 20230303

KURA, Sheet 1 of 2

			380 1st Street Mixed Use Bu	ilding. All work ass	ociated with the s	scope of work associ	ated within the City
	struction, Inc.	BUDGET ESTIMATE WORKSHEET	of Ketchum right-of-way				
Project	. 380 1st Street Mixed Use Building	Estimator:	DH	Bid Date:	03/03/22		
2	. Ketchum, Idaho			Bid Time:	2:00 PM		
	. Williams Partners			Run Date:	03/03/23		
		Project Duration Work days:	47	Addenda:			
	. Corey Streey Mass, LLC	Project Duration Work days:	47		0		
Spec.	Systems/Component	Notes	Responsibility	Quantity	UOM	\$/Unit	Total
33 10 00	6" Fire Line		Canyon Excavation	267	lf	219.06	58,488
33 10 00	4" Water Service		Canyon Excavation	90	lf	201.16	18,104
32 11 00	2" Minus pit run Asphalt Sub Base 8"		Canyon Excavation	4,030	sf	3.92	15,801
32 11 00	4" Crushed Aggregate		Canyon Excavation	4,030	sf	4.64	18,698
32 12 16	Asphalt Pavement	City of Ketchum Standard	Idaho Materials & Constructior	3,364	sf	9.48	31,887
32 12 16	Sawcut Asphalt		CSDI Construction, Inc.	506	lf	12.00	6,072
32 17 23	Pavement Markings	Includes Cross Walk	CSDI Construction, Inc.	1.0	ea	3,250.00	3,250
32 80 00	Irrigations Systems		Native Evergreen Landscapes	100	lf	18.37	1,837
32 80 00	Topsoil		Native Evergreen Landscapes		су	46.00	4,140
32 80 00	Landscaping/Improvements		Native Evergreen Landscapes		ls	1,040.00	1,040
32 80 00	Trees		Native Evergreen Landscapes		ea	978.01	3,912
32 80 00	Tree Grates		Native Evergreen Landscapes		ea	3,567.65	14,271
32 80 00	Silva Cells		Native Evergreen Landscapes		ea	31,638.00	31,638
	Concrete Unit Pavers		Native Evergreen Landscapes			18.96	43,611
	Bench Seating	Includes Powder coating	Native Evergreen Landscapes		ea	5,253.50	15,761
	Bike Racks	Includes Powder coating	Native Evergreen Landscapes		ea	1,850.00	3,700
	Sanitary Sewer Utility	Includes Relocation to new tie in Location			ea	4,000.00	4,000
33 33 00				I	ca	4,000.00	4,000
	Division Subtotal						562,204
SUBTOTAL	L - HARD COSTS						615,491
01100	Liability Insurance	0.52%				3,201	3,201
01106	Builders Risk Insurance	By Owner				0	-
01101	Building Permits	By Owner				-	-
	Overhead	5.25%				35,080	35,080
	Fee	2.10%				14,056	14,056
						SUBTOTAL =	667,828
01151	State/Local Sales/use tax	0.00%				0	-
01151	Local/city tax	0.00%				0	_
01103	Bonding	Not included in total add \$8,049 if req			() 0	-
01910	Owner Contingency	0.00%				0	-
				BUDGET	FSTIMAT	E TOTAL =	667,828

T:\01 Estimating Department\380 1st Ave Ketchum\Distributed to Owner\380 1st Ave Ketchum - KURA Estimate Worksheet - Distributed 20230303

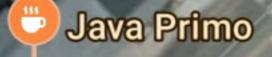

Projects

HER SEL

ISP FRON

AttnStE

Maude's Coffee & Clothes

Premier Cleaners




Smoky Mou Pizzeria G

Ketchyum

()x

TOAL

Hasshington Ale N

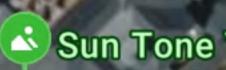

V

Core Engine Fitness

<u>Owner:</u> Corey Streey Mass, LLC 11361 Farlin Street Los Angeles, California 90049

<u>Architect:</u> Williams | Partners Architects Jeff Williams: jeff@williams-partners.com P.O. Box 4373 Ketchum, ID 83340 Ph. 208.726.0020 Fax 208.726.0019

<u>Geotechnical Engineer:</u> Butler Associates Steve Butler: svgeotech@gmail.com P.O. Box 1034 Ketchum, ID 83340 Ph. 208.720.6432

Landscape Architect: Landwork Studio LLC Rob King: rob@landworkstudio.com P.O. Box 300 Ketchum, ID 83340 Ph. 208.726.5331

<u>Civil Engineer:</u> Galena Engineering, Inc Sean Flynn: sflynn@galena-engineering.com 317 N. River Street Hailey, ID 83333 Ph. 208.788.1705

<u>Structural Engineer:</u> Liv Jensen Engineering, PLLC Liv Jensen: liv@cox.net 441 Eastridge Drive Hailey, ID 83333 Ph. 208.720.5549

Interior Design: Jennifer Hoey Interior Design Jennifer Hoey: jennifer@jenniferhoey.com Abbey Mayhew: abbey@jenniferhoey.com P.O. Box 6409 Ketchum, ID 83340 Ph. 208.726.1561

Electrical Consultant: SYSWEST Ross Williams: ross@syswest.net 22922 Lake Wenatchee Highway Leavenworth, WA 98826

<u>Owner's Representative:</u> Grabher Construction P.O. Box 507 Sun Valley, ID 83353 Ph. 208.726.3916 Fax 208.726.9081

<u>General Contractor:</u> **CSDI** Construction, Inc. Gabriel Myers: gmyers@csdiconstruction.com 6353 Supply Way, Boise, Idaho 83716 Office: 208-338-5973 Cell: 208-830-5120

380 N. 1ST AVE. MIXED-USE BUILDING



Land Use Information Map



March 18, 2021

Satellite View 380 North First Avenue; Ketchum, Idaho

1:984 0.01 0.03 mi 0.01 0.01 0.03 0.05 km 0 Blaine County GIS

Made by: Blaine County GIS

PROJECT INFORMATION

LEGAL DESCRIPTION:	LOT 5, BLOCK 37 KETCHUM
ADDRESS:	380 NORTH FIRST AVENUE KETCHUM, ID 83340
ZONING: SETBACKS:	CC, SD 2 (COMMUNITY CORE, SUBDISTRICT 2: MIXED USE) FRONT AND STREET SIDE: 5' AVERAGE INTERIOR SIDE: 0' ADJACENT TO ALLEYWAY: 3'
MAX BUILDING HEIGHT:	42' [AVERAGE FRONT PROPERTY LINE ELEVATION = 5827.2' AVERAGE REAR PROPERTY LINE ELEVATION = 5827.05' MAX HEIGHT = 42'+5827.05' = <u>5869.05'</u>]
CONSTRUCTION TYPE:	V-B (IBC SECTION 602.5)
OCCUPANCY:	OFFICE: BUSINESS GROUP B (IBC 304.1), (2) RESIDENTIAL UNITS (APARTMENTS): RESIDENTIAL GROUP R-3 (IBC 310.4), GARAGES: UTILITY AND MISCELLANEOUS GROUP U (IBC 312) *BUILDING WILL NOT BE CONDOMINIUMIZED.

DRAWING INDEX

COVER SHEET

<u>02</u> (A 0.0	COVER SHEET 3	S 00
		S 10
CIVIL		S 10
-		S 10
TOPO C 0.1	CIVIL SURVEY COVER & CONSTRUCTION NOTES	S 10
C 0.1		S 50
C 0.3 C 1.0	SITE GEOMETRY PLAN	S 50
C 1.0	GRADING & DRAINAGE PLAN	S 50 S 50
C 1.2	DETAIL SHEET	s 50 S 50
C 1.2		S 50
	_	S 50
LANDSCAP	٨	S 50
L-1.0	SITE PLAN 1	S 50
L-2.0	GRADING PLAN	SSK-
L-3.0	LANDSCAPE PLAN 1	
L-3.1	LANDSCAPE MATERIALS PLAN	FI FOTDIO
L-4.0	CONSTRUCTION MANAGEMENT PLAN 1	ELECTRIC
		E 1.
BULDING I	NFORMATION / SYSTEMS	E 1.
A 0.1	CODE ANALYSIS / EGRESS DIAGRAMS 🔟	E 1.
A 0.2	CODE ANALYSIS / EGRESS DIAGRAMS	E 1. E 1.
A 0.3	CODE ANALYSIS / EGRESS DIAGRAMS	E 1.
A 0.4	CODE ANALYSIS / EGRESS DIAGRAMS	E 2.
<u>⁄oi</u> { Å 0.5 ``	ĎŮĬĽĎĬŇĠ ŠÝŠŤĚŇS	E 2.
<mark>⊱</mark> A 0.6	BUILDING SYSTEMS	E 2.
A 0.7	BUILDING SYSTEMS	
	BUILDING SYSTEMS 201	
	BUILDING SYSTEMS	
A 0.10	BUILDING SYSTEMS	ξ ID 0.
A 0.11	MATERIALS BOARD 🔟	ξ ID 1.
		ξ ID 1.
ARCHITECT	URAL SITE PLAN	E ID 1. E ID 1.
All	ARCHITECTURAL SITE PLAN	
<u>A</u> , 1, 2	ARCHITECTURAL SITE PLAN 201	

FLOOR PLANS

∕02 € A 2.1	FIRST FLOOR PLAN - 1/8"
A 2.2	SECOND FLOOR PLAN - 1/8"
ξA 2.3	THIRD FLOOR PLAN - 1/8"
ξA 2.4	ROOF PLAN - 1/8"/01
A 2.5	FIRST FLOOR PLAN - 1/4" 1
ξA 2.6	SECOND FLOOR PLAN - 1/4
× A 2.7	THIRD FLOOR PLAN - 1/4 ^m
ξ A 2.8	ROOF PLAN - 1/4"/01

BUILDING SECTIONS

	RIULDING SECTIONS (1))
	BUILDING SECTIONS	
A 3.3	BUILDING SECTIONS	
A 3.4	BUILDING SECTIONS	
A 3.5	BUILDING SECTIONS	
	BUILDING SECTIONS	

EXTERIOR ELEVATIONS

A 4.1	EXTERIOR ELEVATIONS - EXISTING
<u>∕01</u> { Å 4.2	ĚXTĚŘIOŘ ĚLĚVATIONS 3
₹ A 4,3	EXTERIOR ELEVATIONS
A 4.4	EXTERIOR ELEVATIONS
<u>/1</u> (Å 4.5	EXTERIOR ELEVATIONS

REFLECTED CEILING PLANS

A 5.1 A 5.2 A 5.3 R	EFLECTED CEILING PLAN EFLECTED CEILING PLAN EFLECTED CEILING PLAN
------------------------------	---

INTERIOR ELEVATIONS

A 6.1	INTERIOR ELEVATIONS
¢ A 6.2	INTERIOR ELEVATIONS
<mark>></mark> A 6.3	INTERIOR ELEVATIONS
<mark>₹</mark> A 6.4	INTERIOR ELEVATIONS
¢ A 6.5	INTERIOR ELEVATIONS
A 6.6	INTERIOR ELEVATIONS
ξ Α 6,7	INTERIOR ELEVATIONS 3
A 6.8	INTERIOR ELEVATIONS

ARCHITECTURAL DETAILS

A 7.1	ARCHITECTURAL DETAILS
<u>∕01</u> { Å 7.2	ARCHITECTURAL DETAILS 3
A 7.3	ARCHITECTURAL DETAILS 🚽
× A 7.4	ARCHITECTURAL DETAILS
EA 7.5	ARCHITECTURAL DETAILS

DOOR AND WINDOW SCHEDULES

A 8.1	WINDOW SCHEDULE
8.2	DOOR SCHEDULE
A 8.3	DOOR AND WINDOW DETAILS

A 0.J	DOOK AND WINDOW DLIAILS
A 8.4	DOOR AND WINDOW DETAILS
<u>A 8.5</u>	DOOR AND WINDOW DETAILS
00000000	

3D VIEWS

A 9.1 3D VIEWS

S 000 S 100 S 101 S 102 S 103 S 500 S 501 S 502	STRUCTURAL SPECIFICATIONS OT FOUNDATION AND FIRST FLOOR FRAMING PLAN OT SSKA SSKR SECOND FLOOR AND LOWER ROOF FRAMING PLAN OT 3RD FLOOR AND MID-ROOF FRAMING PLAN OT UPPER ROOF FRAMING PLAN OT STRUCTURAL DETAILS OT SSKR STRUCTURAL DETAILS OT SSKR STRUCTURAL DETAILS OT
S 503	STRUCTURAL DETAILS 1
S 504	STRUCTURAL DETAILS
S 505	STRUCTURAL DETAILS 1 SKIN
S 506	STRUCTURAL DETAILS
S 507	STRUCTURAL DETAILS OI SKIN STRUCTURAL DETAILS OI SKIN
S 508 SSK-10	STRUCTURAL DETAILS 201 2011
221-10	
	TELCOMM DRAWINGS
-	
E 1.1	FIRST FLOOR ELECTRICAL PLAN
E 1.2	SECOND FLOOR ELECTRICAL PLAN
E 1.3 E 1.4	THIRD FLOOR ELECTRICAL PLAN Roof Electrical plan
E 1.4 E 1.5	ELECTRICAL PLAN
E 1.5	FIXTURE SCHEDULE
E 2.1	FIRST FLOOR TELCOM PLAN
E 2.2	SECOND FLOOR TELCOM PLAN
E 2.2	THIRD FLOOR TELCOM PLAN
L 2.J	
INTERIORS	
ID 0.0	INTERIOR DESIGN COVER SHEET
ID 1.0	FIRST FLOOR OVERALL PLAN
ID 1.1	KITCHEN
ID 1.2	UNIT 1 BED ALCOVE
ID 1.3	
ID 1.4	UNIT 1 BATH
ID 1.5	UNIT 1 MUDROOM/LAUNDRY
ID 1.6	UNIT 1 HALLWAY/STORAGE
ID 1.7	CABIN OFFICE
ID 1.8	CABIN OFFICE
ID 1.9	BREAKROOM/KITCHENETTE
ID 1.10	UNIT 1 GARAGE
ID 1.11	UNIT 2 GARAGE
ID 2.1	SECOND LEVEL PLAN
ID 2.2	UNIT 2 LIVING/HALL/DINING/KITCHEN
ID 2.3 ID 2.4	UNIT 2 LIVING/HALL/DINING/KITCHEN
ID 2.4 ID 2.5	BEDROOM 2
ID 2.5 ID 2.6	BEDROOM 2
ID 2.0 ID 2.7	BATH 2
ID 2.7 ID 2.8	MASTER BED/HALLWAY/LINEN
ID 2.0	MASTER BATH
ID 2.10	MASTER CLOSET
ID 2.10	OUTDOOR KITCHEN
ID 3.1	FINISHES
	············ · · · · · · · · · · · · ·

STRUCTURAL DRAWINGS

Building

WILLIAMS	PARTNERS
\mathbf{O}	
8(Lot
	5,
Z	Bloc
•	k 3.
	7, K
St	etch
A	ot 5, Block 37, Ketchum,

ixed-Use

ARCHITECTS

MAIL P.O.B. 4373 KETCHUM, IDAHO 83340 PHONE 208.726.0020 FAX 208.726.0019 WWW WILLIAMS-PARTNERS.COM


DRAWINGS


DATE: ISSUED: 05/12/2021 COK SCHEMATIC PRESENTATION 06/10/2021 | COK HPC REVIEW 09/30/2021 DESIGN REVIEW 04/22/2022 PRICING SET 08/05/2022 PERMIT 08/02/2023 ISSUED FOR CONSTRUCTION


REVISIONS NUMBER: DATE:


01 08/02/2023



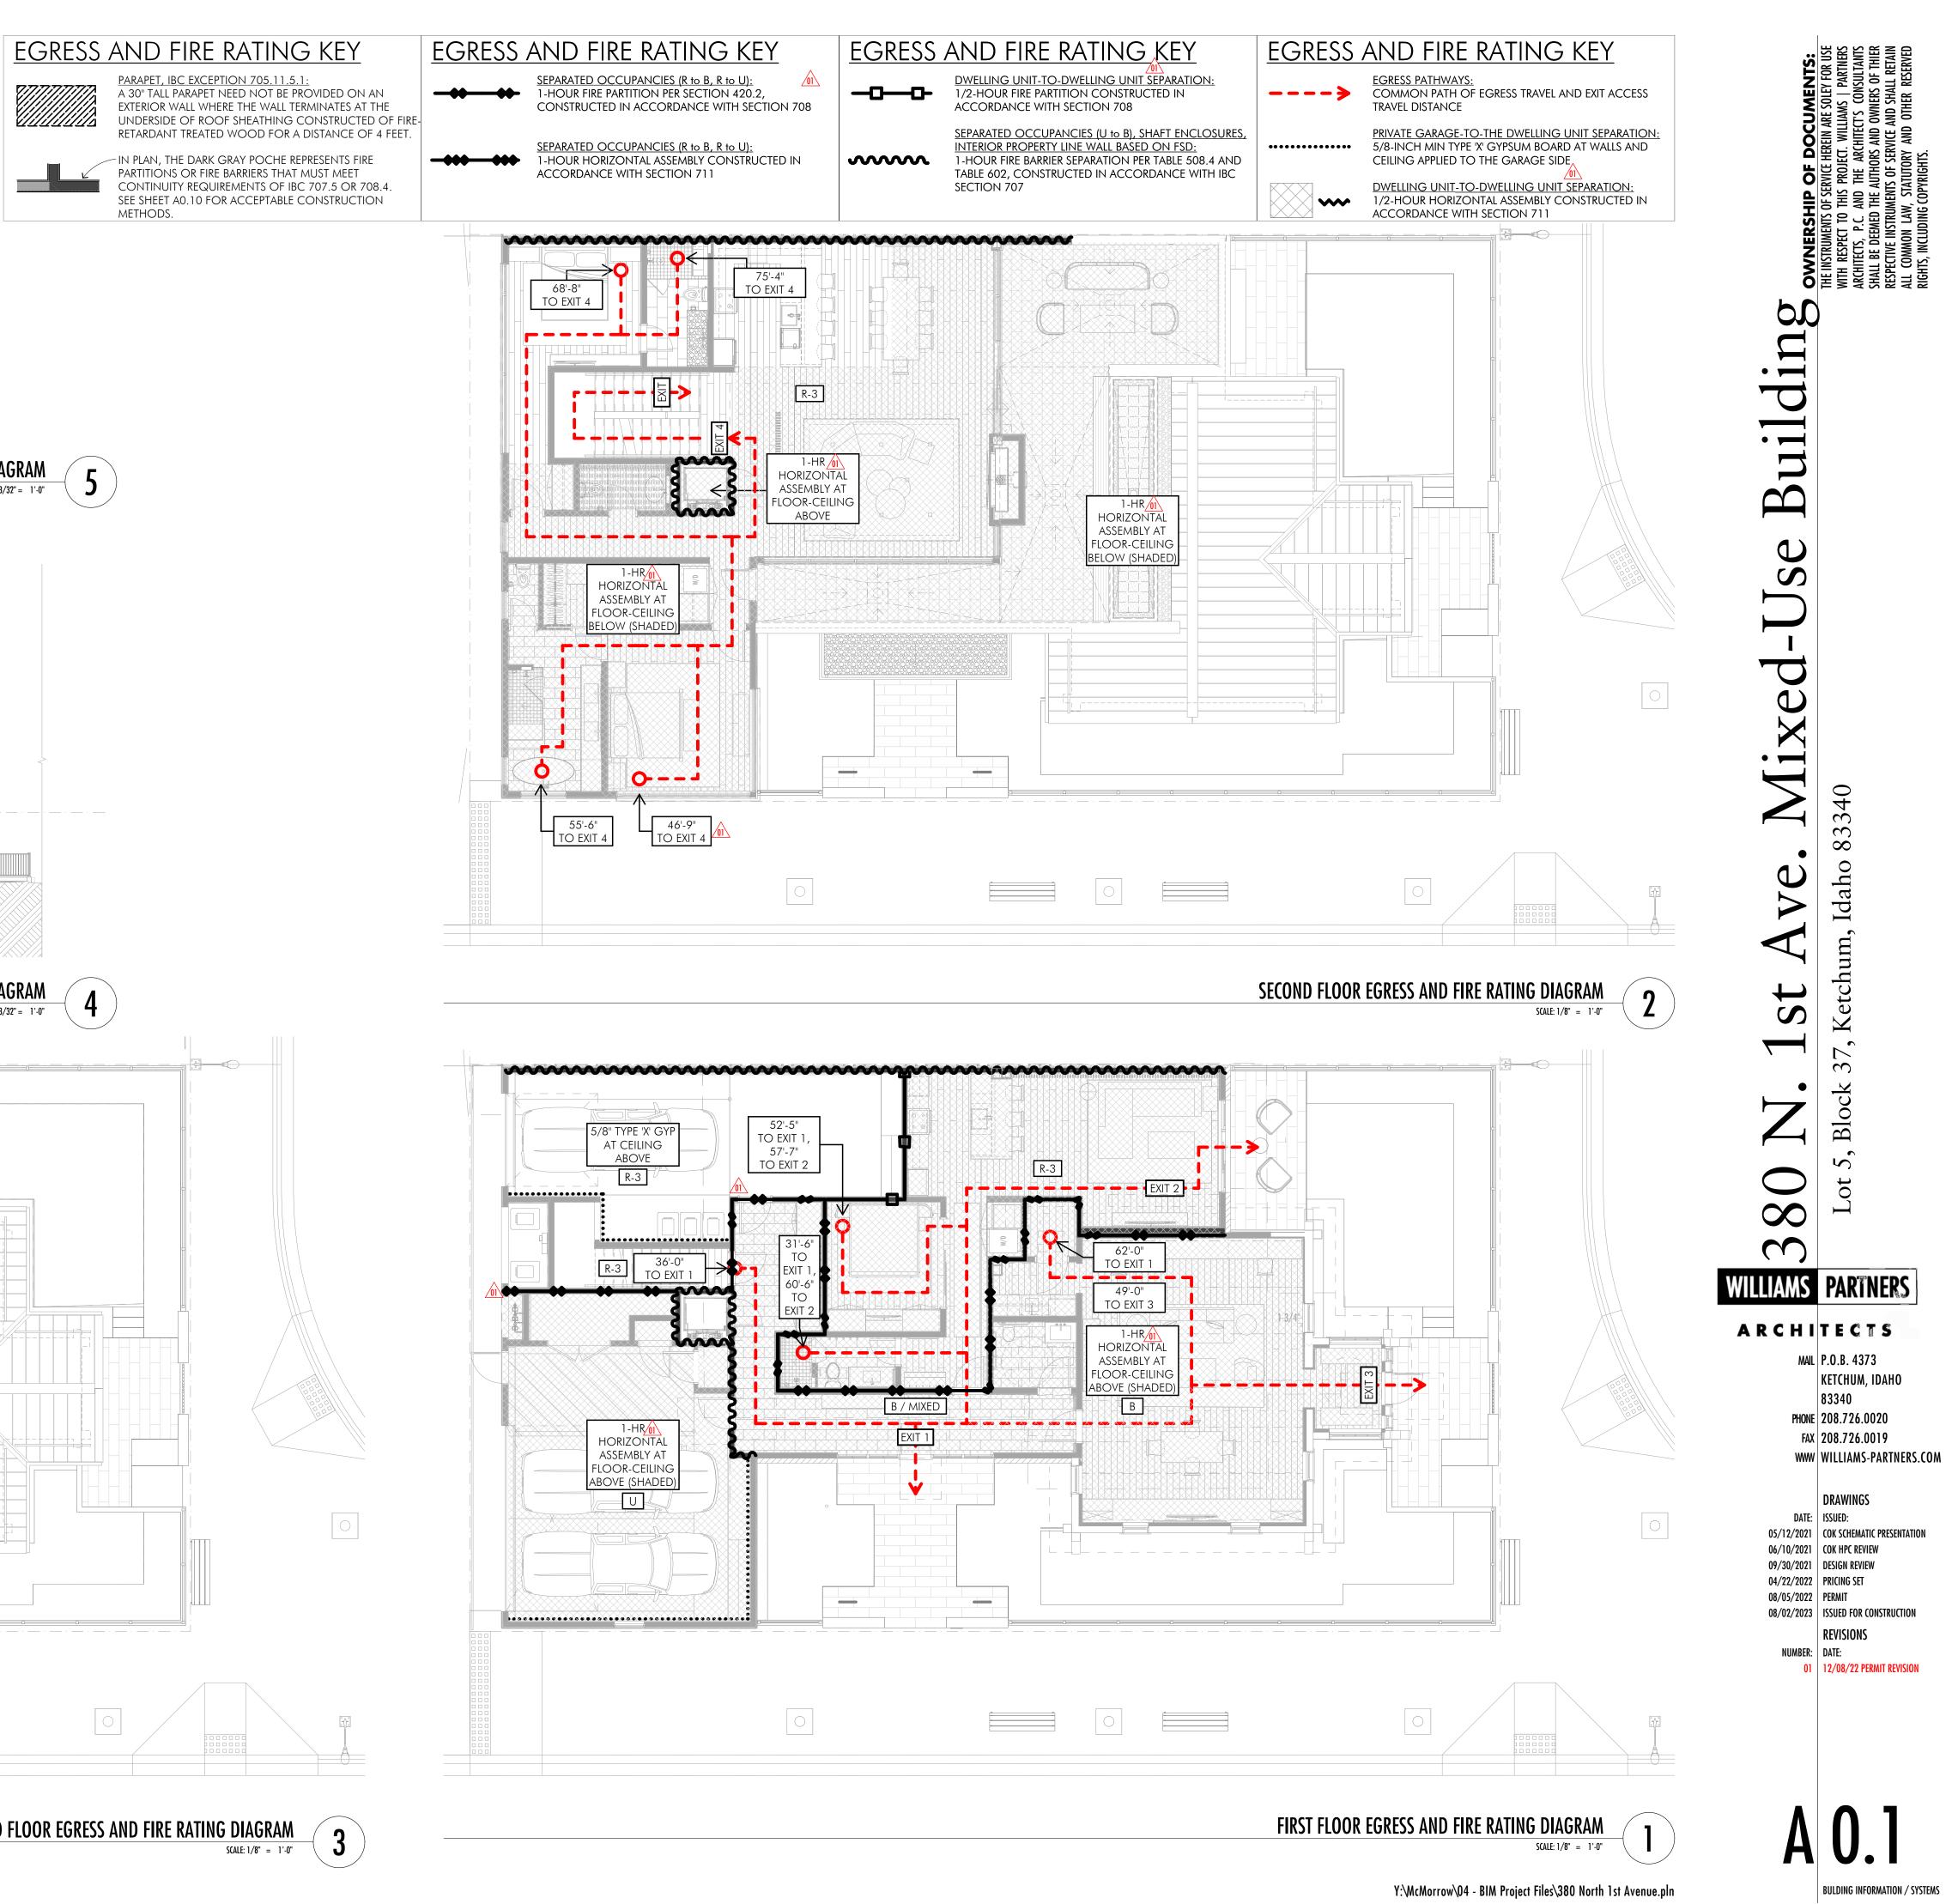

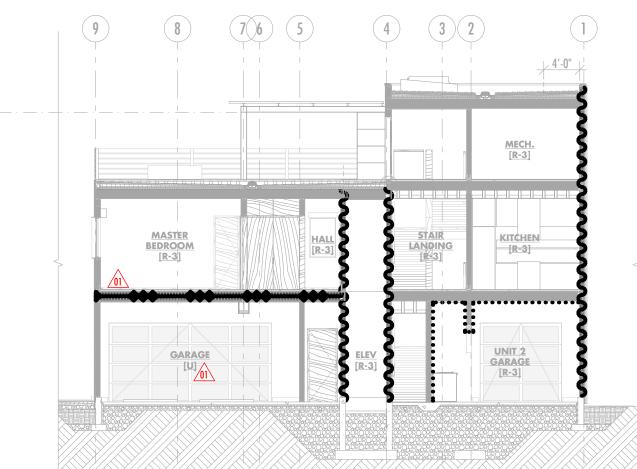

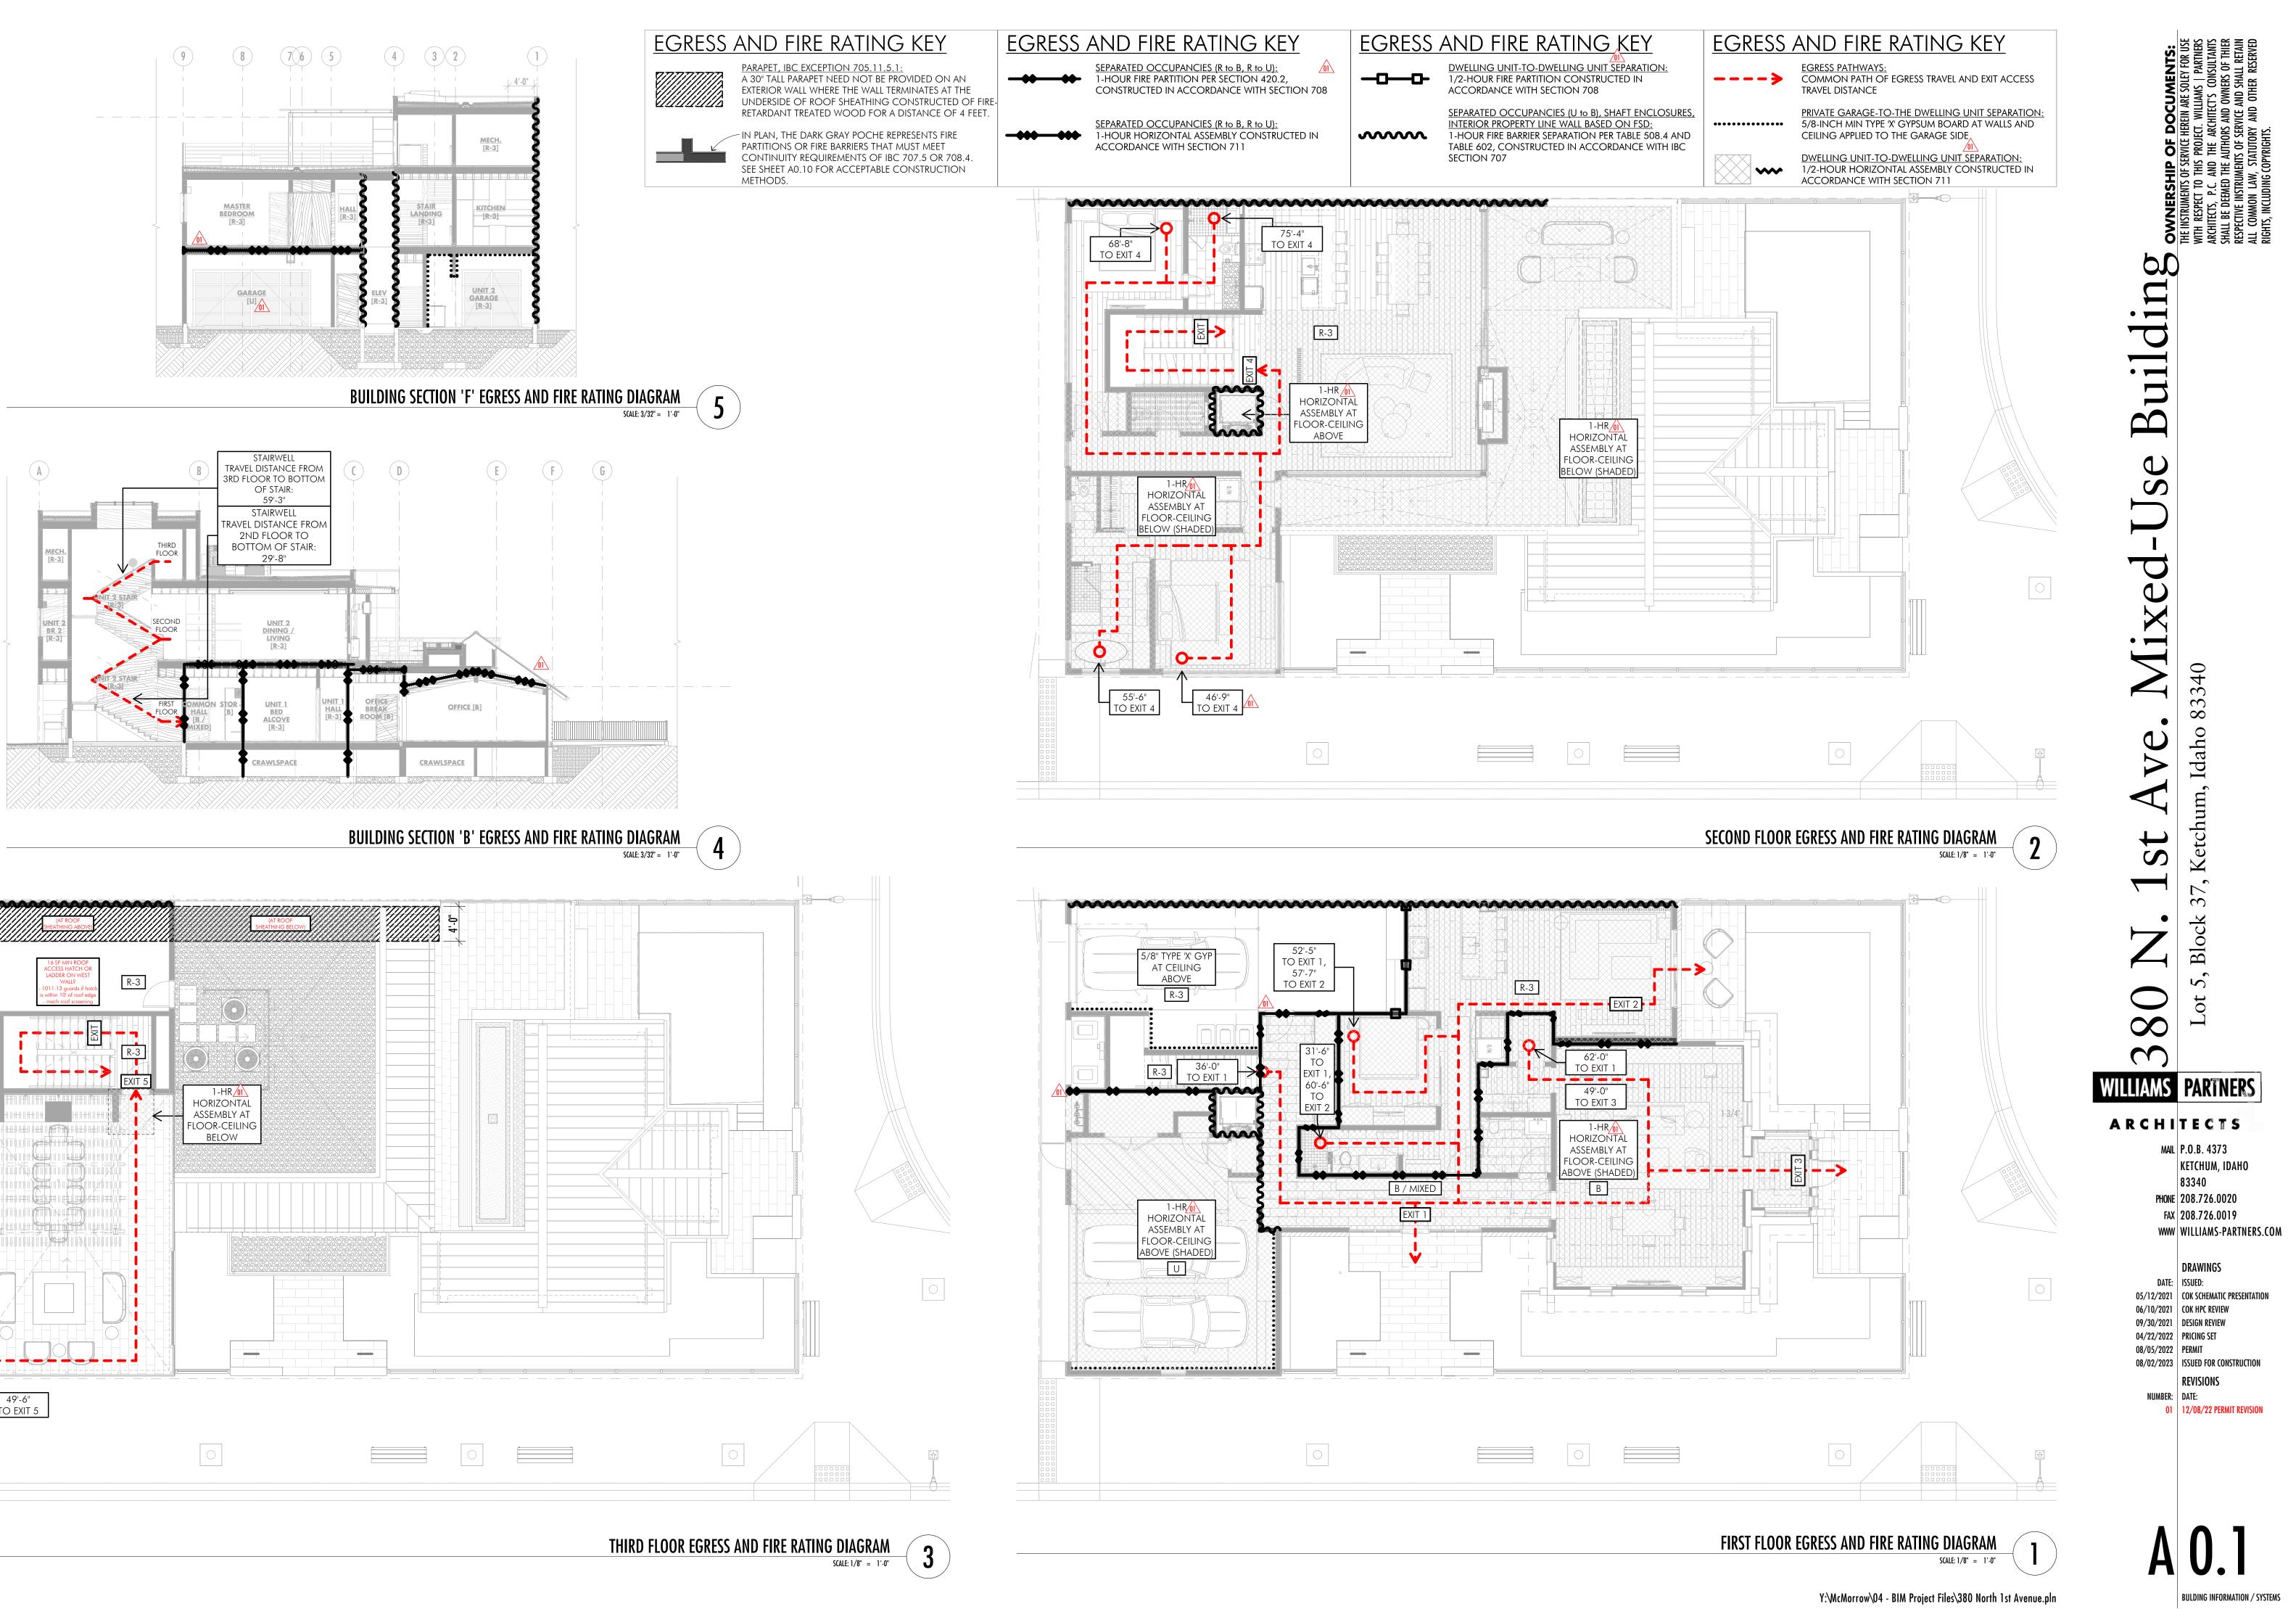

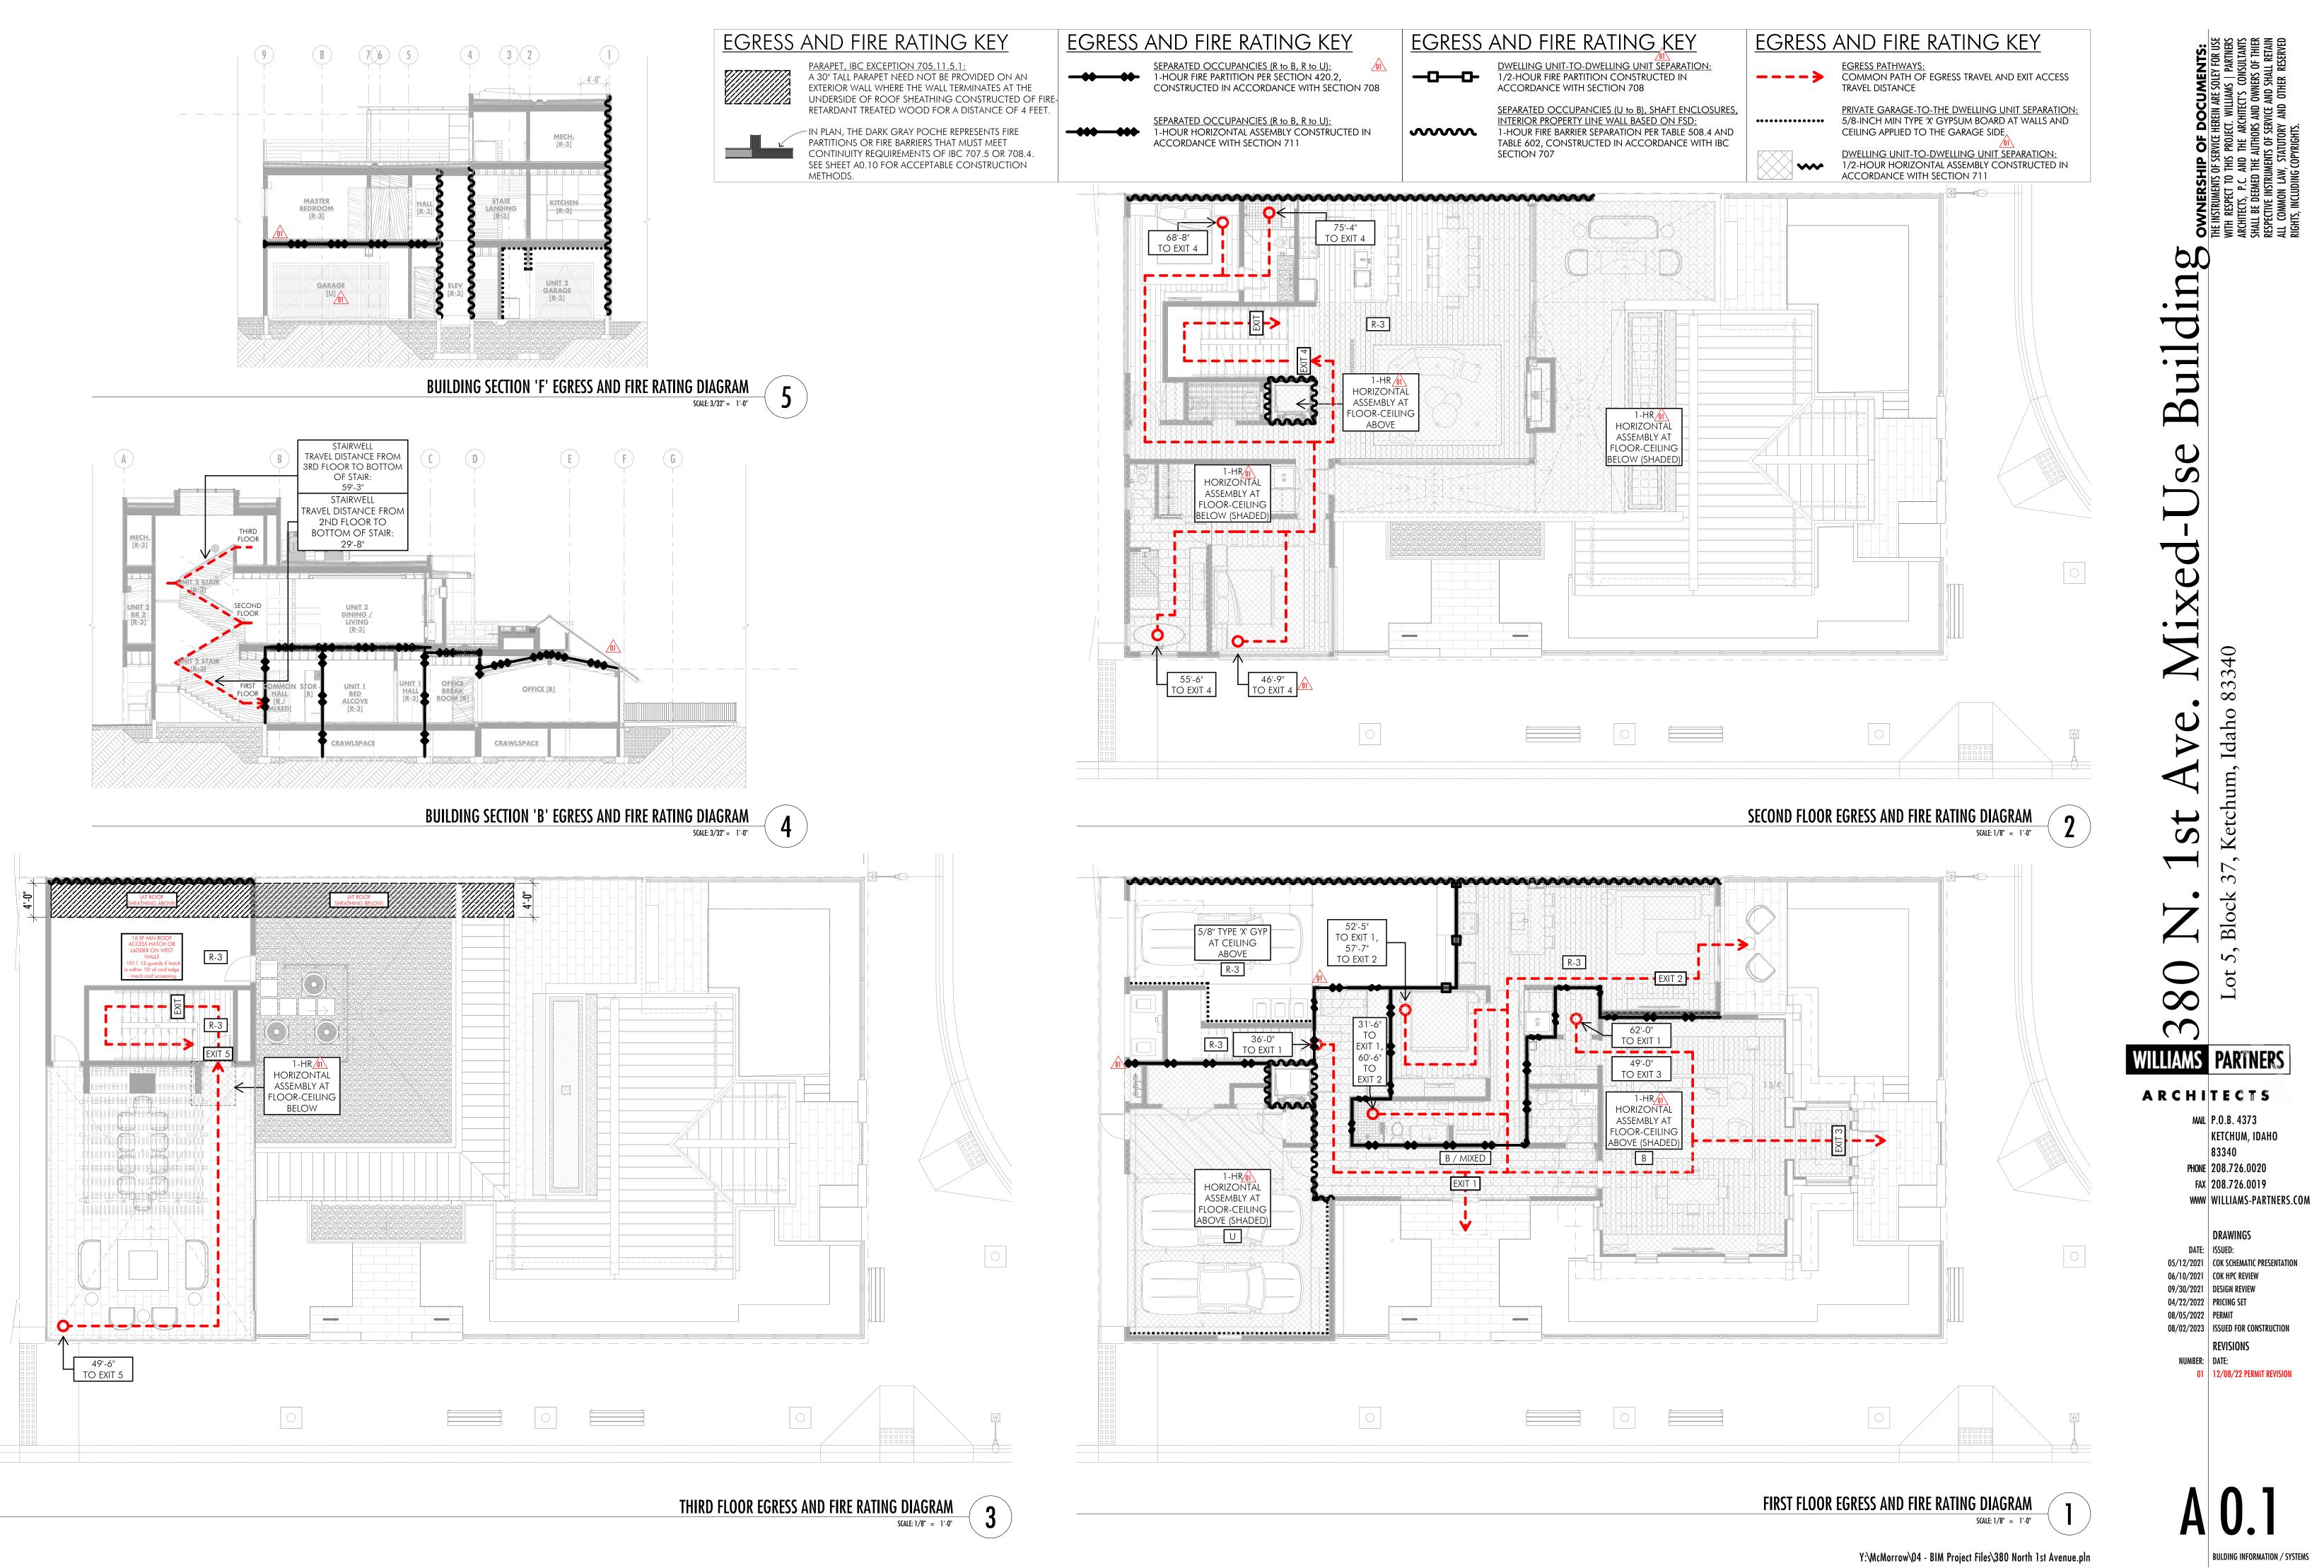

CODE INFORMATION

SECTION 714 PENETRATIONS

714.1.1 DUCTS AND AIR TRANSFER OPENINGS. PENETRATIONS OF FIRE-RESISTANCE-RATED WALLS BY DUCTS THAT ARE NOT PROTECTED WITH DAMPERS SHALL COMPLY WITH SECTIONS 714.3 THROUGH 714.4.3. PENETRATIONS OF HORIZONTAL ASSEMBLIES NOT PROTECTED WITH A SHAFT AS PERMITTED BY SECTION 717.6, AND NOT REQUIRED TO BE PROTECTED WITH FIRE DAMPERS BY OTHER SECTIONS OF THIS CODE, SHALL COMPLY WITH SECTIONS 714.5 THROUGH 714.6.2. DUCTS AND AIR TRANSFER OPENINGS THAT ARE PROTECTED WITH DAMPERS SHALL COMPLY WITH SECTION 717.

714.4 FIRE-RESISTANCE-RATED WALLS. PENETRATIONS INTO OR THROUGH FIRE WALLS, FIRE BARRIERS, SMOKE BARRIER WALLS AND FIRE PARTITIONS SHALL COMPLY WITH SECTIONS 714.4.1 THROUGH 714.4.3. PENETRATIONS IN SMOKE BARRIER WALLS SHALL ALSO COMPLY WITH SECTION 714.5.4. 714.4.1 THROUGH PENETRATIONS. THROUGH PENETRATIONS OF FIRE-RESISTANCE-RATED WALLS SHALL COMPLY WITH SECTION 714.4.1.1 OR 714.4.1.2.

714.4.2 MEMBRANE PENETRATIONS. MEMBRANE PENETRATIONS SHALL COMPLY WITH SECTION 714.4.1. WHERE WALLS OR PARTITIONS ARE REQUIRED TO HAVE A FIRE RESISTANCE RATING, RECESSED FIXTURES SHALL BE INSTALLED SUCH THAT THE REQUIRED FIRE RESISTANCE WILL NOT BE REDUCED.

THERMAL- AND SOUND- INSULATING MATERIALS (SECTION 720) 720.2 CONCEALED INSTALLATION. INSULATING MATERIALS, WHERE CONCEALED AS INSTALLED IN BUILDINGS OF ANY TYPE OF CONSTRUCTION, SHALL HAVE A FLAME SPREAD INDEX OF NOT MORE THAN 25 AND A SMOKE-DEVELOPED INDEX OF NOT MORE THAN 450. EXCEPTION: CELLULOSIC FIBER LOOSE-FILL INSULATION COMPLYING WITH THE REQUIREMENTS OF SECTION 720.6 SHALL NOT BE REQUIRED TO MEET A FLAME SPREAD INDEX REQUIREMENT BUT SHALL BE REQUIRED TO MEET A SMOKE-DEVELOPED INDEX OF NOT MORE THAN 450 WHEN TESTED IN ACCORDANCE WITH CAN/ULC \$102.2.

INTERIOR FINISH REQUIREMENTS (TABLE 803.13)

WALL AND CEILING FINISH MATERIALS SHALL HAVE A FLAME SPREAD INDEX OF NOT GREATER THAN THE FOLLOWING FOR THE GROUP AND LOCATION DESIGNATED, PER TABLE 803.13:

	EXIT STAIRS AND	CORRIDORS AND	ROOMS &
	EXIT PASSAGEWAYS	EXIT ACCESS STAIRWAYS	<u>ENCLOSED SPACES</u>
В	В	С	С
R-3	С	С	С
U	NO RESTRICTIONS	NO RESTRICTIONS	NO
RESTR	ICTIONS		

803.1.2 INTERIOR WALL AND CEILING FINISH MATERIALS TESTED IN ACCORDANCE WITH ASTM E84 OR UL 723. INTERIOR WALL AND CEILING FINISH MATERIALS SHALL BE CLASSIFIED IN ACCORDANCE WITH ASTM E84 OR UL 723. SUCH INTERIOR FINISH MATERIALS SHALL BE GROUPED IN THE FOLLOWING CLASSES IN ACCORDANCE WITH THEIR FLAME SPREAD AND SMOKE-DEVELOPED INDICES.

<u>CLASS A</u> = FLAME SPREAD INDEX 0-25; SMOKE-DEVELOPED INDEX 0-450. <u>CLASS B</u> = FLAME SPREAD INDEX 26-75; SMOKE-DEVELOPED INDEX 0-450. CLASS C = FLAME SPREAD INDEX 76-200; SMOKE-DEVELOPED INDEX 0-450. SHALL BE PROTECTED TO AFFORD THE REQUIRED FIRE-RESISTANCE RATING EXCEPTION: MATERIALS TESTED IN ACCORDANCE WITH SECTION 803.1.1 AND AS INDICATED IN SECTIONS 803.1.3 THROUGH 803.13.

FIRE ALARM AND DETECTION SYSTEMS (SECTION 907)

[F] 907.2 WHERE REQUIRED-NEW BUILDINGS AND STRUCTURES. AN APPROVED FIRE ALARM SYSTEM INSTALLED IN ACCORDANCE WITH THE PROVISIONS OF THIS CODE AND NFPA 72 SHALL BE PROVIDED IN NEW BUILDINGS AND STRUCTURES IN ACCORDANCE WITH SECTIONS 907.2.1 THROUGH 907.2.23 AND PROVIDE OCCUPANT NOTIFICATION IN ACCORDANCE WITH SECTION 907.5, UNLESS OTHER REQUIREMENTS ARE PROVIDED BY ANOTHER SECTION OF THIS CODE

NOT FEWER THAN ONE MANUAL FIRE ALARM BOX SHALL BE PROVIDED IN AN 711.2.4 FIRE-RESISTANCE RATING. THE FIRE-RESISTANCE RATING OF APPROVED LOCATION TO INITIATE A FIRE ALARM SIGNAL FOR FIRE ALARM SYSTEMS EMPLOYING AUTOMATIC FIRE DETECTORS OR WATERFLOW DETECTION DEVICES. WHERE OTHER SECTIONS OF THIS CODE ALLOW ELIMINATION OF FIRE ALARM BOXES DUE TO SPRINKLERS, A SINGLE FIRE ALARM BOX SHALL BE INSTALLED.

[F] 907.2.2 GROUP B. A MANUAL FIRE ALARM SYSTEM SHALL BE INSTALLED IN GROUP B OCCUPANCIES WHERE ONE OF THE FOLLOWING CONDITIONS FXISTS

1. THE COMBINED GROUP B OCCUPANT LOAD OF ALL FLOORS IS 500 OR MORE

2. THE GROUP B OCCUPANT LOAD IS MORE THAN 100 PERSONS ABOVE OR BELOW THE LOWEST LEVEL OF EXIT DISCHARGE.

3. THE FIRE AREA CONTAINS AN AMBULATORY CARE FACILITY. EXCEPTION: MANUAL FIRE ALARM BOXES ARE NOT REQUIRED WHERE THE BUILDING IS EQUIPPED THROUGHOUT WITH AN AUTOMATIC SPRINKLER SYSTEM INSTALLED IN ACCORDANCE WITH SECTION 903.3.1.1 AND THE OCCUPANT NOTIFICATION APPLIANCES WILL ACTIVATE THROUGHOUT THE NOTIFICATION ZONES UPON SPRINKLER WATER FLOW.

NUMBER OF EXITS AND EXIT ACCESS DOORWAYS (SECTION 1006) 1006.3.3.1 MIXED OCCUPANCIES. WHERE ONE EXIT, OR EXIT ACCESS STAIRWAY OR RAMP PROVIDING ACCESS TO EXITS AT OTHER STORIES, IS PERMITTED TO SERVE INDIVIDUAL STORIES, MIXED OCCUPANCIES SHALL BE PERMITTED TO BE SERVED BY SINGLE EXITS PROVIDED EACH INDIVIDUAL OCCUPANCY COMPLIES WITH THE APPLICABLE REQUIREMENTS OF TABLE 1006.3.3(1) OR 1006.3.3(2) FOR THAT OCCUPANCY. WHERE APPLICABLE, CUMULATIVE OCCUPANT LOADS FROM ADJACENT OCCUPANCIES SHALL BE CONSIDERED TO BE IN ACCORDANCE WITH THE PROVISIONS OF SECTION 1004.1. IN EACH STORY OF A MIXED OCCUPANCY BUILDING, THE MAXIMUM NUMBER OF OCCUPANTS SERVED BY A SINGLE EXIT SHALL BE SUCH THAT THE SUM OF THE RATIOS OF THE CALCULATED NUMBER OF OCCUPANTS OF THE SPACE DIVIDED BY THE ALLOWABLE NUMBER OF OCCUPANTS INDICATED IN TABLE 1006.3.3(2) FOR EACH OCCUPANCY DOES NOT EXCEED ONE. WHERE DWELLING UNITS ARE LOCATED ON A STORY WITH OTHER OCCUPANCIES, THE ACTUAL NUMBER OF DWELLING UNITS DIVIDED BY FOUR PLUS THE RATIO FROM THE OTHER OCCUPANCY DOES NOT EXCEED ONE.

GENERAL MEANS OF EGRESS (SECTION 1003)

CEILING HEIGHT SHALL NOT BE LESS THAN 7 FEET 6 INCHES. EXITS SHALL BE CONTINOUS FROM THE POINT OF ENTRY INTO THE EXIT TO THE EXIT DISCHARGE PER SECTION 1003.6.

MEANS OF EGRESS SIZING (SECTION 1005)

1005.7 ENCROACHMENT. ENCROACHMENTS INTO THE REQUIRED MEANS OF EGRESS WIDTH SHALL BE IN ACCORDANCE WITH THE PROVISIONS OF THIS SECTION. 1005.7.1 DOORS. DOORS, WHEN FULLY OPENED, SHALL NOT REDUCE THE REQUIRED WIDTH BY MORE THAN 7 INCHES (178 MM). DOORS IN ANY POSITION SHALL NOT REDUCE THE REQUIRED WIDTH BY MORE THAN ONE-HALF. EXCEPTIONS:

2. THE RESTRICTIONS ON DOOR SWING SHALL NOT APPLY TO DOORS WITHIN INDIVIDUAL DWELLING UNITS AND SLEEPING UNITS OF GROUP R-2 OCCUPANCIES AND DWELLING UNITS OF GROUP R-3 OCCUPANCIES.

CODE INFORMATION

FIRE PARTITIONS (SECTION 708), CONTINUED

3. FIRE PARTITIONS SERVING AS A CORRIDOR WALL SHALL BE PERMITTED TO TERMINATE AT THE UPPER MEMBRANE OF THE CORRIDOR CEILING ASSEMBLY WHERE THE CORRIDOR CEILING IS CONSTRUCTED AS REQUIRED FOR THE CORRIDOR WALL.

708.4.1 SUPPORTING CONSTRUCTION. THE SUPPORTING CONSTRUCTION FOR A FIRE PARTITION SHALL HAVE A FIRE-RESISTANCE RATING THAT IS EQUAL TO OR GREATER THAN THE REQUIRED FIRE-RESISTANCE RATING OF THE SUPPORTED FIRE PARTITION. EXCEPTION: IN BUILDINGS OF TYPES IIB, IIIB AND VB CONSTRUCTION, THE SUPPORTING CONSTRUCTION REQUIREMENT SHALL NOT APPLY TO FIRE PARTITIONS SEPARATING TENANT SPACES IN COVERED AND OPEN MALL BUILDINGS, FIRE PARTITIONS SEPARATING DWELLING UNITS, FIRE PARTITIONS SEPARATING SLEEPING UNITS AND FIRE PARTITIONS SERVING AS CORRIDOR WALLS. EXCEPTION

IN BUILDINGS OF TYPE IIB, IIIB AND VB CONSTRUCTION, THE SUPPORTING CONSTRUCTION REQUIREMENT SHALL NOT APPLY TO FIRE PARTITIONS SEPARATING TENANT SPACES IN COVERED AND OPEN MALL BUILDINGS, FIRE PARTITIONS SEPARATING DWELLING UNITS, FIRE PARTITIONS SEPARATING SLEEPING UNITS AND FIRE PARTITIONS SERVING AS CORRIDOR WALLS. 708.4.2 FIREBLOCKS AND DRAFTSTOPS IN COMBUSTIBLE CONSTRUCTION. IN COMBUSTIBLE CONSTRUCTION WHERE FIRE PARTITIONS DO NOT EXTEND TO THE UNDERSIDE OF THE FLOOR OR ROOF SHEATHING, DECK OR SLAB ABOVE, THE SPACE ABOVE AND ALONG THE LINE OF THE FIRE PARTITION SHALL BE PROVIDED WITH ONE OF THE FOLLOWING: 1. FIREBLOCKING UP TO THE UNDERSIDE OF THE FLOOR OR ROOF SHEATHING, DECK OR SLAB ABOVE USING MATERIALS COMPLYING WITH SECTION 718.2.1

2. DRAFTSTOPPING UP TO THE UNDERSIDE OF THE FLOOR OR ROOF SHEATHING, DECK OR SLAB ABOVE USING MATERIALS COMPLYING WITH SECTION 718.3.1 FOR FLOORS OR SECTION 718.4.1 FOR ATTICS. EXCEPTIONS:

1. BUILDINGS EQUIPPED WITH AN AUTOMATIC SPRINKLER SYSTEM INSTALLED THROUGHOUT IN ACCORDANCE WITH SECTION 903.3.1.1, OR IN ACCORDANCE WITH SECTION 903.3.1.2 PROVIDED THAT PROTECTION IS PROVIDED IN THE SPACE BETWEEN THE TOP OF THE FIRE PARTITION AND UNDERSIDE OF THE FLOOR OR ROOF SHEATHING, DECK OR SLAB ABOVE AS REQUIRED FOR SYSTEMS COMPLYING WITH SECTION 903.3.1.1. 2. WHERE CORRIDOR WALLS PROVIDE A SLEEPING UNIT OR DWELLING UNIT SEPARATION, DRAFTSTOPPING SHALL ONLY BE REQUIRED ABOVE ONE OF THE CORRIDOR WALLS.

5. IN GROUP R-3 OCCUPANCIES WITH FEWER THAN THREE DWELLING UNITS, FIRE-BLOCKING AND DRAFTSTOPPING SHALL NOT BE REQUIRED IN FLOOR ASSEMBLIES.

FLOOR AND ROOF ASSEMBLIES (SECTION 711)

711.2 HORIZONTAL ASSEMBLIES. HORIZONTAL ASSEMBLIES SHALL COMPLY WITH SECTIONS 711.2.1 THROUGH 711.2.6. 711.2.1 MATERIALS. ASSEMBLIES SHALL BE OF MATERIALS PERMITTED BY THE

BUILDING TYPE OF CONSTRUCTION. 711.2.2 CONTINUITY. ASSEMBLIES SHALL BE CONTINUOUS WITHOUT VERTICAL OPENINGS, EXCEPT AS PERMITTED BY THIS SECTION AND SECTION

712. 711.2.3 SUPPORTING CONSTRUCTION. THE SUPPORTING CONSTRUCTION

OF THE HORIZONTAL ASSEMBLY SUPPORTED EXCEPTION: IN BUILDINGS OF TYPE IIB, IIIB OR VB CONSTRUCTION, THE CONSTRUCTION SUPPORTING THE HORIZONTAL ASSEMBLY IS NOT

REQUIRED TO BE FIRE-RESISTANCE RATED AT THE FOLLOWING: 1. HORIZONTAL ASSEMBLIES AT THE SEPARATIONS OF INCIDENTAL USES AS SPECIFIED BY TABLE 509 PROVIDED THAT THE REQUIRED FIRE-RESISTANCE

RATING DOES NOT EXCEED 1 HOUR. 2. HORIZONTAL ASSEMBLIES AT THE SEPARATIONS OF DWELLING UNITS AND SLEEPING UNITS AS REQUIRED BY SECTION 420.3.

3. HORIZONTAL ASSEMBLIES AT SMOKE BARRIERS CONSTRUCTED IN ACCORDANCE WITH SECTION 709.

HORIZONTAL ASSEMBLIES SHALL COMPLY WITH SECTIONS 711.2.4.1 THROUGH 711.2.4.6 BUT SHALL BE NOT LESS THAN THAT REQUIRED BY THE BUILDING TYPE OF CONSTRUCTION.

711.2.4.1 SEPARATING MIXED OCCUPANCIES. WHERE THE HORIZONTAL ASSEMBLY SEPARATES MIXED OCCUPANCIES, THE ASSEMBLY SHALL HAVE A FIRE-RESISTANCE RATING OF NOT LESS THAN THAT REQUIRED BY SECTION 508.4 BASED ON THE OCCUPANCIES BEING SEPARATED.

711.2.4.3 DWELLING UNITS AND SLEEPING UNITS. HORIZONTAL ASSEMBLIES SERVING AS DWELLING OR SLEEPING UNIT SEPARATIONS IN ACCORDANCE WITH SECTION 420.3 SHALL BE NOT LESS THAN 1-HOUR FIRE-RESISTANCE-RATED CONSTRUCTION.

EXCEPTION: HORIZONTAL ASSEMBLIES SEPARATING DWELLING UNITS AND SLEEPING UNITS SHALL BE NOT LESS THAN 1/2-HOUR FIRE-RESISTANCE-RATED CONSTRUCTION IN A BUILDING OF TYPES IIB, IIIB AND VB CONSTRUCTION, WHERE THE BUILDING IS EQUIPPED THROUGHOUT WITH AN AUTOMATIC SPRINKLER SYSTEM IN ACCORDANCE WITH SECTION 903.3.1.1.

711.2.6 UNUSABLE SPACE. IN 1-HOUR FIRE-RESISTANCE-RATED FLOOR/CEILING ASSEMBLIES, THE CEILING MEMBRANE IS NOT REQUIRED TO BE INSTALLED OVER UNUSABLE CRAWL SPACES. IN 1-HOUR FIRE-RESISTANCE-RATED ROOF ASSEMBLIES, THE FLOOR MEMBRANE IS NOT REQUIRED TO BE INSTALLED WHERE UNUSABLE ATTIC SPACE OCCURS ABOVE.

SHAFT ENCLOSURES (SECTION 713)

713.2 CONSTRUCTION. SHAFT ENCLOSURES SHALL BE CONSTRUCTED AS FIRE BARRIERS IN ACCORDANCE WITH SECTION 707 OR HORIZONTAL ASSEMBLIES IN ACCORDANCE WITH SECTION 711, OR BOTH. 713.4 FIRE-RESISTANCE RATING. SHAFT ENCLOSURES SHALL HAVE A FIRE-

RESISTANCE RATING OF NOT LESS THAN 2 HOURS WHERE CONNECTING FOUR STORIES OR MORE, AND NOT LESS THAN 1 HOUR WHERE CONNECTING LESS THAN FOUR STORIES. THE NUMBER OF STORIES CONNECTED BY THE SHAFT ENCLOSURE SHALL INCLUDE ANY BASEMENTS BUT NOT ANY MEZZANINES. SHAFT ENCLOSURES SHALL HAVE A FIRE-RESISTANCE RATING NOT LESS THAN THE FLOOR ASSEMBLY PENETRATED, BUT NEED NOT EXCEED 2 HOURS. SHAFT ENCLOSURES SHALL MEET THE **REQUIREMENTS OF SECTION 703.2.1.**

713.5 CONTINUITY. SHAFT ENCLOSURES SHALL BE CONSTRUCTED AS FIRE BARRIERS IN ACCORDANCE WITH SECTION 707 OR HORIZONTAL ASSEMBLIES CONSTRUCTED IN ACCORDANCE WITH SECTION 711, OR BOTH, AND SHALL HAVE CONTINUITY IN ACCORDANCE WITHSECTION 707.5 FOR FIRE BARRIERS OR SECTION 711.2.2 FOR HORIZONTAL ASSEMBLIES, AS APPLICABLE 713.7 OPENINGS. OPENINGS IN A SHAFT ENCLOSURE SHALL BE PROTECTED IN ACCORDANCE WITH SECTION 716 AS REQUIRED FOR FIRE BARRIERS.

DOORS SHALL BE SELF- OR AUTOMATIC-CLOSING BY SMOKE DETECTION IN ACCORDANCE WITH SECTION 716.2.6.6. 713.7.1 PROHIBITED OPENINGS. OPENINGS OTHER THAN THOSE NECESSARY

FOR THE PURPOSE OF THE SHAFT SHALL NOT BE PERMITTED IN SHAFT ENCLOSURES.

5.2. THE ROOF IS PROTECTED WITH 0.625-INCH (16 MM) TYPE X GYPSUM BOARD DIRECTLY BENEATH THE UNDERSIDE OF THE ROOF SHEATHING OR DECK, SUPPORTED BY NOT LESS THAN NOMINAL 2-INCH (51 MM) LEDGERS ATTACHED TO THE SIDES OF THE ROOF FRAMING MEMBERS FOR A MINIMUM DISTANCE OF 4 FEET (1220 MM) 6. WHERE THE WALL IS PERMITTED TO HAVE NOT LESS THAN 25 PERCENT OF THE EXTERIOR WALL AREAS CONTAINING UNPROTECTED OPENINGS BASED ON FIRE SEPARATION DISTANCE AS DETERMINED IN ACCORDANCE WITH SECTION 705.8. [= FSD OF 5' OR GREATER IN A SPRINKLERED BUILDING] 705.11.1 PARAPET CONSTRUCTION. PARAPETS SHALL HAVE THE SAME FIRE-RESISTANCE RATING AS THAT REQUIRED FOR THE SUPPORTING WALL, AND ON ANY SIDE ADJACENT TO A ROOF SURFACE, SHALL HAVE

CODE INFORMATION

FIRE-RESISTANCE RATING OF STRUCTURAL MEMBERS (SECTION 704) 704.4.1 LIGHT-FRAME CONSTRUCTION. STUDS, COLUMNS AND BOUNDARY ELEMENTS THAT ARE INTEGRAL ELEMENTS INWALLS OF LIGHT-FRAME CONSTRUCTION AND ARE LOCATED ENTIRELY BETWEEN THE TOP AND BOTTOM PLATES OR TRACKS SHALL BE PERMITTED TO HAVE REQUIRED FIRE-RESISTANCE RATINGS PROVIDED BY THE MEMBRANE PROTECTION PROVIDED FOR THE WALL.

EXTERIOR WALLS (SECTION 705)

705.11 PARAPETS. PARAPETS SHALL BE PROVIDED ON EXTERIOR WALLS OF BUILDINGS. EXCEPTIONS: A PARAPET NEED NOT BE PROVIDED ON AN EXTERIOR WALL

WHERE ANY OF THE FOLLOWING CONDITIONS EXIST: 5. IN GROUPS R-2 AND R-3 WHERE THE ENTIRE BUILDING IS PROVIDED

WITH A CLASS C ROOF COVERING, THE EXTERIOR WALL SHALL BE PERMITTED TO TERMINATE AT THE UNDERSIDE OF THE ROOF SHEATHING OR DECK IN TYPES III, IV AND V CONSTRUCTION, PROVIDED THAT ONE OR BOTH OF THE FOLLOWING CRITERIA IS MET:

5.1. THE ROOF SHEATHING OR DECK IS CONSTRUCTED OF APPROVED NONCOMBUSTIBLE MATERIALS OR OF FIRE-RETARDANT TREATED WOOD FOR A DISTANCE OF 4 FEET (1220 MM).

NONCOMBUSTIBLE FACES FOR THE UPPERMOST 18 INCHES (457 MM), INCLUDING COUNTERFLASHING AND COPING MATERIALS. THE HEIGHT OF THE PARAPET SHALL BE NOT LESS THAN 30 INCHES (762 MM) ABOVE THE POINT WHERE THE ROOF SURFACE AND THE WALL INTERSECT. WHERE THE ROOF SLOPES TOWARD A PARAPET AT A SLOPE GREATER THAN TWO UNITS VERTICAL IN 12 UNITS HORIZONTAL (16.7-PERCENT SLOPE), THE PARAPET SHALL EXTEND TO THE SAME HEIGHT AS ANY PORTION OF THE ROOF WITHIN A FIRE SEPARATION DISTANCE WHERE PROTECTION OF WALL OPENINGS IS REQUIRED, BUT THE HEIGHT SHALL BE NOT LESS THAN 30

INCHES (762 MM). FIRE BARRIERS (SECTION 707)

707.3 FIRE-RESISTANCE RATING. THE FIRE-RESISTANCE RATING OF FIRE BARRIERS SHALL COMPLY WITH THIS SECTION.

707.3.1 SHAFT ENCLOSURES. THE FIRE-RESISTANCE RATING OF THE FIRE BARRIER SEPARATING BUILDING AREAS FROM A SHAFT SHALL COMPLY WITH SECTION 713.4.

707.3.2 INTERIOR EXIT STAIRWAY AND RAMP CONSTRUCTION. THE FIRE-RESISTANCE RATING OF THE FIRE BARRIER SEPARATING BUILDING AREAS FROM AN INTERIOR EXIT STAIRWAY OR RAMP SHALL COMPLY WITH SECTION 1023.1. 707.3.3 ENCLOSURES FOR EXIT ACCESS STAIRWAYS. THE FIRE-RESISTANCE RATING OF THE FIRE BARRIER SEPARATING BUILDING AREAS FROM AN EXIT ACCESS STAIRWAY OR RAMP SHALL COMPLY WITH SECTION 713.4.

707.3.4 EXIT PASSAGEWAY. THE FIRE-RESISTANCE RATING OF THE FIRE BARRIER SEPARATING BUILDING AREAS FROM AN EXIT PASSAGEWAY SHALL COMPLY WITH SECTION 1024.3.

707.3.9 SEPARATED OCCUPANCIES. WHERE THE PROVISIONS OF SECTION 508.4 ARE APPLICABLE, THE FIRE BARRIER SEPARATING MIXED OCCUPANCIES SHALL HAVE A FIRE RESISTANCE RATING OF NOT LESS THAN THAT INDICATED IN TABLE 508.4 BASED ON THE OCCUPANCIES BEING SEPARATED. 707.5 CONTINUITY. FIRE BARRIERS SHALL EXTEND FROM THE TOP OF THE FOUNDATION OR FLOOR/CEILING ASSEMBLY BELOW TO THE UNDERSIDE OF THE FLOOR OR ROOF SHEATHING, SLAB OR DECK ABOVE AND SHALL BE SECURELY ATTACHED THERETO. SUCH FIRE BARRIERS SHALL BE CONTINUOUS THROUGH CONCEALED SPACE, SUCH AS THE SPACE ABOVE A SUSPENDED CEILING. JOINTS AND VOIDS AT INTERSECTIONS SHALL COMPLY WITH SECTIONS 707.8 AND 707.9

EXCEPTIONS:

1. SHAFT ENCLOSURES SHALL BE PERMITTED TO TERMINATE AT A TOP ENCLOSURE COMPLYING WITH SECTION 713.12. 2. INTERIOR EXIT STAIRWAY AND RAMP ENCLOSURES REQUIRED BY SECTION 1023 AND EXIT ACCESS STAIRWAY AND RAMP ENCLOSURES REQUIRED BY SECTION 1019 SHALL BE PERMITTED TO TERMINATE AT A TOP ENCLOSURE COMPLYING WITH SECTION 713.12.

707.5.1 SUPPORTING CONSTRUCTION. THE SUPPORTING CONSTRUCTION FOR A FIRE BARRIER SHALL BE PROTECTED TO AFFORD THE REQUIRED FIRE-RESISTANCE RATING OF THE FIRE BARRIER SUPPORTED. HOLLOW VERTICAL SPACES WITHIN A FIRE BARRIER SHALL BE FIRE BLOCKED IN ACCORDANCE WITH SECTION 718.2 AT EVERY FLOOR LEVEL. EXCEPTIONS:

2. SUPPORTING CONSTRUCTION FOR 1-HOUR FIRE BARRIERS REQUIRED BY TABLE 509 IN BUILDINGS OF TYPES IIB, IIIB AND VB CONSTRUCTION IS NOT REQUIRED TO BE FIRE-RESISTANCE RATED UNLESS REQUIRED BY OTHER SECTIONS OF THIS CODE.

FIRE PARTITIONS (SECTION 708)

708.3 FIRE-RESISTANCE RATING. FIRE PARTITIONS SHALL HAVE A FIRE-RESISTANCE RATING OF NOT LESS THAN 1 HOUR. EXCEPTIONS:

1. CORRIDOR WALLS PERMITTED TO HAVE A 1/2-HOUR FIRE-RESISTANCE RATING BY TABLE 1020.1

2. DWELLING UNIT AND SLEEPING UNIT SEPARATIONS IN BUILDINGS OF TYPES IIB, IIIB AND VB CONSTRUCTION SHALL HAVE FIRE RESISTANCE RATINGS OF NOT LESS THAN 1/2-HOUR IN BUILDINGS EQUIPPED THROUGHOUT WITH AN AUTOMATIC SPRINKLER SYSTEM IN ACCORDANCE WITH SECTION 903.3.1.1.

708.4 CONTINUITY. FIRE PARTITIONS SHALL EXTEND FROM THE TOP OF THE FOUNDATION OR FLOOR/CEILING ASSEMBLY BELOW AND BE SECURELY ATTACHED TO ONE OF THE FOLLOWING:

1. THE UNDERSIDE OF THE FLOOR OR ROOF SHEATHING, DECK OR SLAB ABOVE.

2. THE UNDERSIDE OF A FLOOR/CEILING OR ROOF/CEILING ASSEMBLY HAVING A FIRE-RESISTANCE RATING THAT IS NOT LESS THAN THE FIRE-RESISTANCE RATING OF THE FIRE PARTITION. **EXCEPTIONS:**

1. FIRE PARTITIONS SHALL NOT BE REQUIRED TO EXTEND INTO A CRAWL SPACE BELOW WHERE THE FLOOR ABOVE THE CRAWL SPACE HAS A MINIMUM 1-HOUR FIRE-RESISTANCE RATING.

2. FIRE PARTITIONS SERVING AS A CORRIDOR WALL SHALL NOT BE REQUIRED TO EXTEND ABOVE THE LOWER MEMBRANE OF A CORRIDOR CEILING PROVIDED THAT THE CORRIDOR CEILING MEMBRANE IS EQUIVALENT TO CORRIDOR WALL MEMBRANE, AND EITHER OF THE FOLLOWING CONDITIONS IS MET:

2.1. THE ROOM-SIDE MEMBRANE OF THE CORRIDOR WALL EXTENDS TO THE UNDERSIDE OF THE FLOOR OR ROOF SHEATHING, DECK OR SLAB OF A FIRE-RESISTANCE-RATED FLOOR OR ROOF ABOVE.

2.2. THE BUILDING IS EQUIPPED WITH AN AUTOMATIC SPRINKLER SYSTEM INSTALLED THROUGHOUT IN ACCORDANCE WITH SECTION 903.3.1.1 OR 903.3.1.2, INCLUDING AUTOMATIC SPRINKLERS INSTALLED IN THE SPACE BETWEEN THE TOP OF THE FIRE PARTITION AND UNDERSIDE OF THE FLOOR OR ROOF SHEATHING, DECK OR SLAB ABOVE.

CODE INFORMATION

CITY OF KETCHUM CODE AMENDMENTS

COMBUSTIBLE MATERIALS ON THE EXTERIOR SIDE OF EXTERIOR WALLS (SECTION 1405, CITY OF KETCHUM CODE AMENDMENT) SECTION 1405.1 IS AMENDED AS FOLLOWS BY ADDING THE FOLLOWING SENTENCE: ALL MATERIALS WITHIN 12" VERTICAL OF FINISHED GRADE SHALL BE 1 HOUR RATED, NONCOMBUSTIBLE, OR COVERED WITH MINIMUM 28 GAUGE FLASHING. THE AREA 12" HORIZONTAL FROM THE BASE OF A WALL SHALL BE FINISHED IN A WAY TO PREVENT ANY VEGETATION GROWING, AND FOR VEGETATIVE DEBRIS TO BE EASILY REMOVED.

ROOFING FIRE CLASSIFICATION (SECTION 1505, CITY OF KETCHUM CODE AMENDMENT)

SECTION 1505.1 IS AMENDED AS FOLLOWS: 1505.2 CLASS A ROOFING REQUIRED. CLASS A ROOF ASSEMBLIES WITH NO WOOD PRODUCTS IN THE ROOF COVERING ARE REQUIRED ON ALL NEW BUILDINGS. CLASS A ROOF ASSEMBLIES WITH NO WOOD PRODUCTS IN ROOF COVERING ARE REQUIRED FOR ALL RE-ROOFS OVER 3,000 SQUARE FEET OF ROOF AREA. CLASS A IS NOT REQUIRED WHEN LESS THAN TWENTY-FIVE (25) PERCENT OF

THE ROOF AREA IS BEING REPAIRED AND ADDITIONAL AREAS ARE NOT SUBSEQUENTLY REPAIRED WITHIN FIVE (5) YEARS. ADDITIONS TO BUILDINGS OVER 1,000 SQUARE FEET OF ROOF AREA REQUIRE THAT THE ROOF OF THE ENTIRE BUILDING BE UPGRADED TO A CLASS A ROOF ASSEMBLY WITH NO WOOD PRODUCTS IN THE ROOF COVERING SECTION 1513 IS ADDED: 1513 SNOW RETENTION DEVICES. THESE DEVICES

ARE PERMANENTLY ATTACHED TO THE ROOFING ASSEMBLY AND SHALL BE PLACED ON THE ROOF ABOVE, INCLUDING BUT NOT LIMITED TO, SKYLIGHTS, SUN ROOMS, GREENHOUSES, AND PEDESTRIAN AREAS, TO LIMIT THE POTENTIAL FOR SLIDING SNOW OR ICE ONTO PEDESTRIAN AREAS BELOW SAID ROOF AREAS FOR ALL OCCUPANCIES. MINIMUM DESIGN SHALL BE EQUAL TO THE DESIGN ROOF SNOW LOAD OF 100 POUNDS PER SQUARE FOOT.

2018 INTERNATIONAL BUILDING CODE (IBC) REFERENCES MOTOR-VEHICLE-RELATED OCCUPANCIES (SECTION 406)

406.2.1 AUTOMATIC GARAGE DOOR OPENERS AND VEHICULAR GATES AUTOMATIC GARAGE DOOR OPENERS SHALL BE LISTED AND LABELED IN ACCORDANCE WITH UL 325. WHERE PROVIDED, AUTOMATIC VEHICULAR GATES SHALL COMPLY WITH SECTION 3110.

406.2.2 CLEAR HEIGHT. THE CLEAR HEIGHT OF EACH FLOOR LEVEL IN VEHICLE AND PEDESTRIAN TRAFFIC AREAS SHALL BE NOT LESS THAN 7 FEET (2134 MM). CANOPIES UNDER WHICH FUELS ARE DISPENSED SHALL HAVE A CLEAR HEIGHT IN ACCORDANCE WITH SECTION 406.7.2.

406.2.3 ACCESSIBLE PARKING SPACES. WHERE PARKING IS PROVIDED, ACCESSIBLE PARKING SPACES, ACCESS AISLES AND VEHICULAR ROUTES SERVING ACCESSIBLE PARKING SHALL BE PROVIDED IN ACCORDANCE WITH SECTION 1106.

406.2.7 ELECTRIC VEHICLE CHARGING STATIONS. WHERE PROVIDED, ELECTRIC VEHICLE CHARGING STATIONS SHALL BE INSTALLED IN ACCORDANCE WITH NFPA 70. ELECTRIC VEHICLE CHARGING SYSTEM EQUIPMENT SHALL BE LISTED AND LABELED IN ACCORDANCE WITH UL 2202. ELECTRIC VEHICLE SUPPLY EQUIPMENT SHALL BE LISTED AND LABELED IN ACCORDANCE WITH UL 2594. ACCESSIBILITY TO ELECTRIC VEHICLE CHARGING STATIONS SHALL BE PROVIDED IN ACCORDANCE WITH CHAPTER 11

406.3.1 CLASSIFICATION: PRIVATE GARAGES AND CARPORTS SHALL BE CLASSIFIED AS GROUP U OCCUPANCIES. EACH PRIVATE GARAGE SHALL BE NOT GREATER THAN 1,000 SQUARE FEET (93 M) IN AREA. MULTIPLE PRIVATE GARAGES ARE PERMITTED IN A BUILDING WHERE EACH PRIVATE GARAGE IS SEPARATED FROM THE OTHER PRIVATE GARAGES BY 1-HOUR FIRE BARRIERS IN ACCORDANCE WITH SECTION 707, OR 1-HOUR HORIZONTAL ASSEMBLIES IN ACCORDANCE WITH SECTION 711, OR BOTH.

*406.3.2 SEPARATION: FOR OTHER THAN PRIVATE GARAGES ADJACENT TO DWELLING UNITS, THE SEPARATION OF PRIVATE GARAGES FROM OTHER OCCUPANCIES SHALL COMPLY WITH SECTION 508. SEPARATION OF PRIVATE GARAGES FROM DWELLING UNITS SHALL COMPLY WITH SECTIONS 406.3.2.1 AND 406.3.2.2.

406.3.2.1 DWELLING UNIT SEPARATION: THE PRIVATE GARAGE SHALL BE separated from the dwelling unit and its attic area by means o GYPSUM BOARD, NOT LESS THAN 1/2-INCH IN THICKNESS, APPLIED TO THE GARAGE SIDE. GARAGES BENEATH HABITABLE ROOMS SHALL BE SEPARATED FROM ALL HABITABLE ROOMS ABOVE BY NOT LESS THAN 5/8-INCH TYPE X GYPSUM BOARD OR EQUIVALENT AND 1/2-INCH GYPSUM BOARD APPLIED TO STRUCTURES SUPPORTING THE SEPARATION FROM HABITABLE ROOMS ABOVE THE GARAGE. DOOR OPENINGS BETWEEN A PRIVATE GARAGE AND THE DWELLING UNIT SHALL BE EQUIPPED WITH EITHER SOLID WOOD DOORS OR SOLID OR HONEYCOMB CORE STEEL DOORS NOT LESS THAN 1 3/8-INCHES IN THICKNESS, OR DOORS IN COPMLIANCE WITH SECTION 716.2.2.1 WITH A FIRE PROTECTION RATING OF NOT LESS THAN 20 MINUTES. DOORS SHALL BE SELF-CLOSING AND SELF-LATCHING.

GROUPS I-1, R-1, R-2, R-3 AND R-4 (SECTION 420)

420.2 SEPARATION WALLS. WALLS SEPARATING DWELLING UNITS IN THE SAME BUILDING, WALLS SEPARATING SLEEPING UNITS IN THE SAME BUILDING AND WALLS SEPARATING DWELLING OR SLEEPING UNITS FROM OTHER OCCUPANCIES CONTIGUOUS TO THEM IN THE SAME BUILDING SHALL BE CONSTRUCTED AS FIRE PARTITIONS IN ACCORDANCE WITH SECTION 708. 420.3 HORIZONTAL SEPARATION. FLOOR ASSEMBLIES SEPARATING DWELLING UNITS IN THE SAME BUILDINGS, FLOOR ASSEMBLIES SEPARATING SLEEPING UNITS IN THE SAME BUILDING AND FLOOR ASSEMBLIES SEPARATING DWELLING OR SLEEPING UNITS FROM OTHER OCCUPANCIES CONTIGUOUS TO THEM IN THE SAME BUILDING SHALL BE CONSTRUCTED AS HORIZONTAL ASSEMBLIES IN ACCORDANCE WITH SECTION 711.

EXCEPTION: IN GROUP R-3 AND R-4 FACILITIES, FLOOR ASSEMBLIES WITHIN THE DWELLING UNITS OR SLEEPING UNITS ARE NOT REQUIRED TO BE CONSTRUCTED AS HORIZONTAL ASSEMBLIES.

[F] 420.4 AUTOMATIC SPRINKLER SYSTEM. GROUP R OCCUPANCIES SHALL BE EQUIPPED THROUGHOUT WITH AN AUTOMATIC SPRINKLER SYSTEM IN ACCORDANCE WITH SECTION 903.2.8. QUICK-RESPONSE OR RESIDENTIAL AUTOMATIC SPRINKLERS SHALL BE INSTALLED IN ACCORDANCE WITH SECTION 903.3.2.

[F] 420.5 FIRE ALARM SYSTEMS AND SMOKE ALARMS. FIRE ALARM SYSTEMS AND SMOKE ALARMS SHALL BE PROVIDED IN GROUP I-1, R-1 AND R-2 OCCUPANCIES IN ACCORDANCE WITH SECTIONS 907.2.6, 907.2.8 AND 907.2.9, RESPECTIVELY. SINGLE- OR MULTIPLE-STATION SMOKE ALARMS SHALL BE PROVIDED IN GROUPS I-1, R-2, R-3 AND R-4 IN ACCORDANCE WITH SECTION 907.2.10

420.9 GROUP R COOKING FACILITIES. IN GROUP R OCCUPANCIES, COOKING APPLIANCES USED FOR DOMESTIC COOKING OPERATIONS SHALL BE IN ACCORDANCE WITH SECTION 917.2 OF THE INTERNATIONAL MECHANICAL CODE.

CODE INFORMATION

SPRINKLER SYSTEM:	NFPA 13
	THE BU

ALLOWABLE BUILDING AREA TABLE 506.2 ALLOWABLE AREA FACTOR: R-3, SM (BUILDINGS TWO OR MORE STORIES SPRINKLERED IN ACCORDANCE WITH 903.3.1.1, TYPE V-B = <u>UNLIMITED</u> B, SM (BUILDINGS TWO OR MORE STORIES SPRINKLERED IN ACCORDANCE WITH 903.3.1.1), TYPE V-B = <u>27,000 SF</u> U, SM (BUILDINGS TWO OR MORE STORIES SPRINKLERED IN ACCORDANCE WITH 903.3.1.1), TYPE V-B = <u>16,500 SF</u>	CODES REFERENCED:	 2018 INTERNATIONAL BUILDING CODE (IBC) 2018 INTERNATIONAL EXISTING BUILDING CODE (IEBC) 2018 INTERNATIONAL ENERGY CONSERVATION CODE (IECC) 2017 ICC 400 (STANDARDS ON THE DESIGN AND CONSTRUCTION OF LOG STRUCTURES)
*FRONTAGE AND SPRINKLER INCREASES NOT CALC'D DUE TO AREA CONFORMANCE WITHOUT AREA MODIFICATIONS	JURISDICTIONS:	CITY OF KETCHUM PLANNING & BUILDING DEPARTMENTS CITY OF KETCHUM FIRE DEPARTMENT
OCCUPANT LOAD: TABLE 1004.5 MAXIMUM FLOOR AREA ALLOWANCES PER OCCUPANT ACCESSORY STORAGE AREAS, MECHANICAL EQUIPMENT ROOM: 300 GROSS BUSINESS AREAS OCCUPANT LOAD FACTOR: 150 GROSS RESIDENTIAL OCCUPANT LOAD FACTOR: 200 GROSS PARKING GARAGES OCCUPANT LOAD FACTOR: 200 GROSS	<u>CITY OF KETCHUM PRO</u> <u>BUILDING AREA</u> :	DJECT INFORMATION FIRST FLOOR EXISTING (OFFICE): 742 S.F. NEW (OFFICE) 86 S.F. NEW COMMON SPACE: 442 S.F.
FIRST FLOOR: OFFICE (B): 848 / 150 = 5.65 COMMON HALL (B): 442 / 150 = 2.95 PRIVATE GARAGES (U): (774+490) / 200 = 6.32 UNIT 1 RESIDENTIAL (R-3): 750 / 200 = 3.75 UNIT 0 RESIDENTIAL (R-3): 1750 / 200 = 0.075		NEW COMMON PARKING: 774 S.F. NEW UNIT 1 LIVING: 750 S.F. NEW UNIT 2 GARAGE: 510 S.F. NEW UNIT 2 LIVING: 175 S.F. SUB-TOTAL: 3,479 S.F.
$\frac{\text{UNIT 2 RESIDENTIAL (R-3): 175 / 200 = 0.875}}{\text{TOTAL FIRST FLOOR OCCUPANT LOAD: 19.545 = 20}$ SECOND FLOOR: $\frac{\text{UNIT 2 RESIDENTIAL (R-3): 1,951 / 200 = 9.755}}{\text{TOTAL SECOND FLOOR OCCUPANT LOAD: 9.755 = 10}}$		SUB-TOTAL TOWARDS F.A.R.: THREE PARKING STALLS FOR DEVELOPMENTS ON SINGLE KETCHUM TOWN SITE LOTS OF 5,600 S.F. IN SIZE OR LESS ARE NOT INCLUDED IN THE GROSS FLOOR AREA CALCULATION $[3,479$ S.F $(3 \times (9 \times 18)) = 2,993$ S.F.]
THIRD FLOOR: UNIT 2 RESIDENTIAL (R-3): 38 / 200 = 0.19 <u>MECHANICAL: 377 / 300 = 1.26</u> TOTAL THIRD FLOOR OCCUPANT LOAD: 1.45 = 2		SECOND FLOORUNIT 2 LIVING:1,944 S.F.TERRACE:710 S.F.
TOTAL 'B' OCCUPANT LOAD:9TOTAL UNIT 1 'R-3' OCCUPANT LOAD:4TOTAL UNIT 2 'R-3' OCCUPANT LOAD:12TOTAL PRIVATE GARAGE 'U' OCC LOAD:7		THIRD FLOORUNIT 2 LIVING:46 S.F.COMMON MECHANICAL:377 S.F.TERRACE:792 S.F.
TOTAL BUILDING OCCUPANT LOAD:32TYPE OF CONSTRUCTION:V-B		TOTAL REMODEL (EXISTING CABIN):742 S.F.TOTAL NEW:5,104 S.F.
SPRINKLER SYSTEM: NFPA 13 SPRINKLER SYSTEM THROUGHOUT THE BUILDING PER 903.3.1.1		TOTAL G.S.F. (INCLUDING GARAGES): 5,846 S.F. TOTAL TOWARDS F.A.R.: 5,360 S.F. [5,360 / 5,505 = 0.97 F.A.R.]
BUILDING AREA AND HEIGHT (TABLE 503): <u>FIRE RESISTANCE RATING REQUIREMENTS FOR BUILDING ELEMENTS</u> TABLE 601, BASED ON TYPE V-B CONSTRUCTION:		3,559 S.F. (OR 64.7% OF LOT AREA)
PRIMARY STRUCTURAL FRAME:0-HOURINTERIOR / EXTERIOR BEARING WALLS:0-HOUREXTERIOR NONBEARING WALLS AND PARTITIONS:SEE TABLE 602INTERIOR NONBEARING WALLS AND PARTITIONS:0-HOURFLOOR CONSTRUCTION AND ASSOCIATED MEMBERS:0-HOUR	<u>Site Area</u> : <u>Parking rqmts</u> :	0.126 ACRES (5,505 S.F.) UNIT 1 (750 S.F. OR LESS): 0 SPACES UNIT 2 (2,001 S.F. AND ABOVE): 2 SPACES OFFICE (1 SPACE PER 1,000 G.S.F.): 1 SPACE
ROOF CONSTRUCTION AND ASSOCIATED MEMBERS: 0-HOUR FIRE RESISTANCE RATINGS FOR EXTERIOR WALLS BASED ON FIRE SEPARATION	ZONING:	CC, SD 2 (COMMUNITY CORE, SUBDISTRICT 2: MIXED USE)
<u>DISTANCE</u> TABLE 602, BASED ON TYPE V-B CONSTRUCTION AND OCCUPANCIES R-3, B, AND U:	<u>SETBACKS</u> :	FRONT AND STREET SIDE: 5' AVERAGE INTERIOR SIDE: 0' ADJACENT TO ALLEYWAY: 3'
NORTHEASTSOUTHWESTLESS THAN 5 FTN/AN/A1-HOURN/A5 TO 10 FEETN/AN/AN/AN/A	MAX BUILDING HEIGHT	<u>-</u> : 42'
10 TO 30 FEETN/A0-HOUR0-HOURN/A30 FEET PLUS0-HOUR0-HOUR0-HOUR0-HOUR		BUILDING CODE (IBC) PROJECT INFORMATION
*NOTE 'i' FOR OCCUPANCY GROUP R: FOR A GROUP R-3 BUILDING OF TYPE VB CONSTRUCTION, THE EXTERIOR WALL SHALL NOT BE REQUIRED TO HAVE A FIRE-RESISTANCE RATING WHERE THE FIRE SEPARATION DISTANCE IS 5 FEET OR GREATER. EXTERIOR WALLS (SECTION 705) <u>705.5 FIRE-RESISTANCE RATINGS</u> . EXTERIOR WALLS SHALL BE FIRE-RESISTANCE	<u>OCCUPANCY</u> :	OFFICE: BUSINESS GROUP B (IBC 304.1), (2) RESIDENTIAL DWELLING UNITS: RESIDENTIAL GROUP R-3 (IBC 310.4), (2) PRIVATE GARAGES: UTILITY AND MISCELLANEOUS GROUP U (IBC 312), COMMON AREA HALL: MIXED USE, BUSINESS GRP B *BUILDING WILL NOT BE CONDOMINIUMIZED, OCCUPANCIES ARE TO BE SEPARATED PER CODE.
RATED IN ACCORDANCE WITH TABLES 601 AND 602 AND THIS SECTION. THE REQUIRED FIRE-RESISTANCE RATING OF EXTERIOR WALLS WITH A FIRE SEPARATION DISTANCE OF GREATER THAN 10 FEET (3048 MM) SHALL BE RATED FOR EXPOSURE TO FIRE FROM THE INSIDE. THE REQUIRED FIRE- RESISTANCE RATING OF EXTERIOR WALLS WITH A FIRE SEPARATION DISTANCE OF LESS THAN OR EQUAL TO 10 FEET (3048 MM) SHALL BE RATED FOR	EXISTING OCCUPANCY	<u>(OF CABIN</u> : RESTAURANT GROUP A-2 (SECTION 303) [TO CHANGE TO BUSINESS GROUP B WITH APPROVAL OF CODE OFFICIAL]
EXPOSURE TO FIRE FROM BOTH SIDES. TABLE 705.8: MAXIMUM AREA OF EXTERIOR WALL OPENINGS BASED ON FIRE	SPRINKLER SYSTEM:	NFPA 13 SPRINKLER SYSTEM THROUGHOUT THE BUILDING PER 903.3.1.1
SEPARATION DISTANCE AND DEGREE OF OPENING PROTECTION <u>SOUTH ELEVATION AT INTERIOR PROPERTY LINE</u> : EXTERIOR WALLS WITH A FIRE SEPARATION OF 0' TO LESS THAN 3' SHALL NOT BE PERMITTED TO HAVE OPENINGS. <u>SOUTH ELEVATION AT OFFICE ENTRY</u> : EXTERIOR WALLS WITH A FIRE SEPARATION OF 05 TO LESS THAN 20 HAVE NO HAVE OF EXTERIOR WALLS	FIRST FLOOR: SECOND FLOC <u>THIRD FLOOR:</u>	537 SF
SEPARATION OF 25' TO LESS THAN 30' HAVE NO LIMIT OF EXTERIOR WALL OPENINGS WHEN UNPROTECTED AND SPRINKLERED. EAST ELEVATION* (20' ALLEY ROW WIDTH + 3' ALLEY SETBACK = 13' MINIMUM SEPARATION DISTANCE TO CENTERLINE OF ALLEY): EXTERIOR WALLS WITH A FIRE SEPARATION OF 10' TO LESS 15' SHALL HAVE WALL		6,066 SF <u>HEIGHT</u> SLE BUILDING HEIGHT IN FEET ABOVE GRADE PLANE: ED IN ACCORDANCE WITH 903.3.1.1,
OPENINGS LIMITED TO 45% WHEN UNPROTECTED AND SPRINKLERED. <u>NORTH ELEVATION* (60' ROW WIDTH = 30' MINIMUM SEPARATION</u> <u>DISTANCE TO CENTERLINE OF ROW) AND WEST ELEVATION* (100' ROW</u> <u>WIDTH = 50' MINIMUM SEPARATION DISTANCE TO CENTERLINE OF ROW</u>): EXTERIOR WALLS WITH A FIRE SEPARATION OF 30' OR GREATER HAVE NO	B, SPRINKLERED TYPE V U, SPRINKLERED	F-B = 60 FEET D IN ACCORDANCE WITH 903.3.1.1, F-B = 60 FEET D IN ACCORDANCE WITH 903.3.1.1, F-B = 60 FEET
LIMIT OF EXTERIOR WALL OPENINGS. * <u>NOTE 'f</u> : THE AREA OF UNPROTECTED AND PROTECTED OPENINGS SHALL NOT BE LIMITED FOR GROUP R-3 OCCUPANCIES, WITH A FIRE SEPARATION DISTANCE OF 5 FEET OR GREATER.	TABLE 504.4 ALLOWAB R-3, SPRINKLER TYPE V B, SPRINKLEREE	BLE NUMBER OF STORIES ABOVE GRADE PLANE: ED IN ACCORDANCE WITH 903.3.1.1, -B = 4 STORIES D IN ACCORDANCE WITH 903.3.1.1,
MIXED USE AND OCCUPANCY (SECTION 508) TABLE 508.4 REQUIRED SEPARATION OF OCCUPANCIES OCCUPANCY 'R' TO OCCUPANCY 'B' (SPRINKLERED): 1-HR	U, SPRINKLEREI TYPE V	F-B = 3 STORIES D IN ACCORDANCE WITH 903.3.1.1, F-B = 2 STORIES NCY. IN A BUILDING CONTAINING MIXED
OCCUPANCY 'R' TO OCCUPANCY 'U' (SPRINKLERED): 1-HR* *SEE 406.3.2 RE: PRIVATE GARAGES 508.2.4 SEPARATION OF OCCUPANCIES EXCEPTION 2: GROUP I-1, R-1, R-2, AND R-3 DWELLING UNITS AND SLEEPING	OCCUPANCIES IN ACC	CORDANCE WITH SECTION 508, NO INDIVIDUAL CORDANCE WITH SECTION 508, NO INDIVIDUAL CEED THE HEIGHT AND NUMBER OF STORY LIMITS TION FOR THE APPLICABLE OCCUPANCIES.
UNITS SHALL BE SEPARATED FROM OTHER DWELLING OR SLEEPING UNITS AND FROM ACCESSORY OCCUPANCIES CONTIGUOUS TO THEM IN ACCORDANCE WITH THE REQUIREMENTS OF SECTION 420.	ALLOWABLE BUILDING TABLE 506.2 ALLOWAB R-3 SM (BUILD	
508.4.4 SEPARATION. INDIVIDUAL OCCUPANCIES SHALL BE SEPARATED FROM ADJACENT OCCUPANCIES IN ACCORDANCE WITH TABLE 508.4. 508.4.4.1 CONSTRUCTION. REQUIRED SEPARATIONS SHALL BE FIRE BARRIERS	àcco b, Sm (buildin	RDANCE WITH 903.3.1.1, TYPE V-B = <u>UNLIMITED</u> IGS TWO OR MORE STORIES SPRINKLERED IN RDANCE WITH 903.3.1.1), TYPE V-B = $27,000$ SF
CONSTRUCTED IN ACCORDANCE WITH SECTION 707 OR HORIZONTAL ASSEMBLIES CONSTRUCTED IN ACCORDANCE WITH SECTION 711, OR BOTH, SO AS TO COMPLETELY SEPARATE ADJACENT OCCUPANCIES.	U, SM (BUILDIN ACCO *FRONTAGE AND SPRII	IGS TWO OR MORE STORIES SPRINKLERED IN RDANCE WITH 903.3.1.1), TYPE V-B = $16,500$ SF NKLER INCREASES NOT CALC'D DUE TO IOUT AREA MODIFICATIONS

ILS H A F <u>ع</u> ن 2 ک **ک** • Δ $\boldsymbol{\mathcal{O}}$ • ----- \sim \propto D U. \sim Bl \odot ARCHITECTS MAIL P.O.B. 4373 KETCHUM, IDAHO 83340 PHONE 208.726.0020 FAX 208.726.0019 WWW WILLIAMS-PARTNERS.COM DRAWINGS

DATE: ISSUED: 05/12/2021 COK SCHEMATIC PRESENTATION 06/10/2021 | COK HPC REVIEW 09/30/2021 DESIGN REVIEW 04/22/2022 | PRICING SET 08/05/2022 PERMIT 08/02/2023 ISSUED FOR CONSTRUCTION REVISIONS

NUMBER: DATE:

CODE INFORMATION

HOISTWAY ENCLOSURES (SECTION 3002)

3002.1 HOISTWAY ENCLOSURE PROTECTION. ELEVATOR, DUMBWAITER AND OTHER HOISTWAY ENCLOSURES SHALL BE SHAFT ENCLOSURES COMPLYING WITH SECTIONS 712 AND 713.

3005.4 MACHINE ROOMS, CONTROL ROOMS, MACHINERY SPACES, AND CONTROL SPACES. ELEVATOR MACHINE ROOMS, CONTROL ROOMS, CONTROL SPACES AND MACHINERY SPACES OUTSIDE OF BUT ATTACHED TO A HOISTWAY THAT HAVE OPENINGS INTO THE HOISTWAY SHALL BE ENCLOSED WITH FIRE BARRIERS CONSTRUCTED IN ACCORDANCE WITH SECTION 707 OR HORIZONTAL ASSEMBLIES CONSTRUCTED IN

ACCORDANCE WITH SECTION 711, OR BOTH. THEFIRE-RESISTANCE RATING SHALL BE NOT LESS THAN THE REQUIRED RATING OF THE HOISTWAY ENCLOSURE SERVED BY THE MACHINERY. OPENINGS IN THE FIRE BARRIERS SHALL BE PROTECTED WITH ASSEMBLIES HAVING A FIRE PROTECTION RATING NOT LESS THAN THAT REQUIRED FOR THE HOISTWAY ENCLOSURE DOORS. **EXCEPTIONS:**

1. FOR OTHER THAN FIRE SERVICE ACCESS ELEVATORS AND OCCUPANT EVACUATION ELEVATORS, WHERE MACHINE ROOMS, MACHINERY SPACES, CONTROL ROOMS AND CONTROL SPACES DO NOT ABUT AND DO NOT HAVE OPENINGS TO THE HOISTWAY ENCLOSURE THEY SERVE, THE FIRE BARRIERS CONSTRUCTED IN ACCORDANCE WITH SECTION 707 OR HORIZONTAL ASSEMBLIES CONSTRUCTED IN ACCORDANCE WITH SECTION 711, OR BOTH, SHALL BE PERMITTED TO BE REDUCED TO A 1-HOURFIRE-RESISTANCE RATING.

2. FOR OTHER THAN FIRE SERVICE ACCESS ELEVATORS AND OCCUPANT EVACUATION ELEVATORS, IN BUILDINGS FOUR STORIES OR LESS ABOVE GRADE PLANE WHERE MACHINE ROOM, MACHINERY SPACES, CONTROL ROOMS AND CONTROL SPACES DO NOT ABUT AND DO NOT HAVE OPENINGS TO THE HOISTWAY ENCLOSURE THEY SERVE, THE MACHINE ROOM, MACHINERY SPACES, CONTROL ROOMS AND CONTROL SPACES ARE

NOT REQUIRED TO BE FIRE-RESISTANCE RATED. 3006.2 HOISTWAY OPENING PROTECTION REQUIRED. ELEVATOR HOISTWAY DOOR OPENINGS SHALL BE PROTECTED IN ACCORDANCE WITHSECTION 3006.3 WHERE AN ELEVATOR HOISTWAY CONNECTS MORE THAN THREE STORIES, IS REQUIRED TO BE ENCLOSED WITHIN ASHAFT ENCLOSURE IN ACCORDANCE WITH SECTION 712.1.1 AND ANY OF THE FOLLOWING CONDITIONS APPLY

1. THE BUILDING IS NOT PROTECTED THROUGHOUT WITH AN AUTOMATIC SPRINKLER SYSTEM IN ACCORDANCE WITH SECTION 903.3.1.1 OR 903.3.1.2 2. THE BUILDING CONTAINS A GROUP I-1, CONDITION 2 OCCUPANCY.

3. THE BUILDING CONTAINS A GROUP I-2 OCCUPANCY.

4. THE BUILDING CONTAINS A GROUP I-3 OCCUPANCY

5. THE BUILDING IS A HIGH RISE AND THE ELEVATOR HOISTWAY IS MORE THAN 75 FEET (22 860 MM) IN HEIGHT. THE HEIGHT OF THE HOISTWAY SHALL BE MEASURED FROM THE LOWEST FLOOR TO THE HIGHEST FLOOR OF THE FLOORS SERVED BY THE HOISTWAY.

CODE INFORMATION

INTERIOR SPACE DIMENSIONS (SECTION 1207)

1207.1 MINIMUM ROOM WIDTHS. HABITABLE SPACES, OTHER THAN A KITCHEN, SHALL BE NOT LESS THAN 7 FEET (2134 MM) IN ANY PLAN DIMENSION. KITCHENS SHALL HAVE A CLEAR PASSAGEWAY OF NOT LESS THAN 3 FEET (914 MM) BETWEEN COUNTER FRONTS AND APPLIANCES OR COUNTER FRONTS AND WALLS.

1207.2 MINIMUM CEILING HEIGHTS. OCCUPIABLE SPACES, HABITABLE SPACES AND CORRIDORS SHALL HAVE A CEILING HEIGHT OF NOT LESS THAN 7 FEET 6 INCHES (2286 MM) ABOVE THE FINISHED FLOOR. BATHROOMS, TOILET ROOMS, KITCHENS, STORAGE ROOMS AND LAUNDRY ROOMS SHALL HAVE A CEILING HEIGHT OF NOT LESS THAN 7 FEET (2134 MM) ABOVE THE FINISHED FLOOR.

1207.3 ROOM AREA. EVERY DWELLING UNIT SHALL HAVE NOT LESS THAN ONE ROOM THAT SHALL HAVE NOT LESS THAN 120 SQUARE FEET (11.2 M) OF NET FLOOR AREA. OTHER HABITABLE ROOMS SHALL HAVE ANET FLOOR AREA OF NOT LESS THAN 70 SQUARE FEET (6.5 M). EXCEPTION: KITCHENS ARE NOT REQUIRED TO BE OF A MINIMUM FLOOR

AREA. SAFETY GLAZING, HAZARDOUS LOCATIONS (CHAPTER 24) 2406.4 HAZARDOUS LOCATIONS. THE LOCATIONS SPECIFIED IN SECTIONS 2406.4.1 THROUGH 2406.4.7 SHALL BE CONSIDERED TO BE SPECIFIC HAZARDOUS LOCATIONS REQUIRING SAFETY GLAZING MATERIALS.

2406.4.1 GLAZING IN DOORS. GLAZING IN ALL FIXED AND OPERABLE PANELS OF SWINGING, SLIDING AND BIFOLD DOORS SHALL BE CONSIDERED TO BE A HAZARDOUS LOCATION. 2406.4.2 GLAZING ADJACENT TO DOORS. GLAZING IN AN INDIVIDUAL

FIXED OR OPERABLE PANEL ADJACENT TO A DOOR WHERE THE NEAREST VERTICAL EDGE OF THE GLAZING IS WITHIN A 24-INCH (610 MM) ARC OF EITHER VERTICAL EDGE OF THE DOOR IN A CLOSED POSITION AND WHERE THE BOTTOM EXPOSED EDGE OF THE GLAZING IS LESS THAN 60 INCHES (1524 MM) ABOVE THE WALKING SURFACE SHALL BE CONSIDERED TO BE A HAZARDOUS LOCATION.

2406.4.3 GLAZING IN WINDOWS. GLAZING IN AN INDIVIDUAL FIXED OR OPERABLE PANEL THAT MEETS ALL OF THE FOLLOWING CONDITIONS SHALL BE CONSIDERED TO BE A HAZARDOUS LOCATION: 1. THE EXPOSED AREA OF AN INDIVIDUAL PANE IS GREATER THAN 9 SQUARE

FEET (0.84 M). 2. THE BOTTOM EDGE OF THE GLAZING IS LESS THAN 18 INCHES (457 MM)

ABOVE THE FLOOR 3. THE TOP EDGE OF THE GLAZING IS GREATER THAN 36 INCHES (914 MM) ABOVE THE FLOOR.

4. ONE OR MORE WALKING SURFACE(S) ARE WITHIN 36 INCHES (914 MM) MEASURED HORIZONTALLY AND IN A STRAIGHT LINE, OF THE PLANE OF THE GLAZING.

2406.4.4 GLAZING IN GUARDS AND RAILINGS. GLAZING IN GUARDS AND RAILINGS, INCLUDING STRUCTURAL BALUSTER PANELS AND NONSTRUCTURAL IN-FILL PANELS, REGARDLESS OF AREA OR HEIGHT ABOVE

A WALKING SURFACE SHALL BE CONSIDERED TO BE A HAZARDOUS LOCATION.

2406.4.5 GLAZING AND WET SURFACES

GLAZING IN WALLS, ENCLOSURES OR FENCES CONTAINING OR FACING HOT TUBS, SPAS, WHIRLPOOLS, SAUNAS, STEAM ROOMS, BATHTUBS, SHOWERS AND INDOOR OR OUTDOOR SWIMMING POOLS WHERE THE BOTTOM EXPOSED EDGE OF THE GLAZING IS LESS THAN 60 INCHES (1524 MM) MEASURED VERTICALLY ABOVE ANY STANDING OR WALKING SURFACE SHALL BE CONSIDERED TO BE A HAZARDOUS LOCATION. THIS SHALL APPLY TO SINGLE GLAZING AND ALL PANES IN MULTIPLE GLAZING.


2406.4.6 GLAZING ADJACENT TO STAIRWAYS AND RAMPS. GLAZING WHERE THE BOTTOM EXPOSED EDGE OF THE GLAZING IS LESS THAN 60 INCHES (1524 MM) ABOVE THE PLANE OF THE ADJACENT WALKING SURFACE OF STAIRWAYS, LANDINGS BETWEEN FLIGHTS OF STAIRS AND RAMPS SHALL BE CONSIDERED TO BE A HAZARDOUS LOCATION. EXCEPTIONS:

1. THE SIDE OF A STAIRWAY, LANDING OR RAMP THAT HAS A GUARD COMPLYING WITH THE PROVISIONS OF SECTIONS 1015 AND 1607.8, AND THE PLANE OF THE GLASS IS GREATER THAN 18 INCHES (457 MM) FROM THE railing.

2. GLAZING 36 INCHES (914 MM) OR MORE MEASURED HORIZONTALLY FROM THE WALKING SURFACE.

2406.4.7 GLAZING ADJACENT TO THE BOTTOM STAIRWAY LANDING. GLAZING ADJACENT TO THE LANDING AT THE BOTTOM OF A STAIRWAY WHERE THE GLAZING IS LESS THAN 60 INCHES (1524 MM) ABOVE THE LANDING AND WITHIN A 60-INCH (1524 MM) HORIZONTAL ARC THAT IS LESS THAN 180 DEGREES (3.14 RAD) FROM THE BOTTOM TREAD NOSING SHALL BE CONSIDERED TO BE A HAZARDOUS LOCATION.

FOAM PLASTIC INSULATION (SECTION 2603)

2603.4 THERMAL BARRIER. EXCEPT AS PROVIDED FOR IN SECTIONS 2603.4.1 AND 2603.9, FOAM PLASTIC SHALL BE SEPARATED FROM THE INTERIOR OF A BUILDING BY AN APPROVED THERMAL BARRIER OF 1/2-INCH (12.7 MM) GYPSUM WALLBOARD, HEAVY TIMBER IN ACCORDANCE WITHSECTION 602.4 OR A MATERIAL THAT IS TESTED IN ACCORDANCE WITH AND MEETS THE ACCEPTANCE CRITERIA OF BOTH THE TEMPERATURE TRANSMISSION FIRE TEST AND THE INTEGRITY FIRE TEST OF NFPA 275. COMBUSTIBLE CONCEALED SPACES SHALL COMPLY WITHSECTION 718.

MINIMUM PLUMBING FACILITIES (SECTION 2902)

TABLE 2902 BUSINESS (OCCUPANT LOAD = 9 PEOPLE TOTAL):

- 1 WATER CLOSET PER 25 FOR THE FIRST 50

- 1 LAVATORY PER 40 FOR THE FIRST 80
- 0 BATHTUBS/SHOWERS

- 1 DRINKING FOUNTAIN PER 100 (SEE SECTION 410 OF THE IPC)

- 1 SERVICE SINK, <u>SUBNOTE E</u>: NOT REQUIRED FOR BUSINESS AND MERCANTILE CLASSIFICATIONS WITH AN OCCUPANT LOAD OF 15 OR FEWER. **RESIDENTIAL (APARTMENT HOUSE):**

- 1 WATER CLOSET PER DWELLING UNIT

- 1 LAVATORY PER DWELLING UNIT - 1 BATHTUB/SHOWER PER DWELLING UNIT

- 1 KITCHEN SINK PER DWELLING UNIT

- 1 AUTOMATIC CLOTHES WASHER CONNECTION PER 20 DWELLING UNITS [P] 2902.2 SEPARATE FACILITIES. WHERE PLUMBING FIXTURES ARE REQUIRED, SEPARATE FACILITIES SHALL BE PROVIDED FOR EACH SEX.

EXCEPTIONS: 1. SEPARATE FACILITIES SHALL NOT BE REQUIRED FOR DWELLING UNITS AND

SLEEPING UNITS. 2. SEPARATE FACILITIES SHALL NOT BE REQUIRED IN STRUCTURES OR TENANT SPACES WITH A TOTAL OCCUPANT LOAD, INCLUDING BOTH EMPLOYEES

AND CUSTOMERS, OF 15 OR FEWER. 4. SEPARATE FACILITIES SHALL NOT BE REQUIRED IN BUSINESS OCCUPANCIES

IN WHICH THE MAXIMUM OCCUPANT LOAD IS 25 OR FEWER. [P] 2902.6 SMALL OCCUPANCIES. DRINKING FOUNTAINS SHALL NOT BE REQUIRED FOR AN OCCUPANT LOAD OF 15 OR FEWER

CODE INFORMATION

ACCESSIBLE ENTRANCES (SECTION 1105)

1105.1 PUBLIC ENTRANCES. IN ADDITION TO ACCESSIBLE ENTRANCES REQUIRED BY SECTIONS 1105.1.1 THROUGH 1105.1.7, AT LEAST 60 PERCENT OF ALL PUBLIC ENTRANCES SHALL BE ACCESSIBLE

1105.1.7 DWELLING UNITS AND SLEEPING UNITS. AT LEAST ONE ACCESSIBLE ENTRANCE SHALL BE PROVIDED TO EACH DWELLING UNIT AND SLEEPING UNIT IN A FACILITY.

EXCEPTION: AN ACCESSIBLE ENTRANCE IS NOT REQUIRED TO DWELLING UNITS AND SLEEPING UNITS THAT ARE NOT REQUIRED TO BE ACCESSIBLE UNITS, TYPE A UNITS OR TYPE B UNITS.

DWELLING AND SLEEPING UNITS (SECTION 1107)

1107.6.3 GROUP R-3. IN GROUP R-3 OCCUPANCIES WHERE THERE ARE FOUR OR MORE DWELLING UNITS OR SLEEPING UNITS INTENDED TO BE OCCUPIED AS A RESIDENCE IN A SINGLE STRUCTURE, EVERY DWELLING UNIT AND SLEEPING UNIT INTENDED TO BE OCCUPIED AS A RESIDENCE SHALL BE A TYPE B UNIT. BEDROOMS WITHIN CONGREGATE LIVING FACILITIES, DORMITORIES, SORORITIES, FRATERNITIES, AND BOARDING HOUSES SHALL BE COUNTED AS SLEEPING UNITS FOR THE PURPOSE OF DETERMINING THE NUMBER OF UNITS.

VENTILATION (SECTION 1202)

1202.3 UNVENTED ATTIC AND UNVENTED ENCLOSED RAFTER ASSEMBLIES UNVENTED ATTICS AND UNVENTED ENCLOSED ROOF FRAMING ASSEMBLIES CREATED BY CEILINGS APPLIED DIRECTLY TO THE UNDERSIDE OF THE ROOF FRAMING MEMBERS/RAFTERS AND THE STRUCTURAL ROOF SHEATHING AT THE TOP OF THE ROOF FRAMING MEMBERS SHALL BE PERMITTED WHERE ALL OF THE FOLLOWING CONDITIONS ARE MET:

1. THE UNVENTED ATTIC SPACE IS COMPLETELY WITHIN THE BUILDING THERMAL ENVELOPE.

2. NO INTERIOR CLASS I VAPOR RETARDERS ARE INSTALLED ON THE CEILING SIDE (ATTIC FLOOR) OF THE UNVENTED ATTIC ASSEMBLY OR ON THE CEILING SIDE OF THE UNVENTED ENCLOSED ROOF FRAMING ASSEMBLY

3. WHERE WOOD SHINGLES OR SHAKES ARE USED, NOT LESS THAN A 1/4-INCH (6.4 MM) VENTED AIRSPACE SEPARATES THE SHINGLES OR SHAKES AND THE ROOFING UNDERLAYMENT ABOVE THE STRUCTURAL SHEATHING. 4. IN CLIMATE ZONES 5, 6, 7 AND 8, ANY AIR-IMPERMEABLE INSULATION SHALL BE A CLASS II VAPOR RETARDER OR SHALL HAVE A CLASS II VAPOR

RETARDER COATING OR COVERING IN DIRECT CONTACT WITH THE UNDERSIDE OF THE INSULATION. 5. INSULATION SHALL BE LOCATED IN

ACCORDANCE WITH THE FOLLOWING: 5.1. ITEM 5.1.1, 5.1.2, 5.1.3 OR 5.1.4 SHALL BE MET, DEPENDING ON THE AIR PERMEABILITY OF THE INSULATION DIRECTLY UNDER THE STRUCTURAL

ROOF SHEATHING. 5.1.1. WHERE ONLY AIR-IMPERMEABLE INSULATION IS PROVIDED, IT SHALL BE APPLIED IN DIRECT CONTACT WITH THE UNDERSIDE OF THE STRUCTURAL ROOF SHEATHING.

5.1.2. WHERE AIR-PERMEABLE INSULATION IS PROVIDED INSIDE THE BUILDING THERMAL ENVELOPE, IT SHALL BE INSTALLED IN ACCORDANCE WITH ITEM 5.1.1. IN ADDITION TO THE AIR-PERMEABLE INSULATION INSTALLED DIRECTLY BELOW THE STRUCTURAL SHEATHING, RIGID BOARD OR SHEET INSULATION SHALL BE INSTALLED DIRECTLY ABOVE THE STRUCTURAL ROOF SHEATHING IN ACCORDANCE WITH THE R-VALUES IN TABLE 1202.3 FOR CONDENSATION CONTROL.

5.1.3. WHERE BOTH AIR-IMPERMEABLE AND AIR-PERMEABLE INSULATION ARE PROVIDED, THE AIR-IMPERMEABLE INSULATION SHALL BE APPLIED IN DIRECT CONTACT WITH THE UNDERSIDE OF THE STRUCTURAL ROOF SHEATHING IN ACCORDANCE WITH ITEM 5.1.1 AND SHALL BE IN ACCORDANCE WITH THE R-VALUES IN TABLE 1202.3 FOR CONDENSATION CONTROL. THE AIR-PERMEABLE INSULATION SHALL BE INSTALLED DIRECTLY UNDER THE AIR-IMPERMEABLE INSULATION.

5.1.4. ALTERNATIVELY, SUFFICIENT RIGID BOARD OR SHEET INSULATION SHALL BE INSTALLED DIRECTLY ABOVE THE STRUCTURAL ROOF SHEATHING TO MAINTAIN THE MONTHLY AVERAGE TEMPERATURE OF THE UNDERSIDE OF THE STRUCTURAL ROOF SHEATHING ABOVE 45°F (7°C). FOR CALCULATION PURPOSES, AN INTERIOR AIR TEMPERATURE OF 68°F (20°C) IS ASSUMED AND THE EXTERIOR AIR TEMPERATURE IS ASSUMED TO BE THE MONTHLY AVERAGE OUTSIDE AIR TEMPERATURE OF THE THREE COLDEST MONTHS. TABLE 1202.3 INSULATION FOR CONDENSATION CONTROL CLIMATE ZONE 6: R-25 MINIMUM R-VALUE OF AIR-IMPERMEABLE

INSULATION. 1202.5 NATURAL VENTILATION. NATURAL VENTILATION OF AN OCCUPIED SPACE SHALL BE THROUGH WINDOWS, DOORS, LOUVERS OR OTHER OPENINGS TO THE OUTDOORS. THE OPERATING MECHANISM FOR SUCH

OPENINGS SHALL BE PROVIDED WITH READY ACCESS SO THAT THE OPENINGS ARE READILY CONTROLLABLE BY THE BUILDING OCCUPANTS. 1202.5.1 VENTILATION AREA REQUIRED. THE OPENABLE AREA OF THE OPENINGS TO THE OUTDOORS SHALL BE NOT LESS THAN 4 PERCENT OF THE FLOOR AREA BEING VENTILATED.

1202.5.1.1 ADJOINING SPACES. WHERE ROOMS AND SPACES WITHOUT OPENINGS TO THE OUTDOORS ARE VENTILATED THROUGH AN ADJOINING ROOM, THE OPENING TO THE ADJOINING ROOM SHALL BE

UNOBSTRUCTED AND SHALL HAVE AN AREA OF NOT LESS THAN 8 PERCENT OF THE FLOOR AREA OF THE INTERIOR ROOM OR SPACE, BUT NOT LESS THAN 25 SQUARE FEET (2.3 M). THE OPENABLE AREA OF THE OPENINGS TO THE OUTDOORS SHALL BE BASED ON THE TOTAL FLOOR AREA BEING VENTILATED.

1202.5.2.1 BATHROOMS. ROOMS CONTAINING BATHTUBS, SHOWERS, SPAS AND SIMILAR BATHING FIXTURES SHALL BE MECHANICALLY VENTILATED IN ACCORDANCE WITH THE INTERNATIONAL MECHANICAL CODE.

LIGHTING (SECTION 1024)

1204.1 GENERAL. EVERY SPACE INTENDED FOR HUMAN OCCUPANCY SHALL BE PROVIDED WITH NATURAL LIGHT BY MEANS OF EXTERIOR GLAZED OPENINGS IN ACCORDANCE WITH SECTION 1204.2 OR SHALL BE PROVIDED WITH ARTIFICIAL LIGHT IN ACCORDANCE WITH SECTION 1204.3. EXTERIOR GLAZED OPENINGS SHALL OPEN DIRECTLY ONTO A PUBLIC WAY OR ONTO A YARD OR COURT IN ACCORDANCE WITH SECTION 1205.

1204.2 NATURAL LIGHT. THE MINIMUM NET GLAZED AREA SHALL BE NOT LESS THAN 8 PERCENT OF THE FLOOR AREA OF THE ROOM SERVED. 1204.3 ARTIFICIAL LIGHT. ARTIFICIAL LIGHT SHALL BE PROVIDED THAT IS

ADEQUATE TO PROVIDE AN AVERAGE ILLUMINATION OF 10 FOOTCANDLES (107 LUX) OVER THE AREA OF THE ROOM AT A HEIGHT OF 30 INCHES (762 MM) ABOVE THE FLOOR LEVEL.

1204.4 STAIRWAY ILLUMINATION. STAIRWAYS WITHIN DWELLING UNITS AND EXTERIOR STAIRWAYS SERVING A DWELLING UNIT SHALL HAVE AN ILLUMINATION LEVEL ON TREAD RUNS OF NOT LESS THAN 1 FOOTCANDLE (11 LUX). STAIRWAYS IN OTHER OCCUPANCIES SHALL BE GOVERNED BY CHAPTER 10.

1204.4.1 CONTROLS. THE CONTROL FOR ACTIVATION OF THE REQUIRED STAIRWAY LIGHTING SHALL BE IN ACCORDANCE WITH NFPA 70.

CODE INFORMATION

GUARDS (SECTION 1015), CONTINUED

1015.4 OPENING LIMITATIONS. REQUIRED GUARDS SHALL NOT HAVE OPENINGS THAT ALLOW PASSAGE OF A SPHERE 4 INCHES (102 MM) IN DIAMETER FROM THE WALKING SURFACE TO THE REQUIRED GUARD HEIGHT. EXCEPTIONS:

6. WITHIN INDIVIDUAL DWELLING UNITS AND SLEEPING UNITS IN GROUP R-2 AND R-3 OCCUPANCIES, GUARDS ON THE OPEN SIDES OF STAIRS SHALL NOT HAVE OPENINGS THAT ALLOW PASSAGE OF A SPHERE 4 3/8 (111 MM) INCHES IN DIAMETER.

1015.6 MECHANICAL EQUIPMENT, SYSTEMS AND DEVICES. GUARDS SHALL BE PROVIDED WHERE VARIOUS COMPONENTS THAT REQUIRE SERVICE ARE LOCATED WITHIN 10 FEET (3048 MM) OF A ROOF EDGE OR OPEN SIDE OF A WALKING SURFACE AND SUCH EDGE OR OPEN SIDE IS LOCATED MORE THAN 30 INCHES (762 MM) ABOVE THE FLOOR, ROOF OR GRADE BELOW. THE GUARD SHALL EXTEND NOT LESS THAN 30 INCHES (762 MM) BEYOND EACH END OF SUCH COMPONENTS. THE GUARD SHALL BE CONSTRUCTED SO AS TO PREVENT THE PASSAGE OF A SPHERE 21 INCHES (533 MM) IN DIAMETER. EXCEPTION: GUARDS ARE NOT REQUIRED WHERE PERSONAL FALL ARREST ANCHORAGE CONNECTOR DEVICES THAT COMPLY WITH ANSI/ASSE Z 359.1 ARE INSTALLED.

1015.7 ROOF ACCESS. GUARDS SHALL BE PROVIDED WHERE THE ROOF HATCH OPENING IS LOCATED WITHIN 10 FEET (3048 MM) OF A ROOF EDGE OR OPEN SIDE OF A WALKING SURFACE AND SUCH EDGE OR OPEN SIDE IS LOCATED MORE THAN 30 INCHES (762 MM) ABOVE THE FLOOR, ROOF OR GRADE BELOW. THE GUARD SHALL BE CONSTRUCTED SO AS TO PREVENT THE PASSAGE OF A SPHERE 21 INCHES (533 MM) IN DIAMETER. EXCEPTION: GUARDS ARE NOT REQUIRED WHERE PERSONAL FALL ARREST ANCHORAGE CONNECTOR DEVICES THAT COMPLY WITH ANSI/ASSE Z 359.1 ARE INSTALLED.

1015.8 WINDOW OPENINGS. WINDOWS IN GROUP R-2 AND R-3 BUILDINGS INCLUDING DWELLING UNITS, WHERE THE TOP OF THE SILL OF AN OPERABLE WINDOW OPENING IS LOCATED LESS THAN 36 INCHES ABOVE THE FINISHED FLOOR AND MORE THAN 72 INCHES (1829 MM) ABOVE THE FINISHED GRADE OR OTHER SURFACE BELOW ON THE EXTERIOR OF THE BUILDING, SHALL COMPLY WITH ONE OF THE FOLLOWING:

1. OPERABLE WINDOWS WHERE THE TOP OF THE SILL OF THE OPENING IS LOCATED MORE THAN 75 FEET (22 860 MM) ABOVE THE FINISHED GRADE OR OTHER SURFACE BELOW AND THAT ARE PROVIDED WITH WINDOW FALL PREVENTION DEVICES THAT COMPLY WITH ASTM F2006. 2. OPERABLE WINDOWS WHERE THE OPENINGS WILL NOT ALLOW A 4-INCH-DIAMETER (102 MM) SPHERE TO PASS THROUGH THE OPENING WHEN

THE WINDOW IS IN ITS LARGEST OPENED POSITION. 3. OPERABLE WINDOWS WHERE THE OPENINGS ARE PROVIDED WITH WINDOW FALL PREVENTION DEVICES THAT COMPLY WITH ASTM F2090. 4. OPERABLE WINDOWS THAT ARE PROVIDED WITH WINDOW OPENING CONTROL DEVICES THAT COMPLY WITH SECTION 1015.8.1

1015.8.1 WINDOW OPENING CONTROL DEVICES. WINDOW OPENING CONTROL DEVICES SHALL COMPLY WITH ASTM F2090. THE WINDOW OPENING CONTROL DEVICE, AFTER OPERATION TO RELEASE THE CONTROL DEVICE ALLOWING THE WINDOW TO FULLY OPEN, SHALL NOT REDUCE THE MINIMUM NET CLEAR OPENING AREA OF THE WINDOW UNIT TO LESS THAN THE AREA REQUIRED BY SECTION 1030.2.

EXIT ACCESS TRAVEL DISTANCE (SECTION 1017)

1017.2 LIMITATIONS. EXIT ACCESS TRAVEL DISTANCE SHALL NOT EXCEED THE VALUES GIVEN IN TABLE 1017.2.

1017.3 MEASUREMENT. EXIT ACCESS TRAVEL DISTANCE SHALL BE MEASURED FROM THE MOST REMOTE POINT OF EACH ROOM, AREA OR SPACE ALONG THE NATURAL AND UNOBSTRUCTED PATH OF HORIZONTAL AND VERTICAL EGRESS TRAVEL TO THE ENTRANCE TO AN EXIT.

1017.3.1 EXIT ACCESS STAIRWAYS AND RAMPS. TRAVEL DISTANCE ON EXIT ACCESS STAIRWAYS OR RAMPS SHALL BE INCLUDED IN THE EXIT ACCESS TRAVEL DISTANCE MEASUREMENT. THE MEASUREMENT ALONG STAIRWAYS SHALL BE MADE ON A PLANE PARALLEL AND TANGENT TO THE STAIR TREAD NOSINGS IN THE CENTER OF THE STAIR AND LANDINGS. THE MEASUREMENT ALONG RAMPS SHALL BE MADE ON THE WALKING SURFACE IN THE CENTER OF THE RAMP AND LANDINGS.

EXIT ACCESS STAIRWAYS AND RAMPS (SECTION 1019)

1019.3 OCCUPANCIES OTHER THAN GROUPS I-2 AND I-3. IN OTHER THAN GROUP I-2 AND I-3 OCCUPANCIES, FLOOR OPENINGS CONTAINING EXIT ACCESS STAIRWAYS OR RAMPS THAT DO NOT COMPLY WITH ONE OF THE CONDITIONS LISTED IN THIS SECTION SHALL BE ENCLOSED WITH A SHAFT ENCLOSURE CONSTRUCTED IN ACCORDANCE WITH SECTION 713. 2. IN GROUP R-1, R-2 OR R-3 OCCUPANCIES, EXIT ACCESS STAIRWAYS AND RAMPS CONNECTING FOUR STORIES OR LESS SERVING AND CONTAINED WITHIN AN INDIVIDUAL DWELLING UNIT OR SLEEPING UNIT OR LIVE/WORK UNIT.

CORRIDORS (SECTION 1020)

1020.1 CONSTRUCTION. CORRIDORS SHALL BE FIRE-RESISTANCE RATED IN ACCORDANCE WITH TABLE 1020.1. THE CORRIDOR WALLS REQUIRED TO BE FIRE-RESISTANCE RATED SHALL COMPLY WITH SECTION 708 FOR FIRE PARTITIONS.

2. A FIRE-RESISTANCE RATING IS NOT REQUIRED FOR CORRIDORS CONTAINED WITHIN A DWELLING UNIT OR SLEEPING UNIT IN AN OCCUPANCY IN GROUPS I-1 AND R.

4. A FIRE-RESISTANCE RATING IS NOT REQUIRED FOR CORRIDORS IN AN OCCUPANCY IN GROUP B THAT IS A SPACE REQUIRING ONLY A SINGLE MEANS OF EGRESS COMPLYING WITH SECTION 1006.2.

5. CORRIDORS ADJACENT TO THE EXTERIOR WALLS OF BUILDINGS SHALL BE PERMITTED TO HAVE UNPROTECTED OPENINGS ON UNRATED EXTERIOR WALLS WHERE UNRATED WALLS ARE PERMITTED BY TABLE 602 AND UNPROTECTED OPENINGS ARE PERMITTED BY TABLE 705.8.

TABLE 1020.1: CORRIDOR FIRE-RESISTANCE RATING OCCUPANCY B REQUIRED FIRE-RESISTANCE RATING: 0-HOUR, WITH

SPRINKLER SYSTEM

TABLE 1020.2: MINIMUM CORRIDOR WIDTH:

WITH AN OCCUPANT LOAD OF LESS THAN 50: 36" MINIMUM WIDTH WITHIN A DWELLING UNIT: 36" MINIMUM WIDTH

ACCESSIBLE ROUTE (SECTION 1104)

1104.1 SITE ARRIVAL POINTS. AT LEAST ONE ACCESSIBLE ROUTE WITHIN THE SITE SHALL BE PROVIDED FROM PUBLIC TRANSPORTATION STOPS, ACCESSIBLE PARKING, ACCESSIBLE PASSENGER LOADING ZONES, AND PUBLIC STREETS OR SIDEWALKS TO THE ACCESSIBLE BUILDING ENTRANCE SERVED. EXCEPTION: OTHER THAN IN BUILDINGS OR FACILITIES CONTAINING OR SERVING TYPE B UNITS, AN ACCESSIBLE ROUTE SHALL NOT BE REQUIRED BETWEEN SITE ARRIVAL POINTS AND THE BUILDING OR FACILITY ENTRANCE IF VERTICALLY ABOVE THE ADJACENT WALKING SURFACES. THE ONLY MEANS OF ACCESS BETWEEN THEM IS A VEHICULAR WAY NOT PROVIDING FOR PEDESTRIAN ACCESS.

1104.2 WITHIN A SITE. AT LEAST ONE ACCESSIBLE ROUTE SHALL CONNECT ACCESSIBLE BUILDINGS, ACCESSIBLE FACILITIES, ACCESSIBLE ELEMENTS AND ACCESSIBLE SPACES THAT ARE ON THE SAME SITE.

CODE INFORMATION

STAIRWAYS (SECTION 1011)

1011.2 WIDTH AND CAPACITY. THE REQUIRED CAPACITY OF STAIRWAYS SHALL BE DETERMINED AS SPECIFIED IN SECTION 1005.1, BUT THE MINIMUM WIDTH SHALL BE NOT LESS THAN 44 INCHES (1118 MM). SEE SECTION 1009.3 FOR ACCESSIBLE MEANS OF EGRESS STAIRWAYS. EXCEPTIONS:

1. STAIRWAYS SERVING AN OCCUPANT LOAD OF LESS THAN 50 SHALL HAVE A WIDTH OF NOT LESS THAN 36 INCHES (914 MM). 1011.3 HEADROOM. STAIRWAYS SHALL HAVE A HEADROOM CLEARANCE OF NOT LESS THAN 80 INCHES (2032 MM) MEASURED VERTICALLY FROM A LINE CONNECTING THE EDGE OF THE NOSINGS. SUCH HEADROOM SHALL BE CONTINUOUS ABOVE THE STAIRWAY TO THE POINT WHERE THE LINE INTERSECTS THE LANDING BELOW, ONE TREAD DEPTH BEYOND THE BOTTOM RISER. THE MINIMUM CLEARANCE SHALL BE MAINTAINED THE FULL WIDTH OF THE STAIRWAY AND LANDING. 1011.5.2 RISER HEIGHT AND TREAD DEPTH EXCEPTION

2. IN GROUP R-3 OCCUPANCIES; WITHIN DWELLING UNITS IN GROUP R-2 OCCUPANCIES; AND IN GROUP U OCCUPANCIES THAT ARE ACCESSORY TO A GROUP R-3 OCCUPANCY OR ACCESSORY TO INDIVIDUAL DWELLING UNITS IN GROUP R-2 OCCUPANCIES; THE MAXIMUM RISER HEIGHT SHALL BE 7 3/4 INCHES (197 MM); THE THE POWER SUPPLY FOR MEANS OF EGRESS ILLUMINATION SHALL MINIMUM TREAD DEPTH SHALL BE 10 INCHES (254 MM). A NOSING PROJECTION NOT LESS THAN 3/4 INCH (19.1 MM) BUT NOT MORE THAN 1 1/4 INCHES (32 MM) SHALL BE PROVIDED ON STAIRWAYS WITH SOLID RISERS WHERE THE TREAD DEPTH IS LESS THAN 11 INCHES (279 MM) 2. CORRIDORS.

1011.6 STAIRWAY LANDINGS. THERE SHALL BE A FLOOR OR LANDING AT THE TOP AND BOTTOM OF EACH STAIRWAY. THE WIDTH OF LANDINGS, MEASURED PERPENDICULARLY TO THE DIRECTION OF TRAVEL, SHALL BE NOT LESS THAN THE WIDTH OF STAIRWAYS SERVED. EVERY LANDING SHALL HAVE A MINIMUM DEPTH, MEASURED PARALLEL TO THE DIRECTION OF TRAVEL, EQUAL TO THE WIDTH OF THE STAIRWAY OR 48 INCHES (1219 MM), WHICHEVER IS LESS. DOORS OPENING ONTO A LANDING SHALL NOT REDUCE THE LANDING TO LESS THAN ONE-HALF THE REQUIRED WIDTH. WHEN FULLY OPEN, THE DOOR SHALL NOT PROJECT MORE THAN 7 INCHES (178 MM) INTO A LANDING. WHERE WHEELCHAIR SPACES ARE REQUIRED ON THE STAIRWAY LANDING IN ACCORDANCE WITH SECTION 1009.6.3, THE WHEELCHAIR SPACE SHALL NOT BE LOCATED IN THE REQUIRED WIDTH OF THE LANDING AND DOORS SHALL NOT SWING OVER

THE WHEELCHAIR SPACES 1011.7.3 ENCLOSURES UNDER INTERIOR STAIRWAYS. THE WALLS AND SOFFITS WITHIN ENCLOSED USABLE SPACES UNDER ENCLOSED AND UNENCLOSED STAIRWAYS SHALL BE PROTECTED BY 1-HOUR FIRE-RESISTANCE-RATED CONSTRUCTION OR THE FIRE-RESISTANCE RATING OF THE STAIRWAY ENCLOSURE, WHICHEVER IS GREATER. ACCESS TO THE ENCLOSED SPACE SHALL NOT BE DIRECTLY FROM WITHIN THE STAIRWAY ENCLOSURE.

EXCEPTION: SPACES UNDER STAIRWAYS SERVING AND CONTAINED WITHIN A SINGLE RESIDENTIAL DWELLING UNIT IN GROUP R-2 OR R-3 SHALL BE PERMITTED TO BE PROTECTED ON THE ENCLOSED SIDE WITH 1/2-INCH (12.7 MM) GYPSUM BOARD

1011.11 HANDRAILS. FLIGHTS OF STAIRWAYS SHALL HAVE HANDRAILS ON EACH SIDE AND SHALL COMPLY WITH SECTION 1014. WHERE GLASS IS USED TO PROVIDE THE HANDRAIL, THE HANDRAIL SHALL COMPLY WITH SECTION 2407. EXCEPTIONS: 1. FLIGHTS OF STAIRWAYS WITHIN DWELLING UNITS AND FLIGHTS OF SPIRAL STAIRWAYS ARE PERMITTED TO HAVE A HANDRAIL ON ONE SIDE ONLY.

1011.12.2 ROOF ACCESS. WHERE A STAIRWAY IS PROVIDED TO A ROOF ACCESS TO THE ROOF SHALL BE PROVIDED THROUGH A PENTHOUSE COMPLYING WITH SECTION 1510.2. EXCEPTION: IN BUILDINGS WITHOUT AN OCCUPIED ROOF, ACCESS TO THE ROOF SHALL BE PERMITTED TO BE A ROOF HATCH OR TRAP DOOR NOT LESS THAN 16 SQUARE FEET (1.5 M) IN AREA AND HAVING A MINIMUM DIMENSION OF 2 FEET (610 MM).

EXIT SIGNS (SECTION 1013)

1013.1 WHERE REQUIRED. EXITS AND EXIT ACCESS DOORS SHALL BE MARKED BY AN APPROVED EXIT SIGN READILY VISIBLE FROM ANY DIRECTION OF EGRESS TRAVEL. THE PATH OF EGRESS TRAVEL TO EXITS AND WITHIN EXITS SHALL BE MARKED BY READILY VISIBLE EXIT SIGNS TO CLEARLY INDICATE THE DIRECTION OF EGRESS TRAVEL IN CASES WHERE THE EXIT OR MM). THE CLEAR OPENING WIDTH OF DOORWAYS WITH SWINGING THE PATH OF EGRESS TRAVEL IS NOT IMMEDIATELY VISIBLE TO THE OCCUPANTS. INTERVENING MEANS OF EGRESS DOORS WITHIN EXITS SHALL BE MARKED BY EXIT SIGNS. EXIT SIGN PLACEMENT SHALL BE SUCH THAT ANY POINT IN AN EXIT ACCESS CORRIDOR OR EXIT PASSAGEWAY IS WITHIN 100 FEET (30 480 MM) OR THE LISTED VIEWING DISTANCE OF THE SIGN, WHICHEVER IS LESS, FROM THE NEAREST VISIBLE EXIT SIGN. EXCEPTIONS:

1. EXIT SIGNS ARE NOT REQUIRED IN ROOMS OR AREAS THAT REQUIRE ONLY ONE EXIT OR EXIT ACCESS.

2. MAIN EXTERIOR EXIT DOORS OR GATES THAT ARE OBVIOUSLY AND CLEARLY IDENTIFIABLE AS EXITS NEED NOT HAVE EXIT SIGNS WHERE APPROVED BY THE BUILDING OFFICIAL. 3. EXIT SIGNS ARE NOT REQUIRED IN OCCUPANCIES IN GROUP U AND INDIVIDUAL SLEEPING UNITS OR DWELLING UNITS IN GROUP R-1, R-2 OR R-

GUARDS (SECTION 1015)

1015.2 WHERE REQUIRED. GUARDS SHALL BE LOCATED ALONG OPEN-SIDED WALKING SURFACES, INCLUDING MEZZANINES, EQUIPMENT PLATFORMS, AISLES, STAIRS, RAMPS AND LANDINGS THAT ARE LOCATED MORE THAN 30 INCHES (762 MM) MEASURED VERTICALLY TO THE FLOOR OR GRADE BELOW AT ANY POINT WITHIN 36 INCHES (914 MM) HORIZONTALLY TO THE EDGE OF THE OPEN SIDE. GUARDS SHALL BE ADEQUATE IN STRENGTH AND ATTACHMENT IN ACCORDANCE WITH SECTION 1607.8.

1015.3 HEIGHT. REQUIRED GUARDS SHALL BE NOT LESS THAN 42 INCHES (1067 MM) HIGH, MEASURED VERTICALLY AS FOLLOWS: 1. FROM THE ADJACENT WALKING SURFACES. 2. ON STAIRWAYS AND STEPPED AISLES, FROM THE LINE CONNECTING THE LEADING EDGES OF THE TREAD NOSINGS. 3. ON RAMPS AND RAMPED AISLES, FROM THE RAMP SURFACE AT THE GUARD.

EXCEPTIONS: 1. FOR OCCUPANCIES IN GROUP R-3 NOT MORE THAN THREE STORIES ABOVE GRADE IN HEIGHT AND WITHIN INDIVIDUAL DWELLING UNITS IN OCCUPANCIES IN GROUP R-2 NOT MORE THAN THREE STORIES ABOVE GRADE IN HEIGHT WITH SEPARATE MEANS OF EGRESS, REQUIRED GUARDS SHALL BE NOT LESS THAN 36 INCHES (914 MM) IN HEIGHT MEASURED 2. FOR OCCUPANCIES IN GROUP R-3, AND WITHIN INDIVIDUAL DWELLING UNITS IN OCCUPANCIES IN GROUP R-2, GUARDS ON THE OPEN SIDES OF STAIRS SHALL HAVE A HEIGHT NOT LESS THAN 34 INCHES (864 MM) MEASURED VERTICALLY FROM A LINE CONNECTING THE LEADING EDGES OF THE TREADS.

3. FOR OCCUPANCIES IN GROUP R-3, AND WITHIN INDIVIDUAL DWELLING UNITS IN OCCUPANCIES IN GROUP R-2, WHERE THE TOP OF THE GUARD SERVES AS A HANDRAIL ON THE OPEN SIDES OF STAIRS, THE TOP OF THE GUARD SHALL BE NOT LESS THAN 34 INCHES (864 MM) AND NOT MORE THAN 38 INCHES (965 MM) MEASURED VERTICALLY FROM A LINE CONNECTING THE LEADING EDGES OF THE TREADS.

CODE INFORMATION

MEANS OF EGRESS ILLUMINATION (SECTION 1008)

1008.2 ILLUMINATION REQUIRED. THE MEANS OF EGRESS SERVING A ROOM OR SPACE SHALL BE ILLUMINATED AT ALL TIMES THAT THE ROOM OR SPACE IS OCCUPIED.

EXCEPTIONS: 1. OCCUPANCIES IN GROUP U.

3. DWELLING UNITS AND SLEEPING UNITS IN GROUPS R-1, R-2 AND R-3. 1008.2.1 ILLUMINATION LEVEL UNDER NORMAL POWER. THE MEANS OF EGRESS ILLUMINATION LEVEL SHALL BE NOT LESS THAN 1 FOOTCANDLE (11 LUX) AT THE WALKING SURFACE.

1008.2.3 EXIT DISCHARGE. ILLUMINATION SHALL BE PROVIDED ALONG THE PATH OF TRAVEL FOR THE EXIT DISCHARGE FROM EACH EXIT TO THE PUBLIC WAY

EXCEPTION

ILLUMINATION SHALL NOT BE REQUIRED WHERE THE PATH OF THE EXIT DISCHARGE MEETS BOTH OF THE FOLLOWING REQUIREMENTS: 1. THE PATH OF EXIT DISCHARGE IS ILLUMINATED FROM THE EXIT TO A SAFE

DISPERSAL AREA COMPLYING WITH SECTION 1028.5 2. A DISPERSAL AREA SHALL BE ILLUMINATED TO A LEVEL NOT LESS THAN 1 FOOTCANDLE (11 LUX) AT THE WALKING SURFACE.

1008.3 EMERGENCY POWER FOR ILLUMINATION NORMALLY BE PROVIDED BY THE PREMISES' ELECTRICAL SUPPLY. 1008.3.1 GENERAL. IN THE EVENT OF POWER SUPPLY FAILURE IN ROOMS AND SPACES THAT REQUIRE TWO OR MORE MEANS OF EGRESS, AN EMERGENCY ELECTRICAL SYSTEM SHALL AUTOMATICALLY ILLUMINATE ALL OF THE FOLLOWING AREAS: 1. AISLES.

3. EXIT ACCESS STAIRWAYS AND RAMPS.

1008.3.2 BUILDINGS. IN THE EVENT OF POWER SUPPLY FAILURE IN

BUILDINGS THAT REQUIRE TWO OR MORE MEANS OF EGRESS, AN EMERGENCY ELECTRICAL SYSTEM SHALL AUTOMATICALLY ILLUMINATE ALL OF THE FOLLOWING AREAS:

- 1. INTERIOR EXIT ACCESS STAIRWAYS AND RAMPS. 2. INTERIOR AND EXTERIOR EXIT STAIRWAYS AND RAMPS.
- 3. EXIT PASSAGEWAYS.
- 4. VESTIBULES AND AREAS ON THE LEVEL OF DISCHARGE USED FOR EXIT DISCHARGE IN ACCORDANCE WITH SECTION 1028.1
- 5. EXTERIOR LANDINGS AS REQUIRED BY SECTION 1010.1.6 FOR EXIT

DOORWAYS THAT LEAD DIRECTLY TO THEEXIT DISCHARGE. 1008.3.3 ROOMS AND SPACES. IN THE EVENT OF POWER SUPPLY FAILURE, AN EMERGENCY ELECTRICAL SYSTEM SHALL AUTOMATICALLY ILLUMINATE ALL OF THE FOLLOWING AREAS:

- 1. ELECTRICAL EQUIPMENT ROOMS. 2. FIRE COMMAND CENTERS.
- 3. FIRE PUMP ROOMS
- 4. GENERATOR ROOMS 5. PUBLIC RESTROOMS WITH AN AREA GREATER THAN 300 SQUARE FEET (27.87 M).

1008.3.4 DURATION. THE EMERGENCY POWER SYSTEM SHALL PROVIDE POWER FOR A DURATION OF NOT LESS THAN 90 MINUTES AND SHALL CONSIST OF STORAGE BATTERIES, UNIT EQUIPMENT OR AN ON-SITE GENERATOR. THE INSTALLATION OF THE EMERGENCY POWER SYSTEM SHALL BE IN ACCORDANCE WITH SECTION 2702

1008.3.5 ILLUMINATION LEVEL UNDER EMERGENCY POWER. EMERGENCY LIGHTING FACILITIES SHALL BE ARRANGED TO PROVIDE INITIAL ILLUMINATION THAT IS NOT LESS THAN AN AVERAGE OF 1 FOOTCANDLE (11 LUX) AND A MINIMUM AT ANY POINT OF 0.1 FOOTCANDLE (1 LUX) MEASURED ALONG THE PATH OF EGRESS AT FLOOR LEVEL. ILLUMINATION LEVELS SHALL BE PERMITTED TO DECLINE TO 0.6 FOOTCANDLE (6 LUX) AVERAGE AND A MINIMUM AT ANY POINT OF 0.06 FOOTCANDLE (0.6 LUX) AT THE END OF THE EMERGENCY LIGHTING TIME DURATION. A MAXIMUM-TO-MINIMUM ILLUMINATION UNIFORMITY RATIO OF 40 TO 1 SHALL NOT BE EXCEEDED. IN GROUP I-2 OCCUPANCIES, FAILURE OF A SINGLE LAMP IN A LUMINAIRE SHALL NOT REDUCE THE ILLUMINATION LEVEL TO LESS THAN 0.2 FOOTCANDLE (2.2 LUX).

DOORS, GATES AND TURNSTILES (SECTION 1010)

1010.1.1 SIZE OF DOORS. THE REQUIRED CAPACITY OF EACH DOOR OPENING SHALL BE SUFFICIENT FOR THEOCCUPANT LOAD THEREOF AND SHALL PROVIDE A MINIMUM CLEAR OPENING WIDTH OF 32 INCHES (813 DOORS SHALL BE MEASURED BETWEEN THE FACE OF THE DOOR AND THE STOP, WITH THE DOOR OPEN 90 DEGREES (1.57 RAD). WHERE THIS SECTION REQUIRES A MINIMUM CLEAR OPENING WIDTH OF 32 INCHES (813 MM) AND A DOOR OPENING INCLUDES TWO DOOR LEAVES WITHOUT A MULLION, ONE LEAF SHALL PROVIDE A MINIMUM CLEAR OPENING WIDTH OF 32 INCHES (813 MM). IN GROUP I-2, DOORS SERVING AS MEANS OF EGRESS DOORS WHERE USED FOR THE MOVEMENT OF BEDS SHALL PROVIDE A MINIMUM CLEAR OPENING WIDTH OF 41 1/2 INCHES (1054 MM). THE MAXIMUM WIDTH OF A SWINGING DOOR LEAF SHALL BE 48 INCHES (1219 MM) NOMINAL. THE MINIMUM CLEAR OPENING HEIGHT OF DOORS SHALL BE NOT LESS THAN 80 INCHES (2032 MM). EXCEPTIONS: 1. IN GROUP R-2 AND R-3 DWELLING AND SLEEPING UNITS THAT ARE NOT REQUIRED TO BE AN ACCESSIBLE UNIT, TYPE A UNIT OR TYPE B UNIT, THE MINIMUM AND MAXIMUM WIDTH SHALL NOT APPLY TO DOOR OPENINGS THAT ARE NOT PART OF THE REQUIRED MEANS OF EGRESS.

7. IN DWELLING AND SLEEPING UNITS THAT ARE NOT REQUIRED TO BE ACCESSIBLE, TYPE A OR TYPE B UNITS, EXTERIOR DOOR OPENINGS OTHER THAN THE REQUIRED EXIT DOOR SHALL HAVE A MINIMUM CLEAR OPENING HEIGHT OF 76 INCHES (1930 MM).

8. IN GROUPS I-1, R-2, R-3 AND R-4, IN DWELLING AND SLEEPING UNITS THAT ARE NOT REQUIRED TO BE ACCESSIBLE, TYPE A OR TYPE B UNITS, THE MINIMUM CLEAR OPENING WIDTHS SHALL NOT APPLY TO INTERIOR EGRESS DOORS.

11. THE MINIMUM CLEAR OPENING WIDTH SHALL NOT APPLY TO DOORS FOR NON-ACCESSIBLE SHOWER OR SAUNA COMPARTMENTS 12. THE MINIMUM CLEAR OPENING WIDTH SHALL NOT APPLY TO THE DOORS FOR NONACCESSIBLE TOILET STALLS.

1010.1.1.1 PROJECTIONS INTO CLEAR WIDTH. THERE SHALL NOT BE PROJECTIONS INTO THE REQUIRED CLEAR OPENING WIDTH LOWER THAN 34 INCHES (864 MM) ABOVE THE FLOOR OR GROUND. PROJECTIONS INTO THE CLEAR OPENING WIDTH BETWEEN 34 INCHES (864 MM) AND 80 INCHES (2032 MM) ABOVE THE FLOOR OR GROUND SHALL NOT EXCEED 4 INCHES (102 MM).

EXCEPTION: DOOR CLOSERS AND DOOR STOPS SHALL BE PERMITTED TO BE 78 INCHES (1980 MM) MINIMUM ABOVE THE FLOOR.

ACCESSIBLE MEANS OF EGRESS (SECTION 1009)

1009.1 ACCESSIBLE MEANS OF EGRESS REQUIRED. ACCESSIBLE MEANS OF EGRESS SHALL COMPLY WITH THIS SECTION. ACCESSIBLE SPACES SHALL BE PROVIDED WITH NOT LESS THAN ONE ACCESSIBLE MEANS OF EGRESS. WHERE MORE THAN ONE MEANS OF EGRESS IS REQUIRED BY SECTION 1006.2 OR 1006.3 FROM ANY ACCESSIBLE SPACE, EACH ACCESSIBLE PORTION OF THE SPACE SHALL BE SERVED BY NOT LESS THAN TWO ACCESSIBLE MEANS OF EGRESS.

• — • \frown $\boldsymbol{\mathcal{O}}$ • \sim \sim \propto q \sim Bl ∞ WILLIAMS PARTNERS ARCHITECTS MAIL P.O.B. 4373

KETCHUM, IDAHO 83340 PHONE 208.726.0020 FAX 208.726.0019 WWW WILLIAMS-PARTNERS.COM

DRAWINGS

DATE: ISSUED: 05/12/2021 COK SCHEMATIC PRESENTATION 06/10/2021 | COK HPC REVIEW 09/30/2021 DESIGN REVIEW 04/22/2022 | PRICING SET 08/05/2022 | PERMIT 08/02/2023 ISSUED FOR CONSTRUCTION REVISIONS

NUMBER: DATE:

CODE INFORMATION

FIRE SAFETY (SECTION 1203)

1203.3 MEANS OF EGRESS. EXISTING DOOR OPENINGS AND CORRIDOR AND STAIRWAY WIDTHS LESS THAN THOSE SPECIFIED ELSEWHERE IN THIS CODE MAY BE APPROVED, PROVIDED THAT, IN THE OPINION OF THE CODE OFFICIAL, THERE IS SUFFICIENT WIDTH AND HEIGHT FOR A PERSON TO PASS THROUGH THE OPENING OR TRAVERSE THE MEANS OF EGRESS. WHERE APPROVED BY THE CODE OFFICIAL, THE FRONT OR MAIN EXIT DOORS NEED NOT SWING IN THE DIRECTION OF THE PATH OF EXIT TRAVEL, PROVIDED THAT OTHER APPROVED MEANS OF EGRESS HAVING SUFFICIENT CAPACITY TO SERVE THE TOTAL OCCUPANT LOAD ARE PROVIDED. STRUCTURAL (SECTION 1205)

[BS] 1205.1 GENERAL. HISTORIC BUILDINGS SHALL COMPLY WITH THE APPLICABLE STRUCTURAL PROVISIONS FOR THE WORK AS CLASSIFIED IN CHAPTER 4 OR 5.

EXCEPTIONS:

1. THE CODE OFFICIAL SHALL BE AUTHORIZED TO ACCEPT EXISTING FLOORS AND EXISTING LIVE LOADS AND TO APPROVE OPERATIONAL CONTROLS THAT LIMIT THE LIVE LOAD ON ANY FLOOR.

2.REPAIR OF SUBSTANTIAL STRUCTURAL DAMAGE IS NOT REQUIRED TO COMPLY WITH SECTIONS 405.2.3 AND 405.2.4. SUBSTANTIAL STRUCTURAL DAMAGE SHALL BE REPAIRED IN ACCORDANCE WITH SECTION 405.2.1. RELOCATED BUILDINGS (SECTION 1206)

1206.1 RELOCATED BUILDINGS. FOUNDATIONS OF RELOCATED HISTORIC BUILDINGS AND STRUCTURES SHALL COMPLY WITH THE INTERNATIONAL BUILDING CODE. RELOCATED HISTORIC BUILDINGS SHALL OTHERWISE BE CONSIDERED A HISTORIC BUILDING FOR THE PURPOSES OF THIS CODE. RELOCATED HISTORIC BUILDINGS AND STRUCTURES SHALL BE SITED SO THAT EXTERIOR WALL AND OPENING REQUIREMENTS COMPLY WITH THE INTERNATIONAL BUILDING CODE OR WITH THE COMPLIANCE ALTERNATIVES OF THIS CODE.

RELOCATED OR MOVED BUILDINGS (CHAPTER 14)

[BS] 1402.2 FOUNDATION. THE FOUNDATION SYSTEM OF RELOCATED BUILDINGS SHALL COMPLY WITH THEINTERNATIONAL BUILDING CODE OR THE INTERNATIONAL RESIDENTIAL CODE AS APPLICABLE [BS] 1402.3 WIND LOADS. BUILDINGS SHALL COMPLY WITH INTERNATIONAL

BUILDING CODE OR INTERNATIONAL RESIDENTIAL CODE WIND PROVISIONS AS APPLICABLE. EXCEPTIONS:

2. STRUCTURAL ELEMENTS WHOSE STRESS IS NOT INCREASED BY MORE THAN 10 PERCENT.

[BS] 1402.4 SEISMIC LOADS. BUILDINGS SHALL COMPLY WITH INTERNATIONAL BUILDING CODE OR INTERNATIONAL RESIDENTIAL CODE SEISMIC PROVISIONS AT THE NEW LOCATION AS APPLICABLE.

EXCEPTIONS: 1. STRUCTURAL ELEMENTS WHOSE STRESS IS NOT INCREASED BY MORE THAN 10 PERCENT

[BS] 1402.5 SNOW LOADS. STRUCTURES SHALL COMPLY WITH INTERNATIONAL BUILDING CODE OR INTERNATIONAL RESIDENTIAL CODE SNOW LOADS AS APPLICABLE WHERE SNOW LOADS AT THE NEW LOCATION ARE HIGHER THAN THOSE AT THE PREVIOUS LOCATION.

EXCEPTION: STRUCTURAL ELEMENTS WHOSE STRESS IS NOT INCREASED BY MORE THAN 5 PERCENT

CODE INFORMATION

2018 INTERNATIONAL EXISTING BUILDING CODE (IEBC)

MECHANICAL (SECTION 808)

808.1 RECONFIGURED OR CONVERTED SPACES. RECONFIGURED SPACES INTENDED FOR OCCUPANCY AND SPACES CONVERTED TO HABITABLE OR OCCUPIABLE SPACE IN ANY WORK AREA SHALL BE PROVIDED WITH NATURAL OR MECHANICAL VENTILATION IN ACCORDANCE WITH THE INTERNATIONAL MECHANICAL CODE.

EXCEPTION: EXISTING MECHANICAL VENTILATION SYSTEMS SHALL COMPLY WITH THE REQUIREMENTS OF SECTION 808.2. 808.2 ALTERED EXISTING SYSTEMS. IN MECHANICALLY VENTILATED SPACES, EXISTING MECHANICAL VENTILATION SYSTEMS THAT ARE ALTERED, RECONFIGURED, OR EXTENDED SHALL PROVIDE NOT LESS THAN 5 CUBIC

FEET PER MINUTE (CFM) (0.0024 M /S) PER PERSON OF OUTDOOR AIR AND NOT LESS THAN 15 CFM (0.0071 M /S) OF VENTILATION AIR PER PERSON; OR NOT LESS THAN THE AMOUNT OF VENTILATION AIR DETERMINED BY THE INDOOR AIR QUALITY PROCEDURE OF ASHRAE 62.1

CHAPTER 9 - LEVEL 3 ALTERATIONS FIRE PROTECTION (SECTION 904)

904.1 AUTOMATIC SPRINKLER SYSTEMS. AN AUTOMATIC SPRINKLER SYSTEM SHALL BE PROVIDED IN AWORK AREA WHERE REQUIRED BY SECTION 802.2 OR THIS SECTION.

904.2 FIRE ALARM AND DETECTION SYSTEMS. FIRE ALARM AND DETECTION SHALL BE PROVIDED IN ACCORDANCE WITH SECTION 907 OF THE INTERNATIONAL BUILDING CODE AS REQUIRED FOR NEW CONSTRUCTION

MEANS OF EGRESS (SECTION 905) 905.1 GENERAL. THE MEANS OF EGRESS SHALL COMPLY WITH THE REQUIREMENTS OFSECTION 805 EXCEPT AS SPECIFICALLY REQUIRED INSECTIONS 905.2 AND 905.3.

STRUCTURAL (SECTION 906)

[BS] 906.2 EXISTING STRUCTURAL ELEMENTS RESISTING LATERAL LOADS. WHERE WORK INVOLVES A SUBSTANTIAL STRUCTURAL ALTERATION, THE LATERAL LOAD-RESISTING SYSTEM OF THE ALTERED BUILDING SHALL BE SHOWN TO SATISFY THE REQUIREMENTS OF SECTIONS 1609 AND 1613 OF THE INTERNATIONAL BUILDING CODE. REDUCED SEISMIC FORCES SHALL BE PERMITTED.

907.1 MINIMUM REQUIREMENTS. LEVEL 3 ALTERATIONS TO EXISTING BUILDINGS OR STRUCTURES ARE PERMITTED WITHOUT REQUIRING THE ENTIRE BUILDING OR STRUCTURE TO COMPLY WITH THE ENERGY REQUIREMENTS OF THE INTERNATIONAL ENERGY CONSERVATION CODE OR INTERNATIONAL RESIDENTIAL CODE. THE ALTERATIONS SHALL CONFORM TO THE ENERGY REQUIREMENTS OF THE INTERNATIONAL ENERGY CONSERVATION CODE OR INTERNATIONAL RESIDENTIAL CODE AS THEY RELATE TO NEW CONSTRUCTION ONLY.

CHAPTER 10 - CHANGE OF OCCUPANCY

GENERAL (SECTION 1001)

1001.2 CERTIFICATE OF OCCUPANCY. A CHANGE OF OCCUPANCY OR A CHANGE OF OCCUPANCY WITHIN A SPACE WHERE THERE IS A DIFFERENT FIRE PROTECTION SYSTEM THRESHOLD REQUIREMENT IN CHAPTER 9 OF THE INTERNATIONAL BUILDING CODE SHALL NOT BE MADE TO ANY STRUCTURE WITHOUT THE APPROVAL OF THE CODE OFFICIAL. A CERTIFICATE OF OCCUPANCY SHALL BE ISSUED WHERE IT HAS BEEN DETERMINED THAT THE REQUIREMENTS FOR THE CHANGE OF OCCUPANCY HAVE BEEN MET.

STRUCTURAL (SECTION 1006) [BS] 1006.1 LIVE LOADS. STRUCTURAL ELEMENTS CARRYING TRIBUTRARY LIVE LOADS FROM AN AREA WITH ACHANGE OF OCCUPANCY SHALL SATISFY THE REQUIREMENTS OF SECTION 1607 OF THE INTERNATIONAL BUILDING CODE. DESIGN LIVE LOADS FOR AREAS OF NEW OCCUPANCY SHALL BE BASED ON SECTION 1607 OF THE INTERNATIONAL BUILDING CODE. DESIGN LIVE LOADS FOR OTHER AREAS SHALL BE PERMITTED TO USE PREVIOUSLY APPROVED DESIGN LIVE LOADS. EXCEPTION: STRUCTURAL ELEMENTS WHOSE DEMAND-CAPACITY RATIO CONSIDERING THE CHANGE OF OCCUPANCY IS NOT MORE THAN 5 PERCENT GREATER THAN THE DEMAND-CAPACITY RATIO

BASED ON PREVIOUSLY APPROVED LIVE LOADS CHANGE OF OCCUPANCY CLASSIFICATION (SECTION 1011 1011.1 GENERAL. THE PROVISIONS OF THIS SECTION SHALL APPLY TO BUILDINGS OR PORTIONS THEREOF UNDERGOING A CHANGE OF OCCUPANCY CLASSIFICATION. THIS INCLUDES A CHANGE OF OCCUPANCY CLASSIFICATION WITHIN A GROUP AS WELL AS A CHANGE OF OCCUPANCY CLASSIFICATION FROM ONE GROUP TO A DIFFERENT GROUP OR WHERE THERE IS A CHANGE OF OCCUPANCY WITHIN A SPACE WHERE THERE IS A

DIFFERENT FIRE PROTECTION SYSTEM THRESHOLD REQUIREMENT IN CHAPTER 9 OF THE INTERNATIONAL BUILDING CODE. SUCH BUILDINGS SHALL ALSO COMPLY WITH SECTIONS 1002 THROUGH 1010 OF THIS CODE. THE APPLICATION OF REQUIREMENTS FOR THE CHANGE OF OCCUPANCY SHALL BE AS SET FORTH IN SECTIONS 1011.1.1 THROUGH 1011.1.4. A CHANGE OF OCCUPANCY, AS DEFINED IN SECTION 202, WITHOUT A CORRESPONDING CHANGE OF OCCUPANCY CLASSIFICATION SHALL COMPLY WITH SECTION 1001.2.

1011.1.1 COMPLIANCE WITH CHAPTER 9. THE REQUIREMENTS OF CHAPTER 9 SHALL BE APPLICABLE THROUGHOUT THE BUILDING FOR THE NEW OCCUPANCY CLASSIFICATION BASED ON THE SEPARATION CONDITIONS SET FORTH IN SECTIONS 1011.1.1.1 AND 1011.1.1.2.

1011.1.1.2 CHANGE OF OCCUPANCY CLASSIFICATION WITH SEPARATION. WHERE A PORTION OF AN EXISTING BUILDING IS CHANGED TO A NEW OCCUPANCY CLASSIFICATION OR WHERE THERE IS A CHANGE OF OCCUPANCY WITHIN A SPACE WHERE THERE IS A DIFFERENT FIRE PROTECTION SYSTEM THRESHOLD REQUIREMENT IN CHAPTER 9 OF THE INTERNATIONAL BUILDING CODE, AND THAT PORTION IS SEPARATED FROM THE REMAINDER OF THE BUILDING WITH FIRE BARRIERS HAVING A FIRE-RESISTANCE RATING AS REQUIRED IN THE INTERNATIONAL BUILDING CODE FOR THE SEPARATE OCCUPANCY, THAT PORTION SHALL COMPLY WITH ALL OF THE REQUIREMENTS OF CHAPTER 9 OF THIS CODE FOR THE NEW OCCUPANCY CLASSIFICATION AND WITH THE REQUIREMENTS OF THIS

CHAPTER. HISTORIC BUILDINGS (CHAPTER 12)

[BS] 1201.2 REPORT. A HISTORIC BUILDING UNDERGOING ALTERATION OR CHANGE OF OCCUPANCY SHALL BE INVESTIGATED AND EVALUATED. IF IT IS INTENDED THAT THE BUILDING MEET THE REQUIREMENTS OF THIS CHAPTER, A WRITTEN REPORT SHALL BE PREPARED AND FILED WITH THE CODE OFFICIAL BY A REGISTERED DESIGN PROFESSIONAL WHERE SUCH A REPORT IS NECESSARY IN THE OPINION OF THE CODE OFFICIAL. SUCH REPORT SHALL BE IN ACCORDANCE WITH CHAPTER 1 AND SHALL IDENTIFY EACH REQUIRED SAFETY FEATURE THAT IS IN COMPLIANCE WITH THIS CHAPTER AND WHERE COMPLIANCE WITH OTHER CHAPTERS OF THESE PROVISIONS WOULD BE DAMAGING TO THE CONTRIBUTING HISTORIC FEATURES. FOR BUILDINGS ASSIGNED TO SEISMIC DESIGN CATEGORY D, E OR F, A STRUCTURAL EVALUATION DESCRIBING, AT A MINIMUM, THE VERTICAL AND HORIZONTAL ELEMENTS OF THE LATERAL FORCE-RESISTING SYSTEM AND ANY STRENGTHS OR WEAKNESSES THEREIN SHALL BE PREPARED. ADDITIONALLY, THE REPORT SHALL DESCRIBE EACH FEATURE THAT IS NOT IN COMPLIANCE WITH THESE PROVISIONS AND SHALL DEMONSTRATE HOW THE INTENT OF THESE PROVISIONS IS COMPLIED WITH IN PROVIDING AN EQUIVALENT LEVEL OF SAFFTY

CODE INFORMATION

2018 INTERNATIONAL EXISTING BUILDING CODE (IEBC)

BUILDING ELEMENTS AND MATERIALS (SECTION 802), CONTINUED 802.6 FIRE-RESISTANCE RATINGS. WHERE APPROVED BY THE CODE OFFICIAL, BUILDINGS WHERE AN AUTOMATIC SPRINKLER SYSTEM INSTALLED IN ACCORDANCE WITH SECTION 903.3.1.1 OR 903.3.1.2 OF THE INTERNATIONAL BUILDING CODE HAS BEEN ADDED, AND THE BUILDING IS NOW SPRINKLERED THROUGHOUT, THE REQUIRED FIRE-RESISTANCE RATINGS OF BUILDING ELEMENTS AND MATERIALS SHALL BE PERMITTED TO MEET THE REQUIREMENTS OF THE CURRENT BUILDING CODE. THE BUILDING IS REQUIRED TO MEET THE OTHER APPLICABLE REQUIREMENTS OF THE INTERNATIONAL BUILDING CODE. PLANS, INVESTIGATION AND EVALUATION REPORTS, AND OTHER DATA SHALL BE SUBMITTED INDICATING WHICH BUILDING ELEMENTS AND MATERIALS THE APPLICANT IS REQUESTING THE CODE OFFICIAL TO REVIEW AND APPROVE FOR DETERMINATION OF APPLYING THE CURRENT BUILDING CODE FIRE-RESISTANCE RATINGS. ANY SPECIAL CONSTRUCTION FEATURES, INCLUDING FIRE-RESISTANCE-RATED ASSEMBLIES AND SMOKE-RESISTIVE ASSEMBLIES, CONDITIONS OF OCCUPANCY, MEANS-OF-EGRESS CONDITIONS, FIRE CODE DEFICIENCIES, APPROVED MODIFICATIONS OR APPROVED ALTERNATIVE MATERIALS, DESIGN AND METHODS OF CONSTRUCTION, AND EQUIPMENT APPLYING TO THE BUILDING THAT IMPACT REQUIRED FIRE-RESISTANCE RATINGS SHALL BE IDENTIFIED IN THE EVALUATION REPORTS SUBMITTED.

FIRE PROTECTION (SECTION 803) 803.2 AUTOMATIC SPRINKLER SYSTEMS. AUTOMATIC SPRINKLER SYSTEMS SHALL BE PROVIDED IN ACCORDANCE WITH THE REQUIREMENTS OF SECTIONS 803.2.1 THROUGH 803.2.4. INSTALLATION REQUIREMENTS SHALL BE IN ACCORDANCE WITH THE INTERNATIONAL BUILDING CODE. 803.4 FIRE ALARM AND DETECTION. AN APPROVED FIRE ALARM SYSTEM SHALL BE INSTALLED IN ACCORDANCE WITH SECTIONS 803.4.1 THROUGH 803.4.3. WHERE AUTOMATIC SPRINKLER PROTECTION IS PROVIDED IN ACCORDANCE WITH SECTION 803.2 AND IS CONNECTED TO THE BUILDING FIRE ALARM SYSTEM, AUTOMATIC HEAT DETECTION SHALL NOT BE REQUIRED. AN APPROVED AUTOMATIC FIRE DETECTION SYSTEM SHALL BE INSTALLED IN ACCORDANCE WITH THE PROVISIONS OF THIS CODE AND NFPA 72. DEVICES, COMBINATIONS OF DEVICES, APPLIANCES, AND EQUIPMENT SHALL BE APPROVED. THE AUTOMATIC FIRE DETECTORS SHALL BE SMOKE DETECTORS, EXCEPT THAT AN APPROVED ALTERNATIVE TYPE OF DETECTOR SHALL BE INSTALLED IN SPACES SUCH AS BOILER ROOMS, WHERE PRODUCTS OF COMBUSTION ARE PRESENT DURING NORMAL OPERATION IN SUFFICIENT

QUANTITY TO ACTUATE A SMOKE DETECTOR. MEANS OF EGRESS (SECTION 805) 805.4.3 DOOR CLOSING. IN ANY WORK AREA, ALL DOORS OPENING ONTO AN EXIT PASSAGEWAY AT GRADE OR AN EXIT STAIRWAY SHALL BE SELF-

CLOSING OR AUTOMATIC-CLOSING BY LISTED CLOSING DEVICES. EXCEPTIONS: 1. WHERE EXIT ENCLOSURE IS NOT REQUIRED BY THE INTERNATIONAL

BUILDING CODE 2. MEANS OF EGRESS WITHIN OR SERVING ONLY A TENANT SPACE THAT IS ENTIRELY OUTSIDE THE WORK AREA.

STRUCTURAL (SECTION 806) [BS] 806.2 EXISTING STRUCTURAL ELEMENTS CARRYING GRAVITY LOADS. ANY EXISTING GRAVITY LOAD-CARRYING STRUCTURAL ELEMENT FOR WHICH AN ALTERATION CAUSES AN INCREASE IN DESIGN DEAD, LIVE OR SNOW LOAD, INCLUDING SNOW DRIFT EFFECTS, OF MORE THAN 5 PERCENT SHALL BE REPLACED OR ALTERED AS NEEDED TO CARRY THE GRAVITY LOADS REQUIRED BY THE INTERNATIONAL BUILDING CODE FOR NEW STRUCTURES. ANY EXISTING GRAVITY LOAD-CARRYING STRUCTURAL ELEMENT WHOSE GRAVITY LOAD-CARRYING CAPACITY IS DECREASED AS PART OF THE ALTERATION SHALL BE SHOWN TO HAVE THE CAPACITY TO RESIST THE APPLICABLE DESIGN DEAD, LIVE AND SNOW LOADS, INCLUDING SNOW DRIFT EFFECTS, REQUIRED BY THE INTERNATIONAL BUILDING CODE FOR NEW STRUCTURES. EXCEPTIONS

1. BUILDINGS OF GROUP R OCCUPANCY WITH NOT MORE THAN FIVE DWELLING OR SLEEPING UNITS USED SOLELY FOR RESIDENTIAL PURPOSES WHERE THE ALTERED BUILDING COMPLIES WITH THE CONVENTIONAL LIGHT-FRAME CONSTRUCTION METHODS OF THE INTERNATIONAL BUILDING CODE OR THE PROVISIONS OF THE INTERNATIONAL RESIDENTIAL CODE. 2. BUILDINGS IN WHICH THE INCREASED DEAD LOAD IS ATTRIBUTABLE TO THE ADDITION OF A SECOND LAYER OF ROOF COVERING WEIGHING 3 POUNDS PER SQUARE FOOT (0.1437 KN/M) OR LESS OVER AN EXISTING SINGLE LAYER OF ROOF COVERING

[BS] 806.3 EXISTING STRUCTURAL ELEMENTS RESISTING LATERAL LOADS. EXCEPT AS PERMITTED BY SECTION 806.4, WHERE THE ALTERATION INCREASES DESIGN LATERAL LOADS, OR WHERE THE ALTERATION RESULTS IN PROHIBITED STRUCTURAL IRREGULARITY AS DEFINED IN ASCE 7, OR WHERE THE ALTERATION DECREASES THE CAPACITY OF ANY EXISTING LATERAL LOAD-CARRYING STRUCTURAL ELEMENT, THE STRUCTURE OF THE ALTERED BUILDING OR STRUCTURE SHALL MEET THE REQUIREMENTS OF SECTIONS 1609 AND 1613 OF THE INTERNATIONAL BUILDING CODE. REDUCED SEISMIC FORCES SHALL BE PERMITTED.

EXCEPTION: ANY EXISTING LATERAL LOAD-CARRYING STRUCTURAL ELEMENT WHOSE DEMAND-CAPACITY RATIO WITH THE ALTERATION CONSIDERED IS NOT MORE THAN 10 PERCENT GREATER THAN ITS DEMAND-CAPACITY RATIO WITH THE ALTERATION IGNORED SHALL BE PERMITTED TO REMAIN UNALTERED. FOR PURPOSES OF CALCULATING DEMAND-CAPACITY RATIOS, THE DEMAND SHALL CONSIDER APPLICABLE LOAD COMBINATIONS WITH DESIGN LATERAL LOADS OR FORCES IN ACCORDANCE WITH SECTIONS 1609 AND 1613 OF THE INTERNATIONAL BUILDING CODE. REDUCED SEISMIC FORCES SHALL BE PERMITTED. FOR PURPOSES OF THIS EXCEPTION, COMPARISONS OF DEMAND-CAPACITY RATIOS AND CALCULATION OF DESIGN LATERAL LOADS, FORCES AND CAPACITIES SHALL ACCOUNT FOR THE CUMULATIVE EFFECTS OF ADDITIONS AND ALTERATIONS SINCE ORIGINAL CONSTRUCTION. [BS] 806.4 VOLUNTARY LATERAL FORCE-RESISTING SYSTEM ALTERATIONS. STRUCTURAL ALTERATIONS THAT ARE INTENDED EXCLUSIVELY TO IMPROVE THE LATERAL FORCE-RESISTING SYSTEM AND ARE NOT REQUIRED BY OTHER SECTIONS OF THIS CODE SHALL NOT BE REQUIRED TO MEET THE REQUIREMENTS OF SECTION 1609 OR SECTION 1613 OF THE INTERNATIONAL BUILDING CODE, PROVIDED THAT THE FOLLOWING CONDITIONS ARE MET: 1. THE CAPACITY OF EXISTING STRUCTURAL SYSTEMS TO RESIST FORCES IS NOT REDUCED. 2. NEW STRUCTURAL ELEMENTS ARE DETAILED AND CONNECTED TO EXISTING OR NEW STRUCTURAL ELEMENTS AS REQUIRED BY THE INTERNATIONAL BUILDING CODE FOR NEW CONSTRUCTION. 3. NEW OR RELOCATED NONSTRUCTURAL ELEMENTS ARE DETAILED AND CONNECTED TO EXISTING OR NEW STRUCTURAL ELEMENTS AS REQUIRED BY THE INTERNATIONAL BUILDING CODE FOR NEW CONSTRUCTION. 4. THE ALTERATIONS DO NOT CREATE A STRUCTURAL IRREGULARITY AS DEFINED IN ASCE 7 OR MAKE AN EXISTING STRUCTURAL

IRREGULARITY MORE SEVERE ELECTRICAL (SECTION 807)

807.1 NEW INSTALLATIONS. NEWLY INSTALLED ELECTRICAL EQUIPMENT AND WIRING RELATING TO WORK DONE IN ANYWORK AREA SHALL COMPLY WITH ALL APPLICABLE REQUIREMENTS OF NFPA 70 EXCEPT AS PROVIDED FOR IN SECTION 807.3.

CODE INFORMATION

2018 INTERNATIONAL EXISTING BUILDING CODE (IEBC)

SCOPE AND ADMINISTRATION (SECTION 101) [A] 101.4 APPLICABILITY. THIS CODE SHALL APPLY TO THE REPAIR, ALTERATION, CHANGE OF OCCUPANCY, ADDITION AND RELOCATION OF EXISTING BUILDINGS, REGARDLESS OF OCCUPANCY, SUBJECT TO THE CRITERIA OF SECTIONS 101.4.1 AND 101.4.2. SECTION 604 ALTERATION-LEVEL 3 604.1 SCOPE. LEVEL 3 ALTERATIONS APPLY WHERE THE WORK AREA EXCEEDS 50 PERCENT OF THE BUILDING AREA. 604.2 APPLICATION. LEVEL 3 ALTERATIONS SHALL COMPLY WITH THE PROVISIONS OF CHAPTERS 7 AND 8 FOR LEVEL 1 AND 2 ALTERATIONS, RESPECTIVELY, AS WELL AS THE PROVISIONS OF CHAPTER 9. CHAPTER 7 - LEVEL 1 ALTERATIONS 702.1 INTERIOR FINISHES. NEWLY INSTALLED INTERIOR WALL, FLOOR, TRIM AND CEILING FINISHES SHALL COMPLY WITH CHAPTER 8 OF THE INTERNATIONAL BUILDING CODE. 702.6 MATERIALS AND METHODS. NEW WORK SHALL COMPLY WITH THE MATERIALS AND METHODS REQUIREMENTS IN THE INTERNATIONAL BUILDING CODE, INTERNATIONAL ENERGY CONSERVATION CODE, INTERNATIONAL MECHANICAL CODE, AND INTERNATIONAL PLUMBING CODE, AS APPLICABLE, THAT SPECIFY MATERIAL STANDARDS, DETAIL OF INSTALLATION AND CONNECTION, JOINTS, PENETRATIONS, AND CONTINUITY OF ANY ELEMENT, COMPONENT, OR SYSTEM IN THE BUILDING. FIRE PROTECTION (SECTION 703) AND MEANS OF EGRESS (SECTION 704) 703.1, 704.1 GENERAL. ALTERATIONS SHALL BE DONE IN A MANNER THAT MAINTAINS THE LEVEL OF FIRE PROTECTION AND MEANS OF EGRESS PROVIDED.

REROOFING (SECTION 705) [BS] 705.1 GENERAL. MATERIALS AND METHODS OF APPLICATION USED FOR RECOVERING OR REPLACING AN EXISTING ROOF COVERING SHALL COMPLY WITH THE REQUIREMENTS OF CHAPTER 15 OF THE INTERNATIONAL BUILDING CODE

[BS] 705.2 STRUCTURAL AND CONSTRUCTION LOADS. STRUCTURAL ROOF COMPONENTS SHALL BE CAPABLE OF SUPPORTING THE ROOF-COVERING SYSTEM AND THE MATERIAL AND EQUIPMENT LOADS THAT WILL BE ENCOUNTERED DURING INSTALLATION OF THE SYSTEM. [BS] 705.3 ROOF REPLACEMENT. ROOF REPLACEMENT SHALL INCLUDE THE

REMOVAL OF ALL EXISTING LAYERS OF ROOF COVERINGS DOWN TO THE ROOF DECK. EXCEPTION: WHERE THE EXISTING ROOF ASSEMBLY INCLUDES AN ICE BARRIER MEMBRANE THAT IS ADHERED TO THE ROOF DECK, THE EXISTING ICE BARRIER MEMBRANE SHALL BE PERMITTED TO REMAIN IN PLACE AND COVERED WITH AN ADDITIONAL LAYER OF ICE BARRIER MEMBRANE IN ACCORDANCE WITH SECTION 1507 OF THE INTERNATIONAL BUILDING CODE. [BS] 705.3.1 ROOF RECOVER. THE INSTALLATION OF A NEW ROOF COVERING OVER AN EXISTING ROOF COVERING SHALL BE PERMITTED WHERE ANY OF THE FOLLOWING CONDITIONS OCCUR: 1. THE NEW ROOF COVERING IS INSTALLED IN ACCORDANCE WITH THE ROOF COVERING MANUFACTURER'S APPROVED INSTRUCTIONS. 2. COMPLETE AND SEPARATE ROOFING SYSTEMS, SUCH AS STANDING-SEAM METAL ROOF PANEL SYSTEMS, THAT ARE DESIGNED TO TRANSMIT THE ROOF LOADS DIRECTLY TO THE BUILDING'S STRUCTURAL SYSTEM AND THAT DO NOT RELY ON EXISTING ROOFS AND ROOF COVERINGS FOR SUPPORT, ARE INSTALLED

3. METAL PANEL, METAL SHINGLE AND CONCRETE AND CLAY TILE ROOF COVERINGS ARE INSTALLED OVER EXISTING WOOD SHAKE ROOFS IN ACCORDANCE WITH SECTION 705.4. 4. A NEW PROTECTIVE ROOF COATING IS APPLIED OVER AN EXISTING PROTECTIVE ROOF COATING, A METAL ROOF PANEL, METAL ROOF SHINGLES, MINERAL-SURFACED ROLL ROOFING, A BUILT-UP ROOF MODIFIED BITUMEN ROOFING, THERMOSET AND THERMOPLASTIC SINGLE-PLY ROOFING OR A SPRAY POLYURETHANE FOAM ROOFING SYSTEM [BS] 705.3.1.1 EXCEPTIONS. A ROOF RECOVER SHALL NOT BE PERMITTED WHERE ANY OF THE FOLLOWING CONDITIONS OCCUR: 1. THE EXISTING ROOF OR ROOF COVERING IS WATER SOAKED OR HAS DETERIORATED TO THE POINT THAT THE EXISTING ROOF OR ROOF COVERING IS NOT ADEQUATE AS A BASE FOR ADDITIONAL ROOFING. 2. THE EXISTING ROOF COVERING IS SLATE, CLAY, CEMENT OR ASBESTOS-CEMENT TILE. 3. THE EXISTING ROOF HAS TWO OR MORE APPLICATIONS OF ANY TYPE OF ROOF COVERING.

STRUCTURAL (SECTION 706) [BS] 706.2 ADDITION OR REPLACEMENT OF ROOFING OR REPLACEMENT OF EQUIPMENT. ANY EXISTING GRAVITY LOAD-CARRYING STRUCTURAL ELEMENT FOR WHICH AN ALTERATION CAUSES AN INCREASE IN DESIGN DEAD, LIVE OR SNOW LOAD, INCLUDING SNOW DRIFT EFFECTS, OF MORE THAN 5 PERCENT SHALL BE REPLACED OR ALTERED AS NEEDED TO CARRY THE GRAVITY LOADS REQUIRED BY THE INTERNATIONAL BUILDING CODE FOR NEW STRUCTURES.

CHAPTER 8 - LEVEL 2 ALTERATIONS GENERAL (SECTION 801)

OUTSIDE THE WORK AREA.

801.3 COMPLIANCE. NEW CONSTRUCTION ELEMENTS, COMPONENTS, SYSTEMS, AND SPACES SHALL COMPLY WITH THE REQUIREMENTS OF THE INTERNATIONAL BUILDING CODE. EXCEPTIONS:

1. WHERE WINDOWS ARE ADDED THEY ARE NOT REQUIRED TO COMPLY WITH THE LIGHT AND VENTILATION REQUIREMENTS OF THE INTERNATIONAL BUILDING CODE.

2. NEWLY INSTALLED ELECTRICAL EQUIPMENT SHALL COMPLY WITH THE **REQUIREMENTS OF SECTION 807.** 3. THE LENGTH OF DEAD-END CORRIDORS IN NEWLY CONSTRUCTED SPACES SHALL ONLY BE REQUIRED TO COMPLY WITH THE PROVISIONS OF

SECTION 805.6. 4. THE MINIMUM CEILING HEIGHT OF THE NEWLY CREATED HABITABLE AND OCCUPIABLE SPACES AND CORRIDORS SHALL BE 7 FEET (2134 MM). 6. NEW STRUCTURAL MEMBERS AND CONNECTIONS SHALL BE PERMITTED TO COMPLY WITH ALTERNATIVE DESIGN CRITERIA IN ACCORDANCE WITH

SECTION 302. BUILDING ELEMENTS AND MATERIALS (SECTION 802) 802.4 INTERIOR FINISH. THE INTERIOR FINISH OF WALLS AND CEILINGS IN EXITS AND CORRIDORS IN ANY WORK AREA SHALL COMPLY WITH THE REQUIREMENTS OF THE INTERNATIONAL BUILDING CODE. EXCEPTION: EXISTING INTERIOR FINISH MATERIALS THAT DO NOT COMPLY WITH THE INTERIOR FINISH REQUIREMENTS OF THE INTERNATIONAL BUILDING CODE SHALL BE PERMITTED TO BE TREATED WITH AN APPROVED FIRE-RETARDANT COATING IN ACCORDANCE WITH THE MANUFACTURER'S INSTRUCTIONS TO ACHIEVE THE REQUIRED RATING. 802.4.1 SUPPLEMENTAL INTERIOR FINISH REQUIREMENTS. WHERE THE WORK AREA ON ANY FLOOR EXCEEDS 50 PERCENT OF THE FLOOR AREA, SECTION 802.4 SHALL APPLY TO THE INTERIOR FINISH IN EXITS AND CORRIDORS SERVING THE WORK AREA THROUGHOUT THE FLOOR. EXCEPTION: INTERIOR FINISH WITHIN TENANT SPACES THAT ARE ENTIRELY

CODE INFORMATION

2018 INTERNATIONAL ENERGY CONSERVATION CODE (IECC AS AMENDED BY THE IDAHO BUILDING CODE BOARD PER CITY OF KETCHUM MUNICIPAL CODE 15.04.010 CODES ADOPTED

SCOPE AND ADMINISTRATION (SECTION R101) R101.4.1 MIXED RESIDENTIAL AND COMMERCIAL BUILDINGS. WHERE A BUILDING INCLUDES BOTH RESIDENTIAL BUILDING AND COMMERCIAL BUILDING PORTIONS, EACH PORTION SHALL BE SEPARATELY CONSIDERED AND MEET THE APPLICABLE PROVISIONS OF THE IECC-COMMERCIAL PROVISIONS OR IECC-RESIDENTIAL PROVISIONS.

<u>CLIMATE ZONE</u>:

TABLE R402.1.2 (AMENDED BY IDAHO BUILDING CODE BOARD), INSULATION AND FENESTRATION REQUIREMENTS BY COMPONENT FENESTRATION U-FACTOR: 0.30

	0.00
SKYLIGHT U-FACTOR:	0.55
CEILING R-VALUE:	49
WOOD FRAME WALL R-VALUE:	22 OR 13+5ci
MASS WALL R-VALUE:	15 (CONTINOUS) / 20 (CAVITY)
FLOOR R-VALUE:	30
BASEMENT WALL R-VALUE:	15 (CONINUOUS) / 19 (CAVITY)
SLAB R-VALUE & DEPTH:	10, 4 FT
CRAWLSPACE WALL R-VALUE:	15 (CONTINOUS) / 19 (CAVITY)

TABLE R402.6 (AMENDED BY IDAHO BUILDING CODE BOARD), LOG HOME PRESCRIPTIVE THERMAL ENVELOPE REQUIREMENTS BY

COMPONENT		
FENESTRATION U-FA	ACTOR: 0.30	
SKYLIGHT U-FACTO	R: 0.60	
CEILING R-VALUE:	49	
MIN AVERAGE LOG	SIZE: 8 INCH	IES
FLOOR R-VALUE:	30	
BASEMENT WALL R-V	/ALUE: 15 (CC	NINUOUS) / 19 (CAVITY)
SLAB R-VALUE & DEP	TH: 10,4 F	Т
CRAWLSPACE WALL	R-VALUE: 10 (CC	NTINOUS) / 13 (CAVITY)

CITY OF KETCHUM REQUIREMENTS

NATIONAL GREEN BUILDING STANDARD (NGBS) SILVER CERTIFICATION DOCUMENTATION VERIFIED BY A NAHB

VFRIFIFR PRESCRIPTIVE PATH, PERFORMANCE PATH, COMCHECK OR RESCHECK, <u>OR</u> IECC SECTION C406 ADDITIONAL EFFICIENCY PACKAGE OPTIONS

EXTERIOR ENERGY CONSERVATION (KETCHUM 15.20.050)

SNOWMELT REQUIREMENTS - INSULATE BELOW AND PERIMETER WITH MINIMUM R-10 STRUCTURAL INSULATION

- MINIMUM 92 PERCENT EFFICIENCY BOILER

AUTOMATED CONTROLS CAPABLE OF SHUTTING OFF THE SYSTEM WITH THE PAVEMENT TEMPERATURE IS ABOVE 50 DEGREES AND NO PRECIP IS FALLING AND AN AUTOMATIC OR MANUAL CONTROL THAT WILL ALLOW SHUTOFF WHEN THE OUTDOOR TEMPERATURE IS ABOVE 40 DEGREES - POSITIVE DRAINAGE OFF DRIVEWAY (USE GEOFABRIC UNDER PAVERS)


DRAWINGS

WWW WILLIAMS-PARTNERS.COM

DATE: ISSUED: 05/12/2021 COK SCHEMATIC PRESENTATION 06/10/2021 | COK HPC REVIEW 09/30/2021 DESIGN REVIEW 04/22/2022 | PRICING SET 08/05/2022 | PERMIT 08/02/2023 ISSUED FOR CONSTRUCTION REVISIONS

NUMBER: DATE:




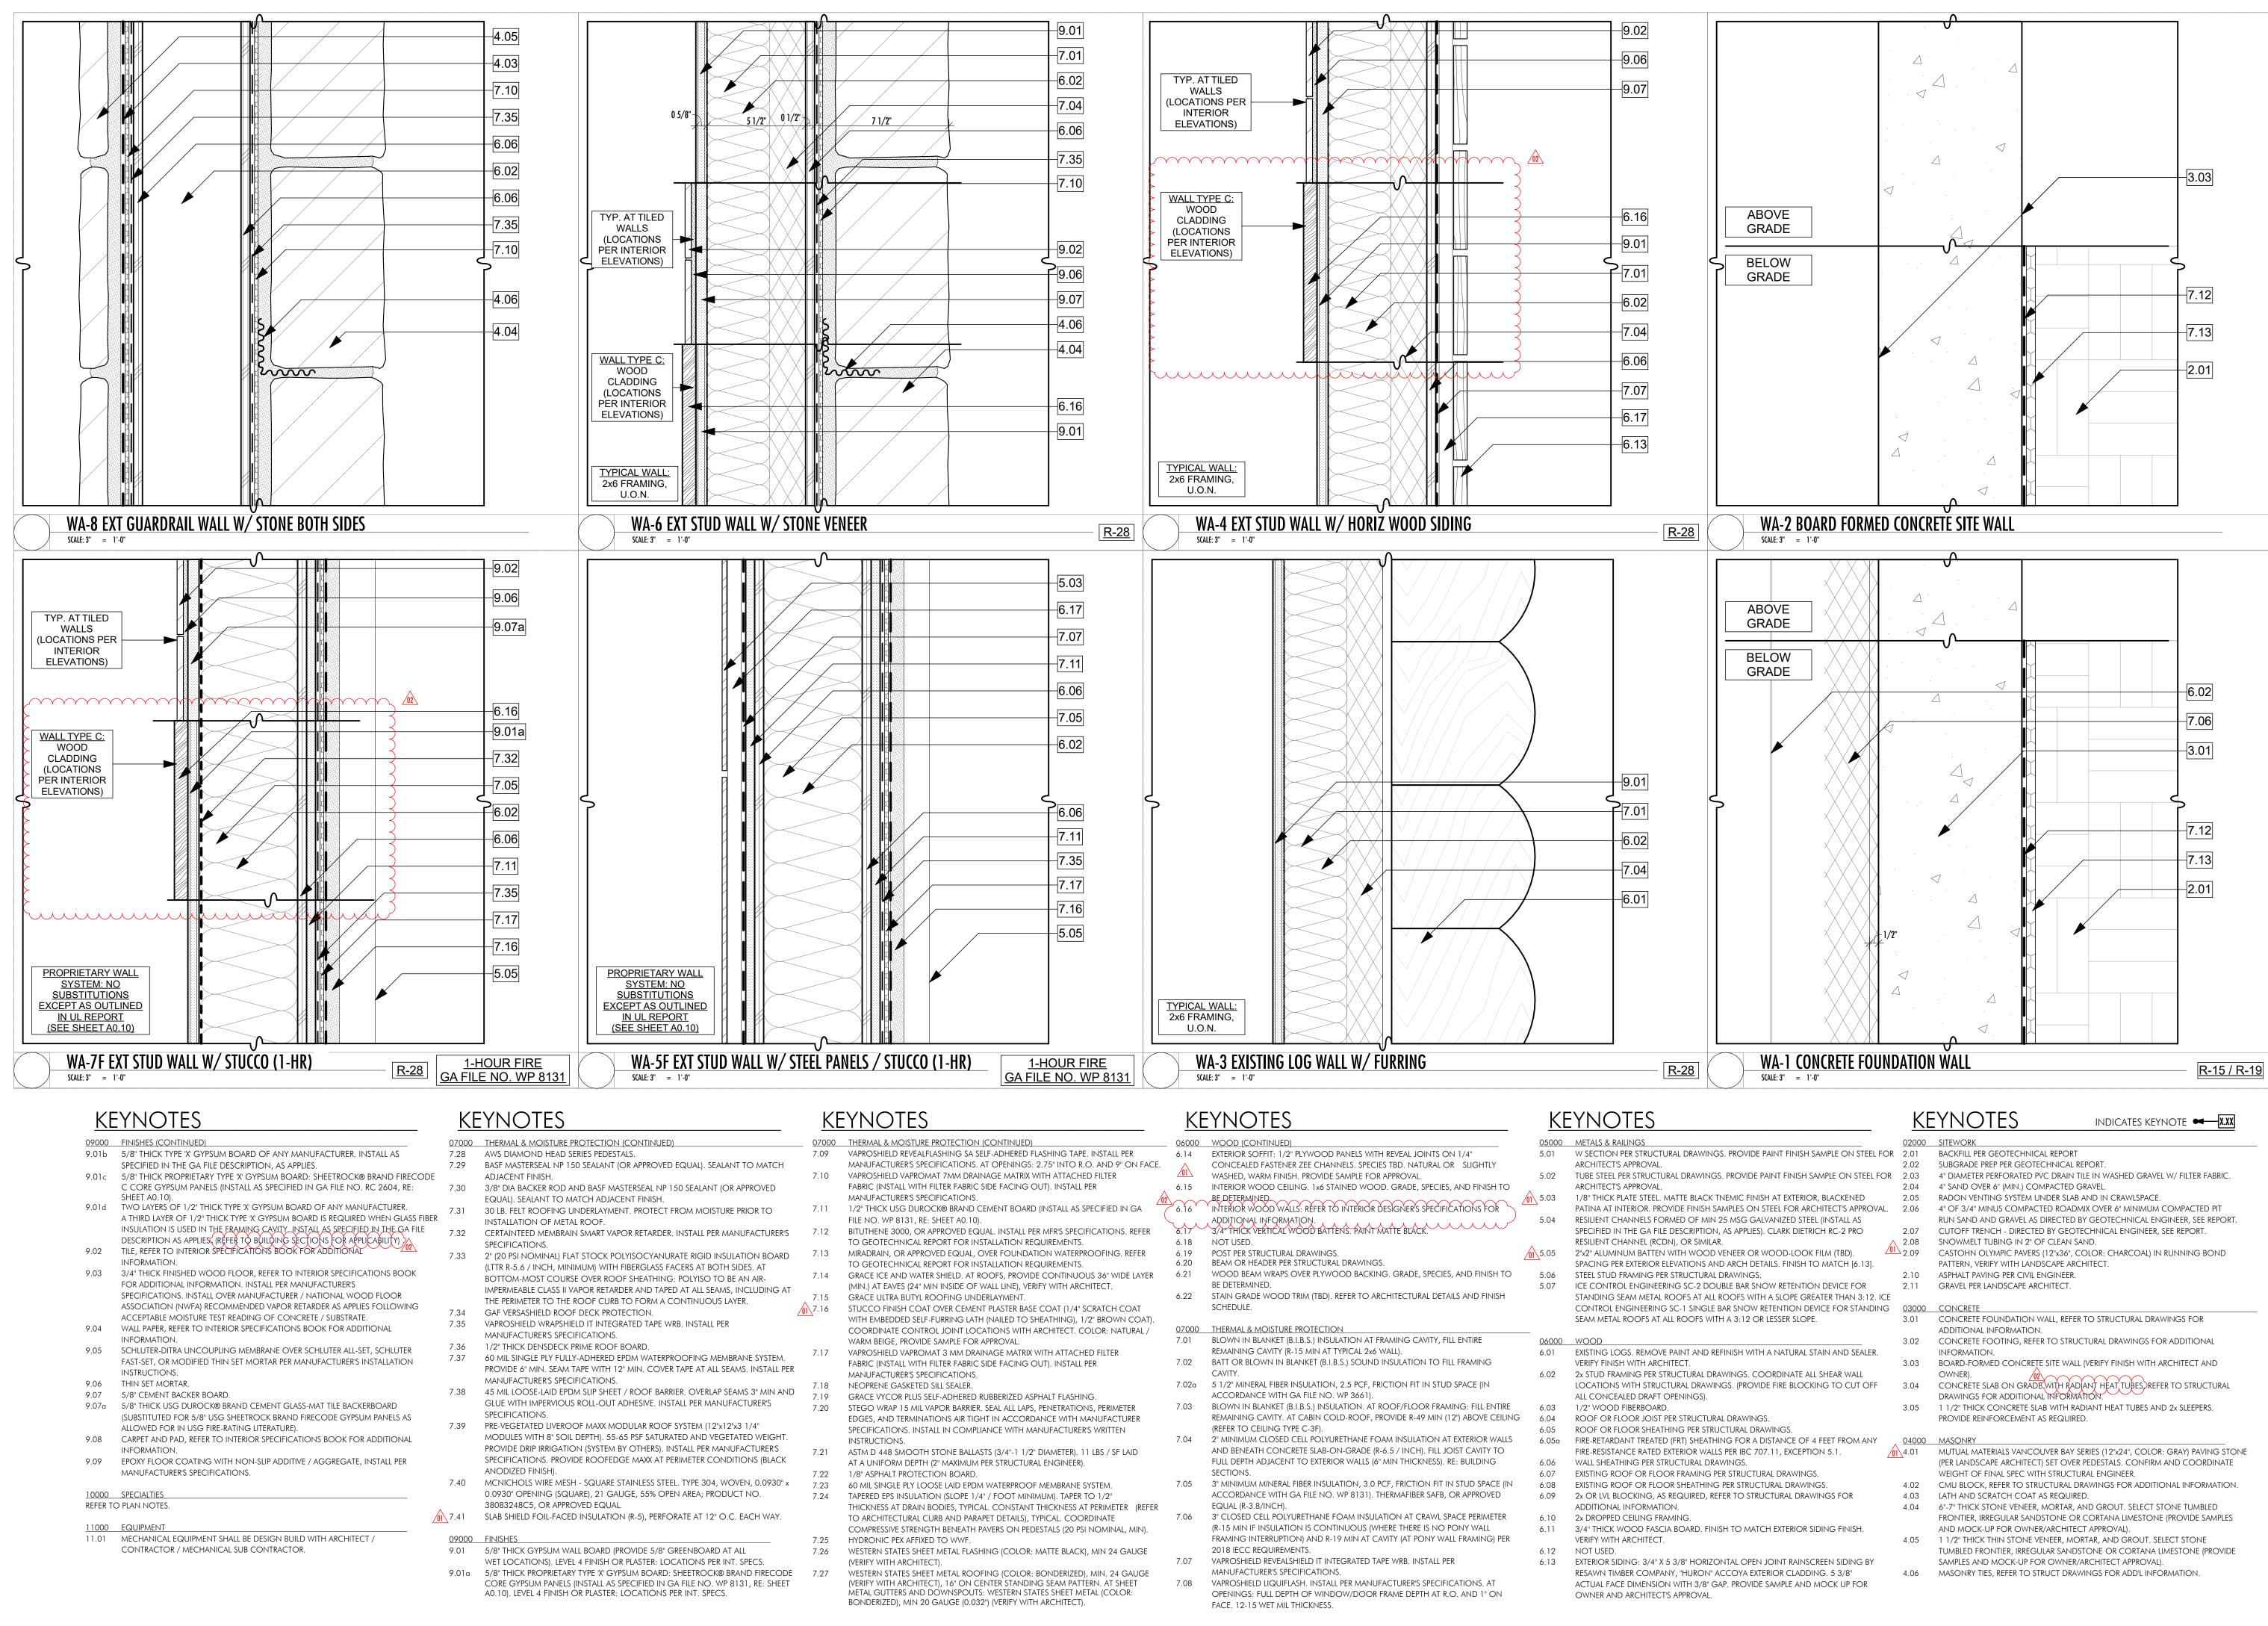





	DRAWINGS
DATE:	ISSUED:
04/18/2022	PRICING SET
08/05/2022	PERMIT
08/02/2023	ISSUED FOR CONSTRUCT

REVISIONS NUMBER: DATE: 01 02/17/2023 02 08/02/2023

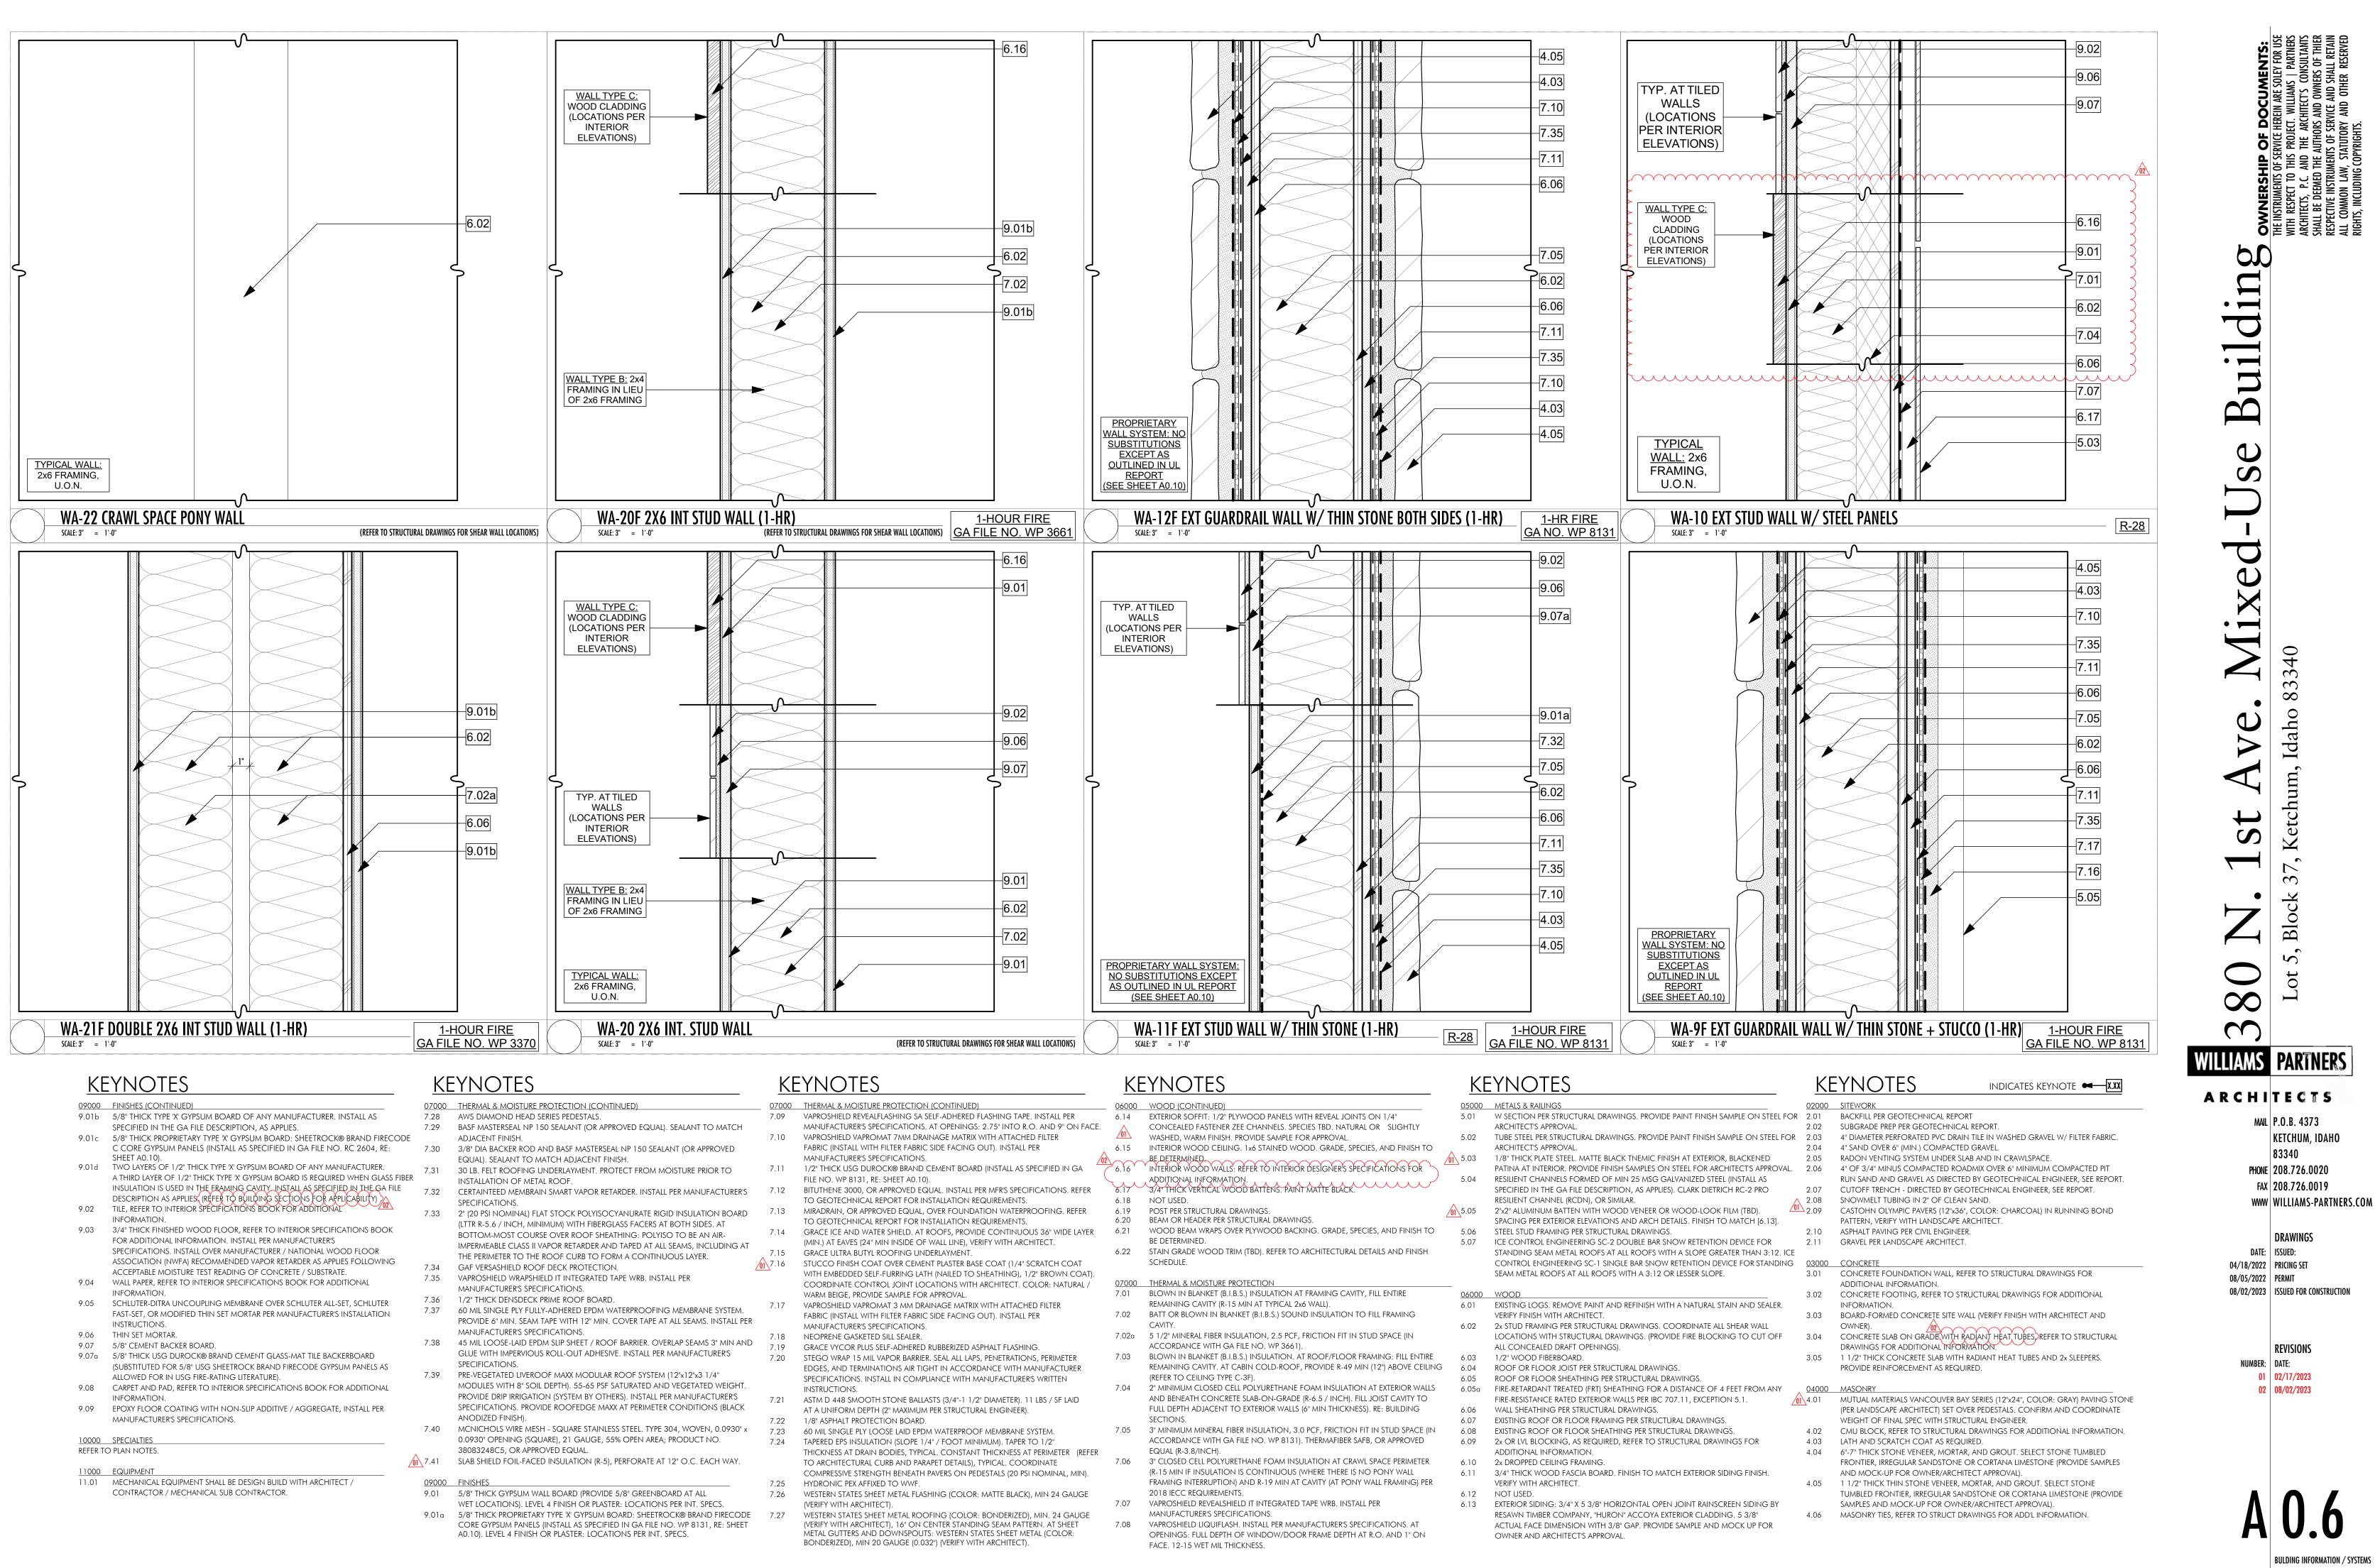

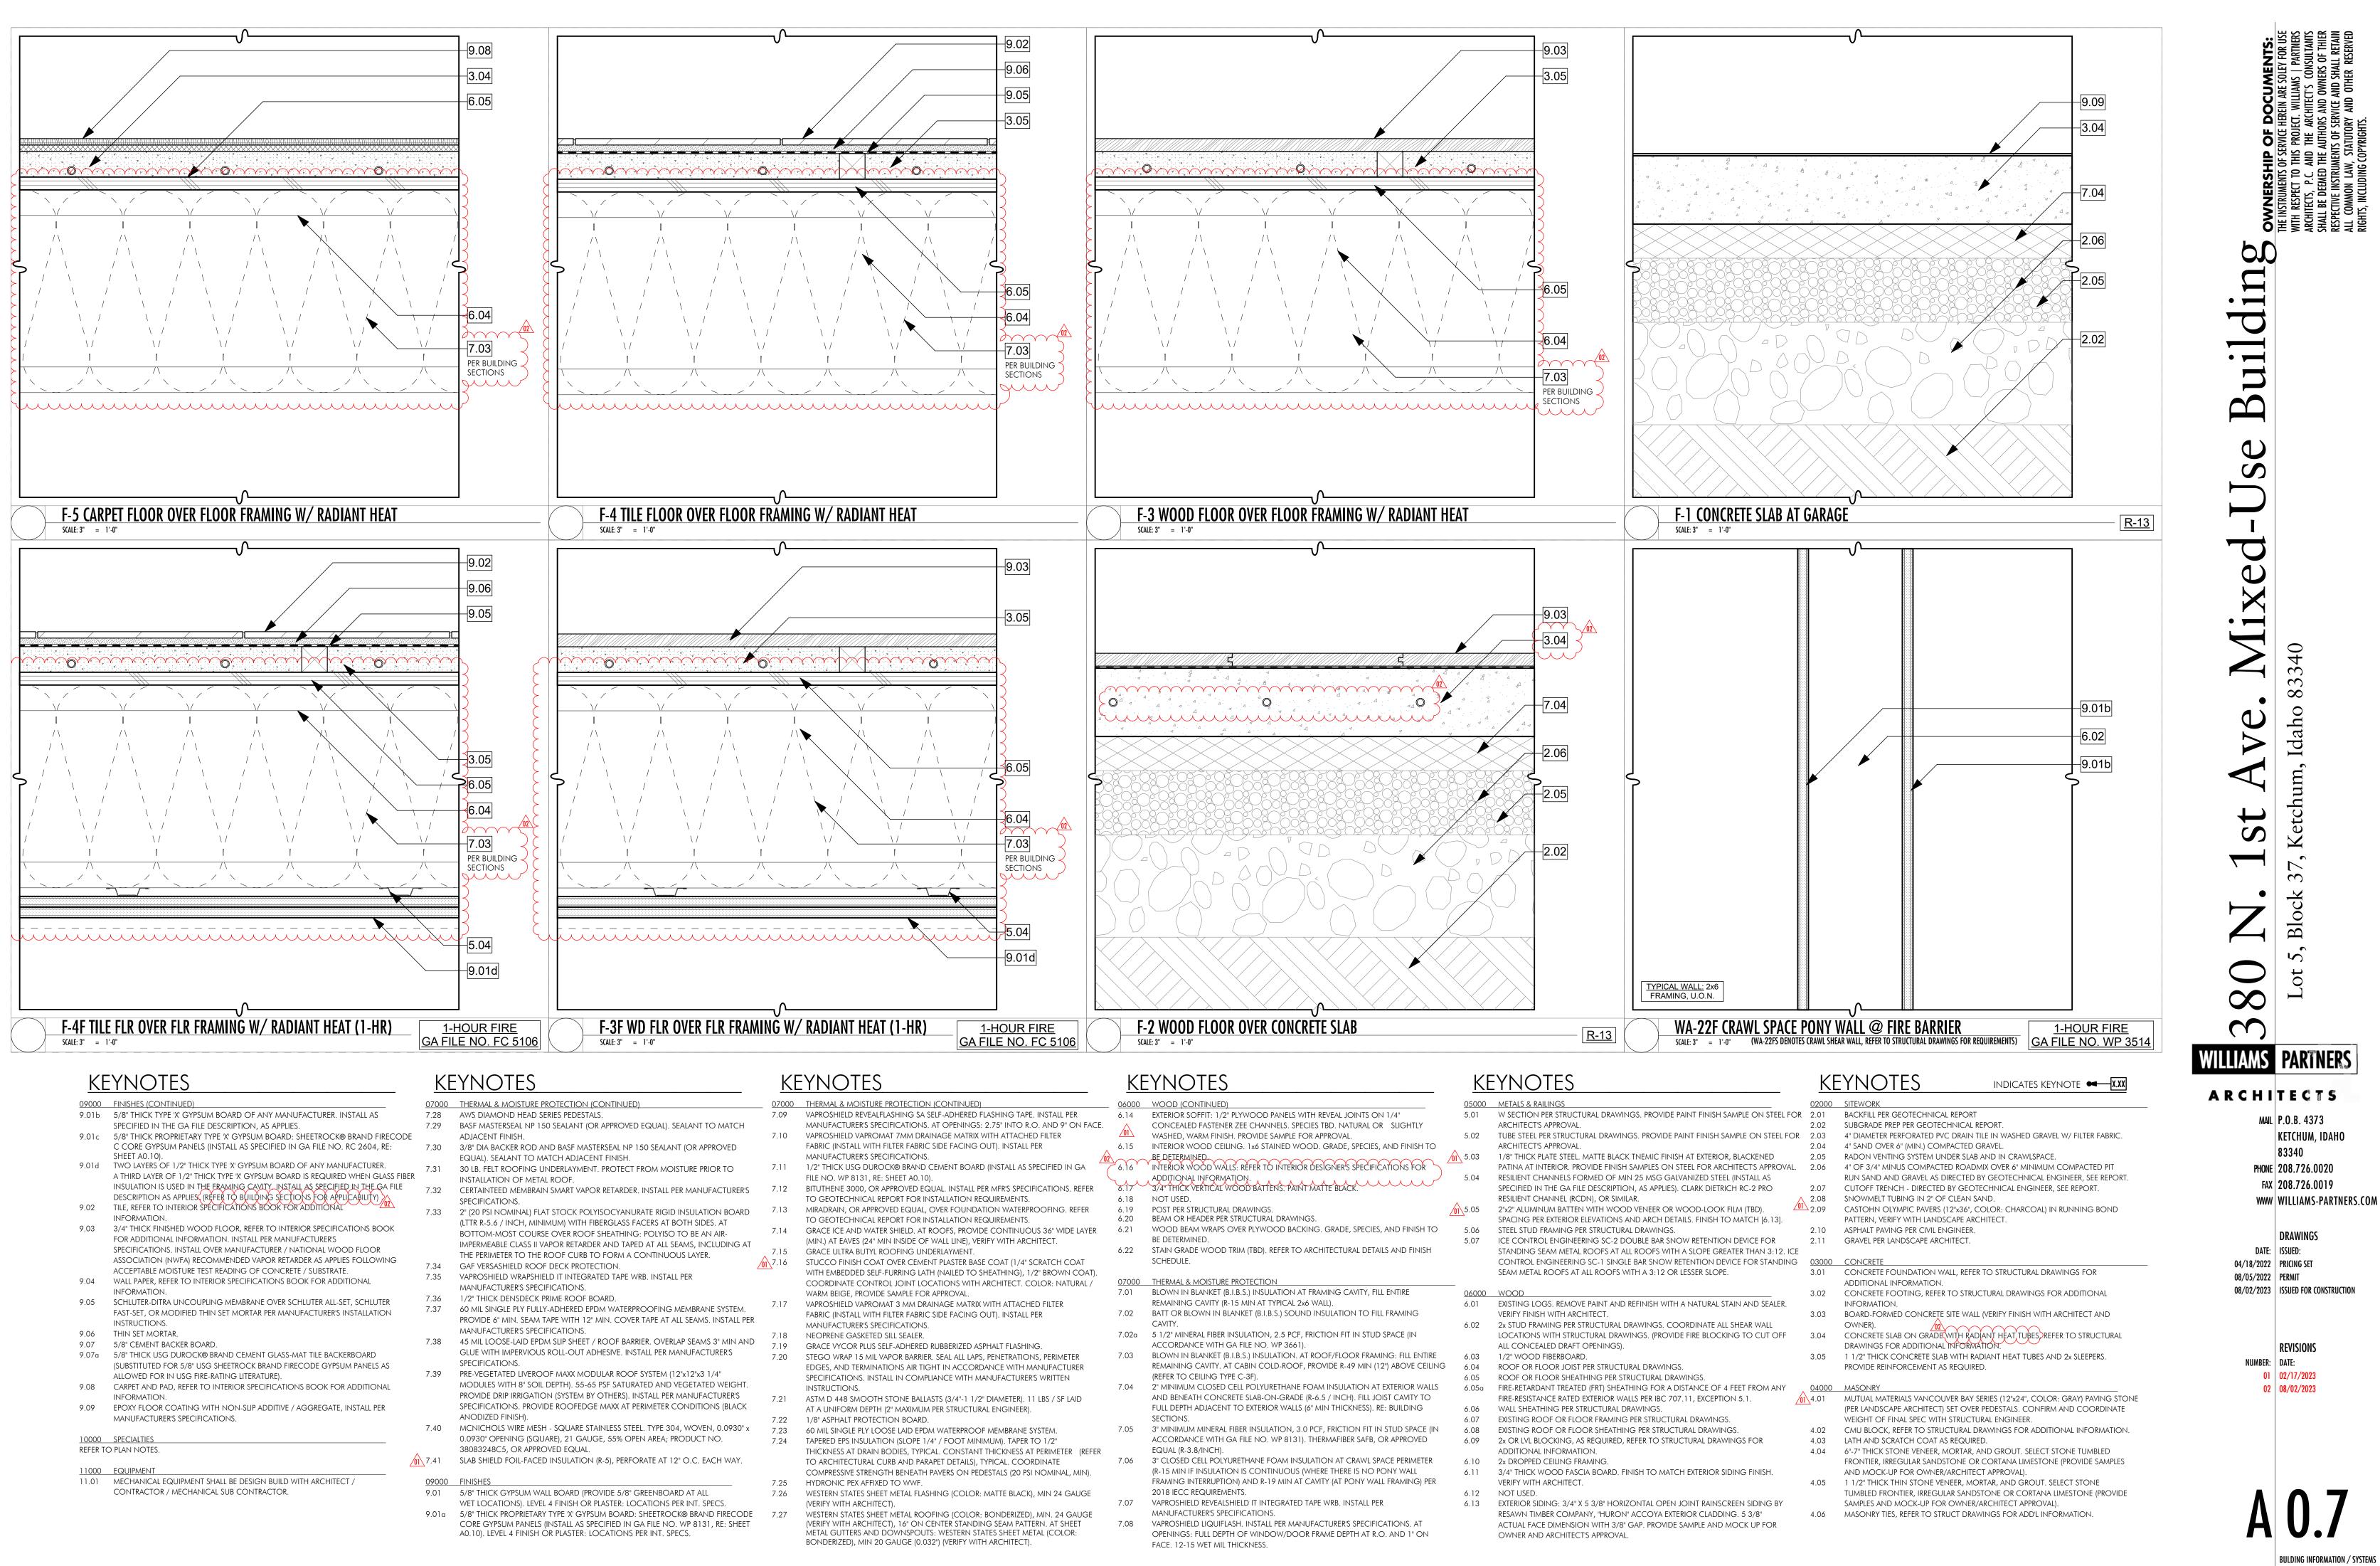


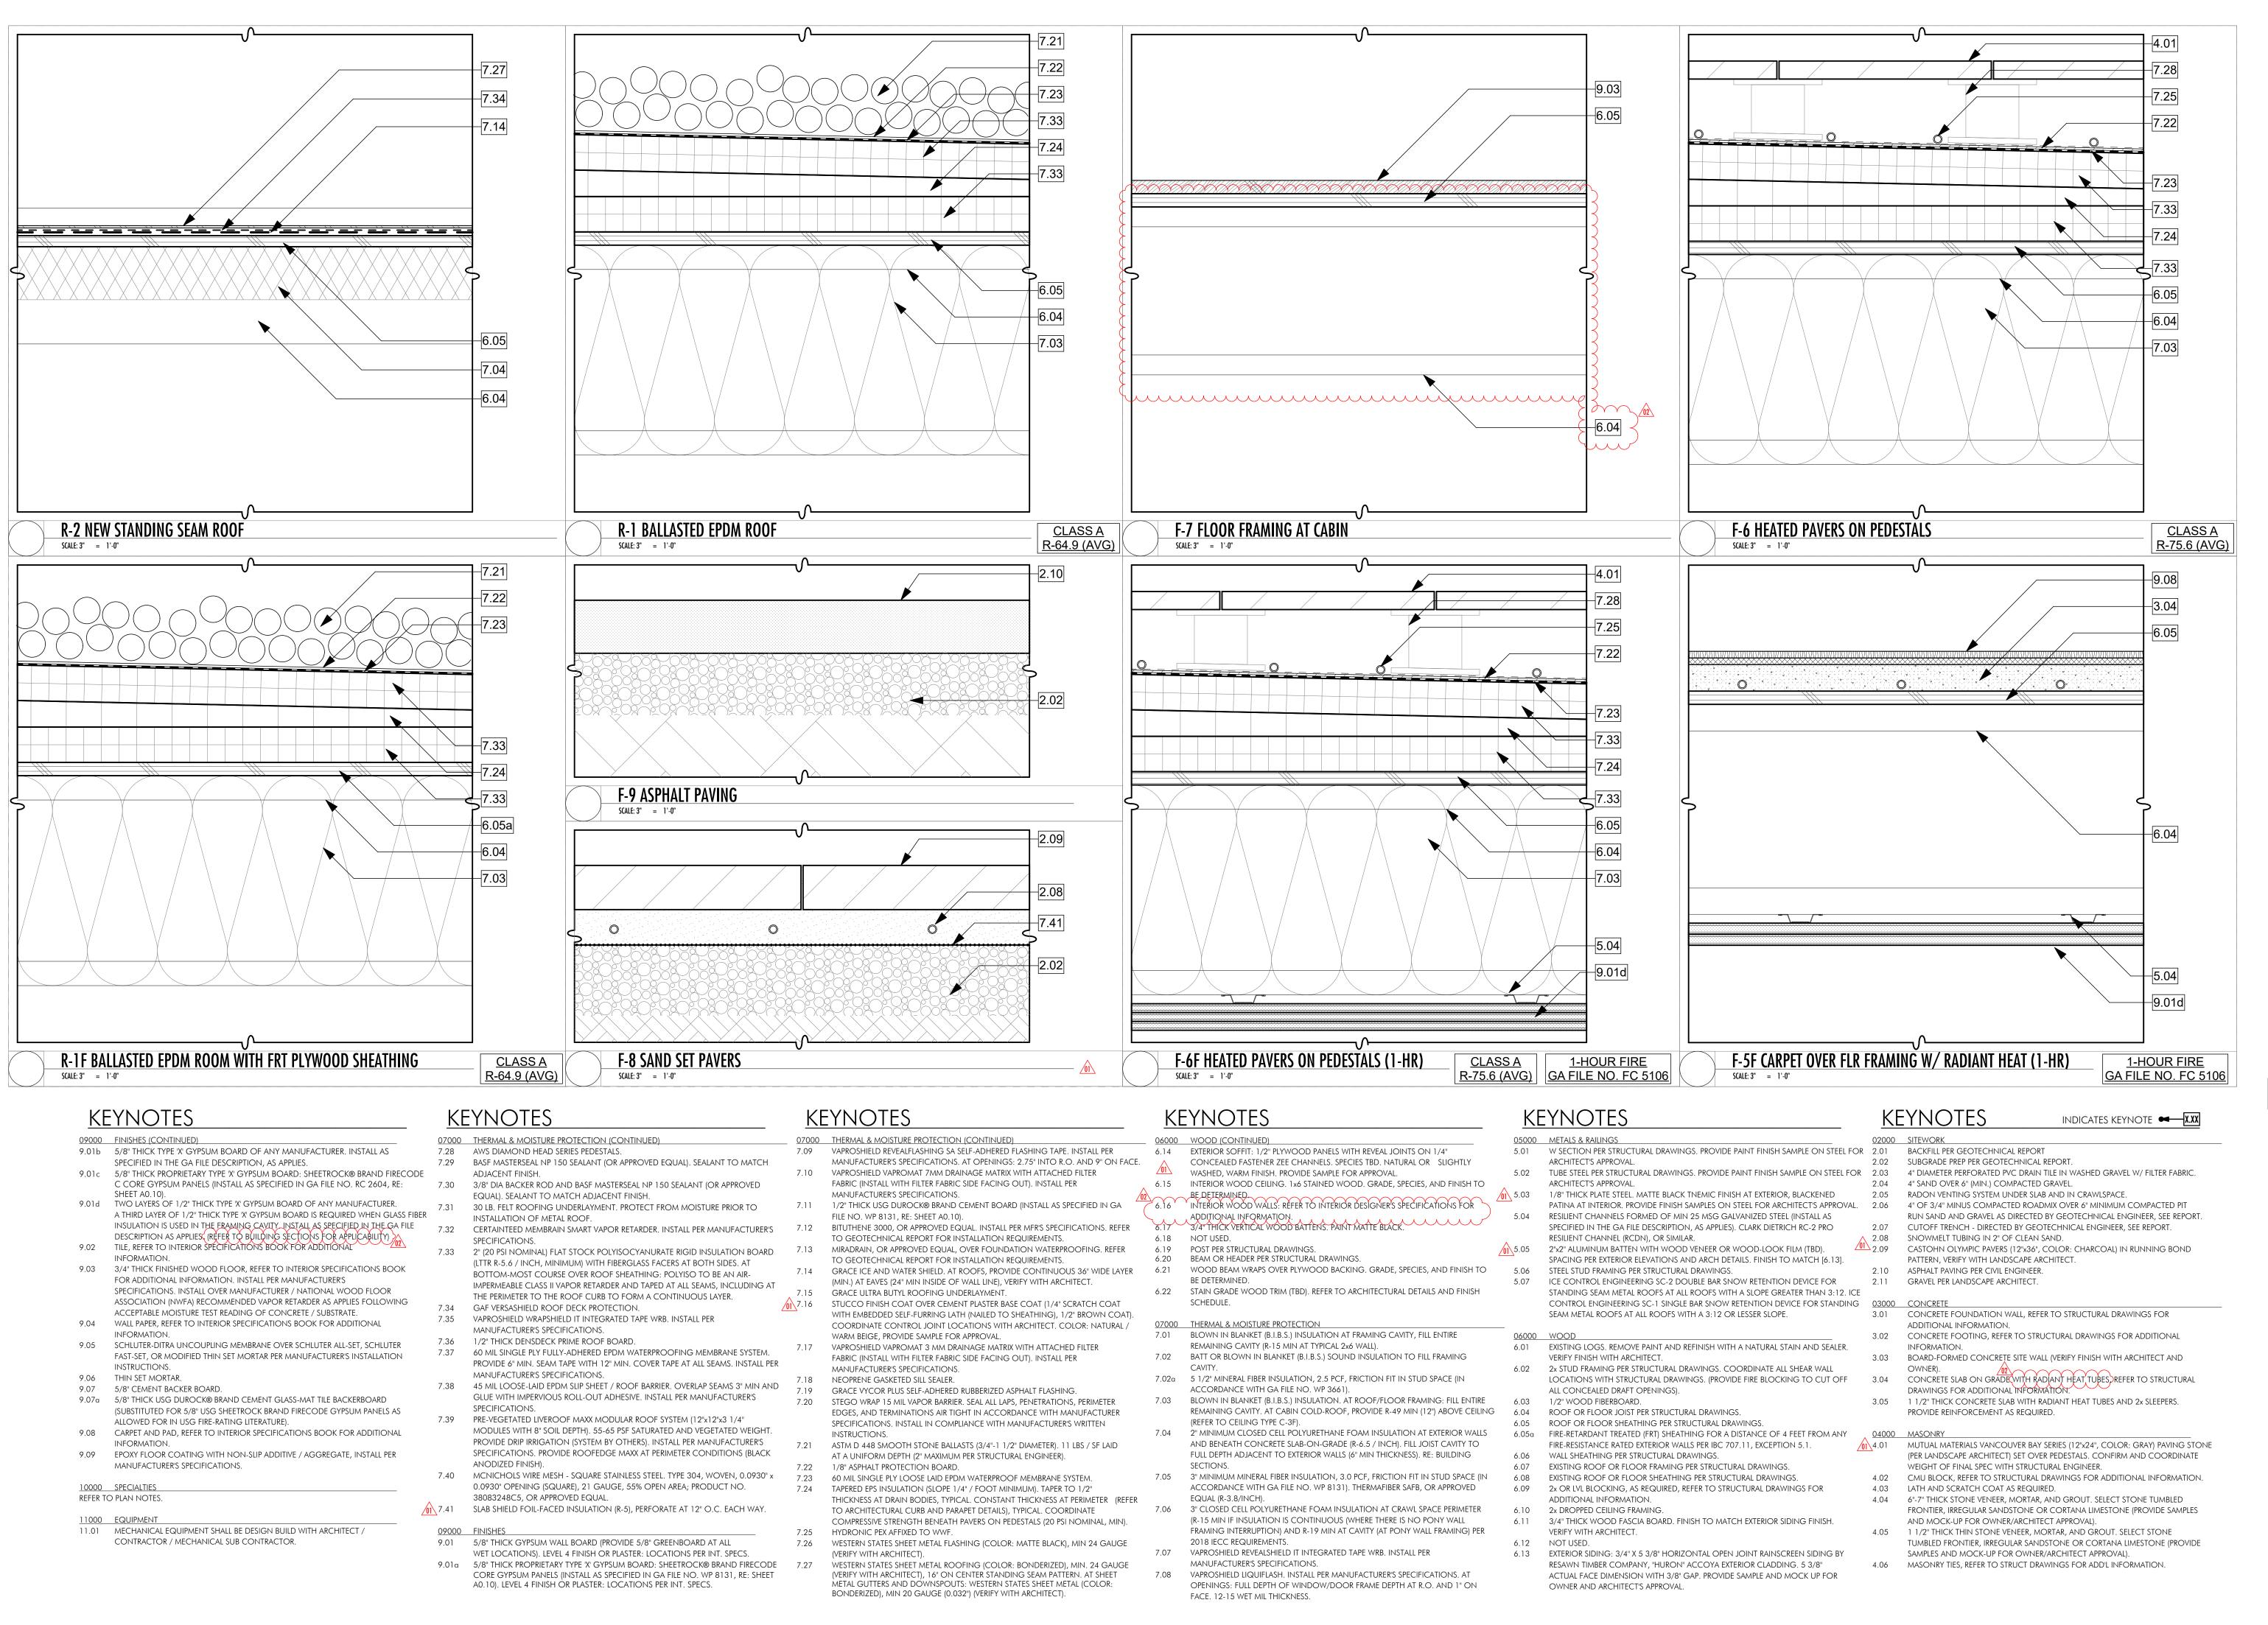


bC din Buil $\boldsymbol{\mathcal{O}}$ \vdash ∞ \frown WILLIAMS PARTNERS ARCHITECTS MAIL P.O.B. 4373 **KETCHUM, IDAHO** 83340 PHONE 208.726.0020 FAX 208.726.0019 WWW WILLIAMS-PARTNERS.COM

DRAWINGS DATE: ISSUED: 04/18/2022 | PRICING SET 08/05/2022 PERMIT 08/02/2023 ISSUED FOR CONSTRUCTION


REVISIONS NUMBER: DATE: 01 02/17/2023 02 08/02/2023

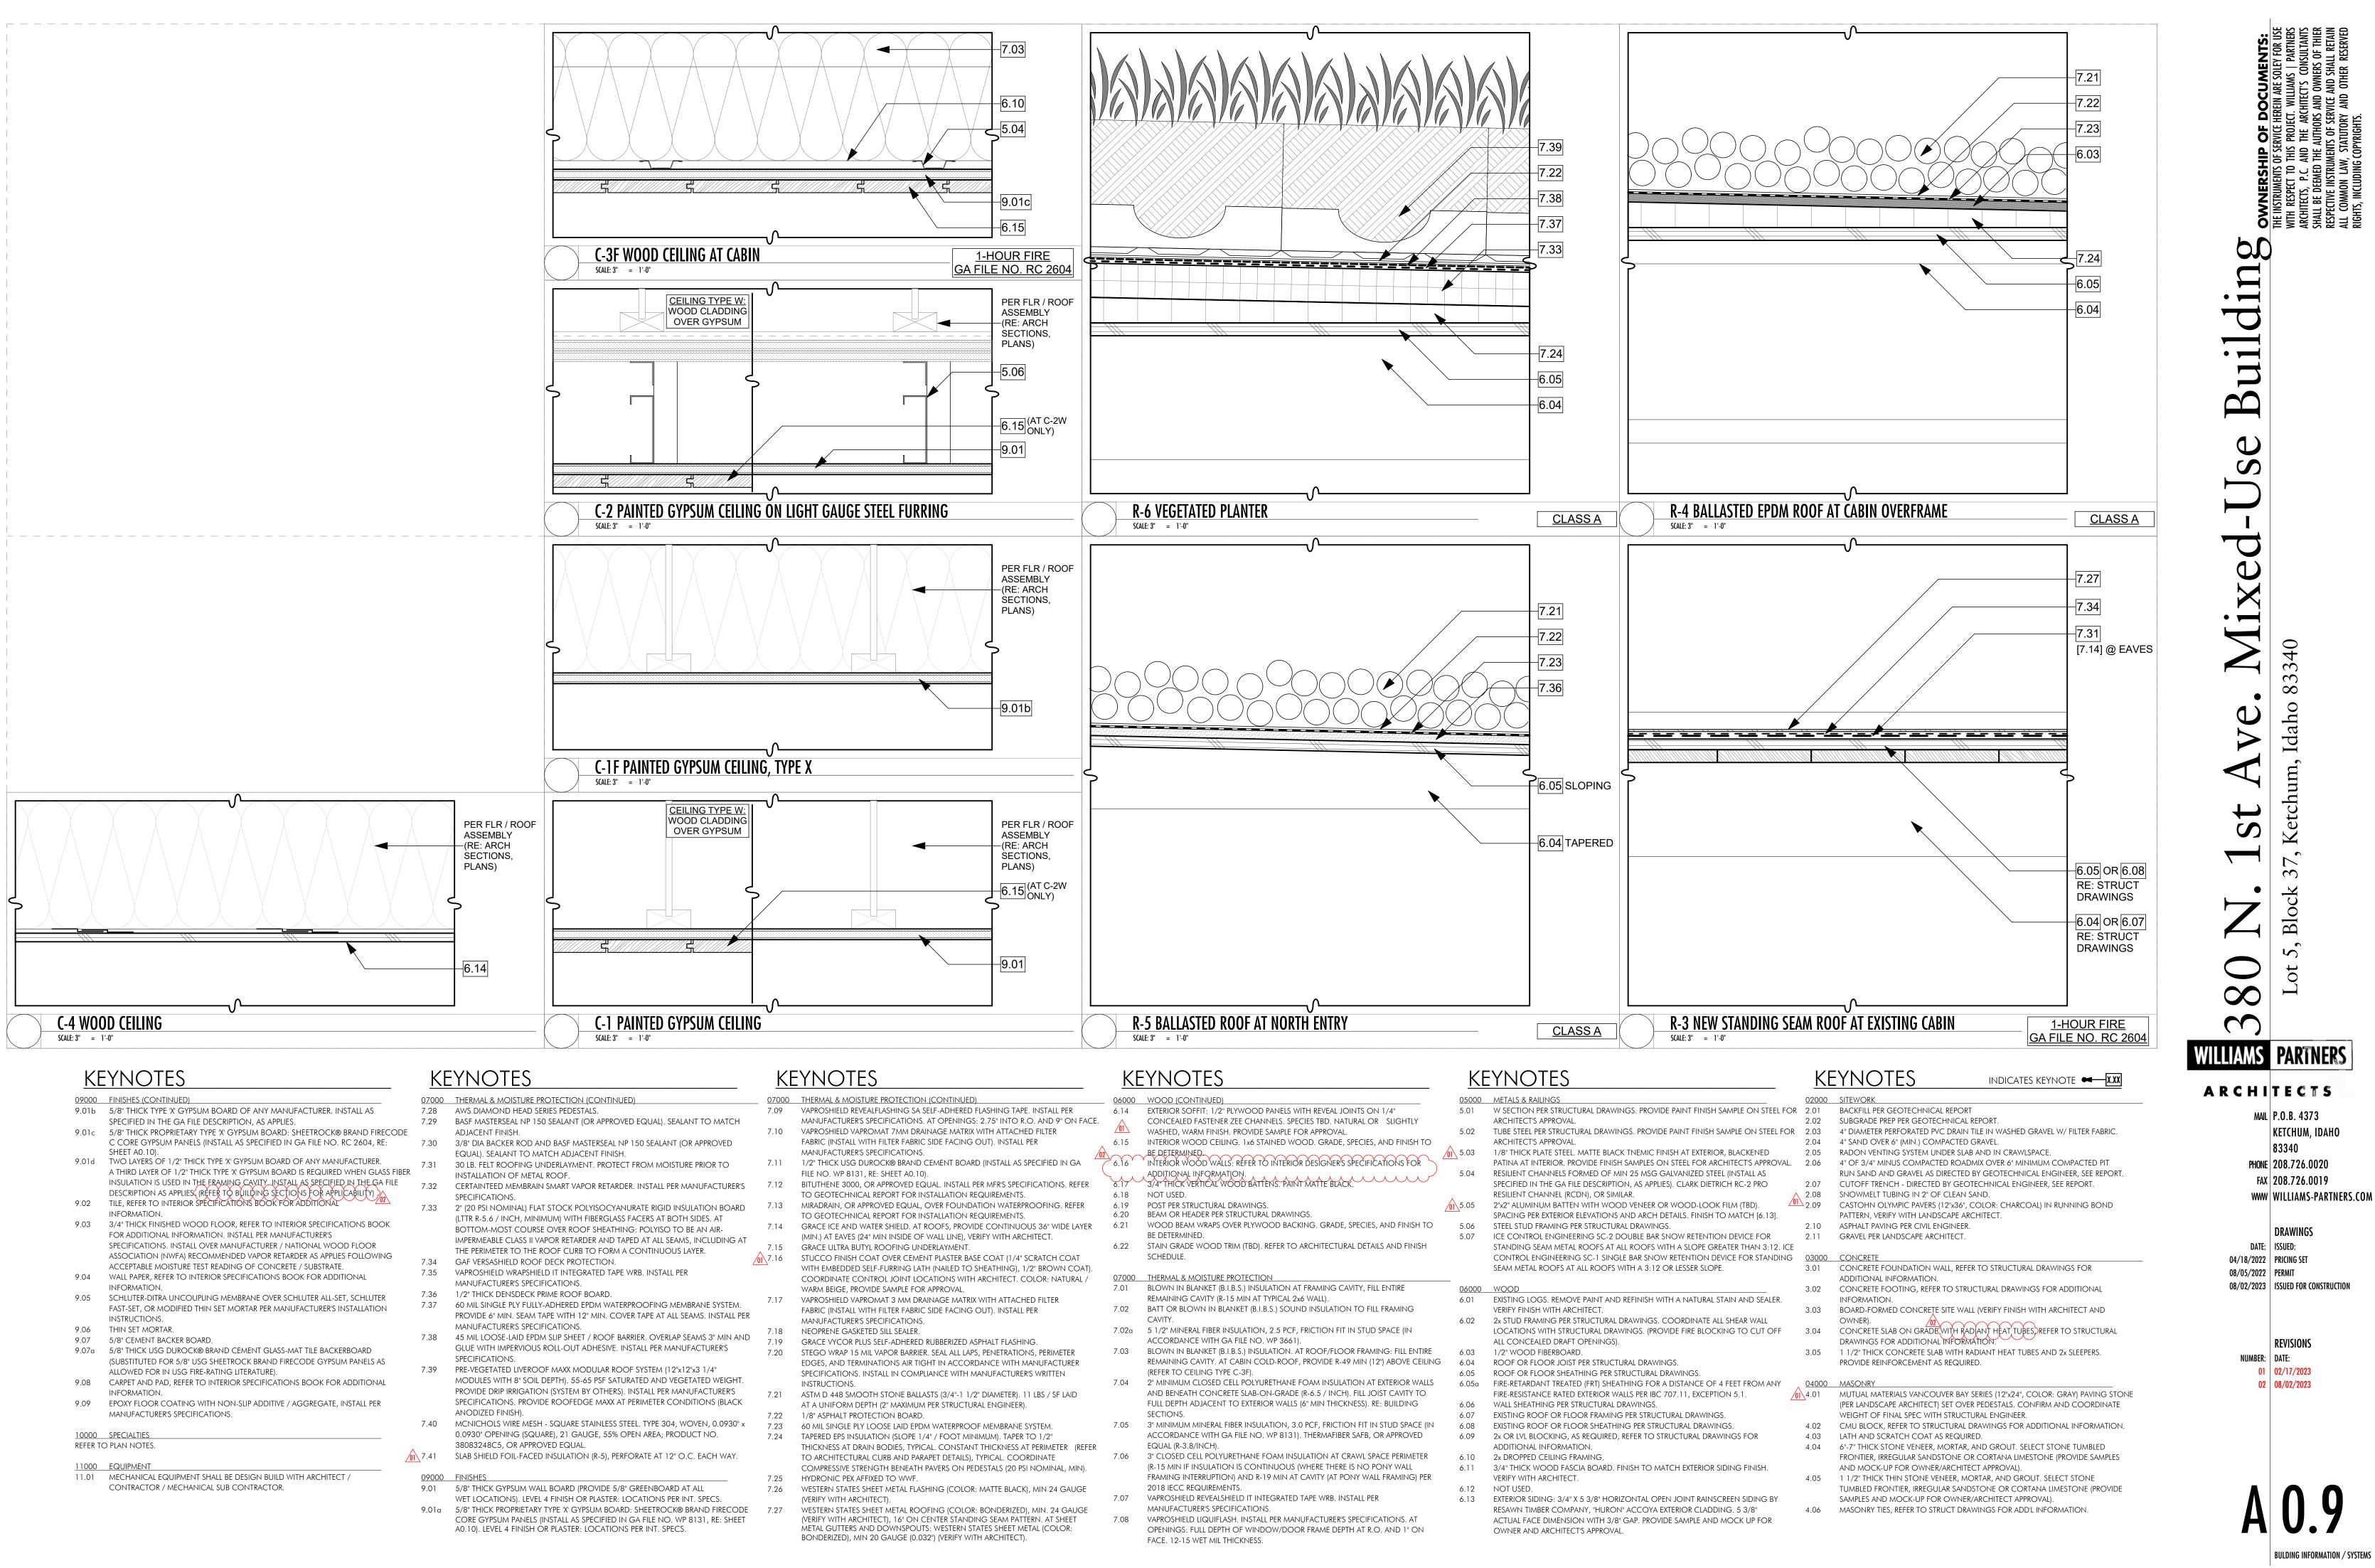


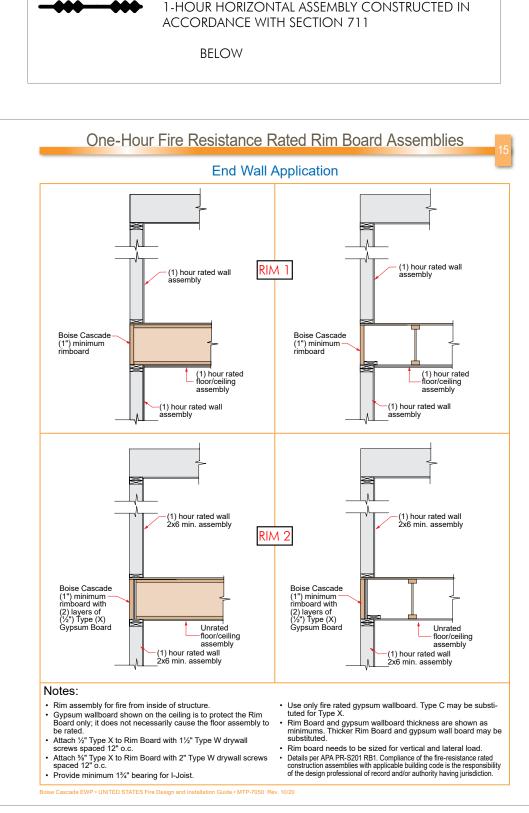


SEFARATED OCCUPANCIES (K 10 D, K 10 U).




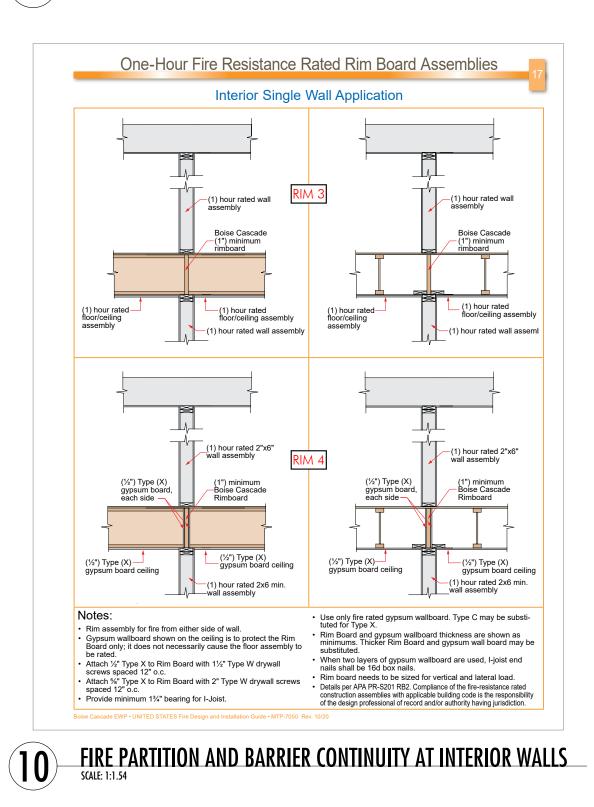

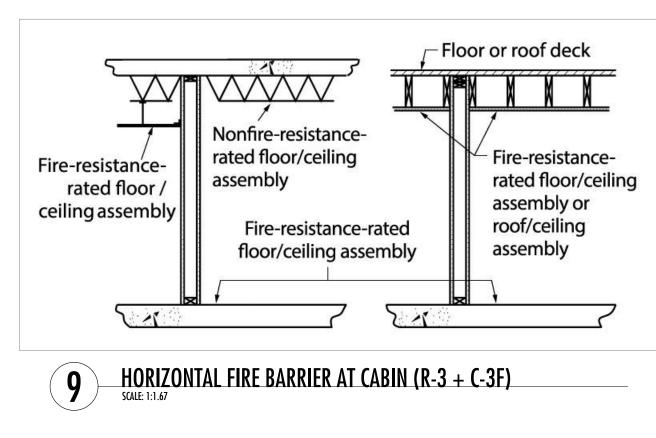


GA FILE NO. BM 1137	PROPRIETARY*	1 HOUR FIRE		
	SUM WALLBOARD oard applied to beam cage with 1" Type S-12 orietary type X gypsum wallboard applied to			Gł
oints.	crews 12" o.c. Joints offset from base layer x 1³/8" steel angles screw attached to stee			
oists at beam top flange and No. 25 gage 2	2 ¹ / ₂ " steel runners hooked over beam lower p.c. Minimum beam size W8x15. (One hou	r h		One lay stud insu
PROPRIETARY GN erican Gypsum Company	YPSUM BOARD 1/2" FireBloc® Type C			Vertical
B America Inc ^o Gypsum - arge North America Inc	1/2" ProRoc® Type C Gypsum Panels 1/2" ToughRock® Fireguard® C 1/2" Firecheck® Type C	Fire Test: UL R	1319-133, 7-16-75;	
ional Gypsum Company	1/2" Gold Bond® Brand FIRE-SHIELD C™ Gypsum Wallboard	Base 11-12	d on UL R3660-7 & -8, -87; esign L524	
	1/2" SHEETROCK® Brand FIRECODE® C			
	Core Gypsum Panels	5		
BEAM PROTECTION				(
SCALE: 1:1.25				
				G
GA FILE NO. CM 1601	GENERIC	1 HOUR FIRE		
	TEEL COLUMN COVER ed around W6x15.5 column and held in place either No. 24 MSG galvanized steel columr		J	One lay angl
cover consisting of two L-shaped sections MSG galvanized steel column covers consis	with snap-lock sheet steel joints or No. 22 sting of two L-shaped sections with lap joints vs 12" o.c. Face layer 1/2" type X gypsum	2		cha scre end
wallboard applied without horizontal joints to 8" o.c. spaced 1" from vertical edges. Met	o column cover with 1" Type S drywall screws tal cornerbead applied to all corners with 1	5		trus stru pan
Type S drywall screws 12" o.c. in each flan	ge.	Fire Test: UL N		nails of d
		12-23 UL N	C505, 77NK1518;	United
		UL D	esign X526	
7 COLUMN PROTECTI	ON			
7 COLUMN PROTECTI SCALE: 1:1.25	ON			
	ION			(
	GENERIC	1 HOUR FIRE	35 to 39 STC	
GA FILE NO. WP 3514 GYPSUM WALLBOAF e layer 5/8" type X gypsum wallboard or gyp	GENERIC RD, WOOD STUDS osum veneer base applied parallel or at righ	t transformer	35 to 39 STC SOUND	G



GA FILE NO. WP 3514 GYPSUM WALLBOAR e layer 5/s" type X gypsum wallboard or gyp angles to each side of 2 x 4 wood studs 10 o.c. Ints staggered 16" on opposite sides. (LOAR MA-22F CRAWL SP SALE: 1:5.33 GA FILE NO. WP 3370 GYPSUM WALLBOAR	GENERIC RD, WOOD STUDS Dosum veneer base applied parallel or at righ S" o.c. with 11/4" Type W drywall screws 12" D-BEARING) ACE PONY WALL @ FIRE BAR	Thickness: 4 ³ /4" Approx. Weight: 7 psf Fire Test: SWR Sound Test: See V (G&H	SOUND	Base la o.c. to m mini gyps 12" laye joint joist STC au insu to a
GA FILE NO. WP 3514 GYPSUM WALLBOAR e layer 5/s" type X gypsum wallboard or gyp angles to each side of 2 x 4 wood studs 16 o.c. Ints staggered 16" on opposite sides. (LOAR MA-22F CRAWL SP SALE: 1:5.33 GA FILE NO. 








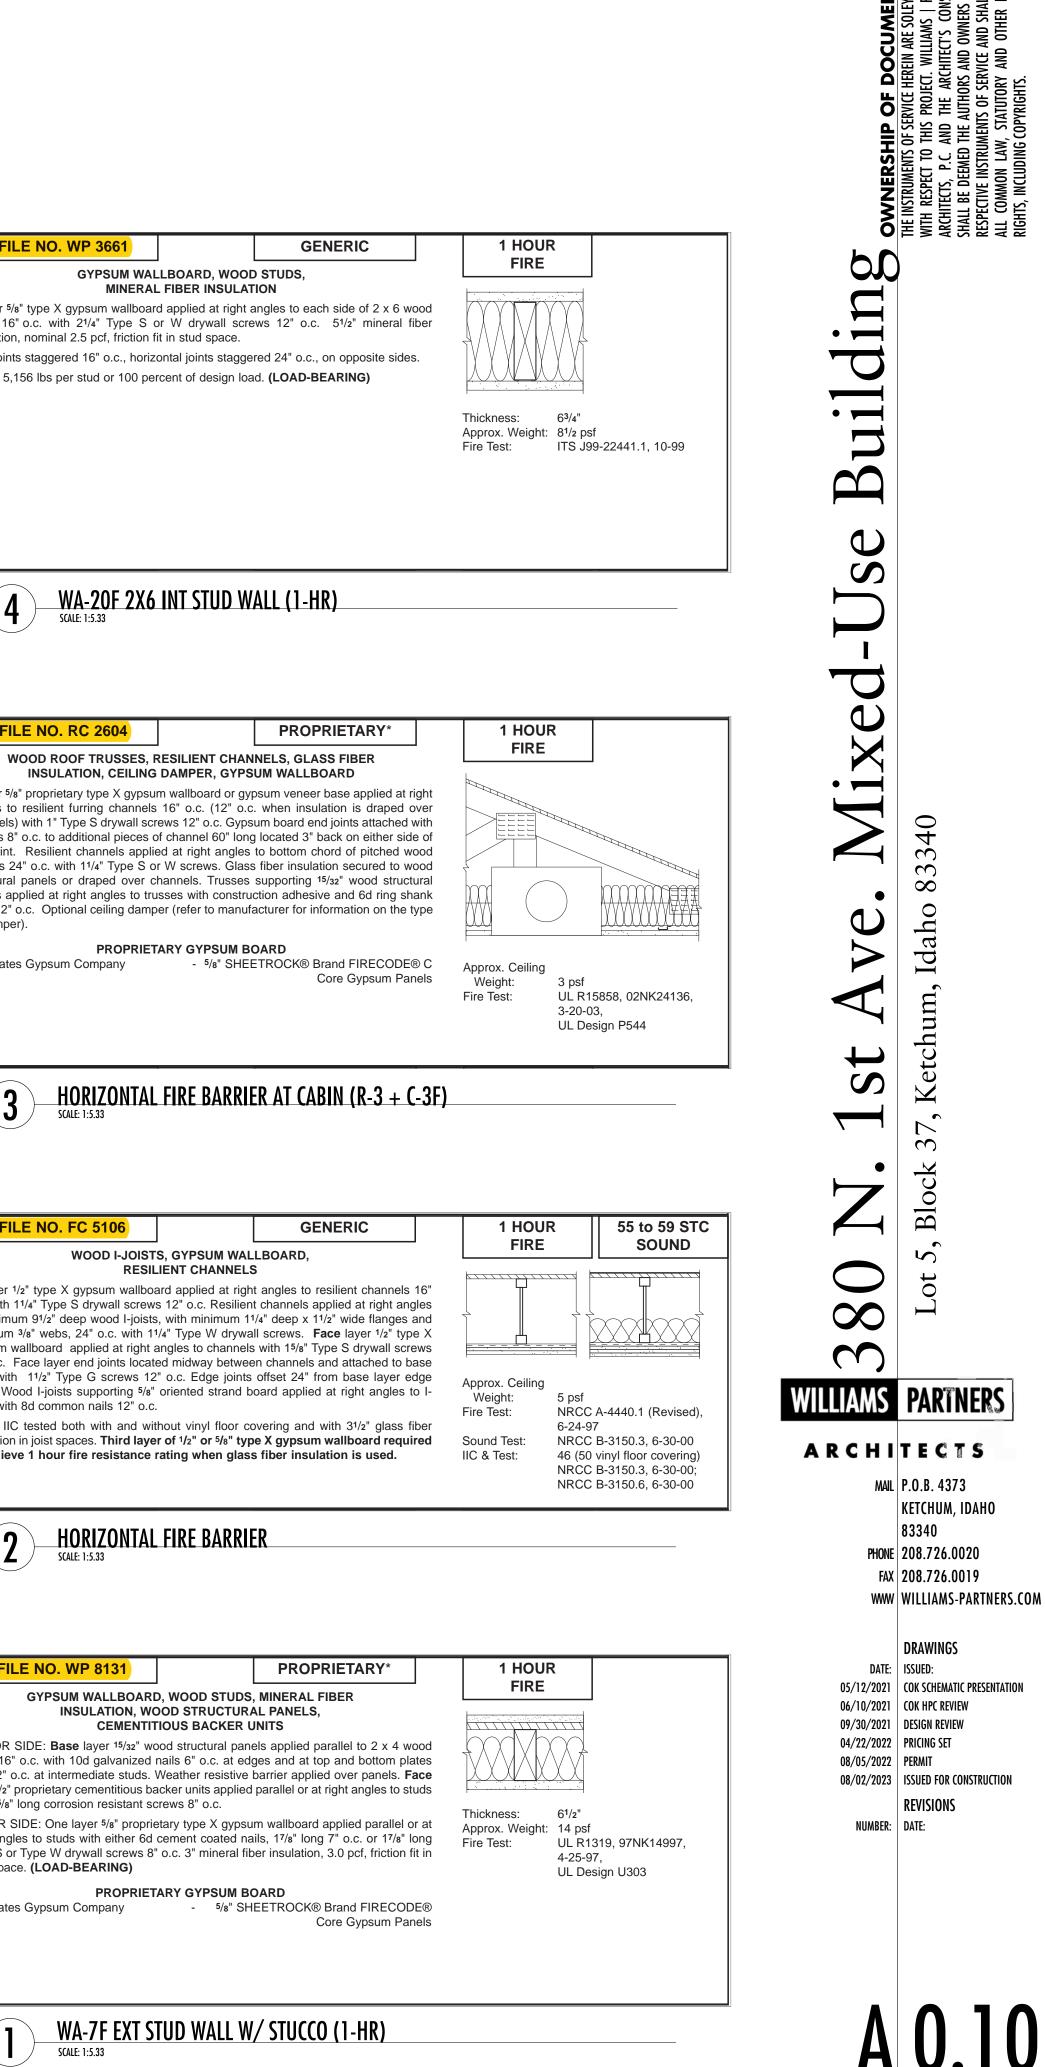

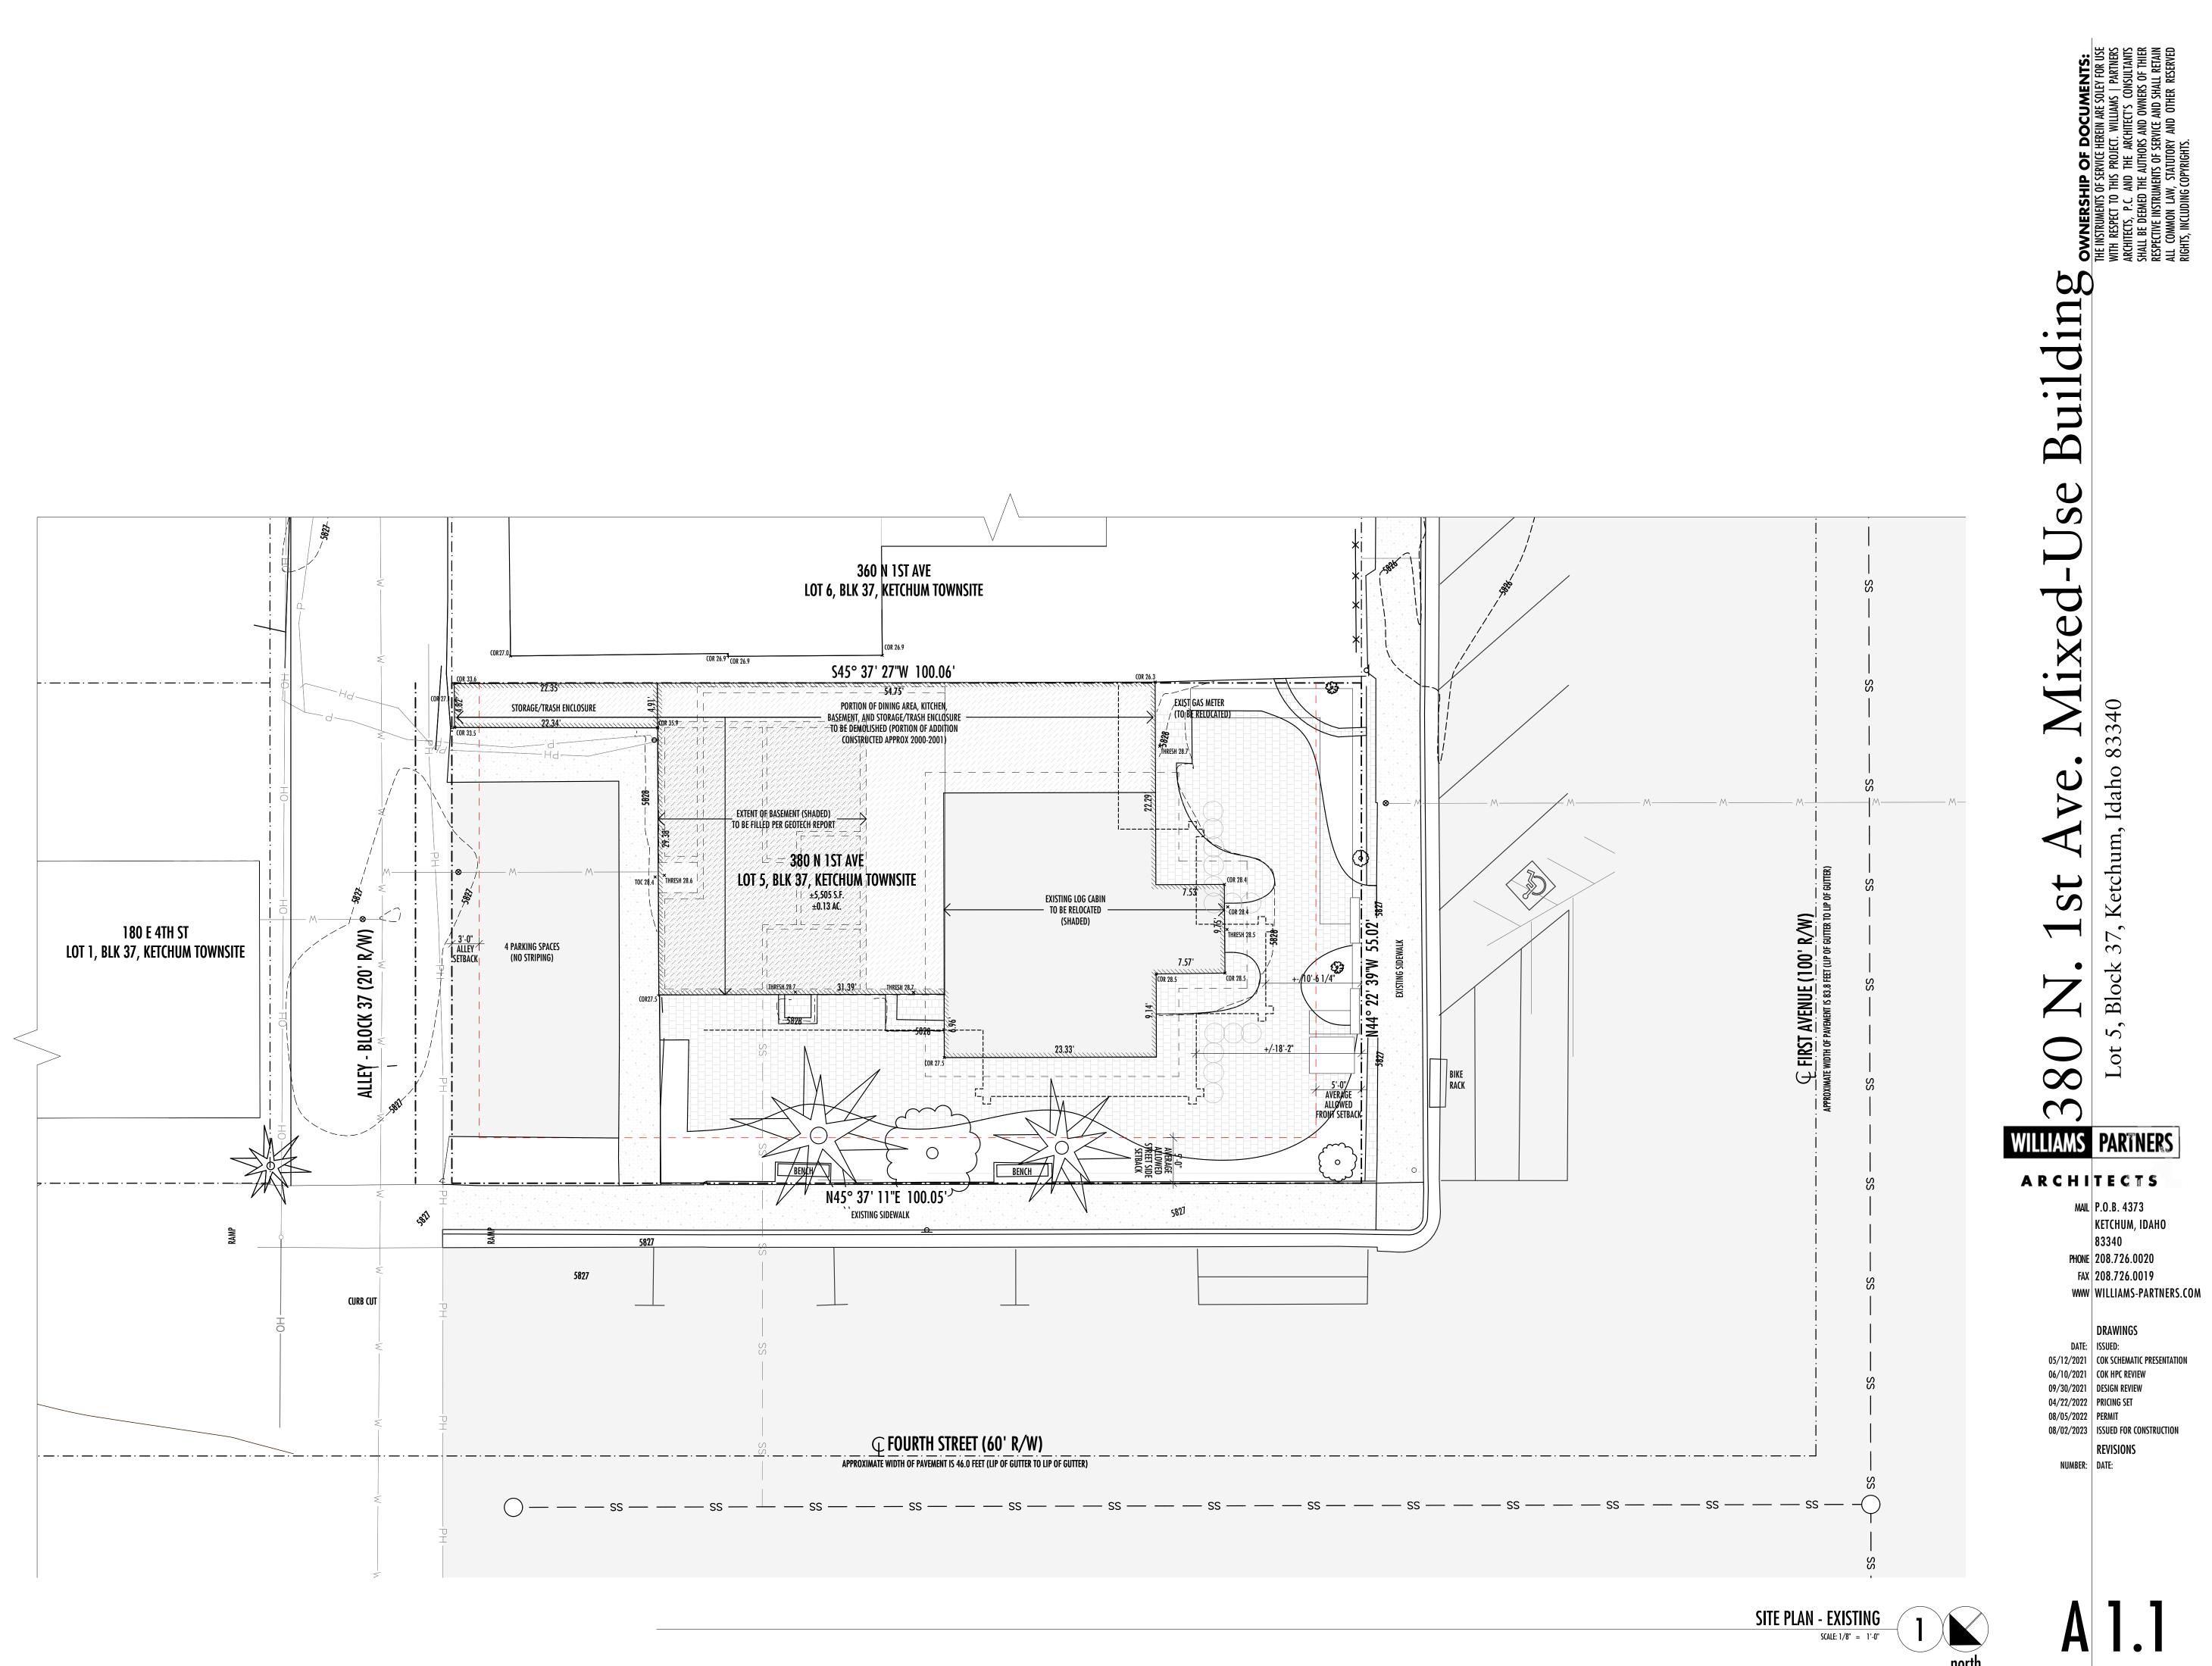

north Y:\McMorrow\04 - BIM Project Files\380 North 1st Avenue.pln

ARCHITECTURAL SITE PLAN

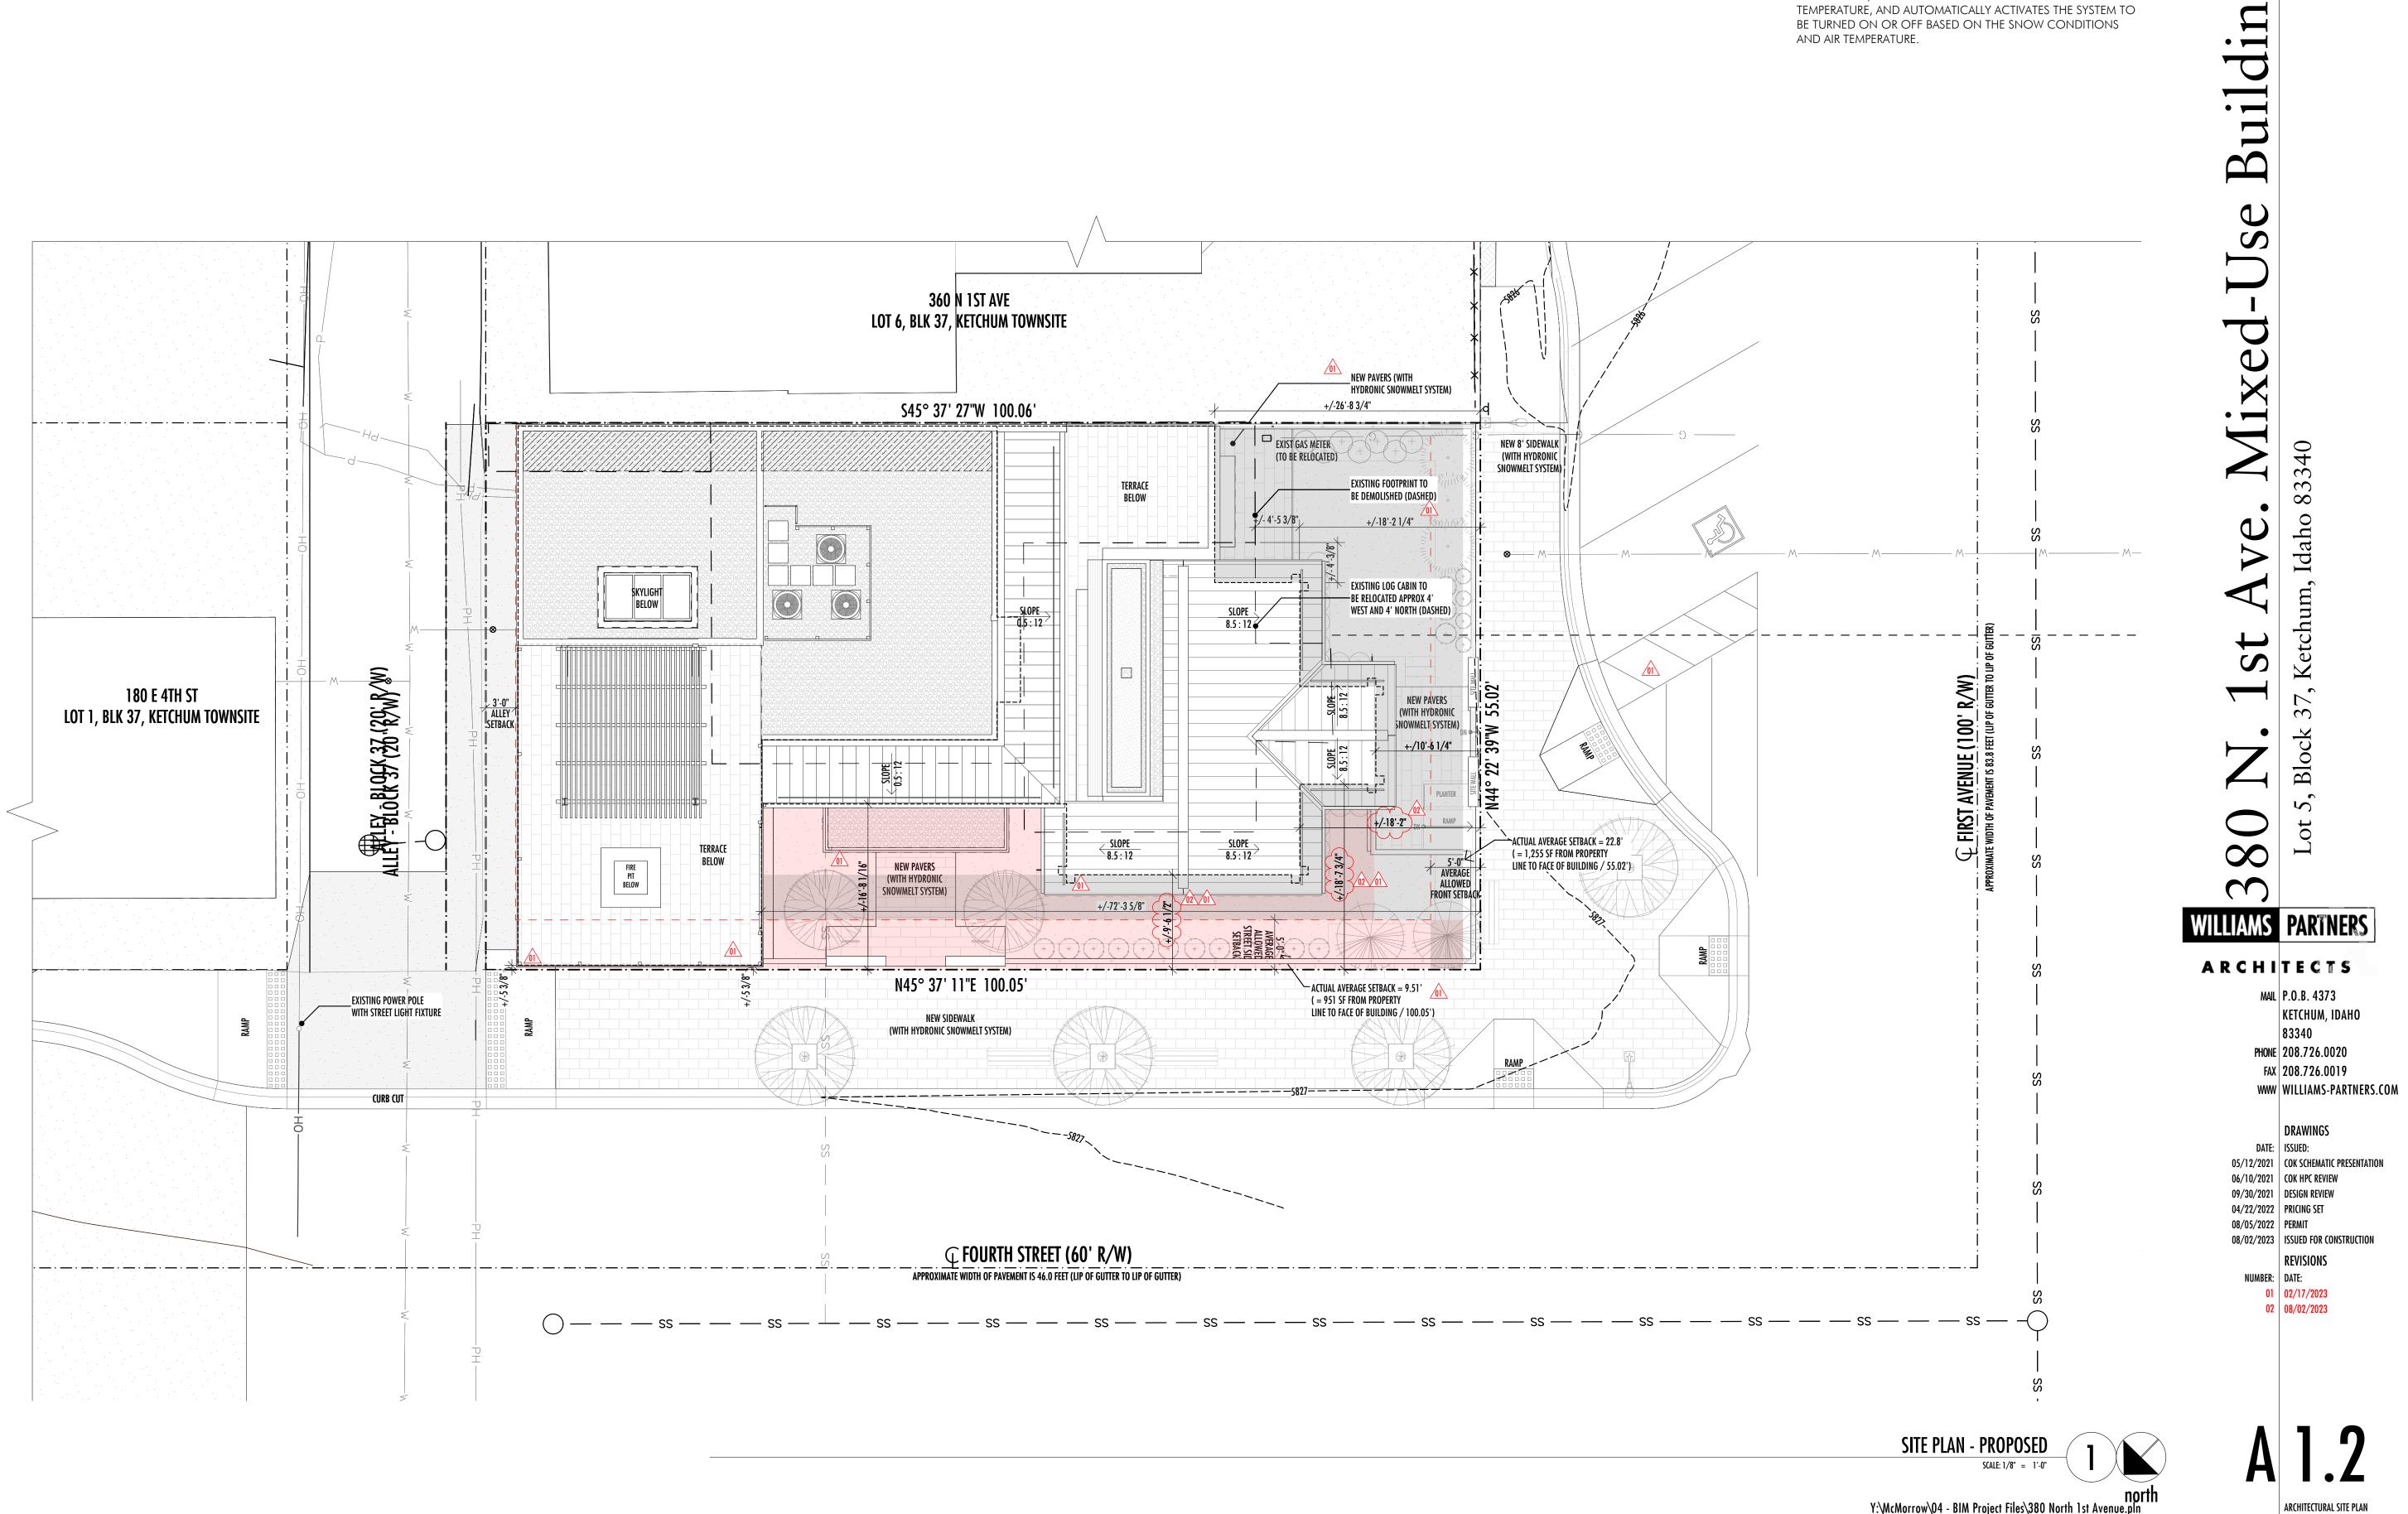

EXTERIOR SNOWMELT

AND AIR TEMPERATURE.

CITY OF KETCHUM SNOWMELT REQMTS. FOR COMMERCIAL PROJECTS:

SNOWMELT SYSTEMS INSTALLED IN THE PUBLIC RIGHT-OF-WAY SHALL BE INSTALLED AND OPERATE AT ALL TIMES DURING THE WINTER ACCORDING TO THE FOLLOWING:

- THE SYSTEM SHALL MEET THE REQUIREMENTS OF THE INTERNATIONAL ENERGY CONSERVATION CODE (2018 IECC,
- C403.12.2) - THE SYSTEM SHALL HAVE AN ELECTRONIC MAIN CONTROL BOARD TO OPERATE THE SYSTEM THAT IS PROGRAMMABLE AND
- OPTIMIZES THE WAY THE SYSTEM FUNCTIONS. - INSTALLATION OF IN-GROUND CONTROL SENSORS LINKED TO THE MAIN CONTROL BOARD THAT DETECT SNOW AND ICE ON THE SURFACE, MONITOR THE SIDEWALK OR DRIVEWAY TEMPERATURE, AND AUTOMATICALLY ACTIVATES THE SYSTEM TO BE TURNED ON OR OFF BASED ON THE SNOW CONDITIONS

Y:\McMorrow\04 - BIM Project Files\380 North 1st Avenue.pln


20

MEMBRANE).

75 cont.

76

90

PLAN NOTES

65


68

70

72

- EXTERIOR GAS FIRE PIT T.B.D.
- SNOW RETENTION BARS, REFER TO KEYNOTE [5.07] AND ARCHITECTURAL DETAILS FOR MORE INFORMATION. LUTRON SIVIOA SHADE POCKET BOX WITH TUBE AND DRIVE AS RECOMENDED BY
- MANUFACTURER. REFER TO DETAILS FOR RECESSED SHADES AND VALENCE DETAILS FOR DUAL ROLL AND SINGLE ROLL SHADE BOXES. SUPPLY AIR GRILLE T.B.D., SEE SYTEMS NOTES FOR ADDITIONAL INFORMATION.
- RETURN AIR GRILLE T.B.D., SEE SYTEMS NOTES FOR ADDITIONAL INFORMATION. PANASONIC "WHISPER CEILING" SPOT VENTILATION FAN (290CFM) PRODUCT NO. "FV-30VQ3", OR APPROVED EQUAL, INSTALL PER MANUFACTURER'S SPEICIFICATIONS. HARDWIRED, INTERCONNECTED SMOKE + CARBON MONOXIDE DETECTOR IN
- ACCORDANCE WITH 2018 IRC, SECTION R314.4. NEST PROTECT, OR APPROVED EQUAL. 57 PROVIDE AND INSTALL RADON MITIGATION SYSTEM PER APPENDIX F RADON CONTROL METHODS (AF 130, IRC 2018). CAST IRON ROOF DRAIN AND DOME WITH MEMBRANE FLASHING CAP. INSTALL IN A 60

2'x2' BOX 4 3/8" ABOVE OF ROOF SHEATHING (COORDINATE AND VERIFY WITH FINAL 61 FOAM PLAN). 4-BAND COUPLINGS TO BE PROVIDED FOR ANY NO-HUB OUTLETS AT 62 DRAIN BODIES WITH VERTICAL OUTLETS, SIDE OUTLET DRAIN BODIES TO HAVE THREADED OUTLET TO 3" DIA CAST IRON DRAIN PIPE. PROVIDE HEAT TAPE AT DRAIN BODY, (5) DAISY CHAIN LOOPS AT 3 LF EACH, ADHERE WITH 5" EPDM TAPE, POWER..

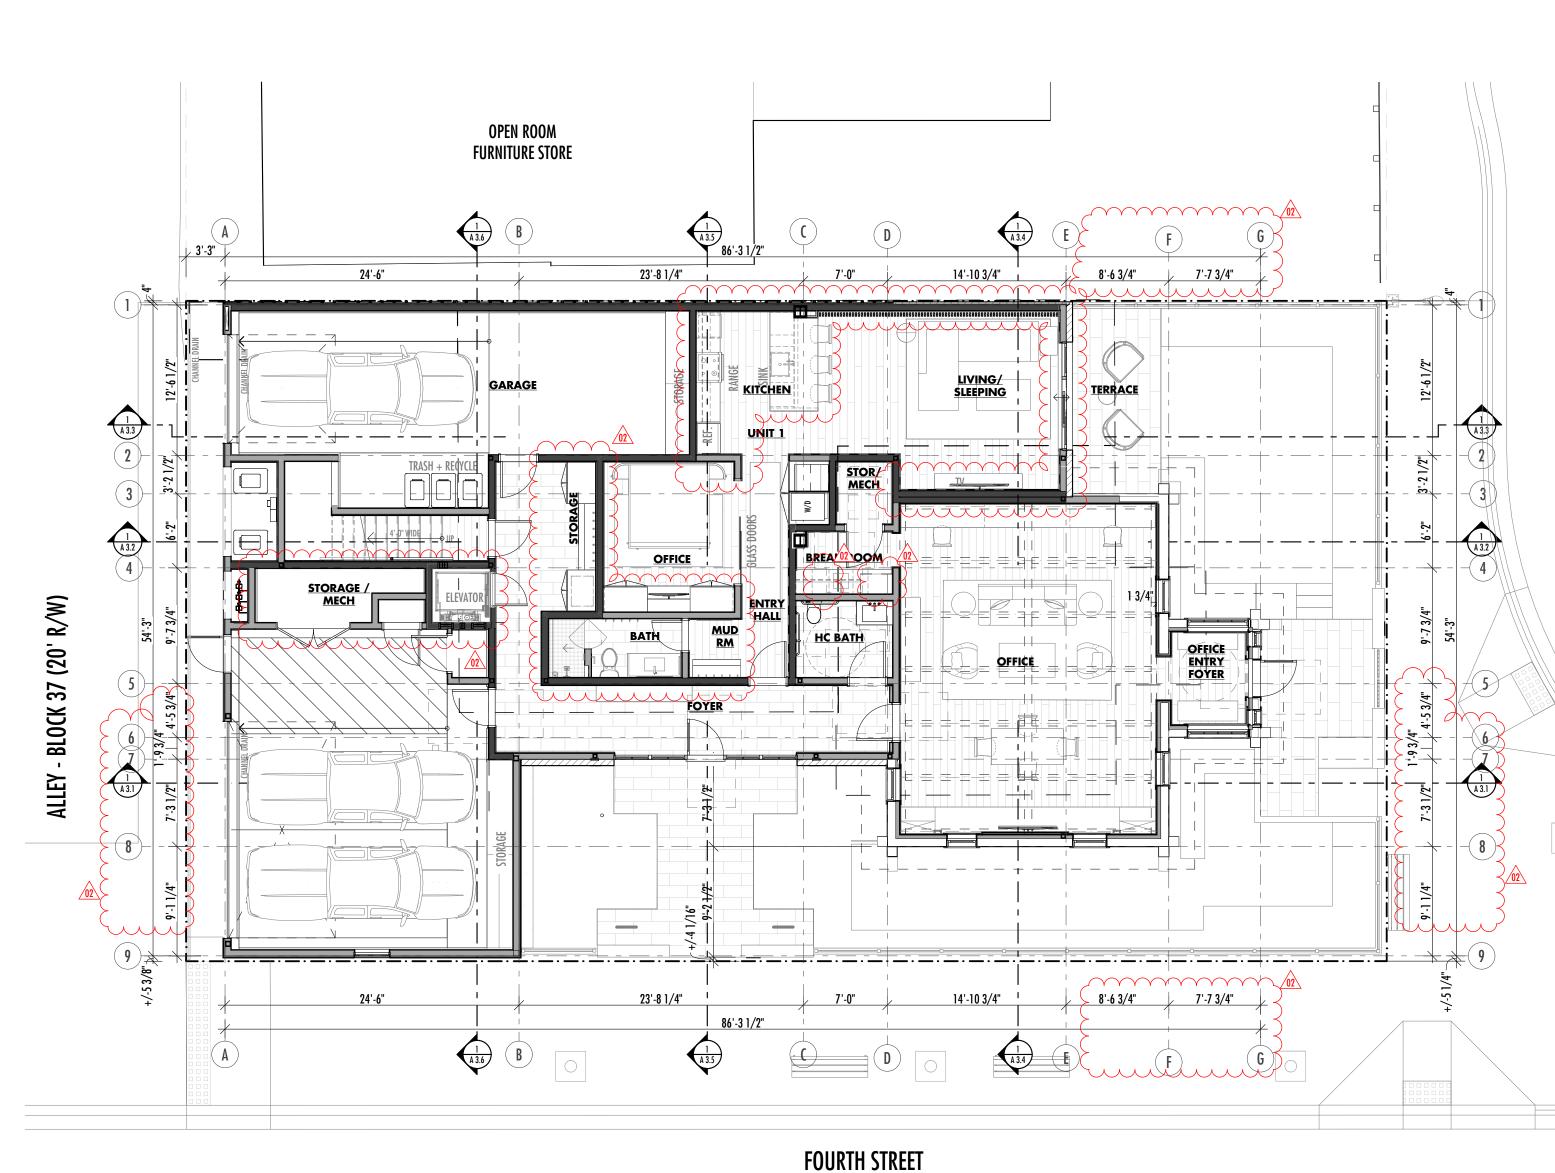

ARCHITECTURAL DETAILS AND LANDSCAPE PLANS FOR ADDITIONAL INFORMATION. 73 TWO-STOP RESIDENTIAL ELEVATOR T.B.D. INSTALL PER MANUFACTURER'S SPECIFICATIONS. 92 DOWNSPOUT. HARDPIPE TO SUBSURFACE DRAIN SYSTEM. 74 93 75 VEHICULAR WHEELSTOP. 94 TRASH PULL-OUT. REFER TO INTERIOR DESIGNER INTERIOR ELEVATIONS. 15" ICE MAKER. REFER TO INTERIOR DESIGNER SPECS FOR ADD'L INFO. ≻ 96 > 97 24" UNDERCOUNTER REFRIGERATOR BELOW COUNTERTOP. TOP-MOUNT AUTOMATIC -COFFEE MACHINE ABOVE COUNTERTOP, REFER TO INTERIOR DESIGNER'S SPECS FOR ADDITIONAL INFORMATION.

...POWER SOURCE FOR HEAT TAPE SHALL BE 48" MIN FROM CENTER OF DRAIN,

COORDINATE WITH ROOFING SUB. PROVIDE CAST IRON OVERFLOW DRAIN, STUB

2"W x 1"T WOOD HANDRAIL AFFIXED TO WALL WITH STEEL HANDRAIL BRACKETS. RETURN

SHEET METAL DOWNSPOUT. HARDPIPE TO SUBSURFACE DRAIN SYSTEM. PROVIDE HEAT

TO WALL AT ENDS. ALLOW 1 1/2" MIN CLEAR TO ADJACENT WALL SURFACE. MOUNT 36"

30" FROM MAIN DRAIN BODY (SET TOP OF OVERFLOW DRAIN 2" ABOVE TOP OF

ABOVE THE SLOPED PLANE ADJOINING THE TREAD NOSINGS TO MEET 2018 IBC.

SHEET METAL GUTTER, REFER TO ARCHITECTURAL DETAILS FOR ADDITIONAL INFO.

TAPE TO 30" MIN. BELOW GRADE. PROVIDE ELECTRICAL FOR HEAT TAPE. REFER TO

PLAN NOTES

KITCHEN FREEZER T.B.D., REFER TO INTERIOR DESIGNER'S SPECS FOR ADD'L INFO. KITCHEN DISHWASHER T.B.D., REFER TO INTERIOR DESIGNER'S SPECS FOR ADD'L INFO. GRILL T.B.D., PROVIDE GAS HOOK UP.

- STACK WASHER / DRYER T.B.D., REFER TO INTERIOR DESIGNER'S DRAWINGS AND SPECIFICATIONS FOR ADDITIONAL INFORMATION. KITCHEN MICROWAVE DRAWERS T.B.D., REFER TO INTERIOR DESIGNER'S SPECS. TV. REFER TO INTERIOR DESIGNER'S SEPCIFICATIONS FOR ADD'L INFORMATION. FROST FREE HOSE BIBB, INTEGRATE IN CABINET BOX WHERE SHOWN. (5) GAS METER MANIFOLD (3 LOW, 2 HIGH), GC TO COORDINATE WITH
- INTERMOUNTAIN GAS. ELECTRICAL METERS, GC TO COORDINATE WITH IDAHO POWER.
- PHONE / CABLE / IRRIGATION EQUIPMENT GARAGE TRENCH DRAIN WITH SAND AND OIL INTERCEPTOR.
- HIGH EFFICIENCY WATER HEATER AND BOILERS T.B.D.
- ELECTRICAL PANEL AS REQUIRED. AC UNITS AS REQUIRED ON CONCRETE PAD
- OUTDOOR REFRIGERATOR T.B.D.
- MONTIGO EXEMPLAR R520. GLASS VIEW SIZE: 61 1/4" x 18 1/8". HORIZONTAL FLUSH LOUVERED POWER VENT. INSTALL PER MANUFACTURER'S SPECIFICATIONS.

42

- SHOWER NICHE, REFER TO INTERIOR ELEVATIONS AND INTERIOR DESIGNER'S SPECIFICATIONS FOR ADDITIONAL INFORMATION.
- KITCHEN SINK, FAUCET, AND DISPOSAL PER INTERIOR DESIGNER'S SPECIFICATIONS. SINK AND FAUCET PER INTERIOR DESIGNERS SPECIFICATIONS.
- MASTER BATH TUB PER INTERIOR DESIGNER'S SPECIFICATIONS. MASTER BATH SHOWER HEAD AND THERMOSTATIC CONTROLS, PER INTERIOR DESIGNERS
- MASTER BATH SHOWER DRAIN PER INTERIOR DESIGNER'S SPECIFCATIONS.
- SPECIFICATIONS.
- SHOWER DRAIN, REFER TO INTERIOR DESIGNER'S SPECIFICATIONS.
- BATH TUB FILLER PER INTERIOR DESIGNER'S SPECIFICATIONS
- GRAB BAR. REFER TO INTERIOR ELEVATIONS FOR PLACEMENT.
- KITCHEN RANGE HOOD T.B.D., REFER TO INTERIOR DESIGNER'S SPECS FOR ADD'L
- INFORMATION. KITCHEN REFRIGERATOR T.B.D., REFER TO INTERIOR DESIGNER'S SPECS FOR ADD'L INFORMATION.
- BUILT IN CABINET (ABOVE SHOWN DASHED), REFI INTERIOR DESIGNER'S SPECIFICATIONS FOR ADDI BUILT IN SHELVING (ABOVE SHOWN DASHED), RE INTERIOR DESIGNER'S SPECIFICATIONS FOR ADDI BUILT IN CUBBIES (ABOVE SHOWN DASHED), REFE DESIGNER'S SPECIFICATIONS FOR ADDITIONAL IN BUILT IN BENCH (ABOVE SHOWN DASHED), REFER DESIGNER'S SPECIFICATIONS FOR ADDITIONAL IN BUILT IN DRESSER (ABOVE SHOWN DASHED), REFE DESIGNER'S SPECIFICATIONS FOR ADDITIONAL IN CLOSET CABINETS (ABOVE SHOWN DASHED), REF INTERIOR DESIGNER'S SPECIFICATIONS FOR ADDI CLOSET ROD AND SHELF (ABOVE SHOWN DASHE INTERIOR DESIGNER'S SPECIFICATIONS FOR ADDI HOOKS, REFER TO INTERIOR ELEVATIONS AND IN INFO.
- SPECIFICATIONS. SHOWER HEAD AND THERMOSTATIC CONTROLS PER INTERIOR DESIGNER'S TOILET, PER INTERIOR DESIGNERS SPECIFICATIONS.
 - KITCHEN RANGE T.B.D., REFER TO INTERIOR DESIGNER'S SPECS FOR ADD'L INFORMATION. 27
- 22 23

PLAN NOTES 20

- - SHOWER BENCH, REFER TO INTERIOR ELEVATION ADDITIONAL INFORMATION.

PLAN NOTES

LINE OF ROOF ABOVE (SHOWN DASHED).

LINE OF OUTRIGGER ABOVE (SHOWN DASHED).

LINE OF COLUMN ABOVE (SHOWN DASHED).

LINE OF BEAM ABOVE (SHOWN DASHED).

LINE OF WALL ABOVE (SHOWN DASHED).

FER TO INTERIOR ELEVATIONS AND	01
DITIONAL INFORMATION.	02
EFER TO INTERIOR ELEVATIONS AND	03
DITIONAL INFORMATION.	04
FER TO INTERIOR ELEVATIONS AND INTERIOR	05
INFORMATION.	06
ER TO INTERIOR ELEVATIONS AND INTERIOR	07
INFORMATION.	08
FER TO INTERIOR ELEVATIONS AND INTERIOR	09
NFORMATION.	10
EFER TO INTERIOR ELEVATIONS AND	11
DITIONAL INFORMATION.	12
IED), REFER TO INTERIOR ELEVATIONS AND	13
DITIONAL INFORMATION.	
NTERIOR DESIGNER'S SPECS FOR ADD'L	14
NS AND INTERIOR DESIGNER'S SPECS FOR	15
	16

LINE OF FOOTING BELOW (SHOWN DASHED). LINE OF COLUMN BELOW (SHOWN DASHED). LINE OF WALL BELOW (SHOWN DASHED). LINE OF ROOF BELOW (SHOWN DASHED). PARAPET WALL BELOW LINE OF ROOF EDGE. LINE OF FOOTING, REFER TO STRUCTURAL DRAWINGS FOR ADDITIONAL INFORMATION. STEEL COLUMN, REFER TO ARCHITECTURAL DETAILS AND STRUCTURAL DRAWINGS FOR ADDITIONAL INFORMATION. CRAWL SPACE ACCESS, REFER TO STRUCTURAL DRAWINGS FOR ADDITIONAL INFORMATION. BENCH.

WOOD SCREEN, REFER TO ARCHITECTURAL DETAILS.

GENERAL NOTES

COORDINATE ALL WORK WITH ARCHITECTURAL DRAWINGS AND SPECIFICATIONS.

DO NOT SCALE DRAWINGS.

CONTRACTOR AND SUB-CONTRACTORS SHALL FAMILIARIZE THEMSELVES WITH EXISTING CONDITIONS, LOCATIONS, AND PROJECT REQUIREMENTS PRIOR TO SUBMITTING A BID.

CONTRACTOR AND SUB-CONTRACTORS SHALL FIELD VERIFY DIMENSIONS. ANY DISCREPANCIES SHALL BE REPORTED TO THE ARCHITECT.

CONTRACTOR SHALL PATCH, REPAIR AND REFINISH ANY EXISTING ELEMENTS REMOVED OR DAMAGED DURING DEMOLITION AND/OR CONSTRUCTION.

PROTECTION SHALL BE PROVIDED TO ALL EXISTING BUILDING ELEMENTS AS REQUIRED.

REFER TO STRUCTURAL DRAWINGS FOR FOUNDATION PLANS, FOOTING LOCATIONS AND SIZES.

BUILDING SECTIONS DO NOT DEPICT EXACT STRUCTURAL CONDITIONS FOR ALL STRUCTURAL COMPONENTS OF THE BUILDING. REFER TO STRUCTURAL DRAWINGS FOR ALL STRUCTURAL COMPONENTS AND SPECIFICATIONS.

PROVIDE BACKING / BLOCKING PER MANUFACTURER'S RECOMENDATIONS FOR ALL WALL AND CEILING MOUNTED FIXTURES, EQUIPMENT AND CASEWORK. FOLLOW ALL RECOMMENDATIONS FOR INSTALLATION FOR THEIR SPECIFIC PRODUCT.

INTERIOR AND EXTERIOR ELEVATIONS EXIST THAT MAY NOT BE DEPICTED IN ELEVATION, BUT ARE CLEARLY SHOWN AND REFERENCEED IN PLAN. IT REMAINS THE RESPONSIBILITY OF THE CONTRACTOR / SUB-CONTRACTORS TO IDENTIFY AND INCLUDE ALL SUCH AREAS IN THEIR PROJECT PRICING AND/OR BID SCOPE OF WORK.

ADVANCED FRAMING TECHNIQUES SHALL BE PERFORMED.

ALL APPLICABLE BUILDING CODES SHALL BE FOLLOWED.



KETCHUM, IDAHO 83340 PHONE 208.726.0020 FAX 208.726.0019 WWW WILLIAMS-PARTNERS.COM


DRAWINGS

DATE: ISSUED: 06/10/2021 | COK HPC REVIEW 09/30/2021 DESIGN REVIEW 04/22/2022 PRICING SET 08/05/2022 PERMIT

05/12/2021 COK SCHEMATIC PRESENTATION 08/02/2023 ISSUED FOR CONSTRUCTION

REVISIONS NUMBER: DATE: 01 02/17/2023 02 08/02/2023



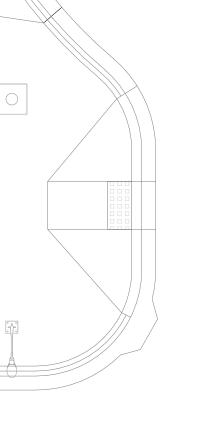

ENUE

FIRST

<u>/01</u>



MEMBRANE).

75 cont.

76

90

PLAN NOTES

65

68

70

73

74

- EXTERIOR GAS FIRE PIT T.B.D.
- SNOW RETENTION BARS, REFER TO KEYNOTE [5.07] AND ARCHITECTURAL DETAILS FOR MORE INFORMATION. LUTRON SIVIOA SHADE POCKET BOX WITH TUBE AND DRIVE AS RECOMENDED BY
- MANUFACTURER. REFER TO DETAILS FOR RECESSED SHADES AND VALENCE DETAILS FOR DUAL ROLL AND SINGLE ROLL SHADE BOXES. SUPPLY AIR GRILLE T.B.D., SEE SYTEMS NOTES FOR ADDITIONAL INFORMATION.
- RETURN AIR GRILLE T.B.D., SEE SYTEMS NOTES FOR ADDITIONAL INFORMATION. PANASONIC "WHISPER CEILING" SPOT VENTILATION FAN (290CFM) PRODUCT NO. "FV-30VQ3", OR APPROVED EQUAL, INSTALL PER MANUFACTURER'S SPEICIFICATIONS. HARDWIRED, INTERCONNECTED SMOKE + CARBON MONOXIDE DETECTOR IN
- ACCORDANCE WITH 2018 IRC, SECTION R314.4. NEST PROTECT, OR APPROVED EQUAL. 57 PROVIDE AND INSTALL RADON MITIGATION SYSTEM PER APPENDIX F RADON CONTROL METHODS (AF 130, IRC 2018). CAST IRON ROOF DRAIN AND DOME WITH MEMBRANE FLASHING CAP. INSTALL IN A 60

2'x2' BOX 4 3/8" ABOVE OF ROOF SHEATHING (COORDINATE AND VERIFY WITH FINAL 61 FOAM PLAN). 4-BAND COUPLINGS TO BE PROVIDED FOR ANY NO-HUB OUTLETS AT 62 DRAIN BODIES WITH VERTICAL OUTLETS, SIDE OUTLET DRAIN BODIES TO HAVE THREADED OUTLET TO 3" DIA CAST IRON DRAIN PIPE. PROVIDE HEAT TAPE AT DRAIN BODY, (5) DAISY CHAIN LOOPS AT 3 LF EACH, ADHERE WITH 5" EPDM TAPE, POWER..

BEDROOM 2 1 A 3.3 - ---- -〔2)─| _**3** I) R/W) 54 (20' 37 BLOCK MASTE 6) CLOSET ALLEY MASTER BATH -(8-) (9) +

TAPE TO 30" MIN. BELOW GRADE. PROVIDE ELECTRICAL FOR HEAT TAPE. REFER TO ARCHITECTURAL DETAILS AND LANDSCAPE PLANS FOR ADDITIONAL INFORMATION. TWO-STOP RESIDENTIAL ELEVATOR T.B.D. INSTALL PER MANUFACTURER'S SPECIFICATIONS. 92 DOWNSPOUT. HARDPIPE TO SUBSURFACE DRAIN SYSTEM. 93 75 VEHICULAR WHEELSTOP. 94 TRASH PULL-OUT. REFER TO INTERIOR DESIGNER INTERIOR ELEVATIONS. ≻ 96 15" ICE MAKER. REFER TO INTERIOR DESIGNER SPECS FOR ADD'L INFO. > 97 24" UNDERCOUNTER REFRIGERATOR BELOW COUNTERTOP. TOP-MOUNT AUTOMATIC -COFFEE MACHINE ABOVE COUNTERTOP, REFER TO INTERIOR DESIGNER'S SPECS FOR ADDITIONAL INFORMATION.

...POWER SOURCE FOR HEAT TAPE SHALL BE 48" MIN FROM CENTER OF DRAIN,

COORDINATE WITH ROOFING SUB. PROVIDE CAST IRON OVERFLOW DRAIN, STUB

2"W x 1"T WOOD HANDRAIL AFFIXED TO WALL WITH STEEL HANDRAIL BRACKETS. RETURN

SHEET METAL DOWNSPOUT. HARDPIPE TO SUBSURFACE DRAIN SYSTEM. PROVIDE HEAT

TO WALL AT ENDS. ALLOW 1 1/2" MIN CLEAR TO ADJACENT WALL SURFACE. MOUNT 36"

30" FROM MAIN DRAIN BODY (SET TOP OF OVERFLOW DRAIN 2" ABOVE TOP OF

ABOVE THE SLOPED PLANE ADJOINING THE TREAD NOSINGS TO MEET 2018 IBC.

SHEET METAL GUTTER, REFER TO ARCHITECTURAL DETAILS FOR ADDITIONAL INFO.

PLAN NOTES

KITCHEN FREEZER T.B.D., REFER TO INTERIOR DESIGNER'S SPECS FOR ADD'L INFO. KITCHEN DISHWASHER T.B.D., REFER TO INTERIOR DESIGNER'S SPECS FOR ADD'L INFO.


- GRILL T.B.D., PROVIDE GAS HOOK UP. STACK WASHER / DRYER T.B.D., REFER TO INTERIOR DESIGNER'S DRAWINGS AND SPECIFICATIONS FOR ADDITIONAL INFORMATION. KITCHEN MICROWAVE DRAWERS T.B.D., REFER TO INTERIOR DESIGNER'S SPECS. TV. REFER TO INTERIOR DESIGNER'S SEPCIFICATIONS FOR ADD'L INFORMATION. FROST FREE HOSE BIBB, INTEGRATE IN CABINET BOX WHERE SHOWN. (5) GAS METER MANIFOLD (3 LOW, 2 HIGH), GC TO COORDINATE WITH
- INTERMOUNTAIN GAS. ELECTRICAL METERS, GC TO COORDINATE WITH IDAHO POWER.
- PHONE / CABLE / IRRIGATION EQUIPMENT
- GARAGE TRENCH DRAIN WITH SAND AND OIL INTERCEPTOR. HIGH EFFICIENCY WATER HEATER AND BOILERS T.B.D.
- ELECTRICAL PANEL AS REQUIRED.
- AC UNITS AS REQUIRED ON CONCRETE PAD OUTDOOR REFRIGERATOR T.B.D.

MONTIGO EXEMPLAR R520. GLASS VIEW SIZE: 61 1/4" x 18 1/8". HORIZONTAL FLUSH LOUVERED POWER VENT. INSTALL PER MANUFACTURER'S SPECIFICATIONS.

42

- SHOWER NICHE, REFER TO INTERIOR ELEVATIONS AND INTERIOR DESIGNER'S SPECIFICATIONS FOR ADDITIONAL INFORMATION.
- KITCHEN SINK, FAUCET, AND DISPOSAL PER INTERIOR DESIGNER'S SPECIFICATIONS. SINK AND FAUCET PER INTERIOR DESIGNERS SPECIFICATIONS.
- MASTER BATH TUB PER INTERIOR DESIGNER'S SPECIFICATIONS. MASTER BATH SHOWER HEAD AND THERMOSTATIC CONTROLS, PER INTERIOR DESIGNERS 23
- SPECIFICATIONS. MASTER BATH SHOWER DRAIN PER INTERIOR DESIGNER'S SPECIFCATIONS.
- SHOWER HEAD AND THERMOSTATIC CONTROLS PER INTERIOR DESIGNER'S SPECIFICATIONS.
- SHOWER DRAIN, REFER TO INTERIOR DESIGNER'S SPECIFICATIONS. TOILET, PER INTERIOR DESIGNERS SPECIFICATIONS.
- BATH TUB FILLER PER INTERIOR DESIGNER'S SPECIFICATIONS
- GRAB BAR. REFER TO INTERIOR ELEVATIONS FOR PLACEMENT.
- KITCHEN RANGE T.B.D., REFER TO INTERIOR DESIGNER'S SPECS FOR ADD'L INFORMATION. 27 KITCHEN RANGE HOOD T.B.D., REFER TO INTERIOR DESIGNER'S SPECS FOR ADD'L
- INFORMATION. KITCHEN REFRIGERATOR T.B.D., REFER TO INTERIOR DESIGNER'S SPECS FOR ADD'L INFORMATION.
- BUILT IN CABINET (ABOVE SHOWN DASHED), REFI INTERIOR DESIGNER'S SPECIFICATIONS FOR ADDI BUILT IN SHELVING (ABOVE SHOWN DASHED), RE INTERIOR DESIGNER'S SPECIFICATIONS FOR ADDI BUILT IN CUBBIES (ABOVE SHOWN DASHED), REFE DESIGNER'S SPECIFICATIONS FOR ADDITIONAL IN BUILT IN BENCH (ABOVE SHOWN DASHED), REFER DESIGNER'S SPECIFICATIONS FOR ADDITIONAL IN BUILT IN DRESSER (ABOVE SHOWN DASHED), REFE DESIGNER'S SPECIFICATIONS FOR ADDITIONAL IN CLOSET CABINETS (ABOVE SHOWN DASHED), REF INTERIOR DESIGNER'S SPECIFICATIONS FOR ADDI CLOSET ROD AND SHELF (ABOVE SHOWN DASHE INTERIOR DESIGNER'S SPECIFICATIONS FOR ADDI HOOKS, REFER TO INTERIOR ELEVATIONS AND IN INFO. SHOWER BENCH, REFER TO INTERIOR ELEVATION

ADDITIONAL INFORMATION.

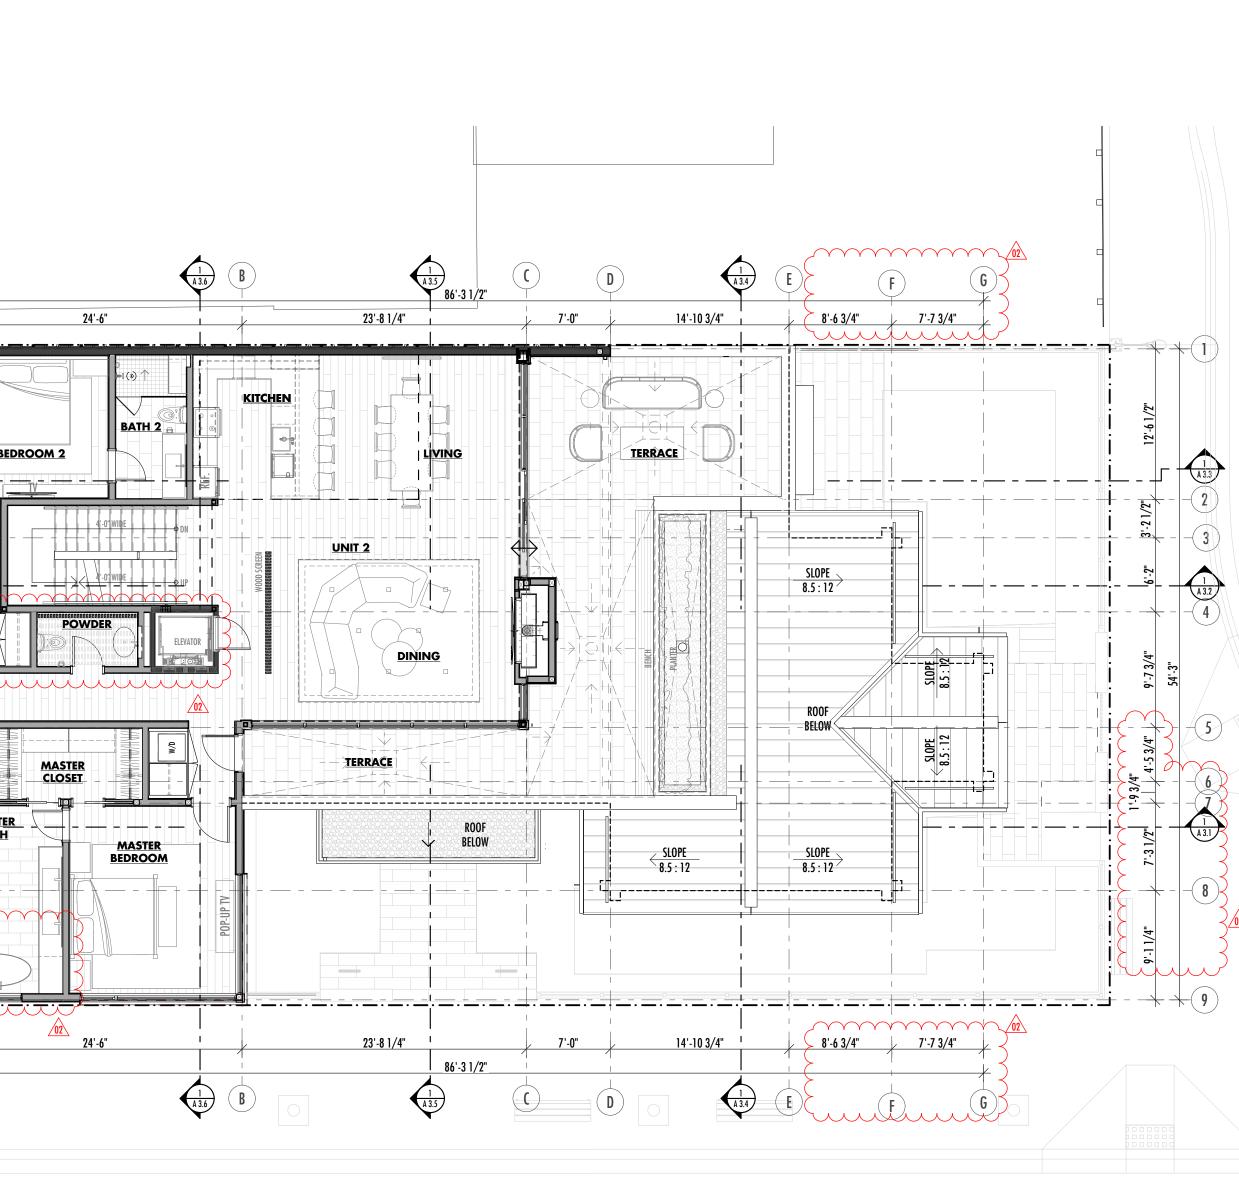

FOURTH STREET

PLAN NOTES

20

22

PLAN NOTES

LINE OF ROOF ABOVE (SHOWN DASHED).

LINE OF OUTRIGGER ABOVE (SHOWN DASHED).

WOOD SCREEN, REFER TO ARCHITECTURAL DETAILS.

LINE OF BEAM ABOVE (SHOWN DASHED).

LINE OF WALL ABOVE (SHOWN DASHED).

FER TO INTERIOR ELEVATIONS AND	01
DITIONAL INFORMATION.	02
EFER TO INTERIOR ELEVATIONS AND	03
DITIONAL INFORMATION.	04
FER TO INTERIOR ELEVATIONS AND INTERIOR	05
NFORMATION.	06
ER TO INTERIOR ELEVATIONS AND INTERIOR	07
NFORMATION.	08
FER TO INTERIOR ELEVATIONS AND INTERIOR	. 09
NFORMATION.	10
EFER TO INTERIOR ELEVATIONS AND	11
DITIONAL INFORMATION.	12
IED), REFER TO INTERIOR ELEVATIONS AND	13
DITIONAL INFORMATION.	
NTERIOR DESIGNER'S SPECS FOR ADD'L	14
NS AND INTERIOR DESIGNER'S SPECS FOR	15
	16

LINE OF COLUMN ABOVE (SHOWN DASHED). LINE OF FOOTING BELOW (SHOWN DASHED). LINE OF COLUMN BELOW (SHOWN DASHED). LINE OF WALL BELOW (SHOWN DASHED). LINE OF ROOF BELOW (SHOWN DASHED). PARAPET WALL BELOW LINE OF ROOF EDGE. LINE OF FOOTING, REFER TO STRUCTURAL DRAWINGS FOR ADDITIONAL INFORMATION. STEEL COLUMN, REFER TO ARCHITECTURAL DETAILS AND STRUCTURAL DRAWINGS FOR ADDITIONAL INFORMATION. CRAWL SPACE ACCESS, REFER TO STRUCTURAL DRAWINGS FOR ADDITIONAL INFORMATION. BENCH.

GENERAL NOTES

COORDINATE ALL WORK WITH ARCHITECTURAL DRAWINGS AND SPECIFICATIONS.

DO NOT SCALE DRAWINGS.

CONTRACTOR AND SUB-CONTRACTORS SHALL FAMILIARIZE THEMSELVES WITH EXISTING CONDITIONS, LOCATIONS, AND PROJECT REQUIREMENTS PRIOR TO SUBMITTING A BID.

CONTRACTOR AND SUB-CONTRACTORS SHALL FIELD VERIFY DIMENSIONS. ANY DISCREPANCIES SHALL BE REPORTED TO THE ARCHITECT.

CONTRACTOR SHALL PATCH, REPAIR AND REFINISH ANY EXISTING ELEMENTS REMOVED OR DAMAGED DURING DEMOLITION AND/OR CONSTRUCTION.

PROTECTION SHALL BE PROVIDED TO ALL EXISTING BUILDING ELEMENTS AS REQUIRED.

REFER TO STRUCTURAL DRAWINGS FOR FOUNDATION PLANS, FOOTING LOCATIONS AND SIZES.

BUILDING SECTIONS DO NOT DEPICT EXACT STRUCTURAL CONDITIONS FOR ALL STRUCTURAL COMPONENTS OF THE BUILDING. REFER TO STRUCTURAL DRAWINGS FOR ALL STRUCTURAL COMPONENTS AND SPECIFICATIONS.

PROVIDE BACKING / BLOCKING PER MANUFACTURER'S RECOMENDATIONS FOR ALL WALL AND CEILING MOUNTED FIXTURES, EQUIPMENT AND CASEWORK. FOLLOW ALL RECOMMENDATIONS FOR INSTALLATION FOR THEIR SPECIFIC PRODUCT.

INTERIOR AND EXTERIOR ELEVATIONS EXIST THAT MAY NOT BE DEPICTED IN ELEVATION, BUT ARE CLEARLY SHOWN AND REFERENCEED IN PLAN. IT REMAINS THE RESPONSIBILITY OF THE CONTRACTOR / SUB-CONTRACTORS TO IDENTIFY AND INCLUDE ALL SUCH AREAS IN THEIR PROJECT PRICING AND/OR BID SCOPE OF WORK.

ADVANCED FRAMING TECHNIQUES SHALL BE PERFORMED.

ALL APPLICABLE BUILDING CODES SHALL BE FOLLOWED.



KETCHUM, IDAHO 83340 PHONE 208.726.0020 FAX 208.726.0019 WWW WILLIAMS-PARTNERS.COM

DRAWINGS

DATE: ISSUED: 06/10/2021 | COK HPC REVIEW 09/30/2021 DESIGN REVIEW 04/22/2022 PRICING SET 08/05/2022 PERMIT

05/12/2021 COK SCHEMATIC PRESENTATION 08/02/2023 ISSUED FOR CONSTRUCTION REVISIONS

NUMBER: DATE: 01 02/17/2023 02 08/02/2023





<u>/01</u>

ENUE

FIRST

MEMBRANE).

75 cont.

76

90

PLAN NOTES

65

68

70

73

- EXTERIOR GAS FIRE PIT T.B.D.
- SNOW RETENTION BARS, REFER TO KEYNOTE [5.07] AND ARCHITECTURAL DETAILS FOR MORE INFORMATION. LUTRON SIVIOA SHADE POCKET BOX WITH TUBE AND DRIVE AS RECOMENDED BY
- MANUFACTURER. REFER TO DETAILS FOR RECESSED SHADES AND VALENCE DETAILS FOR DUAL ROLL AND SINGLE ROLL SHADE BOXES. SUPPLY AIR GRILLE T.B.D., SEE SYTEMS NOTES FOR ADDITIONAL INFORMATION.
- RETURN AIR GRILLE T.B.D., SEE SYTEMS NOTES FOR ADDITIONAL INFORMATION. PANASONIC "WHISPER CEILING" SPOT VENTILATION FAN (290CFM) PRODUCT NO. "FV-30VQ3", OR APPROVED EQUAL, INSTALL PER MANUFACTURER'S SPEICIFICATIONS. HARDWIRED, INTERCONNECTED SMOKE + CARBON MONOXIDE DETECTOR IN
- ACCORDANCE WITH 2018 IRC, SECTION R314.4. NEST PROTECT, OR APPROVED EQUAL. 57 PROVIDE AND INSTALL RADON MITIGATION SYSTEM PER APPENDIX F RADON CONTROL METHODS (AF 130, IRC 2018). CAST IRON ROOF DRAIN AND DOME WITH MEMBRANE FLASHING CAP. INSTALL IN A 60

2'x2' BOX 4 3/8" ABOVE OF ROOF SHEATHING (COORDINATE AND VERIFY WITH FINAL 61 FOAM PLAN). 4-BAND COUPLINGS TO BE PROVIDED FOR ANY NO-HUB OUTLETS AT 62 DRAIN BODIES WITH VERTICAL OUTLETS, SIDE OUTLET DRAIN BODIES TO HAVE THREADED OUTLET TO 3" DIA CAST IRON DRAIN PIPE. PROVIDE HEAT TAPE AT DRAIN BODY, (5) DAISY CHAIN LOOPS AT 3 LF EACH, ADHERE WITH 5" EPDM TAPE, POWER..

TAPE TO 30" MIN. BELOW GRADE. PROVIDE ELECTRICAL FOR HEAT TAPE. REFER TO ARCHITECTURAL DETAILS AND LANDSCAPE PLANS FOR ADDITIONAL INFORMATION. TWO-STOP RESIDENTIAL ELEVATOR T.B.D. INSTALL PER MANUFACTURER'S SPECIFICATIONS. 92 DOWNSPOUT. HARDPIPE TO SUBSURFACE DRAIN SYSTEM. 93 75 VEHICULAR WHEELSTOP. 94 TRASH PULL-OUT. REFER TO INTERIOR DESIGNER INTERIOR ELEVATIONS. 15" ICE MAKER. REFER TO INTERIOR DESIGNER SPECS FOR ADD'L INFO. ≻ 96 > 97 24" UNDERCOUNTER REFRIGERATOR BELOW COUNTERTOP. TOP-MOUNT AUTOMATIC -COFFEE MACHINE ABOVE COUNTERTOP, REFER TO INTERIOR DESIGNER'S SPECS FOR ADDITIONAL INFORMATION.

...POWER SOURCE FOR HEAT TAPE SHALL BE 48" MIN FROM CENTER OF DRAIN,

COORDINATE WITH ROOFING SUB. PROVIDE CAST IRON OVERFLOW DRAIN, STUB

2"W x 1"T WOOD HANDRAIL AFFIXED TO WALL WITH STEEL HANDRAIL BRACKETS. RETURN


SHEET METAL DOWNSPOUT. HARDPIPE TO SUBSURFACE DRAIN SYSTEM. PROVIDE HEAT

TO WALL AT ENDS. ALLOW 1 1/2" MIN CLEAR TO ADJACENT WALL SURFACE. MOUNT 36"

30" FROM MAIN DRAIN BODY (SET TOP OF OVERFLOW DRAIN 2" ABOVE TOP OF

ABOVE THE SLOPED PLANE ADJOINING THE TREAD NOSINGS TO MEET 2018 IBC.

SHEET METAL GUTTER, REFER TO ARCHITECTURAL DETAILS FOR ADDITIONAL INFO.

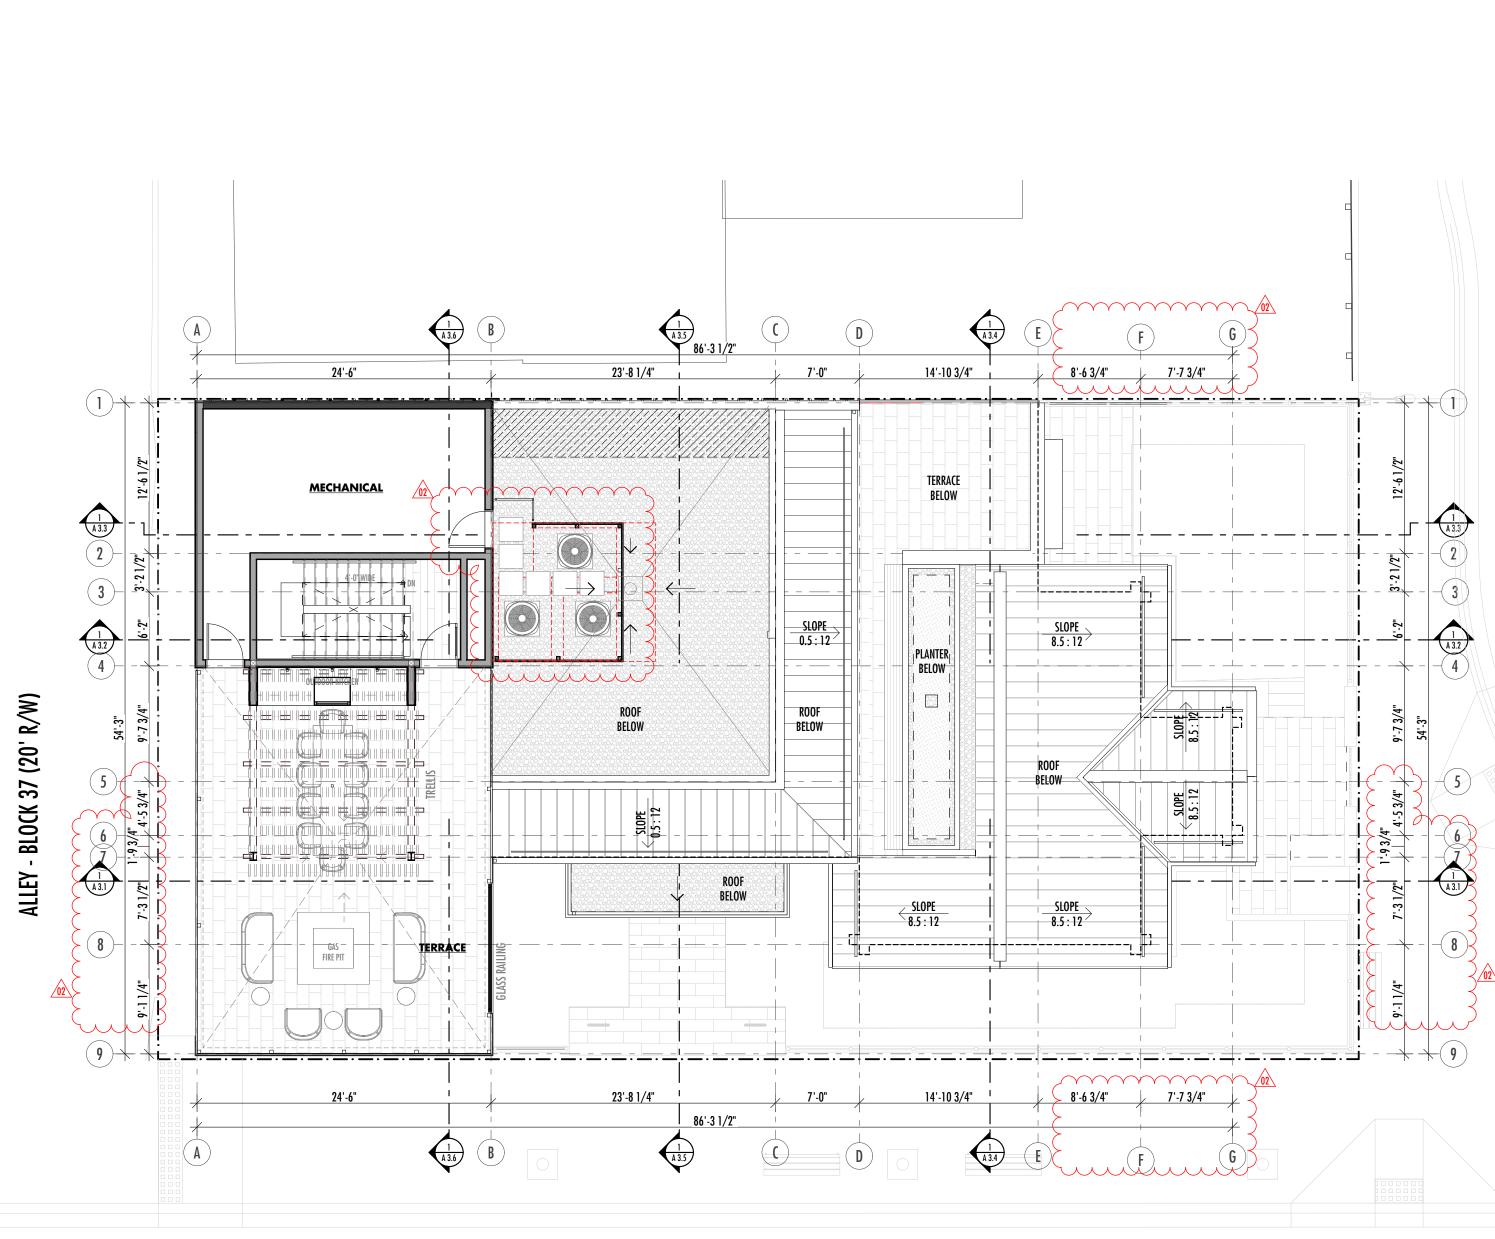

63

PLAN NOTES

- KITCHEN FREEZER T.B.D., REFER TO INTERIOR DESIGNER'S SPECS FOR ADD'L INFO. KITCHEN DISHWASHER T.B.D., REFER TO INTERIOR DESIGNER'S SPECS FOR ADD'L INFO. GRILL T.B.D., PROVIDE GAS HOOK UP.
- STACK WASHER / DRYER T.B.D., REFER TO INTERIOR DESIGNER'S DRAWINGS AND SPECIFICATIONS FOR ADDITIONAL INFORMATION. KITCHEN MICROWAVE DRAWERS T.B.D., REFER TO INTERIOR DESIGNER'S SPECS. TV. REFER TO INTERIOR DESIGNER'S SEPCIFICATIONS FOR ADD'L INFORMATION.
- FROST FREE HOSE BIBB, INTEGRATE IN CABINET BOX WHERE SHOWN. (5) GAS METER MANIFOLD (3 LOW, 2 HIGH), GC TO COORDINATE WITH INTERMOUNTAIN GAS. ELECTRICAL METERS, GC TO COORDINATE WITH IDAHO POWER.
- PHONE / CABLE / IRRIGATION EQUIPMENT
- GARAGE TRENCH DRAIN WITH SAND AND OIL INTERCEPTOR. HIGH EFFICIENCY WATER HEATER AND BOILERS T.B.D.
- ELECTRICAL PANEL AS REQUIRED.
- AC UNITS AS REQUIRED ON CONCRETE PAD OUTDOOR REFRIGERATOR T.B.D.
- MONTIGO EXEMPLAR R520. GLASS VIEW SIZE: 61 1/4" x 18 1/8". HORIZONTAL FLUSH LOUVERED POWER VENT. INSTALL PER MANUFACTURER'S SPECIFICATIONS.

42

- SHOWER NICHE, REFER TO INTERIOR ELEVATIONS AND INTERIOR DESIGNER'S SPECIFICATIONS FOR ADDITIONAL INFORMATION.
- KITCHEN SINK, FAUCET, AND DISPOSAL PER INTERIOR DESIGNER'S SPECIFICATIONS. SINK AND FAUCET PER INTERIOR DESIGNERS SPECIFICATIONS.
- MASTER BATH TUB PER INTERIOR DESIGNER'S SPECIFICATIONS. 22 MASTER BATH SHOWER HEAD AND THERMOSTATIC CONTROLS, PER INTERIOR DESIGNERS 23
- SPECIFICATIONS. MASTER BATH SHOWER DRAIN PER INTERIOR DESIGNER'S SPECIFCATIONS.
- SHOWER HEAD AND THERMOSTATIC CONTROLS PER INTERIOR DESIGNER'S SPECIFICATIONS.
- SHOWER DRAIN, REFER TO INTERIOR DESIGNER'S SPECIFICATIONS.
- TOILET, PER INTERIOR DESIGNERS SPECIFICATIONS. BATH TUB FILLER PER INTERIOR DESIGNER'S SPECIFICATIONS
- GRAB BAR. REFER TO INTERIOR ELEVATIONS FOR PLACEMENT.
- KITCHEN RANGE T.B.D., REFER TO INTERIOR DESIGNER'S SPECS FOR ADD'L INFORMATION. 27 KITCHEN RANGE HOOD T.B.D., REFER TO INTERIOR DESIGNER'S SPECS FOR ADD'L
- INFORMATION. KITCHEN REFRIGERATOR T.B.D., REFER TO INTERIOR DESIGNER'S SPECS FOR ADD'L INFORMATION.
- PLAN NOTES BUILT IN CABINET (ABOVE SHOWN DASHED), REF INTERIOR DESIGNER'S SPECIFICATIONS FOR ADDI BUILT IN SHELVING (ABOVE SHOWN DASHED), RE INTERIOR DESIGNER'S SPECIFICATIONS FOR ADDI BUILT IN CUBBIES (ABOVE SHOWN DASHED), REFE DESIGNER'S SPECIFICATIONS FOR ADDITIONAL IN BUILT IN BENCH (ABOVE SHOWN DASHED), REFER DESIGNER'S SPECIFICATIONS FOR ADDITIONAL IN BUILT IN DRESSER (ABOVE SHOWN DASHED), REFE DESIGNER'S SPECIFICATIONS FOR ADDITIONAL IN CLOSET CABINETS (ABOVE SHOWN DASHED), REF INTERIOR DESIGNER'S SPECIFICATIONS FOR ADDI CLOSET ROD AND SHELF (ABOVE SHOWN DASHE INTERIOR DESIGNER'S SPECIFICATIONS FOR ADDI HOOKS, REFER TO INTERIOR ELEVATIONS AND IN INFO. SHOWER BENCH, REFER TO INTERIOR ELEVATION

ADDITIONAL INFORMATION.

20

FOURTH STREET

PLAN NOTES

LINE OF ROOF ABOVE (SHOWN DASHED).

LINE OF OUTRIGGER ABOVE (SHOWN DASHED).

WOOD SCREEN, REFER TO ARCHITECTURAL DETAILS.

LINE OF BEAM ABOVE (SHOWN DASHED).

LINE OF WALL ABOVE (SHOWN DASHED).

FER TO INTERIOR ELEVATIONS AND	01
DITIONAL INFORMATION.	02
EFER TO INTERIOR ELEVATIONS AND	03
DITIONAL INFORMATION.	04
FER TO INTERIOR ELEVATIONS AND INTERIOR	05
NFORMATION.	06
ER TO INTERIOR ELEVATIONS AND INTERIOR	07
NFORMATION.	08
FER TO INTERIOR ELEVATIONS AND INTERIOR	09
NFORMATION.	10
EFER TO INTERIOR ELEVATIONS AND	11
DITIONAL INFORMATION.	12
IED), REFER TO INTERIOR ELEVATIONS AND	13
DITIONAL INFORMATION.	
NTERIOR DESIGNER'S SPECS FOR ADD'L	14
NS AND INTERIOR DESIGNER'S SPECS FOR	15
	16

LINE OF COLUMN ABOVE (SHOWN DASHED). LINE OF FOOTING BELOW (SHOWN DASHED). LINE OF COLUMN BELOW (SHOWN DASHED). LINE OF WALL BELOW (SHOWN DASHED). LINE OF ROOF BELOW (SHOWN DASHED). PARAPET WALL BELOW LINE OF ROOF EDGE. LINE OF FOOTING, REFER TO STRUCTURAL DRAWINGS FOR ADDITIONAL INFORMATION. STEEL COLUMN, REFER TO ARCHITECTURAL DETAILS AND STRUCTURAL DRAWINGS FOR ADDITIONAL INFORMATION. CRAWL SPACE ACCESS, REFER TO STRUCTURAL DRAWINGS FOR ADDITIONAL INFORMATION. BENCH.

GENERAL NOTES

COORDINATE ALL WORK WITH ARCHITECTURAL DRAWINGS AND SPECIFICATIONS.

DO NOT SCALE DRAWINGS.

CONTRACTOR AND SUB-CONTRACTORS SHALL FAMILIARIZE THEMSELVES WITH EXISTING CONDITIONS, LOCATIONS, AND PROJECT REQUIREMENTS PRIOR TO SUBMITTING A BID.

CONTRACTOR AND SUB-CONTRACTORS SHALL FIELD VERIFY DIMENSIONS. ANY DISCREPANCIES SHALL BE REPORTED TO THE ARCHITECT.

CONTRACTOR SHALL PATCH, REPAIR AND REFINISH ANY EXISTING ELEMENTS REMOVED OR DAMAGED DURING DEMOLITION AND/OR CONSTRUCTION.

PROTECTION SHALL BE PROVIDED TO ALL EXISTING BUILDING ELEMENTS AS REQUIRED.

REFER TO STRUCTURAL DRAWINGS FOR FOUNDATION PLANS, FOOTING LOCATIONS AND SIZES.

BUILDING SECTIONS DO NOT DEPICT EXACT STRUCTURAL CONDITIONS FOR ALL STRUCTURAL COMPONENTS OF THE BUILDING. REFER TO STRUCTURAL DRAWINGS FOR ALL STRUCTURAL COMPONENTS AND SPECIFICATIONS.

PROVIDE BACKING / BLOCKING PER MANUFACTURER'S RECOMENDATIONS FOR ALL WALL AND CEILING MOUNTED FIXTURES, EQUIPMENT AND CASEWORK. FOLLOW ALL RECOMMENDATIONS FOR INSTALLATION FOR THEIR SPECIFIC PRODUCT.

INTERIOR AND EXTERIOR ELEVATIONS EXIST THAT MAY NOT BE DEPICTED IN ELEVATION, BUT ARE CLEARLY SHOWN AND REFERENCEED IN PLAN. IT REMAINS THE RESPONSIBILITY OF THE CONTRACTOR / SUB-CONTRACTORS TO IDENTIFY AND INCLUDE ALL SUCH AREAS IN THEIR PROJECT PRICING AND/OR BID SCOPE OF WORK.

ADVANCED FRAMING TECHNIQUES SHALL BE PERFORMED.

ALL APPLICABLE BUILDING CODES SHALL BE FOLLOWED.



83340 PHONE 208.726.0020 FAX 208.726.0019 WWW WILLIAMS-PARTNERS.COM


DRAWINGS

DATE: ISSUED: 05/12/2021 COK SCHEMATIC PRESENTATION 06/10/2021 | COK HPC REVIEW 09/30/2021 DESIGN REVIEW 04/22/2022 PRICING SET 08/05/2022 PERMIT

08/02/2023 ISSUED FOR CONSTRUCTION REVISIONS

NUMBER: DATE: 01 02/17/2023 02 08/02/2023



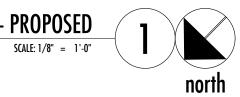

<u>/01</u>

ENUE

FIRST

MEMBRANE).

75 cont.

76

90

92

93

PLAN NOTES 65

68

70

72

73

74

- EXTERIOR GAS FIRE PIT T.B.D.
- SNOW RETENTION BARS, REFER TO KEYNOTE [5.07] AND ARCHITECTURAL DETAILS FOR MORE INFORMATION. LUTRON SIVIOA SHADE POCKET BOX WITH TUBE AND DRIVE AS RECOMENDED BY
- MANUFACTURER. REFER TO DETAILS FOR RECESSED SHADES AND VALENCE DETAILS FOR DUAL ROLL AND SINGLE ROLL SHADE BOXES. SUPPLY AIR GRILLE T.B.D., SEE SYTEMS NOTES FOR ADDITIONAL INFORMATION.
- RETURN AIR GRILLE T.B.D., SEE SYTEMS NOTES FOR ADDITIONAL INFORMATION. PANASONIC "WHISPER CEILING" SPOT VENTILATION FAN (290CFM) PRODUCT NO. "FV-30VQ3", OR APPROVED EQUAL, INSTALL PER MANUFACTURER'S SPEICIFICATIONS. HARDWIRED, INTERCONNECTED SMOKE + CARBON MONOXIDE DETECTOR IN
- ACCORDANCE WITH 2018 IRC, SECTION R314.4. NEST PROTECT, OR APPROVED EQUAL. 57 PROVIDE AND INSTALL RADON MITIGATION SYSTEM PER APPENDIX F RADON CONTROL METHODS (AF 130, IRC 2018). CAST IRON ROOF DRAIN AND DOME WITH MEMBRANE FLASHING CAP. INSTALL IN A 60

2'x2' BOX 4 3/8" ABOVE OF ROOF SHEATHING (COORDINATE AND VERIFY WITH FINAL 61 FOAM PLAN). 4-BAND COUPLINGS TO BE PROVIDED FOR ANY NO-HUB OUTLETS AT 62 DRAIN BODIES WITH VERTICAL OUTLETS, SIDE OUTLET DRAIN BODIES TO HAVE THREADED OUTLET TO 3" DIA CAST IRON DRAIN PIPE. PROVIDE HEAT TAPE AT DRAIN BODY, (5) DAISY CHAIN LOOPS AT 3 LF EACH, ADHERE WITH 5" EPDM TAPE, POWER..

DOWNSPOUT. HARDPIPE TO SUBSURFACE DRAIN SYSTEM. 75 VEHICULAR WHEELSTOP. 94 TRASH PULL-OUT. REFER TO INTERIOR DESIGNER INTERIOR ELEVATIONS. 95 ≻ 96 15" ICE MAKER. REFER TO INTERIOR DESIGNER SPECS FOR ADD'L INFO. > 97 24" UNDERCOUNTER REFRIGERATOR BELOW COUNTERTOP. TOP-MOUNT AUTOMATIC -COFFEE MACHINE ABOVE COUNTERTOP, REFER TO INTERIOR DESIGNER'S SPECS FOR ADDITIONAL INFORMATION.

...POWER SOURCE FOR HEAT TAPE SHALL BE 48" MIN FROM CENTER OF DRAIN,

COORDINATE WITH ROOFING SUB. PROVIDE CAST IRON OVERFLOW DRAIN, STUB

2"W x 1"T WOOD HANDRAIL AFFIXED TO WALL WITH STEEL HANDRAIL BRACKETS. RETURN

SHEET METAL DOWNSPOUT. HARDPIPE TO SUBSURFACE DRAIN SYSTEM. PROVIDE HEAT

TWO-STOP RESIDENTIAL ELEVATOR T.B.D. INSTALL PER MANUFACTURER'S SPECIFICATIONS.

TO WALL AT ENDS. ALLOW 1 1/2" MIN CLEAR TO ADJACENT WALL SURFACE. MOUNT 36"


30" FROM MAIN DRAIN BODY (SET TOP OF OVERFLOW DRAIN 2" ABOVE TOP OF

ABOVE THE SLOPED PLANE ADJOINING THE TREAD NOSINGS TO MEET 2018 IBC.

SHEET METAL GUTTER, REFER TO ARCHITECTURAL DETAILS FOR ADDITIONAL INFO.

TAPE TO 30" MIN. BELOW GRADE. PROVIDE ELECTRICAL FOR HEAT TAPE. REFER TO

ARCHITECTURAL DETAILS AND LANDSCAPE PLANS FOR ADDITIONAL INFORMATION.

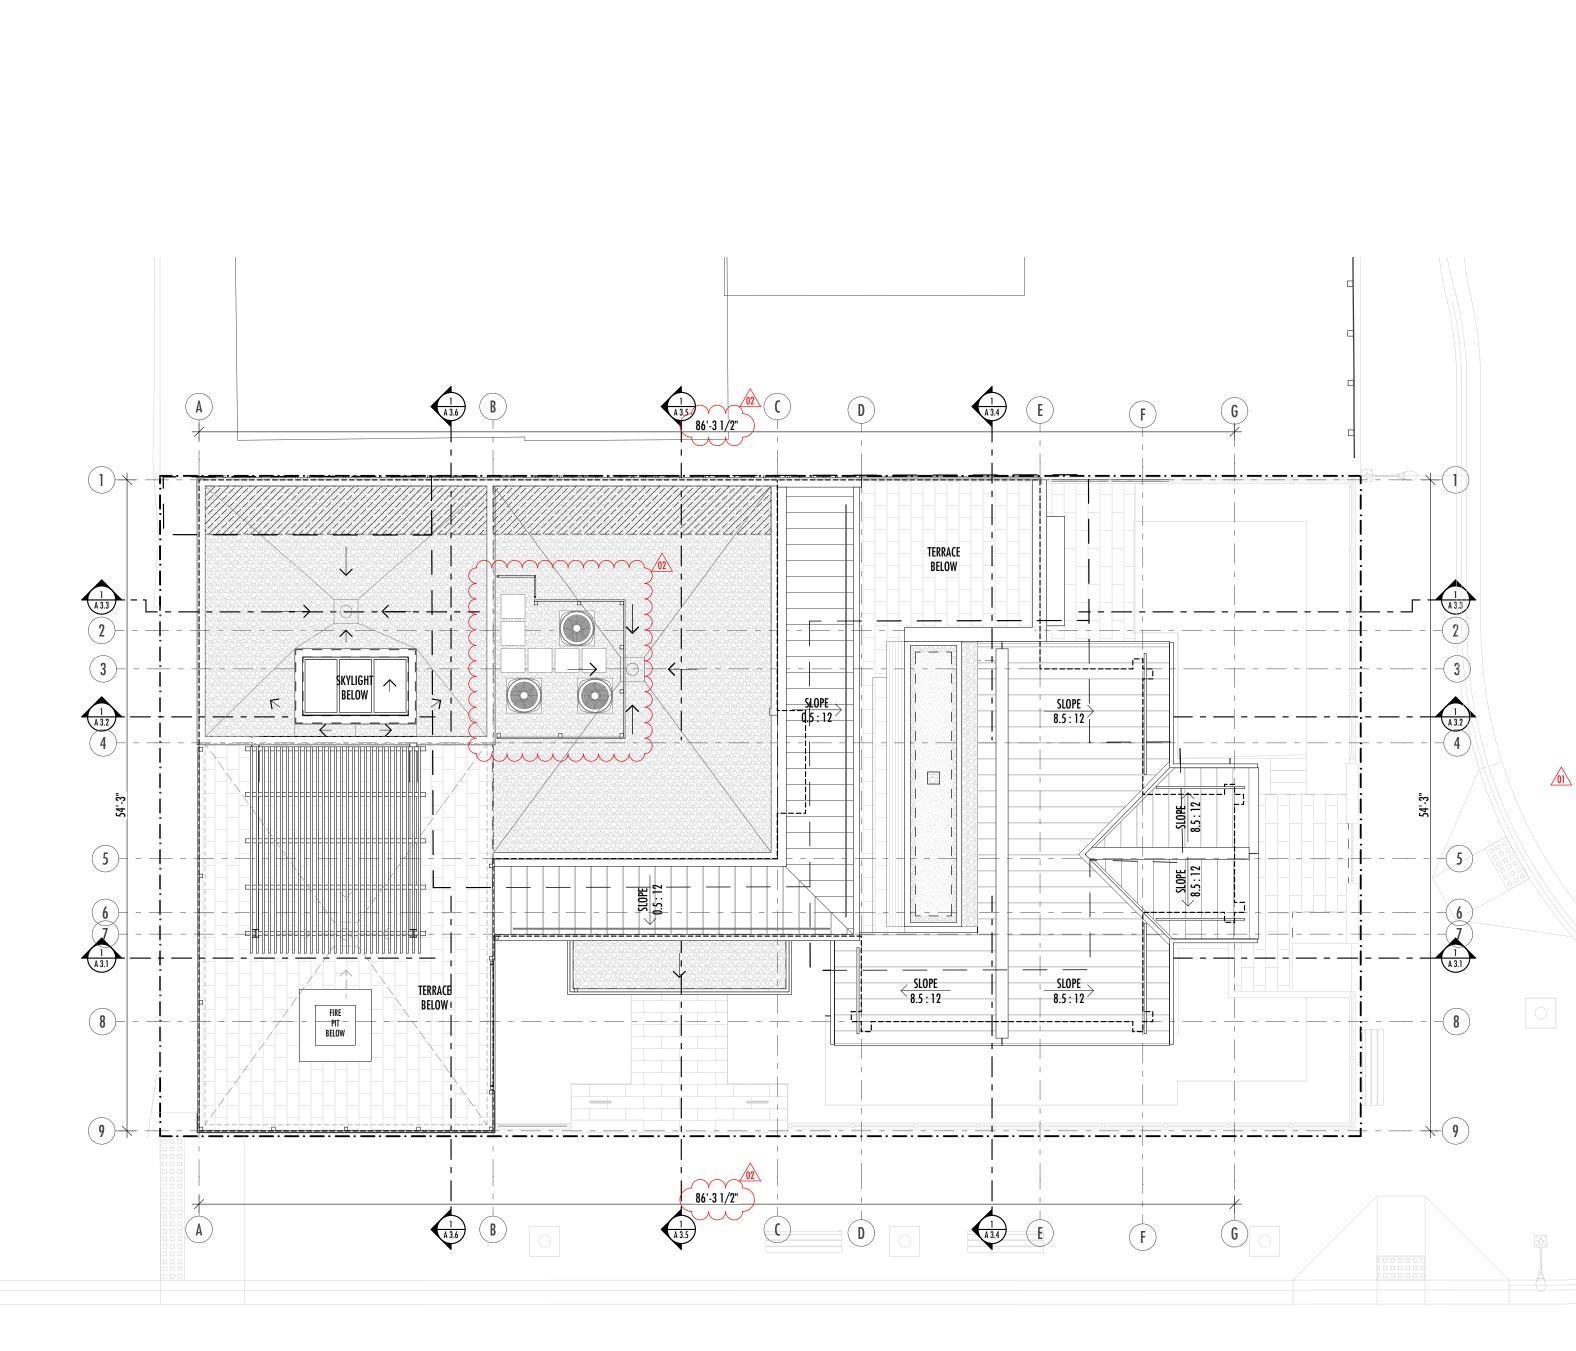

PLAN NOTES

KITCHEN FREEZER T.B.D., REFER TO INTERIOR DESIGNER'S SPECS FOR ADD'L INFO. KITCHEN DISHWASHER T.B.D., REFER TO INTERIOR DESIGNER'S SPECS FOR ADD'L INFO. GRILL T.B.D., PROVIDE GAS HOOK UP.

- STACK WASHER / DRYER T.B.D., REFER TO INTERIOR DESIGNER'S DRAWINGS AND SPECIFICATIONS FOR ADDITIONAL INFORMATION. KITCHEN MICROWAVE DRAWERS T.B.D., REFER TO INTERIOR DESIGNER'S SPECS. TV. REFER TO INTERIOR DESIGNER'S SEPCIFICATIONS FOR ADD'L INFORMATION. FROST FREE HOSE BIBB, INTEGRATE IN CABINET BOX WHERE SHOWN. (5) GAS METER MANIFOLD (3 LOW, 2 HIGH), GC TO COORDINATE WITH
- INTERMOUNTAIN GAS. ELECTRICAL METERS, GC TO COORDINATE WITH IDAHO POWER.
- PHONE / CABLE / IRRIGATION EQUIPMENT GARAGE TRENCH DRAIN WITH SAND AND OIL INTERCEPTOR.
- HIGH EFFICIENCY WATER HEATER AND BOILERS T.B.D.
- ELECTRICAL PANEL AS REQUIRED. AC UNITS AS REQUIRED ON CONCRETE PAD
- OUTDOOR REFRIGERATOR T.B.D.
- MONTIGO EXEMPLAR R520. GLASS VIEW SIZE: 61 1/4" x 18 1/8". HORIZONTAL FLUSH LOUVERED POWER VENT. INSTALL PER MANUFACTURER'S SPECIFICATIONS.

42

- SHOWER NICHE, REFER TO INTERIOR ELEVATIONS AND INTERIOR DESIGNER'S SPECIFICATIONS FOR ADDITIONAL INFORMATION.
- KITCHEN SINK, FAUCET, AND DISPOSAL PER INTERIOR DESIGNER'S SPECIFICATIONS. SINK AND FAUCET PER INTERIOR DESIGNERS SPECIFICATIONS.
- MASTER BATH TUB PER INTERIOR DESIGNER'S SPECIFICATIONS. 22 MASTER BATH SHOWER HEAD AND THERMOSTATIC CONTROLS, PER INTERIOR DESIGNERS 23
- SPECIFICATIONS. MASTER BATH SHOWER DRAIN PER INTERIOR DESIGNER'S SPECIFCATIONS.
- SHOWER HEAD AND THERMOSTATIC CONTROLS PER INTERIOR DESIGNER'S SPECIFICATIONS.
- SHOWER DRAIN, REFER TO INTERIOR DESIGNER'S SPECIFICATIONS.
- TOILET, PER INTERIOR DESIGNERS SPECIFICATIONS. BATH TUB FILLER PER INTERIOR DESIGNER'S SPECIFICATIONS.
- GRAB BAR. REFER TO INTERIOR ELEVATIONS FOR PLACEMENT. KITCHEN RANGE T.B.D., REFER TO INTERIOR DESIGNER'S SPECS FOR ADD'L INFORMATION. 27
- KITCHEN RANGE HOOD T.B.D., REFER TO INTERIOR DESIGNER'S SPECS FOR ADD'L
- INFORMATION. KITCHEN REFRIGERATOR T.B.D., REFER TO INTERIOR DESIGNER'S SPECS FOR ADD'L INFORMATION.
- PLAN NOTES BUILT IN CABINET (ABOVE SHOWN DASHED), REFI INTERIOR DESIGNER'S SPECIFICATIONS FOR ADDI BUILT IN SHELVING (ABOVE SHOWN DASHED), RE INTERIOR DESIGNER'S SPECIFICATIONS FOR ADDI BUILT IN CUBBIES (ABOVE SHOWN DASHED), REFE DESIGNER'S SPECIFICATIONS FOR ADDITIONAL IN BUILT IN BENCH (ABOVE SHOWN DASHED), REFER DESIGNER'S SPECIFICATIONS FOR ADDITIONAL IN BUILT IN DRESSER (ABOVE SHOWN DASHED), REFE DESIGNER'S SPECIFICATIONS FOR ADDITIONAL IN CLOSET CABINETS (ABOVE SHOWN DASHED), REF INTERIOR DESIGNER'S SPECIFICATIONS FOR ADDI CLOSET ROD AND SHELF (ABOVE SHOWN DASHE INTERIOR DESIGNER'S SPECIFICATIONS FOR ADDI HOOKS, REFER TO INTERIOR ELEVATIONS AND IN INFO.

20

SHOWER BENCH, REFER TO INTERIOR ELEVATIONS ADDITIONAL INFORMATION.

ROOF PLAN - PROPOSED

PLAN NOTES

LINE OF ROOF ABOVE (SHOWN DASHED).

LINE OF OUTRIGGER ABOVE (SHOWN DASHED).

WOOD SCREEN, REFER TO ARCHITECTURAL DETAILS.

LINE OF BEAM ABOVE (SHOWN DASHED).

LINE OF WALL ABOVE (SHOWN DASHED).

FER TO INTERIOR ELEVATIONS AND	01
DITIONAL INFORMATION.	02
EFER TO INTERIOR ELEVATIONS AND	03
DITIONAL INFORMATION.	04
FER TO INTERIOR ELEVATIONS AND INTERIOR	05
NFORMATION.	06
ER TO INTERIOR ELEVATIONS AND INTERIOR	07
NFORMATION.	08
FER TO INTERIOR ELEVATIONS AND INTERIOR	. 09
NFORMATION.	10
FER TO INTERIOR ELEVATIONS AND	11
DITIONAL INFORMATION.	12
ED), REFER TO INTERIOR ELEVATIONS AND	13
DITIONAL INFORMATION.	
NTERIOR DESIGNER'S SPECS FOR ADD'L	14
NS AND INTERIOR DESIGNER'S SPECS FOR	15
	16

LINE OF COLUMN ABOVE (SHOWN DASHED). LINE OF FOOTING BELOW (SHOWN DASHED). LINE OF COLUMN BELOW (SHOWN DASHED). LINE OF WALL BELOW (SHOWN DASHED). LINE OF ROOF BELOW (SHOWN DASHED). PARAPET WALL BELOW LINE OF ROOF EDGE. LINE OF FOOTING, REFER TO STRUCTURAL DRAWINGS FOR ADDITIONAL INFORMATION. STEEL COLUMN, REFER TO ARCHITECTURAL DETAILS AND STRUCTURAL DRAWINGS FOR ADDITIONAL INFORMATION. CRAWL SPACE ACCESS, REFER TO STRUCTURAL DRAWINGS FOR ADDITIONAL INFORMATION. BENCH.

GENERAL NOTES

COORDINATE ALL WORK WITH ARCHITECTURAL DRAWINGS AND SPECIFICATIONS.

DO NOT SCALE DRAWINGS.

CONTRACTOR AND SUB-CONTRACTORS SHALL FAMILIARIZE THEMSELVES WITH EXISTING CONDITIONS, LOCATIONS, AND PROJECT REQUIREMENTS PRIOR TO SUBMITTING A BID.

CONTRACTOR AND SUB-CONTRACTORS SHALL FIELD VERIFY DIMENSIONS. ANY DISCREPANCIES SHALL BE REPORTED TO THE ARCHITECT.

CONTRACTOR SHALL PATCH, REPAIR AND REFINISH ANY EXISTING ELEMENTS REMOVED OR DAMAGED DURING DEMOLITION AND/OR CONSTRUCTION.

PROTECTION SHALL BE PROVIDED TO ALL EXISTING BUILDING ELEMENTS AS REQUIRED.

REFER TO STRUCTURAL DRAWINGS FOR FOUNDATION PLANS, FOOTING LOCATIONS AND SIZES.


BUILDING SECTIONS DO NOT DEPICT EXACT STRUCTURAL CONDITIONS FOR ALL STRUCTURAL COMPONENTS OF THE BUILDING. REFER TO STRUCTURAL DRAWINGS FOR ALL STRUCTURAL COMPONENTS AND SPECIFICATIONS.

PROVIDE BACKING / BLOCKING PER MANUFACTURER'S RECOMENDATIONS FOR ALL WALL AND CEILING MOUNTED FIXTURES, EQUIPMENT AND CASEWORK. FOLLOW ALL RECOMMENDATIONS FOR INSTALLATION FOR THEIR SPECIFIC PRODUCT.

INTERIOR AND EXTERIOR ELEVATIONS EXIST THAT MAY NOT BE DEPICTED IN ELEVATION, BUT ARE CLEARLY SHOWN AND REFERENCEED IN PLAN. IT REMAINS THE RESPONSIBILITY OF THE CONTRACTOR / SUB-CONTRACTORS TO IDENTIFY AND INCLUDE ALL SUCH AREAS IN THEIR PROJECT PRICING AND/OR BID SCOPE OF WORK.

ADVANCED FRAMING TECHNIQUES SHALL BE PERFORMED.

ALL APPLICABLE BUILDING CODES SHALL BE FOLLOWED.

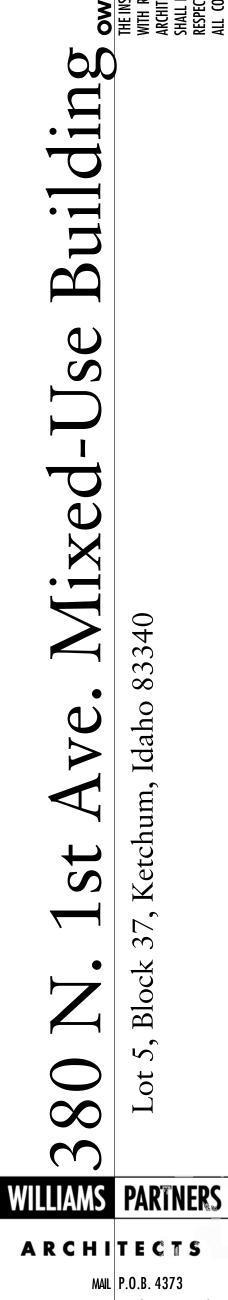

KETCHUM, IDAHO 83340 PHONE 208.726.0020 FAX 208.726.0019 WWW WILLIAMS-PARTNERS.COM

DRAWINGS


REVISIONS

DATE: ISSUED: 06/10/2021 | COK HPC REVIEW 09/30/2021 DESIGN REVIEW 04/22/2022 PRICING SET 08/05/2022 PERMIT


05/12/2021 COK SCHEMATIC PRESENTATION 08/02/2023 ISSUED FOR CONSTRUCTION

NUMBER: DATE: 01 02/17/2023 02 08/02/2023



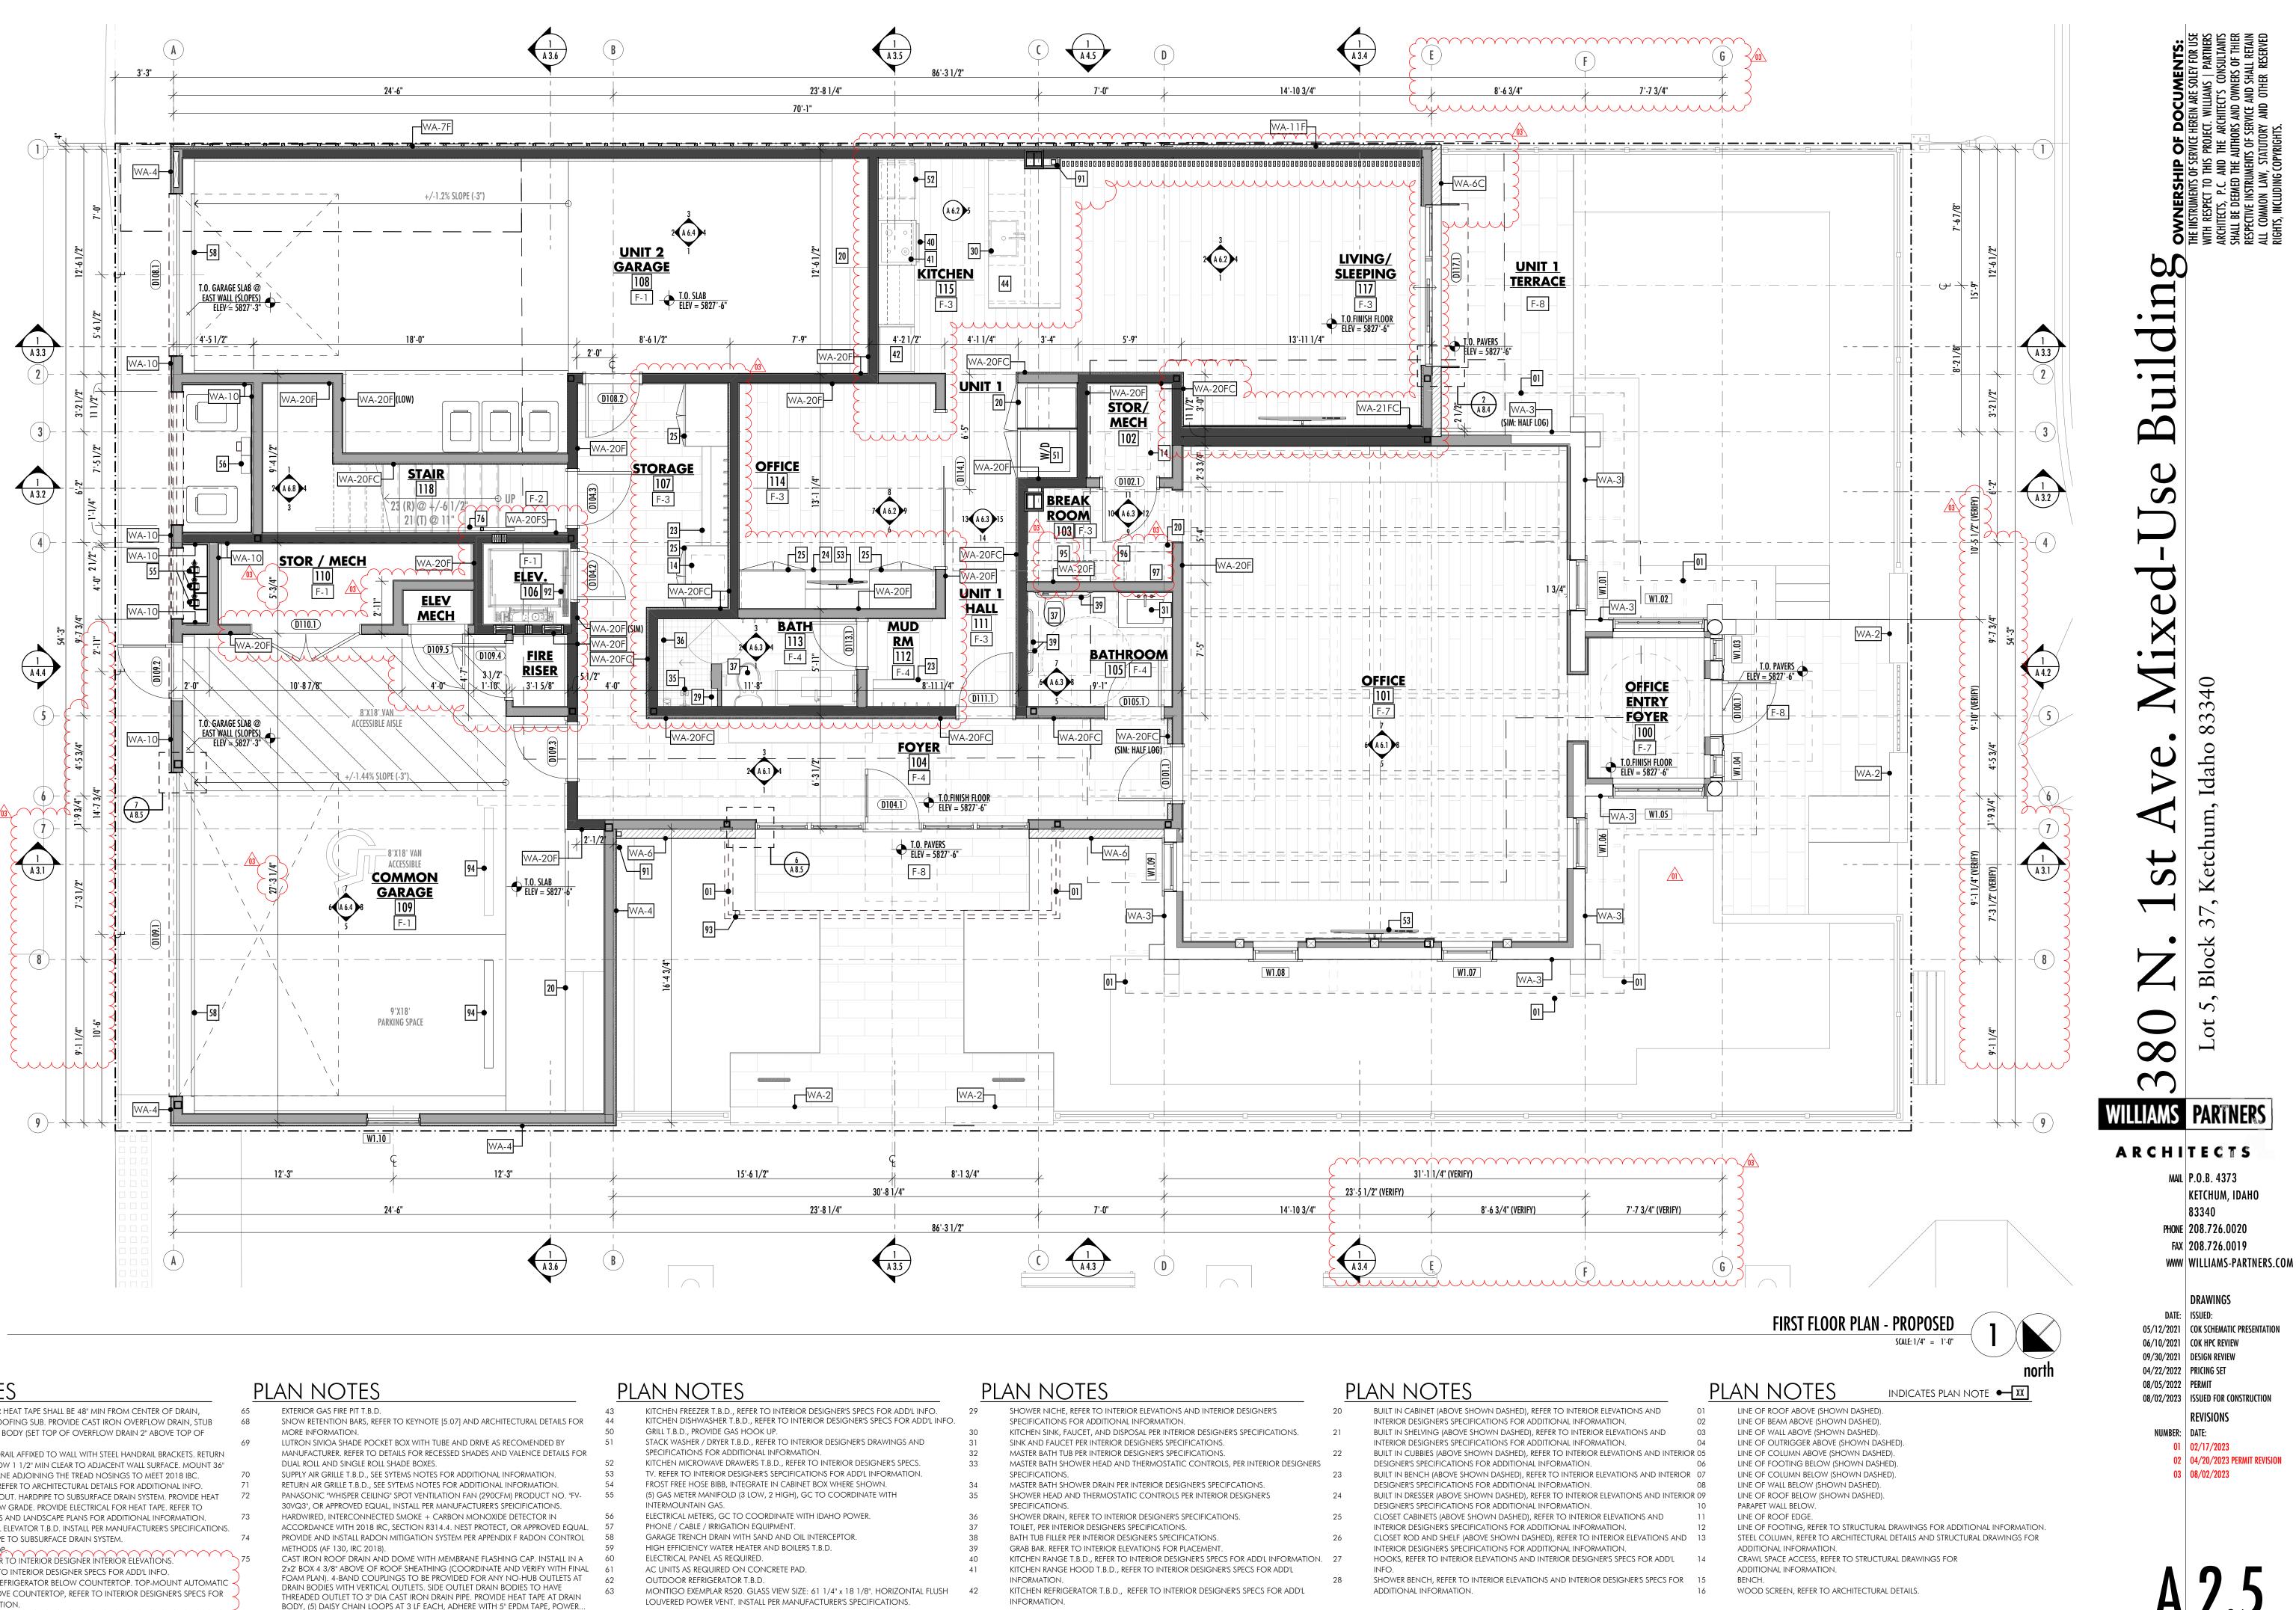


75 cont.	POWER SOURCE FOR HEAT TAPE SHALL BE 48" MIN FROM CENTER OF DRAIN,	65
	COORDINATE WITH ROOFING SUB. PROVIDE CAST IRON OVERFLOW DRAIN, STUB	68
	30" FROM MAIN DRAIN BODY (SET TOP OF OVERFLOW DRAIN 2" ABOVE TOP OF	
	MEMBRANE).	69
76	2"W x 1"T WOOD HANDRAIL AFFIXED TO WALL WITH STEEL HANDRAIL BRACKETS. RETURN	
	TO WALL AT ENDS. ALLOW 1 1/2" MIN CLEAR TO ADJACENT WALL SURFACE. MOUNT 36"	
	ABOVE THE SLOPED PLANE ADJOINING THE TREAD NOSINGS TO MEET 2018 IBC.	70
90	SHEET METAL GUTTER, REFER TO ARCHITECTURAL DETAILS FOR ADDITIONAL INFO.	71
91	SHEET METAL DOWNSPOUT. HARDPIPE TO SUBSURFACE DRAIN SYSTEM. PROVIDE HEAT	72
	TAPE TO 30" MIN. BELOW GRADE. PROVIDE ELECTRICAL FOR HEAT TAPE. REFER TO	
	ARCHITECTURAL DETAILS AND LANDSCAPE PLANS FOR ADDITIONAL INFORMATION.	73
92	TWO-STOP RESIDENTIAL ELEVATOR T.B.D. INSTALL PER MANUFACTURER'S SPECIFICATIONS.	
93	DOWNSPOUT. HARDPIPE TO SUBSURFACE DRAIN SYSTEM.	74
94	VEHICULAR WHEELSTOP	
95	TRASH PULL-OUT. REFER TO INTERIOR DESIGNER INTERIOR ELEVATIONS.	75
96	15" ICE MAKER. REFER TO INTERIOR DESIGNER SPECS FOR ADD'L INFO.	\langle
97	24" UNDERCOUNTER REFRIGERATOR BELOW COUNTERTOP. TOP-MOUNT AUTOMATIC -	<
_	COFFEE MACHINE ABOVE COUNTERTOP, REFER TO INTERIOR DESIGNER'S SPECS FOR)
	ADDITIONAL INFORMATION.)
W		

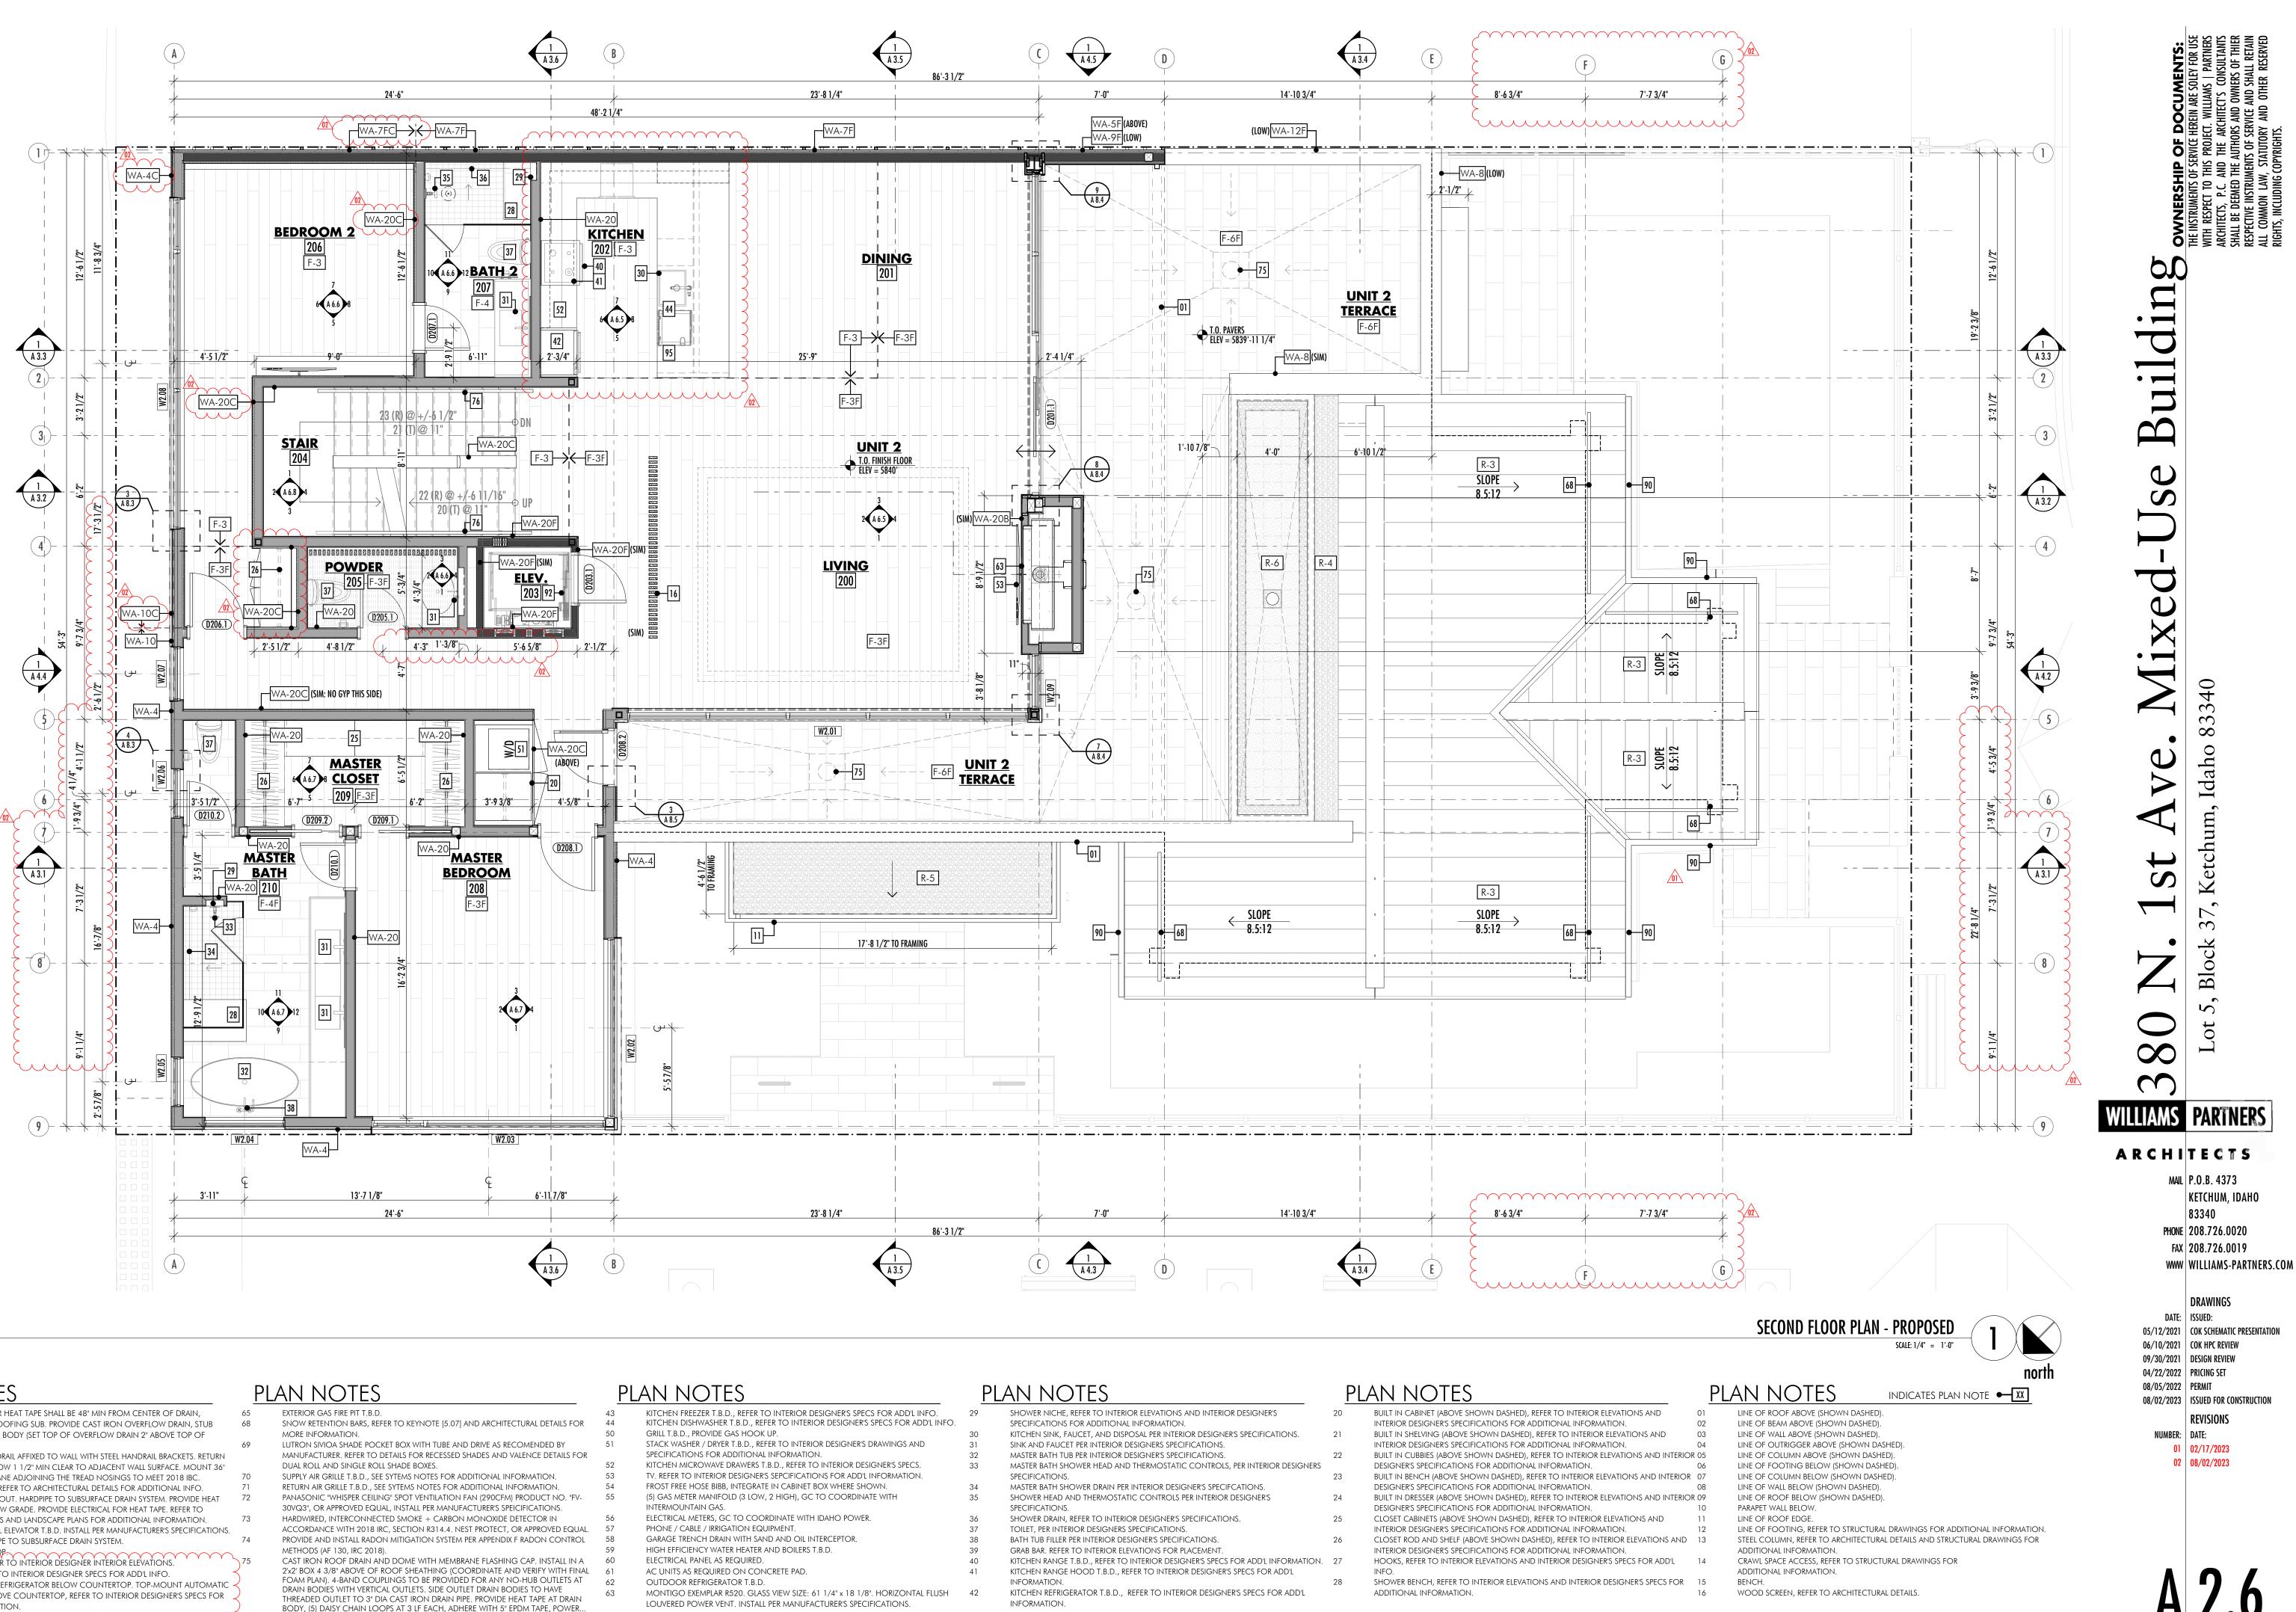


<u>Plan Notes</u>

		-	
75 cont.	POWER SOURCE FOR HEAT TAPE SHALL BE 48" MIN FROM CENTER OF DRAIN,	65	E
	COORDINATE WITH ROOFING SUB. PROVIDE CAST IRON OVERFLOW DRAIN, STUB	68	S
	30" FROM MAIN DRAIN BODY (SET TOP OF OVERFLOW DRAIN 2" ABOVE TOP OF		Ν
	MEMBRANE).	69	L
76	2"W x 1"T WOOD HANDRAIL AFFIXED TO WALL WITH STEEL HANDRAIL BRACKETS. RETURN		Ν
	TO WALL AT ENDS. ALLOW 1 1/2" MIN CLEAR TO ADJACENT WALL SURFACE. MOUNT 36"		0
	ABOVE THE SLOPED PLANE ADJOINING THE TREAD NOSINGS TO MEET 2018 IBC.	70	S
90	SHEET METAL GUTTER, REFER TO ARCHITECTURAL DETAILS FOR ADDITIONAL INFO.	71	R
91	SHEET METAL DOWNSPOUT. HARDPIPE TO SUBSURFACE DRAIN SYSTEM. PROVIDE HEAT	72	F
	TAPE TO 30" MIN. BELOW GRADE. PROVIDE ELECTRICAL FOR HEAT TAPE. REFER TO		3
	ARCHITECTURAL DETAILS AND LANDSCAPE PLANS FOR ADDITIONAL INFORMATION.	73	F
92	TWO-STOP RESIDENTIAL ELEVATOR T.B.D. INSTALL PER MANUFACTURER'S SPECIFICATIONS.		A
93	DOWNSPOUT. HARDPIPE TO SUBSURFACE DRAIN SYSTEM.	74	F
94	-VEHICULAR-WHEELSTOP-	<u>`</u>	Ν
95	TRASH PULL-OUT. REFER TO INTERIOR DESIGNER INTERIOR ELEVATIONS.	75	(
96	15" ICE MAKER. REFER TO INTERIOR DESIGNER SPECS FOR ADD'L INFO.	\prec	2
- 97	24" UNDERCOUNTER REFRIGERATOR BELOW COUNTERTOP. TOP-MOUNT AUTOMATIC	\prec	F
_	COFFEE MACHINE ABOVE COUNTERTOP, REFER TO INTERIOR DESIGNER'S SPECS FOR	\mathcal{I}	L
	ADDITIONAL INFORMATION.		F
W			L

BUILT IN CABINET (ABOVE SHOWN DASHED),
INTERIOR DESIGNER'S SPECIFICATIONS FOR A
BUILT IN SHELVING (ABOVE SHOWN DASHED
INTERIOR DESIGNER'S SPECIFICATIONS FOR A
BUILT IN CUBBIES (ABOVE SHOWN DASHED),
DESIGNER'S SPECIFICATIONS FOR ADDITION
BUILT IN BENCH (ABOVE SHOWN DASHED), R
DESIGNER'S SPECIFICATIONS FOR ADDITION
BUILT IN DRESSER (ABOVE SHOWN DASHED),
DESIGNER'S SPECIFICATIONS FOR ADDITION
CLOSET CABINETS (ABOVE SHOWN DASHED)
INTERIOR DESIGNER'S SPECIFICATIONS FOR A
CLOSET ROD AND SHELF (ABOVE SHOWN DA
INTERIOR DESIGNER'S SPECIFICATIONS FOR A
HOOKS, REFER TO INTERIOR ELEVATIONS AN
INFO.
SHOWER BENCH, REFER TO INTERIOR ELEVAT
ADDITIONAL INFORMATION.

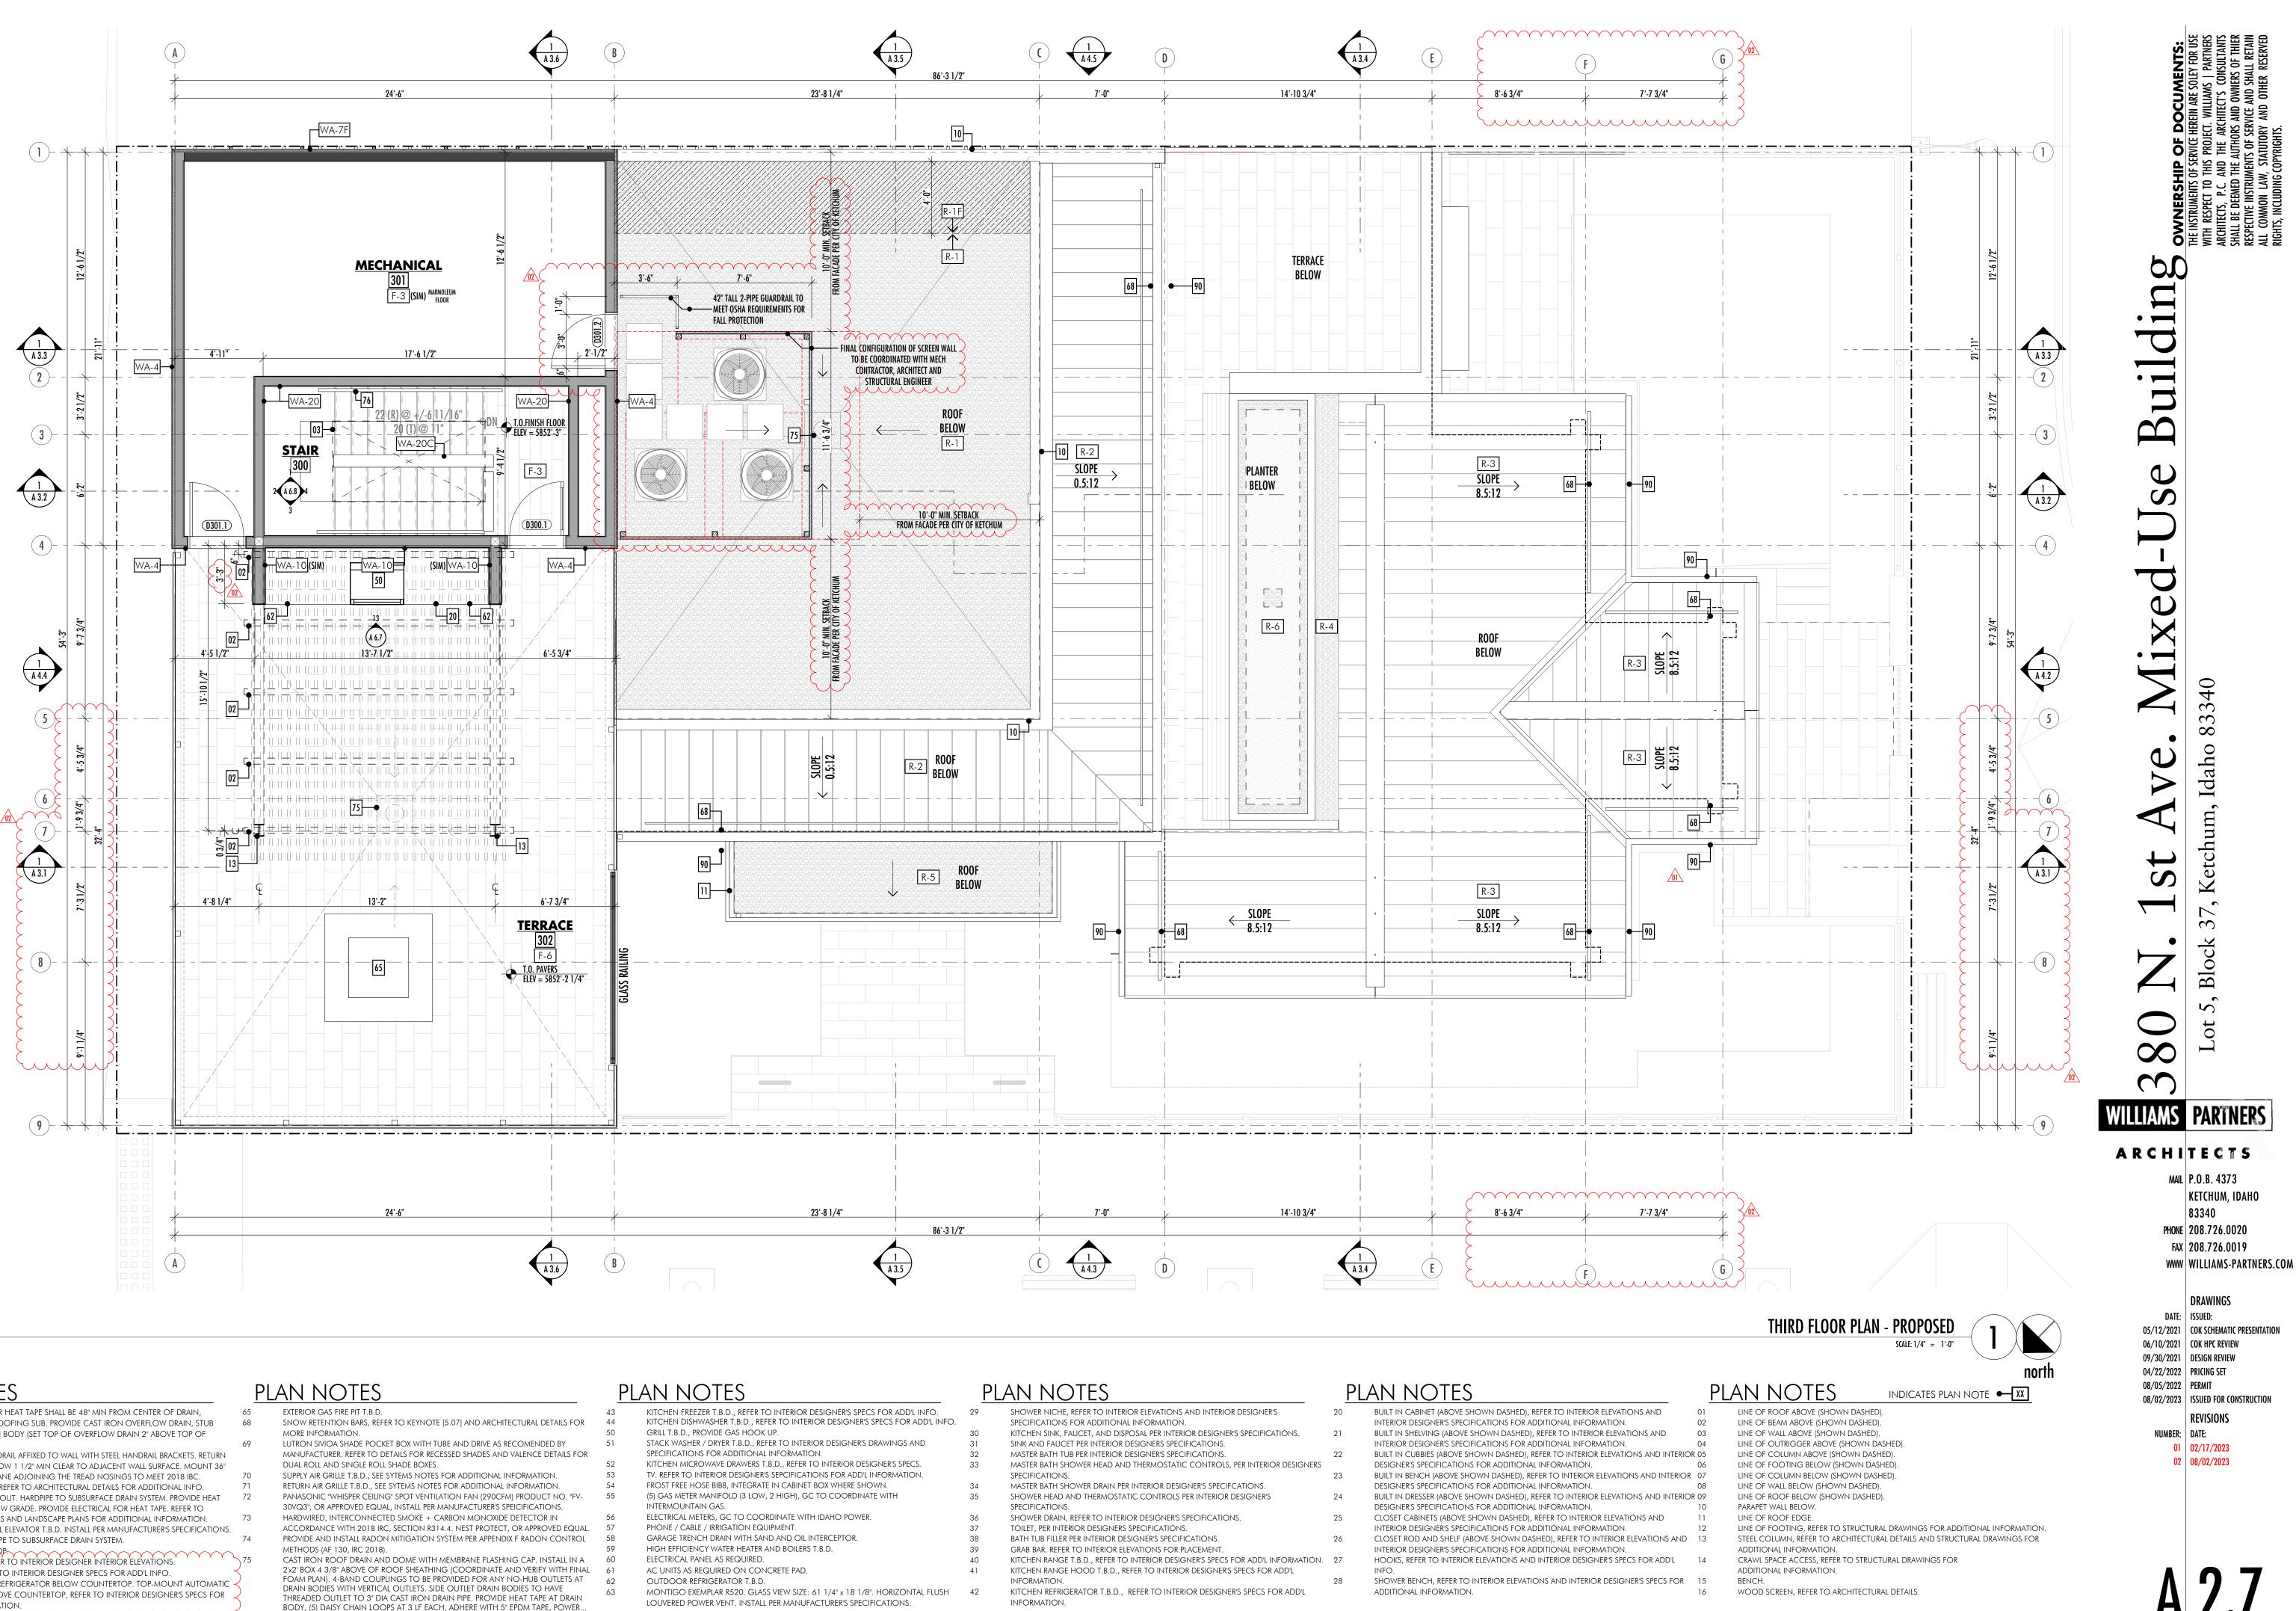


75 cont.	POWER SOURCE FOR HEAT TAPE SHALL BE 48" MIN FROM CENTER OF DRAIN,	65	EXTERIOR GAS
	COORDINATE WITH ROOFING SUB. PROVIDE CAST IRON OVERFLOW DRAIN, STUB	68	SNOW RETENT
	30" FROM MAIN DRAIN BODY (SET TOP OF OVERFLOW DRAIN 2" ABOVE TOP OF		MORE INFORM
	MEMBRANE).	69	lutron sivio,
76	2"W x 1"T WOOD HANDRAIL AFFIXED TO WALL WITH STEEL HANDRAIL BRACKETS. RETURN		MANUFACTUR
	TO WALL AT ENDS. ALLOW 1 1/2" MIN CLEAR TO ADJACENT WALL SURFACE. MOUNT 36"		DUAL ROLL AN
	ABOVE THE SLOPED PLANE ADJOINING THE TREAD NOSINGS TO MEET 2018 IBC.	70	SUPPLY AIR GRI
90	SHEET METAL GUTTER, REFER TO ARCHITECTURAL DETAILS FOR ADDITIONAL INFO.	71	RETURN AIR GR
91	SHEET METAL DOWNSPOUT. HARDPIPE TO SUBSURFACE DRAIN SYSTEM. PROVIDE HEAT	72	Panasonic "V
	TAPE TO 30" MIN. BELOW GRADE. PROVIDE ELECTRICAL FOR HEAT TAPE. REFER TO		30VQ3", OR AF
	ARCHITECTURAL DETAILS AND LANDSCAPE PLANS FOR ADDITIONAL INFORMATION.	73	HARDWIRED, IN
92	TWO-STOP RESIDENTIAL ELEVATOR T.B.D. INSTALL PER MANUFACTURER'S SPECIFICATIONS.		ACCORDANCE
93	DOWNSPOUT. HARDPIPE TO SUBSURFACE DRAIN SYSTEM.	74	PROVIDE AND
94	-VEHICULAR-WHEELSTQP.		METHODS (AF
95	TRASH PULL-OUT. REFER TO INTERIOR DESIGNER INTERIOR ELEVATIONS.	75	CAST IRON RC
≻ 96	15" ICE MAKER. REFER TO INTERIOR DESIGNER SPECS FOR ADD'L INFO.	\prec	2'x2' BOX 4 3/8
> 97	24" UNDERCOUNTER REFRIGERATOR BELOW COUNTERTOP. TOP-MOUNT AUTOMATIC	\langle	FOAM PLAN). 4 DRAIN BODIES
~	COFFEE MACHINE ABOVE COUNTERTOP, REFER TO INTERIOR DESIGNER'S SPECS FOR	\mathcal{L}	THREADED OL
	ADDITIONAL INFORMATION.)	BODY, (5) DAIS
LUL		~	20217 (0) 27 10

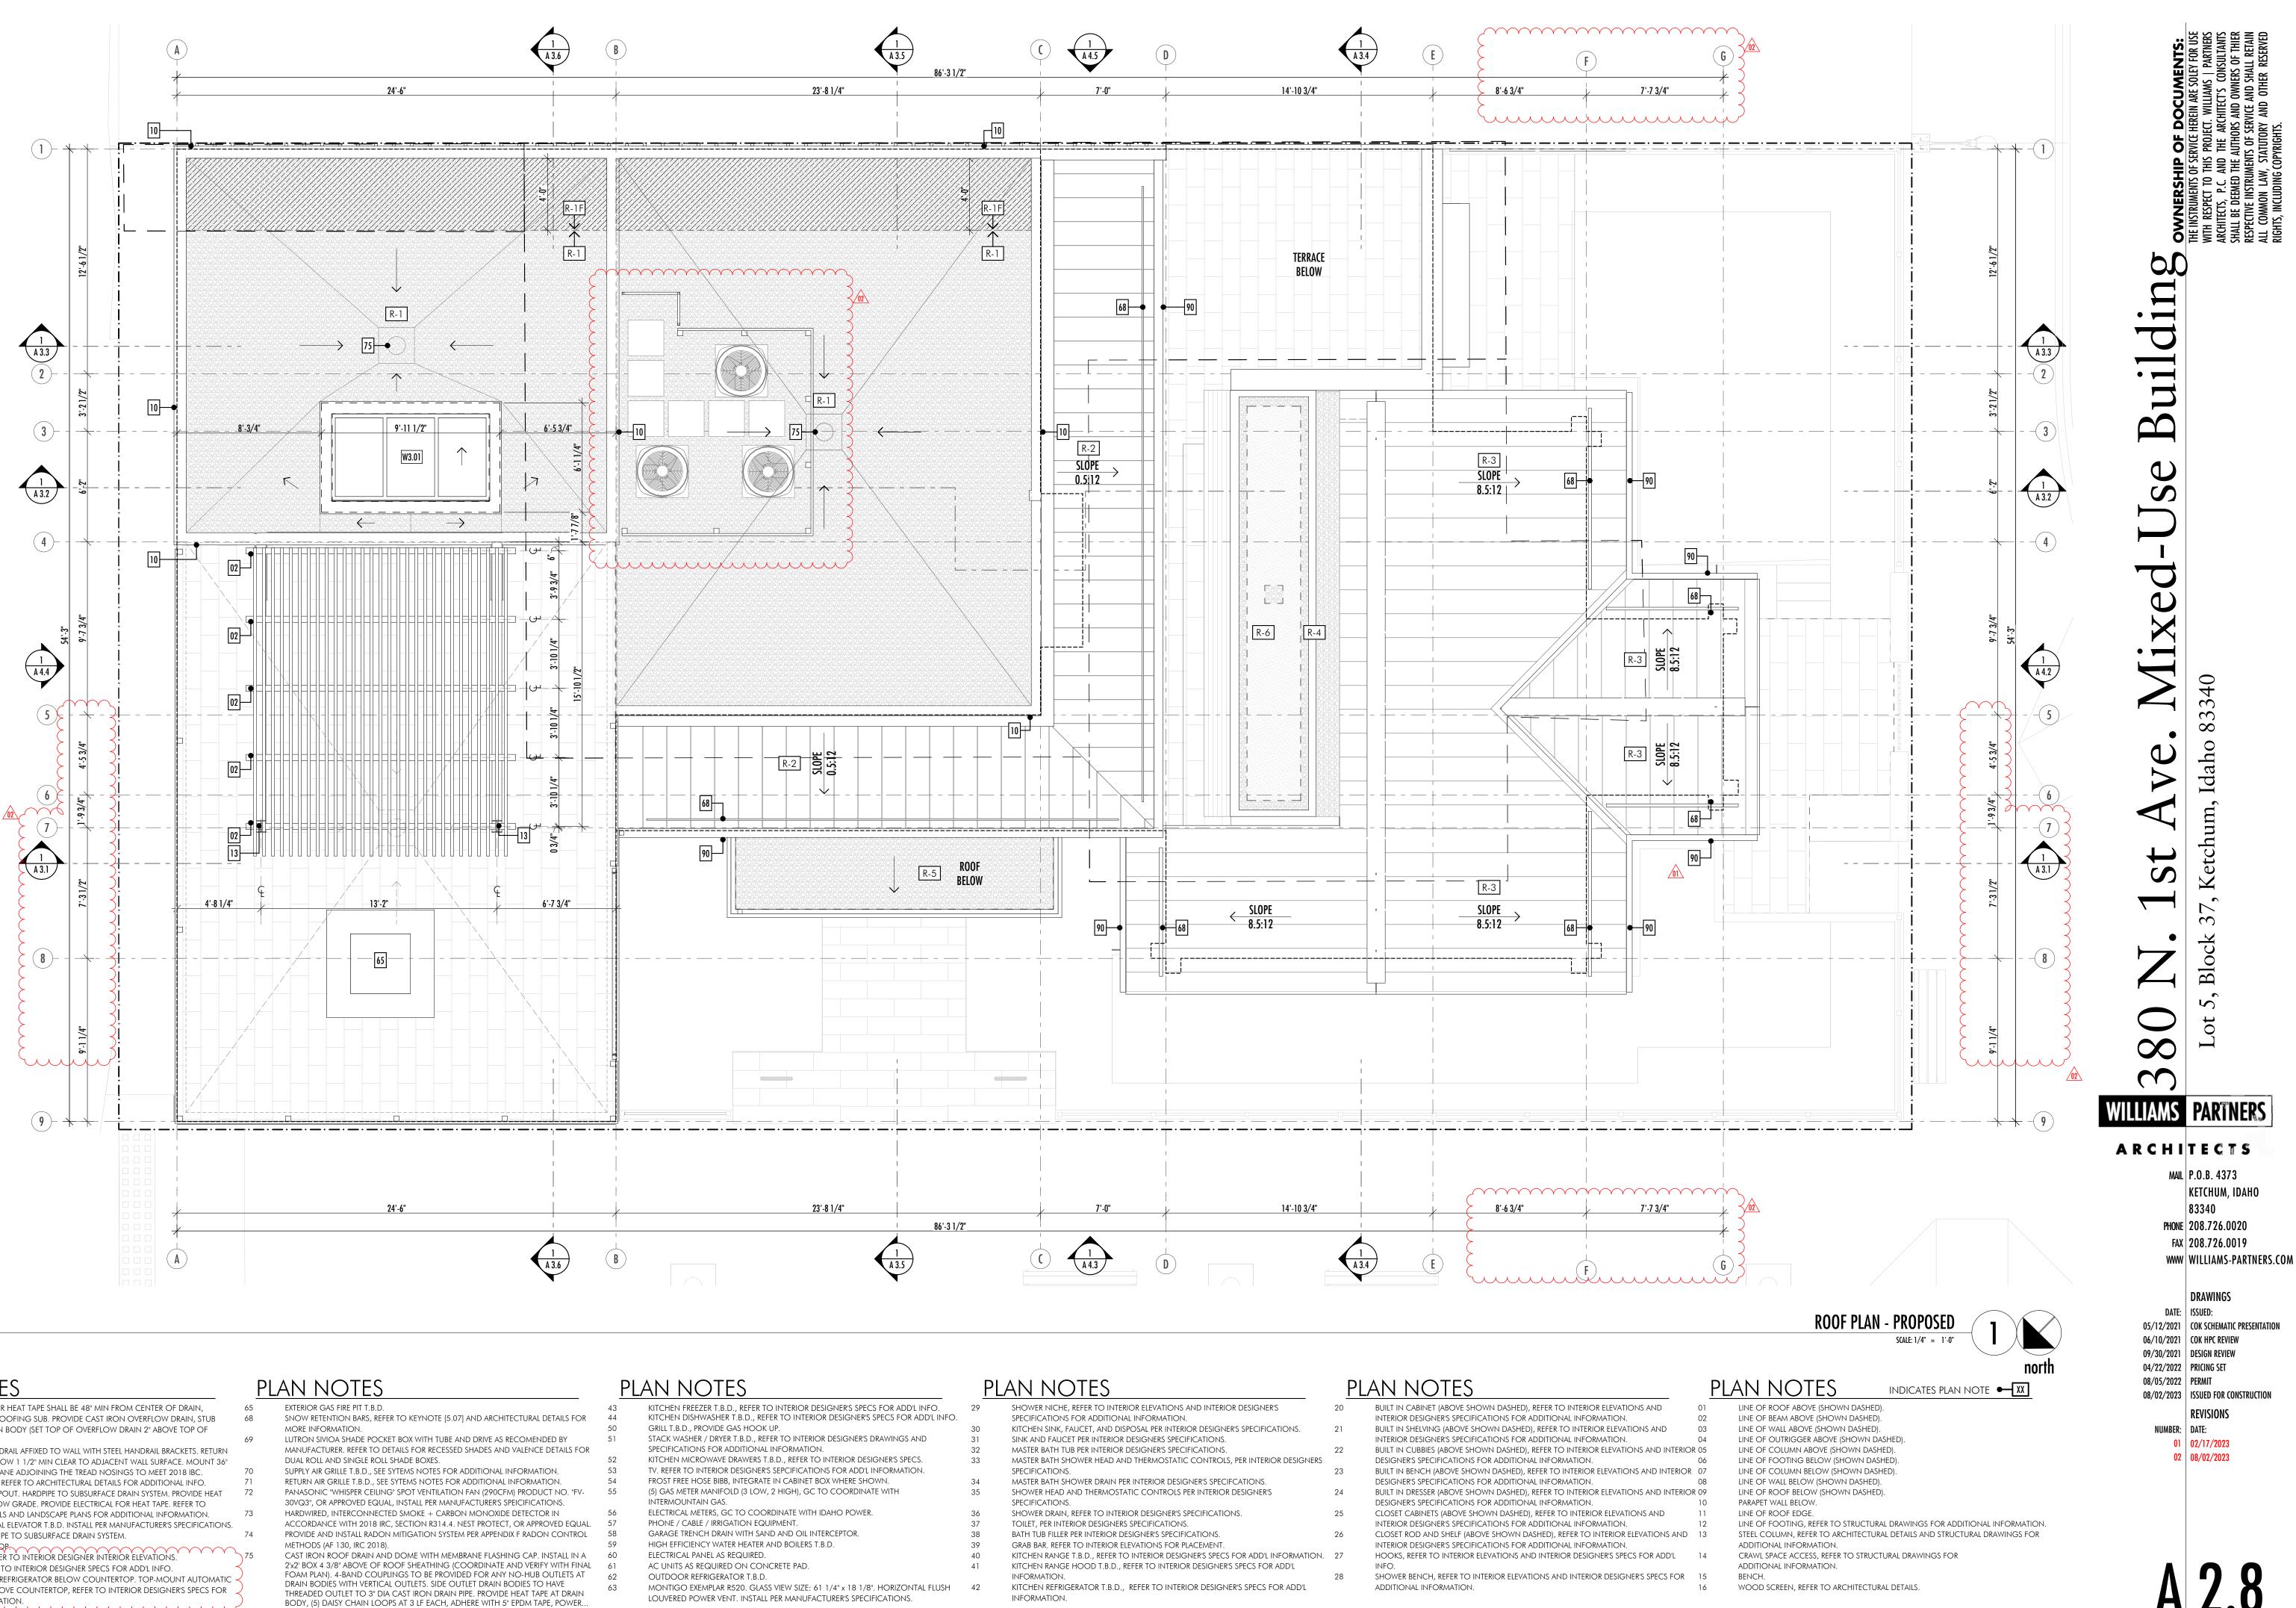

<u>Plan Notes</u>


			,
75 cont.	POWER SOURCE FOR HEAT TAPE SHALL BE 48" MIN FROM CENTER OF DRAIN,	65	EXTERI
	COORDINATE WITH ROOFING SUB. PROVIDE CAST IRON OVERFLOW DRAIN, STUB	68	SNOW
	30" FROM MAIN DRAIN BODY (SET TOP OF OVERFLOW DRAIN 2" ABOVE TOP OF		MORE
	MEMBRANE).	69	LUTRO
76	2"W x 1"T WOOD HANDRAIL AFFIXED TO WALL WITH STEEL HANDRAIL BRACKETS. RETURN		MANU
	TO WALL AT ENDS. ALLOW 1 1/2" MIN CLEAR TO ADJACENT WALL SURFACE. MOUNT 36"		DUAL F
	ABOVE THE SLOPED PLANE ADJOINING THE TREAD NOSINGS TO MEET 2018 IBC.	70	SUPPLY
90	SHEET METAL GUTTER, REFER TO ARCHITECTURAL DETAILS FOR ADDITIONAL INFO.	71	RETURI
91	SHEET METAL DOWNSPOUT. HARDPIPE TO SUBSURFACE DRAIN SYSTEM. PROVIDE HEAT	72	PANAS
	TAPE TO 30" MIN. BELOW GRADE. PROVIDE ELECTRICAL FOR HEAT TAPE. REFER TO		30VQ3
	ARCHITECTURAL DETAILS AND LANDSCAPE PLANS FOR ADDITIONAL INFORMATION.	73	HARDV
92	TWO-STOP RESIDENTIAL ELEVATOR T.B.D. INSTALL PER MANUFACTURER'S SPECIFICATIONS		ACCO
93	DOWNSPOUT. HARDPIPE TO SUBSURFACE DRAIN SYSTEM.	74	PROVIE
94	-VEHICULAR-WHEELSTQP	`	METHO
95	TRASH PULL-OUT. REFER TO INTERIOR DESIGNER INTERIOR ELEVATIONS.	75	CAST I
≻ 96	15" ICE MAKER. REFER TO INTERIOR DESIGNER SPECS FOR ADD'L INFO.	\prec	2'x2' B
> 97	24" UNDERCOUNTER REFRIGERATOR BELOW COUNTERTOP. TOP-MOUNT AUTOMATIC	\prec	FOAM
<u>_</u>	COFFEE MACHINE ABOVE COUNTERTOP, REFER TO INTERIOR DESIGNER'S SPECS FOR)	DRAIN THREA
	ADDITIONAL INFORMATION.		BODY
W		٢	BODI,

BUILT IN CABINET (ABOVE SHOWN DASHED),
INTERIOR DESIGNER'S SPECIFICATIONS FOR A
BUILT IN SHELVING (ABOVE SHOWN DASHED)
INTERIOR DESIGNER'S SPECIFICATIONS FOR A
BUILT IN CUBBIES (ABOVE SHOWN DASHED),
DESIGNER'S SPECIFICATIONS FOR ADDITIONA
BUILT IN BENCH (ABOVE SHOWN DASHED), R
DESIGNER'S SPECIFICATIONS FOR ADDITIONA
BUILT IN DRESSER (ABOVE SHOWN DASHED),
DESIGNER'S SPECIFICATIONS FOR ADDITIONA
CLOSET CABINETS (ABOVE SHOWN DASHED),
INTERIOR DESIGNER'S SPECIFICATIONS FOR A
CLOSET ROD AND SHELF (ABOVE SHOWN DA
INTERIOR DESIGNER'S SPECIFICATIONS FOR A
HOOKS, REFER TO INTERIOR ELEVATIONS AN
INFO.
SHOWER BENCH, REFER TO INTERIOR ELEVAT
ADDITIONAL INFORMATION.

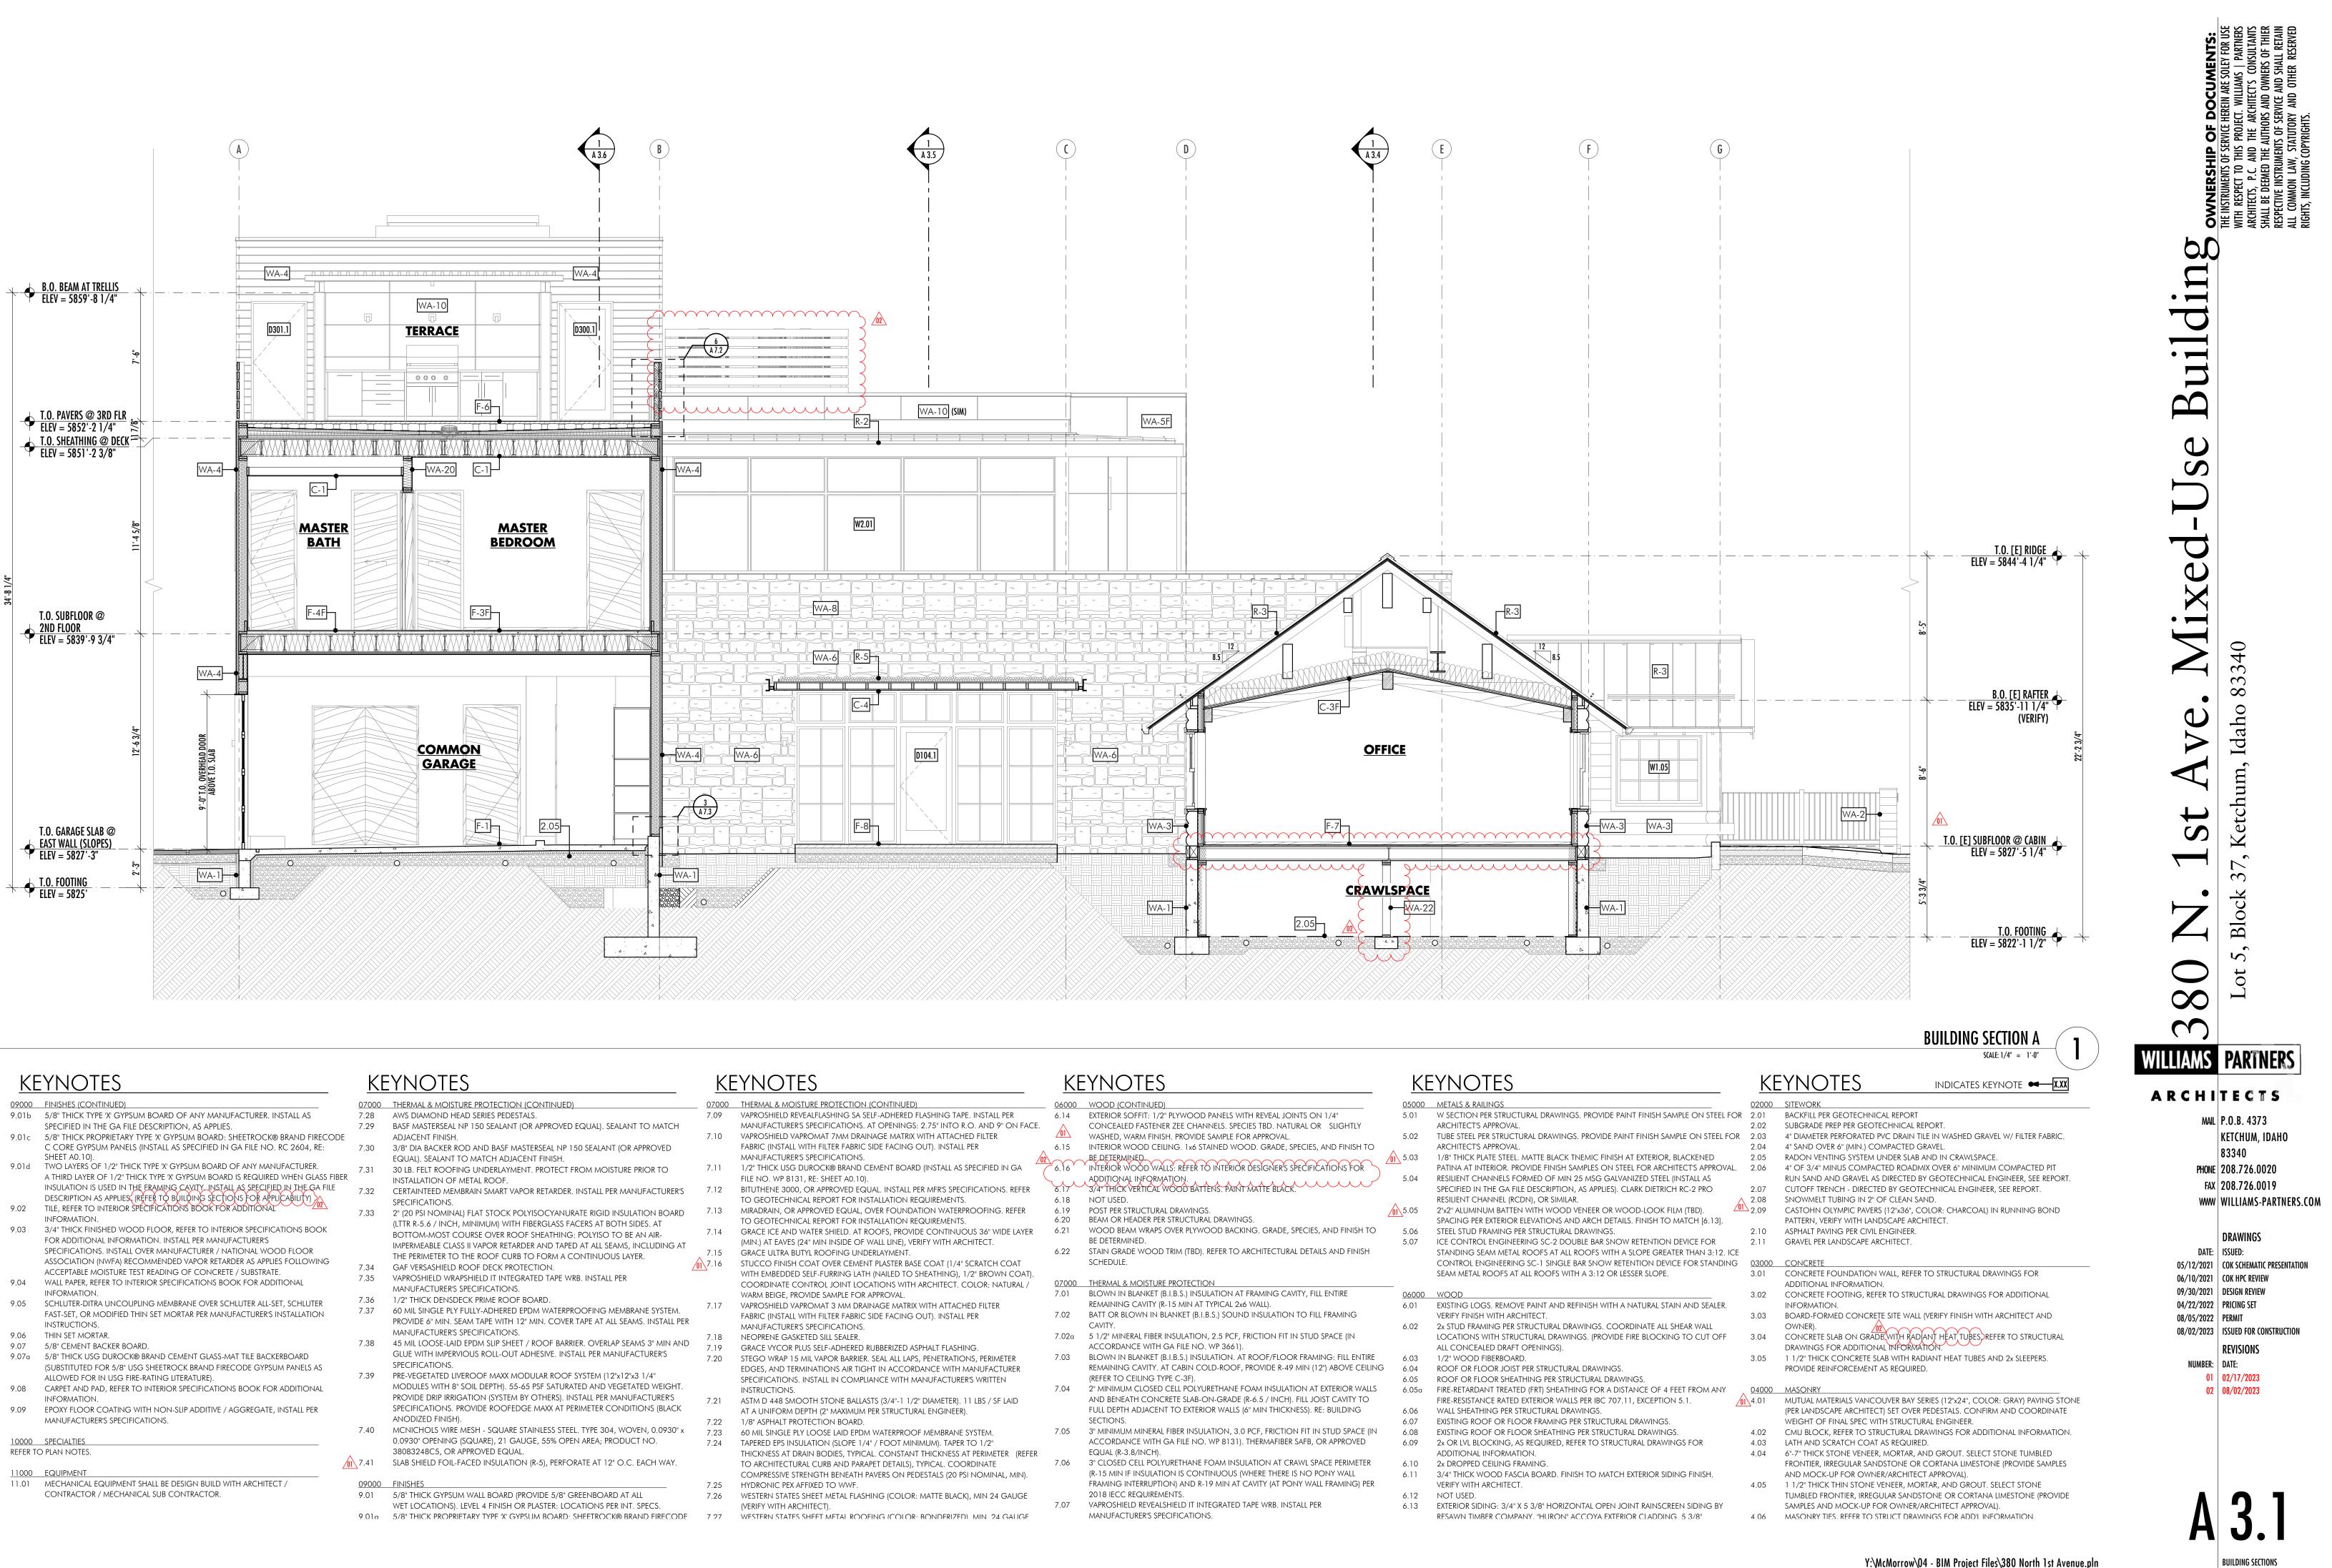


09000	FINISHES (CONTINUED)
9.01b	5/8" THICK TYPE 'X' GYPSUM BOARD OF ANY MANUFACTURER. INSTALL AS
	SPECIFIED IN THE GA FILE DESCRIPTION, AS APPLIES.
9.01c	5/8" THICK PROPRIETARY TYPE 'X' GYPSUM BOARD: SHEETROCK® BRAND FIRECODE
	C CORE GYPSUM PANELS (INSTALL AS SPECIFIED IN GA FILE NO. RC 2604, RE:
	SHEET A0.10).
9.01d	TWO LAYERS OF 1/2" THICK TYPE 'X' GYPSUM BOARD OF ANY MANUFACTURER.
	A THIRD LAYER OF 1/2" THICK TYPE 'X' GYPSUM BOARD IS REQUIRED WHEN GLASS FIBER
	INSULATION IS USED IN THE FRAMING CAVITY, INSTALL AS SPECIFIED IN THE GA FILE
	DESCRIPTION AS APPLIES, (REFER TO BUILDING SECTIONS FOR APPLICABILITY)
9.02	TILE, REFER TO INTERIOR SPECIFICATIONS BOOK FOR ADDITIONAL
	INFORMATION.
9.03	3/4" THICK FINISHED WOOD FLOOR, REFER TO INTERIOR SPECIFICATIONS BOOK
	FOR ADDITIONAL INFORMATION. INSTALL PER MANUFACTURER'S
	SPECIFICATIONS. INSTALL OVER MANUFACTURER / NATIONAL WOOD FLOOR

07000	THERMAL & MOISTURE PROTECTION (CONTINUED)	0700
7.28	AWS DIAMOND HEAD SERIES PEDESTALS.	7.09
7.29	BASF MASTERSEAL NP 150 SEALANT (OR APPROVED EQUAL). SEALANT TO MATCH	
	ADJACENT FINISH.	7.10
7.30	3/8" DIA BACKER ROD AND BASF MASTERSEAL NP 150 SEALANT (OR APPROVED	
	EQUAL). SEALANT TO MATCH ADJACENT FINISH.	
7.31	30 LB. FELT ROOFING UNDERLAYMENT. PROTECT FROM MOISTURE PRIOR TO	7.11
	INSTALLATION OF METAL ROOF.	
7.32	CERTAINTEED MEMBRAIN SMART VAPOR RETARDER. INSTALL PER MANUFACTURER'S	7.12
	SPECIFICATIONS.	
7.33	2" (20 PSI NOMINAL) FLAT STOCK POLYISOCYANURATE RIGID INSULATION BOARD	7.13
	(LTTR R-5.6 / INCH, MINIMUM) WITH FIBERGLASS FACERS AT BOTH SIDES. AT	7.1.4
	BOTTOM-MOST COURSE OVER ROOF SHEATHING: POLYISO TO BE AN AIR-	7.14
	IMPERMEABLE CLASS II VAPOR RETARDER AND TAPED AT ALL SEAMS, INCLUDING AT	7.15
	THE PERIMETER TO THE ROOF CURB TO FORM A CONTINUOUS LAYER.	7.15
7.34	GAF VERSASHIELD ROOF DECK PROTECTION.	
7.35	VAPROSHIELD WRAPSHIELD IT INTEGRATED TAPE WRB. INSTALL PER	
	MANUFACTURER'S SPECIFICATIONS.	
7.36	1/2" THICK DENSDECK PRIME ROOF BOARD.	7.17
7.37	60 MIL SINGLE PLY FULLY-ADHERED EPDM WATERPROOFING MEMBRANE SYSTEM.	,,
	PROVIDE 6" MIN. SEAM TAPE WITH 12" MIN. COVER TAPE AT ALL SEAMS. INSTALL PER	
	MANUFACTURER'S SPECIFICATIONS.	7.18
7.38	45 MIL LOOSE-LAID EPDM SLIP SHEET / ROOF BARRIER. OVERLAP SEAMS 3" MIN AND	7.19
	GLUE WITH IMPERVIOUS ROLL-OUT ADHESIVE. INSTALL PER MANUFACTURER'S	7.20
	SPECIFICATIONS.	
7.39	PRE-VEGETATED LIVEROOF MAXX MODULAR ROOF SYSTEM (12"x12"x3 1/4"	
	MODULES WITH 8" SOIL DEPTH). 55-65 PSF SATURATED AND VEGETATED WEIGHT.	
	PROVIDE DRIP IRRIGATION (SYSTEM BY OTHERS). INSTALL PER MANUFACTURER'S	7.21
	SPECIFICATIONS. PROVIDE ROOFEDGE MAXX AT PERIMETER CONDITIONS (BLACK	
7.40		7.22
7.40	MCNICHOLS WIRE MESH - SQUARE STAINLESS STEEL. TYPE 304, WOVEN, 0.0930" x	7.23
	0.0930" OPENING (SQUARE), 21 GAUGE, 55% OPEN AREA; PRODUCT NO.	7.24
7 41	38083248C5, OR APPROVED EQUAL.	
7.41	SLAB SHIELD FOIL-FACED INSULATION (R-5), PERFORATE AT 12" O.C. EACH WAY.	
09000	FINISHES	7.05
9.01	5/8" THICK GYPSUM WALL BOARD (PROVIDE 5/8" GREENBOARD AT ALL	7.25 7.26
7.01	WET LOCATIONS). LEVEL 4 FINISH OR PLASTER: LOCATIONS PER INT. SPECS.	1.20
0.01		7.07

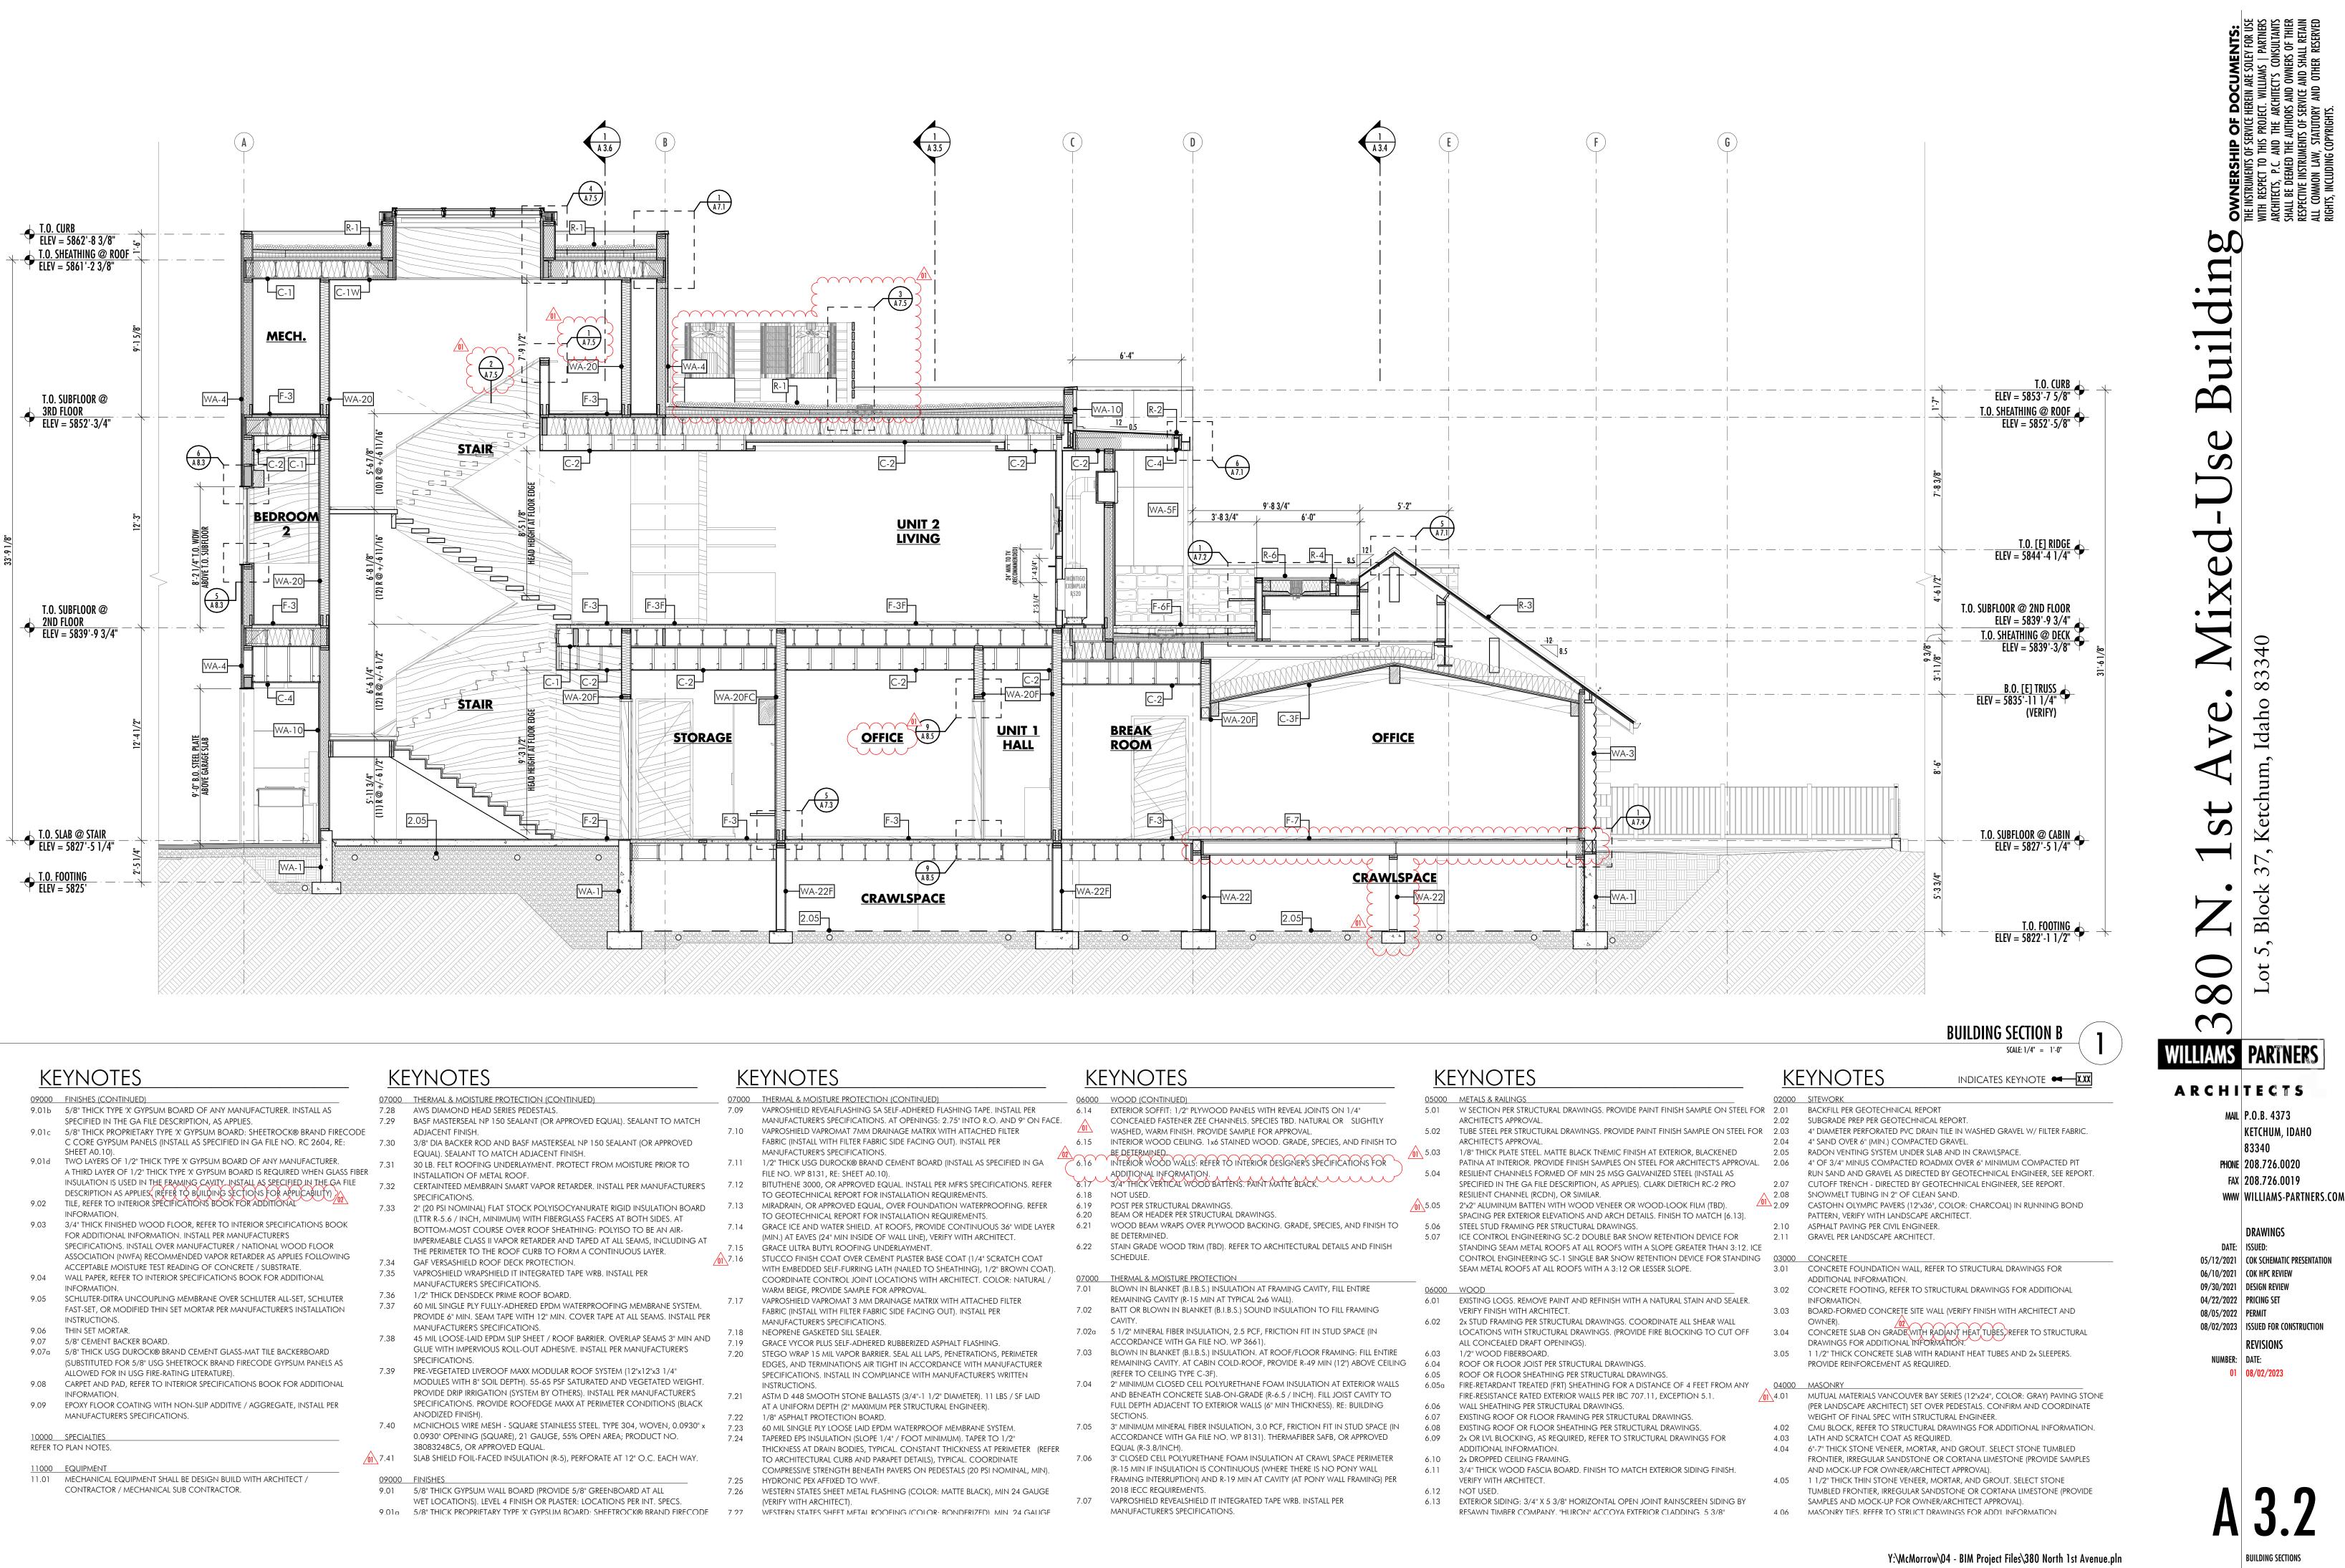

07000	THERMAL & MOISTURE PROTECTION (CONTINUED)	0700
7.28	AWS DIAMOND HEAD SERIES PEDESTALS.	7.09
7.29	BASF MASTERSEAL NP 150 SEALANT (OR APPROVED EQUAL). SEALANT TO MATCH	
	ADJACENT FINISH.	7.10
7.30	3/8" DIA BACKER ROD AND BASF MASTERSEAL NP 150 SEALANT (OR APPROVED	
	EQUAL). SEALANT TO MATCH ADJACENT FINISH.	
7.31	30 LB. FELT ROOFING UNDERLAYMENT. PROTECT FROM MOISTURE PRIOR TO	7.11
	INSTALLATION OF METAL ROOF.	
7.32	CERTAINTEED MEMBRAIN SMART VAPOR RETARDER. INSTALL PER MANUFACTURER'S	7.12
	SPECIFICATIONS.	
7.33	2" (20 PSI NOMINAL) FLAT STOCK POLYISOCYANURATE RIGID INSULATION BOARD	7.13
	(LTTR R-5.6 / INCH, MINIMUM) WITH FIBERGLASS FACERS AT BOTH SIDES. AT	
	BOTTOM-MOST COURSE OVER ROOF SHEATHING: POLYISO TO BE AN AIR-	7.14
	IMPERMEABLE CLASS II VAPOR RETARDER AND TAPED AT ALL SEAMS, INCLUDING AT	
	THE PERIMETER TO THE ROOF CURB TO FORM A CONTINUOUS LAYER.	7.15
7.34	GAF VERSASHIELD ROOF DECK PROTECTION.	7.16
7.35	VAPROSHIELD WRAPSHIELD IT INTEGRATED TAPE WRB. INSTALL PER	
	MANUFACTURER'S SPECIFICATIONS.	
7.36	1/2" THICK DENSDECK PRIME ROOF BOARD.	7.17
7.37	60 MIL SINGLE PLY FULLY-ADHERED EPDM WATERPROOFING MEMBRANE SYSTEM.	7.17
	PROVIDE 6" MIN. SEAM TAPE WITH 12" MIN. COVER TAPE AT ALL SEAMS. INSTALL PER	
	MANUFACTURER'S SPECIFICATIONS.	7.18
7.38	45 MIL LOOSE-LAID EPDM SLIP SHEET / ROOF BARRIER. OVERLAP SEAMS 3" MIN AND	7.19
	GLUE WITH IMPERVIOUS ROLL-OUT ADHESIVE. INSTALL PER MANUFACTURER'S	7.20
	SPECIFICATIONS.	7.20
7.39	PRE-VEGETATED LIVEROOF MAXX MODULAR ROOF SYSTEM (12"x12"x3 1/4"	
	MODULES WITH 8" SOIL DEPTH). 55-65 PSF SATURATED AND VEGETATED WEIGHT.	
	PROVIDE DRIP IRRIGATION (SYSTEM BY OTHERS). INSTALL PER MANUFACTURER'S	7.21
	SPECIFICATIONS. PROVIDE ROOFEDGE MAXX AT PERIMETER CONDITIONS (BLACK	
	anodized finish).	7.22
7.40	MCNICHOLS WIRE MESH - SQUARE STAINLESS STEEL. TYPE 304, WOVEN, 0.0930" x	7.23
	0.0930" OPENING (SQUARE), 21 GAUGE, 55% OPEN AREA; PRODUCT NO.	7.24
	38083248C5, OR APPROVED EQUAL.	
7.41	SLAB SHIELD FOIL-FACED INSULATION (R-5), PERFORATE AT 12" O.C. EACH WAY.	
09000	FINISHES	7.25
9.01	5/8" THICK GYPSUM WALL BOARD (PROVIDE 5/8" GREENBOARD AT ALL	7.26
	WET LOCATIONS). LEVEL 4 FINISH OR PLASTER: LOCATIONS PER INT. SPECS.	

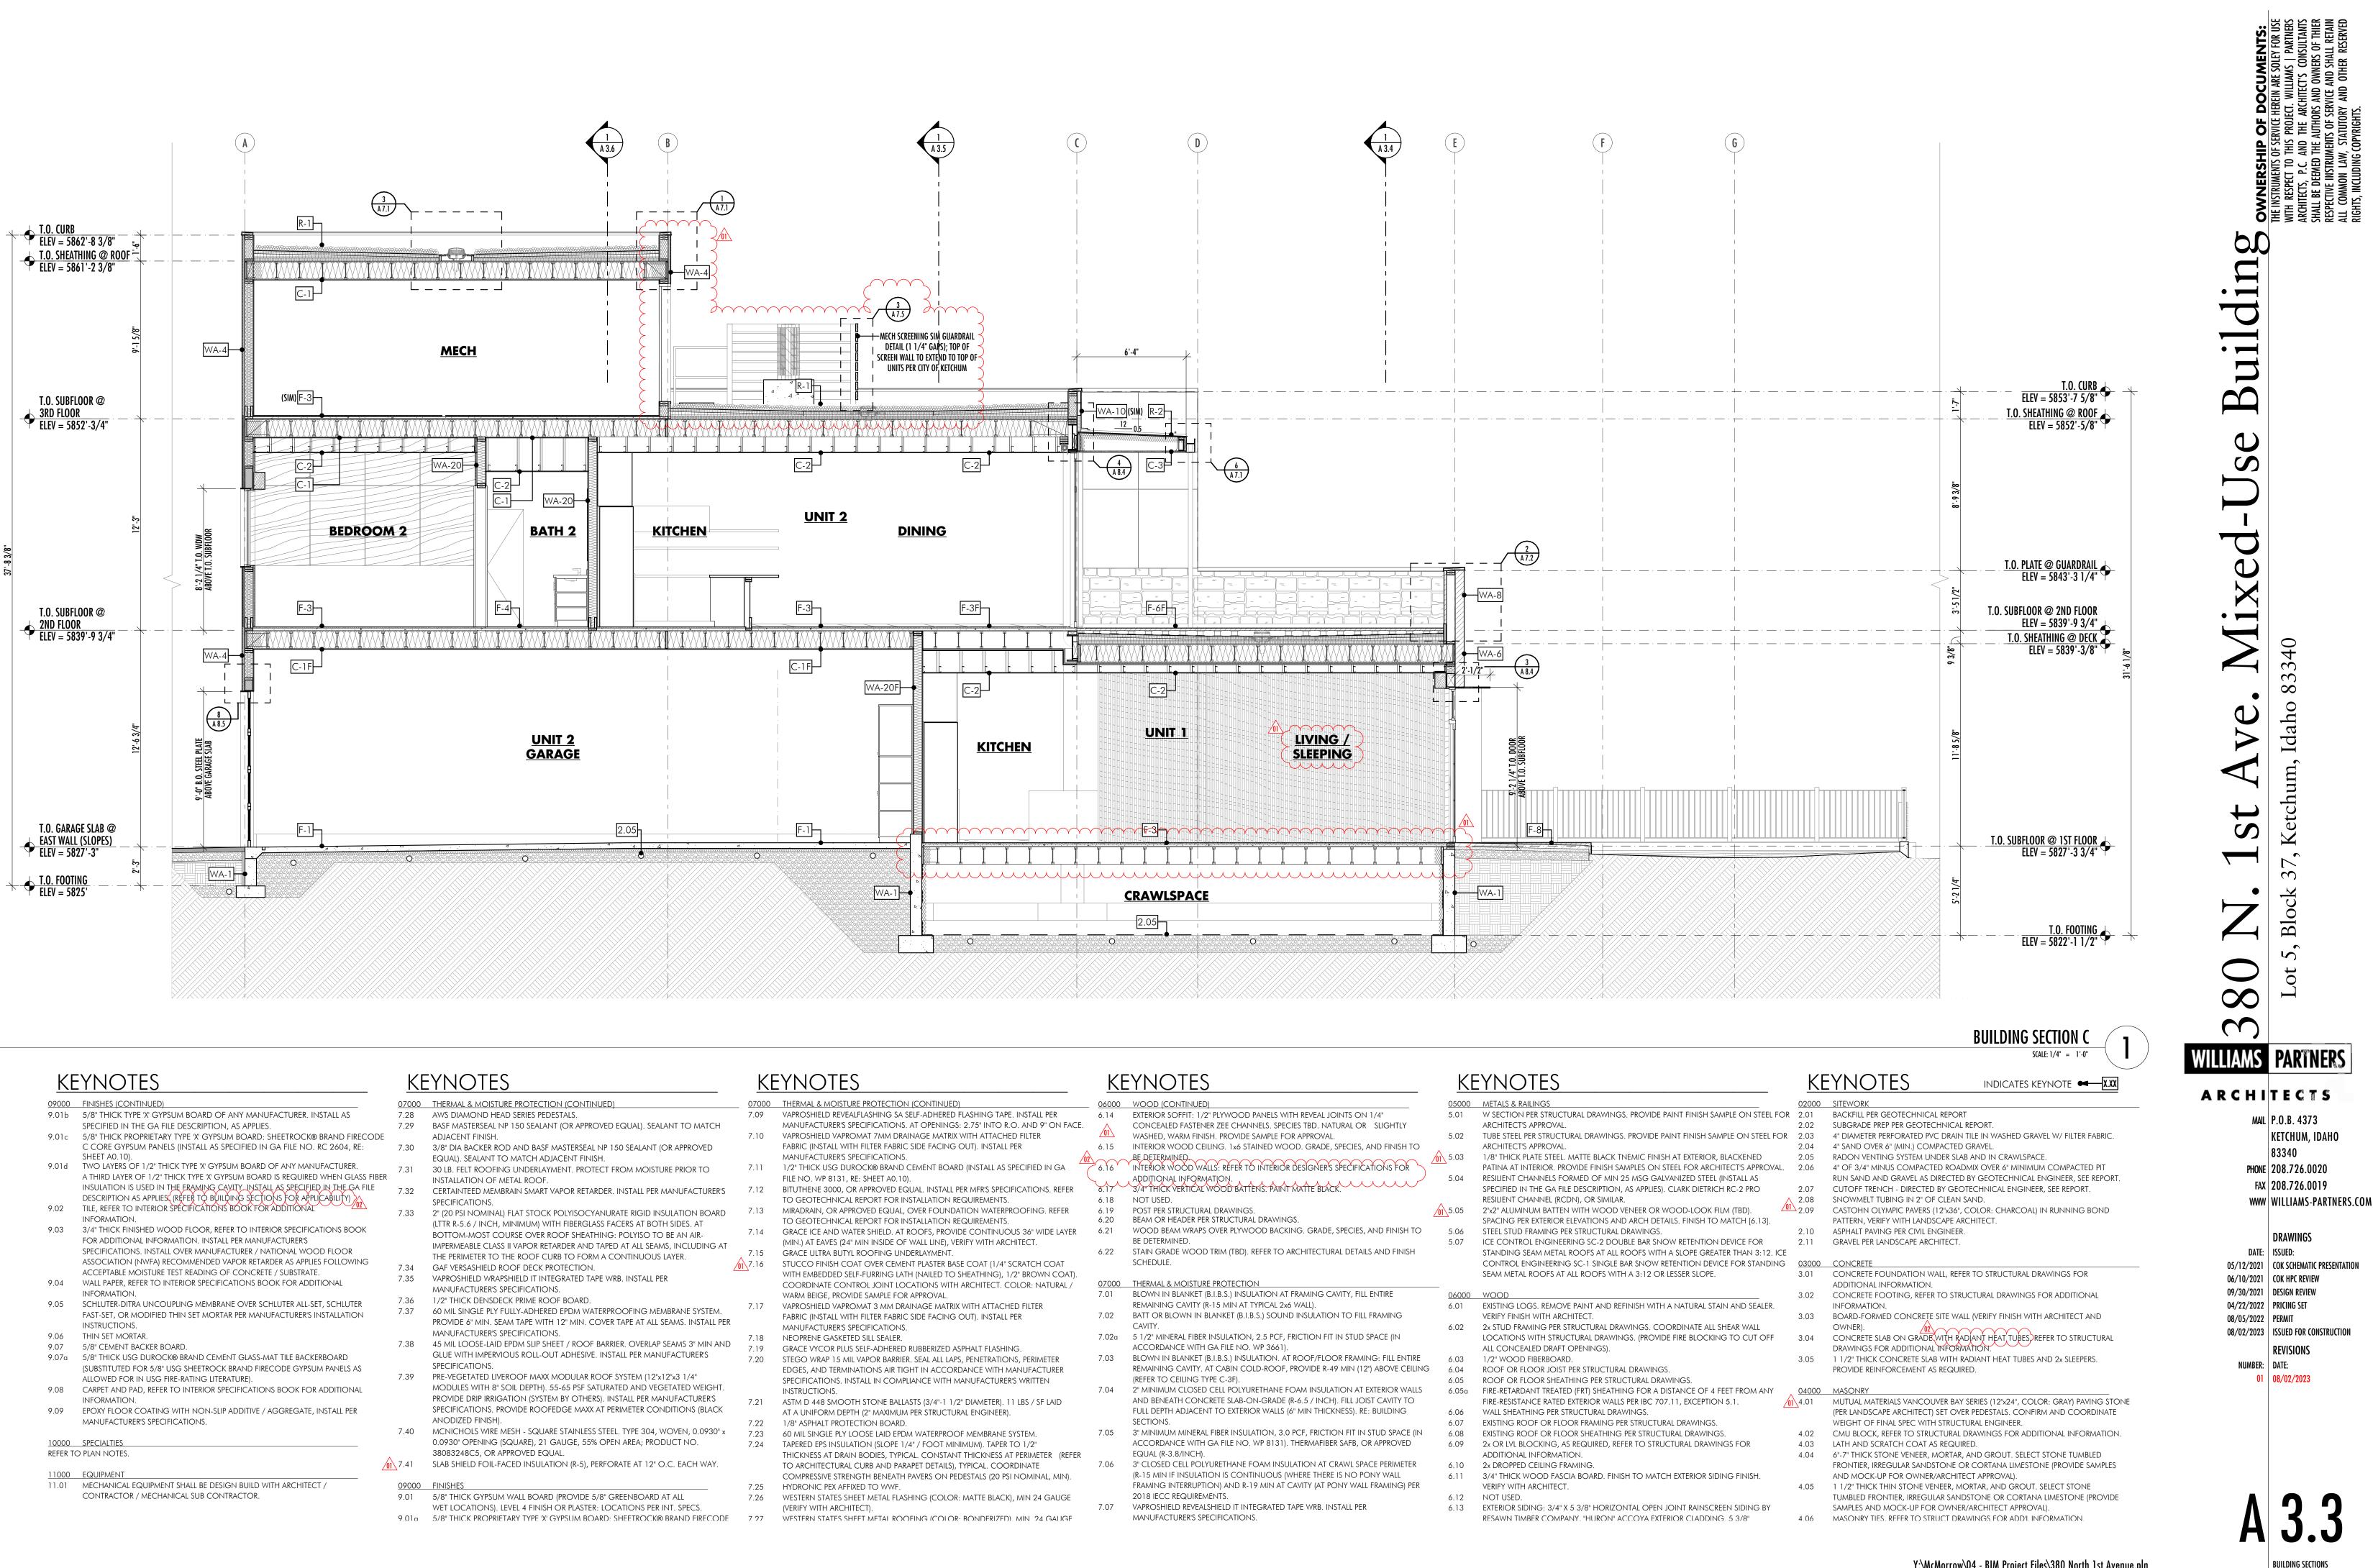

07000	THERMAL & MOISTURE PROTECTION (CONTINUED)	0700
7.28	AWS DIAMOND HEAD SERIES PEDESTALS.	<u>0700</u> 7.09
7.29	BASE MASTERSEAL NP 150 SEALANT (OR APPROVED EQUAL). SEALANT TO MATCH	7.07
/.2/	ADJACENT FINISH.	7.10
7.30	3/8" DIA BACKER ROD AND BASF MASTERSEAL NP 150 SEALANT (OR APPROVED	
	EQUAL). SEALANT TO MATCH ADJACENT FINISH.	
7.31	30 LB. FELT ROOFING UNDERLAYMENT, PROTECT FROM MOISTURE PRIOR TO	7.11
	INSTALLATION OF METAL ROOF.	
7.32	CERTAINTEED MEMBRAIN SMART VAPOR RETARDER. INSTALL PER MANUFACTURER'S	7.12
	SPECIFICATIONS.	
7.33	2" (20 PSI NOMINAL) FLAT STOCK POLYISOCYANURATE RIGID INSULATION BOARD	7.13
	(LTTR R-5.6 / INCH, MINIMUM) WITH FIBERGLASS FACERS AT BOTH SIDES. AT	
	BOTTOM-MOST COURSE OVER ROOF SHEATHING: POLYISO TO BE AN AIR-	7.14
	IMPERMEABLE CLASS II VAPOR RETARDER AND TAPED AT ALL SEAMS, INCLUDING AT	
	THE PERIMETER TO THE ROOF CURB TO FORM A CONTINUOUS LAYER.	7.15
7.34	GAF VERSASHIELD ROOF DECK PROTECTION.	7.16
7.35	VAPROSHIELD WRAPSHIELD IT INTEGRATED TAPE WRB. INSTALL PER	
	MANUFACTURER'S SPECIFICATIONS.	
7.36	1/2" THICK DENSDECK PRIME ROOF BOARD.	7.17
7.37	60 MIL SINGLE PLY FULLY-ADHERED EPDM WATERPROOFING MEMBRANE SYSTEM.	7.17
	PROVIDE 6" MIN. SEAM TAPE WITH 12" MIN. COVER TAPE AT ALL SEAMS. INSTALL PER	
	MANUFACTURER'S SPECIFICATIONS.	7.18
7.38	45 MIL LOOSE-LAID EPDM SLIP SHEET / ROOF BARRIER. OVERLAP SEAMS 3" MIN AND	7.19
	GLUE WITH IMPERVIOUS ROLL-OUT ADHESIVE. INSTALL PER MANUFACTURER'S	7.20
	SPECIFICATIONS.	7.20
7.39	PRE-VEGETATED LIVEROOF MAXX MODULAR ROOF SYSTEM (12"x12"x3 1/4"	
	MODULES WITH 8" SOIL DEPTH). 55-65 PSF SATURATED AND VEGETATED WEIGHT.	
	PROVIDE DRIP IRRIGATION (SYSTEM BY OTHERS). INSTALL PER MANUFACTURER'S	7.21
	SPECIFICATIONS. PROVIDE ROOFEDGE MAXX AT PERIMETER CONDITIONS (BLACK	
	anodized finish).	7.22
7.40	MCNICHOLS WIRE MESH - SQUARE STAINLESS STEEL. TYPE 304, WOVEN, 0.0930" x	7.23
	0.0930" OPENING (SQUARE), 21 GAUGE, 55% OPEN AREA; PRODUCT NO.	7.24
	38083248C5, OR APPROVED EQUAL.	
7.41	SLAB SHIELD FOIL-FACED INSULATION (R-5), PERFORATE AT 12" O.C. EACH WAY.	
09000	FINISHES	7.25
9.01	5/8" THICK GYPSUM WALL BOARD (PROVIDE 5/8" GREENBOARD AT ALL	7.26
	WET LOCATIONS). LEVEL 4 FINISH OR PLASTER: LOCATIONS PER INT. SPECS.	
0.01		




KEYNOTES

09000	FINISHES (CONTINUED)
9.01b	5/8" THICK TYPE 'X' GYPSUM BOARD OF ANY MANUFACTURER. INSTALL AS
	SPECIFIED IN THE GA FILE DESCRIPTION, AS APPLIES.
9.01c	5/8" THICK PROPRIETARY TYPE 'X' GYPSUM BOARD: SHEETROCK® BRAND FIRECODE C CORE GYPSUM PANELS (INSTALL AS SPECIFIED IN GA FILE NO. RC 2604, RE:
9.01d	SHEET A0.10). TWO LAYERS OF 1/2" THICK TYPE 'X' GYPSUM BOARD OF ANY MANUFACTURER.
	A THIRD LAYER OF 1/2" THICK TYPE 'X' GYPSUM BOARD IS REQUIRED WHEN GLASS FIBER INSULATION IS USED IN THE FRAMING CAVITY INSTALL AS SPECIFIED IN THE GA FILE
9.02	DESCRIPTION AS APPLIES, (RĚFEŘ TŎ BŮILĎINĞ SĚCŤIOŇS FOŘ APPLICABILIŤY) TILE, REFER TO INTERIOR SPECIFICATIONS BOOK FOR ADDITIONAL
9.03	INFORMATION. 3/4" THICK FINISHED WOOD FLOOR, REFER TO INTERIOR SPECIFICATIONS BOOK
9.03	5/4 THICK FINISHED WOOD FLOOR, REFER TO INTERIOR SPECIFICATIONS BOOK
	SPECIFICATIONS. INSTALL OVER MANUFACTURER / NATIONAL WOOD FLOOR
	ASSOCIATION (NWFA) RECOMMENDED VAPOR RETARDER AS APPLIES FOLLOWING
	ACCEPTABLE MOISTURE TEST READING OF CONCRETE / SUBSTRATE.
9.04	WALL PAPER, REFER TO INTERIOR SPECIFICATIONS BOOK FOR ADDITIONAL
9.05	SCHLUTER-DITRA UNCOUPLING MEMBRANE OVER SCHLUTER ALL-SET, SCHLUTER
	FAST-SET, OR MODIFIED THIN SET MORTAR PER MANUFACTURER'S INSTALLATION
9.06	THIN SET MORTAR.
9.07	5/8" CEMENT BACKER BOARD.
9.07a	5/8" THICK USG DUROCK® BRAND CEMENT GLASS-MAT TILE BACKERBOARD
	(SUBSTITUTED FOR 5/8" USG SHEETROCK BRAND FIRECODE GYPSUM PANELS AS ALLOWED FOR IN USG FIRE-RATING LITERATURE).
9.08	CARPET AND PAD, REFER TO INTERIOR SPECIFICATIONS BOOK FOR ADDITIONAL
9.09	EPOXY FLOOR COATING WITH NON-SLIP ADDITIVE / AGGREGATE, INSTALL PER MANUFACTURER'S SPECIFICATIONS.
10000	SPECIALTIES
REFER TO	O PLAN NOTES.
11000	

11000	
11.01	MECHANICAL EQUIPMENT SHALL BE DESIGN BUILD WITH ARCHITECT /
	CONTRACTOR / MECHANICAL SUB CONTRACTOR.


KEYNOTES

<u> </u>		. <u>.</u>
07000	THERMAL & MOISTURE PROTECTION (CONTINUED)	0700
7.28	AWS DIAMOND HEAD SERIES PEDESTALS.	7.09
7.29	BASF MASTERSEAL NP 150 SEALANT (OR APPROVED EQUAL). SEALANT TO MATCH	
	ADJACENT FINISH.	7.10
7.30	3/8" DIA BACKER ROD AND BASF MASTERSEAL NP 150 SEALANT (OR APPROVED	
	EQUAL). SEALANT TO MATCH ADJACENT FINISH.	
7.31	30 LB. FELT ROOFING UNDERLAYMENT. PROTECT FROM MOISTURE PRIOR TO	7.11
	INSTALLATION OF METAL ROOF.	
7.32	CERTAINTEED MEMBRAIN SMART VAPOR RETARDER. INSTALL PER MANUFACTURER'S	7.12
	SPECIFICATIONS.	7 1 0
7.33	2" (20 PSI NOMINAL) FLAT STOCK POLYISOCYANURATE RIGID INSULATION BOARD	7.13
	(LTTR R-5.6 / INCH, MINIMUM) WITH FIBERGLASS FACERS AT BOTH SIDES. AT	7.14
	BOTTOM-MOST COURSE OVER ROOF SHEATHING: POLYISO TO BE AN AIR-	7.14
	IMPERMEABLE CLASS II VAPOR RETARDER AND TAPED AT ALL SEAMS, INCLUDING AT	7.15
	THE PERIMETER TO THE ROOF CURB TO FORM A CONTINUOUS LAYER.	7.16
7.34	GAF VERSASHIELD ROOF DECK PROTECTION.	
7.35	VAPROSHIELD WRAPSHIELD IT INTEGRATED TAPE WRB. INSTALL PER	
7.0 /	MANUFACTURER'S SPECIFICATIONS.	
7.36	1/2" THICK DENSDECK PRIME ROOF BOARD.	7.17
7.37	60 MIL SINGLE PLY FULLY-ADHERED EPDM WATERPROOFING MEMBRANE SYSTEM.	
	PROVIDE 6" MIN. SEAM TAPE WITH 12" MIN. COVER TAPE AT ALL SEAMS. INSTALL PER MANUFACTURER'S SPECIFICATIONS.	
7.38	45 MIL LOOSE-LAID EPDM SLIP SHEET / ROOF BARRIER. OVERLAP SEAMS 3" MIN AND	7.18
7.38	GLUE WITH IMPERVIOUS ROLL-OUT ADHESIVE. INSTALL PER MANUFACTURER'S	7.19
	SPECIFICATIONS.	7.20
7.39	PRE-VEGETATED LIVEROOF MAXX MODULAR ROOF SYSTEM (12"x12"x3 1/4"	
7.07	MODULES WITH 8" SOIL DEPTH). 55-65 PSF SATURATED AND VEGETATED WEIGHT.	
	PROVIDE DRIP IRRIGATION (SYSTEM BY OTHERS). INSTALL PER MANUFACTURER'S	
	SPECIFICATIONS. PROVIDE ROOFEDGE MAXX AT PERIMETER CONDITIONS (BLACK	7.21
	ANODIZED FINISH).	7.00
7.40	MCNICHOLS WIRE MESH - SQUARE STAINLESS STEEL. TYPE 304, WOVEN, 0.0930" x	7.22
7.40	0.0930" OPENING (SQUARE), 21 GAUGE, 55% OPEN AREA; PRODUCT NO.	7.23 7.24
	38083248C5, OR APPROVED EQUAL.	7.24
7.41	SLAB SHIELD FOIL-FACED INSULATION (R-5), PERFORATE AT 12" O.C. EACH WAY.	
09000	FINISHES	7.25
9.01	5/8" THICK GYPSUM WALL BOARD (PROVIDE 5/8" GREENBOARD AT ALL	7.26
	WET LOCATIONS). LEVEL 4 FINISH OR PLASTER: LOCATIONS PER INT. SPECS.	
9.01a	5/8" THICK PROPRIETARY TYPE 'X' GYPSUM BOARD: SHEETROCK® BRAND FIRECODE	7 27

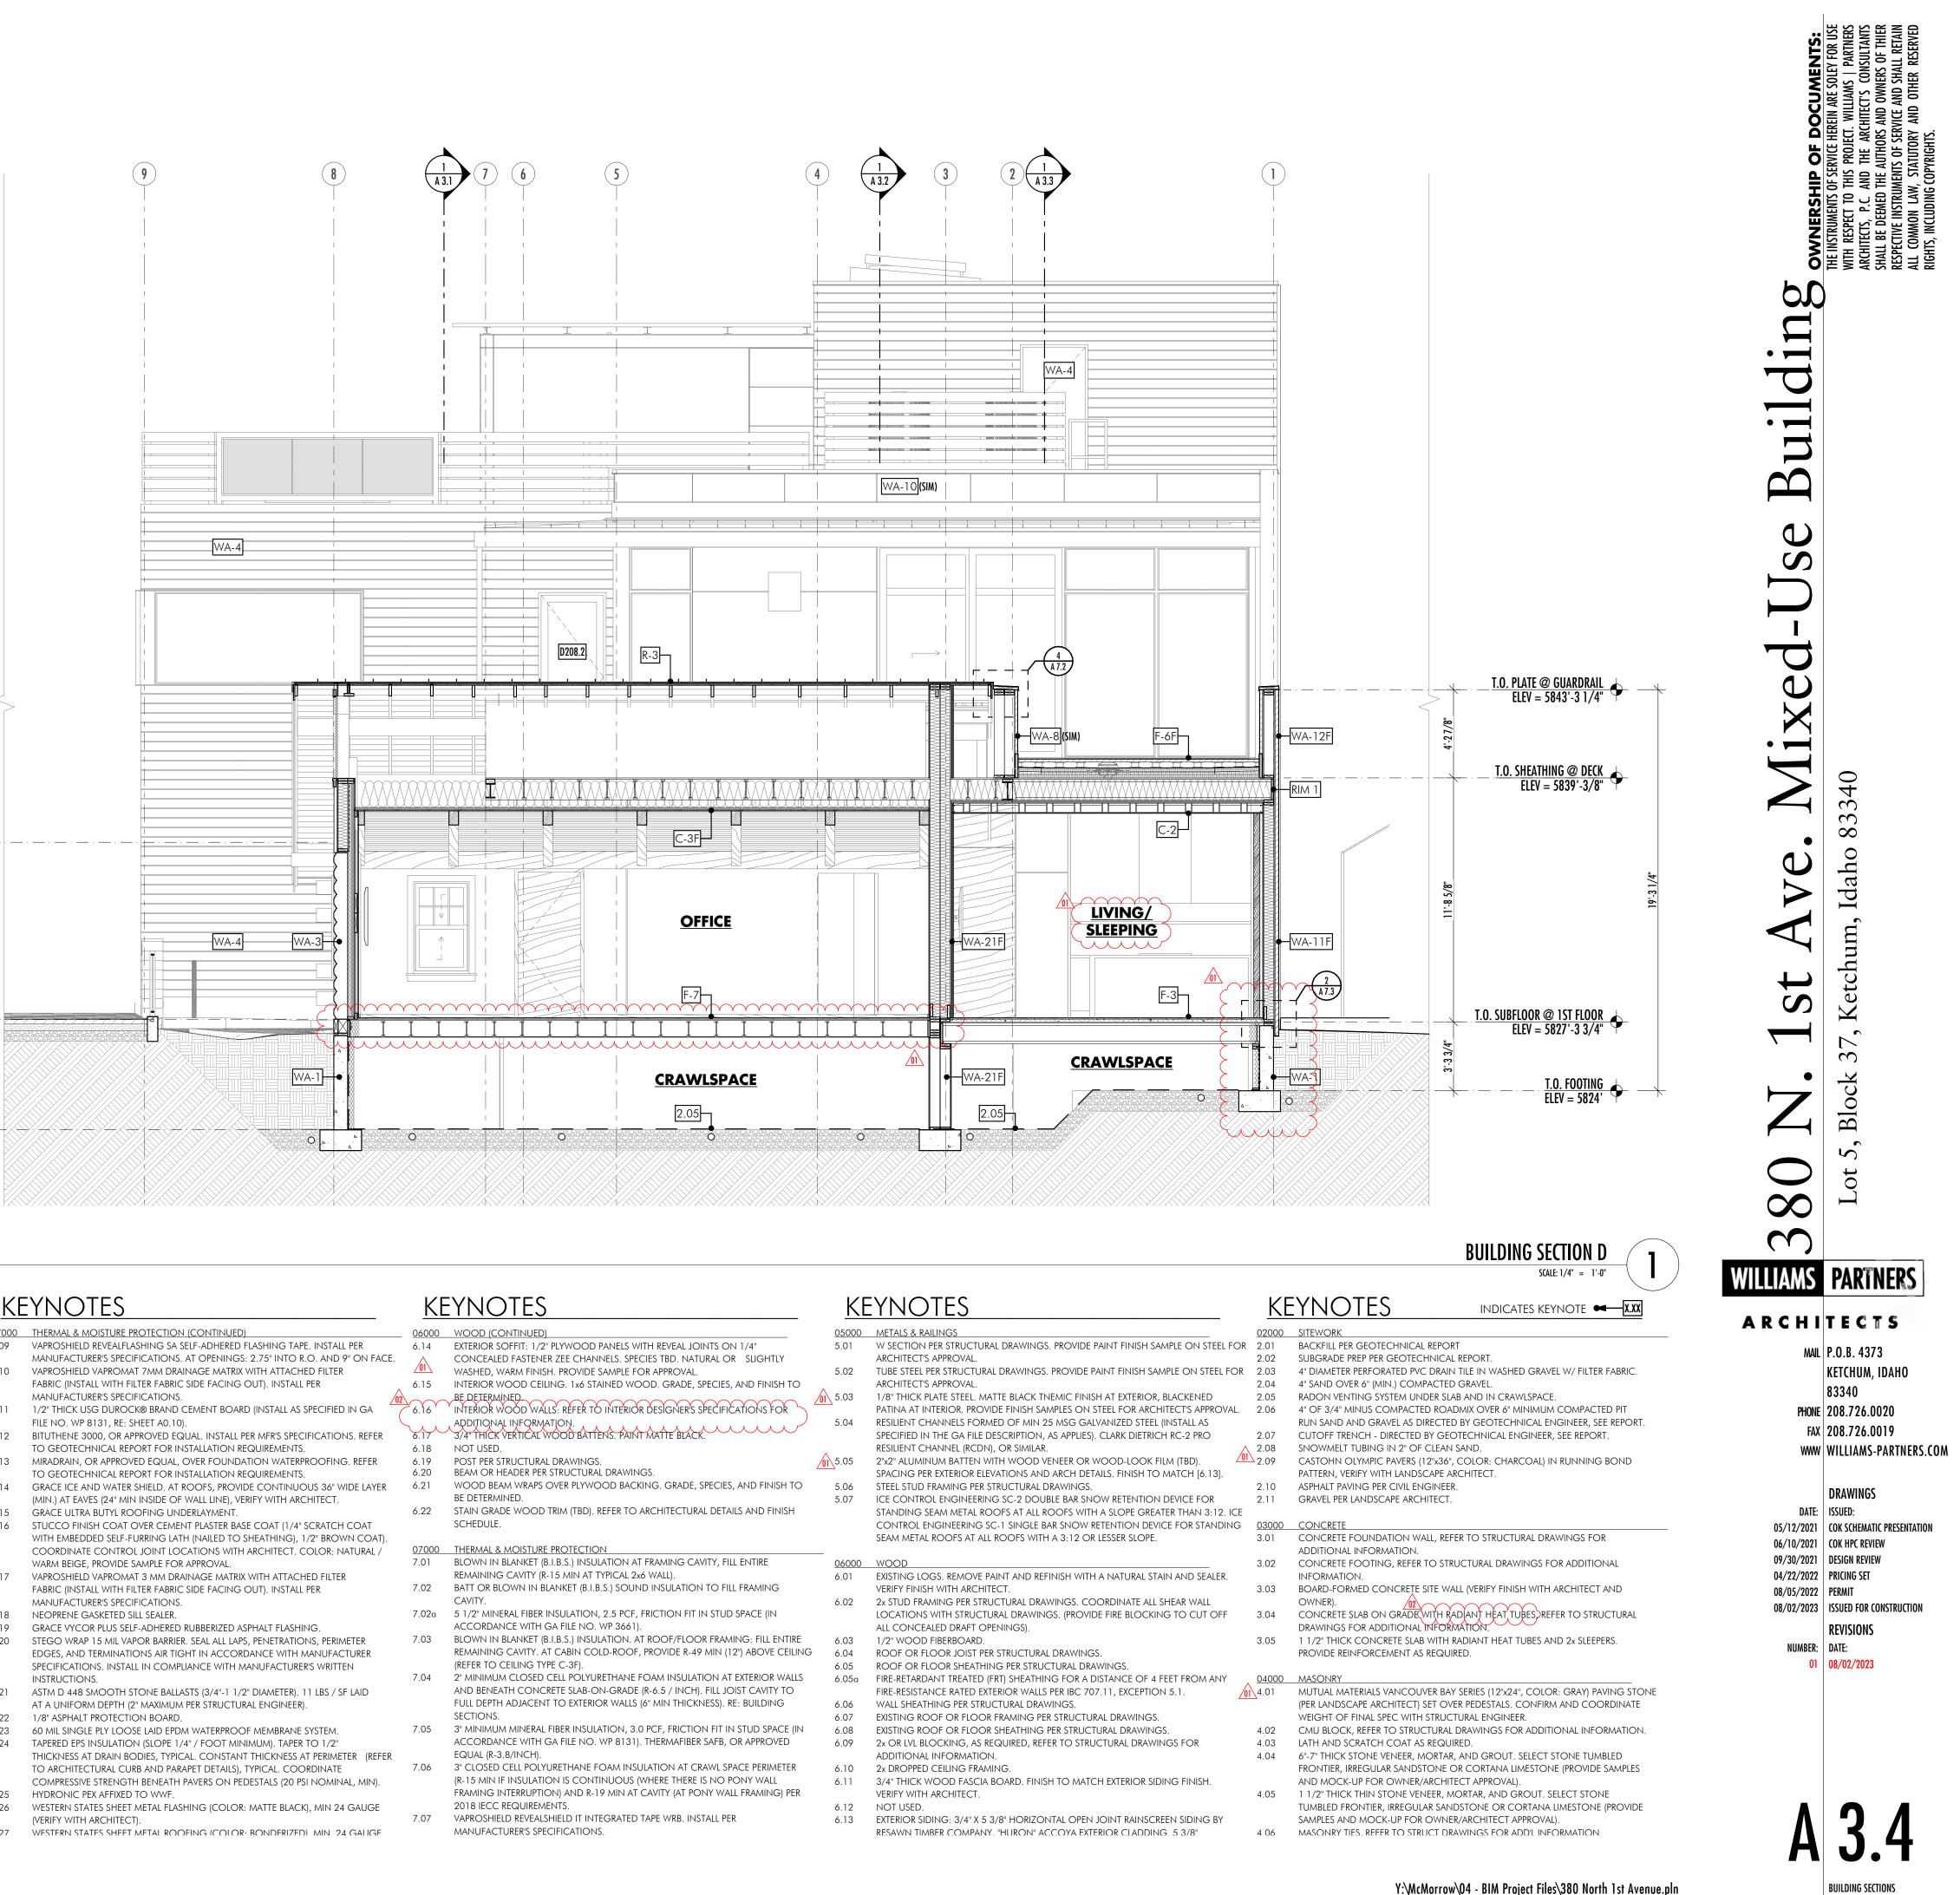

KEYNOTES

- DO0 THERMAL & MOISTURE PROTECTION (CONTINUED)
- MANUFACTURER'S SPECIFICATIONS. AT OPENINGS: 2.75" INTO R.O. AND 9" ON FACE.
- VAPROSHIELD VAPROMAT 7MM DRAINAGE MATRIX WITH ATTACHED FILTER FABRIC (INSTALL WITH FILTER FABRIC SIDE FACING OUT). INSTALL PER
- MANUFACTURER'S SPECIFICATIONS. 1/2" THICK USG DUROCK® BRAND CEMENT BOARD (INSTALL AS SPECIFIED IN GA
- FILE NO. WP 8131, RE: SHEET A0.10). BITUTHENE 3000, OR APPROVED EQUAL. INSTALL PER MFR'S SPECIFICATIONS. REFER
- TO GEOTECHNICAL REPORT FOR INSTALLATION REQUIREMENTS. MIRADRAIN, OR APPROVED EQUAL, OVER FOUNDATION WATERPROOFING. REFER TO GEOTECHNICAL REPORT FOR INSTALLATION REQUIREMENTS. GRACE ICE AND WATER SHIELD. AT ROOFS, PROVIDE CONTINUOUS 36" WIDE LAYER
- GRACE ULTRA BUTYL ROOFING UNDERLAYMENT. STUCCO FINISH COAT OVER CEMENT PLASTER BASE COAT (1/4" SCRATCH COAT
- COORDINATE CONTROL JOINT LOCATIONS WITH ARCHITECT. COLOR: NATURAL / WARM BEIGE, PROVIDE SAMPLE FOR APPROVAL
- FABRIC (INSTALL WITH FILTER FABRIC SIDE FACING OUT). INSTALL PER MANUFACTURER'S SPECIFICATIONS.
- 18 NEOPRENE GASKETED SILL SEALER.
- 20 STEGO WRAP 15 MIL VAPOR BARRIER. SEAL ALL LAPS, PENETRATIONS, PERIMETER EDGES, AND TERMINATIONS AIR TIGHT IN ACCORDANCE WITH MANUFACTURER SPECIFICATIONS. INSTALL IN COMPLIANCE WITH MANUFACTURER'S WRITTEN
- INSTRUCTIONS. ASTM D 448 SMOOTH STONE BALLASTS (3/4"-1 1/2" DIAMETER). 11 LBS / SF LAID AT A UNIFORM DEPTH (2" MAXIMUM PER STRUCTURAL ENGINEER).
- 1/8" ASPHALT PROTECTION BOARD.
- TAPERED EPS INSULATION (SLOPE 1/4" / FOOT MINIMUM). TAPER TO 1/2"
- TO ARCHITECTURAL CURB AND PARAPET DETAILS), TYPICAL. COORDINATE COMPRESSIVE STRENGTH BENEATH PAVERS ON PEDESTALS (20 PSI NOMINAL, MIN). 25 HYDRONIC PEX AFFIXED TO WWF.
- WESTERN STATES SHEET METAL FLASHING (COLOR: MATTE BLACK), MIN 24 GAUGE (VERIFY WITH ARCHITECT).
- 9.01a 5/8" THICK PROPRIETARY TYPE X' GYPSUM BOARD: SHEETROCK® BRAND FIRECODE 7.27 WESTERN STATES SHEFT METAL ROOFING (COLOR: BONDERIZED), MIN . 24 GALIGE

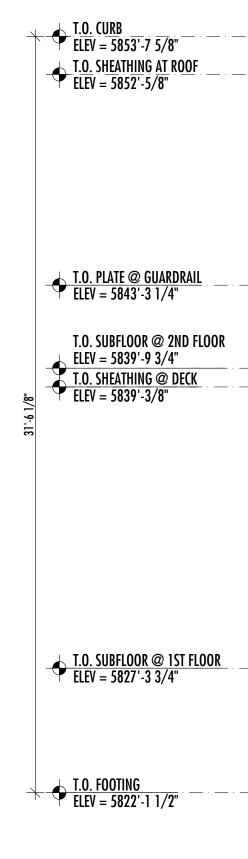


KEYNOTES


<u>··-</u>	
09000	FINISHES (CONTINUED)
9.01b	5/8" THICK TYPE 'X' GYPSUM BOARD OF ANY MANUFACTURER. INSTALL AS
	SPECIFIED IN THE GA FILE DESCRIPTION, AS APPLIES.
9.01c	5/8" THICK PROPRIETARY TYPE 'X' GYPSUM BOARD: SHEETROCK® BRAND FIRECOE
	C CORE GYPSUM PANELS (INSTALL AS SPECIFIED IN GA FILE NO. RC 2604, RE:
	SHEET A0.10).
9.01d	TWO LAYERS OF 1/2" THICK TYPE 'X' GYPSUM BOARD OF ANY MANUFACTURER.
	A THIRD LAYER OF 1/2" THICK TYPE 'X' GYPSUM BOARD IS REQUIRED WHEN GLASS FIE
	INSULATION IS USED IN THE FRAMING CAVITY INSTALL AS SPECIFIED IN THE GA FILE
	DESCRIPTION AS APPLIES, (RÉFER TO BUILDING SECTIONS FOR APPLICABILITY)
9.02	TILE, REFER TO INTERIOR SPECIFICATIONS BOOK FOR ADDITIONAL
	INFORMATION.
9.03	3/4" THICK FINISHED WOOD FLOOR, REFER TO INTERIOR SPECIFICATIONS BOOK
	FOR ADDITIONAL INFORMATION. INSTALL PER MANUFACTURER'S
	SPECIFICATIONS. INSTALL OVER MANUFACTURER / NATIONAL WOOD FLOOR
	ASSOCIATION (NWFA) RECOMMENDED VAPOR RETARDER AS APPLIES FOLLOWING
	ACCEPTABLE MOISTURE TEST READING OF CONCRETE / SUBSTRATE.
9.04	WALL PAPER, REFER TO INTERIOR SPECIFICATIONS BOOK FOR ADDITIONAL
	INFORMATION.
9.05	SCHLUTER-DITRA UNCOUPLING MEMBRANE OVER SCHLUTER ALL-SET, SCHLUTER
	FAST-SET, OR MODIFIED THIN SET MORTAR PER MANUFACTURER'S INSTALLATION
	INSTRUCTIONS.
9.06	THIN SET MORTAR.
9.07	5/8" CEMENT BACKER BOARD.
9.07a	5/8" THICK USG DUROCK® BRAND CEMENT GLASS-MAT TILE BACKERBOARD
	(SUBSTITUTED FOR 5/8" USG SHEETROCK BRAND FIRECODE GYPSUM PANELS AS
	ALLOWED FOR IN USG FIRE-RATING LITERATURE).
9.08	CARPET AND PAD, REFER TO INTERIOR SPECIFICATIONS BOOK FOR ADDITIONAL
	INFORMATION.
9.09	EPOXY FLOOR COATING WITH NON-SLIP ADDITIVE / AGGREGATE, INSTALL PER
	MANUFACTURER'S SPECIFICATIONS.
10000	SPECIALTIES
	PLAN NOTES.
11000	EQUIPMENT

11.01 MECHANICAL EQUIPMENT SHALL BE DESIGN BUILD WITH ARCHITECT / CONTRACTOR / MECHANICAL SUB CONTRACTOR.

KEYNOTES

07000	THERMAL & MOISTURE PROTECTION (CONTINUED)	0700
7.28	AWS DIAMOND HEAD SERIES PEDESTALS.	<u>0,00</u> 7.09
7.29	BASF MASTERSEAL NP 150 SEALANT (OR APPROVED EQUAL). SEALANT TO MATCH	
	ADJACENT FINISH.	7.10
7.30	3/8" DIA BACKER ROD AND BASF MASTERSEAL NP 150 SEALANT (OR APPROVED	
	EQUAL). SEALANT TO MATCH ADJACENT FINISH.	
7.31	30 LB. FELT ROOFING UNDERLAYMENT. PROTECT FROM MOISTURE PRIOR TO	7.11
	INSTALLATION OF METAL ROOF.	
7.32	CERTAINTEED MEMBRAIN SMART VAPOR RETARDER. INSTALL PER MANUFACTURER'S	7.12
	SPECIFICATIONS.	7.10
7.33	2" (20 PSI NOMINAL) FLAT STOCK POLYISOCYANURATE RIGID INSULATION BOARD	7.13
	(LTTR R-5.6 / INCH, MINIMUM) WITH FIBERGLASS FACERS AT BOTH SIDES. AT	7.14
	BOTTOM-MOST COURSE OVER ROOF SHEATHING: POLYISO TO BE AN AIR-	7.14
	IMPERMEABLE CLASS II VAPOR RETARDER AND TAPED AT ALL SEAMS, INCLUDING AT	7.15
7.0.4	THE PERIMETER TO THE ROOF CURB TO FORM A CONTINUOUS LAYER.	7.16
7.34	GAF VERSASHIELD ROOF DECK PROTECTION.	
7.35	VAPROSHIELD WRAPSHIELD IT INTEGRATED TAPE WRB. INSTALL PER MANUFACTURER'S SPECIFICATIONS.	
7.36	1/2" THICK DENSDECK PRIME ROOF BOARD.	
7.37	60 MIL SINGLE PLY FULLY-ADHERED EPDM WATERPROOFING MEMBRANE SYSTEM.	7.17
7.37	PROVIDE 6" MIN. SEAM TAPE WITH 12" MIN. COVER TAPE AT ALL SEAMS. INSTALL PER	
	MANUFACTURER'S SPECIFICATIONS.	
7.38	45 MIL LOOSE-LAID EPDM SLIP SHEET / ROOF BARRIER. OVERLAP SEAMS 3" MIN AND	7.18
7.00	GLUE WITH IMPERVIOUS ROLL-OUT ADHESIVE. INSTALL PER MANUFACTURER'S	7.19
	SPECIFICATIONS.	7.20
7.39	PRE-VEGETATED LIVEROOF MAXX MODULAR ROOF SYSTEM (12"x12"x3 1/4"	
	MODULES WITH 8" SOIL DEPTH). 55-65 PSF SATURATED AND VEGETATED WEIGHT.	
	PROVIDE DRIP IRRIGATION (SYSTEM BY OTHERS). INSTALL PER MANUFACTURER'S	7.21
	SPECIFICATIONS. PROVIDE ROOFEDGE MAXX AT PERIMETER CONDITIONS (BLACK	7.21
	anodized finish).	7.22
7.40	MCNICHOLS WIRE MESH - SQUARE STAINLESS STEEL. TYPE 304, WOVEN, 0.0930" x	7.23
	0.0930" OPENING (SQUARE), 21 GAUGE, 55% OPEN AREA; PRODUCT NO.	7.24
	38083248C5, OR APPROVED EQUAL.	
7.41	SLAB SHIELD FOIL-FACED INSULATION (R-5), PERFORATE AT 12" O.C. EACH WAY.	
09000	FINISHES	7.25
9.01	5/8" THICK GYPSUM WALL BOARD (PROVIDE 5/8" GREENBOARD AT ALL	7.26
	WET LOCATIONS). LEVEL 4 FINISH OR PLASTER: LOCATIONS PER INT. SPECS.	
9 01a	5/8" THICK PROPRIETARY TYPE 'X' GYPSUM BOARD SHEETROCK® BRAND FIRECODE	7 27

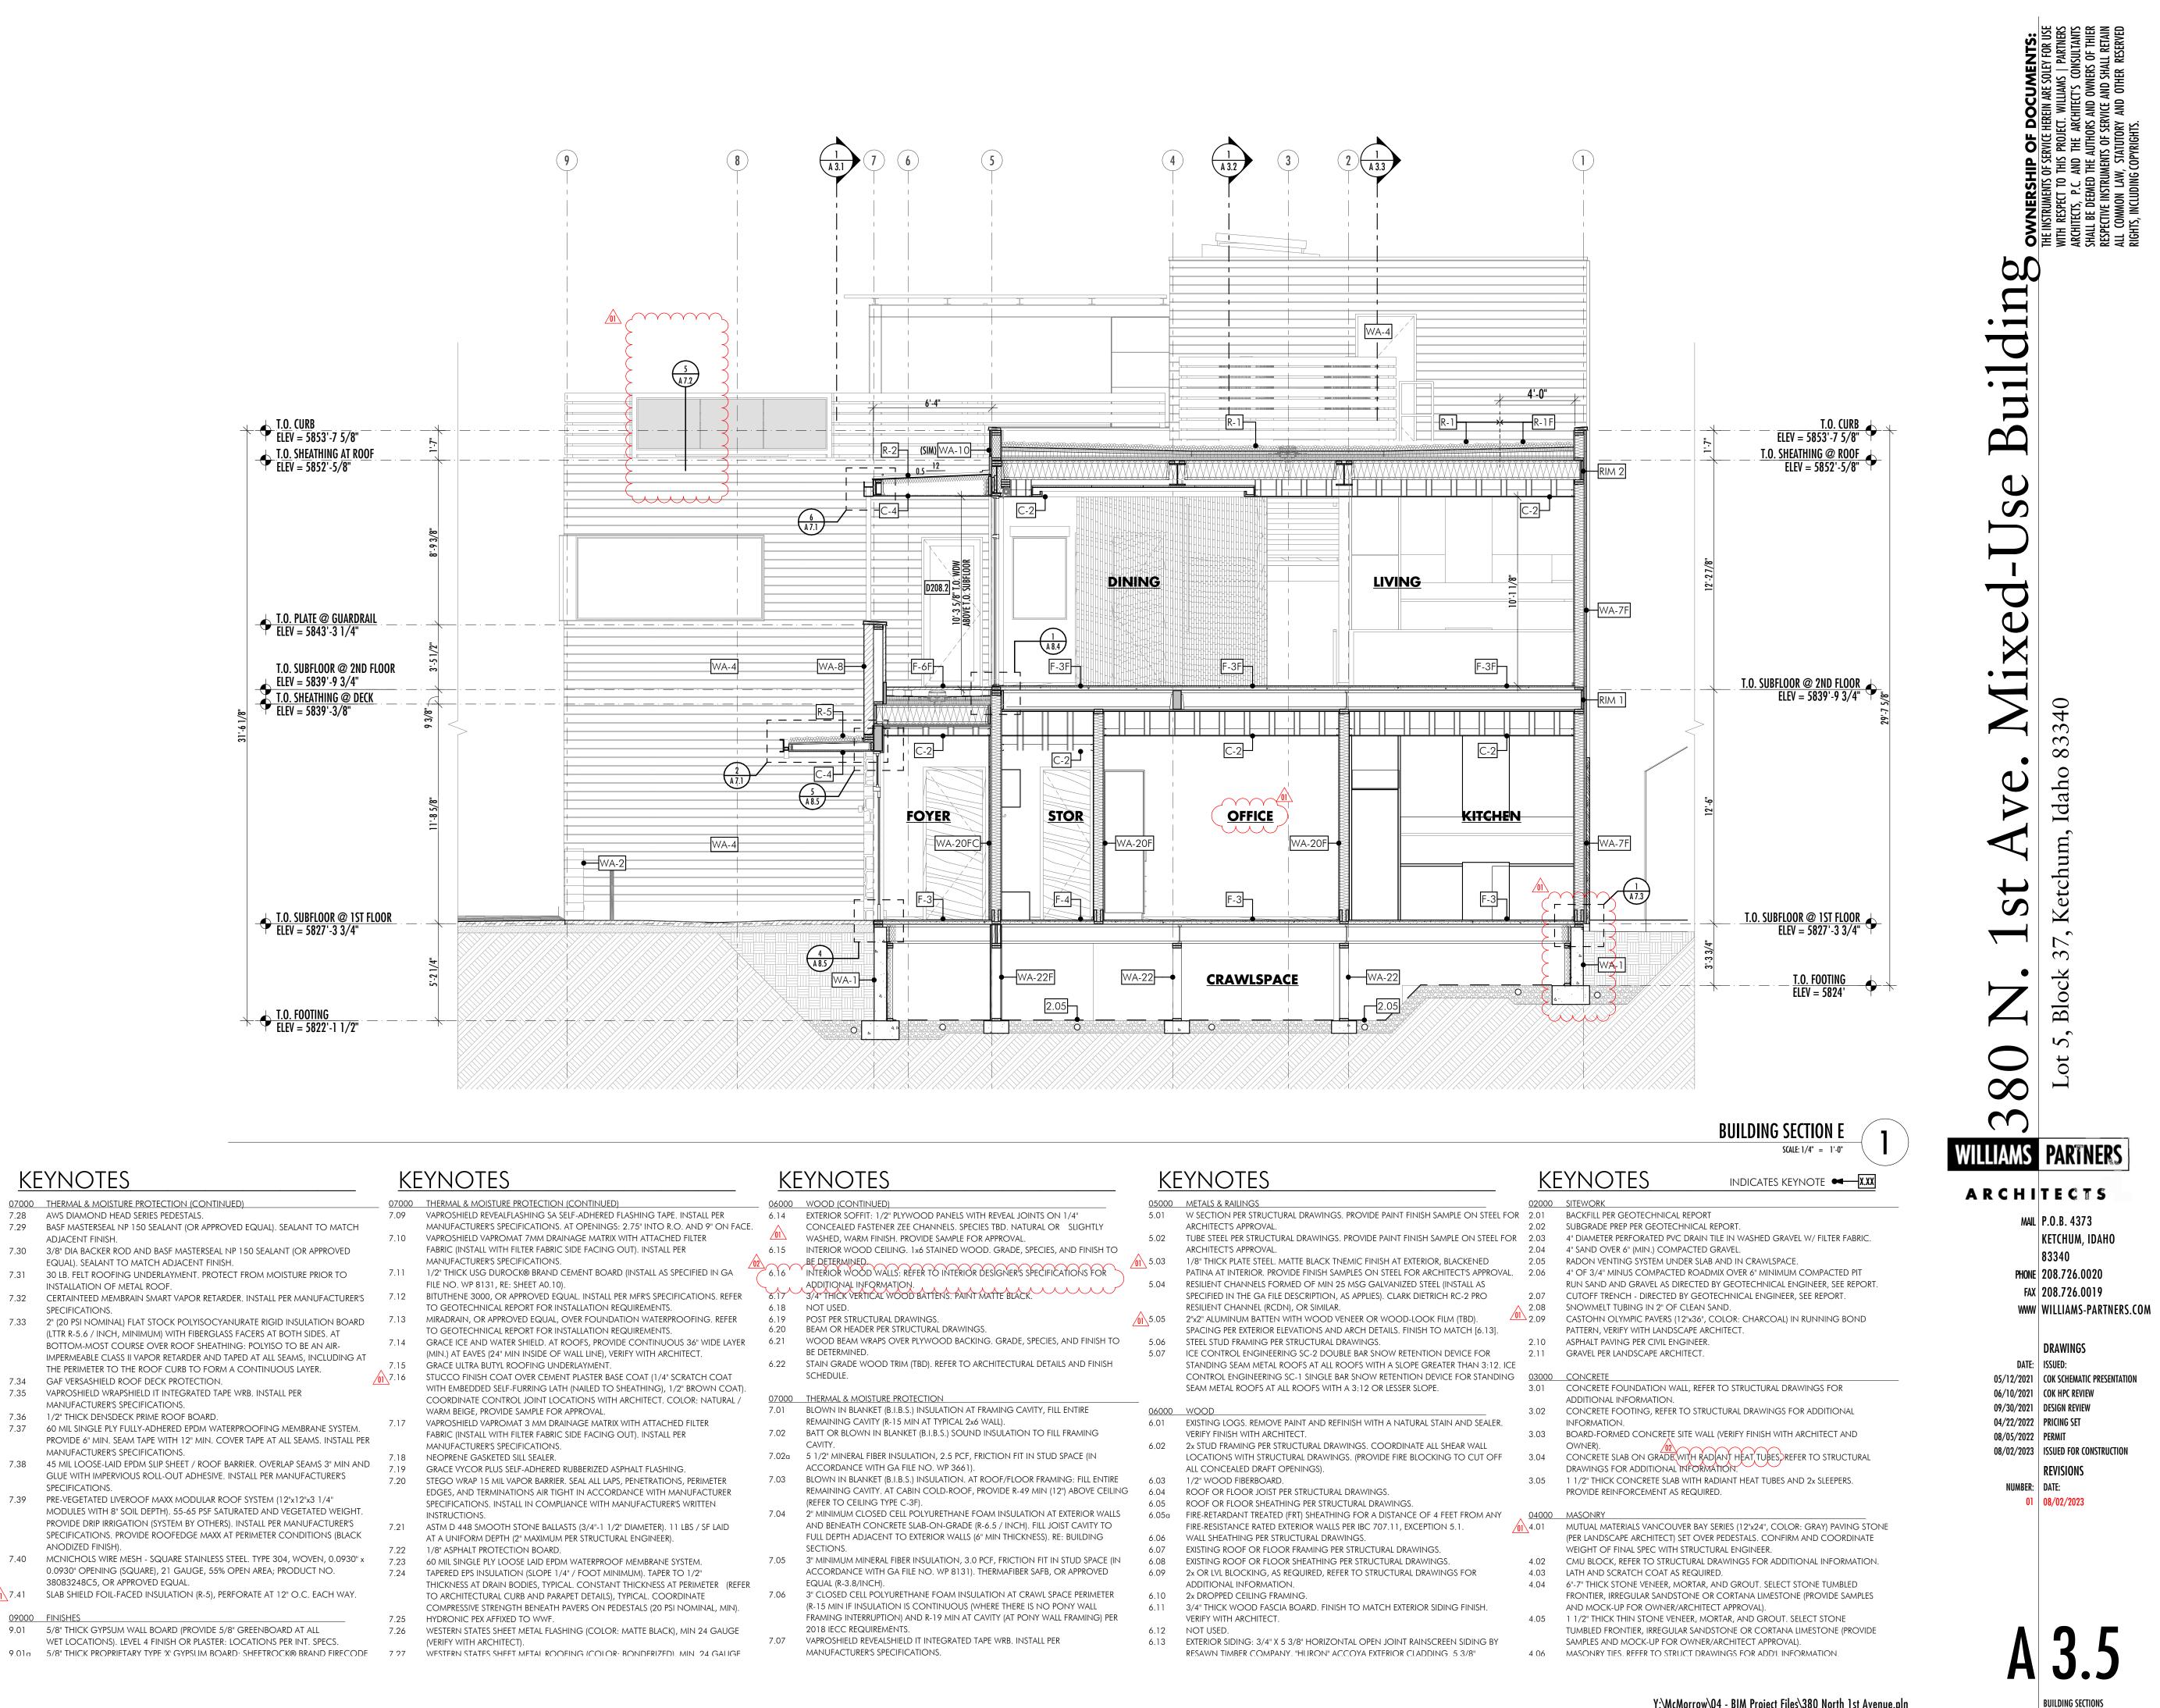

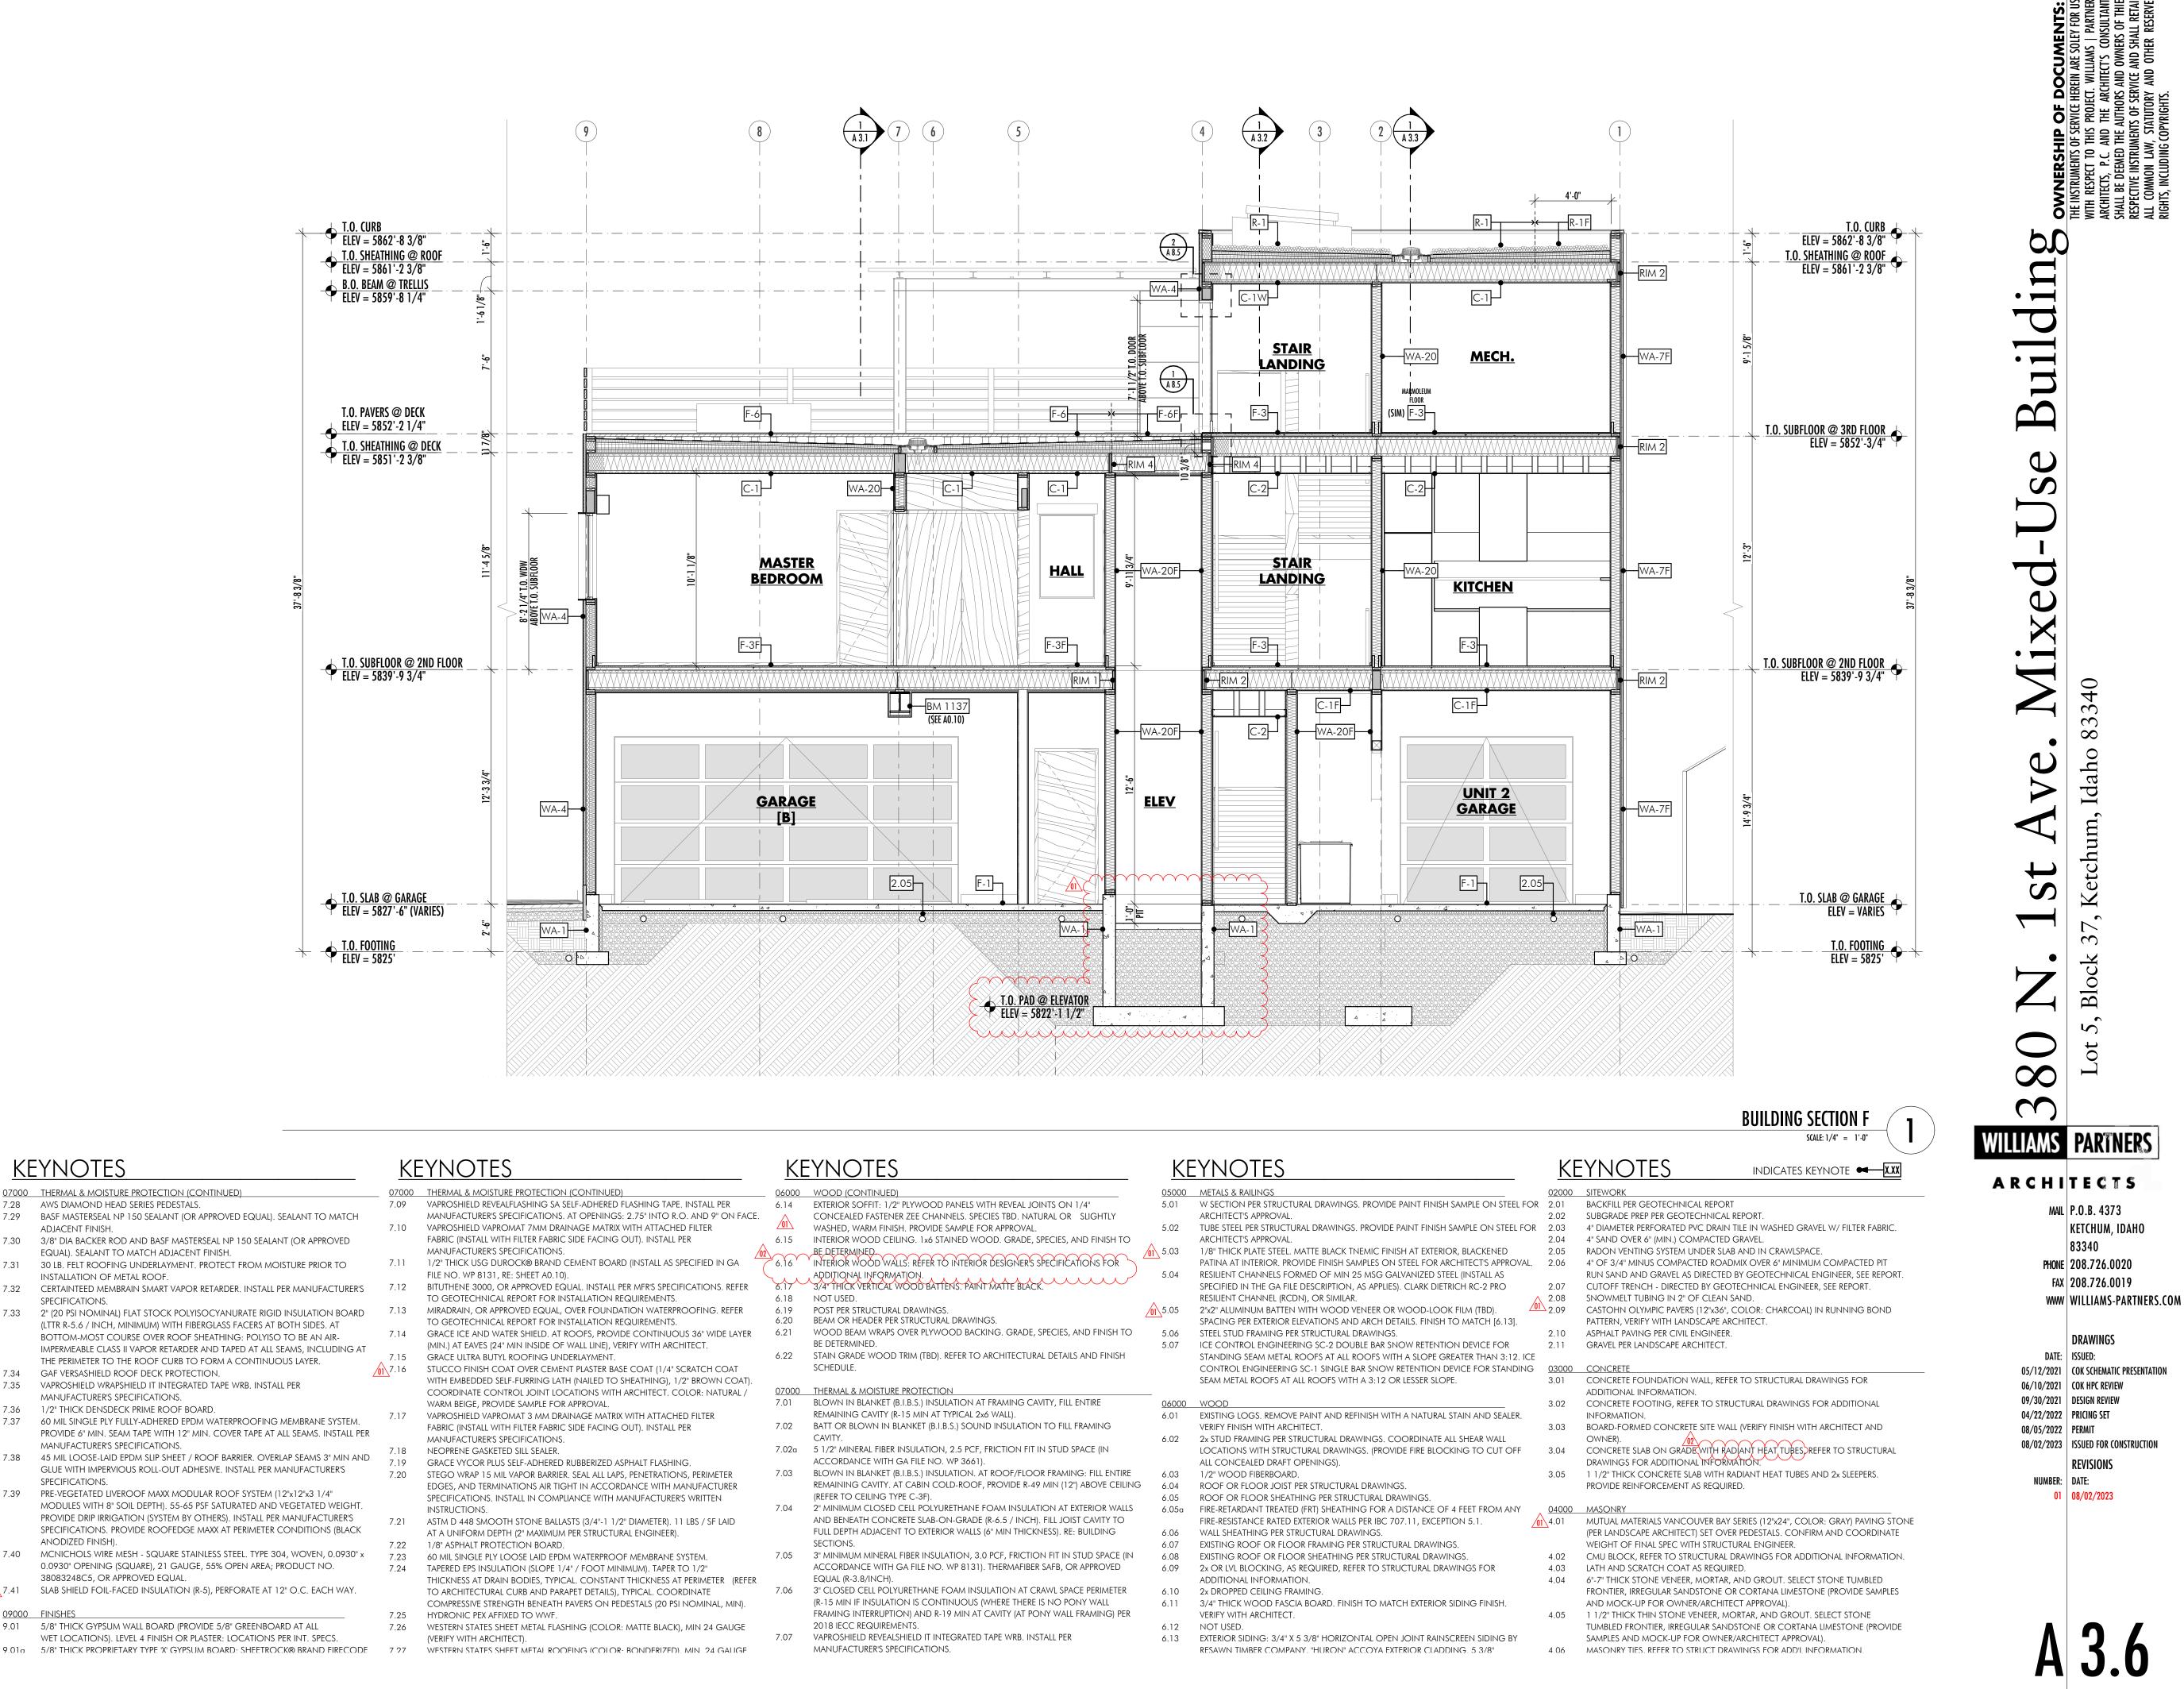

KEYNOTES


09000	FINISHES (CONTINUED)
9.01b	5/8" THICK TYPE 'X' GYPSUM BOARD OF ANY MANUFACTURER. INSTALL AS
	SPECIFIED IN THE GA FILE DESCRIPTION, AS APPLIES.
9.01c	5/8" THICK PROPRIETARY TYPE 'X' GYPSUM BOARD: SHEETROCK® BRAND FIRECODE
	C CORE GYPSUM PANELS (INSTALL AS SPECIFIED IN GA FILE NO. RC 2604, RE:
	SHEET AO.10).
9.01d	TWO LAYERS OF 1/2" THICK TYPE 'X' GYPSUM BOARD OF ANY MANUFACTURER.
	A THIRD LAYER OF 1/2" THICK TYPE X' GYPSUM BOARD IS REQUIRED WHEN GLASS FIBE
	INSULATION IS USED IN THE FRAMING CAVITY INSTALL AS SPECIFIED IN THE GA FILE
	DESCRIPTION AS APPLIES, (RĚFEŘ TÝ BŮILĎING SĚCŤIONS FOŘ APPLICABILIŤY)
9.02	TILE, REFER TO INTERIOR SPECIFICATIONS BOOK FOR ADDITIONAL
	INFORMATION.
9.03	3/4" THICK FINISHED WOOD FLOOR, REFER TO INTERIOR SPECIFICATIONS BOOK
	FOR ADDITIONAL INFORMATION. INSTALL PER MANUFACTURER'S
	SPECIFICATIONS. INSTALL OVER MANUFACTURER / NATIONAL WOOD FLOOR
	ASSOCIATION (NWFA) RECOMMENDED VAPOR RETARDER AS APPLIES FOLLOWING
	ACCEPTABLE MOISTURE TEST READING OF CONCRETE / SUBSTRATE.
9.04	WALL PAPER, REFER TO INTERIOR SPECIFICATIONS BOOK FOR ADDITIONAL
	INFORMATION.
9.05	SCHLUTER-DITRA UNCOUPLING MEMBRANE OVER SCHLUTER ALL-SET, SCHLUTER
	FAST-SET, OR MODIFIED THIN SET MORTAR PER MANUFACTURER'S INSTALLATION
	INSTRUCTIONS.
9.06	THIN SET MORTAR.
9.07	5/8" CEMENT BACKER BOARD.
9.07a	5/8" THICK USG DUROCK® BRAND CEMENT GLASS-MAT TILE BACKERBOARD
	(SUBSTITUTED FOR 5/8" USG SHEETROCK BRAND FIRECODE GYPSUM PANELS AS
	ALLOWED FOR IN USG FIRE-RATING LITERATURE).
9.08	CARPET AND PAD, REFER TO INTERIOR SPECIFICATIONS BOOK FOR ADDITIONAL
	INFORMATION.
9.09	EPOXY FLOOR COATING WITH NON-SLIP ADDITIVE / AGGREGATE, INSTALL PER
	MANUFACTURER'S SPECIFICATIONS.
10000	SPECIALTIES
REFER TO	D PLAN NOTES.
11000	EQUIPMENT

11.01	MECHANICAL EQUIPMENT SHALL BE DESIGN BUILD WITH ARCHITECT /
	CONTRACTOR / MECHANICAL SUB CONTRACTOR.

KEYNOTES


07000	THERMAL & MOISTURE PROTECTION (CONTINUED)	07000
7.28	AWS DIAMOND HEAD SERIES PEDESTALS.	7.09
7.29	BASF MASTERSEAL NP 150 SEALANT (OR APPROVED EQUAL). SEALANT TO MATCH	
	ADJACENT FINISH.	7.10
7.30	3/8" DIA BACKER ROD AND BASF MASTERSEAL NP 150 SEALANT (OR APPROVED	
	EQUAL). SEALANT TO MATCH ADJACENT FINISH.	
7.31	30 LB. FELT ROOFING UNDERLAYMENT. PROTECT FROM MOISTURE PRIOR TO	7.11
	INSTALLATION OF METAL ROOF.	
7.32	CERTAINTEED MEMBRAIN SMART VAPOR RETARDER. INSTALL PER MANUFACTURER'S	7.12
	SPECIFICATIONS.	
7.33	2" (20 PSI NOMINAL) FLAT STOCK POLYISOCYANURATE RIGID INSULATION BOARD	7.13
	(LTTR R-5.6 / INCH, MINIMUM) WITH FIBERGLASS FACERS AT BOTH SIDES. AT	
	BOTTOM-MOST COURSE OVER ROOF SHEATHING: POLYISO TO BE AN AIR-	7.14
	IMPERMEABLE CLASS II VAPOR RETARDER AND TAPED AT ALL SEAMS, INCLUDING AT	
	THE PERIMETER TO THE ROOF CURB TO FORM A CONTINUOUS LAYER.	7.15
7.34	GAF VERSASHIELD ROOF DECK PROTECTION.	01 7.16
7.35	VAPROSHIELD WRAPSHIELD IT INTEGRATED TAPE WRB. INSTALL PER	
	MANUFACTURER'S SPECIFICATIONS.	
7.36	1/2" THICK DENSDECK PRIME ROOF BOARD.	717
7.37	60 MIL SINGLE PLY FULLY-ADHERED EPDM WATERPROOFING MEMBRANE SYSTEM.	7.17
	PROVIDE 6" MIN. SEAM TAPE WITH 12" MIN. COVER TAPE AT ALL SEAMS. INSTALL PER	
	MANUFACTURER'S SPECIFICATIONS.	7.18
7.38	45 MIL LOOSE-LAID EPDM SLIP SHEET / ROOF BARRIER. OVERLAP SEAMS 3" MIN AND	7.19
	GLUE WITH IMPERVIOUS ROLL-OUT ADHESIVE. INSTALL PER MANUFACTURER'S	7.19
	SPECIFICATIONS.	7.20
7.39	PRE-VEGETATED LIVEROOF MAXX MODULAR ROOF SYSTEM (12"x12"x3 1/4"	
	MODULES WITH 8" SOIL DEPTH). 55-65 PSF SATURATED AND VEGETATED WEIGHT.	
	PROVIDE DRIP IRRIGATION (SYSTEM BY OTHERS). INSTALL PER MANUFACTURER'S	7.21
	SPECIFICATIONS. PROVIDE ROOFEDGE MAXX AT PERIMETER CONDITIONS (BLACK	7.21
	anodized finish).	7.22
7.40	MCNICHOLS WIRE MESH - SQUARE STAINLESS STEEL. TYPE 304, WOVEN, 0.0930" x	7.23
	0.0930" OPENING (SQUARE), 21 GAUGE, 55% OPEN AREA; PRODUCT NO.	7.24
	38083248C5, OR APPROVED EQUAL.	<i>,</i> . <u> </u>
7.41	SLAB SHIELD FOIL-FACED INSULATION (R-5), PERFORATE AT 12" O.C. EACH WAY.	
09000	FINISHES	7.25
9.01	5/8" THICK GYPSUM WALL BOARD (PROVIDE 5/8" GREENBOARD AT ALL	7.26
	WET LOCATIONS). LEVEL 4 FINISH OR PLASTER: LOCATIONS PER INT. SPECS.	
9.01a	5/8" THICK PROPRIETARY TYPE 'X' GYPSUM BOARD: SHEETROCK® BRAND FIRECODE	7 97

BUILDING SECTIONS

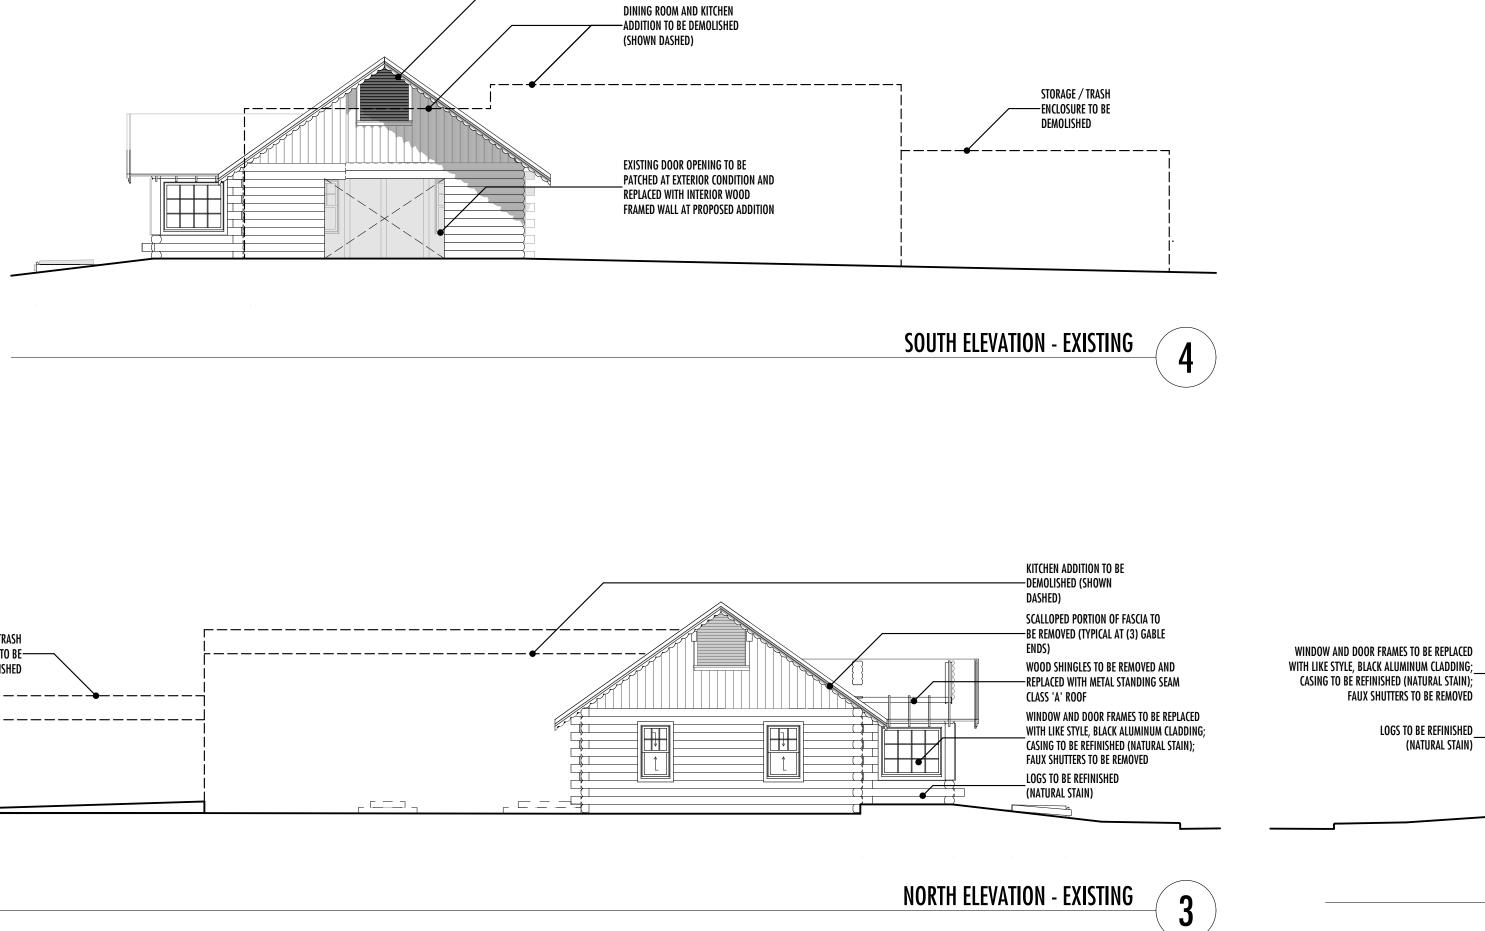

SCALLOPED PORTION OF —FASCIA TO BE REMOVED

(TYPICAL AT (3) GABLE ENDS)

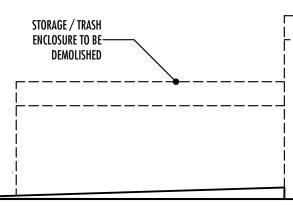

C AN **OWN** THE INSTI Building

83340 \bullet Idaho stchum, Ke • \sim \mathcal{O} $\mathbf{\lambda}$ Bloc ſ 5 ot WILLIAMS PARTNERS ARCHITECTS

MAIL P.O.B. 4373 KETCHUM, IDAHO 83340 PHONE 208.726.0020 FAX 208.726.0019 WWW WILLIAMS-PARTNERS.COM

DRAWINGS

DATE: ISSUED: 05/12/2021 COK SCHEMATIC PRESENTATION 06/10/2021 COK HPC REVIEW 09/30/2021 DESIGN REVIEW 04/22/2022 PRICING SET 08/05/2022 PERMIT 08/02/2023 ISSUED FOR CONSTRUCTION REVISIONS

NUMBER: DATE:






(2) EXISTING INTERIOR DOOR OPENINGS AND (1) PASS-THROUGH WINDOW —OPENING: WALL TO BE DEMOLISHED AND REPLACED WITH WOOD FRAMED INTERIOR WALL CONSTRUCTION !┘------₩---------_ __ __ _ KITCHEN ADDITION TO BE —DEMOLISHED (SHOWN DASHED) WINDOW AND DOOR FRAMES TO BE REPLAC WITH LIKE STYLE, BLACK ALUMINUM CLADD Casing to be refinished (natural stain - YH4- 1 `**~**_~ SHUTTERS TO BE REMOVED X LOGS TO BE REFINISHED (NATURAL STAIN) ▰╓┤

EAST ELEVATION - EXISTING



WOOD SHINGLES TO BE REMOVED AND — REPLACED WITH METAL STANDING SEAM

CLASS 'A' ROOF

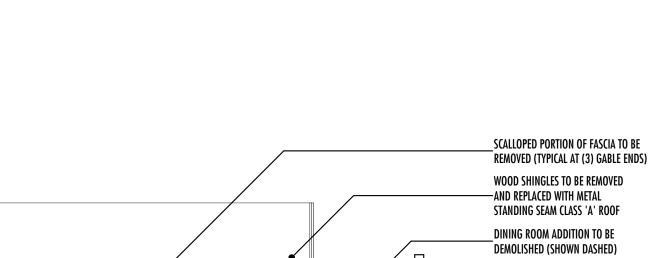

WEST ELEVATION - EXISTING

Y:\McMorrow\04 - BIM Project Files\380 North 1st Avenue.pln

B.O. BEAM @ TRELLIS ELEV = 5859'-8 1/4" T.O. PAVERS @ DECK ELEV = 5852'-2 1/4" T.O. SHEATHING @ DECK ELEV = 5851'-2 3/8" <u>T.O. [E] RIDGE</u> ELEV = 5844'-4 1/4"


KEYNOTES


09000	FINISHES (CONTINUED)
9.01b	5/8" THICK TYPE 'X' GYPSUM BOARD OF ANY MANUFACTURER. INSTALL AS
	SPECIFIED IN THE GA FILE DESCRIPTION, AS APPLIES.
9.01c	5/8" THICK PROPRIETARY TYPE 'X' GYPSUM BOARD: SHEETROCK® BRAND FIRECOD C CORE GYPSUM PANELS (INSTALL AS SPECIFIED IN GA FILE NO. RC 2604, RE: SHEET A0.10).
9.01d	TWO LAYERS OF 1/2" THICK TYPE 'X' GYPSUM BOARD OF ANY MANUFACTURER. A THIRD LAYER OF 1/2" THICK TYPE 'X' GYPSUM BOARD IS REQUIRED WHEN GLASS FIBE INSULATION IS USED IN THE FRAMING CAVITY INSTALL AS SPECIFIED IN THE GA FILE DESCRIPTION AS APPLIES, (REFER TO BUILDING SECTIONS FOR APPLICABILITY)
9.02	TILE, REFER TO INTERIOR SPECIFICATIONS BOOK FOR ADDITIONAL
9.03	3/4" THICK FINISHED WOOD FLOOR, REFER TO INTERIOR SPECIFICATIONS BOOK FOR ADDITIONAL INFORMATION. INSTALL PER MANUFACTURER'S SPECIFICATIONS. INSTALL OVER MANUFACTURER / NATIONAL WOOD FLOOR ASSOCIATION (NWFA) RECOMMENDED VAPOR RETARDER AS APPLIES FOLLOWING ACCEPTABLE MOISTURE TEST READING OF CONCRETE / SUBSTRATE.
9.04	WALL PAPER, REFER TO INTERIOR SPECIFICATIONS BOOK FOR ADDITIONAL INFORMATION.
9.05	SCHLUTER-DITRA UNCOUPLING MEMBRANE OVER SCHLUTER ALL-SET, SCHLUTER FAST-SET, OR MODIFIED THIN SET MORTAR PER MANUFACTURER'S INSTALLATION INSTRUCTIONS.
9.06	THIN SET MORTAR.
9.07	5/8" CEMENT BACKER BOARD.
9.07a	5/8" THICK USG DUROCK® BRAND CEMENT GLASS-MAT TILE BACKERBOARD (SUBSTITUTED FOR 5/8" USG SHEETROCK BRAND FIRECODE GYPSUM PANELS AS ALLOWED FOR IN USG FIRE-RATING LITERATURE).
9.08	CARPET AND PAD, REFER TO INTERIOR SPECIFICATIONS BOOK FOR ADDITIONAL INFORMATION.
9.09	EPOXY FLOOR COATING WITH NON-SLIP ADDITIVE / AGGREGATE, INSTALL PER MANUFACTURER'S SPECIFICATIONS.
10000	SPECIALTIES
REFER TO) PLAN NOTES.

	ALLOWED FOR IN USG FIRE-RATING LITERATURE).	7.39
9.08	CARPET AND PAD, REFER TO INTERIOR SPECIFICATIONS BOOK FOR ADDITIONAL	
9.09	EPOXY FLOOR COATING WITH NON-SLIP ADDITIVE / AGGREGATE, INSTALL PER	
	MANUFACTURER'S SPECIFICATIONS.	7.40
10000	SPECIALTIES	
REFER TO	O PLAN NOTES.	7.41
11000	EQUIPMENT	<u>/01</u> /.41
11.01	MECHANICAL EQUIPMENT SHALL BE DESIGN BUILD WITH ARCHITECT /	<u>09000</u>
	CONTRACTOR / MECHANICAL SUB CONTRACTOR.	9.01

KEYNOTES

07000	THERMAL & MOISTURE PROTECTION (CONTINUED)	07000
7.28	AWS DIAMOND HEAD SERIES PEDESTALS.	7.09
7.29	BASF MASTERSEAL NP 150 SEALANT (OR APPROVED EQUAL). SEALANT TO MATCH	
	ADJACENT FINISH.	7.10
7.30	3/8" DIA BACKER ROD AND BASF MASTERSEAL NP 150 SEALANT (OR APPROVED	
	EQUAL). SEALANT TO MATCH ADJACENT FINISH.	
7.31	30 LB. FELT ROOFING UNDERLAYMENT. PROTECT FROM MOISTURE PRIOR TO	7.11
	INSTALLATION OF METAL ROOF.	
7.32	CERTAINTEED MEMBRAIN SMART VAPOR RETARDER. INSTALL PER MANUFACTURER'S	7.12
	SPECIFICATIONS.	
7.33	2" (20 PSI NOMINAL) FLAT STOCK POLYISOCYANURATE RIGID INSULATION BOARD	7.13
	(LTTR R-5.6 / INCH, MINIMUM) WITH FIBERGLASS FACERS AT BOTH SIDES. AT	
	BOTTOM-MOST COURSE OVER ROOF SHEATHING: POLYISO TO BE AN AIR-	7.14
	IMPERMEABLE CLASS II VAPOR RETARDER AND TAPED AT ALL SEAMS, INCLUDING AT	
	THE PERIMETER TO THE ROOF CURB TO FORM A CONTINUOUS LAYER.	7.15
7.34	GAF VERSASHIELD ROOF DECK PROTECTION.	7.16
7.35	VAPROSHIELD WRAPSHIELD IT INTEGRATED TAPE WRB. INSTALL PER	
	MANUFACTURER'S SPECIFICATIONS.	
7.36	1/2" THICK DENSDECK PRIME ROOF BOARD.	- 1 -
7.37	60 MIL SINGLE PLY FULLY-ADHERED EPDM WATERPROOFING MEMBRANE SYSTEM.	7.17
	PROVIDE 6" MIN. SEAM TAPE WITH 12" MIN. COVER TAPE AT ALL SEAMS. INSTALL PER	
	MANUFACTURER'S SPECIFICATIONS.	7.18
7.38	45 MIL LOOSE-LAID EPDM SLIP SHEET / ROOF BARRIER. OVERLAP SEAMS 3" MIN AND	7.18
	GLUE WITH IMPERVIOUS ROLL-OUT ADHESIVE. INSTALL PER MANUFACTURER'S	7.19
	SPECIFICATIONS.	7.20
7.39	PRE-VEGETATED LIVEROOF MAXX MODULAR ROOF SYSTEM (12"x12"x3 1/4"	
	MODULES WITH 8" SOIL DEPTH). 55-65 PSF SATURATED AND VEGETATED WEIGHT.	
	PROVIDE DRIP IRRIGATION (SYSTEM BY OTHERS). INSTALL PER MANUFACTURER'S	7.21
	SPECIFICATIONS. PROVIDE ROOFEDGE MAXX AT PERIMETER CONDITIONS (BLACK	7.21
	ANODIZED FINISH).	7.22
7.40	MCNICHOLS WIRE MESH - SQUARE STAINLESS STEEL. TYPE 304, WOVEN, 0.0930" x	7.23
	0.0930" OPENING (SQUARE), 21 GAUGE, 55% OPEN AREA; PRODUCT NO.	7.24
	38083248C5, OR APPROVED EQUAL.	<i>, .</i> <u> </u>
7.41	SLAB SHIELD FOIL-FACED INSULATION (R-5), PERFORATE AT 12" O.C. EACH WAY.	
09000	FINISHES	7.25
9.01	5/8" THICK GYPSUM WALL BOARD (PROVIDE 5/8" GREENBOARD AT ALL	7.26
	WET LOCATIONS). LEVEL 4 FINISH OR PLASTER: LOCATIONS PER INT. SPECS.	
9.01a	5/8" THICK PROPRIETARY TYPE 'X' GYPSUM BOARD: SHEETROCK® BRAND FIRECODE	7 27

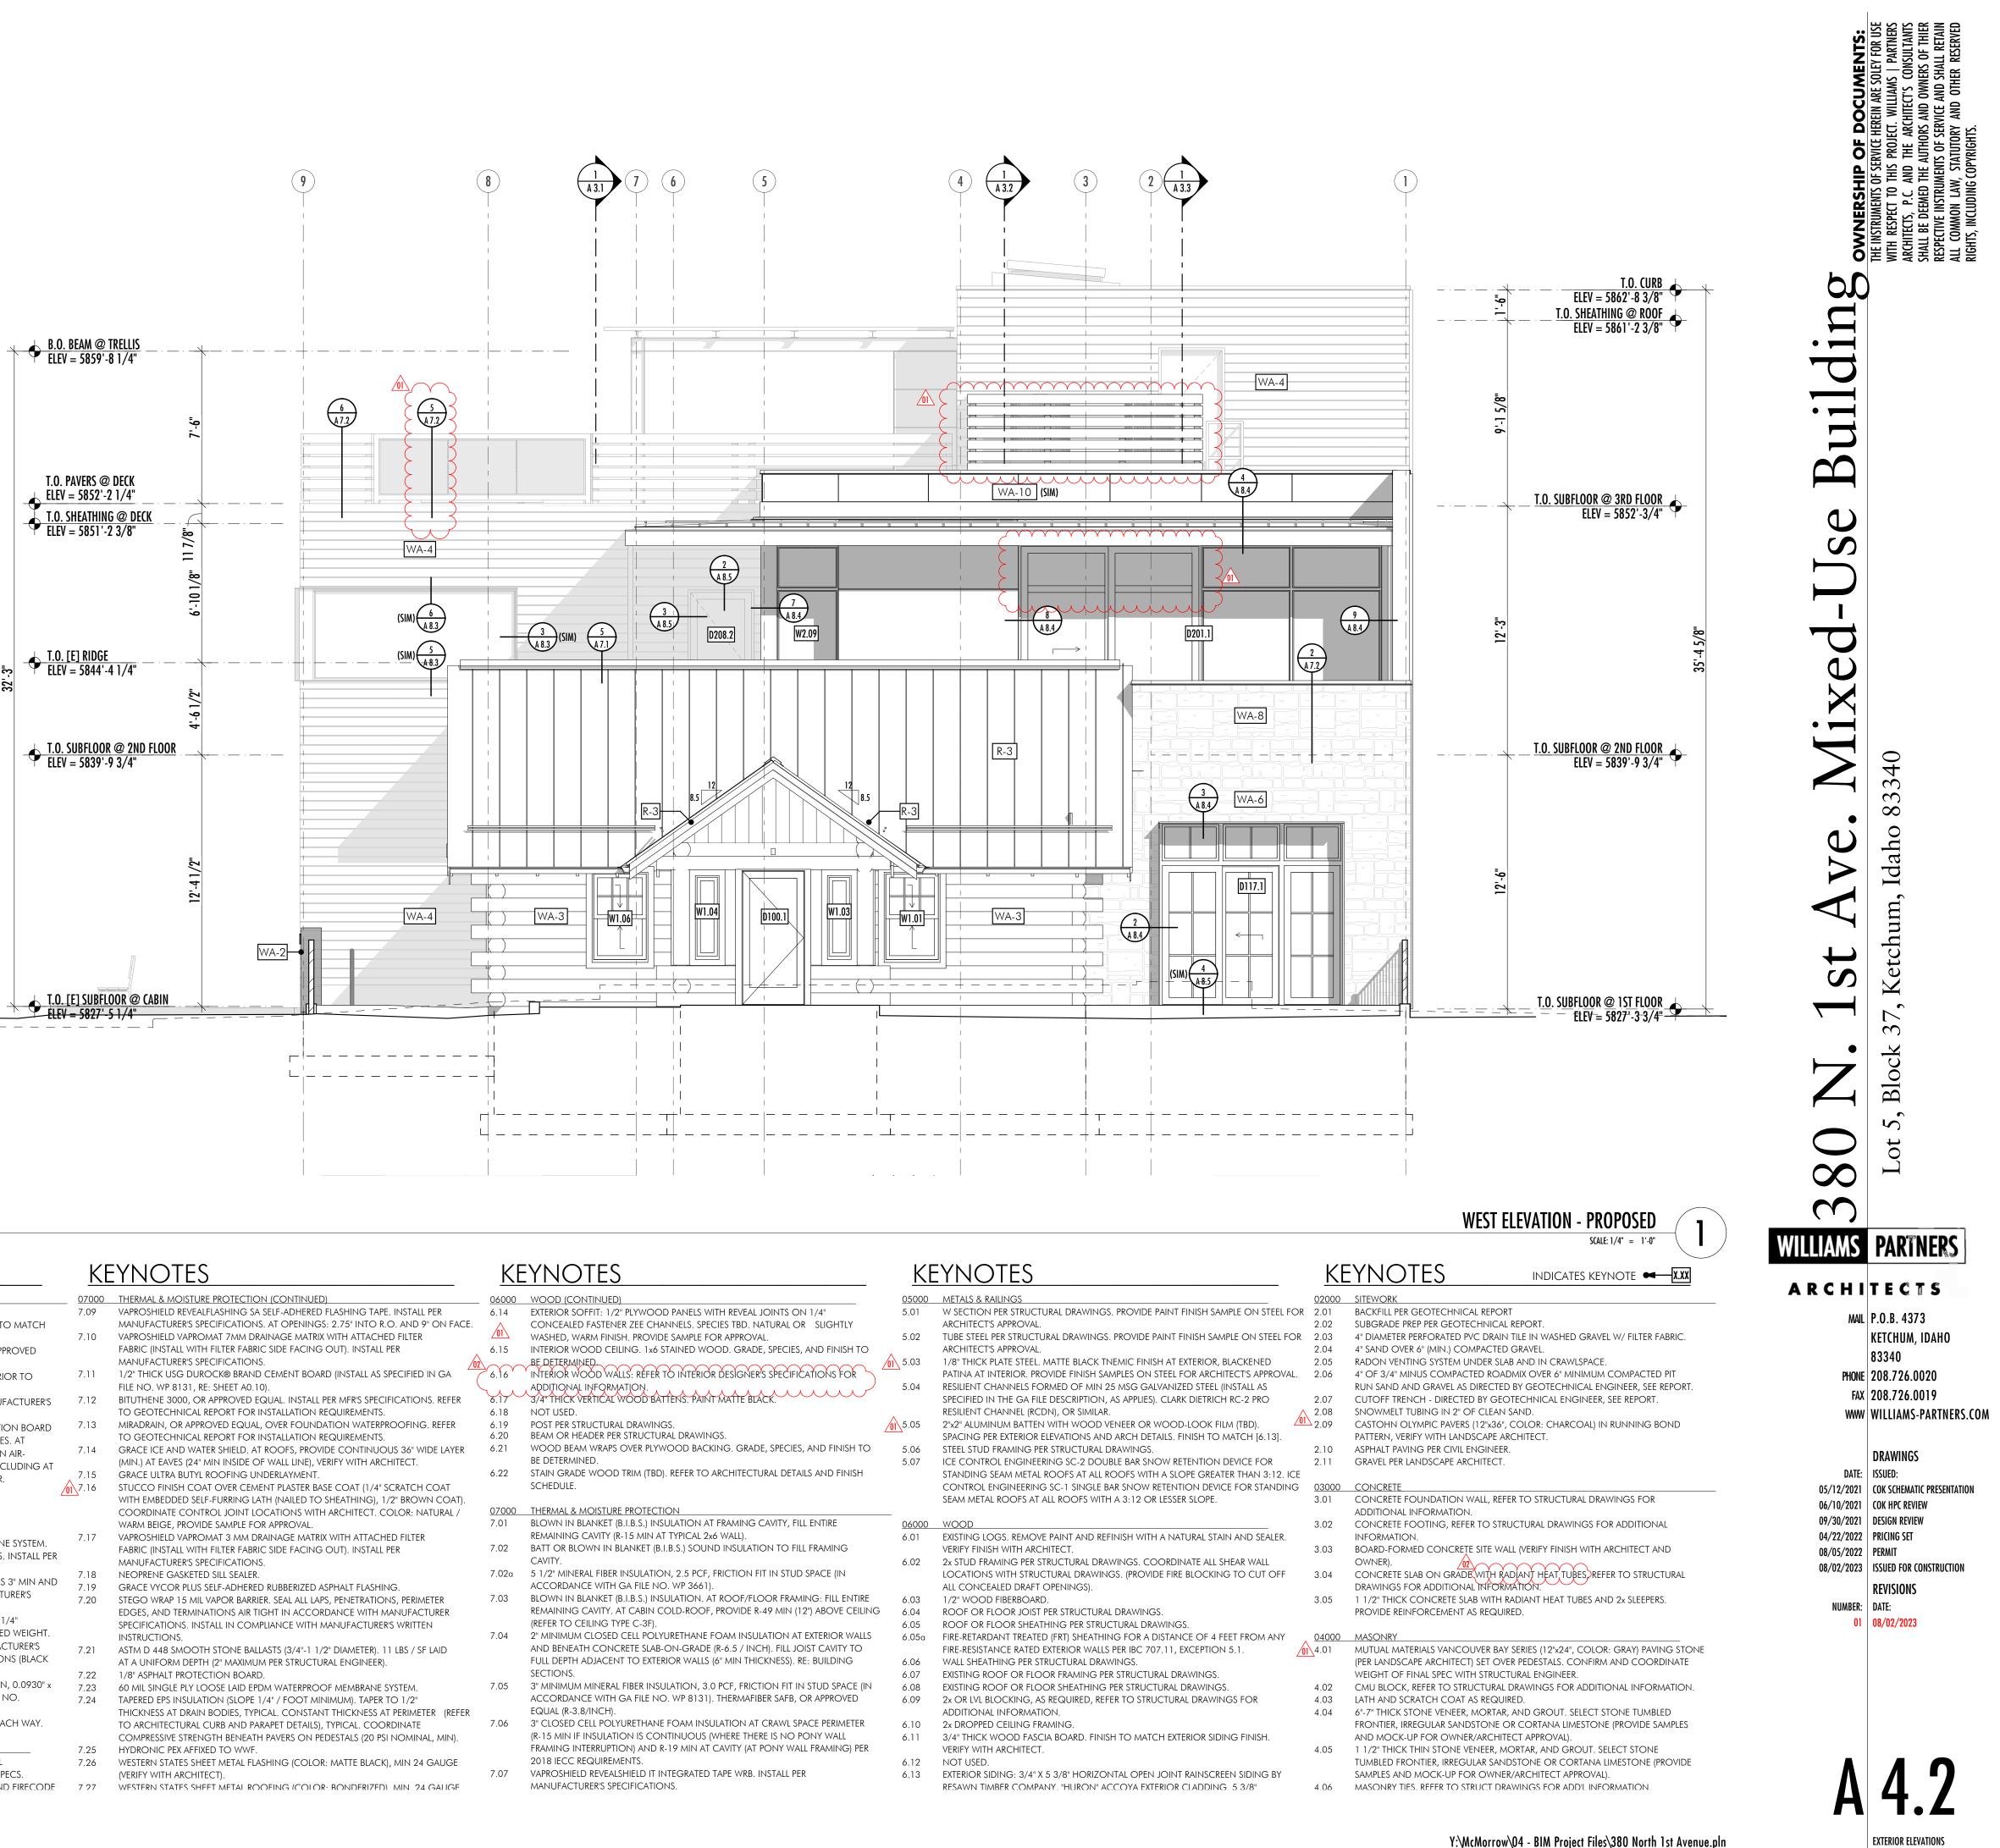

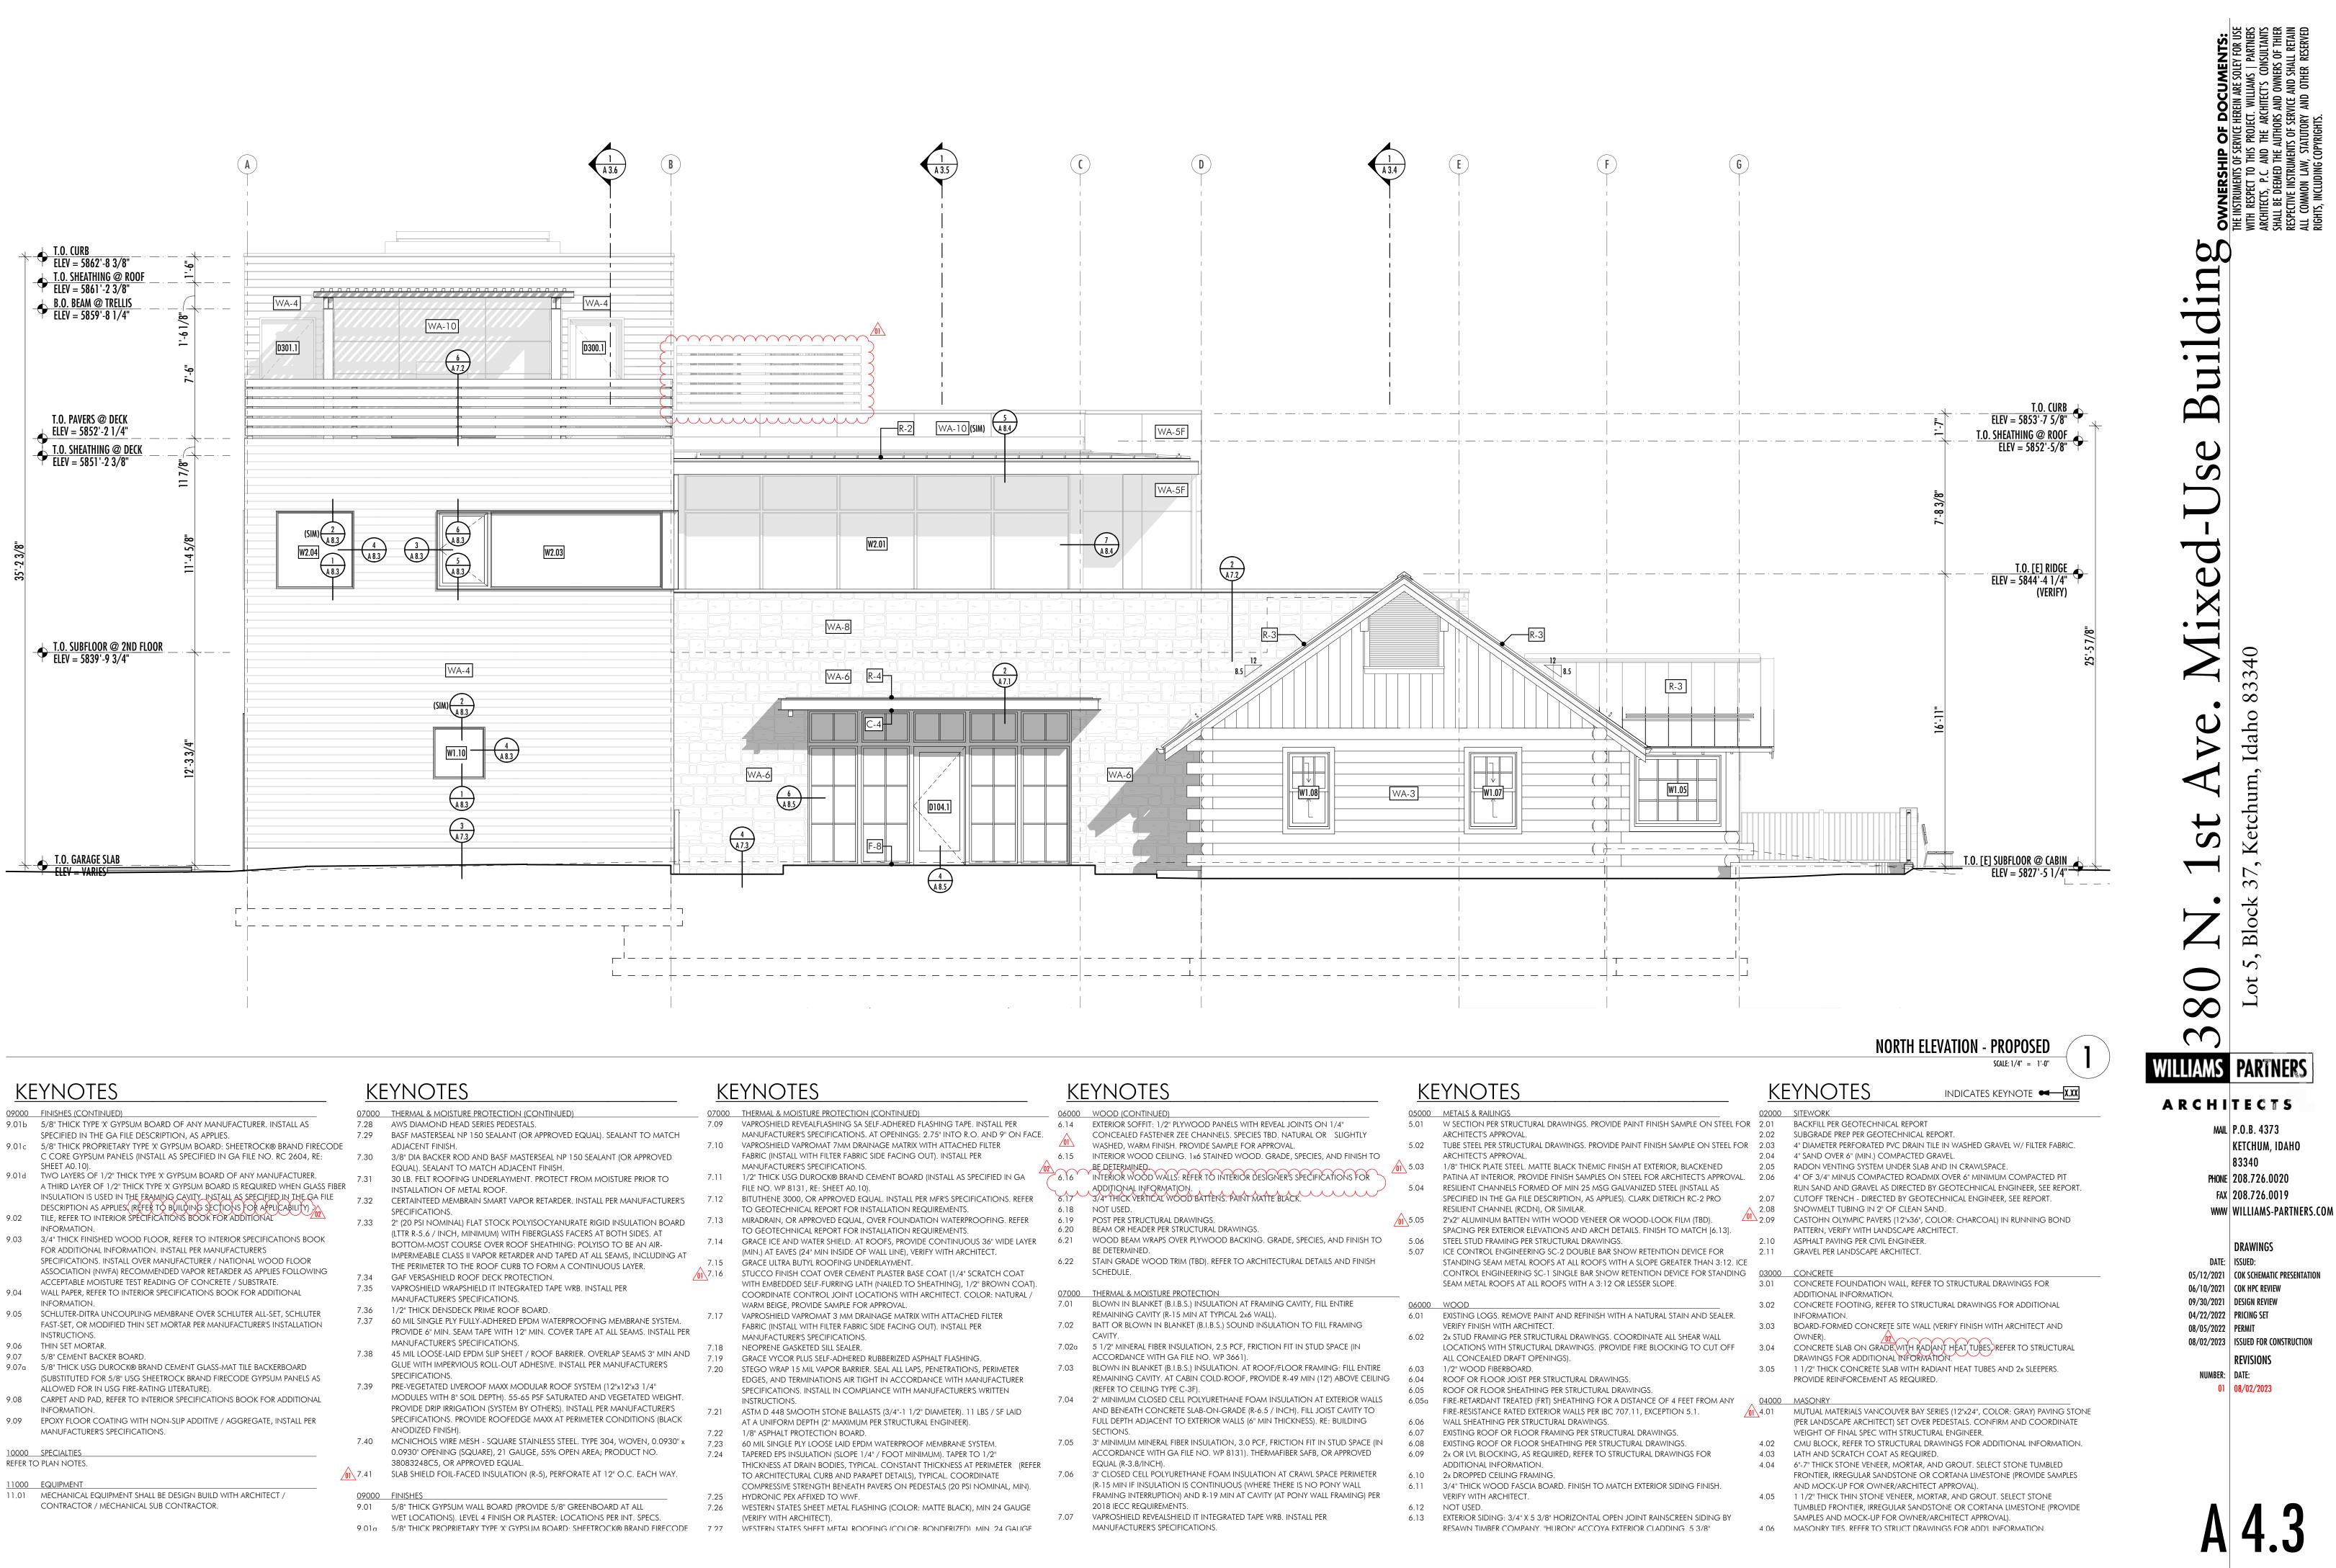

09000 FINISHES (CONTINUED) 9.01b 5/8" THICK TYPE 'X' GYPSUM BOARD OF ANY MANUFACTURER. INSTALL AS 9.01d TWO LAYERS OF 1/2" THICK TYPE 'X' GYPSUM BOARD OF ANY MANUFACTURER. 9.02

9.03


- 9.04
- 9.05
- 9.06
- 9.07a 5/8" THICK USG DUROCK® BRAND CEMENT GLASS-MAT TILE BACKERBOARD
- 9.09 EPOXY FLOOR COATING WITH NON-SLIP ADDITIVE / AGGREGATE, INSTALL PER

REFER TO PLAN NOTES.

11.01 MECHANICAL EQUIPMENT SHALL BE DESIGN BUILD WITH ARCHITECT /

07000	THERMAL & MOISTURE PROTECTION (CONTINUED)	0700
7.28	AWS DIAMOND HEAD SERIES PEDESTALS.	7.09
7.29	BASF MASTERSEAL NP 150 SEALANT (OR APPROVED EQUAL). SEALANT TO MATCH ADJACENT FINISH.	7.10
7.30	3/8" DIA BACKER ROD AND BASF MASTERSEAL NP 150 SEALANT (OR APPROVED EQUAL). SEALANT TO MATCH ADJACENT FINISH.	
7.31	30 LB. FELT ROOFING UNDERLAYMENT. PROTECT FROM MOISTURE PRIOR TO INSTALLATION OF METAL ROOF.	7.11
7.32	CERTAINTEED MEMBRAIN SMART VAPOR RETARDER. INSTALL PER MANUFACTURER'S SPECIFICATIONS.	7.12
7.33	2" (20 PSI NOMINAL) FLAT STOCK POLYISOCYANURATE RIGID INSULATION BOARD (LTTR R-5.6 / INCH, MINIMUM) WITH FIBERGLASS FACERS AT BOTH SIDES. AT	7.13
	BOTTOM-MOST COURSE OVER ROOF SHEATHING: POLYISO TO BE AN AIR- IMPERMEABLE CLASS II VAPOR RETARDER AND TAPED AT ALL SEAMS, INCLUDING AT	7.14
7.34	THE PERIMETER TO THE ROOF CURB TO FORM A CONTINUOUS LAYER. GAF VERSASHIELD ROOF DECK PROTECTION.	7.15
7.35	VAPROSHIELD WRAPSHIELD IT INTEGRATED TAPE WRB. INSTALL PER	<u></u>
7.00	MANUFACTURER'S SPECIFICATIONS.	
7.36	1/2" THICK DENSDECK PRIME ROOF BOARD.	
7.37	60 MIL SINGLE PLY FULLY-ADHERED EPDM WATERPROOFING MEMBRANE SYSTEM. PROVIDE 6" MIN. SEAM TAPE WITH 12" MIN. COVER TAPE AT ALL SEAMS. INSTALL PER	7.17
	MANUFACTURER'S SPECIFICATIONS.	7.18
7.38	45 MIL LOOSE-LAID EPDM SLIP SHEET / ROOF BARRIER. OVERLAP SEAMS 3" MIN AND GLUE WITH IMPERVIOUS ROLL-OUT ADHESIVE. INSTALL PER MANUFACTURER'S SPECIFICATIONS.	7.19 7.20
7.39	PRE-VEGETATED LIVEROOF MAXX MODULAR ROOF SYSTEM (12"x12"x3 1/4" MODULES WITH 8" SOIL DEPTH). 55-65 PSF SATURATED AND VEGETATED WEIGHT.	
	PROVIDE DRIP IRRIGATION (SYSTEM BY OTHERS). INSTALL PER MANUFACTURER'S SPECIFICATIONS. PROVIDE ROOFEDGE MAXX AT PERIMETER CONDITIONS (BLACK	7.21
	anodized finish).	7.22
7.40	MCNICHOLS WIRE MESH - SQUARE STAINLESS STEEL. TYPE 304, WOVEN, 0.0930" x	7.23
	0.0930" OPENING (SQUARE), 21 GAUGE, 55% OPEN AREA; PRODUCT NO. 38083248C5, OR APPROVED EQUAL.	7.24
7.41	SLAB SHIELD FOIL-FACED INSULATION (R-5), PERFORATE AT 12" O.C. EACH WAY.	
09000	FINISHES	7.25
9.01	5/8" THICK GYPSUM WALL BOARD (PROVIDE 5/8" GREENBOARD AT ALL WET LOCATIONS). LEVEL 4 FINISH OR PLASTER: LOCATIONS PER INT. SPECS.	7.26

EXTERIOR ELEVATIONS

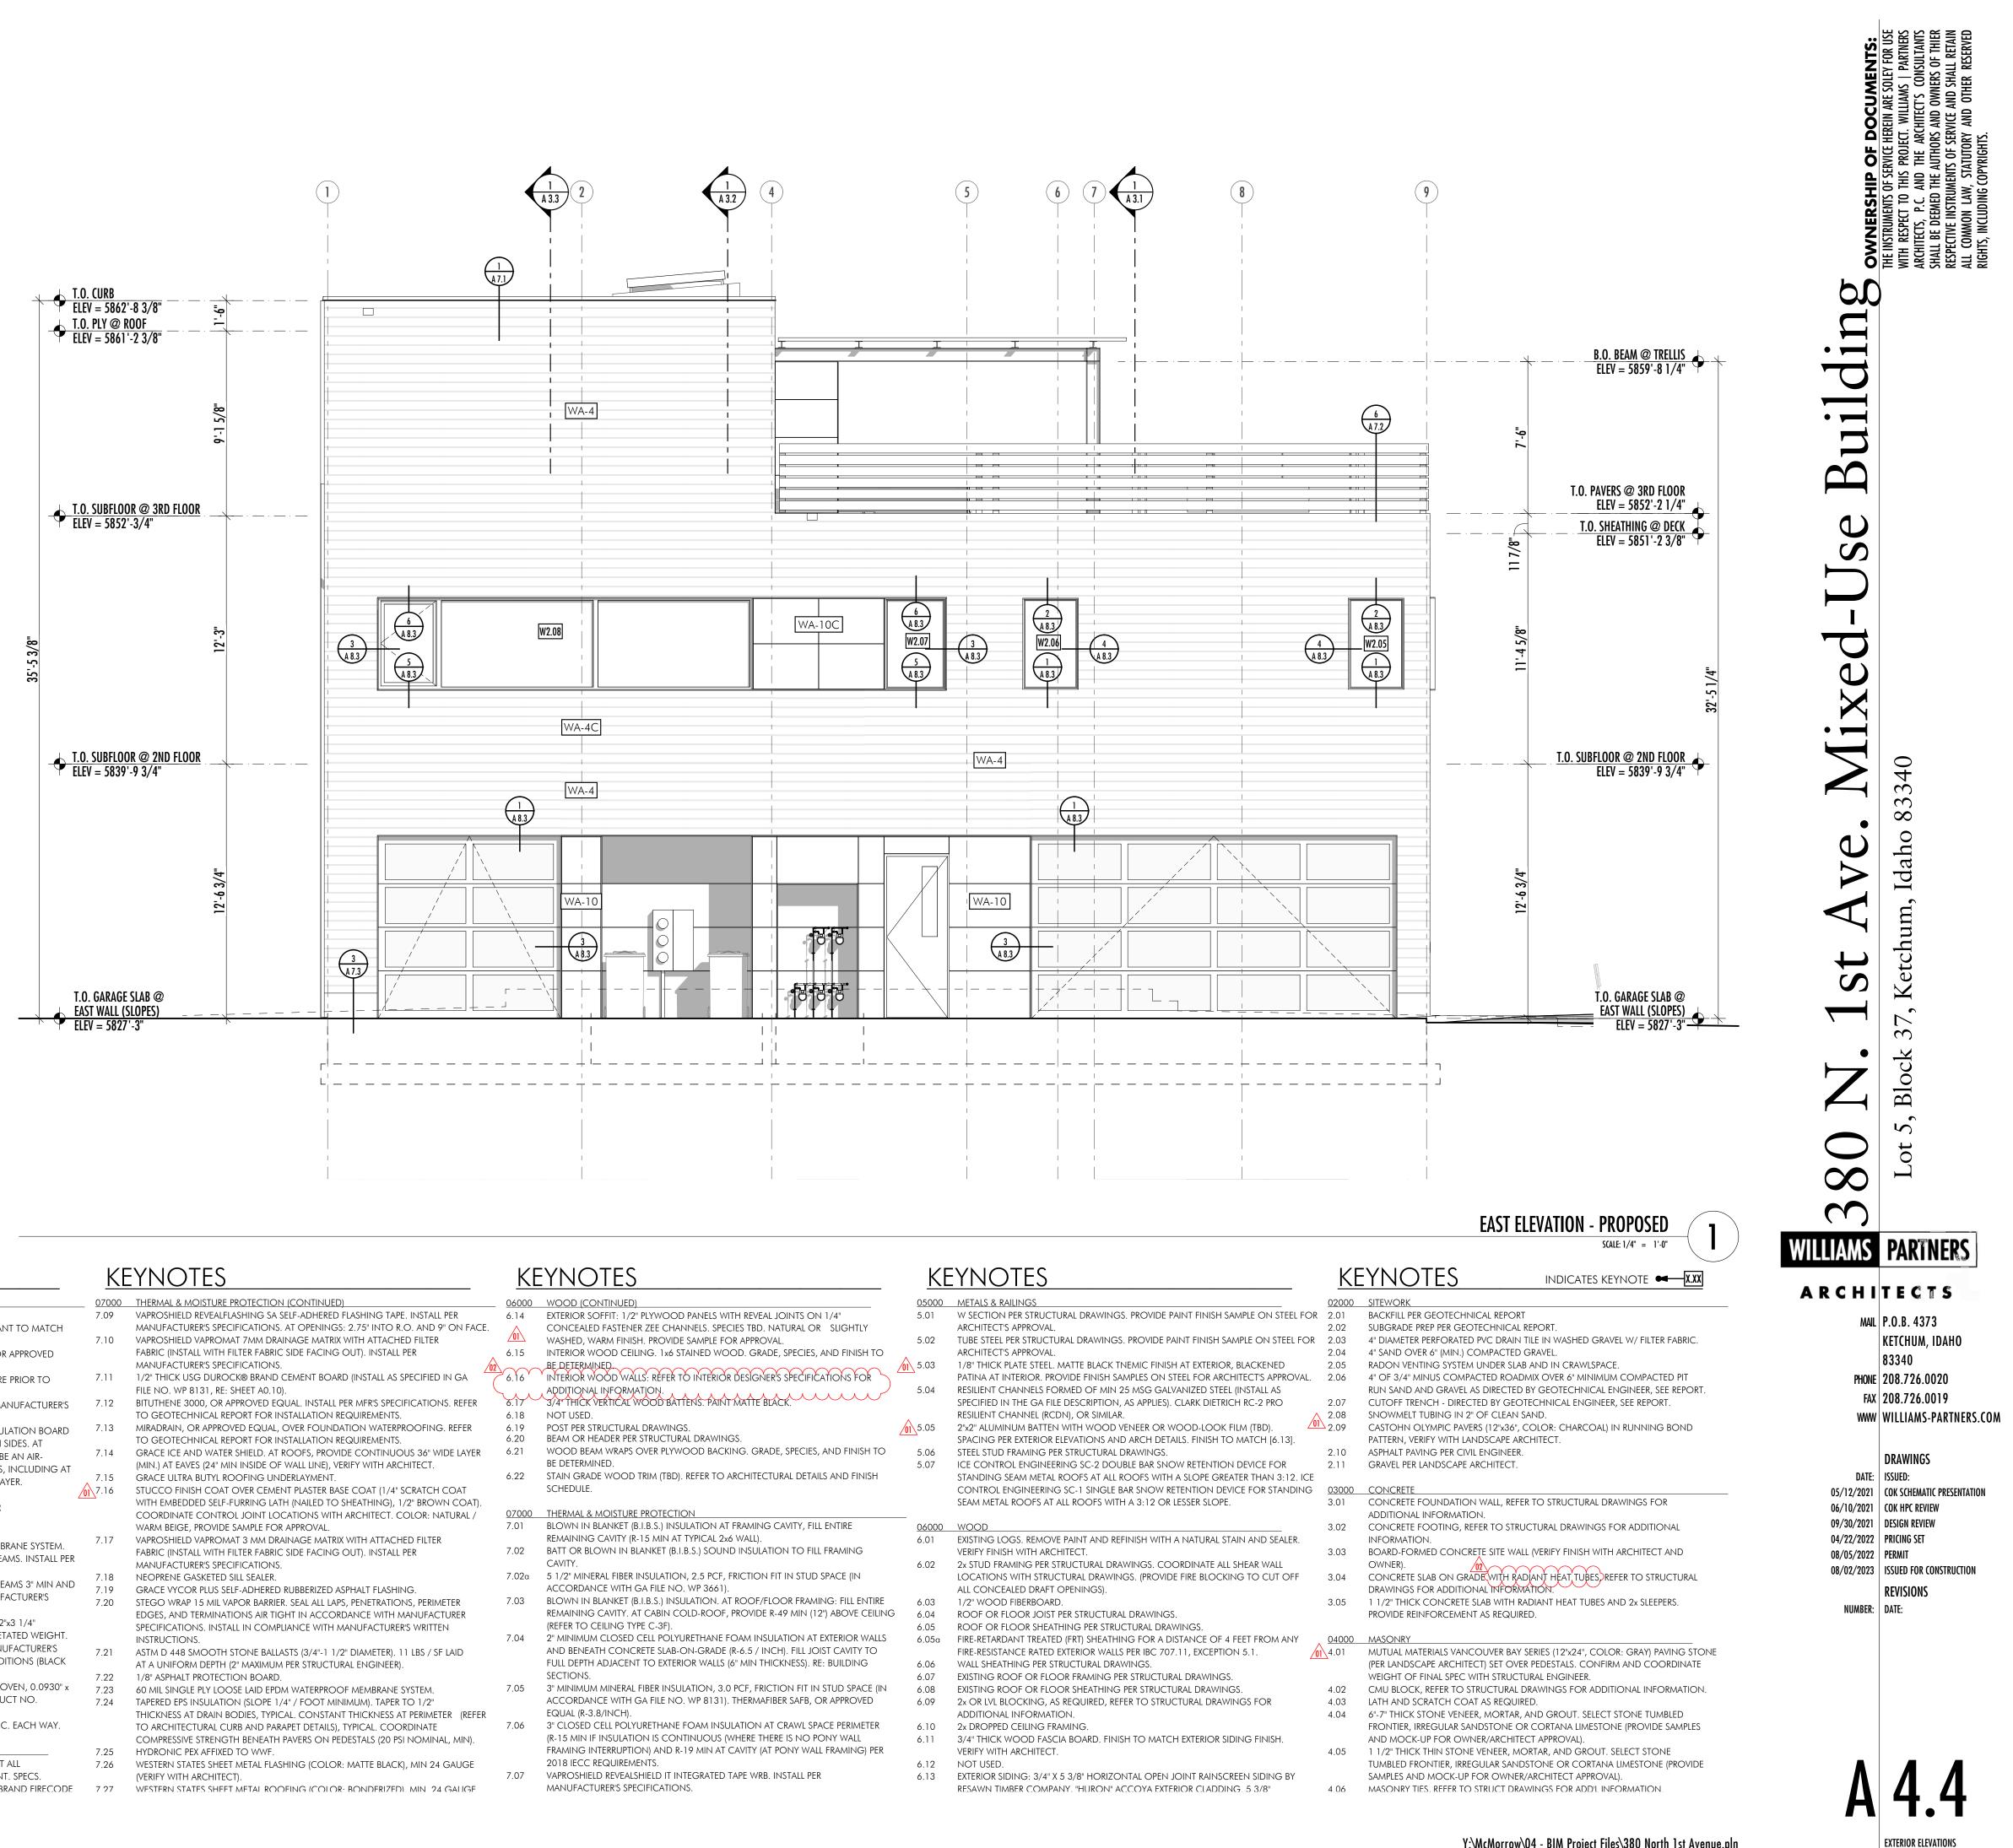


KEYNOTES

09000	FINISHES (CONTINUED)
9.01b	5/8" THICK TYPE 'X' GYPSUM BOARD OF ANY MANUFACTURER. INSTALL AS
	SPECIFIED IN THE GA FILE DESCRIPTION, AS APPLIES.
9.01c	5/8" THICK PROPRIETARY TYPE 'X' GYPSUM BOARD: SHEETROCK® BRAND FIRECODE
	C CORE GYPSUM PANELS (INSTALL AS SPECIFIED IN GA FILE NO. RC 2604, RE:
	SHEET A0.10).
9.01d	TWO LAYERS OF 1/2" THICK TYPE 'X' GYPSUM BOARD OF ANY MANUFACTURER.
	A THIRD LAYER OF 1/2" THICK TYPE 'X' GYPSUM BOARD IS REQUIRED WHEN GLASS FIBER
	INSULATION IS USED IN THE FRAMING CAVITY INSTALL AS SPECIFIED IN THE GA FILE
	DESCRIPTION AS APPLIES (RÉFER TO BUILDING SECTIONS FOR APPLICABILITY)
9.02	TILE, REFER TO INTERIOR SPECIFICATIONS BOOK FOR ADDITIONAL
9.03	3/4" THICK FINISHED WOOD FLOOR, REFER TO INTERIOR SPECIFICATIONS BOOK
	FOR ADDITIONAL INFORMATION. INSTALL PER MANUFACTURER'S
	SPECIFICATIONS. INSTALL OVER MANUFACTURER / NATIONAL WOOD FLOOR
	ASSOCIATION (NWFA) RECOMMENDED VAPOR RETARDER AS APPLIES FOLLOWING
0.04	ACCEPTABLE MOISTURE TEST READING OF CONCRETE / SUBSTRATE.
9.04	WALL PAPER, REFER TO INTERIOR SPECIFICATIONS BOOK FOR ADDITIONAL
9.05	INFORMATION. SCHLUTER-DITRA UNCOUPLING MEMBRANE OVER SCHLUTER ALL-SET, SCHLUTER
9.05	FAST-SET, OR MODIFIED THIN SET MORTAR PER MANUFACTURER'S INSTALLATION
	INSTRUCTIONS.
9.06	THIN SET MORTAR.
9.07	5/8" CEMENT BACKER BOARD.
9.07a	5/8" THICK USG DUROCK® BRAND CEMENT GLASS-MAT TILE BACKERBOARD
7.07u	(SUBSTITUTED FOR 5/8" USG SHEETROCK BRAND FIRECODE GYPSUM PANELS AS
	ALLOWED FOR IN USG FIRE-RATING LITERATURE).
9.08	CARPET AND PAD, REFER TO INTERIOR SPECIFICATIONS BOOK FOR ADDITIONAL
7.00	INFORMATION.
9.09	EPOXY FLOOR COATING WITH NON-SLIP ADDITIVE / AGGREGATE, INSTALL PER
	MANUFACTURER'S SPECIFICATIONS.
	SPECIALTIES
REFER TO) PLAN NOTES.
11000	

11000 EQUIPMENT 11.01 MECHANICAL EQUIPMENT SHALL BE DESIGN BUILD WITH ARCHITECT / CONTRACTOR / MECHANICAL SUB CONTRACTOR.

KEYNOTES

07000	THERMAL & MOISTURE PROTECTION (CONTINUED)	07000
7.28	AWS DIAMOND HEAD SERIES PEDESTALS.	7.09
7.29	BASF MASTERSEAL NP 150 SEALANT (OR APPROVED EQUAL). SEALANT TO MATCH	
	ADJACENT FINISH.	7.10
7.30	3/8" DIA BACKER ROD AND BASF MASTERSEAL NP 150 SEALANT (OR APPROVED	
	EQUAL). SEALANT TO MATCH ADJACENT FINISH.	
7.31	30 LB. FELT ROOFING UNDERLAYMENT. PROTECT FROM MOISTURE PRIOR TO	7.11
	INSTALLATION OF METAL ROOF.	
7.32	CERTAINTEED MEMBRAIN SMART VAPOR RETARDER. INSTALL PER MANUFACTURER'S	7.12
	SPECIFICATIONS.	
7.33	2" (20 PSI NOMINAL) FLAT STOCK POLYISOCYANURATE RIGID INSULATION BOARD	7.13
	(LTTR R-5.6 / INCH, MINIMUM) WITH FIBERGLASS FACERS AT BOTH SIDES. AT	
	BOTTOM-MOST COURSE OVER ROOF SHEATHING: POLYISO TO BE AN AIR-	7.14
	IMPERMEABLE CLASS II VAPOR RETARDER AND TAPED AT ALL SEAMS, INCLUDING AT	
	THE PERIMETER TO THE ROOF CURB TO FORM A CONTINUOUS LAYER.	7.15
7.34	GAF VERSASHIELD ROOF DECK PROTECTION.	7.16
7.35	VAPROSHIELD WRAPSHIELD IT INTEGRATED TAPE WRB. INSTALL PER	
	MANUFACTURER'S SPECIFICATIONS.	
7.36	1/2" THICK DENSDECK PRIME ROOF BOARD.	7.17
7.37	60 MIL SINGLE PLY FULLY-ADHERED EPDM WATERPROOFING MEMBRANE SYSTEM.	7.17
	PROVIDE 6" MIN. SEAM TAPE WITH 12" MIN. COVER TAPE AT ALL SEAMS. INSTALL PER	
	MANUFACTURER'S SPECIFICATIONS.	7.18
7.38	45 MIL LOOSE-LAID EPDM SLIP SHEET / ROOF BARRIER. OVERLAP SEAMS 3" MIN AND	7.19
	GLUE WITH IMPERVIOUS ROLL-OUT ADHESIVE. INSTALL PER MANUFACTURER'S	7.20
	SPECIFICATIONS.	7.20
7.39	PRE-VEGETATED LIVEROOF MAXX MODULAR ROOF SYSTEM (12"x12"x3 1/4"	
	MODULES WITH 8" SOIL DEPTH). 55-65 PSF SATURATED AND VEGETATED WEIGHT.	
	PROVIDE DRIP IRRIGATION (SYSTEM BY OTHERS). INSTALL PER MANUFACTURER'S	7.21
	SPECIFICATIONS. PROVIDE ROOFEDGE MAXX AT PERIMETER CONDITIONS (BLACK	
	anodized finish).	7.22
7.40	MCNICHOLS WIRE MESH - SQUARE STAINLESS STEEL. TYPE 304, WOVEN, 0.0930" x	7.23
	0.0930" OPENING (SQUARE), 21 GAUGE, 55% OPEN AREA; PRODUCT NO.	7.24
	38083248C5, OR APPROVED EQUAL.	
7.41	SLAB SHIELD FOIL-FACED INSULATION (R-5), PERFORATE AT 12" O.C. EACH WAY.	
09000	FINISHES	7.25
9.01	5/8" THICK GYPSUM WALL BOARD (PROVIDE 5/8" GREENBOARD AT ALL	7.26
	WET LOCATIONS). LEVEL 4 FINISH OR PLASTER: LOCATIONS PER INT. SPECS.	
9.01a	5/8" THICK PROPRIETARY TYPE 'X' GYPSUM BOARD: SHEETROCK® BRAND FIRECODE	7 97

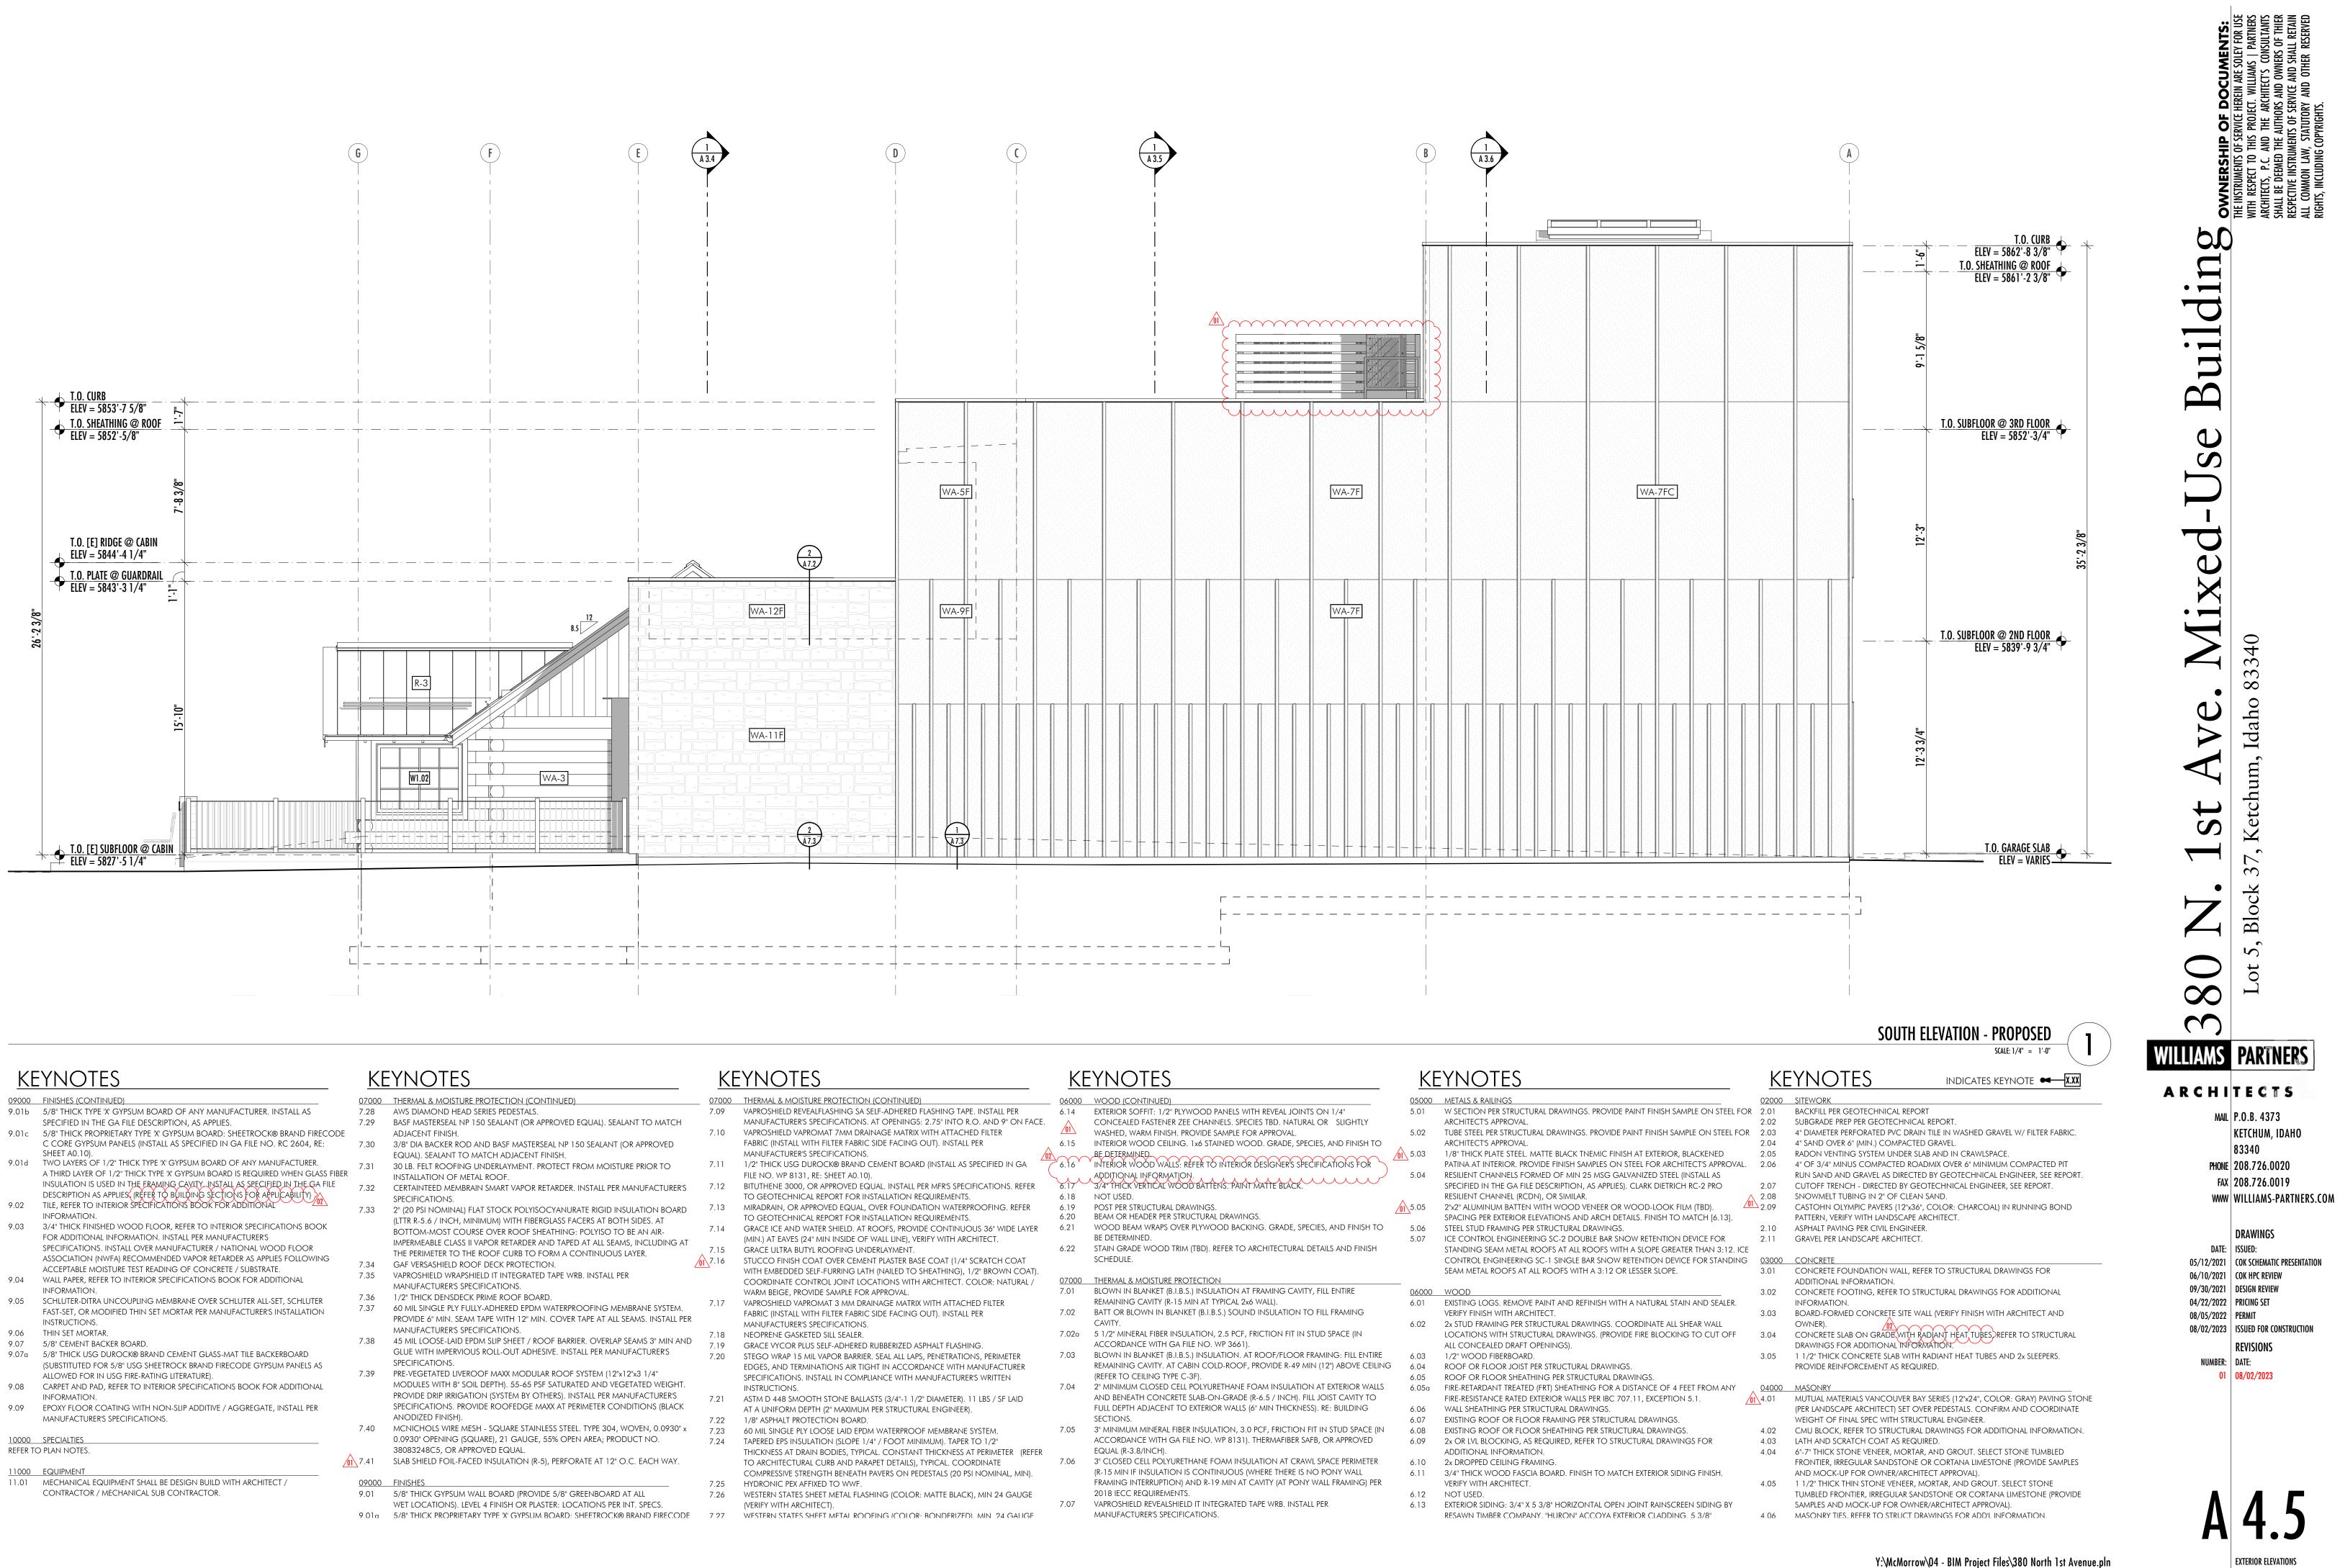


FINISHES (CONTINUED)
5/8" THICK TYPE 'X' GYPSUM BOARD OF ANY MANUFACTURER. INSTALL AS
SPECIFIED IN THE GA FILE DESCRIPTION, AS APPLIES.
5/8" THICK PROPRIETARY TYPE 'X' GYPSUM BOARD: SHEETROCK® BRAND FIRECODE C CORE GYPSUM PANELS (INSTALL AS SPECIFIED IN GA FILE NO. RC 2604, RE: SHEET A0.10).
TWO LAYERS OF 1/2" THICK TYPE 'X' GYPSUM BOARD OF ANY MANUFACTURER.
A THIRD LAYER OF 1/2" THICK TYPE 'X' GYPSUM BOARD IS REQUIRED WHEN GLASS FIBER
INSULATION IS USED IN THE FRAMING CAVITY INSTALL AS SPECIFIED IN THE GA FILE
DESCRIPTION AS APPLIES (RĚFER TỔ BŲILŲING SĚCTIONS FOR APPLICABILITY)
TILE, REFER TO INTERIOR SPECIFICATIONS BOOK FOR ADDITIONAL
INFORMATION.
3/4" THICK FINISHED WOOD FLOOR, REFER TO INTERIOR SPECIFICATIONS BOOK
FOR ADDITIONAL INFORMATION. INSTALL PER MANUFACTURER'S
SPECIFICATIONS. INSTALL OVER MANUFACTURER / NATIONAL WOOD FLOOR
ASSOCIATION (NWFA) RECOMMENDED VAPOR RETARDER AS APPLIES FOLLOWING
ACCEPTABLE MOISTURE TEST READING OF CONCRETE / SUBSTRATE.
WALL PAPER, REFER TO INTERIOR SPECIFICATIONS BOOK FOR ADDITIONAL
INFORMATION.
SCHLUTER-DITRA UNCOUPLING MEMBRANE OVER SCHLUTER ALL-SET, SCHLUTER
FAST-SET, OR MODIFIED THIN SET MORTAR PER MANUFACTURER'S INSTALLATION

9.06 9.07 9.07a 5/8" THICK USG DUROCK® BRAND CEMENT GLASS-MAT TILE BACKERBOARD 9.08 CARPET AND PAD, REFER TO INTERIOR SPECIFICATIONS BOOK FOR ADDITIONAL


REFER TO PLAN NOTES.

11.01 MECHANICAL EQUIPMENT SHALL BE DESIGN BUILD WITH ARCHITECT /


7000	THERMAL & MOISTURE PROTECTION (CONTINUED)
7.28	AWS DIAMOND HEAD SERIES PEDESTALS.
.29	BASF MASTERSEAL NP 150 SEALANT (OR APPROVED EQUAL). SEALANT TO MATCH
	ADJACENT FINISH.
7.30	3/8" DIA BACKER ROD AND BASF MASTERSEAL NP 150 SEALANT (OR APPROVED
	EQUAL). SEALANT TO MATCH ADJACENT FINISH.
.31	30 LB. FELT ROOFING UNDERLAYMENT, PROTECT FROM MOISTURE PRIOR TO
	INSTALLATION OF METAL ROOF.
.32	CERTAINTEED MEMBRAIN SMART VAPOR RETARDER. INSTALL PER MANUFACTURER'S
	SPECIFICATIONS.
.33	2" (20 PSI NOMINAL) FLAT STOCK POLYISOCYANURATE RIGID INSULATION BOARD
	(LTTR R-5.6 / INCH, MINIMUM) WITH FIBERGLASS FACERS AT BOTH SIDES. AT
	BOTTOM-MOST COURSE OVER ROOF SHEATHING: POLYISO TO BE AN AIR-
	IMPERMEABLE CLASS II VAPOR RETARDER AND TAPED AT ALL SEAMS, INCLUDING AT
	THE PERIMETER TO THE ROOF CURB TO FORM A CONTINUOUS LAYER.
.34	GAF VERSASHIELD ROOF DECK PROTECTION.
.35	VAPROSHIELD WRAPSHIELD IT INTEGRATED TAPE WRB. INSTALL PER
	MANUFACTURER'S SPECIFICATIONS.
.36	1/2" THICK DENSDECK PRIME ROOF BOARD.
.37	60 MIL SINGLE PLY FULLY-ADHERED EPDM WATERPROOFING MEMBRANE SYSTEM.
	PROVIDE 6" MIN. SEAM TAPE WITH 12" MIN. COVER TAPE AT ALL SEAMS. INSTALL PER
	MANUFACTURER'S SPECIFICATIONS.
.38	45 MIL LOOSE-LAID EPDM SLIP SHEET / ROOF BARRIER. OVERLAP SEAMS 3" MIN AND
	GLUE WITH IMPERVIOUS ROLL-OUT ADHESIVE. INSTALL PER MANUFACTURER'S
	SPECIFICATIONS.
.39	PRE-VEGETATED LIVEROOF MAXX MODULAR ROOF SYSTEM (12"x12"x3 1/4"
	MODULES WITH 8" SOIL DEPTH). 55-65 PSF SATURATED AND VEGETATED WEIGHT.
	PROVIDE DRIP IRRIGATION (SYSTEM BY OTHERS). INSTALL PER MANUFACTURER'S
	SPECIFICATIONS. PROVIDE ROOFEDGE MAXX AT PERIMETER CONDITIONS (BLACK
	anodized finish).
.40	MCNICHOLS WIRE MESH - SQUARE STAINLESS STEEL. TYPE 304, WOVEN, 0.0930" x
	0.0930" OPENING (SQUARE), 21 GAUGE, 55% OPEN AREA; PRODUCT NO.
	38083248C5, OR APPROVED EQUAL.
.41	SLAB SHIELD FOIL-FACED INSULATION (R-5), PERFORATE AT 12" O.C. EACH WAY.
9000	FINISHES
.01	5/8" THICK GYPSUM WALL BOARD (PROVIDE 5/8" GREENBOARD AT ALL
	WET LOCATIONS). LEVEL 4 FINISH OR PLASTER: LOCATIONS PER INT. SPECS.
01a	5/8" THICK PROPRIETARY TYPE 'X' GYPSI IM BOARD' SHEETROCK® BRAND FIRECODE

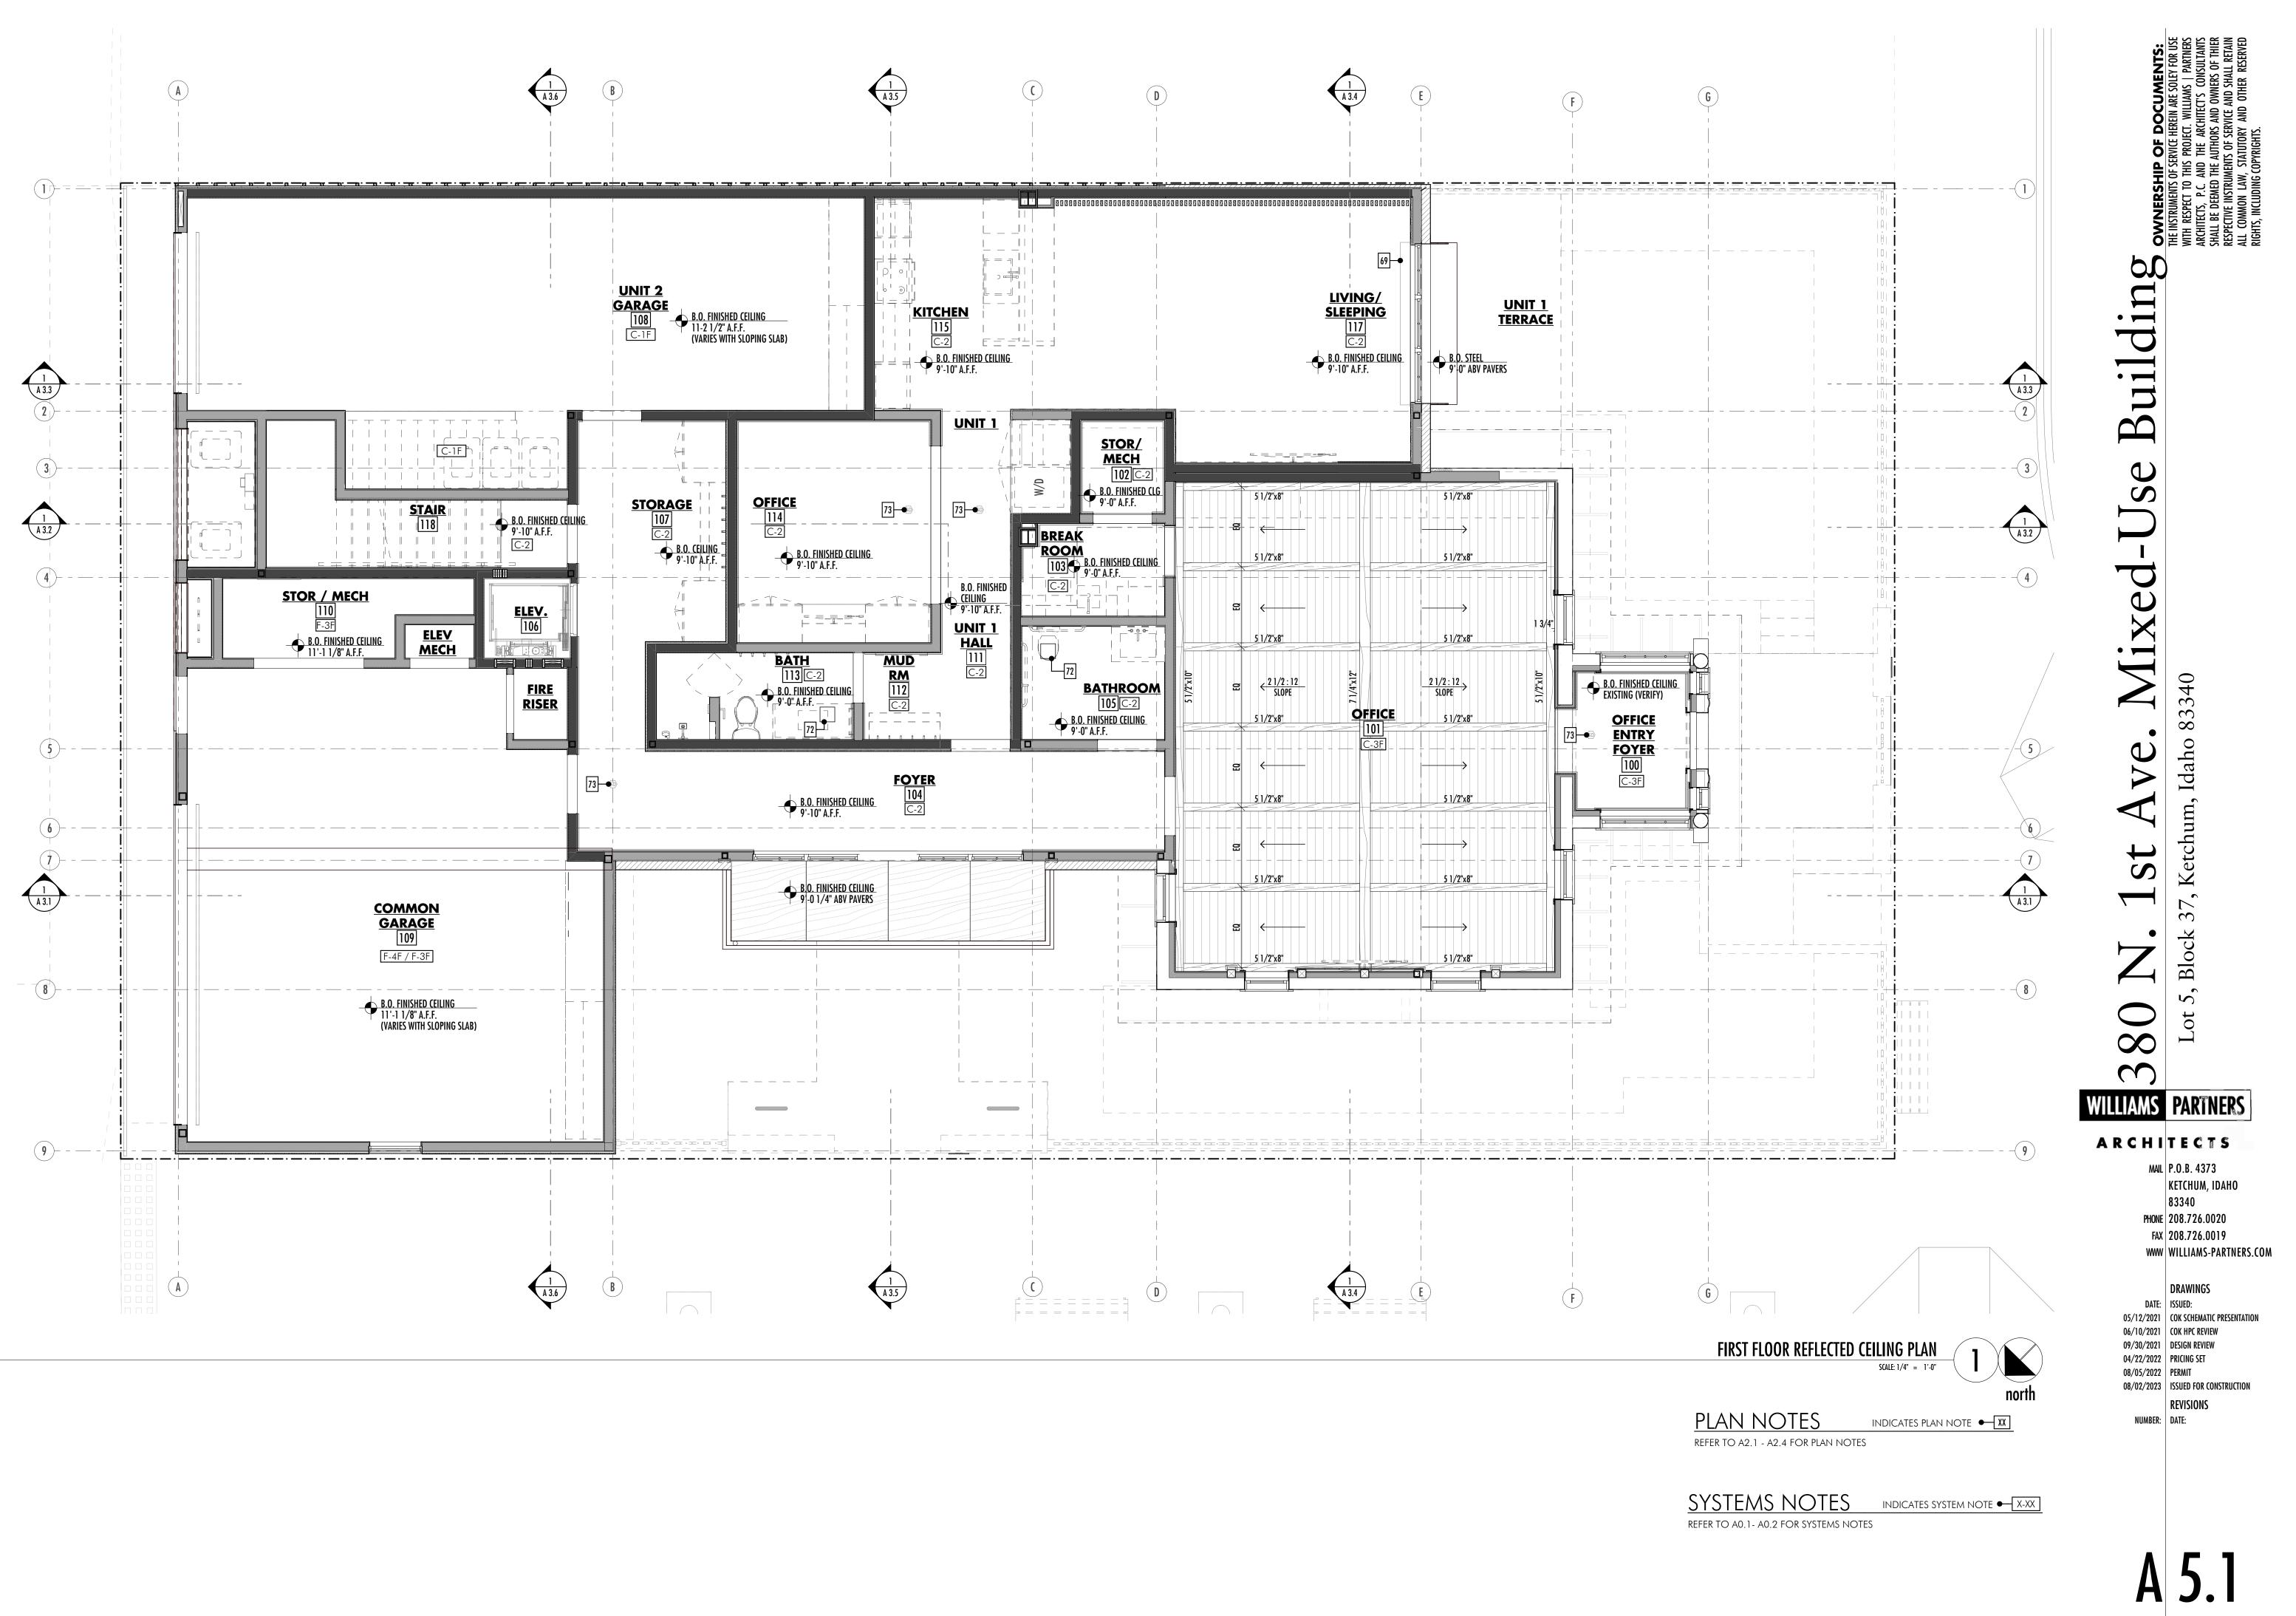


REFLECTED CEILING PLANS

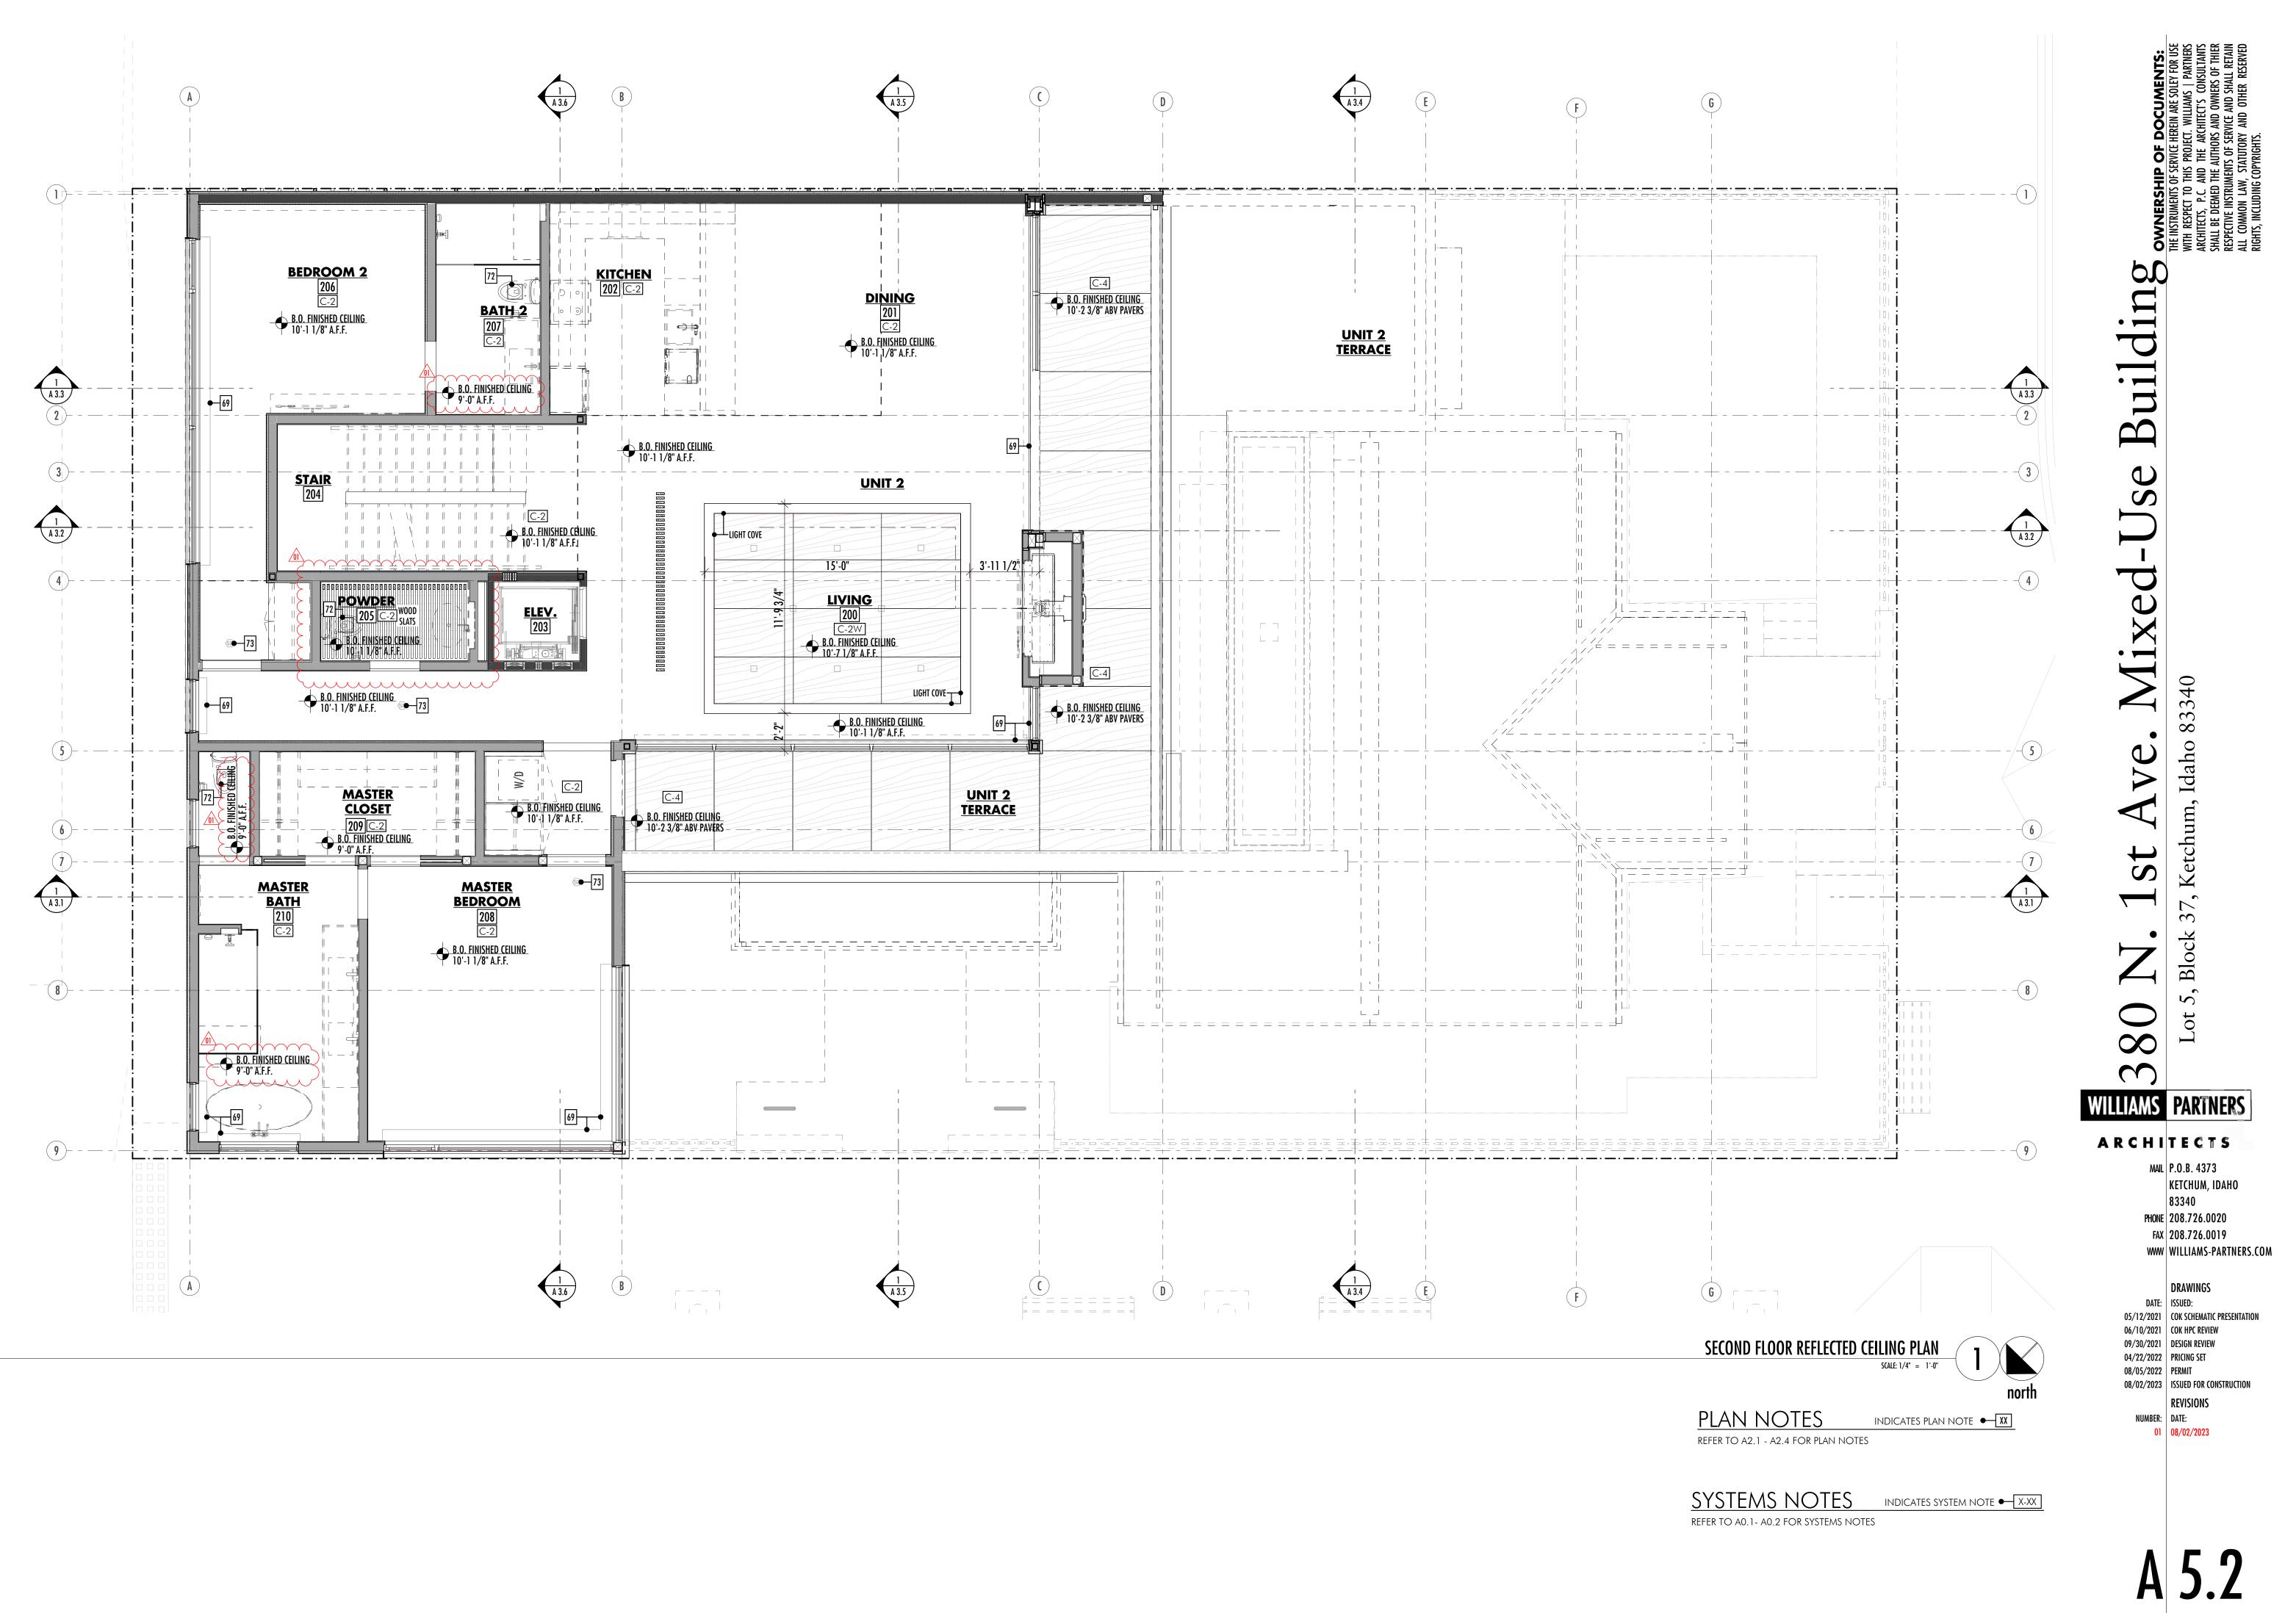


REFLECTED CEILING PLANS

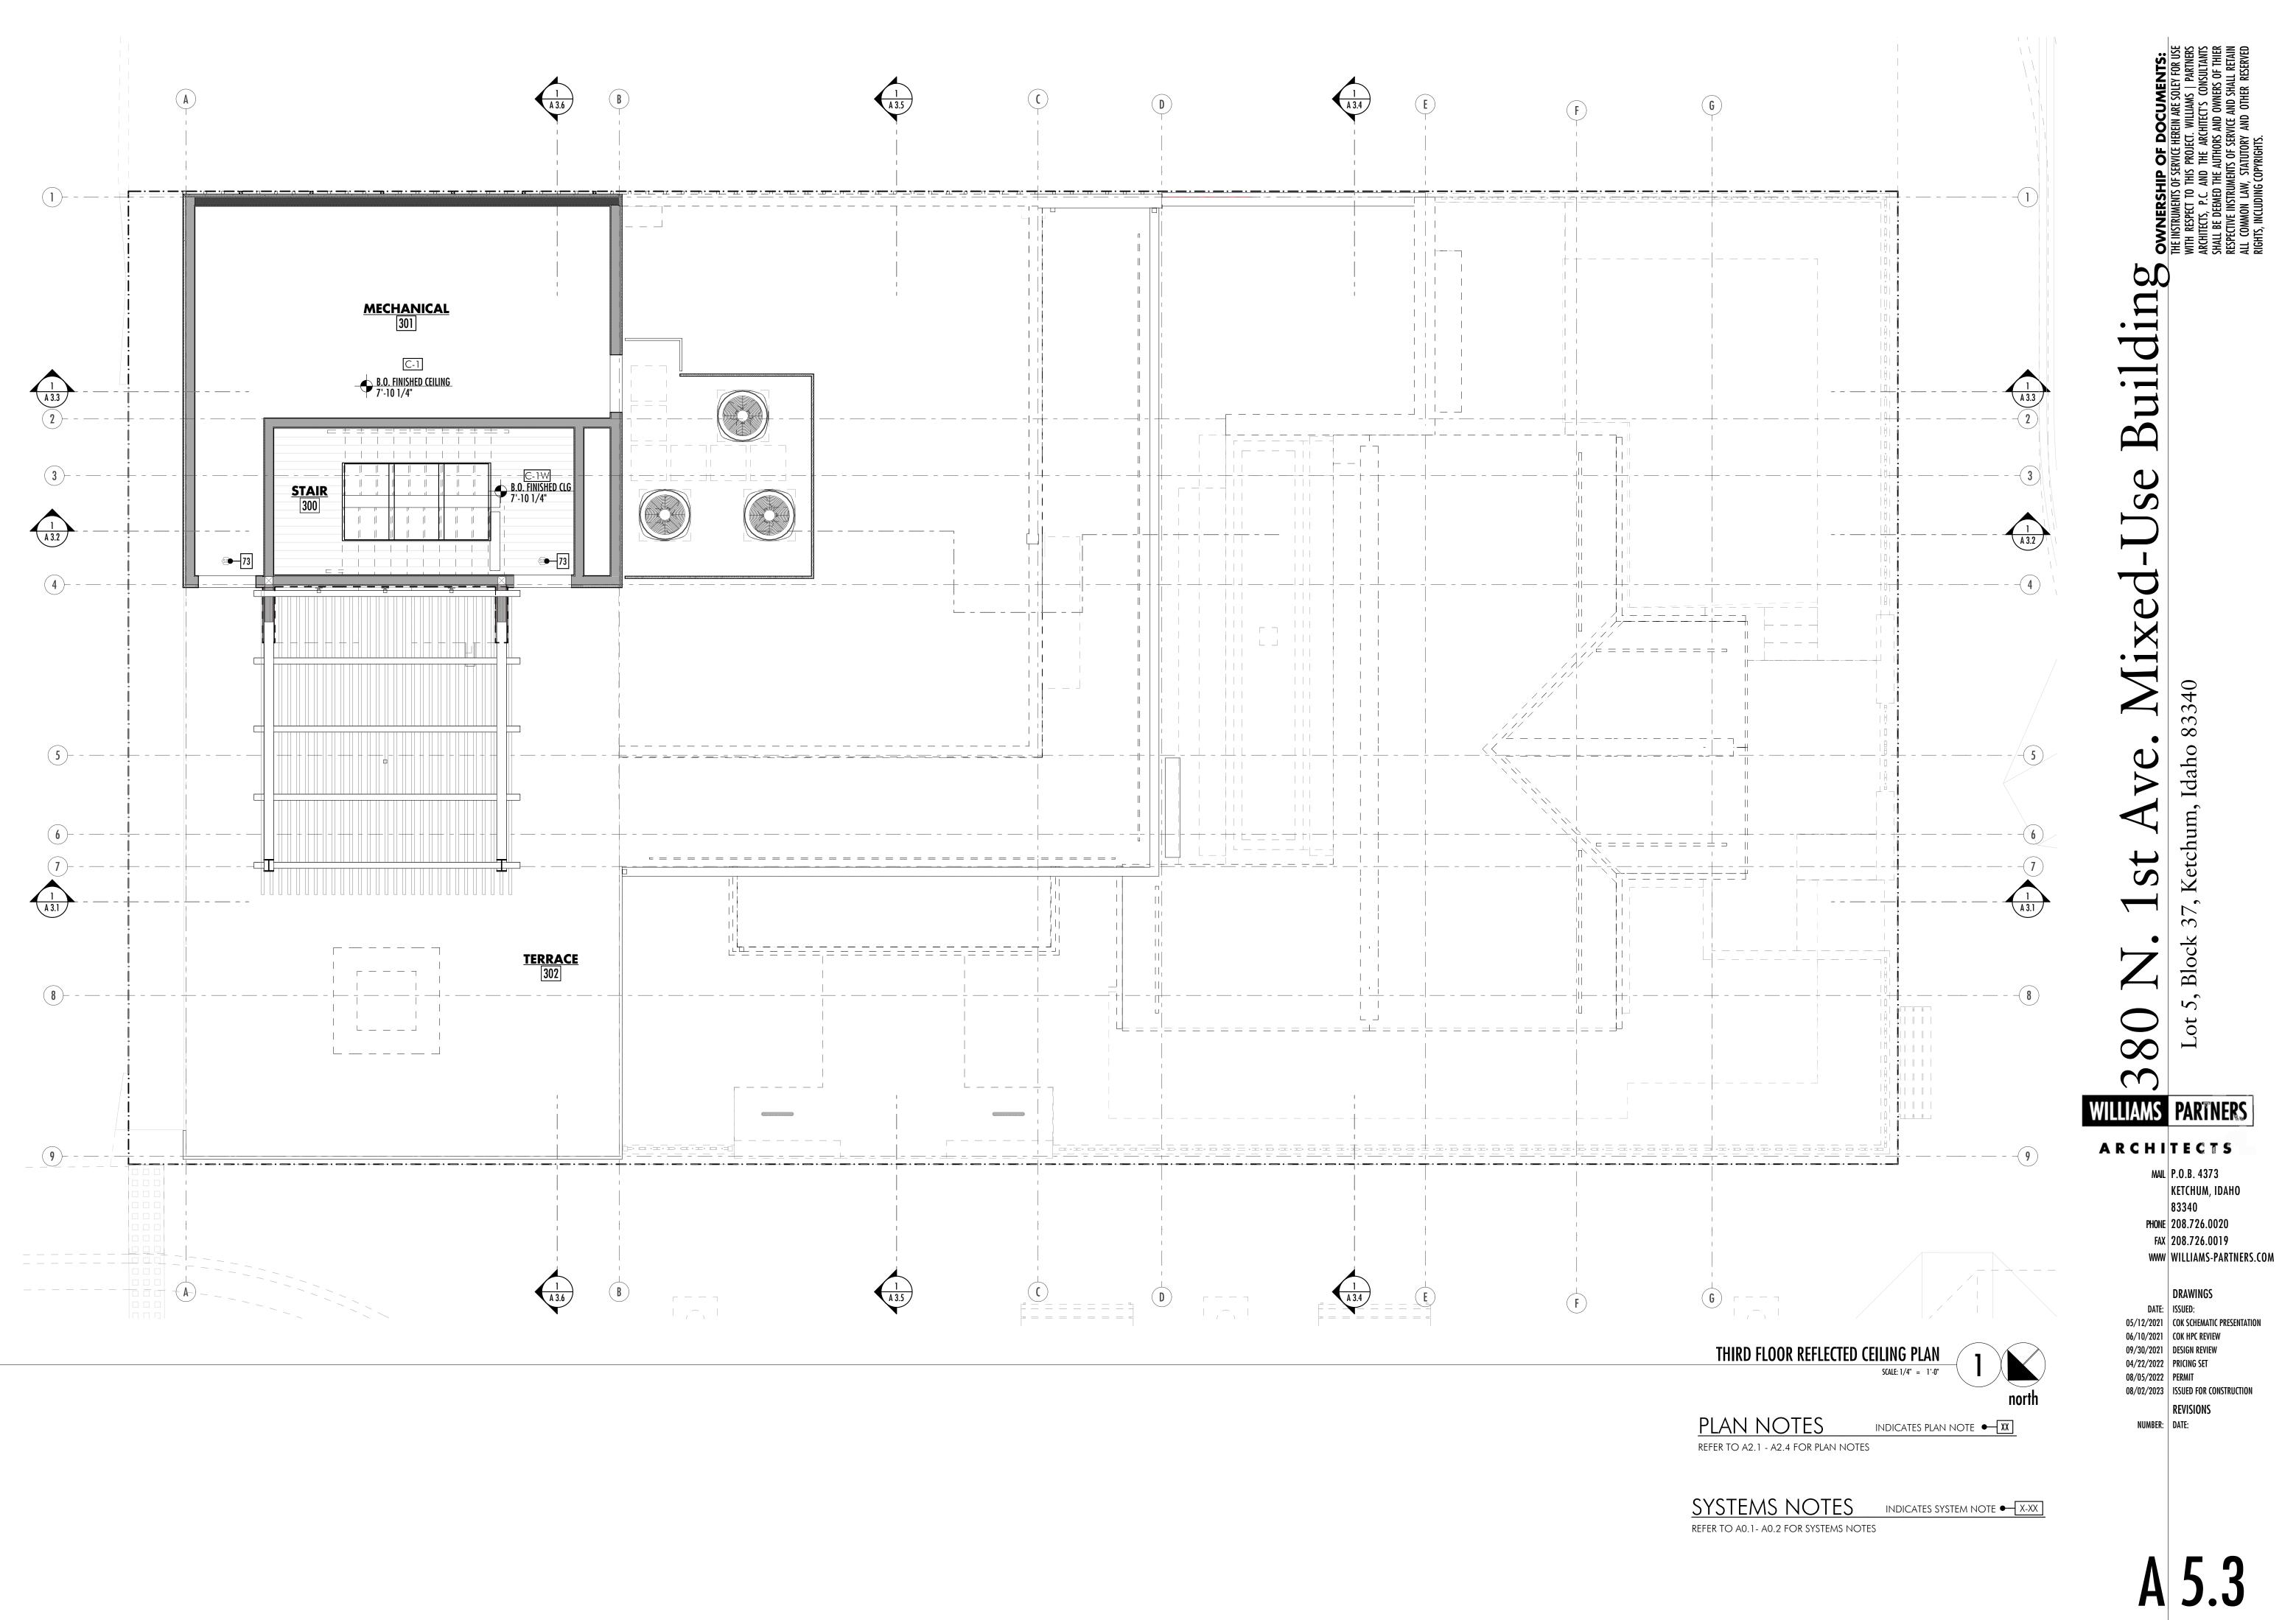



REFLECTED CEILING PLANS

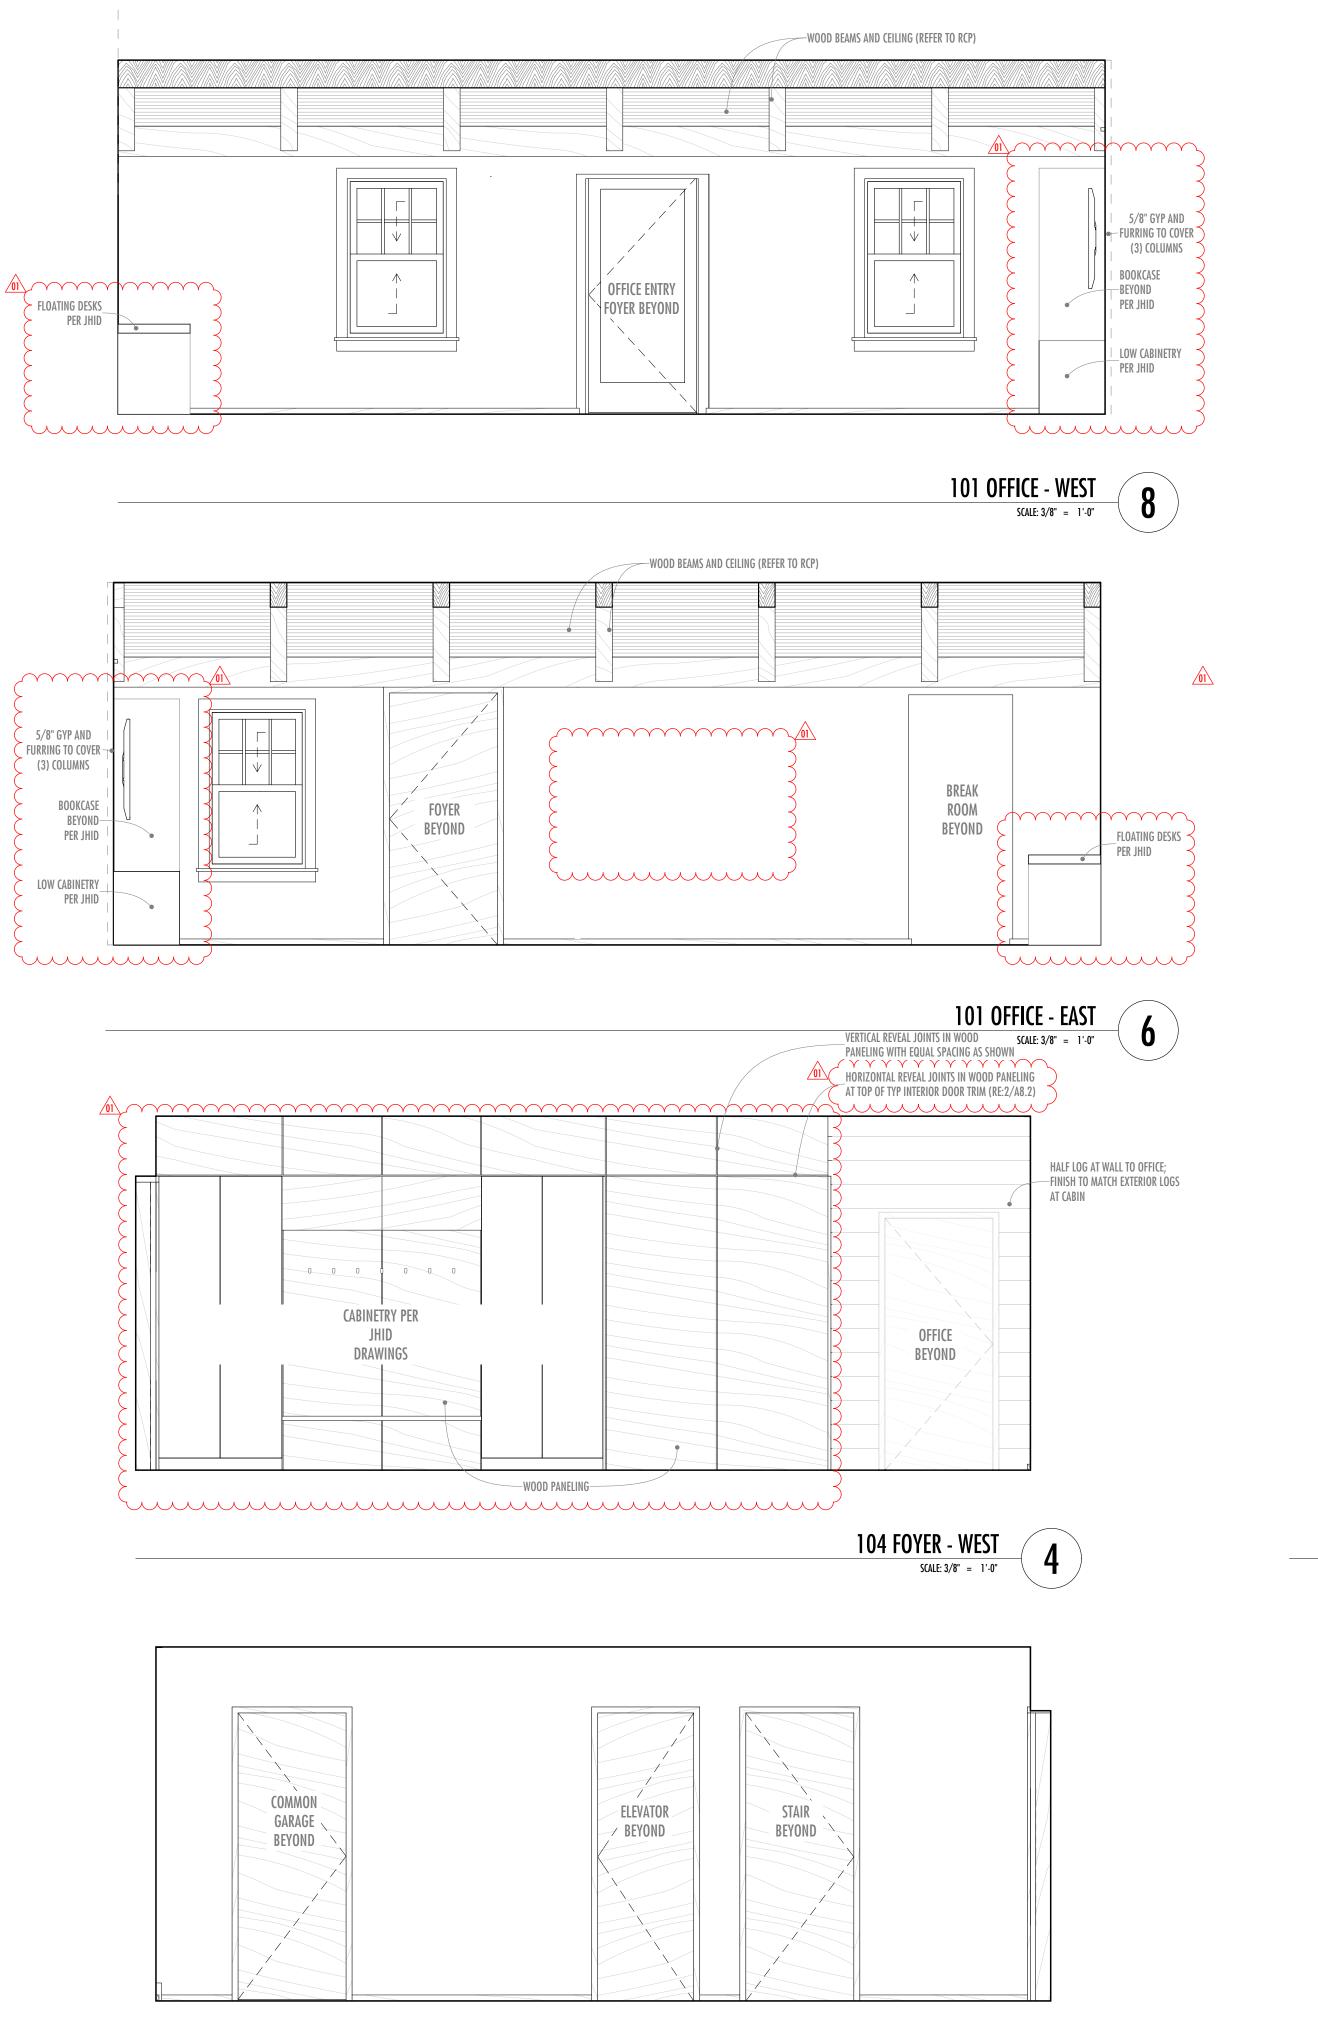


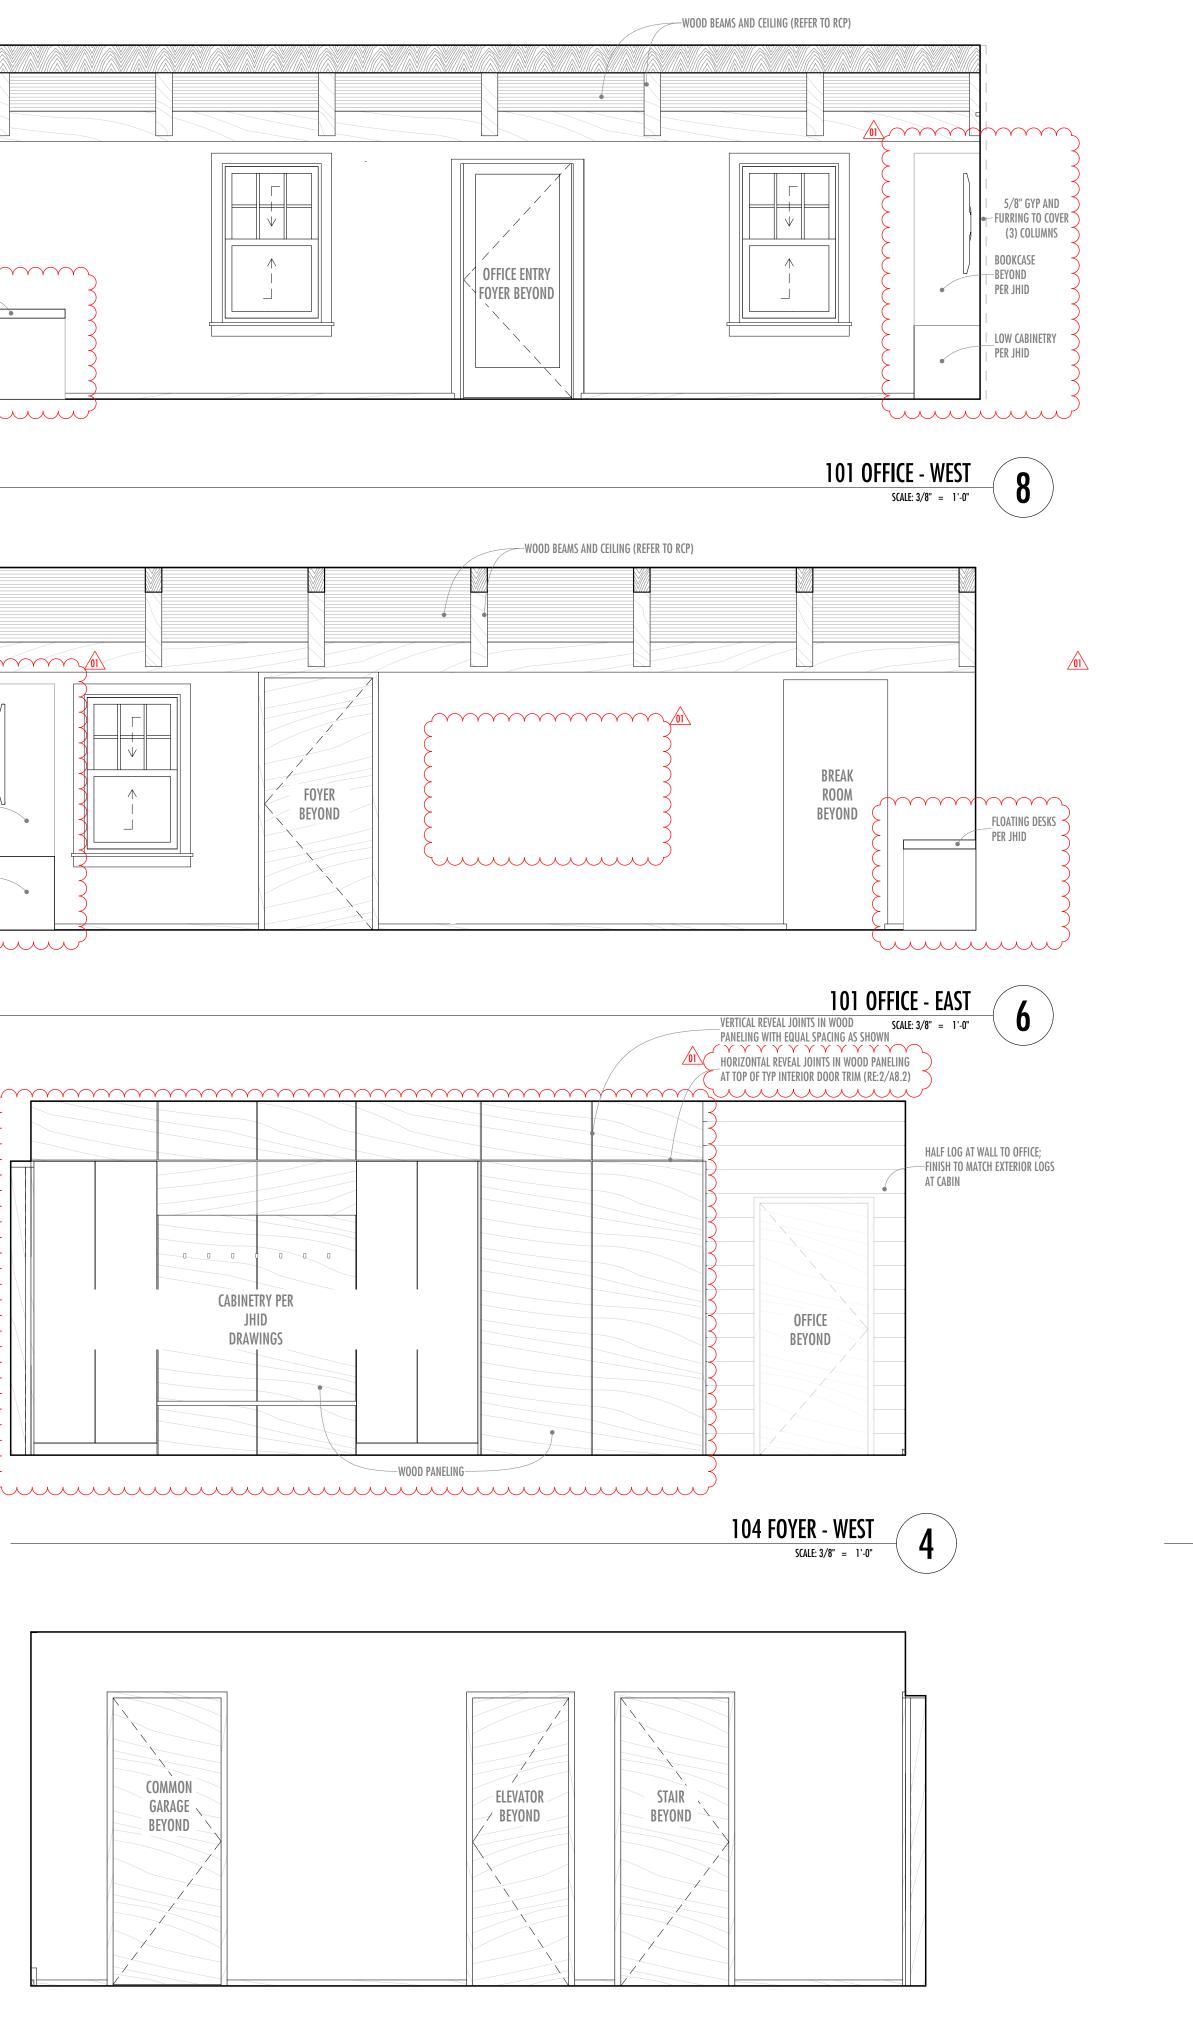



104 FOYER - EAST SCALE: 3/8" = 1'-0"

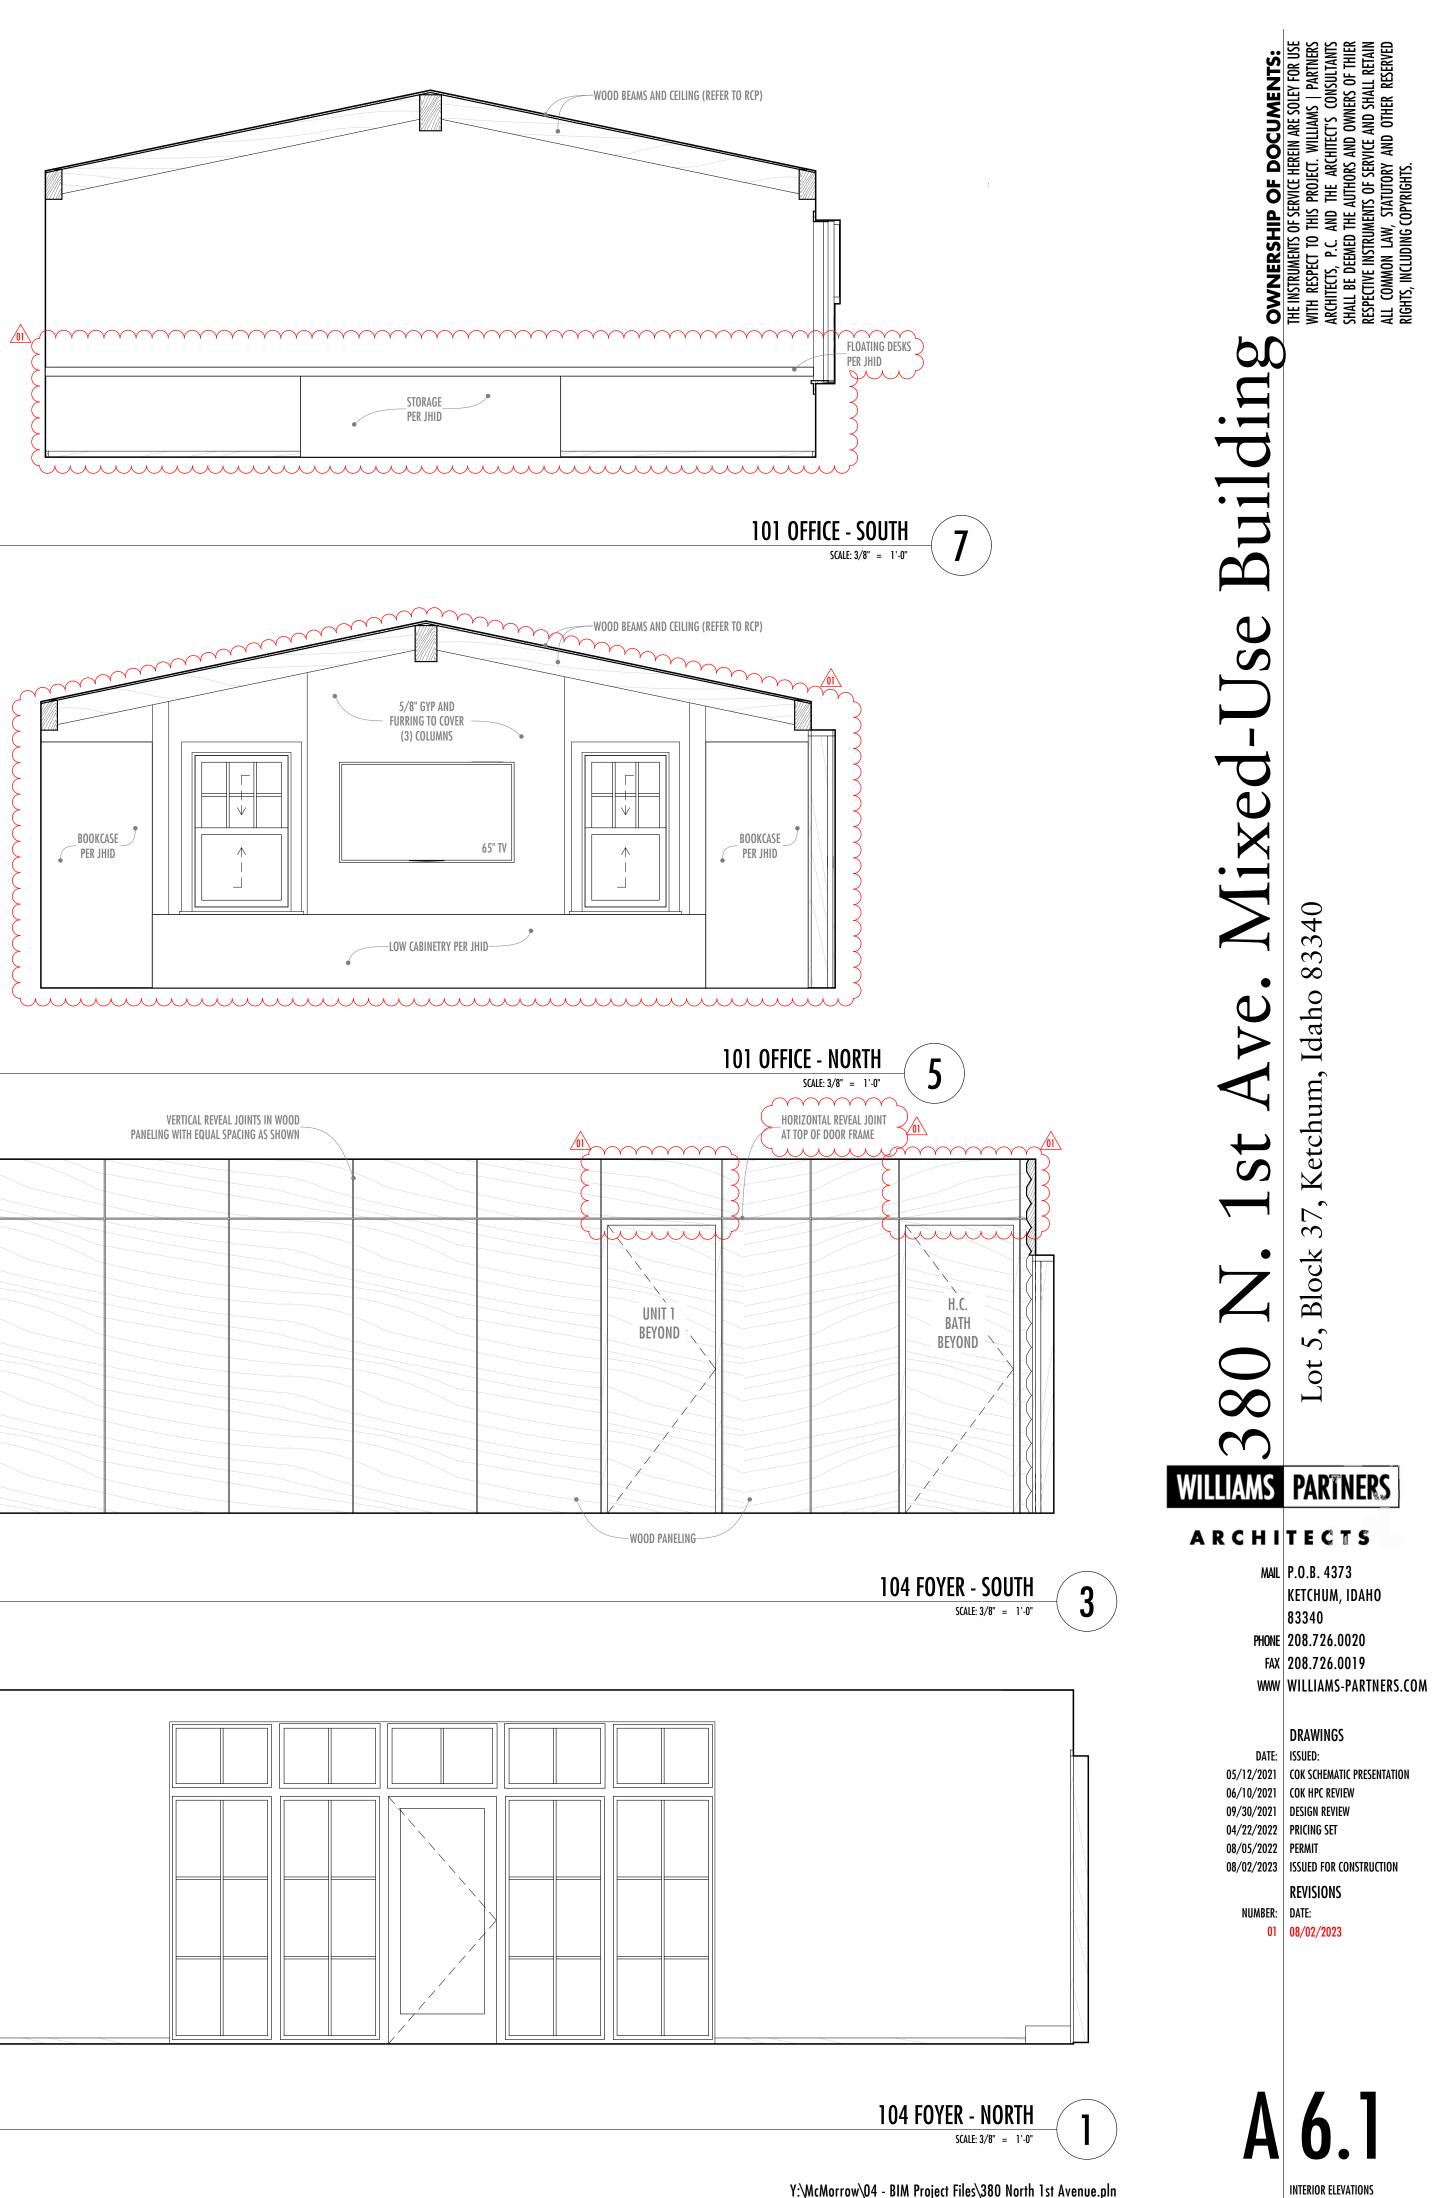

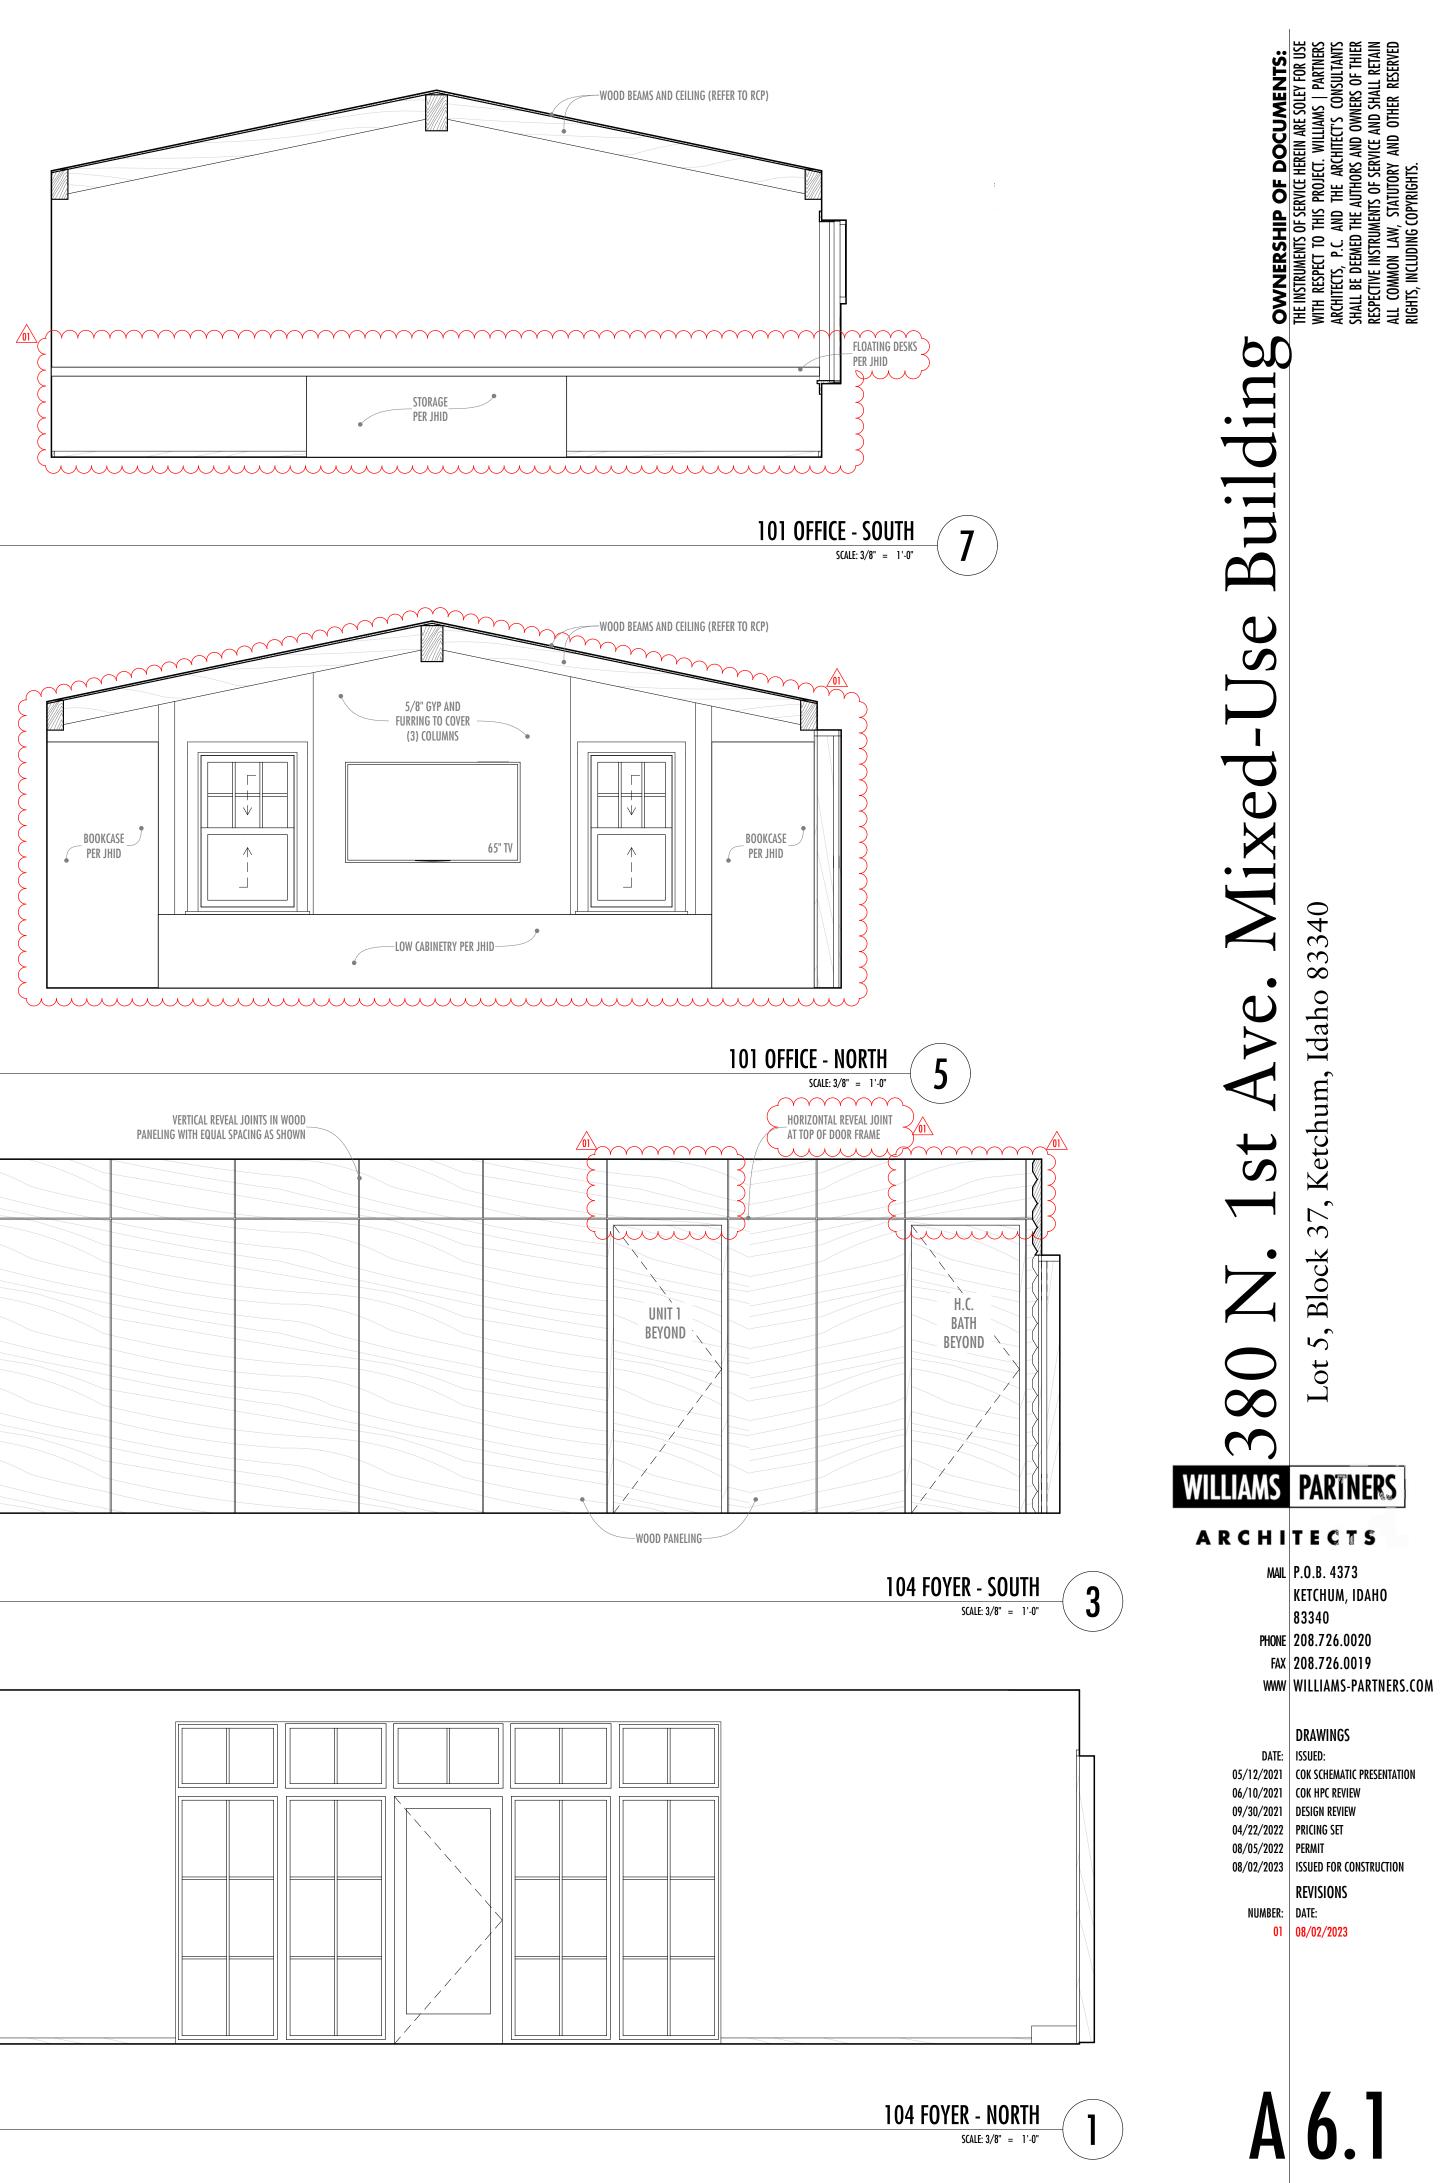


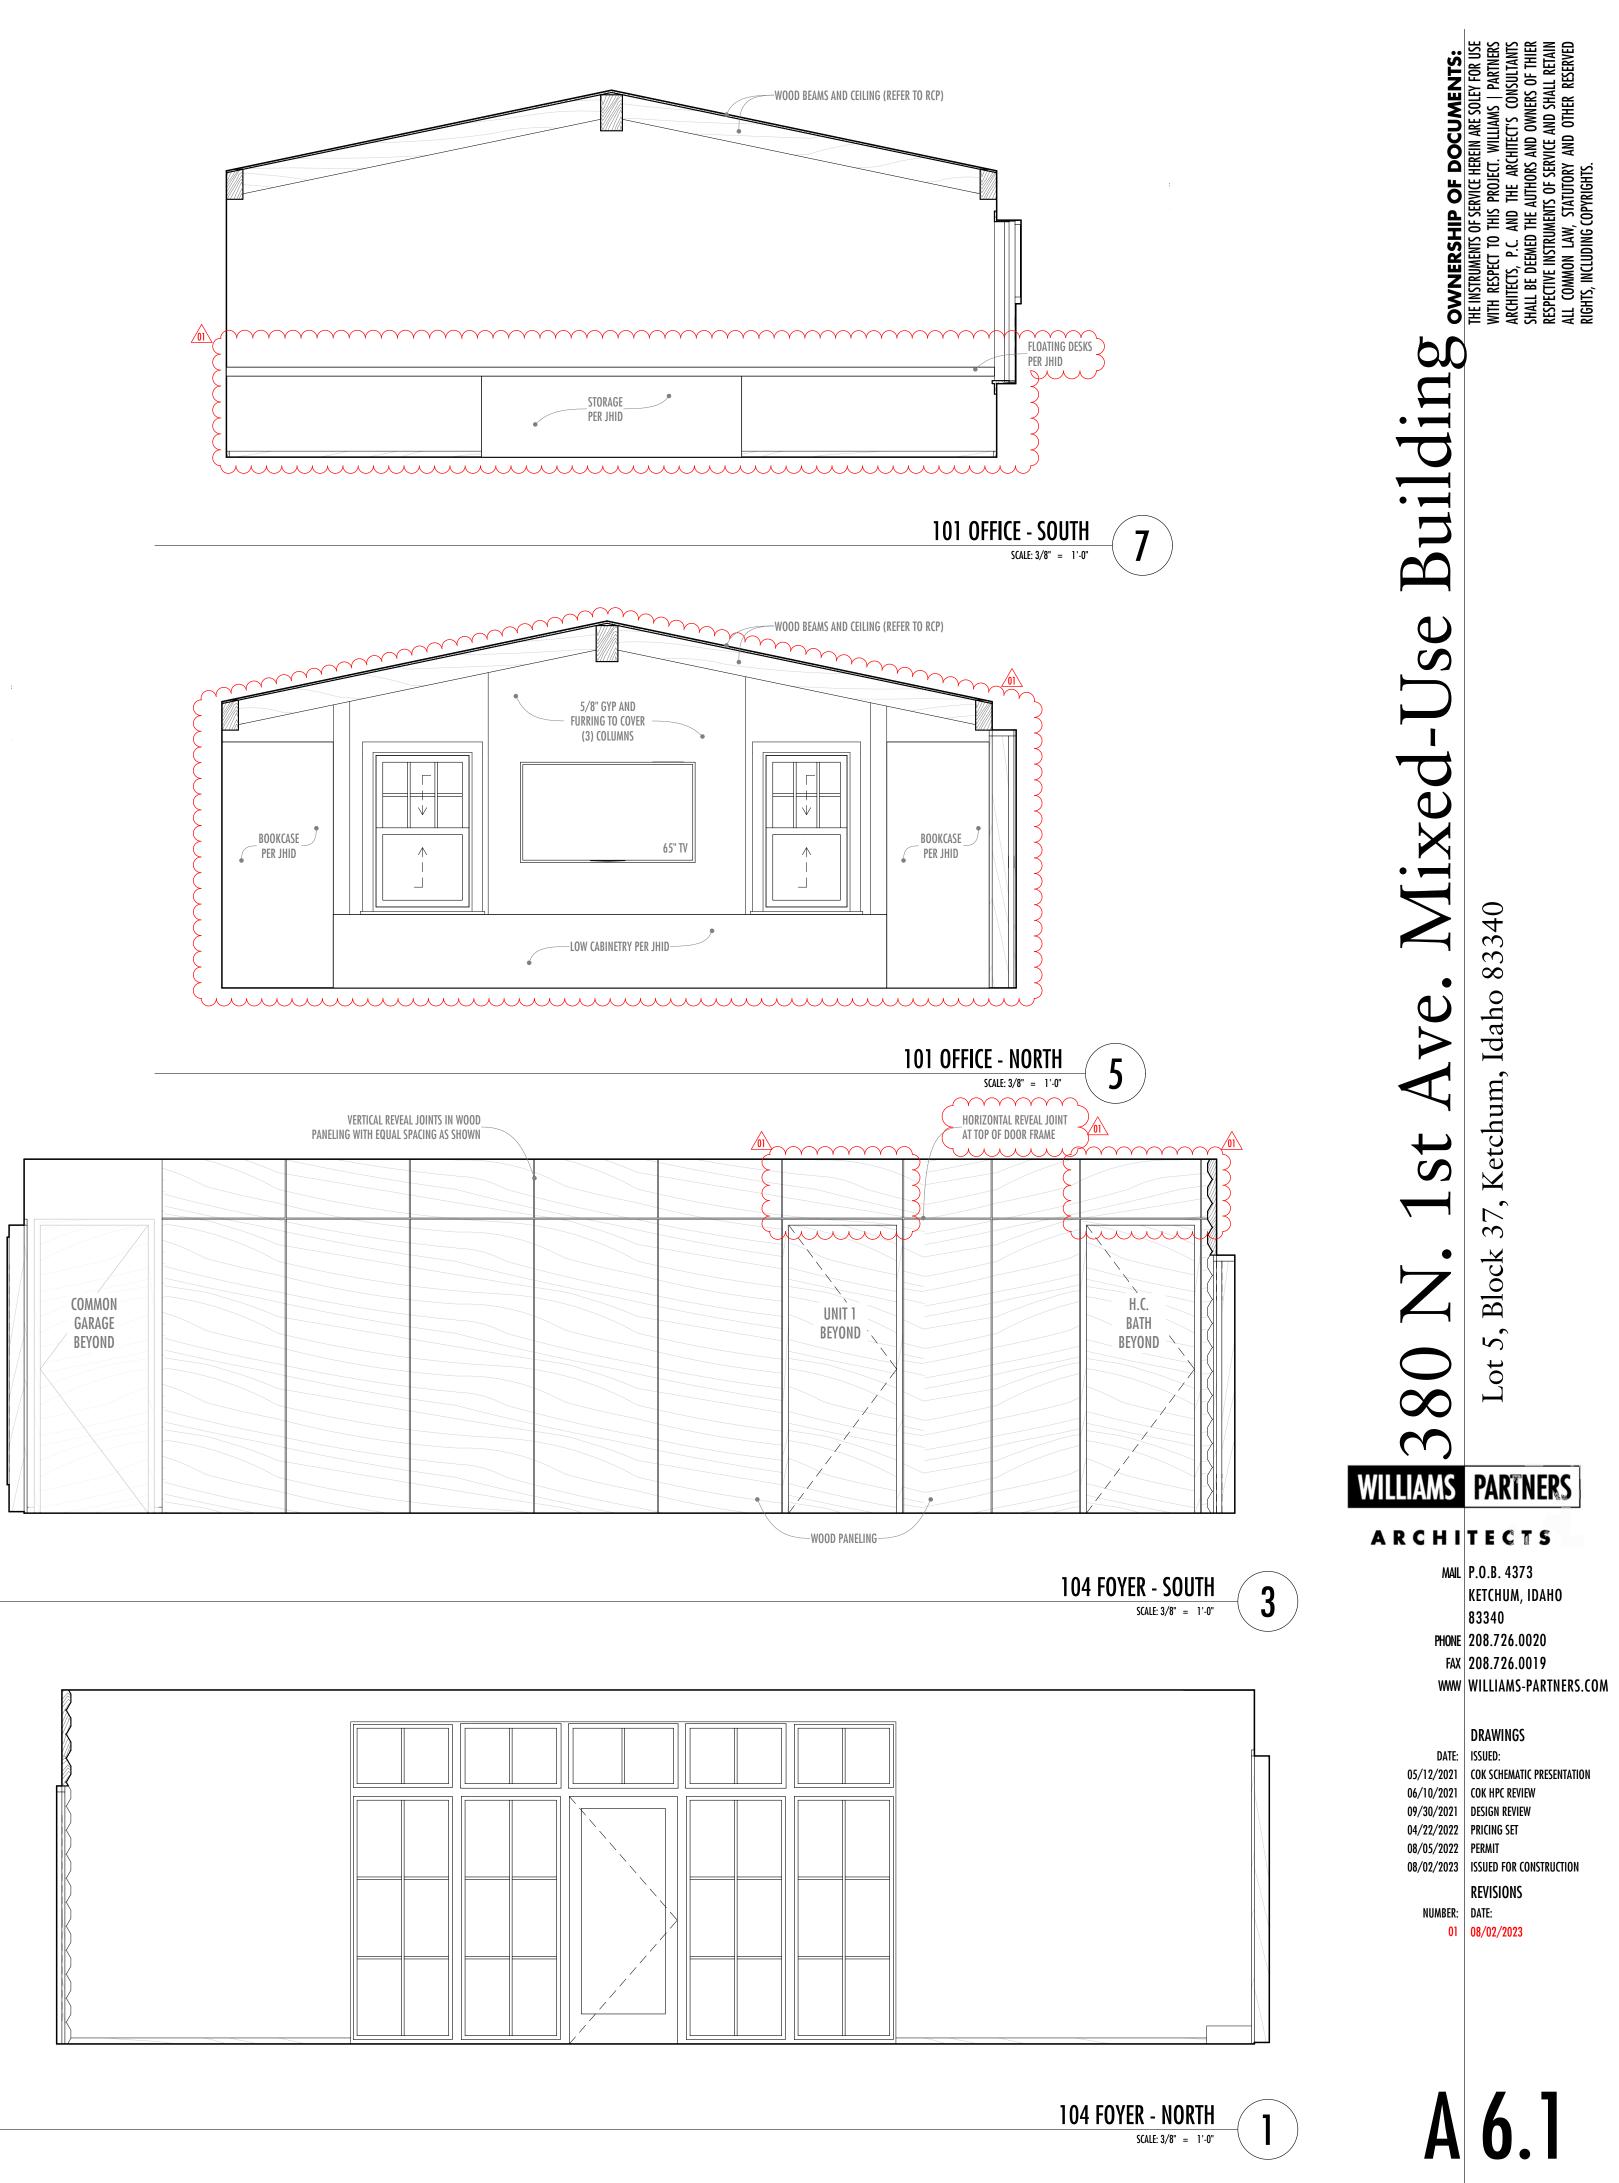


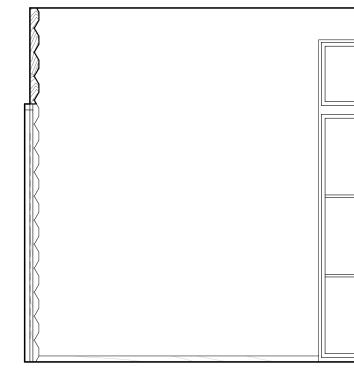


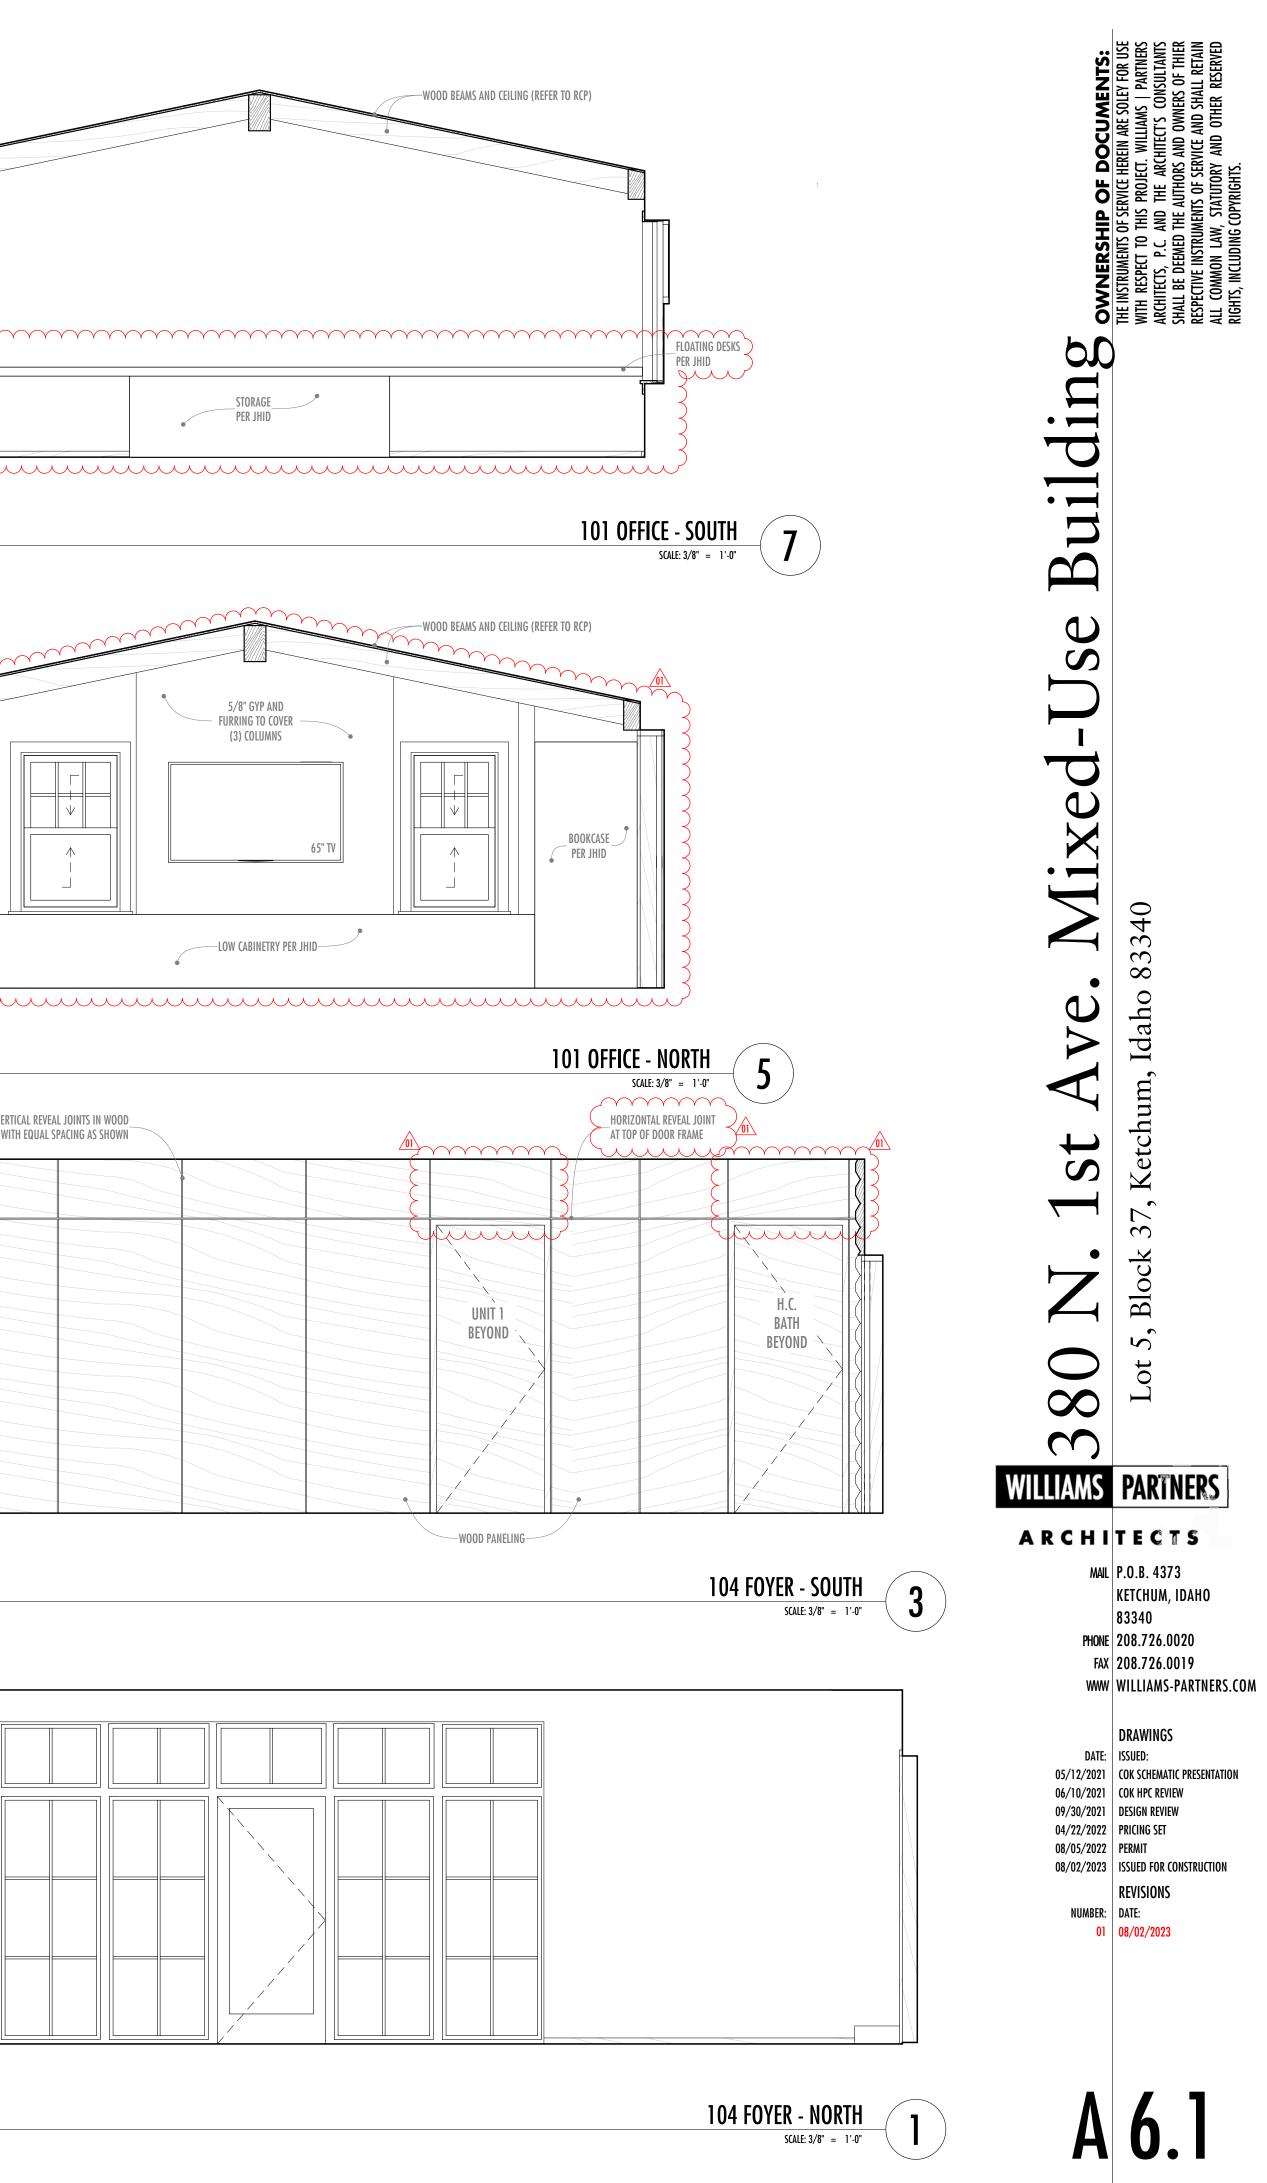



Y:\McMorrow\04 - BIM Project Files\380 North 1st Avenue.pln

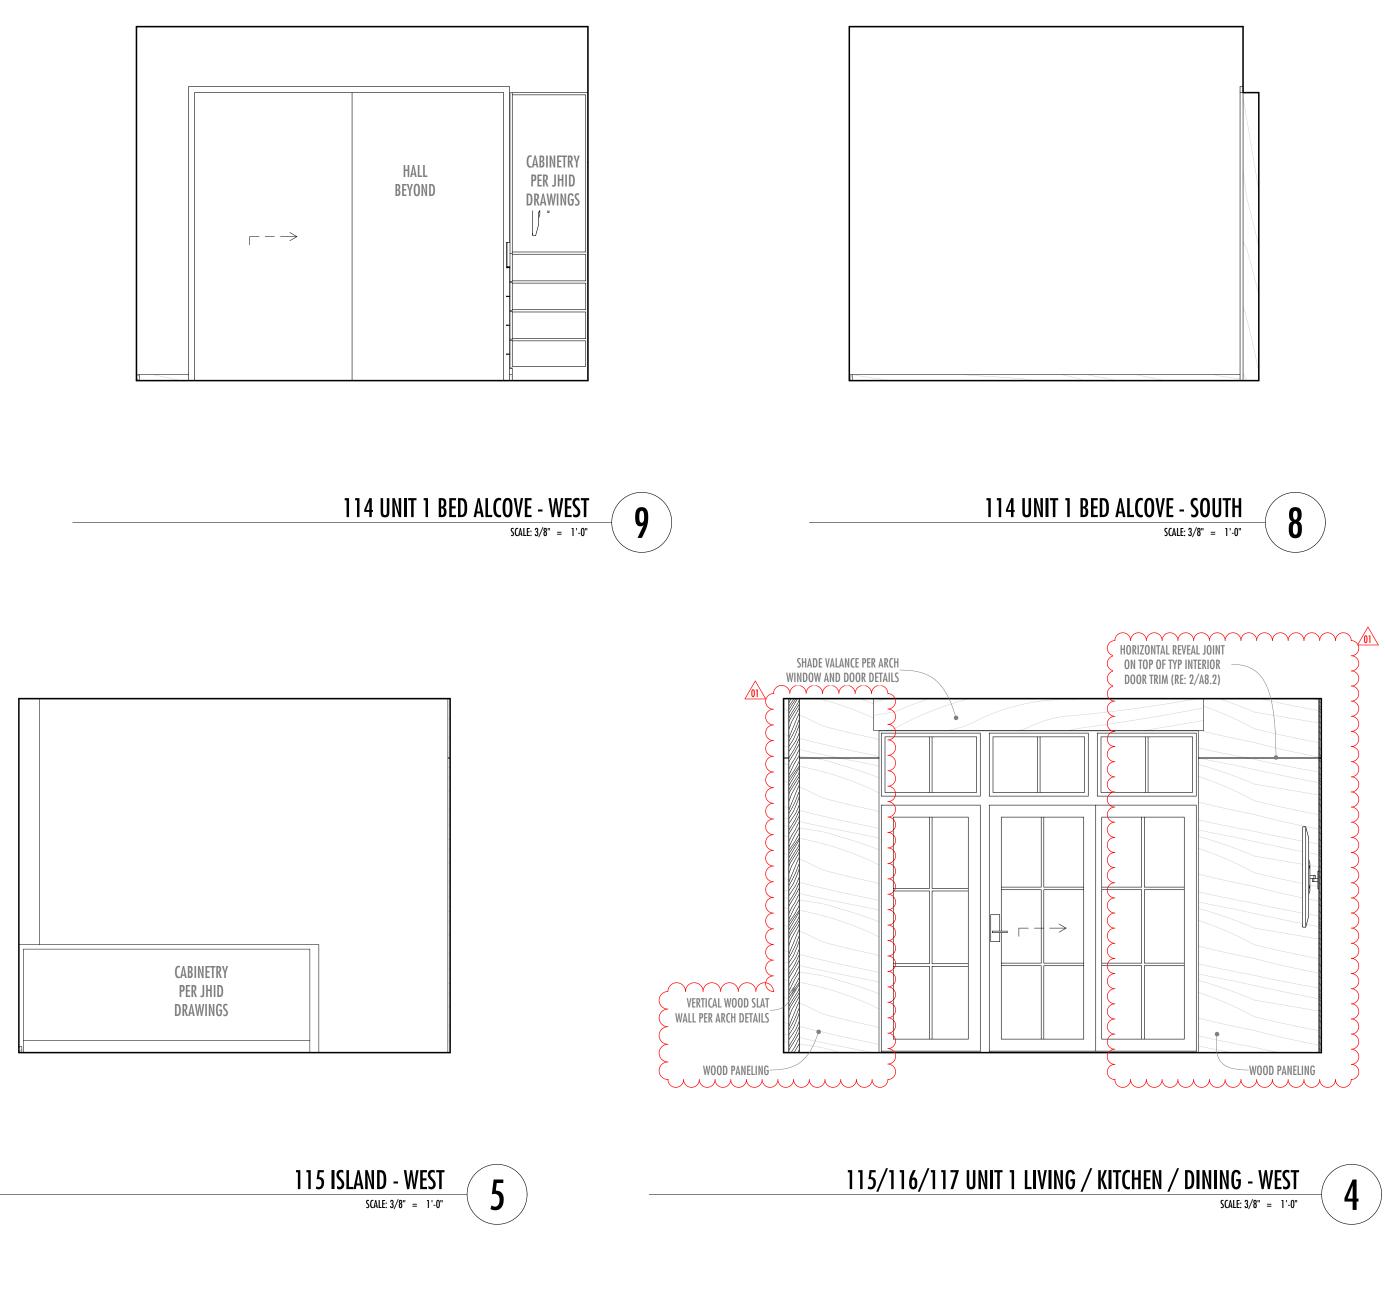


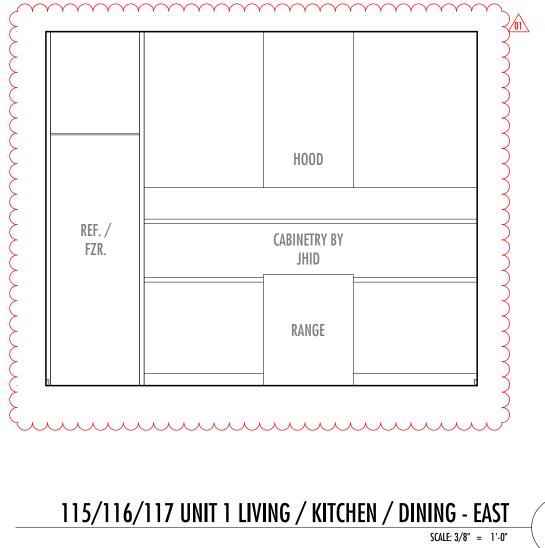

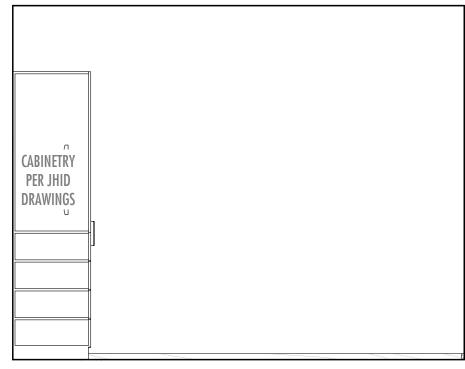

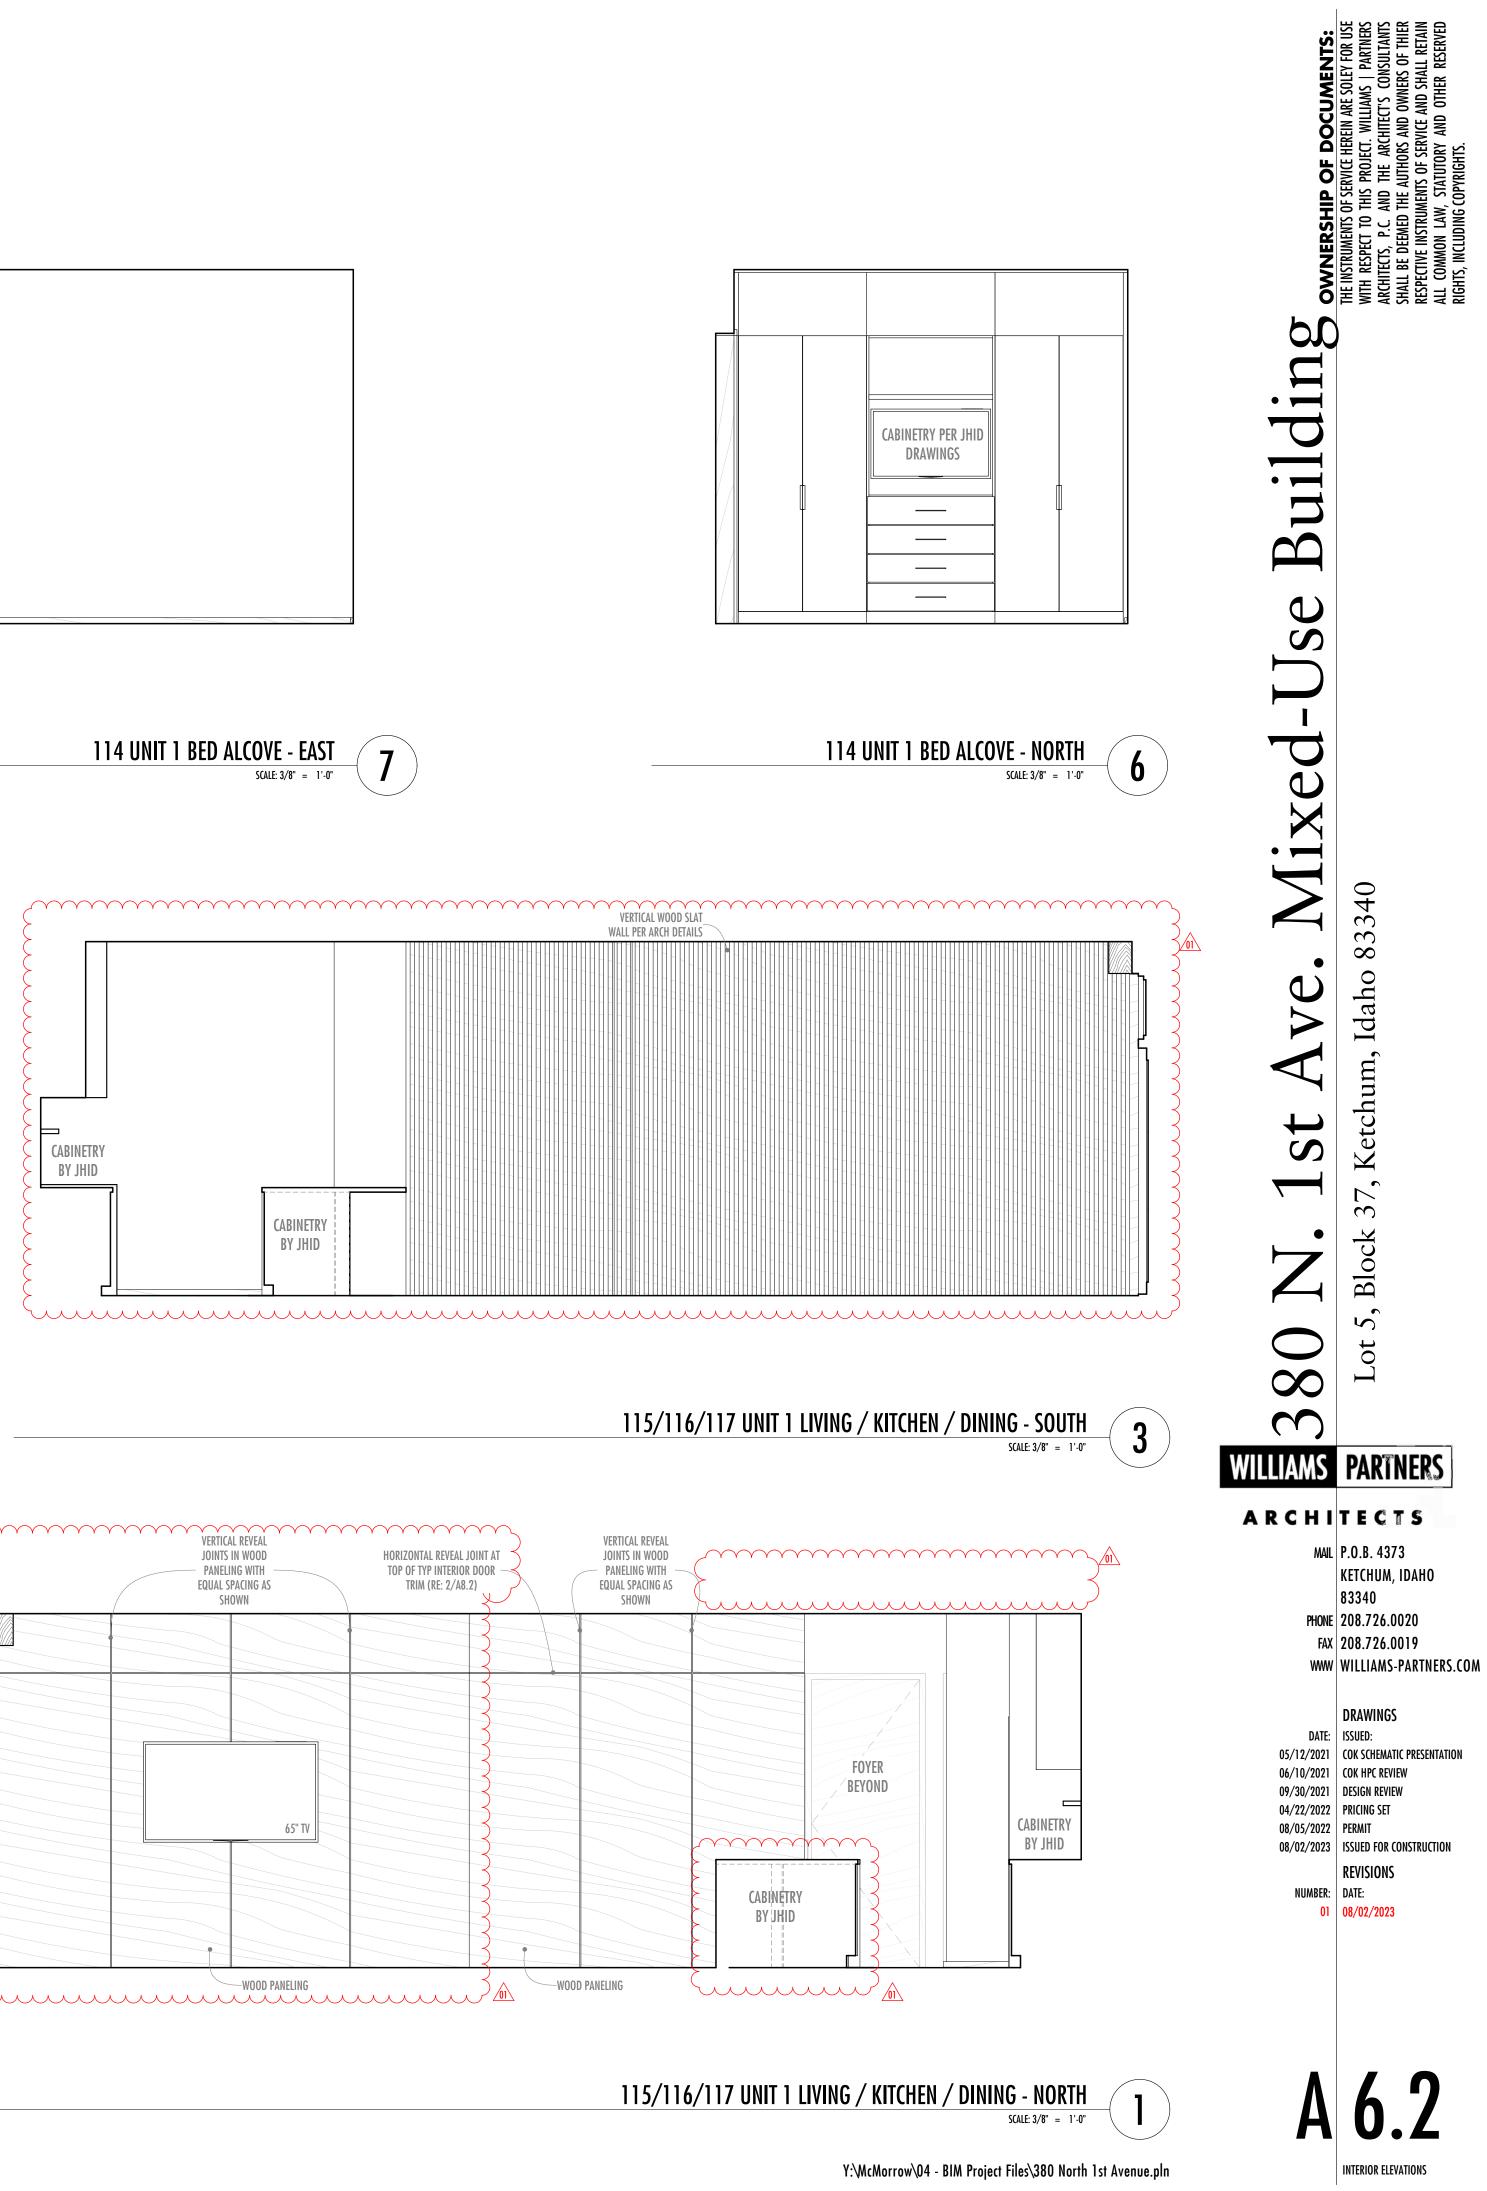

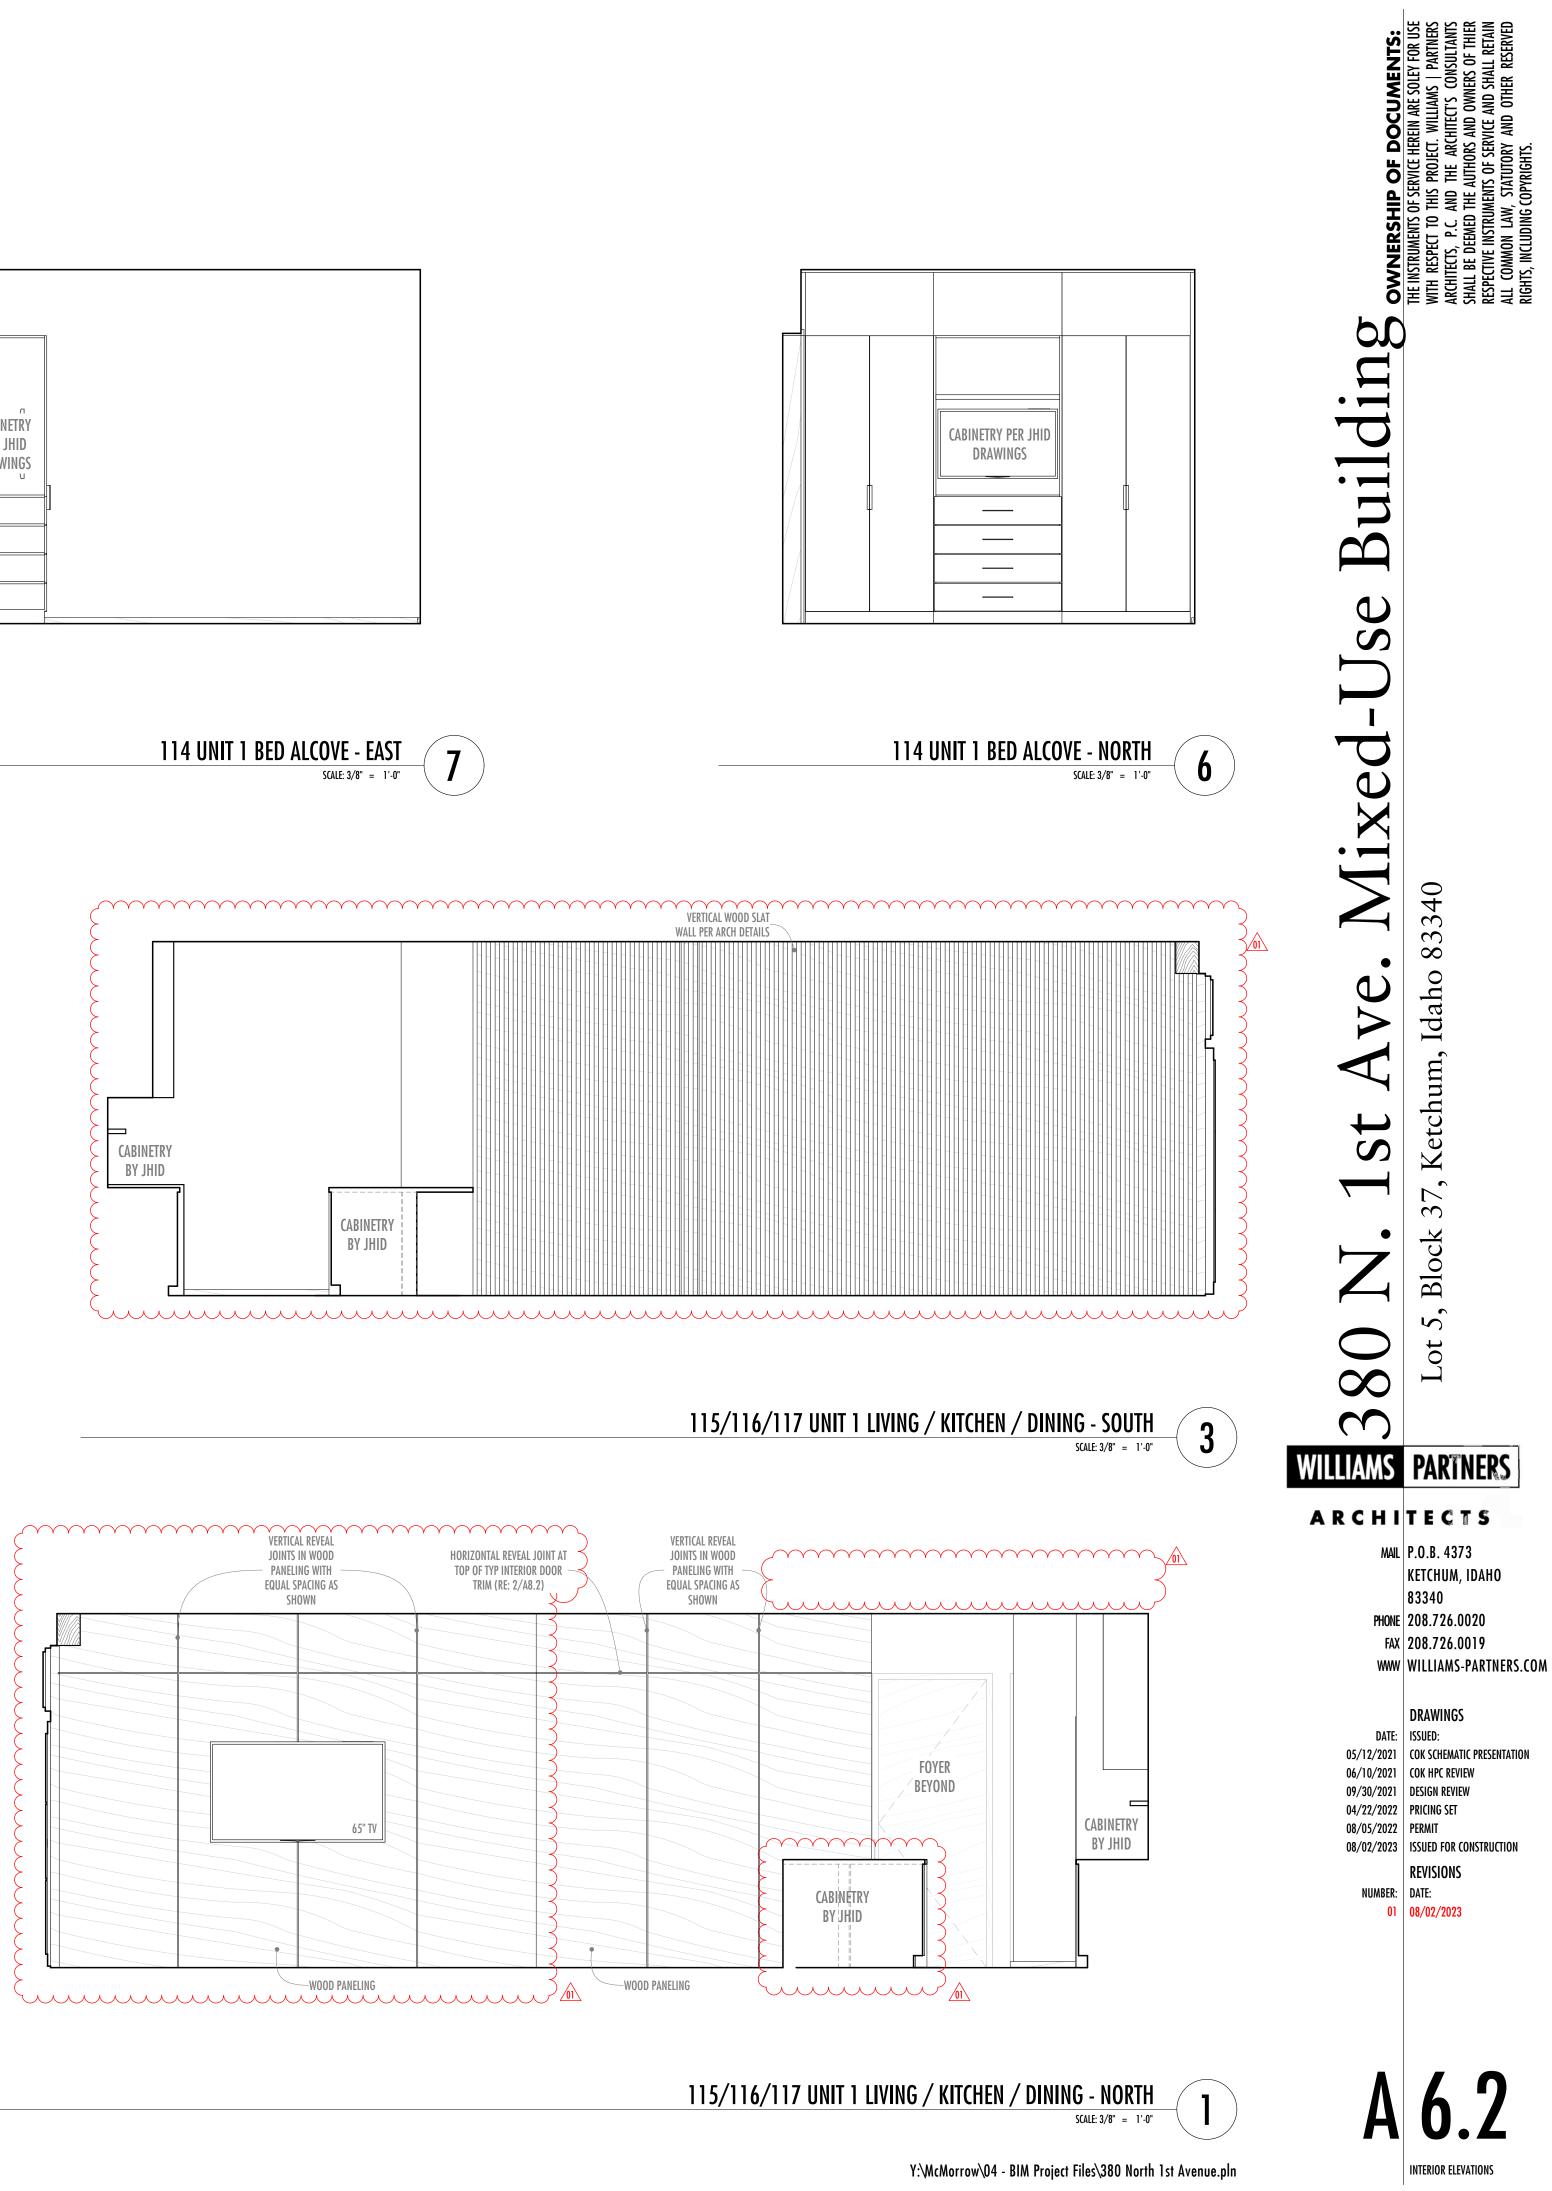

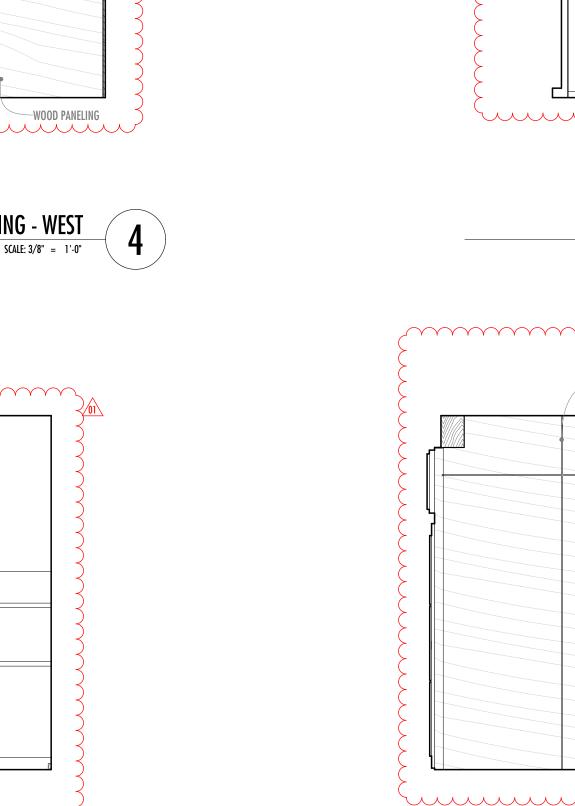







		r
	C	
	CABINETRY	
	BY JHID	
a		J
	n 1	•

Y:\McMorrow\04 - BIM Project Files\380 North 1st Avenue.pln













Y:\McMorrow\04 - BIM Project Files\380 North 1st Avenue.pln

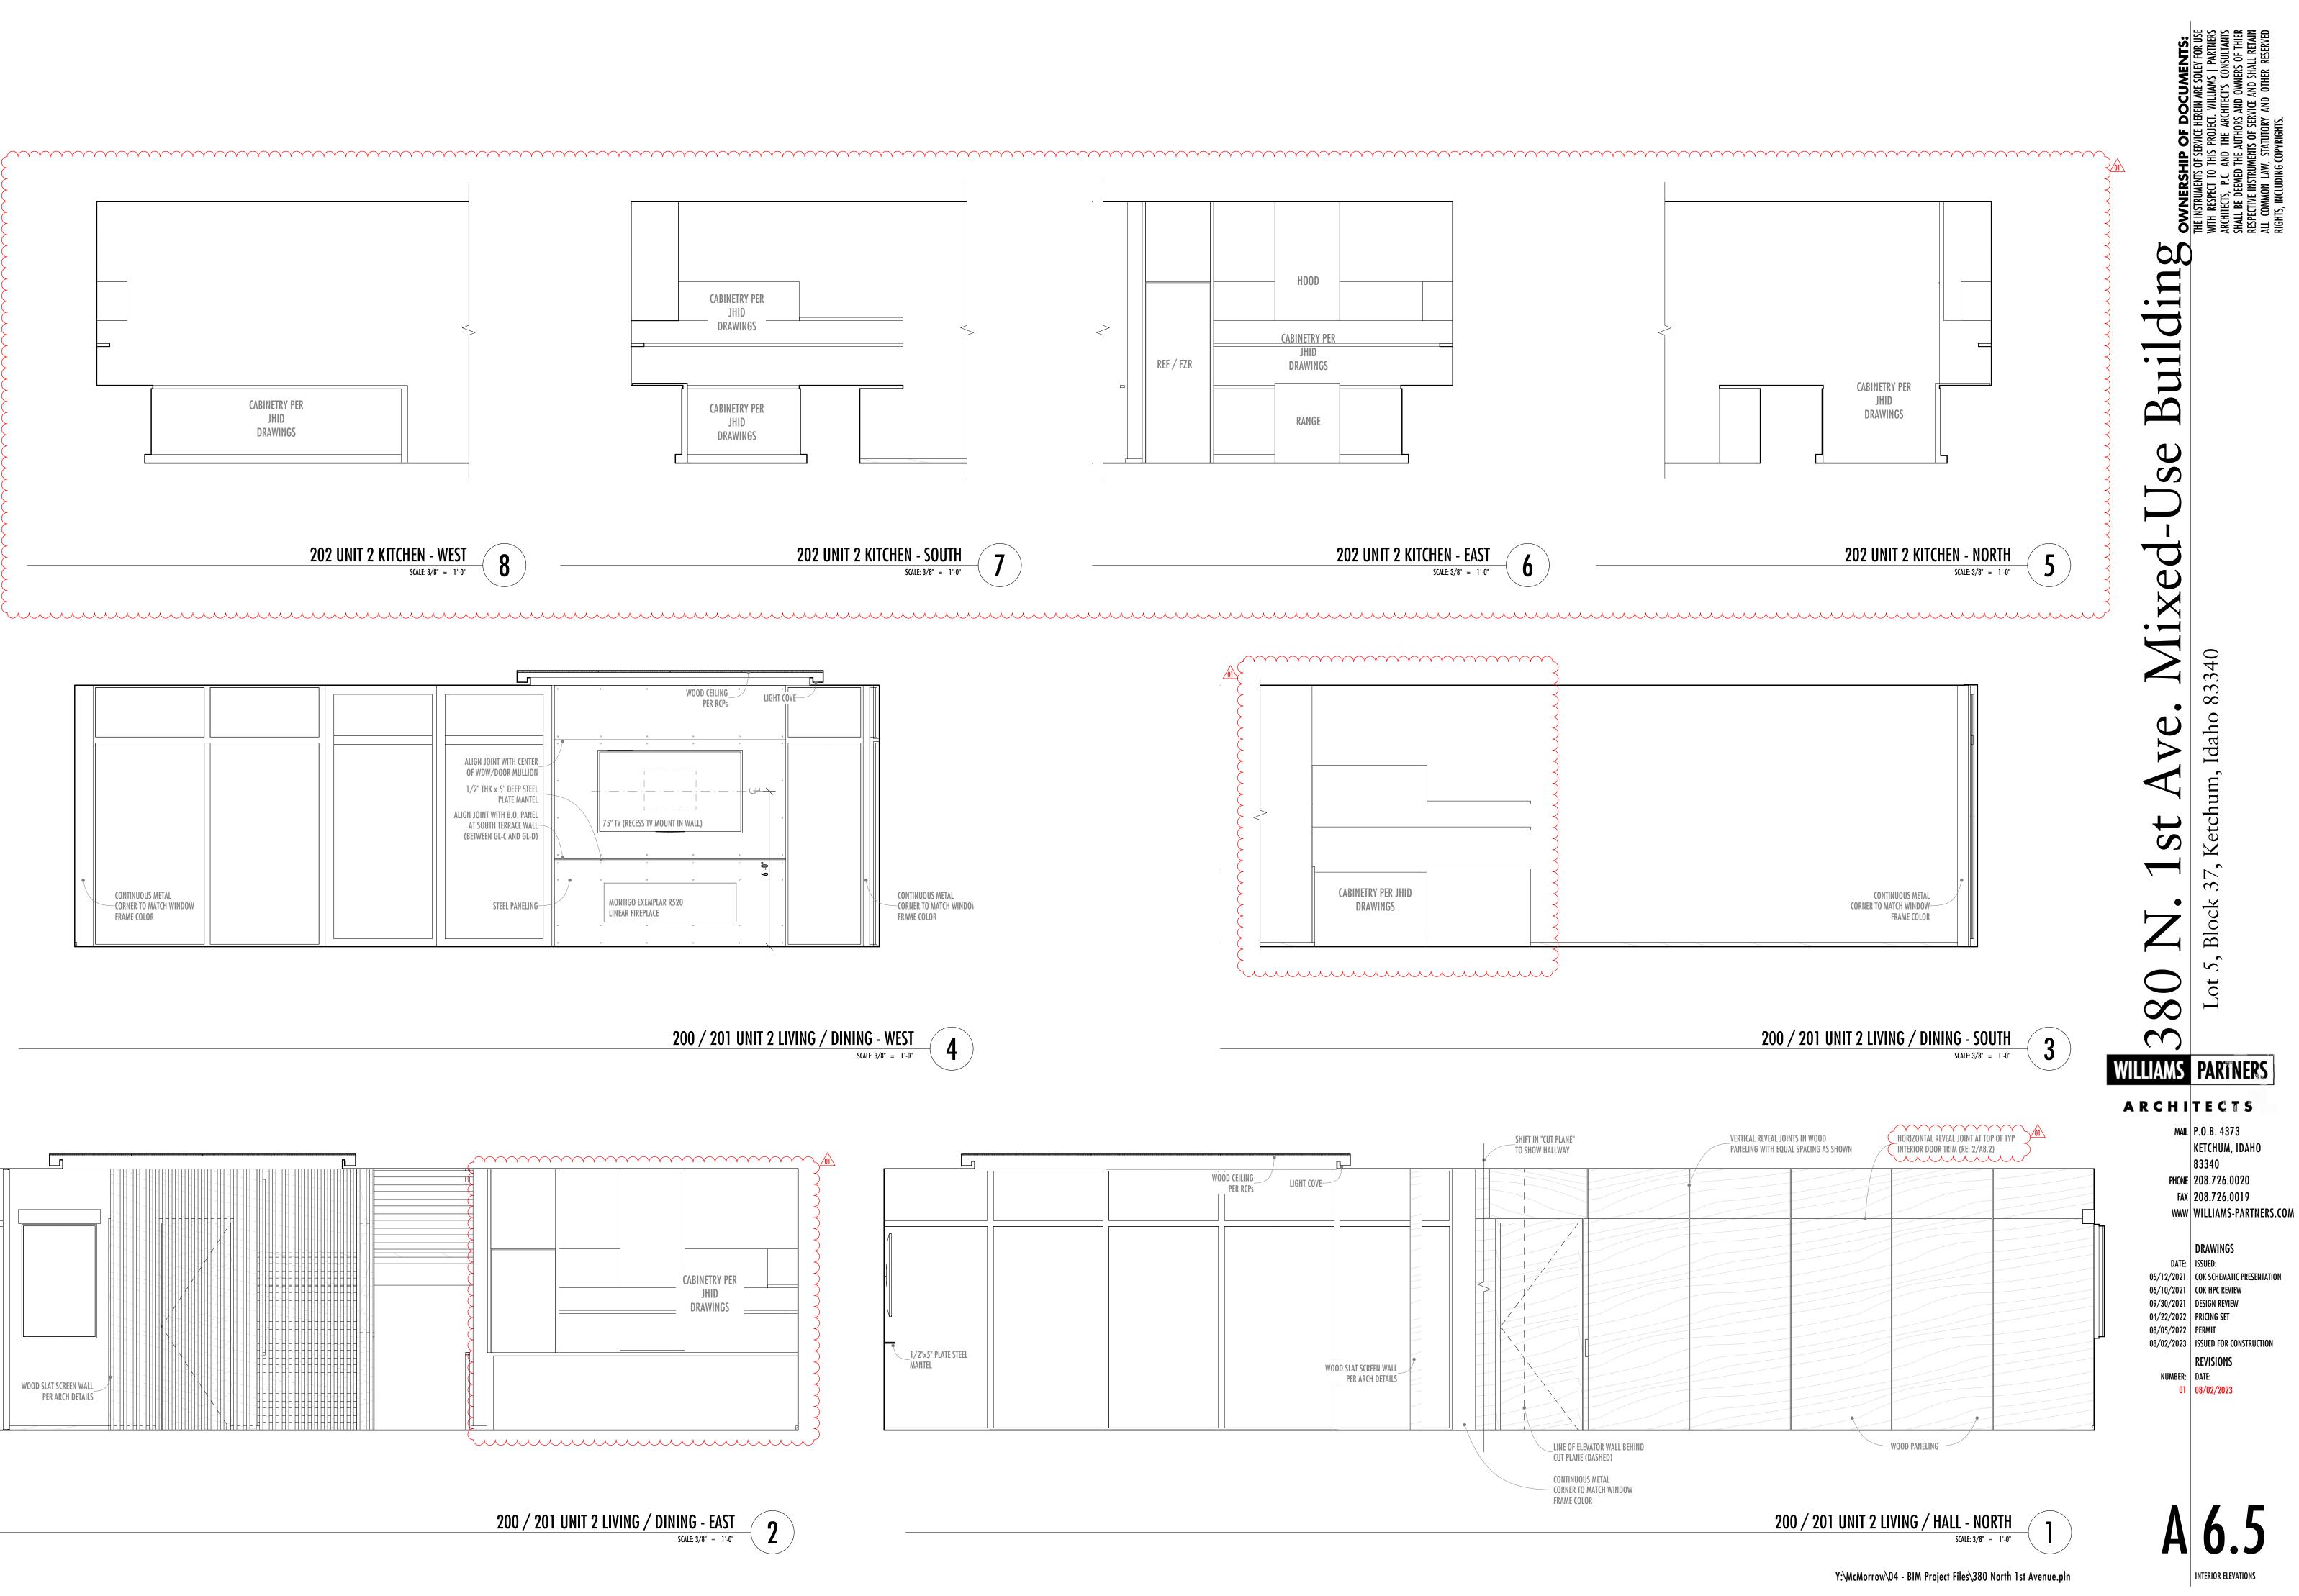

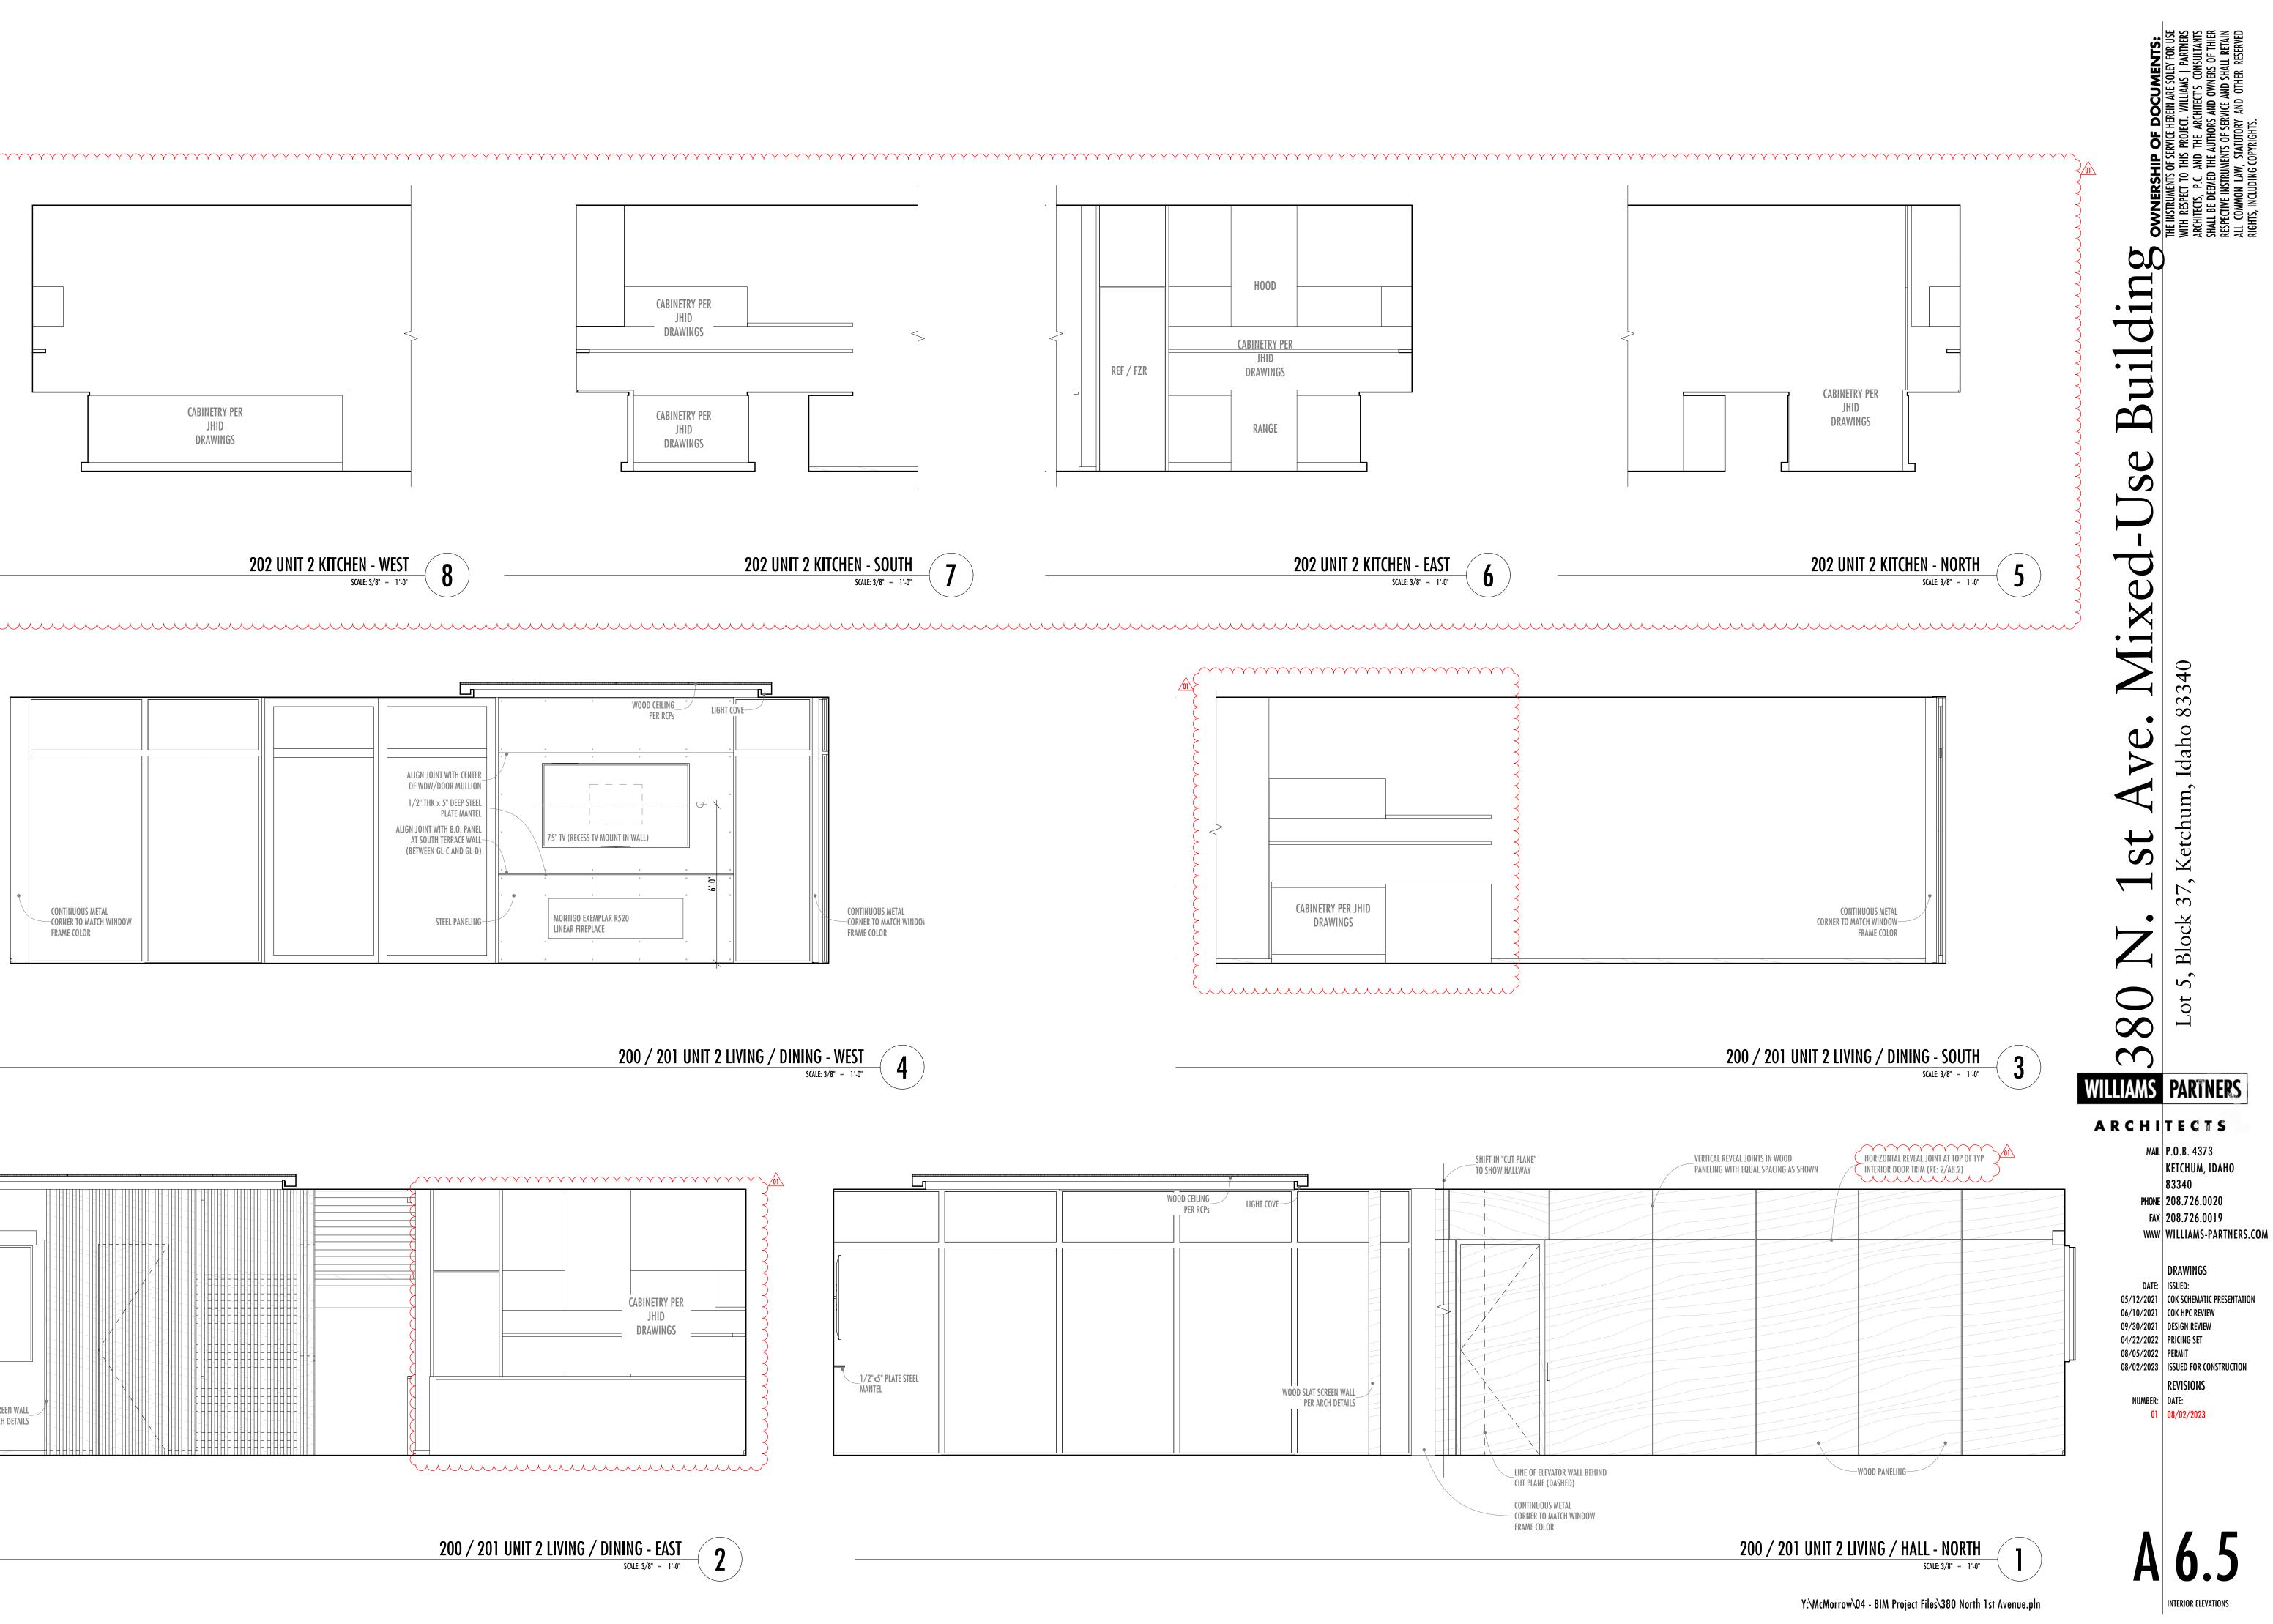


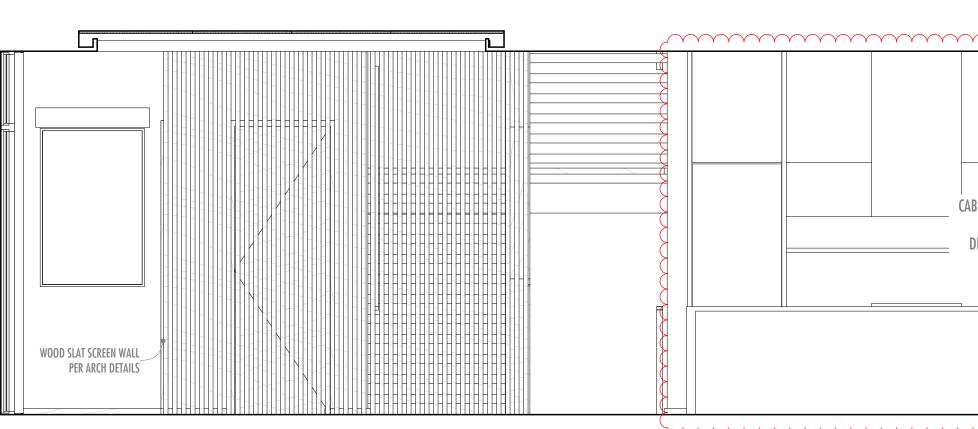





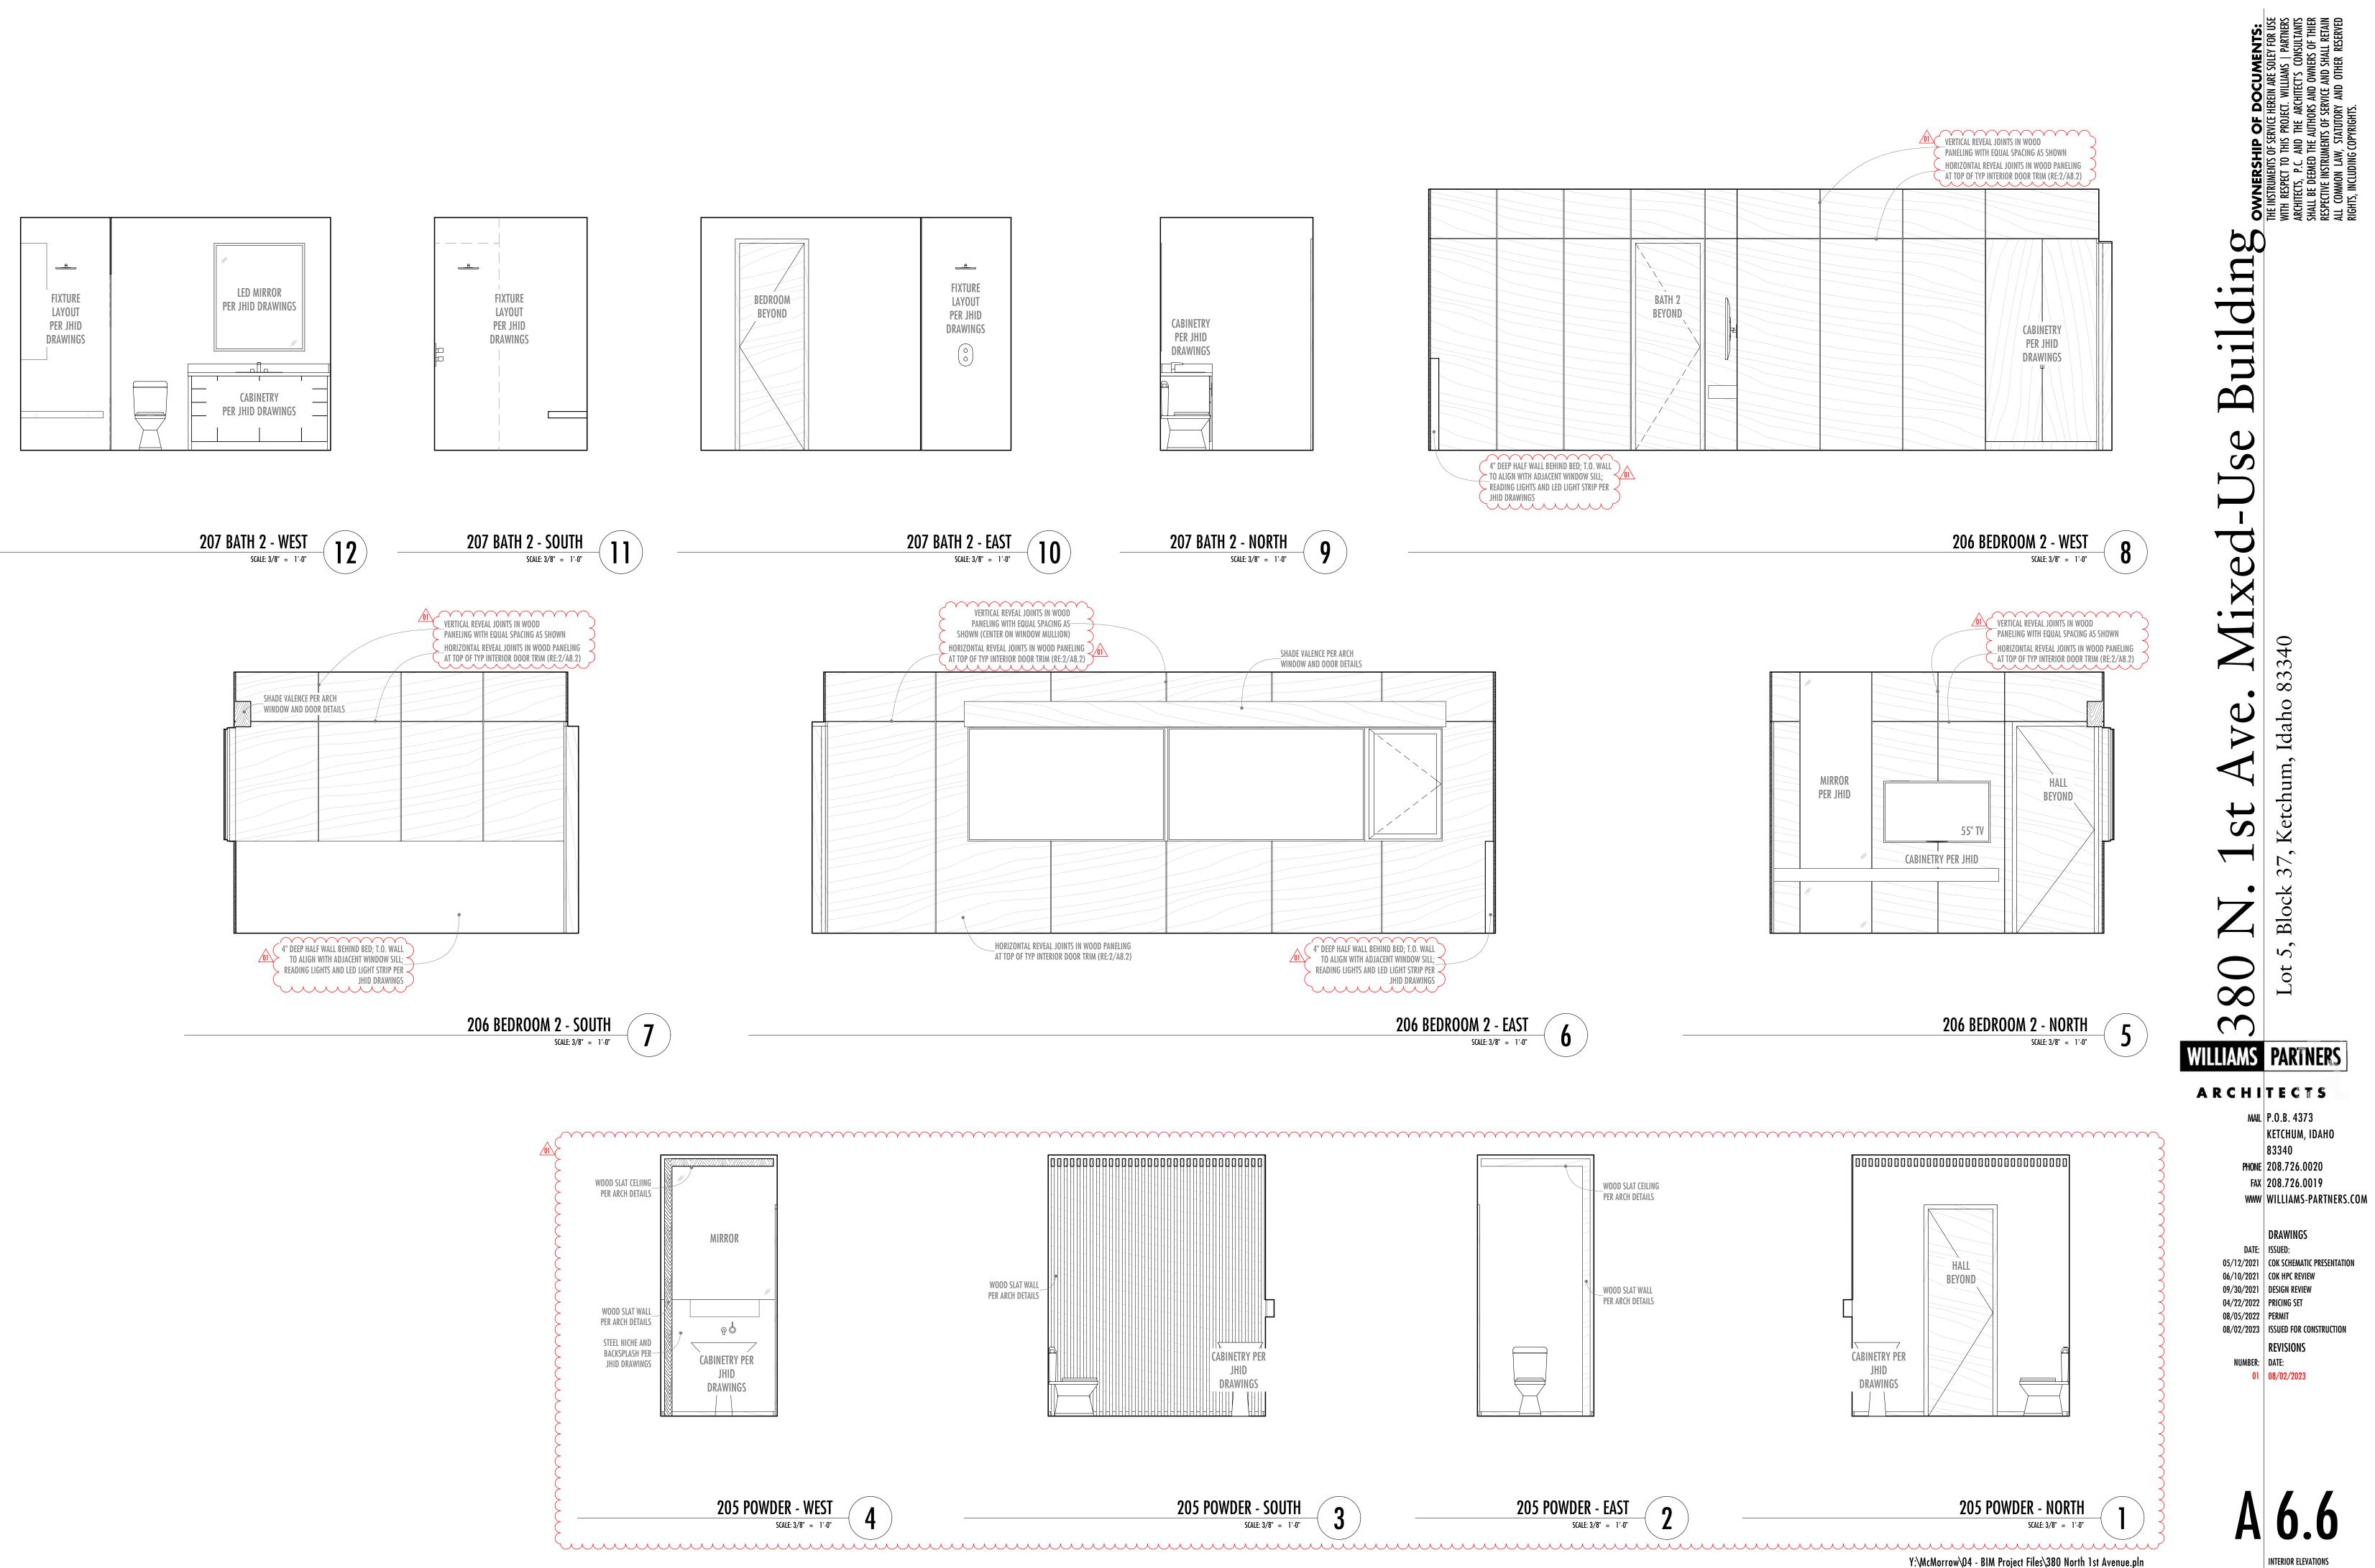





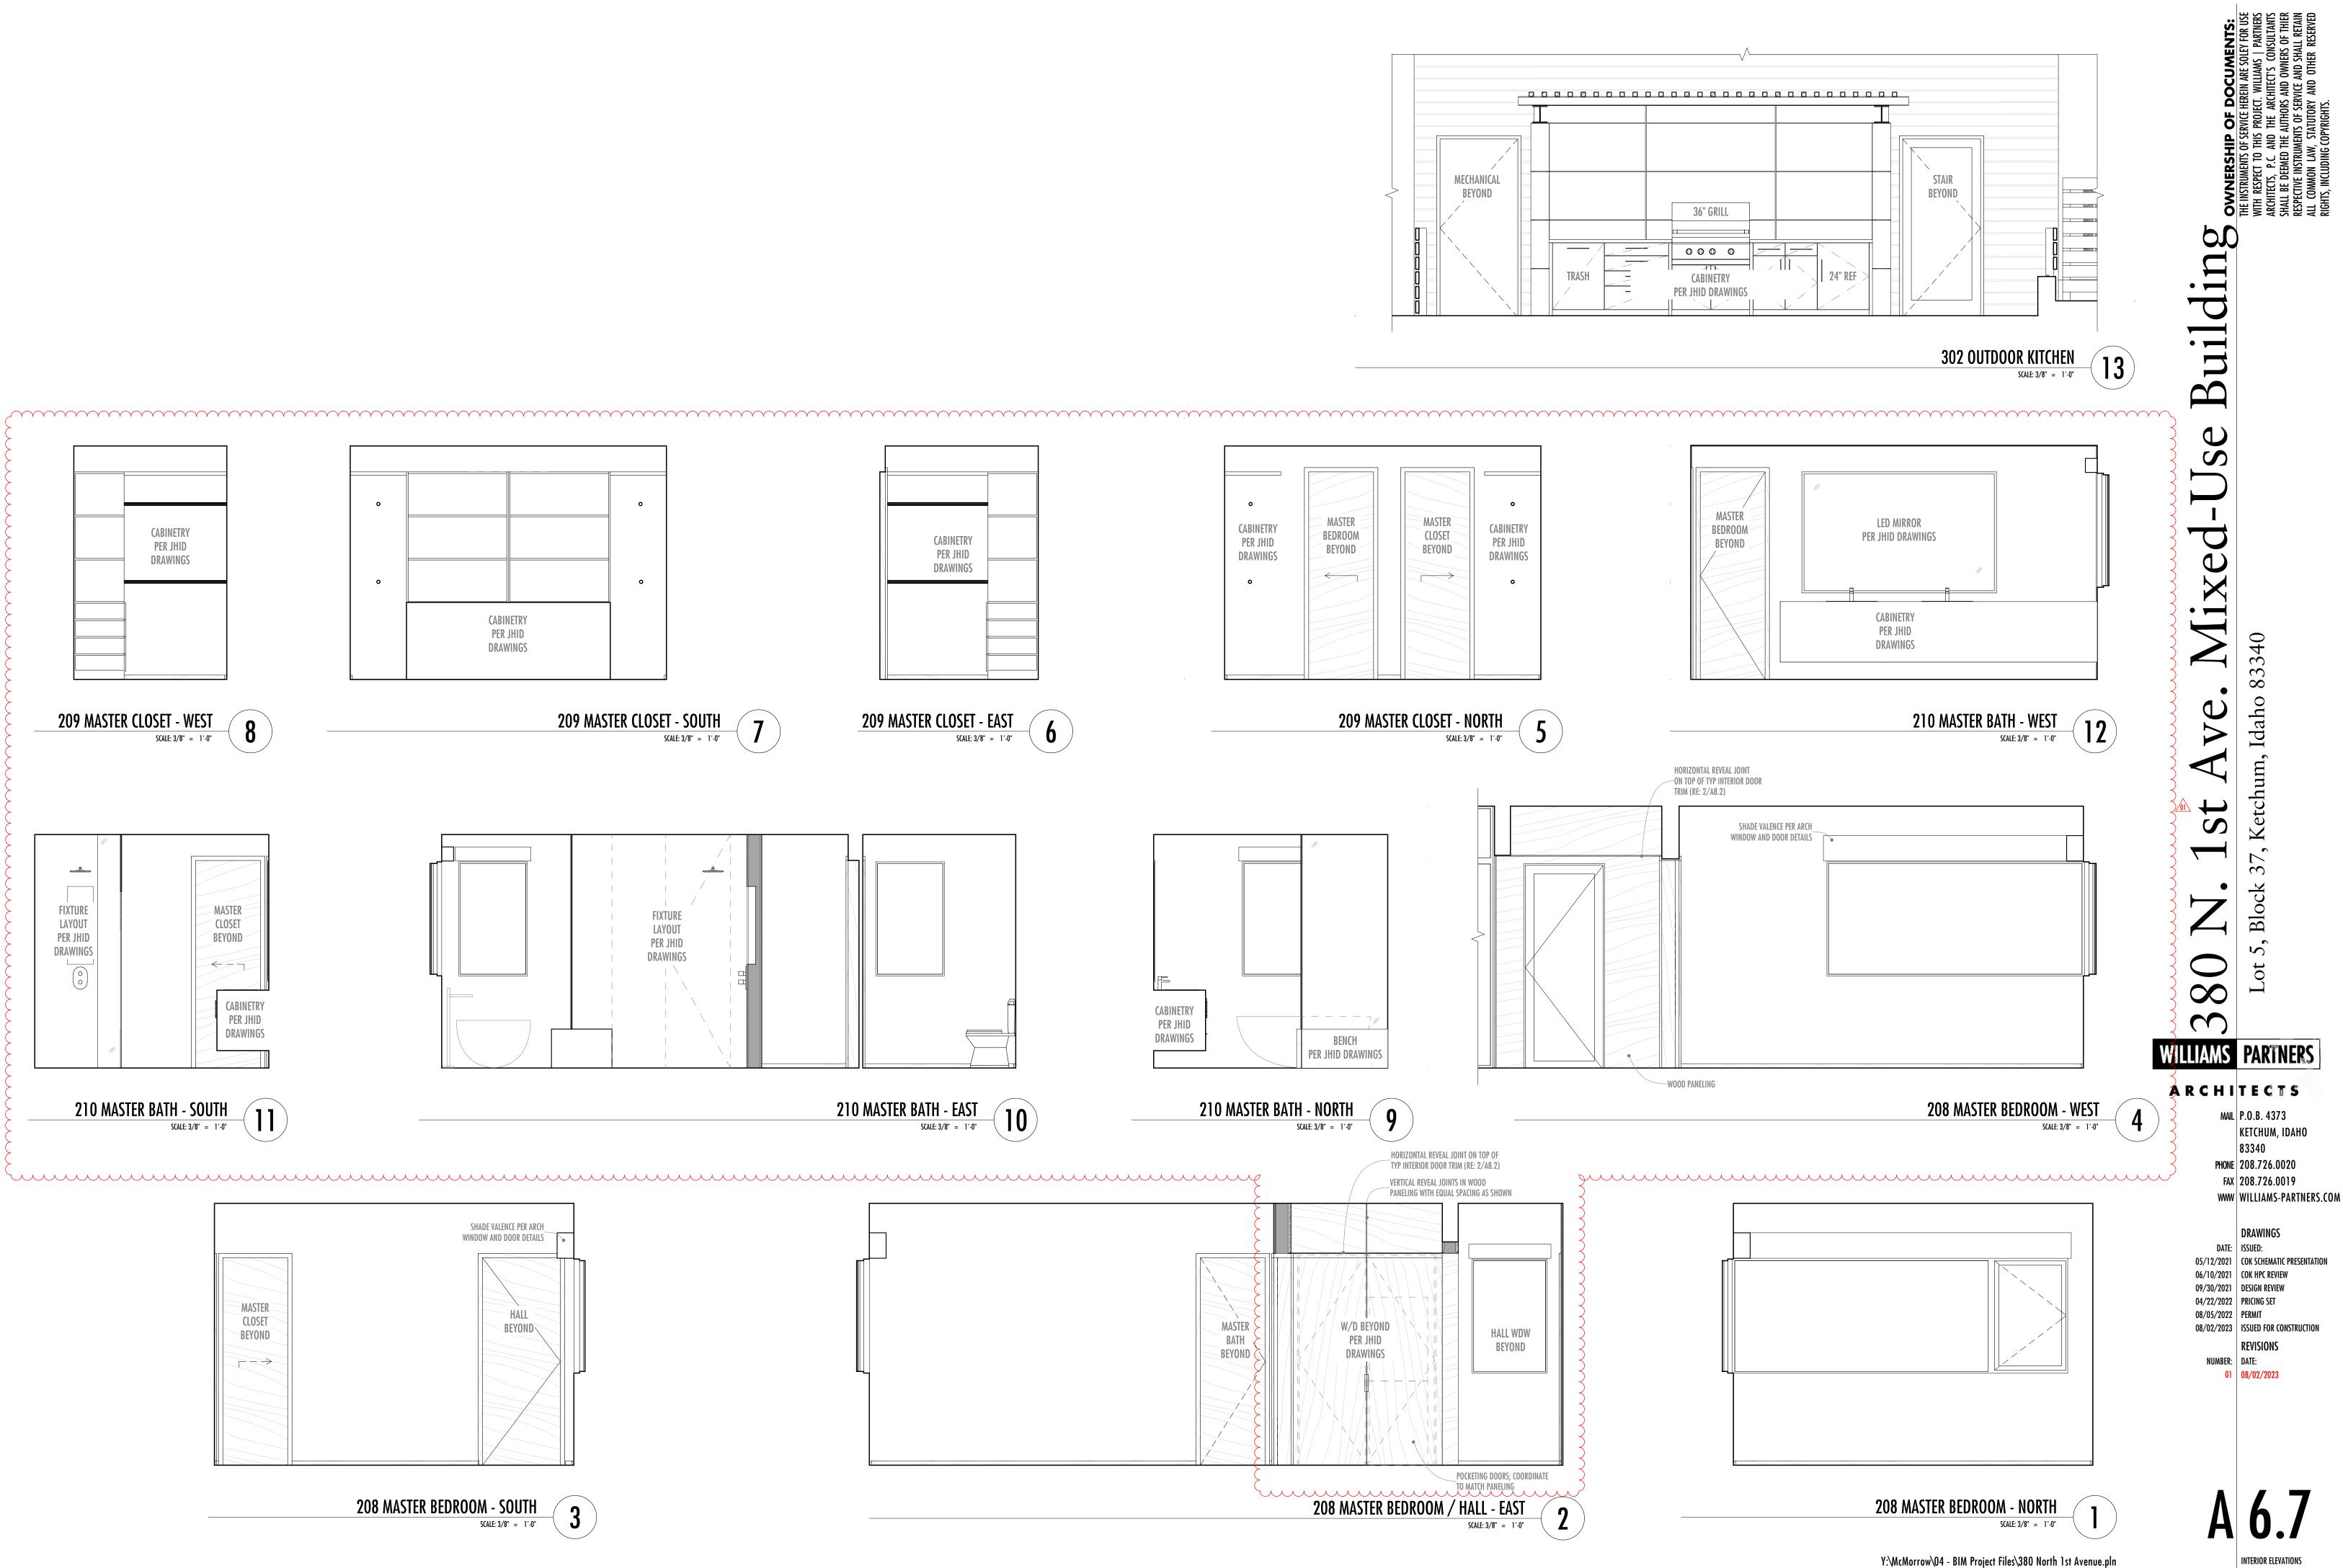


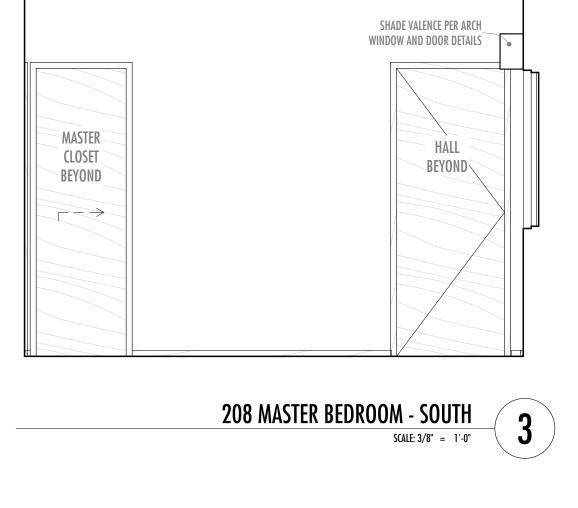

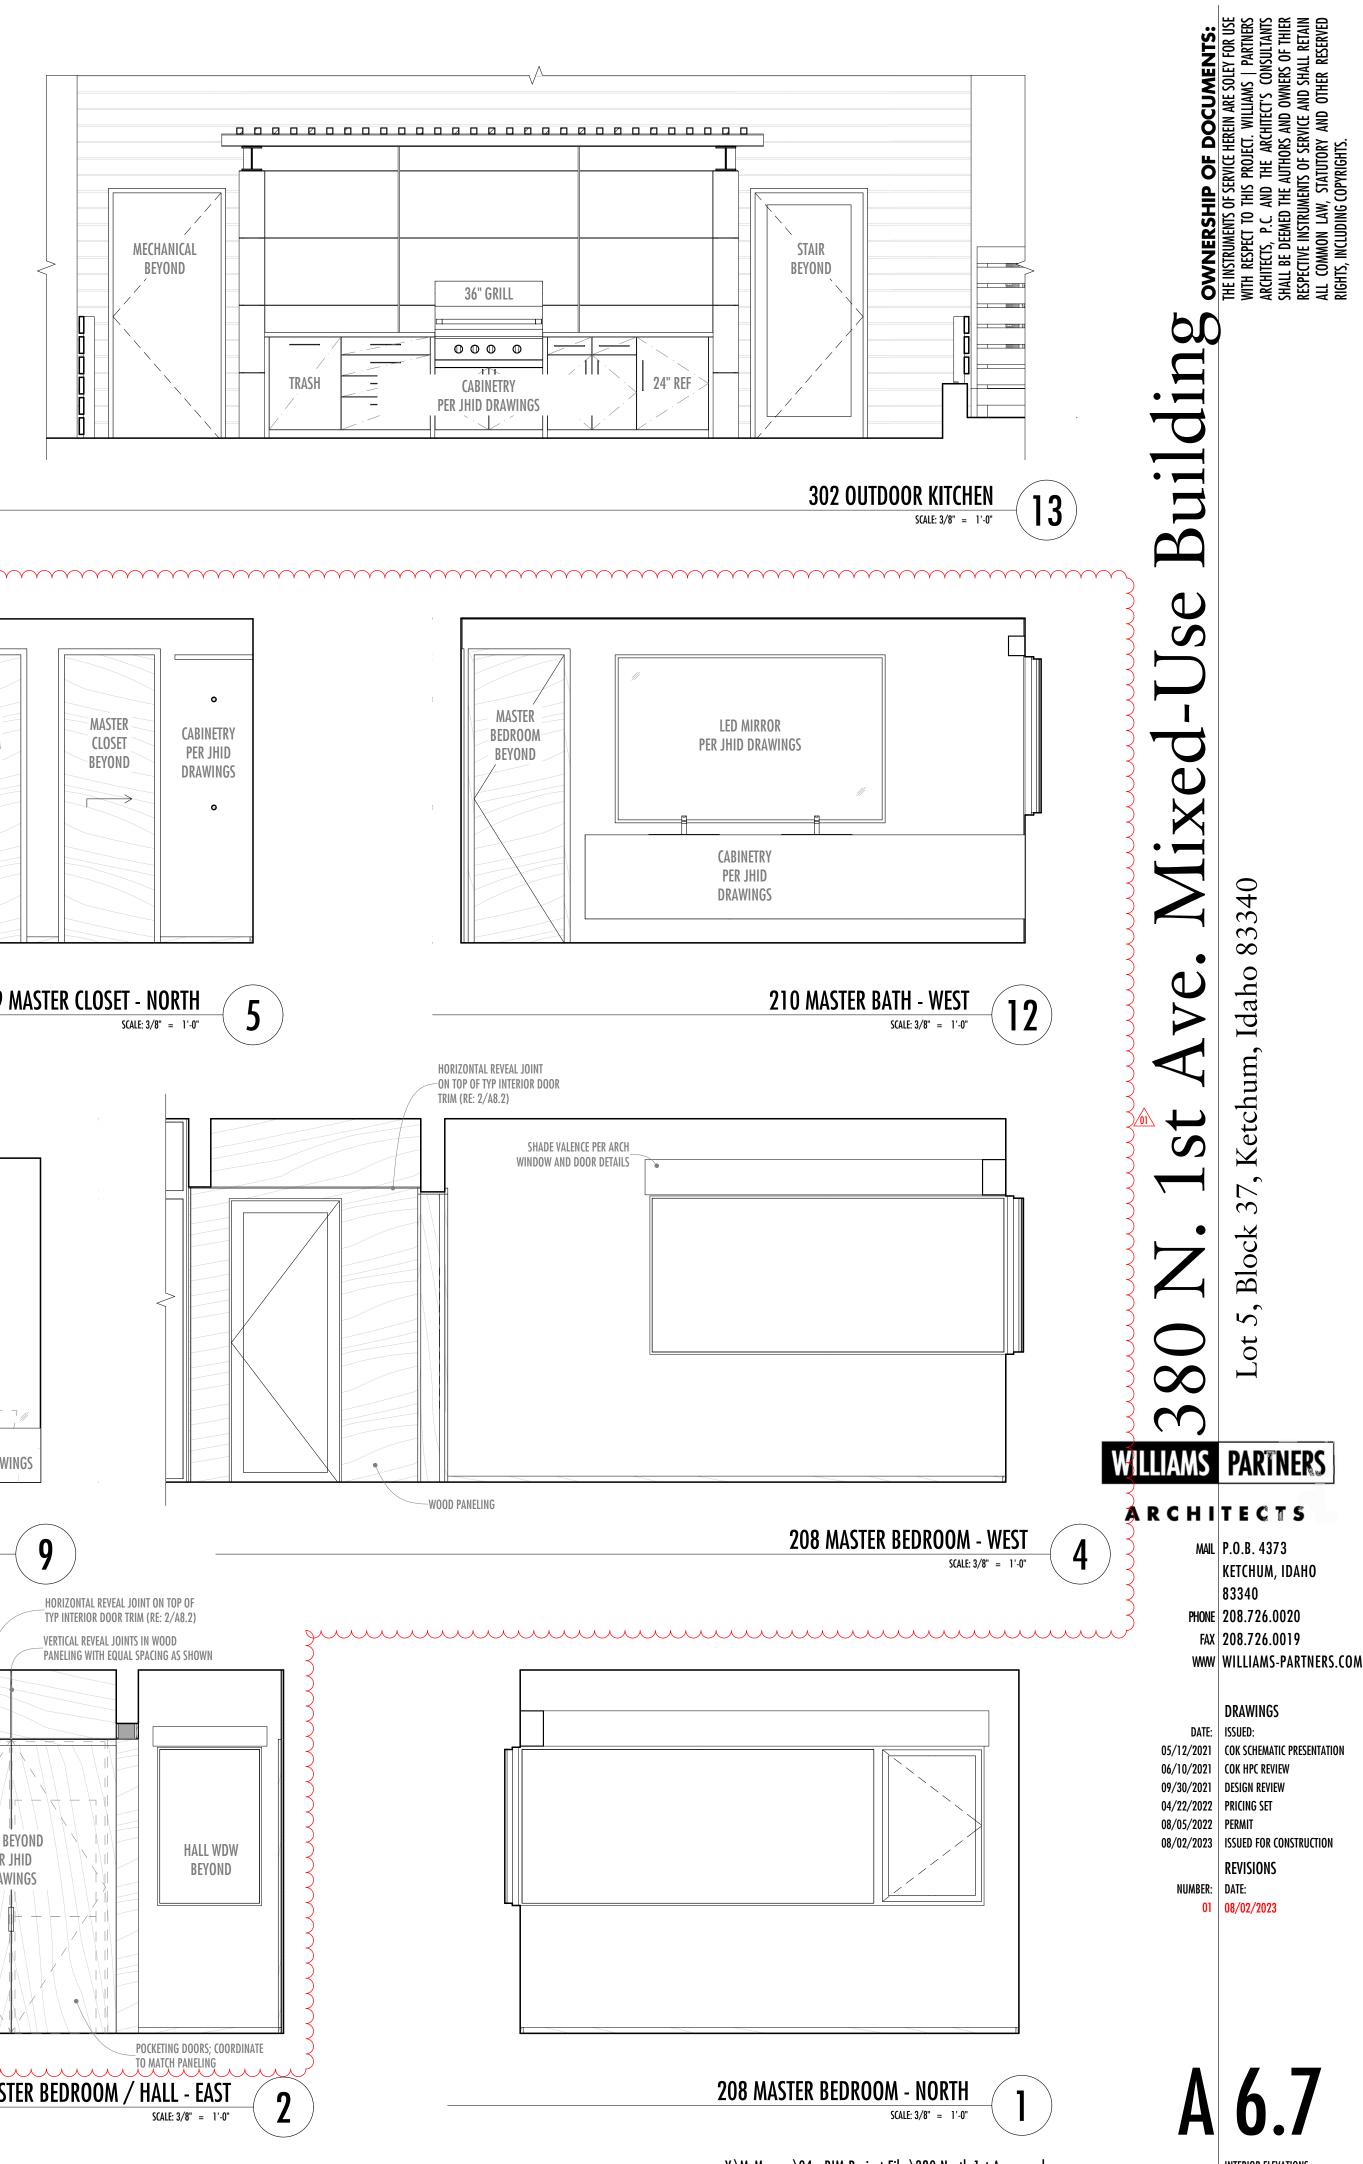

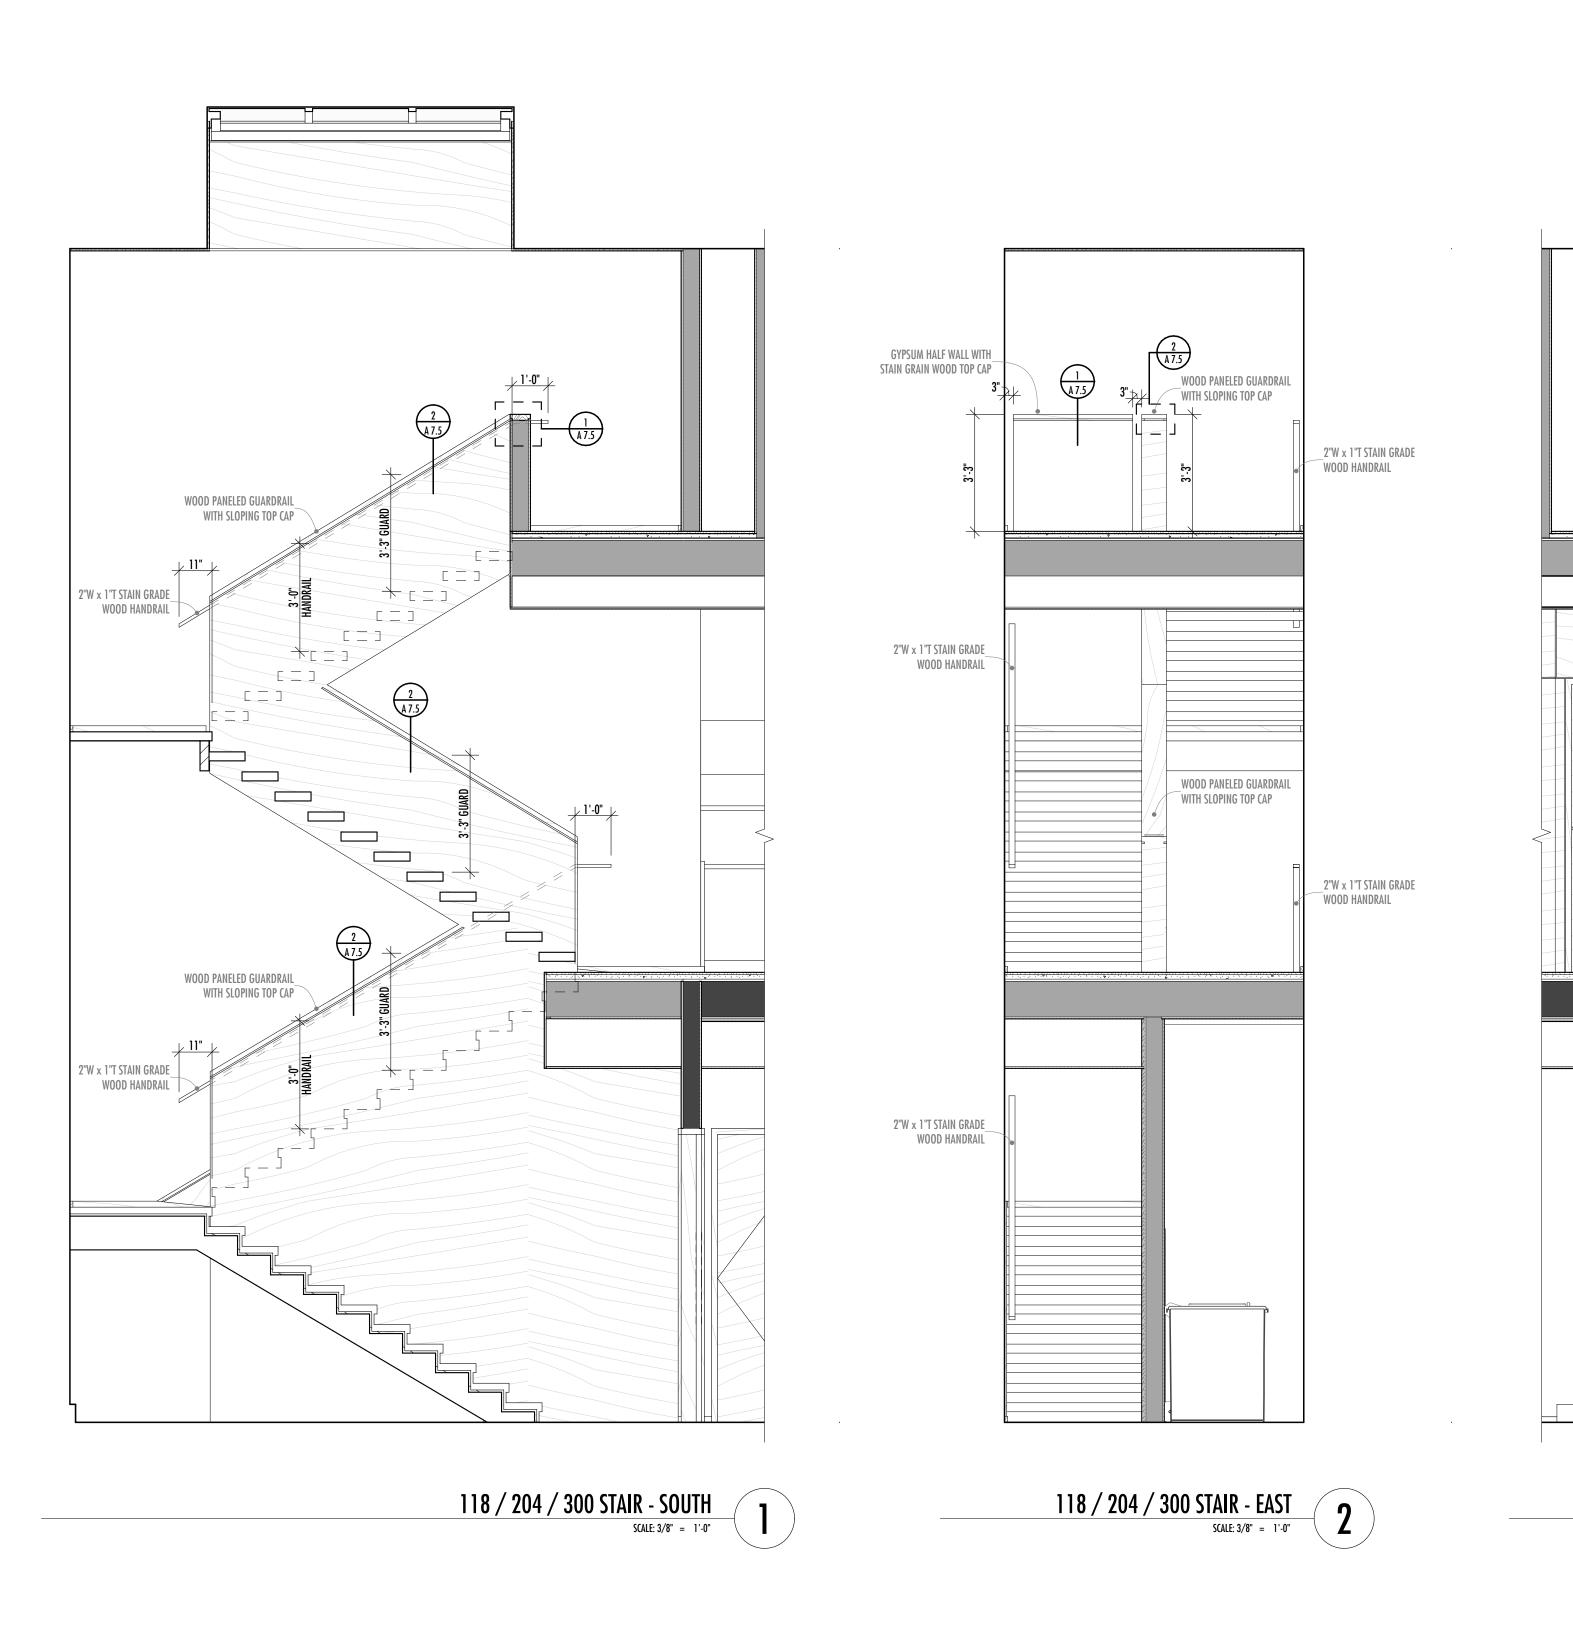

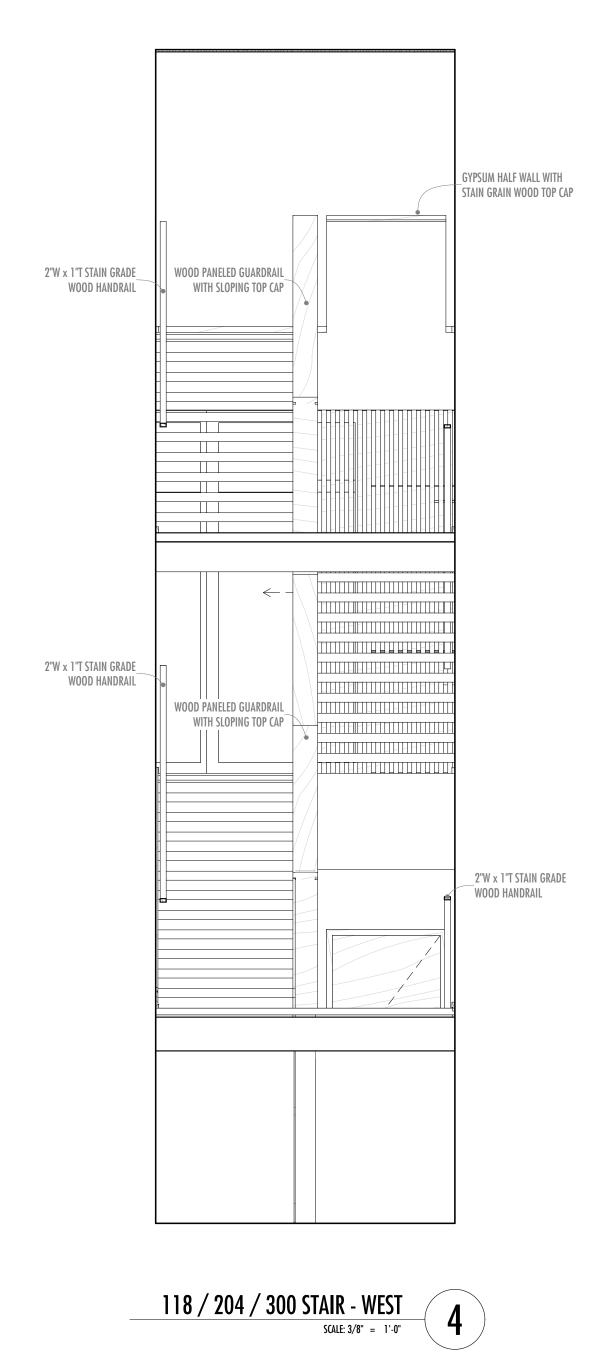

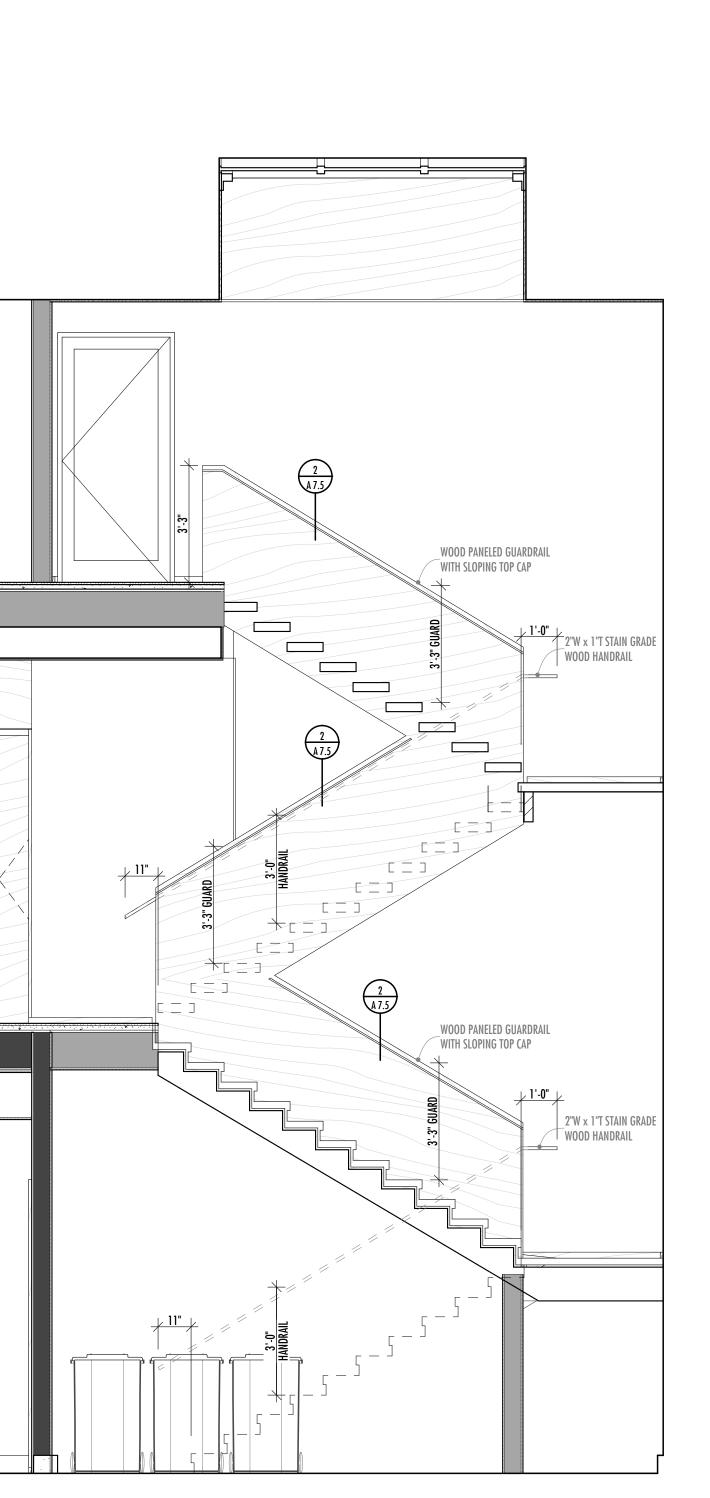


118 / 204 / 300 STAIR - NORTH SCALE: 3/8" = 1'-0" 3

Building Jse xed 340 83. Idah tch t $\mathbf{\mathcal{O}}$ Ke \sim Bloc 5, \bigcirc ,ot 38 Η WILLIAMS PARTNERS ARCHITECTS MAIL P.O.B. 4373 KETCHUM, IDAHO 83340 PHONE 208.726.0020 FAX 208.726.0019 WWW WILLIAMS-PARTNERS.COM DRAWINGS DATE: ISSUED: 05/12/2021 COK SCHEMATIC PRESENTATION 06/10/2021 COK HPC REVIEW 09/30/2021 DESIGN REVIEW 04/22/2022 PRICING SET 08/05/2022 PERMIT 08/02/2023 ISSUED FOR CONSTRUCTION REVISIONS NUMBER: DATE:



Y:\McMorrow\04 - BIM Project Files\380 North 1st Avenue.pln

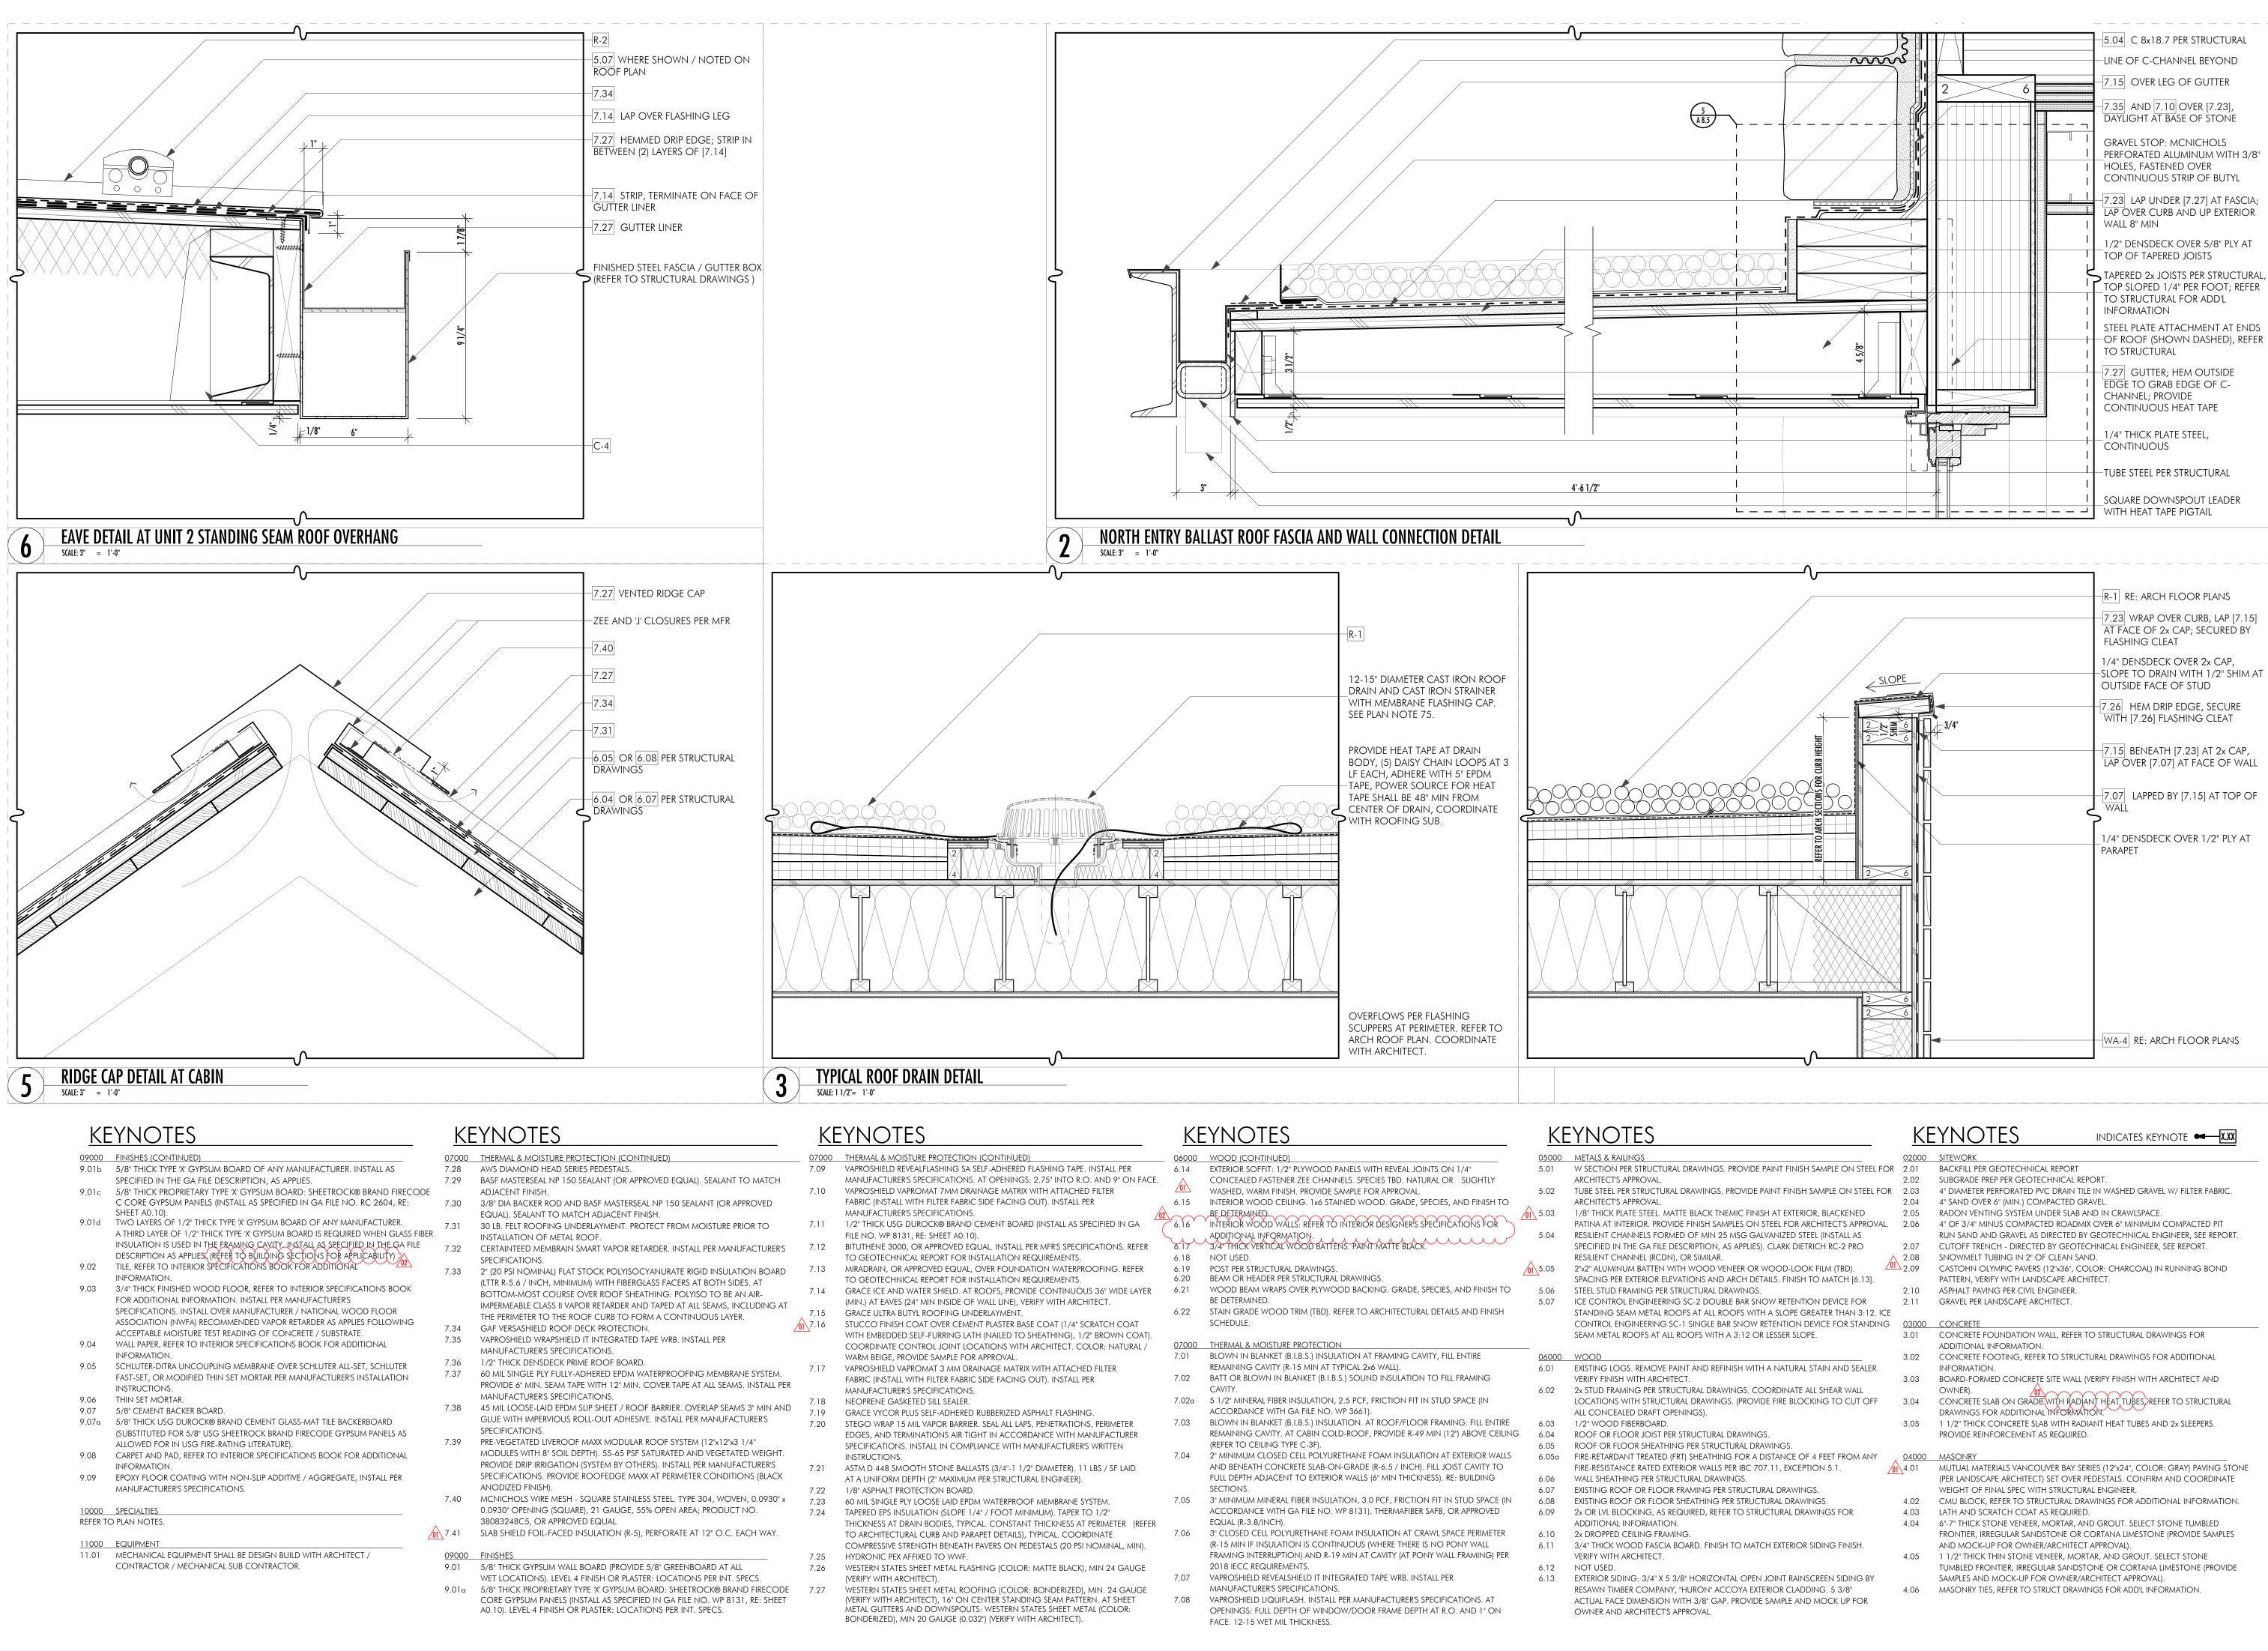


- LICENSE • ARCHITECT AR-1720 C 5 \Box D ∞ \frown WILLIAMS PARTNERS ARCHITECTS MAIL P.O.B. 4373 KETCHUM, IDAHO 83340
 - PHONE 208.726.0020 FAX 208.726.0019 WWW WILLIAMS-PARTNERS.COM

DRAWINGS DATE: ISSUED: 04/18/2022 | PRICING SET 08/05/2022 PERMIT

08/02/2023 ISSUED FOR CONSTRUCTION

REVISIONS NUMBER: DATE:

ARCHITECTURAL DETAILS

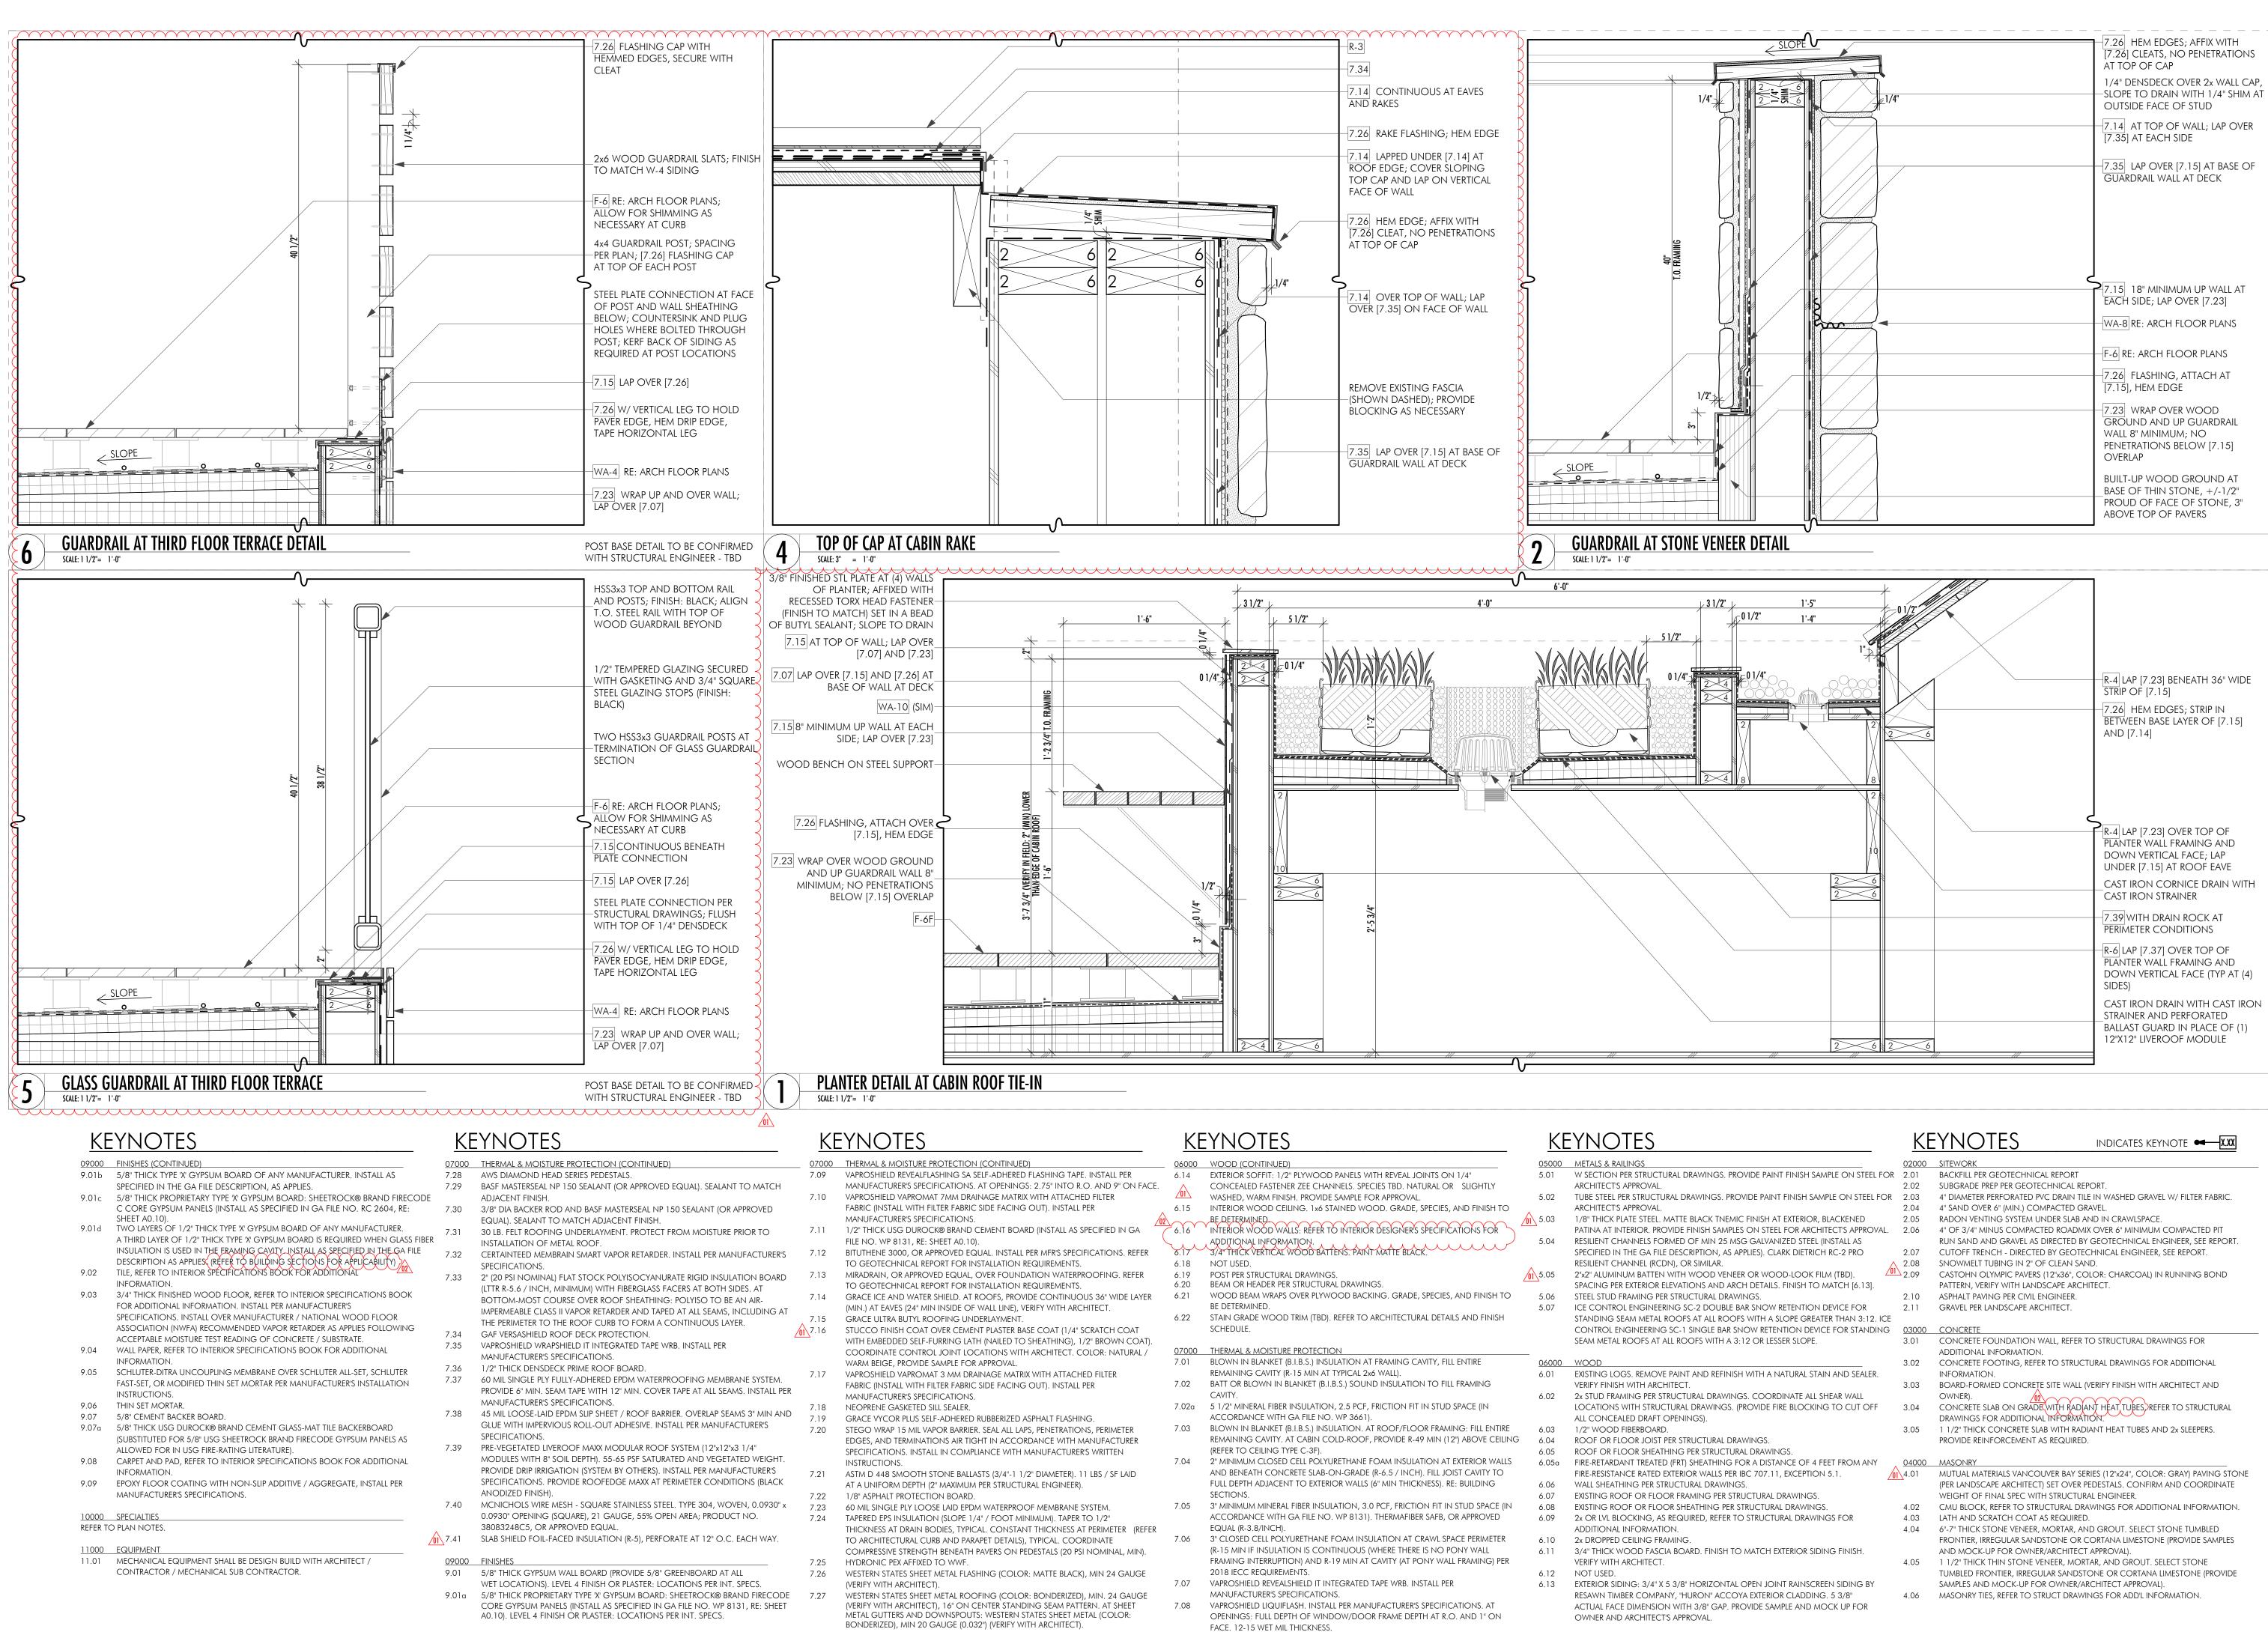

- FACE. 12-15 WET MIL THICKNESS.

CAST IRON CORNICE DRAIN WITH

DOWN VERTICAL FACE (TYP AT (4)

BALLAST GUARD IN PLACE OF (1)

 $\boldsymbol{\mathcal{O}}$ \sim $\boldsymbol{\alpha}$

•

LICENSE

ARCHITECT

AR-1720

WILLIAMS PARTNERS

 ∞

 \frown

ARCHITECTS

MAIL P.O.B. 4373 KETCHUM, IDAHO 83340 PHONE 208.726.0020 FAX 208.726.0019 WWW WILLIAMS-PARTNERS.COM


DRAWINGS DATE: ISSUED: 04/18/2022 | PRICING SET

08/05/2022 PERMIT

08/02/2023 ISSUED FOR CONSTRUCTION

REVISIONS NUMBER: DATE: 01 08/02/2023



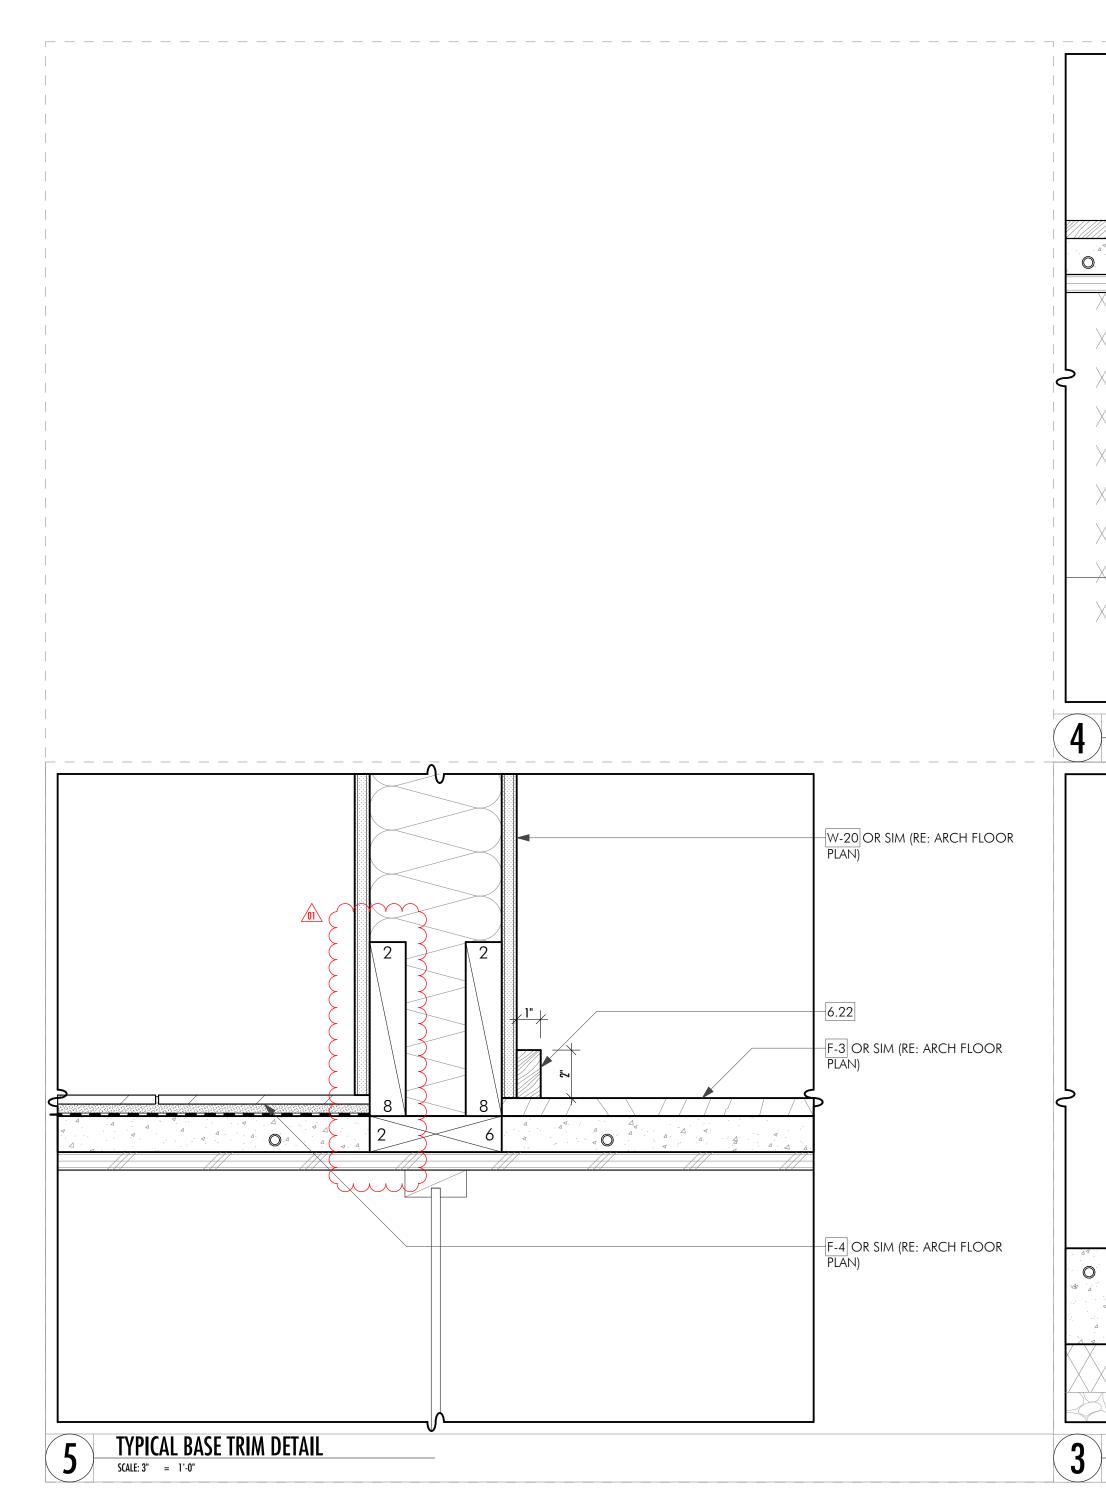


KEYNOTES

- 09000 FINISHES (CONTINUED) 9.01b 5/8" THICK TYPE 'X' GYPSUM BOARD OF ANY MANUFACTURER. INSTALL AS
- SPECIFIED IN THE GA FILE DESCRIPTION, AS APPLIES. 9.01c 5/8" THICK PROPRIETARY TYPE 'X' GYPSUM BOARD: SHEETROCK® BRAND FIRECODE C CORE GYPSUM PANELS (INSTALL AS SPECIFIED IN GA FILE NO. RC 2604, RE:
- SHEFT AO 10) 9.01d TWO LAYERS OF 1/2" THICK TYPE 'X' GYPSUM BOARD OF ANY MANUFACTURER. A THIRD LAYER OF 1/2" THICK TYPE 'X' GYPSUM BOARD IS REQUIRED WHEN GLASS FIBER INSULATION IS USED IN THE FRAMING CAVITY, INSTALL AS SPECIFIED IN THE GA FILE INSULATION IS USED IN THE LANGUAGE SECTIONS FOR APPLICABILITY TILE, REFER TO INTERIOR SPECIFICATIONS BOOK FOR ADDITIONAL 9.02
- INFORMATION. 3/4" THICK FINISHED WOOD FLOOR, REFER TO INTERIOR SPECIFICATIONS BOOK 9.03 FOR ADDITIONAL INFORMATION. INSTALL PER MANUFACTURER'S SPECIFICATIONS. INSTALL OVER MANUFACTURER / NATIONAL WOOD FLOOR ASSOCIATION (NWFA) RECOMMENDED VAPOR RETARDER AS APPLIES FOLLOWING
- ACCEPTABLE MOISTURE TEST READING OF CONCRETE / SUBSTRATE. 9.04 WALL PAPER, REFER TO INTERIOR SPECIFICATIONS BOOK FOR ADDITIONAL
- INFORMATION. 9.05 SCHLUTER-DITRA UNCOUPLING MEMBRANE OVER SCHLUTER ALL-SET, SCHLUTER FAST-SET, OR MODIFIED THIN SET MORTAR PER MANUFACTURER'S INSTALLATION INSTRUCTIONS.
- 9.06 THIN SET MORTAR.
- 5/8" CEMENT BACKER BOARD. 9.07 9.07a 5/8" THICK USG DUROCK® BRAND CEMENT GLASS-MAT TILE BACKERBOARD (SUBSTITUTED FOR 5/8" USG SHEETROCK BRAND FIRECODE GYPSUM PANELS AS ALLOWED FOR IN USG FIRE-RATING LITERATURE).
- CARPET AND PAD, REFER TO INTERIOR SPECIFICATIONS BOOK FOR ADDITIONAL 9.08 INFORMATION. 9.09 EPOXY FLOOR COATING WITH NON-SLIP ADDITIVE / AGGREGATE, INSTALL PER
- MANUFACTURER'S SPECIFICATIONS. 10000 SPECIALTIES
- REFER TO PLAN NOTES.
- 11000 EQUIPMENT 11.01 MECHANICAL EQUIPMENT SHALL BE DESIGN BUILD WITH ARCHITECT / CONTRACTOR / MECHANICAL SUB CONTRACTOR.


KEYNOTES

07000 THERMAL & MOISTURE PROTECTION (CONTINUED) 7.28 AWS DIAMOND HEAD SERIES PEDESTALS 7.29 BASF MASTERSEAL NP 150 SEALANT (OR APPROVED EQUAL). SEALANT TO MATCH 7.10 ADJACENT FINISH 7.30 3/8" DIA BACKER ROD AND BASF MASTERSEAL NP 150 SEALANT (OR APPROVED EQUAL). SEALANT TO MATCH ADJACENT FINISH. 7.11 7.31 30 LB. FELT ROOFING UNDERLAYMENT. PROTECT FROM MOISTURE PRIOR TO INSTALLATION OF METAL ROOF. 7.32 CERTAINTEED MEMBRAIN SMART VAPOR RETARDER, INSTALL PER MANUFACTURER'S 7.12 SPECIFICATIONS 7.33 2" (20 PSI NOMINAL) FLAT STOCK POLYISOCYANURATE RIGID INSULATION BOARD 7.13 (LTTR R-5.6 / INCH, MINIMUM) WITH FIBERGLASS FACERS AT BOTH SIDES. AT 7.14 BOTTOM-MOST COURSE OVER ROOF SHEATHING: POLYISO TO BE AN AIR-IMPERMEABLE CLASS II VAPOR RETARDER AND TAPED AT ALL SEAMS, INCLUDING AT 7 1 5 THE PERIMETER TO THE ROOF CURB TO FORM A CONTINUOUS LAYER. 7.16 7.34 GAF VERSASHIELD ROOF DECK PROTECTION. 7.35 VAPROSHIELD WRAPSHIELD IT INTEGRATED TAPE WRB. INSTALL PER MANUFACTURER'S SPECIFICATIONS. 7.36 1/2" THICK DENSDECK PRIME ROOF BOARD. 7.17 7.37 60 MIL SINGLE PLY FULLY-ADHERED EPDM WATERPROOFING MEMBRANE SYSTEM. PROVIDE 6" MIN. SEAM TAPE WITH 12" MIN. COVER TAPE AT ALL SEAMS. INSTALL PER MANUFACTURER'S SPECIFICATIONS. 7.18 7.38 45 MIL LOOSE-LAID EPDM SLIP SHEET / ROOF BARRIER. OVERLAP SEAMS 3" MIN AND 7 1 9 GLUE WITH IMPERVIOUS ROLL-OUT ADHESIVE. INSTALL PER MANUFACTURER'S 7.20 SPECIFICATIONS. 7.39 PRE-VEGETATED LIVEROOF MAXX MODULAR ROOF SYSTEM (12"x12"x3 1/4" MODULES WITH 8" SOIL DEPTH). 55-65 PSF SATURATED AND VEGETATED WEIGHT PROVIDE DRIP IRRIGATION (SYSTEM BY OTHERS). INSTALL PER MANUFACTURER'S 7.21 SPECIFICATIONS. PROVIDE ROOFEDGE MAXX AT PERIMETER CONDITIONS (BLACK ANODIZED FINISH) 7.22 7.40 MCNICHOLS WIRE MESH - SQUARE STAINLESS STEEL. TYPE 304, WOVEN, 0.0930" x 7.23 0.0930" OPENING (SQUARE), 21 GAUGE, 55% OPEN AREA; PRODUCT NO. 7.24 38083248C5, OR APPROVED FQUAL 7.41 SLAB SHIELD FOIL-FACED INSULATION (R-5), PERFORATE AT 12" O.C. EACH WAY. 09000 FINISHES 7.25 9.01 5/8" THICK GYPSUM WALL BOARD (PROVIDE 5/8" GREENBOARD AT ALL 7.26 WET LOCATIONS). LEVEL 4 FINISH OR PLASTER: LOCATIONS PER INT. SPECS. 9.01a 5/8" THICK PROPRIETARY TYPE X' GYPSUM BOARD: SHEETROCK® BRAND FIRECODE 7.27 CORE GYPSUM PANELS (INSTALL AS SPECIFIED IN GA FILE NO. WP 8131, RE: SHEET

A0.10). LEVEL 4 FINISH OR PLASTER: LOCATIONS PER INT. SPECS.

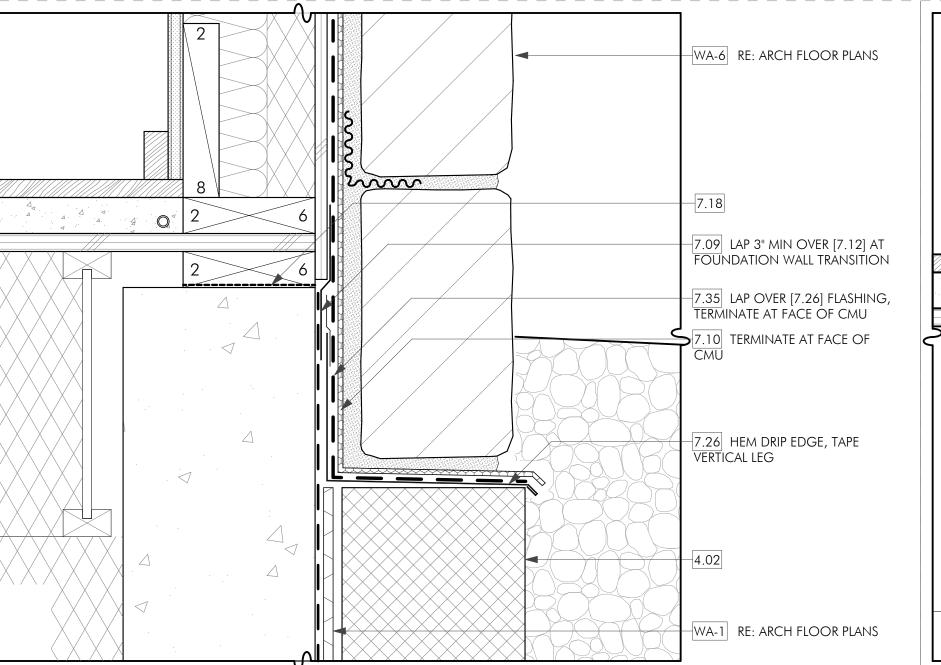

TYPICAL BASE OF WALL DETAIL AT STONE VENEER SCALE: 3" = 1'-0"

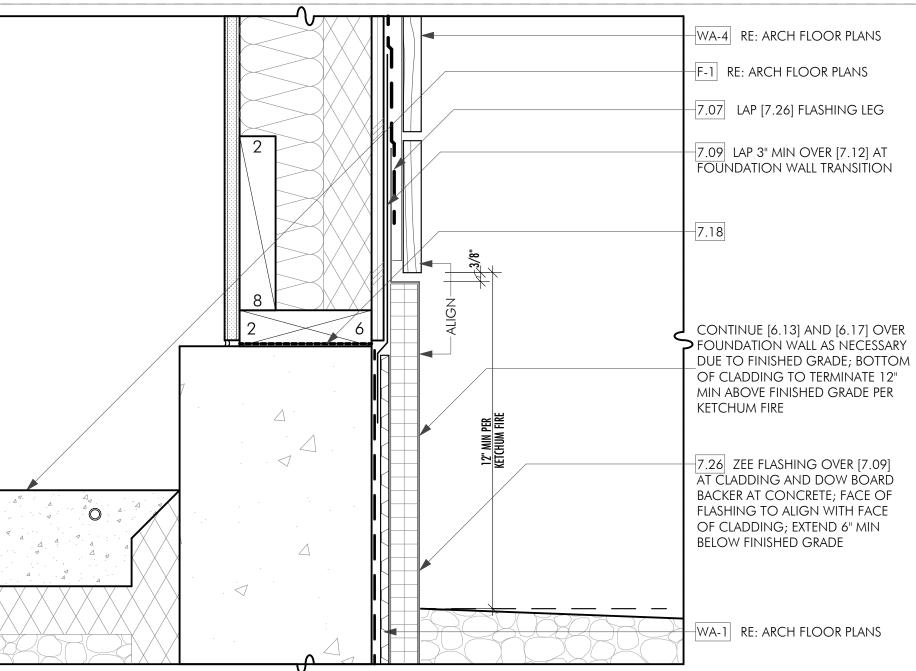


TYPICAL BASE OF WALL DETAIL AT RAINSCREEN SIDING SCALE: 3" = 1'-0"

KEYNOTES

- 07000 THERMAL & MOISTURE PROTECTION (CONTINUED)
- 7.09 VAPROSHIELD REVEALFLASHING SA SELF-ADHERED FLASHING TAPE. INSTALL PER MANUFACTURER'S SPECIFICATIONS. AT OPENINGS: 2.75" INTO R.O. AND 9" ON FACE.
 - VAPROSHIELD VAPROMAT 7MM DRAINAGE MATRIX WITH ATTACHED FILTER FABRIC (INSTALL WITH FILTER FABRIC SIDE FACING OUT). INSTALL PER
 - MANUFACTURER'S SPECIFICATIONS. 1/2" THICK USG DUROCK® BRAND CEMENT BOARD (INSTALL AS SPECIFIED IN GA
 - FILE NO. WP 8131, RE: SHEET A0.10). BITUTHENE 3000, OR APPROVED EQUAL. INSTALL PER MFR'S SPECIFICATIONS. REFER
 - TO GEOTECHNICAL REPORT FOR INSTALLATION REQUIREMENTS. MIRADRAIN, OR APPROVED EQUAL, OVER FOUNDATION WATERPROOFING. REFER TO GEOTECHNICAL REPORT FOR INSTALLATION REQUIREMENTS. GRACE ICE AND WATER SHIELD. AT ROOFS, PROVIDE CONTINUOUS 36" WIDE LAYER
 - (MIN.) AT EAVES (24" MIN INSIDE OF WALL LINE), VERIFY WITH ARCHITECT. GRACE ULTRA BUTYL ROOFING UNDERLAYMENT. STUCCO FINISH COAT OVER CEMENT PLASTER BASE COAT (1/4" SCRATCH COAT
 - WITH EMBEDDED SELF-FURRING LATH (NAILED TO SHEATHING), 1/2" BROWN COAT). COORDINATE CONTROL JOINT LOCATIONS WITH ARCHITECT. COLOR: NATURAL / WARM BEIGE, PROVIDE SAMPLE FOR APPROVAL VAPROSHIELD VAPROMAT 3 MM DRAINAGE MATRIX WITH ATTACHED FILTER
 - FABRIC (INSTALL WITH FILTER FABRIC SIDE FACING OUT). INSTALL PER MANUFACTURER'S SPECIFICATIONS.
 - NEOPRENE GASKETED SILL SEALER.
 - GRACE VYCOR PLUS SELF-ADHERED RUBBERIZED ASPHALT FLASHING. STEGO WRAP 15 MIL VAPOR BARRIER. SEAL ALL LAPS, PENETRATIONS, PERIMETER EDGES, AND TERMINATIONS AIR TIGHT IN ACCORDANCE WITH MANUFACTURER SPECIFICATIONS. INSTALL IN COMPLIANCE WITH MANUFACTURER'S WRITTEN INSTRUCTIONS.
 - ASTM D 448 SMOOTH STONE BALLASTS (3/4"-1 1/2" DIAMETER). 11 LBS / SF LAID AT A UNIFORM DEPTH (2" MAXIMUM PER STRUCTURAL ENGINEER).
 - 1/8" ASPHALT PROTECTION BOARD. 60 MIL SINGLE PLY LOOSE LAID EPDM WATERPROOF MEMBRANE SYSTEM.
 - TAPERED EPS INSULATION (SLOPE 1/4" / FOOT MINIMUM). TAPER TO 1/2" HICKNESS AT DRAIN BODIES, TYPICAL. CONSTANT THICKNESS AT PERIMETER (REFER
 - TO ARCHITECTURAL CURB AND PARAPET DETAILS), TYPICAL. COORDINATE COMPRESSIVE STRENGTH BENEATH PAVERS ON PEDESTALS (20 PSI NOMINAL, MIN). HYDRONIC PEX AFFIXED TO WWF.
 - WESTERN STATES SHEET METAL FLASHING (COLOR: MATTE BLACK), MIN 24 GAUGE (VERIFY WITH ARCHITECT).
 - WESTERN STATES SHEET METAL ROOFING (COLOR: BONDERIZED), MIN. 24 GAUGE (VERIFY WITH ARCHITECT), 16" ON CENTER STANDING SEAM PATTERN. AT SHEET METAL GUTTERS AND DOWNSPOUTS: WESTERN STATES SHEET METAL (COLOR: BONDERIZED), MIN 20 GAUGE (0.032") (VERIFY WITH ARCHITECT).

KEYNOTES

- 06000 WOOD (CONTINUED)
- 6.14 EXTERIOR SOFFIT: 1/2" PLYWOOD PANELS WITH REVEAL JOINTS ON 1/4"
- CONCEALED FASTENER ZEE CHANNELS. SPECIES TBD. NATURAL OR SLIGHTLY
- WASHED, WARM FINISH. PROVIDE SAMPLE FOR APPROVAL.
- 6.15 INTERIOR WOOD CEILING. 1x6 STAINED WOOD. GRADE, SPECIES, AND FINISH TO
- BE DETERMINED 😤 6.16 🎽 INTERIOR WOOD WALLS: RĚFER TÓ INTERIOR ĎESÍGNER'S SPEČIFIČATIONS FOR ADDITIONAL INFORMATION.
- 6.17 3/4" THICK VERTICAL WOOD BATTENS. PAINT MATTE BLACK. 6.18 NOT USED.
- 6.19 POST PER STRUCTURAL DRAWINGS. 6.20 BEAM OR HEADER PER STRUCTURAL DRAWINGS. WOOD BEAM WRAPS OVER PLYWOOD BACKING. GRADE, SPECIES, AND FINISH TO 6.21
- BE DETERMINED 6.22 STAIN GRADE WOOD TRIM (TBD). REFER TO ARCHITECTURAL DETAILS AND FINISH
- SCHEDULE
- 07000 THERMAL & MOISTURE PROTECTION BLOWN IN BLANKET (B.I.B.S.) INSULATION AT FRAMING CAVITY, FILL ENTIRE 7.01 REMAINING CAVITY (R-15 MIN AT TYPICAL 2x6 WALL). 7.02 BATT OR BLOWN IN BLANKET (B.I.B.S.) SOUND INSULATION TO FILL FRAMING
- CAVITY 7.02a 5 1/2" MINERAL FIBER INSULATION, 2.5 PCF, FRICTION FIT IN STUD SPACE (IN
- ACCORDANCE WITH GA FILE NO. WP 3661). 7.03 BLOWN IN BLANKET (B.I.B.S.) INSULATION. AT ROOF/FLOOR FRAMING: FILL ENTIRE
- REMAINING CAVITY. AT CABIN COLD-ROOF, PROVIDE R-49 MIN (12") ABOVE CEILING (REFER TO CEILING TYPE C-3F). 7.04 2" MINIMUM CLOSED CELL POLYURETHANE FOAM INSULATION AT EXTERIOR WALLS AND BENEATH CONCRETE SLAB-ON-GRADE (R-6.5 / INCH). FILL JOIST CAVITY TO FULL DEPTH ADJACENT TO EXTERIOR WALLS (6" MIN THICKNESS). RE: BUILDING
- SECTIONS. 7.05 3" MINIMUM MINERAL FIBER INSULATION, 3.0 PCF, FRICTION FIT IN STUD SPACE (IN ACCORDANCE WITH GA FILE NO. WP 8131). THERMAFIBER SAFB, OR APPROVED
- EQUAL (R-3.8/INCH). 7.06 3" CLOSED CELL POLYURETHANE FOAM INSULATION AT CRAWL SPACE PERIMETER (R-15 MIN IF INSULATION IS CONTINUOUS (WHERE THERE IS NO PONY WALL
- FRAMING INTERRUPTION) AND R-19 MIN AT CAVITY (AT PONY WALL FRAMING) PER 2018 IECC REQUIREMENTS. VAPROSHIELD REVEALSHIELD IT INTEGRATED TAPE WRB. INSTALL PER 7.07
- MANUFACTURER'S SPECIFICATIONS. 7.08
- VAPROSHIELD LIQUIFLASH. INSTALL PER MANUFACTURER'S SPECIFICATIONS. AT OPENINGS: FULL DEPTH OF WINDOW/DOOR FRAME DEPTH AT R.O. AND 1" ON FACE. 12-15 WET MIL THICKNESS.

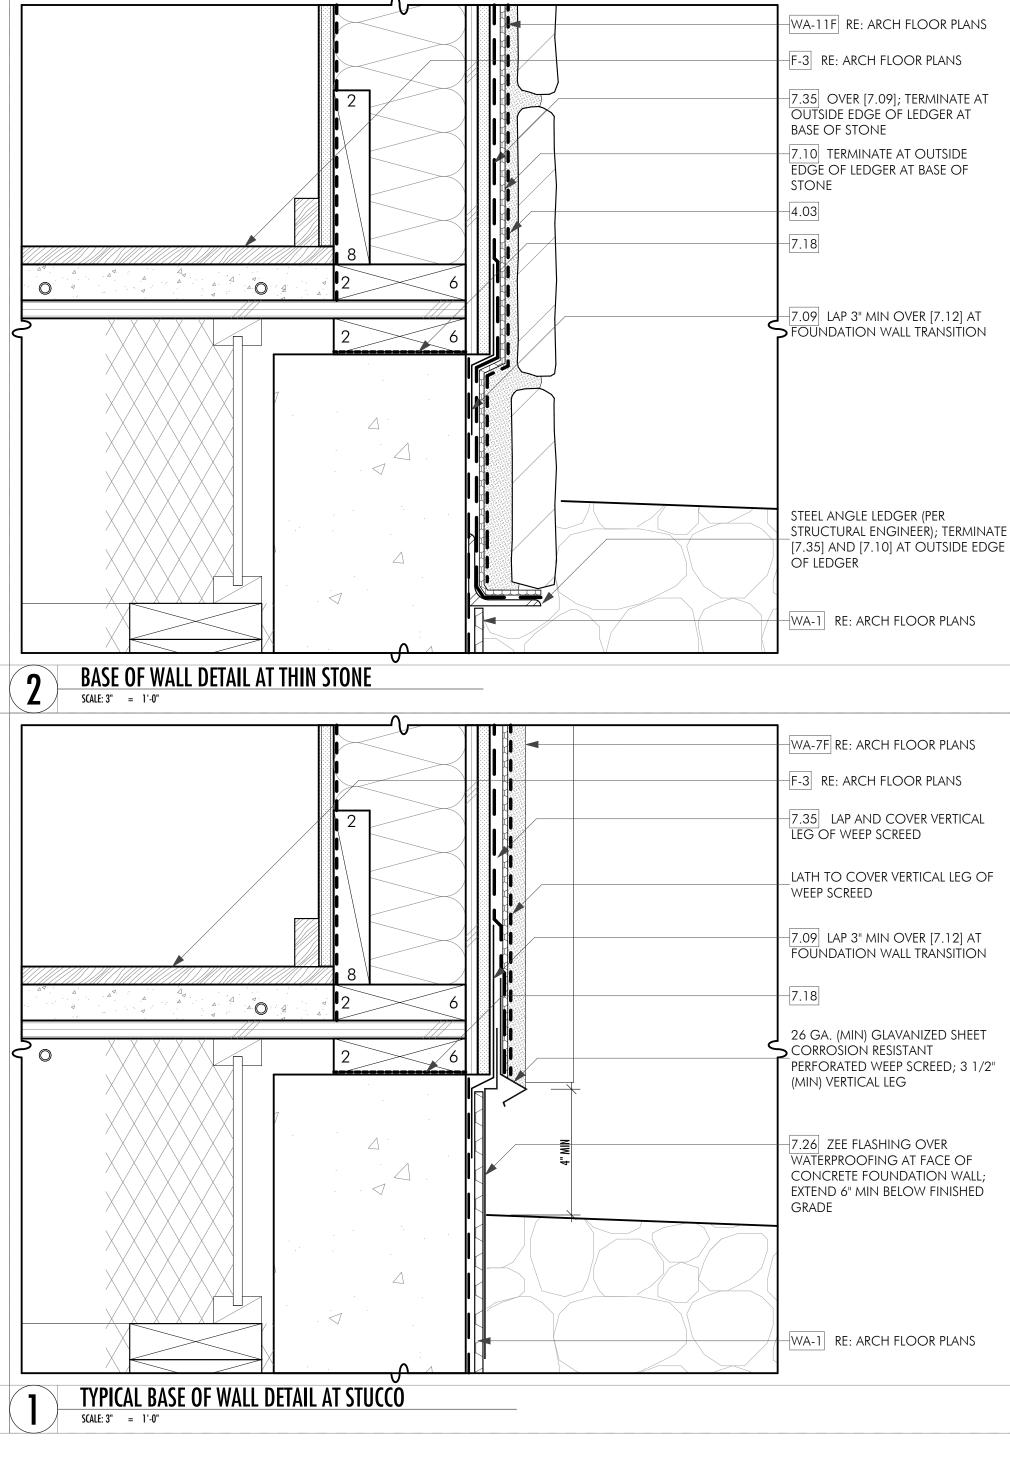

KEYNOTES

- 05000 METALS & RAILINGS 5.01 W SECTION PER STRUCTURAL DRAWINGS. PR ARCHITECT'S APPROVAL. 5.02 TUBE STEEL PER STRUCTURAL DRAWINGS. PR ARCHITECT'S APPROVAL. **01** 5.03 1/8" THICK PLATE STEEL. MATTE BLACK TNEM PATINA AT INTERIOR. PROVIDE FINISH SAMPLI RESILIENT CHANNELS FORMED OF MIN 25 M SPECIFIED IN THE GA FILE DESCRIPTION, AS RESILIENT CHANNEL (RCDN), OR SIMILAR. 2"x2" ALUMINUM BATTEN WITH WOOD VENE
- SPACING PER EXTERIOR ELEVATIONS AND AR 5.06 STEEL STUD FRAMING PER STRUCTURAL DRAV 5.07 ICE CONTROL ENGINEERING SC-2 DOUBLE STANDING SEAM METAL ROOFS AT ALL ROO CONTROL ENGINEERING SC-1 SINGLE BAR S SEAM METAL ROOFS AT ALL ROOFS WITH A

06000 WOOD

5.04

- 6.01 EXISTING LOGS. REMOVE PAINT AND REFINISH VERIFY FINISH WITH ARCHITECT 6.02 2x STUD FRAMING PER STRUCTURAL DRAWIN LOCATIONS WITH STRUCTURAL DRAWINGS. ALL CONCEALED DRAFT OPENINGS). 6.03 1/2" WOOD FIBERBOARD. 6.04 ROOF OR FLOOR JOIST PER STRUCTURAL DRA
- ROOF OR FLOOR SHEATHING PER STRUCTUR 6.05 6.05α FIRE-RETARDANT TREATED (FRT) SHEATHING FIRE-RESISTANCE RATED EXTERIOR WALLS PER
- 6.06 WALL SHEATHING PER STRUCTURAL DRAWING EXISTING ROOF OR FLOOR FRAMING PER ST 6.07
- 6.08 EXISTING ROOF OR FLOOR SHEATHING PER 6.09 2x OR LVL BLOCKING, AS REQUIRED, REFER
- ADDITIONAL INFORMATION. 6.10 2x DROPPED CEILING FRAMING
- 6.11 3/4" THICK WOOD FASCIA BOARD. FINISH TO VERIFY WITH ARCHITECT.
- 6.12 NOT USED. 6.13 EXTERIOR SIDING: 3/4" X 5 3/8" HORIZONTAL RESAWN TIMBER COMPANY, "HURON" ACCC ACTUAL FACE DIMENSION WITH 3/8" GAP. P OWNER AND ARCHITECT'S APPROVAL.

	k
	0200
ROVIDE PAINT FINISH SAMPLE ON STEEL FOR	2.01
	2.02
OVIDE PAINT FINISH SAMPLE ON STEEL FOR	2.03
	2.04
AIC FINISH AT EXTERIOR, BLACKENED	2.05
LES ON STEEL FOR ARCHITECT'S APPROVAL.	2.06
ASG GALVANIZED STEEL (INSTALL AS	
APPLIES). CLARK DIETRICH RC-2 PRO	2.07
	2.08
EER OR WOOD-LOOK FILM (TBD).	2.09
RCH DETAILS. FINISH TO MATCH [6.13].	
WINGS.	2.10
BAR SNOW RETENTION DEVICE FOR	2.11
DFS WITH A SLOPE GREATER THAN 3:12. ICE	
	0300
3:12 OR LESSER SLOPE.	3.01
	3.02
SH WITH A NATURAL STAIN AND SEALER.	~ ~ ~
	3.03
NGS. COORDINATE ALL SHEAR WALL (PROVIDE FIRE BLOCKING TO CUT OFF	2 04
PROVIDE FIRE BLOCKING TO CUT OFF	3.04
	3.05
rawings.	0.00
JRAL DRAWINGS.	
FOR A DISTANCE OF 4 FEET FROM ANY	040
R IBC 707.11, EXCEPTION 5.1.	4.01
IGS.	1.01
TRUCTURAL DRAWINGS.	
STRUCTURAL DRAWINGS.	4.02
TO STRUCTURAL DRAWINGS FOR	4.03
	4.04
O MATCH EXTERIOR SIDING FINISH.	
	4.05
AL OPEN JOINT RAINSCREEN SIDING BY	
OYA EXTERIOR CLADDING. 5 3/8"	4.06
PROVIDE SAMPLE AND MOCK UP FOR	

KEYNOTES 000 SITEWORK

- BACKFILL PER GEOTECHNICAL REPORT
- SUBGRADE PREP PER GEOTECHNICAL REPORT.
- 4" DIAMETER PERFORATED PVC DRAIN TILE IN WASHED GRAVEL W/ FILTER FABRIC. 4" SAND OVER 6" (MIN.) COMPACTED GRAVEL.
- RADON VENTING SYSTEM UNDER SLAB AND IN CRAWLSPACE.
- 4" OF 3/4" MINUS COMPACTED ROADMIX OVER 6" MINIMUM COMPACTED PIT RUN SAND AND GRAVEL AS DIRECTED BY GEOTECHNICAL ENGINEER, SEE REPORT.

INDICATES KEYNOTE 🛋 🛛 🗶

- 07 CUTOFF TRENCH DIRECTED BY GEOTECHNICAL ENGINEER, SEE REPORT. SNOWMELT TUBING IN 2" OF CLEAN SAND.
- CASTOHN OLYMPIC PAVERS (12"x36", COLOR: CHARCOAL) IN RUNNING BOND PATTERN, VERIFY WITH LANDSCAPE ARCHITECT. ASPHALT PAVING PER CIVIL ENGINEER.
- GRAVEL PER LANDSCAPE ARCHITECT.
- 000 CONCRETE 01 CONCRETE FOUNDATION WALL, REFER TO STRUCTURAL DRAWINGS FOR
- ADDITIONAL INFORMATION. 02 CONCRETE FOOTING, REFER TO STRUCTURAL DRAWINGS FOR ADDITIONAL
- INFORMATION 03 BOARD-FORMED CONCRETE SITE WALL (VERIFY FINISH WITH ARCHITECT AND OWNER).
- 04 CONCRETE SLAB ON GRADE WITH RADIANT HEAT TUBES REFER TO STRUCTURAL DRAWINGS FOR ADDITIONAL INFORMATION.
- 1 1/2" THICK CONCRETE SLAB WITH RADIANT HEAT TUBES AND 2x SLEEPERS. PROVIDE REINFORCEMENT AS REQUIRED.


000 MASONRY


- 01 MUTUAL MATERIALS VANCOUVER BAY SERIES (12"x24", COLOR: GRAY) PAVING STONE (PER LANDSCAPE ARCHITECT) SET OVER PEDESTALS. CONFIRM AND COORDINATE WEIGHT OF FINAL SPEC WITH STRUCTURAL ENGINEER. CMU BLOCK, REFER TO STRUCTURAL DRAWINGS FOR ADDITIONAL INFORMATION.
- LATH AND SCRATCH COAT AS REQUIRED. 6"-7" THICK STONE VENEER, MORTAR, AND GROUT. SELECT STONE TUMBLED
- FRONTIER, IRREGULAR SANDSTONE OR CORTANA LIMESTONE (PROVIDE SAMPLES AND MOCK-UP FOR OWNER/ARCHITECT APPROVAL). 1 1/2" THICK THIN STONE VENEER, MORTAR, AND GROUT. SELECT STONE
- TUMBLED FRONTIER, IRREGULAR SANDSTONE OR CORTANA LIMESTONE (PROVIDE SAMPLES AND MOCK-UP FOR OWNER/ARCHITECT APPROVAL). MASONRY TIES, REFER TO STRUCT DRAWINGS FOR ADD'L INFORMATION.


- LICENSE • ARCHITECT AR-1720 liu \mathbf{O} \sim \propto U \sim ∞ ()WILLIAMS PARTNERS ARCHITECTS MAIL P.O.B. 4373
 - KETCHUM, IDAHO 83340 PHONE 208.726.0020 FAX 208.726.0019 WWW WILLIAMS-PARTNERS.COM
 - DRAWINGS DATE: ISSUED: 04/18/2022 | PRICING SET 08/05/2022 PERMIT
 - 08/02/2023 ISSUED FOR CONSTRUCTION


REVISIONS NUMBER: DATE: 01 08/02/2023

ARCHITECTURAL DETAILS

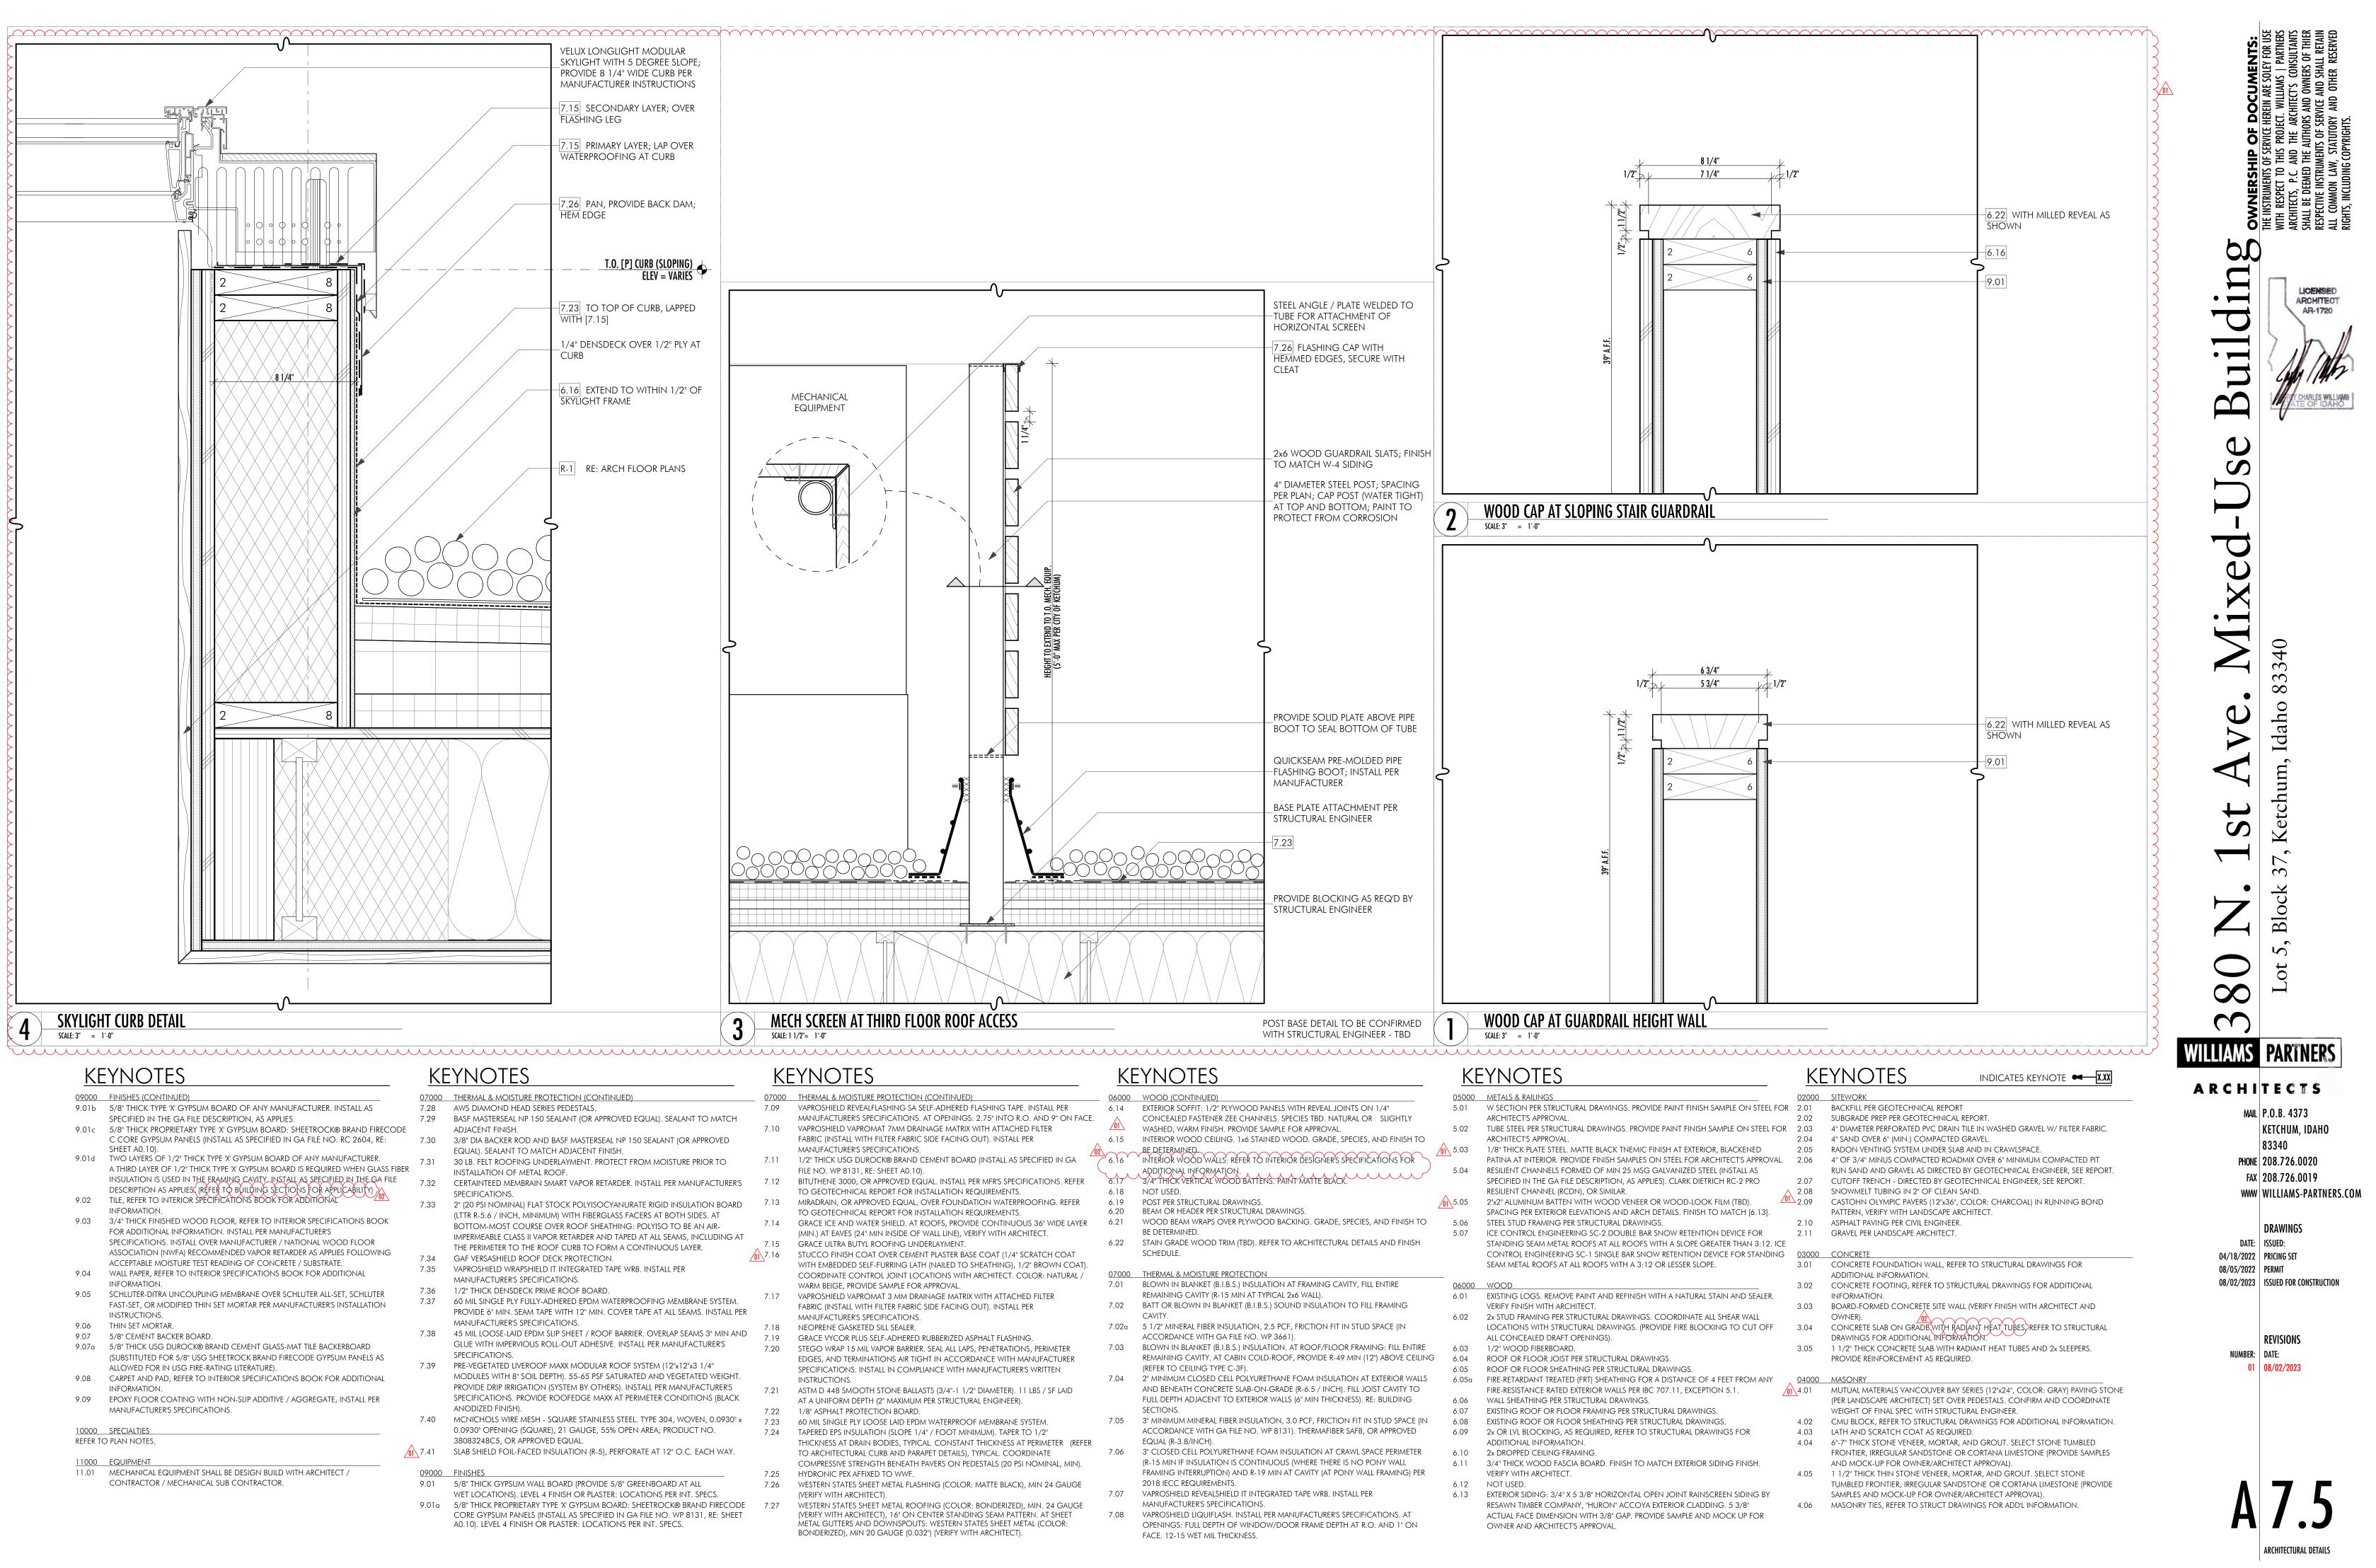

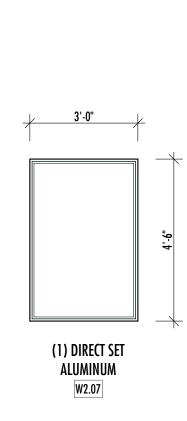


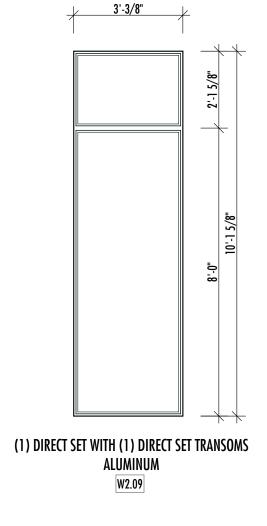


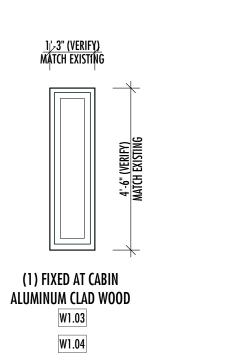



W1.03


W1.04

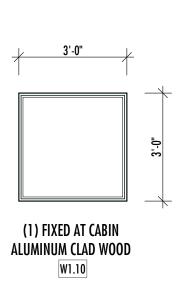


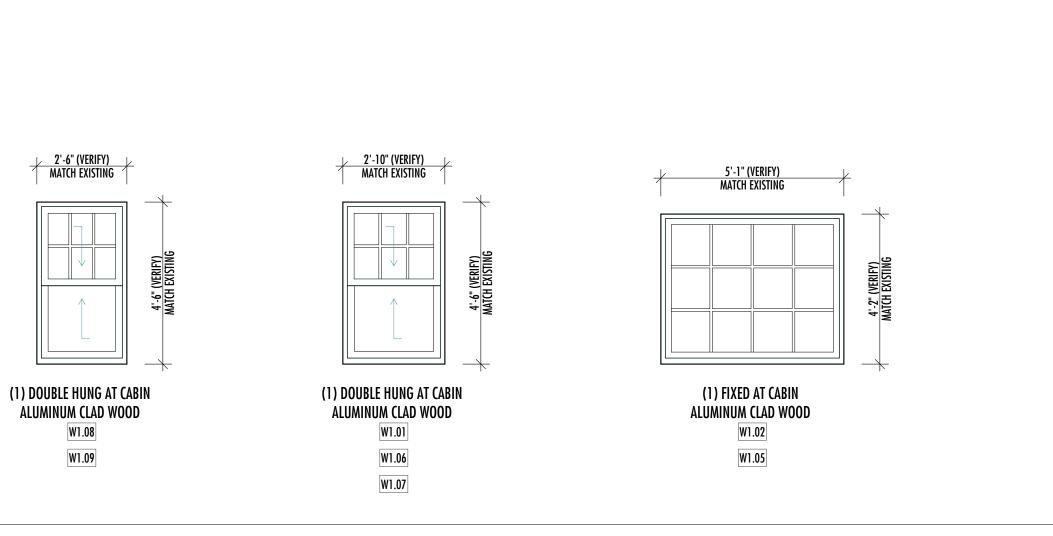

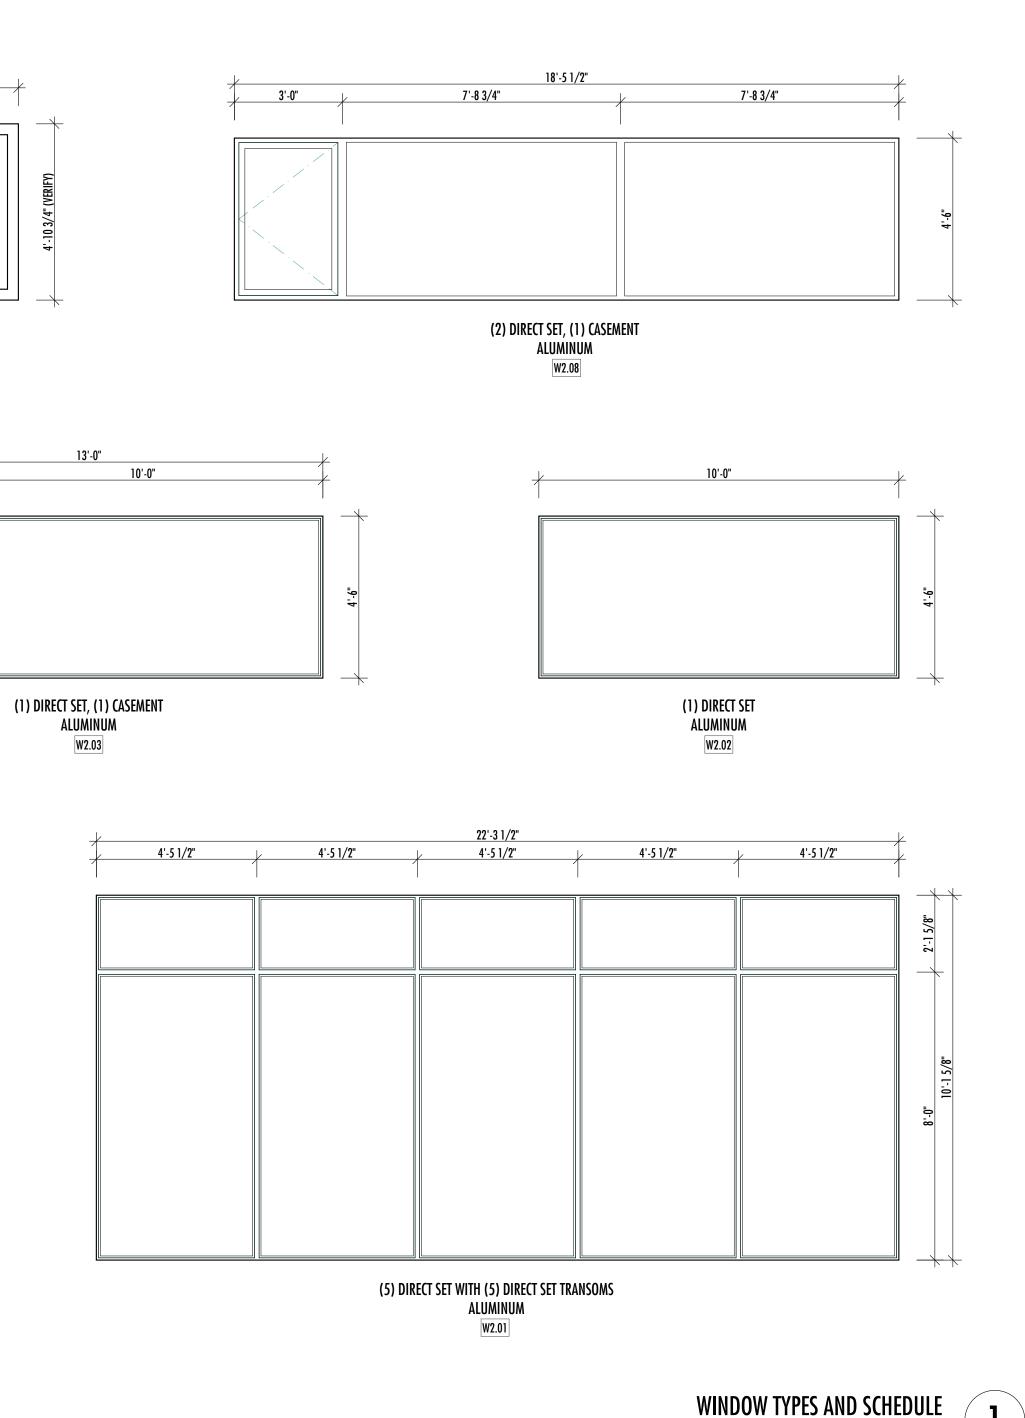


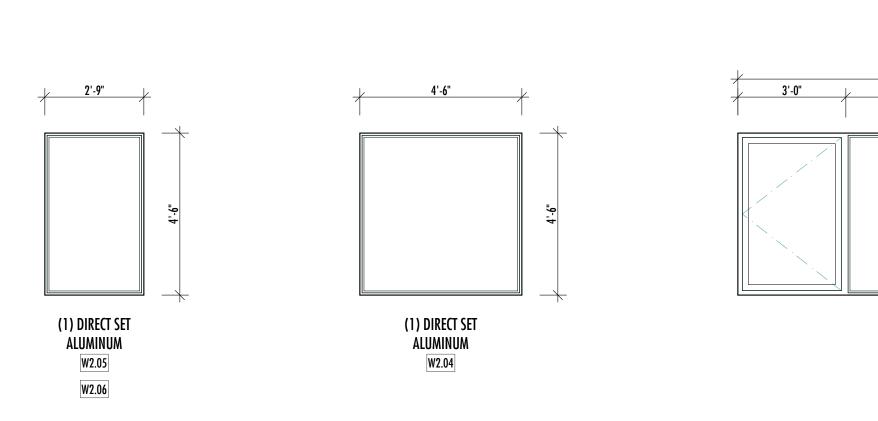

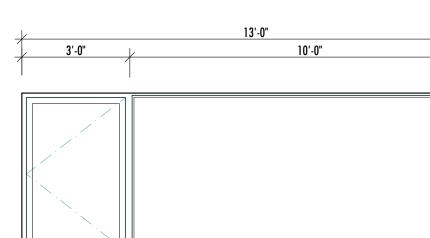

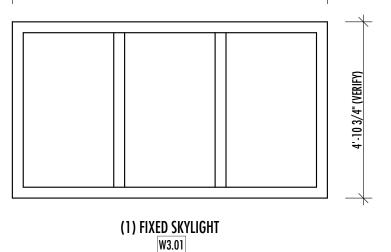

8'-9" (VERIFY)

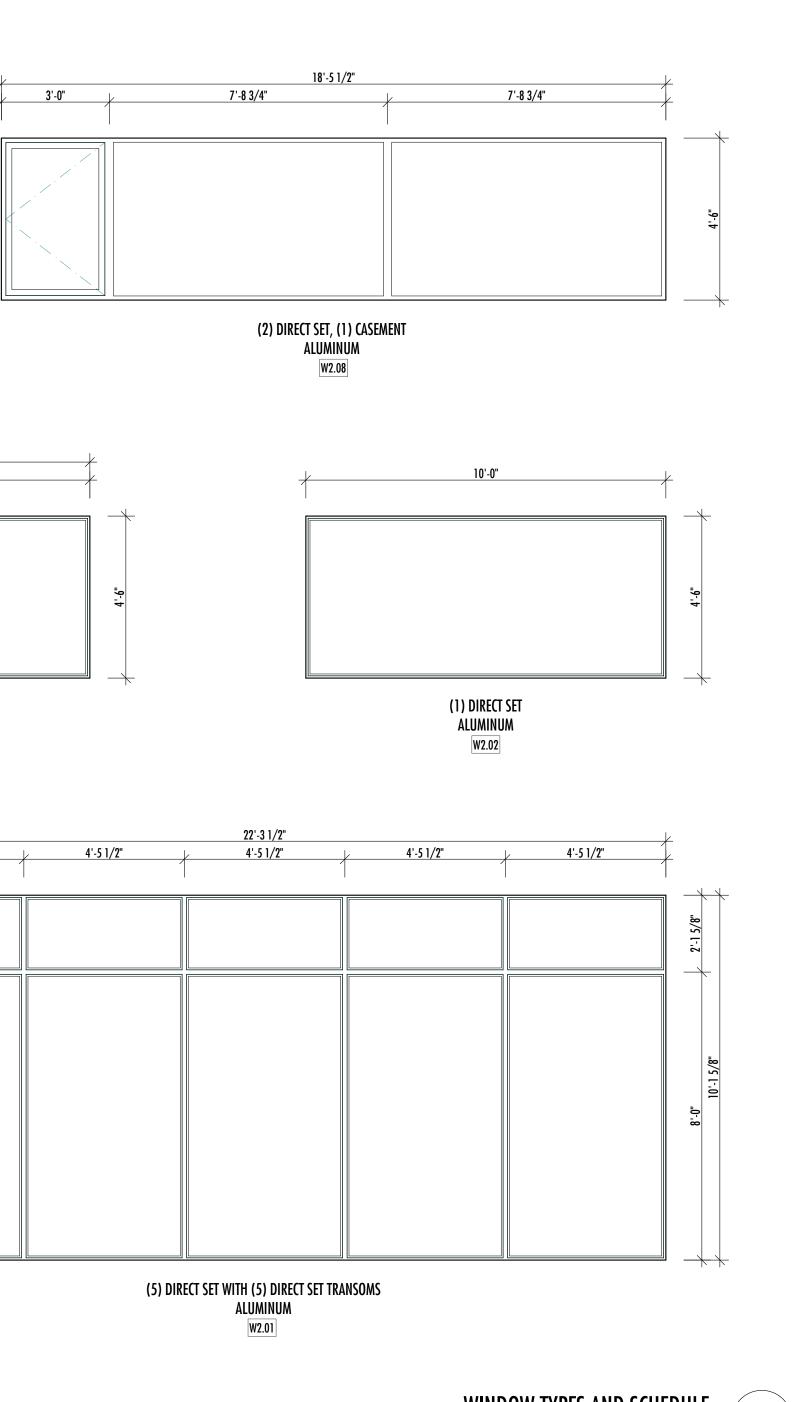

NOTES

EXTERIOR WINDOWS: - 2ND AND 3RD FLOORS:

- WEATHERSHIELD VUE COLLECTION, SQUARE BEAD - HOLLOW CORE METAL AT MECH ROOM DOOR?

- -1ST FLOOR: - SIERRA PACIFIC ALUMINUM CLAD WOOD AT ALL CABIN REPLACEMENT OPENINGS; AT NEW CONSTRUCTION: SIERRA PACIFIC ALUMINUM CLAD WOOD OR WEATHERSHIELD VUE
- COLLECTION, SQUARE BEAD (TBD) - 3RD FLOOR SKYLIGHT: VELUX FIXED CURB-MOUNTED LONGLIGHT (5 DEGREES) MODULAR SKYLIGHT OR ALADDIN (TBD).
- EXTERIOR FINISH: ALUMINUM COLOR: "BLACK" (VERIFY WITH ARCHITECT). - INTERIOR FINISH (@ SIERRA PACIFIC): FIR, UNFINISHED, SHALL BE
- FINISHED ONSITE. - DOUBLE GLAZING, TYPICAL (0.30 MAX U-FACTOR). LOW-E 272.
- PLEASE PROVIDE PRICING FOR TRIPLE GLAZING FOR THE MASTER
- BEDROOM AND 2ND FLOOR LIVING/DINING WINDOW WALL. - PROVIDE SAFETY GLAZING WHERE REQUIRED BY CODE (IBC 2018).
- EXTERIOR WINDOWS AND DOORS ARE DRAWN AS VIEWED FROM THE EXTERIOR.

ed 40 Ś 83 Idaho U >tch \mathbf{O} \mathbf{N} \sim Bloc • 5 ot ∞ \mathbf{n} WILLIAMS PARTNERS ARCHITECTS MAIL P.O.B. 4373 KETCHUM, IDAHO 83340 PHONE 208.726.0020 FAX 208.726.0019 WWW WILLIAMS-PARTNERS.COM

Ο

OE

50

din

Buil

 $\boldsymbol{\mathcal{O}}$

AND SE


5 ≌ 2 ∵ 5

DRAWINGS DATE: ISSUED: 05/12/2021 COK SCHEMATIC PRESENTATION 06/10/2021 COK HPC REVIEW 09/30/2021 DESIGN REVIEW 04/22/2022 PRICING SET 08/05/2022 PERMIT 08/02/2023 ISSUED FOR CONSTRUCTION REVISIONS NUMBER: DATE:

DOOR AND WINDOW SCHEDULES

Y:\McMorrow\04 - BIM Project Files\380 North 1st Avenue.pln

SCALE: 3/8" = 1'-0"

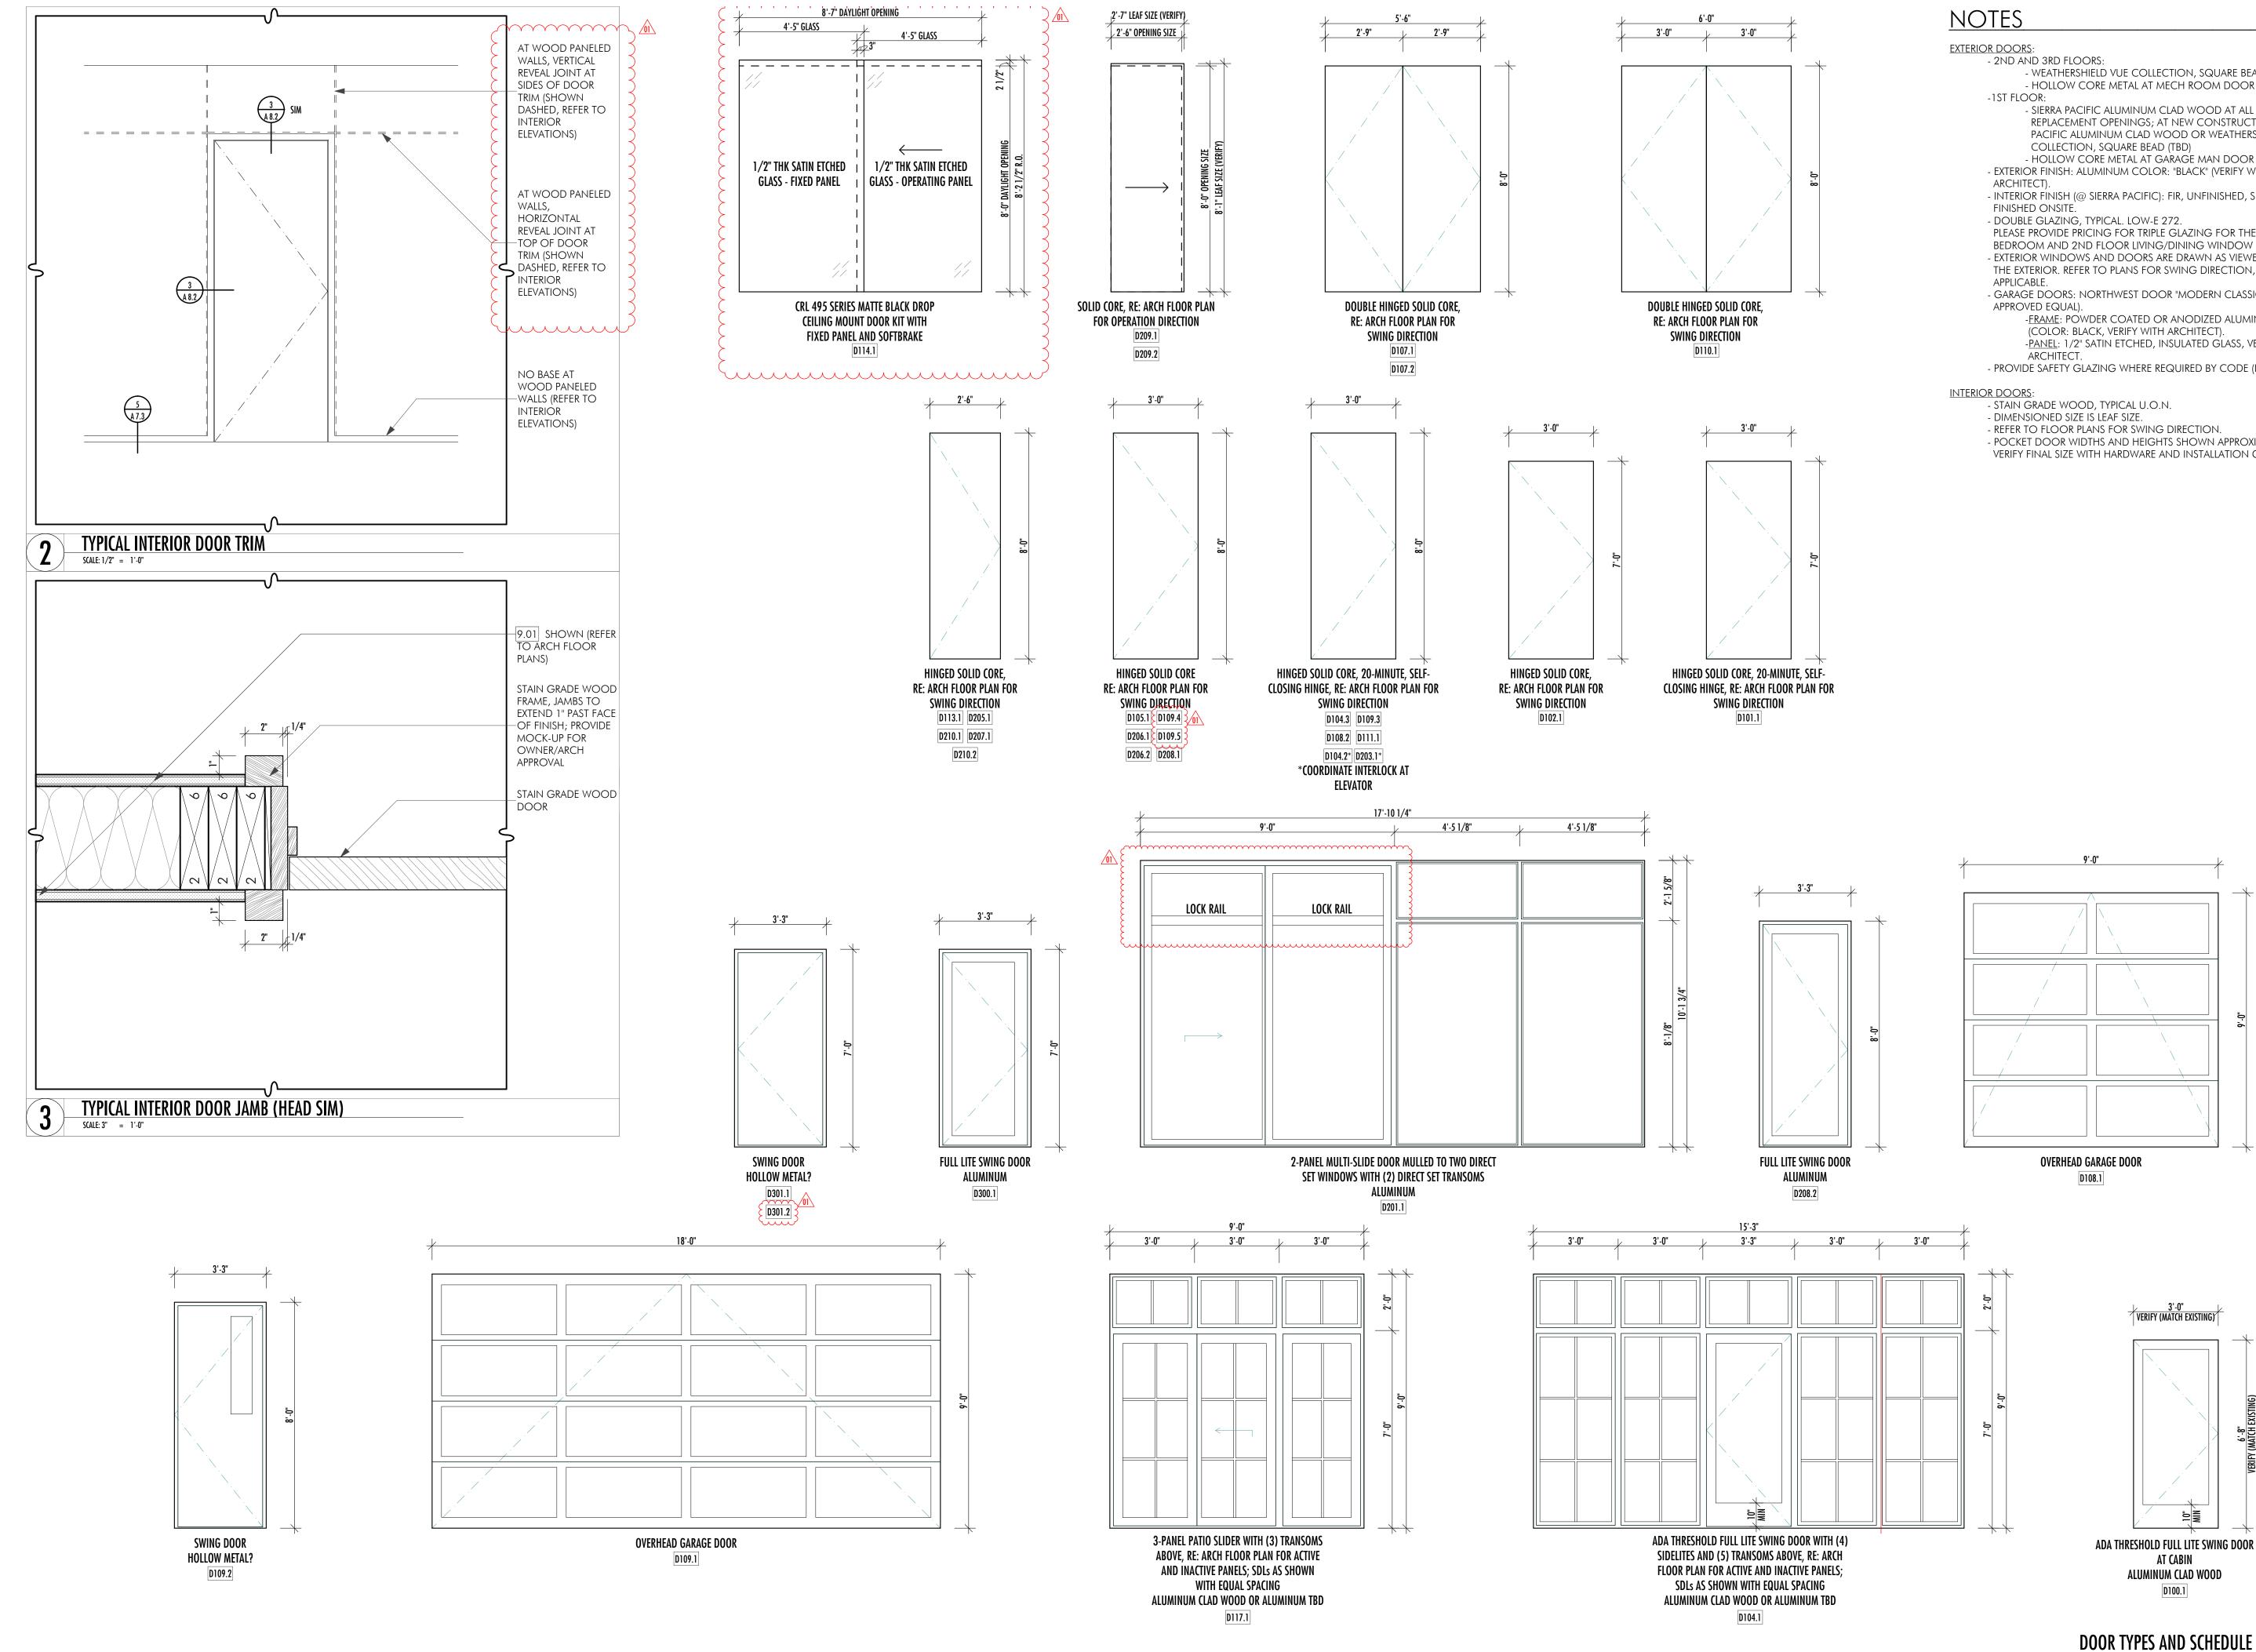





- WEATHERSHIELD VUE COLLECTION, SQUARE BEAD - HOLLOW CORE METAL AT MECH ROOM DOOR TBD
- SIERRA PACIFIC ALUMINUM CLAD WOOD AT ALL CABIN REPLACEMENT OPENINGS; AT NEW CONSTRUCTION: SIERRA PACIFIC ALUMINUM CLAD WOOD OR WEATHERSHIELD VUE
- HOLLOW CORE METAL AT GARAGE MAN DOOR TBD - EXTERIOR FINISH: ALUMINUM COLOR: "BLACK" (VERIFY WITH
- INTERIOR FINISH (@ SIERRA PACIFIC): FIR, UNFINISHED, SHALL BE
- PLEASE PROVIDE PRICING FOR TRIPLE GLAZING FOR THE MASTER BEDROOM AND 2ND FLOOR LIVING/DINING WINDOW WALL. - EXTERIOR WINDOWS AND DOORS ARE DRAWN AS VIEWED FROM
- THE EXTERIOR. REFER TO PLANS FOR SWING DIRECTION, WHERE - GARAGE DOORS: NORTHWEST DOOR "MODERN CLASSIC" (OR
- -FRAME: POWDER COATED OR ANODIZED ALUMINUM
- -PANEL: 1/2" SATIN ETCHED, INSULATED GLASS, VERIFY WITH
- PROVIDE SAFETY GLAZING WHERE REQUIRED BY CODE (IBC 2018).
- - REFER TO FLOOR PLANS FOR SWING DIRECTION.
 - POCKET DOOR WIDTHS AND HEIGHTS SHOWN APPROXIMATE. VERIFY FINAL SIZE WITH HARDWARE AND INSTALLATION GUIDELINES.



PROJI RVICE PROJI FIE AUTHC

AND AND THIS

VALERSH VSTRUMENTS (RESPECT TO TITECTS, P.C. / UTIVE INCETTO

OE

50

5

•

 $\boldsymbol{\mathcal{O}}$

xed

•

>

40

Ò

 \mathbf{O}

 ∞


Idah

n

DOOR AND WINDOW SCHEDULES



SCALE: 3/8" = 1'-0"

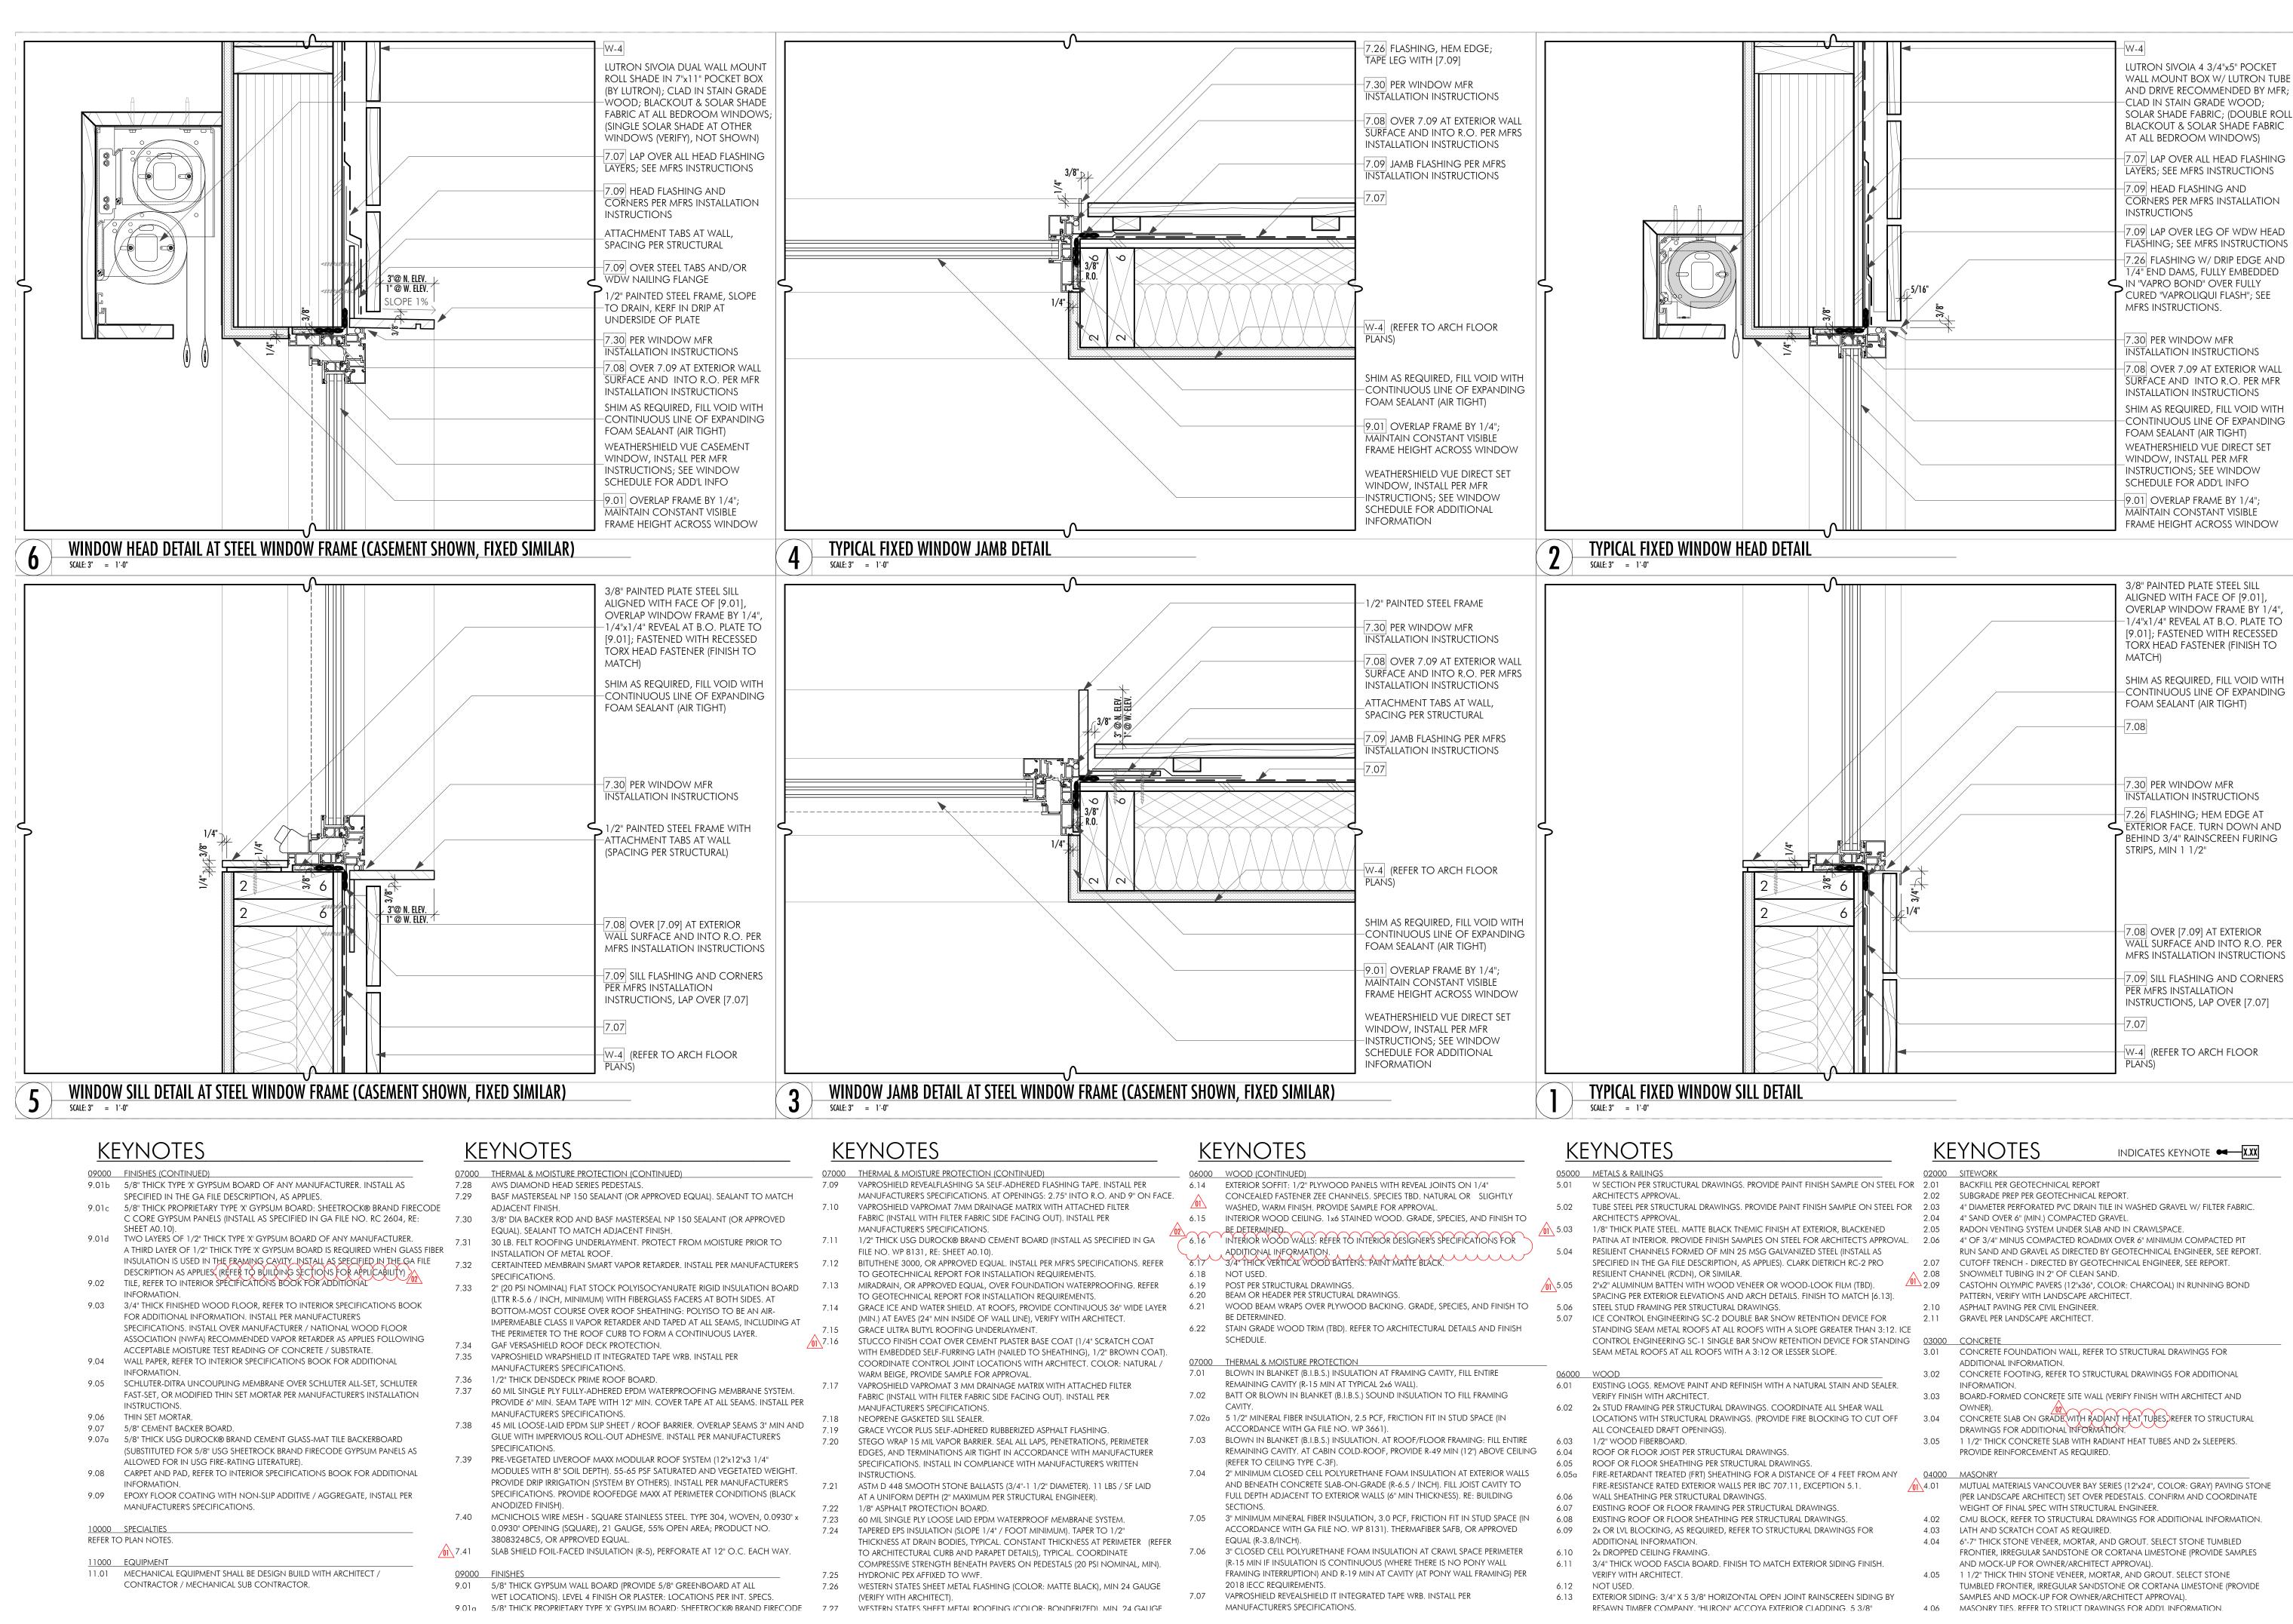

	<u> </u>
	020
ROVIDE PAINT FINISH SAMPLE ON STEEL FOR	2.0
	2.0
ROVIDE PAINT FINISH SAMPLE ON STEEL FOR	2.0
	2.0
MIC FINISH AT EXTERIOR, BLACKENED	2.0
LES ON STEEL FOR ARCHITECT'S APPROVAL.	2.0
MSG GALVANIZED STEEL (INSTALL AS	
APPLIES). CLARK DIETRICH RC-2 PRO	2.0
	2.0
	2.0
RCH DETAILS. FINISH TO MATCH [6.13].	0.1
WINGS. E BAR SNOW RETENTION DEVICE FOR	2.1
DFS WITH A SLOPE GREATER THAN 3:12. ICE	2.1
SNOW RETENTION DEVICE FOR STANDING	030
3:12 OR LESSER SLOPE.	3.0
	0.0
	3.0
ISH WITH A NATURAL STAIN AND SEALER.	
	3.0
NGS. COORDINATE ALL SHEAR WALL	
. (PROVIDE FIRE BLOCKING TO CUT OFF	3.0
DAM/DIOC	3.0
RAWINGS.	
JRAL DRAWINGS. FOR A DISTANCE OF 4 FEET FROM ANY	040
	<u>040</u> 4.0
R IBC 707.11, EXCEPTION 5.1. <u>(01</u>) NGS.	4.0
TRUCTURAL DRAWINGS.	
R STRUCTURAL DRAWINGS.	4.0
TO STRUCTURAL DRAWINGS FOR	4.0
	4.0
to match exterior siding finish.	
	4.0
AL OPEN JOINT RAINSCREEN SIDING BY	
OYA EXTERIOR CLADDING: 5 3/8"	4.0


- ن 2 کا OL • ARCHITECT AR-1720 $\boldsymbol{\mathcal{O}}$ \sim \propto D ∞ $(\)$ WILLIAMS PARTNERS ARCHITECTS MAIL P.O.B. 4373 KETCHUM, IDAHO 83340 PHONE 208.726.0020 FAX 208.726.0019
 - WWW WILLIAMS-PARTNERS.COM

DRAWINGS DATE: ISSUED: 04/18/2022 PRICING SET

- 08/05/2022 PERMIT
- 08/02/2023 ISSUED FOR CONSTRUCTION

REVISIONS NUMBER: DATE:


DOOR AND WINDOW SCHEDULES

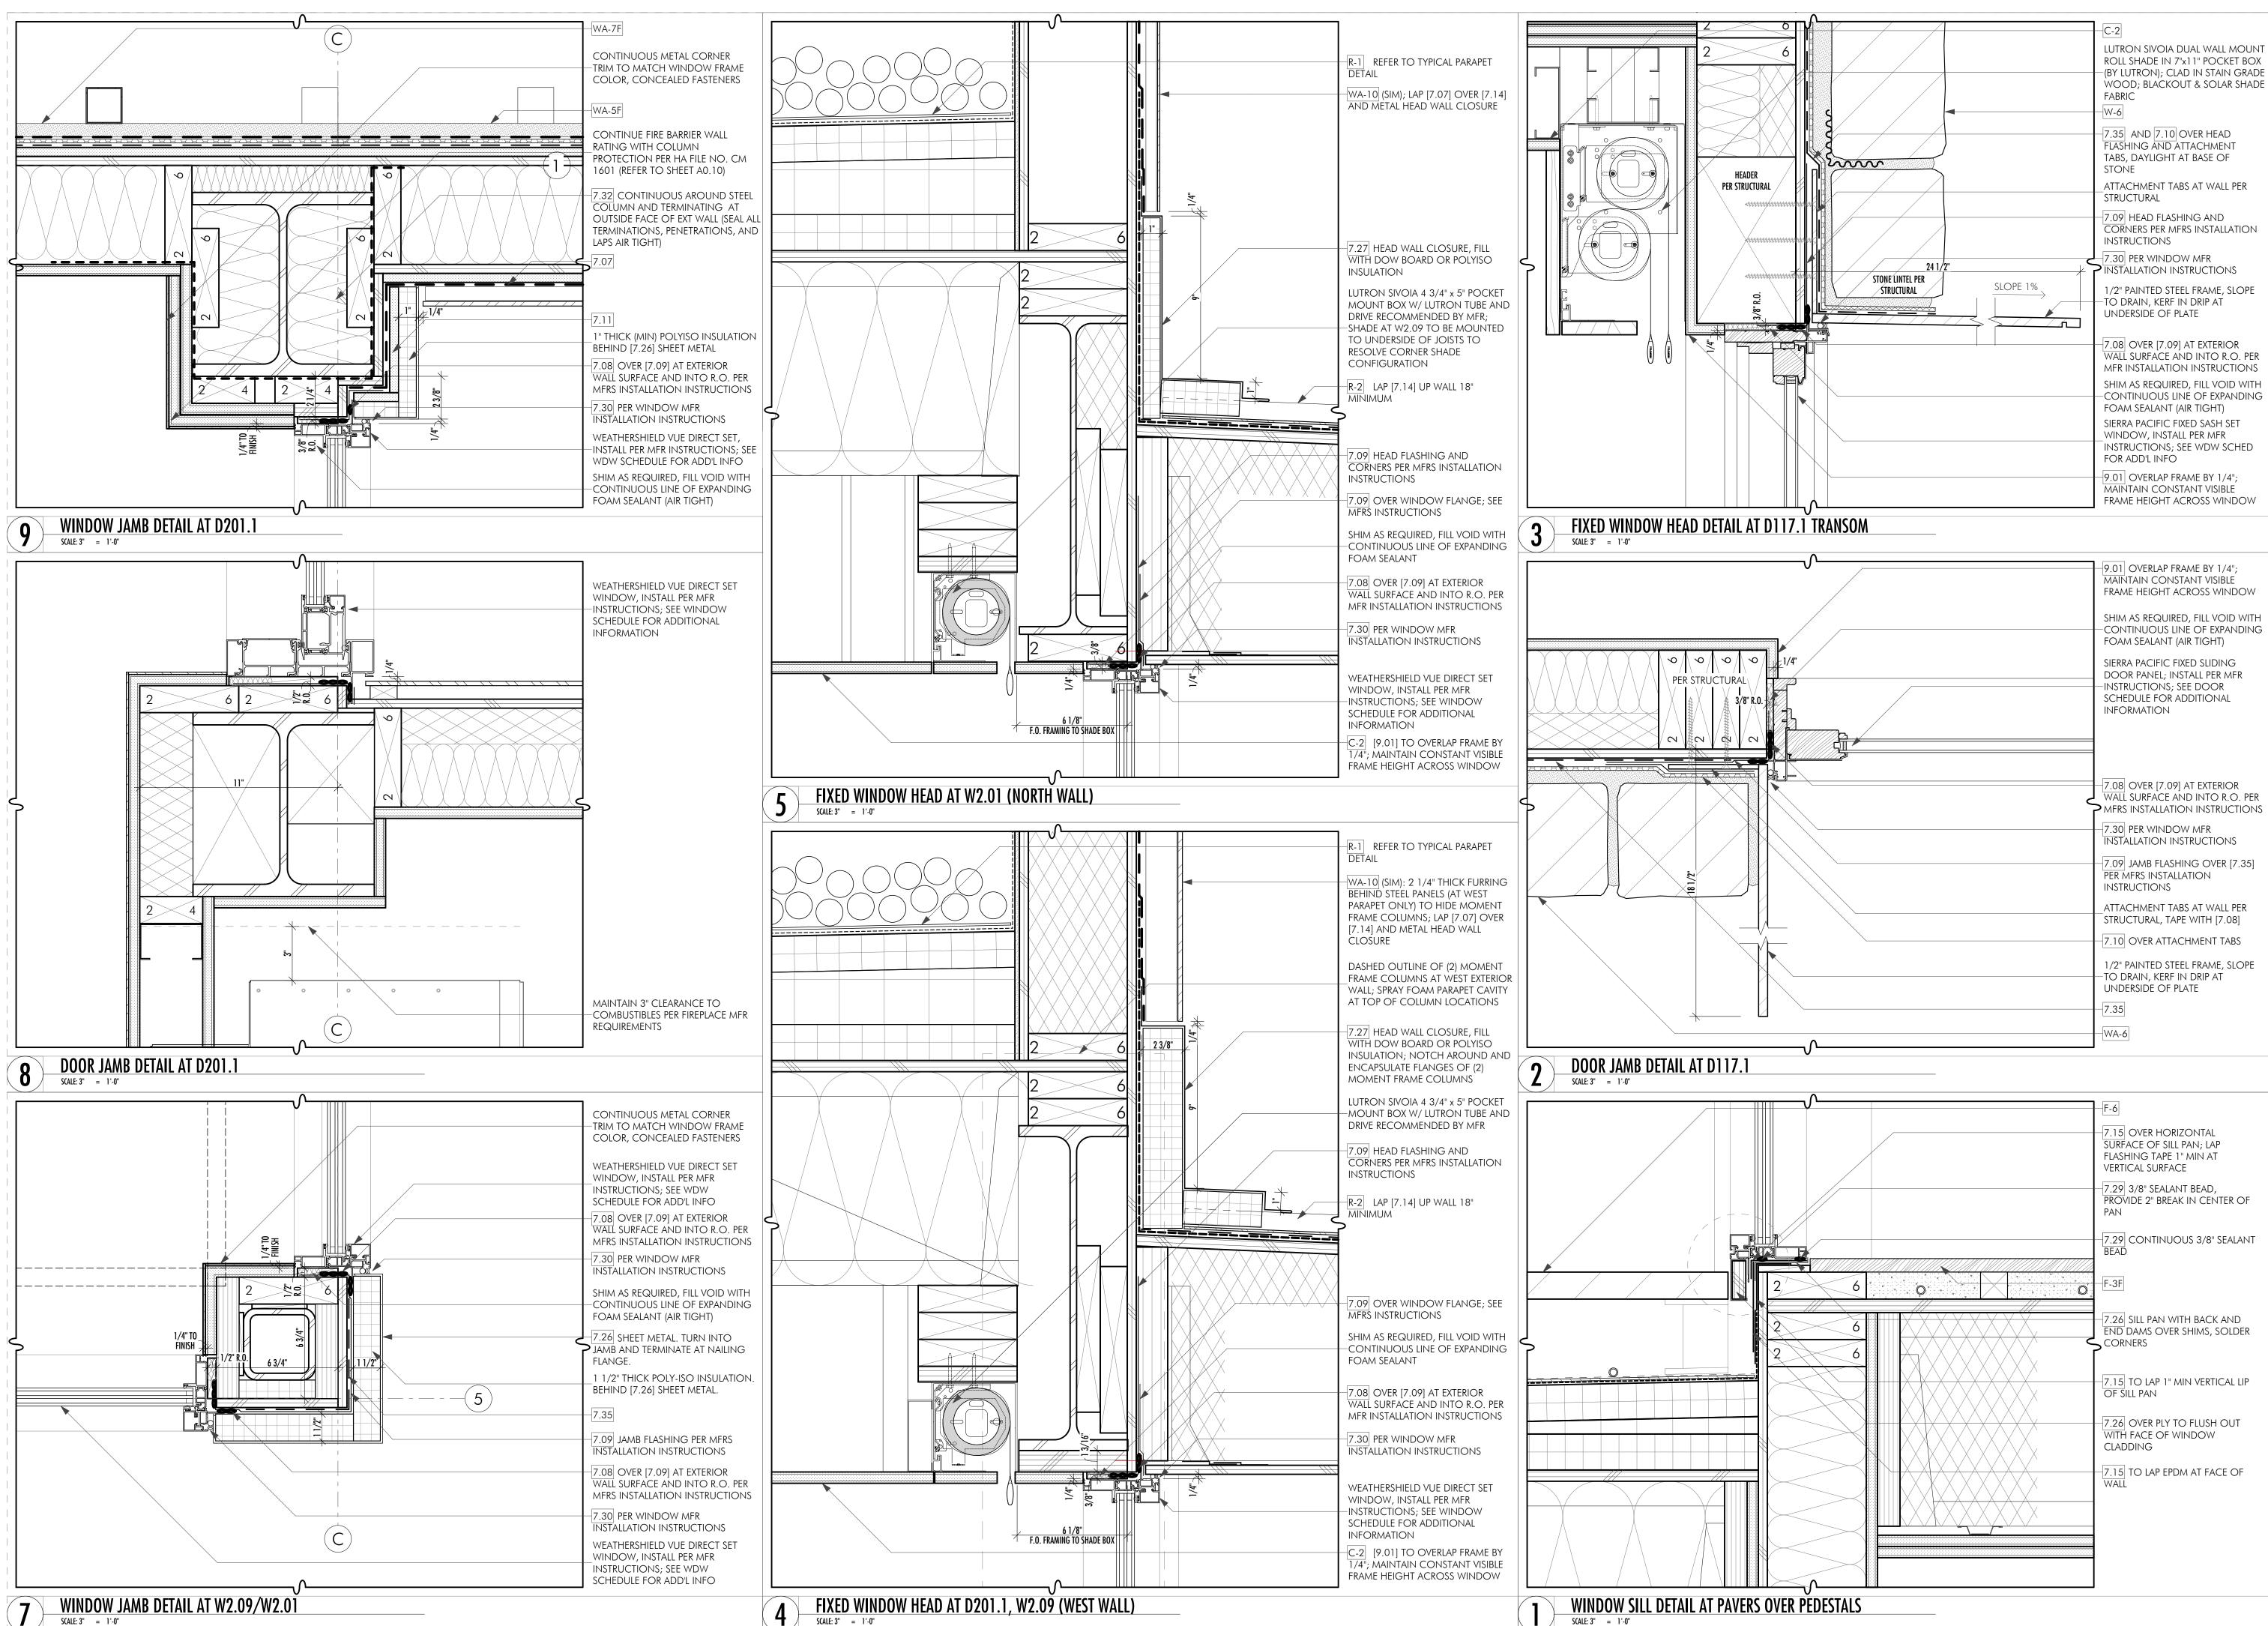

SCALE: 3" = 1'-0"



DOOR AND WINDOW SCHEDULES

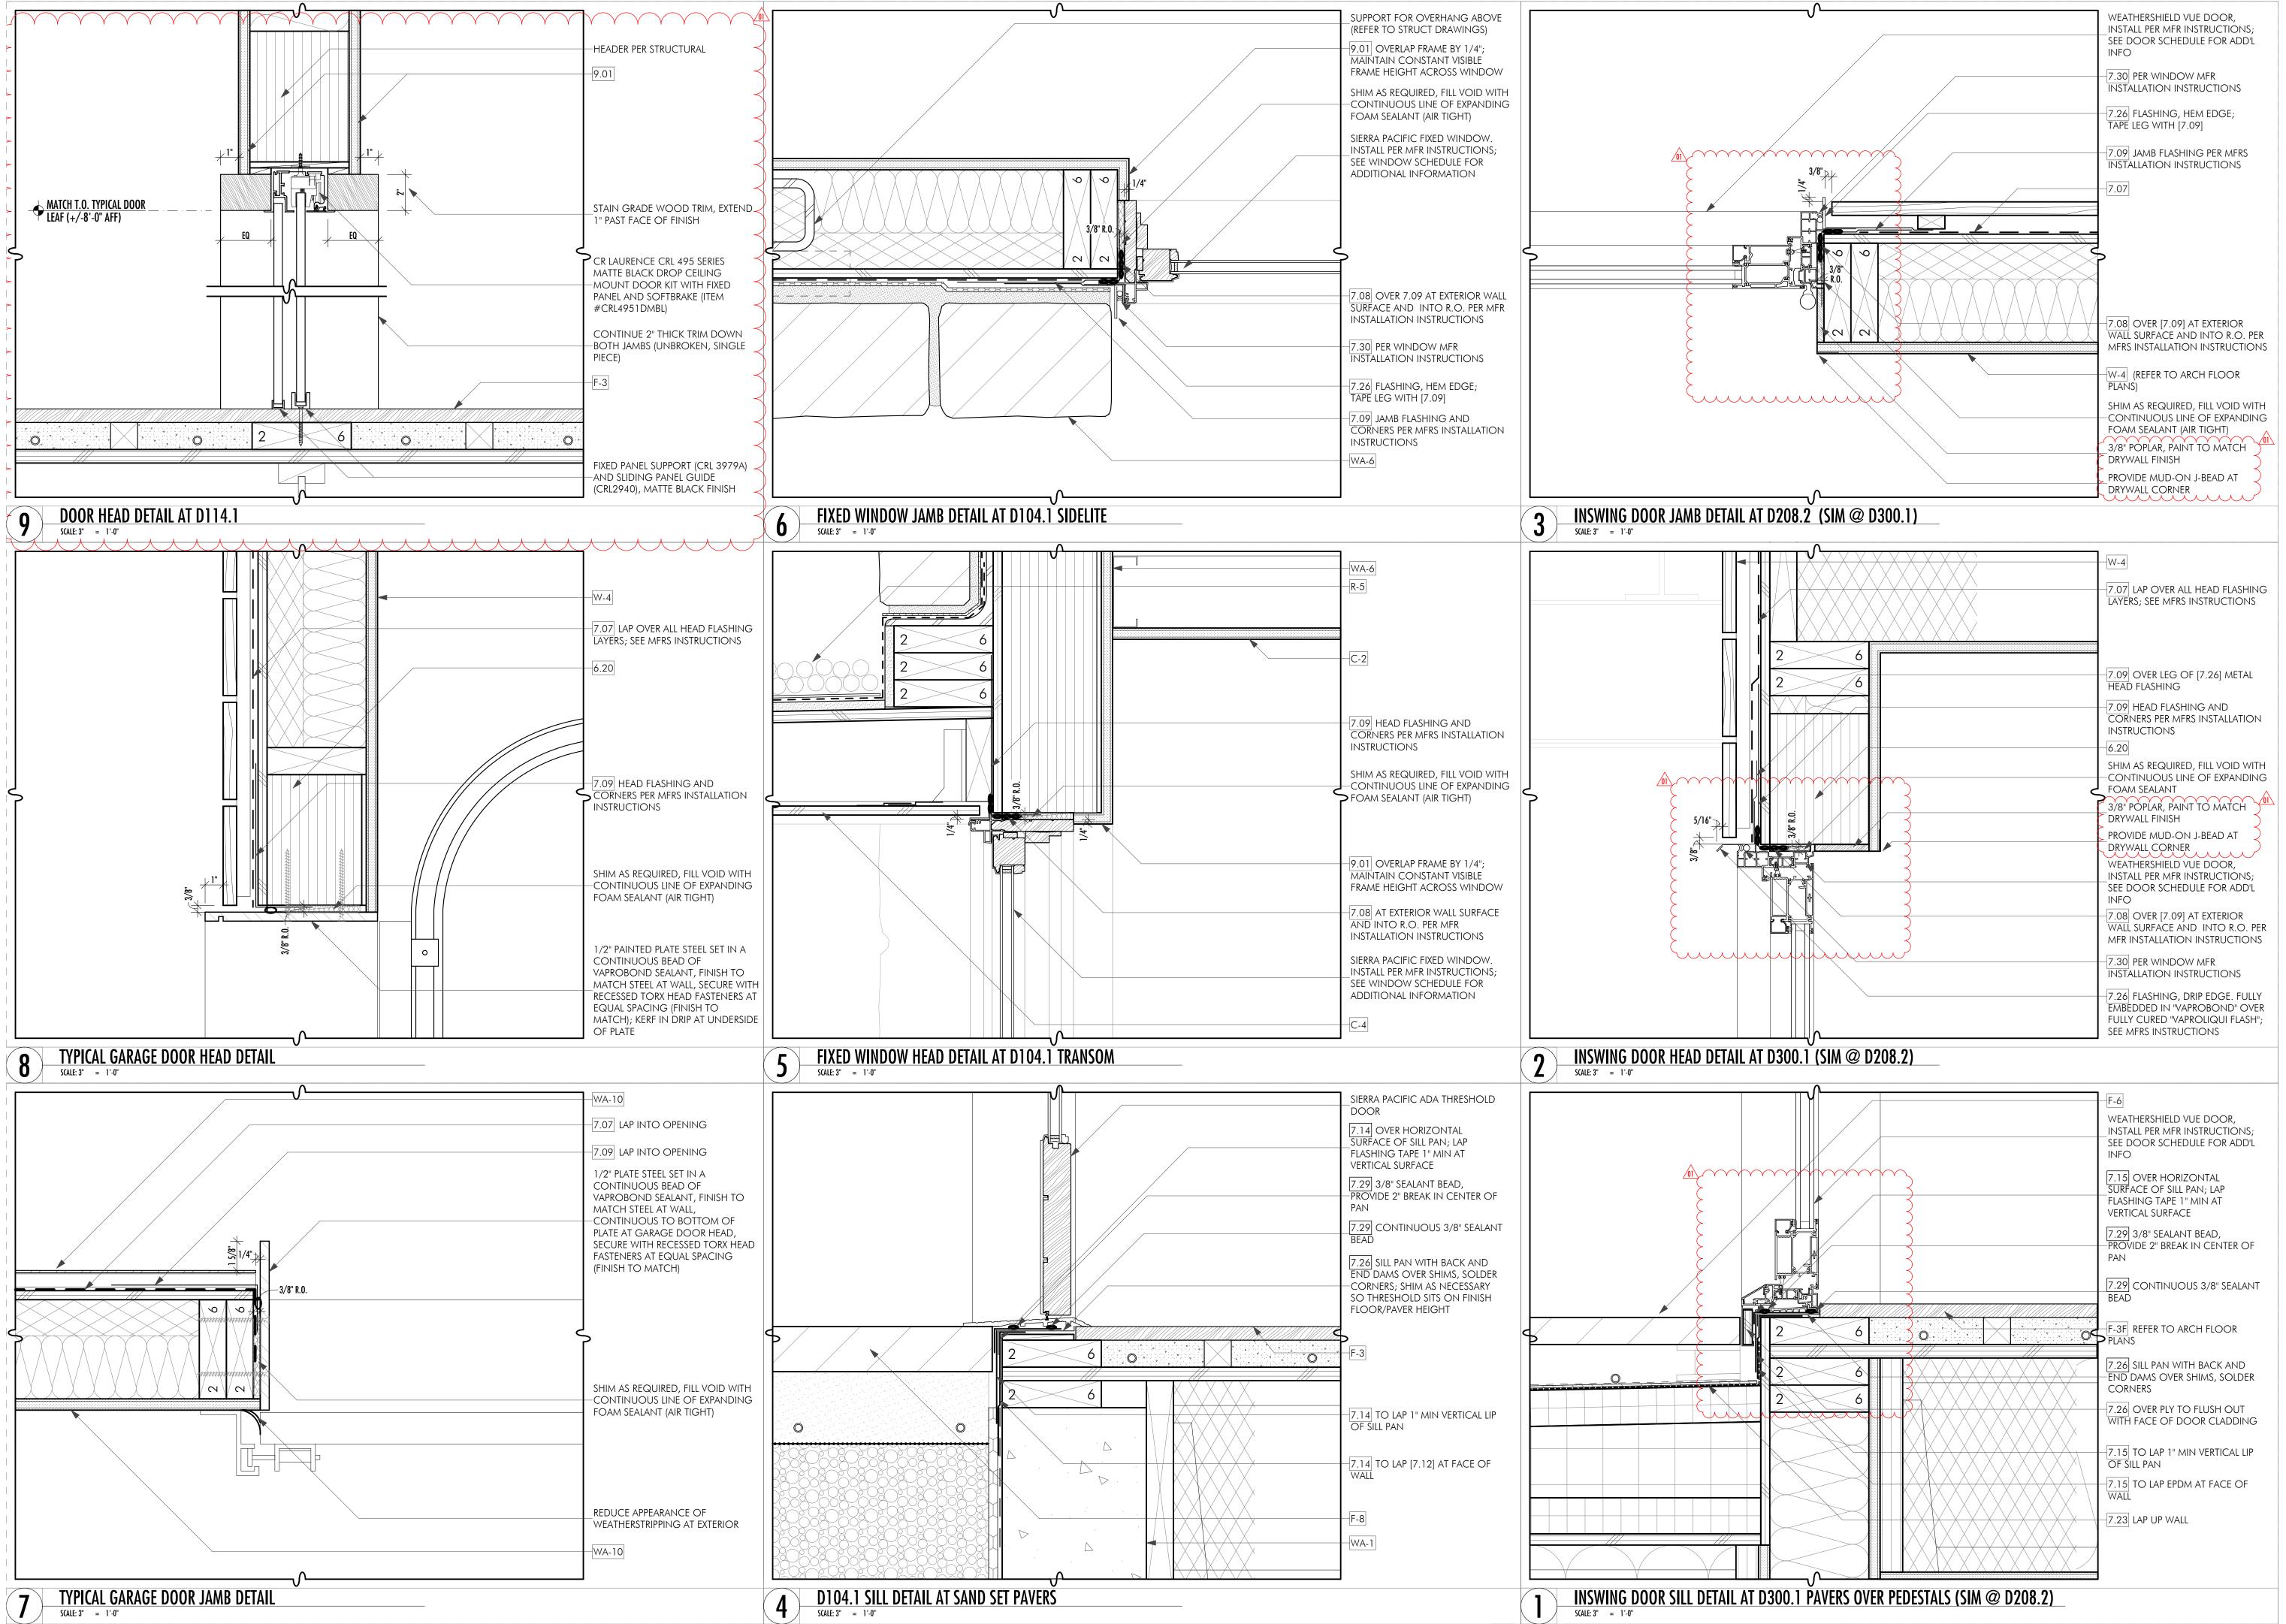



DOOR AND WINDOW SCHEDULES













A 3D VIEWS

4)

Attachment B

BY THE BOARD OF COMMISSIONERS OF THE URBAN RENEWAL AGENCY OF KETCHUM, IDAHO:

A RESOLUTION OF THE BOARD OF COMMISSIONERS OF THE URBAN RENEWAL AGENCY OF KETCHUM, IDAHO, AMENDING THE AGENCY'S PARTICIPATION POLICY; AUTHORIZING THE CHAIR AND EXECUTIVE DIRECTOR TO TAKE APPROPRIATE ACTION; AND PROVIDING AN EFFECTIVE DATE.

THIS RESOLUTION, made on the date hereinafter set forth by the Urban Renewal Agency of Ketchum, Idaho, also known as the Ketchum Urban Renewal Agency, an independent public body, corporate and politic, authorized under the authority of the Idaho Urban Renewal Law of 1965, as amended, Chapter 20, Title 50, Idaho Code, a duly created and functioning urban renewal agency for Ketchum, Idaho, hereinafter the Ketchum Urban Renewal Agency is referred to as the "Agency."

WHEREAS, the Agency, an independent public body, corporate and politic, is an urban renewal agency created by and existing under the authority of and pursuant to the Idaho Urban Renewal Law of 1965, being Idaho Code, Title 50, Chapter 20 (the "Law"), and the Local Economic Development Act, being Idaho Code, Title 50, Chapter 29, as amended and supplemented (the "Act");

WHEREAS, the City of Ketchum (the "City") by adoption of Ordinance No. 992 on November 15, 2006, duly adopted the Ketchum Urban Renewal Plan (the "2006 Plan") to be administered by the Agency;

WHEREAS, upon the approval of Ordinance No. 1077 adopted by the City Council on November 15, 2010, and deemed effective on November 24, 2010, the Agency began implementation of the amended Ketchum Urban Renewal Plan (the "Amended Plan");

WHEREAS, the Agency Board adopted a formal participation policy that sets out the criteria for funding projects requested by various entities on May 16, 2016;

WHEREAS, since May 16, 2016, the Agency has considered several requests for funding through the Participation Policy, which has raised the prospect for greater discretion and flexibility in response to requests for funding through the Participation Policy;

WHEREAS, by virtue of those requests, Agency staff has determined a need for an amendment to the Participation Policy;

WHEREAS, at the Agency Board meeting of June 19, 2017, the Board considered amendments to the Participation Policy;

WHEREAS, Agency adopted amendments to the Participation Policy July 17, 2017:

WHEREAS, the Agency adopted additional amendments to the Participation Policy on June 27, 2022;

WHEREAS, the Board finds it in the best interests of the Agency and the public to approve and adopt the Amended Participation Policy.

NOW, THEREFORE, BE IT RESOLVED BY THE MEMBERS OF THE BOARD OF COMMISSIONERS OF THE KETCHUM URBAN RENEWAL AGENCY OF THE CITY OF KETCHUM, IDAHO, AS FOLLOWS:

<u>Section 1</u>: That the above statements are true and correct.

<u>Section 2</u>: That the Participation Policy, as amended, set forth below is hereby approved and adopted by the Agency Board, and that the Chair and Executive Director are authorized and directed to take all action to implement the Amended Participation Policy.

Participation Policy KURA Funding Criteria for Projects

Section 1: General Funding Criteria for All Projects:

- A. The KURA is not obligated to fund any project, even when the project meets all funding criteria. Funding a project is a discretionary decision by the Ketchum Urban Renewal Board.
- B. Funds generated from projects within the Revenue Allocation Area shall be used first and foremost for publically owned infrastructure and for infrastructure that serves a direct public purpose.
- C. Public infrastructure located below ground or at-grade shall be given priority.
- D. In rare circumstances, funding for a non-infrastructure request may be considered if it is found to meet the criteria described in the section below.
- E. Projects specifically identified in the 2010 Ketchum Urban Renewal Plan shall take priority for funding in all cases.
- F. All requests for Tax Increment Financing shall be made no later than thirty (30) days after the applicant applies for a building permits.
- G. The Agency shall not consider requests to fund public infrastructure that <u>have has</u>-been required by the City of Ketchum in exchange for development bonuses, such as density waivers, variances, and other development bonuses. In these situations, the public infrastructure that was required in exchange for development bonuses shall be paid by the private developer.
- H. Funding approvals are valid for the duration of the fiscal year in which the request was granted, unless otherwise stated in an agreement between the Agency and the entity.

Section 2: Project Funding Categories

- A. Reimbursement to Private Entities for Public Infrastructure
 - 1. Tax increment funds generated by a project within the Revenue Allocation Area may be allocated for reimbursement of public infrastructure expenses incurred by the private development.
 - 2. Reimbursement for public infrastructure shall commence after the project is generating a tax increment benefit to the Agency.
 - 3. No more than 50% of the total tax increment revenue generated from a project may be used for reimbursement to the project developer
 - 4. Commitments for reimbursement in Owner Participation Agreements shall not be greater than five years from the time the project is generating property tax revenue to the Agency.
 - 5. KURA may fund 40% of the cost of the following:
 - a. Cost differential between concrete sidewalks and paver sidewalks, snowmelt systems will not be funded
 - b. Installation of street trees
 - c. Art or other public amenities in the public right-of way
- B. Direct Funding of Public Infrastructure as Defined in Idaho Code §§ 50-2018(10), 50-2903(13) and 50-2903 (14):
 - 1. Tax increment funds may be used to directly finance public infrastructure without a reimbursement agreement.
 - 2. In these cases, payments should be made directly to a public entity, public utility, or other public or semi-public entity that will own and maintain the infrastructure.
- C. Funding for Non-Infrastructure Requests:
 - 1. Requests for funding non-infrastructure may only be considered when a good, service, or benefit is received by the KURA in exchange for funds. In these cases, the approval of funds would result in a benefit to the revenue allocation area that the KURA could not have achieved on its own.
 - 2. Entities requesting funding must be a legally recognized Idaho non-profit corporation organized under Chapter 30, Title 30, Idaho Code or equivalent or a public governmental entity and must have a proven track record of success.
 - 3. Non-infrastructure funding request must result in a net financial benefit to the KURA.
 - 4. Requests for funding administrative or operational costs shall not be considered except as may be proportionally allocated for the project.
- D. Funding of Residential Projects:
 - 1. Only residential projects that incorporate community housing, as defined by the City of Ketchum, will be considered for tax increment funding. Funding will be proportionate to the amount of community housing the project provides. For example, if ten out of 100 residential units are considered community housing, the Agency may consider funding 10% of infrastructure costs. All other residential projects will not be considered.
 - 2. Mixed-Use projects of any scale are considered commercial projects and may apply for tax increment financing, provided they meet all other criteria.

Section 3: That this Resolution shall be in full force and effect immediately upon its adoption and approval.

PASSED By the Urban Renewal Agency of Ketchum, Idaho, on June 27, 2022. Signed by the Chair of the Board of Commissioners, and attested by the Secretary to the Board of Commissioners, on June 27, 2022.

URBAN RENEWAL AGENCY OF KETCHUM

CHAIR) By

ATTEST: By Secretary