

**SECTION 21, TOWNSHIP 42S., RANGE 43E.
TOWN OF LAKE PARK, FLORIDA**



SHEET NO.:	DESCRIPTION:
1	TITLE SHEET
2	DEMOLITION PLAN
3	MASTER PLAN
4-7	PAVING AND DRIVEWAYS
8-10	PAVING AND DRIVEWAYS
11	POLLUTION PREVENTION
12-15	WATER AND WASTEWATER
16	SANITARY SEWER
17-23	FORCE MAIN PIPES
24-28	WATER AND WASTEWATER
29-30	LIFT STATION


- THIS ITEM HAS BEEN DIGITALLY
SIGNED AND SEALED BY
ERIK R. COOPER, P.E. ON
12/23/2024.
- PRINTED COPIES OF THIS
DOCUMENT ARE NOT
CONSIDERED SIGNED AND
SEALED AND THE SIGNATURE
MUST BE VERIFIED ON ANY
ELECTRONIC COPIES.
- ERIK R. COOPER
P.E. LICENSE
No. 56934
STATE OF
FLORIDA
PROFESSIONAL ENGINEER

	7.) REVISED PLANS REVISION 4, 11/05/24 C.O. 8.) REVISED PER SEACOST COMMENTS, 09/15/23 C.O. 9.) REVISED PER SEACOST COMMENTS, 09/15/23 C.O. 10.) REVISED PER SEACOST COMMENTS, 11/09/22 C.O. 11.) REVISED PER SEACOST COMMENTS, 11/09/22 C.O. 12.) REVISED PER SEACOST COMMENTS, 09/31/22 C.O. 13.) 1ST BLDG. DET. REVIEW COMMENTS, 09/31/22 C.O. 14.) 1ST BLDG. DET. REVIEW COMMENTS, 09/31/22 C.O. 15.) 1ST BLDG. DET. REVIEW COMMENTS, 09/31/22 C.O. 16.) REVISIONS PER F.D.O.T. COMMENTS, 10/30/20 B.L.	DESIGN E.C.	DRAWN C.O.	CHECKED C.O.


NOTES:

1. CONTRACTOR TO FIELD VERIFY LOCATION AND DEPTH OF ALL EXISTING UTILITIES PRIOR TO CONSTRUCTION AND NOTIFY ENGINEER OF ANY DISCREPANCIES. ALL UTILITIES SHALL BE PROTECTED BY THE CONTRACTOR. ANY CHANGES TO EXISTING UTILITIES LOCATIONS, SUPPORTS, RELOCATIONS AND NOTIFICATIONS REQUIRED WITH ALL APPLICABLE UTILITY SERVICE PROVIDERS.

48 HOURS BEFORE DIGGING
SHOULDER LAKE & BAYVIEW DRIVE
1-800-432-4770
FLORIDA DEPARTMENT OF
TRANSPORTATION
UTILITY CENTER

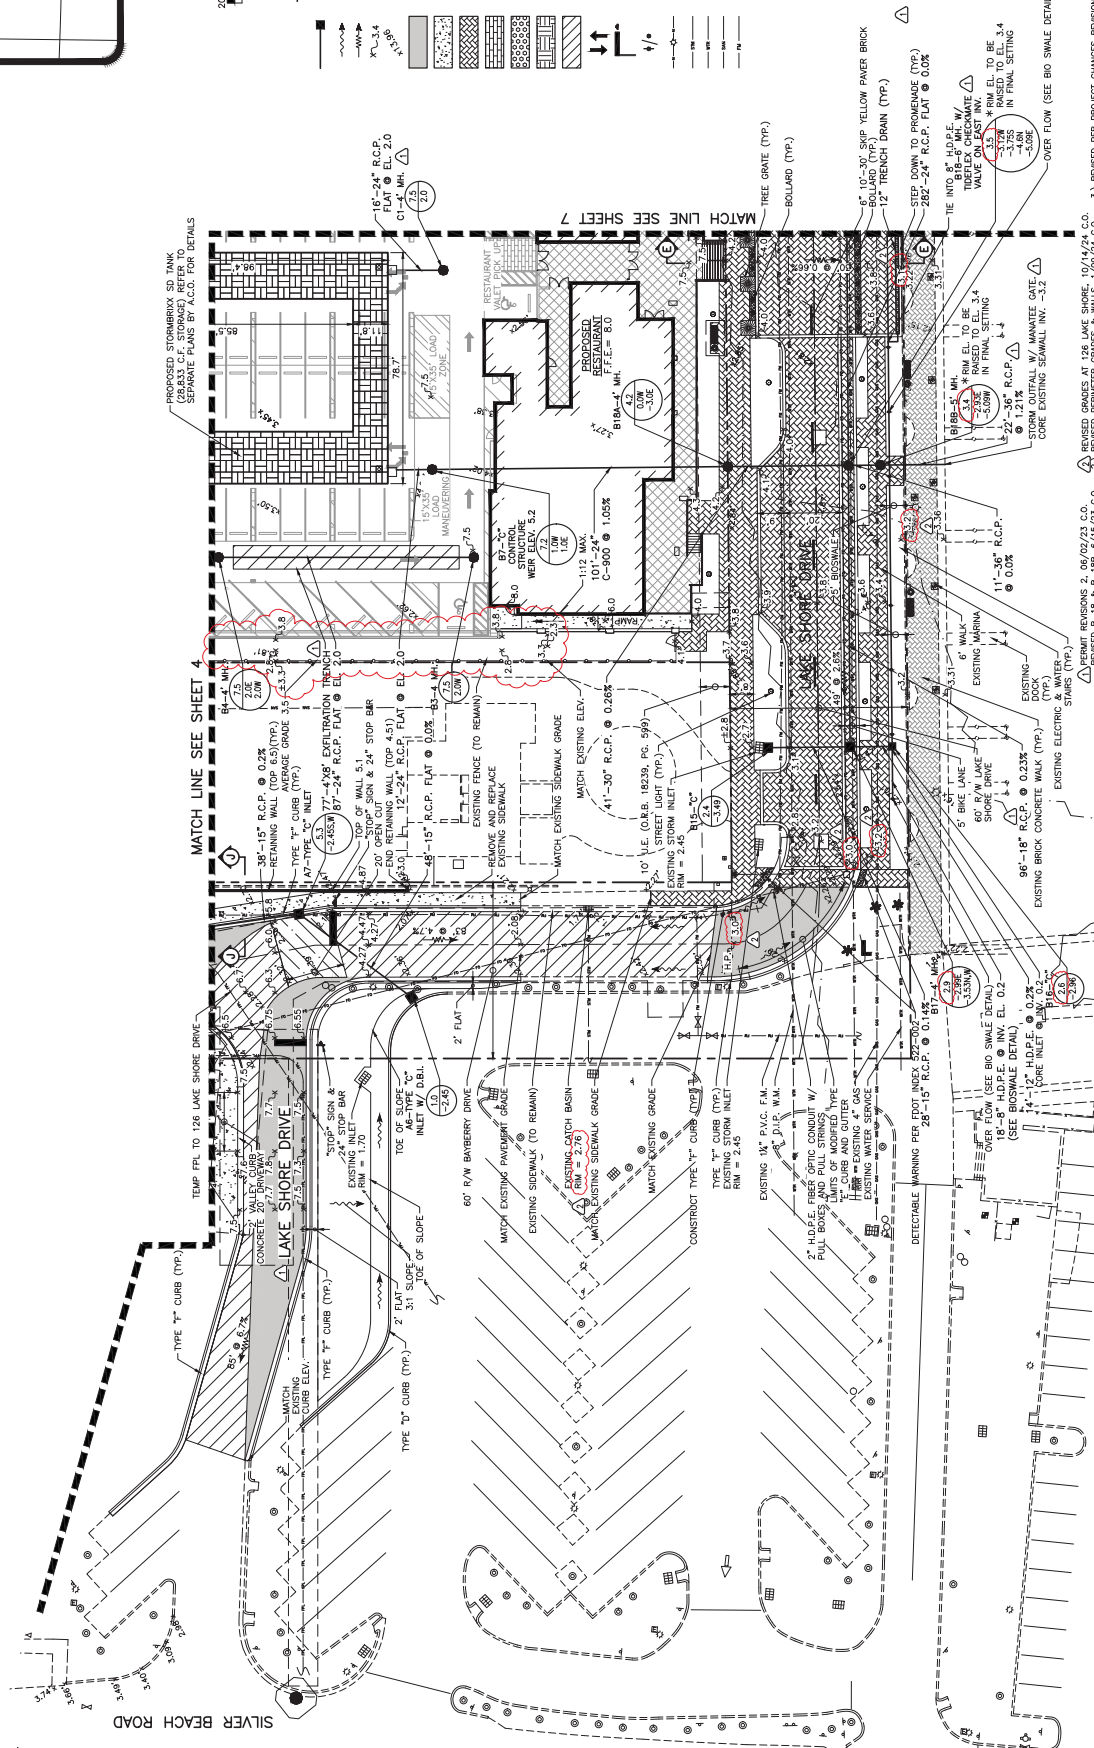

LOCATION MAP
NOT TO SCALE

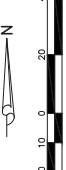

- LEGEND**
- PROPOSED STORM SEWER
 - DIRECTION OF FLOW
 - PROPOSED TOP
 - EXISTING GRADE ELEVATION
 - PROPOSED ASPHALT
 - PROPOSED CONCRETE
 - PROPOSED DECORATIVE CONCRETE
 - PROPOSED BRICK PAVERS
 - PROPOSED DETECTABLE WARNING SURFACE
 - PROPOSED STORMWATER STORAGE
 - MILL AND RESURFACE
 - PROPOSED DIRECTIONAL ARROW
 - PROPOSED 24" WHITE STOP BAR "STOP" SIGN & 6" DOUBLE YELLOW STRIPE
 - PROPOSED LIGHT POLE (BY OTHERS)
 - EXISTING OVERHEAD POWER LINE & POWER POLE
 - EXISTING STORM DRAINAGE PIPE
 - EXISTING WATER MAIN
 - EXISTING SINKER MAIN
 - EXISTING FORCE MAIN

NOTE: ALL ELEVATIONS SHOWN HEREON ARE RELATIVE TO THE NORTH AMERICAN VERTICAL DATUM (N.A.V.D.) OF 1988 BASED ON A SURVEY PREPARED BY BASELINE LAND SURVEY, LLC (561) 417-0700.



THIS ITEM HAS BEEN DIGITALLY SIGNED BY THE ENGINEER. PLEASE ON ERM P. COOPER, P.E. ON 12/23/2024.

PRINTED COPIES OF THIS DOCUMENT ARE NOT VALID. THE ORIGINAL DOCUMENT MUST BE SIGNED AND SEALED AND THE SIGNATURE MUST BE VERIFIED BY THE ENGINEER'S ELECTRONIC COPIES.


SIMMONS & WHITE
Professional Engineer

NAUTILUS 220
SECTION 21, TOWNSHIP 42S., RANGE 43E.
TOWN OF LAKE PARK, FLORIDA
PAVING AND DRAINAGE PLAN

DATE: 11/06/24 C.O.
REVISED PER PROJECT CHANGES REVISION 4, 11/06/24 C.O.
REVISED PER PROJECT CHANGES REVISION 3, 10/14/24 C.O.
REVISED PER PROJECT CHANGES REVISION 2, 06/02/23 C.O.
REVISED PER PROJECT CHANGES REVISION 1, 06/15/23 C.O.


19-038
091892025

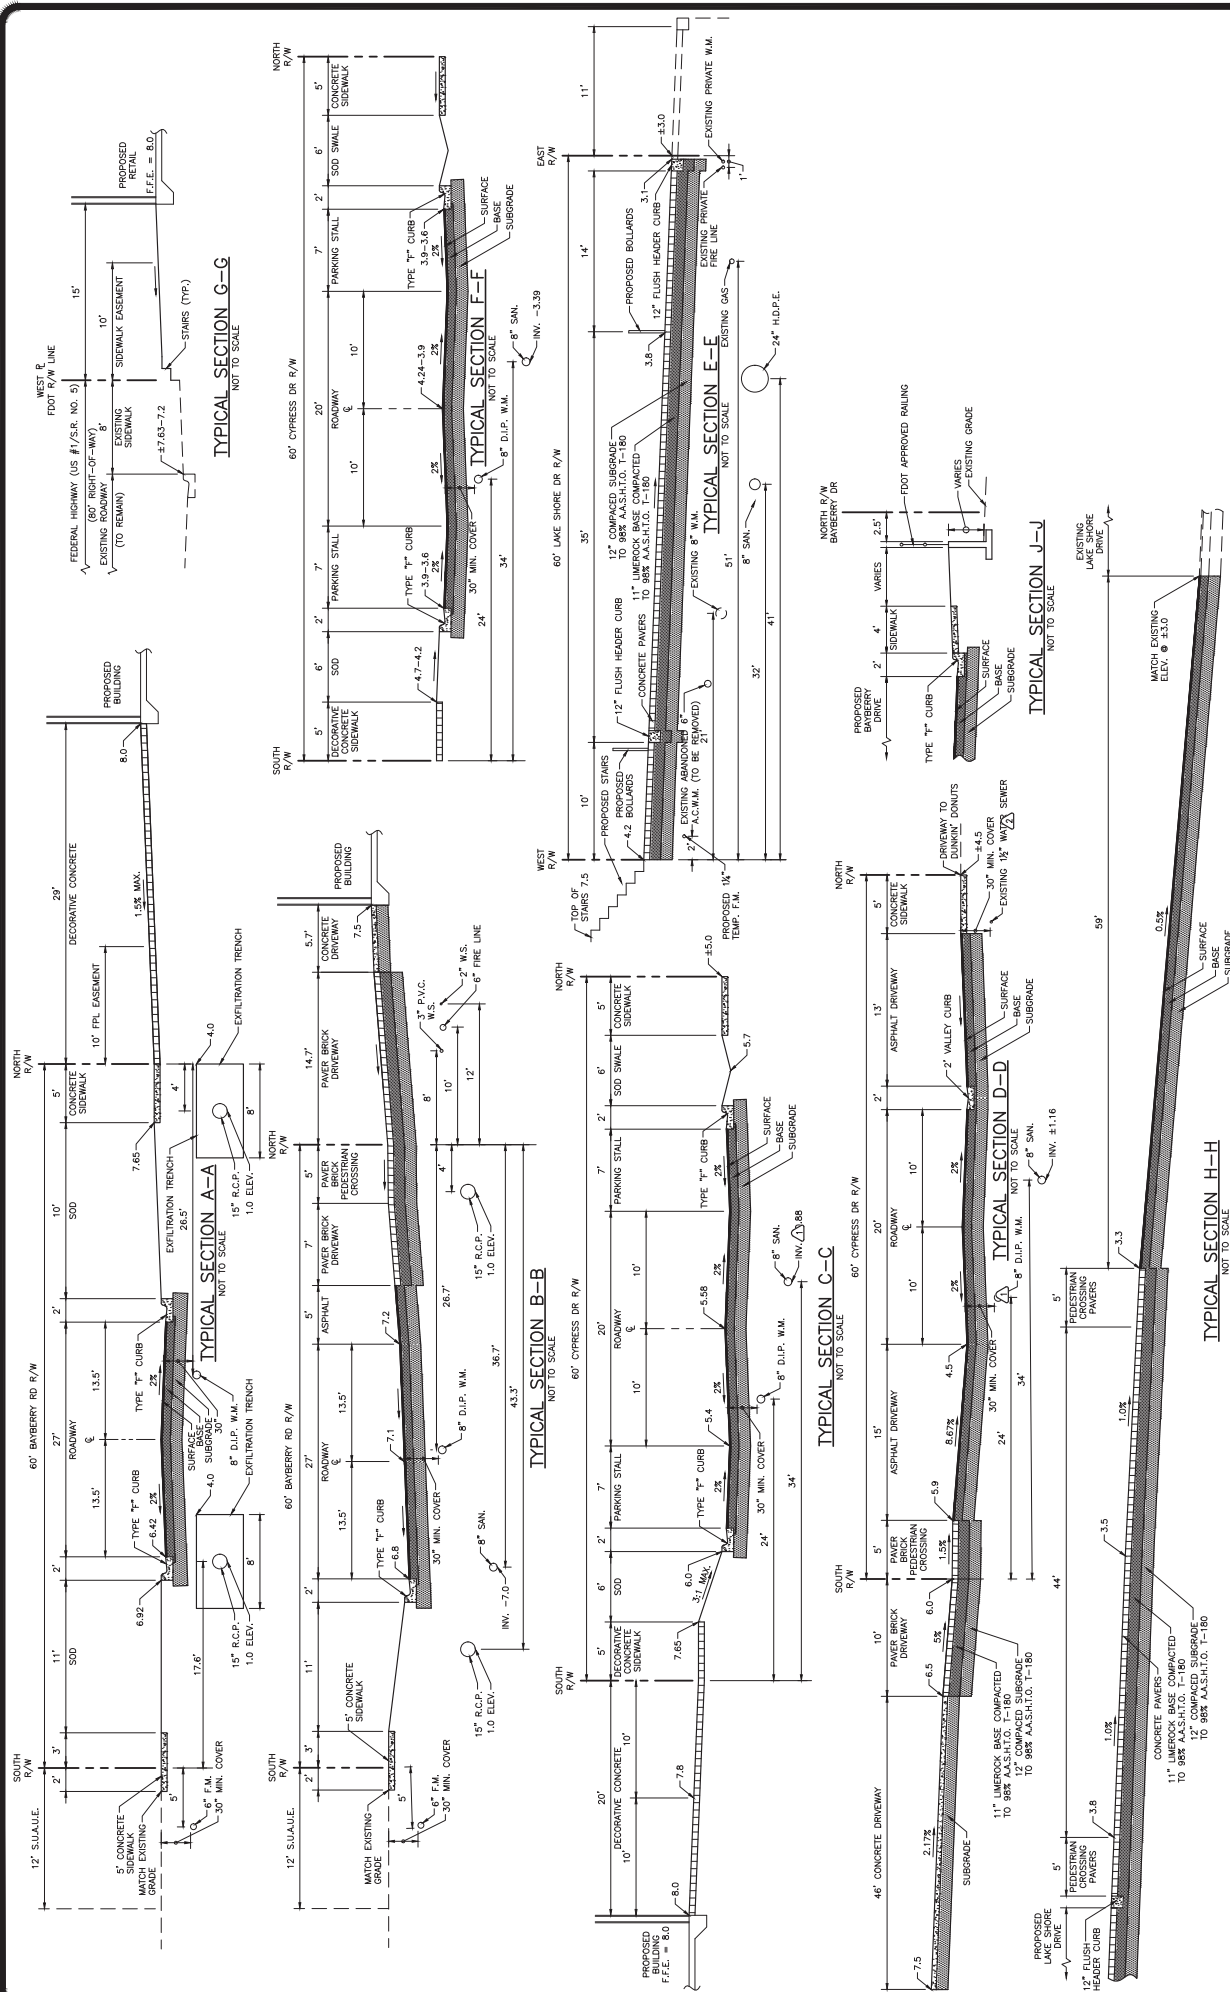

REVISIONS


NO.	DESCRIPTION	DATE
1	REVISED TYPICAL SECTIONS, 11/11/24 C.O.	11/11/24
2	REVISED TYPICAL SECTIONS, 08/02/23 C.O.	08/02/23
3	REVISED SECTION D-D, 04/19/23 C.O.	04/19/23
4	REVISED SECTION E-E, 08/04/22	08/04/22

NAUTILUS 220
SECTION 21, TOWNSHIP 42S., RANGE 43E.
TOWN OF LAKE PARK, FLORIDA
PAVING AND DRAINAGE DETAILS

SIMMONS & WHITE

DATE: 11-03-2024
JOB NO.: 19-038

THIS ITEM HAS BEEN DIGITALLY
SIGNED AND VERIFIED BY THE
ENGINEER. FOR COPIES, PLEAS
CONTACT THE ENGINEER.
11/11/24
STATE OF
FLORIDA
REGISTERED PROFESSIONAL
ENGINEER

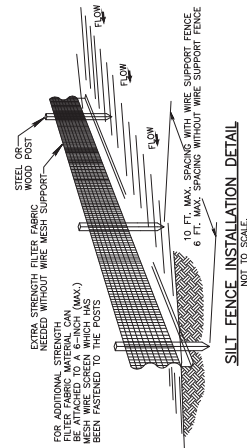


- NOTES:
- 1.) THE HEIGHT OF A SILT FENCE SHALL NOT EXCEED 36 INCHES (90 CM).
 - 2.) THE FILTER FABRIC SHALL BE PURCHASED IN A CONTINUOUS ROLL OUT TO THE LENGTH OF THE BARRIER TO AVOID THE USE OF JOINTS.
 - 3.) THE FILTER FABRIC SHALL BE SECURED TO THE BARRIER BY FASTENING THE FABRIC TO THE BARRIER WITH A MINIMUM OF 12 INCHES (30 CM) SPACING ALONG THE LINE OF POSTS AND UPLOPES FROM THE BARRIER.
 - 4.) THE FILTER FABRIC SHALL BE FASTENED TO THE BARRIER WITH A MINIMUM OF 12 INCHES (30 CM) SPACING ALONG THE LINE OF POSTS AND UPLOPES FROM THE BARRIER.
 - 5.) WHEN STANDARD STRENGTH FILTER FABRIC IS USED, A WIRE MESH SUPPORT FENCE SHALL BE FASTENED SECURELY TO THE UPSLOPE SIDE OF THE POSTS USING HEAVY DUTY GALVANIZED STEEL OR WOOD POSTS. THE WIRE MESH SHALL BE FASTENED TO THE POSTS WITH A MINIMUM OF 12 INCHES (30 CM) SPACING ALONG THE LINE OF POSTS AND UPLOPES FROM THE BARRIER.
 - 6.) THE STANDARD STRENGTH FILTER FABRIC SHALL BE STAPLED OR WIRDED TO THE FENCE. THE STAPLES OR WIRDED SHALL BE EXTENDED ABOVE THE TRENCH AND THE TRENCH SHALL NOT EXCEED MORE THAN 36 INCHES (90 CM) ABOVE THE ORIGINAL GROUND SURFACE.
 - 7.) THE TRENCH SHALL BE BACKFILLED AND THE SOIL COMPACTED OVER THE FILTER FABRIC.

POLLUTION PREVENTION NOTES:

- 1.) THIS PLAN SHOULD BE USED AS A GUIDE. A COMPLETE STORMWATER POLLUTION PREVENTION PLAN SHOULD BE DEVELOPED TO MEET OR EXCEED F.D.E.P. REQUIREMENTS.
- 2.) CONTRACTOR IS RESPONSIBLE TO ENSURE THAT NO DIRT BE DISCHARGED FROM THE SITE OR LEAVES THE SITE BY WIND, RUNOFF, OR OTHER MEANS.
- 3.) CONTRACTOR SHALL BE RESPONSIBLE FOR ALL N.D.P.E.S. REQUIREMENTS INCLUDING FILING OF N.O.I., MONITORING REPORTS AND N.O.I.
- 4.) POLLUTION PREVENTION MEASURES SHALL CONSIST OF, BUT NOT LIMITED TO, THE FOLLOWING:
 - A. CONSTRUCT WASHROCK PAD AT ALL POINTS EGRESS FOR WASHROCK OF TRUCK TIRMS.
 - B. CONSTRUCT EROSION CONTROL FENCE AND/OR TURBIDITY BARRIERS TO PREVENT EROSION AND TURBIDITY.
 - C. NO AREA SHALL BE LEFT EXPOSED TO EROSION DURING CONSTRUCTION. SEEDING AND MULCHING IS REQUIRED FOR ANY AREAS ANTICIPATED TO BE BARE DURING CONSTRUCTION FOR MORE THAN 15 DAYS.
 - D. TURBIDITY BARRIERS TO BE UTILIZED AT PROJECT OUTFALL.
 - E. OTHER MEASURES AS DIRECTED BY THE ENGINEER OR PALM BEACH COUNTY.
- 5.) IT IS THE CONTRACTOR'S RESPONSIBILITY TO COMPLY WITH ALL REQUIREMENTS FOR AFFECTED AREAS GREATER THAN 1 ACRE. POLLUTION PREVENTION MEASURES SHALL INCLUDE (BUT IS NOT LIMITED TO) THE FOLLOWING:
 - A. PREPARATION OF A STORMWATER POLLUTION PREVENTION PLAN (S.W.P.P.P.) IN ACCORDANCE WITH THE D.E.P. "GENERIC PERMIT FOR STORMWATER DISCHARGE FROM LARGE AND SMALL DEVELOPMENTS" (D.E.P. DOCUMENT NO. 62-621.300(4)(A)).
 - B. SUBMITTAL OF THE NOTICE OF INTENT (N.O.I.) TO THE D.E.P.
 - C. MAINTENANCE AND INSPECTION OF THE ELEMENTS OF THE S.W.P.P.P.
 - D. MAINTENANCE OF RECORDS (INSPECTION REPORTS, N.O.I., S.W.P.P.P., ETC.)
 - E. SUBMITTAL OF THE NOTICE OF TERMINATION TO THE D.E.P.
 - F. THE CONCLUSION OF THE PROJECT

48 HOURS BEFORE DIGGING
 1-800-432-4770
 UNIFORMED AND LITIGES
 NOTIFICATION CENTER

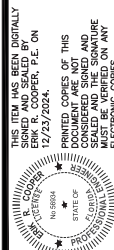

THIS ITEM HAS BEEN DIGITALLY
 SIGNED AND VERIFIED BY
 ERIC R. COOPER, P.E. ON
 12/23/2024.
 PRINTED COPIES OF THIS
 DOCUMENT ARE NOT
 VALID. THE ORIGINAL
 MUST BE SIGNED AND SEALED AND THE SIGNATURE
 MUST BE VERIFIED ON ANY
 ELECTRONIC COPIES.

SIMMONS & WHITE

2.) REVISIONS PER F.D.O.T. COMMENTS, 12/25/20 B.L.
 REVISIONS PER F.D.O.T. COMMENTS, 10/25/20 B.L.

DATE
 19-038

APPROVED
 19-038

DESIGN
 E.C.

DRAWN
 C.O.

CHECKED
 C.O.


SECTION 21, TOWNSHIP 42S., RANGE 43E.
 TOWN OF LAKE PARK, FLORIDA

NAUTILUS 220

POLLUTION PREVENTION PLAN


001892025

001892025

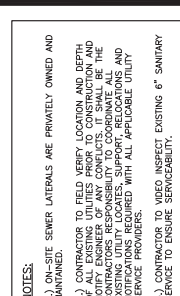


-9.54E
-10.10S

NOTE: ALL ELEVATIONS SHOWN HEREON ARE RELATIVE TO THE NORTH AMERICAN VERTICAL DATUM (N.A.V.D.) OF 1988 BASED ON A SURVEY PREPARED BY BASELINE LAND SURVEY LLC (561) 417-0700.

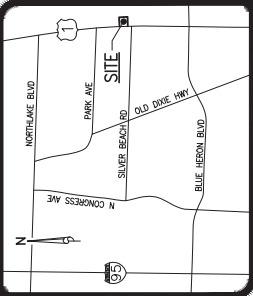


LOCATION MAP
NOT TO SCALE

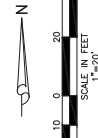

LEGEND

- 51'-4" MH MANHOLE NUMBER AND TYPE
- MANHOLE TOP ELEVATION
- MANHOLE INVERT ELEVATION
- SINGLE SEWER SERVICE W/ CLEAN-OUT
- DOUBLE SEWER SERVICE W/ CLEAN-OUT
- SANITARY SEWER LINE, MANHOLE AND DIRECTION OF FLOW
- FIRE HYDRANT W/ GATE VALVE
- WATER SERVICE, WATER METER & R.P.Z.
- GATE VALVE & GATE VALVE
- WATER MAIN & GATE VALVE
- SAW-CUT, REMOVE, & REPLACE EXISTING CONCRETE, ASPHALT, CURB, ETC.
- MILL & RESURFACE

- NOTES:
- ON-SITE SEWER LATERALS ARE PRIVATELY OWNED AND MAINTAINED.
 - CONTRACTOR TO FIELD VERIFY LOCATION AND DEPTH OF ALL EXISTING UTILITIES PRIOR TO CONSTRUCTION AND NOTIFY ENGINEER OF ANY CONFLICTS. ALL UTILITIES SHALL BE PROTECTED AND NOT REMOVED UNLESS THE EXISTING UTILITY LOCATES, SUPPORT, RELOCATIONS AND SERVICE PROVIDERS.
 - CONTRACTOR TO VIDEO INSPECT EXISTING 6" SANITARY SERVICE TO ENSURE SERVICEABILITY.
 - CONTRACTOR TO LOCATE EXISTING LATERAL TO JUNKY DONUTS AND VISA MANNA CONDOS AND CONNECT TO EXISTING 8" SANITARY LATERAL. EXISTING SANITARY SYSTEM HAS BEEN RELEASED BY THE P.B.C.H.D.

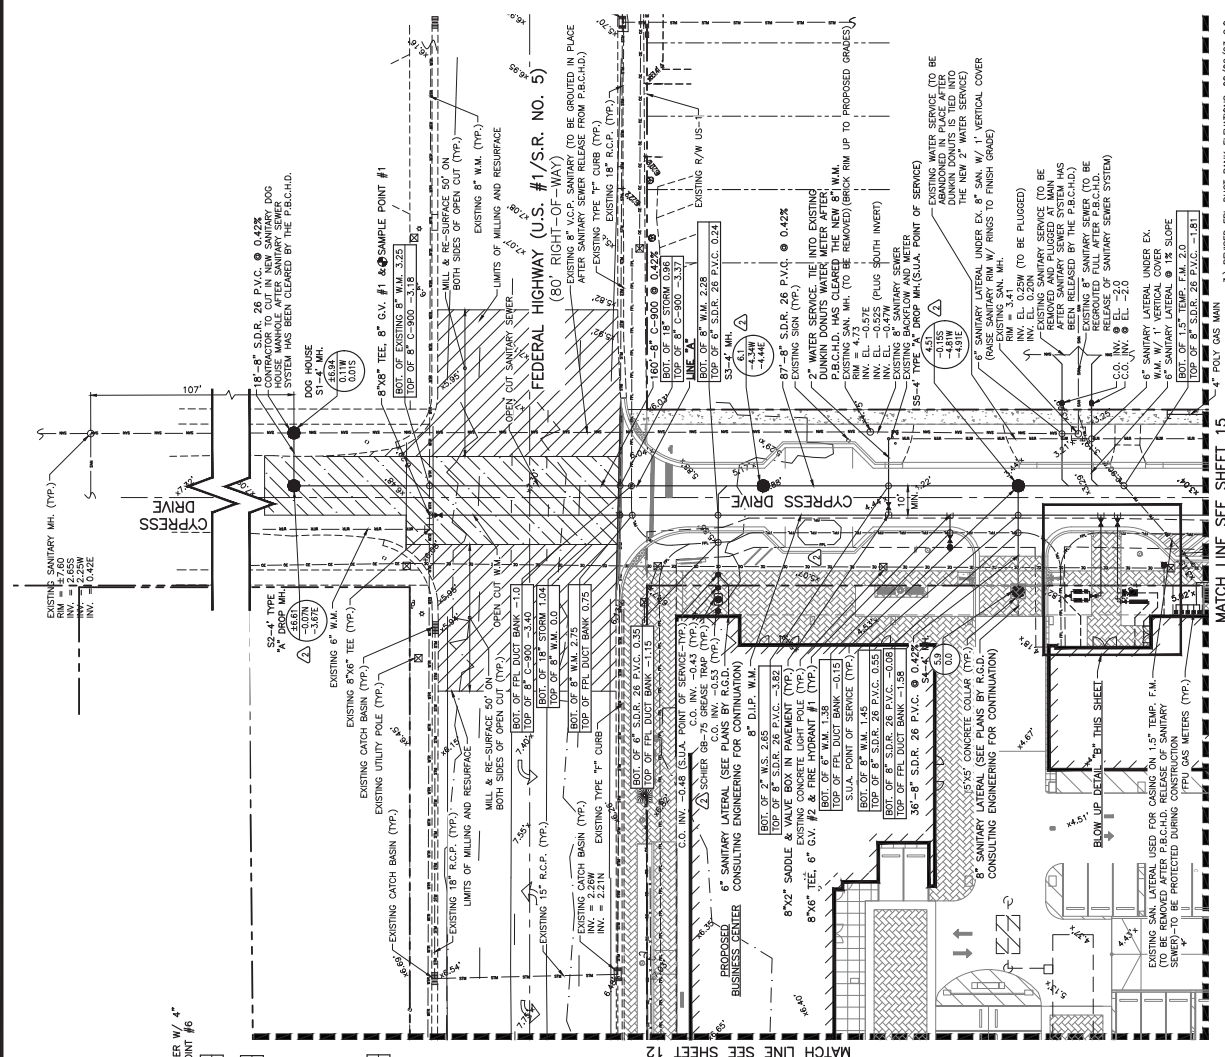

3) REVISED FPL DUCT BANK ELEVATIONS, 09/02/23 C.O.

4) FPLY GAS MAIN


5) PERMIT REVISIONS 2, 06/02/23 C.O.

6) REVISED PER S.U.A., 06/15/23 C.O.

7) REVISED PER S.U.A. COMMENTS, 11/09/22 C.O.

8) REVISED PER S.U.A. COMMENTS, 04/19/23 C.O.

9) S3 PER S.U.A. COMMENTS, 8/17/22 C.O.

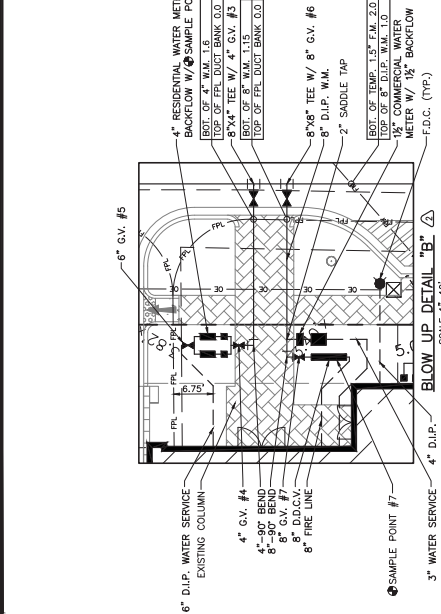

BLOW UP DETAIL "B"

SCALE 1"=10"

4" D.I.P.

6" G.V. #5

4" G.V. #4

4" 90° bend

8" G.V. #7

8" D.C.V.

8" FIRE LINE

3" WATER SERVICE















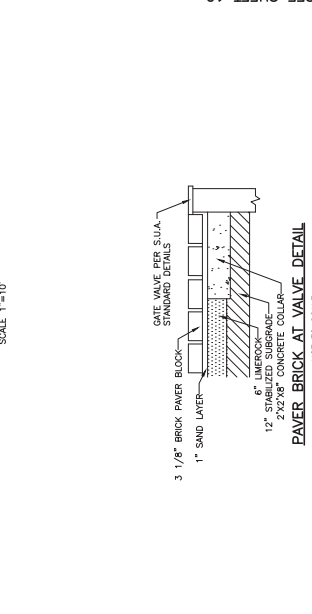

PAVER BRICK AT VALVE DETAIL

NOT TO SCALE

NOTE: SEE LANDSCAPE PLANS FOR PAVEMENT SPECIFICATIONS

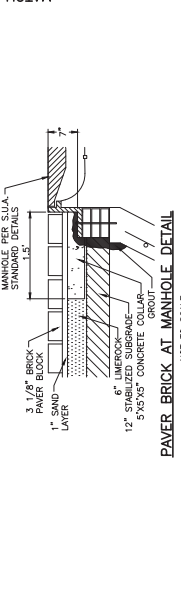

PAVER BRICK AT MANHOLE DETAIL

NOT TO SCALE

NOTE: SEE LANDSCAPE PLANS FOR PAVEMENT SPECIFICATIONS

48 HOURS BEFORE DIGGING
CALL 811 OR VISIT
1-800-4-A- Dig
FOR A FREE SERVICE
LOCATION CENTER








NOTE: ALL ELEVATIONS SHOWN HEREON ARE RELATIVE TO THE NORTH AMERICAN VERTICAL DATUM (N.A.V.D.) OF 1988 BASED ON A SURVEY PREPARED BY BASELINE LAND SURVEY, LLC (561) 417-0700.










THIS ITEM HAS BEEN DIGITALLY
SIGNED BY
ERIK R. COOPER, P.E.
ON
12/23/2024.
PRINTED COPIES OF THIS
DOCUMENT ARE NOT
VALID UNLESS THEY ARE
SEALED AND THE SIGNATURE
IS VERIFIED BY ELECTRONIC
SIGNATURE.

SIMMONS & WHITE
Professional Engineer
www.simmonsandwhite.com

NAUTILUS 220
SECTION 21, TOWNSHIP 42S., RANGE 43E.
TOWN OF LAKE PARK, FLORIDA
WATER AND WASTEWATER PLAN
JAN. NO. 19-038
DATE 12-23-2024
APPROVED
CHECKED
DESIGN
E.C.
DRAWN
C.O.
19-038

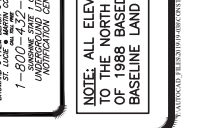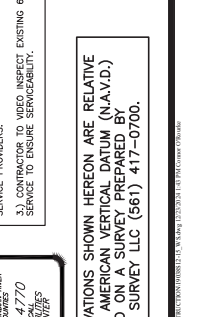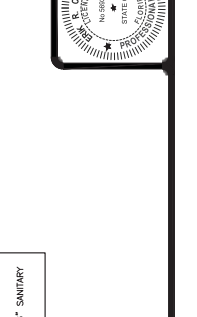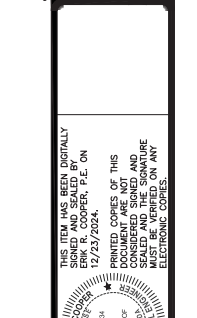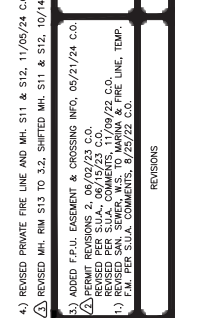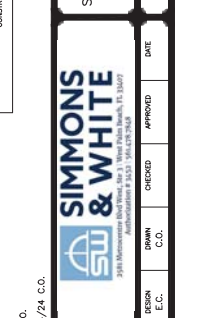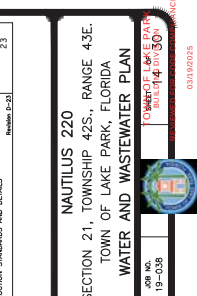



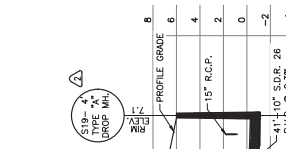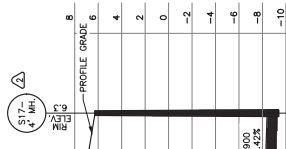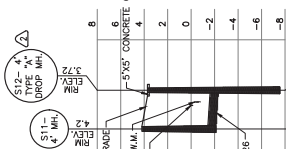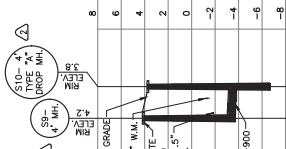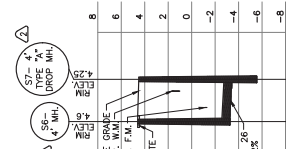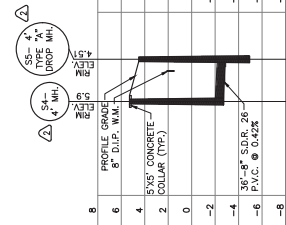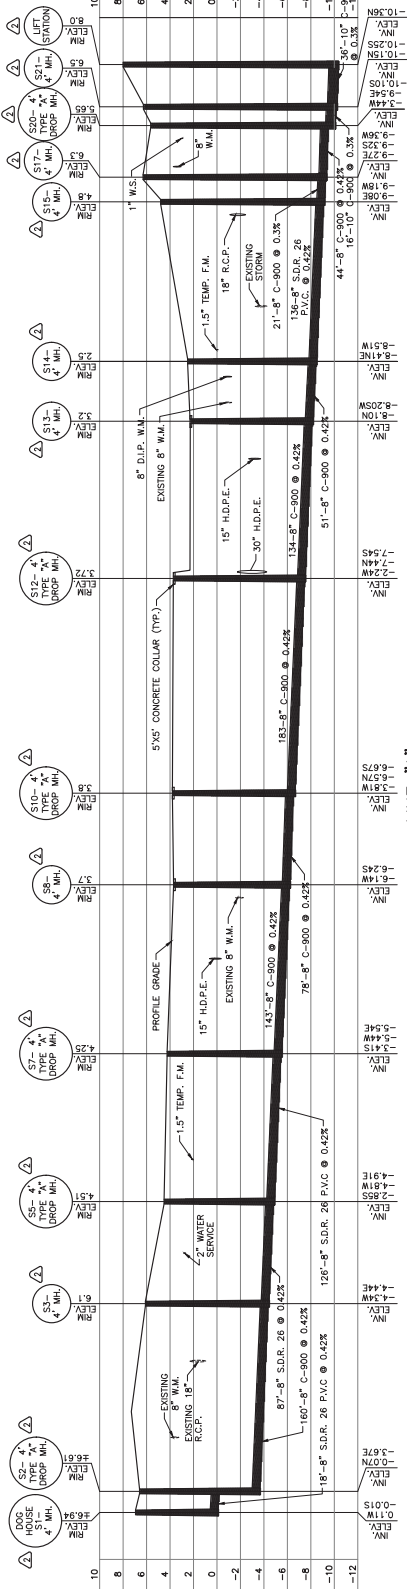

S4-S5
SCALE: 1"=50' (HORIZ.)
1"=5' (VERT.)

S6-S7
SCALE: 1"=50' (HORIZ.)
1"=5' (VERT.)


S9-S10
SCALE: 1"=50' (HORIZ.)
1"=5' (VERT.)

S11-S12
SCALE: 1"=50' (HORIZ.)
1"=5' (VERT.)

S18-S19
SCALE: 1"=50' (HORIZ.)
1"=5' (VERT.)




S19-S20
SCALE: 1"=50' (HORIZ.)
1"=5' (VERT.)

DATUM NOTES:
1.) ALL ELEVATIONS SHOWN HEREON ARE RELATIVE TO THE NORTH AMERICAN VERTICAL DATUM (N.A.V.D.) OF 1988 BASED ON A SURVEY PREPARED BY BASELINE LAND SURVEY LLC (561) 417-0700.
2.) AN APPROXIMATE CONVERSION BETWEEN THE NATIONAL GEODETIC VERTICAL DATUM (N.G.V.D.) OF 1929 AND N.A.V.D. CAN BE MADE BY ADDING 1.47 TO THE N.A.V.D. ELEVATION TO OBTAIN THE N.G.V.D. ELEVATION.

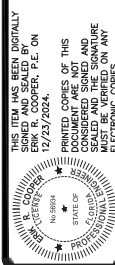

NAUTILUS 220
SECTION 21, TOWNSHIP 42S., RANGE 43E.
TOWN OF LAKE PARK, FLORIDA
SANITARY SEWER PROFILE
TOWN OF LAKE PARK

DATE: 12/23/2024

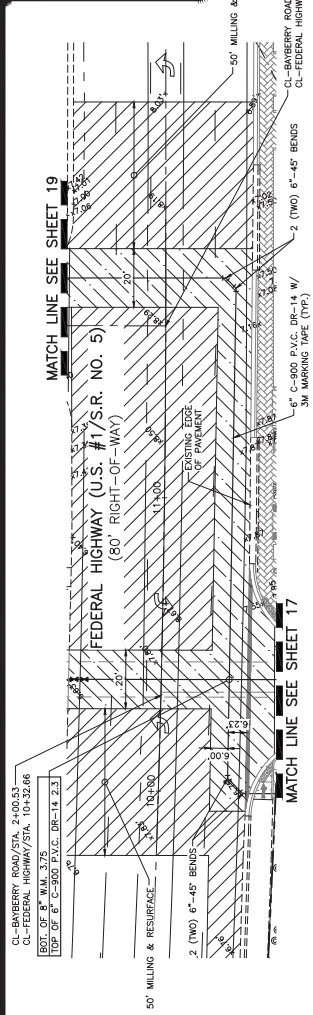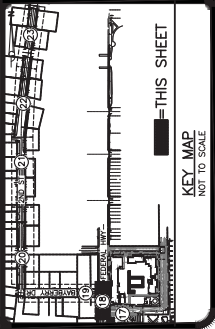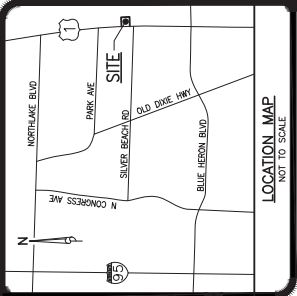

CL-BAYBERRY ROAD/STA. 21+00.53
CL-FEDERAL HIGHWAY/STA. 10+32.66
50' OF 6" W.W. 3.75
10' OF 6" C-900 P.V.C. DP-14 W/ 3M MARKING TAPE (TYP.)

50' MILLING & RESURFACE
2 (TWO) 6"-45' BENDS
6" C-900 P.V.C. DP-14 W/
3M MARKING TAPE (TYP.)


50' MILLING & RESURFACE
2 (TWO) 6"-45' BENDS
6" C-900 P.V.C. DP-14 W/
3M MARKING TAPE (TYP.)

LEGEND
SAMPLIT REMOVE & REPLACE EXISTING
CONCRETE, ASPHALT, CURB, ETC.
MILL & RESURFACE

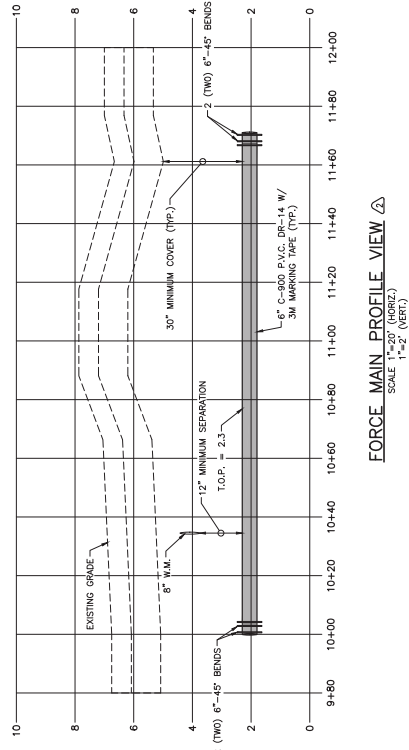

FORCE MAIN PROFILE VIEW
SCALE 1"=20' (HORIZ.)
1"=2' (VERT.)

NOTES:
CONTRACTOR TO PUT HOLE AND FIELD VERIFY
ALL CONDUIT/UTILITY CROSSINGS PRIOR TO
START OF CONSTRUCTION AND REPORT TOP
OF PIPE ELEVATION TO E.O.R.

48 HOURS BEFORE DIGGING
TO THE NORTH AMERICAN VERTICAL DATUM (N.A.V.D.)
1-800-4-4-4-4770

NOTE: ALL ELEVATIONS SHOWN HEREON ARE RELATIVE
TO THE NORTH AMERICAN VERTICAL DATUM (N.A.V.D.)
0.886 BASED ON THE 1988 DATUM
BASELINE LAND SURVEY, LLC (561) 417-0700.



THIS ITEM HAS BEEN DIGITALLY
SIGNED BY ERM R. COOPER, P.E. ON
12/23/2024.
PRINTED COPIES OF THIS
DOCUMENT ARE NOT
VALID UNLESS THEY ARE
SEALED AND THE SIGNATURE
IS VERIFIED ON ANY
ELECTRONIC COPIES.



NAUTILUS 220
SECTION 21, TOWNSHIP 42S., RANGE 43E.
TOWN OF LAKE PARK, FLORIDA
FORCE MAIN PROFILE
JAN. NO. 19-038
DATE 12/23/2024
DESIGN E.C.
CHECKED C.O.
DRAWN C.O.
APPROVED C.O.

NOTES:

CONTRACTOR TO POT HOLE AND FIELD VERIFY
EXISTING CONDITIONS AND ELEVATIONS
START OF CONSTRUCTION AND REPORT TOP
OF PIPE ELEVATION TO E.O.R.

LEGEND

- SHOULDER, REMOVE & REPLACE EXISTING
CONCRETE, ASPHALT, CURB, ETC.
- MILL & RESURFACE





KEY MAP
NOT TO SCALE

THIS SHEET

LOCATION MAP
NOT TO SCALE

MATCH LINE SEE SHEET 20

MATCH LINE SEE SHEET 18

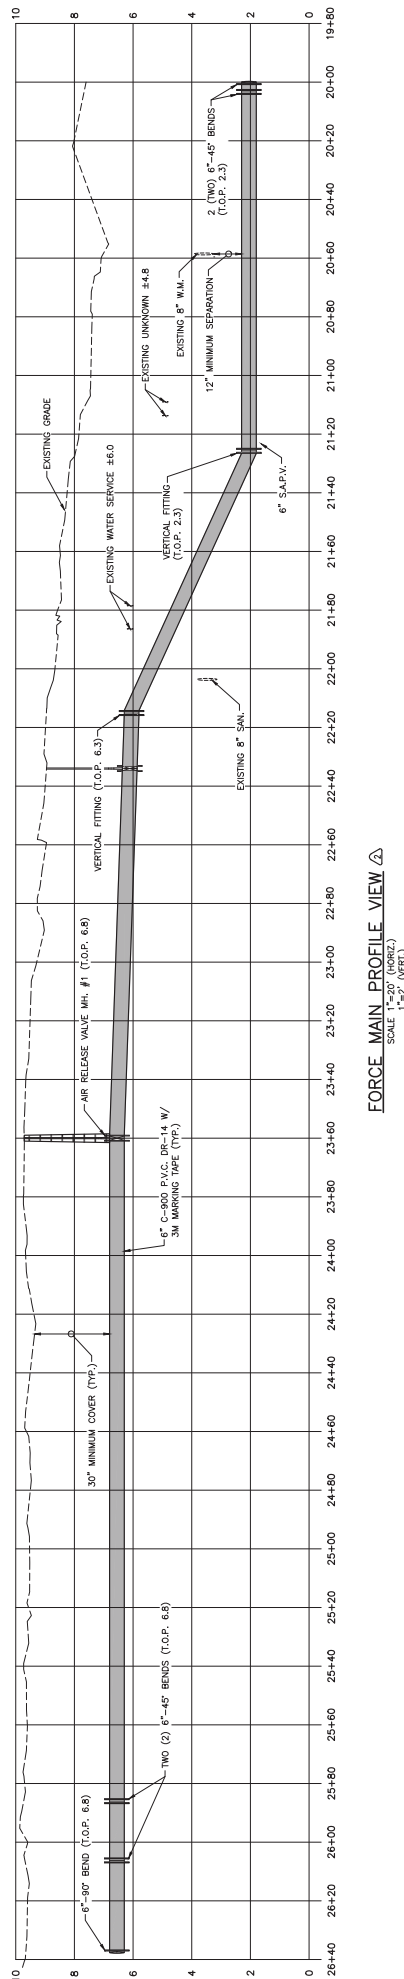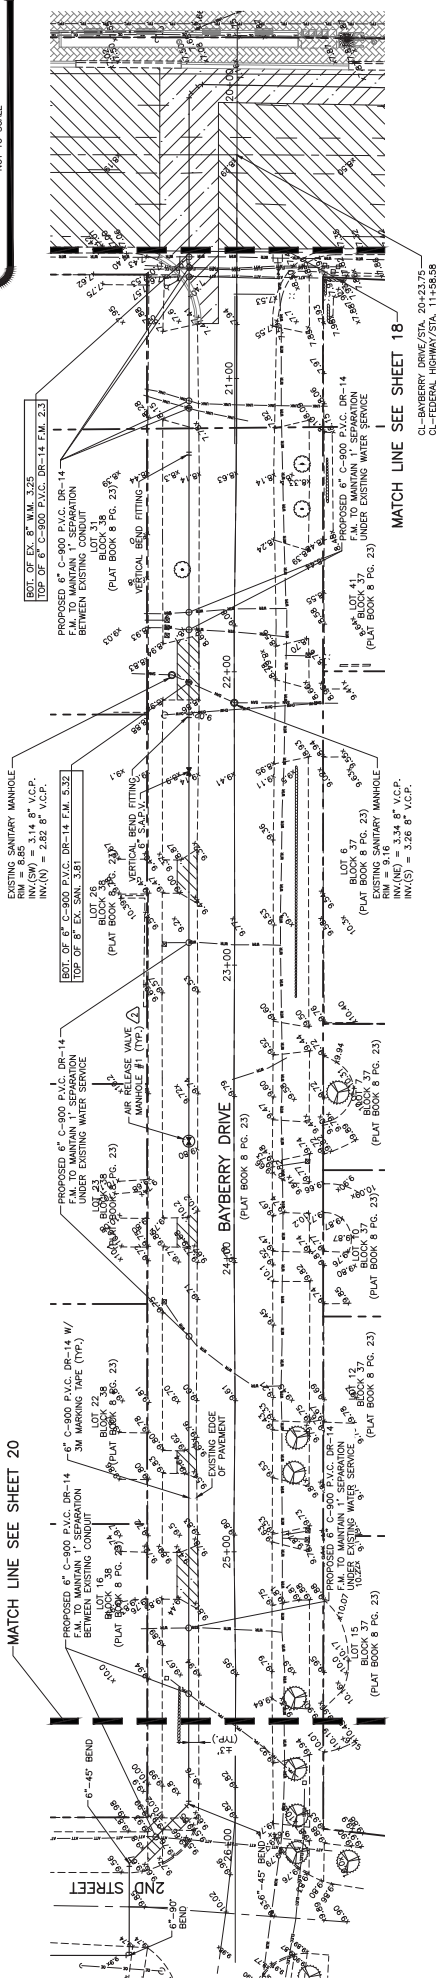

FORCE MAIN PROFILE VIEW
SCALE 1"=20' (VERT.)



NOTE: ALL ELEVATIONS SHOWN HEREON ARE RELATIVE
TO THE NORTH AMERICAN VERTICAL DATUM (N.A.V.D.)
OF 1988 BASED ON A SURVEY PREPARED BY
BASELINE LAND SURVEY LLC (561) 417-0700.

AS SHOWN REFERENCE DURING
CONSTRUCTION. SEE PLANS FOR
1 - 5000 SCALE 1"=40' 170
UNITS/INCH

PERMIT REVISIONS 2, 06/02/23 C.O.
REVISED PER S.U.A., 06/15/23 C.O.
1) 8/25/22 C.O.

SIMMONS & WHITE


NAUTILUS 220
SECTION 21, TOWNSHIP 42S., RANGE 43E.
TOWN OF LAKE PARK, FLORIDA
FORCE MAIN PROFILE
JAN. NO. 19-038
DATE APPROVED
E.C. C.O.

48 HOURS BEFORE DIGGING
NOTICE TO THE PUBLIC
1-800-442-4770
UNSAFE DRIVE LANE
NOTIFICATION CENTER

NOTES:
CONTRACTOR TO NOT HOLE AND FIELD VERIFY
ALL UTILITIES PRIOR TO STAKE CONSTRUCTION AND REPORT TOP
OF PIPE ELEVATION TO E.O.R.





LEGEND
SAWCUT, REMOVE, & REPLACE EXISTING
CONCRETE, ASPHALT, CURB, ETC.

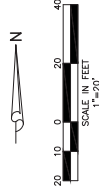

KEY MAP
NOT TO SCALE

LOCATION MAP
NOT TO SCALE

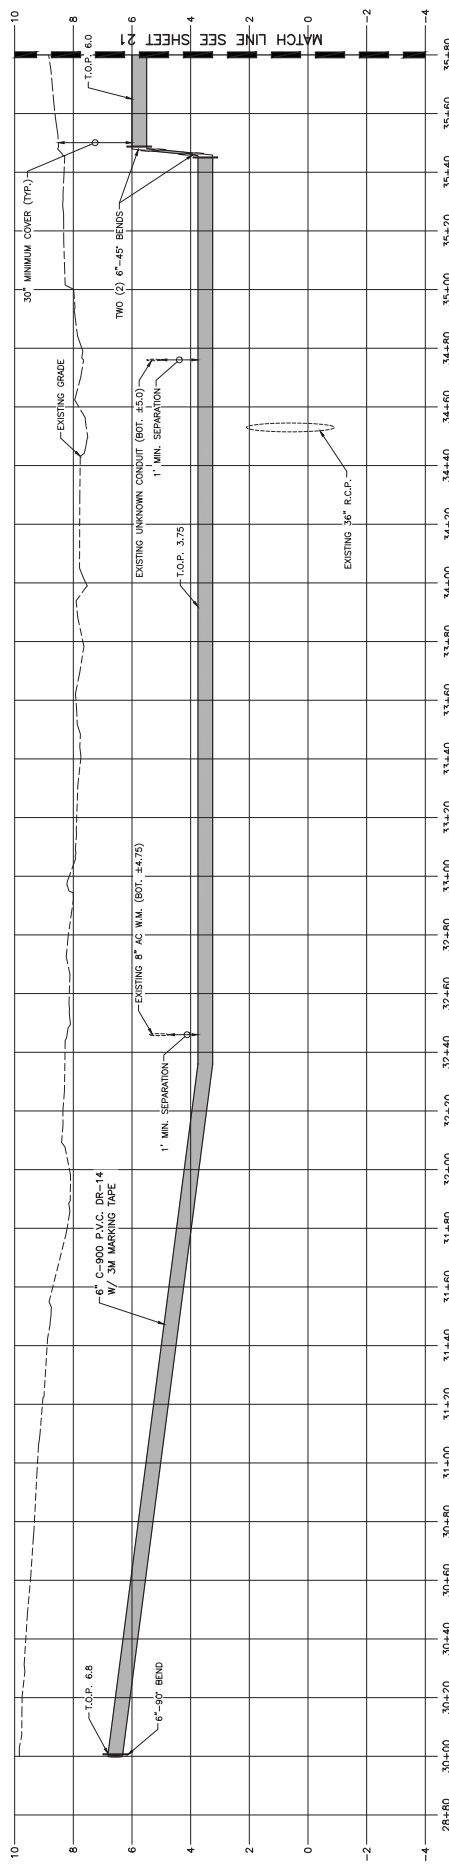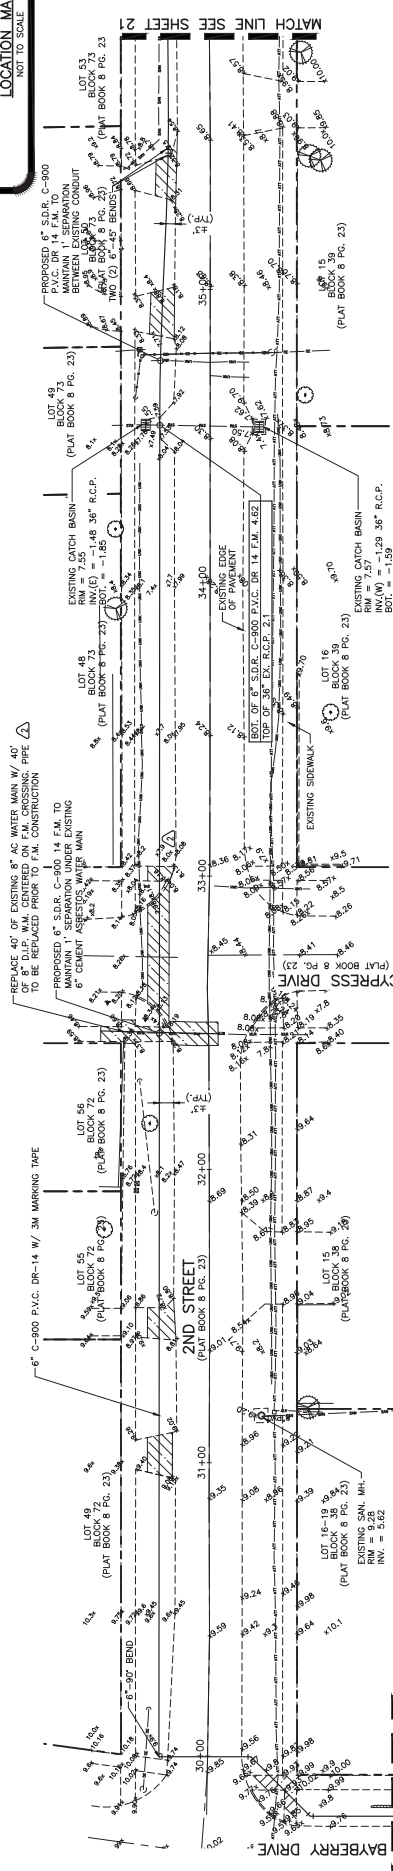

FORCE MAIN PROFILE VIEW
SCALE 1"=20' (HORIZ.)
1"=2' (VERT.)

NOTE: ALL ELEVATIONS SHOWN HEREON ARE RELATIVE
TO THE NORTH AMERICAN VERTICAL DATUM (N.A.V.D.)
ON 1988 BASE. THIS SURVEY WAS PREPARED BY
BASELINE LAND SURVEY, LLC (561) 417-0700.








THIS ITEM HAS BEEN DIGITALLY
SIGNED BY
ERIK P. COOPER, P.E. ON
12/23/2024.
PRINTED COPIES OF THIS
DOCUMENT ARE NOT
VALID UNLESS THE SIGNATURE
IS SEALED AND THE SIGNATURE
IS VERIFIED BY ELECTRONIC COPIES.

REVISIONS
DATE
APPROVED
CHECKED
DESIGN
E.C.
C.O.

SIMMONS & WHITE

NAUTILUS 220
SECTION 21, TOWNSHIP 42S., RANGE 43E.
TOWN OF LAKE PARK, FLORIDA
FORCE MAIN PROFILE
JAN. NO.
19-038
DATE
12/23/2024
TOWN OF LAKE PARK
BULL. 2019-30

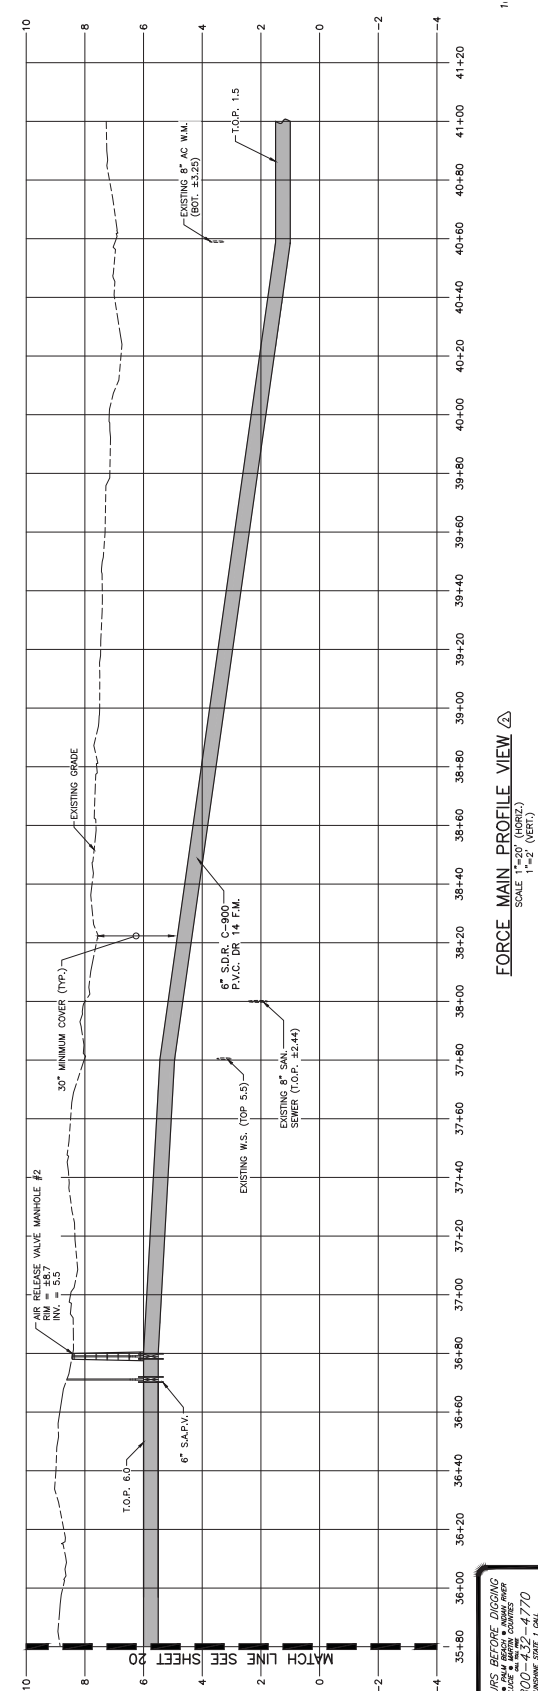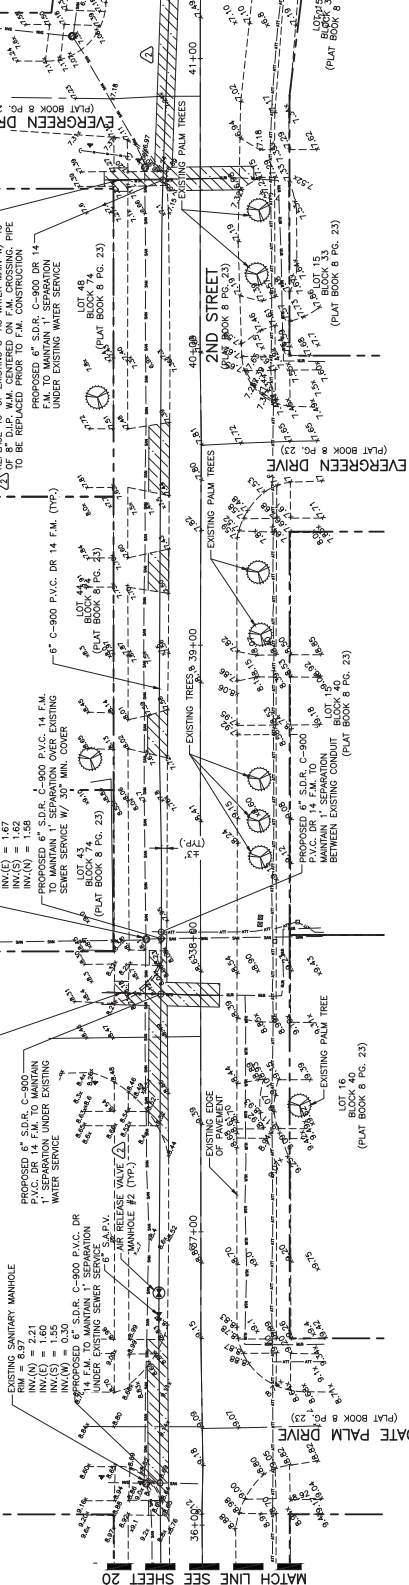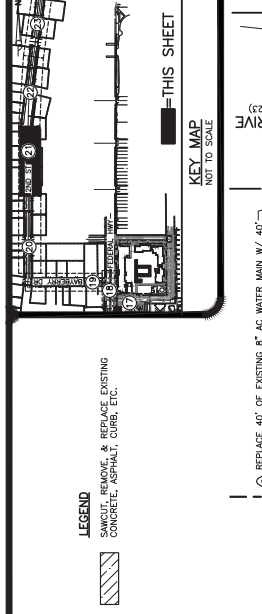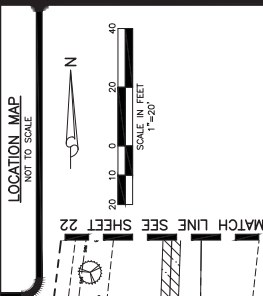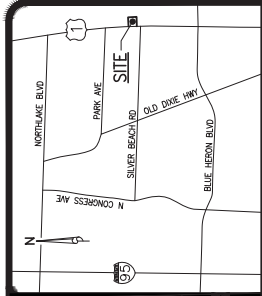

NOTES:
CONTRACTOR TO POT HOLE AND FIELD VERIFY EXISTING SEWER LINE DEPTH AND LOCATION TO START OF CONSTRUCTION AND REPORT TO OF PIPE ELEVATION TO E.O.R.

NAUTILUS 220
SECTION 21, TOWNSHIP 42S., RANGE 43E.
TOWN OF LAKE PARK, FLORIDA
FORCE MAIN PROFILE

SIMMONS & WHITE





REVISIONS
DATE
APPROVED
CHECKED
DRAWN
E.C.
C.O.

THIS ITEM HAS BEEN DIGITALLY
SIGNED BY THE ENGINEER
ON 12/23/2024.
PRINTED COPIES OF THIS
DOCUMENT ARE NOT
VALID UNLESS THE SIGNATURE
IS SEALED AND THE SIGNATURE
IS ELECTRONICALLY SIGNED.

NOTE: ALL ELEVATIONS SHOWN HEREON ARE RELATIVE
TO THE NORTH AMERICAN VERTICAL DATUM (N.A.V.D.)
ON 1988 BASE DATUM. A SURVEYOR HAS
BASELINE LAND SURVEY LLC (561) 417-0700.

48 HOURS BEFORE DIGGING
TO THE NORTH AMERICAN VERTICAL DATUM (N.A.V.D.)
1-800-4-4770-4770
NORTH AMERICAN VERTICAL DATUM
NORTH AMERICAN VERTICAL DATUM

OR CODE COMP.

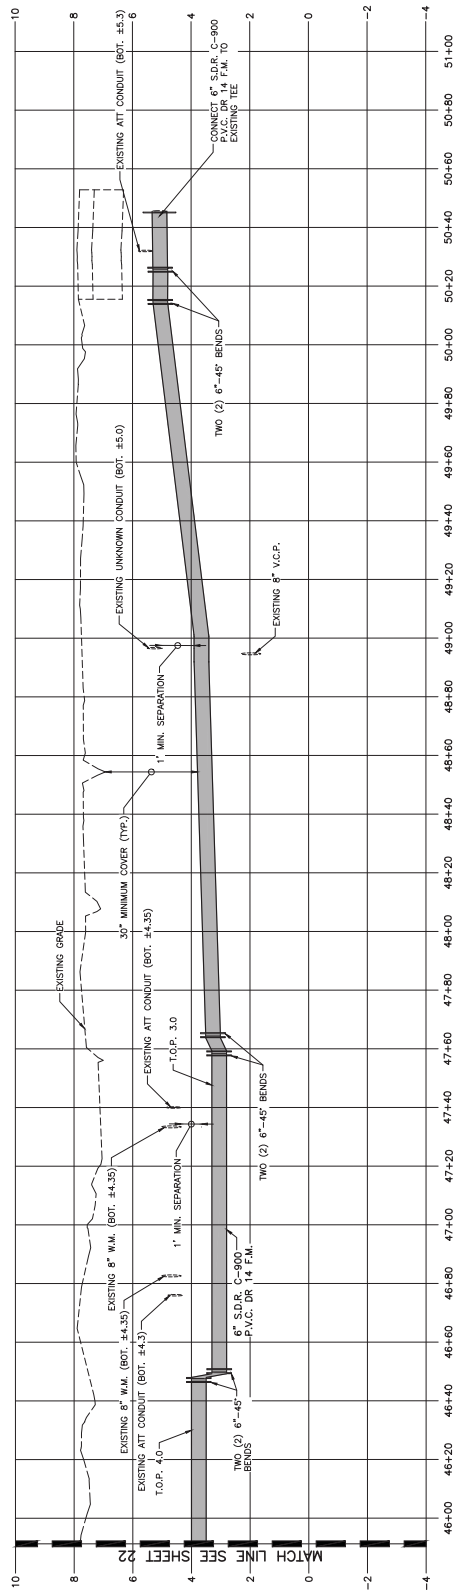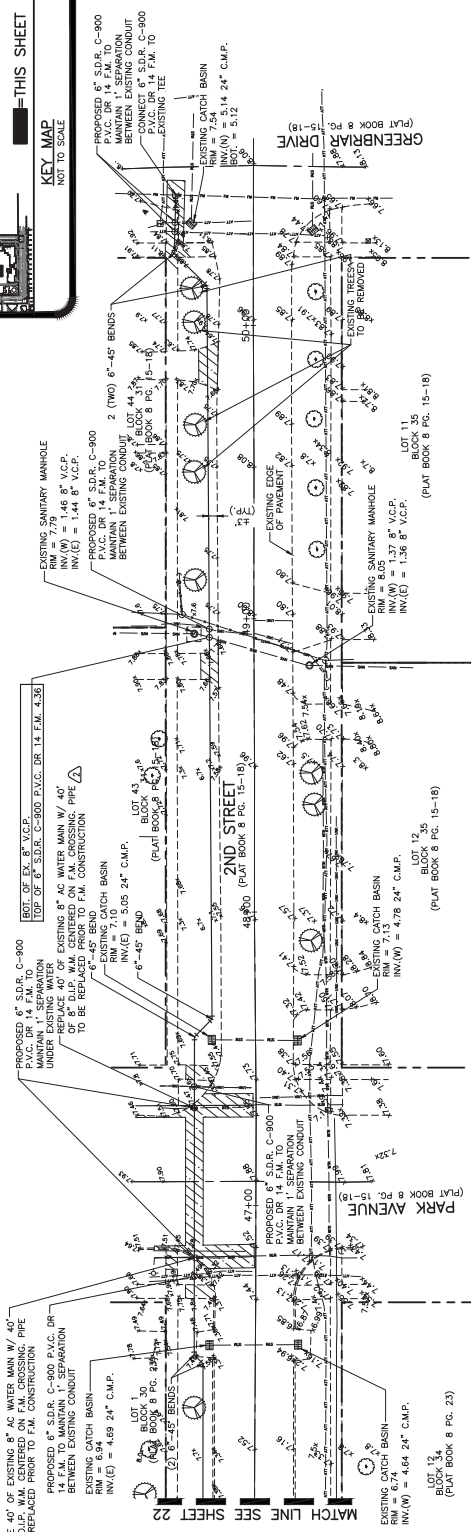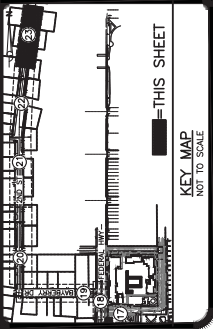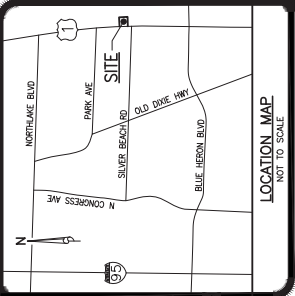

FORCE MAIN PROFILE VIEW
SCALE 1"=20' (HORIZ.)
1"=2' (VERT.)

48 HOURS BEFORE DIGGING
TO THE NORTH AMERICAN VERTICAL DATUM (N.A.V.D.)
0.886 BASED ON A SURVEY PREPARED BY
NAUTILUS 220
1-800-432-4770




REVISIONS	DATE	APPROVED	CHECKED	DRAWN	DESIGN	E.C.
1	06/02/23	C.O.				
2	07/25/22	C.O.				











NAUTILUS 220
SECTION 21, TOWNSHIP 42S., RANGE 43E.
TOWN OF LAKE PARK, FLORIDA
FORCE MAIN PROFILE
JAN. NO. 19-038
DATE 12-23-2024
091892025

		DESIGN E.C.O.	DRAWN C.O.I.	CHECKED C.O.I.	APPROVED	DATE	TOWN OF LAKE PARK 024 030

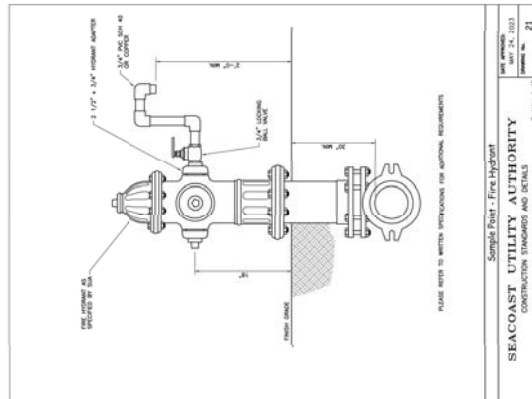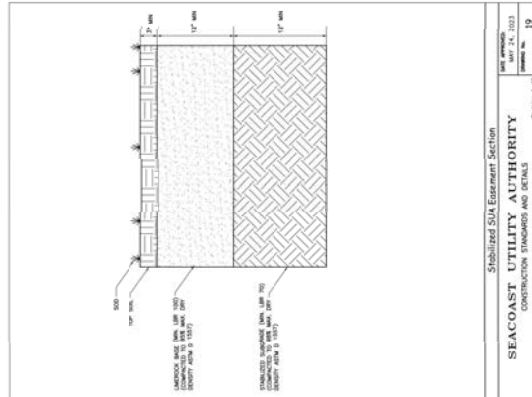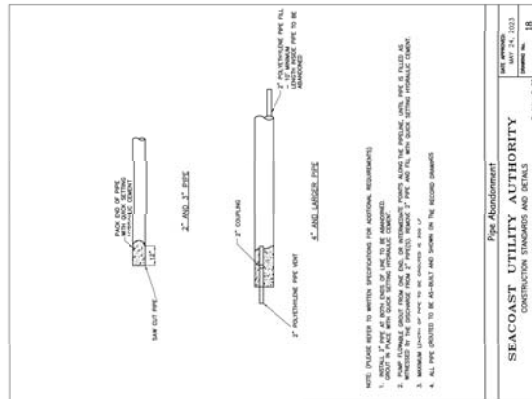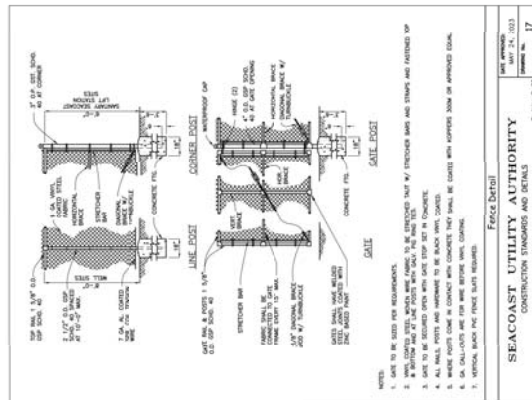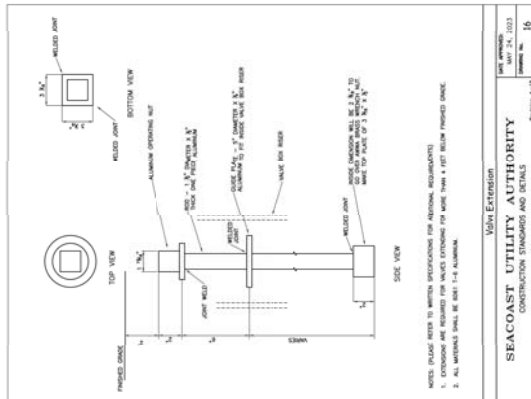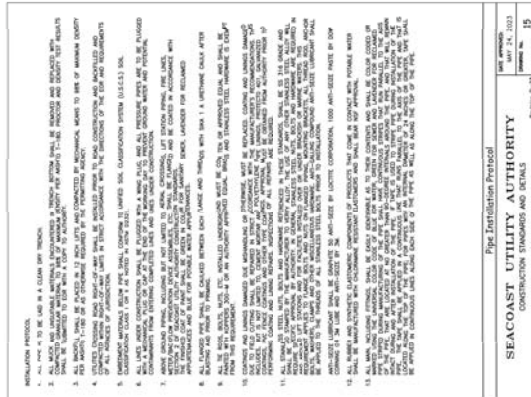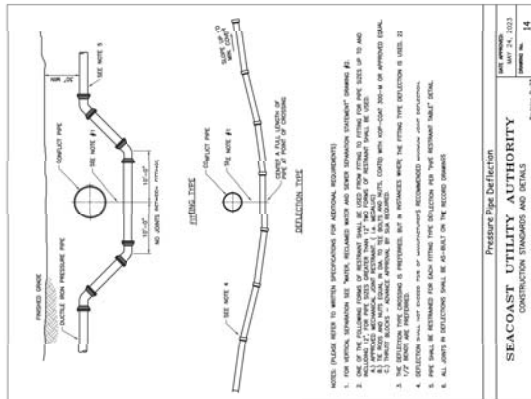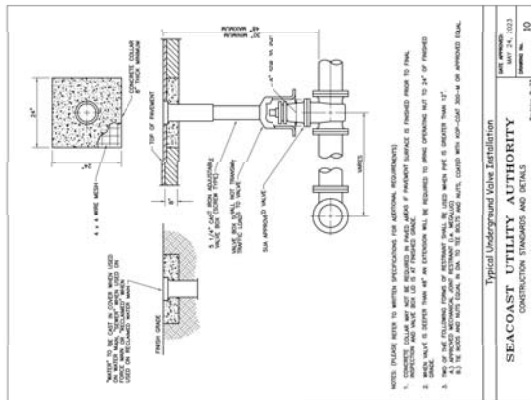

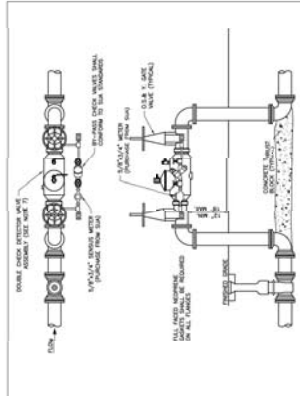


- [illegible]

Above Ground Fireline	
SEACOAST UTILITY AUTHORITY CONSTRUCTION STANDARDS AND DETAILS	
SHEET APPROVED MAY 24, 2023	DRAWING NO. 34

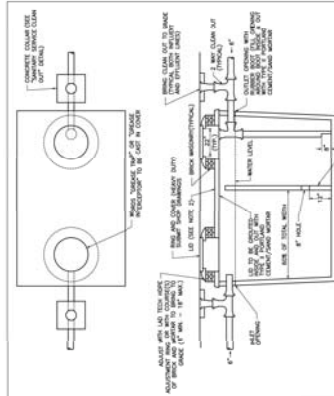


- [illegible]

Concrete Grease Interceptor SEACOAST UTILITY AUTHORITY CONSTRUCTION STANDARDS AND DETAILS	DATE APPROVED MAY 24, 2023	DRAWING NO. 47

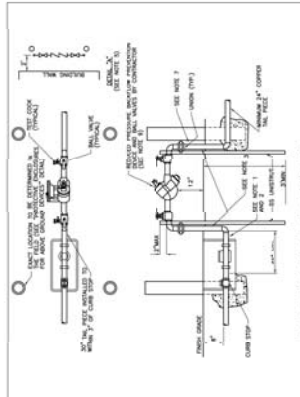


- [illegible]

Water Meter and Backflow Device 3/4" to 2" SEACOAST UTILITY AUTHORITY CONSTRUCTION STANDARDS AND DETAILS	DATE REVISED	36
	MAY 24, 2023	
	Sheet No.	Revision No. 13

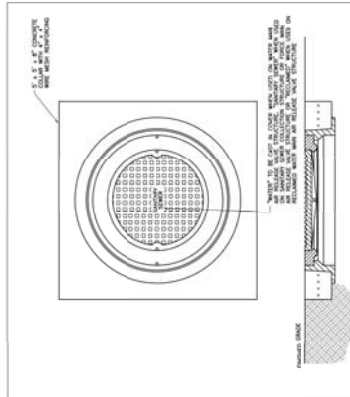


- NOTES (PLEASE REFER TO WRITTEN SPECIFICATIONS FOR ADDITIONAL REQUIREMENTS)
1. IN OTHER AREAS OR AN AREA DEEMED TO HAVE QUESTIONABLE DRAINAGE, A WATER TIGHT MANHOLE INSERT SUCH AS "GROMER" QUALITY OR APPROVED EQUIV. WILL BE REQUIRED.
 2. APPROVED MANHOLES SHOWN: CROWN 7'-0"
 A) U.S. FOUNDRY MODEL NO. 220-148-0
 B) VALON FOUNDRY MODEL NO. 104-101
 3. CONCRETE TOLLIN IS REQUIRED ON EACH MANHOLE IS OUT OF FRAMEWORK.

Manhole Frame and Cover (30" Opening) SEACOAST UTILITY AUTHORITY CONSTRUCTION STANDARDS AND DETAILS	SHEET NUMBER	50
	DATE	MAY 24, 2023
	SHEET NO.	

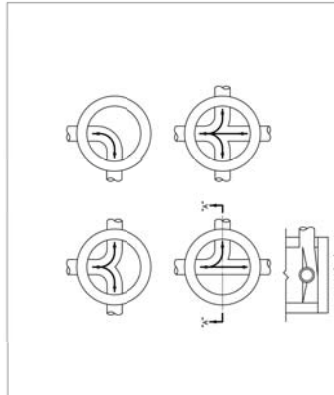


- NOTE: PLEASE REFER TO WRITTEN SPECIFICATIONS FOR ADDITIONAL REQUIREMENTS.
1. SHEET CHANNELS TO BE CONSTRUCTED FOR TROUGH FLOW WITH NO OBSTRUCTIONS.
 2. SPILLWAYS SHALL BE CONSTRUCTED BETWEEN PILES WITH DIFFERENT BATTERY ELEVATIONS PROVIDING FOR SMOOTH FLOW.
 3. CHANNELS FOR FUTURE CONSTRUCTIONS (STUARD) SHALL BE CONSTRUCTED FILLED WITH SAND AND COVERED WITH 1" OF ASPHALT.
 4. SLOPE SAMPLE FILLS WITH A 1:2 SLOPE FROM MARBLE LANT TO CHANNEL.
 5. SHEET PILES SHALL BE A MINIMUM OF 1/2 THE DIAMETER OF THE LARGEST PILE ON 4" DEEP JACKHOLLS IF GRADER.

Flow Patterns for Invert Channels	
DATE APPROVED	MAY 24, 2023
DRAWING NO.	51

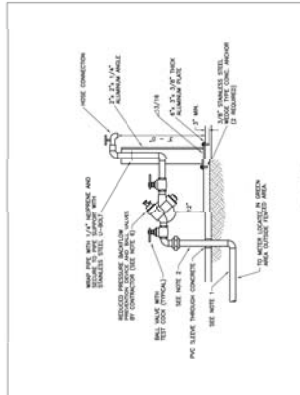


- NOTES: (PLEASE REFER TO WRITTEN SPECIFICATIONS FOR ADDITIONAL REQUIREMENTS)
1. TYPE "A" COVER TUBING (SEE DRAWING).
 2. ADD NOTES SUCH AS "THIS COVER TUBING SHALL COMPLY WITH APPROVED LISTED FITNESS AND CAPACITY. ONLY LISTED TYPE, FITTING, MANUFACTURER, SIZE AND WALL THICKNESS SHALL BE INSTALLED."
 3. BACKFLOW PREVENTION DEVICE SHALL BE CAPABLE WITH LISTED VALVES.
 4. FOR PACKAGING OF BACKFLOW ASSEMBLY WITHIN FITTING AND TEST "TYPICAL LISTED SIZE PLANT" SIZE.
 5. BACKFLOW PREVENTION DEVICE SHALL BE SUPPORTED BY 2X6 STUDS WITH ALUMINUM ANGLE AS SHOWN ABOVE. NOTES TO BE CLIPPED TO AND TYPED WITH THIS SET OF DRAWINGS AND APPROVED MODIFICATIONS.

Lift Station Backflow Preventer Assembly
SAT APPROVED: MAY 24, 2023
DRAWING NO. 38

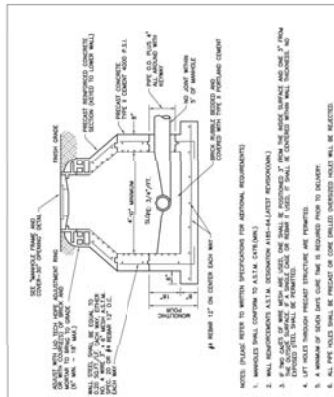



Standard Precast Concrete	DATE APPROVED: MAY 24, 2023	DESIGNED BY: 52
SEACOAST UTILITY AUTHORITY CONSTRUCTION STANDARDS AND DETAILS		

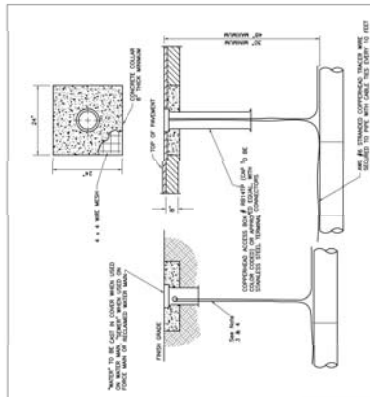


- NOTE: PLEASE REFER TO WRITTEN SPECIFICATIONS FOR ADDITIONAL REQUIREMENTS.
1. REQUIRED TOP AND PFC MARKS AND AS DIRECTED BY SNA.
 2. 800' WALK-TO SURVEILLANCE DISTANCE. *WALK-TO ACCESS BUA'S.
 3. 1/2" x 4" COPPER CLAD GROUND RODS SHALL BE INSTALLED AT BOTH TERMINAL ENDS OF THE TACKER WIRE AND BE ACCESSIBLE.
 4. 1/2" x 4" COPPER CLAD GROUND ROD SHALL BE INSTALLED WHERE PIPE IS BELOW WATER TABLE.
 5. IF A NEW LINE ROD (DRAWING 110) IS IN THE VICINITY, THE TACKER WIRE ACCESS BOX MAY BE MOVED IN THE NAME


Tracer Wire Access Box	
SEACOAST UTILITY AUTHORITY CONSTRUCTION STANDARDS AND DETAILS	
DATE APPROVED: MAY 24, 2023	DRAWING NO.: 44

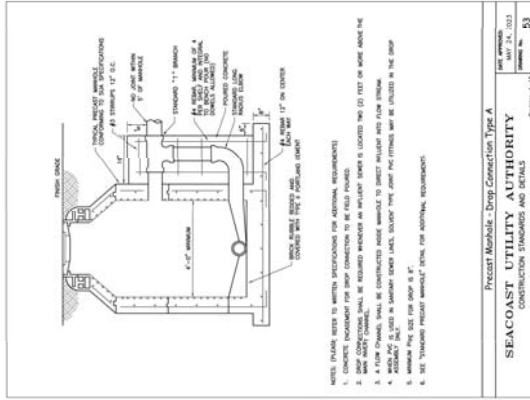


Precast Manhole - Drop Connection Type A	
CONSTRUCTION STANDARDS AND DETAILS	REVISION: 53

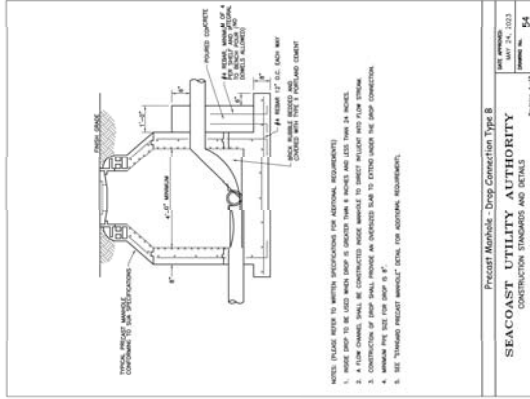


Precast Manhole - Drop Connection Type B	
CONSTRUCTION STANDARDS AND DETAILS	REVISION: 54

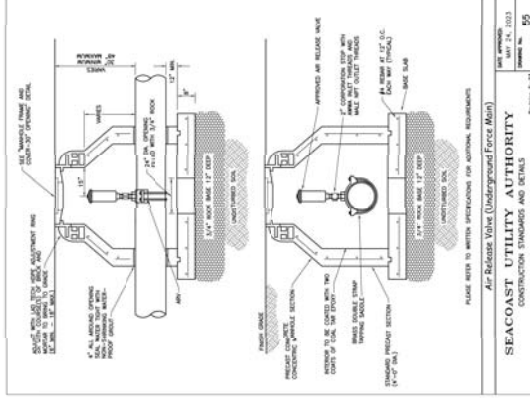


Air Release Valve (Underground Force Main)	
CONSTRUCTION STANDARDS AND DETAILS	REVISION: 55

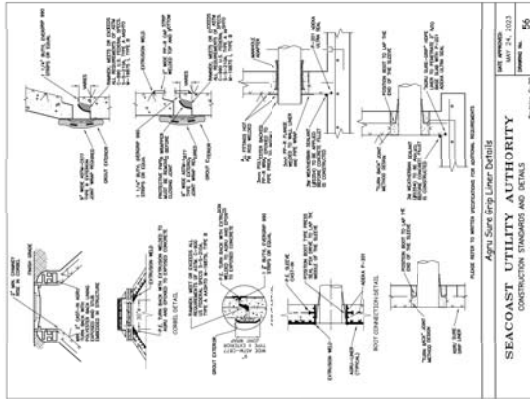


CONSTRUCTION STANDARDS AND DETAILS	REVISION: 56

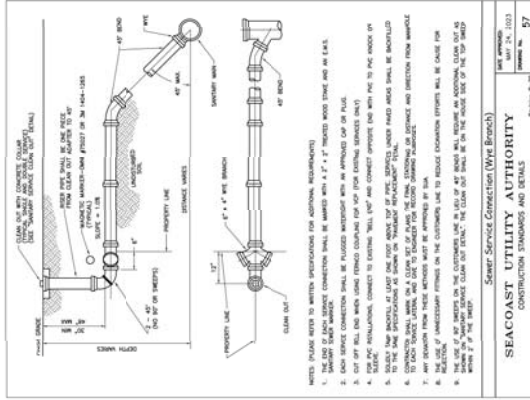


Sewer Service Connection (Wye Branch)	
CONSTRUCTION STANDARDS AND DETAILS	REVISION: 57

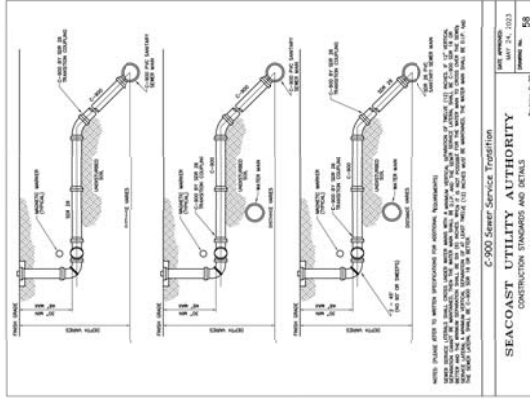

SEACOAST UTILITY AUTHORITY	DATE: JAN 24, 2023
CONSTRUCTION STANDARDS AND DETAILS	REVISION: 58

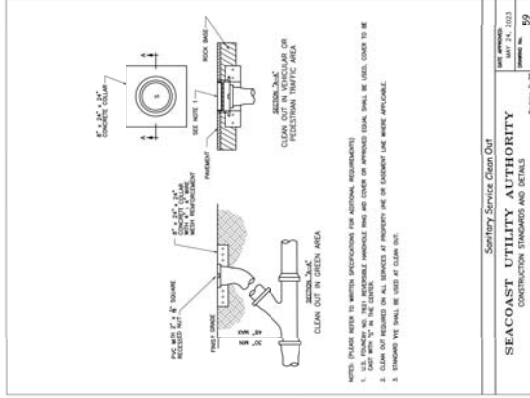

Sanitary Service Clean Out	
SEACOAST UTILITY AUTHORITY	DATE: JAN 24, 2023
CONSTRUCTION STANDARDS AND DETAILS	REVISION: 59

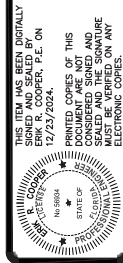








SEACOAST UTILITY AUTHORITY
CONSTRUCTION STANDARDS AND DETAILS

NAUTILUS 220
SECTION 21, TOWNSHIP 42S., RANGE 43E.
TOWN OF LAKE PARK, FLORIDA
WATER AND WASTEWATER DETAILS

DATE: 12/23/2024
APPROVED: [Signature]
CHECKED: [Signature]
DRAWN: [Signature]
E.C. [Signature]

JOHN NO. 19-038
19-038

00182025

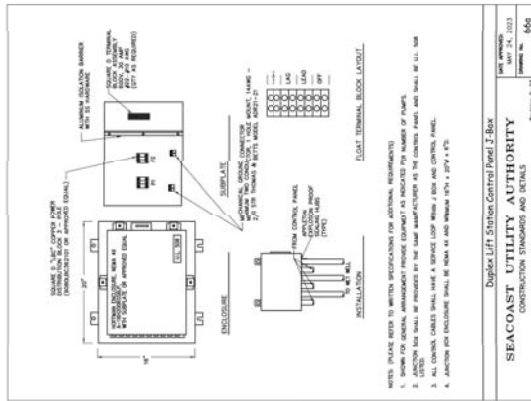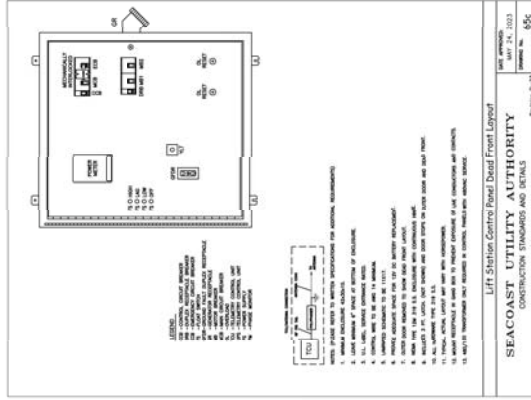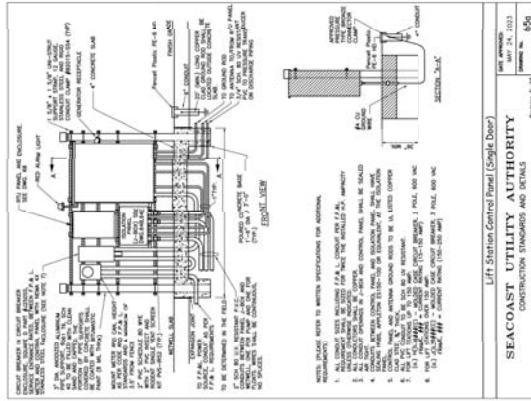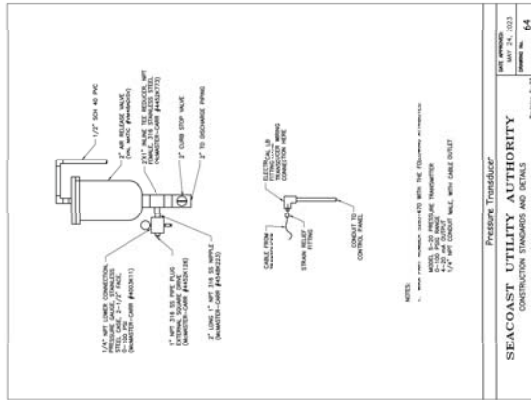[illegible]