


The floor plans do not represent the correct scale & dimensions. Per the survey, front (west) property line is 600'. The west sides of the north & south wings are 203' in length, & the existing school is 172' in length.

Consultants

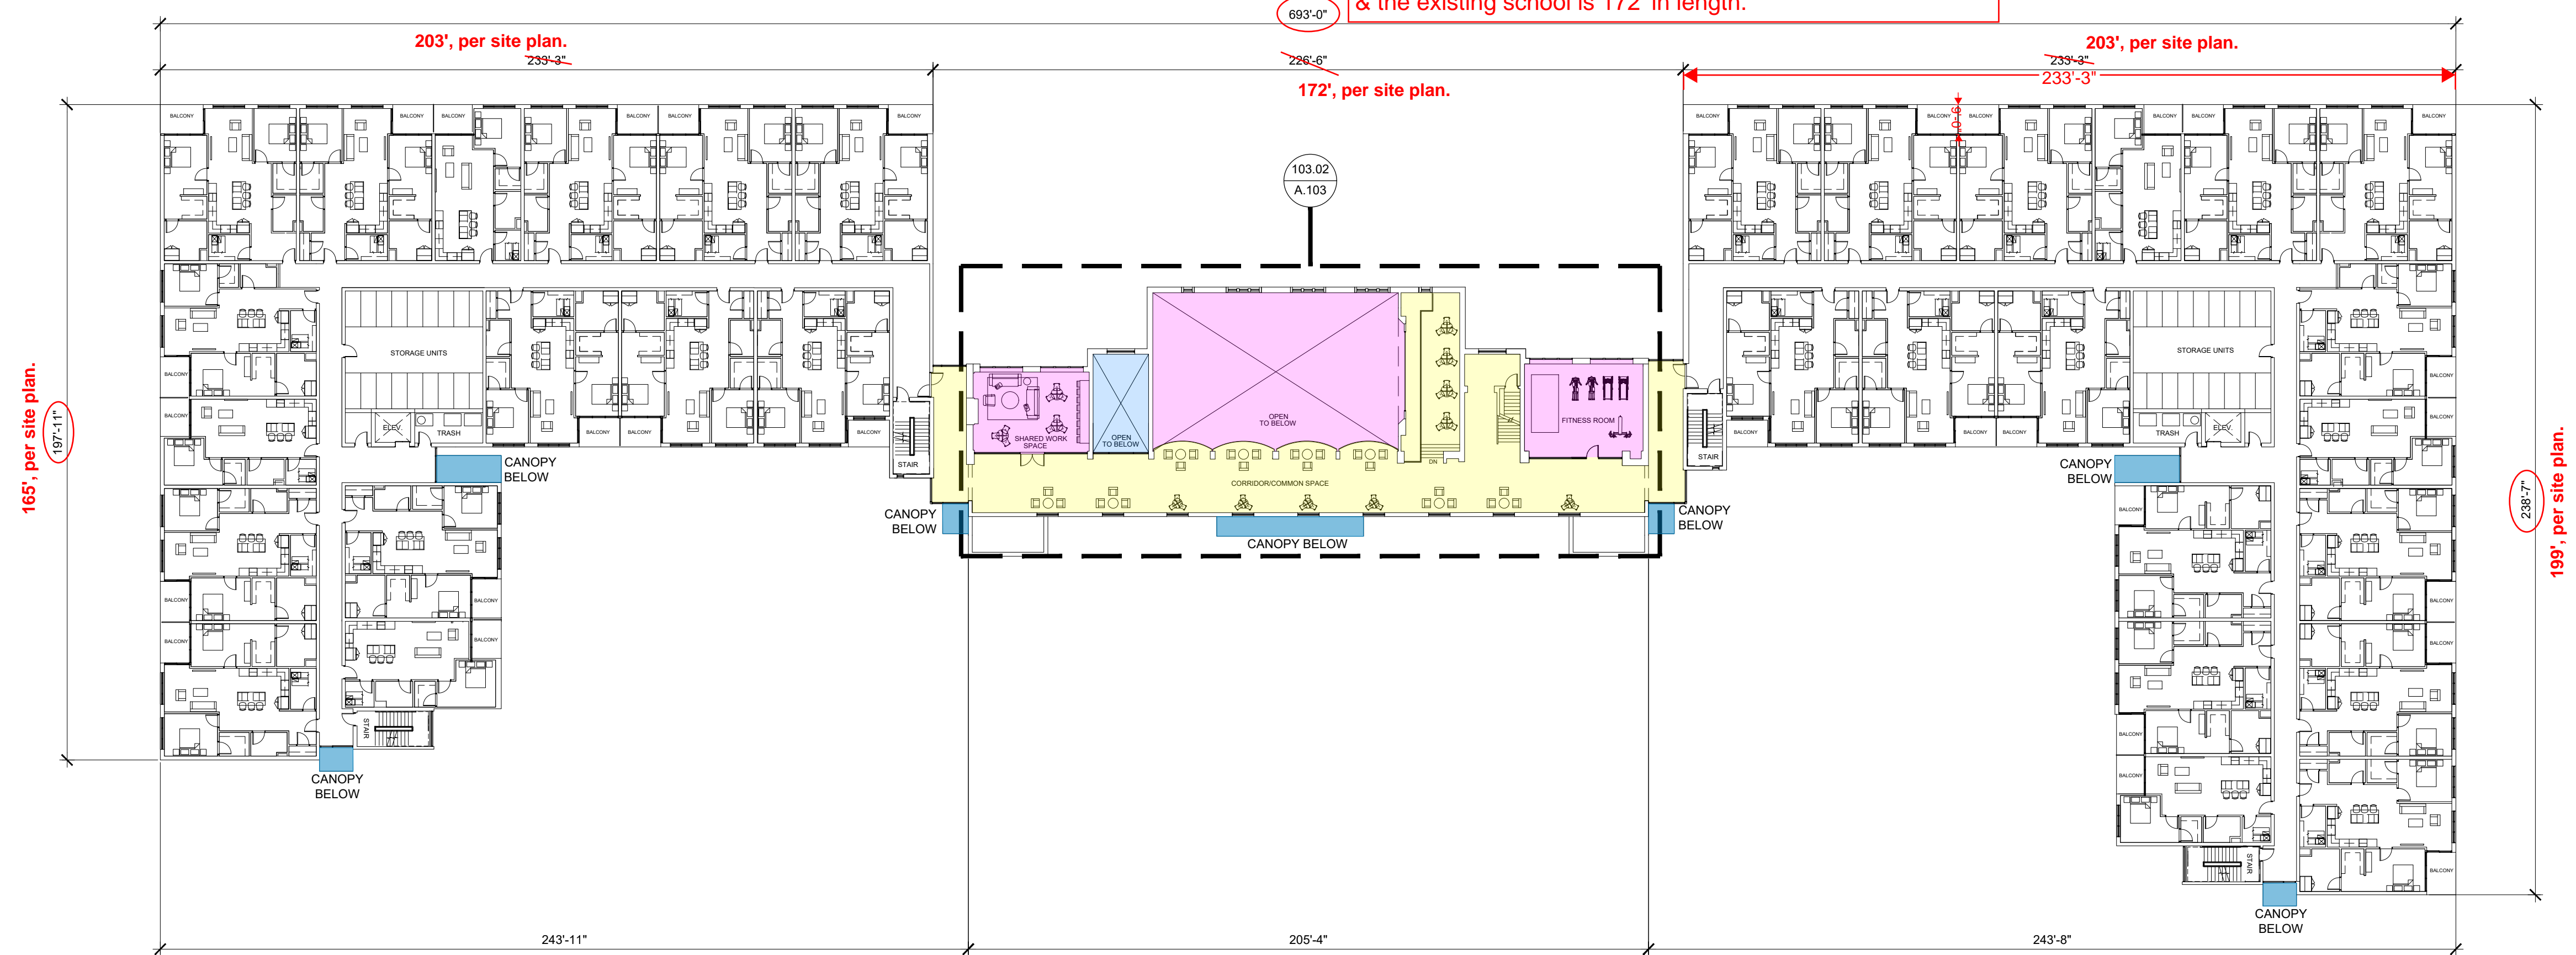


SECOND FLOOR PLAN
SCALE: 1/32"=1'-0"

Project title

PROPOSED BUILDING ADDITION FOR:
**27700 Southfield Rd,
Lathrup Village**

27700 Southfield Road
Lathrup Village, MI 48076

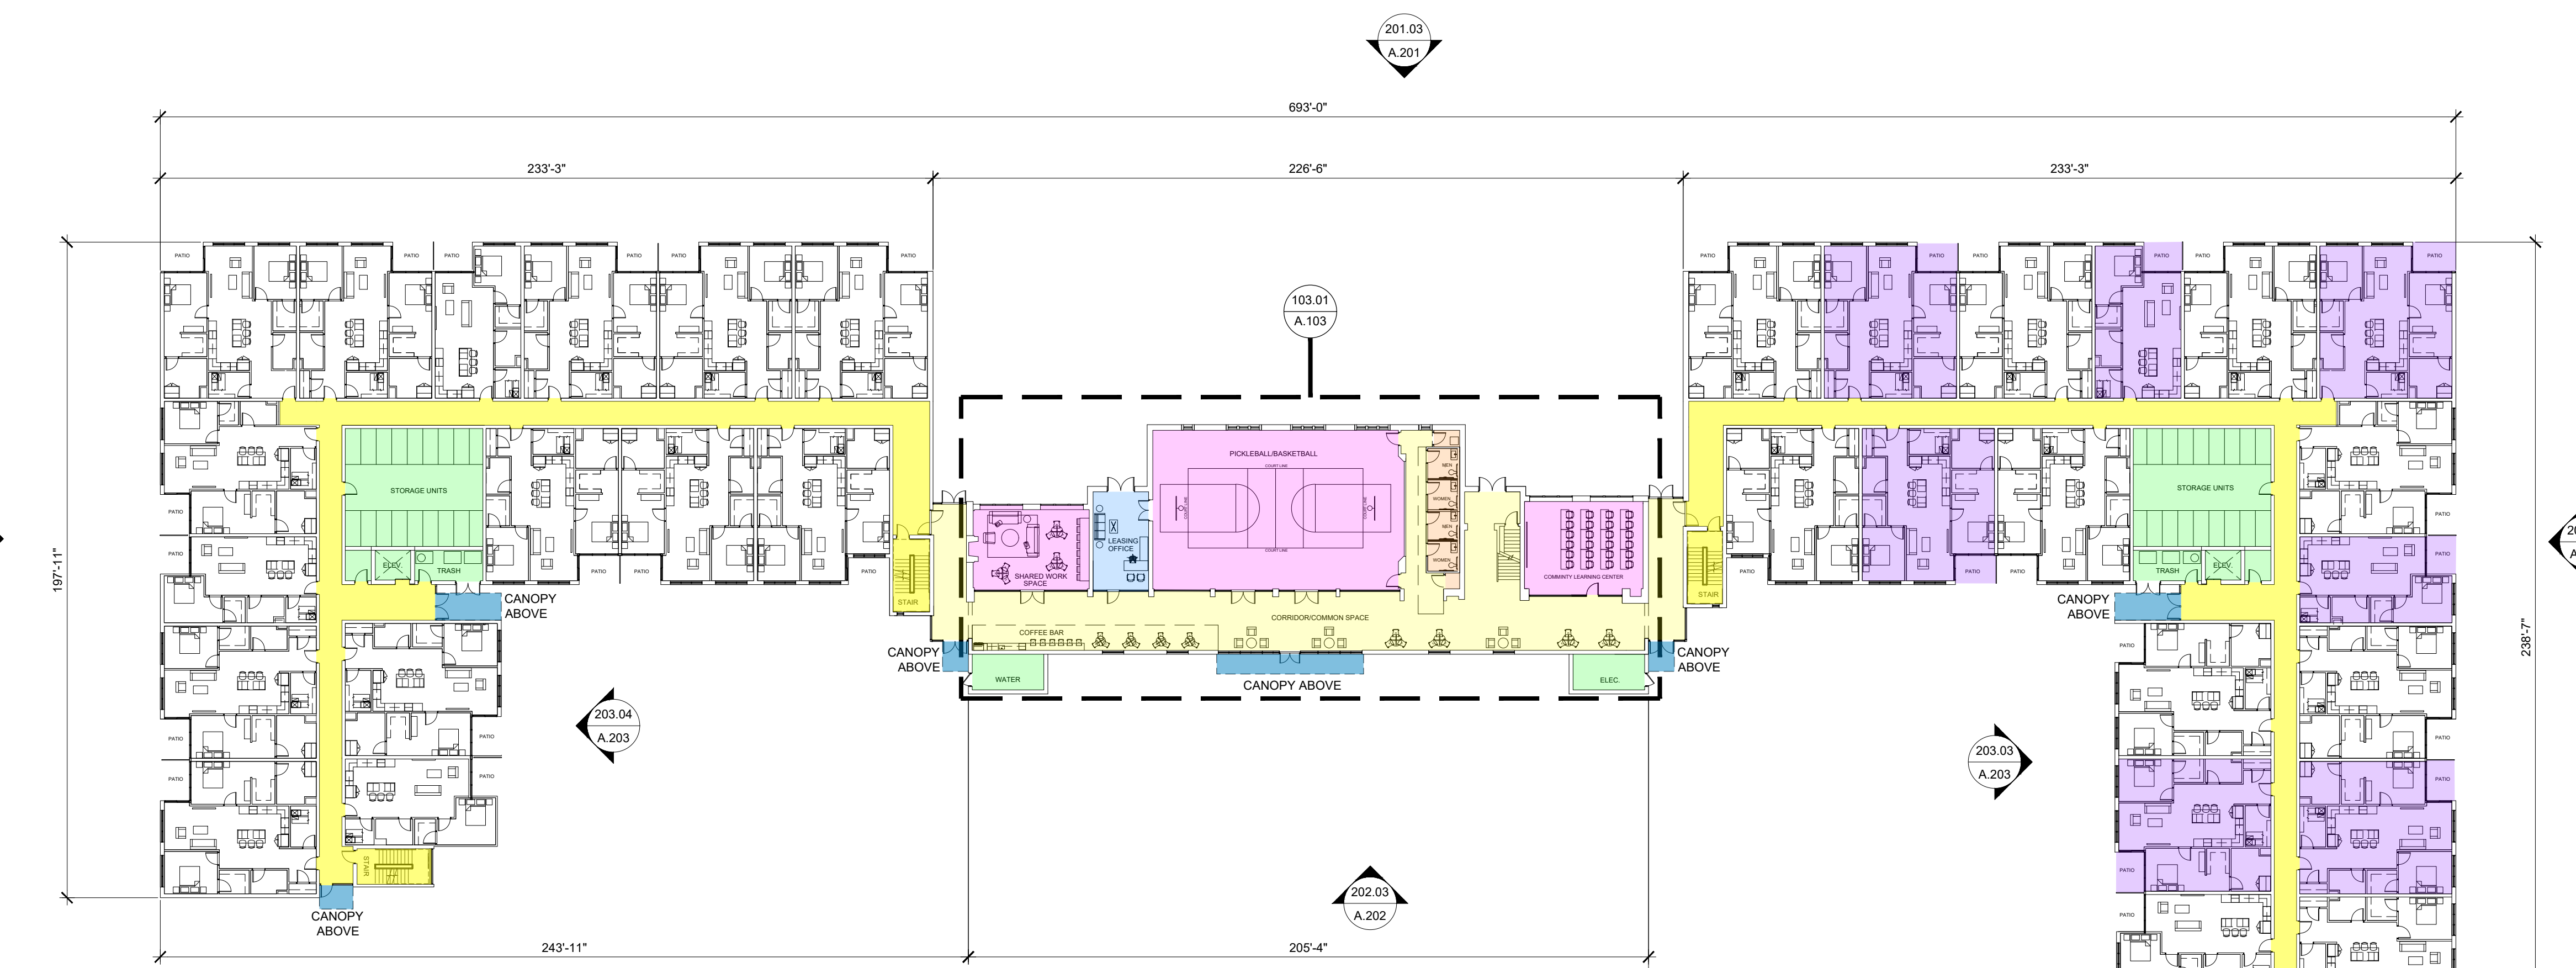


FIRST FLOOR PLAN
SCALE: 1/32"=1'-0"

Sheet title

**FIRST AND SECOND
FLOOR PLANS**

Issued dr/ch
SITE PLAN REVIEW 10.18.24

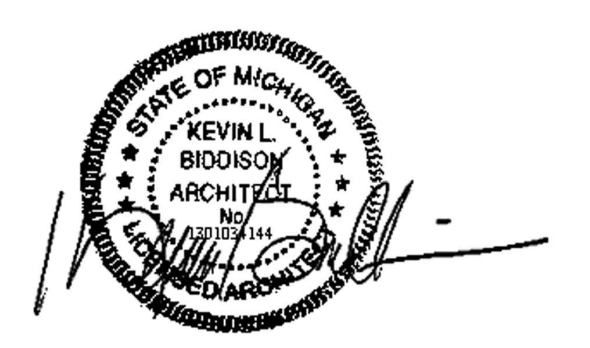

Project no.

2118-24

Sheet no.

A.101

BUILDING AREAS PER FLOOR	
FIRST FLOOR AREA	55,958 s.f. TOTAL
SECOND FLOOR AREA	52,013 s.f. TOTAL
THIRD FLOOR AREA	47,306 s.f. TOTAL
FOURTH FLOOR AREA	47,306 s.f. TOTAL
TOTAL BUILDING AREA	202,583 s.f. TOTAL

UNIT COUNT PER FLOOR					
UNIT TYPE	FLOOR 1	FLOOR 2	FLOOR 3	FLOOR 4	TOTAL
1 BEDROOM	6	6	6	6	24
2 BEDROOM	26	26	26	26	104
COMMON AREA	8242	4707	2800	2800	18,549
				TOTAL	128

FIRST FLOOR UNIT QUANTITIES & AREAS			
UNIT TYPE	QUANTITY	AREA	TOTAL
1 BEDROOM OPT. A	6	780	4680
2 BEDROOM OPT. A	26	1098	28,548
COMMON AREA		12,949	
TOTAL	32	33,228	


FIRST FLOOR/SITE PLAN
PARKING ON SITE: 193 SPACES
TOTAL PARKING TO MEET CITY REQMTS.: 1.5 PER UNIT= 192 SPACES

PROPOSED BUILDING ADDITION FOR:
**27700 Southfield Rd,
Lathrup Village**

27700 Southfield Road
Lathrup Village, MI 48076


SITE PLAN REVIEW 10.18.24

THIRD AND FOURTH FLOOR PLANS

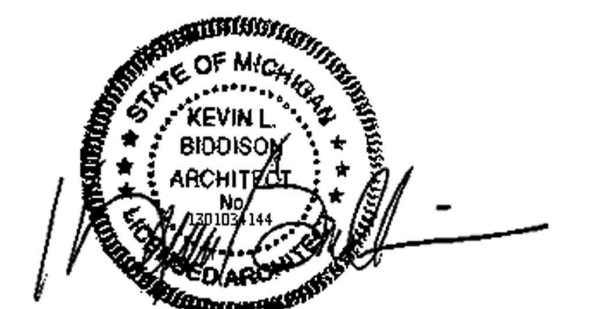


2118-24

A.102

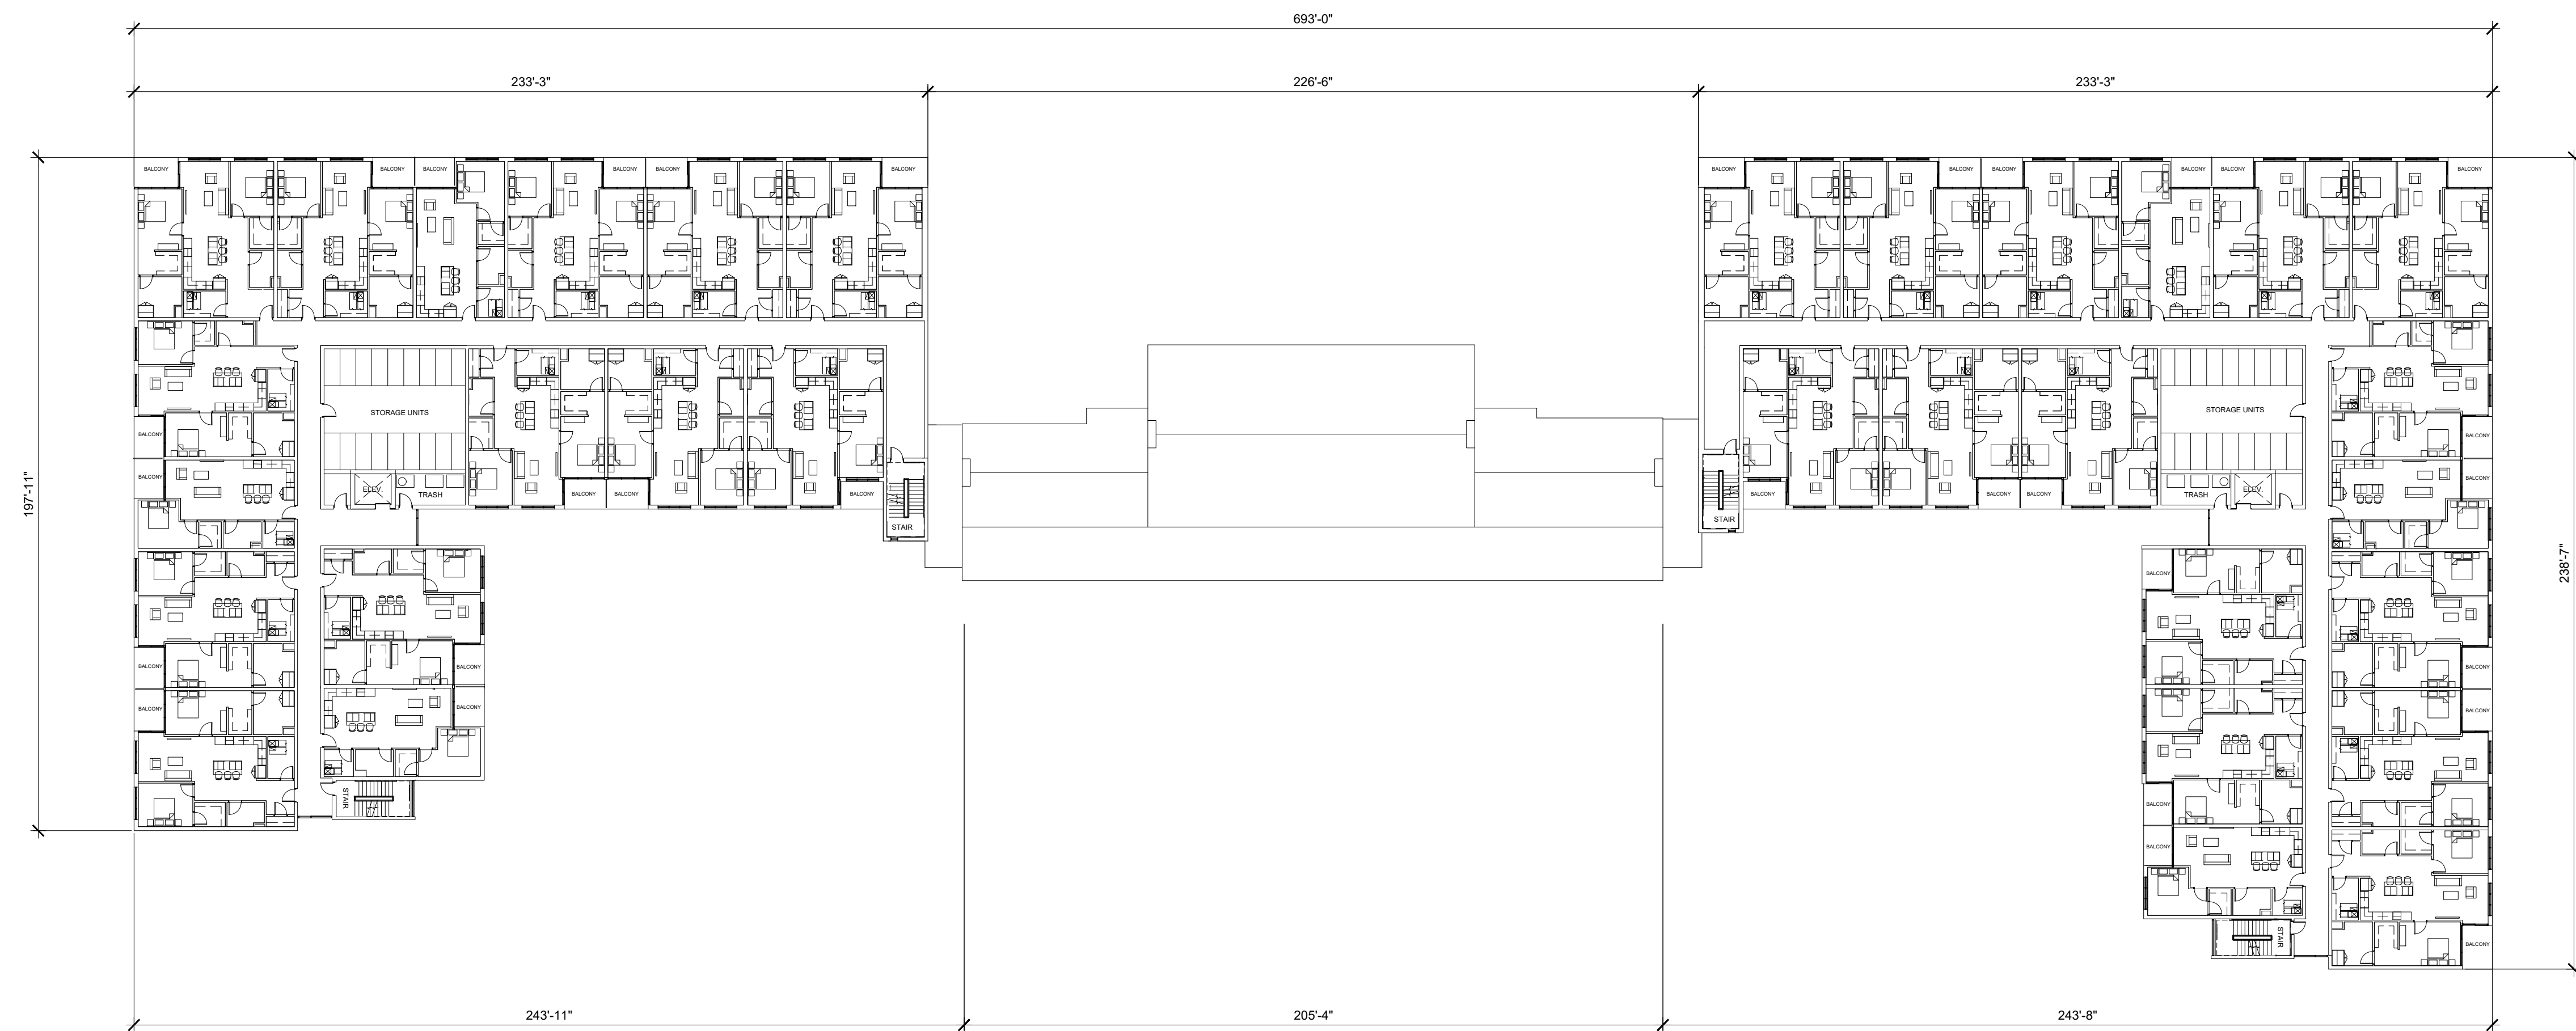

FOURTH FLOOR PLAN
SCALE: 1/32"=1'-0"

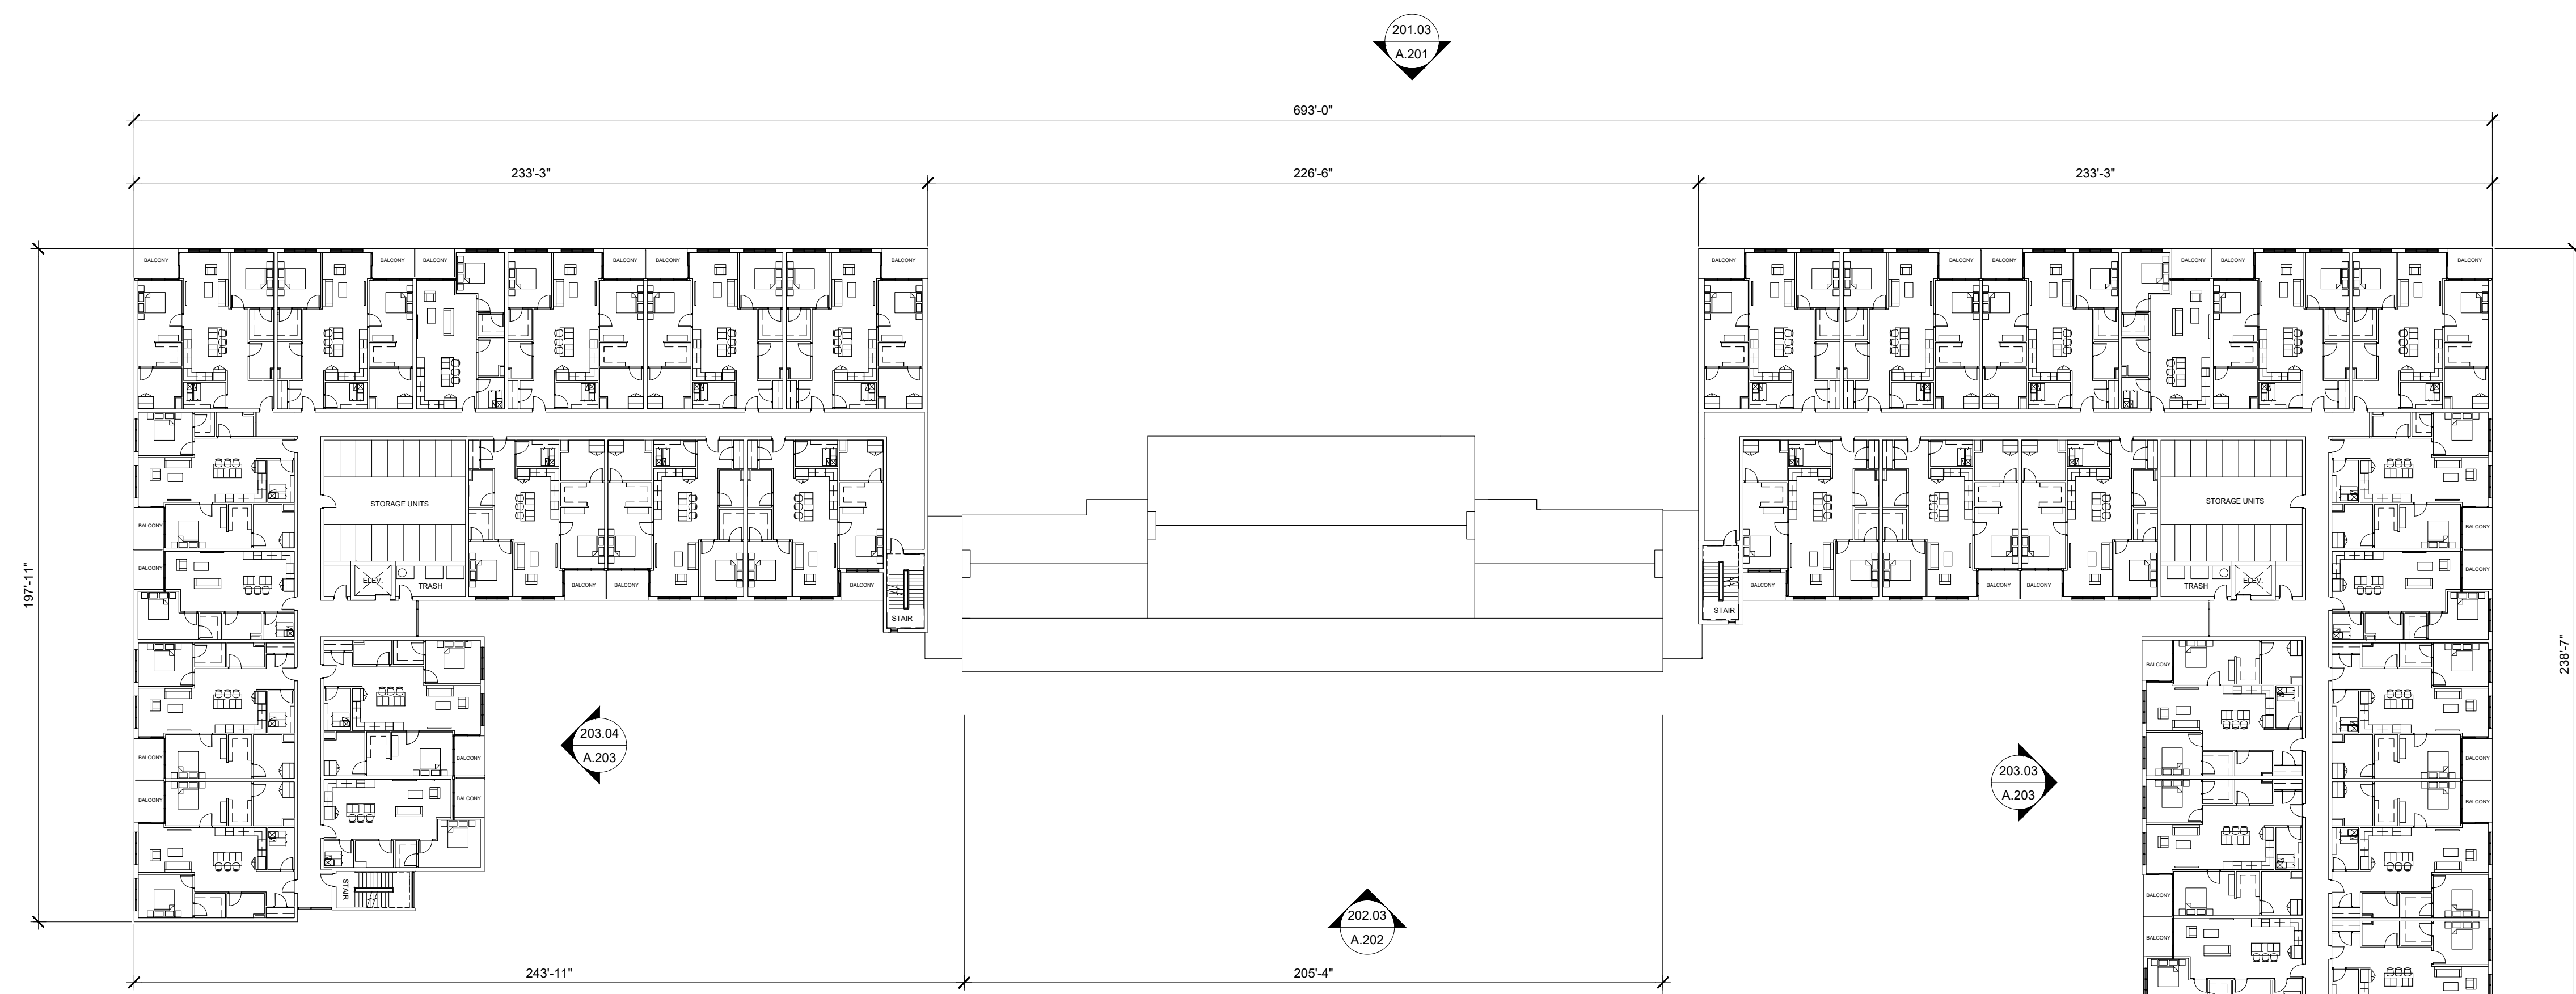



THIRD FLOOR PLAN
SCALE: 1/32"=1'-0"

BUILDING AREAS PER FLOOR	
FIRST FLOOR AREA	55,958 s.f. TOTAL
SECOND FLOOR AREA	52,013 s.f. TOTAL
THIRD FLOOR AREA	47,306 s.f. TOTAL
FOURTH FLOOR AREA	47,306 s.f. TOTAL
TOTAL BUILDING AREA	202,583 s.f. TOTAL


UNIT COUNT PER FLOOR					
UNIT TYPE	FLOOR 1	FLOOR 2	FLOOR 3	FLOOR 4	TOTAL
1 BEDROOM	6	6	6	6	24
2 BEDROOM	26	26	26	26	104
COMMON AREA	8242	4707	2800	2800	18,549
				TOTAL	128

FIRST FLOOR UNIT QUANTITIES & AREAS			
UNIT TYPE	QUANTITY	AREA	TOTAL
1 BEDROOM OPT. A	6	780	4680
2 BEDROOM OPT. A	26	1098	28,548
COMMON AREA		12,949	
TOTAL	32		33,228

FIRST FLOOR/SITE PLAN
PARKING ON SITE: 193 SPACES
TOTAL PARKING TO MEET CITY REQMTS.: 1.5 PER UNIT= 192 SPACES

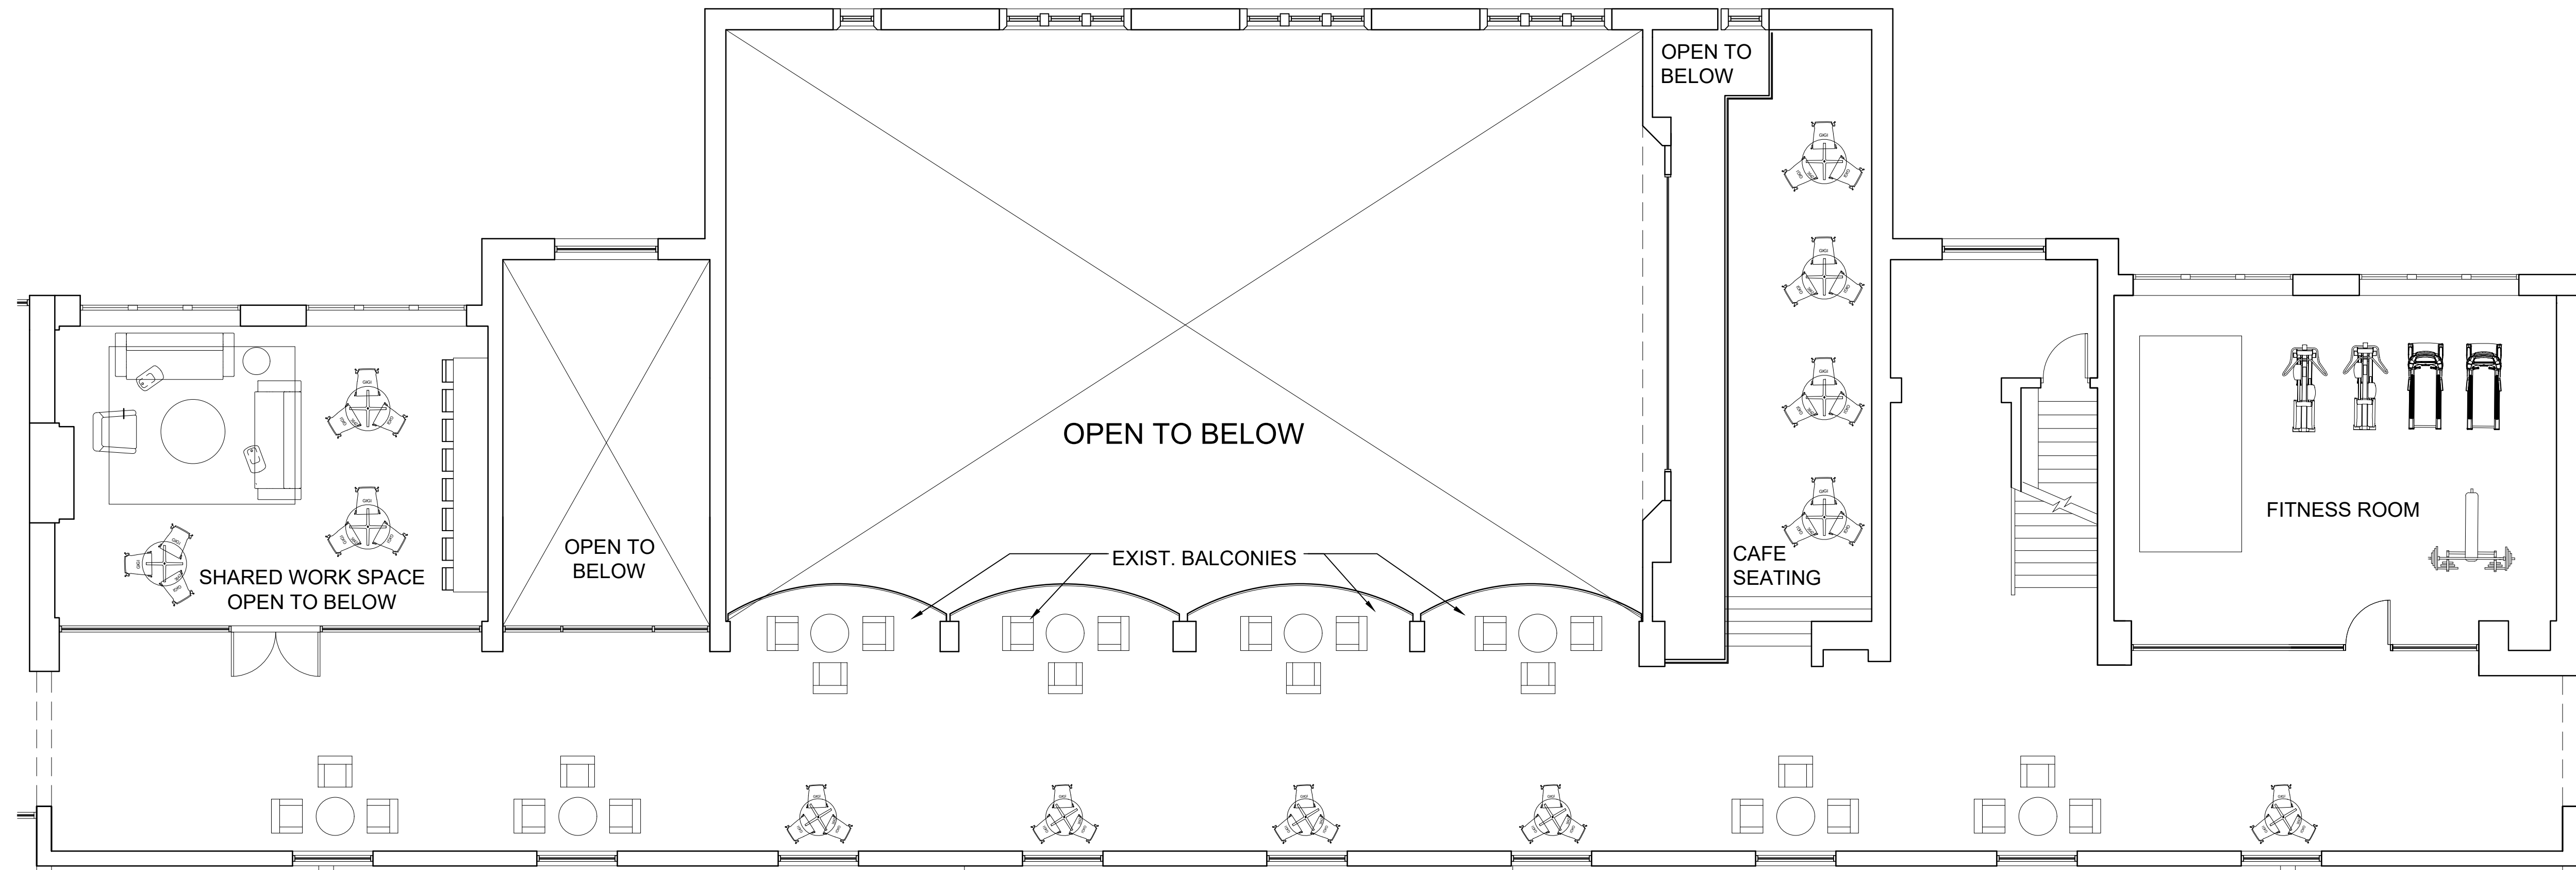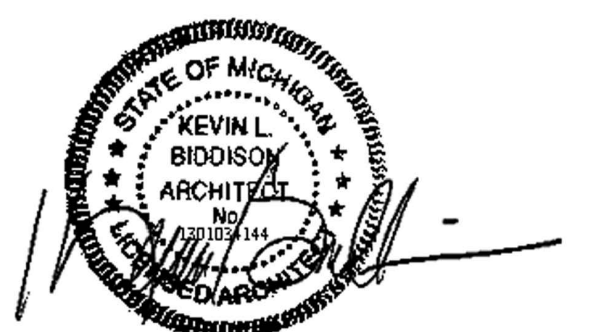

103.02
A.103 ENLARGED SECOND FLOOR COMMON AREA
WITHIN EXISTING BUILDING
SCALE: 1/8"=1'-0"

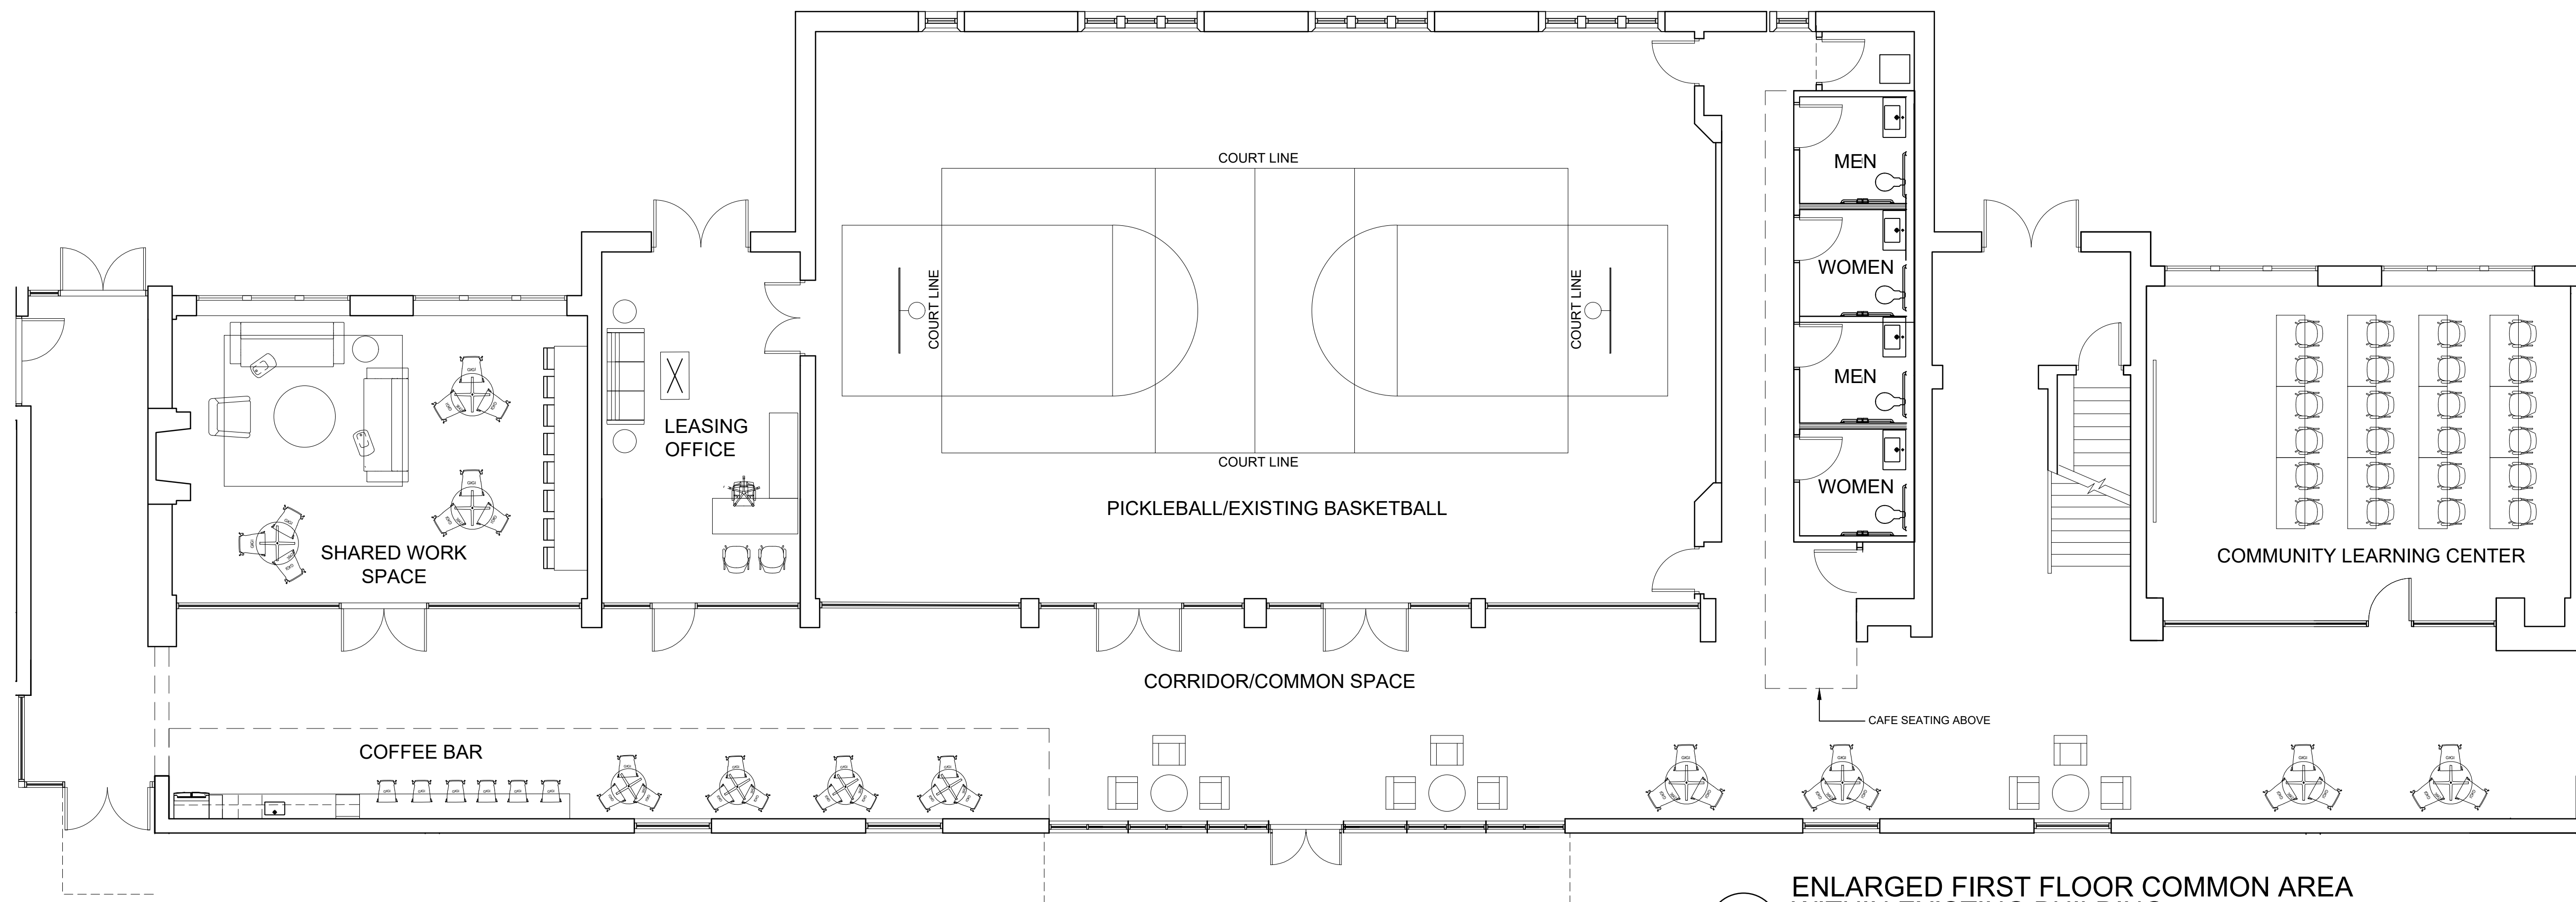

103.01
A.103 ENLARGED FIRST FLOOR COMMON AREA
WITHIN EXISTING BUILDING
SCALE: 1/8"=1'-0"