

OVERALL PROJECT SUMMARY

THE PROJECT IS A RENOVATION OF THE EXISTING COMMUNITY CENTER FOR TEMPORARY ACTIVATION OF AN EMERGENCY OPERATIONS CENTER, INCLUDING MODIFICATIONS TO MEETING ROOMS, ELECTRICAL AND TELECOM SYSTEMS, INSTALLATION OF NEW ROOF MOUNTED RADIO AND TELEVISION ANTENNAE AND EQUIPMENT AND ADDITION OF AN EXTERIOR EMERGENCY BACKUP GENERATOR SYSTEM AND SITE ENCLOSURE WITH ASSOCIATED UNDERGROUND UTILITIES. INCLUDED IS REPAIR AND REPLACEMENT OF EXTERIOR PAVING, HARDSCAPE, LANDSCAPING, IRRIGATION AND SITE IMPROVEMENTS AFFECTED BY THE WORK, LANDSCAPING AND IRRIGATION ADJACENT TO THE EMERGENCY GENERATOR AREA IS NOT IN CONTRACT, TO BE PART OF THE CITY DOG PARK PROJECT.

THE PROJECT SCOPE INCLUDES, BUT IS NOT LIMITED TO, MODIFICATIONS TO: NEW INTERIOR WALLS, DOORS, CEILINGS, AND FINISHES, COMPLIANCE WITH CURRENT LIFE SAFETY CODES, AND MODIFICATION TO BUILDING SYSTEMS (HVAC, ELECTRICAL, LIGHTING, TELECOMMUNICATIONS, AUDIO/VISUAL, AND PLUMBING).

CONTRACTOR WILL BE RESPONSIBLE FOR PREPPING ALL AREAS FOR NEW SCOPE OF WORK INCLUDING PATCHING AND REPAIRING EXISTING CONDITIONS WHERE AFFECTED BY ANY AND ALL DEMOLITION WORK.

THE WORK TO BE PERFORMED UNDER THIS CONTRACT INCLUDES THE FURNISHING OF ALL LABOR, MATERIALS, EQUIPMENT, TRANSPORTATION, SERVICES, PERMITS, TEMPORARY CONTROLS AND CONSTRUCTION FACILITIES, AND ALL GENERAL CONDITIONS, SEISMIC REQUIREMENTS, GENERAL REQUIREMENTS AND INCIDENTALS REQUIRED TO COMPLETE THE WORK ON THE PROJECT IN ITS ENTIRETY AS DESCRIBED IN THE CONTRACT DOCUMENTS.


CITY OF LOS ALTOS
JOB COPY
 REVIEWED FOR CODE COMPLIANCE

CITY OF LOS ALTOS
COMMUNITY CENTER
EMERGENCY OPERATION CENTER
 97 Hillview Ave. Los Altos, CA 94022
PERMIT SET
AUG 03, 2023

APPROVED
BUILDING DIVISION
 PERMIT NO. BLD23-01584
 BY *Ximico* DATE 01/24/2024

APPROVED
PLANNING DIVISION
 FILE NO. _____
 PERMIT NO. _____
 BY N.Zornes DATE _____

- ### GENERAL NOTES - PROJECT
- ALL CONSTRUCTION MATERIALS AND WORKMANSHIP SHALL CONFORM TO THE PROJECT SPECIFICATIONS.
 - ALL WORK SHALL MEET OR EXCEED THE MINIMUM STANDARDS OF THE 2022 CALIFORNIA BUILDING CODE AND ALL APPLICABLE CODES AND ORDINANCES.
 - INFORMATION CONTAINED WITHIN THESE DOCUMENTS SHALL NOT BE CONSTRUED TO PERMIT WORK NOT CONFORMING TO THE APPLICABLE CODES.
 - CONTRACTOR SHALL NOTIFY THE ARCHITECT OF ANY DISCREPANCIES WHICH MAY BE FOUND PRIOR TO THE START OF WORK.
 - CONTRACTOR SHALL REVIEW ALL DOCUMENTS TO COORDINATE W/ THE (E) BLDG CONDITIONS, ANY VARIATIONS AND DISCREPANCIES THAT ARISE IN THIS REVIEW ARE TO BE BROUGHT IMMEDIATELY TO THE ARCHITECT'S ATTENTION.
 - THE CONTRACTOR AND ALL SUBCONTRACTORS ARE REQUIRED TO VISIT AND INSPECT THE SITE PRIOR TO CONSTRUCTION OR ORDERING ANY MATERIALS.
 - ALL DETAILS, SCHEDULES, ADDENDA AND SPECIFICATIONS BOUND SEPARATELY ARE A PART OF THE CONTRACT DOCUMENTS.
 - ITEMS MARKED "NIC" ARE NOT IN CONTRACT, SUCH ITEMS ARE INCLUDED IN THE DOCUMENTS WHEN CONTRACTORS' COORDINATION IS REQUIRED OR FOR CLARIFICATION OF PROJECT LIMITS.
 - DIMENSIONS:
 - IN NO CASE SHALL WORKING DIMENSIONS BE SCALED FROM THE DRAWINGS.
 - OPENINGS: DOOR DIMENSIONS ARE TO THE FACE OF JAMB, UNLESS OTHERWISE NOTED. UNDIMENSIONED DOORS 4" FROM FINISHED FACE OF INTERSECTING PARTITION TO HINGE EDGE OF DOOR, REFER TO DETAILS FOR LOCATION OF DIMENSIONS OF WINDOWS AND OTHER OPENINGS.
 - ALL DIMENSIONS TO WALLS ARE TO THE FACE OF STUD, UNLESS OTHERWISE NOTED.
 - CEILING HEIGHT DIMENSIONS ARE FROM FINISHED FLOOR TO FINISHED FACE OF CEILING, UNLESS OTHERWISE NOTED.
 - ALL DIMENSIONS SHALL BE VERIFIED IN THE FIELD BY GENERAL CONTRACTOR AND ALL SUBCONTRACTORS PRIOR TO PROCEEDING WITH CONSTRUCTION.
 - COORDINATE WITH EQUIPMENT CONTRACTORS FOR ROUGH-IN DIMENSIONS AND TEMPLATES.
 - ALL DIMENSIONS NOTED "CLEAR" OR "CLR" MUST BE STRICTLY MAINTAINED. "CLEAR" MEANS DIMENSION FROM FACE OF FINISH TO FACE OF FINISH OR OBJECT.
 - ALL DIMENSIONS NOTED "VERIFY" OR "VF" ARE TO BE CHECKED BY THE CONTRACTOR PRIOR TO CONSTRUCTION, ANY VARIANCE FROM THE REQUIRED DIMENSIONS MUST BE BROUGHT IMMEDIATELY TO THE ARCHITECT'S ATTENTION.
 - DETAILS MARKED "TYPICAL" SHALL APPLY IN ALL CASES, UNLESS OTHERWISE NOTED.
 - WHERE NO SPECIFIC DETAIL IS SHOWN, THE FRAMING OR CONSTRUCTION SHALL BE IDENTICAL OR SIMILAR TO THAT INDICATED FOR LIKE CASES OF CONSTRUCTION ON THE PROJECT.
 - EXISTING CONDITIONS TO REMAIN, UNLESS OTHERWISE NOTED.
 - THE DRAWINGS INDICATE THE GENERAL EXTENT OF (N) CONSTRUCTION NECESSARY FOR THE WORK, BUT ARE NOT INTENDED TO BE ALL-INCLUSIVE. ALL DEMO AND (N) WORK NECESSARY FOR A FINISHED JOB, IN ACCORDANCE W/ THE INTENTIONS OF THE CONTRACT DOCUMENTS, IS INCLUDED REGARDLESS OF WHETHER SHOWN IN THE CONTRACT DOCUMENTS.
 - (E) BUILDING AND SITE DOCUMENTATION IS BASED ON "AS-BUILT" DRAWINGS AND OBSERVATIONAL SITE INVESTIGATIONS. ACTUAL BUILT CONDITIONS MAY VARY. CONTRACTOR IS TO USE CAUTION IN DEMOLITION, AND IS TO NOTIFY ARCHITECT IMMEDIATELY IF ANY VARIATIONS OR DISCREPANCIES ARE UNCOVERED.
 - PROTECT ALL (E) BUILDINGS, INFRASTRUCTURE, LANDSCAPING AND PAVING TO REMAIN.
 - PROTECTION OF BUILDING ELEMENTS REQUIRING FIRE RESISTANCE AS NOTED ON THE DRAWINGS SHALL BE MAINTAINED. ANY DAMAGE TO A RATED ASSEMBLY FOR ANY REASON THROUGH THE COURSE OF CONSTRUCTION SHALL BE REPAIRED TO MATCH THE APPROVED DETAIL.
 - FIRE SAFETY DURING DEMOLITION AND CONSTRUCTION SHALL COMPLY WITH CFC CHAPTER 33.

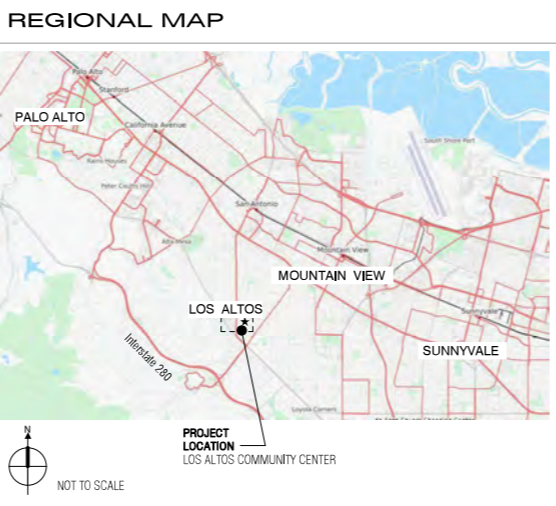

INDEX OF DRAWINGS

GENERAL	COVER SHEET
G0-0	COVER SHEET
G1-0	CODE SUMMARY & OCCUPANCY EGRESS PLAN
G1-1	CALGREEN CHECKLIST & SCCFD APPROVAL LETTER
CIVIL	NOTES AND LEGENDS
C0.1	EXISTING CONDITIONS AND DEMOLITION PLAN
C1.1	HORIZONTAL CONTROL PLAN
C3.1	GRADING AND UTILITY PLAN
C4.1	EROSION CONTROL PLAN
C4.2	BEST MANAGEMENT PRACTICES
C5.1	DETAIL SHEET
ARCHITECTURE	
A1-0	CIVIC CAMPUS PLAN EOC
A1-1	SITE PLAN EAST
A1-2	SITE PLAN WEST
A1-3	ENLARGED SITE PLANS & DOORS
A1-4	GENERATOR ENCLOSURE ENLARGED ELEVATIONS
A1-5	SITE DETAILS - GENERATOR ENCLOSURE
A2-1	EOC FLOOR PLAN
A2-2	EOC ROOF PLAN
A2-3	EOC REFLECTED CEILING PLAN
A3-1	EOC ENLARGED PLAN
A7-1	EOC INTERIOR ELEVATIONS - MP1, MP2 & MEETING ROOMS
A7-2	EOC INTERIOR ELEVATIONS - STORAGE & ROOF AREAS
A9-1	FINISH SCHEDULE
STRUCTURAL	
S0.0	STRUCTURAL GENERAL NOTES
S1.00	FOUNDATION AND ROOF FRAMING PLANS
S1.01	BUILDING SECTIONS AND ELEVATIONS
S3.01	TYPICAL CONCRETE DETAILS
S3.02	CONCRETE DETAILS
PLUMBING	
P0.0	PLUMBING LEGENDS AND ABBREVIATIONS
P2.0	LEVEL 1 PLUMBING FLOOR PLAN
P4.0	PLUMBING DETAILS
ELECTRICAL	
E0-1	SYMBOL LIST, GENERAL NOTES, & LIST OF DRAWINGS
E1-0	CIVIC CAMPUS PLAN EOC - ELECTRICAL
E1-1	SITE PLAN EOC - ELECTRICAL
E1-2	SITE PLAN WEST - ELECTRICAL
E3-1	EOC FLOOR PLAN - ELECTRICAL
E3-2	EOC ROOF PLAN - ELECTRICAL
E4-1	PARTIAL PLAN - GENERATOR AREA
E4-2	PARTIAL PLANS - ELECTRICAL
E4-3	PARTIAL PLAN - ELECTRICAL
E4-4	PARTIAL PLAN - ELECTRICAL
E4-5	PARTIAL PLANS - ELECTRICAL
E5-1	SINGLE LINE DIAGRAM - POWER
E5-2	DIAGRAMS
E6-1	SCHEDULES
E7-1	DETAILS
E8-1	TITLE 24 DOCUMENTATION
LOW VOLTAGE	
TA0-1	GENERAL NOTES, LEGEND, SYMBOL, ABBREV., J-BOX & SYMBOL SCHEDULES
TA2-1	FLOOR PLAN - AUDIOVISUAL
TA2-2	ROOF PLAN - AUDIOVISUAL
TA6-1	RCP - AUDIOVISUAL
TA7-1	OAT AND OBS TELEVISION SYSTEMS SINGLE LINE DIAGRAM
TA9-1	DETAILS - NON-PENETRATION ROOF MOUNT
TN0-1	GENERAL NOTES, LEGEND, ABBREVS., J-BOX SCHEDULE & SYMBOL SCHEDULE
TN2-1	FLOOR PLAN - COMMUNICATIONS
TN2-2	ROOF PLAN - COMMUNICATIONS
TN4-1	MOF/TRI.O ENLARGED PLAN, RCP, & ELEVATIONS
TN5-1	RCP - COMMUNICATIONS
TN7-1	STRUCTURED CABLING SINGLE LINE DIAGRAM
TN8-1	DEVICE SCHEDULE
TN9-1	DETAILS - WALL BOX & RADIO FEED-THROUGH PANEL

DEFERRED SUBMITTALS

PROVIDE SUBMITTALS TO SCCFD FOR THE INSTALLATION/MODIFICATION OF EACH OF THE SYSTEMS LISTED. SUBMIT SHOP DRAWINGS (3 SETS) AND A PERMIT APPLICATION TO THE SANTA CLARA COUNTY FIRE DEPARTMENT FOR APPROVAL BEFORE ALTERING THE SYSTEMS AS APPLICABLE. CALL (408) 341-4420 FOR MORE INFORMATION. NOTE: PROOF THAT THE CORRESPONDING BUILDING PERMIT HAS BEEN FORMALLY ISSUED SHALL BE PROVIDED AT THE TIME OF SUBMITTAL. SEE SCCFD APPROVAL LETTER ON G1-1.

- STANDY EMERGENCY GENERATOR
- FUEL SYSTEM

BID ALTERNATES

BID ALTERNATE #1: 10' ROOM REDUNDANT COOLING
 ADD ALTERNATE ITEM OPTION 1: 2-TON MINI-SPLIT SYSTEM. SEE MECH SECT 230000
 ADD ALTERNATE ITEM OPTION 2: TRANSFER FAN. SEE MECH SECT 230000

ABBREVIATIONS

&	AND	DEPT	DEPARTMENT	GENSET	GENERATOR SET (GENERATOR & ENGINE COMBINATION)	NTS	NOT TO SCALE	SQ	SQUARE
(E)	EXISTING	DF	DOUGLAS FIR/DRINKING FOUNTAIN	GFI	GROUND FAULT INTERRUPT	OC	ON CENTER	SS	STAINLESS STEEL
(N)	NEW	AB	ANCHOR BOLT	GLAM	GLUE LAMINATED	OCC	OCCUPANT	SSD	SEE STRUCTURAL DRAWINGS
@	AT	DIA	DIAMETER	GR	GRADE	OD	OUTSIDE DIAMETER/OVERFLOW DRAIN	SSG	SEE SIGNAGE DRAWINGS
AC	ASPHALTIC CONCRETE	DN	DOWN	GSM	GALVANIZED SHEET METAL	OF	OUTSIDE FACE	SSL	STAINLESS STEEL
ACOUS	ACOUSTICAL	DR	DOOR	GWB	GYPSUM WALL BOARD	OFCI	OWNER FURNISHED CONTRACTOR INSTALLED	STD	STANDARD
ACT	ACOUSTIC CEILING TILE	DS	DOWNSPOUT	GYP	GYPSUM	OFD	OVERFLOW DRAIN	STED	SEE TELECOM DRAWINGS
AD	AREA DRAIN	DTL	DETAIL	H	HIGH	OPN	OPENING	STL	STEEL
ADDL	ADDITIONAL	DWG	DRAWING	HB	HOSE BIB	OPNG	OPENING	STOR	STORAGE
ADJ	ADJACENT/ADJUSTABLE	E	EAST	HD	HEAD	OPP	OPPOSITE	STR	STRUCTURAL
ADMIN	ADMINISTRATION	EJ	EACH	HDR	HEADER	OPP HD	OPPOSITE HAND	STRUC	STRUCTURAL
AFF	ABOVE FINISHED FLOOR	EA	EXPANSION JOINT	HDW	HARDWARE	PPA	PUBLIC ADDRESS	SUSP	SUSPENDED
AGG	AGGREGATE	ELEC	ELECTRICAL	HDWD	HARDWOOD	PCP	PORTLAND CEMENT PLASTER	SYS	SYSTEM
ALT	ALTERNATE	ELEV	ELEVATION/ELEVATOR	HM	HOLLOW METAL	PL	PLATE	T	TREAD
ALUM	ALUMINUM	EOC	EMERGENCY OPERATIONS CENTER	HORZ	HORIZONTAL	PLAM	PLASTIC LAMINATE	T&G	TONGUE & GROOVE
ANOD	ANODIZED	EP	EDGE OF SLAB	HOUR	HOUR	PLY	PLYWOOD	T&D	TO BE DETERMINED
APPROX	APPROXIMATE	EOS	ELECTRICAL PANEL / EMERGENCY POWER	HT	HEIGHT	PR	PAIR	TEL	TELEPHONE
ATS	AUTOMATIC TRANSFER SWITCH	EQ	EQUAL	HVAC	HEATING VENTILATION & AIR CONDITIONING	PROJ	PROJECT/PROJECTOR	TEMP	TEMPERED
AV	AUDIO VISUAL	EQ	EQUAL	ID	INSIDE DIAMETER	PT	PAINTED	THK	THICK/THICKNESS
BD	BOARD	EQUIP	EQUIPMENT	IF	INSIDE FACE	QTY	QUANTITY	THRESH	THRESHOLD
BLDG	BUILDING	EXH	EXHAUST	INCL	INCLUDE/INCLUDING	R	RISER	TJ	TRUSS JOIST
BLK	BLOCK	EXP	EXPANSION	INSUL	INSULATION	RAD	RADIUS	TOC	TOP OF CONCRETE/CURB
BLKG	BLOCKING	EXT	EXTERIOR	INT	INTERIOR	RD	ROOF DRAIN	TOP	TOP OF PAVING
BO	BOTTOM OF	FA	FIRE ALARM	JAN	JANITOR	REF	REFERENCE	TOR	TOP OF ROOF
BOT	BOTTOM	FD	FLOOR DRAIN	JBOX	JUNCTION BOX	REIN	REINFORCE/REINFORCING	TOS	TOP OF WALL
CAB	CABINET	FDN	FOUNDATION	JST	JOIST	REQD	REQUIRED	TOW	TOP OF STEEL
CE	CIVIL ENGINEER	FE	FIRE EXTINGUISHER	JT	JOINT	REQT	REQUIREMENTS	TSS	TUBE STEEL
CFMF	COLD FORMED METAL FRAMING	FC	FIRE EXTINGUISHER CABINET	LAV	LAVATORY	REV	REVISION	TP	TYPICAL
CJ	CONTROL JOINT	FE	FIRE EXTINGUISHER CABINET	LAV	LAVATORY	REV	REVISION	TP	TYPICAL
CLG	CEILING	FIN	FINISH	LB	LAG BOLT	RM	ROOM	UN	UNLESS OTHERWISE NOTED
CLKG	CAULKING	FIN FLR	FINISH FLOOR	LF	LINEAR FEET	RO	ROUGH OPENING	UR	UPRINAL
CLO	CLOSET	FIXT	FIXTURE	LT	LIGHT	RWL	RAIN WATER LEADER	VCT	VINYL COMPOSITION TILE
CLR	CLEAR	FLR	FLOOR	MAX	MAXIMUM	S	SOUTH	VENT	VENTILATION
CMU	CONCRETE MASONRY UNIT	FLRG	FLOORING	MB	MACHINE BOLT	SASM	SELF ADHERING SHEET	VERT	VERTICAL
CNTR	COUNTER	FOC	FACE OF CONCRETE	MECH	MECHANICAL	SCD	SEE CIVIL DRAWINGS	VEST	VESTIBULE
CO	CLEAN OUT	FOF	FACE OF FINISH	MFR	MANUFACTURER	SCHED	SCHEDULE	VIF	VERIFY IN FIELD
COL	COLUMN	FOS	FACE OF STUD	MH	MANHOLE	SE	SEE ELECTRICAL DRAWINGS	W	WEST/WIDTH
CONC	CONCRETE	FR	FIRE RESISTANT/FIRE RETARDANT	MIN	MINIMUM	SED	SEE STRUCTURAL DRAWINGS	WO	WITHOUT
CONT	CONTINUOUS	FRT	FIRE RETARDANT TREATED	MISC	MISCELLANEOUS	SF	SUPPLY FAN	WC	WATER CLOSET
CONTR	CONTRACTOR	FT	FOOT/FEET	MP	MULTIPURPOSE	SHT	SHEET	WD	WOOD
CPT	CARPET	FTG	FOOTING	MTD	MOUNTED	SHTG	SHEATHING	WH	WATER HEATER
CSMT	CASEMENT	FURN	FURNITURE	MTS	MANUAL TRANSFER SWITCH	SIM	SIMILAR	WIN	WINDOW
CTR	CENTER	GA	GAUGE	N	NORTH	SLD	SEE LANDSCAPE DRAWINGS	WO	WHERE OCCURS
CTSK	COUNTERSINK	GALV	GALVANIZED	NA	NOT APPLICABLE	SMD	SEE MECHANICAL DRAWINGS	WP	WORK POINT
CX	CONNECTION	GB	GRAB BAR	NIC	NOT IN CONTRACT	SOG	SLAB ON GRADE	WR	WATER RESISTANT
CD	DEPTH	GEN	GENERAL CONTRACTOR	NO	NUMBER	SPD	SEE PLUMBING DRAWINGS	WT	WEIGHT
DBL	DOUBLE	GEN	GENERATOR	NOM	NOMINAL	SPEC	SPECIFICATION		
DEMO	DEMOLITION								

CODE COMPLIANCE

PARTIAL LIST OF APPLICABLE CODES AS OF JANUARY 1, 2022*

ALL WORK SHALL CONFORM TO 2022 TITLE 24, CALIFORNIA CODE OF REGULATIONS (CCR)

GRADING PLANS, DRAINAGE IMPROVEMENTS, ROAD AND ACCESS REQUIREMENTS AND ENVIRONMENTAL HEALTH CONSIDERATIONS SHALL COMPLY WITH ALL LOCAL ORDINANCES

YEAR	CODE	DESCRIPTION
2022	CALIFORNIA ADMINISTRATIVE CODE (CAC), PART 1, TITLE 24, C.C.R.	
2022	CALIFORNIA BUILDING CODE (CBC), PART 2, TITLE 24, C.C.R. (2021 INTERNATIONAL BUILDING CODE AND 2019 CALIFORNIA AMENDMENTS)	
2022	CALIFORNIA ELECTRIC CODE (CEC), PART 3, TITLE 24, C.C.R. (2020 NATIONAL ELECTRIC CODE AND 2022 CALIFORNIA AMENDMENTS)	
2022	CALIFORNIA MECHANICAL CODE (CMC), PART 4, TITLE 24, C.C.R. (2021 IAPMO UNIFORM MECHANICAL CODE AND 2022 CALIFORNIA AMENDMENTS)	
2022	CALIFORNIA PLUMBING CODE (CPC), PART 5, TITLE 24, C.C.R. (2021 IAPMO UNIFORM PLUMBING CODE AND 2022 CALIFORNIA AMENDMENTS)	
2022	CALIFORNIA ENERGY CODE (CEC), PART 6, TITLE 24, C.C.R.	
2022	CALIFORNIA FIRE CODE (CFC), PART 9, TITLE 24, C.C.R. (2021 INTERNATIONAL FIRE CODE AND 2022 CALIFORNIA AMENDMENTS)	
2022	CALIFORNIA EXISTING BUILDING CODE (CEBC), PART 10, TITLE 24, C.C.R. (2021 INTERNATIONAL EXISTING BUILDING CODE AND 2022 CALIFORNIA AMENDMENTS)	
2019	TITLE 19, C.C.R., REGULATIONS OF THE STATE FIRE MARSHAL	
2022	CALIFORNIA GREEN BUILDING STANDARDS CODE (CALGREEN), PART 11, TITLE 24, C.C.R.	
2022	CALIFORNIA REFERENCED STANDARDS CODE, PART 12, TITLE 24, C.C.R.	
2019	ASME A17.1, CSA B44 SAFETY CODE FOR ELEVATORS AND ESCALATORS (PER 2022 CBC PART 2 CH 35). NOTE: CAL/OSHA ELEVATOR UNIT ENFORCES CCR TITLE 8 AND USES THE 2004 ASME A17.1 BY ADOPTION	

PARTIAL LIST OF APPLICABLE STANDARDS

STANDARD	DESCRIPTION	EDITION
NFPA 13	SPRINKLER SYSTEMS (CA AMENDED)	2022 EDITION
NFPA 14	STANDPIPE & HOSE SYSTEMS, 2013 EDITION (CA AMENDED)	2016 EDITION
NFPA 17	DRY CHEMICAL EXTINGUISHING SYSTEMS	2017 EDITION
NFPA 17A	WET CHEMICAL EXTINGUISHING SYSTEMS	2017 EDITION
NFPA 20	STATIONARY FIRE PUMPS FOR FIRE PROTECTION	2016 EDITION
NFPA 72	NATIONAL FIRE ALARM AND SIGNALING CODE (CA AMENDED)	2022 EDITION
NFPA 80	FIRE DOORS AND OTHER OPENING PROTECTIVES	2016 EDITION
NFPA 1221	STANDARD FOR THE INSTALLATION, MAINTENANCE, AND USE OF EMERGENCY SERVICES COMMUNICATION SYSTEMS	2019 EDITION
NFPA 2001	CLEAN AGENT FIRE EXTINGUISHING SYSTEMS (CA AMENDED)	2015 EDITION
UL 464	AUDIBLE SIGNALING DEVICES FOR FIRE ALARM AND SIGNALING SYSTEMS, INCLUDING ACCESSORIES	2003 EDITION
UL 521	STANDARD FOR HEAT DETECTORS FOR FIRE PROTECTIVE SIGNALING SYSTEMS	2005 EDITION
UL 752	STANDARD FOR BULLET-RESISTING EQUIPMENT	2005 EDITION
UL 1971	STANDARD FOR SIGNALING DEVICES FOR THE HEARING IMPAIRED	2002 (R2010)

FOR A COMPLETE LIST OF APPLICABLE NFPA STANDARDS REFER TO 2022 CBC (SFM) CHAPTER 35 AND CALIFORNIA FIRE CODE CHAPTER 80

SEE CALIFORNIA BUILDING CODE CHAPTER 35 FOR STATE OF CALIFORNIA AMENDMENTS TO THE NFPA STANDARDS.

ACI 318-14 AMERICAN CONCRETE INSTITUTE-BUILDING CODE REQUIREMENTS FOR STRUCTURAL CONCRETE & COMMENTARY

ADA AMERICAN WITH DISABILITIES ACT (ADA) ACCESSIBILITY GUIDELINES, 2010

ASCE AMERICAN INSTITUTE OF STEEL CONSTRUCTION MANUAL, LATEST EDITION

NRS NATIONAL REFERENCE STANDARDS

PROJECT TEAM

Owner	Architect
City of Los Altos 1 N. San Antonio Rd Los Altos, CA 94022 Tel: (650) 947,2700 Fax: (650) 947-2731	Noll & Tam Architects 729 Shoreline Ave Berkeley, CA 94710 Tel: 510,542,2200 Fax: 510,542,2201
Civil	Electrical
BKF Engineers 256 Shoreline Drive Suite 200 Redwood City CA 94065 Tel: (650) 482-6300	O'Mahony & Myer Inc. 4341 Redwood Highway Suite 245 San Rafael CA 94903 Tel: (415) 492-0420
Telecom, AV & Acoustics Smith, Fause and McDonald, Inc. 351 8th Street San Francisco CA 94103 Tel: (415) 255-9140	Radio & Antenna Forrest Telecom Engineering, Inc. 6754 Bernal Ave, Suite 740-104 Pleasanton, CA 94566 Tel: (925) 251-1212
Structural	Cost Estimator
Daedalus 12930 Saratoga Ave, Ste B9 Saratoga, CA 95070 Tel: (408) 517-0373	mack5 1000 Broadway, Suite 260 Oakland, CA 94607 Tel: (510) 595-3020
Mechanical/Plumbing	
Taylor Engineers 1080 Marina Village Parkway, Suite 501 Alameda, CA 94501 Tel: (510) 749-9135	

SEPARATE PERMITS ARE REQUIRED FOR ALL WORK IN THE PUBLIC RIGHT OF WAY FROM THE ENGINEERING DIVISION

APPROVED

APPROVED WITH COMMENTS
 SEE SHEET(S) C3.1 & C4.1 FOR COMMENTS

REVIEWED
 FOR CODE COMPLIANCE
 January 5, 2024
 TRB AND ASSOCIATES

CITY OF LOS ALTOS
ENGINEERING DIVISION
 DATE: 12/6/23 BY: V.C.

APPROVALS

NOLL & TAM
 ARCHITECTS

729 Heinz Avenue
 Berkeley, CA 94710
 tel 510.542.2200
 fax 510.542.2201

ACCESSIBLE PATH OF TRAVEL

ACCESSIBLE PATH OF TRAVEL TO THE AREA OF ALTERATION IS FULLY COMPLIANT. REFER TO A1-1 FOR SITE ACCESSIBILITY & INTERIOR PATH OF TRAVEL TO AREA OF ALTERATION.

CITY OF LOS ALTOS
JOB COPY
 REVIEWED FOR CODE COMPLIANCE

SYMBOL LEGEND

NAME	OCCUPANCY TYPE DESCRIPTION
4000s	TOTAL ROOM AREA IN SQUARE FEET
B 150OL	OCCUPANT LOAD FACTOR PER CBC TABLE 1004.5
1 20OC	TOTAL ROOM OCCUPANCY
	OCCUPANCY TYPE PER CBC TABLE 1004.5
DOOR	X = REQUIRED WIDTH (IN) = 0.2" PER OCCUPANT
X" Y	Y = OCCUPANTS
Z"	Z = WIDTH PROVIDED (IN)
14	COMMON PATH OF EGRESS TRAVEL PER CBC SECTION 1006.2.1

- EXIT ACCESS TRAVEL DISTANCE PER CBC SECTION 1017.2
- 1-HOUR RATED ENCLOSURE
- 2-HOUR RATED ENCLOSURE
- ACCESSIBLE PATH
- OCCUPANT LOAD @ ROOM/SPACE
- OCCUPANT LOAD ACCUMULATED @ BUILDING EXIT
- AREA NOT IN SCOPE - NO OCCUPANCY SHOWN

- FIRE EXTINGUISHER CABINET
- FIRE EXTINGUISHER ON WALL BRACKET
- 36" SINGLE DOOR CAPACITY = 160
- 72" DOUBLE DOOR CAPACITY = 320
- CAPACITY OF MEANS OF EGRESS EXIT DOORS IS CALCULATED BY MULTIPLYING THE OCCUPANT LOAD BY A FACTOR OF 0.2/OCC. (CBC 1005.3.2)
- BUILDING HAS SPRINKLER SYSTEM THROUGHOUT
- MAX COMMON PATH, PER CBC 1006.2.1
- GROUP A-E = 75'
- GROUP B = 100'


- PER CBC 1017.2 MAXIMUM PATH OF TRAVEL TO EXIT - A+E OCCUPANCIES: 250' B OCCUPANCY: 300'
- PER CBC 1030.2 - ASSEMBLY MAIN EXIT - IF OCC LOAD > 300, THEN 1/2 OF OCC MUST EXIT THRU MAIN ENTRY
- PER CBC 303.1.2 - SMALL ASSEMBLY SPACES ASSEMBLY ROOMS W/ < 50 OCC SHALL BE CLASSIFIED AS GROUP B ASSEMBLY ROOMS W/ < 750 SF SHALL BE CLASSIFIED AS GROUP B, OR OTHER ACCESSORY OCCUPANCY

CODE SUMMARY

- (E) CONSTRUCTION TYPE: V6 (NO CHANGE)
- (E) OCCUPANCY GROUP: A-3, B & E NON-SEPARATED (NO CHANGE) A-3 MOST RESTRICTIVE FULLY SPRINKLERED (NO CHANGE) 1 (NO CHANGE) IV
- (E) FIRE SPRINKLERS: 1 (NO CHANGE)
- (E) RISK CATEGORY: IV
- (E) ALLOWABLE AREA INCLUDING FRONTAGE INCREASE: 28,439 SF
- (E) BUILDING AREA: 24,515 SF
- APPROX AREA OF ALTERATION: 735 SF RM 110 MP-2 1192 SF RM 123 MP-1 157 SF RM 120B STOR 98 SF RM 125 ELEC 156 SF RM 126 IT/TELE 406 SF RM 157 ELEC (MAIN) 65 SF RM 173 STOR 121 SF RM 175 STOR
- SUB-TOTAL ALTERATION AREA **2,930 SF**
- BUILDING ELEMENT RATING - TABLE 601 FIRE RESISTANCE: PRIMARY STRUCTURAL FRAME 0-HR BEARING WALLS INTERIOR 0-HR BEARING WALLS EXTERIOR 0-HR NONBEARING WALLS/PARTITIONS 0-HR FLOOR CONSTRUCTION 0-HR ROOF CONSTRUCTION 0-HR ELECTRICAL ROOM 1-HR & 2-HR AS REQ'D BY CEC. SEE ELEC DWGS

N. LOBBY DOOR POTENTIAL LOAD

AGGREGATE NORTH LOBBY:	
NORTH LOBBY	292
1/2 MP1	42
1/2 MP2	24
RECEPTION	3
FUTURE CAFE	2
SUB TOTAL	363
1/2 SOUTH LOBBY	221
TOTAL	584
CAPACITY (4) PAIR OF DOORS	1280

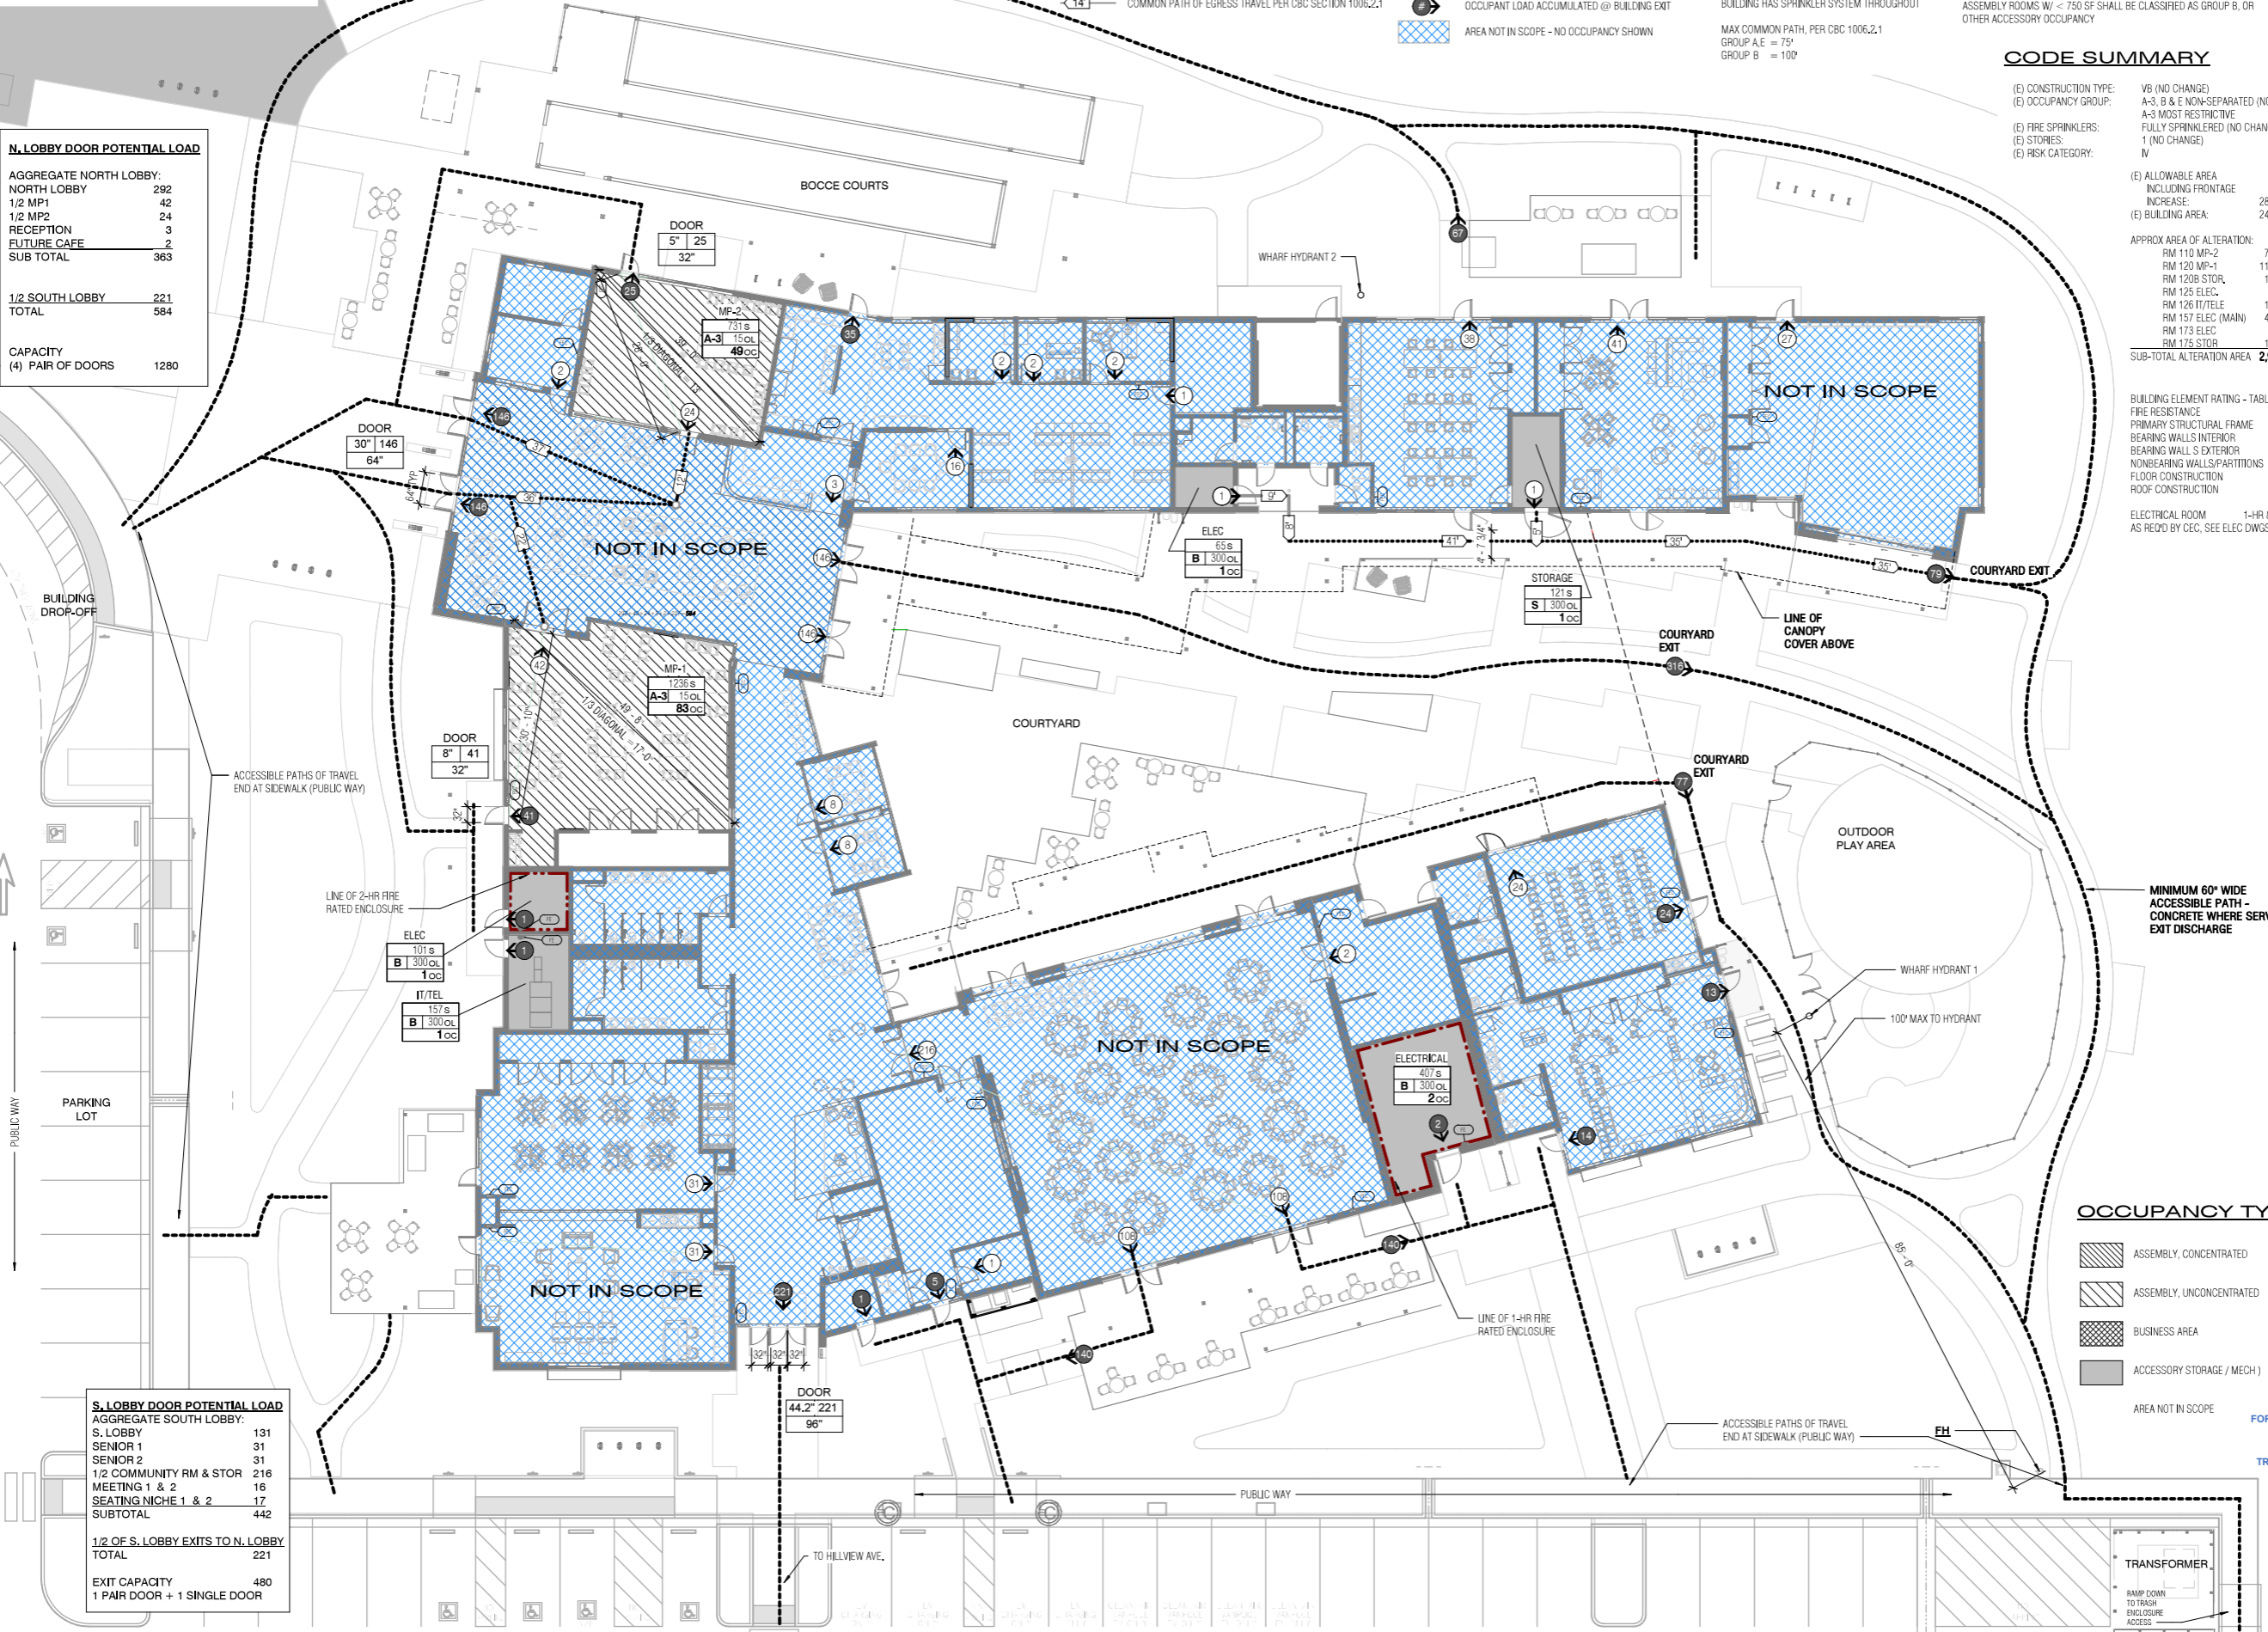

S. LOBBY DOOR POTENTIAL LOAD

AGGREGATE SOUTH LOBBY:	
S. LOBBY	131
SENIOR 1	31
SENIOR 2	31
1/2 COMMUNITY RM & STOR	216
MEETING 1 & 2	16
SEATING NICHE 1 & 2	17
SUBTOTAL	442
1/2 OF S. LOBBY EXITS TO N. LOBBY TOTAL	221
EXIT CAPACITY (1 PAIR DOOR + 1 SINGLE DOOR)	480

OCCUPANCY TYPE

- ASSEMBLY, CONCENTRATED
- ASSEMBLY, UNCONCENTRATED
- BUSINESS AREA
- ACCESSORY STORAGE / MECH
- AREA NOT IN SCOPE

APPROVALS

NOLL & TAM ARCHITECTS
 729 Heinz Avenue
 Berkeley, CA 94710
 tel 510.542.2200
 fax 510.542.2201

729 HEINZ AVENUE
 BERKELEY, CALIFORNIA
 INCORPORATED DECEMBER 1991

SEAL: [Professional Seal]

PROJECT TITLE: **City of Los Altos EMERGENCY OPERATION CENTER**
 97 Hillview Ave. Los Altos, CA 94022

ISSUE TITLE: **PERMIT SET**

ISSUE DATE: **AUG 03, 2023**
 NOLL & TAM JOB NUMBER: **22203**

REVISIONS:

DATE	DESCRIPTION
1/15/2023	PERMIT PLAN CHECK RESPONSE

REVIEWED FOR CODE COMPLIANCE: **January 5, 2024**
 TRB AND ASSOCIATES

SHEET TITLE: **CODE SUMMARY & OCCUPANCY EGRESS PLAN**

SHEET NUMBER: **G1-0**

1/11/2023 2:27:07 PM Autodesk Docs:Los Altos EOCCLAECC_Arch_Central_2023.rvt

DIVISION 5.5 Environmental Quality (Level 500)	SECTION TITLE	CODE SECTION	Y	N/A	O	PLAN SHEET, SPEC. OR ATTACH REFERENCE	APPLICABLE MEASURES
Mandatory	Ultraviolet air delivery	5.506.1	Y	N/A			
Mandatory	Carbon dioxide (CO2) monitoring	5.506.2	N/A				
Mandatory	Acoustical control (with exception)	5.507.1	N/A				
Mandatory	Exterior noise transmission, prescriptive method (with exceptions)	5.507.1.1	N/A				

CITY OF LOS ALTOS
JOB COPY
REVIEWED FOR CODE COMPLIANCE

CALGREEN SIGNATURE DECLARATIONS
Project Name: Los Altos Emergency Operation Center
Project Address: 97 Hillview Ave, Los Altos, CA 94022
Project Description: Alteration to (e) Community Center completed in 2021 and addition of exterior emergency generator

SECTION 1 - DESIGN VERIFICATION
Complete all items of Section 1 - Design Verification and SUBMIT THE ENTIRE CHECKLIST (COLUMNS 2 AND 3) WITH THE PLANS AND BUILDING PERMIT APPLICATION TO THE BUILDING DEPARTMENT.

The owner and design professional responsible for compliance with Cal Green Standards have reviewed the plans and certify that the items checked above are hereby incorporated into the project plans and will be implemented into the project in accordance with the requirements set forth in the 2022 California Green Building Standards Code as adopted by the City of Los Altos.

Morgan Loati
Owner's Signature Date: 11/13/2023
Morgan Loati
Owner's Name (Please Print)
Design Professional's Signature Date: 10/04/2023
Janel Tam
Design Professional's Name (Please Print)
Noll & Tam Architects (510) 542-2200
Name of LEED Accredited Professional or organization
Signature of LEED Accredited Professional or organization Date: 10/12/2023
Dora Polak, AIA LEED AP BD+C
Name of LEED Accredited Professional or organization (Please Print) (510) 542-2200
Email Address for LEED Accredited Professional or organization: dora.polak@nolltam.com

SECTION 2 - IMPLEMENTATION VERIFICATION
Complete, sign and submit the completed checklist together with all original signatures on Section 2 to the Building Department PRIOR TO BUILDING DEPARTMENT FINAL INSPECTION.

I have inspected the work and have received sufficient documentation to verify and certify that the project identified above was constructed in accordance with the Green Building Checklist and in accordance with the requirements of the 2022 California Green Building Standards Code as adopted by the City of Los Altos.

Signature of LEED Accredited Professional or organization Date
Name of LEED Accredited Professional or organization (Please Print) Phone No.

2022 CALGREEN NON-RESIDENTIAL MANDATORY MEASURES CHECKLIST Version 4.12.2023
DEVELOPMENT SERVICES DEPARTMENT - BUILDING DIVISION
VERONICA TINOCO, BUILDING OFFICIAL
BUILDING@LOSALTOS.CA.GOV • WWW.LOSALTOS.CA.GOV

PURPOSE:
The non-residential provisions of the 2022 Cal Green Code outline planning, design and development methods that include environmentally responsible site selection, building design, and building site development to protect, restore and enhance the environmental quality of the site and respect the integrity of adjacent properties; establish the means of conserving water used indoors, outdoors and in wastewater conveyance; outline means of achieving material conservation and resource efficiency; and outline means of reducing the quantity of air contaminants.

Project Name: Los Altos Emergency Operation Center
Project Address: 97 Hillview Ave, Los Altos, CA 94022
Project Description: Alteration to (e) Community Center completed in 2021 and addition of exterior emergency generator


Instructions:
1. The owner or owner's agent shall employ a LEED accredited professional or organization (LACM Section 12.28.03) experienced with the 2022 Green Building Standards Code to inspect, verify and assure that all required work described herein is properly planned and implemented in the project.
2. The LEED accredited professional or organization, in collaboration with the owner and the design professional shall review this checklist, initial the "Applicable Measures" column and sign and date Section 1 - Design Verification at the end of this checklist prior to submittal.
3. PRIOR TO FINAL INSPECTION BY THE BUILDING DIVISION, the LEED accredited professional or organization shall inspect the project. Once all applicable measures have been verified, sign and date Section 2 - Implementation. Verification and submit the completed form to the Building Division: building@losaltos.ca.gov

Application:
This checklist shall be used for nonresidential projects that meet one of the following:
• New construction
• Building additions of 1,000 sq. ft. or greater or
• Building alterations with a permit valuation of \$200,000 or more pursuant to Section 301.3 AND do not trigger a Tier 1 or Tier 2 and initial tenant or occupant improvement to a new commercial building.

Requirement:
Y = Yes (section has been selected and/or included)
N/A = Not Applicable (Code section does not apply to the project-mainly used for additions and alterations)
O = Other (provide explanation)
[N] = New construction pursuant to Section 301.3
[A] = Additions and/or Alterations pursuant to Section 301.4

Chapter 5 Divisions	SECTION TITLE	CODE SECTION	Y	N/A	O	PLAN SHEET, SPEC. OR ATTACH REFERENCE	APPLICABLE MEASURES
DIVISION 5.1 Planning and Design	Mandatory Storm water pollution prevention for projects that disturb less than 1 acre of land	5.106.1	Y			C4.1, C4.2	DP
Mandatory	Short-term bicycle parking (with exception)	5.106.4.1	N/A				
Mandatory	Long-term bicycle parking	5.106.4.2	N/A				
Mandatory	EV Capable spaces	5.106.5.1	N/A				
Mandatory	Electric Vehicle Charging Stations	5.106.5.2	N/A				
Mandatory	Use of Automatic Load Management Systems (ALMS)	5.106.5.3	N/A				
Mandatory	Accessible EVCS	5.106.5.4	N/A				
Mandatory	Light pollution reduction (with exceptions and table)	5.106.6	Y			C2.1, C3.1	DP
Mandatory	Grading and paving (with exception for additions and alterations not altering the drainage path)	5.106.10	Y			C4.1, E8-1, E8-2	DP
Mandatory	Meet the minimum energy efficiency standard	5.201.1	Y				DP
DIVISION 5.2 Energy	Mandatory Separate meters (new buildings or additions > 50,000 SF that consume more than 100 gal/day)	5.303.1.1	N/A				
DIVISION 5.3 Water Efficiency and Conservation	Mandatory Separate meters for tenants in new buildings or additions that consume more than 1,000 gal/day	5.303.1.2	N/A				
Mandatory	Water closets shall not exceed 1.28 gallons per flush (gpf)	5.303.2.1	N/A				
Mandatory	Face-mounted urinals shall not exceed 0.25 gpf	5.303.2.2	N/A				
Mandatory	Single showerhead shall have maximum flow rate of 1.8 gpm at 80 psi	5.303.3.1	N/A				
Mandatory	Multiple showerheads serving one shower shall have a combined flow rate of 1.8 gpm at 80 psi	5.303.3.2	N/A				
Mandatory	Nonresidential lavatory faucets	5.303.3.3	N/A				
Mandatory	Kitchen faucets	5.303.3.4	N/A				
Mandatory	Wash fountains	5.303.3.5	N/A				
Mandatory	Watering faucets	5.303.3.6	N/A				
Mandatory	Watering faucets for wash fountains	5.303.3.7	N/A				
Mandatory	Food waste disposers	5.303.4	N/A				
Mandatory	Areas of additions or alterations	5.303.5	N/A				
Mandatory	Standards for plumbing fixtures and fittings	5.303.6	N/A				
Mandatory	Outdoor potable water use in landscape areas (with notes)	5.304.1	N/A				

Chapter 5 Divisions	SECTION TITLE	CODE SECTION	Y	N/A	O	PLAN SHEET, SPEC. OR ATTACH REFERENCE	APPLICABLE MEASURES
DIVISION 5.4 Material Conservation and Resource Efficiency	Mandatory Weather protection	5.407.1	Y			A3-1	DP
Mandatory	Moisture control: sprinklers	5.407.2.1	N/A				
Mandatory	Moisture control: exterior door protection	5.407.2.2	N/A				
Mandatory	Moisture control: flashing	5.407.2.3	N/A				
Mandatory	Construction waste management: comply with either Sections 5.408.1.1, 5.408.1.2, 5.408.1.3 or more stringent local ordinance	5.408.1	Y			Spec 01 74 19	DP
Mandatory	Construction waste management: documentation	5.408.1.4	Y			Spec 01 74 19	DP
Mandatory	Excavated soil and land clearing debris (100% reuse or recycling)	5.408.2	Y			Spec 01 74 19	DP
Mandatory	Recycling by occupants: additions (with exception)	5.410.1.1	N/A			O	Existing and unchanged
Mandatory	Recycling by occupants: additions (with exception)	5.410.1.2	N/A				
Mandatory	Recycling by occupants: same as ordinance	5.410.1.3	N/A				
Mandatory	Recycling by occupants: required for new buildings (> 10,000 SF)	5.410.2	N/A				
Mandatory	Owner's or owner representative's Project Requirements (OPR)	5.410.2.1	N/A				
Mandatory	Basics of Design (BOD)	5.410.2.2	N/A				
Mandatory	Commissioning plan [N]	5.410.2.3	N/A				
Mandatory	Functional performance testing [N]	5.410.2.4	N/A				
Mandatory	Documentation and training [N]	5.410.2.5	N/A				
Mandatory	Systems manual [N]	5.410.2.6	N/A				
Mandatory	Systems operation training [N]	5.410.2.7	N/A				
Mandatory	Commissioning report [N]	5.410.2.8	N/A				
Mandatory	Testing and adjusting: required for new buildings < 10,000 SF or new systems that serve additions or alterations	5.410.4	Y			Spec 01 40 00, Div 22, 23, 26	DP
Mandatory	System testing plan for renewable energy, landscape irrigation and water reuse	5.410.4.2	Y				Electrical testing included in specification 28 08 00
Mandatory	Procedures for testing and adjusting	5.410.4.3	Y				
Mandatory	Procedures for HVAC balancing	5.410.4.3.1	Y				
Mandatory	Reporting for testing and adjusting	5.410.4.4	Y				
Mandatory	Operation and maintenance (O&M) manual	5.410.4.5	Y			01 78 23, 01 45 23	
Mandatory	Inspections and reports	5.410.4.5.1	Y				
DIVISION 5.5 Environmental Quality	Mandatory Woodsheds	5.503.1	N/A				
Mandatory	Temporary ventilation	5.504.1	Y			Spec 02 41 13	DP
Mandatory	Covering of duct openings and protection of mechanical equipment during construction	5.504.2	Y			Spec 02 41 13	DP
Mandatory	Adhesives, sealants and caulks	5.504.3	Y			Spec 01 81 13 and 02 41 13	
Mandatory	Paints and coatings	5.504.4	Y			Spec 01 81 13	
Mandatory	Aerosol paints and coatings: verification	5.504.4.2	Y			Spec 01 81 13	
Mandatory	Resilient flooring systems	5.504.4					

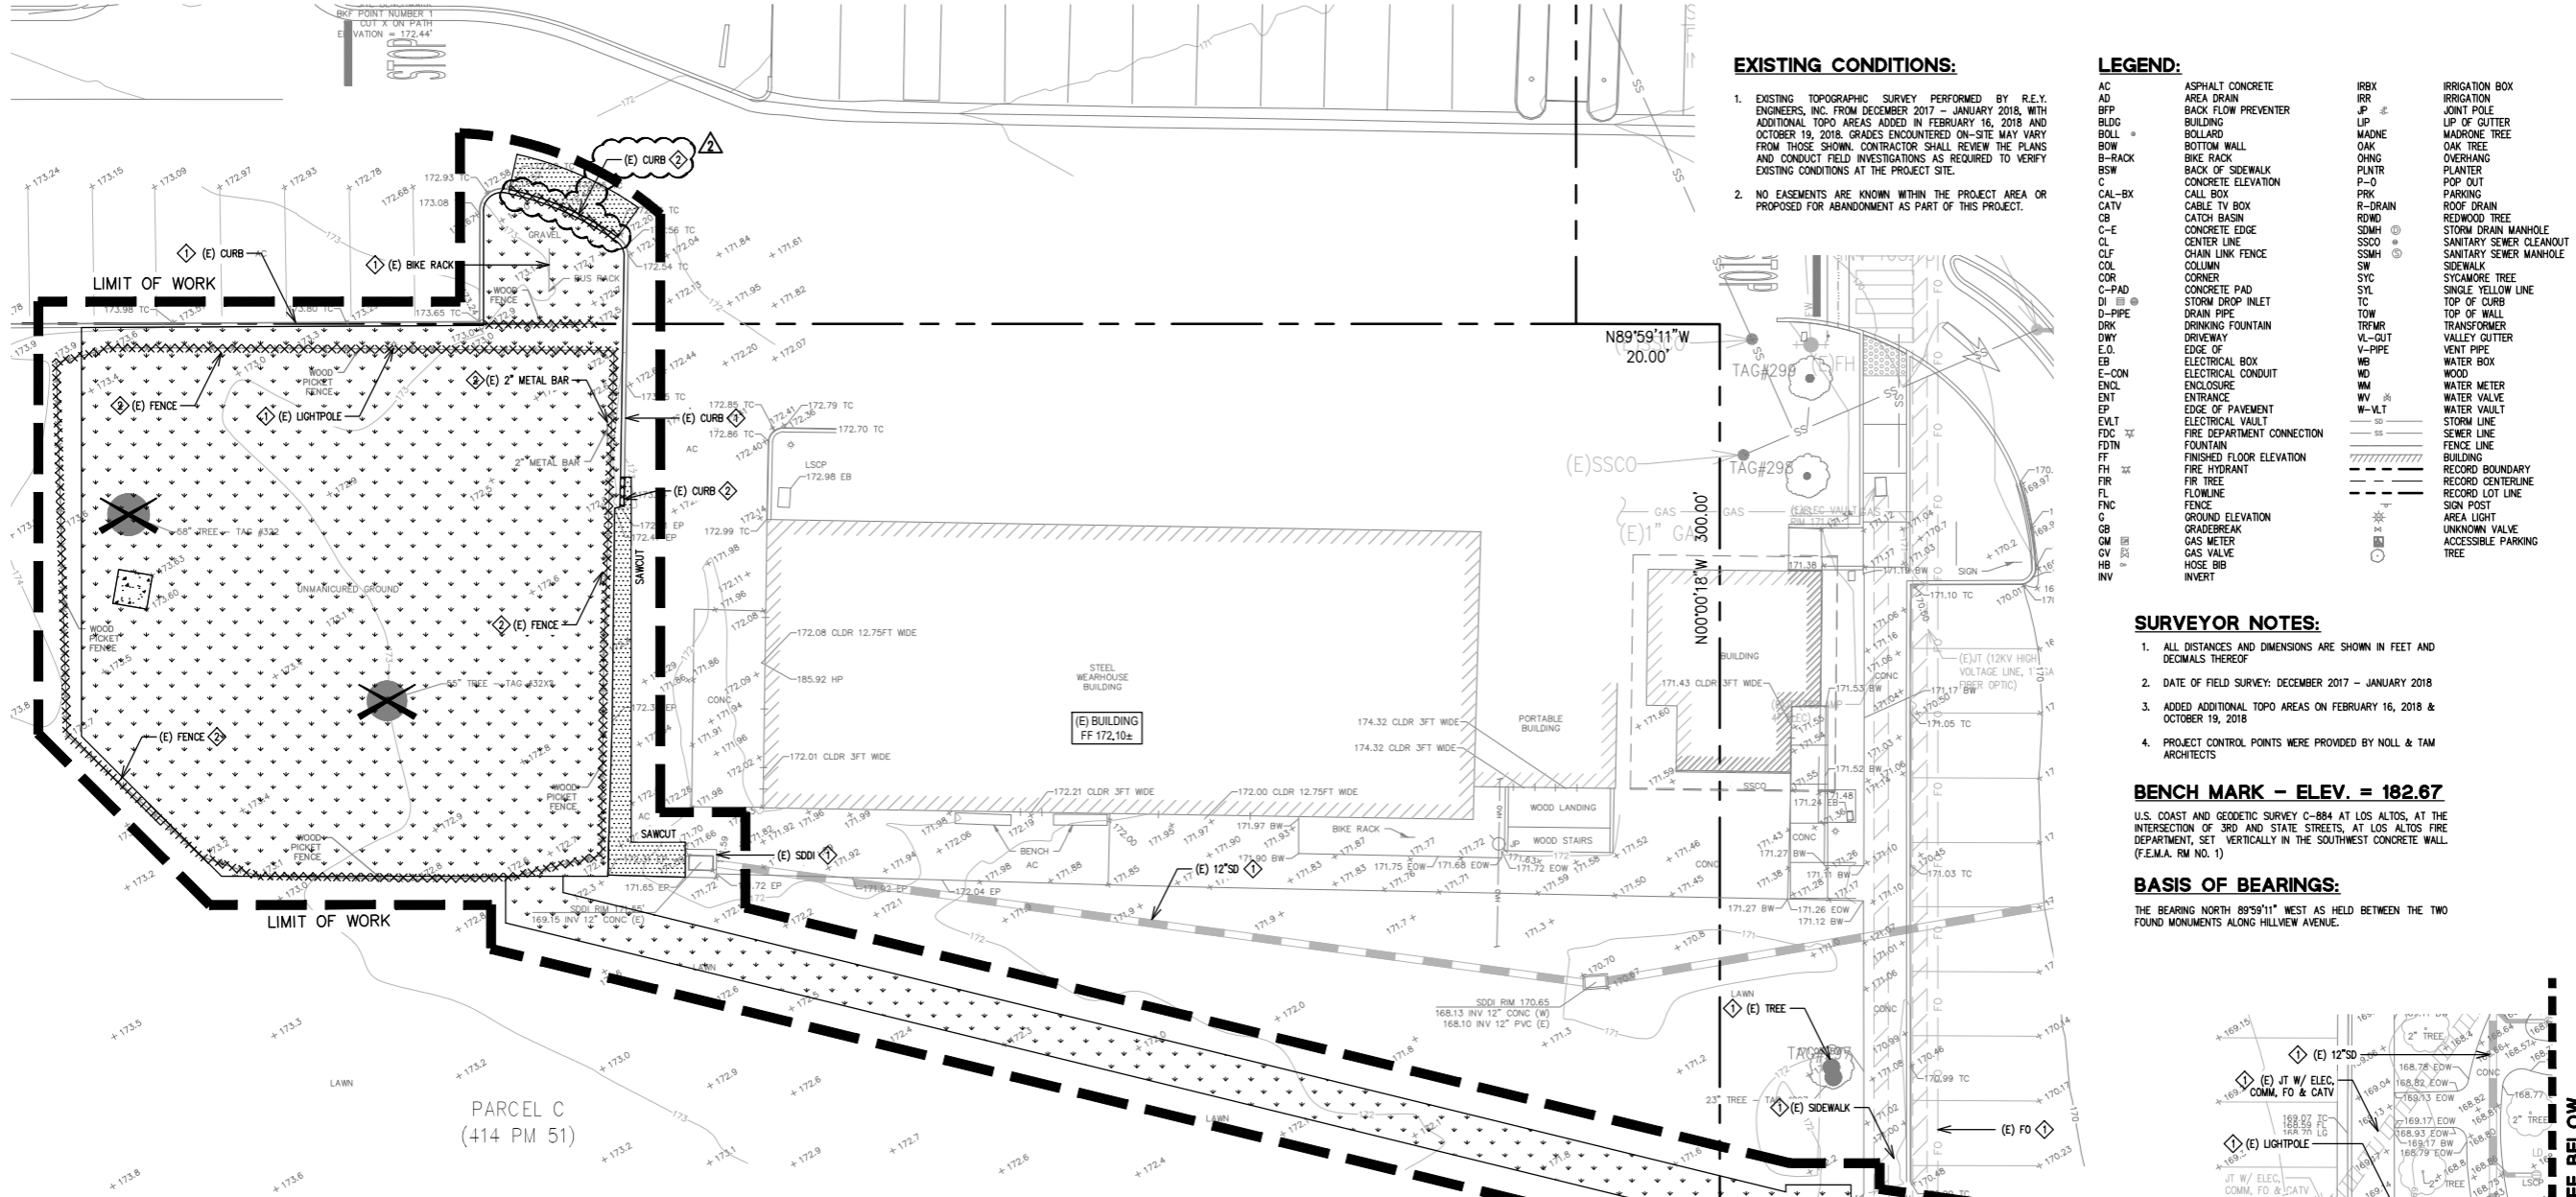

EXISTING CONDITIONS:

- EXISTING TOPOGRAPHIC SURVEY PERFORMED BY R.E.Y. ENGINEERS, INC. FROM DECEMBER 2017 - JANUARY 2018, WITH ADDITIONAL TOPO AREAS ADDED IN FEBRUARY 16, 2018 AND OCTOBER 19, 2018. GRADES ENCOUNTERED ON-SITE MAY VARY FROM THOSE SHOWN. CONTRACTOR SHALL REVIEW THE PLANS AND CONDUCT FIELD INVESTIGATIONS AS REQUIRED TO VERIFY EXISTING CONDITIONS AT THE PROJECT SITE.
- NO EASEMENTS ARE KNOWN WITHIN THE PROJECT AREA OR PROPOSED FOR ABANDONMENT AS PART OF THIS PROJECT.

LEGEND:

AC	ASPHALT CONCRETE	IRBX	IRRIGATION BOX
AD	AREA DRAIN	JP	JOINT POLE
BFP	BACK FLOW PREVENTER	LIP	LIP OF GUTTER
BLDG	BUILDING	MADNE	MAURINE TREE
BOLL	BOLLARD	OAK	OAK TREE
BOW	BOTTOM WALL	OHNG	OVERHANG
B-RACK	BIKE RACK	PLNTR	PLANTER
BSW	BACK OF SIDEWALK	POP	POP OUT
C	CONCRETE ELEVATION	PRK	PARKING
CAL-BX	CALL BOX	R-DRAIN	ROOF DRAIN
CATV	CABLE TV BOX	RDMO	REDWOOD TREE
CB	CATCH BASIN	SDMH	STORM DRAIN MANHOLE
C-E	CONCRETE EDGE	SSCO	SANITARY SEWER CLEANOUT
CL	CENTER LINE	SSMH	SANITARY SEWER MANHOLE
CLF	CHAIN LINK FENCE	SYW	SYCAMORE TREE
COL	COLUMN	SYL	SINGLE YELLOW LINE
COR	CORNER	TC	TOP OF CURB
C-PAD	CONCRETE PAD	TOW	TOP OF WALL
DI	DRAIN DROP INLET	TRNDR	TRANSFORMER
D-PIPE	DRAIN PIPE	VAL-GUT	VALLEY GUTTER
ENT	ENTRANCE	SS	SEWER LINE

SURVEYOR NOTES:

- ALL DISTANCES AND DIMENSIONS ARE SHOWN IN FEET AND DECIMALS THEREOF.
- DATE OF FIELD SURVEY: DECEMBER 2017 - JANUARY 2018
- ADDED ADDITIONAL TOPO AREAS ON FEBRUARY 16, 2018 & OCTOBER 19, 2018
- PROJECT CONTROL POINTS WERE PROVIDED BY NOLL & TAM ARCHITECTS

BENCH MARK - ELEV. = 182.67

U.S. COAST AND GEODETIC SURVEY C-884 AT LOS ALTOS, AT THE INTERSECTION OF 3RD AND STATE STREETS, AT LOS ALTOS FIRE DEPARTMENT, SET VERTICALLY IN THE SOUTHWEST CONCRETE WALL (F.E.M.A. RM NO. 1)

BASIS OF BEARINGS:

THE BEARING NORTH 89°59'11" WEST AS HELD BETWEEN THE TWO FOUND MONUMENTS ALONG HILLVIEW AVENUE.

DEMOLITION NOTES:

- CONTRACTOR IS TO COMPLY WITH ALL GENERAL AND STATE REQUIREMENTS INVOLVING THE REMOVAL AND DISPOSAL OF HAZARDOUS MATERIAL(S).
- CONTRACTOR'S BID IS TO INCLUDE ALL VISIBLE SURFACE AND ALL SUBSURFACE FEATURES IDENTIFIED TO BE REMOVED OR ABANDONED IN THESE DOCUMENTS.
- THE CONTRACTOR SHALL BE RESPONSIBLE FOR A SITE INSPECTION TO FULLY ACKNOWLEDGE THE EXTENT OF THE DEMOLITION WORK.
- THE CONTRACTOR SHALL BE RESPONSIBLE FOR OBTAINING ANY AND ALL PERMITS NECESSARY FOR ENCROACHMENT, GRADING, DEMOLITION, AND DISPOSAL OF SAID MATERIALS AS REQUIRED BY PRIVATE, LOCAL AND STATE JURISDICTIONS. THE CONTRACTOR SHALL PAY ALL FEES ASSOCIATED WITH THE DEMOLITION WORK.
- BACKFILL AND COMPACT ALL DEPRESSIONS AND TRENCHES FROM DEMOLITION ACTIVITY TO FINAL GRADE ELEVATION, CONSISTENT WITH THE GEOTECHNICAL REPORT.
- REMOVAL OF LANDSCAPING SHALL INCLUDE ROOTS AND ORGANIC MATERIALS CONSISTENT WITH THE SOIL COMPACTION REQUIREMENTS OF THE GEOTECHNICAL REPORT.
- PRIOR TO BEGINNING DEMOLITION WORK ACTIVITIES, CONTRACTOR SHALL INSTALL EROSION CONTROL MEASURES OUTLINED IN THE EROSION CONTROL PLAN & DETAILS.
- THE CONTRACTOR SHALL MAINTAIN ALL SAFETY DEVICES, AND SHALL BE RESPONSIBLE FOR CONFORMANCE TO ALL LOCAL, STATE AND FEDERAL SAFETY AND HEALTH STANDARDS LAWS AND REGULATIONS.
- THE CONTRACTOR SHALL PROTECT FROM DAMAGE ALL EXISTING IMPROVEMENTS FACILITIES AND STRUCTURES WHICH ARE TO REMAIN. ANY ITEMS DAMAGED BY THE CONTRACTOR OR HIS AGENTS OR ANY ITEMS REMOVED FOR HIS USE SHALL BE REPLACED IN EQUAL OR BETTER CONDITION AS APPROVED BY THE ARCHITECT OR OWNER'S REPRESENTATIVE.
- COORDINATE WITH ELECTRICAL, MECHANICAL, LANDSCAPING AND ARCHITECTURAL DRAWINGS FOR UTILITY SHUT-DOWN/DISCONNECT LOCATIONS. CONTRACTOR IS TO SHUT OFF ALL UTILITIES AS NECESSARY PRIOR TO DEMOLITION. CONTRACTOR IS TO COORDINATE SERVICE INTERRUPTIONS WITH THE OWNER. DO NOT INTERRUPT SERVICES TO ADJACENT OFF-SITE OWNERS. ALSO SEE ARCHITECTURAL PLANS FOR ADDITIONAL DEMOLITION SCOPE OF WORK.
- NOTIFY OWNER 1 WEEK IN ADVANCE OF UTILITY SHUT-DOWN. OWNER REP: THERESA YEE, PMP, CPC, PROJECT MANAGER (650)947-2825.
- THIS PLAN IS NOT INTENDED TO BE A COMPLETE CATALOGUE OF ALL EXISTING STRUCTURES AND UTILITIES. THIS PLAN INTENDS TO DISCLOSE GENERAL INFORMATION KNOWN BY THE ENGINEER AND TO SHOW THE LIMITS OF THE AREA WHERE WORK WILL BE PERFORMED. THIS PLAN SHOWS THE EXISTING FEATURES TAKEN FROM A FIELD SURVEY, FIELD INVESTIGATIONS AND AVAILABLE INFORMATION. THIS PLAN MAY OR MAY NOT ACCURATELY REFLECT THE TYPE OR EXTENT OF THE ITEMS TO BE ENCOUNTERED AS THEY ACTUALLY EXIST. WHERE EXISTING FEATURES ARE NOT SHOWN, THE CONTRACTOR SHALL SEEK GUIDANCE FROM THE ARCHITECT. THE CONTRACTOR SHALL PERFORM A THOROUGH FIELD INVESTIGATION AND REVIEW OF THE SITE WITHIN THE LIMIT OF WORK SHOWN IN THIS PLAN SET TO DETERMINE THE TYPE, QUANTITY AND EXTENT OF ANY AND ALL ITEMS. THE CONTRACTOR SHALL BE SOLELY RESPONSIBLE FOR DETERMINING THE EXTENT OF EXISTING STRUCTURES AND UTILITIES AND QUANTITY OF WORK INVOLVED IN REMOVING THESE ITEMS FROM THE SITE.

DEMOLITION LEGEND:

	LIMIT OF WORK	WITHIN THE LIMIT OF WORK LINE ALL ITEMS NOT CALLED OUT TO BE REMOVED ARE TO REMAIN AND MUST BE PROTECTED IN PLACE. CONTRACTOR TO USE CAUTION AROUND (E) UTILITIES, UTILITY VAULTS AND WATER VALVES TO REMAIN.
	EXISTING AC PAVING	(E) AC PAVEMENT, AND BASE ROCK TO BE REMOVED. BASE ROCK UNDER AC PAVEMENT CAN BE REUSED IF APPROVED BY GEOTECHNICAL ENGINEER. ALL EDGES TO BE SAWCUT WITH A CLEAN EDGE.
	EXISTING CONCRETE PAVING	(E) CONCRETE, BASE ROCK AND REBAR TO BE REMOVED. BASE ROCK UNDER CONCRETE CAN BE REUSED IF APPROVED BY GEOTECHNICAL ENGINEER. ALL EDGES TO BE SAWCUT WITH A CLEAN EDGE AND EXTEND TO NEAREST (E) SCORE JOINT WHERE FEASIBLE.
	EXISTING LANDSCAPED AREAS	REMOVE ALL TREES, SHRUBS, AND GRASS INCLUDING ALL ROOT MASS UNLESS OTHERWISE SPECIFIED. COORDINATE WITH OWNER AND ARCHITECT PRIOR TO REMOVING ANY TREES. IRRIGATION LINES TO BE REPAIRED TO THE EXTENTS OF NEW PLANTING AND IRRIGATION CONSTRUCTION. SAP.
	EXISTING CURB/WALL TO BE DEMOLISHED AND REMOVED	



DEMOLITION KEYNOTES:

- TO REMAIN, PROTECT IN PLACE. SEE TEMPORARY FACILITIES NOTES.
- TO BE DEMOLISHED
- ADJUST TO PROPOSED FINISH SURFACE. SEE TEMPORARY FACILITIES NOTES.
- (E) TREE AND ASSOCIATED IRRIGATION FACILITIES TO BE REMOVED. REPLACE IN KIND UPON COMPLETION OF UNDERGROUND UTILITY WORK AND RESTORE ADJACENT GROUND COVER BACK TO EXISTING CONDITION.
- (E) TREE AND ASSOCIATED ROOT BALL TO BE REMOVED

TEMPORARY FACILITIES NOTES:

- THE CONTRACTOR IS RESPONSIBLE FOR MAINTAINING OPERATION AND FUNCTION OF EXISTING FACILITIES IMPACTED BY CONSTRUCTION, INCLUDING BUT NOT LIMITED TO EXISTING UTILITIES SERVING ADJACENT STRUCTURES AND AGENCIES WHICH RUN THROUGH THE CONSTRUCTION SITE, EXISTING ACCESS TO THOSE FACILITIES, AND RELATED STRUCTURES. APPLICABLE UTILITIES INCLUDE STORM DRAINAGE, SANITARY SEWER, DOMESTIC/FIRE WATER SUPPLY, IRRIGATION, NATURAL GAS, ELECTRICAL AND COMMUNICATION LINES.
- CONTRACTOR SHALL PLAN PHASING AND METHOD OF DISCONNECTION/RECONNECTION OF SITE UTILITIES TO MINIMIZE DOWNTIME WHERE SHUTDOWN IS NECESSARY, AND PROVIDE THE CITY WITH SCHEDULE FOR ANY PLANNED SHUTDOWN/DISCONNECTION AND RECONNECTION OF SERVICES.
- CONTRACTOR SHALL PROVIDE ALTERNATE MEANS AND METHODS FOR TEMPORARILY MAINTAINING FUNCTIONALITY / OPERATION OF EXISTING FACILITIES TO REMAIN (SUCH AS TEMPORARY USE OF PORTABLE PUMPS, POWER EQUIPMENT, TEMPORARY ALTERNATE SUPPLY/CONVEYANCE PIPES/CONDUITS, APPROPRIATE SIGNAGE) FOR THE CITY TO REVIEW AND APPROVE PRIOR TO COMMENCING CONSTRUCTION.
- CONTRACTOR SHALL TO RESTORE PERMANENT SERVICE TO EXISTING FACILITIES IMPACTED BY CONSTRUCTION TO THE SATISFACTION OF THE CITY.

CITY OF LOS ALTOS
JOB COPY
REVIEWED FOR CODE COMPLIANCE

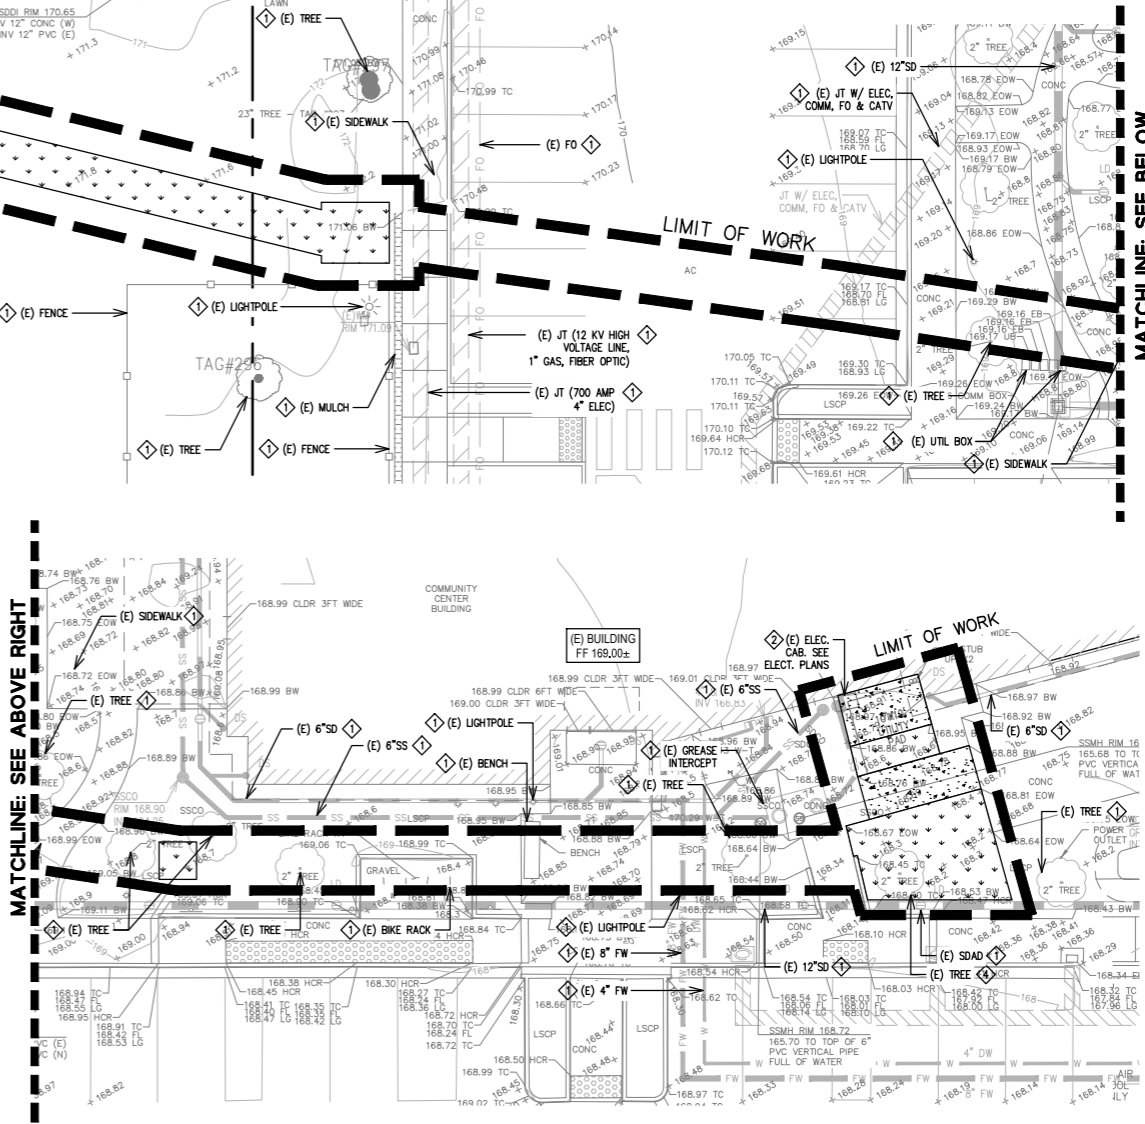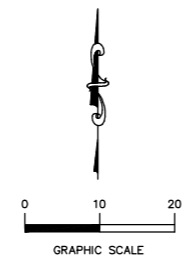


APPROVALS

NOLL & TAM ARCHITECTS

729 Heinz Avenue
Berkeley, CA 94710
tel 510.542.2200
fax 510.542.2201



BKF 100+ YEARS
ENGINEERS · SURVEYORS · PLANNERS

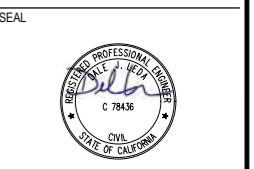

PROJECT TITLE
**City of Los Altos
EMERGENCY OPERATION CENTER**

97 Hillview Ave. Los Altos, CA 94022

ISSUE TITLE
PERMIT SET


ISSUE DATE	AUG 03, 2023
NOLL & TAM JOB NUMBER	22203
REVISIONS	
1	11/15/2023 PERMIT PLAN CHECK RESPONSE
2	12/18/2023 PLAN CHECK RESPONSE

SHEET TITLE
EXISTING CONDITIONS AND DEMOLITION PLAN

SHEET NUMBER

C1.1

DRAWING NAME: K:\2023\170208_Hillview_Community_Center_Permit_Set\Drawings\170208_Hillview_Community_Center_Permit_Set\170208_Hillview_Community_Center_Permit_Set.dwg
PLOT DATE: 11/15/23
PLOT BY: JEM

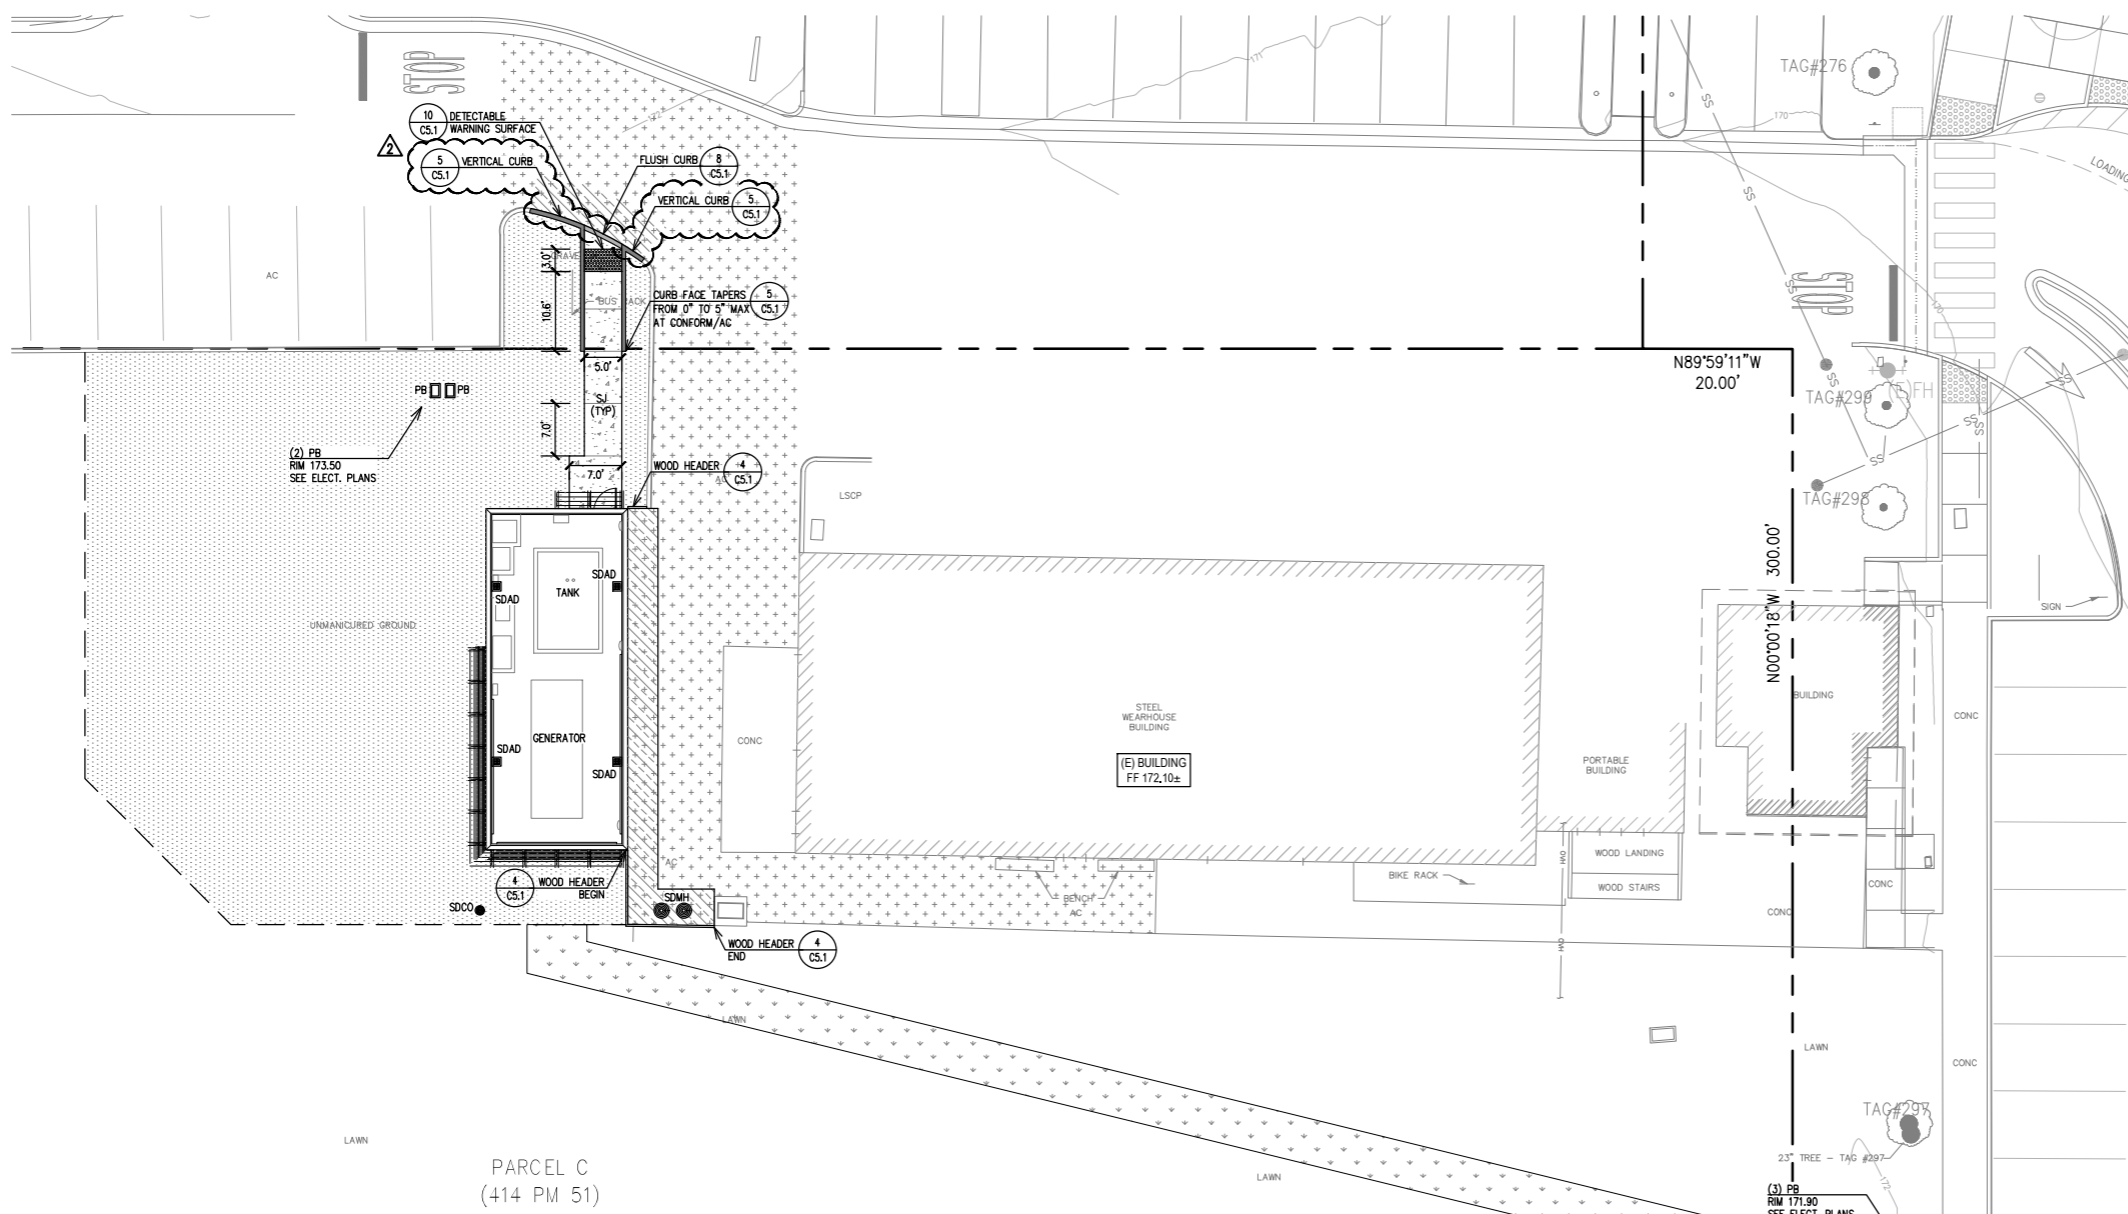

CITY OF LOS ALTOS
JOB COPY
 REVIEWED FOR CODE COMPLIANCE

PAVEMENT NOTES:

1. PAVEMENT SECTION TO BE APPROVED BY GEOTECHNICAL ENGINEER.
2. SEE STRUCTURAL PLANS FOR FOUNDATION DETAILS AND PAVEMENT EDGE AT BUILDING FACE.

HORIZONTAL CONTROL NOTES:

1. NORTHINGS AND EASTINGS ARE BASED ON AN ASSUMED DATUM AND NOT STATE PLANE COORDINATES. THE LISTED NORTHINGS AND EASTINGS SHOULD BE USED FOR RELATIVE GEOMETRY ONLY AND NOT FOR ABSOLUTE PHYSICAL LOCATION.
2. THE BASIS OF BEARING FOR THE SURVEY IS NORTH 89°59'11" WEST AS HELD BETWEEN THE TWO FOUND MONUMENTS ALONG HILLVIEW AVENUE.

TRAFFIC CONTROL NOTES:

1. CONTRACTOR SHALL PREPARE A TRAFFIC CONTROL PLAN FOR ALL WORK WHICH IMPACTS EXISTING PUBLIC STREETS OR AFFECTS ONSITE VEHICULAR CIRCULATION. TRAFFIC CONTROL PLAN TO BE SUBMITTED TO AND APPROVED BY THE CITY PRIOR TO COMMENCEMENT OF WORK.


PAVEMENT/HATCH LEGEND:

CONTRACTOR MUST REVIEW GEOTECHNICAL REPORT BY CAL ENGINEERING AND GEOLOGY ON MAY 22, 2018 FOR EXACT RECOMMENDATION FOR GRADING OPERATIONS AND OVER-EXCAVATION ON-SITE AND PROVIDE SUBMITTAL PRIOR TO STARTING ANY GRADING OPERATIONS.

	STANDARD CONCRETE PAVING	6" CONCRETE W/#4 BARS 18" O.C. - EACH WAY OVER 6" OF CALTRANS CLASS 2 AGGREGATE BASE COMPACTED TO 95% R.C. PROVIDE THICKENED EDGE ON ALL CONCRETE PAVING ADJACENT TO LANDSCAPE AREAS, EXTENDING TO BOTTOM OF BASEROCK SECTION. SEE PLANS FOR SCORE JOINTS.
	AC PAVING	3" AC PAVING OVER 9" OF CALTRANS CLASS 2 AGGREGATE BASE COMPACTED TO 95% R.C.
	SLURRY SEAL (E)AC	TYPE II IN ACCORDANCE WITH SECTION 37-3 OF THE CALTRANS STANDARD SPECIFICATIONS.
	LANDSCAPE	SHREDDED MULCH 4" NOMINAL THICKNESS.
	LANDSCAPE	REPLACE EXISTING PLANTING, TREES, IRRIGATION, AND MULCH IN KIND

SIGNING AND STRIPING NOTES:

1. REPLACE (E) PAVEMENT STRIPING & MARKING IN KIND WITH SAME MATERIAL (THERMOPLASTIC OR PAINT) OR APPROVED EQUAL DUE TO CONSTRUCTION ACTIVITY. PAVEMENT STRIPING OR MARKING SHALL MATCH EXISTING DIMENSIONS.

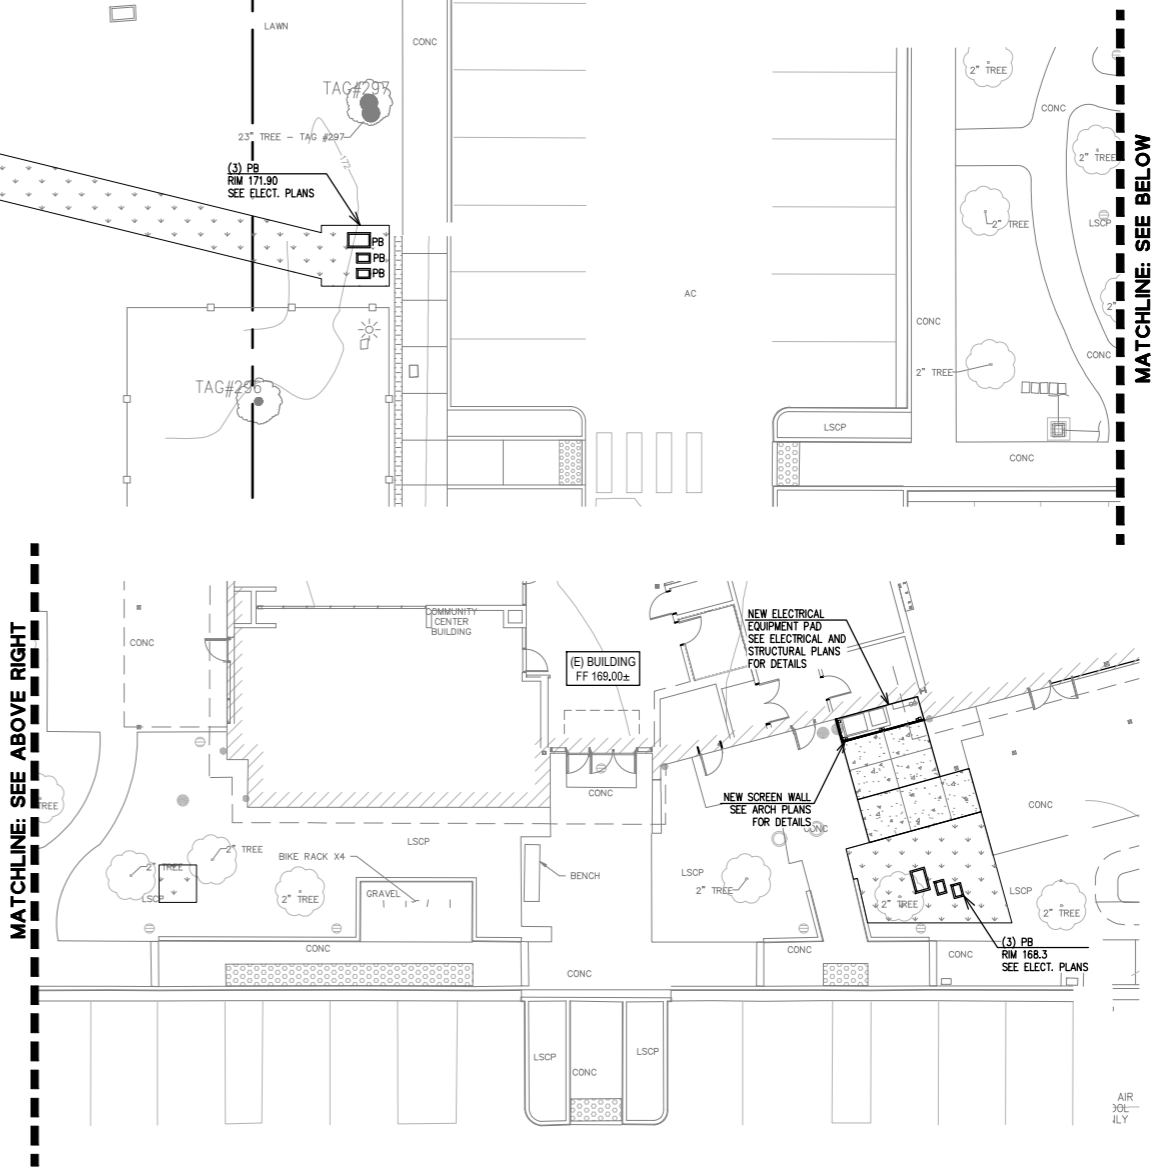

MATCHLINE: SEE BELOW

MATCHLINE: SEE ABOVE RIGHT

APPROVALS

NOLL & TAM ARCHITECTS

729 Heinz Avenue
 Berkeley, CA 94710
 tel 510.542.2200
 fax 510.542.2201

CITY OF LOS ALTOS
JOB COPY
 REVIEWED FOR CODE COMPLIANCE

ENGINEERS · SURVEYORS · PLANNERS

SEAL

PROJECT TITLE

**City of Los Altos
 EMERGENCY OPERATION CENTER**

97 Hillview Ave. Los Altos, CA 94022

ISSUE TITLE

PERMIT SET

ISSUE DATE: AUG 03, 2023
 NOLL & TAM JOB NUMBER: 22203

REVISIONS

DATE	DESCRIPTION
11/15/2023	PERMIT PLAN CHECK RESPONSE
12/18/2023	PLAN CHECK RESPONSE


SHEET TITLE

HORIZONTAL CONTROL PLAN

SHEET NUMBER

C2.1

DRAWING NAME: K:\2017\170208_Hillview_Community_Center_Redev\EN\locsheet_soc_30x42.dwg
 PLOTTED BY: memo
 PLOT DATE: 12-13-23

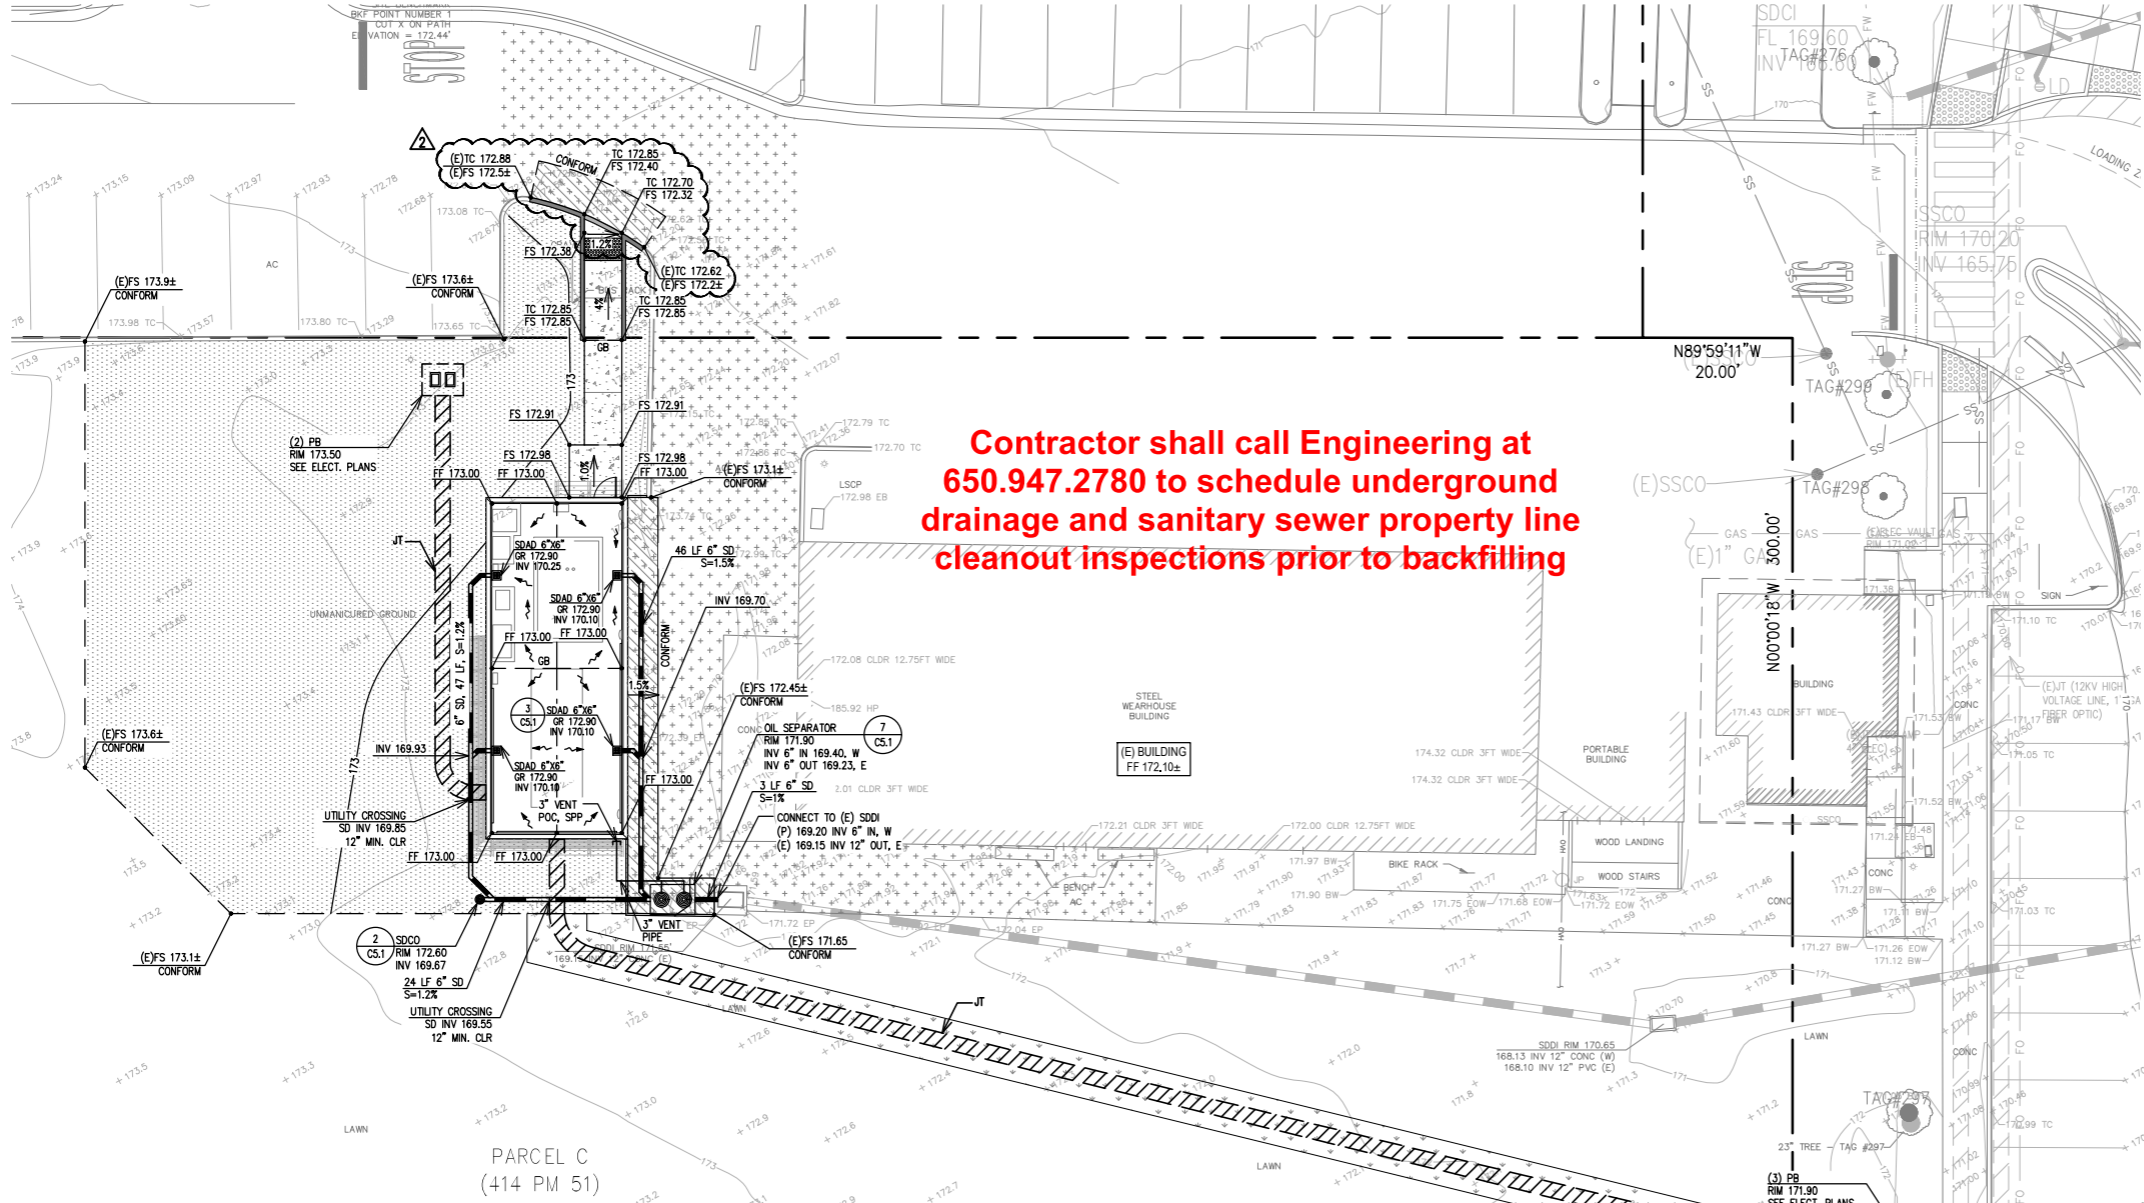

GRADING NOTES:

1. ALL PAVED AREAS ARE TO SLOPE A MINIMUM OF 1% AND MAXIMUM OF 8% ACCESSIBLE STALLS AND LOADING ZONES ARE TO SLOPE AT A MAXIMUM OF 2% IN ALL DIRECTIONS. ACCESSIBLE PATHWAYS ARE TO SLOPE AT A MAXIMUM OF 5% IN THE DIRECTION OF TRAVEL, AND THE SLOPE CROSSWAYS TO THE DIRECTION OF TRAVEL SHALL BE AT A MAXIMUM OF 2%. ANY AREAS ON THE SITE NOT CONFORMING TO THESE BASIC RULES DUE TO EXISTING CONDITIONS OR DISCREPANCIES IN THE DOCUMENTS ARE TO BE REPORTED TO THE PROJECT ENGINEER PRIOR TO PROCEEDING WITH PLACEMENT OF ROCK BASE, FORMWORK FOR CURBS AND/OR FLATWORK.
2. CONTRACTOR SHALL DETERMINE EARTHWORK QUANTITIES BASED ON THE TOPOGRAPHIC SURVEY, THE GEOTECHNICAL INVESTIGATION AND THE PROPOSED SURFACE THICKNESS AND BASE THE BID ACCORDINGLY. IT IS THE CONTRACTORS RESPONSIBILITY TO CONFIRM IF A SEPARATE DEMOLITION CONTRACT HAS BEEN ISSUED TO TAKE THE SITE FROM THE WAY IT IS AT THE TIME OF THE BID TO THE CONDITIONS DESCRIBED IN THESE DOCUMENTS. ANY DIFFERENCES BETWEEN THE STATE IN WHICH THE SITE IS DELIVERED TO THE CONTRACTOR AND THESE DOCUMENTS SHOULD BE NOTED TO THE ENGINEER/ARCHITECT.
3. ALL FILL SHALL BE COMPACTED PER THE GEOTECHNICAL REPORT AND THE CONTRACTOR SHALL COORDINATE AND COMPLY WITH THE DISTRICT'S TESTING AGENCY TO TAKE THE APPROPRIATE TESTS TO VERIFY COMPACTION VALUES.
4. IMPORT SOILS SHOULD MEET THE REQUIREMENTS OF THE SOILS REPORT AND SPECIFICATIONS.
5. DO NOT ADJUST GRADES ON THIS PLAN WITHOUT PRIOR WRITTEN APPROVAL OF THE ENGINEER/ARCHITECT.
6. SITE STRIPPINGS THAT CONTAIN ONLY ORGANIC MATERIAL (NO DERRIS TRASH, BROKEN CONG OR ROCKS GREATER THAN 1" IN DIAMETER) MAY BE USED IN LANDSCAPE AREAS. EXCESS STRIPPINGS SHALL BE REMOVED FROM SITE.
7. TOP OF CONCRETE CURBS ARE 0.50' ABOVE TOP OF PAVING ELEVATIONS, UNLESS NOTED OTHERWISE.
8. ROUGH GRADING TO BE WITHIN 0.1' AND FINISH GRADES ARE TO BE WITHIN 0.05', HOWEVER CONTRACTOR SHALL NOT CONSTRUCT ANY IMPROVEMENTS THAT WILL CAUSE WATER TO POND OR NOT MEET REQUIREMENTS IN GRADING NOTE #1.
9. THE CONTRACTOR SHALL EXERCISE EXTREME CARE TO CONFORM TO THE LINES, GRADES, SECTIONS, AND DIMENSIONS AS SET FORTH ON THESE PLANS. ALL GRADED AREAS SHALL CONFORM TO THE VERTICAL ELEVATIONS SHOWN WITH A TOLERANCE OF ONE-TENTH OF A FOOT, WHERE GRADED AREAS DO NOT CONFORM TO THESE TOLERANCES, THE CONTRACTORS SHALL BE REQUIRED TO DO CORRECTIVE GRADING, AT NO EXTRA COST TO THE CITY.
10. IT SHALL BE THE CONTRACTOR'S RESPONSIBILITY TO CONFIRM THE GROUND ELEVATIONS AND OVERALL TOPOGRAPHY OF THE SITE PRIOR TO THE START OF CONSTRUCTION AS TO THE ACCURACY BETWEEN THE WORK SET FORTH ON THESE PLANS AND THE WORK IN THE FIELD. ANY DISCREPANCIES SHALL BE IMMEDIATELY BROUGHT TO THE ATTENTION OF THE CONSTRUCTION MANAGER AND CIVIL ENGINEER IN WRITING PRIOR TO START OF CONSTRUCTION WHICH MAY REQUIRE CHANGES IN DESIGN AND/OR AFFECT THE EARTHWORK QUANTITIES.
11. TRENCHES SHALL NOT BE LEFT OPEN OVERNIGHT IN EXISTING PUBLIC STREET AREAS. CONTRACTOR SHALL BACKFILL TRENCHES, OR PLACE STEEL PLATING WITH ADEQUATE CUTBACK AND ADEQUATE SHORING TO PREVENT SHIFTING OF STEEL PLATE AND/OR HOT-MIX ASPHALT REQUIRED TO PROTECT OPEN TRENCHES AT THE END OF THE WORKING DAY.

Contractor shall call Engineering at 650.947.2780 to schedule underground drainage and sanitary sewer property line cleanout inspections prior to backfilling

CITY OF LOS ALTOS
JOB COPY
REVIEWED FOR CODE COMPLIANCE

STORM DRAIN NOTES:

1. PRIVATE STORM DRAIN LINES SHALL BE INSTALLED WITH THE FOLLOWING MINIMUM REQUIREMENTS:

PIPE DIAMETER (IN)	PIPE MATERIAL	PIPE COVER (FT)	SLURRY ENCASEMENT REQUIRED?
4 TO 10	PVC SDR 26	1.00 TO 2.99	YES - TRAFFIC AREAS ONLY
4 TO 10	PVC SDR 26	3.00+	NO

2. 4 INCH TO 10 INCH DIAMETER STORM DRAIN PIPE SHALL BE POLYVINYL CHLORIDE (PVC) SDR 26 WHITE PIPE AND SHALL CONFORM TO THE REQUIREMENTS OF ASTM DESIGNATION D3034-73 WITH GLUED JOINTS. ALL DIRECTION CHANGES SHALL BE MADE WITH WYE CONNECTIONS, 22.5° ELBOWS, 45° ELBOWS, OR LONG SWEEP ELBOWS. 90° ELBOWS AND TEES ARE PROHIBITED.
3. 12 INCH AND LARGER DIAMETER STORM DRAIN PIPE SHALL BE HIGH DENSITY POLYETHYLENE (HDPE) PIPE AND SHALL CONFORM TO THE REQUIREMENTS OF AASHTO M252, TYPE S; AASHTO M294, TYPE S (CORRUGATED EXTERIOR, SMOOTH INTERIOR); AND AASHTO MP7 WITH GASKETED BELL AND SPIGOT JOINTS.
4. WHERE STORM DRAIN PIPES ARE INSTALLED IN TRAFFIC RATED AREAS WITH LESS THAN 3.00 FEET OF COVER, PIPE TRENCH AND COVER SHALL BE ENCASED IN A MINIMUM 12 INCH WIDE SLURRY CEMENT BACKFILL, EXTENDING THE FIRST 12 INCHES OF COVER ABOVE THE PIPE.
5. STORM DRAIN LINES WITH LESS THAN 12" OF COVER IN TRAFFIC AREAS SHALL BE CAPPED WITH STEEL REINFORCED CONCRETE. SEE CONCRETE CAP DETAIL ON C6.2.
6. USE DETECTABLE METALIZED WARNING TAPE APPROXIMATELY 6" BELOW THE SURFACE. TAPE SHALL BE A BRIGHT COLOR AND IMPRINTED WITH "CAUTION-STORM DRAIN LINE BELOW", CALICO TYPE 2 OR EQUAL.
7. CONTRACTOR SHALL ORDER AND PURCHASE ROUND ALUMINUM MEDALLION (WITH GREY SPECIFIC LABEL), AND INSTALL AT THE TOP OF CURBS ADJACENT TO EACH CATCH BASIN. CONTRACTOR SHALL OBTAIN THE SHOP DRAWING FOR THE ALUMINUM MEDALLIONS WITH THE SPECIFIC WORDING FROM THE CITY.
8. ALL AREA DRAINS AND CATCH BASINS WITHIN PEDESTRIAN ACCESSIBLE AREAS SHALL MEET ADA REQUIREMENTS.
9. ALL TRENCHES SHALL BE BACK FILLED PER THE SPECIFICATIONS WITH APPROPRIATE TESTS BY THE GEOTECHNICAL ENGINEER TO VERIFY COMPACTION VALUES.
10. FOR GRAVITY FLOW SYSTEMS CONTRACTOR SHALL VERIFY (POTHOLE IF NECESSARY) SIZE, MATERIAL, LOCATION AND DEPTH OF ALL SYSTEMS THAT ARE TO BE CONNECTED TO OR CROSSED PRIOR TO THE TRENCHING OR INSTALLATION OF ANY GRAVITY FLOW SYSTEM.
11. COMPLETE SYSTEMS: ALL UTILITY SYSTEMS ARE DELINEATED IN A SCHEMATIC MANNER ON THESE PLANS. CONTRACTOR IS TO PROVIDE ALL FITTINGS, ACCESSORIES, AND WORK NECESSARY TO COMPLETE THE UTILITY SYSTEM SO THAT IT IS FULLY FUNCTIONING FOR THE PURPOSE INTENDED.
12. ALL DOWNSPOUTS TO BE HARD PIPED AND ROUTED TO BORETRENCH PLANTERS UNLESS OTHERWISE NOTED ON PLANS. SEE ARCHITECTURE PLANS FOR EXACT LOCATION OF THE DOWNSPOUTS.

TEMPORARY FACILITIES NOTES:

1. THE CONTRACTOR IS RESPONSIBLE FOR MAINTAINING OPERATION AND FUNCTION OF EXISTING FACILITIES IMPACTED BY CONSTRUCTION, INCLUDING BUT NOT LIMITED TO EXISTING UTILITIES SERVING ADJACENT STRUCTURES AND AMENITIES WHICH RUN THROUGH THE CONSTRUCTION SITE. EXISTING ACCESS TO THOSE FACILITIES, AND RELATED STRUCTURES: APPLICABLE UTILITIES INCLUDE STORM DRAINAGE, SANITARY SEWER, DOMESTIC/FIRE WATER SUPPLY, IRRIGATION, NATURAL GAS, ELECTRICAL AND COMMUNICATION LINES.
2. CONTRACTOR SHALL PLAN PHASING AND METHOD OF DISCONNECTION/RECONNECTION OF SITE UTILITIES TO MINIMIZE DOWNTIME WHERE SHUTDOWN IS NECESSARY, AND PROVIDE THE CITY WITH SCHEDULE FOR ANY PLANNED SHUTDOWN/DISCONNECTION AND RECONNECTION OF SERVICES.
3. CONTRACTOR SHALL PROVIDE ALTERNATE MEANS AND METHODS FOR TEMPORARILY MAINTAINING FUNCTIONALITY / OPERATION OF EXISTING FACILITIES TO REMAIN (SUCH AS TEMPORARY USE OF PORTABLE PUMPS, POWER EQUIPMENT, TEMPORARY ALTERNATE SUPPLY/CONVEYANCE PIPES/CONDUITS, APPROPRIATE SIGNAGE) FOR THE CITY TO REVIEW AND APPROVE PRIOR TO COMMENCING CONSTRUCTION.
4. CONTRACTOR SHALL TO RESTORE PERMANENT SERVING TO EXISTING FACILITIES IMPACTED BY CONSTRUCTION TO THE SATISFACTION OF THE CITY.

CRITICAL UTILITY CROSSING NOTES:

1. PRIOR TO CONSTRUCTION CONTRACTOR SHALL POTHOLE AND VERIFY LOCATION AND DEPTH OF EXISTING UTILITIES.
2. CONTRACTOR TO USE CAUTION AROUND EXISTING UTILITIES AND MAINTAIN MINIMUM SEPARATION PER PG&E AND CITY OF LOS ALTOS REQUIREMENTS.

JOINT TRENCH NOTES

1. JOINT TRENCH AND BOXES ARE SHOWN SCHEMATICALLY AND FOR COORDINATION PURPOSES ONLY. SEE PLANS BY M.E.P. CONSULTANT FOR DESIGN AND DETAIL INFORMATION.

EARTHWORK QUANTITIES:



CUT	100
FILL	0
BALANCE	100 (EXPORT)

EARTHWORK QUANTITIES SHOWN ARE FOR PLANNING PURPOSES ONLY. THEY INCLUDE CONSIDERATION OF EXISTING AND PROPOSED PAVEMENT SECTIONS AND OVER-EXCAVATION FOR PROPOSED STRUCTURES/FOUNDATIONS. ESTIMATE DOES NOT INCLUDE SWELL, SHRINKAGE FACTORS OR SPILLS FOR UNDERGROUND UTILITIES.

CONTRACTOR SHALL PERFORM THEIR OWN EARTHWORK QUANTITY CALCULATION, AND USE THEIR CALCULATION FOR BIDDING AND COST ESTIMATING PURPOSES. NOT ALL FILL MAY BE SUITABLE FOR RE-USE.

LEGEND:

- STORM DRAIN LINE
- JOINT TRENCH SEE SHEET E1-2 (OPEN TRENCH)
- ELECTRICAL CONDUIT SEE SHEET E1-1 (INSTALLED VIA TRENCHLESS METHOD)
- 6" CONCRETE W/ #4 BARS 18" O.C. - EACH WAY OVER 6" OF CALTRANS CLASS 2 AGGREGATE BASE COMPACTED TO 95% R.C. PROVIDE THICKENED EDGE ON ALL CONCRETE PAVING ADJACENT TO LANDSCAPE AREAS, EXTENDING TO BOTTOM OF BASE/ROCK SECTION. SEE PLANS FOR SCORE JOINTS.
- 3" AC PAVING OVER 9" OF CALTRANS CLASS 2 AGGREGATE BASE COMPACTED TO 95% R.C.
- TYPE II IN ACCORDANCE WITH SECTION 37-3 OF THE CALTRANS STANDARD SPECIFICATIONS.
- SHREDDED MULCH 4" NOMINAL THICKNESS.
- REPLACE EXISTING PLANTING, TREES, IRRIGATION, AND MULCH IN KIND

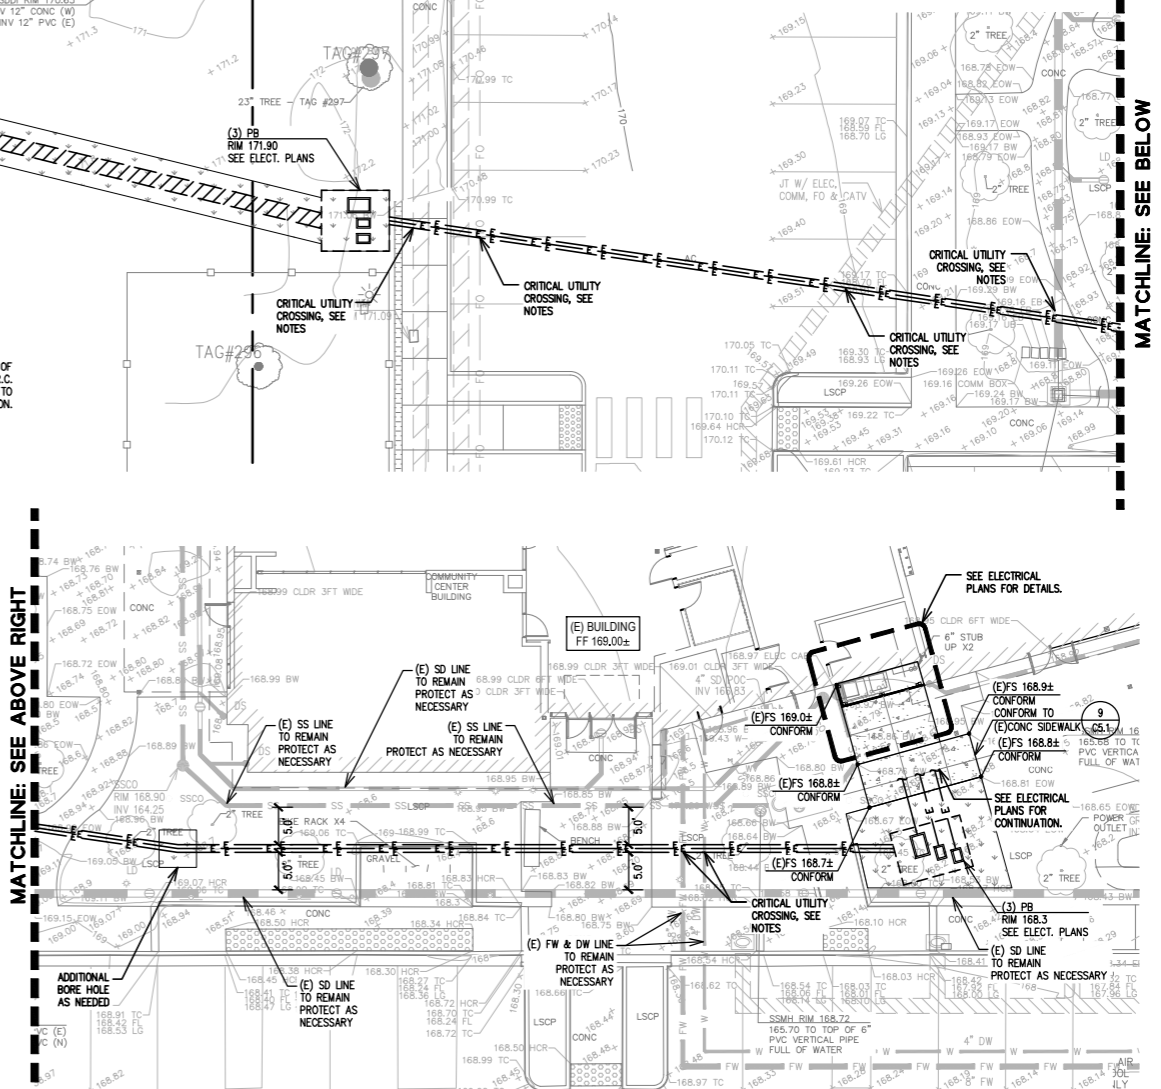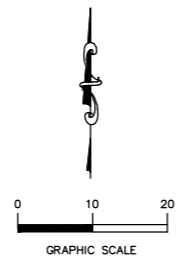

APPROVALS

NOLL & TAM ARCHITECTS
729 Heinz Avenue
Berkeley, CA 94710
tel 510.542.2200
fax 510.542.2201

BKF100+ YEARS
ENGINEERS · SURVEYORS · PLANNERS

SEAL

CITY OF LOS ALTOS - CALIFORNIA
REGISTERED PROFESSIONAL ENGINEER
EXPIRES DECEMBER 31, 2024
C 78436
CIVIL
STATE OF CALIFORNIA

PROJECT TITLE
City of Los Altos EMERGENCY OPERATION CENTER
97 Hillview Ave. Los Altos, CA 94022

ISSUE TITLE
PERMIT SET

ISSUE DATE
AUG 03, 2023

NOLL & TAM JOB NUMBER
22203


REVISIONS

DATE	DESCRIPTION
11/15/2023	PERMIT PLAN CHECK RESPONSE
12/18/2023	PLAN CHECK RESPONSE

SHEET TITLE
GRADING AND UTILITY PLAN

SHEET NUMBER
C3.1




DRAWING NAME: K:\2017\170208_Hillview_Community_Center_Redev\ENR\con sheets\acc_30x42.dwg
PLOT DATE: 12-13-23
PLOTTED BY: memo

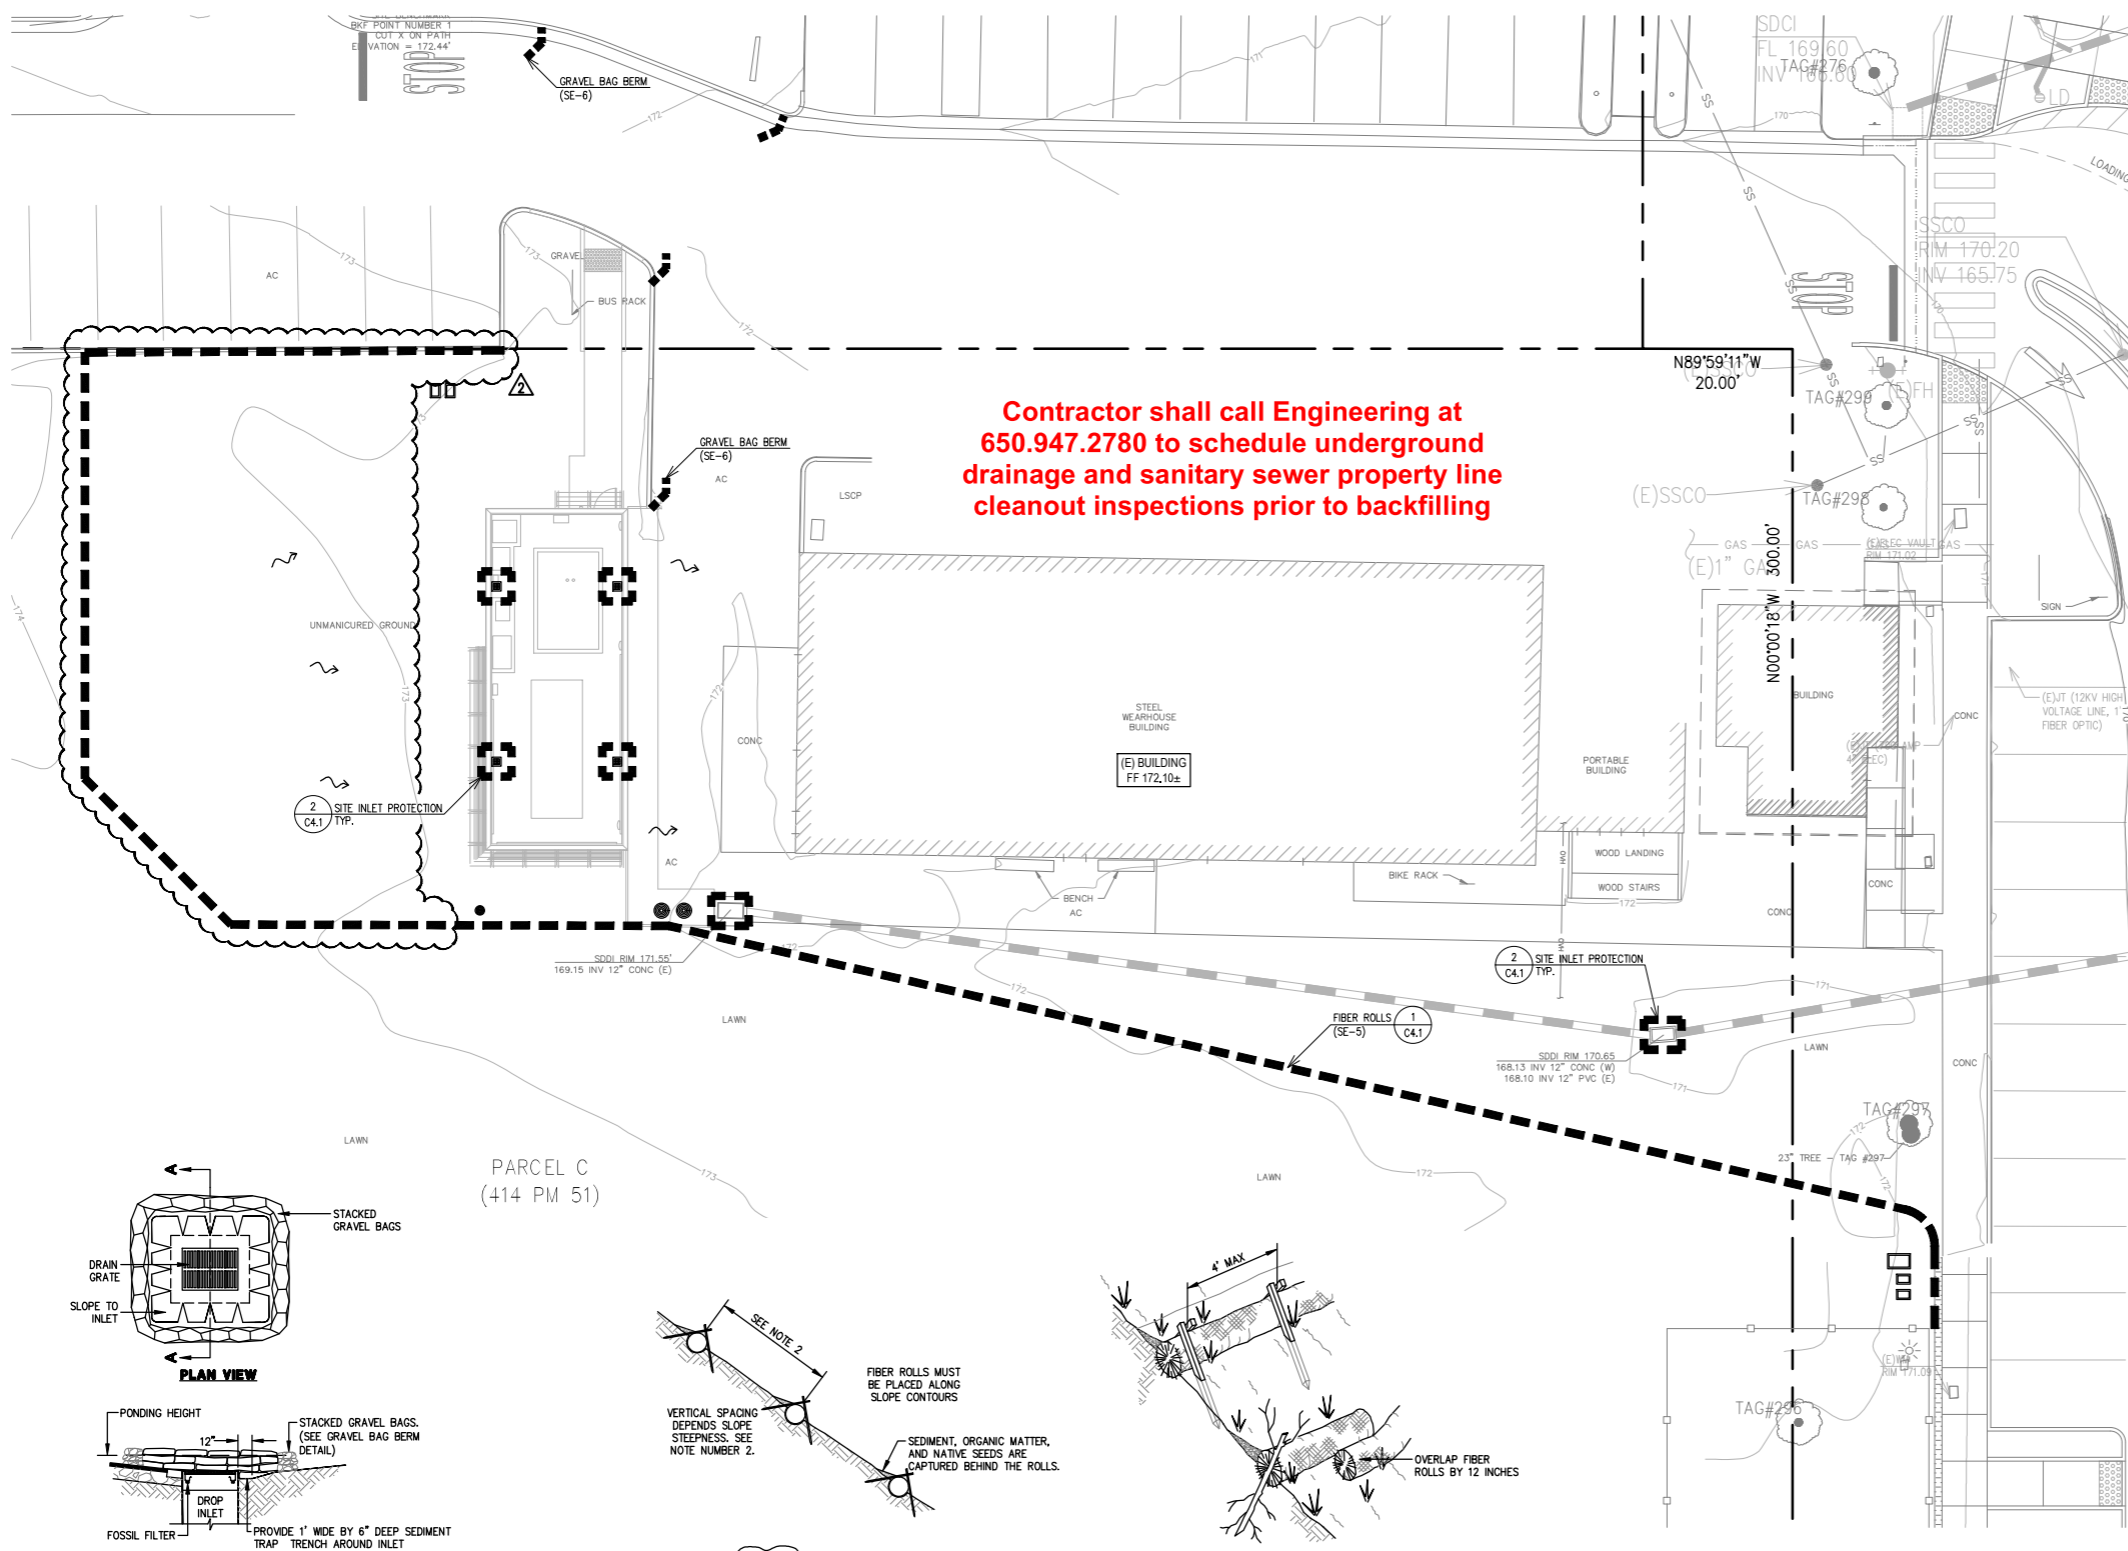

- EROSION CONTROL NOTES:**
- IN ADDITION TO WORK SHOWN, EROSION CONTROL ON-SITE SHALL BE MODIFIED AND EXPANDED UPON AS NEEDED TO COMPLY WITH THE CONSTRUCTION GENERAL PERMIT IN ACCORDANCE WITH THE PROJECT SWPPP, AND AS DIRECTED BY THE PROJECT QUALIFIED SWPPP PRACTITIONER (OSP).
 - IT IS THE CONTRACTOR'S RESPONSIBILITY TO PREPARE A TEMPORARY FENCING PLAN AND OBTAIN APPROVAL FROM THE OWNER.





- EROSION CONTROL LEGEND:**
- CASQA BMP IDENTIFICATION NUMBERS
 - NS NON-STORMWATER MANAGEMENT CONTROL BMPS
 - SE SEDIMENT CONTROL BMPS
 - TC TREATMENT CONTROL BMPS

CITY OF LOS ALTOS
JOB COPY
 REVIEWED FOR CODE COMPLIANCE

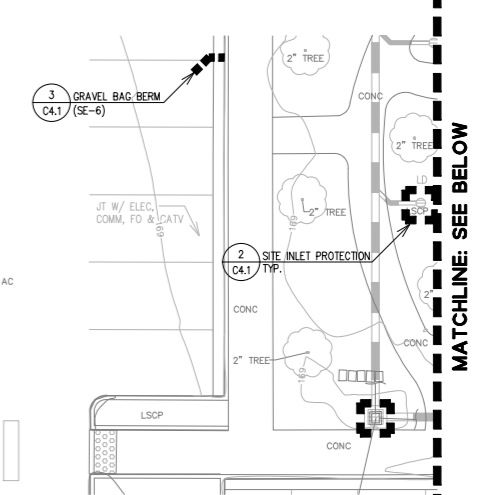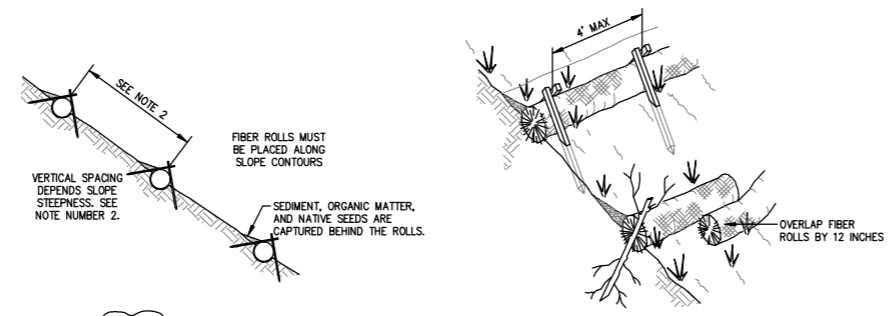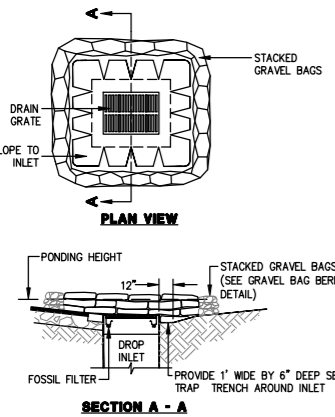

- NOTES:**
- SANDBAGS OF EITHER BURLAP OR WOVEN GEOTEXTILE FABRIC, ARE FILLED WITH GRAVEL, LAYERED AND PACKED TIGHTLY.
 - INSPECT BARRIERS AND REMOVE SEDIMENT AFTER EACH STORM EVENT. SEDIMENT AND GRAVEL MUST BE REMOVED FROM THE TRAVELED WAY IMMEDIATELY.
 - THE TOP OF THE STRUCTURE (PONDING HEIGHT) MUST BE WELL BELOW THE GROUND ELEVATION DOWNSLOPE TO PREVENT RUNOFF FROM BY-PASSING THE INLET. EXCAVATION OF A BASIN ADJACENT TO THE DROP INLET OR A TEMPORARY DIKE ON THE DOWNSLOPE OF THE STRUCTURE MAY BE NECESSARY.
 - FOSSIL FILTERS SHALL BE INCORPORATED IN ALL CATCH BASINS AND FIELD INLETS 24" AND LARGER AND SHALL BE INSTALLED PER MANUFACTURER SPECIFICATIONS. FOSSIL FILTERS TO BE SILT SACK OR APPROVED EQUIVALENT.

- NOTES:**
- FIBER ROLL INSTALLATION REQUIRES THE PLACEMENT AND SECURE STAKING OF THE ROLL IN A TRENCH, 3" TO 4" DEEP, DUG ON CONTOUR. RUNOFF MUST NOT BE ALLOWED TO RUN UNDER OR AROUND ROLL.
 - VERTICAL SPACING FOR SLOPE INSTALLATIONS:
 SLOPE OF 2:1 OR GREATER = 10 FEET APART
 SLOPE OF 4:1 OR FLATTER = 20 FEET APART
 - INSPECT AND REPAIR FIBER ROLLS AFTER EACH STORM EVENT AND REMOVE SEDIMENT WHEN NECESSARY.
 - REMOVED SEDIMENT SHALL BE DEPOSITED TO AN AREA THAT WILL NOT CONTRIBUTE SEDIMENT OFF-SITE, AND CAN BE PERMANENTLY STABILIZED.

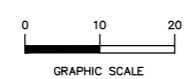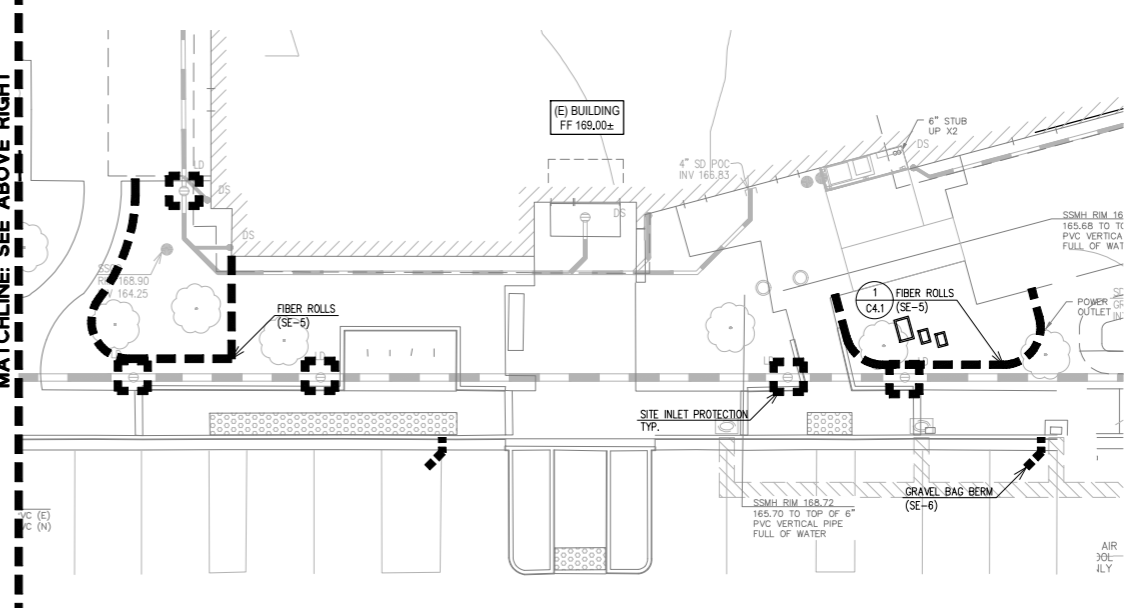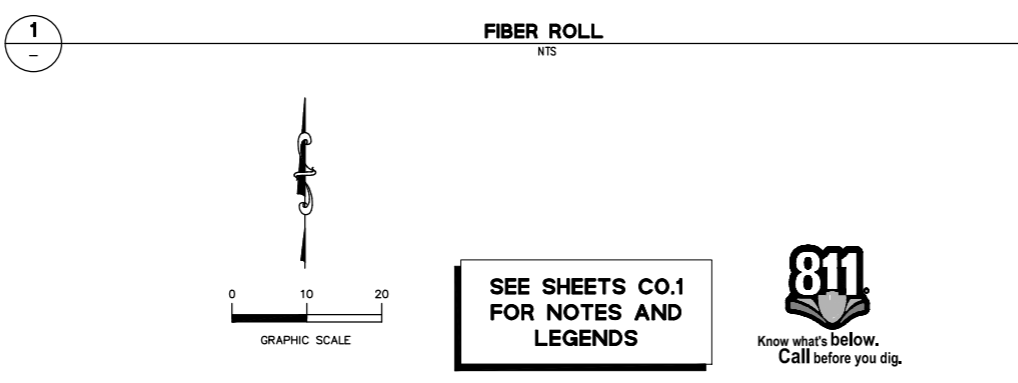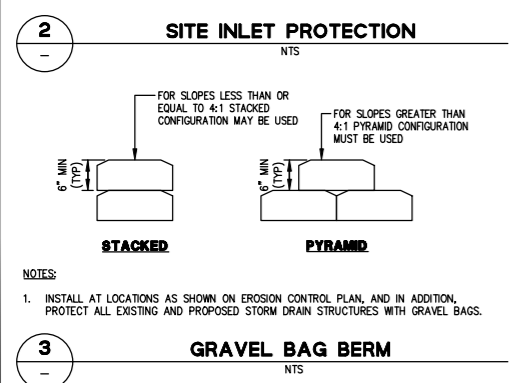

SEE SHEETS CO.1
 FOR NOTES AND
 LEGENDS



APPROVALS

NOLL & TAM ARCHITECTS
 729 Heinz Avenue
 Berkeley, CA 94710
 tel 510.542.2200
 fax 510.542.2201

BKF100+ YEARS
 ENGINEERS · SURVEYORS · PLANNERS

SEAL: [Professional Engineer Seal]

PROJECT TITLE: **City of Los Altos EMERGENCY OPERATION CENTER**
 97 Hillview Ave. Los Altos, CA 94022

ISSUE TITLE: **PERMIT SET**

ISSUE DATE: AUG 03, 2023
 NOLL & TAM JOB NUMBER: 22203

REVISIONS	DATE	DESCRIPTION
1	11/15/2023	PERMIT PLAN CHECK RESPONSE
2	12/18/2023	PLAN CHECK RESPONSE

SHEET TITLE: **EROSION CONTROL PLAN**

SHEET NUMBER: **C4.1**

DRAWING NAME: K:\2017\170208_Hillview_Community_Center_Reedy\ENR\locsheet_s_000_30x42.dwg
 PLOT DATE: 12-13-23 PLOTTED BY: memo

NOLL & TAM ARCHITECTS

729 Heinz Avenue
Berkeley, CA 94710
tel 510.542.2200
fax 510.542.2201



SEAL



PROJECT TITLE

City of Los Altos EMERGENCY OPERATION CENTER

97 Hillview Ave. Los Altos, CA
94022

ISSUE TITLE
PERMIT SET

ISSUE DATE	AUG 03, 2023
NOLL & TAM JOB NUMBER	22203
REVISIONS	
DATE	DESCRIPTION
1	11/15/2023 PERMIT PLAN CHECK RESPONSE
2	12/18/2023 PLAN CHECK RESPONSE

SHEET TITLE
BEST MANAGEMENT PRACTICES

SHEET NUMBER

C4.2

Preventing Pollution: It's Up to Us

In the Santa Clara Valley, storm drains transport water directly to local creeks and San Francisco Bay without treatment. Storm water pollution is a serious problem for wildlife dependent on our waterways and for the people who live near polluted streams or bay lands. Some common sources of this pollution include spilled oil, fuel, and fluids from vehicles and heavy equipment; construction debris; sediment created by erosion; landscaping runoff containing pesticides or weed killers; and materials such as used motor oil, antifreeze, and paint products that people pour or spill into a street or storm drain. Thirteen valley municipalities have joined together with Santa Clara County and the Santa Clara Valley Water District to educate local residents and businesses and fight storm water pollution. To comply with this program, contractors must comply with the practices described in this drawing sheet.


Spill Response Agencies

DIAL 9-1-1
State Office of Emergency Services Warning Center (24 hours) 800-852-7550
Santa Clara County Environmental Health Services (408) 299-6930

Local Pollution Control Agencies

County of Santa Clara Pollution Prevention Program: (408) 441-1195
County of Santa Clara Integrated Waste Management Program: (408) 441-1198
County of Santa Clara District Attorney Environmental Crimes Hotline: (408) 299-TIPS
Santa Clara County Recycling Hotline: 1-800-533-8414
Santa Clara Valley Water District: (408) 265-2600
Santa Clara Valley Water District Pollution Hotline: 1-866-510-5151
Regional Water Quality Control Board San Francisco Bay Region: (510) 622-2300
Palo Alto Regional Water Quality Control Plant: (650) 329-2598
Serving East Palo Alto Sanitary District, Los Altos, Los Altos Hills, Mountain View, Palo Alto, Stanford
City of Los Altos
Building Department: (650) 947-2752
Engineering Department: (650) 947-2780

Fresh Concrete and Mortar Application

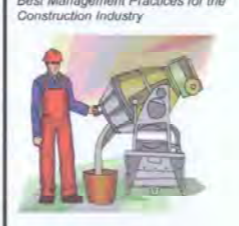

Best Management Practices for the

- Masons and bricklayers
- Sitewalk construction crews
- Pole construction workers
- Construction inspectors
- General contractors
- Home builders
- Developers
- Concrete delivery/pumping workers

Doing The Job Right

- General Business Practices**
- Wash out concrete mixers only in designated wash-out areas in your yard, away from storm drains and waterways, where the water will flow into a temporary waste pit or a dirt area. Let water percolate through soil and dispose of settled, hardened concrete as garbage. Whenever possible, recycle washout by pumping back into mixers for reuse.
 - Wash out clothes onto dirt areas at site that do not flow to streets or drains.
 - Always store both dry and wet materials under cover, protected from rainfall and runoff and away from storm drains or waterways. Protect dry materials from wind.
 - Secure bags of cement after they are open. Be sure to keep wind-blown cement powder away from streets, gutters, storm drains, rainfall, and runoff.
 - Do not use diesel fuel as a lubricant on concrete forms, tools, or trailers.
- Storm Drain Pollution from Fresh Concrete and Mortar Applications**
- Fresh concrete and cement-related materials that wash into local streams, or wet areas are toxic to fish and the aquatic environment. Disposing of these materials to the storm drains or creeks can block storm drains, create debris problems, and is prohibited by law.

Los Altos Municipal Code Requirements

- Los Altos Municipal Code Chapter 10.08.390 Non-storm water discharges**
- Unlawful discharges. It shall be unlawful to discharge any domestic waste or industrial waste into storm drains, gutters, creeks, or San Francisco Bay. Unlawful discharges to storm drains shall include, but not be limited to, discharge from toilets; sinks; industrial processes; cooling systems; boilers; fabric cleaning; equipment cleaning; vehicle cleaning; construction activities, including, but not limited to, painting, paving, concrete placement, saw cutting and grading, swimming pools, spas, and fountains, unless specifically permitted by a discharge permit or unless exempted pursuant to guidelines published by the superintendent.
 - Threatened discharge. It shall be unlawful to cause hazardous materials, domestic waste, or industrial waste to be deposited in such a manner or location as to constitute a threatened discharge into storm drains, gutters, creeks, or San Francisco Bay. A "threatened discharge" is a condition creating a substantial probability of harm, when the probability and potential extent of harm make it reasonably necessary to take immediate action to prevent, reduce or mitigate damages to persons, property or natural resources. Domestic or industrial wastes that are no longer contained in a pipe, tank or other container are considered to be threatened discharges unless they are actively being cleaned up.
- Los Altos Municipal Code Section 10.06.430 Requirements for construction operations.**
- A spill response plan for hazardous waste, hazardous materials and uncontained construction materials shall be prepared and available at the construction sites for all projects where the proposed construction site is equal to or greater than one acre of disturbed soil and for any other projects for which the city engineer determines it is necessary to protect surface waters. Preparation of the plan shall be in accordance with guidelines published by the city engineer.
 - A storm water pollution prevention plan shall be prepared and available at the construction sites for all projects greater than one acre of disturbed soil and for any other projects for which the city engineer determines that a storm water management plan is necessary to protect surface waters. Preparation of the plan shall be in accordance with guidelines published by the city engineer. Prior approval shall be obtained from the city engineer or designee to discharge water pumped from construction sites to the storm drain. The city engineer or designee may require gravity settling and filtration upon a determination that either or both would improve the water quality of the discharge. Contaminated groundwater or water that exceeds state or federal requirements for discharge to navigable waters may not be discharged to the storm drain. Such water may be discharged to the sewer, provided that the requirements of Section 10.09.240 are met and the approval of the superintendent is obtained prior to discharge. No cleanup of construction debris from the streets shall result in the discharge of water to the storm drain system, nor shall any construction debris be deposited or allowed to be deposited in the storm drain system. (Prior code § 5-5.643)
- Criminal and judicial penalties can be assessed for non-compliance.

Roadwork and Paving



Best Management Practices for the

- Road crews
- Driveway/curb/parking lot construction crews
- Seal coat contractors
- Operators of grading equipment, paving machines, dump trucks, concrete mixers
- Construction inspectors
- General contractors
- Home builders
- Developers

Painting and Application of Solvents and Adhesives



Best Management Practices for the

- Homeowners
- Painters
- Painters/contractors
- Plumbers
- Graphic artists
- Dry wall crews
- Floor covering installers
- General contractors
- Home builders
- Developers

Heavy Equipment Operation



Best Management Practices for the

- Vehicle and equipment operators
- Site supervisors
- General contractors
- Home builders
- Developers

Landscaping, Gardening, and Pool Maintenance



Best Management Practices for the

- Landscapers
- Gardeners
- Swimming pool/spa service and repair workers
- General contractors
- Home builders
- Developers
- Homeowners

Doing The Job Right

- General Business Practices**
- Prevent excavations and landscaping materials from wind and rain by storing them under tarps or secured plastic sheeting.
 - Store pesticides, fertilizers, and other chemicals indoors or in a shed or storage cabinet.
 - Schedule grading and excavation projects during dry weather.
 - Use temporary check dams or silt fences to divert runoff away from storm drains.
 - Protect storm drains with sandbags or other sediment controls.
 - Re-vegetation is an excellent form of erosion control for any site.
- Storm water Pollution from Heavy Equipment on Construction Sites**
- Poorly maintained vehicles and heavy equipment that leak fuel, oil, antifreeze or other fluids on the construction site are common sources of storm drain pollution. Prevent spills and leaks by adding equipment from runoff drains, and by washing for leaks and other maintenance problems. Remove construction equipment from the site as soon as possible.

Doing The Job Right

- General Business Practices**
- Prevent excavations and landscaping materials from wind and rain by storing them under tarps or secured plastic sheeting.
 - Store pesticides, fertilizers, and other chemicals indoors or in a shed or storage cabinet.
 - Schedule grading and excavation projects during dry weather.
 - Use temporary check dams or silt fences to divert runoff away from storm drains.
 - Protect storm drains with sandbags or other sediment controls.
 - Re-vegetation is an excellent form of erosion control for any site.
- Landscaping/Garden Maintenance**
- Use pesticides sparingly, according to instructions on the label. Rinse empty containers and use them to dispose of hazardous waste.
 - Collect lawn and garden clippings, pruning waste, and tree trimmings. Chop if necessary, and compost.
 - Do not blow or rake leaves, etc. into the street, or place yard waste in gutters or on dirt shoulders, unless you are piling them for recycling (allowed by San Jose and unincorporated County only). Sweep up any leaves, pine or oak needles, or other debris in San Jose, leave yard waste for curbside recycling programs, or place them in a bag or other container to take to a recycling center.
- Pool/Spa Maintenance**
- Draining Pools or Spas**
- When it is time to drain a pool, spa, or fountain, please be sure to call your local wastewater treatment plant before you start for further guidance on low rate restrictions, backflow prevention, and handling special cleaning waste (such as acid waste). Discharge flows shall not exceed 100 gallon per minute.
- Never discharge pool or spa water to a street or storm drain; discharge to a sanitary sewer allowed.
 - If possible, when emptying a pool or spa let chlorine dissipate for a few days and then recirculate water by draining it gradually into a landscaped area.
 - Do not use copper-based algaecides. Control algae with chlorine or other alternatives, such as sodium bromide.
- Filter cleaning**
- Never clean a filter in the street or near a storm drain. Remove cartridge and discharge wash filter into a dirt area, and spade filter residue into soil. Dispose of spent disinfectant waste in the garbage.
 - If there is no available dirt area, call your local wastewater treatment plant for instructions on discharging filter backwash or rinse water to the sanitary sewer.

Doing The Job Right

- General Business Practices**
- Develop and implement environmental protection plans for roadway construction.
 - Schedule excavation and grading work during dry weather.
 - Check for and repair leaking equipment.
 - Perform major equipment repairs at designated areas in your maintenance yard where cleanup is easier. Avoid performing equipment repairs at construction sites.
 - When refueling or when vehicle/equipment maintenance must be done on site, designate a location away from storm drains and creeks.
 - Do not use diesel oil to lubricate equipment parts or clean equipment.
 - Recycle used oil, concrete, broken asphalt, etc. whenever possible, or dispose of properly.
- During Construction**
- Avoid paving and seal coating in wet weather, or when rain is forecast, to prevent fresh materials from contacting stormwater runoff.
 - Cover and seal catch basins and manholes when applying seal coat, slurry seal, fog seal, or similar materials.
 - Protect drainage ways by using earth dikes, sand bags, or other controls to divert or trap and filter runoff.
- Storm Drain Pollution from Roadwork**
- Road paving, surfacing, and pavement removal happen right in the street, where there are numerous opportunities for spillage. Seal-coat slurry or excavated material to illegally enter storm drains. Extra cleanup is required to store and dispose of materials properly and guard against pollution of storm drains, creeks, and the Bay.

Doing The Job Right

- Handling Paint Products**
- Keep all liquid paint products and waste away from the gutter, street, and storm drains. Liquid residues from paints, thinners, solvents, glues, and cleaning fluids are hazardous wastes and must be disposed of at hazardous waste collection facility (check your local stormwater program listed on the back of this brochure).
 - When thoroughly dry empty paint cans, used brushes, rags, and drop cloths may be disposed of as garbage in a sanitary landfill. Empty, dry paint cans also may be recycled as metal.
 - Wash water from painted buildings constructed before 1978 can contain high amounts of lead. Even if paint chips are not present, before you begin stripping paint or cleaning pre-1978 building exterior with water under high pressure, test paint for lead by taking paint scrapings to a local laboratory. See Yellow Pages for a state-certified laboratory.
 - If there is loose paint on the building, or the paint tests positive for lead, block storm drains with sandbags or other controls to determine whether you may discharge water to the sanitary sewer. If you must send it off-site for disposal as hazardous waste.
- Paint Removal**
- Paint chips and dust from non-hazardous dry stripping and sand blasting may be swept up or collected in plastic drop cloths and disposed of as trash.
 - Chemical paint stripping residues and chips and dust from marine paints or paints containing lead, mercury or tributyltin must be disposed of at hazardous waste. Lead based paint removal requires a state-certified contractor.
 - When stripping or cleaning building exteriors with high pressure water, block storm drains. Direct wash water into a dirt area and waste into soil. Or, check with the local wastewater treatment authority to find out if you can collect (trap or vacuum) building cleaning water and dispose to the sanitary sewer. Sampling of the water may be required to assist the wastewater treatment authority in making its decision.
- Recycle/Reuse Leftover Paints Whenever Possible**
- Recycle or donate excess water-based (latex) paint, or return to supplier.
 - Reuse leftover oil-based paint. Dispose of non-recyclable thinners, sludge and unrefined paint as hazardous waste.
 - Unopened cans of paint may be able to be returned to the paint vendor. Check with the vendor regarding its "buy-back" policy.
- Storm Drain Pollution from Paints, Solvents, and Adhesives**
- All paints, solvents, and adhesives contain chemicals that are harmful to wildlife and humans. San Francisco Bay, and the Pacific Ocean. Toxic chemicals may come from liquid or solid products such as paint, thinners, or rags. Paint material and wastes, adhesives and cleaning fluids should be recycled when possible, or disposed of properly to prevent them from flowing into storm drains and watercourses.

Doing The Job Right

- General Business Practices**
- Keep an orderly site and ensure good housekeeping practices are used.
 - Maintain equipment properly.
 - Cover materials when they are not in use.
 - Keep materials away from streets, storm drains and drainage channels.
 - Ensure dust control water doesn't leave site or discharge to storm drains.
 - Advance Planning To Prevent Pollution
 - Schedule excavation and grading activities for dry weather periods. To reduce soil erosion, plant temporary vegetation or place other erosion control before rain begins. Use the Erosion and Sediment Control Manual available from the Regional Water Quality Control Board, as a reference.
 - Control the amount of runoff crossing your site (especially during excavation) by using berms, silt fences, or sediment drainage ditches to divert water flow around the site. Reduce storm water runoff velocities by constructing temporary check dams where appropriate.
 - Train your employees and subcontractors. Make these best management practices available to everyone who works on the construction site. Inform subcontractors about the storm water requirements and their own responsibilities.
- Good Housekeeping Practices**
- Designate one area of the site for auto parking, vehicle refueling, and routine equipment maintenance. The designated area should be well away from streams or storm drain inlets. berms if necessary. Make major repairs off site.
 - Keep materials out of the rain - prevent runoff contamination at the source. Cover exposed piles of soil or construction materials with plastic sheeting or temporary rods. Before it rains, sweep and remove materials from surfaces that drain to storm drains, creeks, or channels.
 - Keep pollutants off exposed surfaces. Place tarps and recycling receptacles around the site to minimize litter.
- Permits**
- In addition to local building permits, you will need to obtain coverage under the State's General Construction Activity Storm Water Permit if your construction site may be contaminated with toxic (such as oil or solvents) or laden with sediments. Any of these pollutants can harm wildlife in creeks or the Bay. Effective erosion control practices reduce the amount of runoff creating a site and slow the flow with check dams or other erosion control practices.
 - Discharging sediment-laden water from a dewatering site into any water of the state without treatment is prohibited.

Earth-Moving And Dewatering Activities



Best Management Practices for the

- Bulldozers, back hoes, and grading machine operators
- Dump truck drivers
- Site supervisors
- General contractors
- Home builders
- Developers

Doing The Job Right

- General Business Practices**
- Schedule excavation and grading work during dry weather.
 - Perform major equipment repairs away from the job site.
 - When refueling or when vehicle/equipment maintenance must be done on site, designate a location away from storm drains.
 - Do not use diesel oil to lubricate equipment parts or clean equipment.
- Practices During Construction**
- Remove existing vegetation only when absolutely necessary. Plant temporary vegetation for erosion control on slopes or where construction is not immediately planned.
 - Protect down slope drainage courses, streams, and storm drains with earth, or temporary discharge weirs. Use check dams or ditches to divert runoff around excavations. Refer to the Regional Water Quality Control Board's Erosion and Sediment Control Field Manual for more information.
- Storm Drain Pollution from Earth-Moving Activities and Dewatering**
- Soil excavation and grading operations loosen large amounts of soil that can flow or blow into storm drains when handled improperly. Sediments can clog storm drains, smother aquatic life, and destroy habitats in creeks and the Bay. Effective erosion control practices reduce the amount of runoff creating a site and slow the flow with check dams or other erosion control practices.
- Contaminated groundwater is a common problem in the Santa Clara Valley. Depending on soil types and site history, groundwater pumped from construction sites may be contaminated with toxic (such as oil or solvents) or laden with sediments. Any of these pollutants can harm wildlife in creeks or the Bay, or interfere with wastewater treatment plant operation. Discharging sediment-laden water from a dewatering site into any water of the state without treatment is prohibited.

Blueprint for a Clean Bay


Remember: The property owner and the contractor share ultimate responsibility for the activities that occur on a construction site. You may be held responsible for any environmental damage caused by your subcontractors or employees.

Best Management Practices for the Construction Industry




Santa Clara Urban Runoff Pollution Prevention Program

DESIGNED BY: LARRY LIND	APPROVED BY: VICTOR CHOU CITY ENGINEER	CITY OF LOS ALTOS 48056 R.C.L.	DATE: OCTOBER, 2003
CHECKED BY: JIM GUSTAFSON	SHEET OP	OF SHEETS	DRAWING NO.:

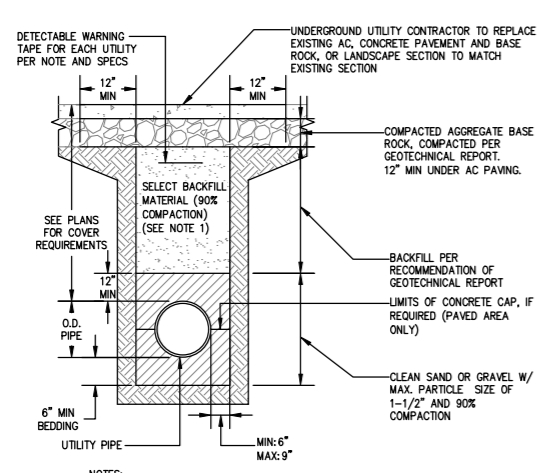


- NOTES:**
1. SELECT BACKFILL MATERIAL - MATERIAL FROM EXCAVATION, FREE FROM STONES OR LUMPS EXCEEDING 3" IN GREATEST DIMENSION, VEGETABLE MATTER, OR UNSATISFACTORY MATERIAL. (SEE SPECIFICATIONS)
 2. FOR NEW STREETS USE DESIGN STRUCTURAL SECTION AS SHOWN ON PLANS.
 3. IF THE EDGE OF THE TRENCH FALLS WITHIN 3' OF THE OUTER, THE ENTIRE PAVEMENT SHALL BE REMOVED.
 4. IF EXISTING PAVEMENT IS LESS THAN 3" THICK, PAVEMENT EDGE SHALL BE SAWCUT TO FULL DEPTH IN LIEU OF GRINDING.
 5. REFER TO ELECTRICAL PLANS FOR CONDUIT TRENCH BACKFILL.

1 PIPE BACKFILL ON-SITE
NTS

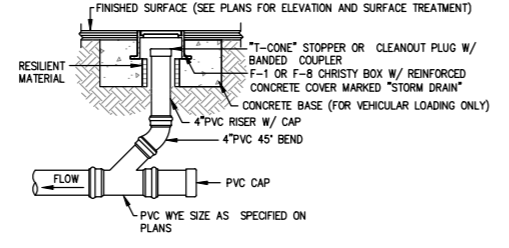


- NOTES:**
1. GULF FITTINGS MAY BE SUBSTITUTED FOR GASKETED FITTINGS AT THE OPTION OF THE INSTALLATION CONTRACTOR.

2 STORM DRAIN CLEANOUT
NTS

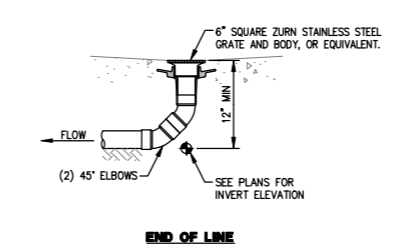

- NOTES:**
1. GULF FITTINGS MAY BE SUBSTITUTED FOR GASKETED FITTINGS AT THE OPTION OF THE INSTALLATION CONTRACTOR.
 2. FOR SHALLOW INVERTS (LESS THAN 12"), USE TYPE7127-90, W/ SIDE OUTLET.
 3. USE ADA COMPLIANT GRATE IN PEDESTRIAN ACCESSIBLE AREAS.


3 AREA DRAIN - SQUARE
NTS

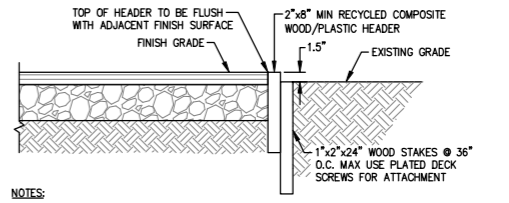


- NOTES:**
1. TOP OF HEADER SHALL MEET ALL PAVED SURFACES FLUSH.
 2. ALLOW FOR THERMAL EXPANSION BY LEAVING GAPS IN JOINTS OR AT THE END OF THE RUN.
 3. HEADERBOARD SHALL BE "TREX" COMPOSITE LUMBER OR APPROVED EQUAL.

4 WOOD HEADER BOARD
NTS


CITY OF LOS ALTOS
JOB COPY
REVIEWED FOR CODE COMPLIANCE

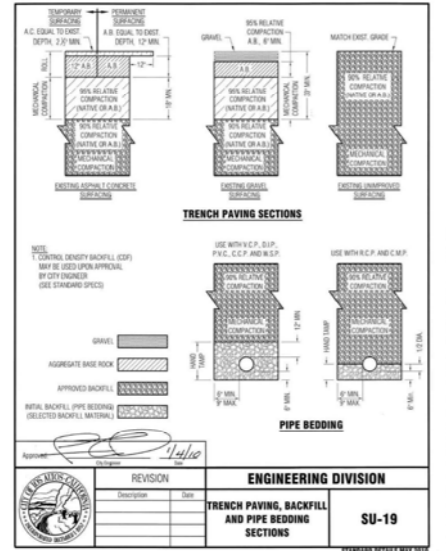


6 TRENCH PAVING, BACKFILL & BEDDING
NTS

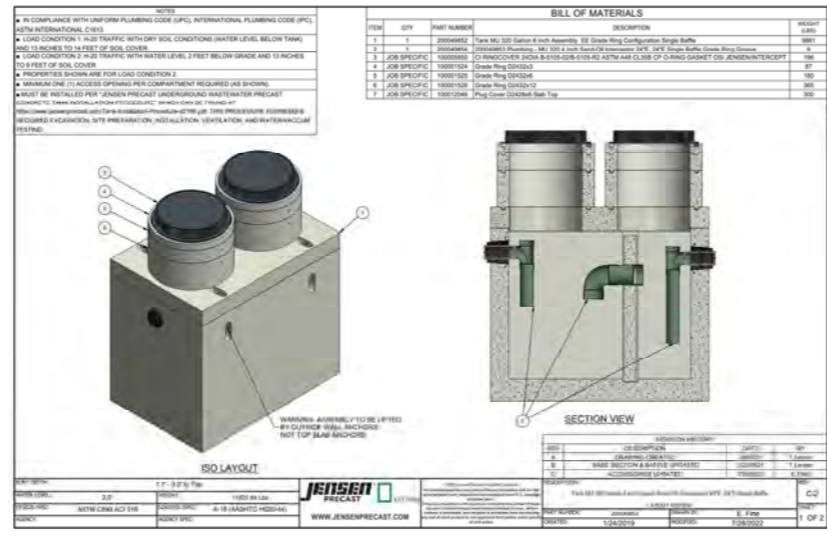


7 320 GALLON SAND-OIL INTERCEPTOR
NTS

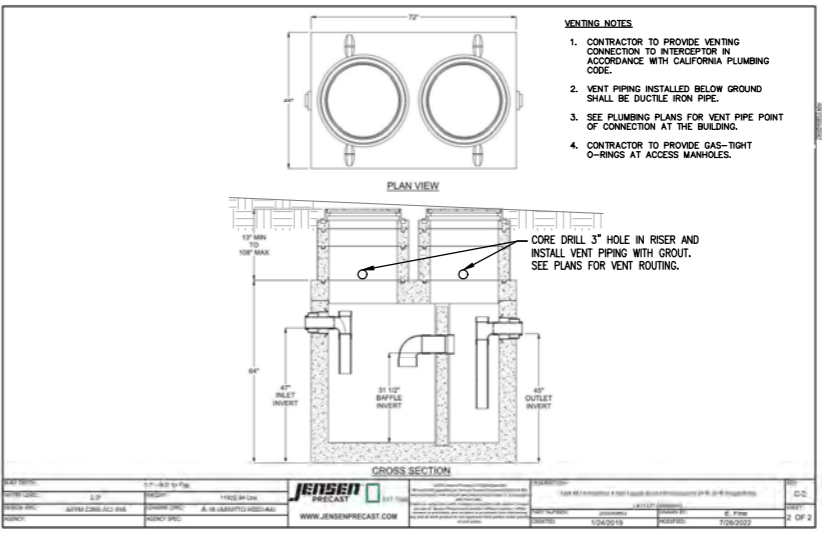

7 320 GALLON SAND-OIL INTERCEPTOR
NTS

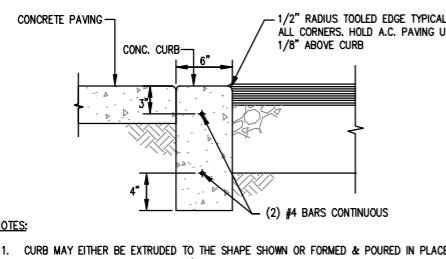

8 FLUSH CURB
NTS

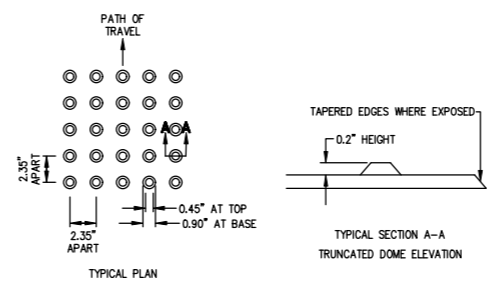

10 DETECTABLE WARNING SURFACE
NTS

APPROVALS

NOLL & TAM
ARCHITECTS

729 Heinz Avenue
Berkeley, CA 94710
tel 510.542.2200
fax 510.542.2201



BKF100+
ENGINEERS · SURVEYORS · PLANNERS

SEAL



PROJECT TITLE
**City of Los Altos
EMERGENCY OPERATION
CENTER**

97 Hillview Ave. Los Altos, CA
94022

ISSUE TITLE
PERMIT SET

ISSUE DATE
AUG 03, 2023

NOLL & TAM JOB NUMBER
22203

REVISIONS	DATE	DESCRIPTION
1	11/15/2023	PERMIT PLAN CHECK RESPONSE
2	12/18/2023	PLAN CHECK RESPONSE

SHEET TITLE
DETAIL SHEET

SHEET NUMBER
C5.1

DRAWING NAME: K:\2017\170208_Hillview_Community_Center_ReDev\ENR\locsheet_s_00_30x42.dwg
PLOT DATE: 12-13-23
PLOTTED BY: memo



SEAL



Date signed: 11/14/2023

PROJECT TITLE

City of Los Altos EMERGENCY OPERATION CENTER

97 Hillview Ave. Los Altos, CA 94022

ISSUE TITLE

PERMIT SET

ISSUE DATE AUG 03, 2023

NOLL & TAM JOB NUMBER 22203

REVISIONS

DATE	DESCRIPTION


SHEET TITLE

CIVIC CAMPUS PLAN EOC

REVIEWED FOR CODE COMPLIANCE
January 5, 2024
TRB AND ASSOCIATES

SHEET NUMBER


A1-0

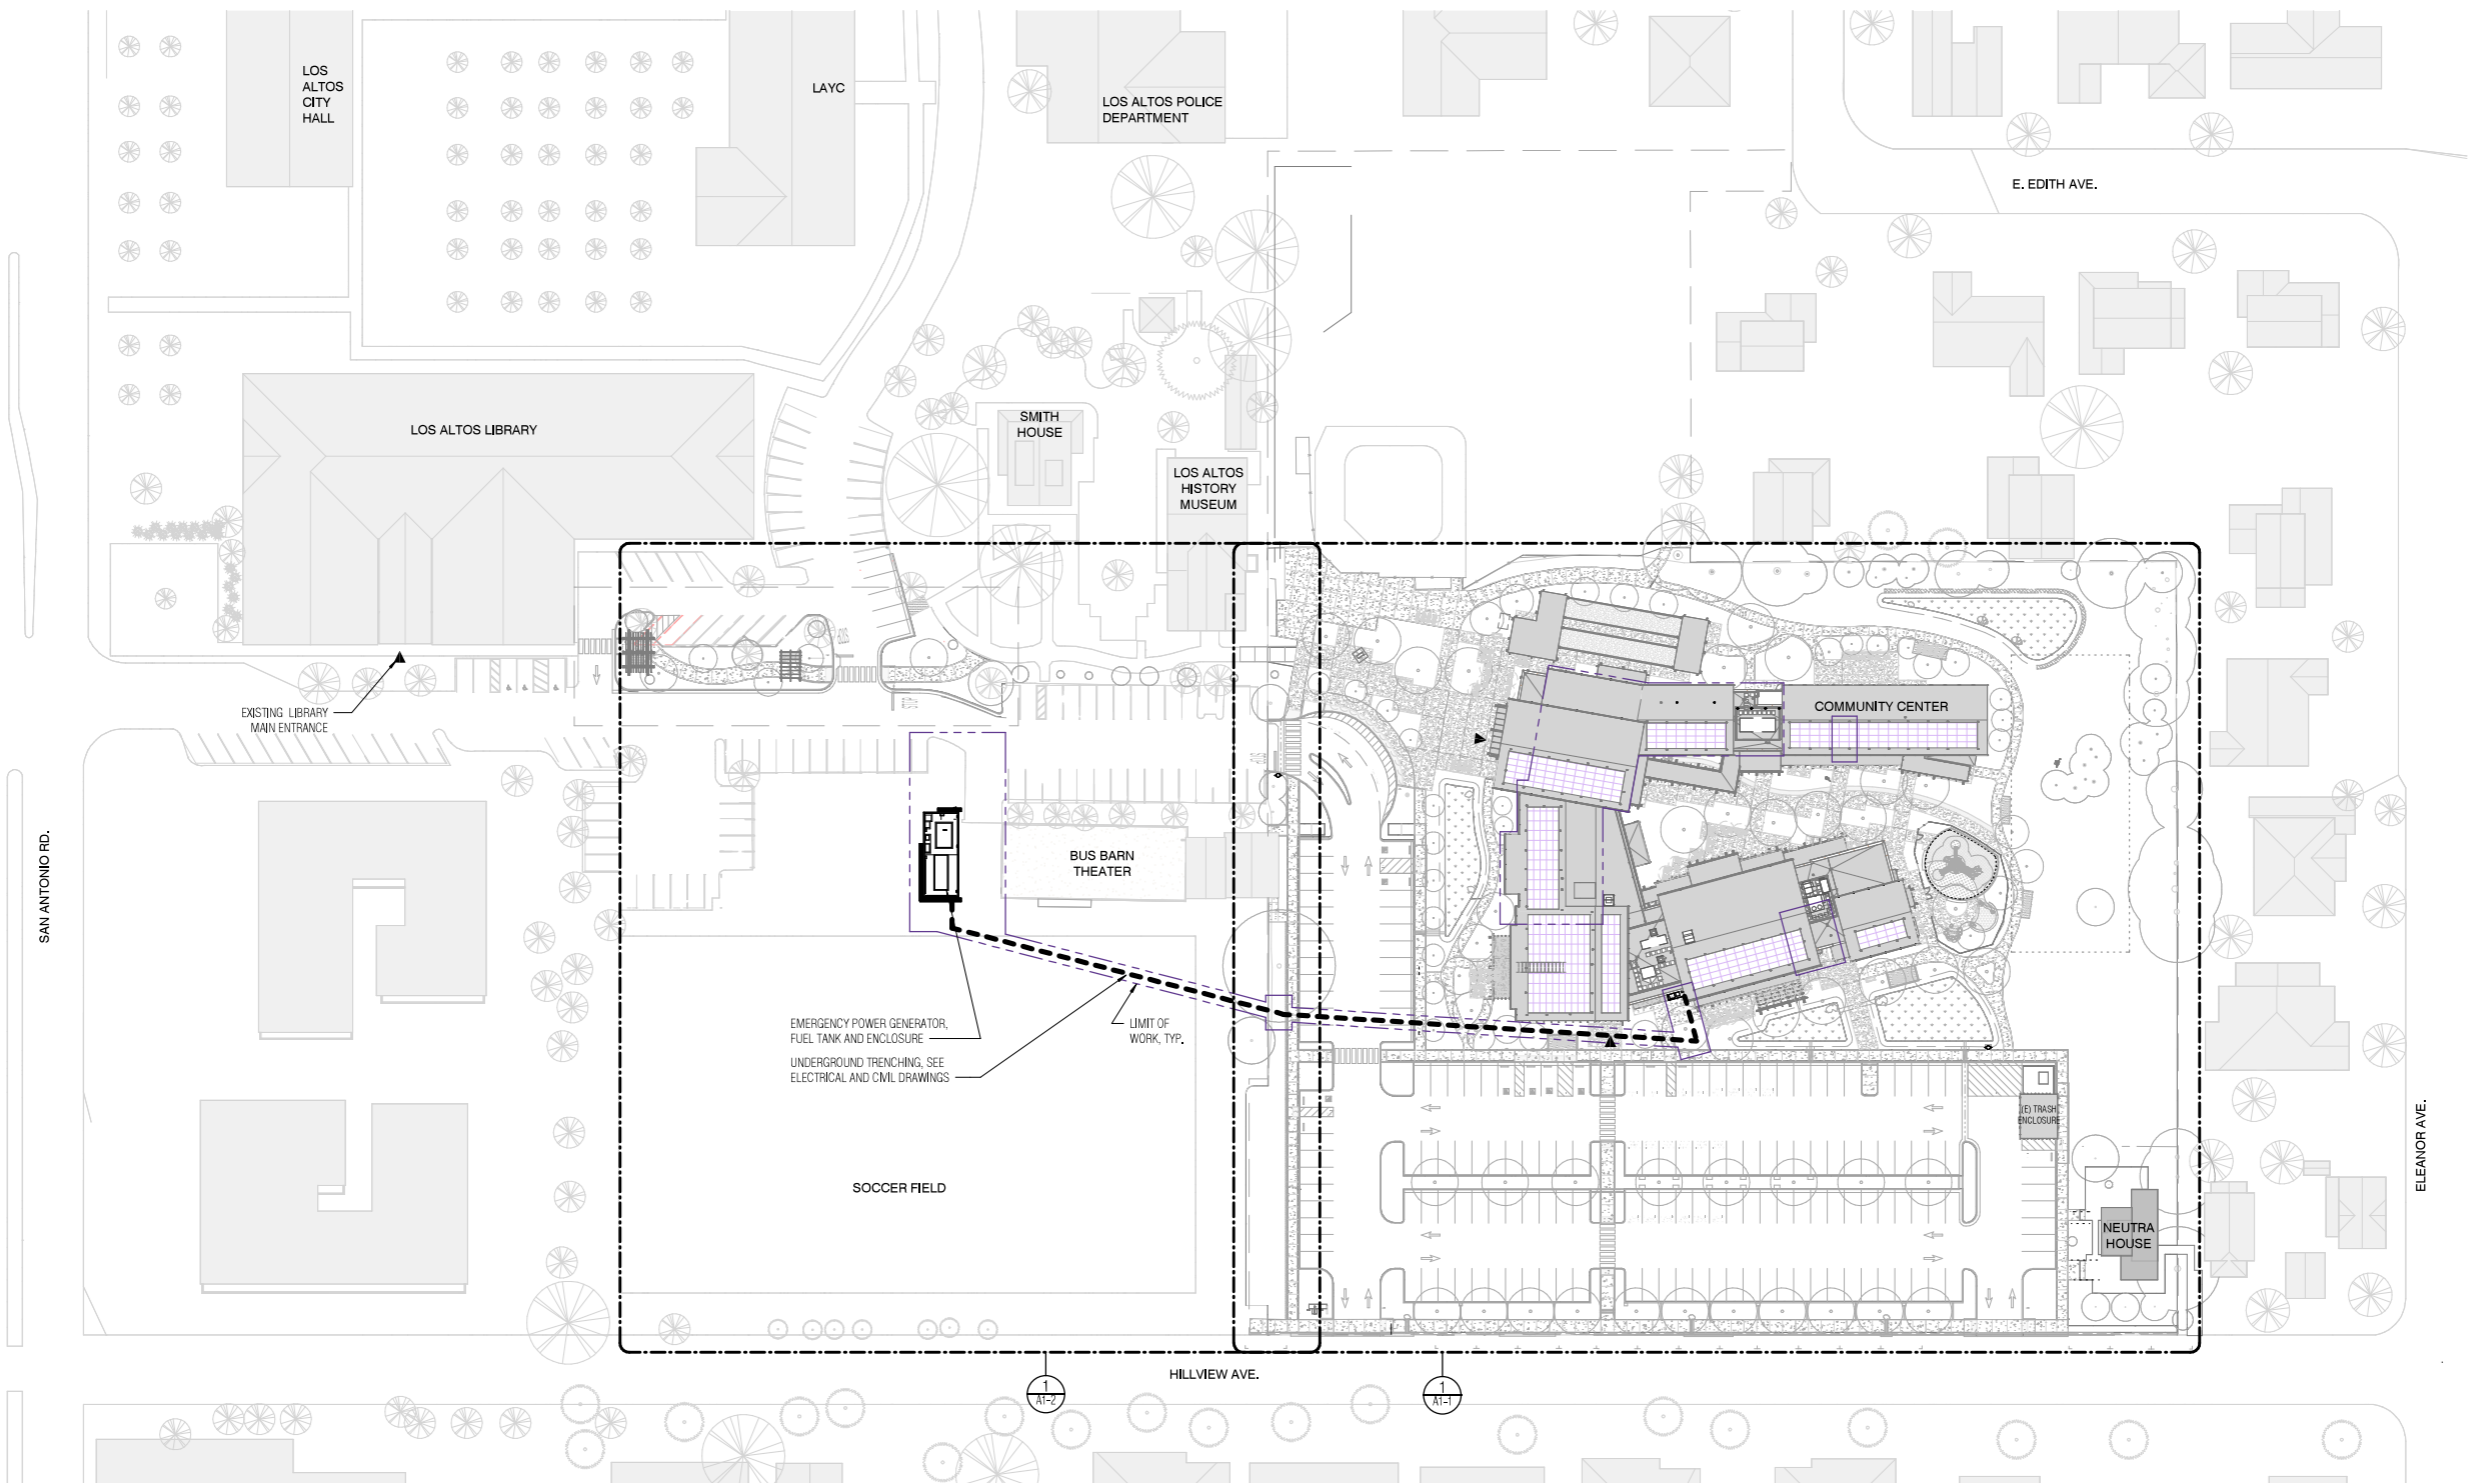

SAN ANTONIO RD.

ELEANOR AVE.


HILLVIEW AVE.

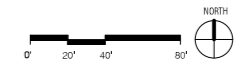


CITY OF LOS ALTOS
JOB COPY
REVIEWED FOR CODE COMPLIANCE

SITE LEGEND	
	PROPERTY LINE
	INDICATES AREA OF ALTERATION
	ACCESSIBLE PATH TO PUBLIC RIGHT OF WAY
	BICYCLE RACK
	ELECTRIC VEHICLE CHARGING STATION
	EXISTING TREES
	NEW TREES
	INTERIOR ACCESSIBLE PATH OF TRAVEL

1 CIVIC CAMPUS EOC
1" = 40'-0"

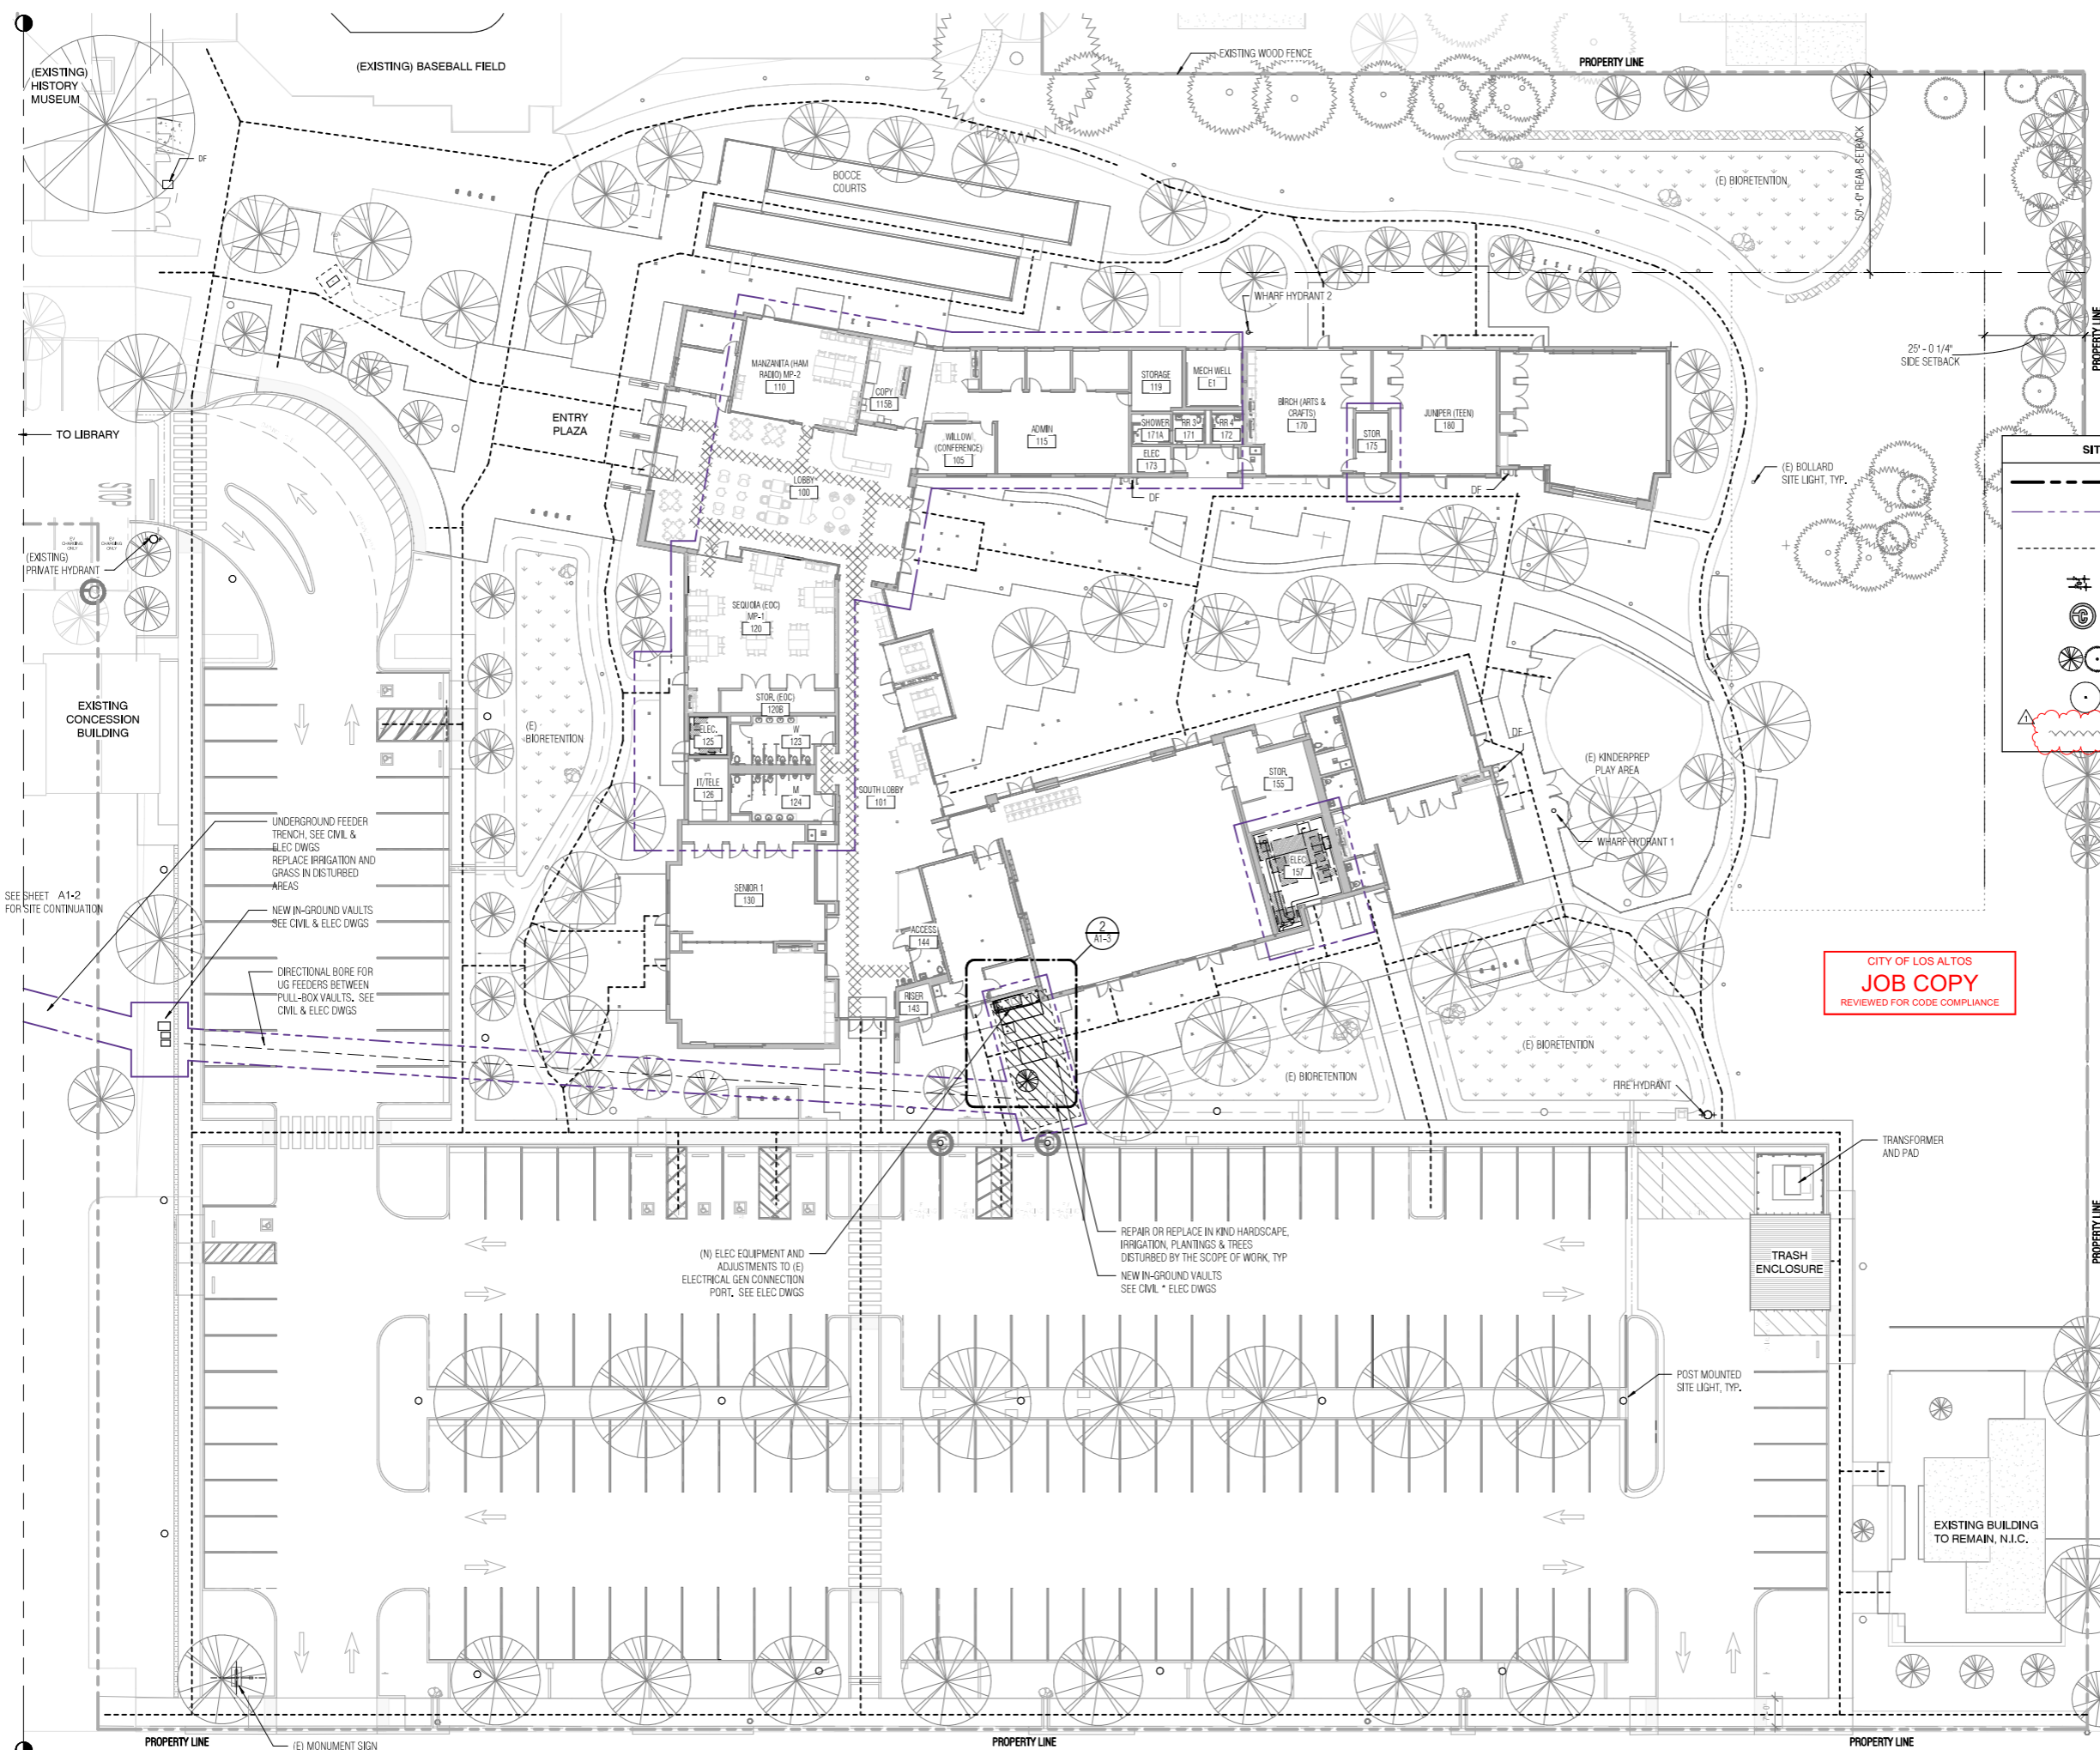

- GENERAL NOTES**
- REFER TO CIVIL, ELECTRICAL, PLUMBING, STRUCTURAL, AND TELECOM DRAWINGS FOR ADDITIONAL INFORMATION. SCOPE, PROTECT IN PLACE EXISTING ITEMS NOT INDICATED TO BE REMOVED.
 - PROVIDE PATCH AND REPAIR OF EXISTING FINISHES, SITE, AND BUILDING IMPROVEMENTS IN KIND WHERE AFFECTED BY WORK.
 - REPAIR PENETRATIONS TO MAINTAIN EXISTING FIRE RATINGS, PROTECT EXISTING FIRE RATINGS, AND REPAIR IF DAMAGED BY WORK.
 - ALL WALKING SURFACES SHALL BE NON-SLIP PER CBC 11B 302.1
 - WOOD FINISH - ALL CEDAR TO RECEIVE STAIN FINISH PER A9-1 FINISH SCHEDULE AND SPEC SECT 06 20 00 FINISH CARPENTRY

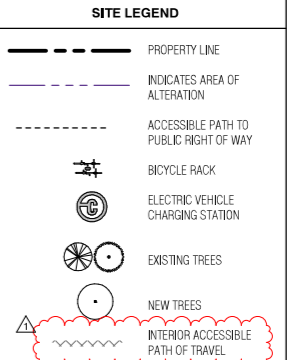

**CITY OF LOS ALTOS
JOB COPY**
REVIEWED FOR CODE COMPLIANCE

APPROVALS

NOLL & TAM
ARCHITECTS

729 Heinz Avenue
Berkeley, CA 94710
tel 510.542.2200
fax 510.542.2201



SEAL
Date signed: 11/14/2023

PROJECT TITLE

**City of Los Altos
EMERGENCY OPERATION CENTER**

97 Hillview Ave, Los Altos, CA 94022

ISSUE TITLE
PERMIT SET

ISSUE DATE
AUG 03, 2023

NOLL & TAM JOB NUMBER
22203

REVISIONS

DATE	DESCRIPTION

SHEET TITLE
SITE PLAN EAST

REVIEWED
FOR CODE COMPLIANCE
January 5, 2024
TRB AND ASSOCIATES


SHEET NUMBER

A1-1

1 SITE PLAN EAST
1/16" = 1'-0"




11142023 2:27:57 PM Autodesk Docs: Los Altos EDC:COLLA:EDC_Auto_Central_2023.rvt

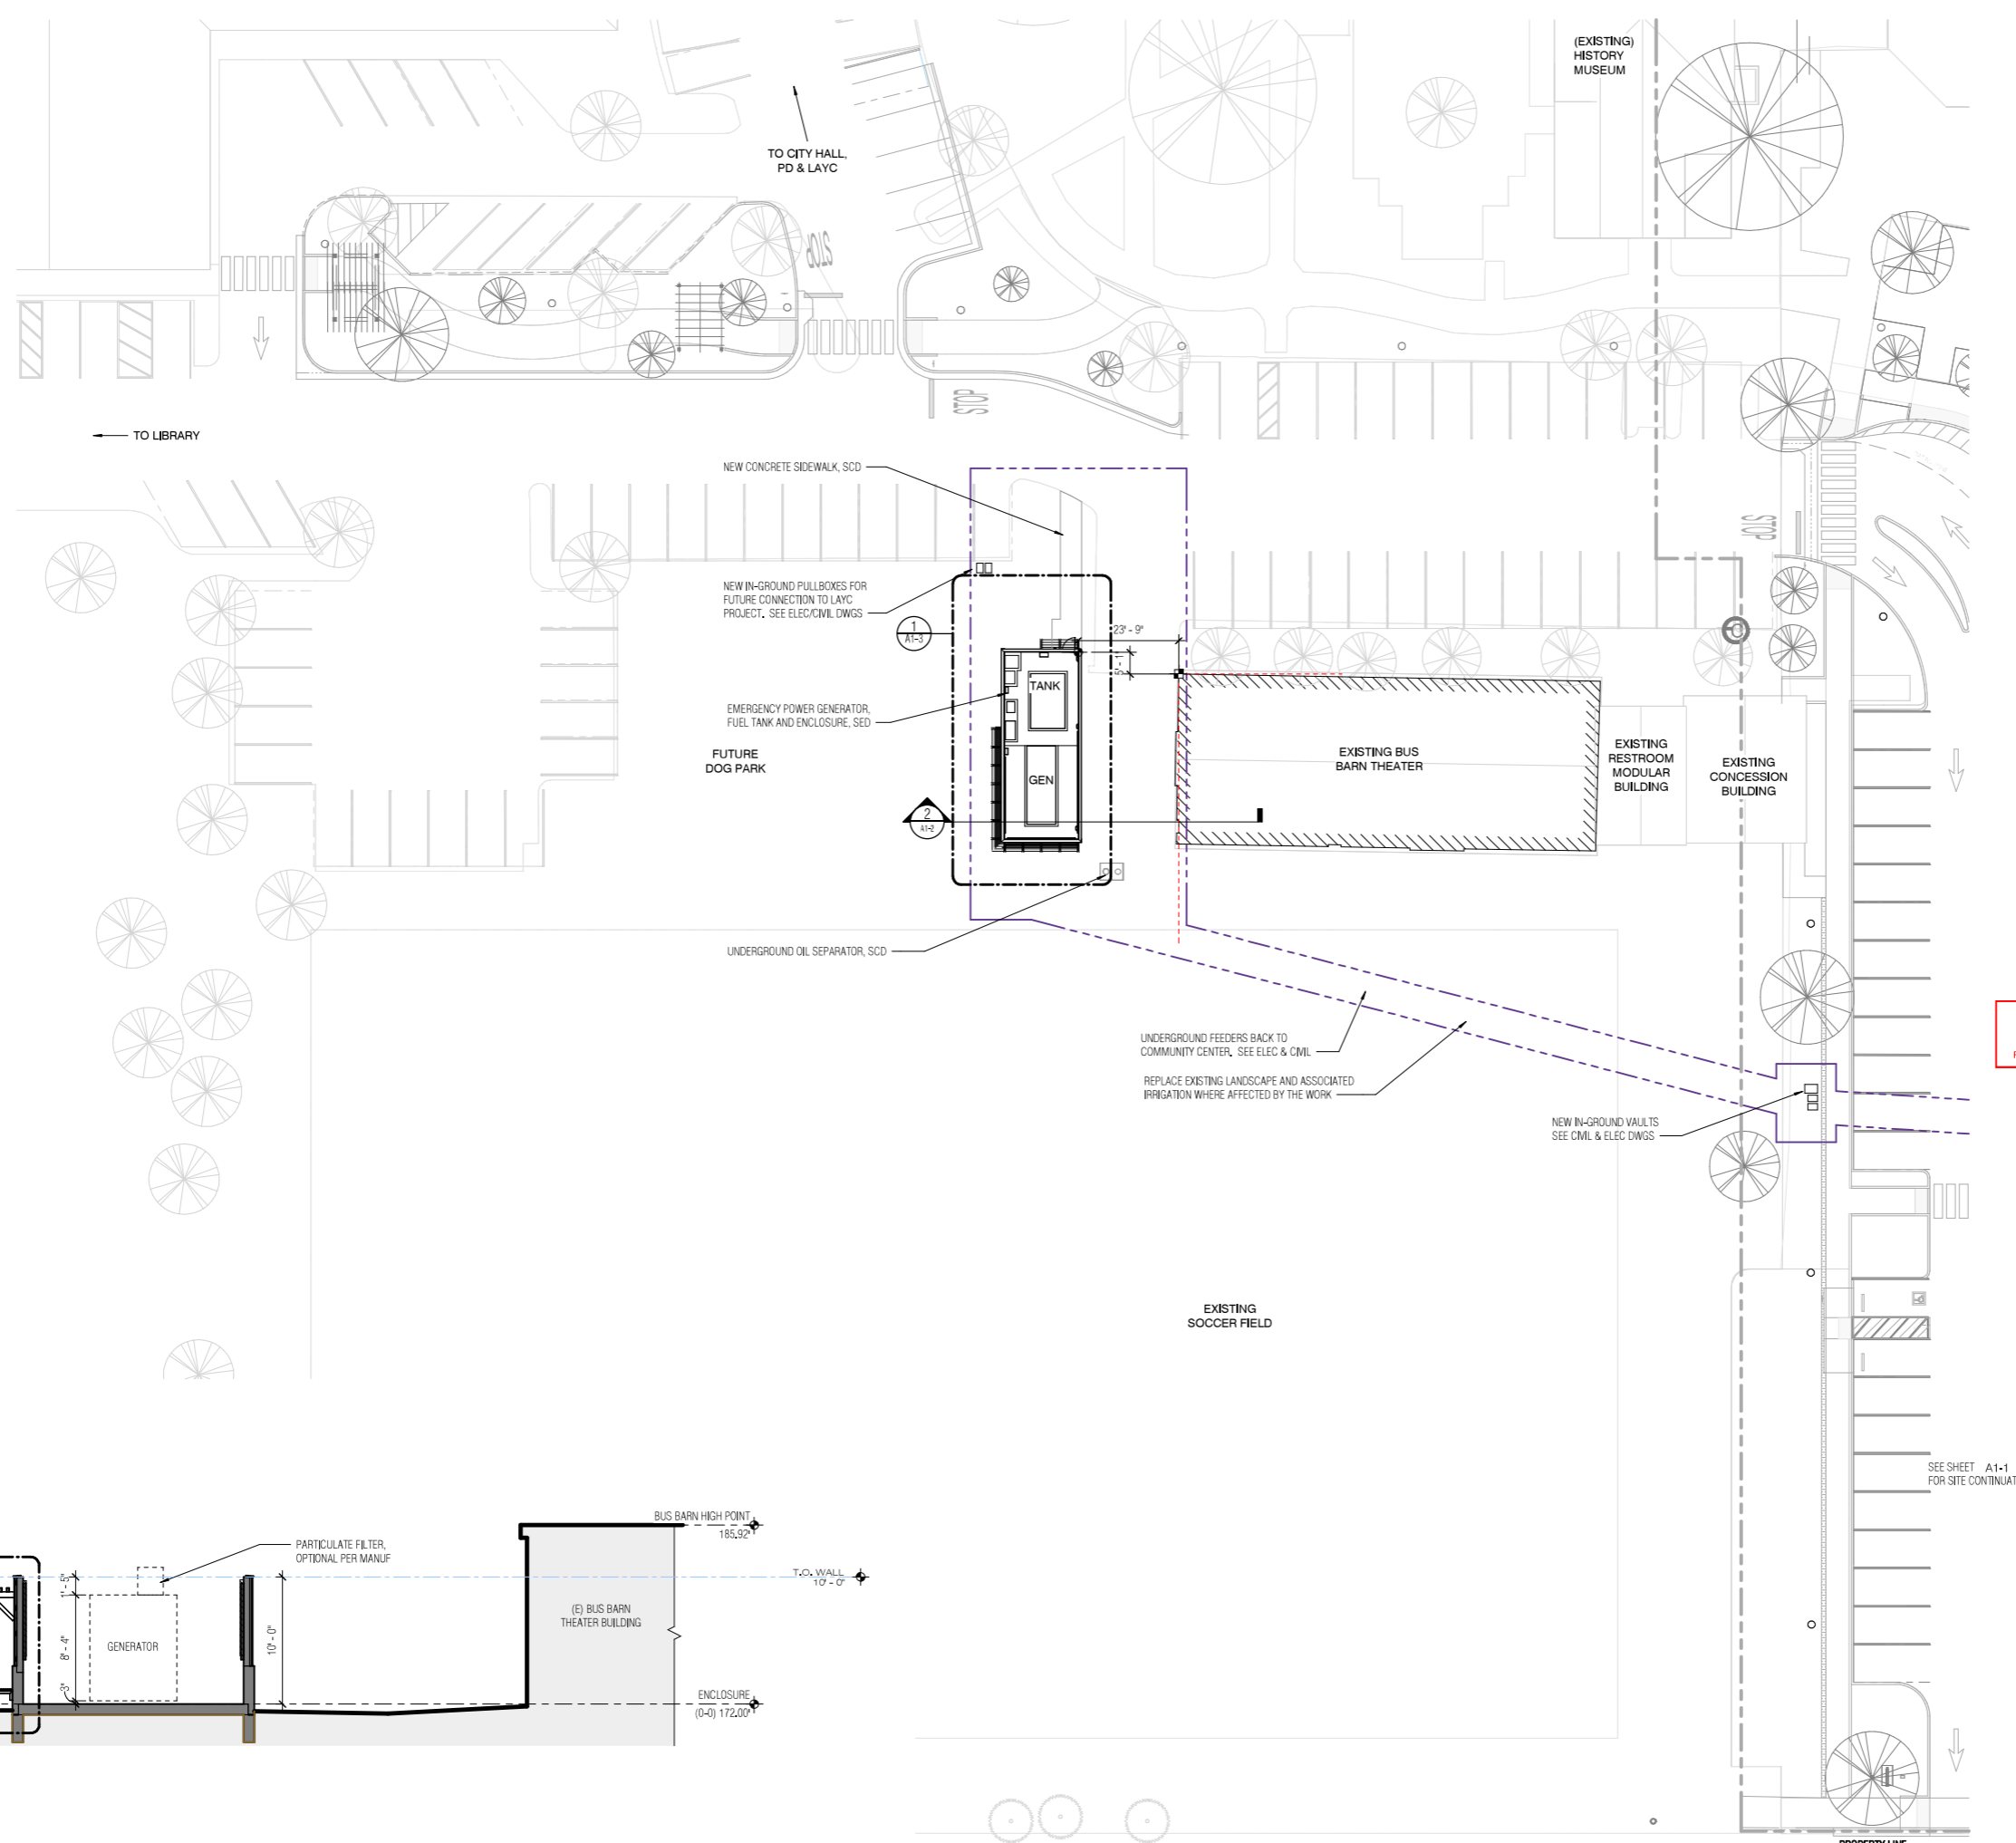

GENERAL NOTES

1. REFER TO CIVIL, ELECTRICAL, PLUMBING, STRUCTURAL, AND TELECOM DRAWINGS FOR ADDITIONAL INFORMATION/SCOPE.
2. PROTECT IN PLACE EXISTING ITEMS NOT INDICATED TO BE REMOVED.
3. PROVIDE PATCH AND REPAIR OF EXISTING FINISHES, SITE, AND BUILDING IMPROVEMENTS IN KIND WHERE AFFECTED BY WORK.
4. REPAIR PENETRATIONS TO MAINTAIN EXISTING FIRE RATINGS.
5. PROTECT BRIGADATION SYSTEM AND REPAIR IF DAMAGED BY WORK.
6. ALL WALKING SURFACES SHALL BE NON-SLIP PER CBC 11B 302.1
7. WOOD FINISH - ALL CEDAR TO RECEIVE STAIN FINISH PER AS-1 FINISH SCHEDULE AND SPEC SECT 06 20 00 FINISH CARPENTRY

SITE LEGEND

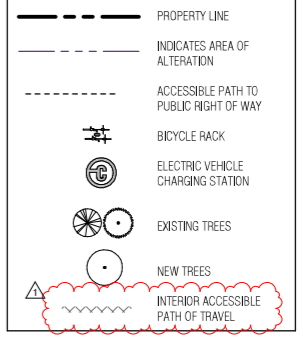

**CITY OF LOS ALTOS
JOB COPY**
 REVIEWED FOR CODE COMPLIANCE

APPROVALS

NOLL & TAM
ARCHITECTS

729 Heinz Avenue
Berkeley, CA 94710
tel 510.542.2200
fax 510.542.2201



SEAL

 Date signed: 11/14/2023

PROJECT TITLE

**City of Los Altos
EMERGENCY OPERATION
CENTER**

97 Hillview Ave. Los Altos, CA
94022

ISSUE TITLE

PERMIT SET

ISSUE DATE

AUG 03, 2023

NOLL & TAM JOB NUMBER

22203

REVISIONS

DATE	DESCRIPTION

SHEET TITLE

SITE PLAN WEST

REVIEWED
 FOR CODE COMPLIANCE
 January 5, 2024
 TRB AND ASSOCIATES


SHEET NUMBER

A1-2

2 SITE SECTION - EOC GENERATOR & ENCLOSURE
 3/16" = 1'-0"


1 SITE PLAN WEST
 1/16" = 1'-0"

11/14/2023 2:28:03 PM Altos\esd\Draw\Los Altos EOC\LA-EOC_A1-2_Central_2023.rvt

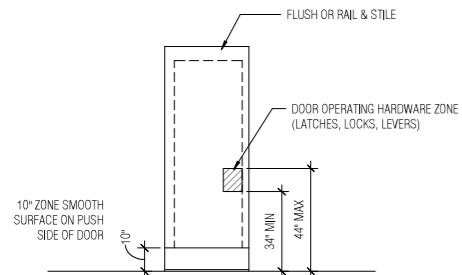


NOTE:
 1. HINGED DOORS AND GATES SHALL HAVE AN OPERATING FORCE NO GREATER THAN 5 POUNDS MAX.
 2. SLIDING AND FOLDING DOORS THAT ARE PART OF AN ACCESSIBLE ROUTE SHALL HAVE AN OPERATING FORCE NO GREATER THAN 5 POUNDS MAX.


5 DOOR HARDWARE (REFERENCE)
 A1-3 3/8" = 1'-0"

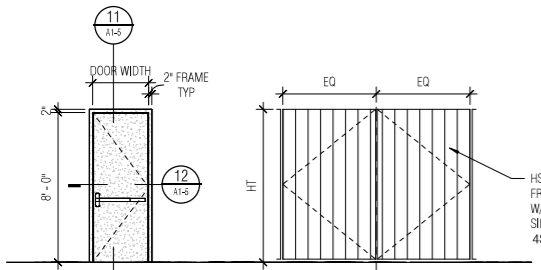

6 DOOR & GATE TYPES
 A1-3 1/4" = 1'-0"

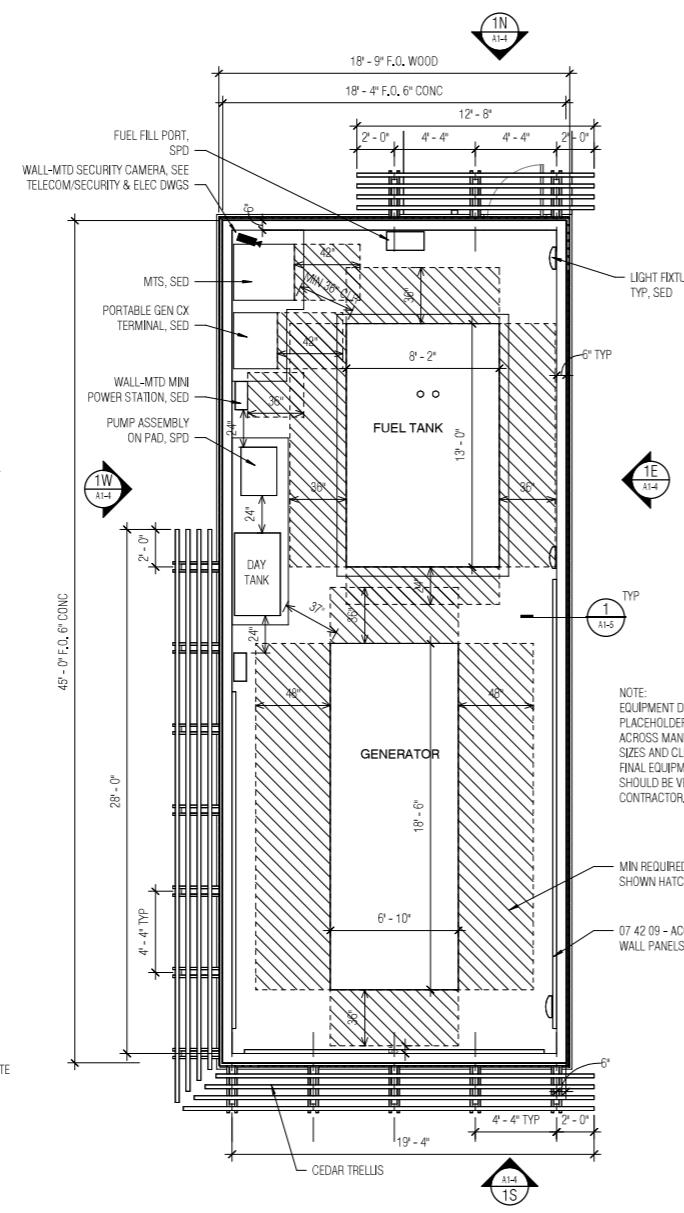


3 ENLARGED PLAN - EOC GENERATOR ENCLOSURE HIGH
 A1-3 1/4" = 1'-0"

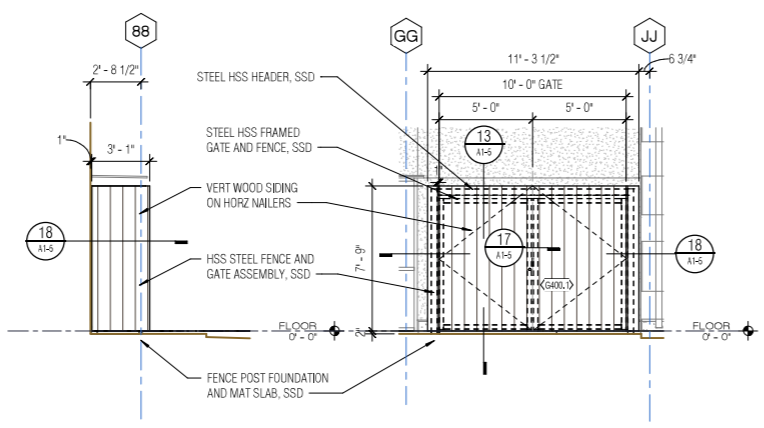


4W EOC WALL SCREEN & GATE - SOUTH FACADE
 A1-3 1/4" = 1'-0"

HATCH PATTERN INDICATES PLANTING REQUESTED IN PLANNING REVIEW, LANDSCAPING AND IRRIGATION NIC. SCOPE TO BE PROVIDED IN CITY DOG PARK PROJECT.
 SUGGESTED PLANT SPECIES INCLUDE:
 DIE GRA MUH CAP
 PEN HAM
 PHO SUN
 SAL BAR
 SEE REF LANDSCAPE NOTES & LEGEND ON A1-3

NOTE:
 EQUIPMENT DIMENSIONS ARE PLACEHOLDERS, SIZES VARY ACROSS MANUFACTURERS AND THE SIZES AND CLEARANCES FOR THE FINAL EQUIPMENT TO BE PROVIDED SHOULD BE VERIFIED BY THE CONTRACTOR.

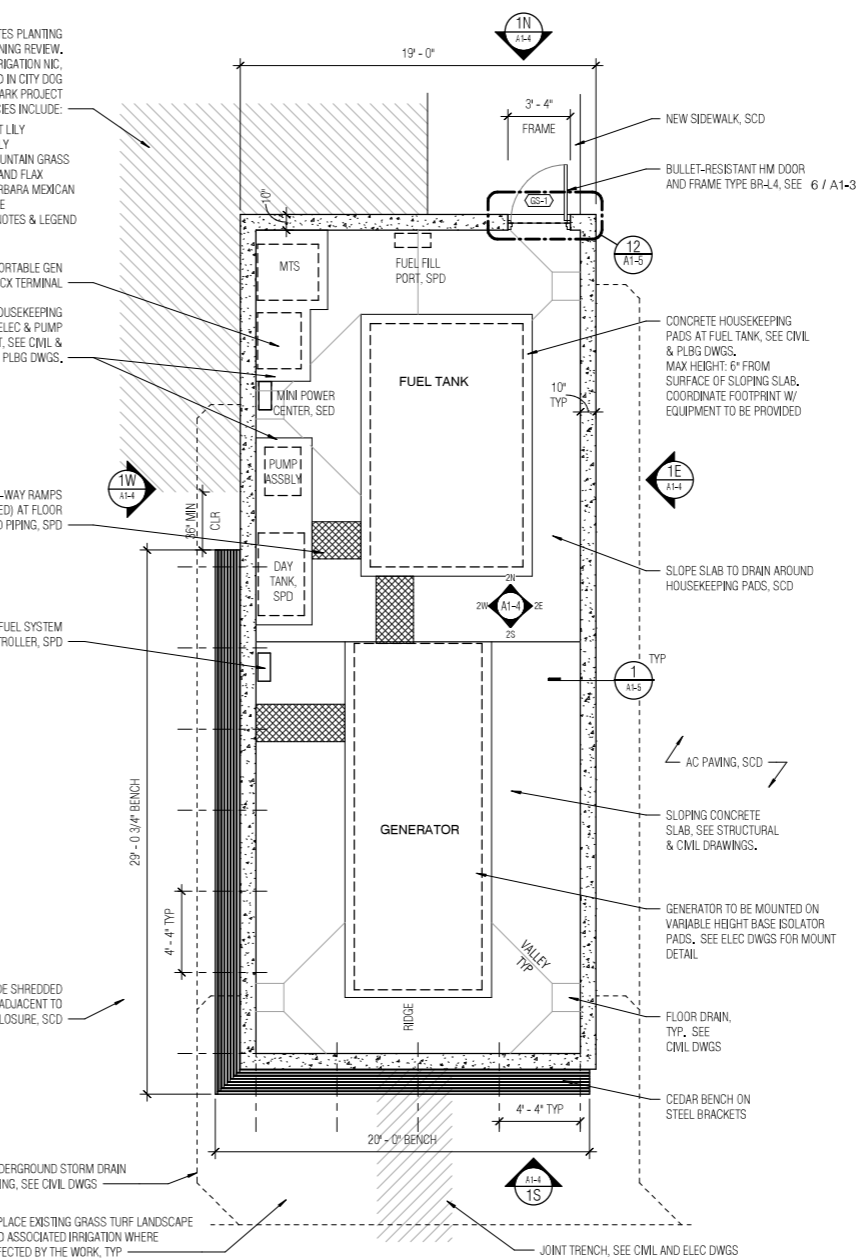

1 ENLARGED PLAN - EOC GENERATOR ENCLOSURE LOW
 A1-3 1/4" = 1'-0"

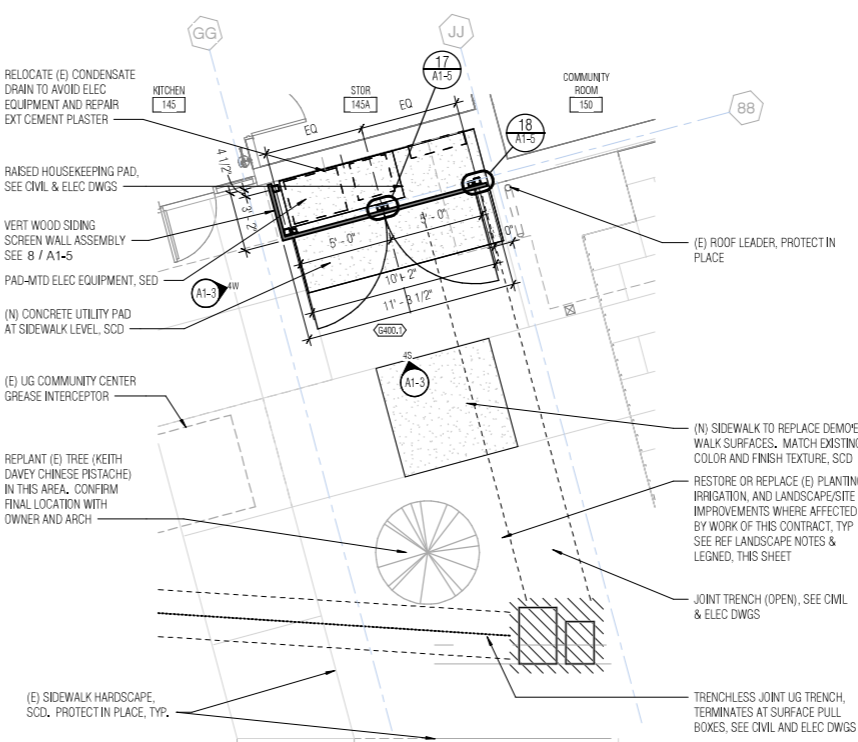

2 ENLARGED SITE PLAN - EOC SOUTH EMERGENCY POWER
 A1-3 1/4" = 1'-0"

FINISH NOTE:
 ALL CEDAR WOOD TO RECEIVE STAIN FINISH PER A9-1 FINISH SCHEDULE AND SPEC 06 20 00 FINISH CARPENTRY

GENERAL NOTES

- REFER TO CIVIL, ELECTRICAL, PLUMBING, STRUCTURAL, AND TELCOM DRAWINGS FOR ADDITIONAL INFORMATION/SCOPE.
- PROTECT IN PLACE EXISTING ITEMS NOT INDICATED TO BE REMOVED.
- PROVIDE PATCH AND REPAIR OF EXISTING FINISHES, SITE, AND BUILDING IMPROVEMENTS IN KIND WHERE AFFECTED BY WORK.
- REPAIR PENETRATIONS TO MAINTAIN EXISTING FIRE RATINGS.
- PROTECT IRRIGATION SYSTEM AND REPAIR IF DAMAGED BY WORK.
- ALL WALKING SURFACES SHALL BE NON-SLIP PER CBC 11B 302.1
- WOOD FINISH - ALL CEDAR TO RECEIVE STAIN FINISH PER A9-1 FINISH SCHEDULE AND SPEC SECT 06 20 00 FINISH CARPENTRY

DOOR NOTES

- HINGED DOORS AND GATES SHALL HAVE AN OPERATING FORCE NO GREATER THAN 5 POUNDS MAX.
- SLIDING AND FOLDING DOORS THAT ARE PART OF AN ACCESSIBLE ROUTE SHALL HAVE AN OPERATING FORCE NO GREATER THAN 5 POUNDS MAX.
- SEE SHEET G3.22 FOR HARDWARE MOUNTING REQUIREMENTS

**CITY OF LOS ALTOS
 JOB COPY
 REVIEWED FOR CODE COMPLIANCE**

LANDSCAPE REF NOTES & LEGEND

LISTED BELOW ARE THE (E) TREES AND PLANTS INCLUDED WITH THE COMMUNITY CENTER PROJECT FOR REFERENCE.

(E) TREES:

CODE	Botanical Name/Common Name
ARB MAR	Arbutus x Marina / Arbutus Multi-Trunk
PIS CHI	Pistacia chinensis 'Keith Davey' / Keith Davey Chinese Pistache

(E) SHRUBS, PERENNIALS, GRASSES:

CODE	Botanical Name/Common Name
ANI ORA	Anigozanthos 'Orange Cross' / Orange Kangaroo Paw
ARC HOW	Arctostaphylos 'Howard McMinn' / Howard McMinn Manzanita
DIE GRA	Diets grandiflora / Fortnight Lily
LEU RED	Leucadendron x 'Red Gem' / Red Conebush
MUH CAP	Muhlenbergia capillaris / Pink Muhly
MUH LIN	Muhlenbergia Lindheimeri / Lindheimer's Muhly
PEN HAM	Pennisetum alopecuroides 'Hameln' / Dwarf Fountain Grass
PHO SUN	Phormium 'Sunset' / New Zealand Flax
RHA ALA	Rhamnus alaternus 'John Edwards' / Italian Buckthorn
SAL BAR	Salvia leucantha 'Santa Barbara' / Santa Barbara Mexican Bush Sage

(E) GROUNDCOVERS:

CODE	Botanical Name/Common Name
CEA CEN	Ceanothus x 'Centennial' / Centennial Ceanothus
ERI KAR	Erigeron karvinskianus / Fleabane

(E) BIORETENTION PLANTINGS:

CODE	Botanical Name/Common Name
CHO ELE	Chondropetalum elephantinum / Large Cape Rush

(E) HYDROSEED PLANTINGS:

CODE	Botanical Name/Common Name
NAT GRA	Hydroseed Native Grass Mix

APPROVALS

NOLL & TAM ARCHITECTS
 729 Heinz Avenue
 Berkeley, CA 94710
 tel 510.542.2200
 fax 510.542.2201



SEAL



PROJECT TITLE

**City of Los Altos
 EMERGENCY OPERATION CENTER**

97 Hillview Ave. Los Altos, CA 94022

ISSUE TITLE

PERMIT SET

ISSUE DATE

AUG 03, 2023

NOLL & TAM JOB NUMBER

22203

REVISIONS

DATE	DESCRIPTION
------	-------------

SHEET TITLE

ENLARGED SITE PLANS & DOORS

REVIEWED FOR CODE COMPLIANCE
 January 5, 2024

TRB AND ASSOCIATES SHEET NUMBER

A1-3



SEAL



Date signed: 11/14/2023

PROJECT TITLE

**City of Los Altos
EMERGENCY OPERATION
CENTER**

97 Hillview Ave. Los Altos, CA
94022

ISSUE TITLE

PERMIT SET

ISSUE DATE **AUG 03, 2023**

NOLL & TAM JOB NUMBER **22203**

REVISIONS



DATE	DESCRIPTION

SHEET TITLE

**GENERATOR
ENCLOSURE
ENLARGED
ELEVATIONS**


SHEET NUMBER

A1-4

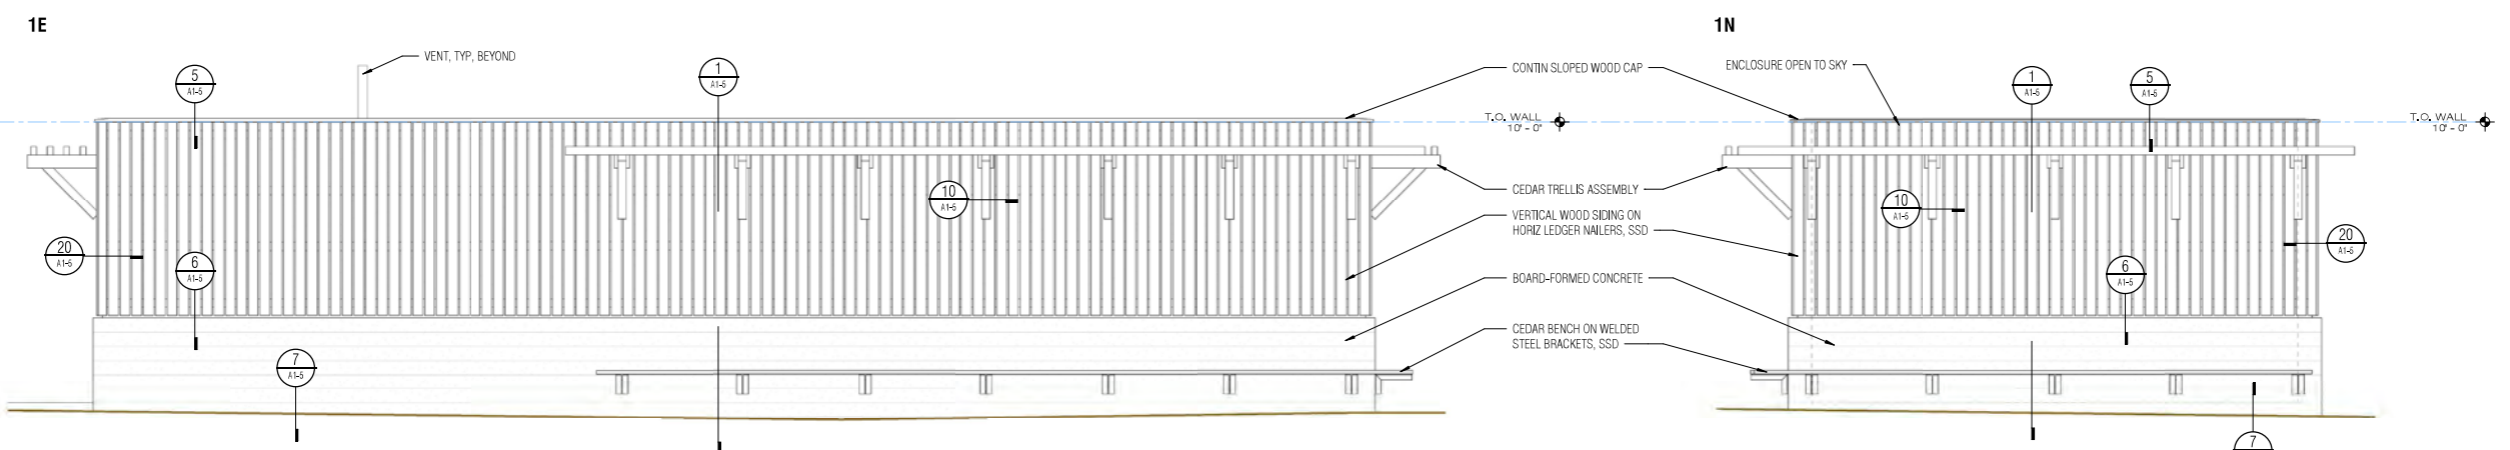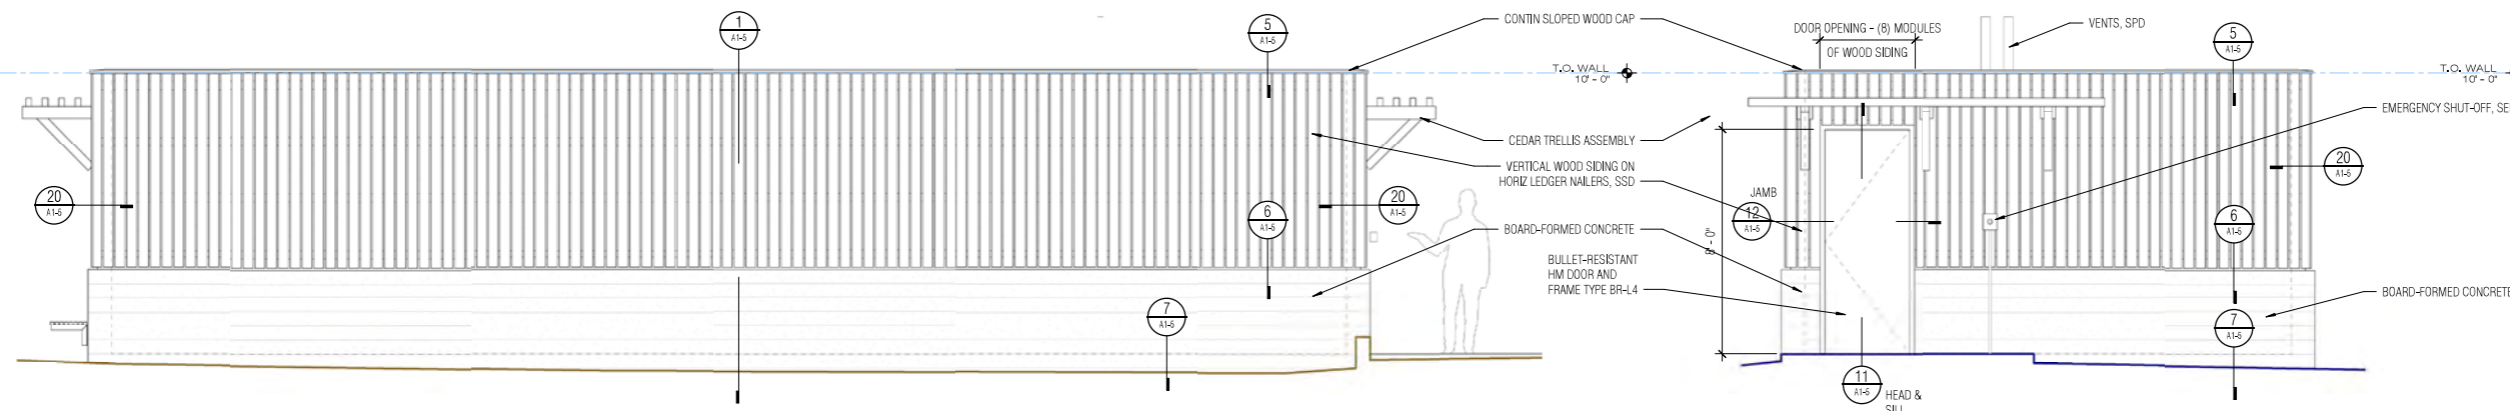


FINISH NOTE:
ALL CEDAR WOOD TO RECEIVE STAIN FINISH PER A9-1 FINISH SCHEDULE
AND SPEC 06 20 00 FINISH CARPENTRY


1W
ENCLOSURE - W
A1-4 3/8" = 1'-0"

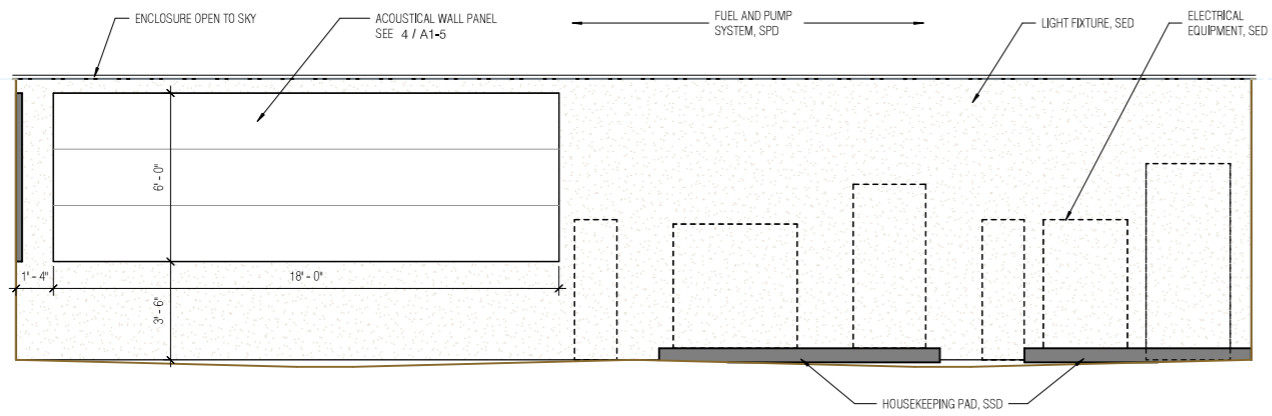


**CITY OF LOS ALTOS
JOB COPY
REVIEWED FOR CODE COMPLIANCE**

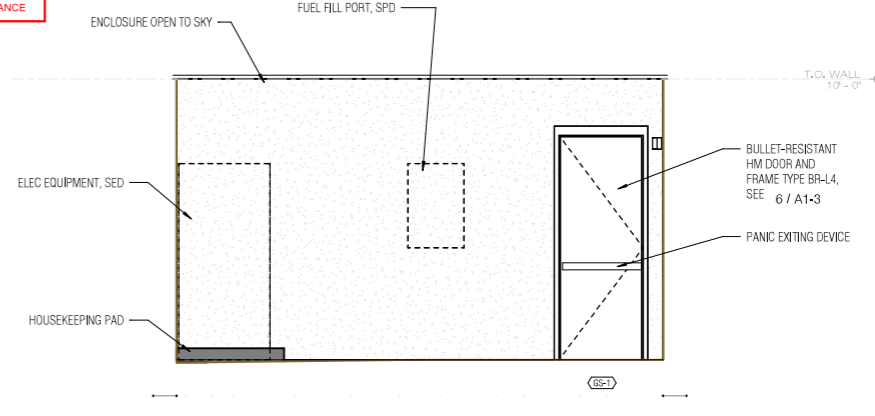

2W

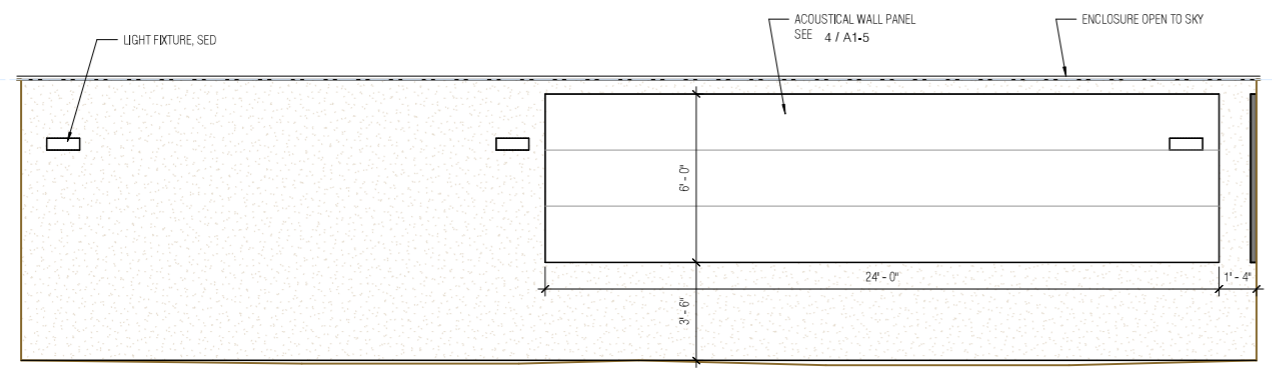


2N

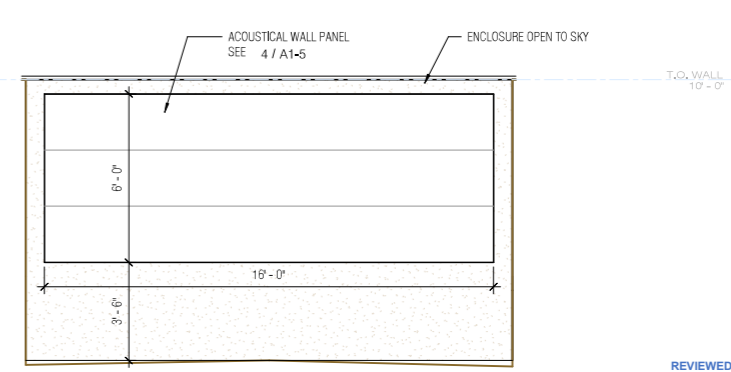


2E
ENCLOSURE INT - E
A1-4 3/8" = 1'-0"

2S


REVIEWED
FOR CODE COMPLIANCE
January 5, 2024
TRB AND ASSOCIATES

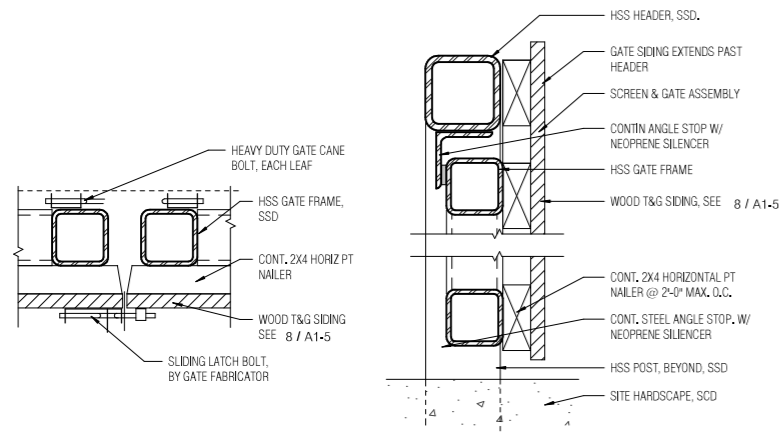


17 EOC WALL SCREEN - GATE LATCH
A1-6 3' = 1'-0"

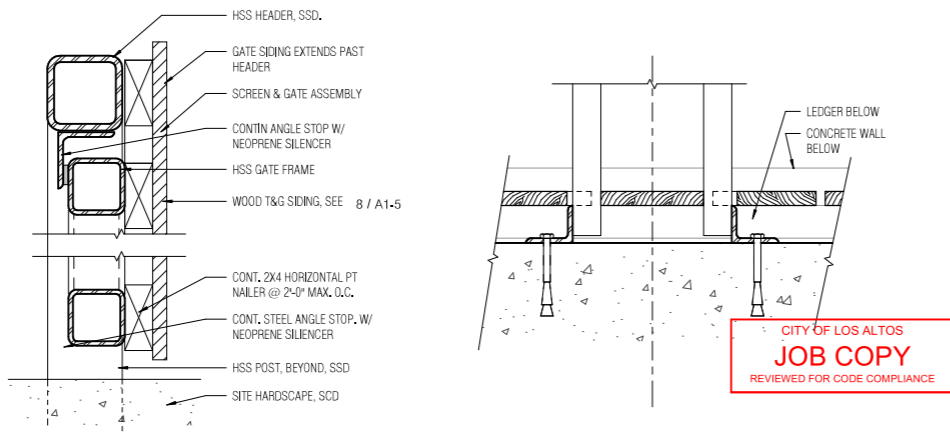


13 EOC WALL SCREEN - GATE SECT
A1-6 3' = 1'-0"

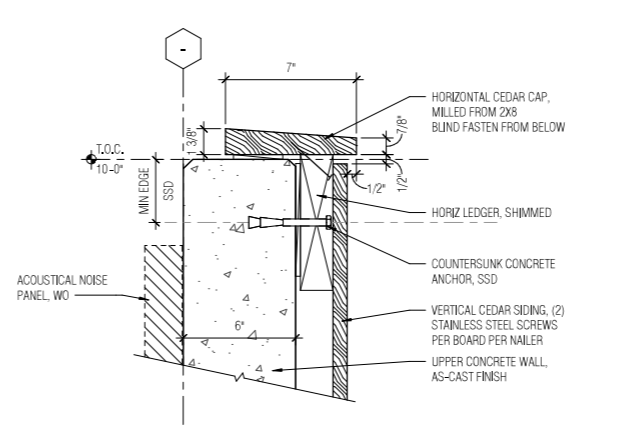


5 SECTION DETAIL - ENCLOSURE - WALL TOP
A1-6 3' = 1'-0"

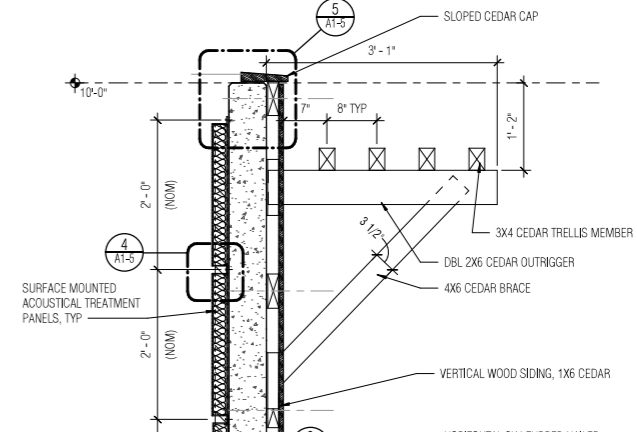


1 ENCLOSURE WALL SECTION
A1-6 1' = 1'-0"

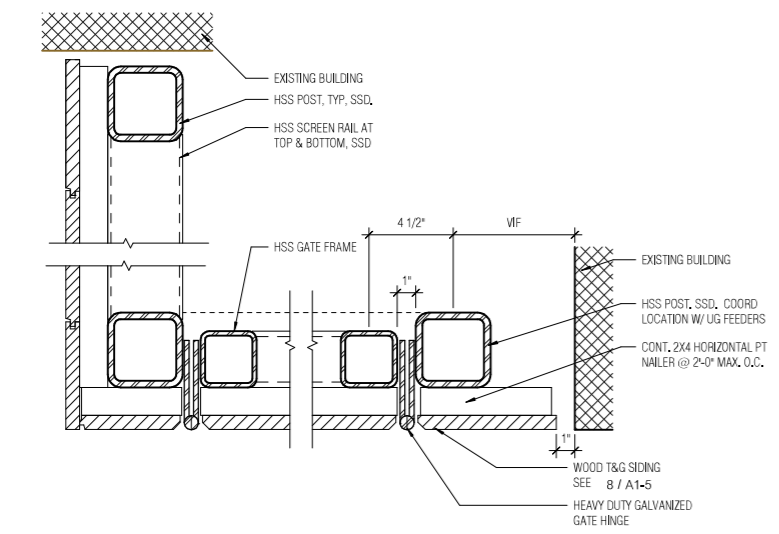


18 EOC WALL SCREEN - GATE JAMB
A1-6 3' = 1'-0"

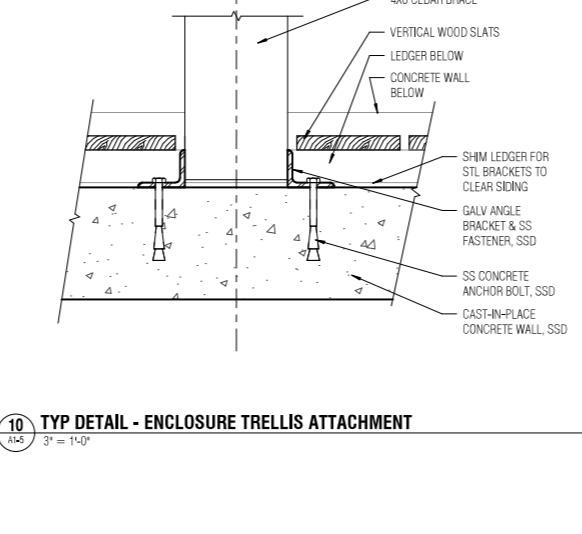


10 TYP DETAIL - ENCLOSURE TRELLIS ATTACHMENT
A1-6 3' = 1'-0"

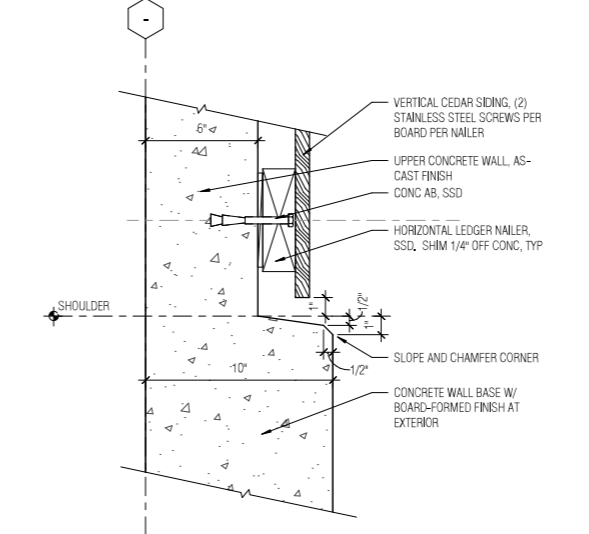


6 SECTION DETAIL - ENCLOSURE - CONC-TRANSITION
A1-6 3' = 1'-0"

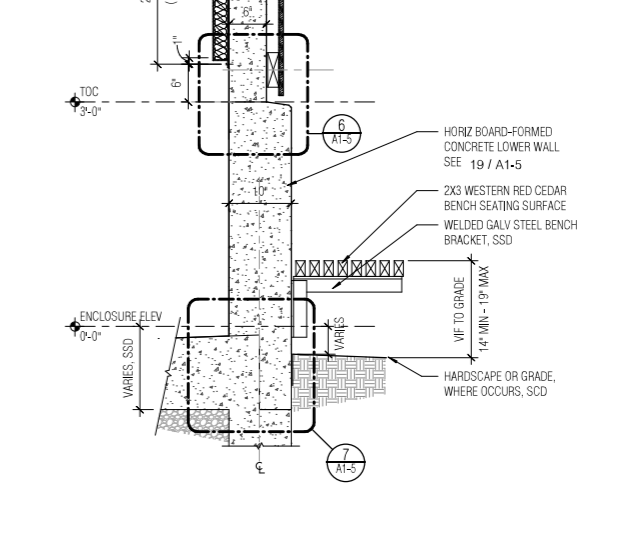


7 SECTION DETAIL - ENCLOSURE - WALL BASE
A1-6 3' = 1'-0"

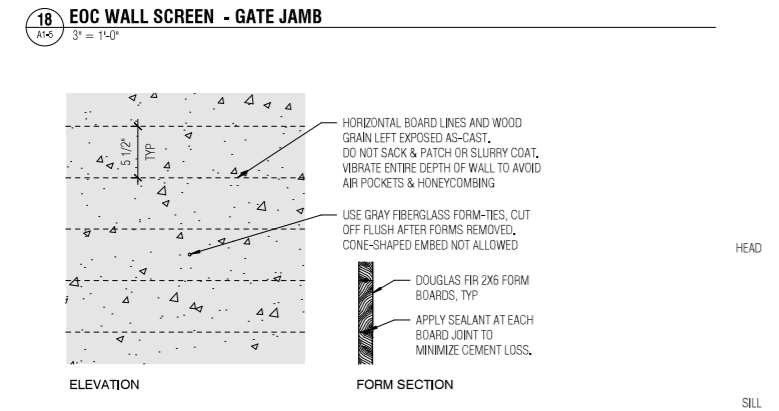


19 BOARD-FORMED CONCRETE DETAIL
A1-6 1 1/2\"/>

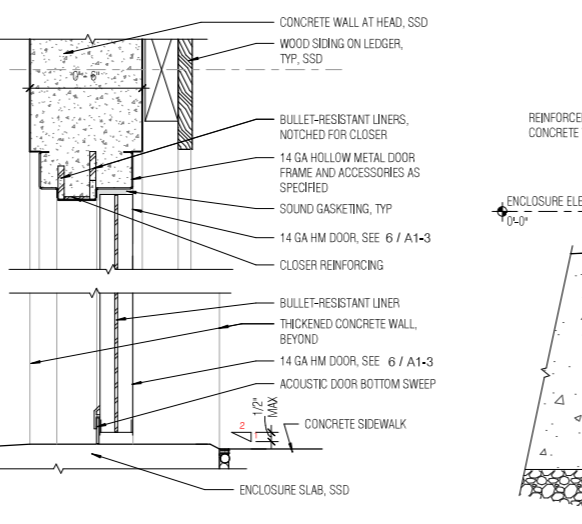


11 EXT DOOR DETAIL - HOLLOW METAL AT CONCRETE
A1-6 3' = 1'-0"

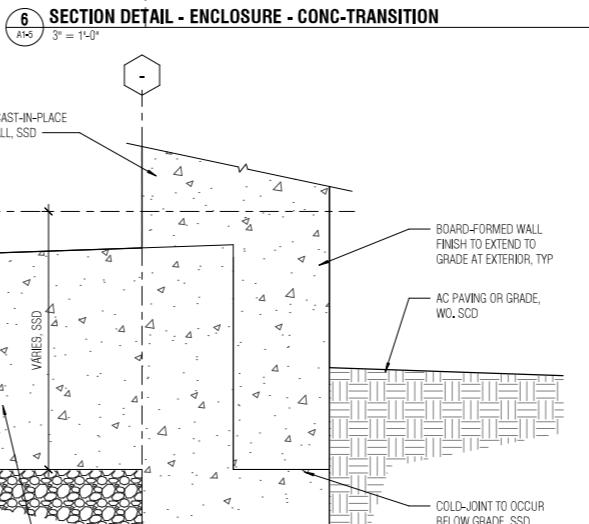


3 TYP ENCLOSURE SIDING - PLAN
A1-6 3' = 1'-0"

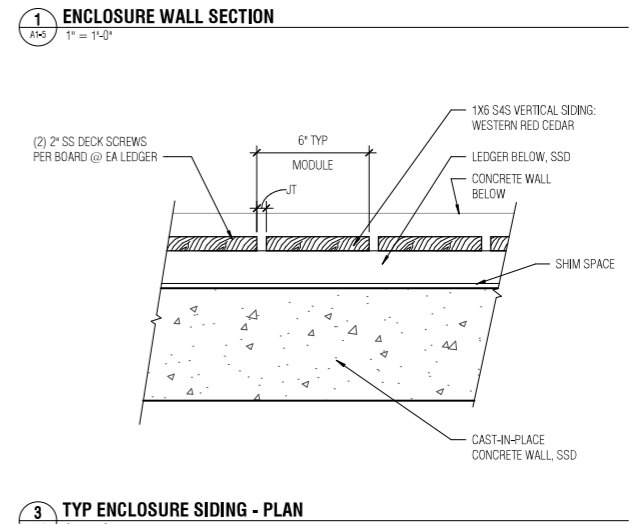


2 TYP ENCLOSURE SIDING - SECTION
A1-6 3' = 1'-0"

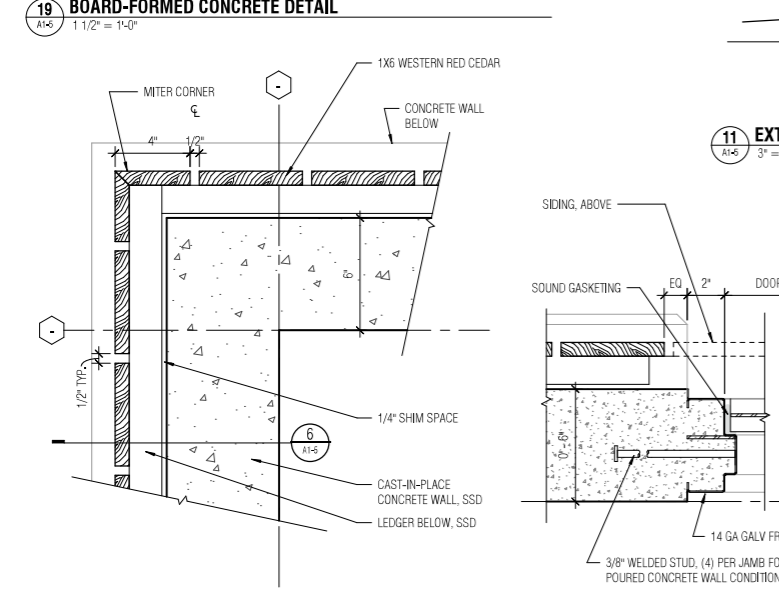


20 TYP PLAN DETAIL - CORNER
A1-6 3' = 1'-0"

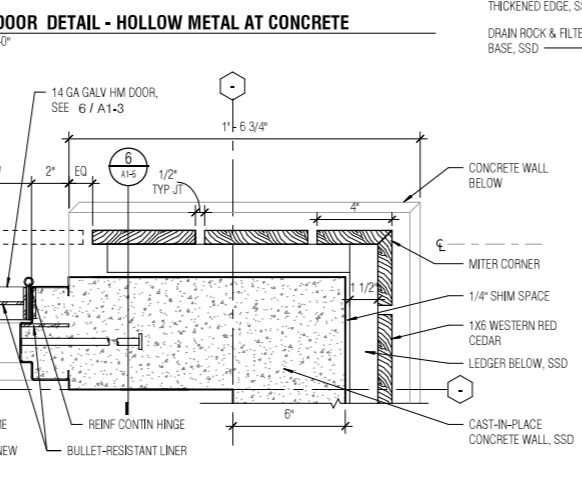

12 TYP PLAN DETAIL - DOOR JAMBS
A1-6 3' = 1'-0"

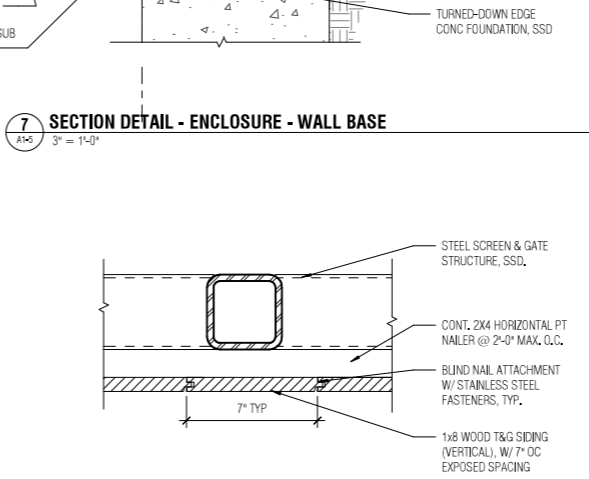

8 TYP GATE & SCREEN ASSEMBLY - PLAN
A1-6 3' = 1'-0"

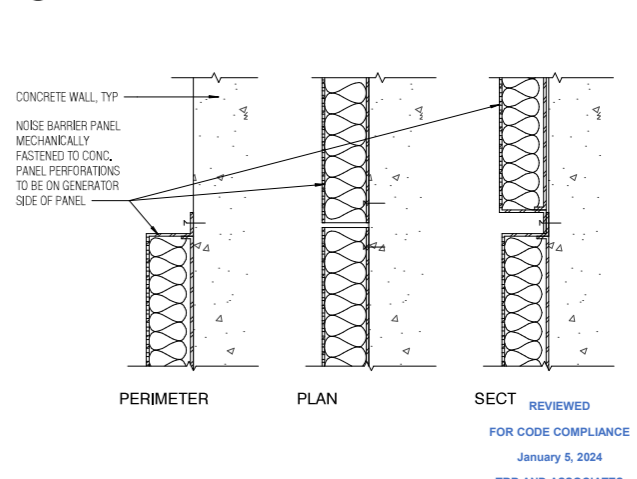

4 ENCLOSURE - NOISE BARRIER - DETAIL
A1-6 3' = 1'-0"

CITY OF LOS ALTOS
JOB COPY
REVIEWED FOR CODE COMPLIANCE

APPROVALS

NOLL & TAM
ARCHITECTS

729 Heinz Avenue
Berkeley, CA 94710
tel 510.542.2200
fax 510.542.2201

PROJECT TITLE
**City of Los Altos
EMERGENCY OPERATION
CENTER**

97 Hillview Ave. Los Altos, CA
94022

ISSUE TITLE
PERMIT SET

ISSUE DATE
AUG 03, 2023


NOLL & TAM JOB NUMBER
22203

REVISIONS	DATE	DESCRIPTION

SHEET TITLE
**SITE DETAILS -
GENERATOR
ENCLOSURE**

SHEET NUMBER
A1-5

11/14/2023 2:28:24 PM Autodesk Docs://Los Altos EOC/CLAECC_Arch_Central_2023.rvt

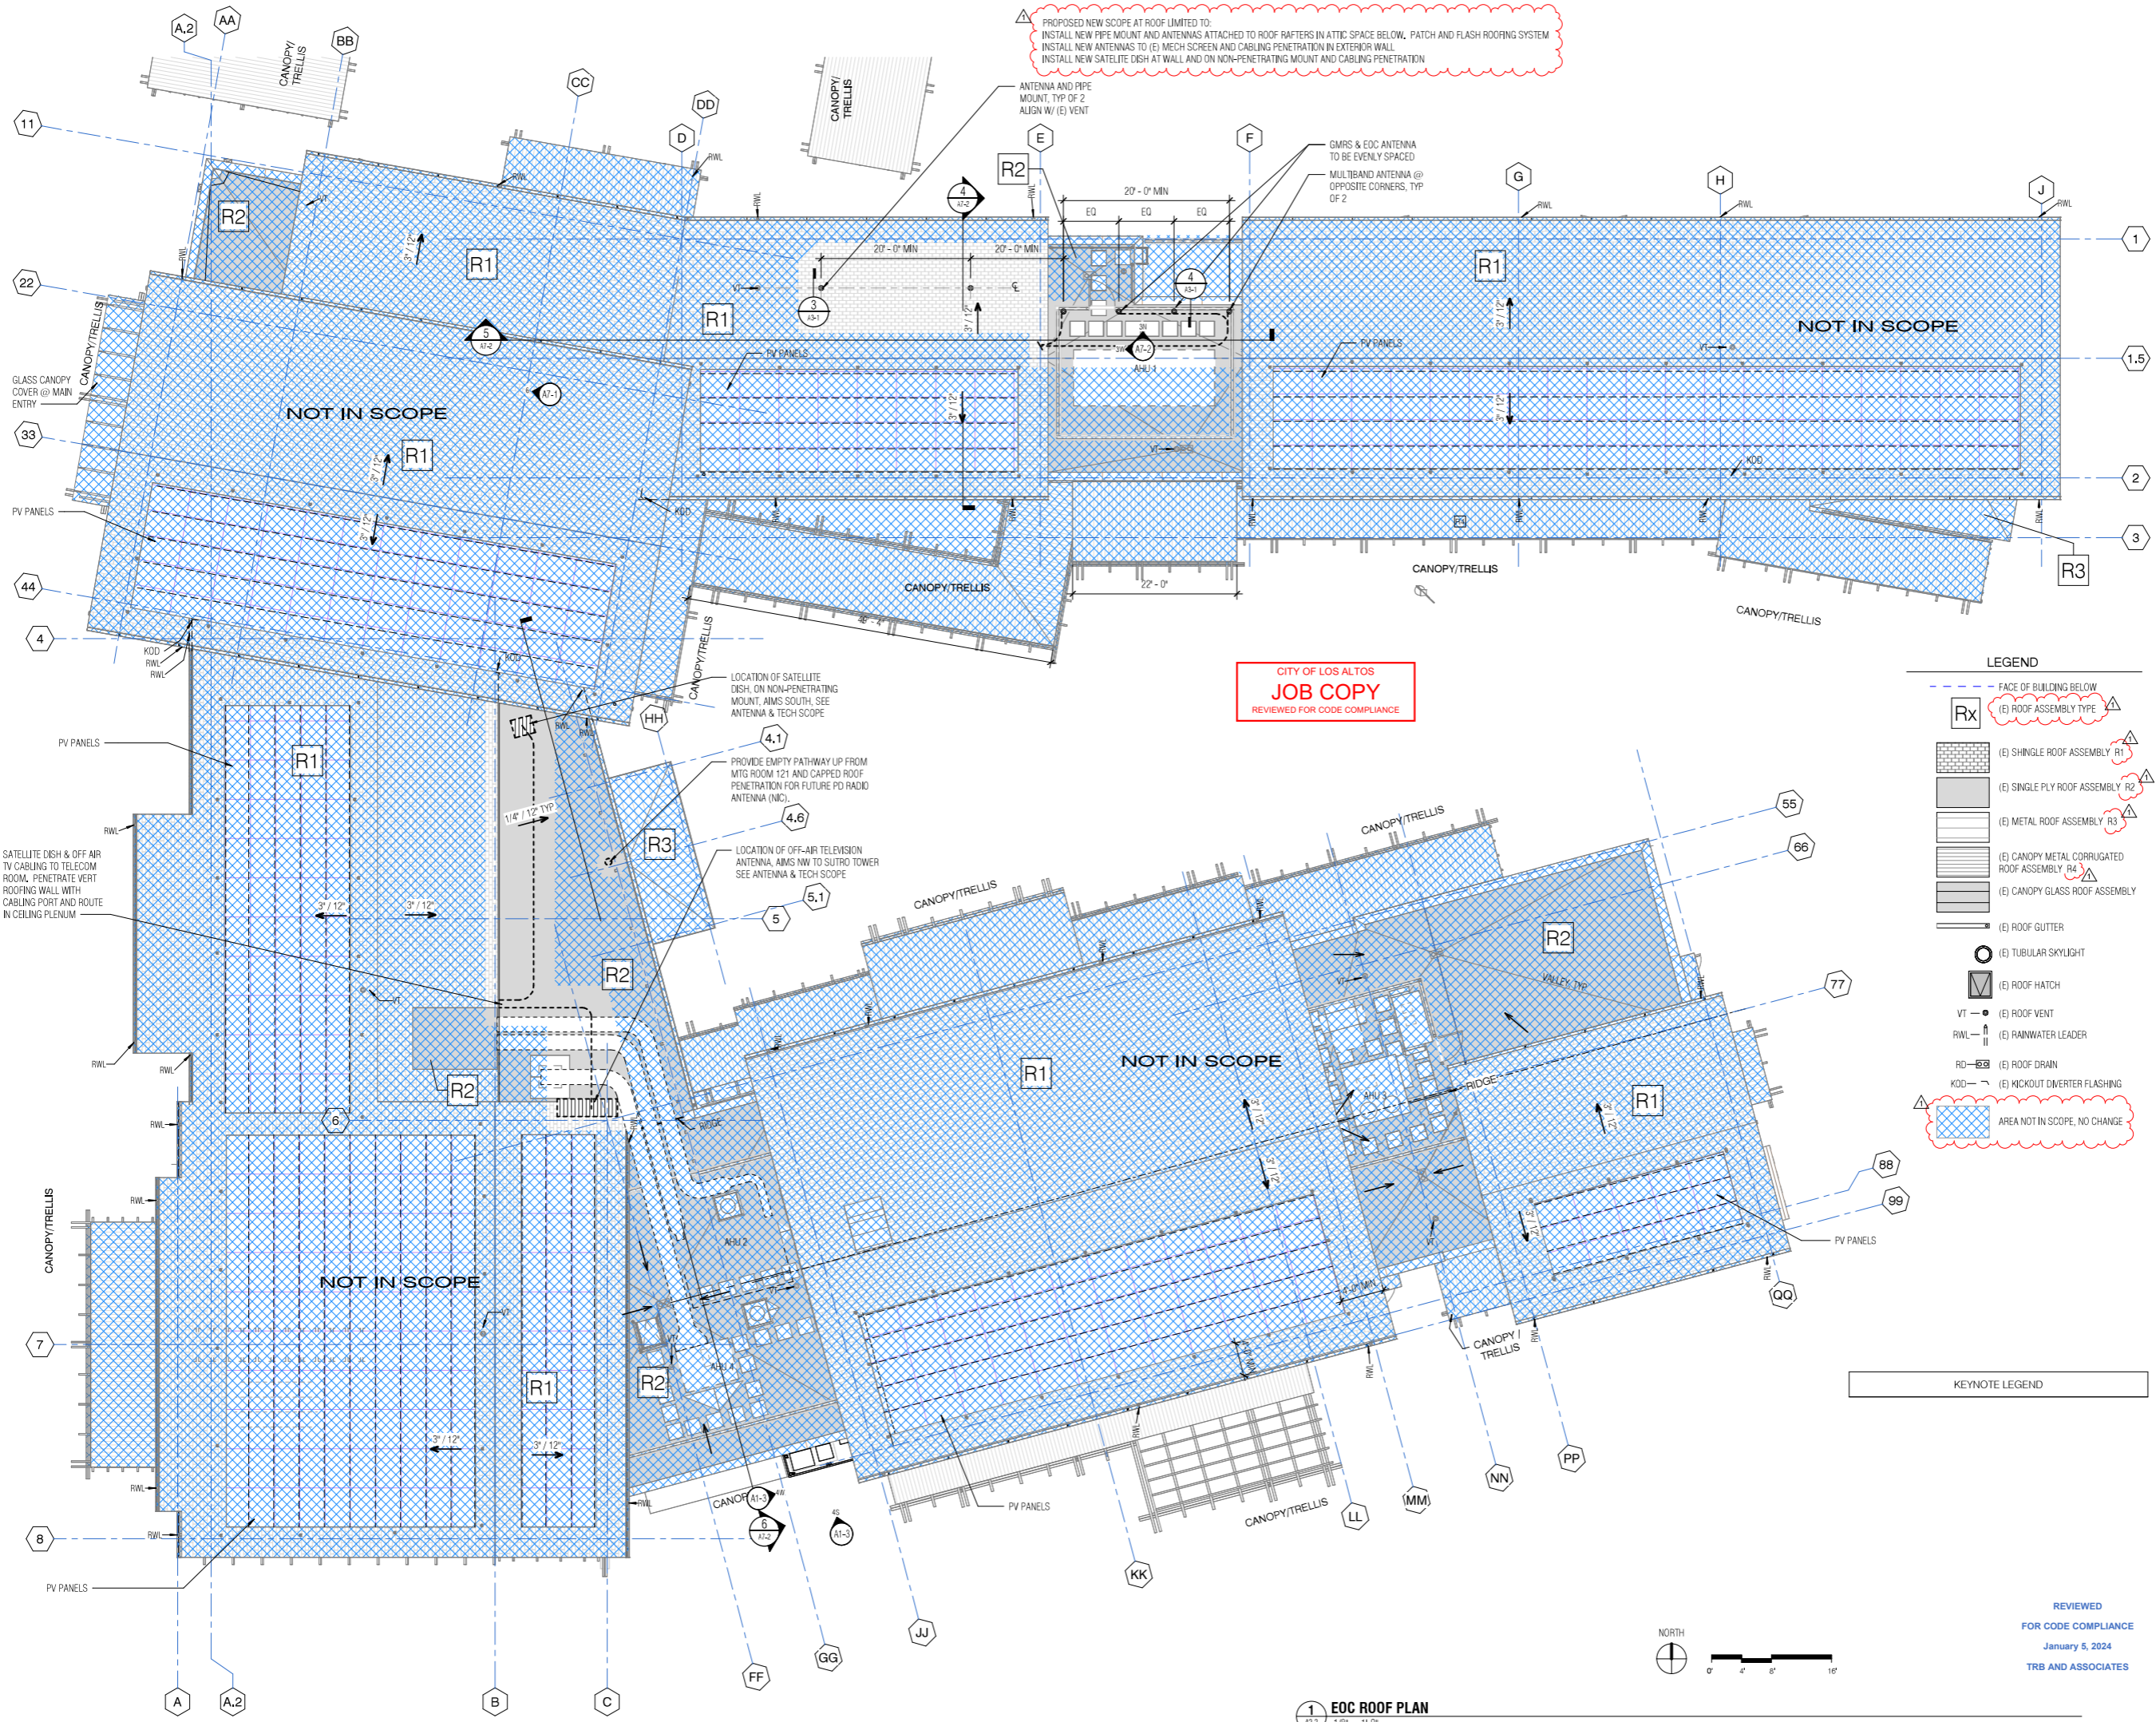


PROPOSED NEW SCOPE AT ROOF LIMITED TO:
 INSTALL NEW PIPE MOUNT AND ANTENNAS ATTACHED TO ROOF RAFTERS IN ATTIC SPACE BELOW. PATCH AND FLASH ROOFING SYSTEM
 INSTALL NEW ANTENNAS TO (E) MECH SCREEN AND CABLING PENETRATION IN EXTERIOR WALL
 INSTALL NEW SATELLITE DISH AT WALL AND ON NON-PENETRATING MOUNT AND CABLING PENETRATION

CITY OF LOS ALTOS
JOB COPY
 REVIEWED FOR CODE COMPLIANCE

- LEGEND**
- FACE OF BUILDING BELOW
 - Rx (E) ROOF ASSEMBLY TYPE
 - (E) SHINGLE ROOF ASSEMBLY R1
 - (E) SINGLE PLY ROOF ASSEMBLY R2
 - (E) METAL ROOF ASSEMBLY R3
 - (E) CANOPY METAL CORRUGATED ROOF ASSEMBLY R4
 - (E) CANOPY GLASS ROOF ASSEMBLY
 - (E) ROOF GUTTER
 - (E) TUBULAR SKYLIGHT
 - (E) ROOF HATCH
 - VT (E) ROOF VENT
 - RWL (E) RAINWATER LEADER
 - RD (E) ROOF DRAIN
 - KOD (E) KICKOUT DIVERTER FLASHING
 - AREA NOT IN SCOPE, NO CHANGE

KEYNOTE LEGEND

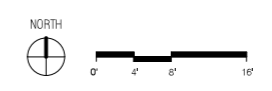

1 EOC ROOF PLAN
 1/8" = 1'-0"

REVIEWED
 FOR CODE COMPLIANCE
 January 5, 2024
 TRB AND ASSOCIATES

APPROVALS

NOLL & TAM
 ARCHITECTS

729 Heinz Avenue
 Berkeley, CA 94710
 tel 510.542.2200
 fax 510.542.2201



SEAL
 PROJECT TITLE
 City of Los Altos
EMERGENCY OPERATION CENTER
 97 Hillview Ave. Los Altos, CA 94022

ISSUE TITLE
PERMIT SET

ISSUE DATE
 AUG 03, 2023
 NOLL & TAM JOB NUMBER
 22203

REVISIONS	DATE	DESCRIPTION
1	11/19/2023	PERMIT PLAN CHECK RESPONSE

SHEET TITLE
EOC ROOF PLAN

SHEET NUMBER
A2-2

11142023 2:29:24 PM Autodesk Docs:Los Altos EOCCLAEDC_Arch_Central_2023.rvt



SEAL



PROJECT TITLE

**City of Los Altos
EMERGENCY OPERATION
CENTER**

97 Hillview Ave. Los Altos, CA
94022

ISSUE TITLE

PERMIT SET

ISSUE DATE **AUG 03, 2023**

NOLL & TAM JOB NUMBER **22203**

REVISIONS


NO.	DATE	DESCRIPTION
1	11/19/2023	PERMIT PLAN CHECK RESPONSE

SHEET TITLE

**EOC REFLECTED
CEILING PLAN**

SHEET NUMBER

A2-3

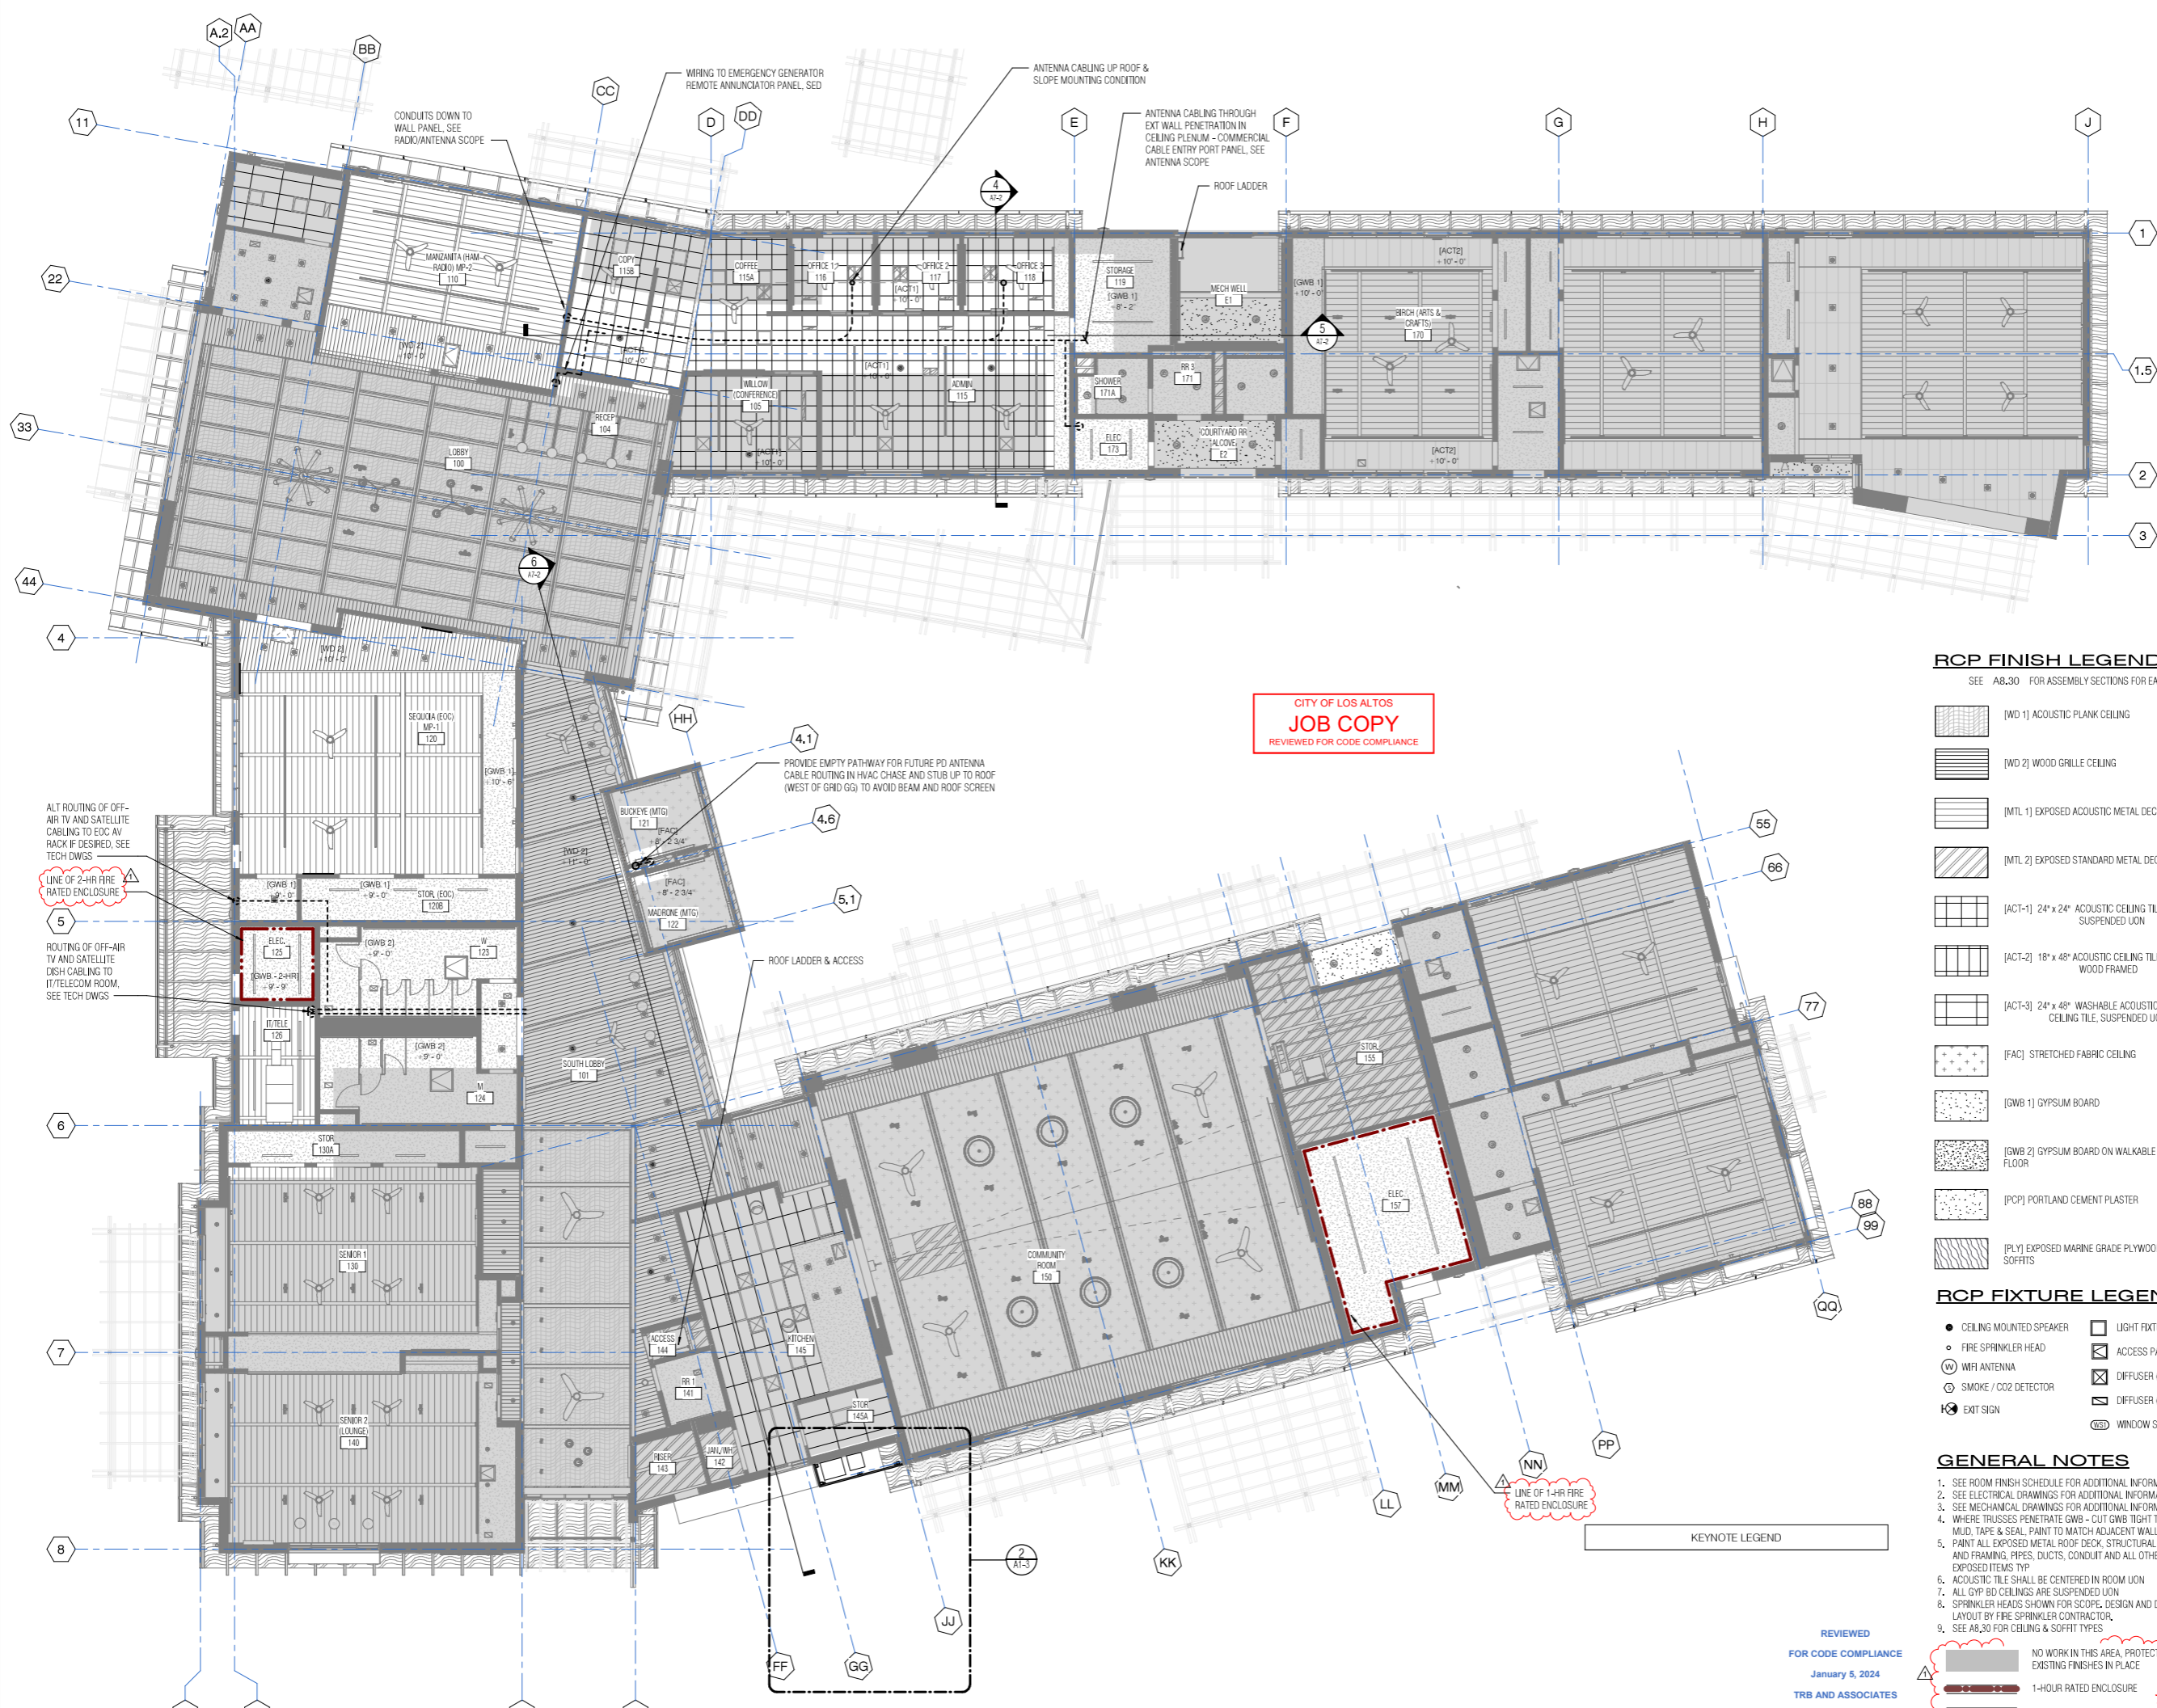

**CITY OF LOS ALTOS
JOB COPY
REVIEWED FOR CODE COMPLIANCE**

RCP FINISH LEGEND

SEE A8.30 FOR ASSEMBLY SECTIONS FOR EACH TYPE.


- [WD 1] ACOUSTIC PLANK CEILING
- [WD 2] WOOD GRILLE CEILING
- [MTL 1] EXPOSED ACOUSTIC METAL DECK
- [MTL 2] EXPOSED STANDARD METAL DECK
- [ACT-1] 24" x 24" ACOUSTIC CEILING TILE, SUSPENDED UON
- [ACT-2] 18" x 48" ACOUSTIC CEILING TILE, WOOD FRAMED
- [ACT-3] 24" x 48" WASHABLE ACOUSTIC CEILING TILE, SUSPENDED UON
- [FAC] STRETCHED FABRIC CEILING
- [GWB 1] GYPSUM BOARD
- [GWB 2] GYPSUM BOARD ON WALKABLE OSB FLOOR
- [PCP] PORTLAND CEMENT PLASTER
- [PLY] EXPOSED MARINE GRADE PLYWOOD SOFFITS

RCP FIXTURE LEGEND

- CEILING MOUNTED SPEAKER
- FIRE SPRINKLER HEAD
- ⊙ WFI ANTENNA
- ⊙ SMOKE / CO2 DETECTOR
- ⊙ EXIT SIGN
- LIGHT FIXTURE
- ⊞ ACCESS PANEL
- ⊞ DIFFUSER (SA)
- ⊞ DIFFUSER (RA)
- ⊞ WINDOW SHADE


GENERAL NOTES

- SEE ROOM FINISH SCHEDULE FOR ADDITIONAL INFORMATION.
- SEE ELECTRICAL DRAWINGS FOR ADDITIONAL INFORMATION.
- SEE MECHANICAL DRAWINGS FOR ADDITIONAL INFORMATION.
- WHERE TRUSSES PENETRATE GWB - CUT GWB TIGHT TO JOISTS, MILD TAPE & SEAL. PAINT TO MATCH ADJACENT WALL.
- PAINT ALL EXPOSED METAL ROOF DECK, STRUCTURAL STEEL AND FRAMING, PIPES, DUCTS, CONDUIT AND ALL OTHER EXPOSED ITEMS TYP.
- ACOUSTIC TILE SHALL BE CENTERED IN ROOM UON
- ALL GYP BD CEILINGS ARE SUSPENDED UON
- SPRINKLER HEADS SHOWN FOR SCOPE. DESIGN AND DETAILED LAYOUT BY FIRE SPRINKLER CONTRACTOR.
- SEE A8.30 FOR CEILING & SOFFIT TYPES

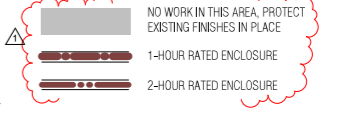


REVIEWED
FOR CODE COMPLIANCE
January 5, 2024
TRB AND ASSOCIATES


REFLECTED CEILING PLAN - EOC
1/8" = 1'-0"

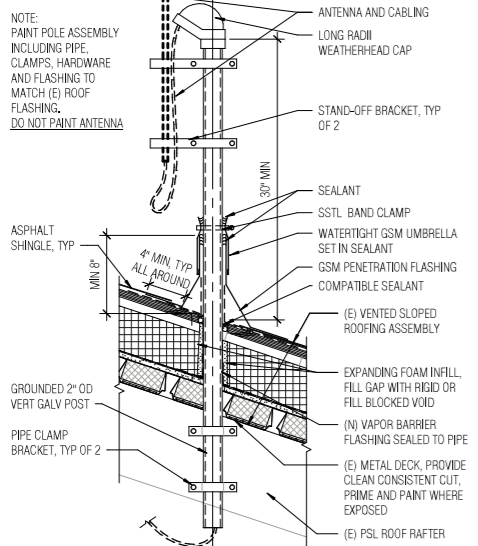

3 EOC TYPICAL PIPE PENETRATION @ SLOPED ROOF ANTENNA
 1 1/2" = 1'-0"

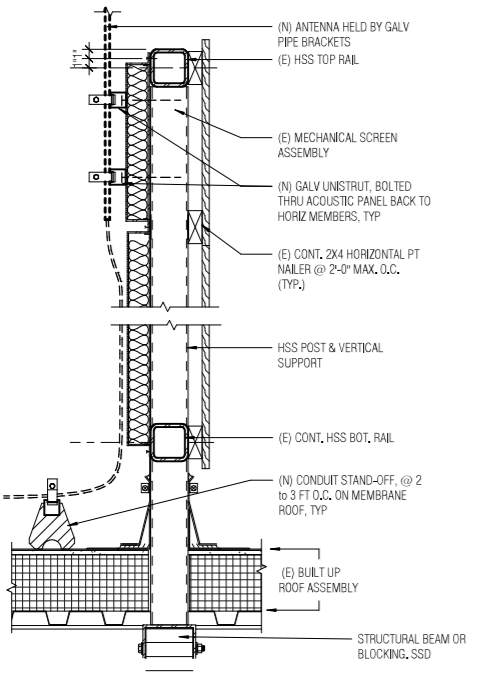

4 EOC ANTENNA MTING @ MECHANICAL ROOF SCREEN
 1 1/2" = 1'-0"

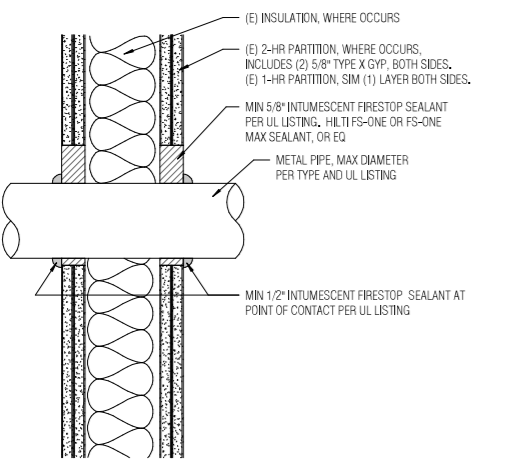

5 PIPE PENETRATION AT FLOOR AND WALL
 3" = 1'-0"



1 ENLARGED FLOOR PLAN - SEQUOIA & MANZANITA
 1/4" = 1'-0"

- GENERAL NOTES**
- REFER TO CIVIL, PLUMBING, ELECTRICAL, AND TELECOM DRAWINGS FOR ADDITIONAL INFORMATION/SCOPE.
 - PROTECT IN PLACE EXISTING ITEMS NOT INDICATED TO BE REMOVED.
 - PROVIDE PATCH AND REPAIR OF EXISTING FINISHES IN KIND WHERE AFFECTED BY WORK.
 - REPAIR PENETRATIONS TO MAINTAIN EXISTING FIRE RATINGS.
 - FOR FIRE RATED PENETRATION DETAILS SEE 5 / AS-1 AND ELEC DRAWINGS
- NO WORK IN THIS AREA. PROTECT EXISTING FINISHES IN PLACE.
- GLASS MARKER BOARD (KEYNOTE 10-01)
- 1.5 HR FIRE RATED ENCLOSURE
- 1.5 HR FIRE RATED ENCLOSURE

CITY OF LOS ALTOS
JOB COPY
 REVIEWED FOR CODE COMPLIANCE

KEYNOTE LEGEND

10-01	GLASS MARKER BOARD
-------	--------------------

APPROVALS

NOLL & TAM ARCHITECTS

729 Heinz Avenue
 Berkeley, CA 94710
 tel 510.542.2200
 fax 510.542.2201



SEAL

APPROVED ARCHITECT
 JANET TAM
 NO. C-14884
 REN. 01-31-25
 STATE OF CALIFORNIA
 Date signed: 11/14/2023

PROJECT TITLE

**City of Los Altos
 EMERGENCY OPERATION
 CENTER**

97 Hillview Ave, Los Altos, CA
 94022

ISSUE TITLE

PERMIT SET

ISSUE DATE **AUG 03, 2023**

NOLL & TAM JOB NUMBER **22203**

REVISIONS

DATE	DESCRIPTION
11/19/2023	PERMIT PLAN CHECK RESPONSE

SHEET TITLE

EOC ENLARGED PLAN

SHEET NUMBER

REVIEWED
 FOR CODE COMPLIANCE
 January 5, 2024
 TRB AND ASSOCIATES

A3-1

11/14/2023 2:30:29 PM Autodesk Docs:Los Altos EOC-COLA-EOC_Arch_Central_2023.rvt

SHEET NOTES

1. REFER TO ELECTRICAL, TELECOM AND RADIO/ANTENNA DRAWINGS FOR ADDITIONAL INFORMATION/SCOPE.
2. PROTECT IN PLACE EXISTING ITEMS NOT INDICATED TO BE REMOVED.
3. PROVIDE PATCH AND REPAIR OF EXISTING FINISHES IN KIND WHERE AFFECTED BY WORK.
4. REPAIR PENETRATIONS TO MAINTAIN EXISTING FIRE RATINGS.

KEYNOTE LEGEND	
10-01	GLASS MARKER BOARD


CITY OF LOS ALTOS
JOB COPY
 REVIEWED FOR CODE COMPLIANCE

NOLL & TAM
ARCHITECTS

729 Heinz Avenue
Berkeley, CA 94710
tel 510.542.2200
fax 510.542.2201



SEAL

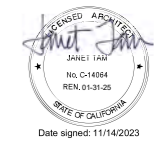

Date signed: 11/14/2023

PROJECT TITLE

City of Los Altos
EMERGENCY OPERATION CENTER

97 Hillview Ave. Los Altos, CA 94022

ISSUE TITLE

PERMIT SET

ISSUE DATE **AUG 03, 2023**

NOLL & TAM JOB NUMBER **22203**

REVISIONS	DATE	DESCRIPTION


SHEET TITLE

EOC INTERIOR ELEVATIONS - MP1, MP2 & MEETING ROOMS

SHEET NUMBER

A7-1

11/14/2023 2:30:42 PM Autodesk Docs://Los Altos EOC/CLAECC_Arch_Central_2023.rvt

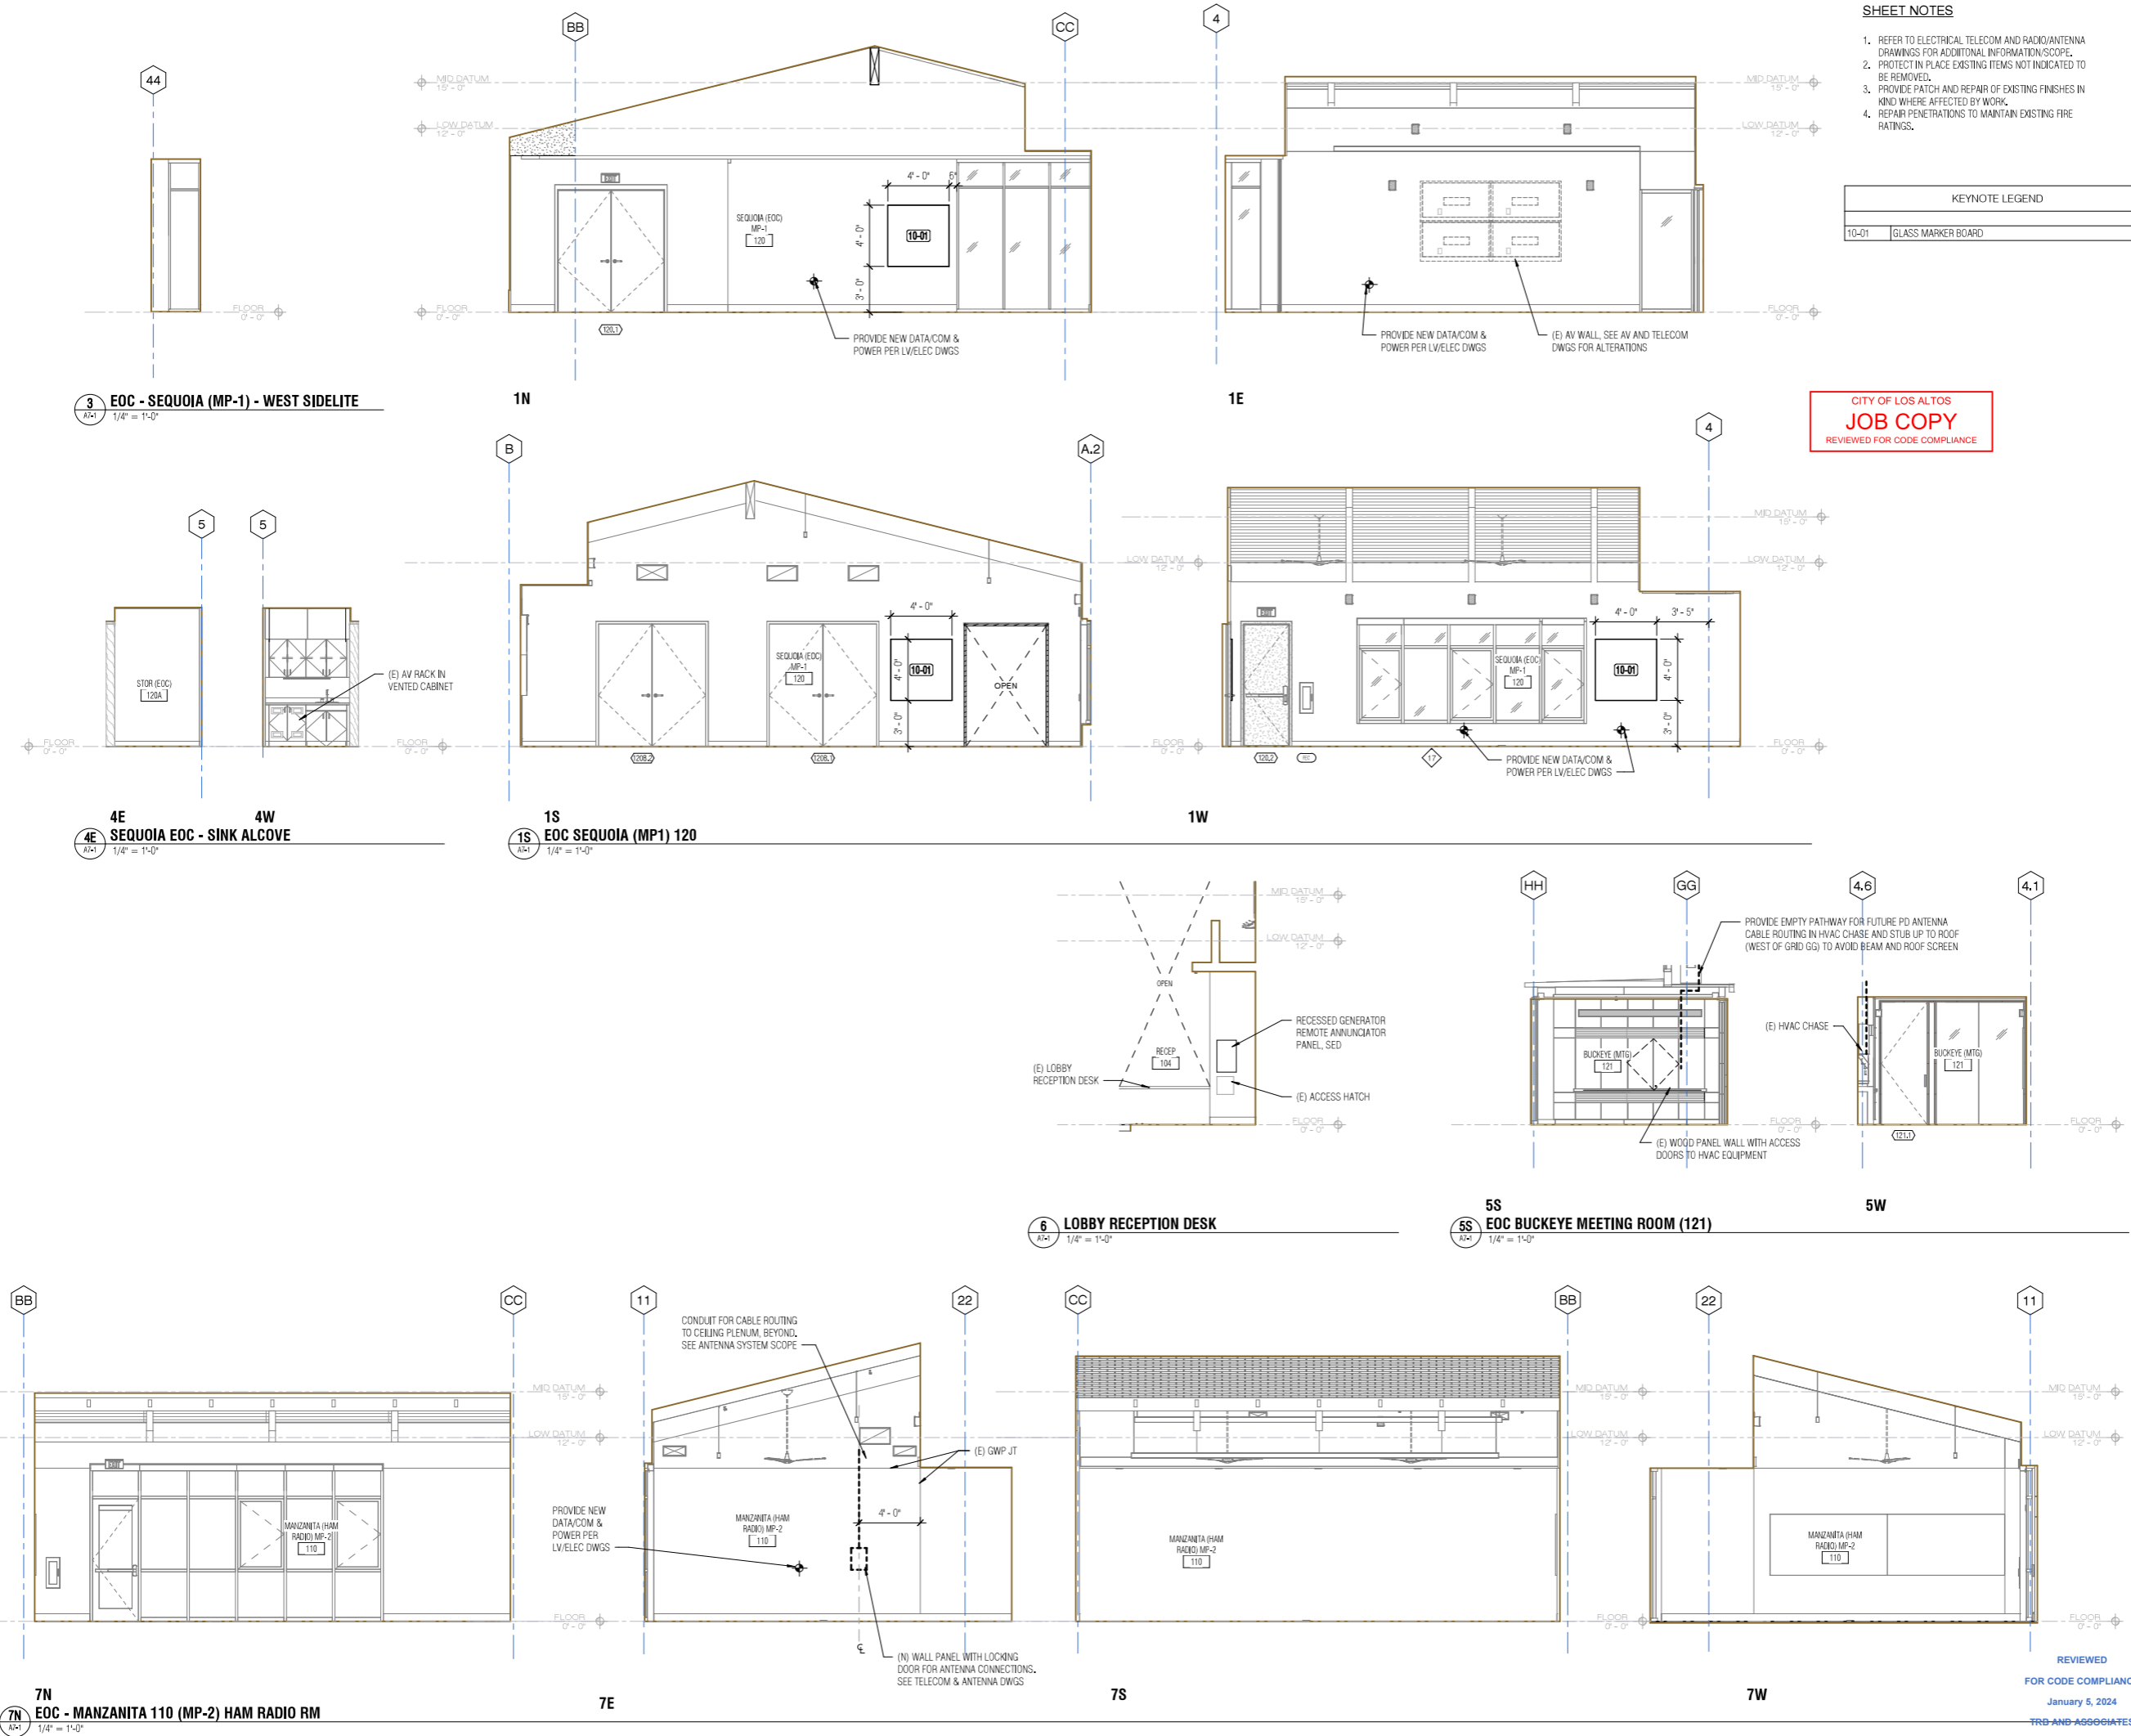

REVIEWED
 FOR CODE COMPLIANCE
 January 5, 2024
 TRB AND ASSOCIATES

SHEET NOTES

- 1. REFER TO ELECTRICAL TELECOM AND RADIO/ANTENNA DRAWINGS FOR ADDITIONAL INFORMATION/SCOPE.
- 2. PROTECT IN PLACE EXISTING ITEMS NOT INDICATED TO BE REMOVED.
- 3. PROVIDE PATCH AND REPAIR OF EXISTING FINISHES IN KIND WHERE AFFECTED BY WORK.
- 4. REPAIR PENETRATIONS TO MAINTAIN EXISTING FIRE RATINGS.

KEYNOTE LEGEND

NOLL & TAM
ARCHITECTS

729 Heinz Avenue
Berkeley, CA 94710
tel 510.542.2200
fax 510.542.2201



CITY OF LOS ALTOS
JOB COPY
REVIEWED FOR CODE COMPLIANCE

SEAL



Date signed: 11/14/2023

PROJECT TITLE

**City of Los Altos
EMERGENCY OPERATION
CENTER**

97 Hillview Ave. Los Altos, CA
94022

ISSUE TITLE

PERMIT SET

ISSUE DATE **AUG 03, 2023**

NOLL & TAM JOB NUMBER **22203**

REVISIONS


NO.	DATE	DESCRIPTION

SHEET TITLE


**EOC INTERIOR
ELEVATIONS -
STORAGE & ROOF
AREAS**

SHEET NUMBER


A7-2

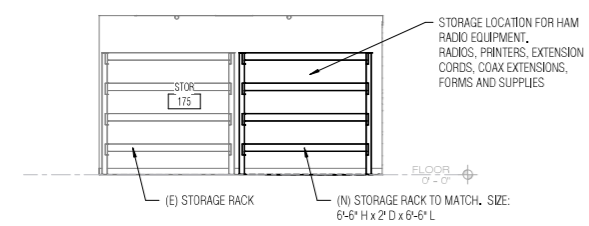


2 EOC 175 - E
A7-2 1/4" = 1'-0"

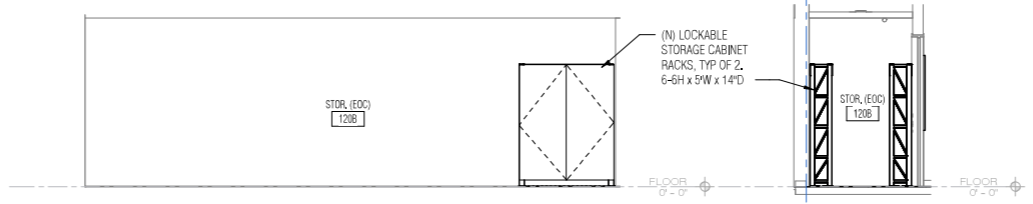


1S EOC 120B MP1 STORAGE ROOM
A7-2 1/4" = 1'-0"

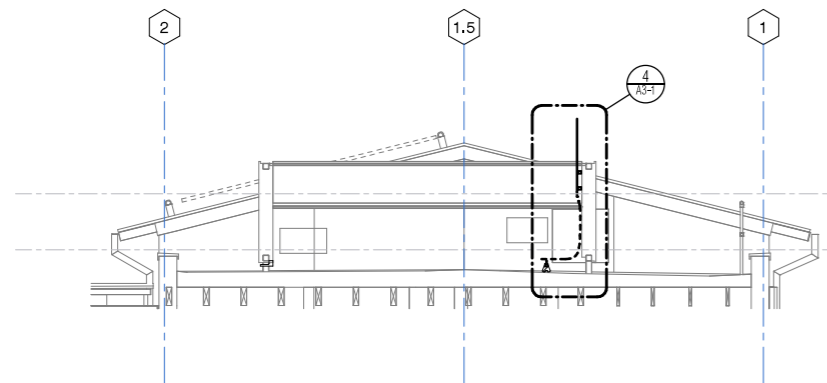


3W EOC ROOF MECH - W
A7-2 1/4" = 1'-0"

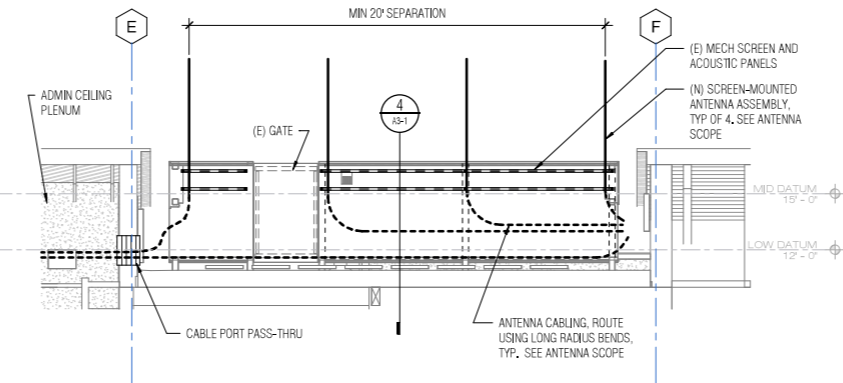



3N

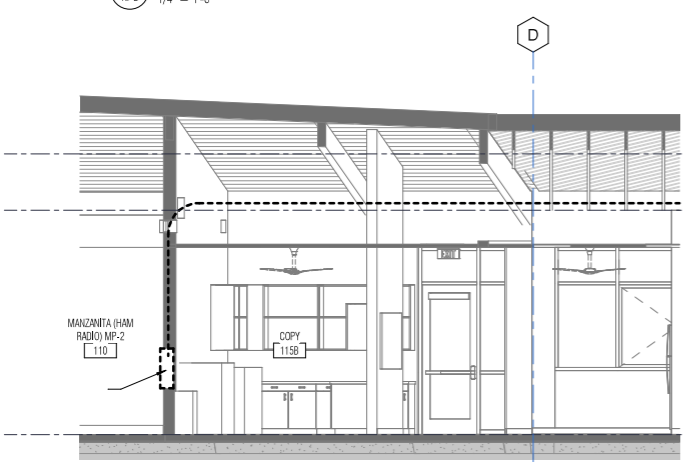

5 EOC LONG SECTION @ ADMIN
A7-2 1/4" = 1'-0"

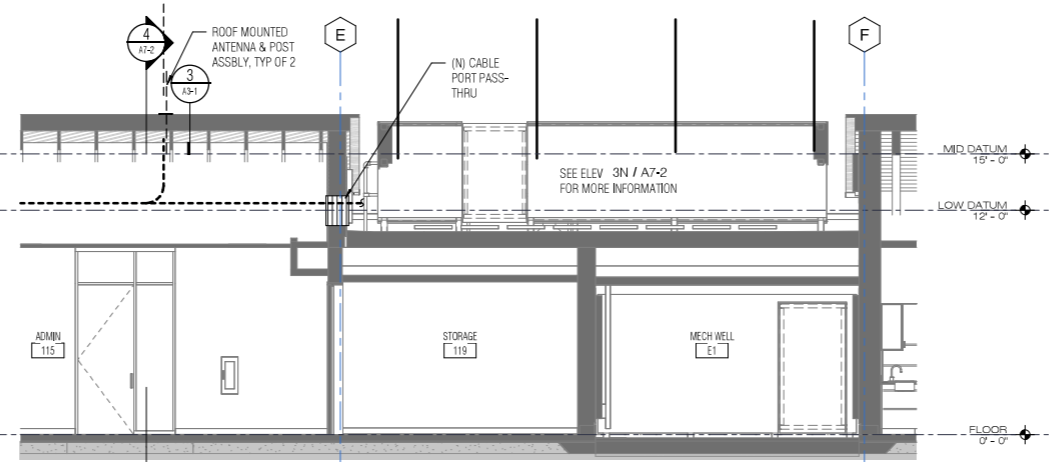

4 EOC CROSS SECTION @ ADMIN
A7-2 1/4" = 1'-0"

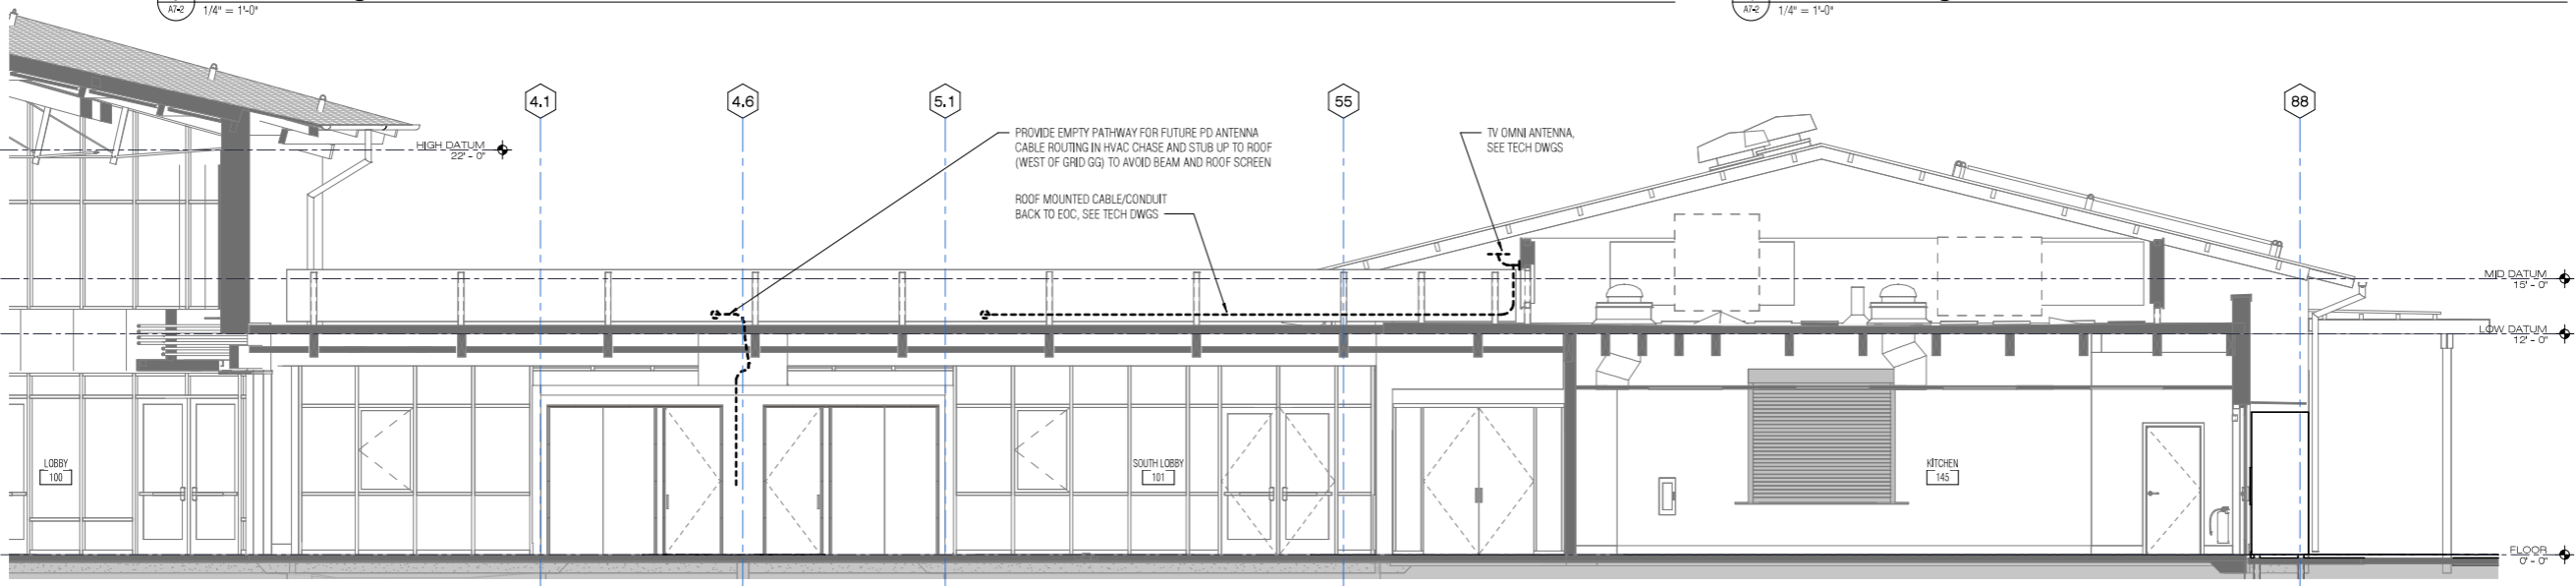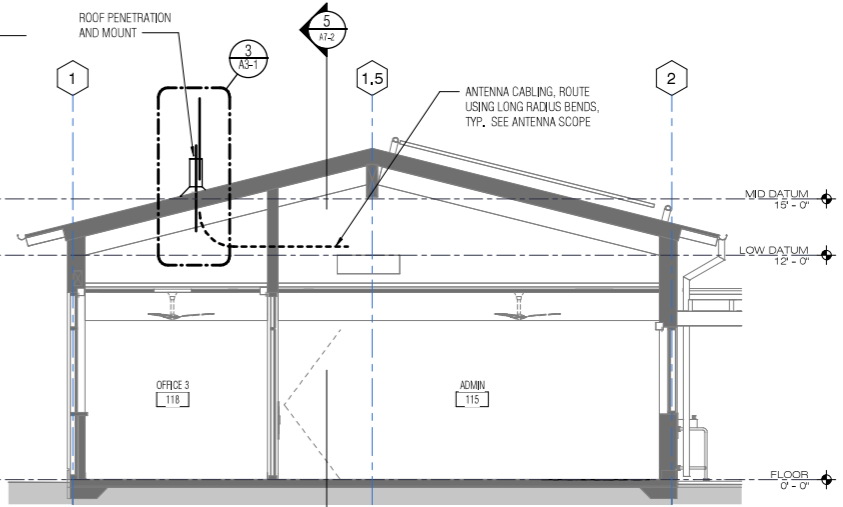

6 EOC LONG SECTION @ SOUTH LOBBY
A7-2 1/4" = 1'-0"

REVIEWED
FOR CODE COMPLIANCE
January 5, 2024
TRB AND ASSOCIATES



729 Heinz Avenue
Berkeley, CA 94710
tel 510.542.2200
fax 510.542.2201



SEAL



Date signed: 11/14/2023

CITY OF LOS ALTOS
JOB COPY
REVIEWED FOR CODE COMPLIANCE

PROJECT TITLE

**City of Los Altos
EMERGENCY OPERATION
CENTER**

97 Hillview Ave. Los Altos, CA
94022

ISSUE TITLE

PERMIT SET

ISSUE DATE **AUG 03, 2023**

NOLL & TAM JOB NUMBER **22203**

REVISIONS	DATE	DESCRIPTION

SHEET TITLE

FINISH SCHEDULE

SHEET NUMBER

A9-1

(E) ROOM FINISH SCHEDULE (EOC) - FOR REFERENCE ONLY

#	Name	Counter Material	Casework Material	Casework Comments	Floor Finish	Base Finish	Ceiling Finish	Ceiling 2 (Soffit) Finish	Wall Finishes				Comments	Room Use	#
									Wall North	Wall East	Wall South	Wall West			
100	LOBBY	-			POLISHED CONCRETE (CONC 1) / ACCENT CARPET [CP2]	6" WOOD	[WD1] ACOUSTIC WOOD PANELIZED PLANK CEILING, [PT-4] ABOVE	[WD2] WOOD GRILLE	PT-1 HIGH / PT-6,1 LOW, FWP-1	[WD2] WOOD GRILLE	PT-1 HIGH / PT-6,1 LOW, FWP-1	[WD2] WOOD GRILLE	SPLIT PAINT COLOR AT SOFFIT, HM DOOR FRAME PAINTED TO MATCH ADJACENT WALL [PT-1]		100
101	SOUTH LOBBY	-			POLISHED CONCRETE (CONC 1) / ACCENT CARPET [CP3]	6" WOOD	[WD1] ACOUSTIC WOOD PLANK AT HIGH CEILING [PT-4] ABOVE	[WD2] WOOD GRILLE AT LOW CEILING	WOOD SIDING AT GL 44	PT-1	-	PT-1, PT-6,2	SEATING NOOKS HAVE WOOD GRILLE SCREEN WALLS, ACCENT PAINT AS SHOWN ON A9,11, HM DOOR FRAMES PAINTED TO MATCH ADJACENT WALL [PT-1]		101
104	RECEP	QUARTZ	WOOD	Reception Desk - Wood, see A8,82	CARPET 1 [CP1] OVER POLISHED CONCRETE (CONC-1)	6" WOOD	-	[WD2] WOOD GRILLE	PT-1 HIGH / PT-6,1 LOW	[WD2] WOOD GRILLE	-	PT-6,1			104
105	CONF.	-			CARPET 1 [CP1]	6" WOOD	[ACT1] (2X2)	-	PT-1	PT-1	PT-1	[WD2] WOOD GRILLE			105
110	MP 2	-			POLISHED CONCRETE (CONC-1)	6" WOOD	[MTL1] EXPOSED ACOUSTICAL METAL DECK	[WD2] WOOD GRILL	PT-1	PT-1	PT-1	PT-1			110
115	ADMIN	CORIAN	PLAM	AV for Conf, Room in Admin Area	CARPET 1 [CP1]	4" RESILIENT	[ACT1] (2X2)	GYPSUM BOARD [PT-2]	PT-1	PT-1	PT-1	PT-1	COORDINATE LAYOUT PATTERN OF CARPET AND CEILING TILE WITH BREAK ALONG GRIDLINE DD, HM DOOR FRAME PAINTED TO MATCH ADJACENT WALL [PT-1]		115
115A	COFFEE	CORIAN	PLAM	Sink	CARPET 1 [CP1]	4" RESILIENT	[ACT1] (2X2)	-	PT-1	PT-1	PT-1	PT-1			115A
115B	COPY	CORIAN	PLAM	Open Cabinets	CARPET 1 [CP1]	4" RESILIENT	[ACT1] (2X2)	-	PT-1	PT-1	PT-1	PT-1	COORDINATE LAYOUT PATTERN OF CARPET AND CEILING TILE WITH BREAK ALONG GRIDLINE DD.		115B
116	OFFICE 1	-			CARPET 1 [CP1]	4" RESILIENT	[ACT1] (2X2)	-	PT-1	PT-1	PT-1	PT-1			116
117	OFFICE 2	-			CARPET 1 [CP1]	4" RESILIENT	[ACT1] (2X2)	-	PT-1	PT-1	PT-1	PT-1			117
118	OFFICE 3	-			CARPET 1 [CP1]	4" RESILIENT	[ACT1] (2X2)	-	PT-1	PT-1	PT-1	PT-1			118
119	STORAGE	-		METAL SHELVING	RESILIENT [RS1]	4" RESILIENT	[ACT1] (2X2)	-	PT-1	PT-1	PT-1	PT-1	HM DOOR FRAME PAINTED TO MATCH ADJACENT WALL [PT-1]		119
120	MP 1	-			CARPET 1 [CP1]	4" RESILIENT	[MTL1] EXPOSED ACOUSTICAL METAL DECK	[WD2] WOOD GRILLE/ GYPSUM BOARD [PT-2]	PT-1	PT-1	PT-1	PT-1	HM DOOR FRAME PAINTED TO MATCH ADJACENT WALL [PT-1]		120
120A	STOR	CORIAN	PLAM	Sink, AV in Lower Cabinet	CARPET 1 [CP1]	4" RESILIENT	GYPSUM BOARD [PT-2]	-	PT-1	PT-1	PT-1	PT-1			120A
120B	STOR.	-			CARPET 1 [CP1]	4" RESILIENT	GYPSUM BOARD [PT-2]	-	PT-1	PT-1	PT-1	PT-1			120B
121	MTG	-	WOOD	HVAC unit in Casework	CARPET 1 [CP1]	4" RESILIENT	[FAC] STRETCHED FABRIC CEILING	-	PT-1	PT-1	PT-1	PT-1			121
122	MTG	-	WOOD	HVAC unit in Casework	CARPET 1 [CP1]	4" RESILIENT	[FAC] STRETCHED FABRIC CEILING	-	PT-1	PT-1	PT-1	PT-1			122
123	W	QUARTZ	-	Sinks	CERAMIC FLOOR TILE (CT1)	NA - ELIMINATED PER ASI-051	WASHABLE GYPSUM BOARD [PT-5,2]	-	CT-2 TO + 7'-2" AFF	CT-2 TO + 7'-2" AFF	CT-2 TO + 7'-2" AFF	CT-2 TO + 7'-2" AFF	PROVIDE FULL-HT WATER RESISTANT GWB TO CEILING, TYP AT CERAMIC TILE, PAINT ABOVE CT [PT-5,1]		123
124	M	QUARTZ	-	Sinks	CERAMIC FLOOR TILE (CT1)	NA - ELIMINATED PER ASI-051	WASHABLE GYPSUM BOARD [PT-5,2]	-	CT-2 TO + 7'-2" AFF	CT-2 TO + 7'-2" AFF	CT-2 TO + 7'-2" AFF	CT-2 TO + 7'-2" AFF	PROVIDE FULL-HT WATER RESISTANT GWB TO CEILING, TYP AT CERAMIC TILE, PAINT ABOVE CT [PT-5,1]		124
125	ELEC.	-			BF CONCRETE [CONC-2]	4" RESILIENT	GYPSUM BOARD - 2HR	-	-	-	-	-	TAPE AND PRIME		125
126	IT/TELE	-			ANTI STATIC [AN-ST]	4" RESILIENT	[MTL2] EXPOSED STRUCTURE	-	-	-	-	-	TAPE AND PRIME		126
130	SENIOR 1	-			CARPET 1 [CP1]	4" RESILIENT	[MTL1] EXPOSED ACOUSTICAL METAL DECK	GYPSUM BOARD [PT-2]	PT-1	PT-1 / PT-6,3 AT ENTRY	PT-1 HIGH / PT-6,3 LOW	PT-1 / PT6,3 LOW	ACCENT PAINT PER A9,11, HM DOOR FRAMES PAINTED TO MATCH ADJACENT WALLS [PT-1]		130
130A	STOR	-			CARPET 1 [CP1]	4" RESILIENT	GYPSUM BOARD [PT-2]	-	PT-1	PT-1	PT-1	PT-1	HM DOOR FRAMES PAINTED TO MATCH ADJACENT WALLS [PT-1]		130A
143	RISER	-			BF CONCRETE [CONC-2]	4" RESILIENT	[MTL2] EXPOSED STRUCTURE	-	PT-1	PT-1	PT-1	PT-1			143
144	ACCESS	-			BF CONCRETE [CONC-2]	4" RESILIENT	[MTL2] EXPOSED STRUCTURE	-	PT-1	PT-1	PT-1	PT-1			144
145A	STOR	-		Kitchen Shelving - Stainless Steel	EPOXY [EPK]	6" INTEGRAL COVE EPOXY	[ACT3] WASHABLE ACOUSTIC CEILING TILE	-	PT-5,1	PT-5,1	PT-5,1	PT-5,1			145A
155	STOR.	-			BF CONCRETE [CONC-2]	4" RESILIENT	[MTL2] EXPOSED STRUCTURE	-	PT-1	PT-1	PT-1	PT-1	HM DOOR FRAME PAINTED TO MATCH ADJACENT WALL [PT-1]		155
156	MECH ACCESS ATTIC	-			PLYWOOD	-	[MTL2] EXPOSED STRUCTURE	-	-	-	-	-			156
157	ELEC	-			BF CONCRETE [CONC-2]	4" RESILIENT	GYPSUM BOARD - 1HR	-	-	-	-	-	TAPE AND PRIME		157
170A	STOR	-		Owner Furnished Storage Shelves	RESILIENT [RS1]	4" RESILIENT	GYPSUM BOARD [PT-2]	-	PT-1	PT-1	PT-1	PT-1	HM DOOR FRAMES PAINTED TO MATCH ADJACENT WALLS [PT-1]		170A
171A	SHOWER	-			CERAMIC TILE [CT-5]	NA - ELIMINATED PER ASI-051	WASHABLE GYPSUM BOARD [PT-5,2]	-	CT-3 TO + 7'-2" AFF	CT-3 TO + 7'-2" AFF	CT-3 TO + 7'-2" AFF	CT-3 TO + 7'-2" AFF	PROVIDE FULL-HT WATER RESISTANT GWB TO CEILING, TYP AT CERAMIC TILE, PAINT ABOVE CT [PT-5,1], HM DOOR FRAME PAINTED TO MATCH ADJACENT WALL [PT-5,1]		171A
173	ELEC	-			BF CONCRETE [CONC-2]	4" RESILIENT	[MTL2] EXPOSED STRUCTURE	-	-	-	-	-	TAPE AND PRIME		173
175	STOR	-		Owner Furnished Storage Shelves	RESILIENT [RS1]	4" RESILIENT	GYPSUM BOARD [PT-2]	-	PT-1	PT-1	PT-1	PT-1	HM DOOR FRAMES AND DOORS PAINTED TO MATCH ADJACENT WALLS [PT-1]		175

SECTION 03 30 00 - CONCRETE

CF-1 BOARD-FORMED CONCRETE

SECTION 03 35 44 - POLISHED CONCRETE FINISHING

CONC-1 AGGREGATE EXPOSURE: MEDIUM COURSE
GLOSS APPEARANCE: HIGH GLOSS
PRODUCT INSTALLED:

SECTION 06 20 00 - FINISH CARPENTRY

WOOD WALL BASE

WD-1: LOCATION: NOT USED
COLOR AND FINISH: MATCH EXISTING
HEIGHT: 4"

SECTION 06 41 00 - ARCHITECTURAL WOODWORK

PLASTIC LAMINATE:

PL-1: LOCATION: PER SCHEDULE
MANUFACTURER: WILSONART
COLOR: BURNISHED CHESTNUT, 4796-60
FINISH / TEXTURE: TBD

WOOD VENEER:

WV-1: LOCATION: PER SCHED (LOBBY, MTG RMS 121 & 122)
SPECIES: WESTERN RED CEDAR
GRADE & CUT: PREMIUM GRADE
VENEER MATCHING: BOOK MATCH
STAIN COLOR & SHEEN: TBD

SOLID WOOD TRIM & BASE:

LOCATION: WALL TRIM IN LOBBY AND WOOD BASE
SPECIES: WESTERN RED CEDAR
GRADE & CUT: PREMIUM GRADE, QUARTER SAWN
FINISH: CLEAR

SECTION 06 83 16 - FIBERGLASS REINFORCED PANELING

PLASTIC PANELING

FRP-1: MANUFACTURER: MARLITE
PRODUCT: CLASS A FRP PANELS
SURFACE FINISH: SMOOTH
COLOR: MANUFACTURERS STANDARD WHITE

SECTION 07 31 13 - ASPHALT SHINGLES

R-1 MANUFACTURER: GAF
PRODUCT: TIMBERLINE HD REFLECTOR SERIES
COLOR: 39
SRI VALUE: 39

SECTION 07 42 09 - EXTERIOR ACOUSTIC ROOF SCREEN PANELS

MANUFACTURER: IAC NOISE CONTROL
PRODUCT: NOISHIELD SLIMLINE, SURFACE MOUNTED
THICKNESS: 2-1/2-INCHES
FINISH: POWDER COATED
COLOR: FROM MANUFACTURERS STANDARD FULL RANGE
NRC: 0,90

SECTION 07 42 53 - FIBER CEMENT RAINSCREEN PANELS

FIBER CEMENT WALL PANEL

MANUFACTURER: EQUITONE
MODULAR SIZE: VARIES
THICKNESS: 1/2-INCH
FINISH: SMOOTH & TEXTURED
JOINTS: FLUSH, OPEN, NO GROUT

SECTION 07 46 23 - WOOD SIDING

SIDING SPECIES AND GRADE: GRADE A WESTERN RED CEDAR
SURFACE TEXTURE: SANDED
PATTERN: SMOOTH-FACED, T&G OR OPEN JOINT SLATS AS SHOWN IN DWGS
THICKNESS: 1-INCH THICK NOMINAL
FASTENERS: STAINLESS STEEL BUGLE-HEAD SQUARE OR STAR DRIVE SCREWS
ACCESSORIES: STARTER STRIPS, EDGE TRIM, CORNER CAP, TOP CAP AND OTHER ITEMS NEEDED AND AS SHOWN IN DWGS

SECTION 07 46 23 - WOOD SIDING, CONT

NATURAL OIL WATERBORNE WOOD STAIN
MANUFACTURER: TIMBER PRO COATINGS
PRODUCT SYSTEM: LOG AND SIDING SMOOTH FORMULA
FINISH: TRANSPARENT SERIES STAIN (TWO COATS REQ'D & UV TOP COAT)
COLOR: TR 12 WOODLANDS

SECTION 09 24 00 - EXTERIOR CEMENT PLASTERING

BASE COAT SYSTEM: QUICKKRETE - ONE COAT FRS & PAREX MESH
PRIMER: PAREX ACRYLIC PRIMER
FINISH: LA HABRA ACRYLIC FINISH
COLOR: ALMOND BEIGE
TEXTURE: TO MATCH EXISTING

SECTION 09 30 00 - CERAMIC TILING

FLOOR TILE CT-1 MANUFACTURER: MOSA
PRODUCT/SERIES: GLOBAL COLLECTION / GRIPGRIP
MODULAR SIZE: 12 X 12
COLOR: SMALL SPECKLED WARM GREY 76640
FINISH: SMOOTH (V)
GROUT: PRISM #185 NEU TAUPÉ

WALL TILE CT-2

MANUFACTURER: MOSA
PRODUCT/SERIES: MURALS LINES
MODULAR SIZE: 15 cm X 15 cm
COLOR: BRIGHT WHITE
FINISH: GLOSS 36510
GROUT: PRISM #381 BRIGHT WHITE

WALL TILE CT-3

MANUFACTURER: MOSA
PRODUCT/SERIES: GLOBALGRIP
MODULAR SIZE: 6 X 6
COLOR: PLAIN PORCELAIN WHITE #76010V
GROUT: PRISM #381 BRIGHT WHITE

COVE BASE TILE CT-4

MANUFACTURER: MOSA
PRODUCT: DP 3 X 6 COVE BASE TO MATCH FLOOR TILE
MODULAR SIZE: 3 X 6
COLOR & FINISH:

SECTION 09 51 00 - ACOUSTICAL CEILINGS

ACOUSTICAL TILE CEILINGS:

ACT-1 MANUFACTURER: (BASIS OF DESIGN) ARMSTRONG OR SIM
PRODUCT: DUNE SECOND LOOK II, SCORED REGULAR
ITEM NO.: 2722
EDGE PROFILE: 9/16" ANGLED REGULAR
TILE EDGE: SQUARE REGULAR 9/16
GRID STYLE: REGULAR 9/16" SUPRAFINE BY ARMSTRONG
SIZE: 2' X 4' X 3/4"
COLOR: WHITE

ACT-2

MANUFACTURER: (BASIS OF DESIGN) ARMSTRONG OR SIM
PRODUCT: ULTIMA
ITEM NUMBER: 1516
EDGE PROFILE: 15/16" BEVELED REGULAR
SIZE: 18" X 48"
COLOR: WHITE

SECTION 09 54 26 - SUSPENDED WOOD CEILINGS

WOOD VENEER ACOUSTICAL CEILING PLANKS:

WD-1 MANUFACTURER: ARMSTRONG
PRODUCT: LQ2-800-C-MP, 0552-0
DESCRIPTION: LINEAR OPEN SERIES 2 - 8-IN PLANK (MICROPERF)
JOINT: 3/8"
SPECIES: WESTERN RED CEDAR
COLOR / FINISH: CLEAR / SATIN 192277-1
PERF PATTERN: 0,552MM PERF SPACED 2MM O.C. W/ OFFSET ALIGNMENT

SOLID WOOD SLAT PANEL:

WD-2 MANUFACTURER: ACOUSTICAL MATERIALS SERVICES
PRODUCT: GB1-6150-C
DESCRIPTION: WOOD GRILLE BACKER SERIES W/ BLACK SCRIM
SIZE: 18" X 48"
SPECIES: POPLAR TO MATCH WESTERN RED CEDAR
COLOR / FINISH: SATIN 192277-2

SECTION 09 54 43 - STRECHED FABRIC CEILING SYSTEMS

FAC MANUFACTURER: CONNED
SYSTEM: EUROSPLAN
CORE THICKNESS: 1" FIBERGLASS
FABRIC COLOR: CLASSIC WHITE

SECTION 09 65 00- RESILIENT FLOORING & BASE

RESILIENT SHEET FLOORING (RUBBER)

RS-1 MANUFACTURER: MANNINGTON
PRODUCT: TELES
SIZES: 35" X 35", 17,5" X 35"
COLOR: BEACH STONE
THICKNESS: 1/8"

LVT RS-2

MANUFACTURER: MANNINGTON
PRODUCT: SPACIA LVT WOOD
COLOR: LIMED WOOD NATURAL 48
SIZE: 7,25" X 48"
THICKNESS: 0,098"

RESILIENT FLOORING (ANTI-STATIC)

RS-2 MANUFACTURER: FLEXCO
PRODUCT: CONDUCTIVE & STATIC DISSIPATIVE SOLID VINYL
COLOR: WHITE /BLUE 69
SIZE: TO MATCH EXISTING
THICKNESS: 1/8"

RESILIENT WALL BASE:

RB-1: MANUFACTURER: BURKE
PRODUCT: TYPE TP - THERMOPLASTIC RUBBER GROUP I
COLOR: 050 MOONBEAM
HEIGHT: 4"
PROFILE: COVED (TOED)

SECTION 09 68 13 - TILE CARPETING

CARPET TILES:

CPT-1: MANUFACTURER: MASLAND
PRODUCT LINE: UNDER THE WIRE
STYLE NO.: 1518
COLOR: 51807 SUGGESTIVE
TILE SIZE: 24" X 24"

CPT-2:

MANUFACTURER: FLOOR
PRODUCT LINE: OASIS RETREAT
SIZE: 19" X 19"
COLOR: MAHOGANY

CPT-3:

MANUFACTURER: FLOOR
PRODUCT LINE: PALM READER
SIZE: 19" X 19"
COLOR: KALE

CPT-4:

MANUFACTURER: FLOOR
PRODUCT LINE: SKYFALL
SIZE: 19" X 19"
COLOR: TURQUOISE

SECTION 09 77 23 - FABRIC WRAPPED PANELS

STANDARD FABRIC-WRAPPED PANELS

FWP-1 MANUFACTURER: G&S ACOUSTICS
PRODUCT: ACOUSTI-PANEL (AP1)
EDGE: SQUARE, WRAPPED
FABRIC MANUF: MAHARAM
FABRIC PRODUCT NAME: MESSENGER
FABRIC COLOR: 058 SNOW


TACKABLE WALL PANELS

IWP-2 MANUFACTURER: G&S ACOUSTICS
PRODUCT: ACOUSTI-TACK (ATF)
EDGE: SQUARE, WRAPPED
FABRIC MANUF: CARNEGIE
FABRIC PRODUCT NAME: XOREL
FABRIC COLOR: NEXUS 6425 910


SECTION 09 90 00 - PAINTING AND COATING

TYPICAL INTERIOR PAINT FINISHES:


CEILINGS & SO

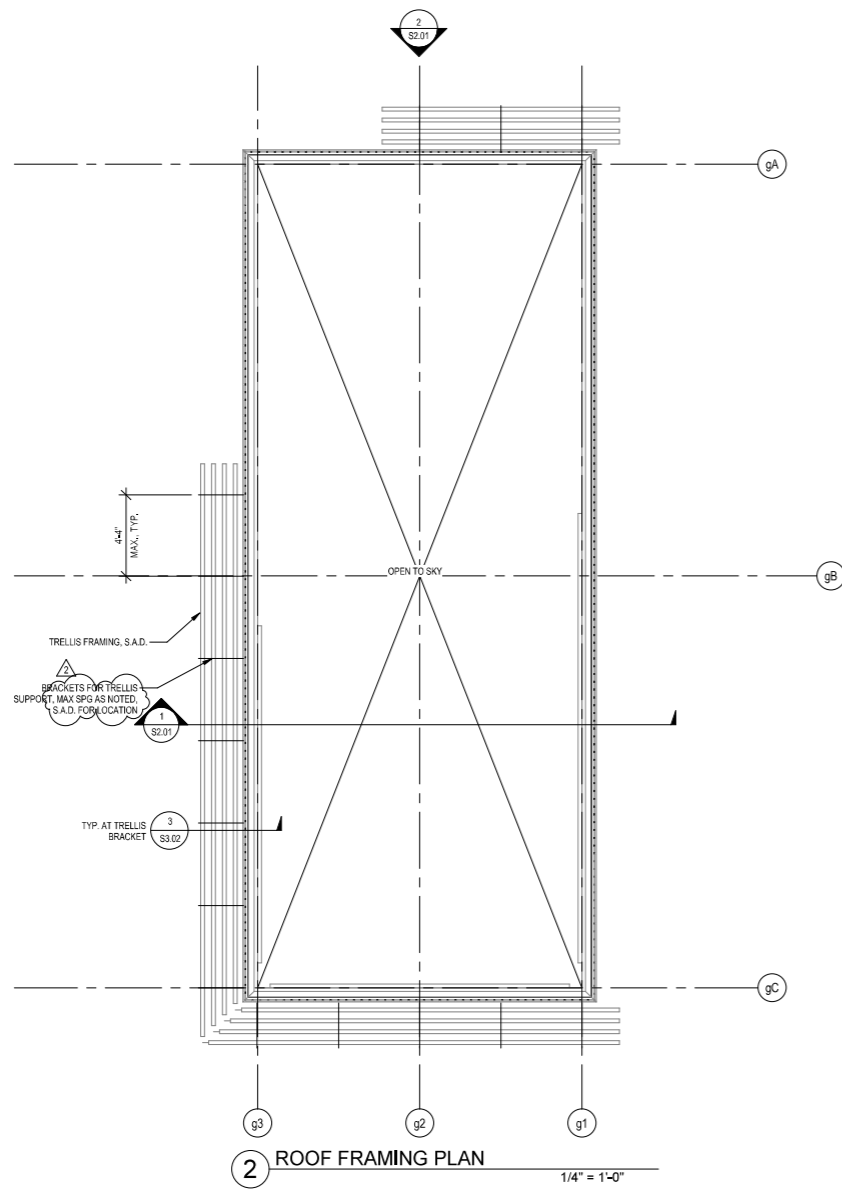

CITY OF LOS ALTOS
JOB COPY
REVIEWED FOR CODE COMPLIANCE

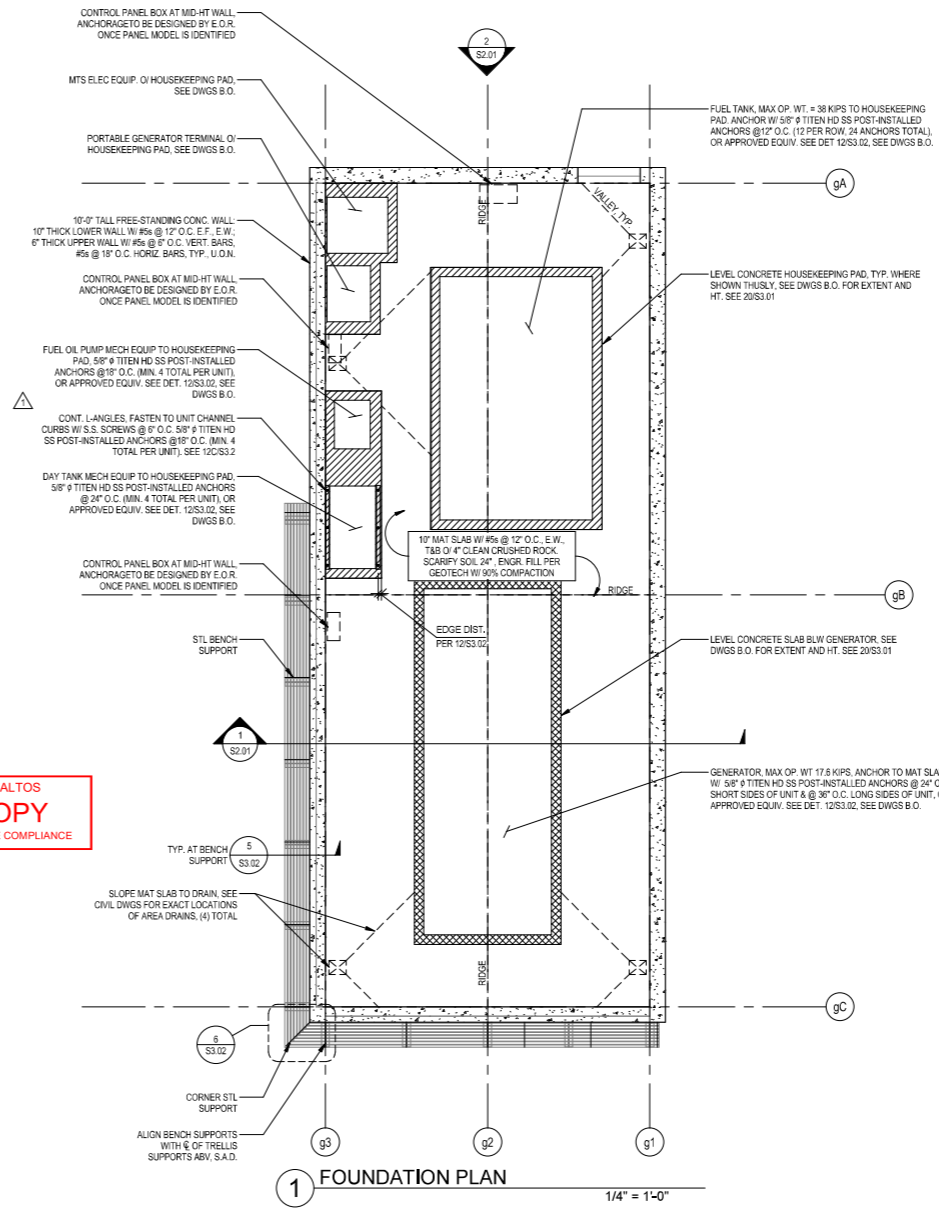

1/21/2023 10:47:55 AM C:\Users\mhammond\Documents\17075_0312023_mh\mhammond\17116.rvt

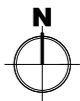

REVIEWED
FOR CODE COMPLIANCE
January 5, 2024
TRB AND ASSOCIATES

PROJECT TITLE
**Los Altos EOC
GENERATOR
ENCLOSURE**

97 Hillview Ave.
Los Altos, CA 94022

ISSUE TITLE
PERMIT SET


ISSUE DATE
AUG 03, 2023

N&T JOB NUMBER
22203

REVISIONS	DATE	DESCRIPTION
1	1/15/2023	PERMIT PLAN CHECK RESPONSE
2	12/18/2023	PLAN CHECK RESUBMITTAL


SHEET TITLE
**FOUNDATION AND
ROOF FRAMING PLANS**

SHEET NUMBER
S1.00

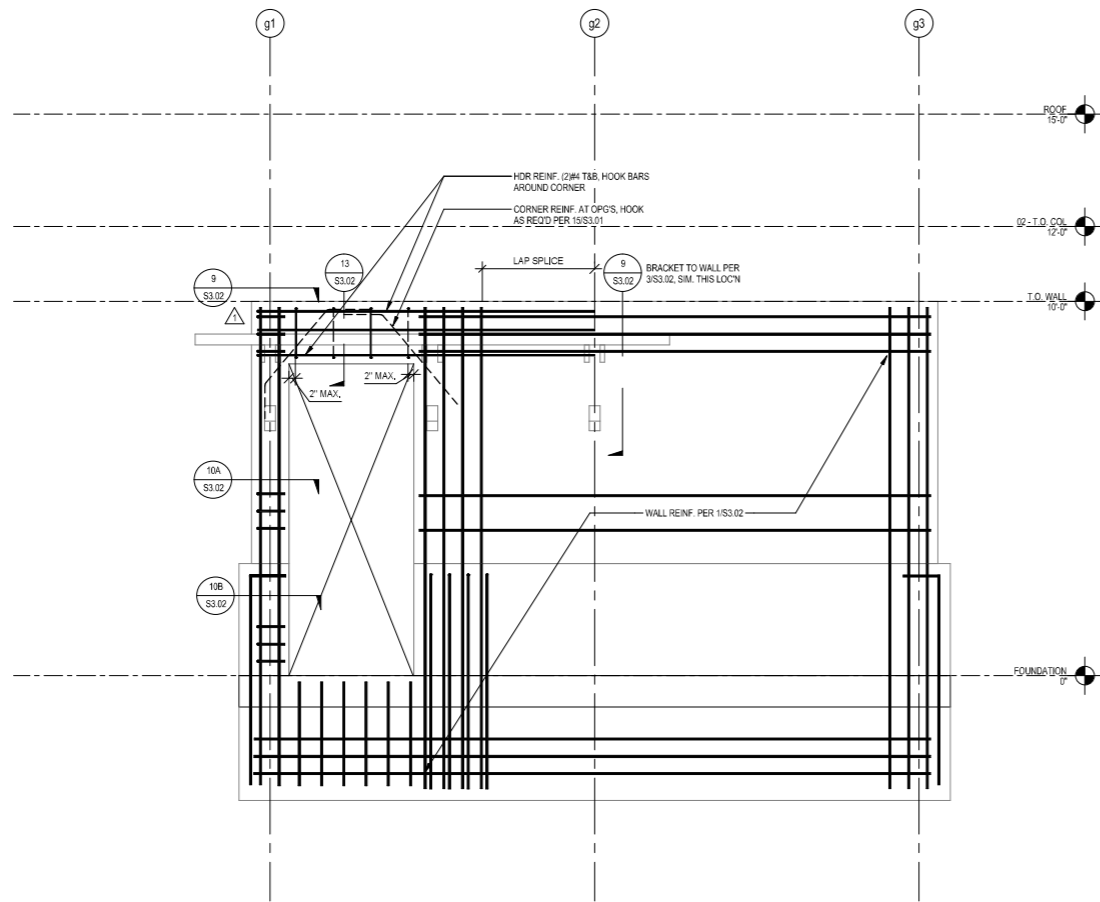

2 EXTERIOR WALL OPENING
1/2" = 1'-0"

CITY OF LOS ALTOS
JOB COPY
REVIEWED FOR CODE COMPLIANCE

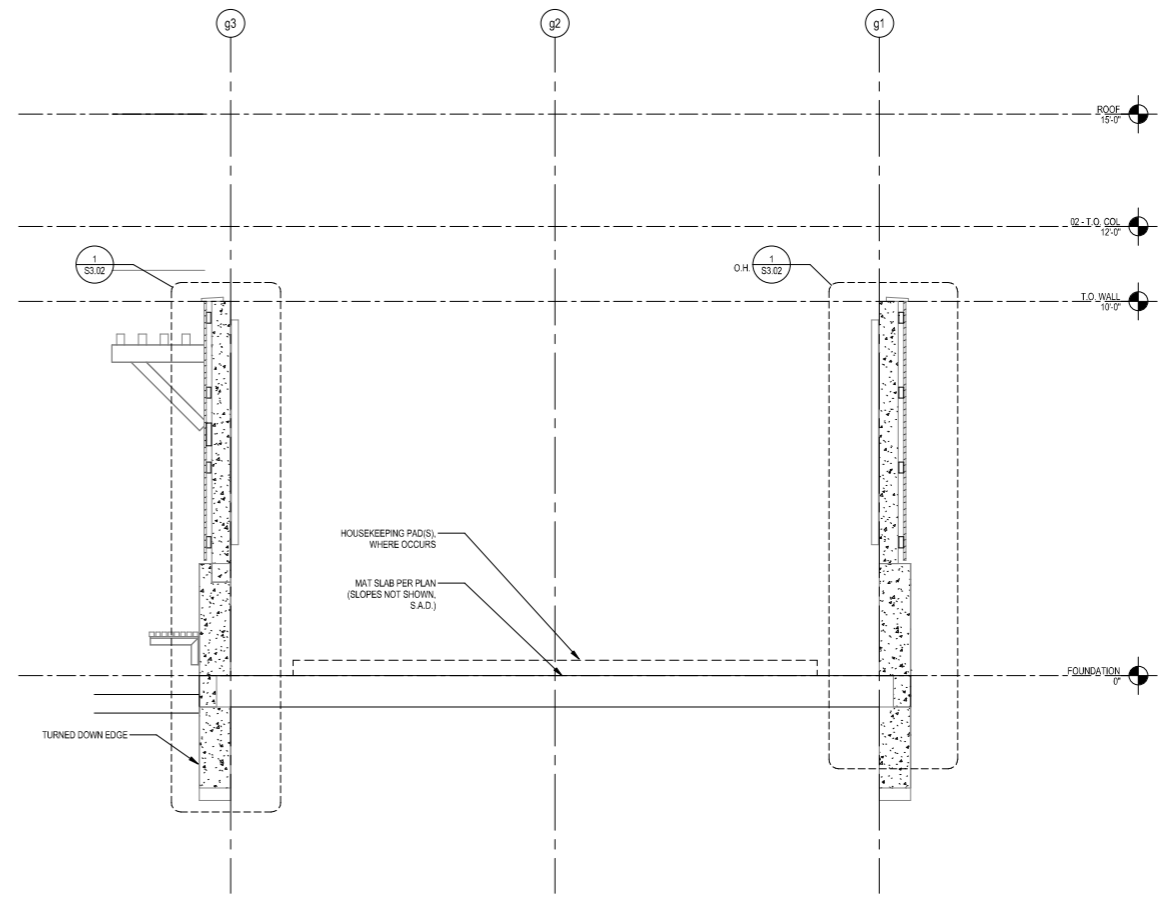

1 BUILDING SECTION
1/2" = 1'-0"

REVIEWED
FOR CODE COMPLIANCE
January 5, 2024
TRB AND ASSOCIATES

PROJECT TITLE

**Los Altos EOC
GENERATOR
ENCLOSURE**

97 Hillview Ave.
Los Altos, CA 94022

ISSUE TITLE

PERMIT SET

ISSUE DATE **AUG 03, 2023**
N&T JOB NUMBER **22203**


REVISIONS	DATE	DESCRIPTION
1	1/19/2023	PERMIT PLAN CHECK RESPONSE
2	12/19/2023	PLAN CHECK RESUBMITTAL

SHEET TITLE

**BUILDING SECTIONS
AND ELEVATIONS**

SHEET NUMBER


S2.01

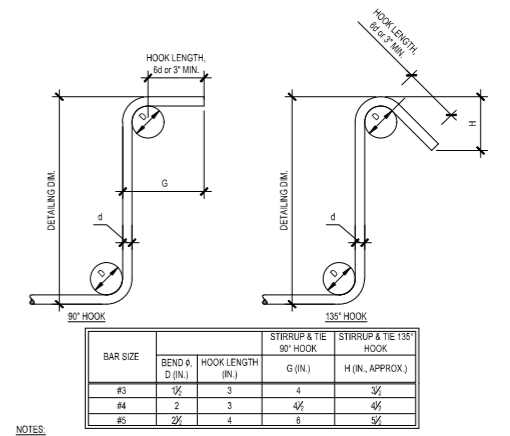

BAR SIZE	STIRRUP & TIE 90° HOOK		STIRRUP & TIE 135° HOOK	
	BEND & D (IN.)	HOOK LENGTH (IN.)	G (IN.)	H (IN. APPROX.)


NOTES:
1. 135° COLUMN TIE HOOKS MAY NOT BE BENT TO LESS THAN 4# OF COLUMN VERT. BAR ENCLOSED IN HOOK.
2. HOOKS & BENDS OF WELDED WIRE FABRIC; MIN. INSIDE BEND DIAMETERS (D) FOR WELDED WIRE REIN. (PLAN OR DEFORMED) TO BE USED AS STIRRUPS OR TIES SHALL BE AT LEAST 4 WIRE #s FOR WIRE LARGER THAN #6s, AND 2 WIRE #s FOR ALL OTHER WIRE #s BENDS WITH INSIDE 4# OF LESS THAN 6 WIRE #s SHALL NOT BE LOCATED LESS THAN 4 WIRE #s FROM NEAREST WELD INTERSECTION.

TYPICAL STIRRUP AND TIE HOOKS N.T.S. 4

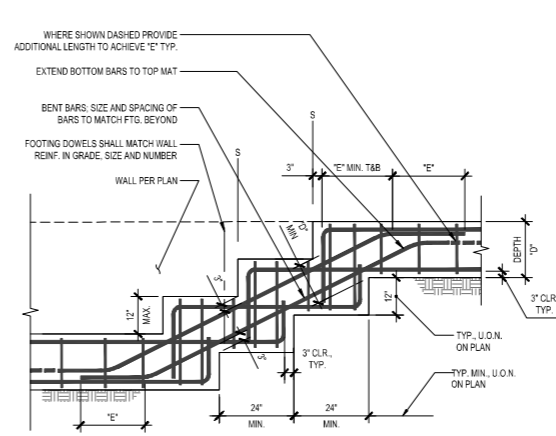


WHERE SHOWN DASHED PROVIDE ADDITIONAL LENGTH TO ACHIEVE 'E' TYP.
EXTEND BOTTOM BARS TO TOP MAT
BENT BARS, SIZE AND SPACING OF BARS TO MATCH FTG. BEYOND
FOOTING DOWELS SHALL MATCH WALL REIN. IN GRADE, SIZE AND NUMBER
WALL PER PLAN
TYP. U.O.N. ON PLAN
TYP. MIN. U.O.N. ON PLAN
3" CLR. TYP.

TYPICAL STEPPED FOOTING OR GRADE BEAM N.T.S. 8

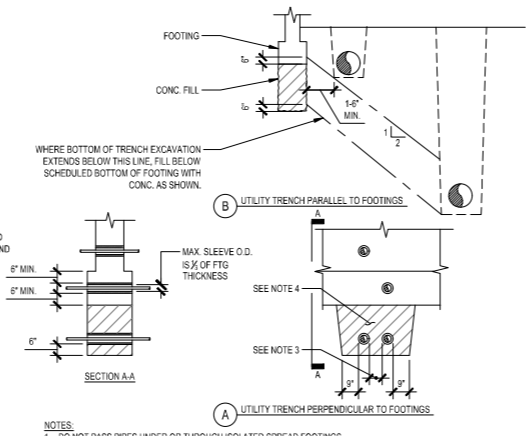


WHERE BOTTOM OF TRENCH EXCAVATION EXTENDS BELOW THIS LINE, FILL BELOW SCHEDULED BOTTOM OF FOOTING WITH CONC. AS SHOWN.
WHERE FULL EXTENSION NOT POSSIBLE, EXTEND AS FAR AS ABLE AND HOOK.
MAX. SLEEVE O.D. IS 1/2 OF FTG THICKNESS
SEE NOTE 4
SEE NOTE 3

TYPICAL PIPE TRENCHES AND PENETRATIONS AT FOUNDATIONS N.T.S. 12

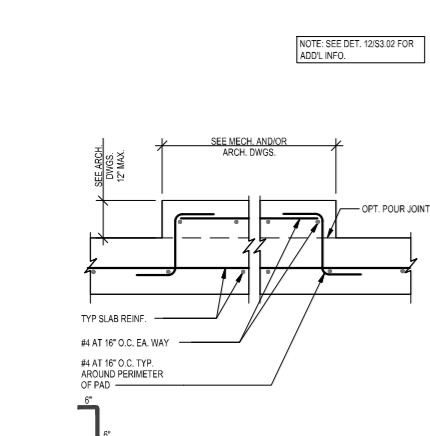


TYPICAL SLAB RAISED PAD NO SCALE 20

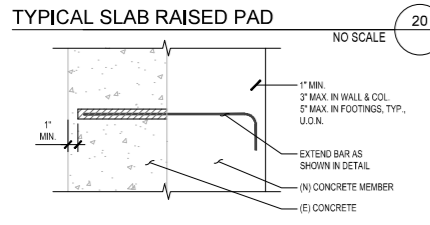


DOWEL SIZE	THREADED ROD SIZE	DRILLED HOLE DIA.	MINIMUM EMBEDMENT LENGTH ¹	TEST LOAD (KIPS)	
				DOWEL	THREADED ROD
#3	3/8"	3/8"	4"	5.28	2.25
#4	1/2"	1/2"	6"	9.60	6.82
#5	5/8"	5/8"	10"	21.12	16.03
#6	3/4"	3/4"	10"	28.80	22.18
#8	1"	1 1/8"	12"	37.92	29.09

NOTES:
1. FOLLOW SPECIFIC EPOXY MANUFACTURER INSTRUCTIONS FOR DRILLED HOLE DIAMETER.
2. EMBED LENGTHS SHOWN ON SPECIFIC DETAILS GOVERN OVER THIS SCHEDULE.
3. DOWEL EMBEDMENT LENGTHS INTO WALLS AND SLABS SHALL NOT EXCEED THICKNESS IN DIRECTION OF DRILLING MINUS ONE INCH.
4. SCHEDULE DOES NOT APPLY TO DOWELS IN BRICK OR CONCRETE MASONRY.
5. SEE SPECS FOR EPOXY, AND SUBMIT EPOXY TECH. INFO. TO S.E. FOR APPROVAL.
6. NOTIFY ENGINEER WHEN EPOXY DOWELS ARE REQUIRED THAT ARE NOT INCLUDED IN CONSTRUCTION DOCUMENTS.
7. TEST LOAD ASSUMES THREADED ROD IS ASTM A36 OR F1554 GR. 36. NOTIFY ENGINEER IF OTHER ROD MATERIAL USED FOR TEST LOAD.


TYPICAL EPOXY DOWEL ANCHORAGE IN CONCRETE N.T.S. 11

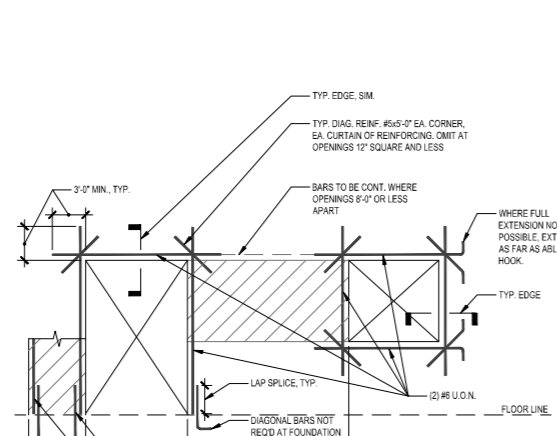


TYPICAL REINFORCING AT OPENINGS & EDGES OF CONCRETE WALLS N.T.S. 15

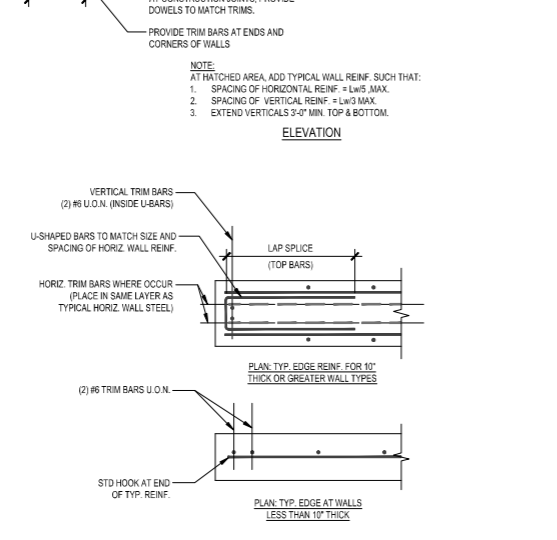


TYPICAL LAP SPLICE SCHEDULE N.T.S. 3

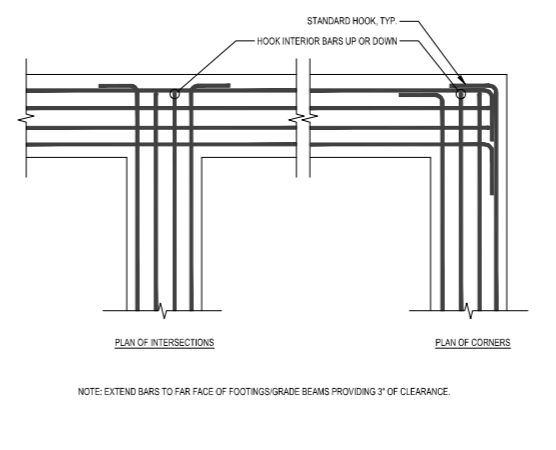


TYPICAL REINFORCING AT FOOTING/GRADE BM CORNERS AND INTERSECTIONS N.T.S. 7

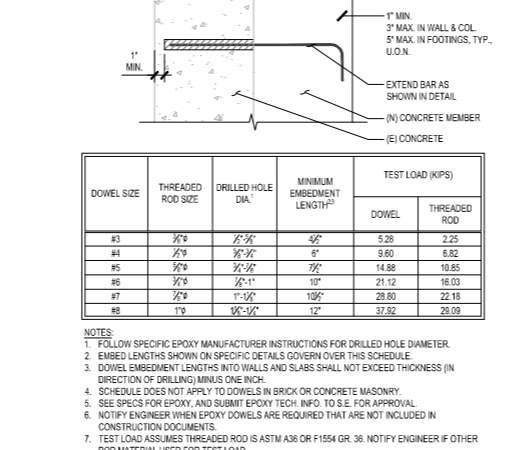


TYPICAL EPOXY DOWEL ANCHORAGE IN CONCRETE N.T.S. 11

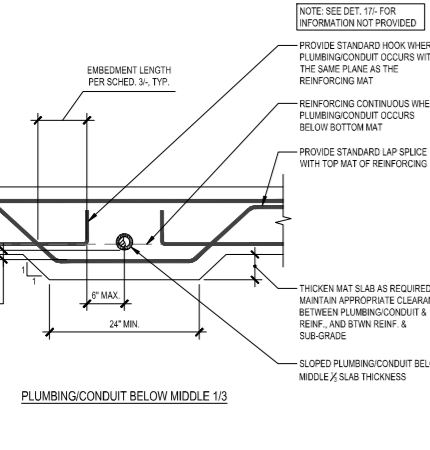


TYPICAL PLUMBING/CONDUIT IN CONCRETE MAT SLAB: THICKENED N.T.S. 18

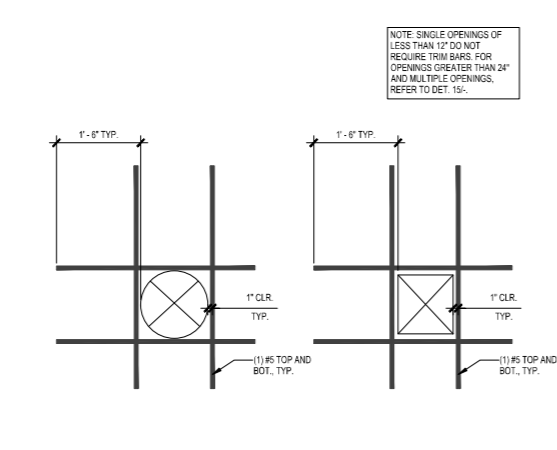

TRIM REINFORCING AT OPENINGS IN WALLS OR SLAB FROM 12\"/>

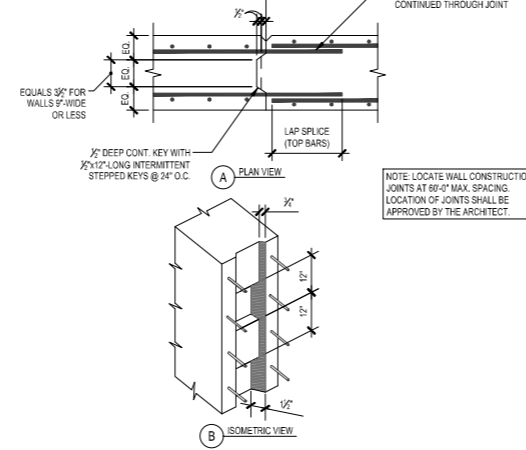


TYP. VERTICAL CONSTRUCTION JOINT IN CONCRETE WALL N.T.S. 10

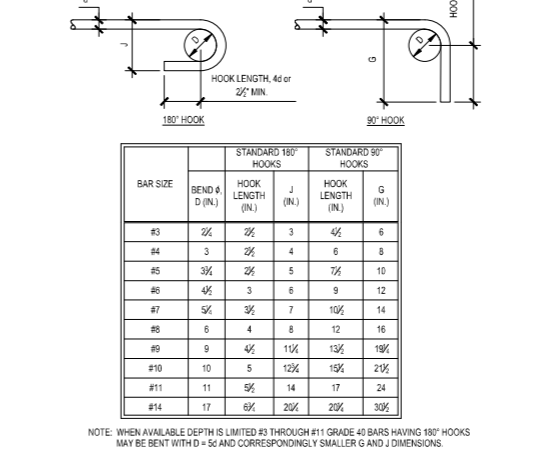


TYPICAL STANDARD REBAR HOOK DIMENSIONS N.T.S. 6

CONCRETE EXPOSURE	MEMBER	REINFORCEMENT	SPECIFIED COVER (IN.)	
			CAST AGAINST AND PERMANENTLY IN CONTACT WITH GROUND	EXPOSED TO WEATHER OR IN CONTACT WITH GROUND
NOT EXPOSED TO WEATHER OR IN CONTACT WITH GROUND	ALL	ALL	3	
	ALL	NO. 6 THROUGH NO. 18 BARS	2	
EXPOSED TO WEATHER OR IN CONTACT WITH GROUND	ALL	NO. 5 BAR, W31 OR D31 WIRE, AND SMALLER	1/2	
	SLABS, JOISTS, AND WALLS	NO. 14 AND NO. 18 BARS	1/2	
NOT EXPOSED TO WEATHER OR IN CONTACT WITH GROUND	BEAMS, COLUMNS, PILECAPS, AND TENSION TIES	PRIMARY REINFORCEMENT, STIRRUPS, TIES, SPIRALS, AND HOOKS	1/2	
	ALL	ALL	3	


TYPICAL CONCRETE COVER OVER REINFORCING STEEL N.T.S. 2

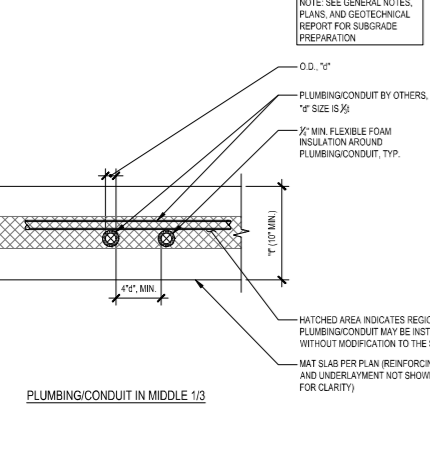


TYPICAL PLUMBING/CONDUIT IN CONCRETE MAT SLAB N.T.S. 17

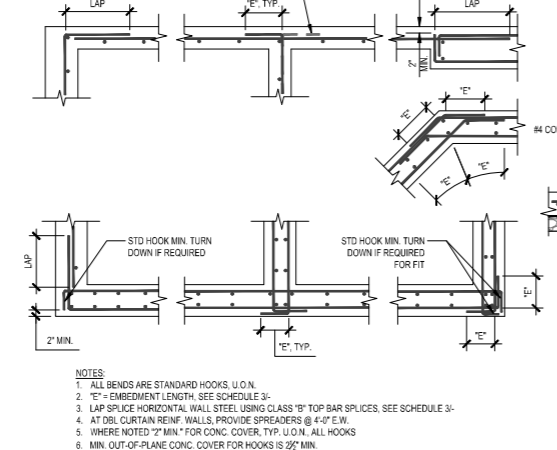


TYPICAL HORIZ. WALL REIN. AT CORNERS AND INTERSECTIONS N.T.S. 13

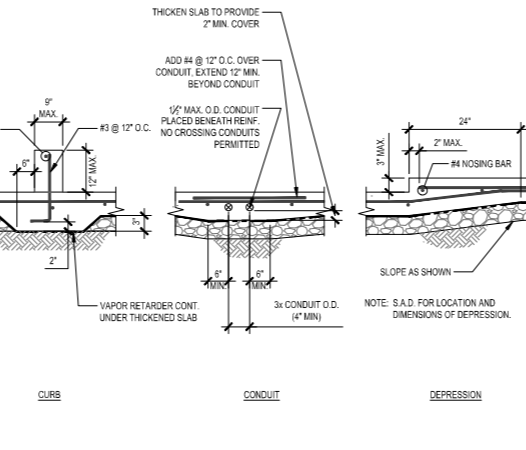


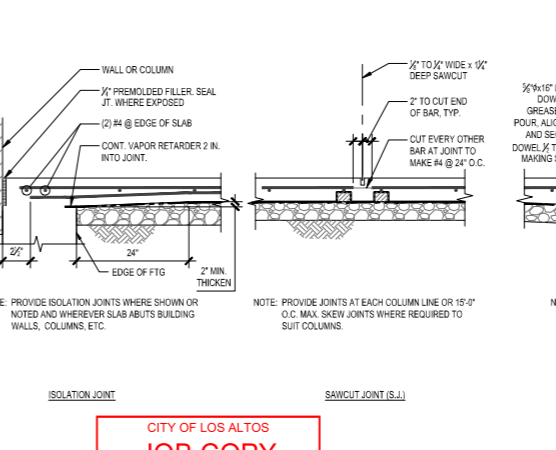


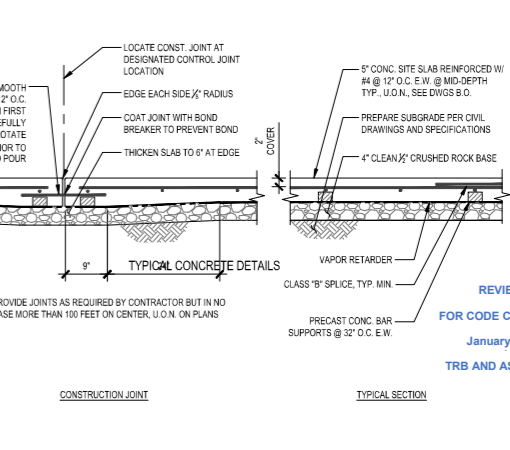

TYPICAL SLAB-ON-GRADE DETAILS N.T.S. 1

CITY OF LOS ALTOS
JOB COPY
REVIEWED FOR CODE COMPLIANCE

PROJECT TITLE
Los Altos EOC GENERATOR ENCLOSURE

97 Hillview Ave.
Los Altos, CA 94022

ISSUE TITLE
PERMIT SET

ISSUE DATE
AUG 03, 2023

NOLL & TAM JOB NUMBER
22203











NO.	DATE	DESCRIPTION
1	11/15/2023	PERMIT PLAN CHECK RESPONSE
2	12/18/2023	PLAN CHECK REVISION #1

DRAWN BY MKN CHECKED BY MKR
SHEET TITLE

FOR CODE COMPLIANCE
January 5, 2024
TRB AND ASSOCIATES

TYPICAL CONCRETE DETAILS

SHEET NUMBER
S3.01

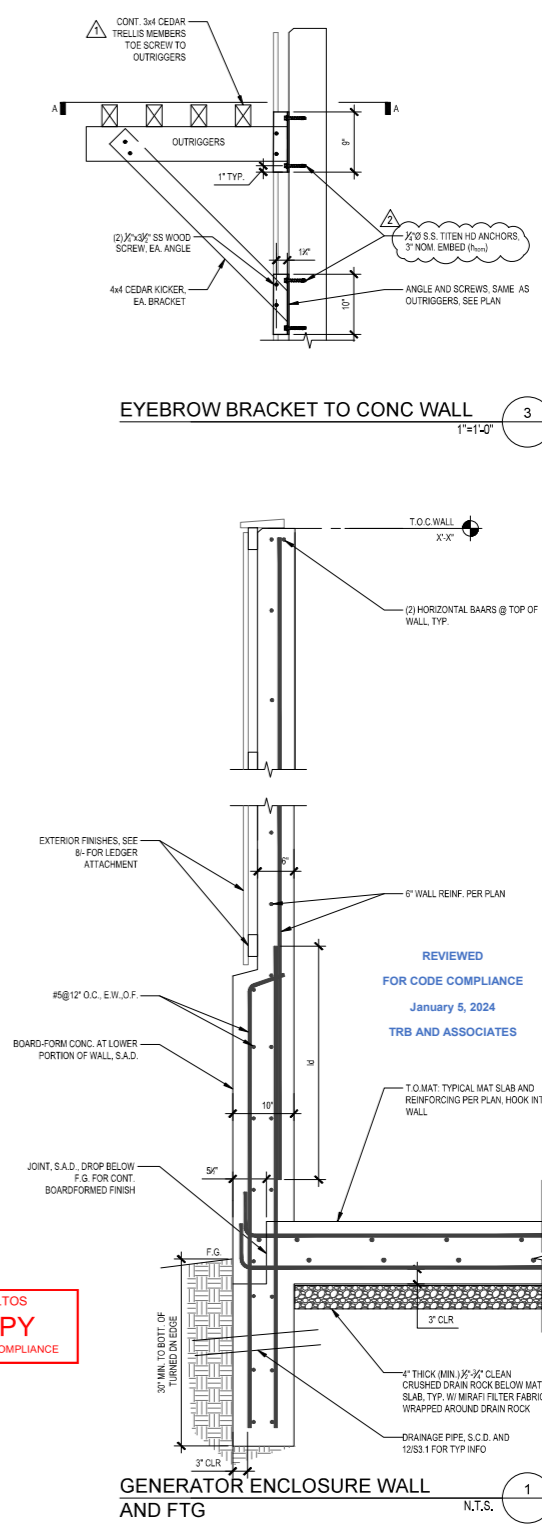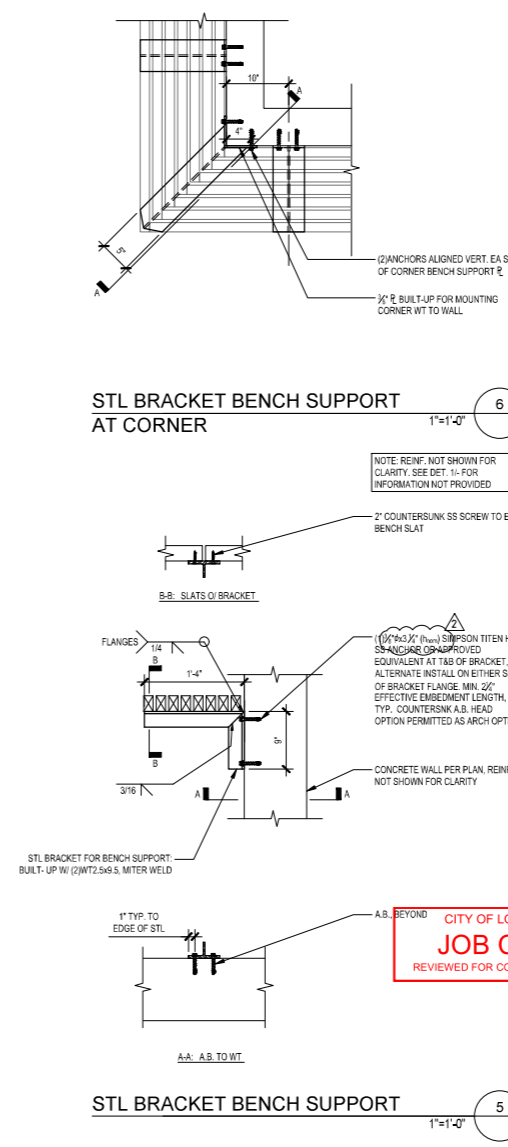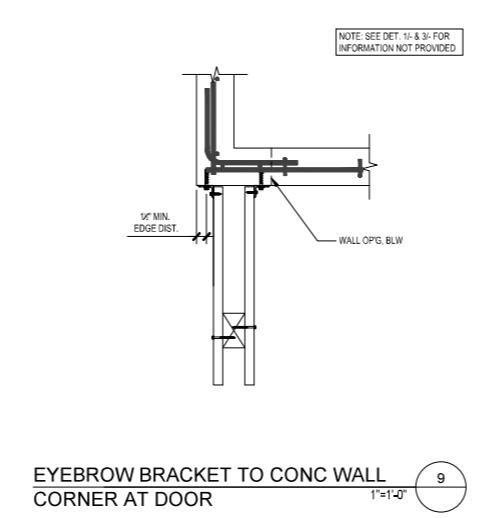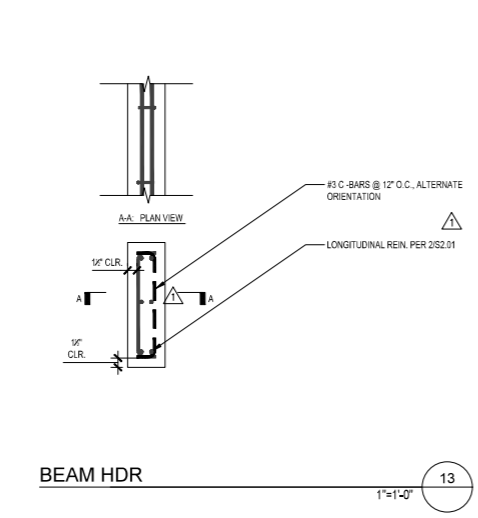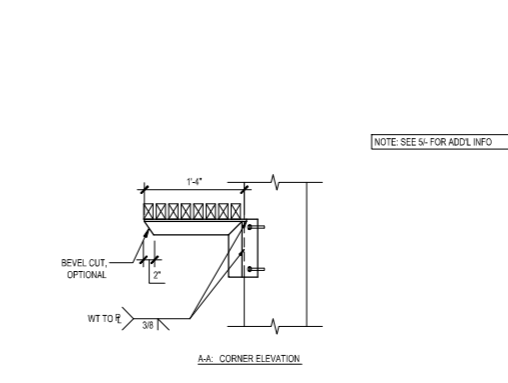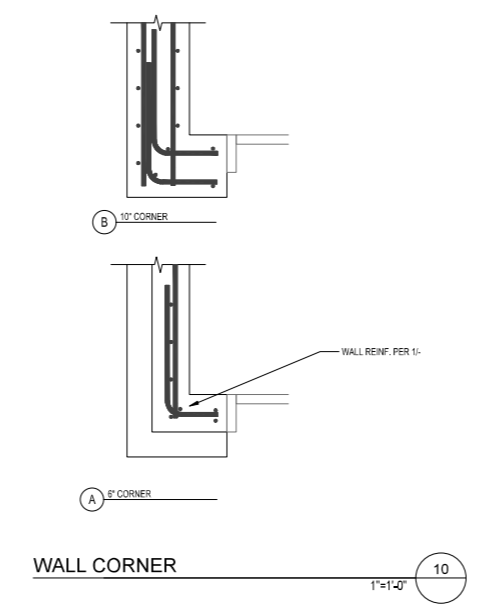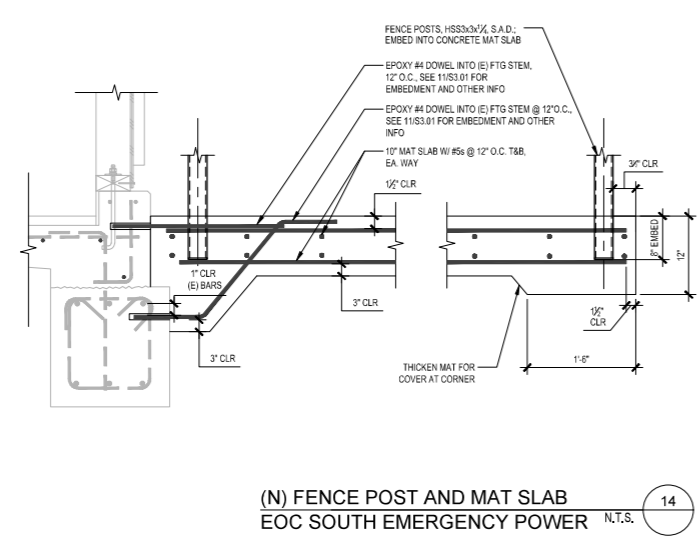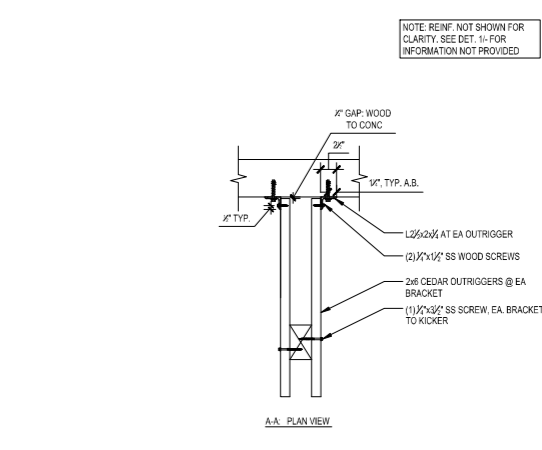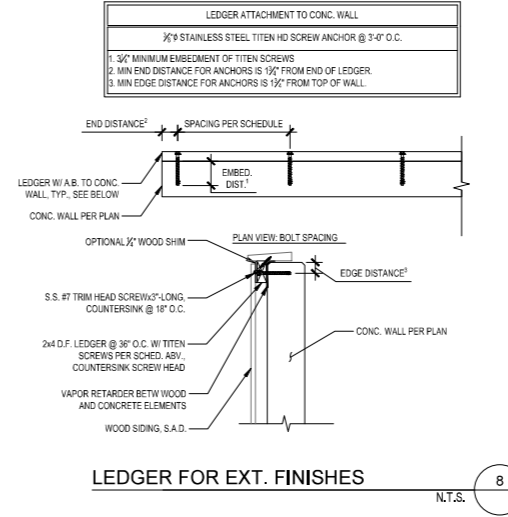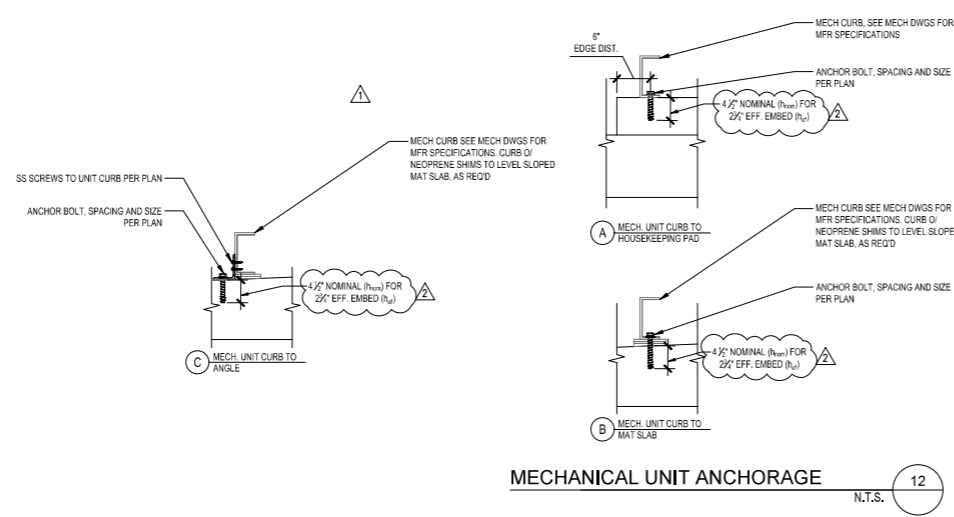

NOLL & TAM ARCHITECTS
729 Heinz Avenue
Berkeley, CA 94710
tel 510.542.2200
fax 510.542.2201

DAEDALUS
3031 Tsch Way, Ste. 110
San Jose, CA 95128
TEL: 408.517.0973
www.daedalus-eng.com

PROFESSIONAL ENGINEER
No. 3454
STRUCTURAL
STATE OF CALIFORNIA

PROJECT TITLE
Los Altos EOC GENERATOR ENCLOSURE

ISSUE TITLE
PERMIT SET

ISSUE DATE
AUG 03, 2023

NOLL & TAM JOB NUMBER
22203

REVISIONS

NO.	DATE	DESCRIPTION
1	11/16/2023	PERMIT PLAN CHECK RESPONSE
2	12/18/2023	PLAN CHECK RESUBMITTAL

DRAWN BY MKN CHECKED BY MKR
SHEET TITLE
CONCRETE DETAILS

SHEET NUMBER
S3.02

DAEDALUS # 17072

PIPE LINE DESIGNATIONS	
	FUEL OIL FILL
	FUEL OIL SUPPLY
	FUEL OIL RETURN

PLUMBING SHEET LIST	
Sheet Number	Sheet Name
PL01	PLUMBING LEGENDS AND ABBREVIATIONS
PL02	LEVEL 1 PLUMBING FLOOR PLAN
PL01	PLUMBING DETAILS
Grand Total 3	

PIPE & ACCESSORIES	
	POINT OF CONNECTION
	POINT OF DISCONNECTION
	DEMOLITION OF PIPING, DEVICES, ETC.
	END OF DEMOLITION WORK
	FLOOR DRAIN
	FLOOR SINK
	COMBINATION ROOF / OVERFLOW DRAIN
	ROOF DRAIN / AREA DRAIN
	ROOF RECEPTOR
	FLOOR CLEANOUT
	WALL CLEANOUT
	HOSE BIBB
	LINE BREAK
	PIPE CAP
	END OF PIPE
	TEMPERATURE SENSOR
	FLEX CONNECTION
	UNION
	FLANGE
	FLOW DIRECTION
	DWV FITTING, 45° ELBOW
	DWV FITTING, 90° ELBOW
	DWV FITTING, 45° TEE
	DWV FITTING, 90° TEE
	PIPE DROP
	PIPE BRANCH, TEE UP
	PIPE BRANCH, TEE DOWN
	REVISION CLOUD AND DELTA
	EQUIPMENT TYPE
	NUMBER TYPE
	DETAIL DESIGNATION
	SHEET NUMBER

VALVES & ACCESSORIES	
	PRESSURE REDUCING VALVE
	BALL VALVE
	BUTTERFLY VALVE
	CHECK VALVE
	CIRCUIT SETTER
	T&P RELIEF VALVE
	AIR-HANDLING UNIT
	THERMOSTATIC MIXING VALVE
	VALVE
	GLOBE VALVE
	WYE STRAINER
	GATE VALVE
	MANUAL AIR VALVE
	TEMP GAUGE
	PRESSURE GAUGE
	LIQUID FILLED THERMOMETER
	VACUUM BREAKER
	VFD
	REDUCER
	CEILING ACCESS PANEL (AP)
	WALL MOUNTED ACCESS PANEL (AP)

EQUIPMENT & ACCESSORIES	
	EXPANSION TANK
	HEAT EXCHANGER
	PUMP
	WATER HAMMER ARRESTOR
	TRAP PRIMER
	WATER METER
	BACKFLOW PREVENTER

PLUMBING PERFORMANCE REQUIREMENTS

- PROVIDE ALL PIPING, VALVES, FITTINGS AND OTHER APPURTENANCES FOR A COMPLETE AND FULLY FUNCTIONAL SYSTEM.
- VERIFY LOCATION OF UTILITIES PRIOR TO PERFORMING WORK. COORDINATE ALL WORK WITH OTHER TRADES.
- COORDINATE ALL CORING OF FLOORS AND WALLS WITH ARCHITECT PRIOR TO START OF WORK.
- BEFORE FABRICATION OR INSTALLATION, THE CONTRACTOR SHALL VERIFY EXACT LOCATIONS OF ALL MECHANICAL EQUIPMENT. EXACT ROUGH-IN LOCATIONS AND REQUIREMENTS SHALL BE COORDINATED IN FIELD.
- PIPING SHALL HAVE SUFFICIENT CLEARANCE FROM STRUCTURE TO ALLOW FOR EXPANSION AND CONTRACTION OF THE PIPING. NO PIPING SHALL TOUCH WOOD, CONCRETE, OTHER PIPING, ETC.
- ALL EQUIPMENT, FIXTURES, ETC. SHALL BE INSTALLED IN STRICT ACCORDANCE WITH THE MANUFACTURERS RECOMMENDATIONS AND INSTRUCTIONS.
- ALL VALVES, UNIONS, ETC. SHALL BE SAME SIZE AS LINE SIZE UNLESS OTHERWISE NOTED ON DRAWINGS.
- PROVIDE UNIONS AFTER EACH THREADED VALVE AND PRIOR TO EQUIPMENT CONNECTIONS.
- FOLLOW THE GENERAL ARRANGEMENT INDICATED ON THE DRAWINGS AS CLOSELY AS POSSIBLE. THE CONTRACTOR SHALL COORDINATE WITH THE ARCHITECTURAL, STRUCTURAL, MECHANICAL, PLUMBING, ELECTRICAL AND ALL OTHER TRADES PRIOR TO INSTALLATION OF THE MATERIALS AND EQUIPMENT TO VERIFY ADEQUATE SPACE AVAILABLE FOR INSTALLATION OF THE WORK SHOWN. THE ARCHITECT AND ENGINEER SHALL BE IMMEDIATELY NOTIFIED IF AN AREA OF CONFLICT OCCURS BETWEEN TRADES.

CALIFORNIA CODES AND STANDARDS


- 2022 CALIFORNIA BUILDING CODE (CBC)
- 2022 CALIFORNIA PLUMBING CODE (CPC)
- 2022 CALIFORNIA ELECTRICAL CODE (CEC)
- 2022 CALIFORNIA MECHANICAL CODE (CMC)
- 2022 CALIFORNIA ENERGY CODE
- 2022 CALIFORNIA FIRE CODE (CFC)
- NATIONAL FIRE PROTECTION ASSOCIATION (NFPA), LATEST ADOPTED EDITION OF APPLICABLE STANDARDS

PLUMBING ABBREVIATIONS			
ABV	ABOVE	G	NATURAL GAS
AC	ALTERNATING CURRENT	GA	GALLON
ACU	AIR-CONDITIONING UNIT(S)	GAL	GENERAL CONTRACTOR
AD	ACCESS DOOR/AREA DRAIN	GCC	GARAGE CLEANOUT
ADA	AMERICAN WITH DISABILITY ACT	GDD	GARAGE DRAIN
ADAAG	ADA AMERICANS ACCESSIBILITY GUIDELINES	GD	GREASE INTERCEPTOR
ADOL	ADDITIONAL	GI	GROUND
ADU	ADJUSTABLE	GND	GOVT
AFF	ABOVE FINISHED FLOOR	GOVT	GALVANIZED PIPE
AG	ABOVE THE GROUND	GPC	GALLONS PER CYCLE
AGA	AMERICAN GAS ASSOCIATION	GPD	GALLONS PER DAY
AHU	AIR-HANDLING UNIT	GPF	GALLONS PER FLUSH
AR COND	AIR-CONDITIONING - (ED)	GPM	GALLONS PER MINUTE
AR	ARCHITECT, ARCHITECTURAL	GPH	GALLONS PER HOUR
ASB	AMERICAN SOCIETY OF BUILDING	GPS	GALLONS PER SECOND
ASCI	AMERICAN NATIONAL STANDARDS INSTITUTE	GVA	GATE VALVE
ASC	ACCESS PANEL	GW	GAS WATER HEATER
ASHRAE	ARCHITECT, ARCHITECTURAL	GW	GREASE WATER
	ASHRAE	GW	GRAY WATER WASTE
		H	HIGH
		HB	HOSE BIB HYDRANT
		HD	HUB DRAIN
		HDR	HEADER
		HOR	HORIZONTAL
		HP	HORSE POWER
		HR/HS	HOURS
		HT	HEIGHT
		HTG	HEATING
		HTR	HEATER
		HVAC	HEATING VENTILATION & AIR CONDITIONING
		HW	HOT WATER
		HWR	HOT WATER RETURN
		HZ	HERTZ (CYCLES PER SECOND)
		ICW	INDUSTRIAL COLD WATER
		ID	INSIDE DIAMETER
		IE	INVERT ELEVATION
		IHW	INDUSTRIAL HOT WATER
		IHW	INDUSTRIAL HOT WATER RETURN
		INC	INCREASER, INCREASING
		INCH	INCH
		INCL	INCLUDE
		INFO	INFORMATION
		INS	INSULATION
		INSP	INSPECT
		INSUL	INSULATION
		INT	INTERNAL, INTERNAL
		INV	INVERT
		IP	IRON PIPE
		IPS	IRON PIPE SIZE
		IW	INDIRECT WASTE
		IWH	INSTANTANEOUS WATER HEATER
		J-BOX	JUNCTION BOX
		JAC	JANITOR'S CLOSET
		KF	KITCHEN FIXTURE
		KW	KILOWATT
		KWH	KILOWATT HOUR
		KW	KILOWATT/AMPERE
		KW	KILOWATT
		L	LENGTH
		LAB	LABORATORY
		LAT	LATERAL
		LAV	LAVATORY
		LBS	POUNDS
		LD	LEAK DETECTION
		LF	LINEAL FEET
		LG	LENGTH
		LH	LEFT HAND
		LPO	LOW POINT DRAIN
		LW	LAB WASTE
		LW	LAB WASTE
		LX	LAB VENT
		MAX	MAXIMUM
		MCC	MOTOR CONTROL CENTER
		ME	MECHANICAL ENGINEER
		MECH	MECHANICAL
		MFR	MANUFACTURER
		MFL	MAXIMUM FLOWS PER DAY
		MH	MANHOLE
		MIN	MINIMUM
		MISC	MISCELLANEOUS
		MS	MOP SINK
		MTR	MOTOR
		MWP	MAXIMUM WORKING PRESSURE
		N	NITROGEN
		NE	NEW
		NC	NORMALLY CLOSED
		NEC	NATIONAL ELECTRICAL CODE
		NFPA	NFPA
		NOM	NOMINAL
		NRS	NON RISING STEAM VALVE
		NA	NOT APPLICABLE
		NBS	NATIONAL BUREAU OF STANDARDS
		NC	NOISE CRITERIA
		NFPA	NATIONAL FIRE PROTECTION ASSOCIATION
		NS	NOT IN SCOPE
		NO, #	NUMBER
		NPS	NOMINAL PIPE SIZE (ALSO CALLED IPS)
		NPSH	NET POSITIVE SUCTION HEAD REQUIRED
		NTS	NOT TO SCALE
		O	OXYGEN
		OC	ON CENTER
		OD	OUTSIDE DIAMETER
		ODD	OVERFLOW DRAIN
		OSD	OPEN SIGHT DRAIN
		OS&Y	OUTSIDE SCREW & YOKE (VALVE)
		OUT	OUTLET
		OZ	OUNCE
		P	PITCH
		PB	LEAD (CHEMICAL ABBREVIATION)
		PD	PLAZA DRAIN, PRESSURE DROP, OR PRESSURE DIFFERENTIAL
		PE	PROFESSIONAL ENGINEER
		PERM	PERMITS
		PG	PRESSURE GAUGE
		PH	PHASE (ELECTRICAL)
		PIV	PISTON INDICATOR VALVE
		PL	PROPERTY LINE
		PLBG	PLUMBING
		POC	POINT OF CONNECTION
		PPM	PARTS PER MILLION
		PRESS	PRESSURE
		PRM	PRIMARY
		PRV	PRESSURE REDUCING VALVE
		PSI	POUNDS PER SQUARE INCH
		PSA	POUNDS PER SQUARE INCH ABSOLUTE
		PSIG	POUNDS PER SQUARE INCH GAUGE
		PVC	POLYVINYL CHLORIDE
		PWS	PURE WATER SUPPLY
		PWR	PURE WATER RETURN
		PWR	POWER
		QT	QUART
		QTY	QUANTITY
		R	HYDRAULIC RADIUS
		(R)	RISE
		RAD	RADIUS
		ROP	REFLECTED CEILING PLAN
		RCVR	RECEIVER
		RD	ROOF DRAIN
		RECIRC	RECIRCULATE
		REF	REFERENCE
		REQD	REQUIRED
		RET	RETURN
		REV	REVISION
		RF	ROOF
		RH	ROOF HAND
		RL	ROOF LEADER
		ROOM	ROOM
		RO	REVERSE OSMOSIS
		RPP	REDUCED PRESSURE BACKFLOW PREVENTER
		RPM	REVOLUTIONS PER MINUTE
		RR	ROOF RECEPTOR
		RW	RAW WATER RECLAIMED WATER RECYCLED WATER
		RWC	RAIN WATER CONDUCTOR
		RWL	RAIN WATER LEADER
		SAD	SEE ARCHITECTURAL DRAWING(S)
		SAI	SANITARY
		SB	SPLASH BLOCK
		SCD	SEE CIVIL DRAWING(S)
		SCFM	CUBIC FT PER MINUTE, STANDARD CONDITIONS
		SCFS	CUBIC FT PER SEC, STANDARD CONDITIONS
		SCH	SCHEDULE
		SCUP	SCUMPER
		SD	STORM DRAIN
		SE	SEWAGE EJECTOR
		SEC	SECTION
		SECT	SECTION
		SERV	SERVICE
		SEW	SEWAGE EJECTOR VENT
		SFT	SQUARE FOOT
		SH	SHOWER
		SHT	SHEET
		SH	SIMILAR
		SK	SKIN
		SLV	SLEEVE
		SLD	SEE LANDSCAPE ARCHITECT DRAWING(S)
		SMD	SEE MECHANICAL DRAWING(S)
		SSD	SEE STRUCTURAL DRAWING(S)
		ST	SHUT-OFF VALVE
		STP	STANDPIPE
		SP	STATIC PRESSURE (SPRINKLER / SUMP PUMP SPECIFICATION)
		SPEC	SPECIFICATION
		SPD	SUMP PUMP DISCHARGE
		SPT	SPRINKLER MAIN
		SS	SERVICE SINK
		STD	STANDARD
		STL	STEEL
		STN	STATION
		SRV	SAFETY RELIEF VALVE
		SO	SQUARE
		SQFT	SQUARE FEET
		SAW	SOIL & WASTE
		(TA)	TO ABOVE
		(TB)	TO BELOW
		TEE	TEE
		T&P	TEMPERATURE & PRESSURE RELIEF VALVE
		TD	TRENCH DRAIN
		TEMP	TEMPERATURE
		TLT	TOLERANCE
		TW	TEMPERED WATER
		TWR	TEMPERED WATER RETURN
		TYP	TYPICAL
		TAP	TAP, TAPPED
		TOT	TAP ON TOP
		TRAP	TRAP PRIMER
		TY	TEE WYE, (SAN TEE)
		TYPCAL	TYPCAL
		UP	PIPE UP THRU FLOOR SLAB
		UR	URNAL
		UNO	UNLESS OTHERWISE NOTED
		V	VENT
		VAP	VACUUM PUMP
		VT	VOLT
		VOL	VOLUME
		VAC	VACUUM
		VVA	VARIABLE
		VB	VALVE BOX
		VEL	VELOCITY
		VERT	VERTICAL
		VLV	VALVE
		VOL	VOLUME
		VP	VENT PIPE
		VS	VENT STACK
		VTR	VENT THROUGH ROOF
		W	WASTE / WATT
		WF	WITH
		WO	WITHOUT
		WC	WATER CLOSET
		WCO	WALL CLEANOUT
		WFS	WATER FLOW SWITCH
		WH	WATER HEATER / WALL HYDRANT
		WM	WATER METER
		WS	WATER STOP
		WHA	WATER HAMMER ARRESTOR
		WL	WATER LEVEL
		WTP	WEATHERPROOF
		WSFU	WATER SUPPLY FIXTURE UNIT WEIGHT
		WT	WEIGHT
		%	PERCENT
		(E)	EXISTING
		(N)	NEW
		@	AT (THE RATE OF)
		&	AND
		#	NUMBER


FUEL STORAGE CALCULATION	
GENERATOR FUEL CONSUMPTION (GPH)	34.4
FUEL NEEDED, HOURS	96
STORAGE REQUIRED, GALLONS	3302.4
MAIN STORAGE TANK, GALLONS	4000
DAY TANK, GALLONS	180
STORAGE PROVIDED, GALLONS	4180

PLUMBING FUEL OIL SYSTEM SCHEDULE															
TYPE	EQUIPMENT NUMBER	DESCRIPTION	SERVICE	LOCATION	MANUFACTURER	MODEL	FLOW @ HEAD	DIMENSION			ELECTRICAL		TANK VOLUME (GALLONS)	OPERATING WEIGHT (LB)	REMARKS
								L	W	H	HP	V			
FOT	1	ABOVEGROUND FUEL TANK													

1/11/2023 3:25:55 PM Autodesk Docs://Los Altos EOC/Los Altos EOC_Generator_P_2023.rvt

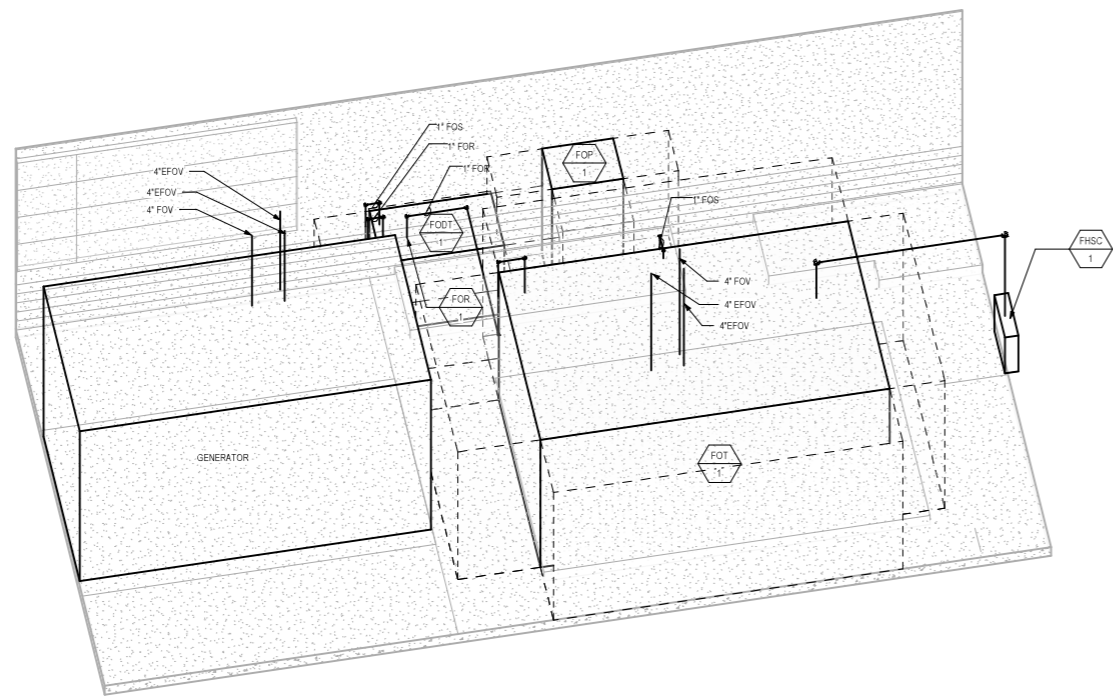

2 3D-FUEL OIL PIPING

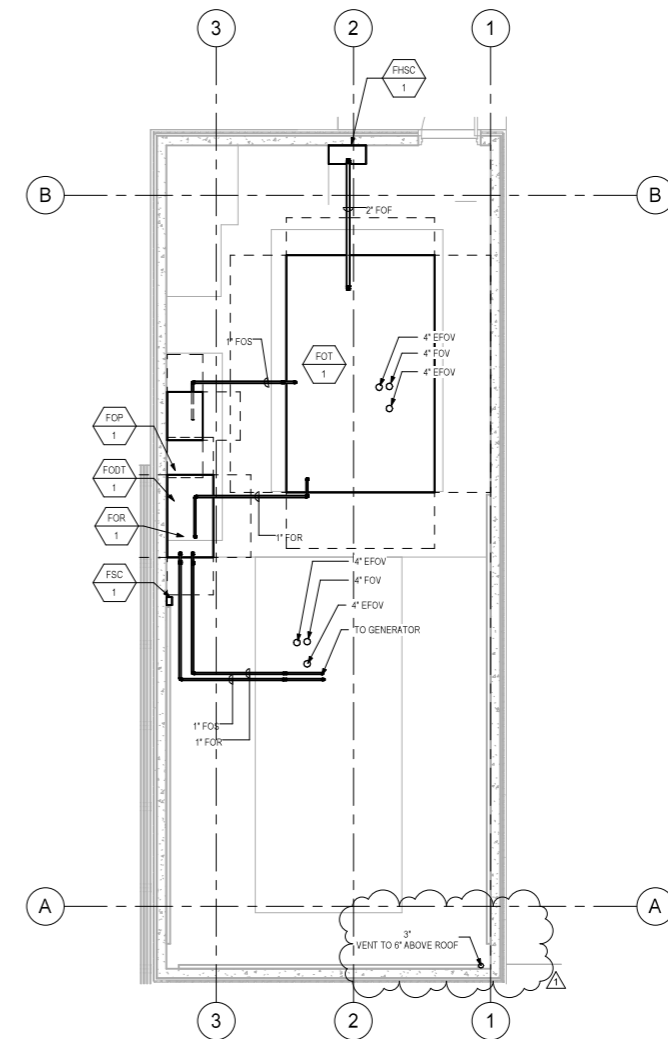

1 PLUMBING-FUEL OIL PIPING PLAN
1/4" = 1'-0"

CITY OF LOS ALTOS
JOB COPY
REVIEWED FOR CODE COMPLIANCE

REVIEWED
FOR CODE COMPLIANCE
January 5, 2024
TRB AND ASSOCIATES

APPROVALS

NOLL & TAM
ARCHITECTS

729 Heinz Avenue
Berkeley, CA 94710
tel 510.542.2200
fax 510.542.2201



SEAL



taylor engineers

1080 Marina Village Parkway,
Suite 501
Alameda, CA 94501-1142

PROJECT TITLE

City of Los Altos
Los Altos CC EOC

97 Hillview Ave.
Los Altos, CA 94022

ISSUE TITLE

PERMIT SET

ISSUE DATE **AUG 03, 2023**

NOLL & TAM JOB NUMBER **22203**

REVISIONS	DATE	DESCRIPTION
1	11/15/2023	PERMIT PLAN CHECK RESPONSE

SHEET TITLE

LEVEL 1 PLUMBING FLOOR PLAN

SHEET NUMBER

P2.01

NOLL & TAM ARCHITECTS

729 Heinz Avenue
Berkeley, CA 94710
tel 510.542.2200
fax 510.542.2201



SEAL



taylor engineers

1080 Marina Village Parkway,
Suite 501
Alameda, CA 94501-1142

PROJECT TITLE

City of Los Altos Los Altos CC EOC

97 Hillview Ave.
Los Altos, CA 94022

ISSUE TITLE

PERMIT SET

ISSUE DATE AUG 03, 2023

NOLL & TAM JOB NUMBER 22203

REVISIONS	DATE	DESCRIPTION
1	11/15/2023	PERMIT PLAN CHECK RESPONSE

SHEET TITLE

PLUMBING DETAILS

SHEET NUMBER


P4.01

NUMBERED NOTES:

- ABOVEGROUND STORAGE TANK - 4000 GALLONS UL-2085
- ATPSF-102-120-50-D-4-TG1 - DUPLEX PUMP SET WITH CONTROLLER, 1/3HP, 208V, SINGLE PHASE BY PREFERRED UTILITIES
- CUSTOM HORIZONTAL SPILL CONTAINER - CARBON STEEL, 5 GALLON CONTAINMENT WITH FILL ENABLE BY PREFERRED UTILITIES
- FLOAT TYPE STORAGE TANK HIGH LEVEL SWITCH #PLS-1 BY PREFERRED UTILITIES
- WIRE FLOAT LEVEL SENSOR #TG-EL-WF-12 BY PREFERRED UTILITIES BY PREFERRED UTILITIES
- SINGLE POPPET FOOT VALVE BY PREFERRED UTILITIES
- FLOAT TYPE LEAK SWITCH #PS-LDS BY PREFERRED UTILITIES
- DISCRIMINATING LEAK SENSOR #HD-A3-C BY PREFERRED UTILITIES
- SOLENOID VALVE - NORMALLY CLOSED - 120 VAC BY PREFERRED UTILITIES
- OVERFILL PREVENTION VALVE #61 F-STOP BY PREFERRED UTILITIES
- FLOAT TYPE VENT LEAK SWITCH #RBS BY PREFERRED UTILITIES
- SWING CHECK VALVE
- MAIN TANK TOP CONTAINMENT SUMP
- NOT USED
- DAY TANK LEAK SWITCH MODEL PLS-1 BY PREFERRED UTILITIES
- DAY TANK INLET AND RETURN SOLENOIDS 120 VAC N.C. BY PREFERRED UTILITIES
- DAY TANK VENT LEAK SWITCH MODEL RBS BY PREFERRED UTILITIES
- SPILL PAN LEAK MODEL PS-LDS BY PREFERRED UTILITIES
- TANK FLOOR LEAK DETECTOR MODEL PS-LDS BY PREFERRED UTILITIES
- CONTAINMENT PIPE LEAK DETECTOR MODEL F-LDS BY PREFERRED UTILITIES
- PUMP SET DISCHARGE FLOW SWITCH MODEL 1116S-5 BY PREFERRED UTILITIES
- DAY TANK 4 POSITION LEVEL SWITCH - PLS-4 BY PREFERRED UTILITIES
- SINGLE POPPET FOOT VALVE BY PREFERRED UTILITIES
- 24 VDC SOLENOID VALVE CONTROLLED BY GENERATOR PANEL
- DOUBLE WALL DAY TANK RUPTURE BASIN - DWDT-180 BY PREFERRED UTILITIES
- DAY TANK RETURN PUMP AND MOTOR ASSY 11872 BY PREFERRED UTILITIES - 480 GPH @ 15 PSI, 1/4HP, 120 VAC.
- DAY TANK 4-20 mA LEVEL SENSOR BY PREFERRED UTILITIES

NOTE:

LOCATE GENERATOR SUPPLY AND RETURN PIPING AS LOW AS POSSIBLE TO ACCOMMODATE GENERATOR PUMP SUCTION AND DISCHARGE CAPACITY

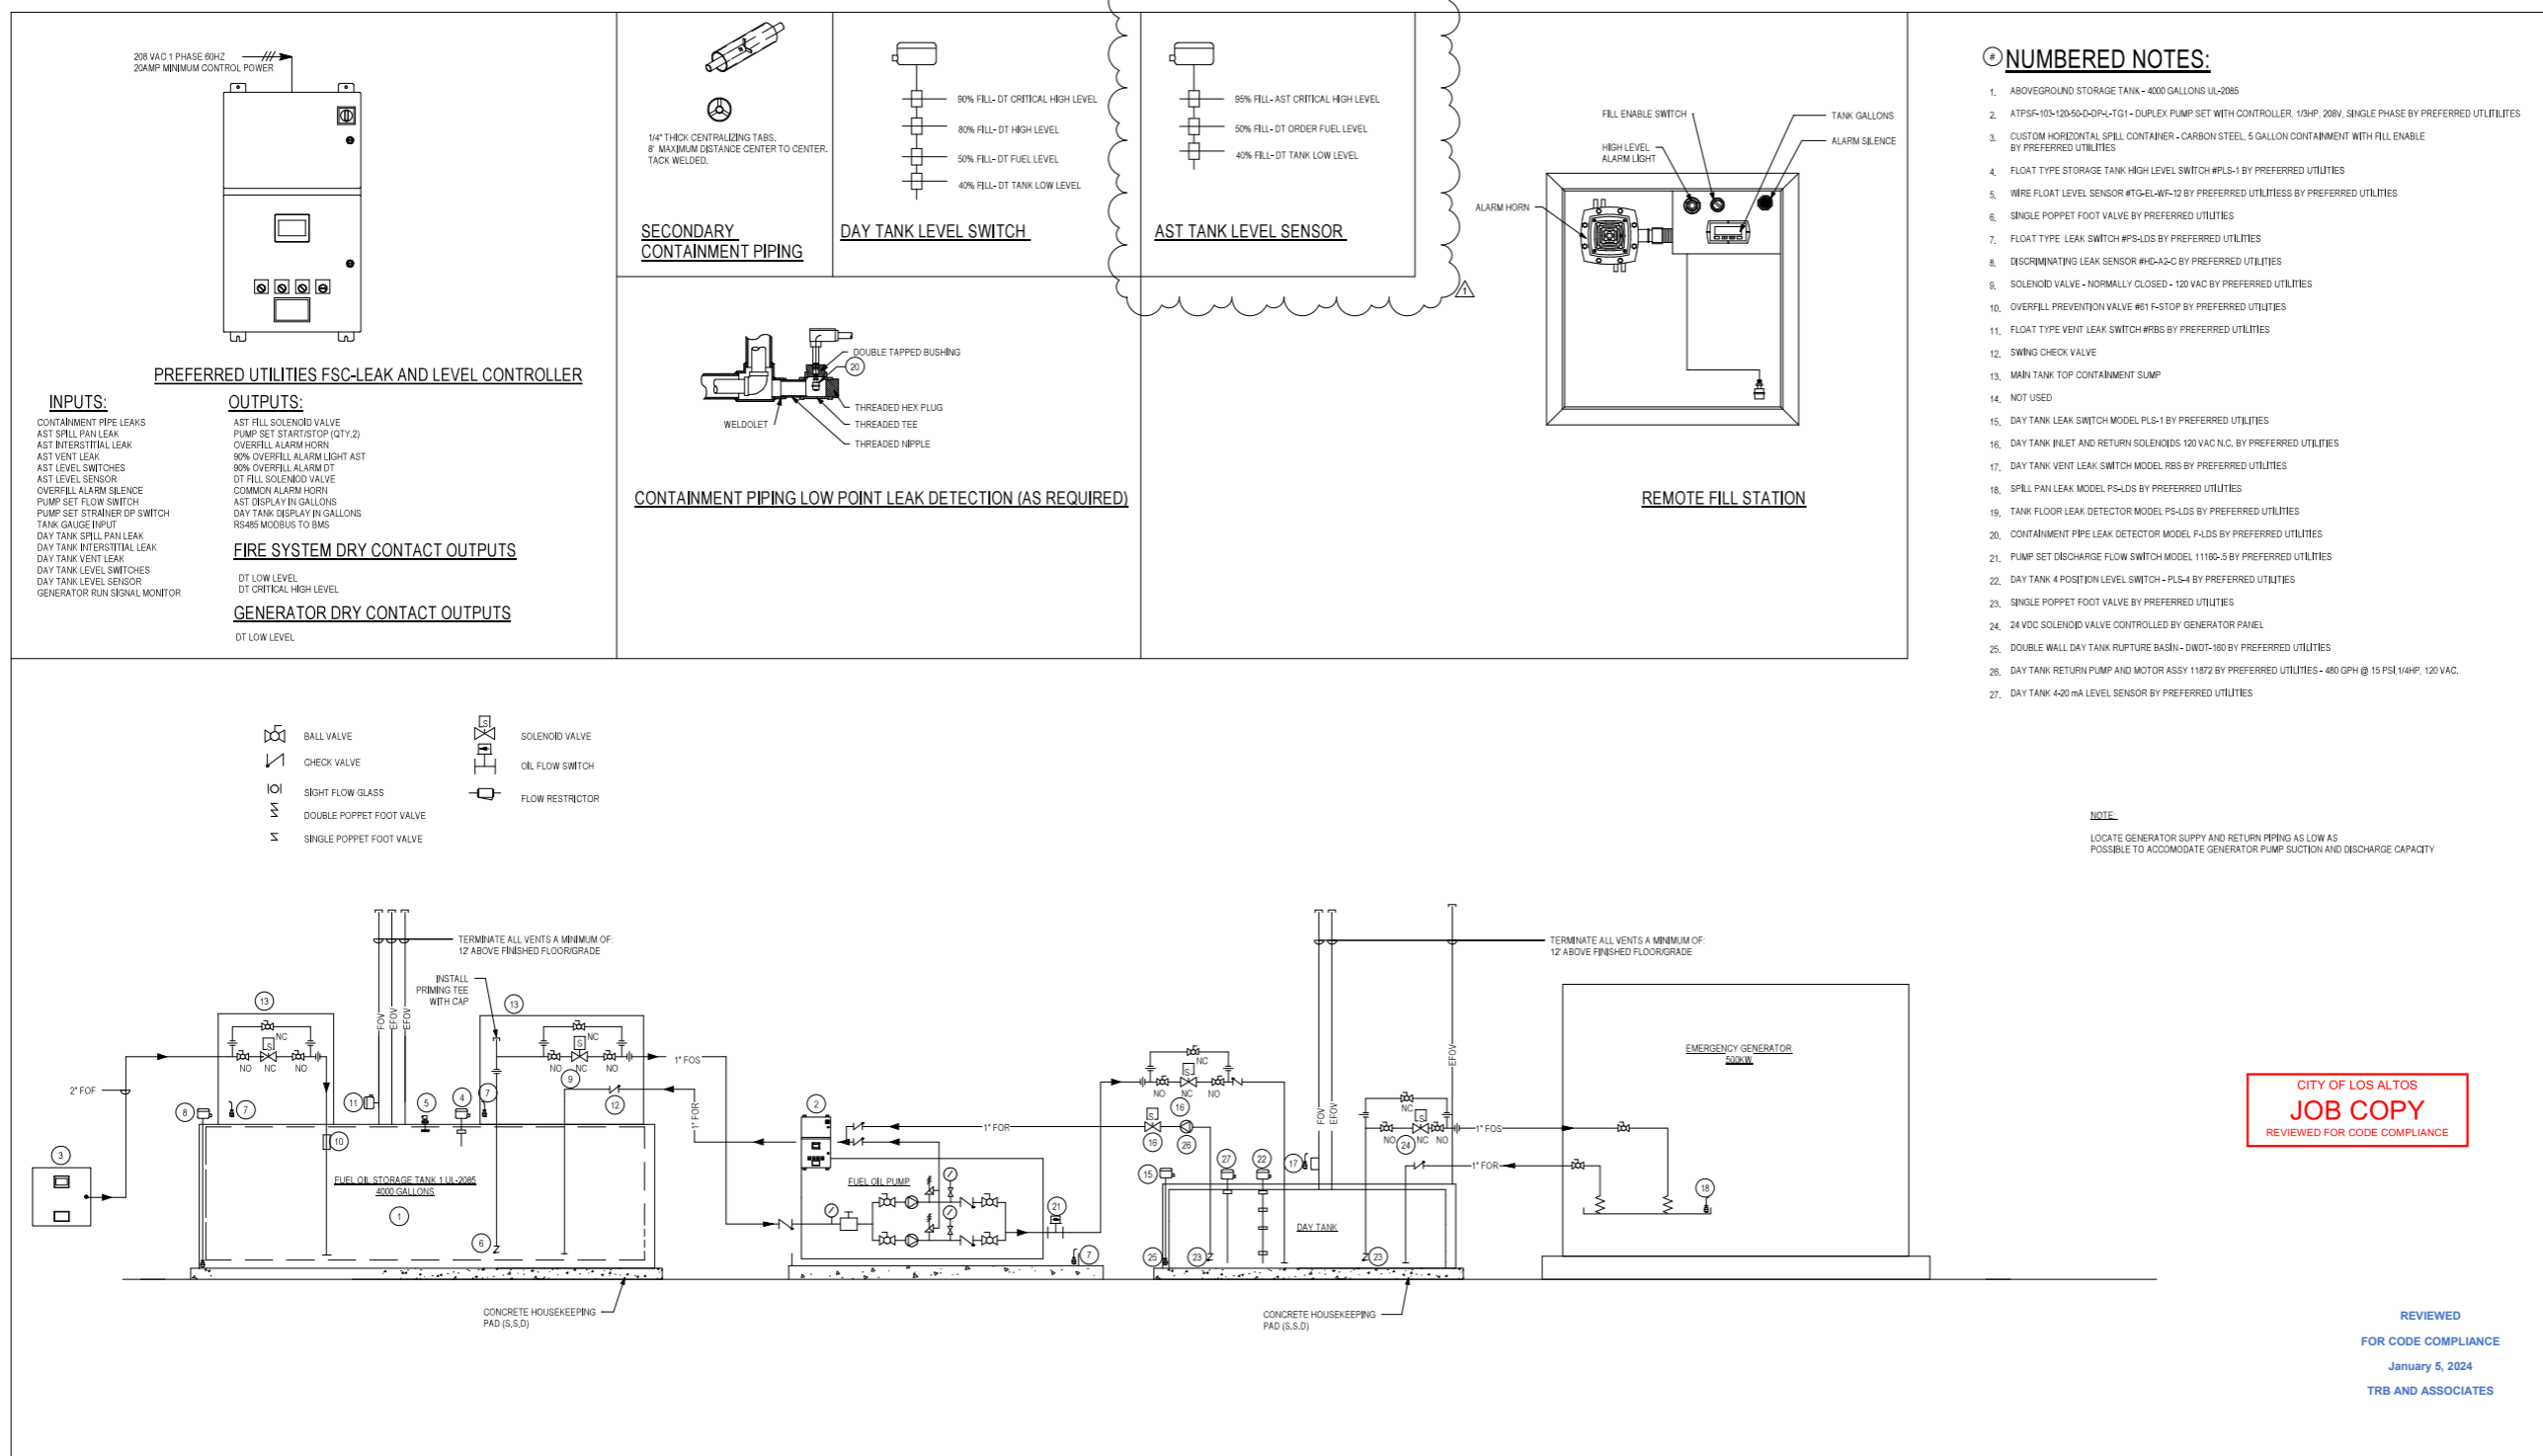

SYMBOLS LIST

	FIRE SMOKE DAMPER BY MECHANICAL, COORDINATE WITH MECHANICAL FOR MONITORING TO FIRE ALARM SYSTEM (INCLUDING SMOKE DETECTOR PROVISIONS), CONTROL OF DAMPER TO BE BY MECHANICAL, U.O.N. PROVIDE TOGGLE TYPE DISCONNECT SWITCH
	FIRE ALARM CONTROL PANEL
	FIRE ALARM ANNUNCIATOR PANEL
	WEATHERPROOF ENCLOSURE
	CONDUIT AND WIRE CONCEALED IN CEILING OR WALL
	CONDUIT AND WIRE CONCEALED IN OR UNDER SLAB OR UNDERGROUND
	CONDUIT AND WIRE RUN EXPOSED
	CROSSMARKS INDICATE QUANTITY OF #12 CONDUCTORS PLUS PARITY SIZED GROUND CONDUCTOR (INCLUDED BUT NOT INDICATED), NO HASHMARKS INDICATES (2)#12 CONDUCTORS PLUS PARITY SIZED GROUND CONDUCTOR, U.O.N.
	GROUND WIRE
	WIRE SIZE 10 AWG FOR ALL CONDUCTORS, INCLUDING GROUND WIRE, THROUGHOUT THE COMPLETE CIRCUIT
	FLEXIBLE METALLIC CONDUIT
	HOMERUN TO PANELBOARD OR TERMINAL BOARD, AS NOTED ON PLANS
	COMPLETE CONNECTION OF EQUIPMENT
	CONDUIT STUBBED OUT, CAPPED AND MARKED
	CONDUIT TURNED UP
	CONDUIT TURNED DOWN
	#4/0 COPPER GROUNDING ELECTRODE CONDUCTOR, U.O.N.
	MECHANICAL EQUIPMENT DESIGNATION - SEE MECHANICAL PLANS
	DETAIL DESIGNATION - SEE DETAIL 3, SHEET E-6
	NUMBERED SHEET NOTE
	UTILITY METER
	CURRENT TRANSFORMERS
	CIRCUIT BREAKER, NUMBER INDICATES 30A 3-POLE
	FEEDER SIZE - SEE POWER SINGLE LINE DIAGRAMS & FEEDER SCHEDULE

ABBREVIATIONS

A.F.F.	ABOVE FINISHED FLOOR
A.F.G.	ABOVE FINISHED GRADE
C	CONDUIT
CATV	CABLE TV
C.O.	CONDUIT ONLY
CU	COPPER
E.C.	ELECTRICAL CONTRACTOR
E	EMERGENCY LIGHT FIXTURE ON EMERGENCY INVERTER, SWITCHABLE, U.O.N.
EMS	ENERGY MANAGEMENT SYSTEM
(E)	EXISTING
EQPT	EQUIPMENT
(ER)	EXISTING EQUIPMENT TO BE RELOCATED
(EX)	EXISTING EQUIPMENT TO BE DISCONNECTED AND REMOVED
EXT	EXTERIOR
FMC	FLEXIBLE METALLIC CONDUIT
GFI	GROUND FAULT CIRCUIT INTERRUPTING TYPE RECEPTACLE
IDF	INTERMEDIATE DISTRIBUTION FRAME
L	LOCKABLE
LV	LOW VOLTAGE
MCB	MAIN CIRCUIT BREAKER
MDF	MAIN DISTRIBUTION FRAME
MFR	MANUFACTURER
MLO	MAIN LUGS ONLY
MTD	MOUNTED
(N)	NEW
N.E.C.	NATIONAL ELECTRICAL CODE
NEU	NEUTRAL
N.I.E.C.	NOT IN ELECTRICAL CONTRACT
O.A.H.	OVERALL HEIGHT
O.F.C.I.	OWNER FURNISHED, CONTRACTOR INSTALLED
P	INDICATES FIXTURES ON PHOTOCCELL CONTROL
PA	PUBLIC ADDRESS
PNL	PANEL
S.A.D.	SEE ARCHITECTURAL DRAWINGS
STC	SIGNAL TERMINAL CABINET
TC	INDICATES FIXTURES ON TIMECLOCK CONTROL
TELE	TELEPHONE
TVSS	TRANSIENT VOLTAGE SURGE SUPPRESSION
U.O.N.	UNLESS OTHERWISE NOTED
VAV	VAV BOX, SEE MECHANICAL DIVISION DRAWINGS FOR LOCATIONS, PROVIDE TOGGLE TYPE DISCONNECT SWITCH
WP	WEATHER PROOF, NEMA 3R
WPIU	WEATHER PROOF WHILE IN USE

SYMBOLS LIST

	ISOLATED RELAY INTERFACE; SEE DETAILS FOR TYPE
	EMERGENCY LIGHTING CONTROL MODULE
	OCCUPANCY SENSOR POWER PACK MOUNTED IN CONCEALED ACCESSIBLE LOCATION
	MAIN SWITCHBOARD, DISTRIBUTION PANEL OR MOTOR CONTROL CENTER
	FLUSH MOUNTED PANELBOARD, 6'-6" TO TOP
	SURFACE MOUNTED PANELBOARD, 6'-6" TO TOP
	FUSED EQUIPMENT DISCONNECT SWITCH WITH FUSE SIZE AS RECOMMENDED BY EQUIPMENT MANUFACTURER
	MOTOR DISCONNECT SWITCH; HORSEPOWER RATED, NON FUSE
	COMBINATION MOTOR STARTER & DISCONNECT, SEE 8/E7.02
	VARIABLE FREQUENCY DRIVE, FURNISHED BY MECHANICAL, INSTALLED & CONNECTED COMPLETE BY ELECTRICAL
	MANUAL MOTOR STARTER WITH OVERLOAD PROTECTION
	MOTOR WITH FLEXIBLE CONDUIT CONNECTION AND DISCONNECT
	TRANSFORMER
	CONCRETE PULLBOX, SIZE AS REQUIRED OR SHOWN - CHRISTY OR EQUAL WITH LABELED LID PER USE
	EV CHARGER
	COPPER GROUND ROD
	FLUSH CEILING MOUNTED JUNCTION BOX, U.O.N.
	FLUSH WALL MOUNTED JUNCTION BOX, +15'A.F.F. MIN. TO BOTTOM OF BOX
	JUNCTION BOX FLUSH FLOOR MOUNTED
	20A 3PG 125V DUPLEX RECEPTACLE, +15'A.F.F. MIN. TO BOTTOM OF BOX
	20A 3PG 125V DUPLEX RECEPTACLE, WEATHERPROOF, +15'A.F.F. MIN. TO BOTTOM OF BOX
	20A 3PG 125V DUPLEX RECEPTACLE, GROUND FAULT CIRCUIT INTERRUPTER TYPE, +15'A.F.F. MIN. TO BOTTOM OF BOX
	20A 3PG 125V DUPLEX RECEPTACLE, ISOLATED GROUND TYPE, +15'A.F.F. MIN. TO BOTTOM OF BOX
	20A 3PG 125V DUPLEX RECEPTACLE, TAMPER RESISTANT, +15'A.F.F. MIN. TO BOTTOM OF BOX
	20A 3PG 125V DUPLEX RECEPTACLE, MOUNTED ABOVE COUNTER, U.O.N.
	20A 3PG 125V DOUBLE DUPLEX RECEPTACLE, +15'A.F.F. MIN. TO BOTTOM OF BOX
	20A 3PG 125V DOUBLE DUPLEX RECEPTACLE, MOUNTED ABOVE COUNTER, U.O.N.
	20A 3PG 125V SINGLE RECEPTACLE, +15'A.F.F. MIN. TO BOTTOM OF BOX
	20A 3PG 125V SINGLE TWISTLOCK RECEPTACLE, NEMA LS-20R, +15'A.F.F. MIN. TO BOTTOM OF BOX
	SPECIAL RECEPTACLE AS INDICATED ON PLANS
	CONTROLLED AND IDENTIFIED (SPLIT-WIRED) DUPLEX RECEPTACLE, WITH ONE HALF OF RECEPTACLE WIRED THROUGH LOCAL PLUG-LOAD CONTROLLER, +15'A.F.F. MIN. TO BOTTOM OF BOX
	CONTROLLED AND IDENTIFIED 20A 3PG 125V DUPLEX RECEPTACLE
	FLUSH IN FLOOR OUTLET BOX WITH QUANTITY OF 20A 3PG 125V DUPLEX RECEPTACLES AS INDICATED ON PLANS
	SURFACE MOUNTED WIREMOLD RACEWAY WITH RECEPTACLES AS INDICATED ON PLANS
	TERMINAL MOUNTING BACKBOARD, 3/4" PLYWOOD, DIMENSIONS AS NOTED ON PLANS, PAINT TO MATCH ADJACENT WALL SURFACE, MAINTAINING UL FIRE LABEL VISIBLE
	TELEPHONE OUTLET, +15'A.F.F. MIN. TO BOTTOM OF BOX
	ADAPT OUTLET, +15'A.F.F. MIN. TO BOTTOM OF BOX
	FIRE ALARM SYSTEM MANUAL PULL STATION, +48'A.F.F. MAX. TO TOP OF BOX
	FIRE ALARM SYSTEM HORN/STROBE, UP 80" U.O.N. NUMBER ADJACENT INDICATES CANDELA VALUE FOR STROBE
	WEATHERPROOF FIRE ALARM SYSTEM HORN/STROBE, UP 80" U.O.N. NUMBER ADJACENT INDICATES CANDELA VALUE FOR STROBE
	FIRE ALARM SYSTEM STROBE, UP 80" U.O.N. NUMBER ADJACENT INDICATES CANDELA VALUE FOR STROBE
	WEATHERPROOF FIRE ALARM SYSTEM HORN, UP 90" U.O.N.
	FIRE ALARM SYSTEM SPEAKER/STROBE, UP 80" U.O.N. NUMBER ADJACENT INDICATES CANDELA VALUE FOR STROBE
	FIRE ALARM SYSTEM SPEAKER, UP 90" U.O.N.
	WEATHERPROOF FIRE ALARM SYSTEM SPEAKER, UP 90" U.O.N.
	FIRE ALARM SYSTEM SPEAKER, CEILING MOUNTED
	WALL MOUNTED ELECTROMAGNETIC DOOR HOLD-OPEN DEVICE, FURNISHED BY DIV. 8, INSTALLED & CONNECTED COMPLETE TO FIRE ALARM SYSTEM BY DIV. 28
	FIRE ALARM SYSTEM SPRINKLER FLOW SWITCH, PROVIDE MONITOR MODULE
	FIRE ALARM SYSTEM SMOKE DETECTOR
	POST INDICATING VALVE
	SPRINKLER FLOW ALARM (PROVIDE BY SPRINKLER CONTRACTOR). CONNECT COMPLETE VIA WATER FLOW SWITCH AUX. CONTACTS
	FIRE ALARM SYSTEM SMOKE DETECTOR
	FIRE ALARM SYSTEM HEAT DETECTOR
	FIRE ALARM SYSTEM HVAC DUCT MOUNTED SMOKE DETECTOR. COORDINATE WITH MECHANICAL FOR SUPPLY, INSTALL AND COMPLETE CONNECTION (INCLUDING CONTROL OF HVAC EQUIPMENT) - SEE SPECIFICATIONS
	FIRE ALARM SYSTEM MONITOR MODULE
	FIRE ALARM SYSTEM CONTROL MODULE
	FIRE ALARM SYSTEM CEILING MOUNTED CARBON MONOXIDE DETECTOR WITH SOUNDER BASE
	FIRE ALARM SYSTEM MAGNETIC DOOR HOLD-OPEN
	FIRE ALARM SYSTEM END-OF-LINE RESISTOR

SYMBOLS LIST

ALL SWITCH AND CONTROL MOUNTING HEIGHTS OF 48" SHALL BE TO TOP OF THE DEVICE BOX. ALL RECEPTACLES WITH MOUNTING HEIGHT OF UP TO 18" SHALL BE NO LOWER THAN 15" TO BOTTOM OF THE DEVICE BOX, TYPICAL, U.O.N.

	INDICATES LUMINAIRE TYPE
	RECESSED 2'x2' OR 2'x4' LUMINAIRE, EDGE-LIT FLAT LENS
	SURFACE CEILING OR COVE MOUNTED LUMINAIRE
	UNDER CABINET LUMINAIRE
	SURFACE OR SUSPENDED LENSED STRIPLIGHT
	SURFACE MOUNTED LUMINAIRE
	RECESSED LUMINAIRE WITH DECORATIVE TRIM
	RECESSED DOWNLIGHT LUMINAIRE
	RECESSED WALLWASH LUMINAIRE
	WALL MOUNTED LUMINAIRE
	WALL MOUNTED EXIT SIGN, ARROWS AS NOTED ON PLANS. SHADED AREA INDICATES NUMBER OF FACES
	CEILING MOUNTED EXIT SIGN, ARROWS AS NOTED ON PLANS. SHADED AREA INDICATES NUMBER OF FACES
	LINE VOLTAGE SINGLE POLE TOGGLE SWITCH, LETTER ADJACENT INDICATES RESPECTIVE ZONE CONTROLLED, +48'A.F.F. MAX. TO TOP OF BOX
	LINE VOLTAGE TWO POLE TOGGLE SWITCH, +48'A.F.F. MAX. TO TOP OF BOX
	LINE VOLTAGE THREE-WAY TOGGLE SWITCH, +48'A.F.F. MAX. TO TOP OF BOX
	LINE VOLTAGE KEY OPERATED TOGGLE SWITCH
	LINE VOLTAGE MOTOR RATED TOGGLE SWITCH INSTALLED AT EQPT SHOWN
	LINE VOLTAGE TOGGLE SWITCH WITH PILOT LIGHT, LIGHT IS ON WHEN CIRCUIT IS CLOSED, +48'A.F.F. MAX. TO TOP OF BOX
	LOW VOLTAGE MOMENTARY CONTACT SWITCH
	LOW VOLTAGE KEYSWITCH MOMENTARY CONTACT SWITCH
	WALL MOUNTED SWITCH TYPE INFRARED OCCUPANCY SENSOR; +48'A.F.F. MAX. TO TOP OF BOX; SINGLE OR DUAL AS NOTED BY LETTERS ADJACENT. SET TO FIXED 20 MINUTE TIME DELAY AND MAX SENSITIVITY
	WALL MOUNTED DUAL TECHNOLOGY OCCUPANCY SENSOR; +48'A.F.F. MAX. TO TOP OF BOX; SINGLE OR DUAL AS NOTED BY LETTERS ADJACENT. SET TO FIXED 20 MINUTE TIME DELAY AND MAX SENSITIVITY
	EMERGENCY LIGHT WITH INTEGRAL BATTERY

BASIS OF DESIGN

- THE LOAD CALCULATION ON E6-1 USES THE RECORDED MAXIMUM DEMAND DATA OBTAINED FROM PG&E OVER A 12-MONTH PERIOD, CEC 220.87.
THE MAX PV SYSTEM OUTPUT IS ADDED TO THE PG&E DATA TO ESTABLISH THE ESTIMATED WORST CASE DEMAND LOAD ON THE EXISTING DISTRIBUTION SYSTEM AT THE COMMUNITY CENTER.
THE PV SYSTEM WILL NOT BE AVAILABLE DURING A PG&E POWER OUTAGE, THE PV OUTPUT DATA WAS USED FOR THE LOAD CALCULATION, AS DURING A POWER OUTAGE THE GENERATOR WOULD NEED TO PROVIDE A LOAD EQUIVALENT TO THE WHAT PG&E WOULD PROVIDE TOGETHER WITH THE MAX PV INPUT.
- USING THE LOAD CALCULATION DATA ABOVE, A 500KW GENERATOR WAS SELECTED.
- THE INTENT OF THE PORTABLE GENERATOR HOOK-UP AND MANUAL TRANSFER SWITCH IS TO ALLOW FOR CONNECTION OF A PORTABLE GENERATOR SHOULD THE NEW PERMANENT GENERATOR BE OFFLINE FOR MAINTENANCE, THE PORTABLE GENERATOR IS NOT INTENDED TO OPERATE IN PARALLEL WITH THE NEW GENERATOR 'EG'.
- THE RATINGS OF THE RELOCATED PORTABLE HOOK-UP EQUIPMENT IS RATED AT 1200AMPS, AND THE NEW MANUAL TRANSFER SWITCH IS RATED AT 800AMPS BASED ON THE 800AMP GENERATOR OUTPUT BREAKER FOR THE COMMUNITY CENTER ONLY.
- THE EXISTING COMMUNITY CENTER HAS TWO EMERGENCY LIGHTING INVERTERS AND FIRE ALARM EQUIPMENT WITH BATTERY BACK UP IN COMPLIANCE WITH CEC ARTICLE 700 EMERGENCY LIFE SAFETY SYSTEMS, THE NEW GENERATOR IS NOT INTENDED TO PROVIDE FOR ARTICLE 700 LOADS.
- THE SCOPE OF THIS PROJECT IS TO INSTALL A NEW GENERATOR FOR STAND-BY BACK-UP POWER TO THE COMMUNITY CENTER AND A FUTURE STAND-BY CONNECTION TO ANOTHER CITY ADMIN SPACE, THE NEW GENERATOR WILL NOT REPLACE THE EXISTING EMERGENCY LIGHTING INVERTERS OR FIRE ALARM EQUIPMENT IN THE COMMUNITY CENTER.
- BASED ON THIS APPROACH THE GENERATOR WAS NOT CONSIDERED TO BE REQUIRED TO BE DESIGNED TO MEET CEC ARTICLE 700 OR 701. THE GENERATOR DESIGN IS BASED ON CEC ARTICLE 702, OPTIONAL STANDBY SYSTEMS.

SPECIAL TESTING

IN ADDITION TO THE TESTING IN THE PROJECT SPECIFICATIONS, THE CONTRACTOR SHALL CARRY OUT THE FOLLOWING TESTS:

TESTING SHALL BE CARRIED OUT TO ENSURE THAT ALL EMERGENCY LOADS ARE WORKING AND FUNCTIONING ON EMERGENCY POWER.

- SIMULATE A LOSS OF NORMAL POWER TO NEW AUTOMATIC TRANSFER SWITCH 'ATS-1' BY SWITCHING OFF THE MAIN BREAKER IN THE MAIN SWITCHBOARD.
- RUN THE EMERGENCY LOADS ON THE GENERATOR FOR UP TO FOUR HOURS TO CONFIRM ALL LOADS ARE AVAILABLE FOR RETURNING OPERATION.
- AFTER TESTING RETURN 'ATS-1' TO NORMAL POWER.
- CONTRACTOR SHALL PLAN TO DO THIS TESTING OVER A WEEKEND AFTER NORMAL OPERATING HOURS.
- CONTRACTOR SHALL INCLUDE IN THEIR BID THE FIRST FULL DIESEL TANK FUEL SUPPLY.

GENERAL NOTES

- PRIOR TO BID THE CONTRACTOR SHALL VISIT THE SITE TO ADEQUATELY DETERMINE ALL PRE-EXISTING CONDITIONS. BY THE ACT OF SUBMITTING A BID, THE CONTRACTOR WILL BE DEEMED TO HAVE COMPLIED WITH THE FOREGOING, TO HAVE ACCEPTED SUCH CONDITIONS, AND TO HAVE MADE ALLOWANCES THEREFORE IN PREPARING THE BID.
- PROVIDE PARITY SIZED GREEN GROUND WIRE IN ALL POWER CONDUITS, BRANCH CIRCUITS (LIGHTING & POWER) AND HOMERUNS. PROVIDE ADDITIONAL ISOLATED GROUND, GREEN WITH YELLOW STRIPE, TO ALL ISOLATED GROUND RECEPTACLES.
- PROVIDE PULLROPE IN ALL EMPTY CONDUITS THROUGHOUT THE PROJECT.
- VERIFY EXACT CONNECTION REQUIREMENTS, OUTLET TYPE(S), MOUNTING HEIGHT(S) AND LOCATION(S) OF ALL OWNER-SUPPLIED EQUIPMENT, AND ALL EQUIPMENT PROVIDED UNDER OTHER SECTIONS OF THE SPECIFICATIONS, PRIOR TO ROUGH-IN. REFER TO ARCHITECTURAL DRAWINGS FOR EQUIPMENT LOCATIONS.
- COORDINATE TRENCHING WITH OWNER AND OTHER TRADES BEFORE BEGINNING WORK.
- ALL CONDUIT PENETRATIONS THROUGH FIRE-RATED WALLS AND FLOORS SHALL BE SEALED AND EQUIPPED WITH U.L. LISTED FIRE PENETRATION ASSEMBLIES TO MAINTAIN FIRE SEPARATION RATING.
- DO NOT INSTALL ANY OUTLETS BACK TO BACK IN STUD WALLS OR DE-MOUNTABLE PARTITIONS.
- CIRCUITRY AND CONDUIT ROUTING SHOWN ON THE PLANS IS DIAGRAMMATIC ONLY. THIS CONTRACTOR IS RESPONSIBLE FOR BECOMING COMPLETELY FAMILIAR WITH THE ARCHITECTURAL AND STRUCTURAL CONDITIONS AND LIMITATIONS IN THE BUILDING AND TO PROVIDE ALL LABOR, TOOLS AND MATERIALS REQUIRED TO PRODUCE A COMPLETELY CONCEALED INSTALLATION WHEREVER INDICATED ON THE PLANS.
- MAINTAIN "AS-BUILT" RECORDS AT ALL TIMES, SHOWING EXACT LOCATION OF ALL UNDERGROUND AND/OR CONCEALED CONDUITS AND SERVICES INSTALLED UNDER THIS CONTRACT, INCLUDING CIRCUIT IDENTIFICATION WHERE APPLICABLE. PROVIDE OWNER WITH "AS-BUILT" DOCUMENTS AS INDICATED IN THE SPECIFICATIONS, AND/OR CALLED FOR IN THE SPECIFICATIONS.
- DRAWINGS INDICATE THE LOCATION(S) OF DEVICES, LUMINAIRE(S) AND EQUIPMENT, AND THE CIRCUIT NUMBER AND PANEL DESIGNATED TO SUPPLY THEM. THE CONTRACTOR SHALL BE RESPONSIBLE FOR COMPLETELY CONNECTING ALL ELECTRICAL DEVICES TO CIRCUITS INDICATED ON THE DRAWINGS.
- UNLESS OTHERWISE NOTED, ALL WORK SHOWN ON DRAWINGS IS NEW AND TO BE PROVIDED AND INSTALLED COMPLETE UNDER THIS CONTRACT.
- ALL EQUIPMENT GROUNDING SHALL CONFORM TO ARTICLE 250 OF THE NATIONAL ELECTRICAL CODE, LATEST EDITION.
- ALL EXTERIOR CONDUIT ABOVE GRADE, INCLUDING ALL ROOF MOUNTED CONDUIT, SHALL BE GALVANIZED RIGID STEEL. COAT ALL EXPOSED THREADS WITH GALVANIZING PAINT. PAINT ALL SURFACE MOUNTED RACEWAYS AND PULLBOXES TO MATCH SURROUNDING CONDITIONS, AS DIRECTED BY THE ARCHITECT.
- ALL ELECTRICAL WORK SHALL BE CARRIED OUT IN ACCORDANCE WITH THE 2022 EDITION OF THE C.E.C., AS WELL AS STATE, AND LOCAL CODES AND REQUIREMENTS.
- ALL CONDUIT SHALL BE CONCEALED, UNLESS OTHERWISE NOTED.
- EQUIPMENT OVERLOADS AND FUSES SHALL BE PROVIDED AND INSTALLED AS PER NAME PLATE ON THE EQUIPMENT ACTUALLY PROVIDED.
- THE CONTRACTOR SHALL VERIFY ALL CRITICAL DIMENSIONS WITH THE ARCHITECTURAL DRAWINGS PRIOR TO ROUGH-IN.
- USE FLEXIBLE CONDUIT FOR ALL MOTOR, TRANSFORMER, RECESSED LUMINAIRE CONNECTIONS, AND CONNECTIONS BETWEEN TWO SEPARATE STRUCTURES AND FOR ALL FINAL CONNECTIONS TO "CRITICAL EQUIPMENT" AS DEFINED IN SPECIFICATIONS. MINIMUM 1/2" DIAMETER, LIQUID TIGHT TYPE USED OUTDOORS AND IN ALL WET LOCATIONS; PROVIDE WITH CODE-SIZE (MINIMUM #12) BARE GROUND WIRE IN ALL FLEXIBLE CONDUIT.
- PROVIDE A DEDICATED NEUTRAL CONDUCTOR FOR ALL BRANCH CIRCUITS.
- ALL CONDUIT CONNECTORS TO OUTLET OR JUNCTION BOXES SHALL HAVE INSULATED THROATS (MANUFACTURED AS AN INTEGRAL PART OF THE CONNECTOR). AFTER-MARKET INSERTABLE THROATS ARE NOT ACCEPTABLE.
- ALL CIRCUITS IN ALL JUNCTION BOXES AND DEVICES SHALL BE CLEARLY IDENTIFIED BY MEANS OF "EZ" NUMBERING TAGS OR EQUIVALENT, TO IDENTIFY THE CIRCUIT NUMBER OR RELAY SUPPLYING THE CONDUCTOR. ALL JUNCTION BOXES SHALL BE LABELED PER SPECIFICATIONS.
- ALL SURFACE MOUNTED POWER AND SIGNAL BOXES IN FINISHED AREAS SHALL BE "WIREFOLD" TYPE, WITH MATCHING RACEWAYS. SURFACE MOUNTED STEEL JUNCTION BOXES AND/OR EMT ARE NOT ACCEPTABLE.
- ALL LOCATIONS OF BARE METAL SURFACE MOUNTED CONDUIT, BOXES, PANEL COVERS, AND RELATED FITTINGS OR ACCESSORIES INSTALLED IN FINISHED AREAS (BOTH INTERIOR AND EXTERIOR) SHALL BE FINISH PAINTED TO MATCH THE SURFACE TO WHICH THEY ARE MOUNTED TO (AFTER INSTALLATION). PAINTING SHALL INCLUDE DIFFERENT COLORS AS REQUIRED TO MATCH EXISTING STRIPING OR OTHER BUILDING FEATURES TO WHICH THE EQUIPMENT IS ATTACHED AND VISIBLE, VERIFY EXACT JUNCTION BOX LOCATION(S) AND ROUTING OF EXPOSED RACEWAYS WITH THE ARCHITECT PRIOR TO ROUGH-IN.
- PROVIDE A BLANK COVER PLATE (COLOR TO MATCH ADJACENT DEVICES OR AS SPECIFICALLY CALLED FOR IN SPECIFICATIONS) FOR ALL JUNCTION BOXES (NEW AND EXISTING) ON THE PROJECT WHEN NO DEVICE IS INSTALLED.
- FOR OUTDOOR 15 AND 20-AMPERE, 125 AND 250-VOLT RECEPTACLES: RECEPTACLES LOCATED IN "WET" LOCATIONS SHALL HAVE "IN-USE" TYPE WEATHERPROOF COVER PLATES PROVIDED AND INSTALLED; RECEPTACLES LOCATED IN "DAMP" LOCATIONS SHALL HAVE "IN-USE" TYPE WEATHERPROOF COVER PLATES IN LOCATIONS DEEMED TO BE "IN-USE" WITH CORO AND PLUG ATTACHED.
- PROVIDE PANEL AND CIRCUIT DESIGNATION LABELS FOR ALL RECEPTACLES AND DISCONNECTS ON THE PROJECT.
- ALL ELECTRICAL EQUIPMENT MUST BE UL LISTED OR APPROVED BY AN ACCREDITED THRD PARTY TESTING AGENCY.

SPECIAL NOTE

ALL POWER INTERRUPTIONS SHALL BE SCHEDULED MINIMUM TWO WEEKS IN ADVANCE WITH THE OWNER AND CAN ONLY OCCUR IN THE MIDDLE OF THE NIGHT FROM MIDNIGHT TO 5AM OR WEEKENDS/HOLIDAYS OR AT OTHER TIMES IF APPROVED IN ADVANCE BY THE OWNER.

LIST OF DRAWINGS

E0-1	SYMBOLS LIST, GENERAL NOTES & LIST OF DRAWINGS
E1-0	CIVIC CAMPUS PLAN EOC - ELECTRICAL
E1-1	SITE PLAN EOC - ELECTRICAL
E1-2	SITE PLAN WEST - ELECTRICAL
E3-1	EOC FLOOR PLAN - ELECTRICAL
E3-2	EOC ROOF PLAN - ELECTRICAL
E4-1	PARTIAL PLAN - GENERATOR AREA
E4-2	PARTIAL PLANS - ELECTRICAL
E4-3	PARTIAL PLAN - ELECTRICAL
E4-4	PARTIAL PLAN - ELECTRICAL
E4-5	PARTIAL PLANS - ELECTRICAL
E5-1	SINGLE LINE DIAGRAM - POWER
E5-2	DIAGRAMS
E6-1	SCHEDULES
E7-1	DETAILS
E8-1	TITLE 24 DOCUMENTATION

CITY OF LOS ALTOS
JOB COPY
REVIEWED FOR CODE COMPLIANCE

REVIEWED
FOR CODE COMPLIANCE
January 5, 2024
TRB AND ASSOCIATES


NOLL & TAM ARCHITECTS

729 Heinz Avenue
Berkeley, CA 94710
tel 510.542.2200
fax 510.542.2201

O'MAHONY & MYER
THE PROFESSIONAL ENGINEERS AND ARCHITECTS
4340 Redwood Hwy., Suite 245
San Rafael, California 94903
Tel (415) 492-0420 Fax (415) 476-9662
www.omcconsulting.com

SEAL

REVISIONS	DATE	DESCRIPTION
1	11/15/2023	PERMIT PLAN CHECK RESPONSE

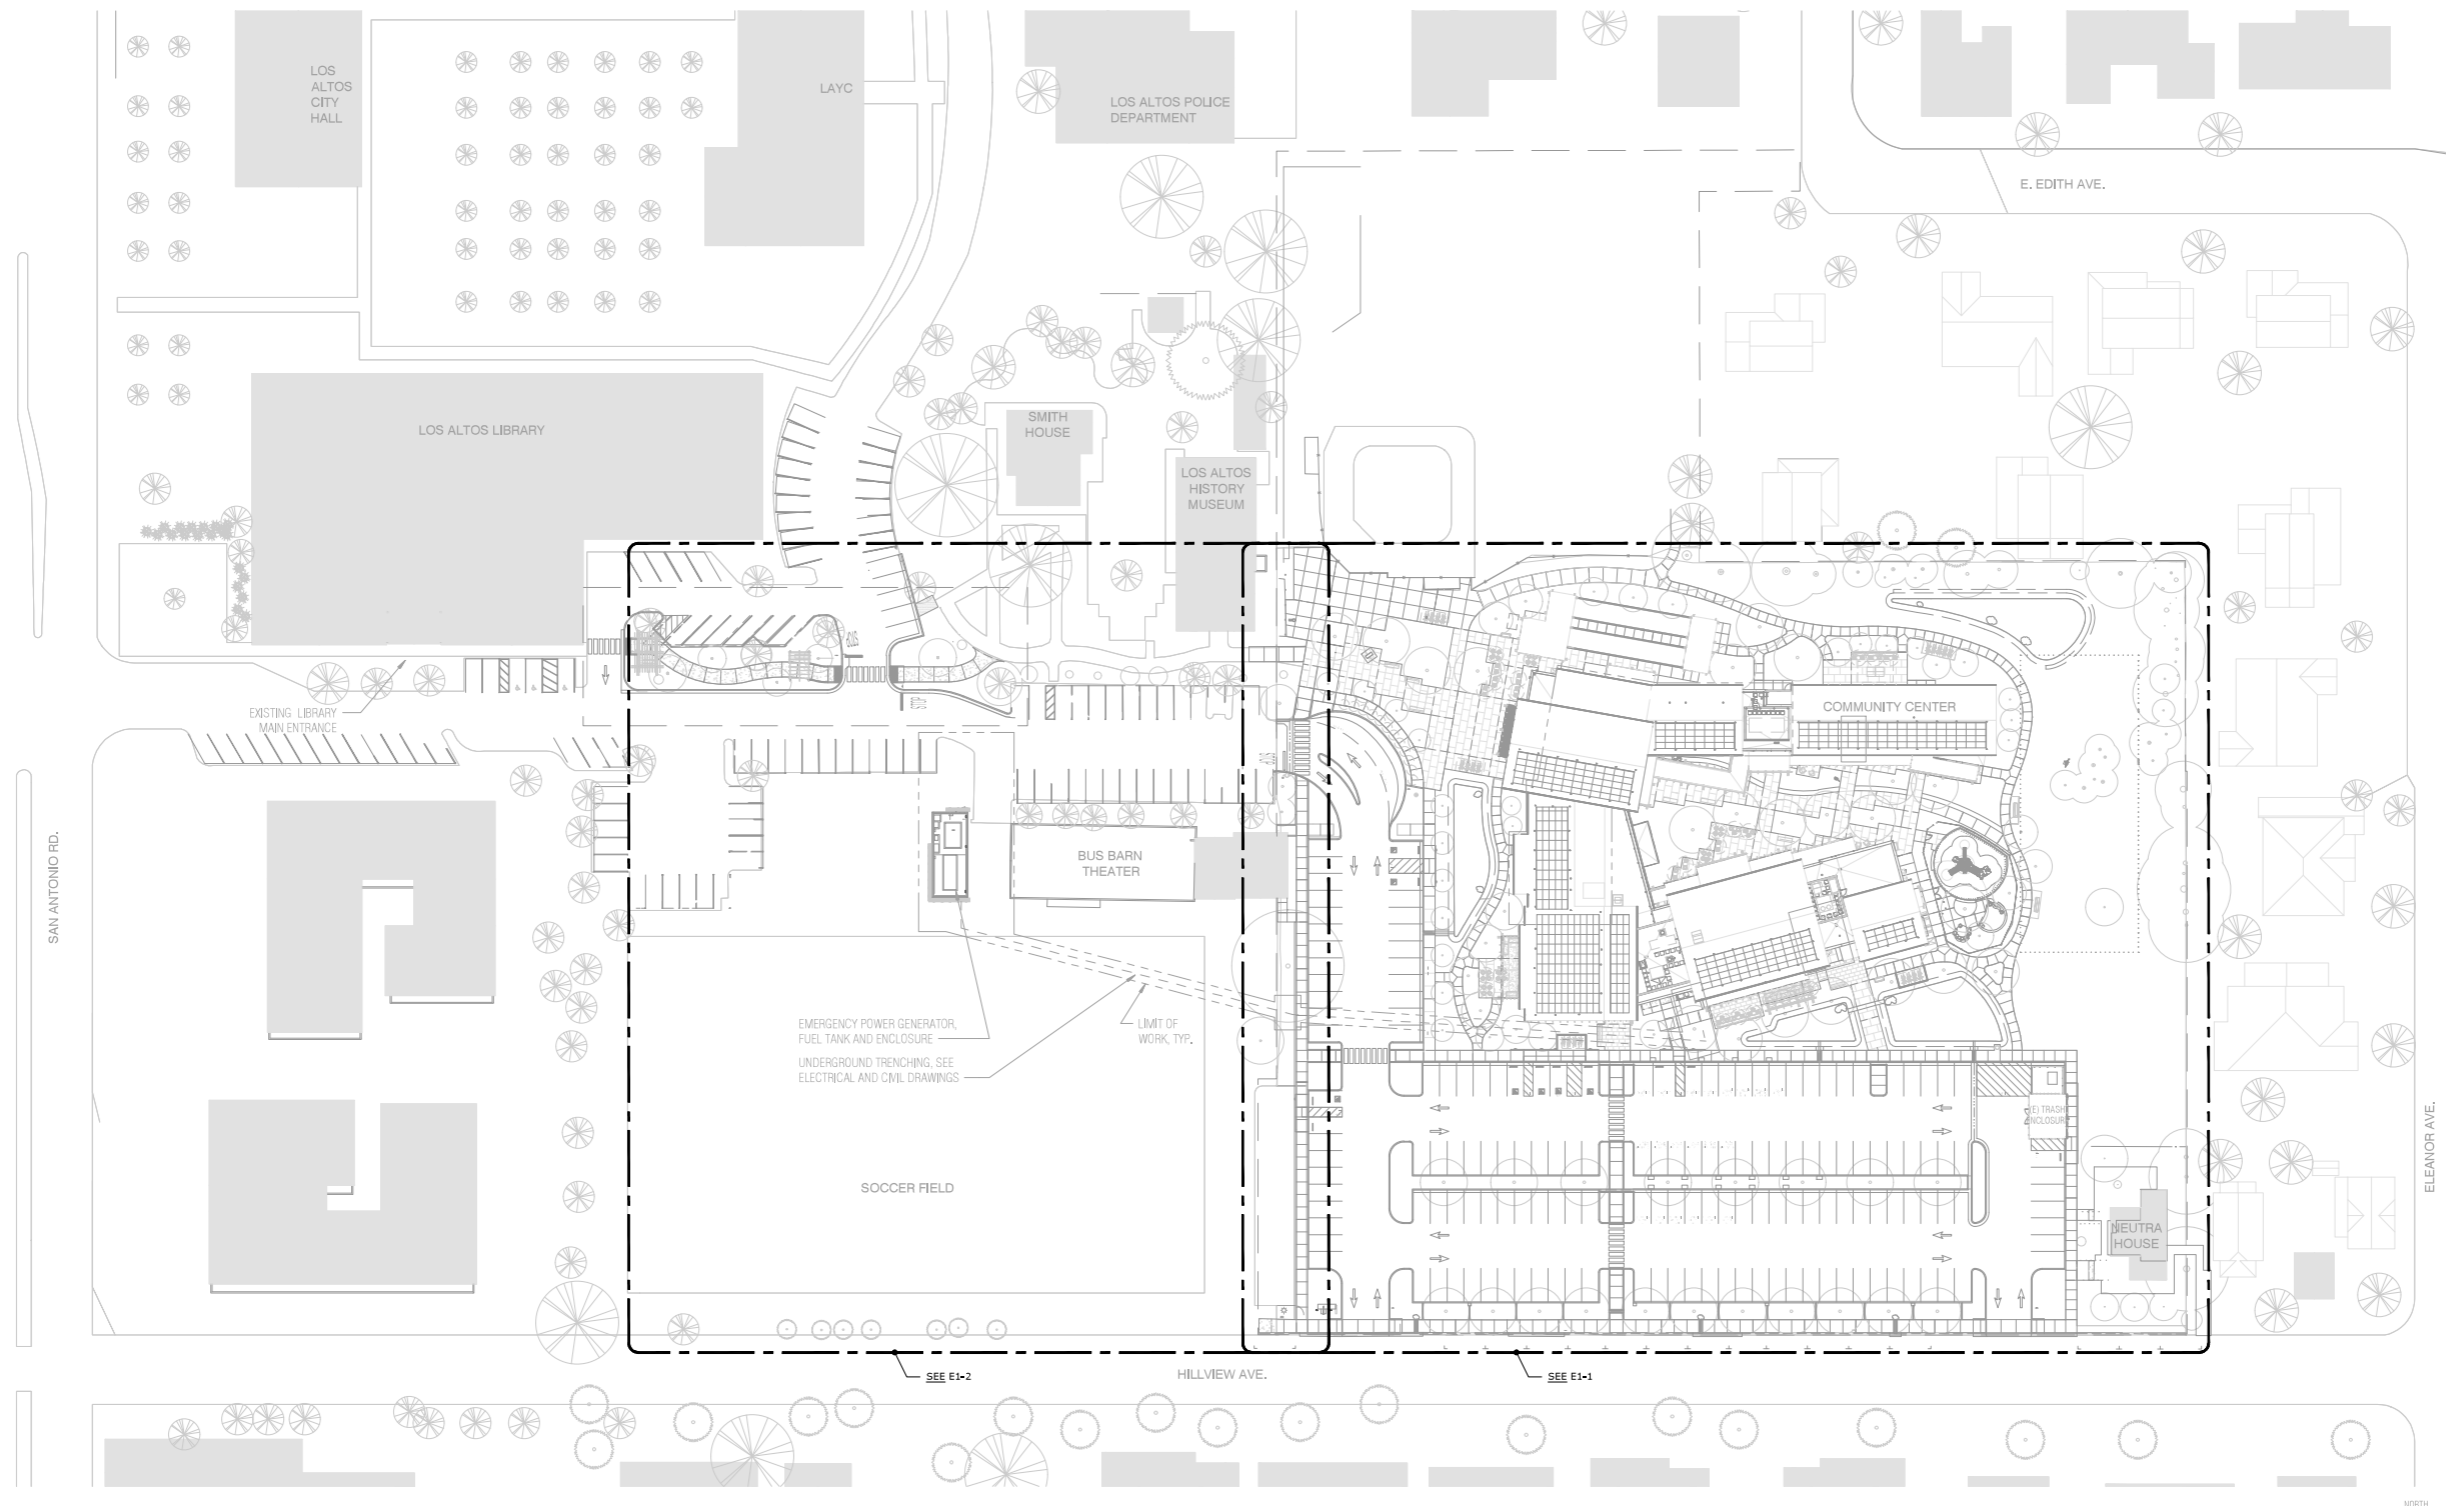

EMERGENCY POWER GENERATOR,
FUEL TANK AND ENCLOSURE
UNDERGROUND TRENCHING, SEE
ELECTRICAL AND CIVIL DRAWINGS

LIMIT OF WORK, TYP.

SEE E1-2

HILLVIEW AVE.

SEE E1-1

CITY OF LOS ALTOS
JOB COPY
REVIEWED FOR CODE COMPLIANCE

REVIEWED
FOR CODE COMPLIANCE
January 5, 2024
TRB AND ASSOCIATES

CIVIC CAMPUS PLAN EOC - ELECTRICAL


SCALE: 1" = 40'-0"



APPROVALS

NOLL & TAM
ARCHITECTS

729 Heinz Avenue
Berkeley, CA 94710
tel 510.542.2200
fax 510.542.2201

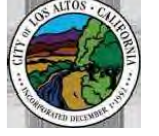

O'MAHONY & MYER
ELECTRICAL ENGINEERS AND CONSULTANTS
4340 Redwood Hwy., Suite 245
San Rafael, California 94903
Tel (415) 492-0420 Fax (415) 478-9662
www.omcconsulting.com

SEAL



PROJECT TITLE

**City of Los Altos
EMERGENCY OPERATION
CENTER**

97 Hillview Ave. Los Altos, CA
94022

ISSUE TITLE

PERMIT SET

ISSUE DATE

AUG 03, 2023

NOLL & TAM JOB NUMBER

22203

REVISIONS


DATE	DESCRIPTION
11/15/2023	PERMIT PLAN CHECK RESPONSE

SHEET TITLE

**CIVIC CAMPUS PLAN
EOC - ELECTRICAL**

SHEET NUMBER

E1-0

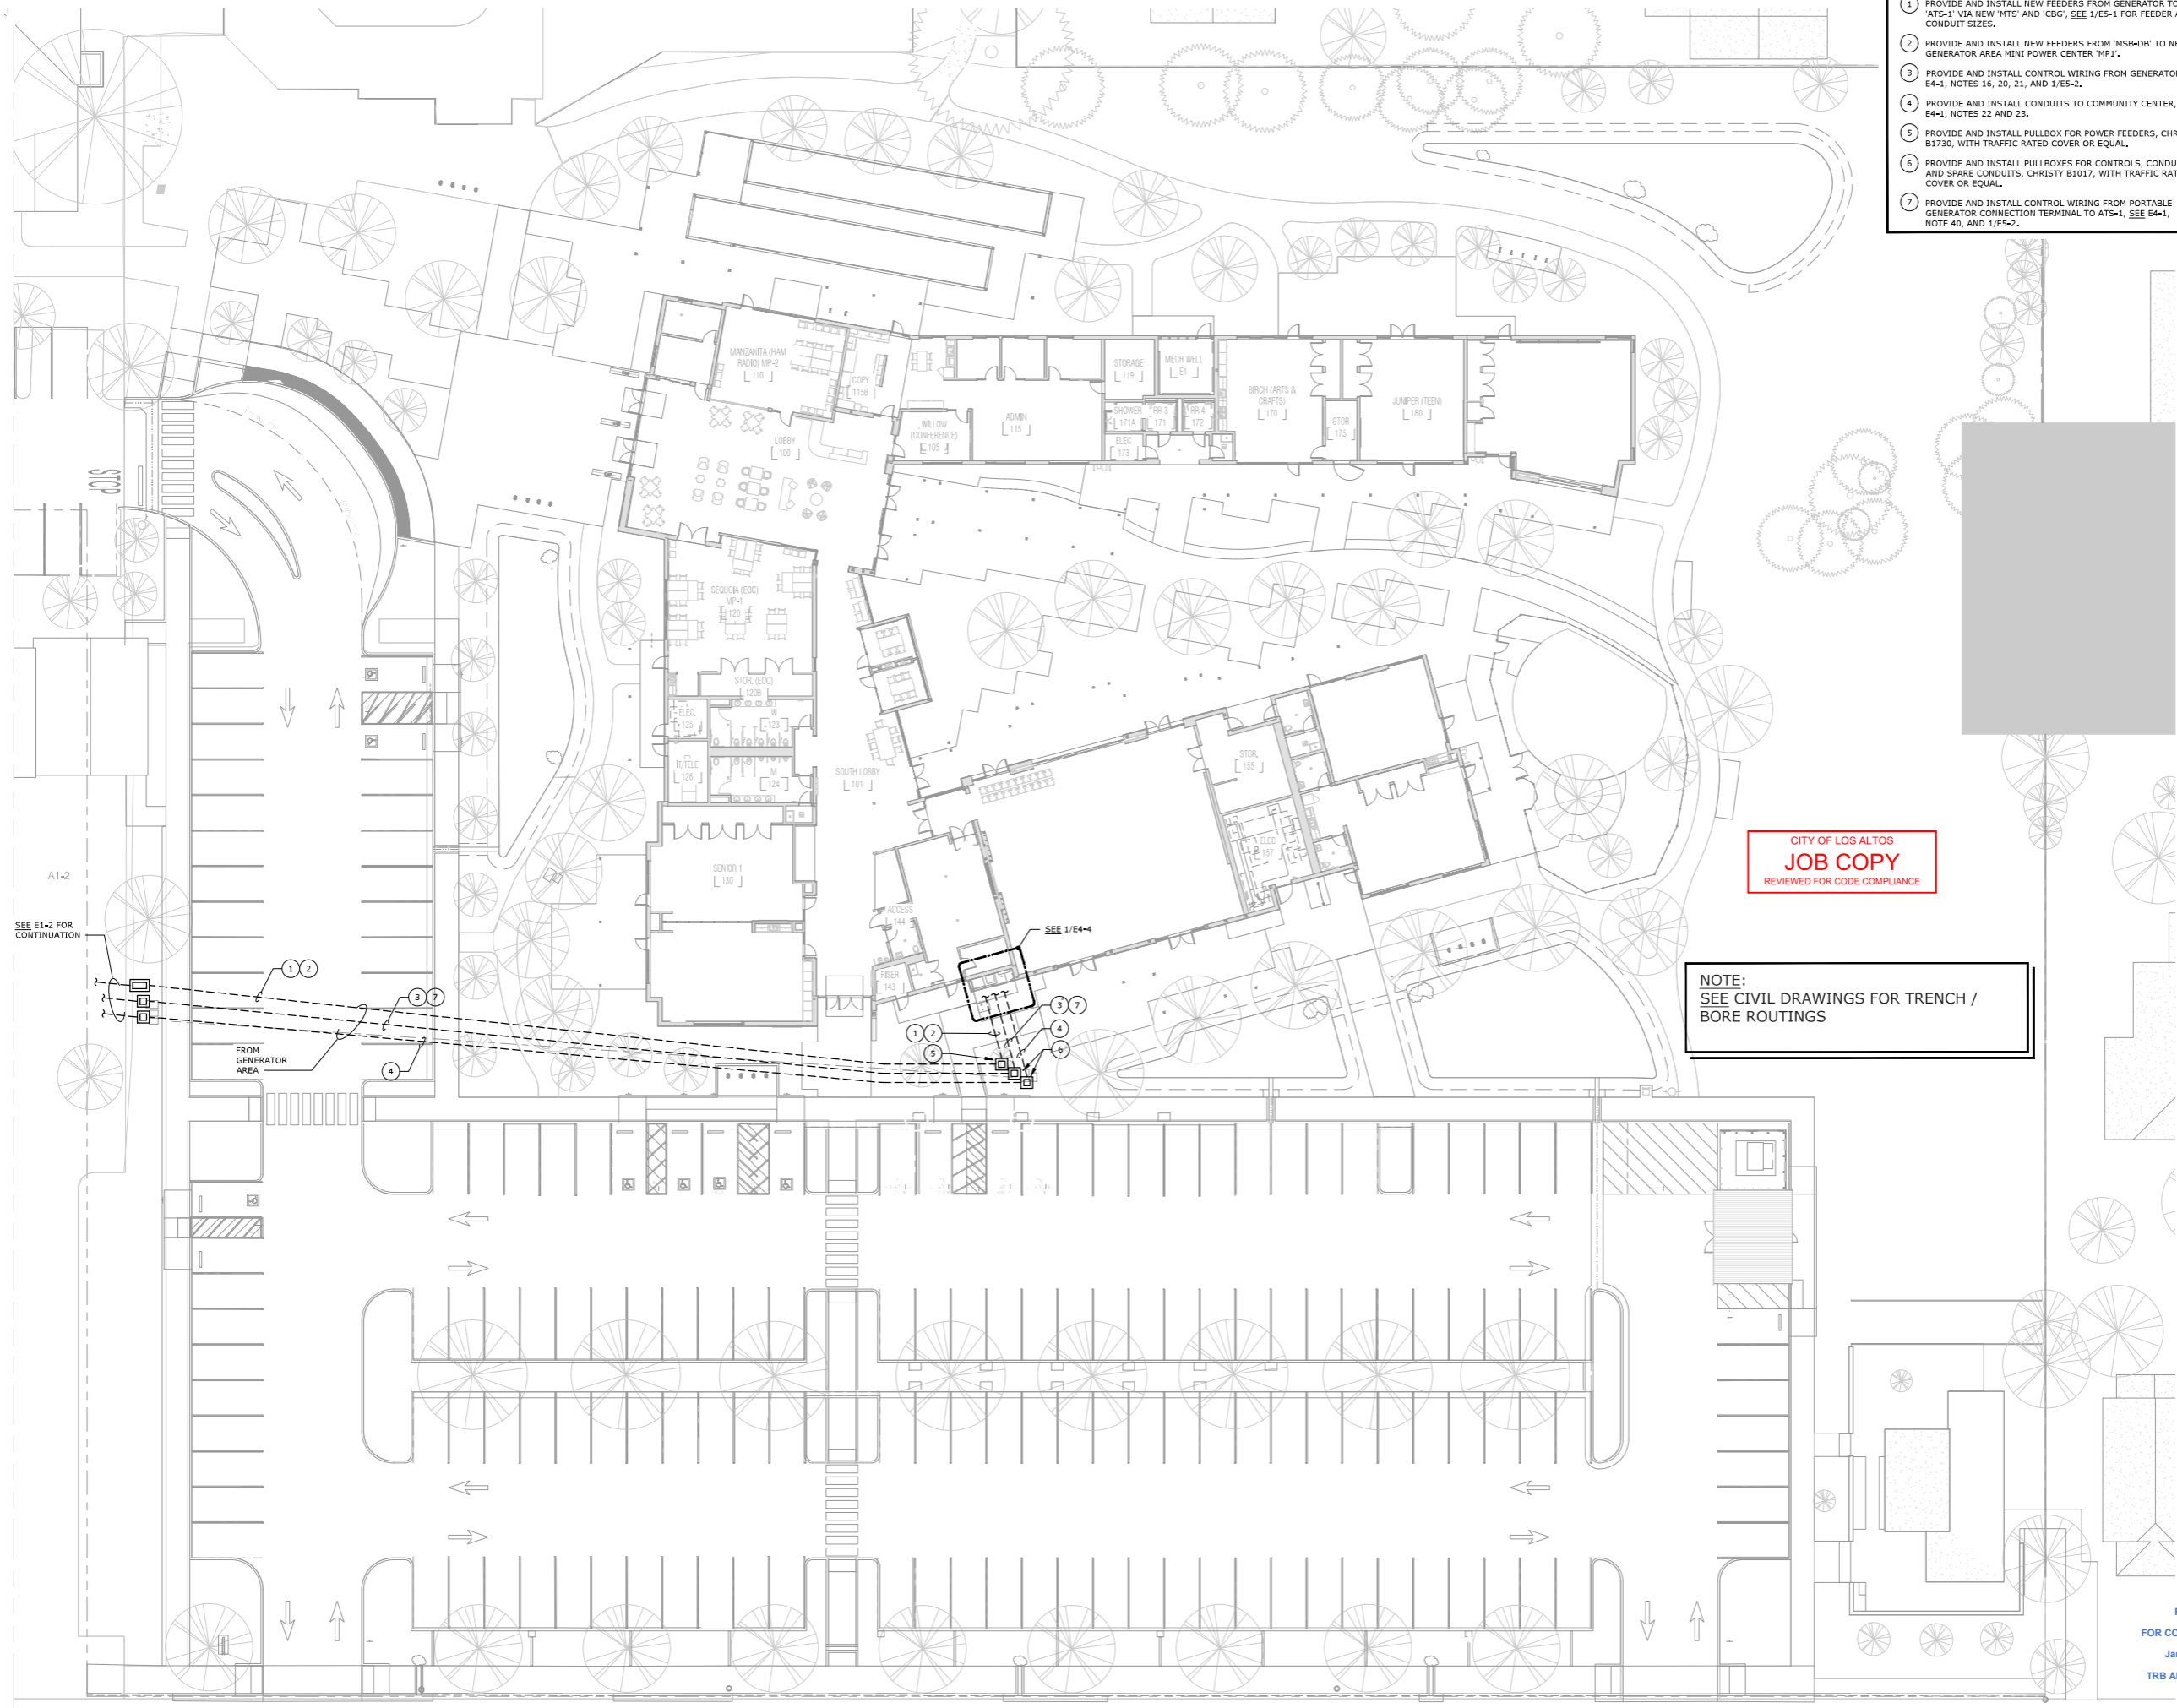

- NUMBERED SHEET NOTES**
- 1 PROVIDE AND INSTALL NEW FEEDERS FROM GENERATOR TO NEW 'ATS-1' VIA NEW 'MTS' AND 'CBG', SEE 1/E5-1 FOR FEEDER AND CONDUIT SIZES.
 - 2 PROVIDE AND INSTALL NEW FEEDERS FROM 'MSB-DB' TO NEW GENERATOR AREA MINI POWER CENTER 'MP1'.
 - 3 PROVIDE AND INSTALL CONTROL WIRING FROM GENERATOR, SEE E4-1, NOTES 16, 20, 21, AND 1/E5-2.
 - 4 PROVIDE AND INSTALL CONDUITS TO COMMUNITY CENTER, SEE E4-1, NOTES 22 AND 23.
 - 5 PROVIDE AND INSTALL PULLBOX FOR POWER FEEDERS, CHRISTY B1730, WITH TRAFFIC RATED COVER OR EQUAL.
 - 6 PROVIDE AND INSTALL PULLBOXES FOR CONTROLS, CONDUITS AND SPARE CONDUITS, CHRISTY B1017, WITH TRAFFIC RATED COVER OR EQUAL.
 - 7 PROVIDE AND INSTALL CONTROL WIRING FROM PORTABLE GENERATOR CONNECTION TERMINAL TO ATS-1, SEE E4-1, NOTE 40, AND 1/E5-2.

CITY OF LOS ALTOS
JOB COPY
REVIEWED FOR CODE COMPLIANCE

NOTE:
SEE CIVIL DRAWINGS FOR TRENCH /
BORE ROUTINGS

SEE E1-2 FOR CONTINUATION

FROM GENERATOR AREA

SITE PLAN EOC - ELECTRICAL
SCALE: 1/16" = 1'-0"



APPROVALS

NOLL & TAM ARCHITECTS
729 Heinz Avenue
Berkeley, CA 94710
tel 510.542.2200
fax 510.542.2201

O'MAHONY & MYER
4340 Redwood Hwy., Suite 245
San Rafael, California 94903
Tel (415) 492-0420 Fax (415) 479-9662
www.omcconsulting.com

SEAL

PROJECT TITLE
**City of Los Altos
EMERGENCY OPERATION CENTER**
97 Hillview Ave. Los Altos, CA 94022

ISSUE TITLE
PERMIT SET

ISSUE DATE
AUG 03, 2023

NOLL & TAM JOB NUMBER
22202

REVISIONS

DATE	DESCRIPTION
11/15/2023	PERMIT PLAN CHECK RESPONSE


SHEET TITLE
SITE PLAN EOC - ELECTRICAL

SHEET NUMBER
E1-1

REVIEWED FOR CODE COMPLIANCE
January 5, 2024
TRB AND ASSOCIATES

NOLL & TAM ARCHITECTS

729 Heinz Avenue
Berkeley, CA 94710
tel 510.542.2200
fax 510.542.2201

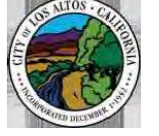

O'MAHONY & MYER
4340 Redwood Hwy., Suite 245
San Rafael, California 94903
Tel (415) 492-0420 Fax (415) 479-9662
www.omconsulting.com

SEAL



PROJECT TITLE

City of Los Altos EMERGENCY OPERATION CENTER

97 Hillview Ave. Los Altos, CA
94022

ISSUE TITLE

PERMIT SET

ISSUE DATE

AUG 03, 2023

NOLL & TAM JOB NUMBER

22203

REVISIONS


DATE	DESCRIPTION
11/15/2023	PERMIT PLAN CHECK RESPONSE

SHEET TITLE

EOC FLOOR PLAN - ELECTRICAL

SHEET NUMBER

E3-1

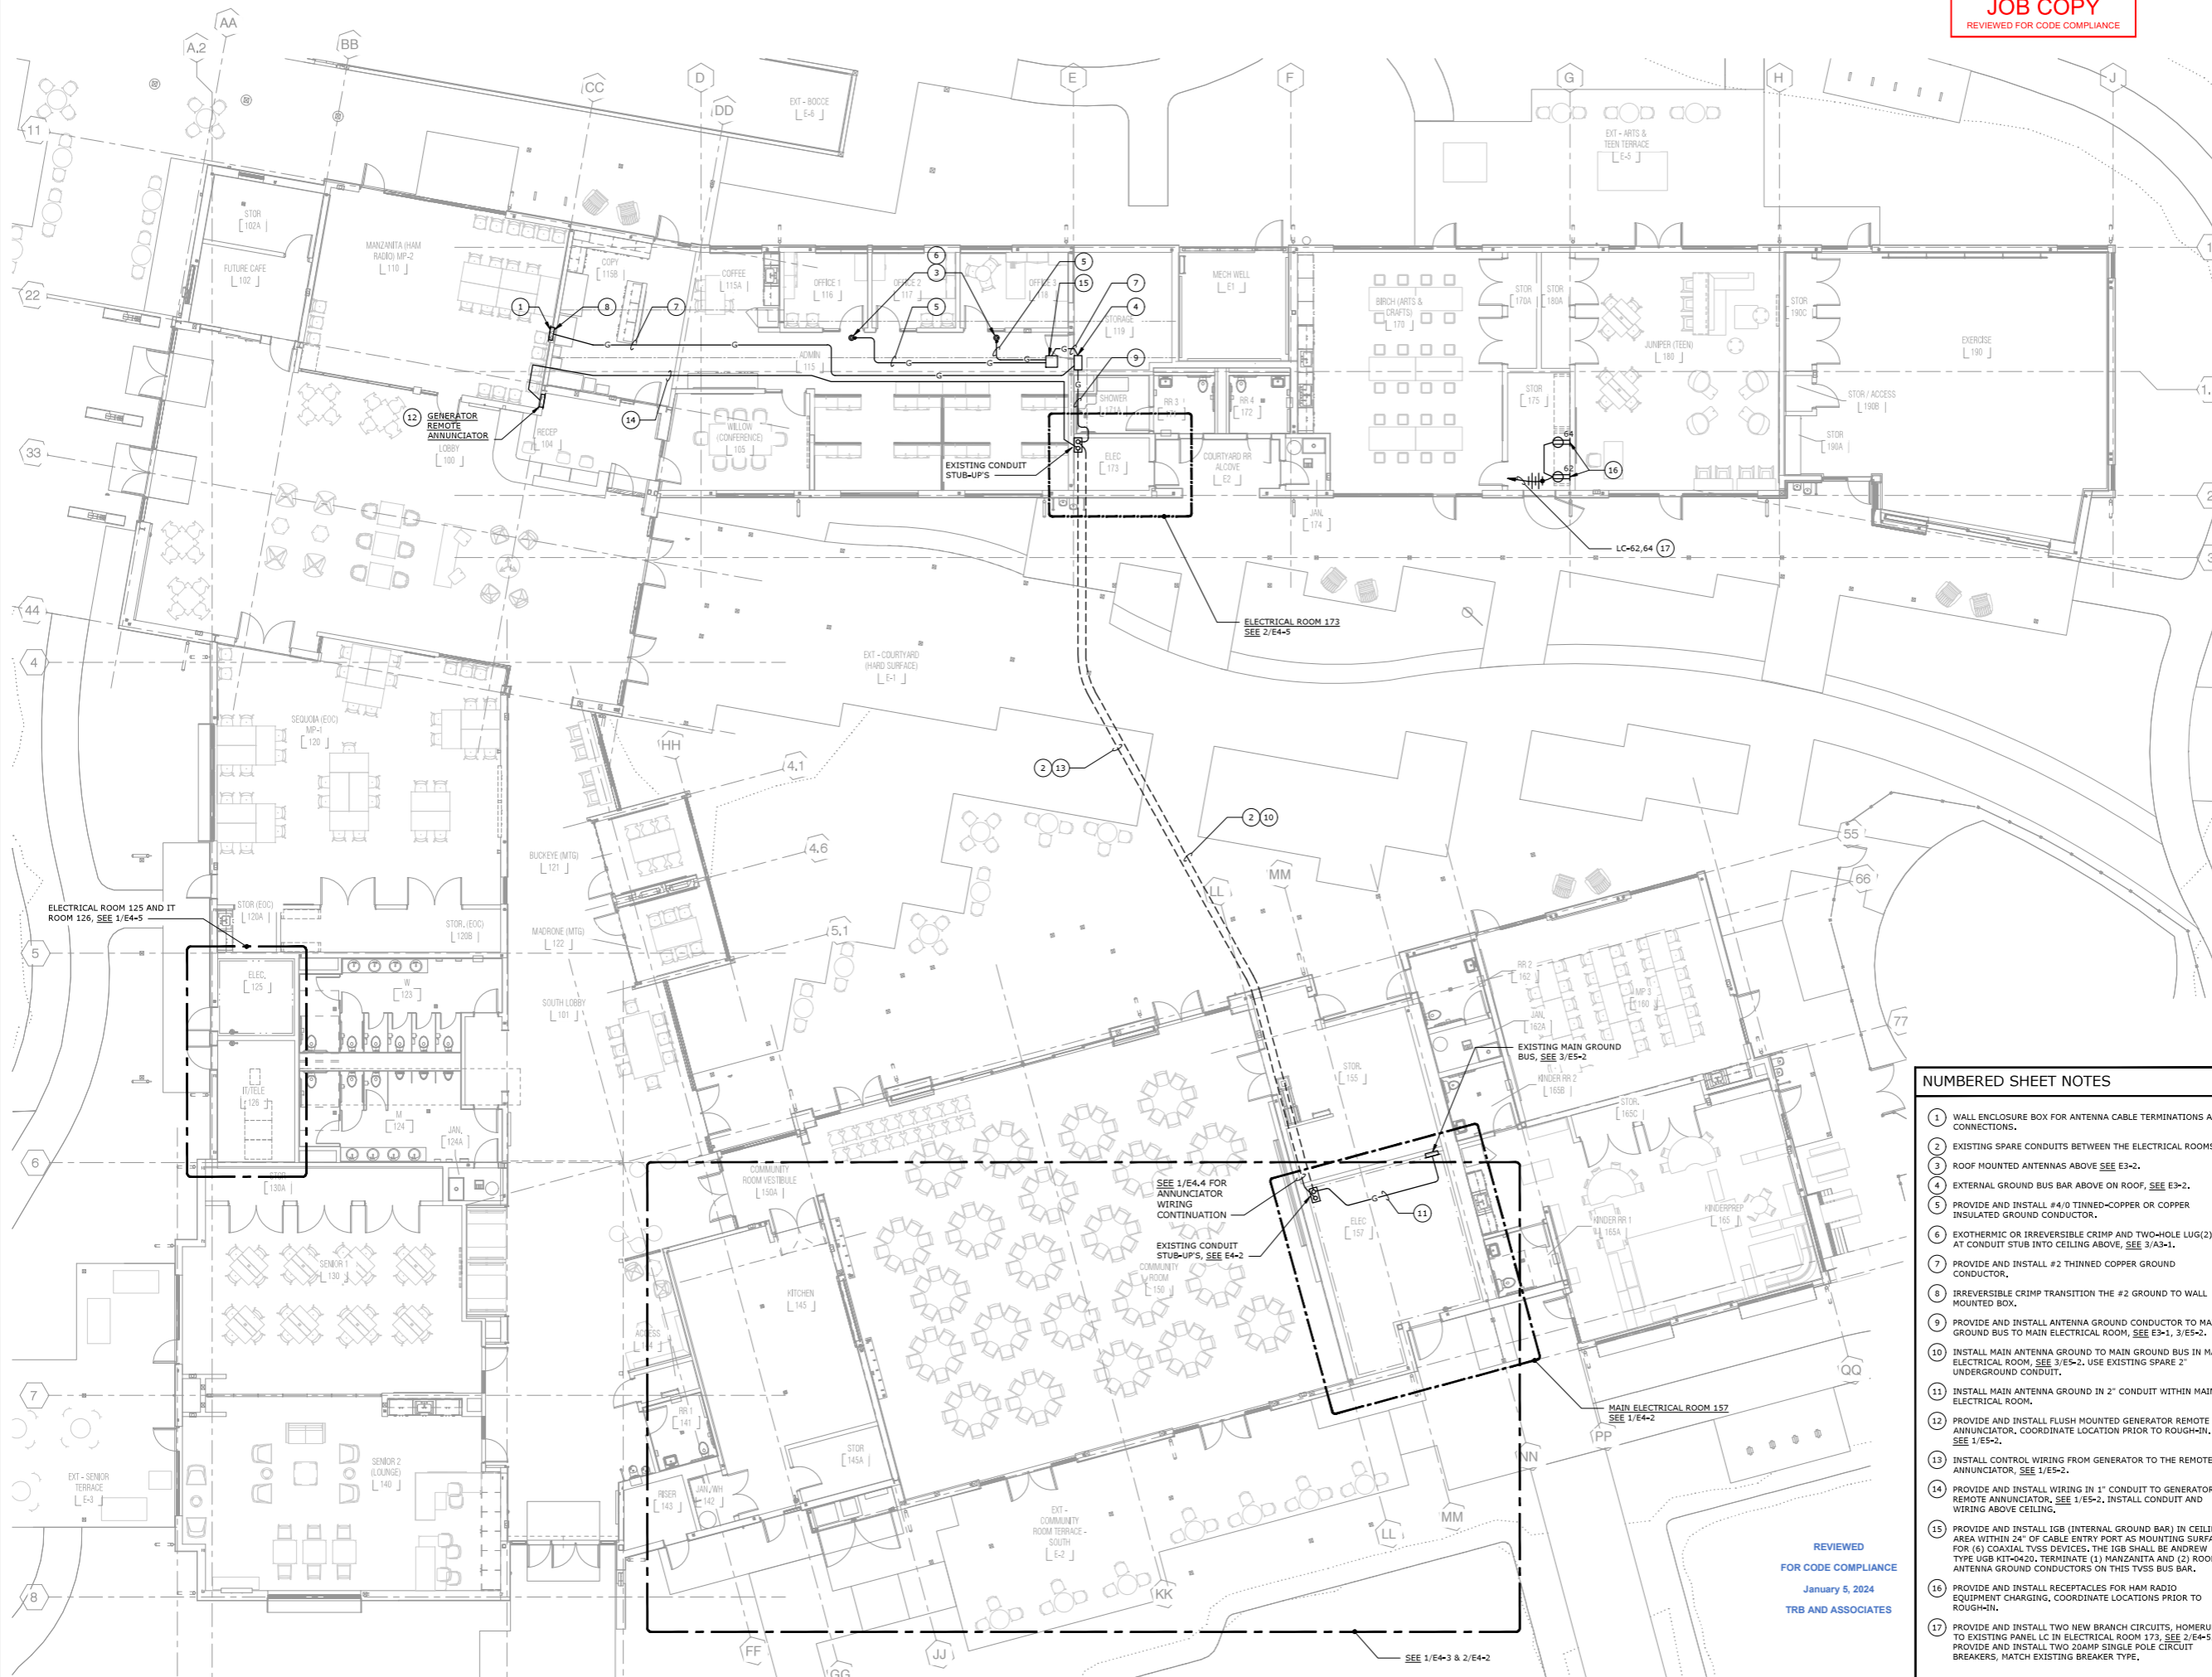

NUMBERED SHEET NOTES

- 1 WALL ENCLOSURE BOX FOR ANTENNA CABLE TERMINATIONS AND CONNECTIONS.
- 2 EXISTING SPARE CONDUITS BETWEEN THE ELECTRICAL ROOMS.
- 3 ROOF MOUNTED ANTENNAS ABOVE SEE E3-2.
- 4 EXTERNAL GROUND BUS BAR ABOVE ON ROOF, SEE E3-2.
- 5 PROVIDE AND INSTALL #4/0 TINNED-COPPER OR COPPER INSULATED GROUND CONDUCTOR.
- 6 EXOTHERMIC OR IRREVERSIBLE CRIMP AND TWO-HOLE LUG(2) AT CONDUIT STUB INTO CEILING ABOVE, SEE 3/A3-1.
- 7 PROVIDE AND INSTALL #2 THINNED COPPER GROUND CONDUCTOR.
- 8 IRREVERSIBLE CRIMP TRANSITION THE #2 GROUND TO WALL MOUNTED BOX.
- 9 PROVIDE AND INSTALL ANTENNA GROUND CONDUCTOR TO MAIN GROUND BUS TO MAIN ELECTRICAL ROOM, SEE E3-1, 3/E5-2.
- 10 INSTALL MAIN ANTENNA GROUND TO MAIN GROUND BUS IN MAIN ELECTRICAL ROOM, SEE 3/E5-2. USE EXISTING SPARE 2" UNDERGROUND CONDUIT.
- 11 INSTALL MAIN ANTENNA GROUND IN 2" CONDUIT WITHIN MAIN ELECTRICAL ROOM.
- 12 PROVIDE AND INSTALL FLUSH MOUNTED GENERATOR REMOTE ANNUNCIATOR, COORDINATE LOCATION PRIOR TO ROUGH-IN, SEE 1/E5-2.
- 13 INSTALL CONTROL WIRING FROM GENERATOR TO THE REMOTE ANNUNCIATOR, SEE 1/E5-2.
- 14 PROVIDE AND INSTALL WIRING IN 1" CONDUIT TO GENERATOR REMOTE ANNUNCIATOR, SEE 1/E5-2. INSTALL CONDUIT AND WIRING ABOVE CEILING.
- 15 PROVIDE AND INSTALL IGB (INTERNAL GROUND BAR) IN CEILING AREA WITHIN 24" OF CABLE ENTRY PORT AS MOUNTING SURFACE FOR (6) COAXIAL TVSS DEVICES. THE IGB SHALL BE ANDREW TYPE UGB KIT-420. TERMINATE (1) MANZANITA AND (2) ROOF ANTENNA GROUND CONDUCTORS ON THIS TVSS BUS BAR.
- 16 PROVIDE AND INSTALL RECEPTACLES FOR HAM RADIO EQUIPMENT CHARGING, COORDINATE LOCATIONS PRIOR TO ROUGH-IN.
- 17 PROVIDE AND INSTALL TWO NEW BRANCH CIRCUITS, HOMERUN TO EXISTING PANEL LC IN ELECTRICAL ROOM 173, SEE 2/E4-5. PROVIDE AND INSTALL TWO 20AMP SINGLE POLE CIRCUIT BREAKERS, MATCH EXISTING BREAKER TYPE.

REVIEWED
FOR CODE COMPLIANCE
January 5, 2024
TRB AND ASSOCIATES


EOC FLOOR PLAN - ELECTRICAL

SCALE: 1/8" = 1'-0"



TYPE	MOUNTING	DESCRIPTION	MANUFACTURER CATALOG #	LIGHT SOURCE	POWER SUPPLY	VOLTS	INPUT WATTS
BF1E	WALL MOUNTED	WALL MOUNTED LED CUTOFF DOWNLIGHT, WITH DIE CAST ALUMINUM HOUSING, PRISMATIC GLASS LENS, DOWNLIGHT ONLY ENCLOSED & GASKETED AND UL WET LOCATION LISTED, BLACK FINISH.	C.W. COLE LIGHTING L2500W-1-HO-(FINISH)	3000°K LED 80 CRI 860 LM	INTEGRAL NON-DIM ELECTRONIC DRIVER + EMERGENCY BATTERY PACK	120/277V	14 W

CITY OF LOS ALTOS
JOB COPY
REVIEWED FOR CODE COMPLIANCE

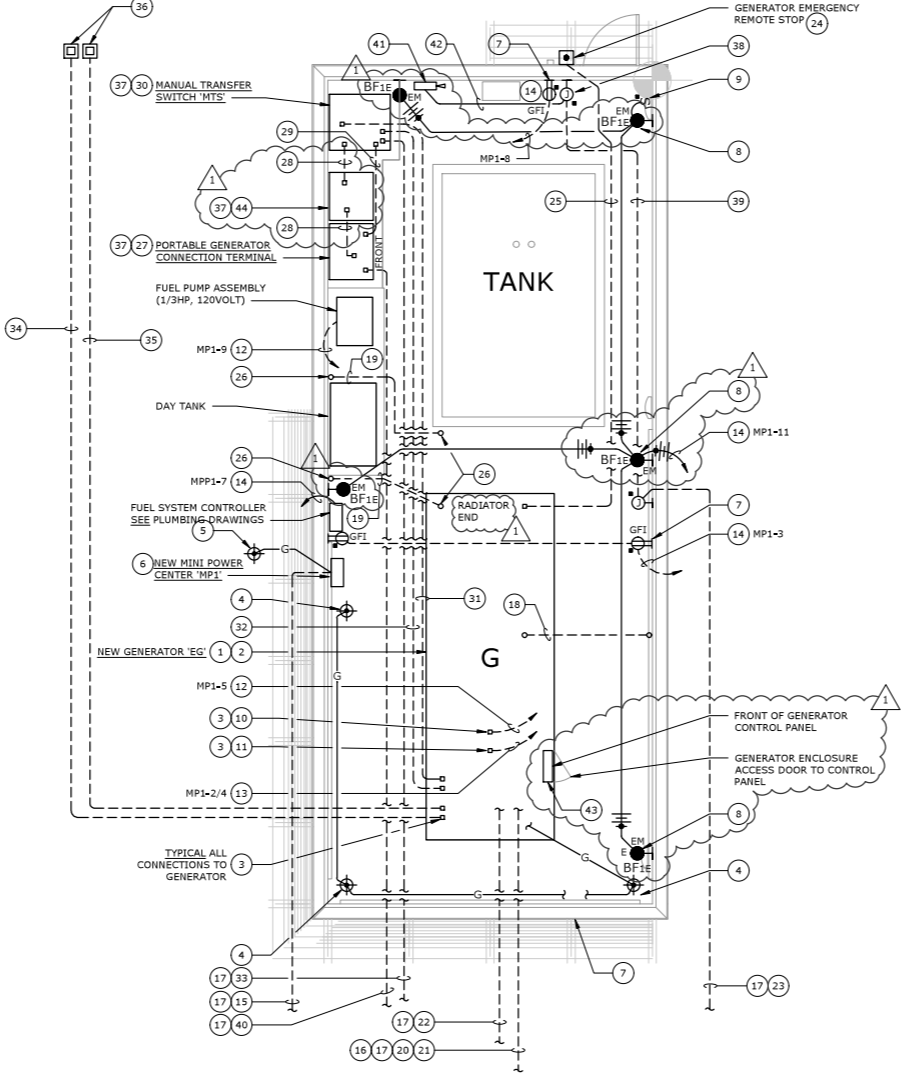

ENLARGED PLAN - EOC GENERATOR ENCLOSURE
SCALE: 1/4" = 1'-0"

NUMBERED SHEET NOTES

- 1 NEW EMERGENCY GENERATOR, SEE E5-1.
- 2 SEE 4/E7-1 FOR GENERATOR STRUCTURAL PAD, GENERATOR TO BE FLUSH WITH SURROUNDING WALKWAY, SEE 6/E7-1 FOR GENERATOR MOUNTING.
- 3 CONFIRM EXACT LOCATION AND CONNECTION POINTS WITH GENERATOR MANUFACTURER PRIOR TO ROUGH-IN AND POURING OF SLAB.
- 4 PROVIDE AND INSTALL GENERATOR GROUNDING, SEE E5-1, 1/E7-1 AND 2/E5-2.
- 5 PROVIDE AND INSTALL GROUNDING FOR MINI POWER CENTER, SEE 1/E5-1, AND 1/E7-1.
- 6 PROVIDE AND INSTALL NEW NEMA 3R MINI POWER CENTER, SEE E5-1, PROVIDE MINI POWER CENTER WITH 480 VOLT PRIMARY BREAKER, STEP-DOWN TRANSFORMER, AND 120/240 VOLT PANEL, SEE E6-1 FOR PANEL SCHEDULE.
- 7 PROVIDE AND INSTALL GFI RECEPTACLE WITH IN-USE LOCKABLE COVER.
- 8 PROVIDE AND INSTALL NEW LIGHT FIXTURE, SEE LUMINAIRE SCHEDULE, INSTALL 4R 7'-6" TO BOTTOM, LIGHT FIXTURE TO BE PROVIDED WITH EMERGENCY BATTERY, SEE LUMINAIRE SCHEDULE.
- 9 PROVIDE AND INSTALL WEATHERPROOF LIGHT SWITCH TO CONTROL NEW LIGHT FIXTURES.
- 10 GENERATOR BATTERY CHARGER.
- 11 GENERATOR ENGINE JACKET HEATER.
- 12 PROVIDE AND INSTALL (2)#10, (1)#10G IN 3/4" CONDUIT HOMERUN TO PANEL.
- 13 PROVIDE AND INSTALL (2)#6, (1)#10G IN 1" CONDUIT HOMERUN TO PANEL.
- 14 PROVIDE AND INSTALL (3)#12, (1)#12G IN 3/4" CONDUIT HOMERUN TO PANEL, WIRE COUNT INCLUDES UNSWITCHED HOT FOR EMERGENCY LIGHTING BATTERY CHARGING.
- 15 PROVIDE AND INSTALL NEW FEEDERS TO NEW MINI POWER CENTER MP1, SEE E5-1.
- 16 INSTALL CONTROL WIRING IN 2" CONDUIT.
- 17 SEE E1-2 FOR CONTINUATION.
- 18 PROVIDE AND INSTALL (2)1-1/4" SPARE UNDERGROUND CONDUITS WITH PULL ROPE FROM GENERATOR, STUB-UP INSIDE GENERATOR AND STUB-UP AT WALL.
- 19 PROVIDE AND INSTALL 1" UNDERGROUND CONDUIT WITH PULLROPE FOR FUEL SYSTEM CONTROLS.
- 20 PROVIDE AND INSTALL CONTROL WIRING FROM GENERATOR TO AUTOMATIC TRANSFER SWITCH ATS-1, SEE 1/E5-2.
- 21 PROVIDE AND INSTALL CONTROL WIRING TO GENERATOR REMOTE ANNUNCIATOR IN COMMUNITY CENTER BUILDING, SEE 1/E5-2.
- 22 PROVIDE AND INSTALL (2) 1-1/4" SPARE CONDUITS WITH PULL ROPE TO COMMUNITY CENTER BUILDING, STUB UP IN GENERATOR BREAKER AREA.
- 23 PROVIDE AND INSTALL (2) 1-1/4" CONDUITS TO COMMUNITY CENTER, USE ONE CONDUIT FOR CCTV CAMERA CABLING AND ONE CONDUIT SPARE FOR FUTURE USE.
- 24 PROVIDE AND INSTALL GENERATOR REMOTE EMERGENCY STOP STATION, SEE 1/E5-2, EMERGENCY STOP MUST BE INSTALLED OUTSIDE OF GENERATOR AREA, SEE 1/E5-2 FOR SIGNAGE REQUIREMENTS.
- 25 PROVIDE AND INSTALL EMERGENCY STOP WIRING IN CONDUIT FROM REMOTE STOP TO GENERATOR, SEE 1/E5-2.
- 26 COORDINATE STUB-UP LOCATION PRIOR TO ROUGH-IN.
- 27 RELOCATE AND REINSTALL THE EXISTING PORTABLE GENERATOR CONNECTION TERMINAL PANEL, SEE 1/E4-3 FOR EXISTING LOCATION, SEE 1/E5-1, COORDINATE LOCATION.
- 28 PROVIDE AND INSTALL NEW UNDERGROUND FEEDERS FROM RELOCATED PORTABLE GENERATOR CONNECTION TERMINAL PANEL VIA NEW 800 AMP CIRCUIT BREAKER TO NEW MANUAL TRANSFER SWITCH 'M'S', SEE 1/E5-1.
- 29 PROVIDE AND INSTALL UNDERGROUND CONDUIT FOR CONTROLS, SEE 1/E5-2.
- 30 PROVIDE AND INSTALL NEW PAD MOUNT NEMA 3R MANUAL TRANSFER SWITCH 'M'S', SEE 1/E5-1.
- 31 PROVIDE AND INSTALL UNDERGROUND FEEDERS FROM GENERATOR TO 'M'S', SEE 1/E5-1.
- 32 PROVIDE AND INSTALL CONTROLS FROM GENERATOR TO 'M'S' FOR POWER SOURCE POSITION, SEE 1/E5-2.
- 33 PROVIDE AND INSTALL EMERGENCY FEEDERS FROM GENERATOR VIA 'M'S' AND CIRCUIT BREAKER 'CB' TO NEW 4-POLE AUTOMATIC TRANSFER SWITCH 'ATS-1', SEE 1/E5-1.
- 34 PROVIDE AND INSTALL (2) 2" CONDUITS FOR FUTURE GENERATOR CONTROLS/ANNUNCIATOR FOR THE YOUTH CENTER OFFICE CONVERSION PROJECT, SEE 1/E5-1.
- 35 PROVIDE AND INSTALL (1) 4" CONDUIT FOR FUTURE EMERGENCY POWER FEEDERS TO THE YOUTH CENTER OFFICE CONVERSION PROJECT, SEE 1/E5-1.
- 36 PROVIDE AND INSTALL PULLBOXES, SEE E1-2.
- 37 PROVIDE HOUSEKEEPING PADS FOR EQUIPMENT, SEE 3/E7-1.
- 38 PROVIDE AND INSTALL J-BOX FOR DOOR SECURITY USE, INSTALL AT +48" ABOVE SLAB.
- 39 PROVIDE AND INSTALL 1" CONDUIT FOR CCTV CAMERA CABLE.
- 40 PROVIDE AND INSTALL CONTROL WIRING FROM PORTABLE GENERATOR CONNECTION TERMINAL TO ATS-1, SEE 1/E5-2.
- 41 FIXED FOCUS IP SECURITY CAMERA PROVIDED UNDER THE WORK OF SECTION 28 23 00, CONTRACTOR TO COORDINATE THE LOCATION OF CAMERA WITH PANELS TO ENSURE AN UNOBSTRUCTED VIEW OF PERSONS ENTERING THROUGH THE DOOR, REFER TO TY 0.1 AND TY 7.1 FOR REQUIRED CAMERA BACK BOX AND TRANSDUCER ENCLOSURE.
- 42 PROVIDE AND INSTALL 3/4" CONDUIT FOR CAMERA CABLING BETWEEN CAMERA AND / OR SECURITY J BOX DESCRIBED IN NOTE 38.
- 43 GENERATOR CONTROL PANEL LOCATION, VERIFY EXACT LOCATION WITH GENERATOR MANUFACTURER SHOP DRAWINGS.
- 44 PROVIDE AND INSTALL NEW 800 AMP CIRCUIT BREAKER, SEE 1/E5-1.

REVIEWED
FOR CODE COMPLIANCE
January 5, 2024
TRB AND ASSOCIATES

APPROVALS

NOLL & TAM ARCHITECTS

729 Heinz Avenue
Berkeley, CA 94710
tel 510.542.2200
fax 510.542.2201



O'MAHONY & MYER
4340 Redwood Hwy., Suite 245
San Rafael, California 94903
Tel (415) 492-0420 Fax (415) 479-9662
www.omcconsulting.com

SEAL



PROJECT TITLE

**City of Los Altos
EMERGENCY OPERATION
CENTER**

97 Hillview Ave. Los Altos, CA
94022

ISSUE TITLE

PERMIT SET

ISSUE DATE **AUG 03, 2023**

NOLL & TAM JOB NUMBER **22203**

REVISIONS	DATE	DESCRIPTION
1	11/15/2023	PERMIT PLAN CHECK RESPONSE

SHEET TITLE

**PARTIAL PLAN -
GENERATOR AREA**



SHEET NUMBER

E4-1



- ### NUMBERED SHEET NOTES
- 1 EXISTING SPARE CONDUITS FROM ELECTRICAL ROOM 125 AND ELECTRICAL ROOM 173.
 - 2 EXISTING CONDUIT STUBS. SEE 1/E4-4.
 - 3 EXISTING SPARE CONDUITS STUBBED UP AT FLOOR.
 - 4 EXISTING CONTROL PANEL ABOVE PANEL.
 - 5 EXISTING FEEDERS FROM MAIN CIRCUIT BREAKER TO EXISTING 3-POLE AUTOMATIC TRANSFER SWITCH. SEE 1/E5-1. FEEDERS PASS THROUGH BETWEEN THE MAIN SWITCHBOARD AND THE 'ATS' (NOT IN CONDUIT). DISCONNECT AND REMOVE EXISTING FEEDERS.
 - 6 EXISTING 3-POLE TRANSFER SWITCH 'ATS' IS TO BE REMOVED AND REPLACED WITH A NEW 4-POLE AUTOMATIC TRANSFER SWITCH 'ATS-1' AT THE SAME LOCATION. SEE 2/E4-2 AND 1/E5-1. AFTER REMOVAL OF THE FEEDERS, REMOVE 'ATS' AND TRANSPORT TO OWNERS' DESIGNATED OFF-SITE STORAGE.
 - 7 DISCONNECT AND REMOVE EXISTING UNDER SLAB FEEDERS FROM EXISTING 3-POLE TRANSFER SWITCH 'ATS' TO EXISTING DISTRIBUTION BOARD 'MSB-DP'. SEE 1/E5-1. EXISTING CONDUITS WILL BE REUSED FOR NEW FEEDERS. SEE 2/E4-2.
 - 8 DISCONNECT AND REMOVE EXISTING UNDERGROUND FEEDERS FROM EXISTING PORTABLE GENERATOR CONNECTION TERMINAL PANEL TO EXISTING 3-POLE TRANSFER SWITCH 'ATS'. SEE 1/E5-1. AND E4-3. THE EXISTING CONDUITS WILL BE REUSED FOR NEW FEEDERS.
 - 9 DISCONNECT AND REMOVE THE EXISTING CONTROL WIRING FROM THE 3-POLE TRANSFER SWITCH 'ATS' TO THE PORTABLE GENERATOR CONNECTION TERMINAL PANEL. SEE 1/E5-1 AND E4-3. THE EXISTING CONDUITS WILL BE REUSED FOR NEW CONTROLS FROM NEW GENERATOR.
 - 10 EXISTING MAIN CIRCUIT BREAKER. SEE 1/E5-1.
 - 11 INSTALL NEW 4-POLE AUTOMATIC TRANSFER SWITCH ADJACENT TO EXISTING MAIN SWITCHBOARD AT THE SAME LOCATION AS THE REMOVED 3-POLE TRANSFER SWITCH. PLACE THE NEW ATS OVER THE EXISTING UNDERGROUND CONDUIT STUBS. THE NEW 4-POLE AUTOMATIC TRANSFER SWITCH SHALL BE ASCO TYPE TO MATCH THE REMOVED ATS FOOTPRINT AND DIMENSIONS. THE NEW ATS SHALL BE ASCO 300 SERIES: NEMA 1, 38" WIDE x 23" DEEP x 87" TALL. WITH SEE CONDUIT AREA 15' x 15' FOR NEW FEEDERS TO PASS FROM MAIN SWITCHBOARD MAIN CIRCUIT BREAKER TO THE AUTOMATIC TRANSFER SWITCH TERMINALS.
 - 12 PROVIDE AND INSTALL NEW FEEDERS FROM MAIN CIRCUIT BREAKER TO NEW 4-POLE AUTOMATIC TRANSFER SWITCH 'ATS-1'. SEE 1/E5-1. INSTALL FEEDERS VIA THE SIDE ACCESS AREA IN THE NEW 'ATS-1'.
 - 13 PROVIDE AND INSTALL NEW FEEDERS FROM THE NEW 4-POLE AUTOMATIC TRANSFER SWITCH 'ATS-1' TO THE EXISTING DISTRIBUTION BOARD 'MSB-DP'. SEE 1/E5-1. INSTALL FEEDERS IN EXISTING UNDERSLAB CONDUITS.
 - 14 PROVIDE AND INSTALL NEW GENERATOR FEEDERS FROM NEW 4-POLE AUTOMATIC TRANSFER SWITCH 'ATS-1' TO THE NEW EXTERIOR CIRCUIT BREAKER 'CB3'. INSTALL FEEDERS IN EXISTING UNDERGROUND CONDUITS. SEE 1/E4-4 AND 1/E5-1.
 - 15 PROVIDE AND INSTALL CONTROL WIRING FROM NEW 4-POLE AUTOMATIC TRANSFER SWITCH 'ATS-1'. SEE 1/E5-1 AND 1/E5-2. INSTALL WIRING TO EXISTING UNDERGROUND CONDUIT TO NEW EXTERIOR PULL CAN. SEE E4-4.
 - 16 BOLT NEW ATS TO FLOOR SLAB. SEE 3/E7-1 FOR BOLT TYPE AND QUANTITY.
 - 17 PROVIDE AND INSTALL TWO (2) EV LOAD POWER OFF SWITCHES. SEE 1/E5-1.

CITY OF LOS ALTOS
JOB COPY
REVIEWED FOR CODE COMPLIANCE

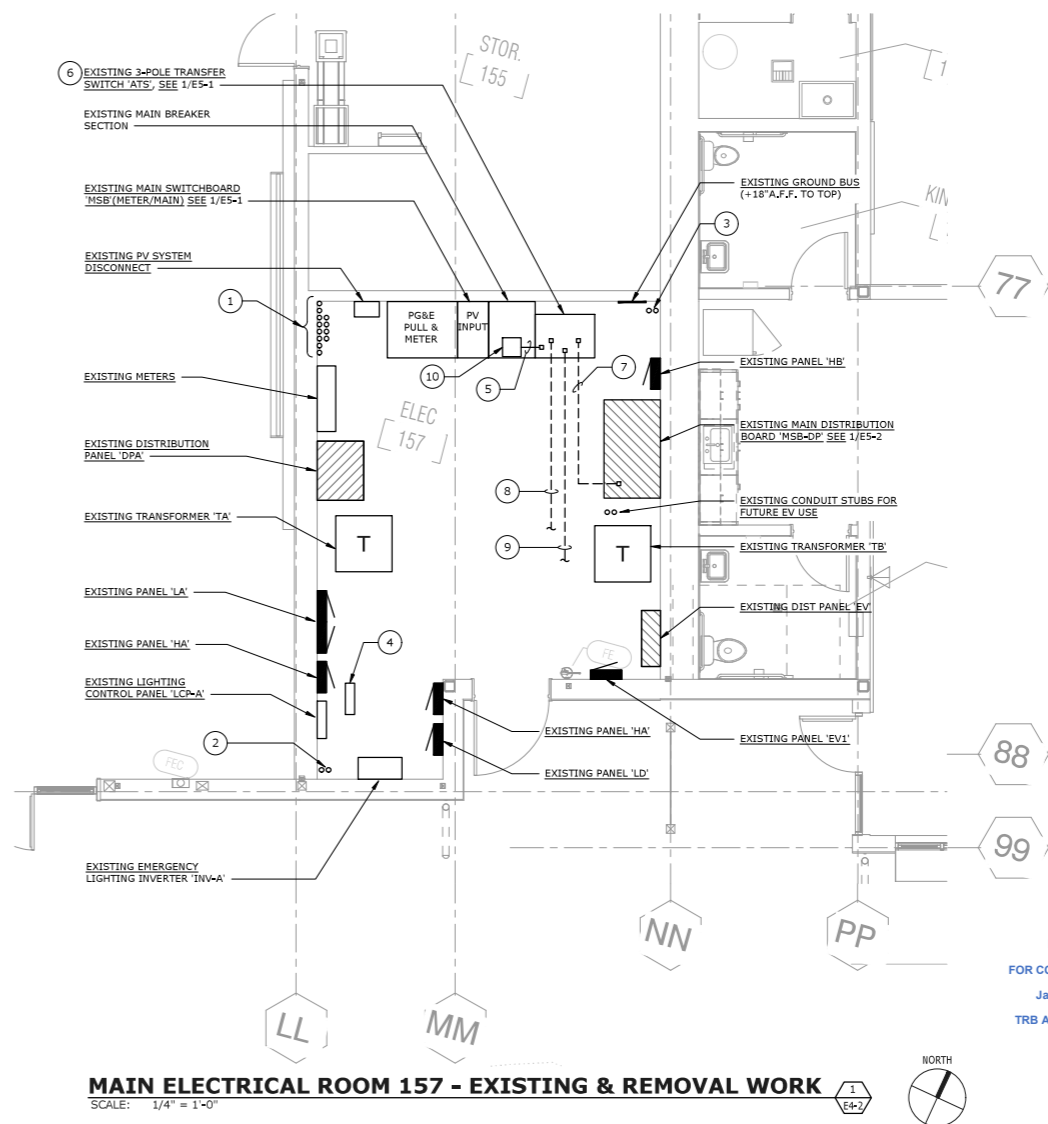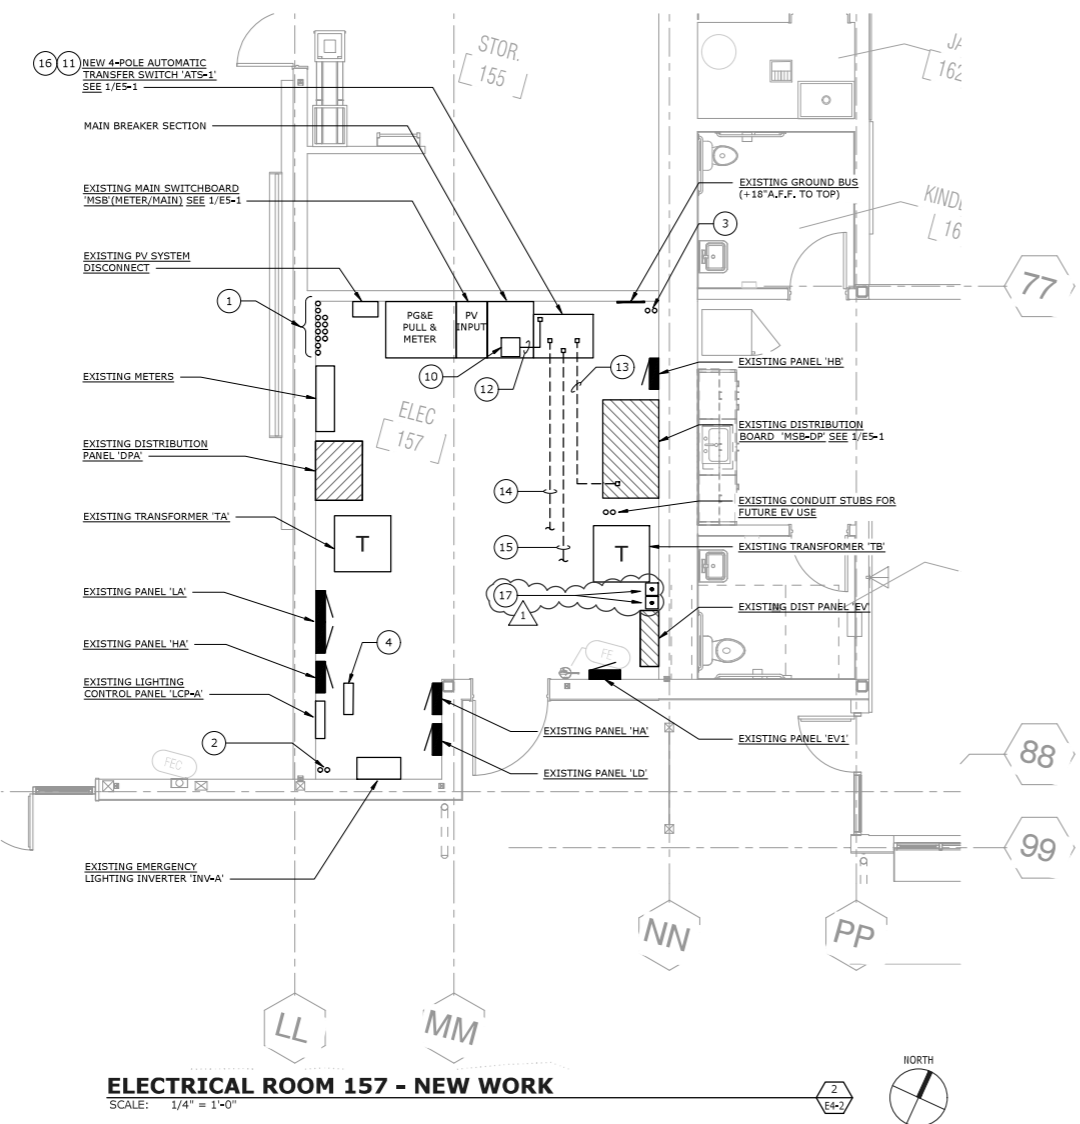

REVIEWED
FOR CODE COMPLIANCE
January 5, 2024
TRB AND ASSOCIATES

APPROVALS

NOLL & TAM

ARCHITECTS

729 Heinz Avenue
Berkeley, CA 94710
tel 510.542.2200
fax 510.542.2201

O'MAHONY & MYER
MEMBER OF THE O'MAHONY GROUP
4340 Redwood Hwy., Suite 245
San Rafael, California 94903
Tel (415) 492-0420 Fax (415) 479-9662
www.omconsulting.com

SEAL

PROJECT TITLE

City of Los Altos
EMERGENCY OPERATION
CENTER

97 Hillview Ave. Los Altos, CA
94022

ISSUE TITLE

PERMIT SET

ISSUE DATE AUG 03, 2023

NOLL & TAM JOB NUMBER 22203

REVISIONS	DATE	DESCRIPTION
1	11/15/2023	PERMIT PLAN CHECK RESPONSE

SHEET TITLE

PARTIAL PLANS -
ELECTRICAL

SHEET NUMBER

E4-2


- ### NUMBERED SHEET NOTES
- 1 EXISTING CONDUIT STUBS AT PAD FROM MAIN ELECTRICAL ROOM.
 - 2 EXISTING CONDENSATE COPPER PIPE THROUGH WALL.
 - 3 DISCONNECT AND REMOVE EXISTING FEEDERS FROM THE EXISTING 3-POLE TRANSFER SWITCH 'ATS' TO THE EXISTING PORTABLE GENERATOR CONNECTION TERMINAL PANEL. SEE E5-1. EXISTING CONDUITS TO BE REUSED FOR NEW FEEDERS TO NEW 4 POLE AUTOMATIC TRANSFER SWITCH. SEE E4-4.
 - 4 DISCONNECT AND REMOVE EXISTING CONTROL WIRING FROM THE EXISTING 3-POLE TRANSFER SWITCH TO THE EXISTING PORTABLE GENERATOR CONNECTION TERMINAL PANEL. SEE E5-1. EXISTING CONDUIT TO BE REUSED.
 - 5 RELOCATE EXISTING PORTABLE GENERATOR CONNECTION TERMINAL PANEL. SEE 1/E4-1 FOR NEW LOCATION AT GENERATOR ENCLOSURE AREA. SEE 1/E5-1.
 - 6 DISCONNECT AND REMOVE EXISTING FEEDERS AND CONTROL WIRING FROM 'ATS' AT THE PORTABLE GENERATOR TERMINAL PANEL. SEE 1/E5-1. EXISTING CONDUITS TO BE REUSED. SEE E4-4 & 1/E5-1.
 - 7 EXISTING CONDUIT STUBS IN MAIN ELECTRICAL ROOM 157. SEE E4-2.
 - 8 TWO EXISTING 4" UNDERGROUND CONDUITS.
 - 9 EXISTING 3 POLE TRANSFER SWITCH TO BE REPLACED WITH A NEW 4-POLE AUTOMATIC TRANSFER SWITCH. SEE 1/E5-1, AND E4-2.

CITY OF LOS ALTOS
JOB COPY
REVIEWED FOR CODE COMPLIANCE


NOLL & TAM

ARCHITECTS

729 Heinz Avenue
Berkeley, CA 94710
tel 510.542.2200
fax 510.542.2201

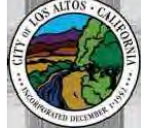

O'MAHONY & MYER
REGISTERED PROFESSIONAL ENGINEERS
4340 Redwood Hwy., Suite 245
San Rafael, California 94903
Tel (415) 492-0420 Fax (415) 478-9662
www.omconsulting.com

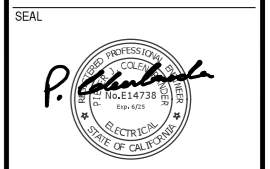

PROJECT TITLE

**City of Los Altos
EMERGENCY OPERATION
CENTER**

97 Hillview Ave. Los Altos, CA
94022

ISSUE TITLE

PERMIT SET

ISSUE DATE AUG 03, 2023

NOLL & TAM JOB NUMBER 22203


REVISIONS	DATE	DESCRIPTION
1	11/15/2023	PERMIT PLAN CHECK RESPONSE

SHEET TITLE

**PARTIAL PLAN -
ELECTRICAL**

SHEET NUMBER


E4-3

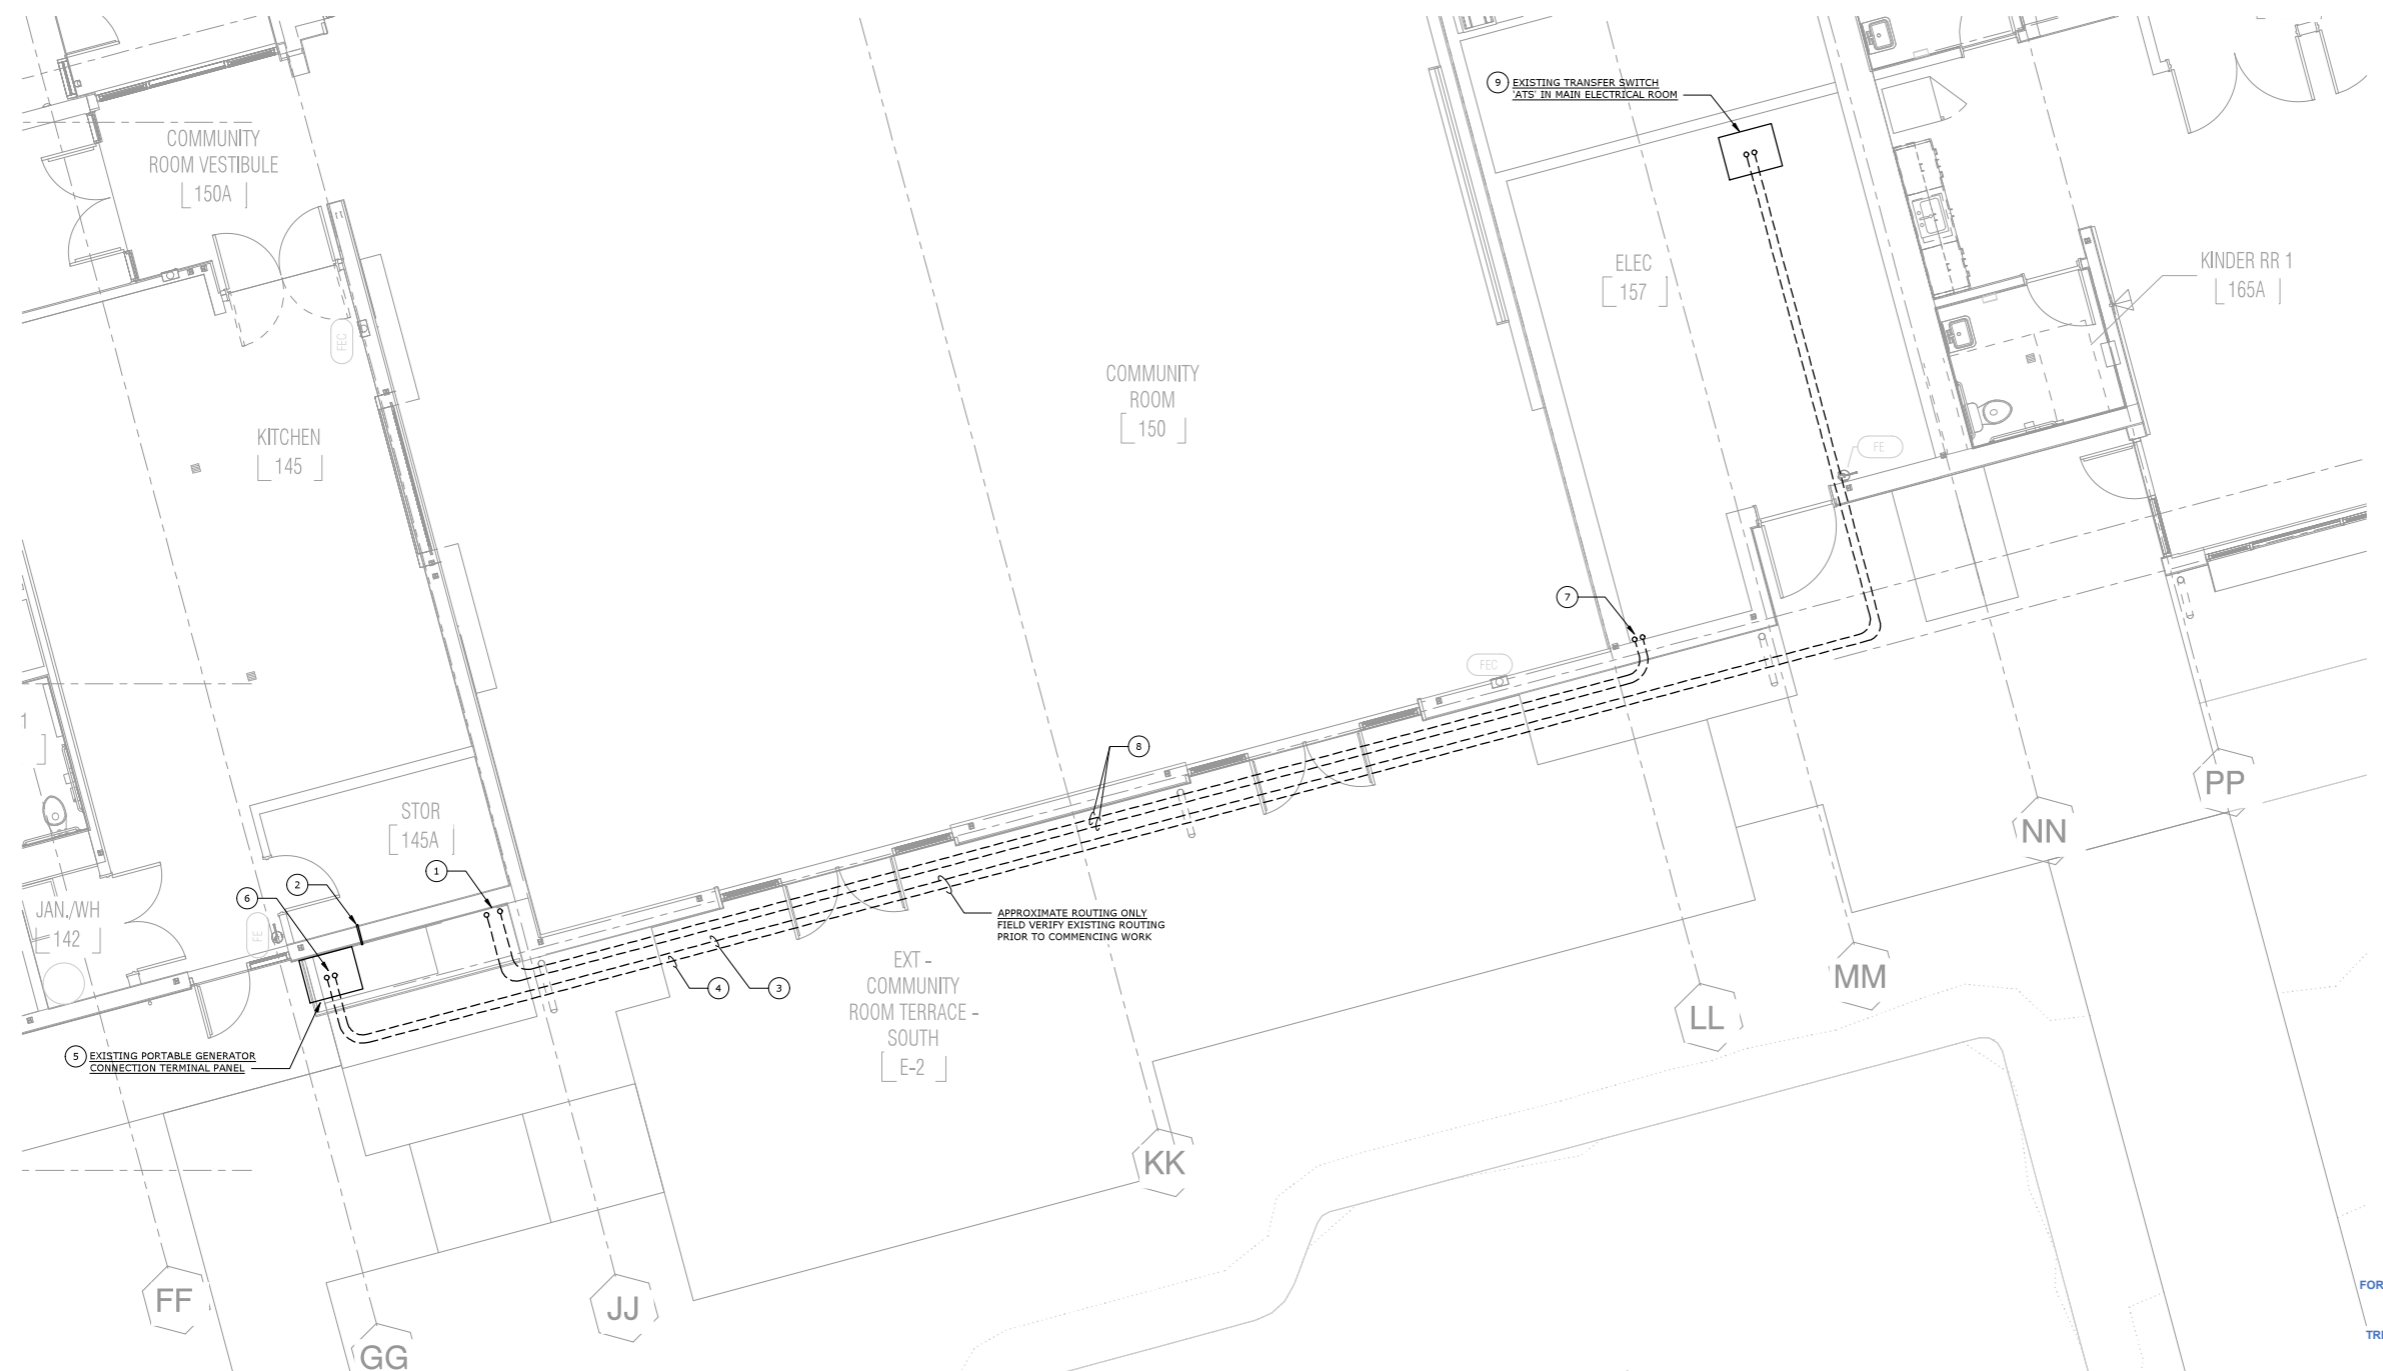

PARTIAL PLAN - EXISTING & REMOVAL WORK
SCALE: 1/4" = 1'-0"

REVIEWED
FOR CODE COMPLIANCE
January 5, 2024
TRB AND ASSOCIATES



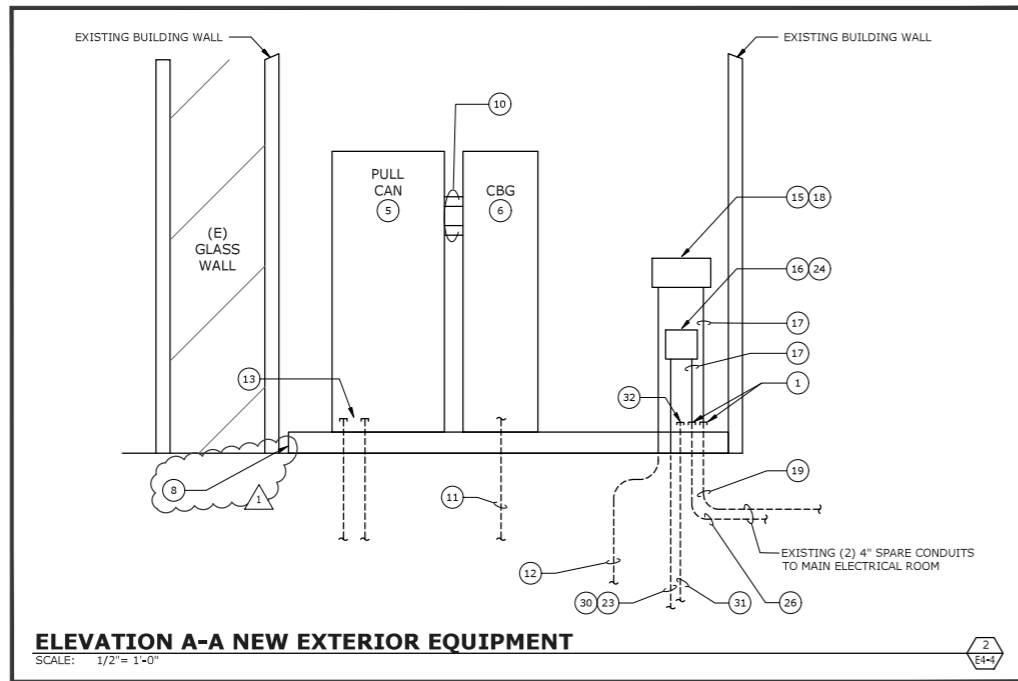

ELEVATION A-A NEW EXTERIOR EQUIPMENT
SCALE: 1/2" = 1'-0"

CITY OF LOS ALTOS
JOB COPY
REVIEWED FOR CODE COMPLIANCE

- NUMBERED SHEET NOTES**
- 18 ROUTE NEW MINI POWER CENTER 'MPI' FEEDERS VIA NEW PULL CAN/GUTTER TO 'MSB-DP', SEE 1/E5-1.
 - 19 USE EXISTING SPARE CONDUIT FOR NEW MINI POWER CENTER 'MPI' FEEDERS TO 'MSB-DP', SEE 1/E5-1.
 - 20 EXTEND NEW 4" CONDUIT FROM STUB-UP TO NEW PULL CAN.
 - 21 PROVIDE AND INSTALL CEILING OR WALL MOUNTED PULL CANS 12"x12"x9" DEEP.
 - 22 PROVIDE AND INSTALL NEW MINI POWER CENTER 'MPI' FEEDERS IN NEW EMT CONDUIT TO 'MSB-DP', SEE E4-2 AND 1/E5-1.
 - 23 PROVIDE AND INSTALL 2" CONDUIT WITH CONTROL WIRING TO 'ATS', 'MTS' AND REMOTE ANNUNCIATOR, SEE E4-1, NOTES 20, 21, 26, AND 1/E5-2.
 - 24 ROUTE NEW GENERATOR CONTROLS VIA NEW PULL CAN/GUTTER TO 'ATS-1' AND THE GENERATOR REMOTE ANNUNCIATOR.
 - 25 MOVE EXISTING CONDENSATE PIPE TO NEW LOCATION, SEE NOTE 2 FOR EXISTING LOCATION.
 - 26 USE EXISTING SPARE CONDUIT FOR GENERATOR CONTROL WIRING TO 'ATS-1', REMOTE ANNUNCIATOR AND WIRING FROM PORTABLE GENERATOR TERMINAL TO 'ATS-1', SEE 1/E5-2.
 - 27 PROVIDE AND INSTALL GENERATOR CONTROL WIRING IN 1" C, TO 'ATS-1' FROM GENERATOR AND PORTABLE TERMINAL, SEE 1/E5-2.
 - 28 PROVIDE AND INSTALL CONTROL WIRING FROM GENERATOR TO REMOTE ANNUNCIATOR AT RECEPTION, SEE E3-1 AND 1/E5-2. INSTALL WIRING IN 1" CONDUIT (EMT) WITHIN ELECTRICAL ROOM.
 - 29 USE EXISTING SPARE UNDERGROUND CONDUIT TO ELECTRICAL ROOM 173 FOR WIRING TO GENERATOR REMOTE ANNUNCIATOR, SEE 1/E5-2, E3-1, AND 2/E4-5.
 - 30 PROVIDE AND INSTALL CONTROL WIRING FROM PORTABLE GENERATOR CONNECTION TERMINAL TO 'ATS-1', SEE E4-1, NOTE 40, AND 1/E5-2.
 - 31 PROVIDE AND INSTALL CONDUITS FROM GENERATOR, SEE 1/E4-1, NOTE 22, AND 23.
 - 32 STUB CONDUITS NOTED IN NOTE 31, UP ADJACENT TO WALL, SEE 10/E7-1.

- NUMBERED SHEET NOTES**
- 1 TWO EXISTING 4" CONDUIT STUBS FROM MAIN ELECTRICAL ROOM.
 - 2 RELOCATE EXISTING CONDENSATE COPPER PIPE THROUGH WALL, COORDINATE NEW LOCATION.
 - 3 PROVIDE AND INSTALL NEW GENERATOR FEEDERS TO NEW 4 POLE AUTOMATIC TRANSFER SWITCH 'ATS-1' IN EXISTING UNDERGROUND CONDUITS, SEE 1/E5-5 AND 2/E4-2.
 - 4 EXISTING CONTROL CONDUIT TO REMAIN AS SPARE SEE E4-3, NOTE 4.
 - 5 PROVIDE AND INSTALL NEW NEMA 3R PAD MOUNTED PULL CAN, INSTALL OVER EXISTING CONDUIT STUBS, SEE 1/E4-3 AND E5-1.
 - 6 PROVIDE AND INSTALL NEW PAD MOUNT NEMA 3R CIRCUIT BREAKER AND ENCLOSURE, SEE E5-1.
 - 7 SEE 9/E7-1 FOR EQUIPMENT BRACING TO WALL.
 - 8 SEE 3/E7-1 FOR HOUSEKEEPING PADS.
 - 9 NOT USED.
 - 10 PROVIDE AND INSTALL SURFACE RIGID GALVANIZED STEEL CONDUIT BETWEEN PULL CAN, CIRCUIT BREAKER 'CBG' ENCLOSURE, AND 'MTS', SEE 1/E5-1.
 - 11 PROVIDE AND INSTALL FEEDERS FROM GENERATOR VIA 'MTS', SEE 1/E5-1.
 - 12 PROVIDE AND INSTALL FEEDERS FROM MINI POWER CENTER 'MPI', SEE 1/E5-1.
 - 13 EXISTING CONDUIT STUBS, SEE 1/E5-1 FOR QUANTITY AND SIZES, USE THREE OF THE EXISTING 3" CONDUITS FOR NEW FEEDERS TO 'ATS-1'.
 - 14 EXISTING CONDUIT STUBS IN MAIN ELECTRICAL ROOM, SEE E4-2.
 - 15 PROVIDE AND INSTALL NEMA 3R PULL CAN OR GUTTER 12"x12"x9" DEEP FOR NEW FEEDERS TO MINI POWER CENTER 'MPI'.
 - 16 PROVIDE AND INSTALL NEMA 3R PULL CAN OR GUTTER 12"x12"x9" DEEP FOR NEW GENERATOR SYSTEM CONTROL WIRING.
 - 17 PROVIDE AND INSTALL 4" RGS CONDUIT FROM EXISTING STUB-UP TO NEW PULL CAN/GUTTER.

APPROVALS

NOLL & TAM ARCHITECTS

729 Heinz Avenue
Berkeley, CA 94710
tel 510.542.2200
fax 510.542.2201

O'MAHONY & MYER
4340 Redwood Hwy., Suite 245
San Rafael, California 94903
Tel (415) 492-0420 Fax (415) 476-9662
www.omconsulting.com

PROJECT TITLE
**City of Los Altos
EMERGENCY OPERATION
CENTER**

97 Hillview Ave, Los Altos, CA
94022

ISSUE TITLE
PERMIT SET

ISSUE DATE
AUG 03, 2023

NOLL & TAM JOB NUMBER
22203


REVISIONS

DATE	DESCRIPTION
11/15/2023	PERMIT PLAN CHECK RESPONSE

SHEET TITLE
**PARTIAL PLAN -
ELECTRICAL**

SHEET NUMBER
E4-4

REVIEWED
FOR CODE COMPLIANCE
January 5, 2024
TRB AND ASSOCIATES

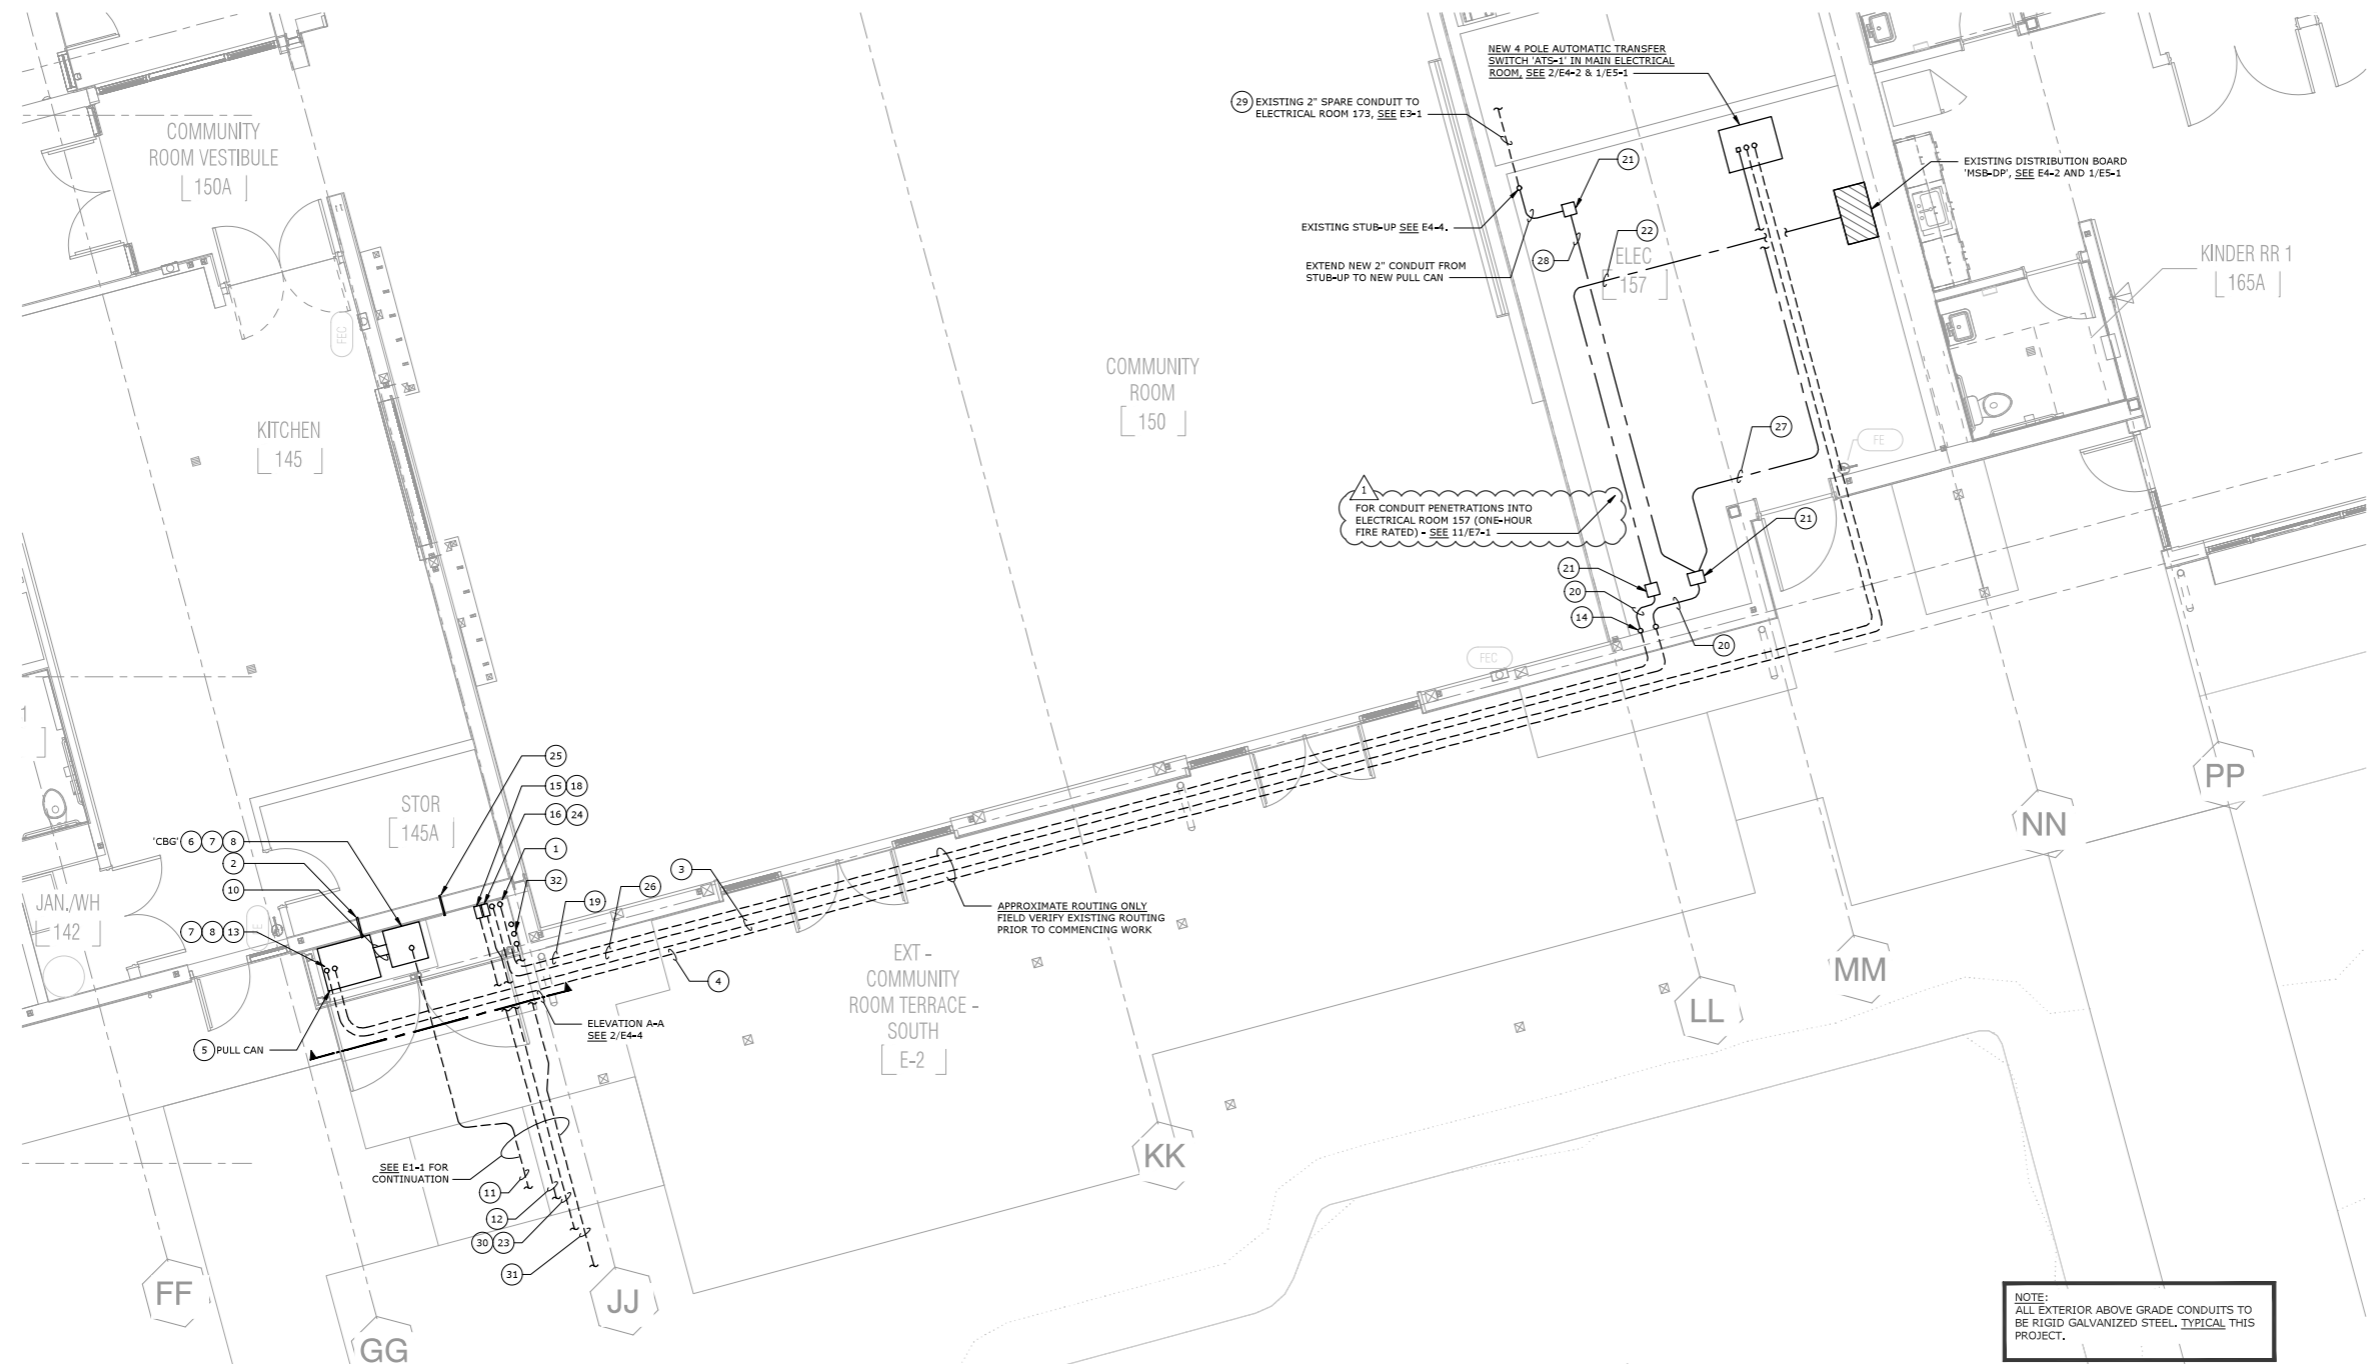


PARTIAL PLAN - NEW WORK
SCALE: 1/4" = 1'-0"


NOTE:
ALL EXTERIOR ABOVE GRADE CONDUITS TO
BE RIGID GALVANIZED STEEL, TYPICAL THIS
PROJECT.

- ### NUMBERED SHEET NOTES
- 1 EXISTING DUPLEX CONVENIENCE RECEPTACLE MOUNTED ON CABLE TRAY.
 - 2 EXISTING ELECTRICAL CONNECTIONS TO TELE/DATA RACKS. (12) 30AMP 120V CIRCUITS FOR (12) L6-30R RECEPTACLES ON CABLE TRAY.
 - 3 EXISTING ELECTRICAL CONNECTIONS TO TELE/DATA RACKS. (8) 20AMP 120V CIRCUITS FOR L5-20R RECEPTACLES ON CABLE TRAY.
 - 4 COORDINATE LOCATION PRIOR TO ROUGH-IN.
 - 5 PROVIDE AND INSTALL NEW GFI RECEPTACLE.
 - 6 PROVIDE AND INSTALL (3)#10, (1)#10G, IN 3/4" CONDUIT TO PANEL 'LE', PROVIDE AND INSTALL NEW CIRCUIT BREAKER. SEE PANEL SCHEDULE.
 - 7 PROVIDE AND INSTALL (2)#12, (1)#12G, IN 3/4" CONDUIT TO PANEL 'LE', PROVIDE AND INSTALL NEW CIRCUIT BREAKER. SEE PANEL SCHEDULE.
 - 8 EXISTING GROUND BUS BELOW IT CABINET.
 - 9 EXISTING SPARE CONDUITS FROM MAIN ELECTRICAL ROOMS 125 AND 157.
 - 10 EXISTING SPARE CONDUITS FROM ELECTRICAL ROOMS 159 AND 173.
 - 11 NEW WIRING TO GENERATOR REMOTE ANNUNCIATOR. SEE E3-1.
 - 12 NEW RADIO ANTENNA GROUNDING. SEE E3-1.

CITY OF LOS ALTOS
JOB COPY
REVIEWED FOR CODE COMPLIANCE

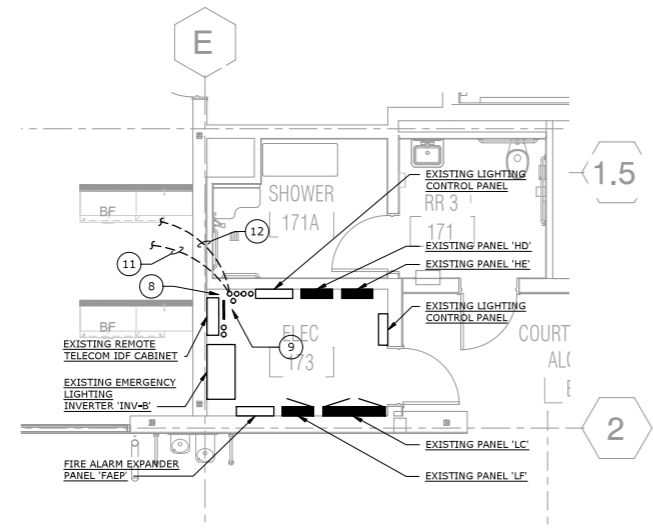

ELECTRICAL ROOM 173
SCALE: 1/4" = 1'-0"

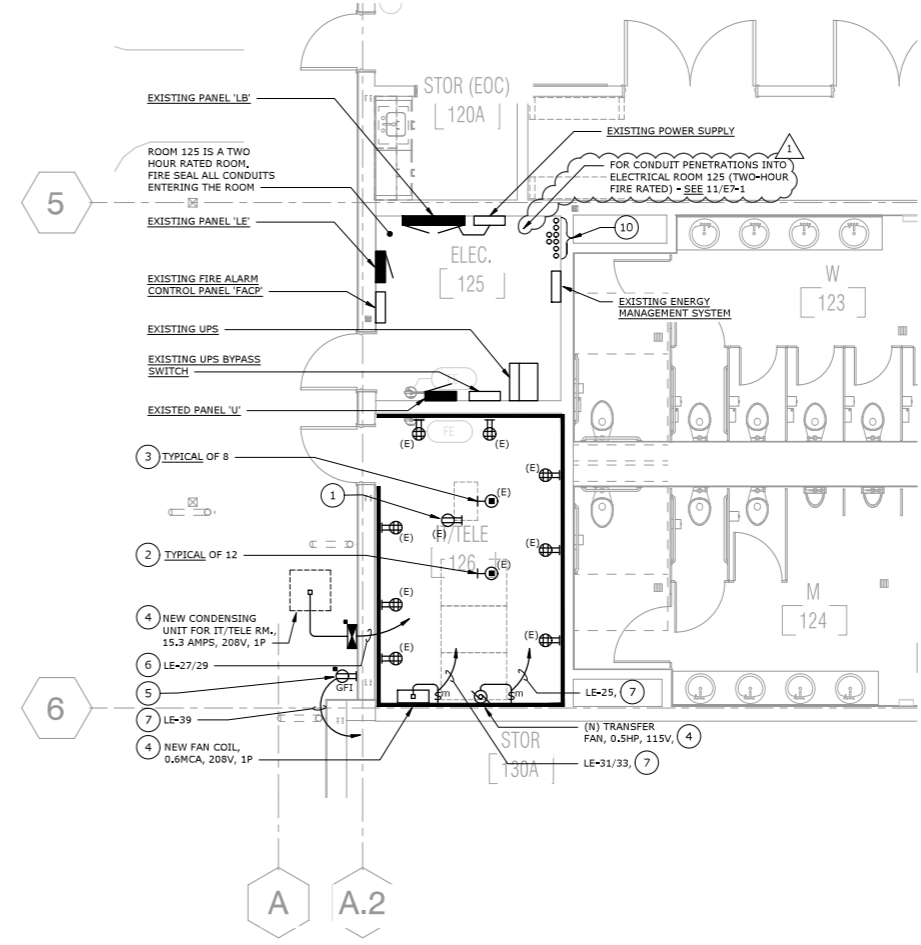

ELECTRICAL ROOM 125 & IT TELE ROOM 126
SCALE: 1/4" = 1'-0"




REVIEWED
FOR CODE COMPLIANCE
January 5, 2024
TRB AND ASSOCIATES


APPROVALS

NOLL & TAM ARCHITECTS

729 Heinz Avenue
Berkeley, CA 94710
tel 510.542.2200
fax 510.542.2201

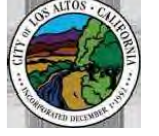

O'MAHONY & MYER
4340 Redwood Hwy., Suite 245
San Rafael, California 94903
Tel (415) 492-0420 Fax (415) 479-9662
www.omcconsulting.com

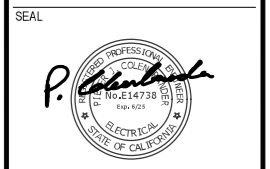

PROJECT TITLE

**City of Los Altos
EMERGENCY OPERATION
CENTER**

97 Hillview Ave. Los Altos, CA
94022

ISSUE TITLE
PERMIT SET

ISSUE DATE
AUG 03, 2023

NOLL & TAM JOB NUMBER
22203

REVISIONS	DATE	DESCRIPTION
1	11/15/2023	PERMIT PLAN CHECK REVERSE


SHEET TITLE
**PARTIAL PLANS -
ELECTRICAL**

SHEET NUMBER
E4-5

COPPER FEEDER SCHEDULE		
FEEDER	CONDUIT	CONDUCTORS
20004	(6) 3"	6 SETS: (4)400 MCM & (1)250 MCM G.
12004	(4) 3"	4 SETS: (4)350 MCM & (1)#3/0 G.
10004	(3) 3"	3 SETS: (4)400 MCM & (1)#2/0 G.
8004	(2) 4"	2 SETS: (4)500 MCM & (1)#1/0 G.
5004	(2) 3"	2 SETS: (4)250 MCM & (1)#1/0 G.
4503	(2) 2"	2 SETS: (3)#4/0 & (1)#1/0 G.
4004	(1) 4"	(4)500 MCM & (1)#1/0 G.
2254	(1) 3"	(4)#4/0 & (1)#4 G.
2253	(1) 2"	(3)#4/0 & (1)#4 G.
1754	(1) 2"	(4)#2/0 & (1)#6 G.
1753	(1) 2"	(3)#2/0 & (1)#6 G.
1504	(1) 2"	(4)#1/0 & (1)#6 G.
1004	(1) 2"	(4)#2 & (1)#6 G.
603	(1) 1"	(3)#6 & (1)#10 G.

FEEDER TAG KEY	
(G 400 4)	G = INDICATES DOUBLE EQUIPMENT GROUND
(N)	N = INDICATES DOUBLE NEUTRAL
(NG)	NG = INDICATES DOUBLE NEUTRAL & DOUBLE EQUIPMENT GROUND
(#)	# = WIRE QUANTITY (PHASE & NEUTRAL)
(#)	# = FEEDER AMPACITY
(IG)	INDICATES ISOLATED GROUND (IG)

NOTE: ALL WIRE SIZES TO BE BASED ON A 75 DEGREE INSULATION RATING. STANDARD LOCATIONS: #12 TO #1 AWG: THWN/THHN DUAL RATED FOR ALL WET AND DRY LOCATIONS; #1 TO THROUGH #4/0 AWG: XHHW (55 MILS) FOR ALL WET AND DRY LOCATIONS; 250MCM AND LARGER: XHHW (65 MILS).

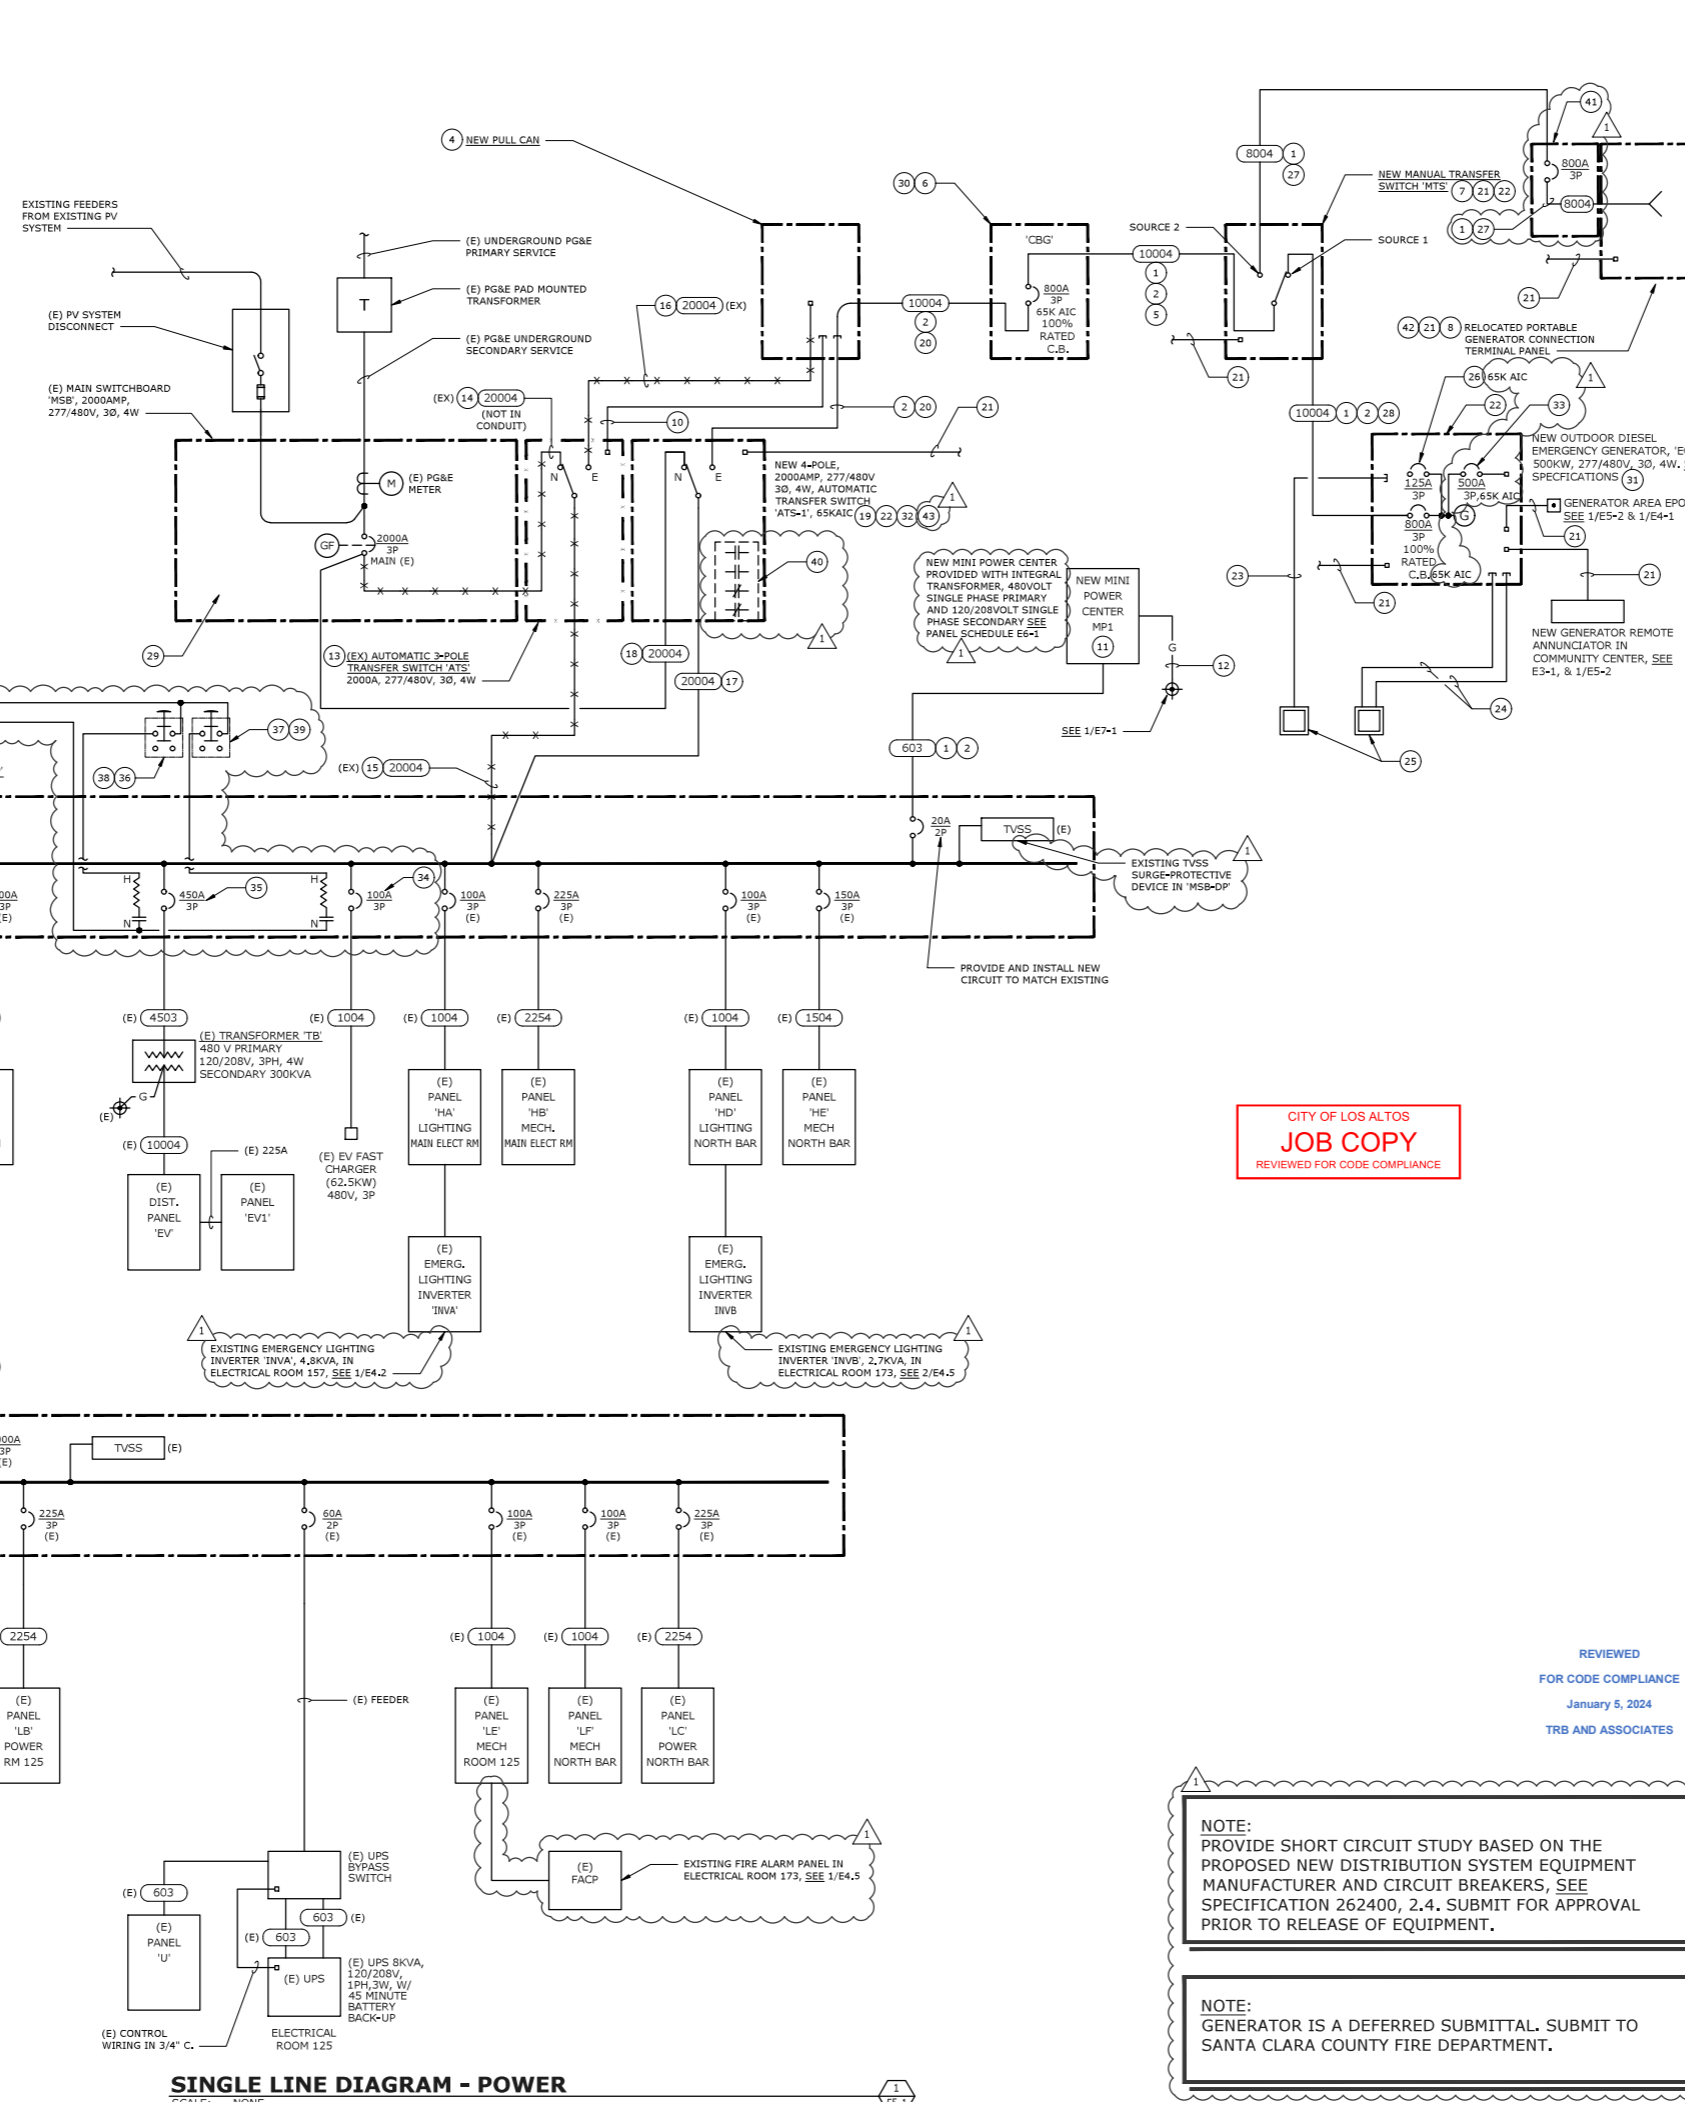

SINGLE LINE DIAGRAM - POWER
SCALE: NONE

CITY OF LOS ALTOS
JOB COPY
REVIEWED FOR CODE COMPLIANCE

REVIEWED
FOR CODE COMPLIANCE
January 5, 2024
TRB AND ASSOCIATES

NOTE:
PROVIDE SHORT CIRCUIT STUDY BASED ON THE PROPOSED NEW DISTRIBUTION SYSTEM EQUIPMENT MANUFACTURER AND CIRCUIT BREAKERS, SEE SPECIFICATION 262400, 2.4. SUBMIT FOR APPROVAL PRIOR TO RELEASE OF EQUIPMENT.

NOTE:
GENERATOR IS A DEFERRED SUBMITTAL. SUBMIT TO SANTA CLARA COUNTY FIRE DEPARTMENT.

NUMBERED SHEET NOTES

- PROVIDE AND INSTALL NEW FEEDERS.
- FEEDER INCREASED FOR VOLT DROP.
- NOT USED.
- PROVIDE AND INSTALL NEW NEMA 3R PAD MOUNTED PULL CAN. THE PULL CAN IS TO BE LOCATED AT THE SAME LOCATION OF THE EXISTING PORTABLE GENERATOR TERMINAL PANEL WHICH WILL BE RELOCATED, SEE 1/E4-3 AND 1/E4-4. INSTALL NEW PULL CAN OVER THE EXISTING CONDUIT STUBS FROM EXISTING TRANSFER SWITCH 'ATS'.
- PROVIDE AND INSTALL NEW FEEDERS UNDERGROUND FROM 'MTS' TO 'CBG', SEE 1/E1-1, AND E1-2.
- PROVIDE AND INSTALL NEW PAD MOUNT NEMA 3R CIRCUIT BREAKER AND ENCLOSURE, SEE 1/E4-3. CIRCUIT BREAKER IS REQUIRED PER CEC 700.12 (D) (5) AS GENERATOR IS NOT VISIBLE FROM THE BUILDING.
- PROVIDE AND INSTALL NEW PAD MOUNT NEMA 3R MANUAL TRANSFER SWITCH 'MTS'. THE SWITCH SHALL BE 800AMP 4' POLE, 277/480V, 3P, 4W, 65K AIC. SEE 1/E4-4. THE MANUAL TRANSFER SWITCH SHALL BE ASKO TYPE OR EQUAL, 200-400V, SERIES 300 MTS/UL 1008, MECHANICAL OPERATION WITH CONTACT POINTS FOR MONITORING, SEE 1/E5-2.
- RELOCATE AND REINSTALL EXISTING PORTABLE GENERATOR CONNECTION TERMINAL PANEL. SEE 1/E4-3 FOR EXISTING LOCATION. SEE 1/E4-4 FOR NEW LOCATION. THE EXISTING PORTABLE GENERATOR CONNECTION PANEL IS AN ASCO 300, QUICK CONNECT, CAMLOCK, 1200AMP, 277/480V, 3P, 4W, NEMA 3R, FEEDERS UNDERGROUND BOTTOM EXIT.
- NOT USED.
- DISCONNECT AND REMOVE EXISTING CONTROL WIRING FROM 'ATS' TO EXISTING PORTABLE GENERATOR CONNECTION TERMINAL PANEL SEE E4-3. THE EXISTING CONDUIT WILL BE REUSED.
- INSTALL AT GENERATOR ENCLOSURE AREA, SEE 1/E4-1.
- PROVIDE AND INSTALL GROUNDING 1#6GG FOR MINI POWER CENTER TRANSFORMER, SEE 1/E4-1.
- EXISTING 3-POLE TRANSFER SWITCH 'ATS' TO BE REMOVED AND REPLACED WITH A NEW 4-POLE AUTOMATIC TRANSFER SWITCH 'ATS-1' AT THE SAME LOCATION, SEE 1/E4-2 AND 2/E4-2.
- DISCONNECT AND REMOVE EXISTING FEEDERS FROM EXISTING MAIN SWITCHBOARD TO EXISTING TRANSFER SWITCH 'ATS', SEE 1/E4-2.
- DISCONNECT AND REMOVE EXISTING UNDERSLAB FEEDERS FROM EXISTING 3-POLE TRANSFER SWITCH 'ATS'. SEE 1/E4-2. EXISTING CONDUITS WILL BE REUSED FOR NEW FEEDERS, SEE 2/E4-2 AND E4-4.
- PROVIDE AND INSTALL NEW FEEDERS FROM NEW 4 POLE AUTOMATIC TRANSFER SWITCH 'ATS-1' TO DISTRIBUTION BOARD 'MSB-DP'. USE EXISTING UNDERSLAB CONDUITS, SEE 1/E4-2 AND 2/E4-2.
- PROVIDE AND INSTALL NEW FEEDERS FROM MAIN CIRCUIT BREAKER TO NEW 4-POLE AUTOMATIC TRANSFER SWITCH 'ATS-1'. SEE 2/E4-2.
- NEW 4 POLE AUTOMATIC TRANSFER SWITCH 'ATS-1' TO BE LOCATED AT SAME LOCATION AS THE EXISTING TRANSFER SWITCH SCHEDULED TO BE REMOVED, SEE 1/E4-2, AND 2/E4-2.
- PROVIDE AND INSTALL FEEDERS FROM THE NEW EXTERIOR CIRCUIT BREAKER 'CBG' TO NEW 4 POLE AUTOMATIC TRANSFER SWITCH 'ATS-1' IN MAIN ELECTRICAL ROOM. SEE 2/E4-2. NEW FEEDERS TO BE IN NEW CONDUIT BETWEEN 'CBG' TO NEW PULL CAN, FROM NEW PULL CAN TO NEW 'ATS-1' IN MAIN ELECTRICAL ROOM USE THREE OF THE EXISTING UNDERGROUND 3" CONDUITS, SEE 1/E4-4.
- SEE 1/E5-2 FOR CONTROL WIRING.
- SEE 2/E5-2 FOR GROUNDING.
- PROVIDE AND INSTALL FEEDER CONDUIT FROM GENERATOR TO PULLBOX FOR FUTURE EMERGENCY POWER FOR THE YOUTH CENTER OFFICE CONVERSION PROJECT, SEE 1/E4-1.
- PROVIDE AND INSTALL CONTROLS CONDUITS FROM GENERATOR TO PULLBOX FOR FUTURE GENERATOR CONTROLS/ANNUNCIATOR FOR THE YOUTH CENTER OFFICE CONVERSION PROJECT, SEE 1/E4-1.
- PROVIDE AND INSTALL PULLBOXES, SEE 1/E1-2 AND 1/E4-1.
- PROVIDE AND INSTALL GENERATOR CIRCUIT BREAKER FOR FUTURE YOUTH CENTER OFFICE CONVERSION PROJECT.
- SEE 1/E4-1 FOR NEW FEEDERS TO 'MTS' FROM PORTABLE GENERATOR CONNECTION TERMINAL PANEL.
- SEE 1/E4-1 FOR NEW FEEDERS FROM GENERATOR TO 'MTS'.
- PER CEC 700.7(A) PROVIDE ENGRAVED SIGN (SCREWED ONTO COVER) AT SERVICE ENTRANCE EQUIPMENT/MAN SWITCHBOARD WITH THE FOLLOWING TEXT: "THIS FACILITY IS PROVIDED WITH AN EMERGENCY DIESEL GENERATOR LOCATED NORTH OF THE EXTERIOR SOCCER FIELD."
- PROVIDE ENGRAVED SIGN (SCREWED ONTO EXTERIOR COVER) OF THE CIRCUIT BREAKER ENCLOSURE WITH THE FOLLOWING TEXT: "EMERGENCY GENERATOR DISCONNECT."
- PROVIDE AND INSTALL NEW EMERGENCY GENERATOR. SUBMIT TO SANTA CLARA COUNTY FIRE DEPARTMENT FOR APPROVAL.
- PROVIDE AND INSTALL NEW ASCO 4-POLE AUTOMATIC TRANSFER SWITCH. SEE SPECIFICATION 26 36 01.
- PROVIDE CIRCUIT BREAKER FOR CONNECTING TEMPORARY LOAD BANK FOR GENERATOR TESTING.
- REPLACE EXISTING 100AMP/3 POLE CIRCUIT BREAKER WITH A NEW 100AMP, 480V, 3 POLE, 65KA AIC, SHUNT TRIP CIRCUIT BREAKER. BREAKER SHALL BE EATON TYPE TO MATCH EXISTING.
- REPLACE EXISTING 450AMP/3 POLE CIRCUIT BREAKER WITH A NEW 450AMP, 480V, 3 POLE, 65KA AIC, SHUNT TRIP CIRCUIT BREAKER. BREAKER SHALL BE EATON TYPE TO MATCH EXISTING.
- PROVIDE AND INSTALL WALL-MOUNTED MAINTAINED CONTACT (PUSH TO ACTIVATE PULL TO RE-SET) POWER OFF BUTTON, SCHNEIDER ELECTRIC #ZB4BT4, 2P N.O., 120V, RED MUSHROOM-HEAD W/PROTECTIVE SHROUD, CLEAR PLASTIC HINGED COVER, ENGRAVED "EV POWER OFF TO TB".
- PROVIDE AND INSTALL WALL-MOUNTED MAINTAINED CONTACT (PUSH TO ACTIVATE PULL TO RE-SET) POWER OFF BUTTON, SCHNEIDER ELECTRIC #ZB4BT4, 2P N.O., 120V, RED MUSHROOM-HEAD W/PROTECTIVE SHROUD, CLEAR PLASTIC HINGED COVER, ENGRAVED "EV FAST CHARGE POWER OFF".
- PRESSING THE EPO SHALL SHUNT-TRIP EV TRANSFORMER 'TB' FEEDER BREAKER, SEE 2/E4-2 FOR EPO LOCATION.
- PRESSING THE EPO SHALL SHUNT-TRIP 'EV FAST CHARGE' BREAKER.
- PROVIDE AND INSTALL TWO N.O. SPARE CONTACTS, AND TWO N.C. SPARE CONTACTS FOR FUTURE AUTOMATIC EV CHARGER LOAD SHEDDING CONTROL OF EV FEEDER BREAKERS.
- PROVIDE AND INSTALL 800 AMP, 480V, THREE-PHASE CIRCUIT BREAKER IN NEMA 3R ENCLOSURE TO PROTECT THE FEEDERS FROM THE PORTABLE GENERATOR CONNECTION TERMINAL PANEL TO THE MANUAL TRANSFER SWITCH 'MTS'. INSTALL ADJACENT TO THE PORTABLE GENERATOR CONNECTION TERMINAL, SEE 1/E4-3.
- PROVIDE AND INSTALL NEW ENGRAVED LABEL ON EXTERIOR COVER TO READ: "PORTABLE GENERATOR SIZE NOT TO EXCEED 800KW". REMOVE EXISTING SIGNAGE ON COVER OF THE PORTABLE GENERATOR CONNECTION TERMINAL PANEL.
- GENERATOR POWER SYSTEM TO AUTOMATICALLY PROVIDE POWER WITHIN 10 SECONDS AFTER UTILITY POWER IS LOST.

APPROVALS

NOLL & TAM ARCHITECTS
729 Heinz Avenue
Berkeley, CA 94710
tel 510.542.2200
fax 510.542.2201

O'MAHONY & MYER
4340 Redwood Hwy., Suite 245
San Rafael, California 94903
Tel (415) 492-0420 Fax (415) 479-9662
www.omconsulting.com

PROJECT TITLE
**City of Los Altos
EMERGENCY OPERATION
CENTER**

97 Hillview Ave. Los Altos, CA
94022

ISSUE TITLE
PERMIT SET

ISSUE DATE
AUG 03, 2023




NOLL & TAM JOB NUMBER
22203

REVISIONS

NO.	DATE	DESCRIPTION
1	11/15/2023	PERMIT PLAN CHECK RESPONSE

SHEET TITLE
**SINGLE LINE
DIAGRAM - POWER**

SHEET NUMBER
E5-1

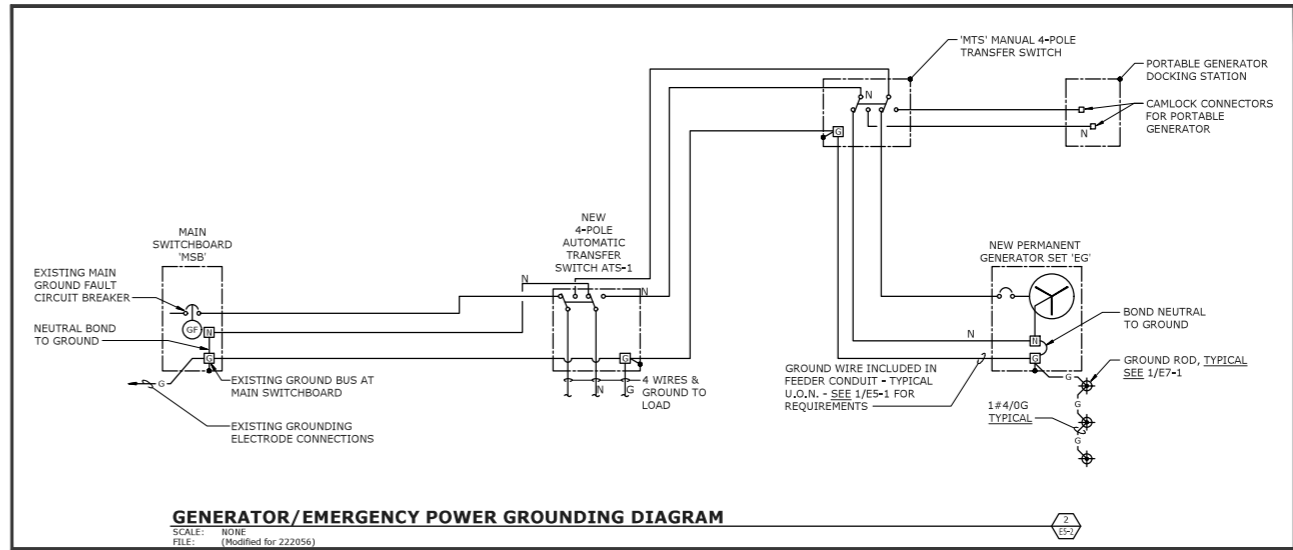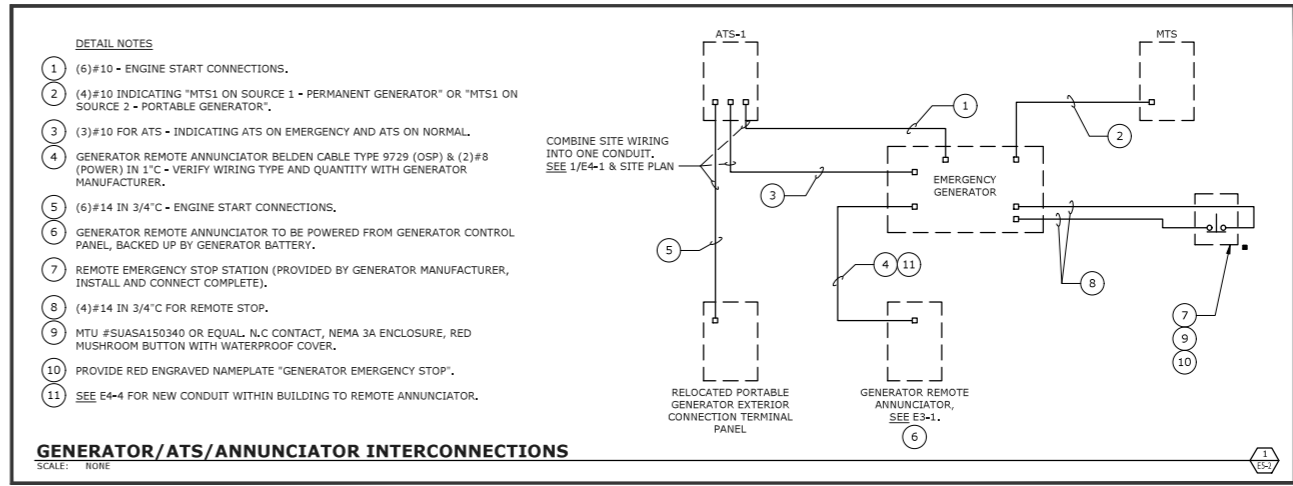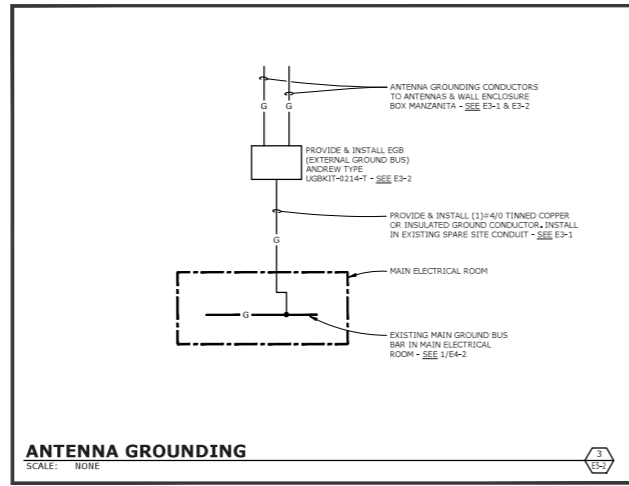

CITY OF LOS ALTOS
JOB COPY
REVIEWED FOR CODE COMPLIANCE

REVIEWED
FOR CODE COMPLIANCE
January 5, 2024
TRB AND ASSOCIATES

APPROVALS


NOLL & TAM
ARCHITECTS

729 Heinz Avenue
Berkeley, CA 94710
tel 510.542.2200
fax 510.542.2201



O'MAHONY & MYER
CONSULTING ENGINEERS AND ARCHITECTS
4340 Redwood Hwy., Suite 245
San Rafael, California 94903
Tel (415) 492-0420 Fax (415) 479-9662
www.omcconsulting.com

SEAL

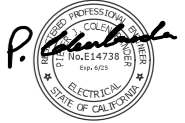

PROJECT TITLE

**City of Los Altos
EMERGENCY OPERATION
CENTER**

97 Hillview Ave. Los Altos, CA
94022

ISSUE TITLE

PERMIT SET

ISSUE DATE **AUG 03, 2023**

NOLL & TAM JOB NUMBER **22203**

REVISIONS

DATE	DESCRIPTION
11/15/2023	PERMIT PLAN CHECK RESPONSE

SHEET TITLE

DIAGRAMS

SHEET NUMBER

E5-2

Load Calculations					
				KVA	KW
Existing PG&E Demand (Community Center)				208	
133.2 KW	1.25	166.5 KW			
Existing Community Center PV System:					
Max System PV rating: 160 Amps @ 480 volt				133	
Estimated existing total max demand (Community Center With EOC):					
				341 KVA	273 KW
Future Youth Center conversion to city offices project:					
Future emergency load:	82	KVA		82 KVA	66 KW
Sub-Total				423 KVA	339 KW

CITY OF LOS ALTOS
JOB COPY
REVIEWED FOR CODE COMPLIANCE

EXISTING PANEL LE														
VOLTS: 120 / 208			PHASE: 3 PH			WIRE: 4 W			BUSING: 100A			POLES: 4SP		
MAIN BRKR: 100A MCB			FEEDER: SEE SINGLE LINE			CONDUIT: SEE SINGLE LINE			MOUNTED: SURFACE			AIC RATING: 65 KAIC		
LOAD DESCRIPTION	TYPE	A	B	C	BRKR	CKT	CKT	BRKR	A	B	C	TYPE	LOAD DESCRIPTION	
HVAC - CLG FANS LOBBY (E)	H	0.36			20/1	1	2	15/2	0.18			H	HVAC - FCUB MP1 120 (E)	
EMG POWER ELECT 120 (E)	H	0.10			20/1	3	4		0.16			H	HVAC - FCUB MP1 120 (E)	
HVAC - CLG FANS LOBBY (E)	H		0.50		20/1	5	6	15/2		0.37		H	HVAC - FCUB & FCUB3 WOMEN 123 (E)	
HVAC - CLG FANS MP1 120 (E)	H	0.40			20/1	7	8		0.37			H	HVAC - FCUB & FCUB3 WOMEN 123 (E)	
HVAC - CLG FANS SENIOR 120 (E)	H		0.20		20/1	9	10	15/2		0.10	0.10	H	HVAC - FCUB & FCUB3 ELECT 125, IT 126 (E)	
HVAC - CLG FANS SENIOR 140 (E)	H		0.30		20/1	11	12					H	HVAC - FCUB & FCUB3 ELECT 125, IT 126 (E)	
HVAC - CRJAN 124A, CPs FOR FCUB (E)	H	0.60			20/1	13	14	15/2	0.07			H	HVAC - FCUB & FCUB3 MEETING 121, 122 (E)	
RECEPTACLES ELECTRICAL ROOM (E)	R	0.38			20/1	15	16		0.07	0.07		H	HVAC - FCUB & FCUB3 MEETING 121, 122 (E)	
RECEIVER (E)	M				20/1	17	18	15/2				H	HVAC - BRB3 MEN 124 (E)	
LOBBY X MASS CHRISTMAS TREE (E)	R	0.36			20/1	19	20		0.06	0.06		H	HVAC - FCUB1 SENIOR 130 (E)	
FIRE SMOKE DAMPERS (E)	M		0.10		20/1	21	22	15/2		0.18		H	HVAC - FCUB1 SENIOR 130 (E)	
SPARE					20/1	23	24					H	HVAC - FCUB1 SENIOR 130 (E)	
NEW TRANSFER PAN *	H	1.20			25/2	25	26	15/2	0.18		0.18	H	HVAC - FCUB12 SENIOR 140 (E)	
NEW CONDENSING UNIT *	H	1.00			25/2	27	28					H	HVAC - FCUB12 SENIOR 140 (E)	
NEW FAN COIL *	H	0.07			15/2	31	32		5.00			H	SPACE	
SPACE			0.07			33	34	40/3		5.00		H	SPACE	
SPACE						35	36				5.00	H	SPACE	
SPACE						37	38					H	SPACE	
NEW RECEPTACLE CONDENSING UNIT *	R		0.18		20/1	39	40					H	SPACE	
SPACE						41	42					H	SPACE	
TOTALS				2.93	2.91	2.90			5.83	5.69	5.70			

NEW PANEL MP1 (MINI POWER CENTER)														
VOLTS: 120 / 208 V			PHASE: 3 PH			WIRE: 4 W			BUSING: 100A			POLES: 2AP		
MAIN BRKR: 45A MCB			FEEDER: SEE SINGLE LINE			CONDUIT: SEE SINGLE LINE			MOUNTED: SURFACE			AIC RATING: 42 KAIC		
LOAD DESCRIPTION	TYPE	A	B	C	BRKR	CKT	CKT	BRKR	A	B	C	TYPE	LOAD DESCRIPTION	
RECEPTACLES GENERATOR AREA	R	0.36			20/1	1	2	30/2	1.80			M	GENERATOR JACKET HEATER	
GENERATOR BATTERY CHARGER	M	0.20			20/1	3	4					M	GENERATOR JACKET HEATER	
FUEL PUMP CONTROLLER	M	0.20			20/1	5	6					R	RECEPTACLES GENERATOR AREA	
FUEL PUMP ASSEMBLY	M	1.00			20/1	7	8	20/1		0.15		R	RECEPTACLES GENERATOR AREA	
LIGHTING	L		0.80		20/1	9	10	20/1					SPACE	
SPARE					20/1	11	12	20/1					SPACE	
SPACE					20/1	13	14						SPACE	
SPACE						15	16						SPACE	
SPACE						17	18						SPACE	
SPACE						19	20						SPACE	
SPACE						21	22						SPACE	
SPACE						23	24						SPACE	
TOTALS				1.20	1.36				1.80	1.98				

VOLT DROP CALCULATIONS							Los Altos EOC	
FEEDER	LENGTH (FEET)	FLA (AMPS)	VOLTS	WIRE SIZE	OHMS / FT.	V-DROP (@ FLA)		
800 Amp Feeder from Generator	608	676	Generator Max Output To Community Center EOC					
10004 FEEDER 3 SETS 225 AMPS RUN	608	225		480	400	0.0321	7.61	1.58%
Feeder to new Mini Power Center								
480 VBR Single Phase 7.5KVA	608	15		480	6	0.461	7.76	1.62%

PHASE A: 8.76 KVA
PHASE B: 8.60 KVA
PHASE C: 8.60 KVA
73.00 MAX AMPS / PHASE

PHASE A: 3.00 KVA
PHASE B: 3.34 KVA
27.83 MAX AMPS / PHASE

NOLL & TAM ARCHITECTS

729 Heinz Avenue
Berkeley, CA 94710
tel 510.542.2200
fax 510.542.2201



O'MAHONY & MYER
4340 Redwood Hwy., Suite 245
San Rafael, California 94903
Tel (415) 492-0420 Fax (415) 476-9662
www.omcconsulting.com



PROJECT TITLE

**City of Los Altos
EMERGENCY OPERATION CENTER**

97 Hillview Ave. Los Altos, CA 94022

ISSUE TITLE
PERMIT SET

ISSUE DATE
AUG 03, 2023

NOLL & TAM JOB NUMBER
22203













REVISIONS	DATE	DESCRIPTION
1	11/15/2023	PERMIT PLAN CHECK RESPONSE

SHEET TITLE
SCHEDULES

SHEET NUMBER
E6-1

REVIEWED
FOR CODE COMPLIANCE
January 5, 2024
TRB AND ASSOCIATES

CITY OF LOS ALTOS
JOB COPY
 REVIEWED FOR CODE COMPLIANCE

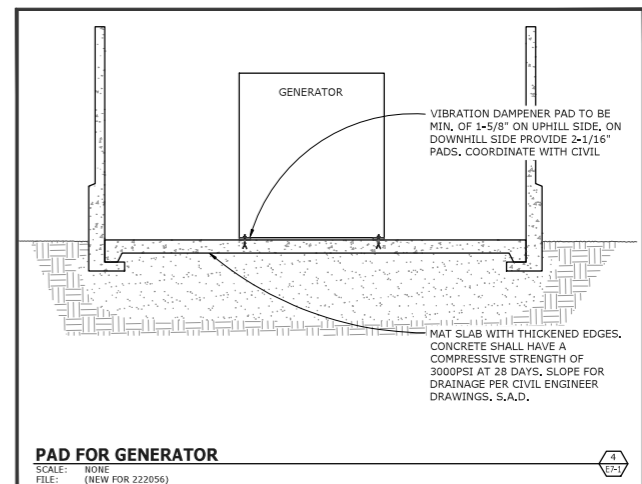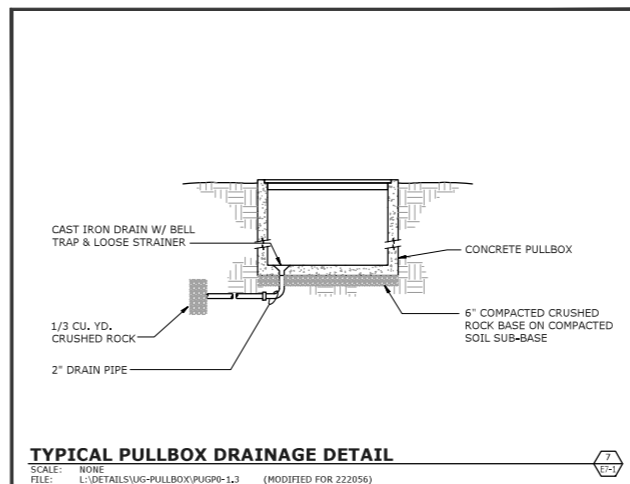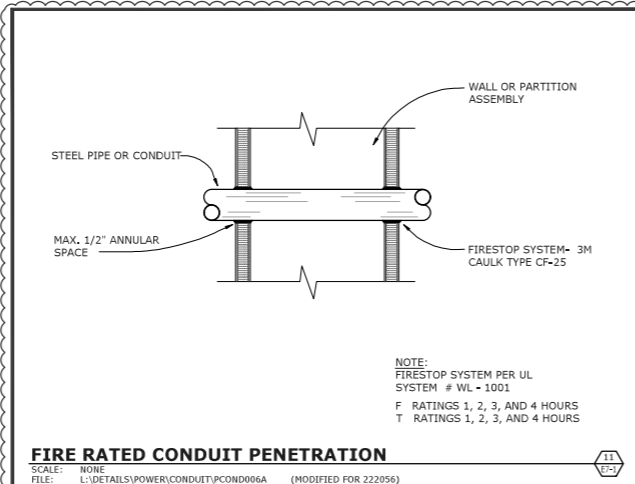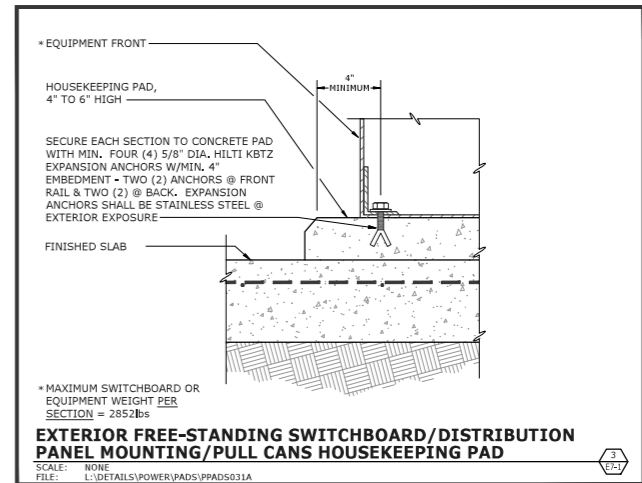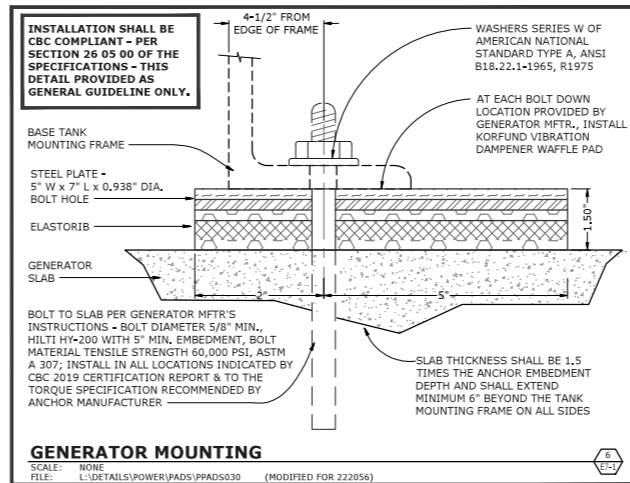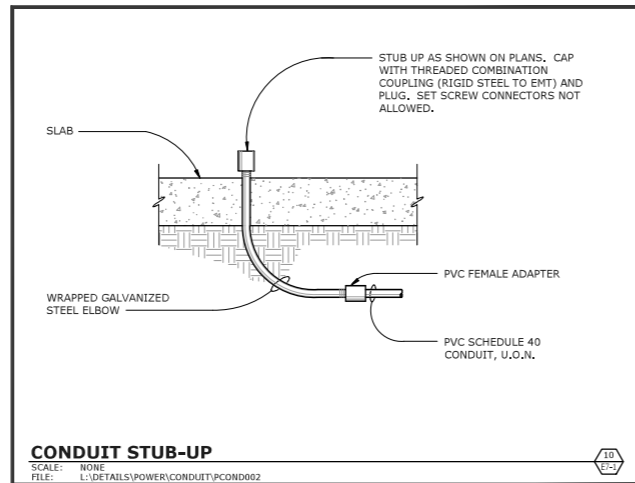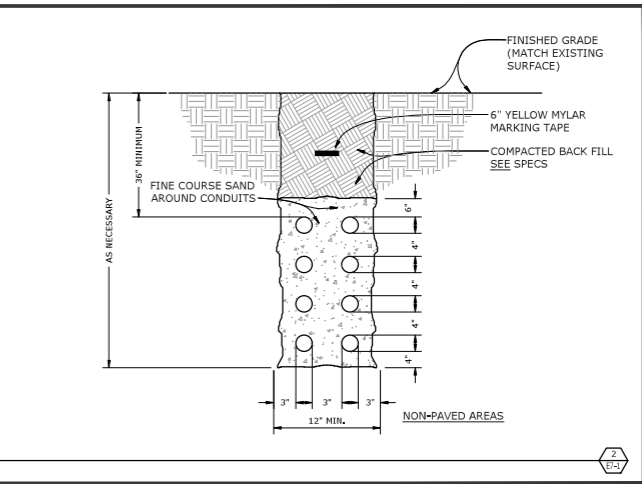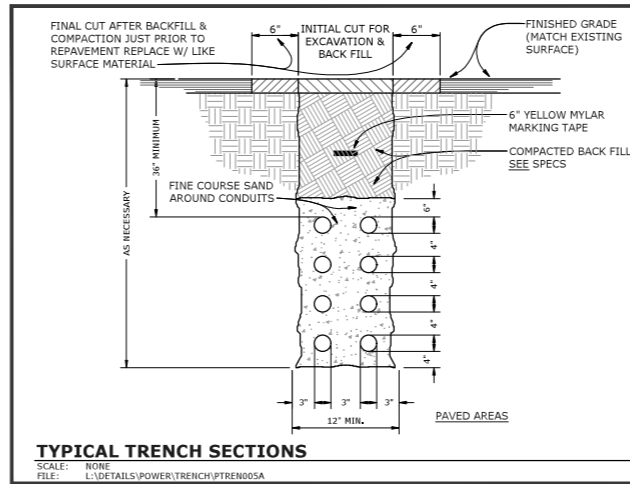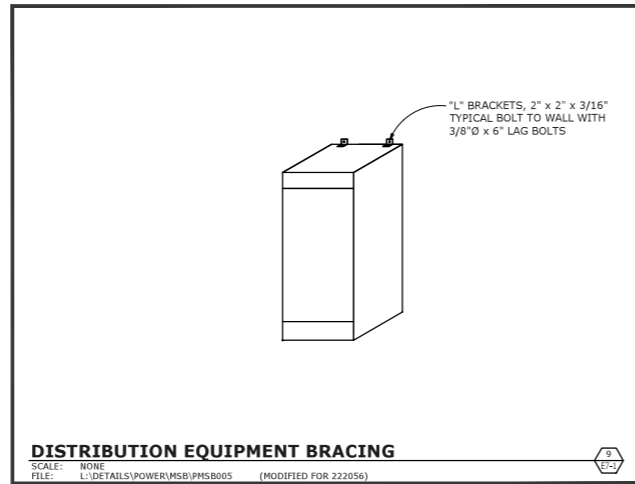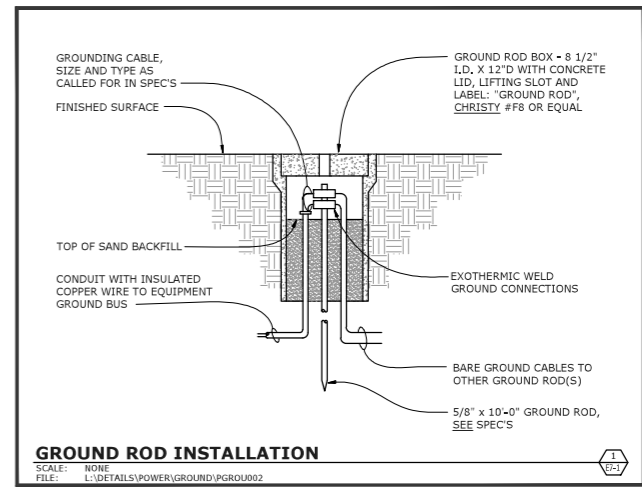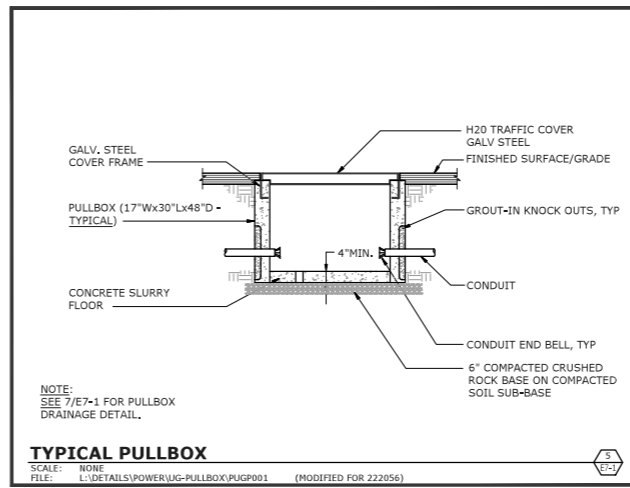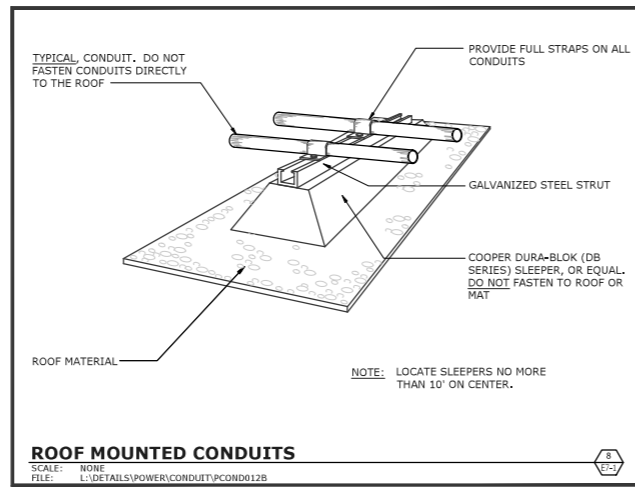

APPROVALS

NOLL & TAM ARCHITECTS

729 Heinz Avenue
 Berkeley, CA 94710
 tel 510.542.2200
 fax 510.542.2201



O'MAHONY & MYER
 CIVIL ENGINEERS AND ARCHITECTS
 4340 Redwood Hwy., Suite 245
 San Rafael, California 94903
 Tel (415) 492-0420 Fax (415) 476-9662
 www.omconsulting.com

SEAL



PROJECT TITLE

**City of Los Altos
 EMERGENCY OPERATION CENTER**

97 Hillview Ave. Los Altos, CA 94022

ISSUE TITLE

PERMIT SET

ISSUE DATE **AUG 03, 2023**

NOLL & TAM JOB NUMBER **22203**

REVISIONS

DATE	DESCRIPTION
11/15/2023	PERMIT PLAN CHECK REPOSE

SHEET TITLE **DETAILS**


SHEET NUMBER **E7-1**

REVIEWED
 FOR CODE COMPLIANCE
 January 5, 2024
 TRB AND ASSOCIATES

AUDIO VISUAL SYSTEMS GENERAL NOTES

- REFER TO SPECIFICATIONS FOR COMPLETE REQUIREMENTS.
- PROVIDE CONDUIT, BOXES AND FITTINGS SHOWN ON AUDIO VISUAL (AV) DRAWINGS UNDER THE WORK OF SECTION 27 05 33 COMMUNICATIONS RACEWAYS, BOXES AND FITTINGS. UNLESS OTHERWISE INDICATED, PROVIDE 1 INCH TRADE SIZE MINIMUM. PROVIDE RACEWAY SIZE AS REQUIRED FOR A MAXIMUM OF 30 PERCENT WIRE FILL.
- PROVIDE FIRESTOPPING UNDER THE WORK OF SECTION 27 05 33.
- LOCATIONS SHOWN ON THE ARCHITECTURAL DRAWINGS TAKE PRECEDENCE OVER LOCATIONS SHOWN ON THE COMMUNICATIONS SYSTEMS DRAWINGS.
- DEVICE QUANTITIES SHOWN ON FLOOR PLANS AND REFLECTED CEILING PLANS TAKE PRECEDENCE OVER DEVICE QUANTITIES SHOWN ON FUNCTIONAL DIAGRAMS.
- QUANTITIES SHOWN ON FUNCTIONAL DIAGRAMS TAKE PRECEDENCE OVER QUANTITIES SHOWN ON RACK ELEVATIONS.
- QUANTITIES SHOWN ON DEVICE SCHEDULES TAKE PRECEDENCE OVER QUANTITIES SHOWN ON FUNCTIONAL DIAGRAMS, FLOOR PLANS AND REFLECTED CEILING PLANS.
- LOCATIONS SHOWN ON LARGE SCALE DRAWINGS TAKE PRECEDENCE OVER LOCATIONS SHOWN ON SMALL SCALE DRAWINGS.
- NOT USED.
- WIRING FOR THE WORK OF AUDIO VISUAL SYSTEMS IS NOT PERMITTED TO SHARE CONDUIT, SLEEVES OR J-HOOKS WITH WIRING FOR WORK OF COMMUNICATIONS WIRES, CABLES AND RELATED. MAINTAIN AT LEAST 2 INCHES SEPARATION IF RUNNING PARALLEL. MAINTAIN AT LEAST 3 INCHES OF SEPARATION VERTICALLY IF CROSSING AT RIGHT ANGLES.

LEGEND

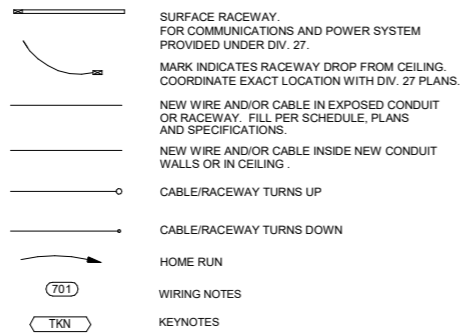

JUNCTION BOX SCHEDULE


SYMBOL	H (INCHES)	W (INCHES)	D (INCHES)
J1	6	6	4
J2	8	8	4
J3	12	12	4
J4	12	12	6
J5	12	12	8
J6	16	12	8
J7	18	18	6
J8	20	16	6
J9	20	16	8
J10	20	20	6
J11	20	20	8
J12	24	20	6
J13	24	20	8
J14	24	24	8
J15	30	24	8
J16	30	30	8
J17	36	30	8
J18	36	36	8

SUFFIX	NOTE
NONE - NEMA 1	ALL JUNCTION BOXES TO BE HINGED TYPE, PROVIDED WITHOUT PRE-PUNCHED KNOCKOUTS. PENETRATIONS IN JUNCTION BOXES SHALL BE CUT OR PUNCHED AS REQUIRED FOR INSTALLATION. PAINT ALL INTERIOR BOXES TO MATCH WALL FINISH. COORDINATE FINISH WITH ARCH. PLANS.
A - NEMA 12	
B - NEMA 3R	
C - NEMA 4	
D - NEMA 4X	


ABBREVIATIONS

A.D.A.	AMERICANS WITH DISABILITIES ACT	MMF	MULTI MODE OPTICAL FIBER
A.F.C.	ABOVE FINISHED CEILING	MOD.	MODULAR
A.F.F.	ABOVE FINISHED FLOOR	MPOE	MINIMUM POINT OF ENTRY
ALT	ALTERNATE	(N)	NEW
A.M.F.F.	ABOVE MEZZANINE FINISHED FLOOR	NEC	NATIONAL ELECTRICAL CODE
BDF	BUILDING DISTRIBUTION FACILITY	N.I.C.	NOT IN CONTRACT
B.F.C.	BELOW FINISHED CEILING	NTS	NOT TO SCALE
BLDG.	BUILDING	O.C.	ON CENTER
B.O.H.	BACK OF HOUSE	O.D.	OUTSIDE DIAMETER
C.	CONDUIT	O.F.E.	OWNER FURNISHED EQUIPMENT
CAT.	CATEGORY	OPP.	OPPOSITE
CBC	CALIFORNIA BUILDING CODE	OSP	OUTSIDE PLANT
CEC	CALIFORNIA ELECTRICAL CODE	PNL.	PANEL
COMM.	COMMUNICATIONS	PROJ.	PROJECT
C.L.	CENTERLINE	P.S.R.H.	PROJECT STANDARD RECEPTACLE HEIGHT +18" ATT. U.O.N.
C.O.	CONDUIT ONLY	P.S.S.H.	PROJECT STANDARD SWITCH HEIGHT +48" AFF TO U.O.N.
CONT.	CONTINUATION	RE:	REFER TO
CS	COMMUNICATIONS SYSTEM	REF.	REFERENCE
(D)	DEMOLISH EXISTING	S.A.D.	SEE ARCHITECTURAL DRAWINGS
DED	DEDUCTIVE	S.E.D.	SEE ELECTRICAL DRAWINGS
DIA.	DIAMETER	S.I.D.	SEE INTERIORS DRAWINGS
DIV	DIVISION	S.M.D.	SEE MECHANICAL DRAWINGS
(E)	EXISTING	SIM.	SIMILAR
E.A.	EACH	SMF	SINGLE MODE OPTICAL FIBER
EIA	ELECTRONIC INDUSTRIES ASSOCIATION	SN	SHEET NOTE
ELEV.	ELEVATION	SP	SHIELDED PAIR - SEE SPECIFICATIONS
E.O.L.	END OF LINE	SPEC	SPECIFICATION
EQPT.	EQUIPMENT	S.R.	SURFACE RACEWAY
FIN	FINISHED	STD	STANDARD
FUT	FUTURE	STP	SHIELDED TWISTED PAIR
H.R.	HOME RUN	T.C.	TELECOMMUNICATIONS CLOSET
HT.	HEIGHT	TEL	TELEPHONE
IDF	INTERMEDIATE DISTRIBUTION FACILITY	TELCOM	TELECOMMUNICATIONS
J.BOX	JUNCTION BOX	TIA	TELECOMMUNICATIONS INDUSTRY ASSOCIATION
LAN	LOCAL AREA NETWORK	TP	TWISTED PAIR
MAX.	MAXIMUM	TYP.	TYPICAL
MDF	MAIN DISTRIBUTION FACILITY	U.O.N.	UNLESS OTHERWISE NOTED
MIN.	MINIMUM	W/	WITH
		WP	WEATHERPROOF

AV FUNCTIONALS LEGEND

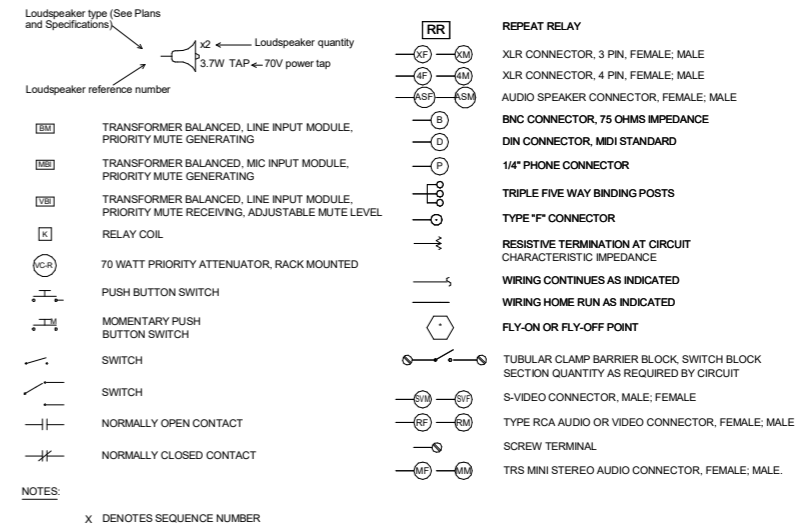

GENERAL SYMBOLS

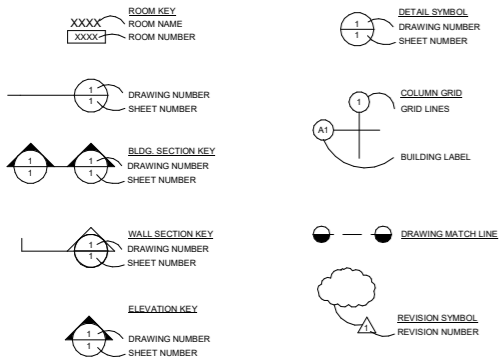

SYMBOL SCHEDULE

SYMBOL	DEVICE	FUNCTION OR SERVICE	LOCATION	WORK OF	ROUGH-IN	RACEWAY	ELEVATION	CABLE FILL & HOMERUN DESTINATION, U.O.N.	FINISH	WEIGHT, LB	DETAIL SHEET(S)
3331Y 041 BY V	MEDIA PANEL, OFF-AIR TELEVISION OUTPUT	AUDIO-VISUAL SYSTEMS	WALL	27 41 23	2 GANG OLD WORK BOX WITH 1 GANG PLATE	R6	+18" A.F.F. TO C.L., U.O.N.	PER FUNCTIONAL AND AS NOTED.	MATCH SURROUNDING PLATES	N/A	N/A
3331Y 041 BY V	MEDIA PANEL, DBS TELEVISION OUTPUT	AUDIO-VISUAL SYSTEMS	WALL	27 41 23	2 GANG OLD WORK BOX WITH 1 GANG PLATE	R6	+18" A.F.F. TO C.L., U.O.N.	PER FUNCTIONAL AND AS NOTED.	MATCH SURROUNDING PLATES	N/A	N/A

NOTE NO. DEVICE NOTES

DN1	THE LABEL INDICATES THE STATION NUMBER. REFER TO THE DEVICE SCHEDULES
WO1	WORK OF OTHERS. AUDIOVISUAL CONTRACTOR TO COORDINATE IN FIELD WITH CONTRACTOR PROVIDING INFRASTRUCTURE/BACKBOXES.
LR11	FLUSH 4S BOX IN WALL ADJ. TO INDICATED LOCATION. FISH CABLE THROUGH FURNITURE TO OWNER SELECTED MOUNTING LOCATION.
LR12	TOP OF DOOR AND IN DOOR FRAME, NOT MORE THAN 6" FROM JAMB SIDE. INSTALLATION SHALL NOT COMPROMISE FIRE RATING OF DOOR.
LR13	4S BOX W/ 1 GANG RING BLANK COVER PLATE
LR14	ABOVE DESK IN ELECTRIFIED BELT OR AT BASE IN ELECTRIFIED BASE PER OWNER'S REP.
LR15	AT SUSPENDED CLG CONDITIONS, SM 4S BOX, BLNK COVER & FLEX C TO DEVICE. ELSEWHERE MOUNTED IN CEILING ADJ TO DEVICE OR MNT DEVICE TO COVER PLATE.
LR16	SURFACE MTD 4S BOX WITH BLANK COVER PLATE INSTALLED ADJACENT TO TRACK AND WITHIN 6" OF FLOOR. PROVIDE ONE DEVICE AT OPPOSITE SIDES OF EACH OPENING. INSTALL DEVICE TO TRACK PER MANUFACTURER'S INSTRUCTIONS.
LR17	CUSTOM VENTED BACKBOX (CRESTRON BB4L OR EQUAL) WITH LOCKING HINGED COVER PLATE (FSR WB-MR3G OR EQUAL).
LR18	4S BOX W/ BLANK COVER PLATE W/ GROMMET OPENING MTD WITHIN 6" OF LATCH AT UNDERSIDE OF ROOF. EXTEND HS TO HATCH FRAME AND INSTALL IN ACCORDANCE WITH MANUFACTURER INSTRUCTIONS.
LR19	4S BOX W/ 1 GANG RING WITH LOCKING HINGED COVER PLATE (FSR WB-MR2G OR EQUAL).
LR10	PROVIDE BACKING IN WALL TO SUPPORT DEVICE WEIGHING UP TO 100 POUNDS SUPPORTED UP TO 12" FROM FINISHED FACE OF WALL.

RACEWAY NOTES

R1	2" C. H.R. TO R35
R2	NOT USED.
R3	NOT USED.
R4	AS DETAILED AND/OR SCHEDULED
R5	3/4" C. H.R. TO ACCESSIBLE CEILING, U.O.N.
R6	1" C. H.R. TO ACCESSIBLE CEILING, U.O.N.
R7	1-1/4" C. H.R. TO ACCESSIBLE CEILING, U.O.N.
R8	LIQUIDTITE TO SERVING EFM, EFM-R OR FMP, AS APPLIES. SIZE TO MATCH FILL AT 40% FILL MAXIMUM.
R9	AT ACCESSIBLE CEILING, PROVIDE ABOVE CEILING PATHWAY USING CABLE HOOKS. WHERE MOUNTED IN GYP CEILING, EXTEND 3/4" C. TO ACCESSIBLE CEILING.
R10	1-1/4" C TO 1 GANG COMPARTMENT. SEE ELECTRICAL DRAWINGS FOR ELECTRICAL ROUGH-IN
R11	(3) 1-1/4" C TO 6 GANG COMPARTMENT STUBBED TO ACCESSIBLE CEILING, (2) 1-1/4" C TO 3 GANG COMPARTMENT STUBBED TO ACCESSIBLE CEILING, AND (1) 1-1/4" C TO EACH 1 GANG COMPARTMENT STUBBED TO ACCESSIBLE CEILING. SEE DIV. 26 FOR ELECTRICAL RACEWAY.
R12	3/4" C. BETWEEN MAIN STATION 4S BACKBOX AND POWER SUPPLY 4S BACKBOX. 3/4" FROM MAIN STATION BACKBOX TO ADJACENT SIM LAB ACCESSIBLE CEILING.
R13	(2) 1.5"C. FROM EACH 5S BACKBOX TO ACCESSIBLE CEILING AND (2) 1"C. FROM 4S BACKBOX TO ACCESSIBLE CEILING

ACCESSIBLE CEILING IS A T-BAR OR SIMILAR GRID BASED, PANELIZED REMOVEABLE CEILING MEETING THE DEFINITION FOR ACCESSIBLE WIRING METHODS IN ARTICLE 100 OF THE CALIFORNIA ELECTRICAL CODE.

CITY OF LOS ALTOS
JOB COPY
REVIEWED FOR CODE COMPLIANCE

APPROVALS



SEAL

PROJECT TITLE

City of Los Altos
 Los Altos CC EOC
 97 Hillview Ave.
 Los Altos, CA 94022

ISSUE TITLE

PERMIT SET

ISSUE DATE

AUG 03, 2023

REVISIONS

DATE	DESCRIPTION

SHEET TITLE

GENERAL NOTES,
 LEGEND, SYMBOL,
 ABBREVIATIONS,
 JUNCTION BOX &
 SYMBOL SCHEDULES

SHEET NUMBER

TA0-1

REVIEWED
 FOR CODE COMPLIANCE
 January 5, 2024
 TRB AND ASSOCIATES



KEYNOTES

APPROVALS

NOLL & TAM
ARCHITECTS

729 Heinz Avenue
Berkeley, CA 94710
tel 510.542.2200
fax 510.542.2201



SEAL

PROJECT TITLE

**City of Los Altos
Los Altos CC EOC**

97 Hillview Ave.
Los Altos, CA 94022

ISSUE TITLE
PERMIT SET

ISSUE DATE
AUG 03, 2023

NOLL & TAM JOB NUMBER
22203

REVISIONS
DATE DESCRIPTION

CITY OF LOS ALTOS
JOB COPY
REVIEWED FOR CODE COMPLIANCE

REVIEWED
FOR CODE COMPLIANCE
January 5, 2024
TRB AND ASSOCIATES


SHEET TITLE
**FLOOR PLAN -
AUDIOVISUAL**

SHEET NUMBER

TA2-1

8/2/2023 3:36:56 PM AutodesK Docs:\Los Altos EOC\COLA-EOC_Av\JT_Central_2023.rvt

1 FLOOR PLAN - AUDIOVISUAL
1/8" = 1'-0"

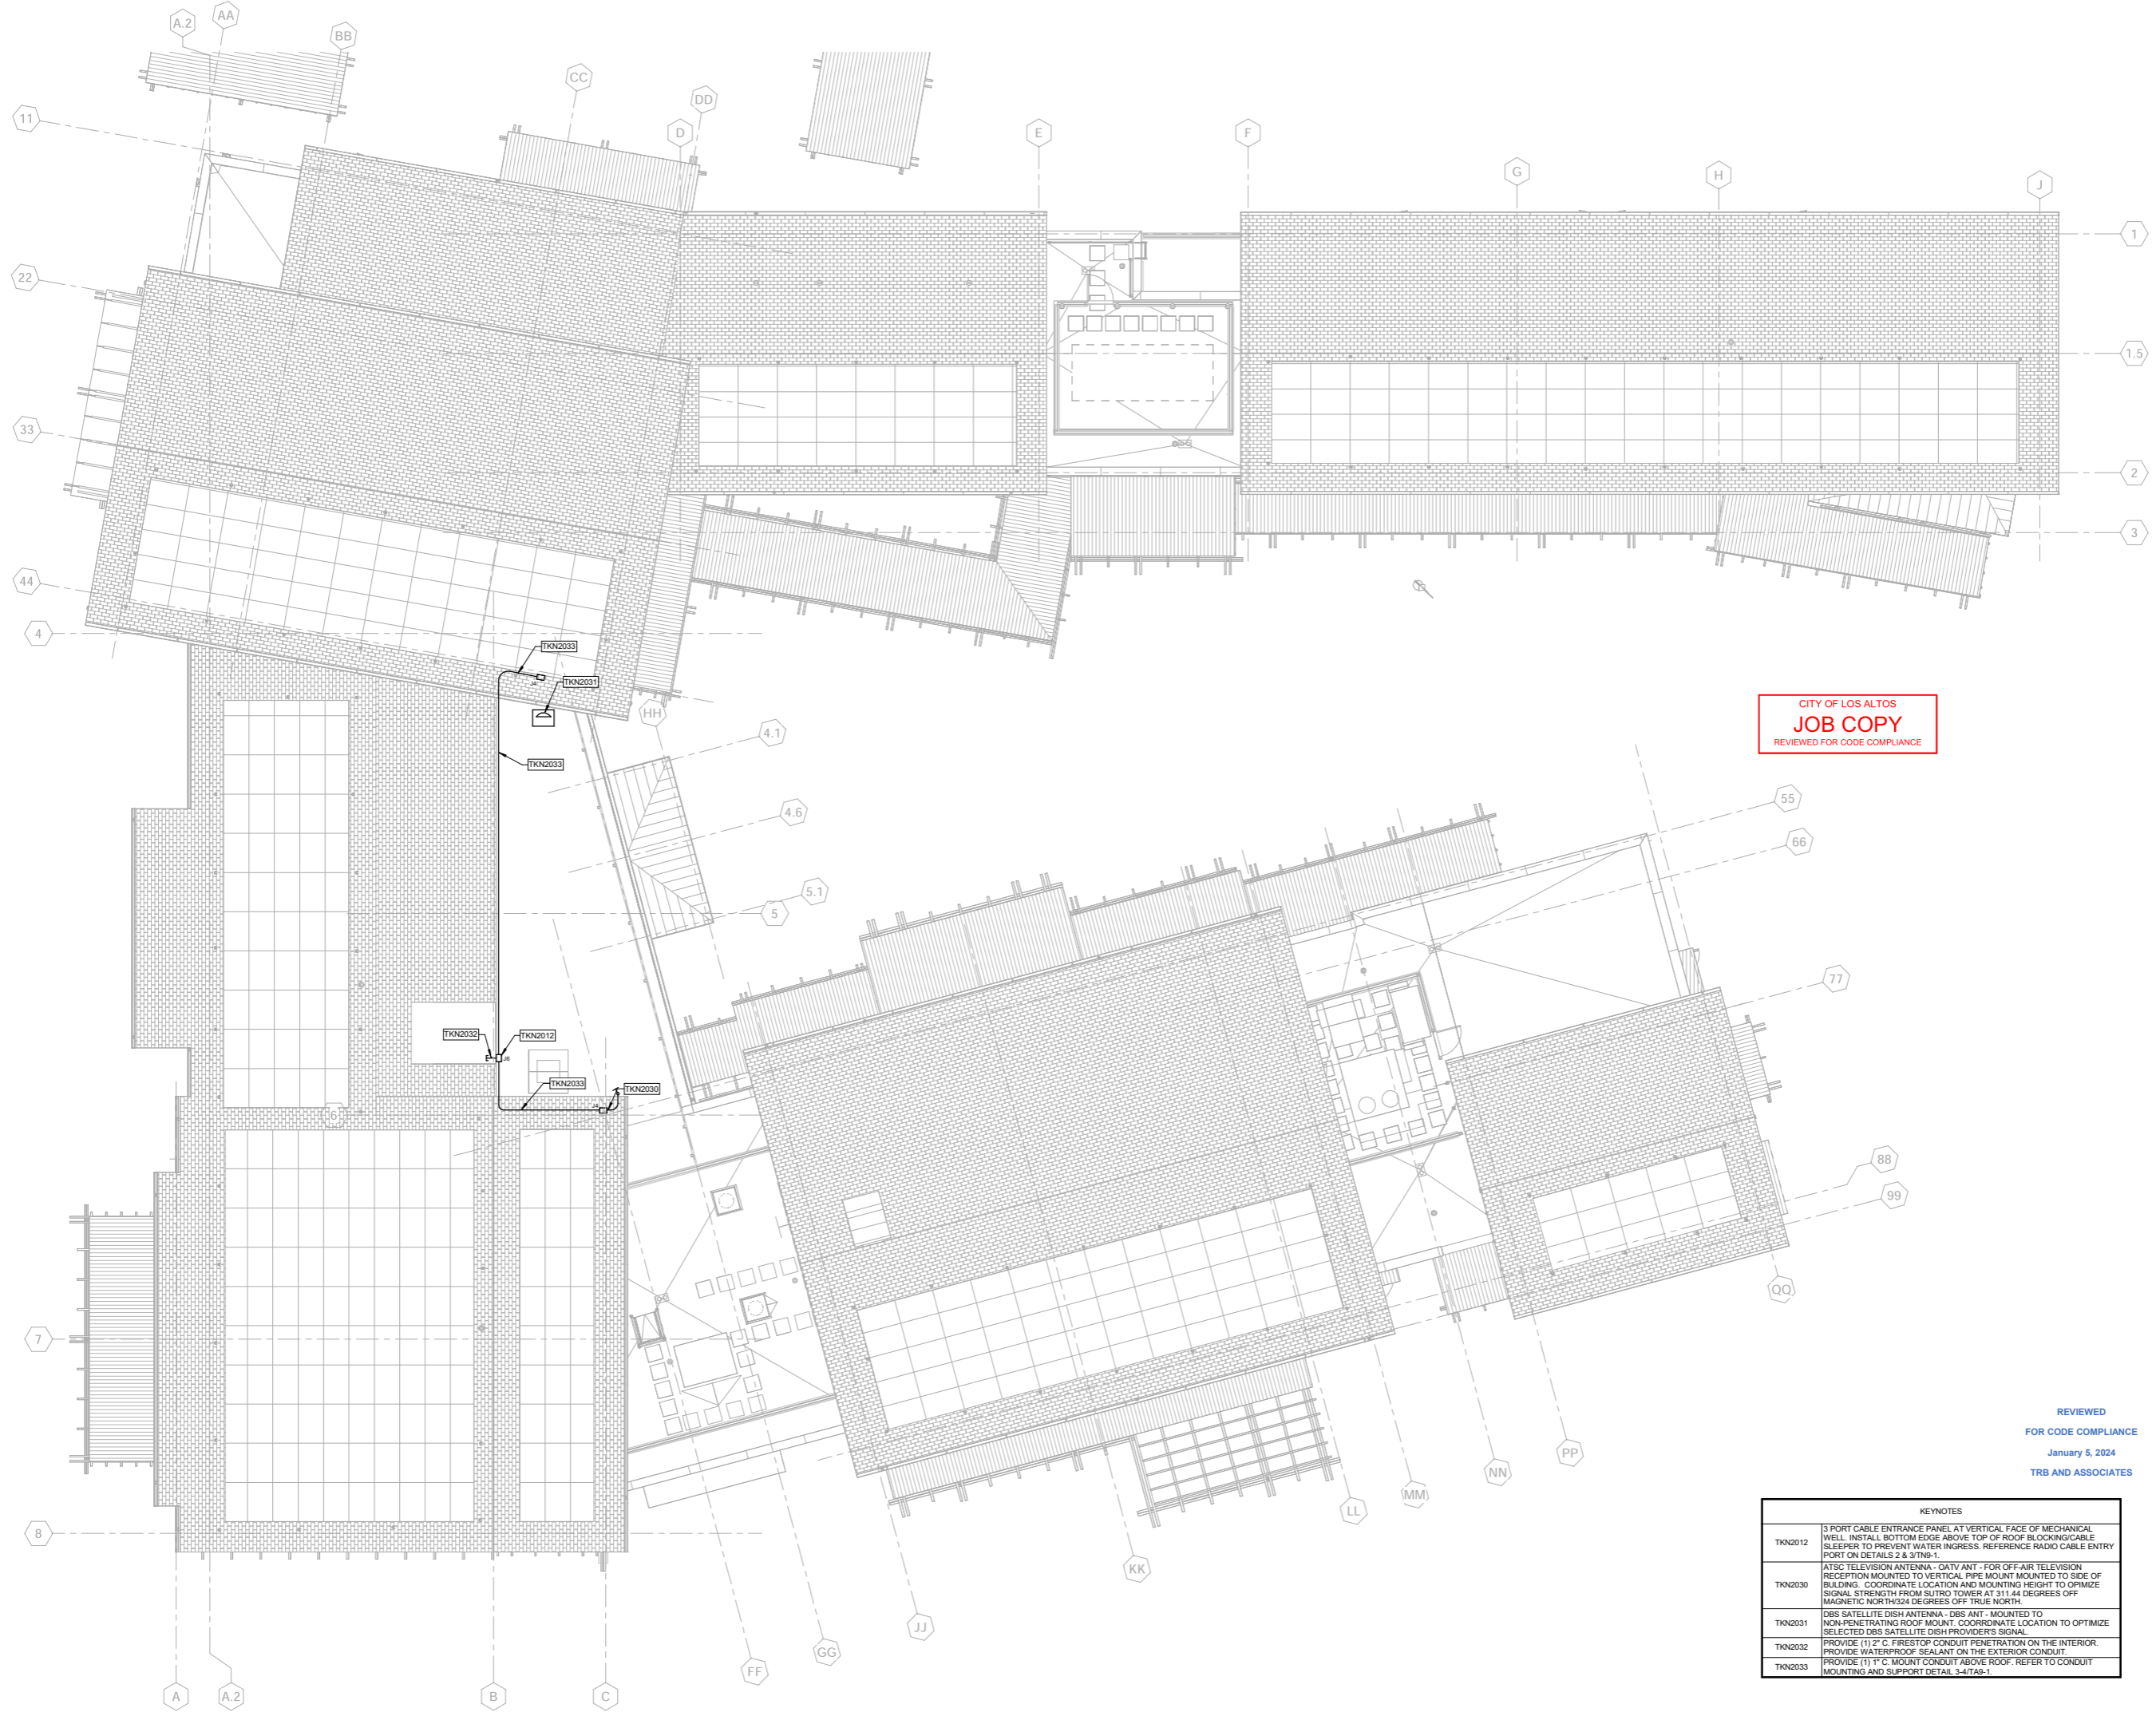

CITY OF LOS ALTOS
JOB COPY
 REVIEWED FOR CODE COMPLIANCE

REVIEWED
 FOR CODE COMPLIANCE
 January 5, 2024
 TRB AND ASSOCIATES

KEYNOTES	
TKN2012	3 PORT CABLE ENTRANCE PANEL AT VERTICAL FACE OF MECHANICAL WELL. INSTALL BOTTOM EDGE ABOVE TOP OF ROOF BLOCKING/CABLE SLEEPER TO PREVENT WATER INGRESS. REFERENCE RADIO CABLE ENTRY PORT ON DETAILS 2 & 3/TN-1.
TKN2030	ATSC TELEVISION ANTENNA - QATV ANT - FOR OFF-AIR TELEVISION RECEPTION MOUNTED TO VERTICAL PIPE MOUNT MOUNTED TO SIDE OF BUILDING. COORDINATE LOCATION AND MOUNTING HEIGHT TO OPTIMIZE SIGNAL STRENGTH FROM SUTRO TOWER AT 311.44 DEGREES OFF MAGNETIC NORTH/324 DEGREES OFF TRUE NORTH.
TKN2031	DBS SATELLITE DISH ANTENNA - DBS ANT - MOUNTED TO NON-PENETRATING ROOF MOUNT. COORDINATE LOCATION TO OPTIMIZE SELECTED DBS SATELLITE DISH PROVIDER'S SIGNAL.
TKN2032	PROVIDE (1) 2" C. FIRESTOP CONDUIT PENETRATION ON THE INTERIOR. PROVIDE WATERPROOF SEALANT ON THE EXTERIOR CONDUIT.
TKN2033	PROVIDE (1) 1" C. MOUNT CONDUIT ABOVE ROOF. REFER TO CONDUIT MOUNTING AND SUPPORT DETAIL 3-4/TAG-1.

8/22/2023 3:37:01 PM Autocad Doc:Los Altos EDCOCLA-EOC_AvJT_Central_2023.rvt


1 ROOF PLAN - AUDIOVISUAL
 1/8" = 1'-0"

APPROVALS

NOLL & TAM

ARCHITECTS

729 Heinz Avenue
 Berkeley, CA 94710
 tel 510.542.2200
 fax 510.542.2201



SEAL

PROJECT TITLE

City of Los Altos
 Los Altos CC EOC

97 Hillview Ave.
 Los Altos, CA 94022

ISSUE TITLE

PERMIT SET

ISSUE DATE AUG 03, 2023

NOLL & TAM JOB NUMBER 22203

REVISIONS	DATE	DESCRIPTION

SHEET TITLE

ROOF PLAN - AUDIOVISUAL

SHEET NUMBER

TA2-2

KEYNOTES
 TKN2001C PROVIDE (1) 2" C. ABOVE CEILING AREA HOMERUN CONDUIT TO MDF/TR 1.0 AND EXTEND CONDUIT TO THE NEAREST CABLE TRAY

APPROVALS

NOLL & TAM
 ARCHITECTS

729 Heinz Avenue
 Berkeley, CA 94710
 tel 510.542.2200
 fax 510.542.2201



CITY OF LOS ALTOS
JOB COPY
 REVIEWED FOR CODE COMPLIANCE

SEAL

PROJECT TITLE

City of Los Altos
 Los Altos CC EOC

97 Hillview Ave.
 Los Altos, CA 94022

ISSUE TITLE
PERMIT SET

ISSUE DATE
 AUG 03, 2023

NOLL & TAM JOB NUMBER
 22203

REVISIONS	DATE	DESCRIPTION

SHEET TITLE
RCP - AUDIOVISUAL

SHEET NUMBER


TA6-1

REVIEWED
 FOR CODE COMPLIANCE
 January 5, 2024
 TRB AND ASSOCIATES

8/2/2023 3:37:07 PM Autodesk Docs://Los Altos EOC/EOC-A-VI_T_Central_2023.rvt

1 RCP - AUDIOVISUAL
 1/8" = 1'-0"

KEYNOTES	
TKN	TELECOMMUNICATIONS SYSTEMS: COMPLY WITH DIVISION 27.
(TKN1)	ROOFTOP MOUNTED OFF-AIR TELEVISION MULTI-DIRECTIONAL ANTENNA.
(TKN2)	ROOFTOP MOUNTED DBS SATELLITE DISH ANTENNA.
(TKN3)	RG6L
(TKN4)	1-2 RG6L AS REQUIRED BY DBS PROVIDER.
(TKN5)	CITY FURNISHED CART MOUNTED DISPLAY WITH HDMI INPUT.
(TKN6)	10' HDMI CABLE.
(TKN7)	CITY FURNISHED CART MOUNTED TV WITH ATSC TUNER INPUT.
(TKN8)	10' RG6 CABLE.

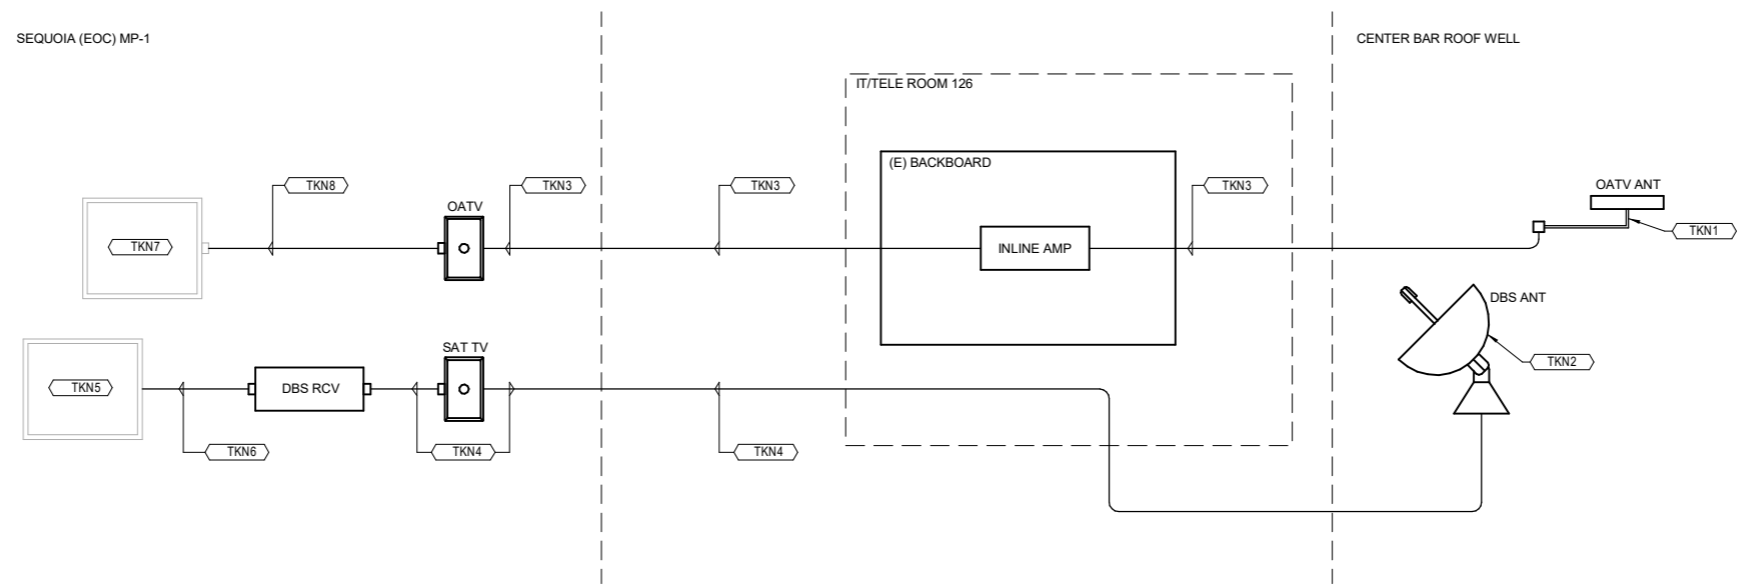

CITY OF LOS ALTOS
JOB COPY
 REVIEWED FOR CODE COMPLIANCE

1 OAT AND DBS TELEVISION SYSTEM SINGLE LINE DIAGRAM
 NTS

APPROVALS

NOLL & TAM
 ARCHITECTS

729 Heinz Avenue
 Berkeley, CA 94710
 tel 510.542.2200
 fax 510.542.2201



SEAL

PROJECT TITLE

City of Los Altos
 Los Altos CC EOC

97 Hillview Ave.
 Los Altos, CA 94022

ISSUE TITLE
PERMIT SET

ISSUE DATE
 AUG 03, 2023

NOLL & TAM JOB NUMBER
 22203

REVISIONS

DATE	DESCRIPTION

SHEET TITLE
OAT AND DBS TELEVISION SYSTEMS SINGLE LINE DIAGRAM


SHEET NUMBER

TA7-1

REVIEWED
 FOR CODE COMPLIANCE
 January 5, 2024
 TRB AND ASSOCIATES


KEYNOTES	
TKN	COMMUNICATIONS SYSTEMS COMPLY WITH DIVISION 27.
(TKN1)	NPRM AS SPECIFIED IN SECTION 27 41 33. ASYMMETRICAL DESIGN PERMITS MAST TO BE PLACED ADJACENT TO ROOF EDGE/PARAPET PROVIDING DBS MAXIMUM SIGNAL STRENGTH WITH MINIMUM MAST HEIGHT.
(TKN2)	CUT MAST TO HEIGHT REQUIRED WHILE MINIMIZING PUBLIC VISIBILITY.

CITY OF LOS ALTOS
JOB COPY
REVIEWED FOR CODE COMPLIANCE

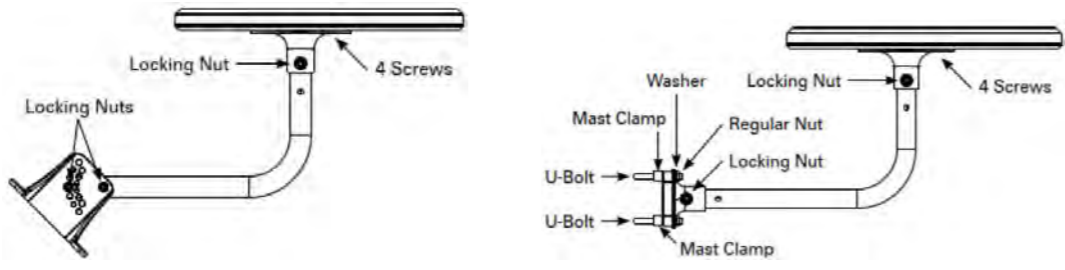


WALL AND ROOF MOUNT

POLE MOUNT

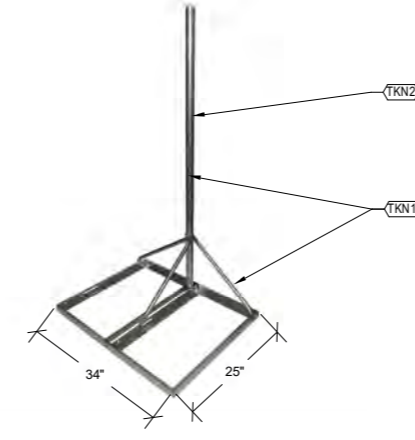

2A NPRM ISOMETRIC

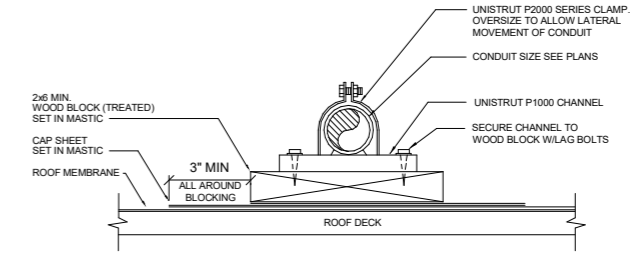

3 CONDUIT MOUNTING ABOVE ROOF

1 OMNIDIRECTIONAL TV ANTENNA MOUNTING DETAIL

2 NON-PENETRATING ROOF MOUNT



DB Series
Base with Galv. Channel - 1" (25mm) high
Dimensions - 5" (127mm) High x 6" (152mm) Wide x Length (overall length)
Ultimate Load Capacity - (uniform load) *

DB5 = 200 lbs. (0.89kN)	DB30 = 1,500 lbs. (6.67kN)
DB10 = 500 lbs. (2.22kN)	DB40 = 2,000 lbs. (8.89kN)
DB20 = 1,000 lbs. (4.45kN)	DB48 = 2,500 lbs. (11.12kN)

UPC Part #	Cat #	Height	Width	Overall Length	Weight Each
782051 50036	DB5	5" (127mm)	6" (152mm)	4.8" (122mm)	2.76 (1.25kg)
782051 49972	DB10	5" (127mm)	6" (152mm)	9.8" (249mm)	5.26 (2.39kg)
782051 49874	DB20	5" (127mm)	6" (152mm)	35.3" (895mm)	10.63 (4.82kg)
782051 50021	DB30	5" (127mm)	6" (152mm)	36.8" (935mm)	15.98 (7.25kg)
782051 50022	DB40	5" (127mm)	6" (152mm)	41.4" (1052mm)	21.34 (9.68kg)
782051 50023	DB48	5" (127mm)	6" (152mm)	52.0" (1321mm)	26.70 (12.0kg)




DB6 Series
Base with 12 ga. (2.6mm) Galv. Channel - 2 3/4" (62mm) high
Dimensions - 6 1/2" (163mm) High x 6" (152mm) Wide x Length (overall length)
Ultimate Load Capacity - (uniform load) *


DB610 = 500 lbs. (2.22kN)	DB640 = 2,000 lbs. (8.89kN)
DB620 = 1,000 lbs. (4.45kN)	DB648 = 2,500 lbs. (11.12kN)
DB630 = 1,500 lbs. (6.67kN)	

UPC Part #	Cat #	Height	Width	Overall Length	Weight Each
782051 50024	DB610	6 1/2" (163mm)	6" (152mm)	9.6" (244mm)	6.30 (2.86kg)
782051 50025	DB620	6 1/2" (163mm)	6" (152mm)	24.3" (613mm)	12.90 (5.86kg)
782051 50026	DB630	6 1/2" (163mm)	6" (152mm)	30.8" (782mm)	19.49 (8.82kg)
782051 50027	DB640	6 1/2" (163mm)	6" (152mm)	41.4" (1052mm)	26.00 (11.79kg)
782051 50028	DB648	6 1/2" (163mm)	6" (152mm)	52.0" (1321mm)	32.56 (14.78kg)


4 CONTRACTOR'S OPTION: B-LINE DURA BLOK ROOFTOP SUPPORT SYSTEM

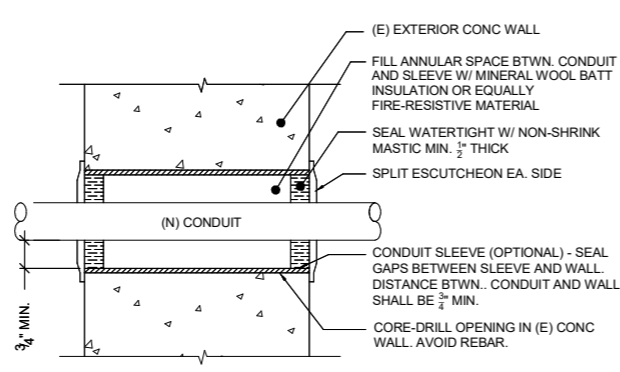

5 (N) CONDUIT THRU (E) EXT. CONC WALL

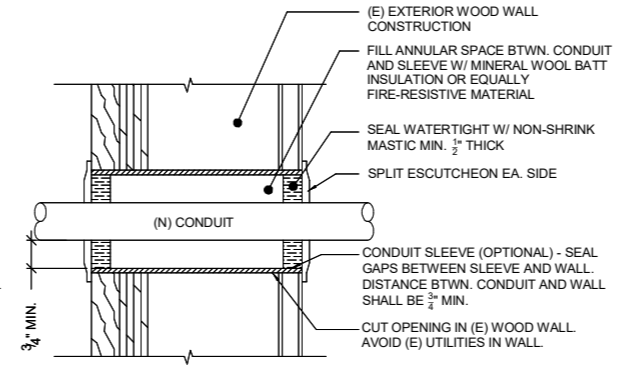

6 (N) CONDUIT THRU (E) EXT. WOOD WALL

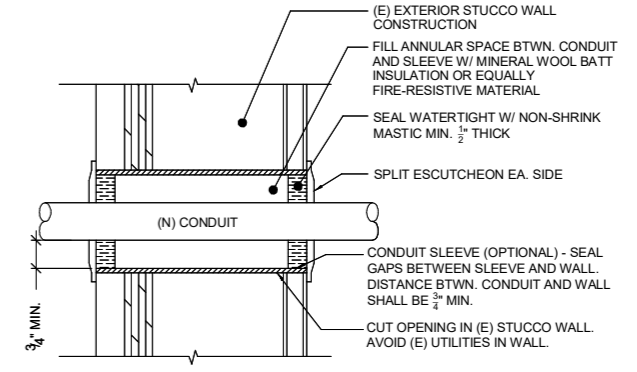

7 (N) CONDUIT THRU (E) EXT. STUCCO WALL

REVIEWED
FOR CODE COMPLIANCE
January 5, 2024
TRB AND ASSOCIATES

SEAL

PROJECT TITLE

City of Los Altos
Los Altos CC EOC

97 Hillview Ave.
Los Altos, CA 94022

ISSUE TITLE

PERMIT SET

ISSUE DATE AUG 03, 2023

NOLL & TAM JOB NUMBER 22203

REVISIONS	DATE	DESCRIPTION

SHEET TITLE

DETAILS -
NON-PENETRATION
ROOF MOUNT


SHEET NUMBER

TA9-1

COMMUNICATIONS SYSTEMS GENERAL NOTES

- REFER TO SPECIFICATIONS FOR COMPLETE REQUIREMENTS.
- PROVIDE CONDUIT, BOXES AND FITTINGS SHOWN ON COMMUNICATIONS SYSTEMS (TN) SYSTEM DRAWINGS UNDER THE WORK OF SECTION 27 05 33 COMMUNICATIONS RACEWAYS, BOXES AND FITTINGS. UNLESS OTHERWISE INDICATED, PROVIDE 1 INCH TRADE SIZE MINIMUM. PROVIDE RACEWAY SIZE AS REQUIRED FOR A MAXIMUM OF 30 PERCENT WIRE FILL.
- PROVIDE FIRESTOPPING UNDER THE WORK OF SECTION 27 05 33 COMMUNICATIONS RACEWAYS, BOXES AND FITTINGS.
- LOCATIONS SHOWN ON THE ARCHITECTURAL DRAWINGS TAKE PRECEDENCE OVER LOCATIONS SHOWN ON THE COMMUNICATIONS SYSTEMS DRAWINGS.
- DEVICE QUANTITIES SHOWN ON FLOOR PLANS AND REFLECTED CEILING PLANS TAKE PRECEDENCE OVER DEVICE QUANTITIES SHOWN ON FUNCTIONAL DIAGRAMS.
- QUANTITIES SHOWN ON FUNCTIONAL DIAGRAMS TAKE PRECEDENCE OVER QUANTITIES SHOWN ON RACK ELEVATIONS.
- QUANTITIES SHOWN ON DEVICE SCHEDULES TAKE PRECEDENCE OVER QUANTITIES SHOWN ON FUNCTIONAL DIAGRAMS, FLOOR PLANS AND REFLECTED CEILING PLANS.
- LOCATIONS SHOWN ON LARGE SCALE DRAWINGS TAKE PRECEDENCE OVER LOCATIONS SHOWN ON SMALL SCALE DRAWINGS.

GENERAL SYMBOLS

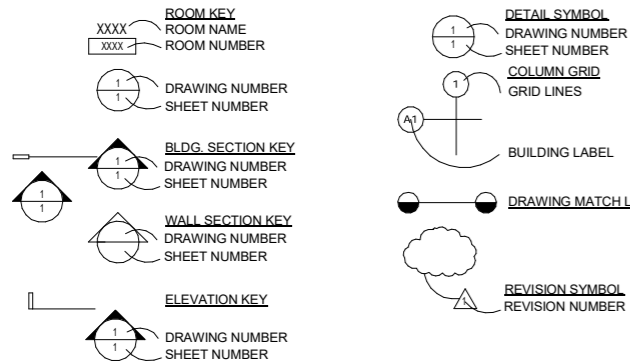

MATERIAL & EQUIPMENT LEGEND


1IDP	1" INNERDUCT, PLENUM RATED	UTP5e-4	UNSHIELDED TWISTED PAIR, CAT. 5e
2IDP	2" INNERDUCT, PLENUM RATED	UTP5e-4P	UNSHIELDED TWISTED PAIR, CAT. 5e PLENUM
C5ePP	CATEGORY 5e PATCH PANEL	UTP5e-4OP	UNSHIELDED TWISTED PAIR, CAT. 5e OUTSIDE PLANT
C6PP	CATEGORY 6 PATCH PANEL	UTP6-4	UNSHIELDED TWISTED PAIR, CAT. 6
FOH-P	FIBER OPTIC CABLE HYBRID, PLENUM RATED	UTP6-4P	UNSHIELDED TWISTED PAIR, CAT. 6 PLENUM
FOH-OPR	FIBER OPTIC CABLE HYBRID, OUTSIDE PLANT RISER RATED	UTP6-4OP	UNSHIELDED TWISTED PAIR, CAT. 6 OUTSIDE PLANT
FOM-OPR	FIBER OPTIC CABLE, MULTI MODE OUTSIDE PLANT RISER RATED	110TBXX	110 TERMINAL BLOCK, CAT. 5, XX-NO OF PAIRS
FOS-OPR	FIBER OPTIC CABLE, SINGLE MODE OUTSIDE PLANT RISER RATED	110PWTBXX	110 TERMINAL BLOCK, PRE-WIRED W/50 PIN CONNECTOR, XX- NO OF PAIRS
FPP	FIBER PATCH PANEL	PWC3PP	PRE-WIRED, 50 PIN CONNECTOR (REAR) & RJ45 (FRONT) CAT.3 PATCH PANEL
FSC	FIBER SPLICE CLOSURE	TB15	TERMINAL BLOCK WITH 15 AMP SWITCH BLADE.
FSP	FIBER SPLICE PANEL		
FTB	FIBER TERMINAL BOX		
IDF	INTERMEDIATE DISTRIBUTION FACILITY		
MDF	MAIN DISTRIBUTION FACILITY.		
MM	MULTI MODE OPTICAL FIBER		
MMP	MULTIMEDIA PLATE		
MPOE	MINIMUM POINT OF ENTRY		
OSP	OUTSIDE PLANT		
SM	SINGLE MODE OPTICAL FIBER		
T.C.	TELECOMMUNICATIONS CLOSET		
T-OPD	TELEPHONE CABLE, OUTSIDE PLANT, DUCTWAY		

SYMBOL SCHEDULE

SYMBOL	DEVICE	FUNCTION OR SERVICE	LOCATION	WORK OF	ROUGH-IN	RACEWAY	ELEVATION	CABLE FILL & HOMERUN DESTINATION, U.O.N.	FINISH	WEIGHT, LB	DETAIL SHEET(S)
[—]	WALL SLEEVE/CONDUIT	PATHWAY	INDICATED	27 05 33	N/A	R11					
[J]	J-BOX WITH BLANK FACE PLATE	COMMUNICATIONS PATHWAY	INDICATED	27 05 33	4S BOX, 2-1/8" DEEP MIN., U.O.N. AT CMJ WALLS, PROVIDE 3-1/2" DEEP 2 GANG MASONRY BOX.	R4	INDICATED		STEEL	2	
[M]	MULTIMEDIA DEVICE PLATE, DN1	COMMUNICATIONS	INDICATED AND/OR SCHEDULED	27 05 33, 27 15 00	FLUSH 2 GAND OLD WORK BOX, 2-7/8" DEEP MIN., W/ 1 GANG RING, U.O.N.	R7	+18" AFF TO CL., U.O.N.	AS SCHEDULED	WHITE OR IVORY - MATCH ADJ. ELECTRICAL U.O.N.		
[W]	FLUSH IN WALL 12" WIDE X 16.75" HIGH BY 4" DEEP MIN PULL BOX WITH LOCKING COVER WITH INTEGRAL CABLE EXIT DOOR	RADIO SYSTEMS	INDICATED	27 05 33	N/A	AS DETAILED	BOTTOM EDGE AT +18" AFF, U.O.N.	PER FUNCTIONAL	PAINTED TO MATCH SURROUNDINGS.	LESS THAN 10 LB.	TN9.1

NOTE NO.	DEVICE NOTES	LOCATION	WORK OF	ROUGH-IN	RACEWAY	ELEVATION	CABLE FILL & HOMERUN DESTINATION, U.O.N.	FINISH	WEIGHT, LB	DETAIL SHEET(S)
DN1	SUBSCRIPT INDICATES QUANTITY OF CATEGORY AND COAX CABLES PROVIDED AT WAO AND DESTINATION. (DATA/VOICE CABLING IS CAT6 TO STANDARD WAO'S, CAT6A TO WIFI WAO'S, (BROADBAND VIDEO CABLING IS RG-6. EXAMPLES: D2 REPRESENTS 2 C6 CABLES AND JACKS TERMINATED AT THE INDICATED WAO AND SERVING TR. B1 IS 1 RG-6 TERMINATED AT THE INDICATED WAO AND SERVING TR.	LR16	27 05 33	4S BOX WITH BLANK COVER PLATE INSTALLED ADJACENT TO TRACK AND WITHIN 6" OF FLOOR. PROVIDE ONE DEVICE AT OPPOSITE SIDES OF EACH OPENING. INSTALL DEVICE TO TRACK PER MANUFACTURER'S INSTRUCTIONS.	R1	NOT USED				
		LR17	27 05 33	NOT USED	R2	NOT USED				
		LR18	27 05 33	4S BOX W/ BLANK COVER PLATE W/ GROMMET OPENING MTD WITHIN 6" OF LATCH AT UNDERSIDE OF ROOF. EXTEND HS TO HATCH FRAME AND INSTALL IN ACCORDANCE WITH MANUFACTURER INSTRUCTIONS.	R3	NOT USED				
		LR19	27 05 33	4S BOX, 2-1/8" DEEP MIN., W/ 1 GANG RING WITH LOCKING HINGED COVER PLATE (FSR WB-MR2G OR EQUAL).	R4	AS DETAILED AND/OR SCHEDULED		R11		
		LR10	27 05 33	OUTLETS SHALL BE PLACED SO THEY WILL NOT BE COVERED BY AN UNDER-COUNTER CABINET.	R5	3/4" C. H.R. TO ACCESSIBLE CEILING OR FLOOR, OR TO SERVING BDF, IDF OR EQUIPMENT ROOM, U.O.N.				
WO1	WORK OF NOTES LOCATION & ROUGH-IN NOTES	LR18	27 05 33	1" C. H.R. TO ACCESSIBLE CEILING OR FLOOR, OR TO SERVING BDF, IDF OR EQUIPMENT ROOM, U.O.N.	R6	1-1/4" C. H.R. TO ACCESSIBLE CEILING OR FLOOR, OR TO SERVING BDF, IDF OR EQUIPMENT ROOM, U.O.N.				
LR11	FLUSH 4S BOX IN WALL ADJ. TO INDICATED LOCATION. FISH CABLE THROUGH FURNITURE TO CITY SELECTED MOUNTING LOCATION.	LR10	27 05 33	LIQUIDTITE TO SERVING EFM, EFM-R OR FMP, AS APPLIES. SIZE TO MATCH FILL AT 40% FILL MAXIMUM.	R7	AT ACCESSIBLE CEILING, EXTEND TO BASKET TRAY AT CENTER OF ROOM. WHERE MOUNTED IN GYP CEILING, EXTEND 3/4" C. TO BASKET TRAY AT CENTER OF ROOM		R12		
LR12	NOT USED	LR11	27 05 33	PROVIDE BACKING AND SUPPORT FOR 5 POUND DEVICE.	R8	NOT USED				
LR13	4S BOX W/ 1 GANG RING BLANK COVER PLATE	LR12	27 05 33	NOT USED	R9	NOT USED				
LR14	ABOVE DESK IN ELECTRIFIED BELT OR AT BASE IN ELECTRIFIED BASE PER CITY'S REP.	LR13	27 05 33	PROVIDE BACKING IN WALL SUITABLE TO SUPPORT A 20 POUND DEVICE WITH A LOAD CENTROID 18 INCHES FROM THE FACE OF THE WALL.	R10	2 1-1/4" C TO 4 GANG COMPARTMENT, 1 - 1" TO 1 GANG COMPARTMENT, STUBBED TO ACCESSIBLE CEILING OR FLOOR EXTEND TO TR ROOM USING BASKET TRAY. SEE ELECTRICAL DRAWINGS FOR ELECTRICAL ROUGH-IN.				
LR15	AT SUSPENDED CLG CONDITIONS, SM 4S BOX, BLNK COVER & FLEX C TO DEVICE. ELSEWHERE MOUNTED IN CEILING ADJ TO DEVICE OR MNT DEVICE TO COVER PLATE.	LR14	27 05 33	PROVIDE BACKING IN WALL SUITABLE TO SUPPORT A 200 POUND DEVICE WITH A LOAD CENTROID 8 INCHES FROM THE FACE OF THE WALL.						
		LR15	27 05 33	AS DETAILED AND/OR SCHEDULED ON THE ARCHITECTURAL DRAWINGS.						

LEGEND

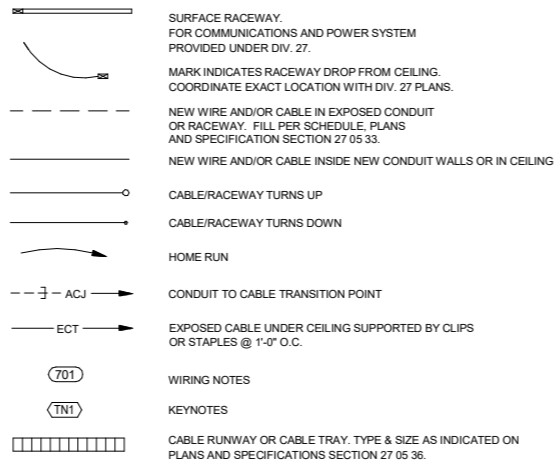

JUNCTION BOX SCHEDULE

SYMBOL	H (INCHES)	W (INCHES)	(INCHES)
J1	6	6	4
J2	8	8	4
J3	12	12	4
J4	12	12	6
J5	12	12	8
J6	16	12	6
J7	18	18	8
J8	20	16	6
J9	20	16	8
J10	20	20	6
J11	20	20	8
J12	24	20	6
J13	24	20	8
J14	24	24	8
J15	30	24	8
J16	30	30	8
J17	36	30	8
J18	36	36	8

SUFFIX

NONE	- NEMA 1	C	- NEMA 4
A	- NEMA 12	D	- NEMA 4X
B	- NEMA 3R		

EXAMPLE: J16C= 30"H X 30"W X 8"D HINGED NEMA 4 JBOX.

NOTE 1

ALL JUNCTION BOXES TO BE HINGED TYPE, PROVIDED WITHOUT PRE-PUNCHED KNOCKOUTS. PENETRATIONS IN JUNCTION BOXES SHALL BE CUT OR PUNCHED AS REQUIRED FOR INSTALLATION. PAINT ALL INTERIOR BOXES TO MATCH WALL FINISH. COORDINATE FINISH WITH ARCH. PLANS.

ABBREVIATIONS

1SR-1	SINGLE CHAMBER SURFACE RACEWAY
3SR-25	THREE CHAMBER SURFACE RACEWAY
A.D.A.	AMERICANS WITH DISABILITIES ACT
ADF	AREA DISTRIBUTION FACILITY
A.F.C.	ABOVE FINISHED CEILING
A.F.F.	ABOVE FINISHED FLOOR
ALT	ALTERNATE
A.M.F.F.	ABOVE MEZZANINE FINISHED FLOOR
BDF	BUILDING DISTRIBUTION FACILITY
B.F.C.	BELOW FINISHED CEILING
BLDG.	BUILDING
B.O.H.	BACK OF HOUSE
C.	CONDUIT
CAT.	CATEGORY
CBC	CALIFORNIA BUILDING CODE
CEC	CALIFORNIA ELECTRICAL CODE
COMM.	COMMUNICATIONS
C.L.	CENTERLINE
C.O.	CONDUIT ONLY
CONT.	CONTINUATION
CS	COMMUNICATIONS SYSTEM
(D)	DEMOLISH EXISTING
DED	DEDUCTIVE
ø, DIA.	DIAMETER
DIV	DIVISION
(E)	EXISTING
EA	EACH
EIA	ELECTRONIC INDUSTRIES ASSOCIATION
ELEV.	ELEVATION
E.O.L.	END OF LINE
EQPT.	EQUIPMENT
FIN	FINISHED
FUT	FUTURE
H.R.	HOME RUN
HT.	HEIGHT
J. JBOX	JUNCTION BOX
LAN	LOCAL AREA NETWORK
MATV	MASTER ANTENNA TELEVISION
MAX.	MAXIMUM
MIN.	MINIMUM
MOD.	MODULAR
MON.	MONUMENT
(N)	NEW
NEC	NATIONAL ELECTRICAL CODE
N.I.C.	NOT IN CONTRACT
NTS	NOT TO SCALE
O.C.	ON CENTER
O.D.	OUTSIDE DIAMETER
O.F.E.	OWNER FURNISHED EQUIPMENT
OPP.	OPPOSITE
PNL.	PANEL
PROJ.	PROJECT
P.S.R.H	PROJECT STANDARD RECEPTACLE HEIGHT +18" AFF. U.O.N.
P.S.S.H.	PROJECT STANDARD SWITCH HEIGHT +48" AFF TO U.O.N.
RE:	REFER TO
REF.	REFERENCE
SIM.	SIMILAR
SM	SINGLE MODE OPTICAL FIBER
SN	SHEET NOTE
SP	SHIELDED PAIR - SEE SPECIFICATIONS
SPEC	SPECIFICATION
S.R.	SURFACE RACEWAY
STD	STANDARD
STP	SHIELDED TWISTED PAIR
T.C.	TELECOMMUNICATIONS CLOSET
TEL	TELEPHONE
TELCOM	TELECOMMUNICATIONS
TIA	TELECOMMUNICATIONS INDUSTRY ASSOCIATION
T-OPD	TELEPHONE CABLE, OUTSIDE PLANT, DUCTWAY
TP	TWISTED PAIR
TYP.	TYPICAL
U.O.N.	UNLESS OTHERWISE NOTED
W/	WITH
WP	WEATHERPROOF

CITY OF LOS ALTOS
JOB COPY
 REVIEWED FOR CODE COMPLIANCE

APPROVALS

NOLL & TAM
 ARCHITECTS

729 Heinz Avenue
 Berkeley, CA 94710
 tel 510.542.2200
 fax 510.542.2201



SEAL

PROJECT TITLE

City of Los Altos
 Los Altos CC EOC

97 Hillview Ave.
 Los Altos, CA 94022

ISSUE TITLE

PERMIT SET

ISSUE DATE

AUG 03, 2023

NOLL & TAM JOB NUMBER

22203

REVISIONS

DATE	DESCRIPTION

SHEET TITLE

GENERAL NOTES,
 LEGEND,
 ABBREVIATIONS,
 JBOX SCHEDULE &
 SYMBOL SCHEDULE

SHEET NUMBER

TN0-1



CITY OF LOS ALTOS
JOB COPY
REVIEWED FOR CODE COMPLIANCE

SHEET NOTE:
1. PROTECT IN PLACE THE (E) HORIZONTAL AND BACKBONE CABLING WHILE PULLING IN (N) HORIZONTAL CABLING.

KEYNOTES	
TKN2001	PROVIDE FLUSH IN WALL 12" WIDE X 16.75" HIGH BY 4" DEEP MIN PULL BOX WITH LOCKING COVER WITH INTEGRAL CABLE EXIT DOOR EQUIVALENT TO FSR WB-X3-PLT WITH WB-X3-CVR-WHT COVER. BOTTOM AT +118' AFF. CENTER ON LOCATION PLANNED FOR LAARES RADIO ACTIVITY.
TKN2002	STUB 3-2" C. FROM TOP OF BOX TO ACCESSIBLE CEILING SPACE ABOVE ROOM 115B.
TKN2005	(E) 2.4" C. ROUTES ABOVE MOISTURE BARRIER AND STUBS UP TO CLG VOID ABOVE COPY ROOM.
TKN2009	(E) (4) 2.5" C. ROUTES ABOVE MOISTURE BARRIER AND STUBS UP TO ACCESSIBLE SOFFIT.
TKN2010	(E) (2) 2.5" C. ROUTES ABOVE MOISTURE BARRIER AND STUBS UP TO ACCESSIBLE SOFFIT.
TKN2011	WORK OF PROJECT INCREASES THE (E) UTP6-4 CABLE AND CAT6 JACK COUNT AT THIS WAO FROM 4 TO 6.

REVIEWED
FOR CODE COMPLIANCE
January 5, 2024
TRB AND ASSOCIATES

APPROVALS

NOLL & TAM
ARCHITECTS

729 Heinz Avenue
Berkeley, CA 94710
tel 510.542.2200
fax 510.542.2201



SEAL

PROJECT TITLE

**City of Los Altos
Los Altos CC EOC**

97 Hillview Ave.
Los Altos, CA 94022

ISSUE TITLE

PERMIT SET

ISSUE DATE

AUG 03, 2023

NOLL & TAM JOB NUMBER

22203

REVISIONS

NO.	DATE	DESCRIPTION


SHEET TITLE

**FLOOR PLAN -
COMMUNICATIONS**

SHEET NUMBER

TN2-1

8/22/2023 3:37:15 PM AutoCAD Doc: Los Altos EOC\EOC-AVJT_Central_2023.rvt

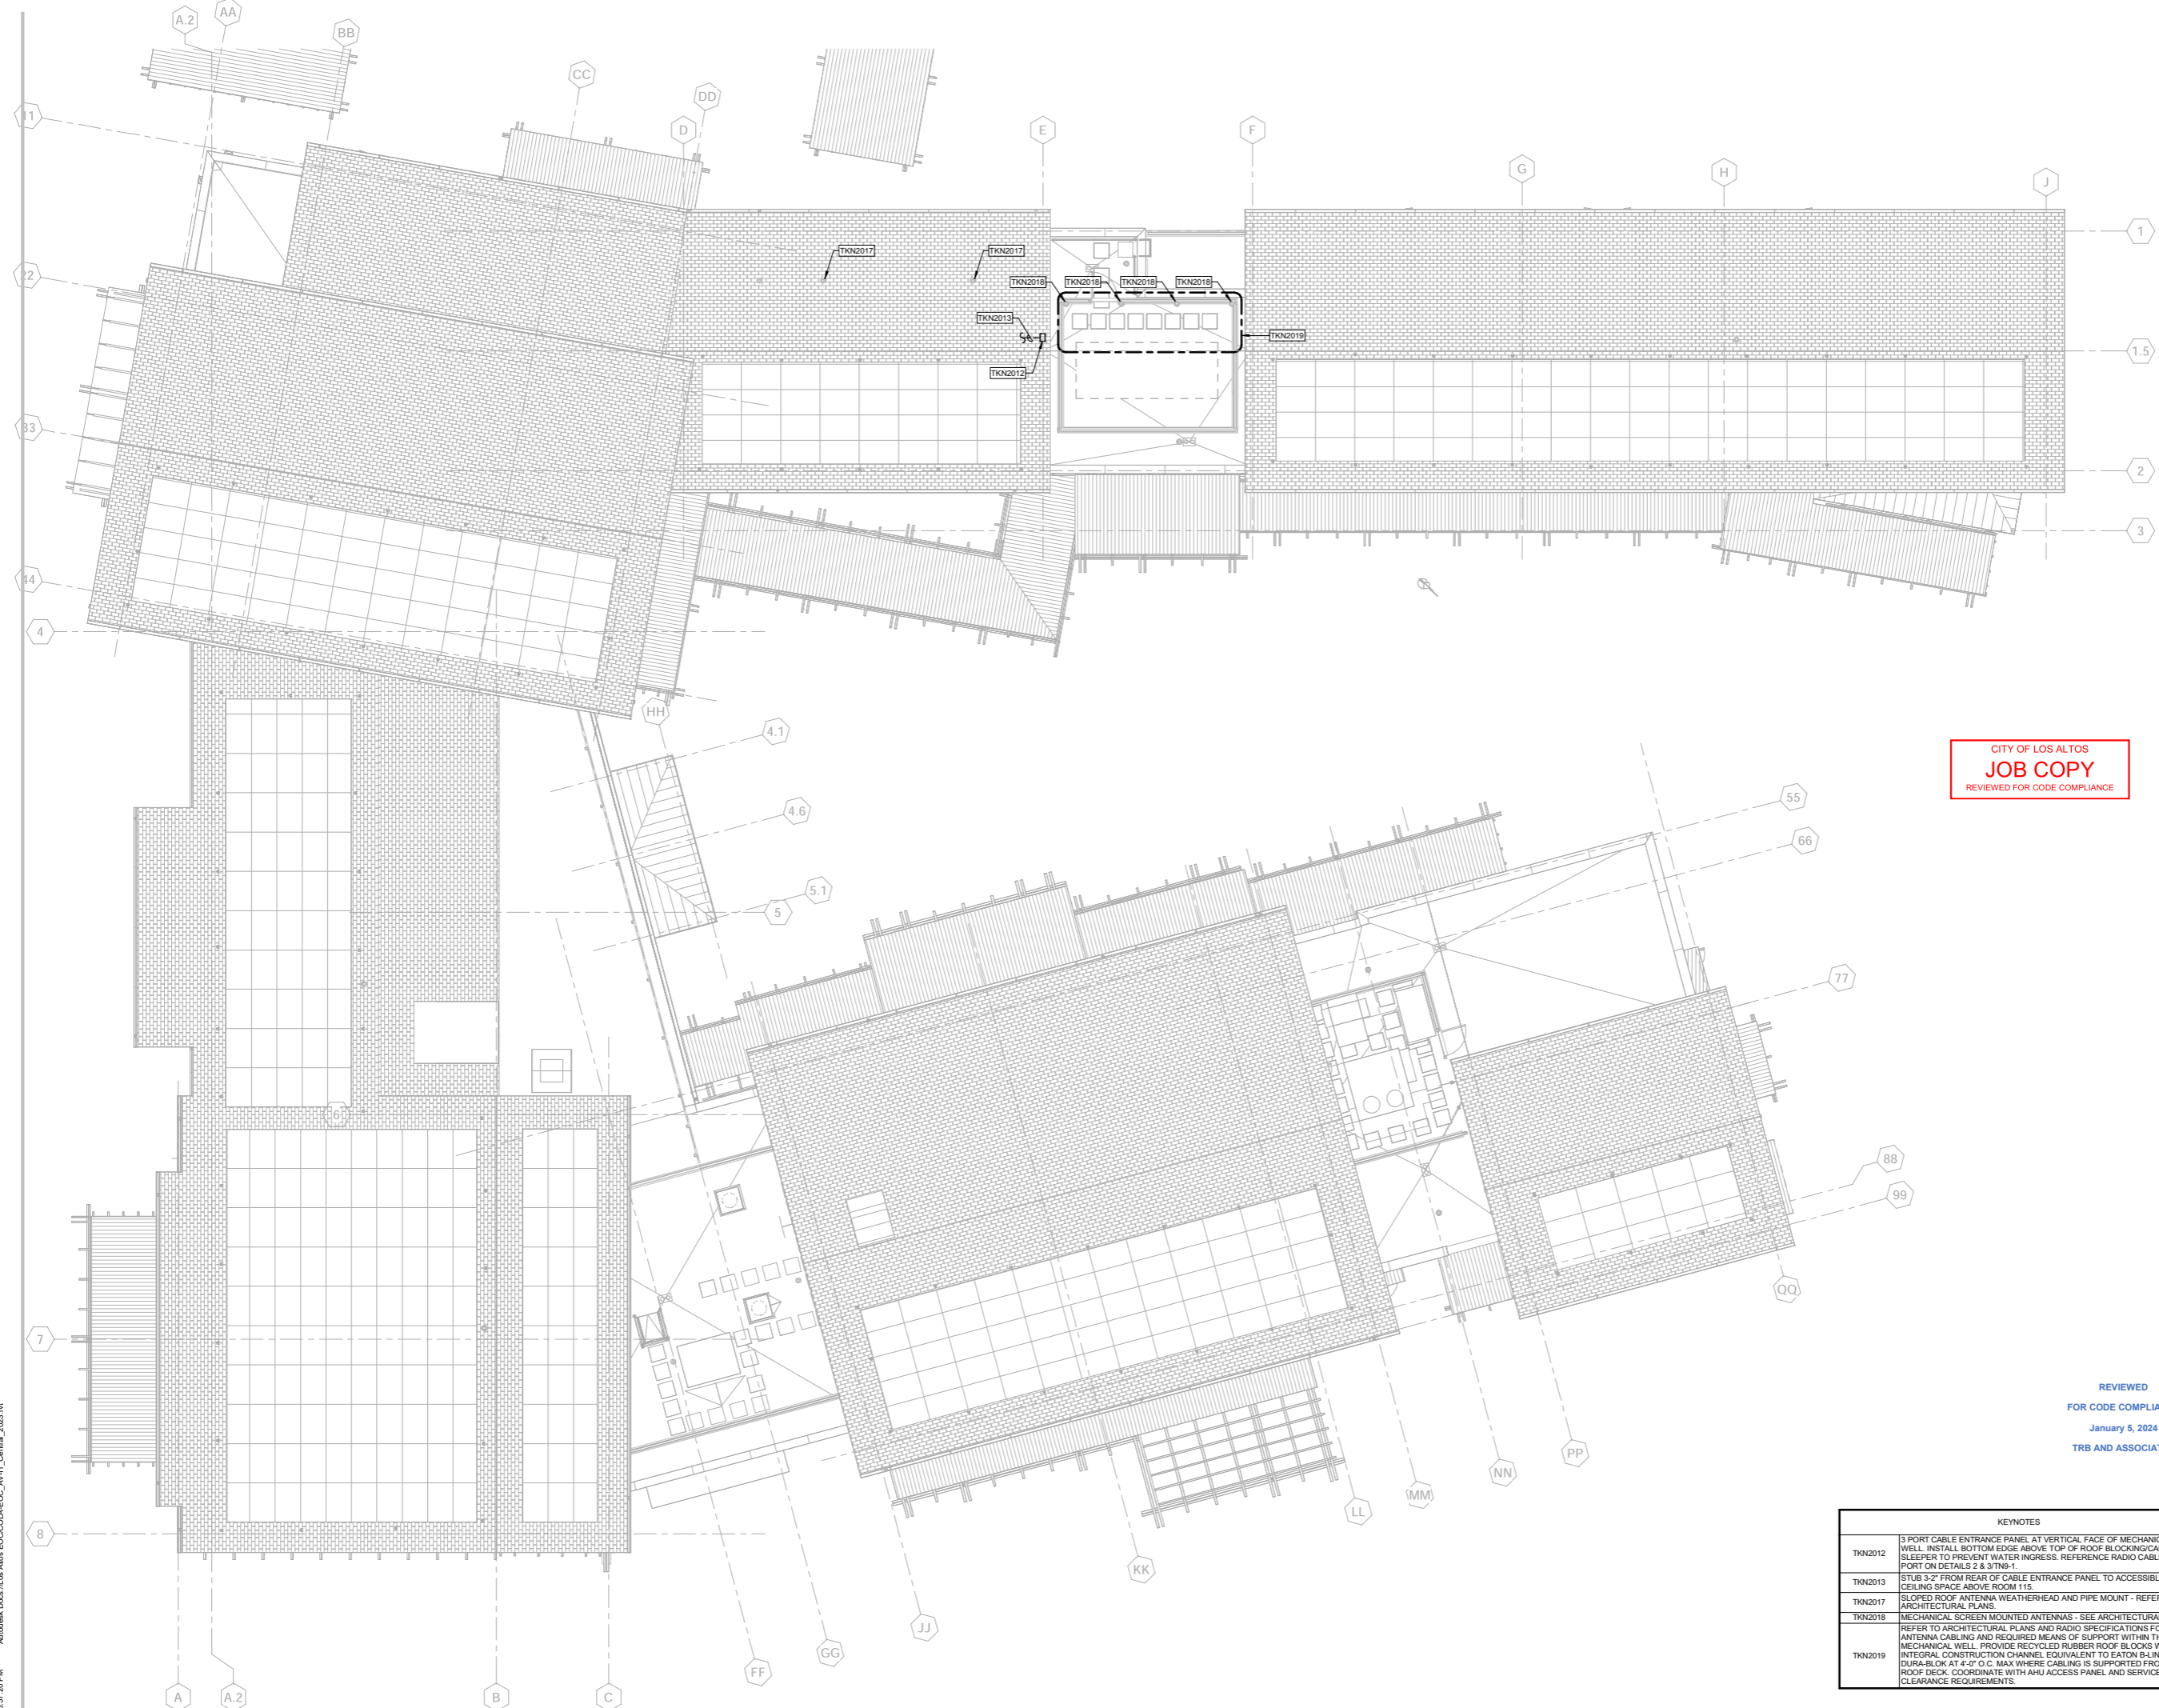

CITY OF LOS ALTOS
JOB COPY
 REVIEWED FOR CODE COMPLIANCE

REVIEWED
 FOR CODE COMPLIANCE
 January 5, 2024
 TRB AND ASSOCIATES

KEYNOTES	
TKN2012	3 PORT CABLE ENTRANCE PANEL AT VERTICAL FACE OF MECHANICAL WELL. INSTALL BOTTOM EDGE ABOVE TOP OF ROOF BLOCKING/CABLE SLEEPER TO PREVENT WATER INGRESS. REFERENCE RADIO CABLE ENTRY PORT ON DETAILS 2 & 3/TN8-1.
TKN2013	STUB 3'-2" FROM REAR OF CABLE ENTRANCE PANEL TO ACCESSIBLE CEILING SPACE ABOVE ROOM 115.
TKN2017	SLOPED ROOF ANTENNA WEATHERHEAD AND PIPE MOUNT - REFER TO ARCHITECTURAL PLANS.
TKN2018	MECHANICAL SCREEN MOUNTED ANTENNAS - SEE ARCHITECTURAL PLANS. REFER TO ARCHITECTURAL PLANS AND RADIO SPECIFICATIONS FOR ANTENNA CABLING AND REQUIRED MEANS OF SUPPORT WITHIN THE MECHANICAL WELL. PROVIDE RECYCLED RUBBER ROOF BLOCKS WITH INTEGRAL CONSTRUCTION CHANNEL EQUIVALENT TO EATON 8-LINE DURA-BLOK AT 4'-0" O.C. MAX WHERE CABLING IS SUPPORTED FROM (E) ROOF DECK. COORDINATE WITH AHU ACCESS PANEL AND SERVICE CLEARANCE REQUIREMENTS.
TKN2019	

8/2/2023 3:37:20 PM Autocad: Docs:\Los Altos EOC\CLLA-EOC_AvJT_Central_2023.rvt


1 ROOF PLAN - COMMUNICATIONS
 1/8" = 1'-0"

APPROVALS

NOLL & TAM

ARCHITECTS

729 Heinz Avenue
 Berkeley, CA 94710
 tel 510.542.2200
 fax 510.542.2201



SEAL

PROJECT TITLE

**City of Los Altos
Los Altos CC EOC**

97 Hillview Ave.
Los Altos, CA 94022

ISSUE TITLE

PERMIT SET

ISSUE DATE AUG 03, 2023

NOLL & TAM JOB NUMBER 22203

REVISIONS


REVISIONS	DATE	DESCRIPTION

SHEET TITLE


**ROOF PLAN -
COMMUNICATIONS**

SHEET NUMBER


TN2-2

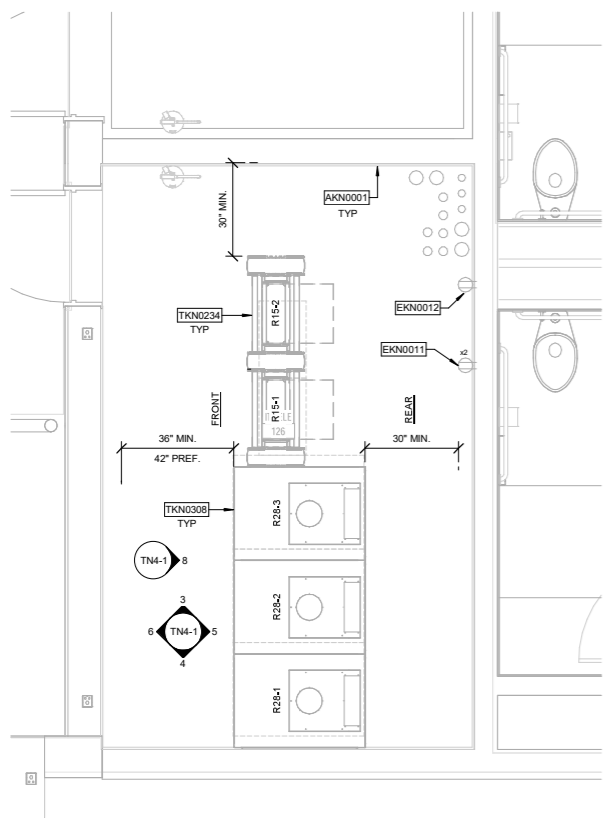


1 MDF/TR 1.0 - ENLARGED PLAN
1/2" = 1'-0"

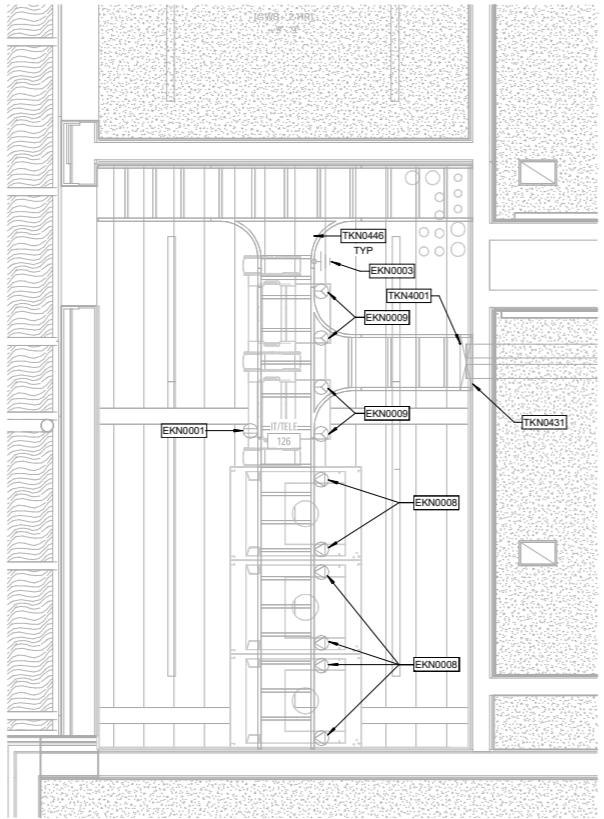


2 MDF/TR 1.0 - ENLARGED RCP
1/2" = 1'-0"

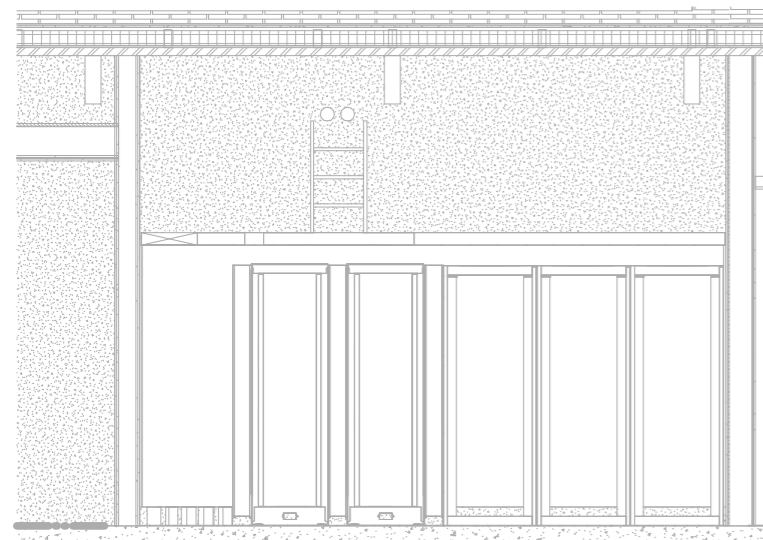


5 MDF/TR 1.0 - EAST ELEVATION
1/2" = 1'-0"

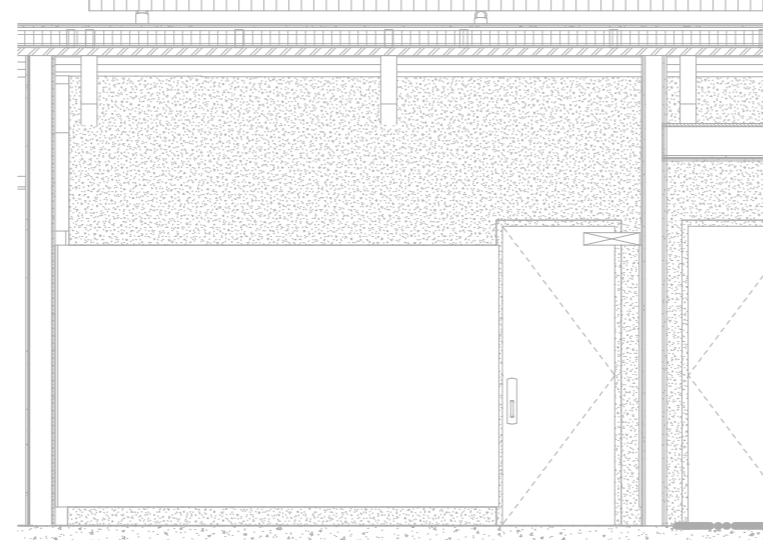


6 MDF/TR 1.0 - WEST ELEVATION
1/2" = 1'-0"

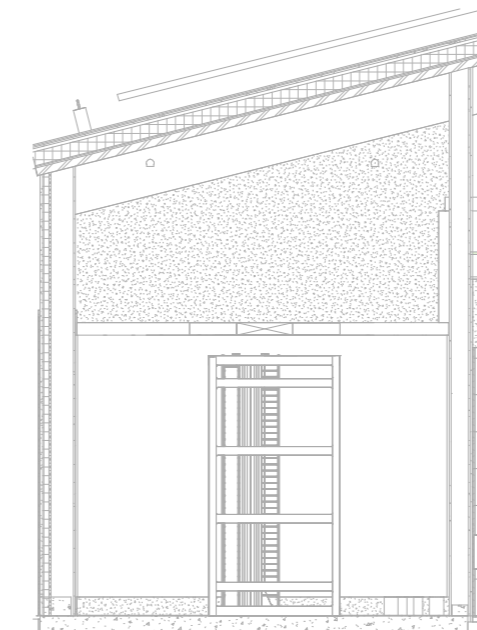


3 MDF/TR 1.0 - NORTH ELEVATION
1/2" = 1'-0"

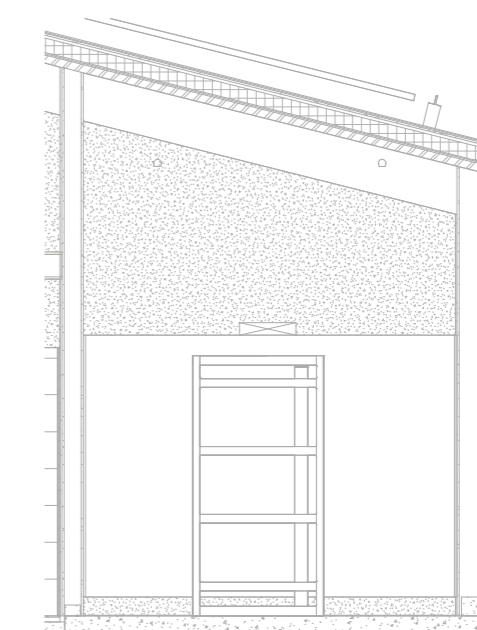

4 MDF/TR 1.0 - SOUTH ELEVATION
1/2" = 1'-0"

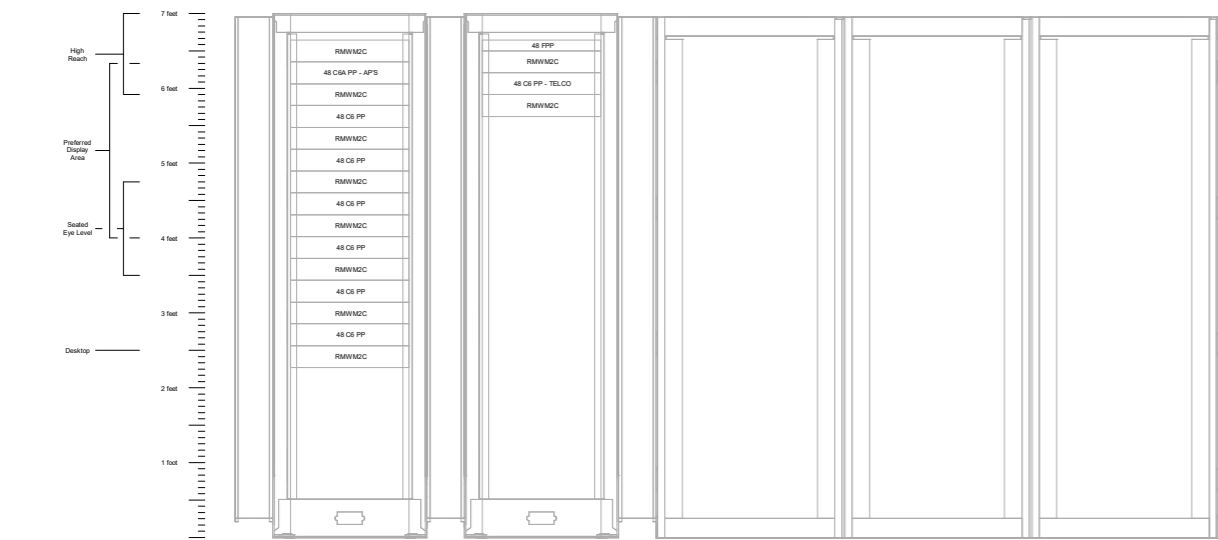

7 MDF/TR 1.0 - RACK ELEVATION
1" = 1'-0"

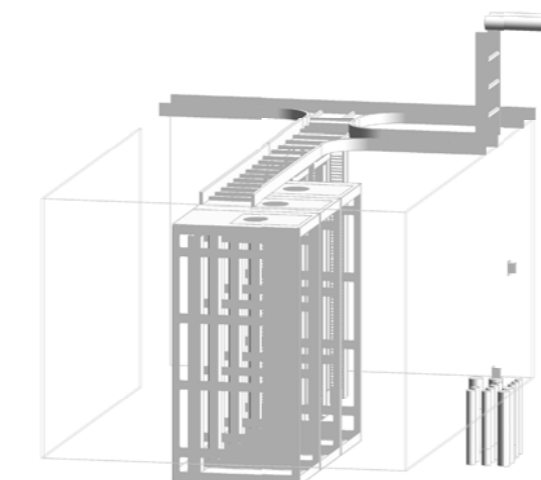

7 MDF/TR 1.0 - 3D VIEW

SHEET NOTE:
1. STRUCTURED CABLING AND RELATED INFRASTRUCTURE SHOWN THIS SHEET IS (E), U.O.N. PROTECT IN PLACE.

KEYNOTES	
EKN0001	(E) 3/4" FIRE TREATED PLY FROM 6" AFF TO UNDERSIDE OF CEILING.
EKN0001	(E) DUPLEX 120V CONVENIENCE RECEPTACLE MOUNTED TO FRONT FACE OF CABLETRAY.
EKN0003	(E) GROUND RACK AND CABLE TRAY PER NEC ARTICLE 250.
EKN0008	(E) TWO L6-30R, EA CONNECTED TO SEPARATE 30A CKTS MOUNTED TO SIDE OF CABLE TRAY AT EITHER SIDE OF EACH CABINET.
EKN0009	(E) TWO L5-20R, EA CONNECTED TO SEPARATE 20A CKTS MOUNTED TO SIDE OF CABLE TRAY AT EITHER SIDE OF EACH RELAY RACK.
EKN0011	2-20A CKTS HW IN SURF MTD BACKBOX AT +18" AFF FOR ACCESS CONTROL PANEL(S).
EKN0012	(E) 120V DUPLEX RECEPTACLE MOUNTED TO BACKBOARD FOR BROADBAND AMPLIFIER/ELECTRONICS.
TKN0234	(E) RACK TYPE R15, 2 POST SEISMIC RELAY RACK W/ VERTICAL WIRE MANAGERS.
TKN0308	(E) RACK TYPE R28, SERVER/AV/NETWORK EQUIPMENT CABINET WITH VERTICAL WIRE MANAGER, 42" DEEP.
TKN0431	(E) 18 CR RUN VERTICALLY, SUPPORTED FROM WALL.
TKN0446	(E) 18-4 CT SUPPORTED FROM CEILING AT 7'-6" AFF.
TKN4001	(E) 18 CR PROVIDES SUPPORT FOR CABLING TRANSITION FROM HIGH PATHWAY ENTRIES.

CITY OF LOS ALTOS
JOB COPY
REVIEWED FOR CODE COMPLIANCE

APPROVALS

NOLL & TAM
ARCHITECTS

729 Heinz Avenue
Berkeley, CA 94710
tel 510.542.2200
fax 510.542.2201

SEAL

PROJECT TITLE

City of Los Altos
Los Altos CC EOC

97 Hillview Ave.
Los Altos, CA 94022

ISSUE TITLE

PERMIT SET

ISSUE DATE: AUG 03, 2023
NOLL & TAM JOB NUMBER: 22203

REVISIONS	DATE	DESCRIPTION

SHEET TITLE

MDF/TR 1.0 - ENLARGED PLAN, RCP & ELEVATIONS

SHEET NUMBER

TN4-1

REVIEWED
FOR CODE COMPLIANCE
January 5, 2024
TRB AND ASSOCIATES



CITY OF LOS ALTOS
JOB COPY
 REVIEWED FOR CODE COMPLIANCE

REVIEWED
 FOR CODE COMPLIANCE
 January 5, 2024
 TRB AND ASSOCIATES

KEYNOTES	
TKN1010	(E) (2) 4" C.
TKN1011	EXTEND 1" C FROM GENERATOR ACCESS CONTROL PATHWAY (SEE ELECTRICAL PLANS) TO ACCESSIBLE CEILING VOID.
TKN2013	STUB 3/2" FROM REAR OF CABLE ENTRANCE PANEL TO ACCESSIBLE CEILING SPACE ABOVE ROOM 115.
TKN2014	PROVIDE CABLE HOOK MEANS OF SUPPORT FOR LAARES RADIO CABLING BETWEEN CONDUIT SLEEVES AT 4" MAX O.C. ABOVE ACCESSIBLE CEILING. ROUTE TO MAXIMIZE FUTURE ACCESSIBILITY FROM BELOW BY FOLLOWING WALKING PATHS. ROUTE AROUND EXISTING ABOVE CEILING OBSTRUCTIONS.
TKN2015	PROVIDE 1.5" C MIN SLEEVES THROUGH ABOVE CEILING PARTITIONS. PROVIDE STC RATED ACOUSTICAL SEAL EQUIVALENT TO STI FIRESTOP #4NEZ.
TKN2016	STUB-LIPS TO SLOPED ROOF ANTENNA WEATHERHEAD - REFER TO ARCHITECTURAL PLANS.

APPROVALS

NOLL
& TAM

ARCHITECTS

729 Heinz Avenue
 Berkeley, CA 94710
 tel 510.542.2200
 fax 510.542.2201



SEAL

PROJECT TITLE

City of Los Altos
 Los Altos CC EOC

97 Hillview Ave.
 Los Altos, CA 94022

ISSUE TITLE
PERMIT SET

ISSUE DATE
 AUG 03, 2023

NOLL & TAM JOB NUMBER
 22203

REVISIONS

NO.	DATE	DESCRIPTION


SHEET TITLE
RCP - COMMUNICATIONS

SHEET NUMBER

TN6-1

8/22/2023 3:37:40 PM Autodesk Docs://Los Altos EOC/EOC-Arch/IT_Central_2023.rvt

RCP - COMMUNICATIONS
 1/8" = 1'-0"

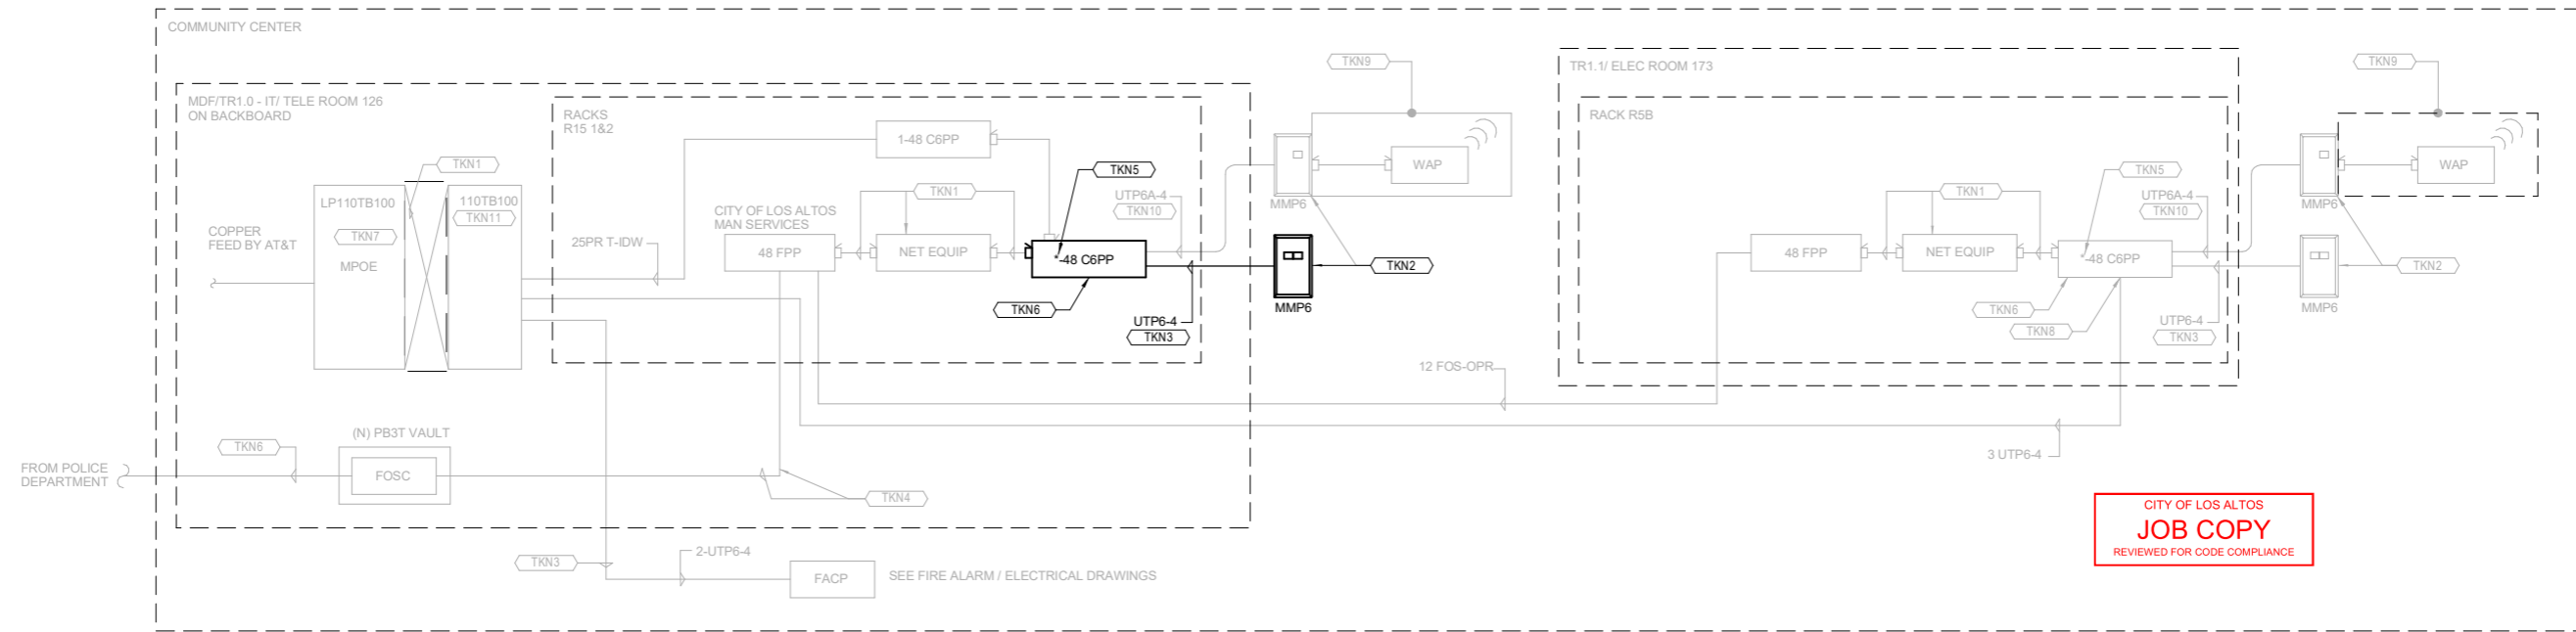

1 STRUCTURED CABLING SINGLE LINE DIAGRAM
NTS

KEYNOTES

- TKN TELECOMMUNICATIONS SYSTEMS: COMPLY WITH DIVISION 27.
- TKN1 NETWORK ELECTRONICS, PATCH CORDS, PATCHING, AND CROSS-CONNECTIONS ARE CITY FURNISHED AND INSTALLED.
- TKN2 PROVIDE WAO QUANTITY AS INDICATED ON THE PLANS AND SCHEDULES. REFER TO TY PLANS FOR THE LOCATIONS OF IP CAMERAS INSTALLED UNDER THE WORK OF DIV. 28 SERVED WITH STRUCTURED CABLING INSTALLED UNDER THE WORK OF DIVISION 27.
- TKN3 CONTRACT DOCUMENTS DIAGRAMMATICALLY SHOW THAT THE BASIS OF DESIGN PATHWAYS EXTEND BELOW SLAB. AT CONTRACTOR'S OPTION, PATHWAYS MAY BE RELOCATED TO EXTEND ENTIRELY ABOVE SLAB PROVIDED THAT THEY REMAIN FULLY CONCEALED FROM THE PUBLIC AND MAINTAIN NO MORE THAN 270 DEGREES OF BEND BETWEEN PULL POINTS. CERTAIN STRUCTURED CABLING MANUFACTURER'S CONSTRUE PATHWAY BELOW SLAB AND ABOVE THE MOISTURE BARRIER AS A WET LOCATION AND WILL NOT WARRANTY THEIR CABLING FOR USE IN SUCH PATHWAY UNLESS A WATERBLOCKING CABLING CONSTRUCTION IS UTILIZED. WHERE CONTRACTOR SELECTS CABLING FROM A MANUFACTURER HAVING THIS POLICY, THE CONTRACTOR SHALL SUPPLY UTP4-60P AND UTP4-60AP CABLING FOR THE AFFECTED CONDITIONS AT NO ADDITIONAL COST TO THE CITY, INCLUDING FOR INCREASED PATHWAY SIZE WHERE REQUIRED TO ACCOMMODATE THE INCREASED CABLE DIAMETER.
- TKN4 REFER TO KEYNOTES TKN1003 AND TKN1004 ON SHEET TN1.0. WORK OF THIS PROJECT PULLS BACK AND PROTECTS (E) CITY OF LOS ALTOS MAN FIBER IN (N) VAULT AS INDICATED. PROVIDE FOSC FIBER SPLICE CASE TO PROTECT FIBER FROM ELEMENTS DURING CONSTRUCTION. FOLLOWING COMPLETION OF (N) TR IN (N) COMMUNITY CENTER, WORK OF THE PROJECT EXTENDS (E) FIBER TO (N) COMMUNITY CENTER. TERMINATES AND TESTS EACH STRAND. IN THE EVENT INSTALLED CABLING CAN NOT BE EXTENDED TO LOCATION OF (N) TR, CONTRACTOR TO SPLICE (N) 12 FOS-OP TO (E) CABLE AT (N) VAULT AND EXTEND (N) CABLING TO (N) TR.
- TKN5 REFER TO THE QUANTITY OF 24 PORT AND 48 PORT PATCH PANELS INDICATED IN THE DEVICE SCHEDULE.
- TKN6 (E) CITY OF LOS ALTOS 12 STRAND SINGLE MODE OSP FIBER CONNECTING CITY PD MDF TO (E) MDF AT (E) COMMUNITY CENTER. REFER TO KEYNOTES TKN1003 AND TKN1004 ON SHEET TN1.0.
- TKN7 MPOE CABLE AND LIGHTNING PROTECTOR IS BY AT&T. COORDINATE PLACEMENT IN TR.
- TKN8 PROVIDE AT LEAST 2 PAIR (USOC INS 3.4.5.6) TERMINATED THROUGH FOR EACH JACK.
- TKN9 CITY TO FURNISH AND INSTALL THE WIRELESS ACCESS POINTS (WAPS).
- TKN10 PROVIDE UTP6A-4OP FOR WAO'S AT EXTERIOR ACCESS POINT LOCATIONS.
- TKN11 PROVIDE UNDER THE WORK OF THE PROJECT.

SEAL

PROJECT TITLE

**City of Los Altos
Los Altos CC EOC**

97 Hillview Ave.
Los Altos, CA 94022

ISSUE TITLE

PERMIT SET

ISSUE DATE **AUG 03, 2023**

NOLL & TAM JOB NUMBER **22203**


REVISIONS	DATE	DESCRIPTION
▲		

SHEET TITLE


**STRUCTURED
CABLING SINGLE LINE
DIAGRAM**

SHEET NUMBER

TN7-1

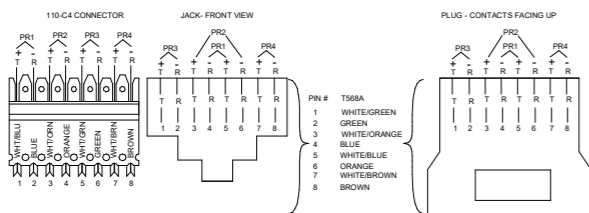

2 T568A WIRING
NTS

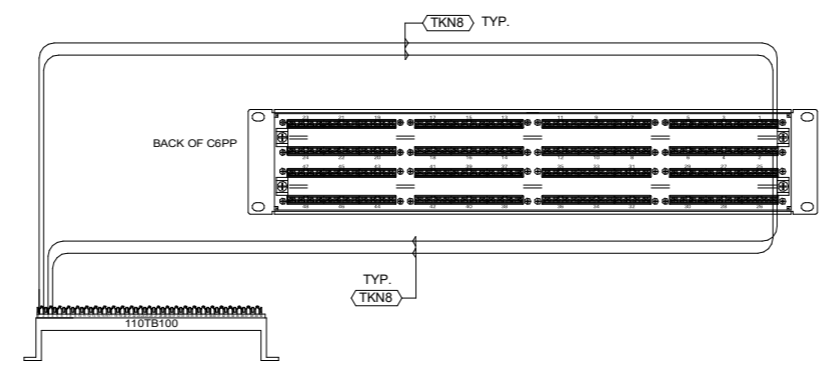


3 110TB100 TO C6PP CROSS-CONNECT
NTS

REVIEWED
FOR CODE COMPLIANCE
January 5, 2024
TRB AND ASSOCIATES

Plate Station No.	Room No.	Room Name	F" Type Connector	Cat. 6 Jack Count	Access Point Jack Cat. 6a Jack Count	TOTAL FILL	Cat6 CK #1 Labeling	Cat6 CK #2 Labeling	Cat6 CK #3 Labeling	Cat6 CK #4 Labeling	Cat6 CK #5 Labeling	Cat6 CK #6 Labeling	F" Connector CK Labeling	RG-6M FILL	Home Run Location	Notes
FLOOR PLAN																
100-AA	100	LOBBY	1	2		2	0001	0002					B-1	1 RG-6M	IT/TELE ROOM 126	
100-AB			1	2		2	0003	0004					B-2	1 RG-6M	IT/TELE ROOM 126	
100-DA			0	2		2	0005	0006							IT/TELE ROOM 126	
100-EA			0	6		6	0007	0008	0009	0010	0011	0012			IT/TELE ROOM 126	
100-EB			0	6		6	0013	0014	0015	0016	0017	0018			IT/TELE ROOM 126	
100-WA			0	0	2	2	0019	0020							IT/TELE ROOM 126	
101-AA	101	SOUTH LOBBY	1	2		2	0021	0022					B-3	1 RG-6M	IT/TELE ROOM 126	
101-CA			1	2		2	0023	0024					B-4	1 RG-6M	IT/TELE ROOM 126	
101-WA			0	0	2	2	0025	0026							IT/TELE ROOM 126	
101-WB			0	2		2	0027	0028							IT/TELE ROOM 126	
102-AA	102	CAFÉ	0	4		4	0029	0030	0031	0032					IT/TELE ROOM 126	
102-CA			0	1		1	0033								IT/TELE ROOM 126	
104-WA	104	RECAP	1	0	2	2	0034	0035					B-5	1 RG-6M	IT/TELE ROOM 126	
105-BA	105	CONF.	1	2		2	0036	0037					B-6	1 RG-6M	IT/TELE ROOM 126	
105-BB			1	2		2	0038	0039					B-7	1 RG-6M	IT/TELE ROOM 126	
105-EA			0	4		4	0040	0041	0042	0043					IT/TELE ROOM 126	
110-BA	110	MP2	0	2		2	0044	0045							IT/TELE ROOM 126	
110-BB			0	2		2	0046	0047							IT/TELE ROOM 126	
110-DA			0	2		2	0048	0049							IT/TELE ROOM 126	
110-DB			0	2		2	0050	0051							IT/TELE ROOM 126	
110-EA			0	4		4	0052	0053	0054	0055					IT/TELE ROOM 126	
110-WA			0	0	2	2	0056	0057							IT/TELE ROOM 126	
115-BA	115	ADMIN	0	4		4	0058	0059	0060	0061					IT/TELE ROOM 126	
115-BB			0	4		4	0062	0063	0064	0065					IT/TELE ROOM 126	
115-CA			0	4		4	0066	0067	0068	0069					IT/TELE ROOM 126	
115-CB			0	4		4	0070	0071	0072	0073					IT/TELE ROOM 126	
115-DA			0	4		4	0074	0075	0076	0077					IT/TELE ROOM 126	
115-DB			0	4		4	0078	0079	0080	0081					IT/TELE ROOM 126	
115-DC			0	4		4	0082	0083	0084	0085					IT/TELE ROOM 126	
115-EA			0	4		4	0086	0087	0088	0089					IT/TELE ROOM 126	
115-EB			0	4		4	0090	0091	0092	0093					IT/TELE ROOM 126	
115-WA			0	0	2	2	0094	0095							IT/TELE ROOM 126	
115A-AA	115A	COFFEE	1	4		4	0096	0097	0098	0099			B-8	1 RG-6M	IT/TELE ROOM 126	
115A-CA			0	1		1	0100								IT/TELE ROOM 126	
115B-BA	115B	COPY	0	4		4	0101	0102	0103	0104					IT/TELE ROOM 126	
115B-CA			0	4		4	0105	0106	0107	0108					IT/TELE ROOM 126	
115B-EA			0	2		2	0109	0110							IT/TELE ROOM 126	
115B-EB			0	2		2	0111	0112							IT/TELE ROOM 126	
116-BA	116	OFFICE 1	0	2		2	0113	0114							IT/TELE ROOM 126	
116-DA			0	2		2	0115	0116							IT/TELE ROOM 126	
117-BA	117	OFFICE 2	0	2		2	0117	0118							IT/TELE ROOM 126	
117-DA			0	2		2	0119	0120							IT/TELE ROOM 126	
118-BA	118	OFFICE 3	0	2		2	0121	0122							IT/TELE ROOM 126	
118-DA			0	2		2	0123	0124							IT/TELE ROOM 126	
120-AA	120	MP1	0	1		1	0125								IT/TELE ROOM 126	
120-AB			0	6		6	0126	0127	0128	0129	0130	0131			IT/TELE ROOM 126	
120-AC			0	6		6	0132	0133	0134	0135	0136	0137			IT/TELE ROOM 126	
120-AD			0	6		6	0138	0139	0140	0141	0142	0143			IT/TELE ROOM 126	
120-BA			0	2		2	0144	0145							IT/TELE ROOM 126	
120-BB			0	6		6	0146	0147	0148	0149	0150	0151			IT/TELE ROOM 126	
120-CA			1	2		2	0152	0153					B-9	1 RG-6M	IT/TELE ROOM 126	
120-CB			1	2		2	0154	0155					B-10	1 RG-6M	IT/TELE ROOM 126	
120-CC			1	2		2	0156	0157					B-11	1 RG-6M	IT/TELE ROOM 126	
120-CD			0	2		2	0158	0159							IT/TELE ROOM 126	
120-CE			0	6		6	0160	0161	0162	0163	0164	0165			IT/TELE ROOM 126	
120-EA			0	6		6	0166	0167	0168	0169	0170	0171			IT/TELE ROOM 126	
120-EB			0	6		6	0172	0173	0174	0175	0176	0177			IT/TELE ROOM 126	
120-EC			0	6		6	0178	0179	0180	0181	0182	0183			IT/TELE ROOM 126	
120-WA			0	0	2	2	0184	0185							IT/TELE ROOM 126	
120A-DA	120A	STOR.	1	4		4	0186	0187	0188	0189			B-12	1 RG-6M	IT/TELE ROOM 126	
120A-WA			0	0	2	2	0190	0191							IT/TELE ROOM 126	
121-BA	121	MTG	0	2		2	0192	0193							IT/TELE ROOM 126	
121-DA			0	2		2	0194	0195							IT/TELE ROOM 126	
122-BA	122	MTG	0	2		2	0196	0197							IT/TELE ROOM 126	
122-DA			0	2		2	0198	0199							IT/TELE ROOM 126	
125-AA	125	ELEC	0	2		2	0200	0201							IT/TELE ROOM 126	
130-AA	130	SENIOR 1	0	2		2	0202	0203							IT/TELE ROOM 126	
130-BA			1	4		4	0204	0205	0206	0207			B-13	1 RG-6M	IT/TELE ROOM 126	
130-BB			0	2		2	0208	0209							IT/TELE ROOM 126	
130-CA			1	2		2	0210	0211					B-14	1 RG-6M	IT/TELE ROOM 126	
130-CB			0	1		1	0212								IT/TELE ROOM 126	
130-WA			0	0	2	2	0213	0214							IT/TELE ROOM 126	
140-AA	140	SENIOR 2 (LOUNGE)	0	2		2	0215	0216							IT/TELE ROOM 126	
140-CA			0	1		1	0217								IT/TELE ROOM 126	
140-CB			0	2		2	0218	0219							IT/TELE ROOM 126	
140-DA			1	2		2	0220	0221					B-15	1 RG-6M	IT/TELE ROOM 126	
140-EA			0	4		4	0222	0223	0224	0225					IT/TELE ROOM 126	
140-WA			0	0	2	2	0226	0227							IT/TELE ROOM 126	
150-BA	150	COMMUNITY ROOM	0	1		1	0228								IT/TELE ROOM 126	
150-CA			0	6		6	0229	0230	0231	0232	0233	0234			IT/TELE ROOM 126	
150-DA			0	6		6	0235	0236	0237	0238	0239	0240			IT/TELE ROOM 126	
150-CB			0	6		6	0241	0242	0243	0244	0245	0246			IT/TELE ROOM 126	
150-DB			0	6		6	0247	0248	0249	0250	0251	0252			IT/TELE ROOM 126	
150-DA			0	6		6	0253	0254	0255	0256	0257	0258			IT/TELE ROOM 126	
150-EA			0	6		6	0259	0260	0261	0262	0263	0264			IT/TELE ROOM 126	
150-DB			0	6		6	0265	0266	0267	0268	0269	0270			IT/TELE ROOM 126	
150-DB			0	6		6	0271	0272	0273	0274	0275	0276			IT/TELE ROOM 126	
150-DC			0	1		1	0277								IT/TELE ROOM 126	
150-EA			0	4		4	0278	0279	0280	0281					IT/TELE ROOM 126	
150-WA			0	0	2	2	0282	0283							IT/TELE ROOM 126	
150-WB			0	0	2											

KEYNOTES	
TKN	TELECOMMUNICATIONS SYSTEMS: COMPLY WITH DIVISION 27.
TKN1	FASTEN IN PLACE AND PROVIDE A WATERTIGHT SEAL AT THE PERIMETER PER THE MANUFACTURER'S INSTRUCTIONS AND IN ACCORDANCE WITH THE REQUIREMENTS OF DIV 4 THROUGH 10.
TKN2	PROVIDE PORT MANUFACTURER'S BOOT ASSEMBLY AS REQUIRED TO MATCH COUNTY'S INITIAL RADIO CABLE COUNT. MATCH BOOT OPENING DIAMETER(S) TO DIAMETER OF COUNTY CABLING. PROVIDE BOOTS WITH MULTIPLE OPENINGS WHERE DIRECTED BY COUNTY'S REPRESENTATIVE.
TKN3	PROVIDE MANUFACTURER'S SNAP-IN ENTRY PORT CAP AT UNUSED OPENINGS.

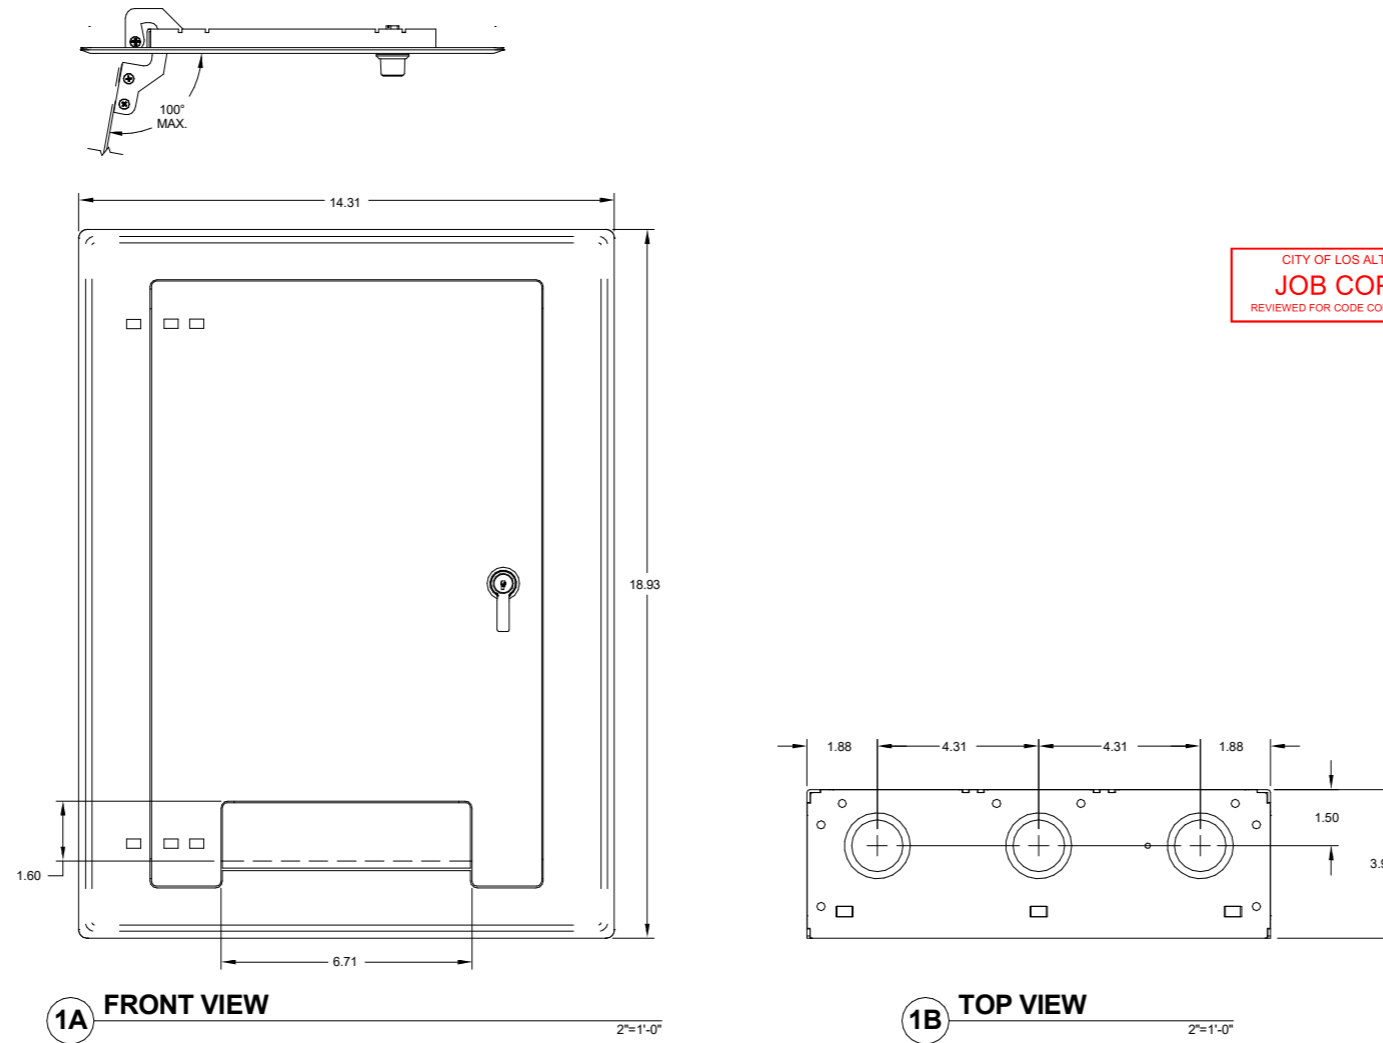


CITY OF LOS ALTOS
JOB COPY
REVIEWED FOR CODE COMPLIANCE

1A FRONT VIEW 2"=1'-0"


1B TOP VIEW 2"=1'-0"

1 MPB3 - WALL PANEL BOX 2"=1'-0"
MEDIA PATCH BOX TYPE 3 - MPB3

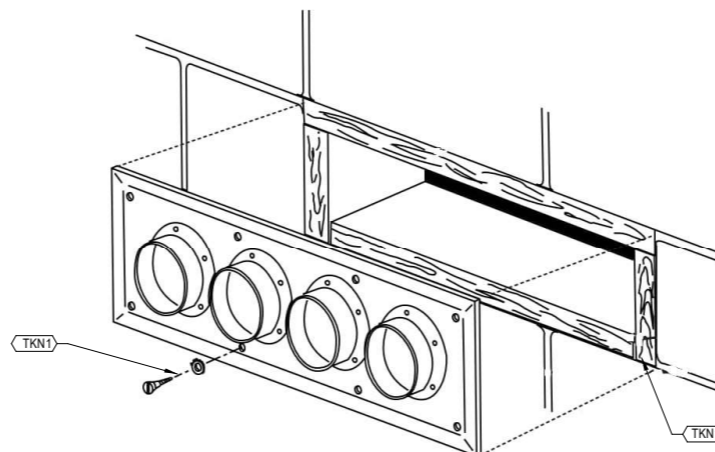

TYPICAL INSTALLATION DETAIL IS FOR FOUR PORT ASSEMBLY - PROVIDE THREE PORT VERSION OF ASSEMBLY

2 3 PORT RADIO FEED THROUGH FITTING 2"=1'-0"
PROVIDE EQUIVALENT TO COMMSCOPE #204673-3

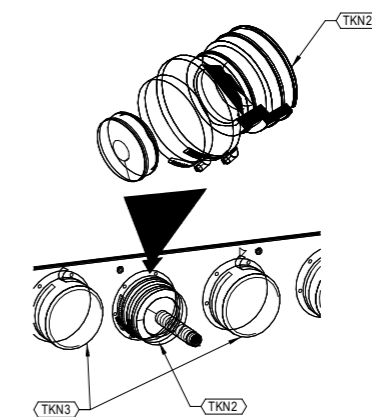

REVIEWED
FOR CODE COMPLIANCE
January 5, 2024
TRB AND ASSOCIATES

3 RADIO FEED PORT BOOT AND CAP ASSEMBLIES NTS

NOLL & TAM
ARCHITECTS

729 Heinz Avenue
Berkeley, CA 94710
tel 510.542.2200
fax 510.542.2201



SEAL

PROJECT TITLE

City of Los Altos
Los Altos CC EOC

97 Hillview Ave.
Los Altos, CA 94022

ISSUE TITLE

PERMIT SET

ISSUE DATE

AUG 03, 2023

NOLL & TAM JOB NUMBER

22203

REVISIONS

DATE	DESCRIPTION

SHEET TITLE

DETAILS - WALL BOX
AND RADIO FEED
THROUGH PANEL


SHEET NUMBER

TN9-1

ELECTRONIC SECURITY SYSTEMS GENERAL NOTES

- REFER TO SPECIFICATIONS FOR COMPLETE REQUIREMENTS.
- PROVIDE CONDUIT, BOXES AND FITTINGS SHOWN ON ELECTRONIC SECURITY SYSTEMS (TY) SYSTEM DRAWINGS UNDER THE WORK OF SECTION 28 05 28 PATHWAYS FOR ELECTRONIC SAFETY AND SECURITY UNLESS OTHERWISE INDICATED. PROVIDE 1 INCH TRADE SIZE MINIMUM. PROVIDE RACEWAY SIZE AS REQUIRED FOR A MAXIMUM OF 30 PERCENT WIRE FILL.
- PROVIDE FIRESTOPPING UNDER THE WORK OF SECTION 28 05 28 PATHWAYS FOR ELECTRONIC SAFETY AND SECURITY.
- LOCATIONS SHOWN ON THE ARCHITECTURAL DRAWINGS TAKE PRECEDENCE OVER LOCATIONS SHOWN ON THE COMMUNICATIONS SYSTEMS DRAWINGS.
- DEVICE QUANTITIES SHOWN ON FLOOR PLANS AND REFLECTED CEILING PLANS TAKE PRECEDENCE OVER DEVICE QUANTITIES SHOWN ON FUNCTIONAL DIAGRAMS.
- QUANTITIES SHOWN ON FUNCTIONAL DIAGRAMS TAKE PRECEDENCE OVER QUANTITIES SHOWN ON RACK ELEVATIONS.
- QUANTITIES SHOWN ON DEVICE SCHEDULES TAKE PRECEDENCE OVER QUANTITIES SHOWN ON FUNCTIONAL DIAGRAMS, FLOOR PLANS AND REFLECTED CEILING PLANS.
- LOCATIONS SHOWN ON LARGE SCALE DRAWINGS TAKE PRECEDENCE OVER LOCATIONS SHOWN ON SMALL SCALE DRAWINGS.
- NOT USED.
- WIRING FOR THE WORK OF ELECTRONIC SECURITY SYSTEMS IS NOT PERMITTED TO SHARE CONDUIT, SLEEVES OR HOOKS WITH WIRING FOR WORK OF DIVISION 27. MAINTAIN AT LEAST 2 INCHES SEPARATION IF RUNNING PARALLEL. MAINTAIN AT LEAST 3 INCHES OF SEPARATION VERTICALLY IF CROSSING AT RIGHT ANGLES.

GENERAL SYMBOLS

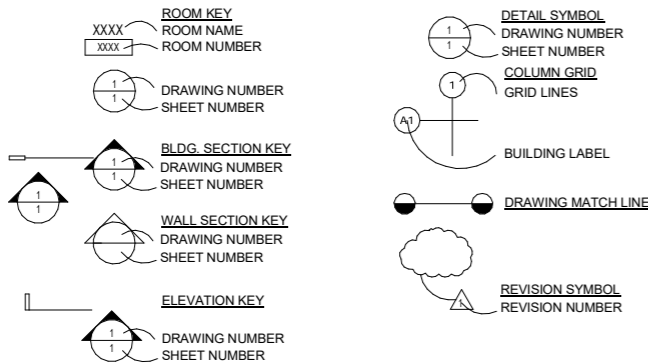

MATERIAL & EQUIPMENT LEGEND

1IDP	1" INNERDUCT, PLENUM RATED	OSP	OUTSIDE PLANT
2IDP	2" INNERDUCT, PLENUM RATED	SM	SINGLE MODE OPTICAL FIBER
C5ePP	CATEGORY 5e PATCH PANEL	UTP5e-4	UNSHIELDED TWISTED PAIR, CAT. 5e
C6PP	CATEGORY 6 PATCH PANEL	UTP5e-4P	UNSHIELDED TWISTED PAIR, CAT. 5e PLENUM
FOH-P	FIBER OPTIC CABLE HYBRID, PLENUM RATED	UTP5e-4OP	UNSHIELDED TWISTED PAIR, CAT. 5e OUTSIDE PLANT
FOH-OPR	FIBER OPTIC CABLE HYBRID, OUTSIDE PLANT RISER RATED	UTP6-4	UNSHIELDED TWISTED PAIR, CAT. 6
FOM-OPR	FIBER OPTIC CABLE, MULTI MODE OUTSIDE PLANT RISER RATED	UTP6-4P	UNSHIELDED TWISTED PAIR, CAT. 6 PLENUM
FOS-OPR	FIBER OPTIC CABLE, SINGLE MODE OUTSIDE PLANT RISER RATED	UTP6-4OP	UNSHIELDED TWISTED PAIR, CAT. 6 OUTSIDE PLANT
FPP	FIBER PATCH PANEL	110TBXX	110 TERMINAL BLOCK, CAT.5, XX-NO OF PAIRS
FSC	FIBER SPLICE CLOSURE	110PWTBXX	110 TERMINAL BLOCK, PRE-WIRED W/50 PIN CONNECTOR, XX- NO OF PAIRS
FSP	FIBER SPLICE PANEL	TB15	TERMINAL BLOCK WITH 15 AMP SWITCH BLADE.
FTB	FIBER TERMINAL BOX		
IDF	INTERMEDIATE DISTRIBUTION FACILITY		
MDF	MAIN DISTRIBUTION FACILITY		
MM	MULTI MODE OPTICAL FIBER		
MMP	MULTIMEDIA PLATE		

NOTE:
SEE SPECIFICATION SECTIONS FOR REFERENCE DESCRIPTIONS AND REQUIREMENTS. FOR OTHER MATERIAL AND EQUIPMENT TYPES REFER TO SPECIFICATIONS.


SYMBOL SCHEDULE

SYMBOL	DEVICE	FUNCTION OR SERVICE	LOCATION	WORK OF	ROUGH-IN	RACEWAY	ELEVATION	CABLE FILL & HOMERUN DESTINATION, U.O.N.	FINISH	WEIGHT, LB	DETAIL SHEET(S)
↔	WALL SLEEVE	PATHWAY	INDICATED	28 05 28	N/A	R11					
📹	CCTV CAMERA, FIXED FOCUS, TCP/IP, EXTERIOR WITH BRACKET ARM.	VISUAL SURVEILLANCE	REFER TO ELECTRICAL DRAWING E4-1	28 05 28 28 23 00	FLUSH CAST 5S BOX 1 G. RING	R5	+9' AFF	IT/TELE ROOM 126	WHITE	2	4/TY9-1

NOTE NO.	DEVICE NOTES
	RACEWAY NOTES
R1	1/2" C. H.R. TO NEAREST IDS TERMINAL CABINET
R2	3/4" C. H.R. TO NEAREST IDS TERMINAL CABINET
R3	1" C. H.R. TO NEAREST IDS TERMINAL CABINET
R4	AS DETAILED AND/OR SCHEDULED
R5	3/4" C. H.R. TO ACCESSIBLE CEILING OR FLOOR, OR TO SERVING BDF, IDF OR EQUIPMENT ROOM, U.O.N.
R6	1" C. H.R. TO ACCESSIBLE CEILING OR FLOOR, OR TO SERVING BDF, IDF OR EQUIPMENT ROOM, U.O.N.
R7	1-1/4" C. H.R. TO ACCESSIBLE CEILING OR FLOOR, OR TO SERVING BDF, IDF OR EQUIPMENT ROOM, U.O.N.
R8	NOT USED
R9	NOT USED
R10	NOT USED
R11	UNLESS OTHERWISE SHOWN, PROVIDE 1.5" EMT SLEEVE, WITH INSULATED THROAT BUSHING AT EACH END, STUBBED OUT 4 INCHES FROM FACE OF WALL, AT ELEVATION APPROXIMATELY 6 INCHES ABOVE ACCESSIBLE CEILING. INSTALL SLEEVE IN AN ACCESSIBLE LOCATION AS DEFINED IN CALIFORNIA ELECTRICAL CODE, ARTICLE 100 DEFINITIONS. PROVIDE FIRESTOPPING UNDER WORK OF SECTION 28 05 28. BOND TO GROUND. COMPLY WITH DIVISION 26 AND SECTION 28 05 26.

ACCESSIBLE CEILING IS A T-BAR OR SIMILAR GRID BASED, PANELIZED REMOVEABLE CEILING MEETING THE DEFINITION FOR ACCESSIBLE WIRING METHODS IN ARTICLE 100 OF THE CALIFORNIA ELECTRICAL CODE.

LEGEND

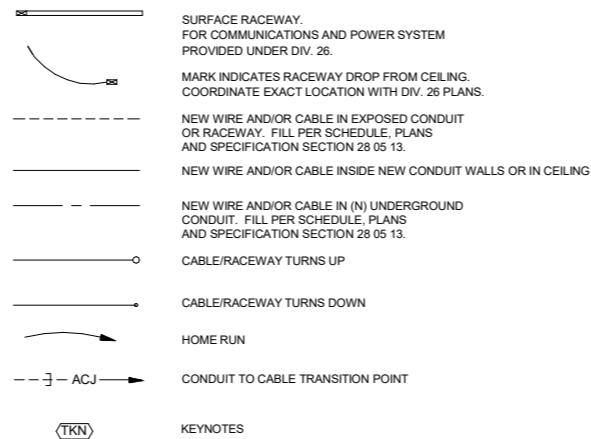

ABBREVIATIONS

1SR-1	SINGLE CHAMBER SURFACE RACEWAY
3SR-2.5	THREE CHAMBER SURFACE RACEWAY
A.D.A.	AMERICANS WITH DISABILITIES ACT
ADF	AREA DISTRIBUTION FACILITY
A.F.C.	ABOVE FINISHED CEILING
A.F.F.	ABOVE FINISHED FLOOR
ALT	ALTERNATE
A.M.F.F.	ABOVE MEZZANINE FINISHED FLOOR
BDF	BUILDING DISTRIBUTION FACILITY
B.F.C.	BELOW FINISHED CEILING
B.L.D.G.	BUILDING
B.O.H.	BACK OF HOUSE
C.	CONDUIT
CAT.	CATEGORY
CBC	CALIFORNIA BUILDING CODE
CEC	CALIFORNIA ELECTRICAL CODE
COMM.	COMMUNICATIONS
C.L.	CENTERLINE
C.O.	CONDUIT ONLY
CONT.	CONTINUATION
CS	COMMUNICATIONS SYSTEM
(D)	DEMOLISH EXISTING
DED	DUCTIVE
Ø, DIA.	DIAMETER
DIV	DIVISION
(E)	EXISTING
EA	EACH
EIA	ELECTRONIC INDUSTRIES ASSOCIATION
ELEV.	ELEVATION
E.O.L.	END OF LINE
EQPT.	EQUIPMENT
FIN	FINISHED
FUT	FUTURE
H.R.	HOME RUN
HT.	HEIGHT
J. JBOX	JUNCTION BOX
LAN	LOCAL AREA NETWORK
MATV	MASTER ANTENNA TELEVISION
MAX.	MAXIMUM
MIN.	MINIMUM
MOD.	MODULAR
MON.	MONUMENT
(N)	NEW
NEC	NATIONAL ELECTRICAL CODE
N.I.C.	NOT IN CONTRACT
NTS	NOT TO SCALE
O.C.	ON CENTER
O.D.	OUTSIDE DIAMETER
O.F.E.	OWNER FURNISHED EQUIPMENT
OPP.	OPPOSITE
PNL.	PANEL
PROJ.	PROJECT
P.S.R.H	PROJECT STANDARD RECEPTACLE HEIGHT +18" AFF, U.O.N.
P.S.S.H.	PROJECT STANDARD SWITCH HEIGHT +48" AFF TO U.O.N.
RE:	REFER TO
REF.	REFERENCE
SIM.	SIMILAR
SM	SINGLE MODE OPTICAL FIBER
SN	SHEET NOTE
SP	SHIELDED PAIR - SEE SPECIFICATIONS
SPEC	SPECIFICATION
S.R.	SURFACE RACEWAY
STD	STANDARD
STP	SHIELDED TWISTED PAIR
T.C.	TELECOMMUNICATIONS CLOSET
TEL	TELEPHONE
TELCOM	TELECOMMUNICATIONS
TIA	TELECOMMUNICATIONS INDUSTRY ASSOCIATION
TP	TWISTED PAIR
TYP.	TYPICAL
U.O.N.	UNLESS OTHERWISE NOTED
W/	WITH
WP	WEATHERPROOF

JUNCTION BOX SCHEDULE

SYMBOL	H (INCHES)	W (INCHES)	(INCHES)
J1	6	6	4
J2	8	8	4
J3	12	12	4
J4	12	12	6
J5	12	12	8
J6	16	12	6
J7	18	18	8
J8	20	16	6
J9	20	16	8
J10	20	20	6
J11	20	20	8
J12	24	20	6
J13	24	20	8
J14	24	24	8
J15	30	24	8
J16	30	30	8
J17	36	30	8
J18	36	36	8

SUFFIX:
NONE - NEMA 1 C - NEMA 4
A - NEMA 12 D - NEMA 4X
B - NEMA 3R

EXAMPLE: J16C= 30"H X 30"W X 8"D HINGED NEMA 4 JBOX.

NOTE 1
ALL JUNCTION BOXES TO BE HINGED TYPE, PROVIDED WITHOUT PRE-PUNCHED KNOCKOUTS. PENETRATIONS IN JUNCTION BOXES SHALL BE CUT OR PUNCHED AS REQUIRED FOR INSTALLATION. PAINT ALL INTERIOR BOXES TO MATCH WALL FINISH. COORDINATE FINISH WITH ARCH. PLANS.

APPROVALS

NOLL & TAM
ARCHITECTS

729 Heinz Avenue
Berkeley, CA 94710
tel 510.542.2200
fax 510.542.2201



CITY OF LOS ALTOS
JOB COPY
REVIEWED FOR CODE COMPLIANCE

SEAL

PROJECT TITLE

City of Los Altos
Los Altos CC EOC

97 Hillview Ave.
Los Altos, CA 94022

ISSUE TITLE

PERMIT SET

ISSUE DATE AUG 03, 2023

NOLL & TAM JOB NUMBER 22203

REVISIONS	DATE	DESCRIPTION

REVIEWED

FOR CODE COMPLIANCE

January 5, 2024

TRB AND ASSOCIATES

SHEET TITLE

GENERAL NOTES,
LEGEND, SYMBOL,
ABBREVIATIONS,
JUNCTION BOX &
SYMBOL SCHEDULES

SHEET NUMBER

TY0-1



SEAL

PROJECT TITLE

City of Los Altos
Los Altos CC EOC

97 Hillview Ave.
Los Altos, CA 94022

ISSUE TITLE

PERMIT SET

ISSUE DATE **AUG 03, 2023**

NOLL & TAM JOB NUMBER **22203**

REVISIONS

DATE	DESCRIPTION

SHEET TITLE

**ACCESS & INTRUSION
DETECTION SYSTEM
SINGLE LINE DIAGRAM**

SHEET NUMBER

TY7-1


SHEET NOTES

- SINGLE DIAGRAM IS DIAGRAMMATIC. CONTRACTOR TO SUBMIT SHOP DRAWINGS INDICATING EXACT QTY AND LOCATION OF ACCESS CONTROL PANELS AND RELATED HARDWARE REQUIRED TO MEET THE FUNCTIONAL REQUIREMENTS OF THE PROJECT.
- PROVIDE BATTERY BACKUP (UPS AND/OR PANEL MOUNTED BATTERY) TO SUPPORT OPERATIONS OF THE BACKBOARD MOUNTED PORTIONS OF THE ELECTRONIC SECURITY SYSTEMS FOR AT LEAST 20 MIN. FOLLOWING LOSS OF POWER, INCLUDING CARD READERS, ACCESS CONTROL (DGP) AND IDS PANELS, ELECTRIC LOCKS AND FIELD MONITORING DEVICES. REFER TO KEYNOTE TN10 FOR THE BACKUP REQUIREMENTS FOR THE RACK MOUNT SERVER COMPONENTS WHICH ARE SUPPORTING BOTH BUILDINGS.

**CITY OF LOS ALTOS
JOB COPY
REVIEWED FOR CODE COMPLIANCE**

KEYNOTES

- TKN ELECTRONIC SECURITY SYSTEMS; COMPLY WITH DIVISIONS 28.
- TKN1 LOW VOLTAGE POWER REQUIRED VARIES WITH DEVICE MANUFACTURER.
- TKN2 DEVICE QUANTITY AS INDICATED ON THE PLANS.
- TKN3 LOCATE TRANSCIEVER IN CAMERA WALL MOUNT ARM VOID, OR IN BACKBOX AS REQUIRED. PROVIDE SUPPLEMENTAL NEMA 4 WEATHERPROOF PULL BOX AT GENERATOR ENCLOSURE IF REQUIRED TO HOUSE TRANSCIEVER.
- TKN4 CAT6 PATCH CORDS. PROVIDE QTY. AS REQUIRED.
- TKN5 PROVIDE CABLE GAUGE AS REQUIRED TO SUIT DEVICE. VOLTAGE OF POWER SUPPLY AND RUN LENGTH IN ACCORDANCE WITH THE MANUFACTURERS DIRECTIONS. AT UNDERGROUND CONDITIONS, PROVIDE CABLING SUITABLE TO EXPOSURE TO CONTINUOUS STANDING WATER.
- TKN6 STRUCTURED CABLING IS WORK OF DIVISION 27.
- TKN7 DUPLEX FIBER OPTIC PATCH CORDS. PROVIDE QTY. AS REQUIRED.
- TKN8 MMP6 MOUNTED TO SURFACE MTD BACKBOX OR EQUIVALENT USING SPECIFIED JACKS MTD IN 'BSLUIT BOX' MECHANICALLY FASTENED TO INTERIOR OF ENCLOSURE. WHERE CIRCUIT REQUIRES FIBER CONNECTIVITY, PROVIDE LC CONNECTOR, OTHERWISE PROVIDE CAT6 RJ45.
- TKN9 PROVIDE QTY AS REQUIRED.
- TKN10 PROVIDE UNINTERRUPTIBLE POWER BACKUP FOR ENTIRE SYSTEM FOR UP TO 4 HOURS OPERATION FOLLOWING LOSS OF POWER.
- TKN11 PROVIDE AUXILIARY CAMERA POWER AS REQUIRED WHERE CAMERA IS NOT DESIGNED TO OPERATE ON POE POWER ALONE INCLUDING ALL PTZ AND ALL EXTERIOR CAMERAS, WHICH SHALL BE PROVIDED WITH INTEGRAL HEATERS.
- TKN12 WHERE PATHWAY IS UNDERGROUND, PROVIDE THWN OR EQUIVALENT UNDERGROUND RATED CABLING AS SPECIFIED IN DIVISION 26 FOR SIM APPLICATIONS. SELECT GAUGE TO SUIT RUN LENGTHS.
- TKN13 SECURE TO RACK OR BACKBOARD AS DIRECTED BY THE CITY'S REPRESENTATIVE.
- TKN14 CITY FURNISHED
- TKN15 REFER TO TN6-1 FOR ACCESSIBLE CEILING AS WELL AS NEW AND (E) CEILING PATHWAYS.
- TKN16 UTP6-40P.
- TKN17 THWN OR EQUIVALENT UNDERGROUND RATED CABLING AS SPECIFIED IN DIVISION 26 FOR SIM APPLICATIONS. SELECT GAUGE TO SUIT RUN LENGTHS.
- TKN18 PROVIDE A SEPARATE INTRUSION DETECTION SUBSYSTEM WHERE ACCESS CONTROL SYSTEM IS NOT UL 1076 LISTED AS A BURGLAR ALARM.
- TKN19 WHERE INTRUSION DETECTION PROVIDED BY A SEPARATE SUBSYSTEM THAN ACCESS CONTROL, DOOR POSITION SWITCHES HAVE DPDT OUTPUT. WIRE A SEPARATE PAIR FROM EACH OUTPUT TO THE ACCESS CONTROL AND THE INTRUSION DETECTION PANEL.
- TKN20 WHERE INSTALLED ELECTRIC LOCKING HARDWARE PROVIDES LATCH RETRACTION MONITORING, PROVIDE CONDUCTORS AND DGP MONITORING POINTS AND DGP PROGRAMMING AS REQUIRED TO MONITOR LATCH STATUS.
- TKN21 REFER TO SHEET NOTE 2. FOR POWER BACK-UP REQUIREMENTS.
- TKN22 REFER TO ELECTRICAL SITE PLANS FOR GENERATOR ACCESS CONTROL PATHWAY TO BE USED TO PULL IN THE VISUAL SURVEILLANCE CABLING.

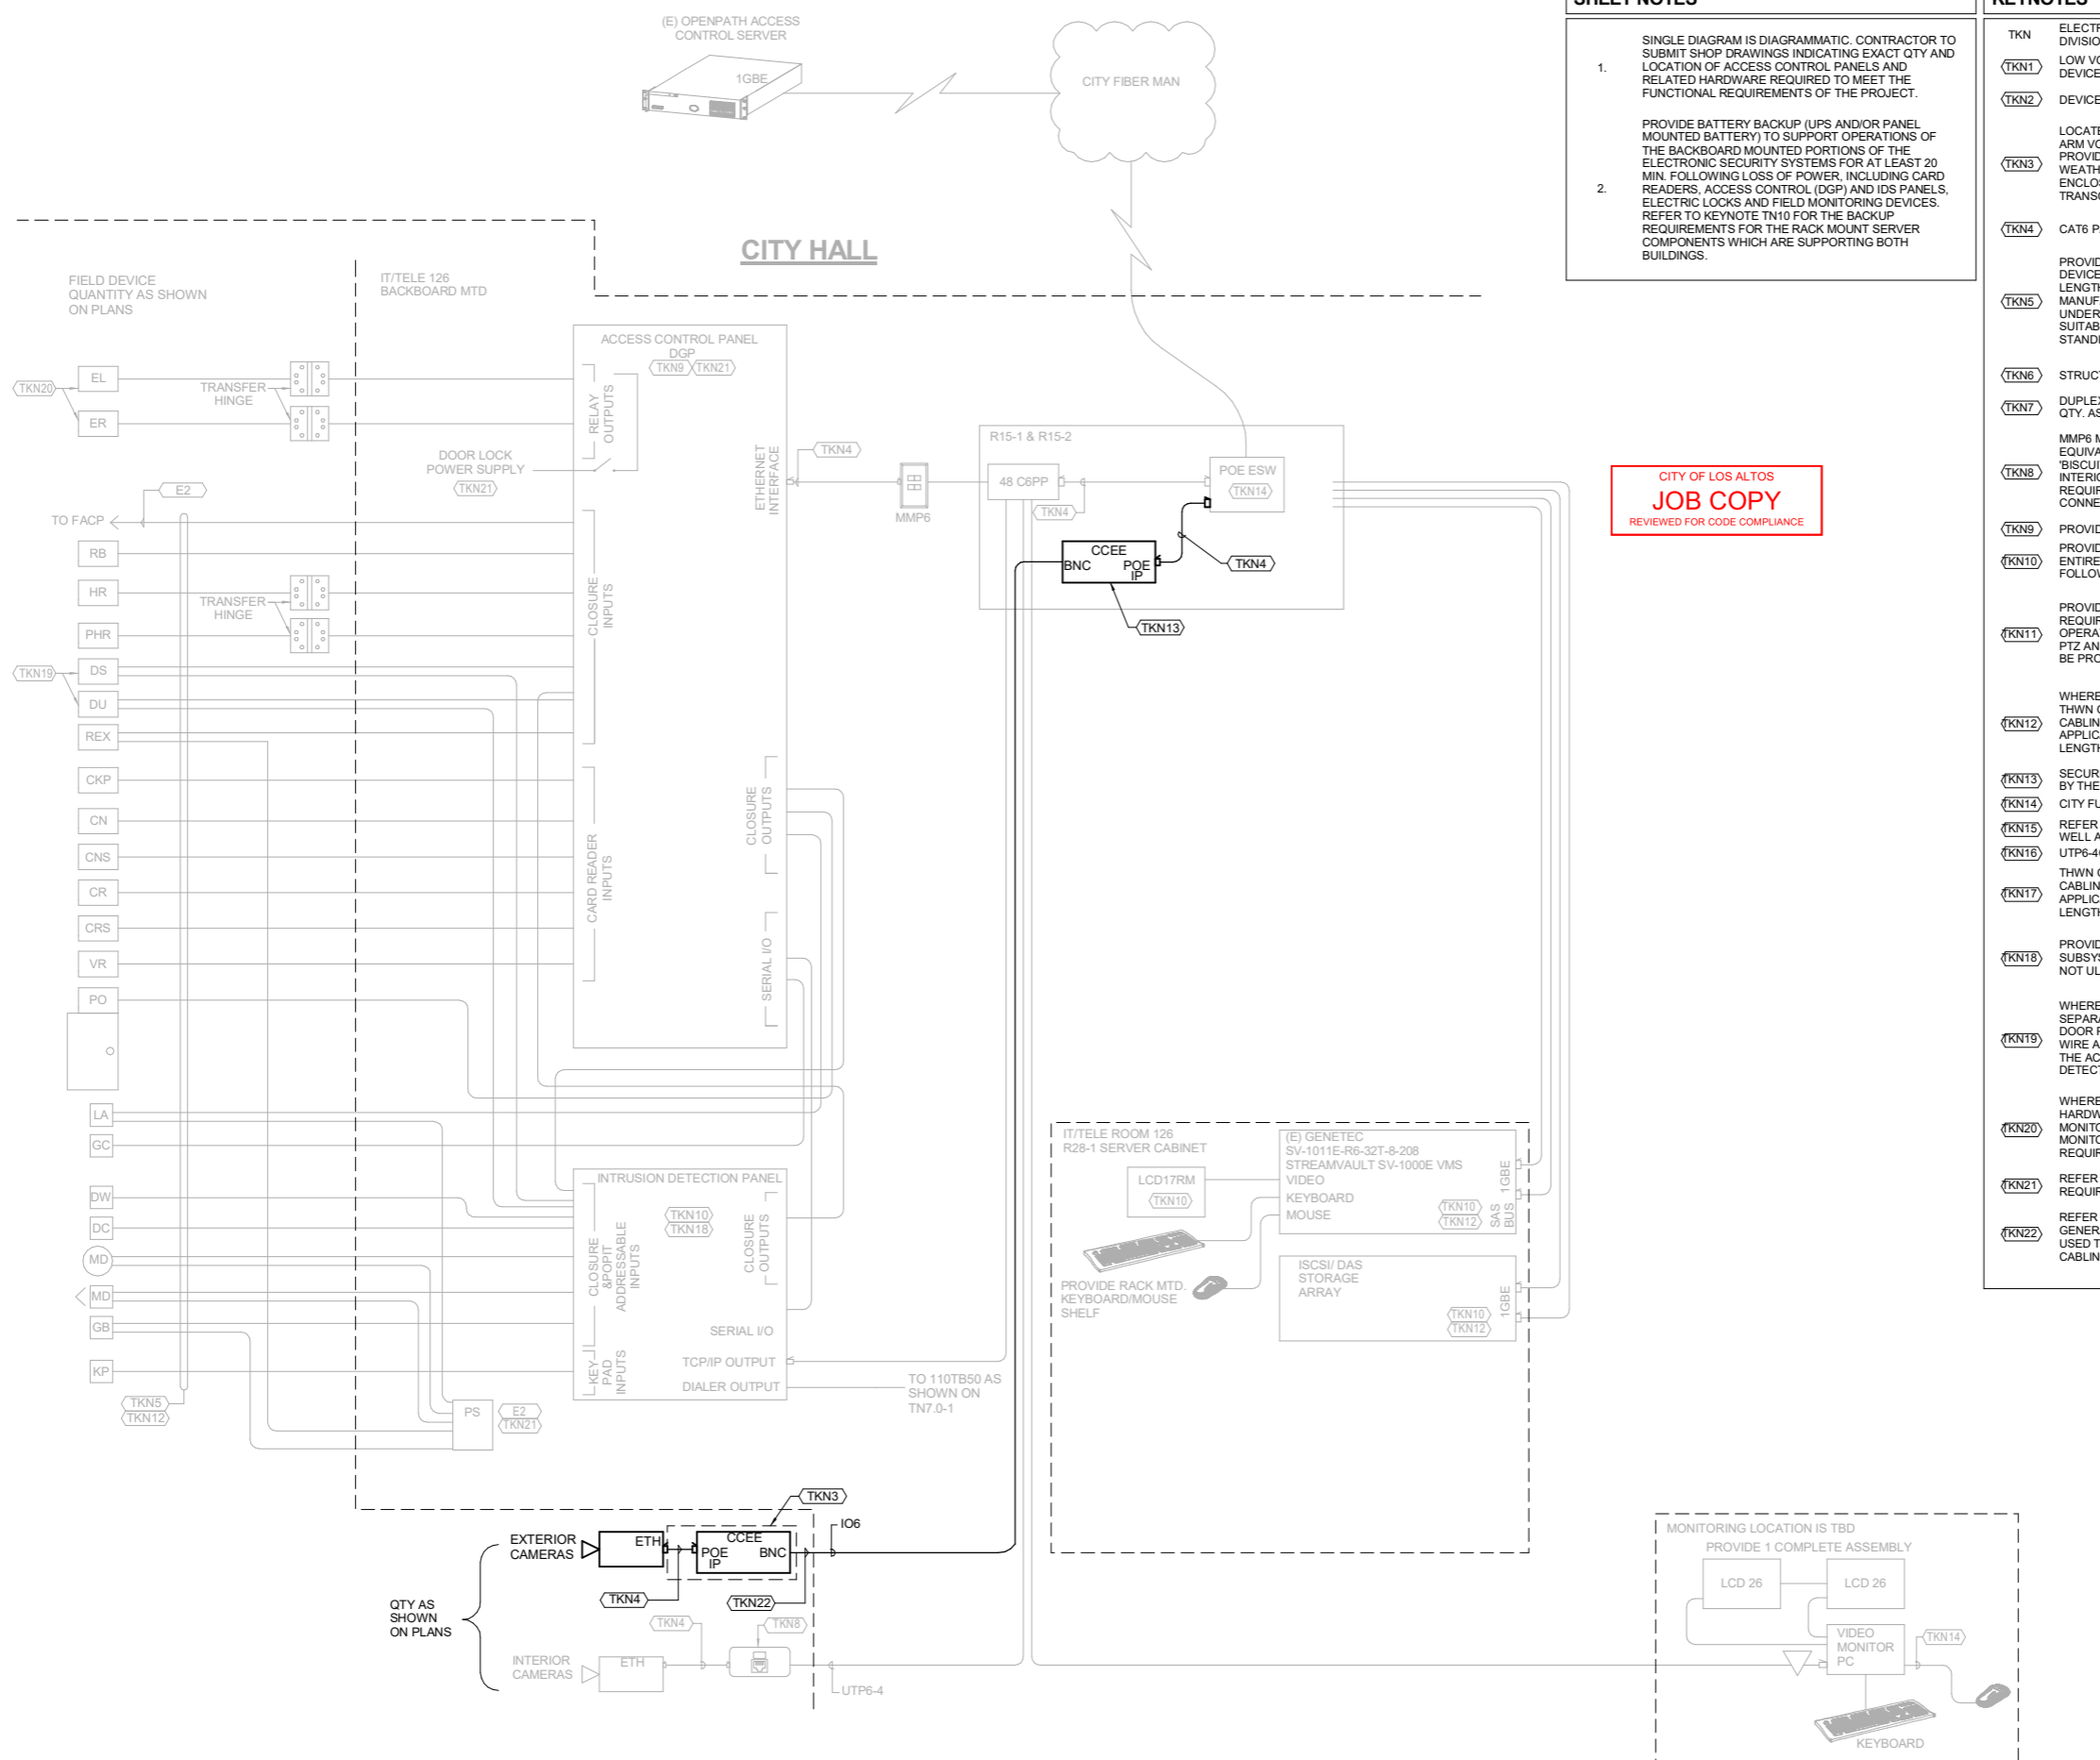


COMMUNITY CENTER

**ELECTRONIC SECURITY SYSTEMS
SINGLE LINE DIAGRAM**


1

NTS

REVIEWED
FOR CODE COMPLIANCE
January 5, 2024
TRB AND ASSOCIATES

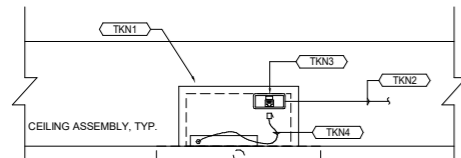


1A SIDE VIEW NTS

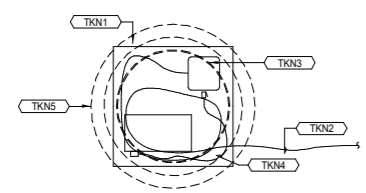


1B TOP VIEW NTS

1 IP CAMERA WIRING DETAIL NTS

CATEGORY MEDIA STATION CABLING TO IP CAMERAS TO TERMINATE AT PERMANENT ENCLOSURE/JACK ASSEMBLY, AND A PATCH CORD SHALL BE USED TO MAKE THE CONNECTION FROM THE PERMANENTLY INSTALLED JACK TO THE CAMERA.

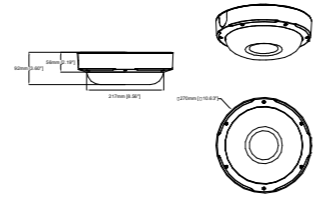


3 TYPICAL 360 DEGREE VIEW IP CAMERA ASSEMBLY NTS

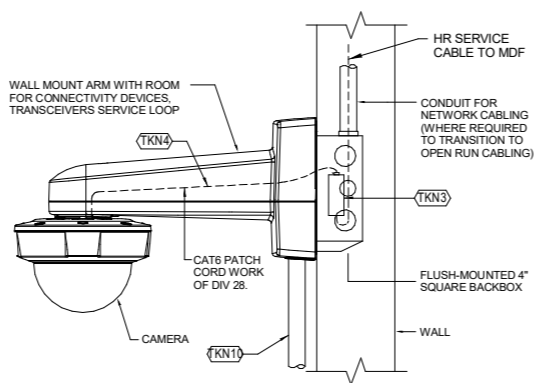


NOTE:
1) FOR EXTERIOR CAMERA USE INCLUDED WEATHERPROOF HOUSING.

4 CAMERA WALL MOUNT ARM TYP. NTS

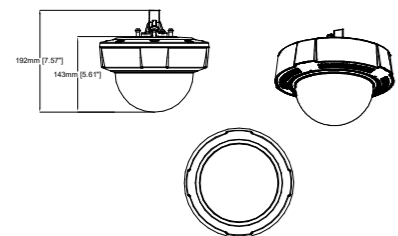

2 TYPICAL 180 DEGREE VIEW IP CAMERA ASSEMBLY NTS

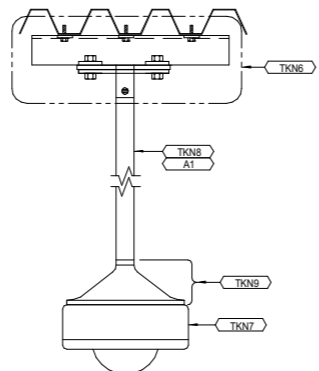

5 IP CAMERA PENDANT MOUNT INTERIOR CEILING/STRUCTURE MOUNTED. NTS

CITY OF LOS ALTOS
JOB COPY
REVIEWED FOR CODE COMPLIANCE

KEYNOTES	
TKN	COMMUNICATIONS AND ELECTRONIC SECURITY SYSTEMS. COMPLY WITH DIVISIONS 27 AND 28.
TKN1	55 TYPE ELECTRICAL BACKBOX EQUAL TO RANDL INDUSTRIES T-55017 WHERE SURFACE MOUNT OF IP CAMERA TO FLUSH MOUNT BACKBOX WITH INTEGRAL STRUCTURED CABLING BISCUIT BOX REQUIRED. PROVIDE EXTERIOR GRADE BOX AT EXTERIOR CONDITIONS AS REQUIRED BY SECTION 28 05 28 - PATHWAYS FOR ELECTRONIC SAFETY AND SECURITY
TKN2	CATEGORY 6 STATION CABLING BY DIVISION 27.
TKN3	AT INTERIOR, SMALL FORM FACTOR MULTIMEDIA ENCLOSURE SUITABLE FOR SURFACE MOUNTING WITH INTEGRAL CATEGORY 6 JACK FOR TERMINATION OF STATION CABLING. OMIT AT SITE CAMERAS SERVED BY IO6 COAX CABLING AND LOCATE CCEE IN BACKBOX OR IN WALL MOUNT ARM COMPARTMENT, AS REQUIRED.
TKN4	CATEGORY 6 PATCH CORD PROVIDE LENGTH AS REQUIRED. WHERE CAMERA IS MOUNTED TO BACKBOX, COIL INSIDE BACKBOX.
TKN5	SURFACE MOUNT IP CAMERA SUPPORTED FROM FLUSH MOUNTED BACKBOX.
TKN6	PROVIDE EQUAL TO CHIEF MANUFACTURING CMA110, 8" X 8" STEEL PLATE CEILING PLATE FITTING WITH 1" NPT PIPE THREAD ADAPTER.
TKN7	IP SECURITY CAMERA.
TKN8	1" NPT PIPE THREADED FOR PENDENT MOUNTING FROM STRUCTURE ABOVE.
TKN9	CAMERA MANUFACTURER'S PENDANT MOUNT ADAPTER
TKN10	WHERE SURFACE MOUNTED CONDUIT ENTERS SURFACE MOUNTED BACKBOX, OR WALL MOUNT ARM WITH INTEGRAL DEVICE BOX EQUIVALENT TO AXIS T91H61, CONDUIT TO ENTER FROM BELOW TO PREVENT WATER PENETRATION OF DEVICE BOX.

NOLL & TAM
ARCHITECTS

729 Heinz Avenue
Berkeley, CA 94710
tel 510.542.2200
fax 510.542.2201



SEAL

PROJECT TITLE

City of Los Altos
Los Altos CC EOC

97 Hillview Ave.
Los Altos, CA 94022

ISSUE TITLE
PERMIT SET

ISSUE DATE
AUG 03, 2023

NOLL & TAM JOB NUMBER
22203

REVISIONS	DATE	DESCRIPTION

SHEET TITLE
**ESS DETAILS -
CAMERA DETAILS**

SHEET NUMBER

TY9-1

REVIEWED
FOR CODE COMPLIANCE
January 5, 2024
TRB AND ASSOCIATES