

ADDENDUM TO AGREEMENT
(Rail with Trail Pathway - Nine Mile Drain/Rutledge Lateral)

ADDENDUM TO AGREEMENT, made and entered into this ____ day of _____, 2026, by and between NAMPA & MERIDIAN IRRIGATION DISTRICT, an irrigation district organized and existing under and by virtue of the laws of the State of Idaho ("***District***"), and the CITY OF MERIDIAN, a political subdivision and municipality of the State of Idaho (hereinafter referred to as "***City***"), is made with reference to the following facts:

The District and the City previously entered into a Project/Pathway Agreement dated December 2, 2025, recorded as Instrument No. 2025-081166, records of Ada County, Idaho (hereinafter the "***Project/Pathway Agreement***") . The purpose of the Project/ Pathway Agreement is to permit City to: 1) construct and install a 10' wide asphalt pedestrian pathway across and over the Rutledge Lateral and Nine Mile Drain and within the District's easements; and 2) in order to construct the above-referenced pathway over the Nine Mile Drain, pipe the Nine Mile Drain for a distance of 207 linear feet in 60" Class III RCP, including a new concrete headwall on the downstream end; and 3) in order to construct the above-referenced pathway over the Rutledge Lateral, pipe the Rutledge Lateral for a distance of 1,340 linear feet in 36" Class III RCP, including six new cast in place boxes and reconstruction of one existing delivery box, located in Meridian, Ada County, Idaho. The City now desires to modify and/or amend said Project/Pathway Agreement to permit and allow City to modify the type of pipe installed in the Rutledge Lateral and to change said pipe to 36" HDPE SDR 21 with solid fused (welded) joints in lieu of RCP pipe, and to provide for Irrigation Box #8 (5' x 8'). Execution of this Addendum in accordance with these facts will affect or change the terms of said Project/Pathway Agreement.

NOW, THEREFORE, for and in consideration of the premises and of the covenants, agreements and conditions herein and those set forth in the Agreement referred to above, the parties agree as follows:

1. Paragraph 1 of said Project/Pathway Agreement is hereby amended and modified to allow the City to modify the type of pipe installed in the Rutledge Lateral and to change said pipe to 36" HDPE SDR 21 with solid fused (welded) joints in lieu of RCP pipe, and to provide for Irrigation Box #8 (5' x 8'). Construction authorized by this Addendum shall be performed in accordance with the plans attached hereto as **Exhibit 1** and by this reference incorporated herein.
2. Construction/installation of the pipe authorized by this Addendum has already been

completed.

3. Said Project/Pathway Agreement is hereby affirmed and shall remain in full force and effect except as modified by this Addendum. The District and City acknowledge and agree that each is bound by the covenants, conditions and agreements contained in said Agreement.

4. The covenants, conditions and agreements contained herein and in said Project/Pathway Agreement shall constitute covenants to run with, and running with, all of the lands of the City described in Exhibit A of said Project/Pathway Agreement, and shall be binding on each of the parties hereto and on all parties and all persons claiming under them or either of them, and the advantages hereof shall inure to the benefit of each of the parties hereto and their respective successors and assigns, including, but not limited to, dedications, transfers and assignments of facilities to public entities.

IN WITNESS WHEREOF, the District and the City have hereunto caused their names to be subscribed as of the day and year herein first above written.

NAMPA & MERIDIAN IRRIGATION DISTRICT

By _____
David Duvall, Water Superintendent

STATE OF IDAHO)
) ss:
County of Canyon)

On this ____ day of _____, 2026, before me, the undersigned, a Notary Public in and for said State, personally appeared DAVID DUVALL, known to me to be the Water Superintendent of NAMPA & MERIDIAN IRRIGATION DISTRICT, the irrigation district that executed the foregoing instrument and acknowledged to me that such irrigation district executed the same.

IN WITNESS WHEREOF, I have hereunto set my hand and affixed my official seal, the day and year in this certificate first above written.

Notary Public for Idaho
Residing at _____, Idaho
My Commission Expires: _____

CITY OF MERIDIAN

By: _____
Its: _____

ATTEST:


By: _____
Its: _____

STATE OF IDAHO)
)ss.
County of Canyon)

On this ____ day of _____, 2026, before me, the undersigned, a notary public in and for said state, personally appeared _____ and _____ known or identified to me to be the _____ and _____ of CITY OF MERIDIAN, the entity that executed the foregoing instrument, and acknowledged to me that said entity executed the same.

IN WITNESS WHEREOF, I have hereunto set my hand and affixed my official seal, the day and year in this certificate first above written.

Notary Public for _____
Residing at _____,
My Commission Expires: _____

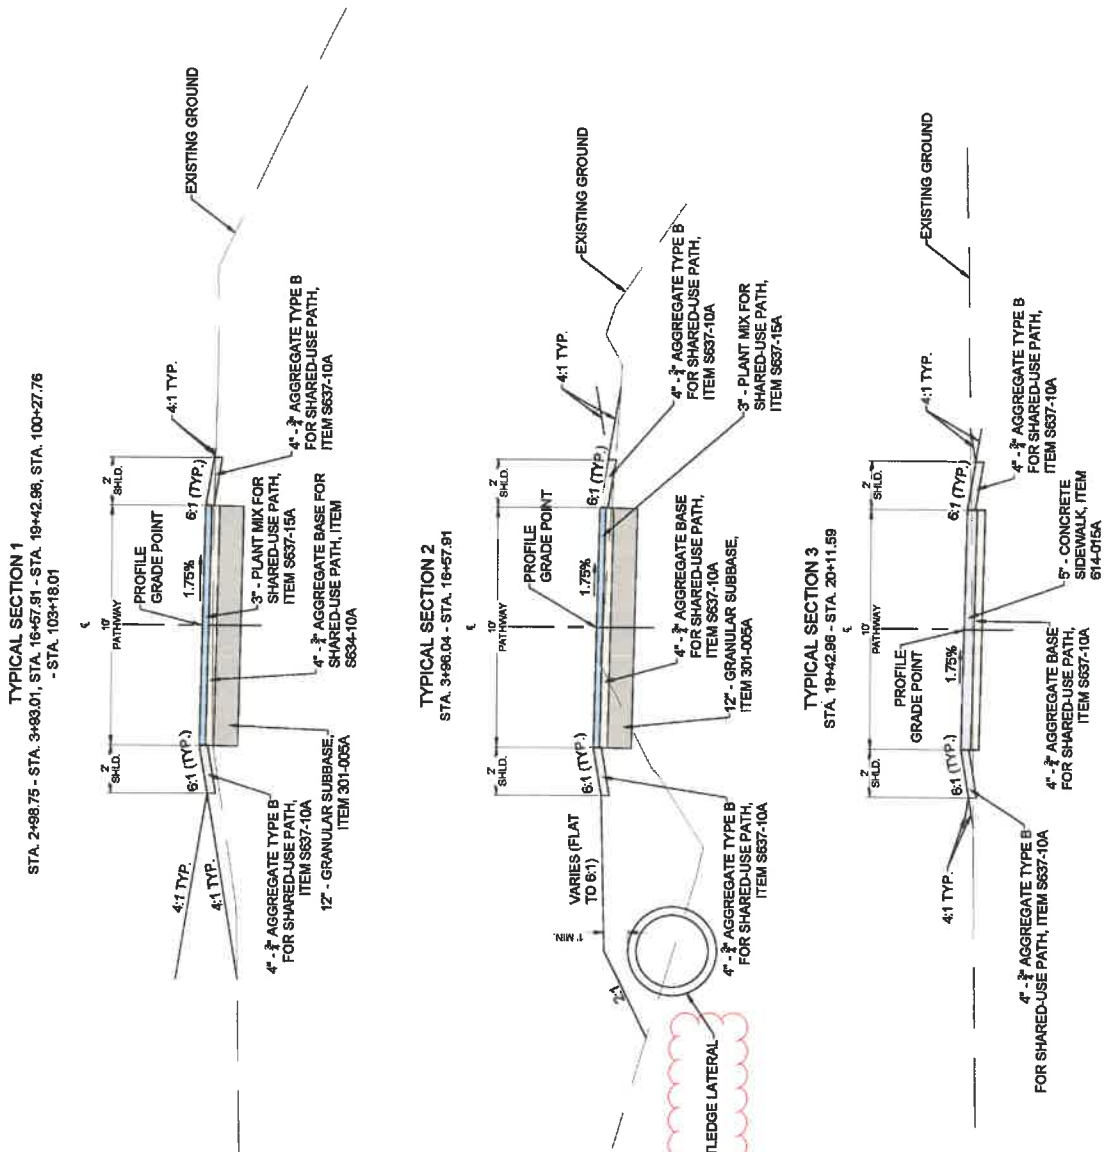

HOPE SDR 21
36" RCP @ RUTLEDGE LATERAL

REVISIONS		DESIGNED		SCALES SHOWN		PROJECT NO.		TYPICAL SECTIONS	
NO.	DATE	BY	DESCRIPTION	A. CORLEY	ARE FOR 11" X 17" PRINTS ONLY	A013(918)	RAIL W/ TRAIL PATHWAY, MERIDIAN	English	COUNTY ADA
1	10/20/20	JA	36" HOPE SDR 21	E. HULSHANDER					KEY NUMBER 13818
				DETAILED	CADD FILE NAME				
				DRAWING CHECKED	DRAWING DATE: 11/17/20				SHEET 7 OF 26

SHEET NUMBER											
STATION - STATION											
ITEM NO.	ITEM	UNIT	TOTAL	10	11	12	13	14	20	21-24	25-27
				100+00 - 104+16	2+20 - 7+30	7+30 - 12+30	12+30 - 17+30	17+30 - 20+38			
202-005A	SELECTIVE REM OF TREES INCLUDING STUMPS	EACH	10								
203-003A	REMOVAL OF OBSTRUCTIONS - RCP, IRRIGATION	FT	163		136	7	3				
203-060A	REMOVAL OF CONCRETE SIDEWALK	SY	12	12				27			
203-070A	REMOVAL OF CURB & GUTTER	FT	48	48							
203-080A	REMOVAL OF GUARDRAIL	FT	19	19							
203-122A	REMOVAL OF MISCELLANEOUS ITEMS - IRRIGATION BOX	EACH	1		1						
203-122B	REMOVAL OF MISCELLANEOUS ITEMS - CONCRETE HEADGATE	EACH	1					1			
205-005A	EXCAVATION	CY	720								
205-030A	BORROW	CY	1417								
205-060A	WATER FOR DUST ABATEMENT	MG	50								
212-011A	FIBER WATTLE	FT	4119							4119	
212-060A	STABILIZED CONSTRUCTION ENTRANCE	EACH	2								
212-105A	WATER AND POLLUTION	CA	2000								
301-005A	GRANULAR SUBBASE	TON	1340								
405-240A	MISCELLANEOUS PAVEMENT	SY	17	11				6			
604-025A	12" IRRIGATION PIPE - RCP	FT	22					22			
604-035A	18" IRRIGATION PIPE - RCP	FT	21		440	405	437	21			
604-065A	36" IRRIGATION PIPE - RCP	FT	1591				63	144			
604-105A	60" IRRIGATION PIPE - RCP	FT	207					1			
605-455A	MANHOLE TYPE A - SIZE 48"	EACH	1		1	1	1	1			
609-025A	MINOR STR - IRRIGATION BOX, SIZE 5'X5'	EACH	4								
609-025B	MINOR STR - IRRIGATION BOX, SIZE 15'X5'	EACH	1					1			
609-025C	MINOR STR - IRRIGATION BOX, SIZE 8'X8'	EACH	1					1			
609-025D	MINOR STR - IRRIGATION STEEL GRATE	EACH	1					1			
609-025E	MINOR STR - IRRIGATION BOX, SIZE 6'X6'	EACH	1		1						
614-015A	SIDEWALK	SY	115	3				112			
614-025A	CURB RAMP - TYPE A	SY	13	13							
614-025B	CURB RAMP - TYPE G - MIDBLOCK	SY	14	14							
615-490A	CURB & GUTTER - ROLLED	FT	47	47							
616-010A	SIGN TYPE B-1	SF	25						25		
616-040J	STEEL SIGN POST E-1	FT	40						40		
626-010A	TEMPORARY TRAFFIC CONTROL SIGNS	SF	85								85
626-035A	BARRICADE TYPE 2	EACH	2								2
626-050A	DRUMS	EACH	20	20							20
630-010A	T.W./S.A PAVEMENT MARKINGS - PREFORMED THERMOPLASTIC	SF	162						162		
S637-10A	AGGREGATE BASE FOR SHARED-USE PATH	TON	684								
S637-15A	PLANT MIX FOR SHARED-USE PATH	TON	364								
S900-50A	CONTINGENCY AMOUNT - MISCELLANEOUS WORK	CA	5000								
S901-05A	SP CONNECT TO EXISTING IRRIGATION BOX	EACH	2		1			1			
S901-05B	SP CONCRETE HEADWALL	EACH	1				1				
S901-05C	SP 12" CANAL GATE (C-10)	EACH	1					1			
S901-05D	SP DETECTABLE WARNING DOMES	EACH	1					1			
S901-05E	SP PERMANENT BARRICADE	EACH	1		1			1			
S904-05A	SP DRAIN BYPASS AND DEWATERING	LS	1								
26+9-05A	MOBILIZATION	LS	1								
S911-05B	36" IRRIGATION PIPE - HDPE SDR 21	FT	1591		440	495	487	199			


NO.	DATE	BY	REVISIONS	DESIGNED	SCALES SHOWN ARE FOR 1" X 17"	 IDAHO TRANSPORTATION DEPARTMENT	 KELLER ASSOCIATES, INC.	PROJECT NO.	ROADWAY SUMMARY	English COUNTY KEY NUMBER 13918 SHEET 8 OF 23	
			DESCRIPTION	DESIGN CHECKED	A. CORLEY						RAIL W/ TRAIL PATHWAY, MERIDIAN A013(918)
				DETAILED	E. HILSLANDER						
					CADD FILE NAME	A. CORLEY					
					DRAWING CHECKED	D. CATHANAN					
					DRAWING DATE:	8/30/25					

STATION TO STATION	IRRIGATION PIPE (LENGTH IN FEET)				PIPE SIZE (INCHES)		METAL PIPE										CONCRETE PIPE		FILL HEIGHT FT.	STR. EXC. C.Y.	COMP. BK.FILL C.Y.	MINOR STRUCTURES					APRONS	INLETS	CATCH BASINS	REMARKS (INDICATE ELONGATION) (WHEN REQUIRED)	
	12"	18"	36"	60"	STEEL PIPE					ALUMINUM PIPE					IRRI- GATION	TYPE OF BEDDING	
					RIBBED POLYETHYLENE (PE)	CORRUGATED POLYETHYLENE (PE)	RIBBED POLYETHYLENE (PVC)	GALVANIZED STEEL	DEPTH " CORRUGATION	LENGTH " CORRUGATION	COATED	ANNULAR CORR.	HELVICAL CORR.	THICK (")			DEPTH " CORRUGATION	LENGTH " CORRUGATION				COATED	ANNULAR CORR.	HELVICAL CORR.	
2+85.71 - 3+88.47																																																																																																																																																																																																																																																																																																																																																																																																																																																																																																																																																																																																																																																																																																																																																																																																																																																																																																																																																																																																																																																																																																																																																																																																																																		

IRRIGATION BOX & 1 MANHOLE SCHEDULE

LABEL NO.	STATION	OFFSET	RIM ELEVATION	SUMP ELEVATION	PIPE NORTH			PIPE SOUTH			PIPE EAST			PIPE WEST		
					SIZE	F.L. ELEVATION	GATE	SIZE	F.L. ELEVATION	GATE	SIZE	F.L. ELEVATION	GATE	SIZE	F.L. ELEVATION	GATE
RR BOX 1	3+91.08	12.25' LT	2598.25	2598.63				36"			36"	2590.63	NO	36"	2590.63	NO
RR BOX 2	6+74.66	13.42' LT	2597.00	2590.10				36"			36"	2591.10	NO	36"	2591.10	NO
RR BOX 3	10+76.17	13.69' LT	2597.00	2590.77				36"			36"	2591.78	NO	36"	2591.77	NO
RR BOX 4	14+77.47	12.83' LT	2597.45	2591.45				36"			36"	2592.45	NO	36"	2592.45	NO
RR BOX 5	17+42.73	48.22' LT	2597.88	2591.88				36"			36"	2592.88	NO	36"	2592.88	NO
RR BOX 6	18+67.21	52.83' LT	2598.41	2592.12	12"	2594.73	YES	36"	2594.41	NO				36"	2593.12	NO
RR BOX 7	18+79.72	14.39' LT	2599.03	2598.99										60"	2590.00	NO
RR BOX 7 CONT.														24"	2590.25	NO
RR MH 1	18+06.01	6.01' LT	2599.02	2591.71										18"	2592.25	NO

REVISIONS NO. DATE BY DESCRIPTION 1 10/20/2018 JA 36" HOPE SDX 21		DESIGNED A. CORLEY DESIGN CHECKED E. HULSLANDER DETAILED A. CORLEY DRAWING CHECKED D. CAIRWATMAN	SCALES SHOWN ARE FOR 11" X 17" PRINTS ONLY CADD FILE NAME DRAWING DATE 8/16/23	IDAHO TRANSPORTATION DEPARTMENT 	PROJECT NO. A013(918)	IRRIGATION PIPE SUMMARY RAIL W/ TRAIL PATHWAY, MERIDIAN	English COUNTY ADA KEY NUMBER 13918 SHEET 9 OF 28
--	--	---	---	---	--------------------------	--	--

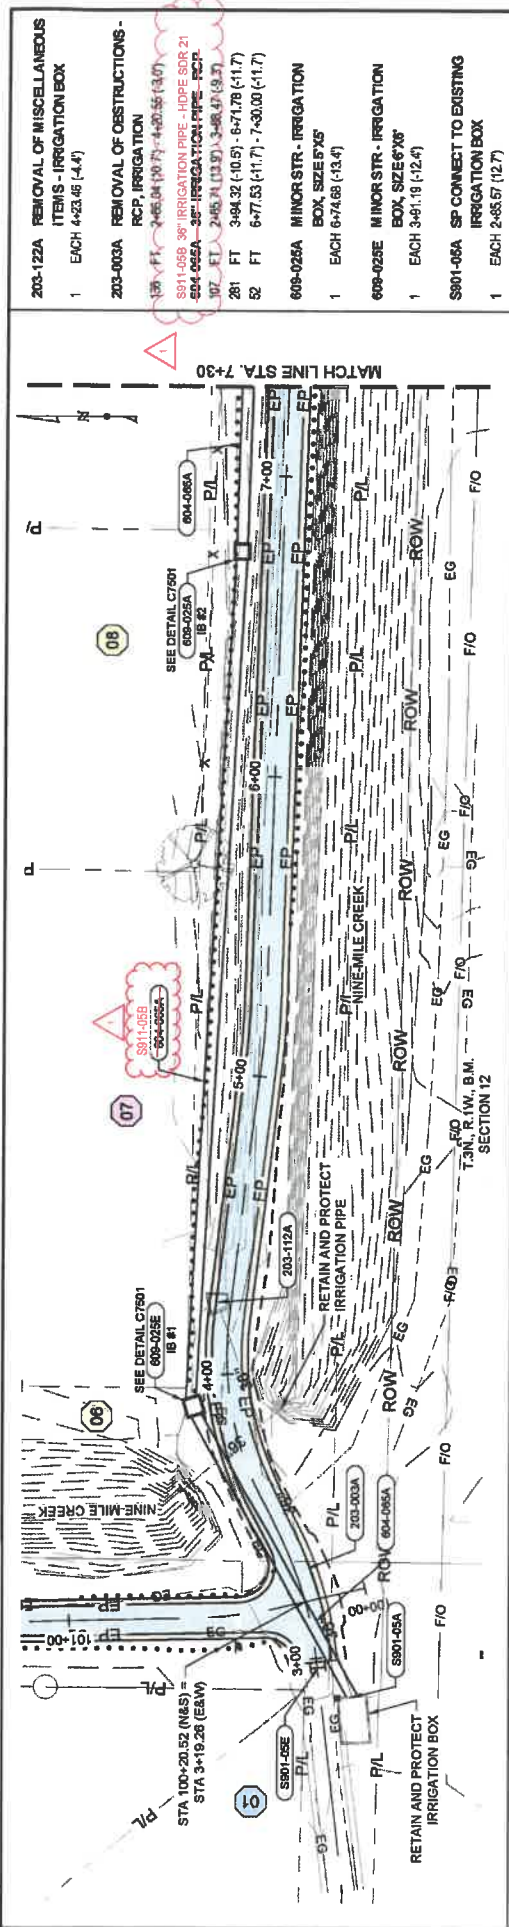

S901-00E SP PERMANENT BARRICADE
1 EACH 2'-6.82' (0.0)


NO.	DATE	BY	DESCRIPTION
1	10/20/20	CA	SP DOTS BOX 11


DESIGNED		SCALES SHOWN ARE FOR 11"x17" PRINTS ONLY	
A. CORLEY	E. HILLISLANDER	CADD FILE NAME	DRAWING DATE: 8/15/25

REVISIONS		PROJECT NO.	
2+50	3+00	6+00	7+30

PLAN AND PROFILE (E&W)		English	
RAIL W/ TRAIL PATHWAY, MERIDIAN		COUNTY ADA	KEY NUMBER 13818

SHEET 12 OF 28

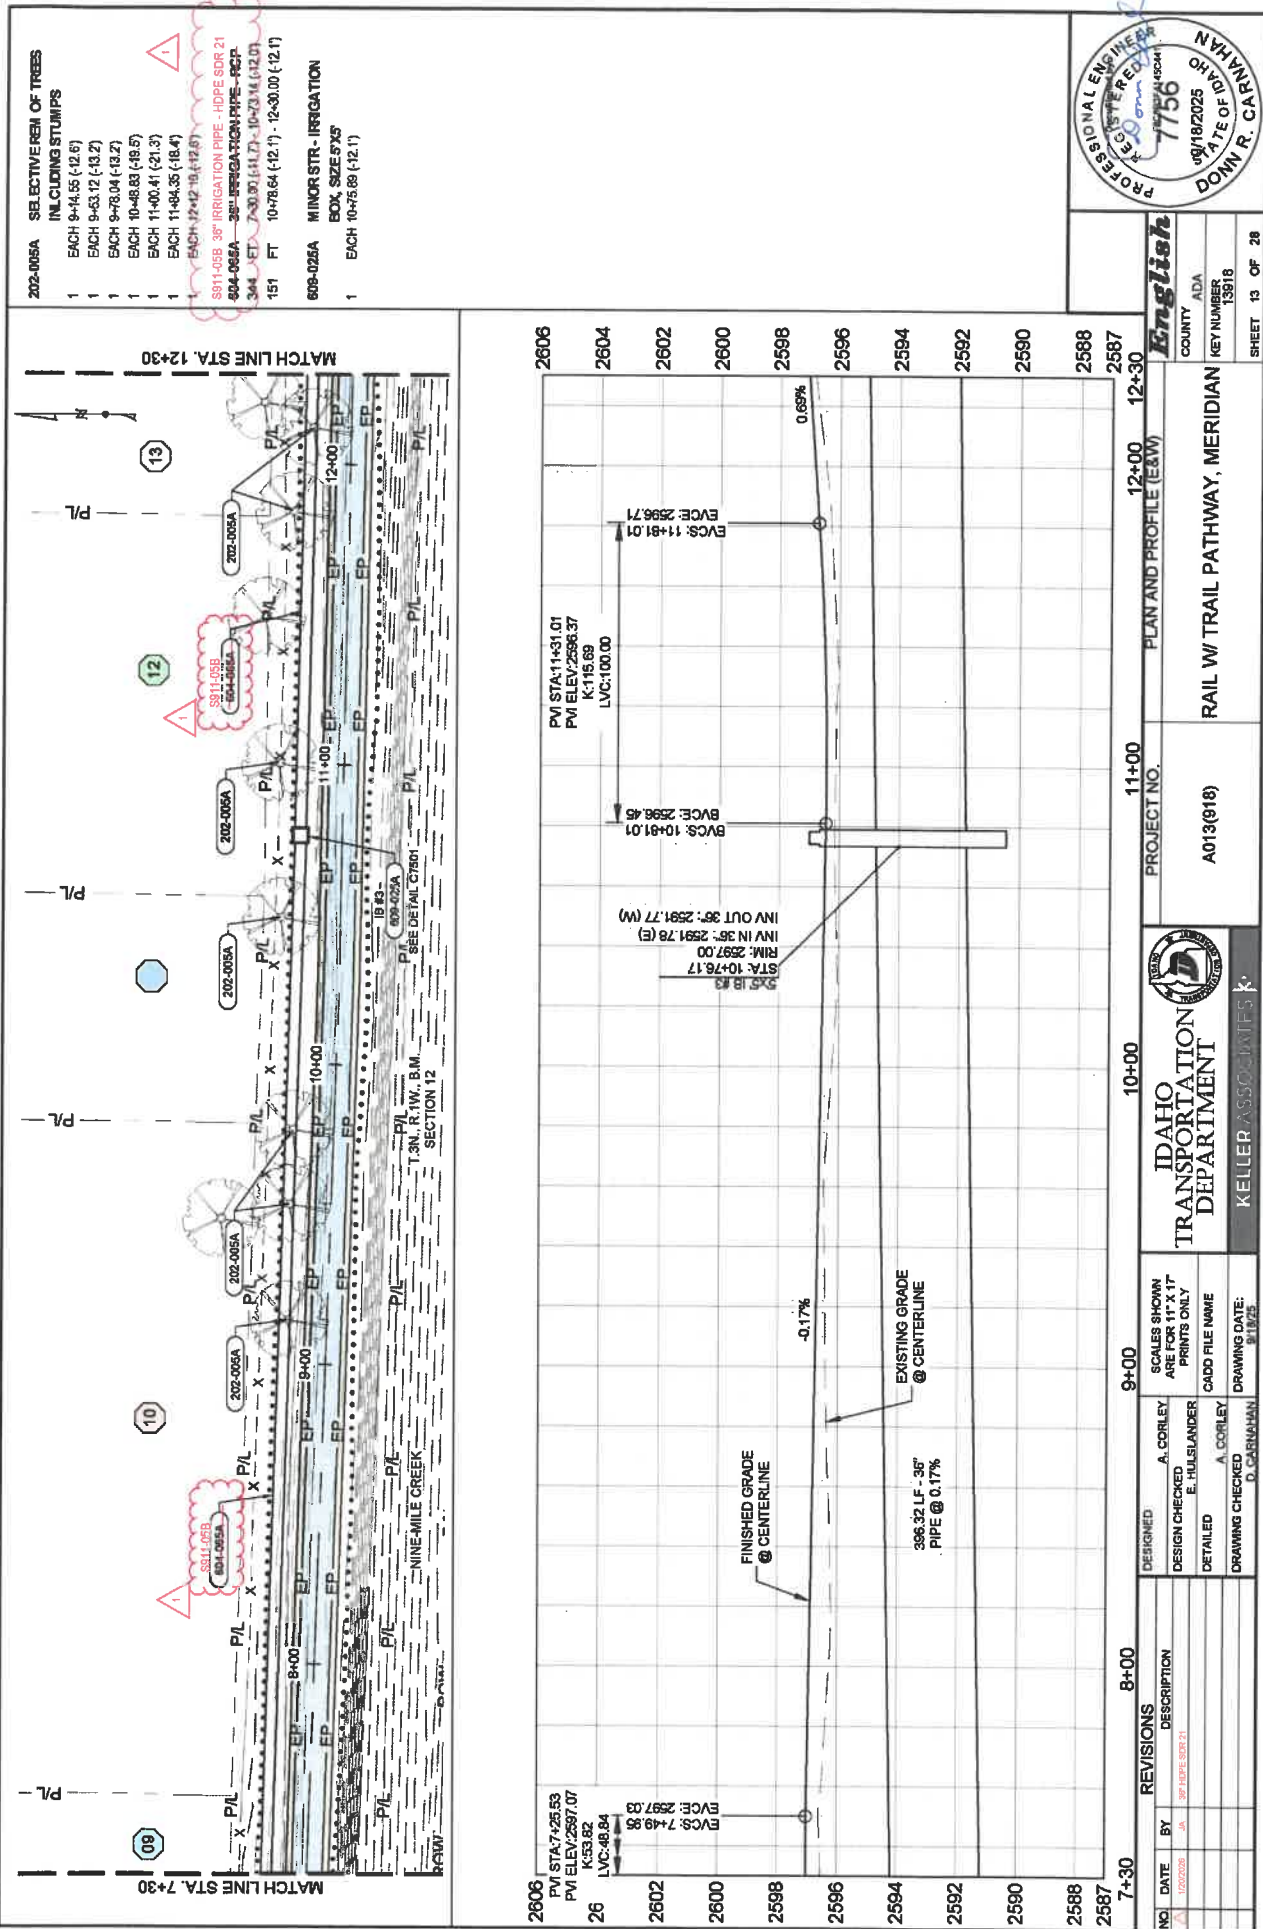

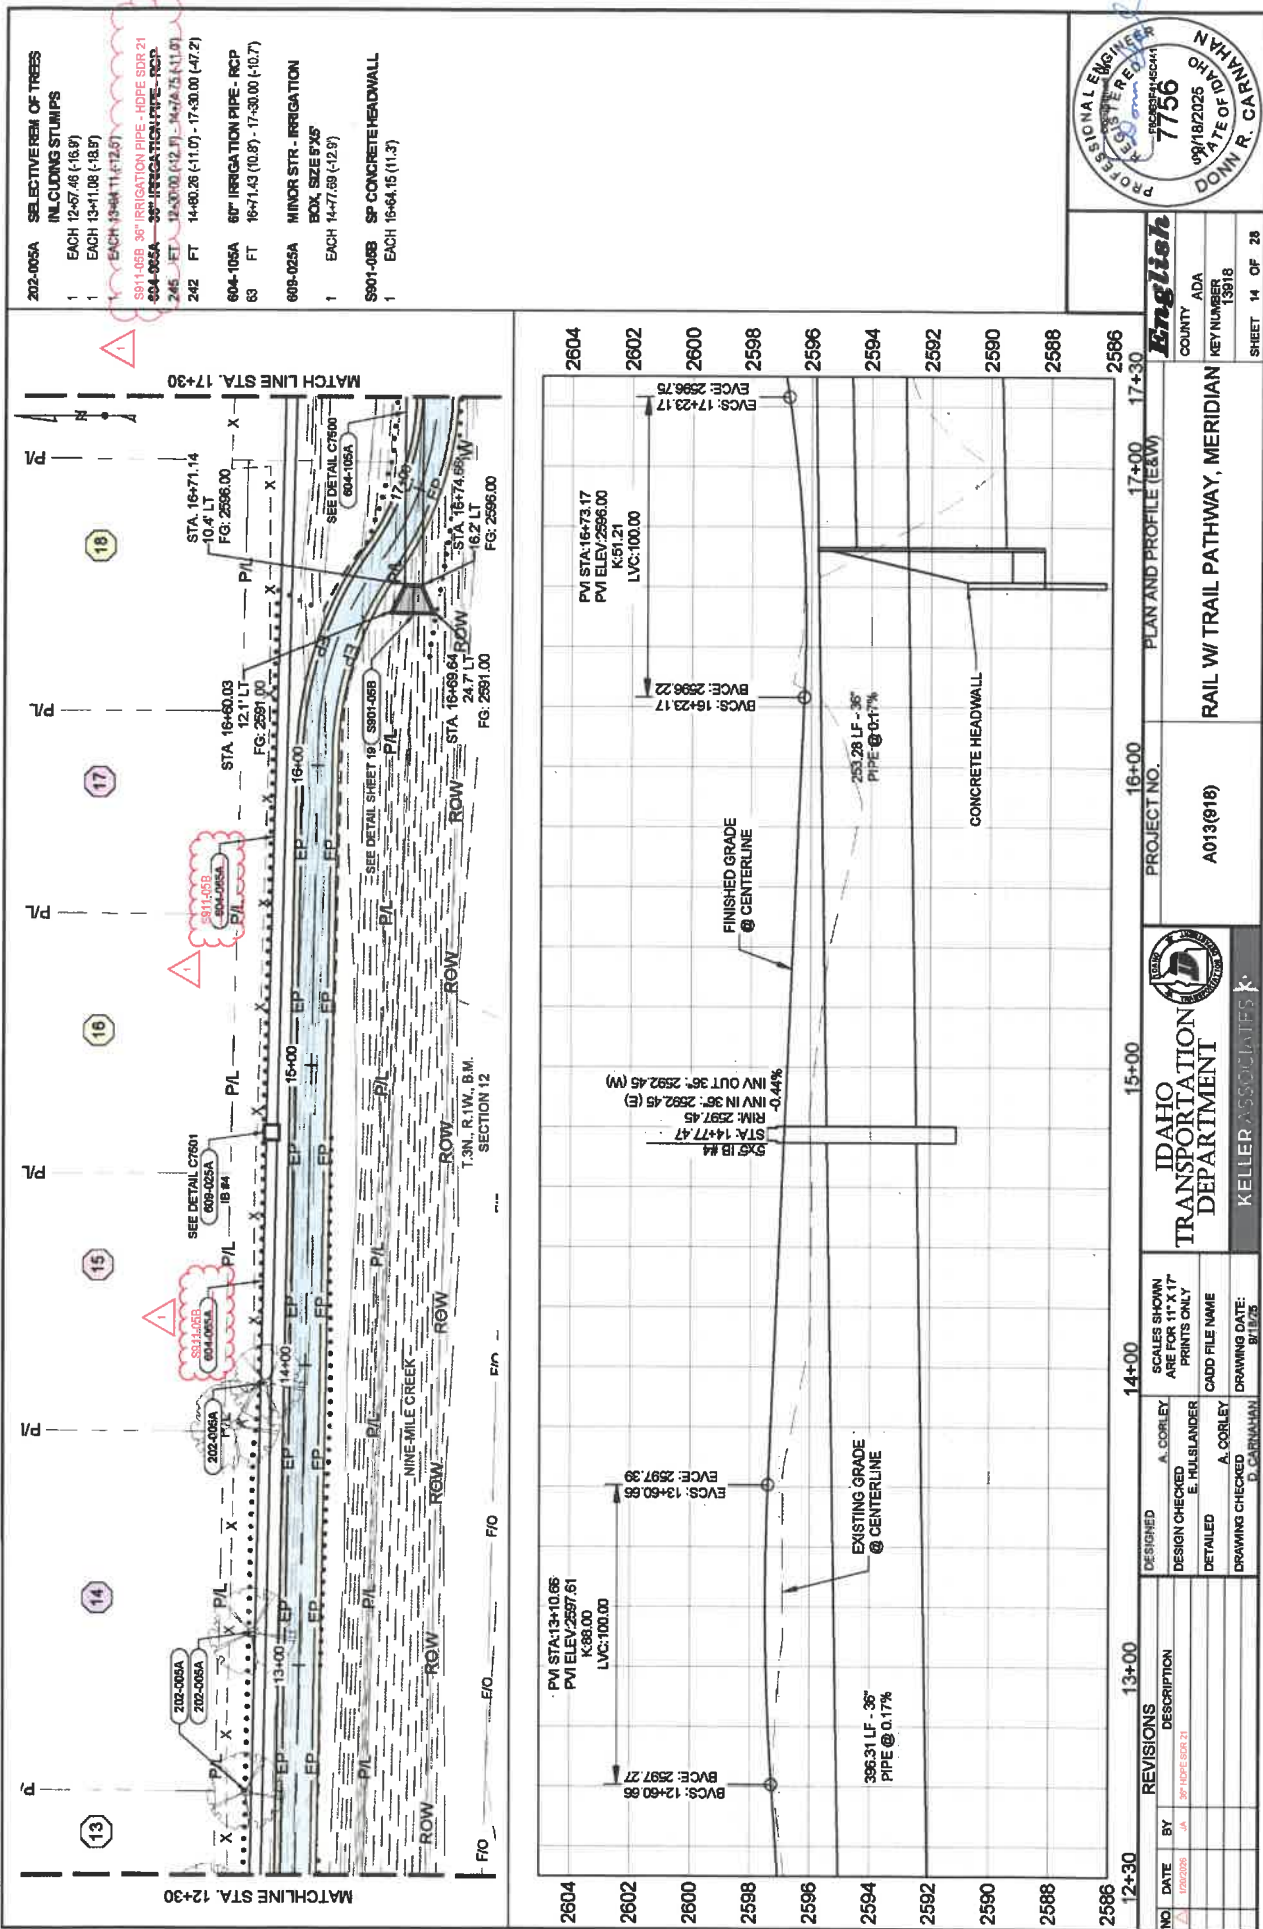

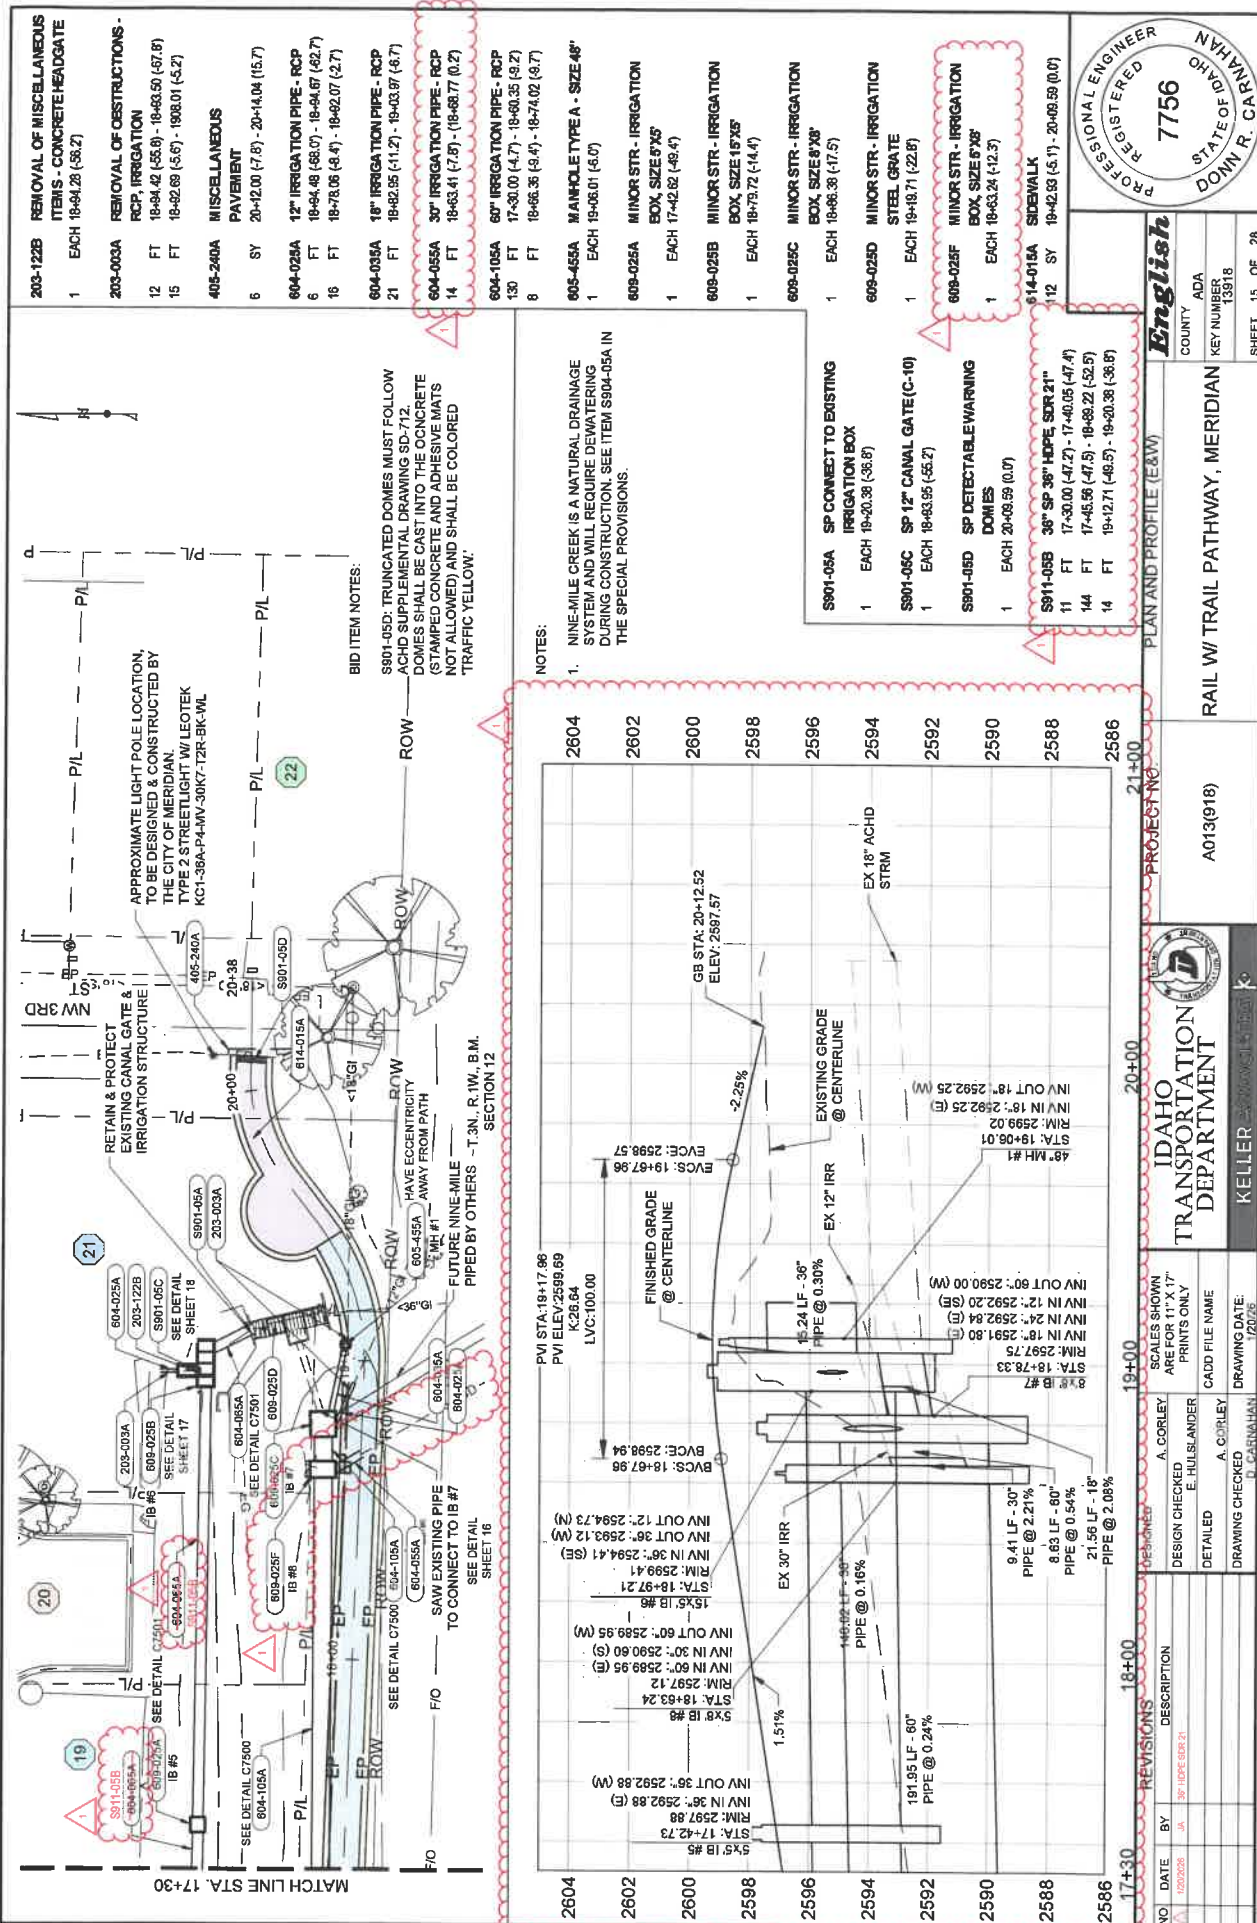


Exhibit 1, page 7