



April 11, 2023  
AVO 37449.004

Ms. Ramie Hammonds  
Development Services Director/Building Official  
City of Sanger  
201 Bolivar Street  
P.O. Box 1729  
Sanger, Texas 76266

**Re: Palomino Bay Addition – Drainage Study in support of the Preliminary Plat  
Second Review**

Dear Ms. Hammonds,

Halff Associates, Inc. was requested by the City of Sanger to provide a review of the drainage study and downstream assessment in support of the preliminary plat for the Palomino Bay development. The drainage study prepared Eikon Architects and Engineers was received on September 27, 2022. First review comments were provided on October 24, 2022. A second submittal was received on November 28<sup>th</sup>, 2022 and comments were provide on December 14, 2022. A third submittal was received on March 29, 2023.

We have completed our 3<sup>rd</sup> review and offer the following comments. Please refer to the Denton County Subdivision Rules and Regulations dated July 2009 for drainage criteria; hereafter referred to as Criteria Manual.

**General:**

1. 1<sup>st</sup> /2<sup>nd</sup> /3<sup>rd</sup> Review Comment: Plans and plat are reviewed separately. Please note an accepted drainage study is required prior to plat acceptance.  
1<sup>st</sup> Review Response: An applicable drainage study as required per the current Denton County Subdivision Rules and Regulations as outlined in Section VII – Chapter IV will be provided prior to the final plat application.  
2<sup>nd</sup> Review Comment: A drainage study needs to be completed prior to plat acceptance.  
2<sup>nd</sup> Review Response: The proposed drainage analyses/plans are illustrated in the recently submitted civil engineering plans. The design has been coordinated with Denton County development services on the application and intent of the Denton County Drainage design standards. The County is available to meet to discuss their drainage design requirements, including intent and application. Please let us know if we can set up a meeting with the County.
2. 1<sup>st</sup> /2<sup>nd</sup> /3<sup>rd</sup> Review Comment: Please address comments on attached markups and provide annotated responses on markups.  
1<sup>st</sup> Review Response: Responses are on the markups  
2<sup>nd</sup> Review Comment: Please provide annotated responses with next submittal  
2<sup>nd</sup> Review Response: The responses are on the markups. Please see the final civil engineering plans.  
3<sup>rd</sup> Review Comment: It appears the annotated responses included are for review #1.

3. Development is located adjacent to the Lake Ray Roberts flowage easement (elevation 645.5). Please coordinate with USACE to obtain permission regarding runoff and velocities into the flowage easement.

1<sup>st</sup> Review Response: A meeting with USACE occurred on 11/10/22. USACE acceptable with layout as long as velocities at or below 5 fps in final engineering plans.

2<sup>nd</sup> /3<sup>rd</sup> Review Comment: **Noted. Please ensure velocities reaching the flowage easements are less than 5cfs. Provide cross sections with hydraulic parameters to verify.**

2<sup>nd</sup> Review Response: On November 10th, 2022 an in-person meeting was held at the Lake Lewisville office of USACE to discuss this comment. Among the meeting attendees were by Rob Jordan (USACE), Kevin Ware, Gary Hazlewood (Westwood), and Clint Baker (Westwood). The USACE instructed that they are acceptable with the layout as long as the velocities are at or below 5 feet-per-second in the final engineering plans.

3<sup>rd</sup> Review Comment: **Provide RAS model for proposed channels. Include existing condition cross sections at and downstream of proposed channel to establish backwater and to analyze transition and transitional velocities. Include velocity analysis for the 2, 5, 10, 25, and 100-yr flood events and required by the Criteria manual Section IV.1.5.**

4. 1<sup>st</sup> / 2<sup>nd</sup> /3<sup>rd</sup> Review Comment: The FEMA floodplain appears shifted on exhibits and plat. Please verify and update as needed. Any activity within the FEMA floodplain will require an approved floodplain development permit.

1<sup>st</sup> Review Response: No grading activities are planned to occur within 100-year FEMA floodplain or the USACE flowage easement.

2<sup>nd</sup> Review Comment: Comment not addressed; it appears FEMA floodplain is drawn incorrectly on plans. A section of FEMA floodplain appears to reach development. Please note, any activity within the FEMA floodplain will required an FDP; provide prior to grading permit.

2<sup>nd</sup> Review Response: The FEMA mapped floodplain limits do not always match the on the ground elevations. No grading activities are planned to occur within in the 100-year FEMA floodplain or the USACE flowage easements, which is illustrated on the final civil engineering plans.

3<sup>rd</sup> Review Comment: (a) Verify FEMA floodplain, it appears shifted. Based on digital FEMA files, Zone AE is closer to contour shapes; see DA map markup. (b) Show and label USACE flowage easement or plat and grading sheets; typically, at a contour elevation (ie 645.5). (c)

5. 1<sup>st</sup> and 2<sup>nd</sup> Review Comment: Please include the following on the final plat: (a) Lake Ray Roberts flowage easement, (b) floodplain easement based on Lake Ray Roberts fully developed 100-yr elevation + 10', (c) provide minimum finished floor elevations 2' above fully developed 100-yr water surface elevation; base Min FFE on the higher 100-yr fully developed floodplain for lake or proposed channel. (d) update drainage easements based on comments (e) provide any additional drainage easement at roadside ditches to encompass the fully developed 100-yr floodplain.

1<sup>st</sup> Review Response: Designers acknowledge these requirements for final plat.

2<sup>nd</sup> Review Comments: Noted. Please address (a) and (b) and provide preliminary DE sizes for preliminary plat (comments d and e).

2<sup>nd</sup> Review Response:

(a) Please see final civil engineering plans/ final plat.

(b) The minimum finish floor elevations are 2' above (647.00) the verified (with the USACE) 100-year water surface elevation of Lake Ray Roberts, which is 645.00'.

20' drainage easements are provided in most places. Please provide the code requirements for 10' of additional easement past the channel banks. Per discussions with the City and City Engineer, normal depth calculations for water depth in channel is acceptable. The county does allow the HGL to extend past the ROW if a drainage easement is in place.

3<sup>rd</sup> Review Comment: (a) Show flowage easement; see markups.

(b) Please provide source of fully developed 100-yr elevation for the Lake.

For lots adjacent to channels, the Min FFE must be 2' above channels fully developed 100-yr water surface elevation. Use upstream cross section. The rest can be based on the Lake's fully developed 100-yr elevation.

(c) Access for maintenance is required for all channels; 10' on each side (Chapter 10 Section 10.105 (5) Easements.

(d) Update drainage easements based on comments

(e) Provide any additional drainage easement at roadside ditches to encompass the fully developed 100-yr floodplain.

6. 1<sup>st</sup> /2<sup>nd</sup> Review Comment: Please note, additional comments may result once additional info is provided.

1<sup>st</sup> Review Response: Designers acknowledged.

3<sup>rd</sup> Review Comment: Please address markups and provide annotated responses. Please note Please note, not all comments are provided on the letter since some comments are easier to show and explain on the markups.

### **Hydrology and Hydraulics:**

7. 1<sup>st</sup> and 2<sup>nd</sup> Review Comment: Please provide a separate proposed drainage area map, show proposed development footprint, proposed contours and provide flow calculations. Include 100-yr fully developed flow calculations.

1<sup>st</sup> Review Response: An incomplete drainage study with map was included.

2<sup>nd</sup> Review Comments: Please addressed comments on proposed drainage area map and provide annotated responses.

2<sup>nd</sup> Review Response: Please see final civil engineering plans. Grading is mostly limited to the right of way and drainage easements. These are 2 acre lots. Any grading on the lots will occur once the lots are purchased and the home sites are designed.

3<sup>rd</sup> Review Comments: Please addressed comments on proposed drainage area map and provide annotated responses.

8. 1<sup>st</sup>/2<sup>nd</sup> /3<sup>rd</sup> Review Comment: Provide a comparison of existing and proposed flows, water surface elevations and velocities at each site outfall.

1<sup>st</sup> Review Response: Designers stated that all detailed calculations will be provided with the detailed engineering plans.

2<sup>nd</sup> Review Comments: There is insufficient information provided to review. Please provide with next submittal.

2<sup>nd</sup> Review Response: Please see the final civil engineering plans. Per discussions with the City and City Engineer, normal depth calculations for water depth in channel is acceptable. Per discussions with the City and City Engineer using FWHA HDS-5 is an acceptable tool to

computer culvert hydraulics. The design has been coordinated with Denton County development services on application and intent of the Denton County Drainage design standards.

3<sup>rd</sup> Review Comment: Comment refers to existing and proposed flow comparison. Please provide. Address comments on DA maps and provide annotated responses.

9. 1<sup>st</sup> and 2<sup>nd</sup> Review Comment: What is the plan to mitigate increases on flow, water surface elevations and velocity? If obtaining permission for increases from adjacent owner, please provide documentation; include exhibits and calculations.

1<sup>st</sup> Review Response: Designers stated that all detailed calculations will be provided with the detailed engineering plans.

2<sup>nd</sup> Review Comments: There is insufficient information provided to review. Please address with next submittal. Adverse impact analysis must be addressed with drainage study in support of preliminary plat.

2<sup>nd</sup> Review Response: Since the USCOE/Lake Ray Roberts is the majority adjacent landowner, on November 10th, 2022 an in-person meeting was held at the at the Lake Lewisville office of USACE to discuss this comment. Among the meeting attendees were by Rob Jordan (USACE), Kevin Ware, Gary Hazlewood (Westwood), and Clint Baker (Westwood). USACE instructed that they are acceptable with the layout as long as the velocities are at or below 5 feet-per-second, which is illustrated in the final engineering plans.

3<sup>rd</sup> Review Comment: (a) Please provide documentation/permission regarding runoff and velocities into adjacent property (b) Please ensure velocities reaching the flowage easements and/or USACE property are less than 5cfs

10. 1<sup>st</sup> and 2<sup>nd</sup> Review Comment: Indicate landuse for selected runoff coefficients for existing, proposed, and ultimate conditions or provide a separate landuse map.

1<sup>st</sup> Review Response: Designers stated that this information is provided on drainage map.

2<sup>nd</sup> Review Comments: The drainage study and map are incomplete. There is insufficient information provided to review. Please provide with next submittal.

2<sup>nd</sup> Review Response: Please see the final civil engineering plans for the landuse map.

3<sup>rd</sup> Review Comment: Please use fully developed conditions for channel/ditches/ and culvert design. Update C values and indicate landuse or provide a separate landuse map.

11. 1<sup>st</sup> /2<sup>nd</sup> /3<sup>rd</sup> Review Comment: Show and label flowage easement on grading sheets and drainage area maps.

1<sup>st</sup> Review Response: Designers stated the information is included.

2<sup>nd</sup> /3<sup>rd</sup> Review Comments: The USACE flowage easement is not shown correctly (i.e., 645.5 msl). Please verify and update as needed.

2<sup>nd</sup> Review Response: Please see the final civil engineering plans for these details.

12. 1<sup>st</sup> / 2<sup>nd</sup> /3<sup>rd</sup> Review Comment: Provide diversion channels to convey and direct offsite runoff to the streets. Please provide channel cross sections with hydraulic parameters for proposed channels. Please note, a HEC-RAS model is required to confirm water surface profiles in channels, roadside ditches and culverts.

1<sup>st</sup> Review Response: Designers stated that all detailed calculations will be provided with the detailed engineering plans.



2<sup>nd</sup> Review Comments: There is insufficient information provided to review. Please provide with next submittal.

2<sup>nd</sup> Review Response: Please see the final civil engineering plans for the updated drainage details illustrating these requirements. Per discussions with the City and City Engineer, normal depth calculations for water depth in channel is acceptable. Per discussions with the City and City Engineer using FWHA HDS-5 is an acceptable tool to computer culvert hydraulics.

3<sup>rd</sup> Review Comment: Refer to comment 15.

13. 1<sup>st</sup> and 2<sup>nd</sup> Review Comment: Provide channels to convey offsite/onsite runoff thru site. Channels must be designed to standards. Please refer to criteria manual Section IV-B and section IV3.4 (trapezoidal, 4:1 SS, 1' freeboard from 100-yr fully developed water surface elevation to top of bank, etc). Provide drainage easements with adequate access; include 10' beyond top of bank on both sides.

1<sup>st</sup> Review Response: Designers stated that all detailed calculations with be provided with the detailed engineering plans.

2<sup>nd</sup> Review Comments: There is insufficient information provided to review. Please provide with next submittal.

2<sup>nd</sup> Review Response: Please see the final civil engineering plans/plat for the proposed designs.

3<sup>rd</sup> Review Comment: Address comments on attached markups and provide annotated responses.

14. 1<sup>st</sup>/ 2<sup>nd</sup> /3<sup>rd</sup> Review Comment: Provide preliminary size of proposed culverts. Please note, a RAS model will be required for culverts to confirm backwater, headwater and freeboard.

1<sup>st</sup> Review Response: Designers stated that preliminary culvert sizes have been added, and that all detailed calculations with be provided with the detailed engineering plans.

2<sup>nd</sup> Review Comments: There is insufficient information provided to review. Please provide with next submittal.

2<sup>nd</sup> Review Response: Please see the final civil engineering plans for these details. Per discussions with the City and City Engineer, normal depth calculations for water depth in channel is acceptable. Per discussions with the City and City Engineer using FWHA HDS-5 is an acceptable tool to computer culvert hydraulics.

3<sup>rd</sup> Review Comment: Address comments on attached markups and provide annotated responses.

**Address the following comments with future drainage study to support final plat and construction plans:**

15. 1<sup>st</sup>-3<sup>rd</sup> Review Comment: Provide RAS model for all proposed channels and culverts. Verify proposed channels contain the fully developed 100-yr flow with 1' freeboard. Use  $n=.04$  for earthen channel. Include a RAS workmap or add RAS cross sections to the grading plans. Extend RAS model downstream of property line to establish backwater.

2<sup>nd</sup> Review Response: Please see the final civil engineering plans for these details. Per discussions with the City and City Engineer, normal depth calculations for water depth in channel is acceptable. Per discussions with the City and City Engineer using FWHA HDS-5 is an acceptable tool to computer culvert hydraulics. The design has been coordinated with Denton County development services on application and intent of the Denton County Drainage design standards.

3<sup>rd</sup> Review Comments: Please provide RAS models per Criteria. RAS is needed to accurately model backwater, transitions, and velocities (ie. mixed flow regime for steep channels). This may be waived on a case by case basis; however, for this project this has not been discussed. It appears a RAS model will be needed for this case.

Please address comments on attached markups and provide annotated responses. Refer to sheet C-12 and 13.

16. 1<sup>st</sup>-3<sup>rd</sup> Review Comment: Provide RAS model for all proposed roadside ditches (Criteria Manual Section IV.3.4). Include proposed culverts and driveway culverts and verify the 100-yr fully developed flow is contained within the right of way. If not contained within ROW, additional DE must be dedicated to contain the fully developed 100-yr water surface elevation.  
2<sup>nd</sup> Review Response: Please see the final civil engineering plans for these details. Per discussions with the City and City Engineer, normal depth calculations for water depth in channel is acceptable. Per discussions with the City and City Engineer using FWHA HDS-5 is an acceptable tool to computer culvert hydraulics.  
3<sup>rd</sup> Review Comments: Please provide RAS models per Criteria. RAS is needed to accurately model backwater caused by driveways. 100-yr HGL must reflect the effects of backwater from driveway culverts.
17. 1<sup>st</sup>-3<sup>rd</sup> Review Comment: Show and label proposed driveway culvert on street plan and profile. Include 100-yr HGL. Please use a min of 15". Design driveway culvert to pass the fully developed 100-yr flood event. Use RAS to evaluate backwater and tailwater at proposed culverts.  
2<sup>nd</sup> Review Response: These are 2 acre lots where the driveway location will not be determined until the house location is sited. Denton County requires culvert calculations at the time of the building permit.  
3<sup>rd</sup> Review Comments: Typically for all projects with rural streets, the location of driveway is unknown and must be assumed. Roadside ditches must convey the fully developed 100-yr flow. 100-yr HGL must reflect the effects of backwater from driveway culverts. A RAS model will be required to evaluate water surface profiles in ditches. Include driveway culverts and verify 100-yr HGL is contained within the ROW. (section IV.3.4). Once all backwater effect are analyzed, additional DE may be required to contain the fully developed 100-yr flows
18. 1<sup>st</sup>-3<sup>rd</sup> Review Comment: Provide Plan and profile for all proposed channels. Show and label the fully developed 100-yr water surface profile and left and right top of bank; verify 1' freeboard. Include culverts and verify 1' freeboard to top of road.  
2<sup>nd</sup> Review Response: Please see the final civil engineering plans for these details.  
3<sup>rd</sup> Review Comment: Address comments on attached markups and provide annotated responses.
19. 1<sup>st</sup>-3<sup>rd</sup> Review Comment: Provide side yard swales to direct lot flows to the roads. Directing flow to adjacent lots is not allowed.  
2<sup>nd</sup> Review Response: Please see final civil engineering plans. Grading is mostly limited to the right of way and drainage easements. These are 2 acre lots. Any grading on the lots to occur once lot is purchased and home sites are designed.

April 11, 2023

Page 7 of 7

3<sup>rd</sup> Review Comment: Provide a typical cross section for the side yard swales to direct flows to roads. Include dimensions, depth, lot line, hydraulic parameters, etc. (b) Include flow arrows for side yard swales on grading sheets.

20. Verify that a USACE Section 404 of Clean Water Act investigation was/will be conducted. Placement of fill or realignment of existing channels may require authorization by an appropriate Section 404 permit. Provide results of investigation. Show and label any wetlands and/or Water of the US on grading plans.

2<sup>nd</sup> Review Response: Eikon has completed a larger sitewide wetlands/waters of the US evaluation on the entirety of the property, but for this first phase, there are no proposed grading areas that affect Wetlands/USCOE areas. Eikon is coordinating with the USCOE on these matters.

3<sup>rd</sup> Review Comment: Please provide results of investigation and mark any WOUS on grading sheets.

The Engineer shall revise the hydrologic study and/or plans in accordance with the above comments and/or provide a written response that addresses each comment. If you have any questions or need additional information, please do not hesitate to call me at (817) 764-7466.

Sincerely,


**HALFF ASSOCIATES, INC.**

Firm No. 0312



Emilia Yanagi, P.E., CFM

Drainage Review Consultant for the City of Sanger

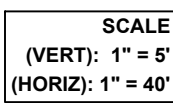

TDLR #

Issued Date: 03-15-2023  
Project No: EIK052622E-2

Drawn By:	MP/MD
Checked By:	SG
Designed By:	MP/MD
Issue Record	
#	Description
	Date

[illegible]


## DESIGN PHASE

PAVING PLAN I

**C-06**




EXISTING TIME OF CONCENTRATION CALCULATIONS																	
1		2					3				4					5	7
		SHEET FLOW					SHALLOW CONCENTRATED FLOW				CHANNEL FLOW						
Basin Area Designation	Sub-basins	Sheet Flow Length (ft)	P <sub>2</sub> (in)	Land Slope (ft/ft)	n	t <sub>sheet</sub> (min)	Shallow Flow Length (ft)	Shallow Flow Slope (ft/ft)	Shallow Flow Velocity (ft/sec)	t <sub>shallow</sub> (min)	Channel Length (ft)	Channel Slope (ft/ft)	n	Average Velocity (ft/sec)	t <sub>channel</sub> (min)	Computed t <sub>c</sub> (min)	Design* t <sub>c</sub> (min)
Palomino Bay - EXISTING CONDITIONS																	
A		50	3.36	0.041	0.15	4.14	648	0.022	2.41	4.48		0.0085	0.03	4	0	8.62	15.00
B	B-1, B-2	50	3.36	0.010	0.15	7.25	737	0.018	2.17	5.66	470	0.0085	0.03	4	1.9583	14.87	15.00
C	C-1, C-2	50	3.36	0.005	0.15	9.56	1726	0.152	6.29	4.57	176	0.0085	0.03	4	0.7333	14.87	15.00
D		50	3.36	0.044	0.15	4.02	576	0.034	2.98	3.22		0.0085	0.03	4	0	7.24	15.00
E		50	3.36	0.056	0.15	3.64	810	0.033	2.93	4.61		0.0085	0.03	4	0	8.25	15.00
F		50	3.36	0.006	0.15	8.77	558	0.041	3.27	2.85		0.0085	0.03	4	0	11.62	15.00
G		50	3.36	0.004	0.15	10.25	376	0.036	3.06	2.05		0.0085	0.03	4	0	12.30	15.00

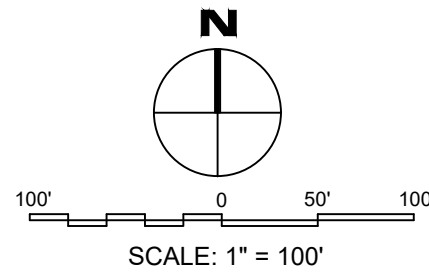

Show and label flowage easement (typically at contour elevation; ie 645.5)

Palomino Bay Runoff Calculations																
Pre Development Drainage Area Calculations (2, 5, 10, 25, 50 and 100-Year Design Frequency)																
1	2	3	4	5	6	7.0	8	9.0	10	11.0	12	13.0	14	15.0	16	17.0
Area Designation	Area (acres)	Runoff Coefficient C	CA	Total Tc* (Min)	Runoff Q <sub>2</sub> (cfs)	Runoff Q <sub>5</sub> (cfs)	Runoff Q <sub>10</sub> (cfs)	Runoff Q <sub>25</sub> (cfs)	Runoff Q <sub>50</sub> (cfs)	Runoff Q <sub>100</sub> (cfs)	Runoff Q <sub>2</sub> (cfs)	Runoff Q <sub>5</sub> (cfs)	Runoff Q <sub>10</sub> (cfs)	Runoff Q <sub>25</sub> (cfs)	Runoff Q <sub>50</sub> (cfs)	Runoff Q <sub>100</sub> (cfs)
ONSITE																
A	5.63	0.30	1.69	15.0	3.9	6.6	4.85	8.2	5.50	9.3	6.41	10.8	7.14	12.1	7.91	13.4
B-1	4.76	0.30	1.43	15.0	3.9	5.6	4.85	6.9	5.50	7.9	6.41	9.2	7.14	10.2	7.91	11.3
B-2	7.66	0.30	2.30	15.0	3.9	9.0	4.85	11.1	5.50	12.6	6.41	14.7	7.14	16.4	7.91	18.2
C-1	6.85	0.30	2.06	15.0	3.9	8.0	4.85	10.0	5.50	11.3	6.41	13.2	7.14	14.7	7.91	16.3
C-2	8.54	0.30	2.56	15.0	3.9	10.0	4.85	12.4	5.50	14.1	6.41	16.4	7.14	18.3	7.91	20.3
D	5.77	0.30	1.73	15.0	3.9	6.8	4.85	8.4	5.50	9.5	6.41	11.1	7.14	12.4	7.91	13.7
E	12.97	0.30	3.89	15.0	3.9	15.2	4.85	18.9	5.50	21.4	6.41	24.9	7.14	27.8	7.91	30.8
F	5.22	0.30	1.57	15.0	3.9	6.1	4.85	7.6	5.50	8.6	6.41	10.0	7.14	11.2	7.91	12.4
G	8.73	0.30	2.62	15.0	3.9	10.2	4.85	12.7	5.50	14.4	6.41	16.8	7.14	18.7	7.91	20.7
OS-1	3.67	0.30	1.10	15.0	3.9	4.3	4.85	5.3	5.50	6.1	6.41	7.1	7.14	7.9	7.91	8.7
OS-2	7.90	0.30	2.37	15.0	3.9	9.2	4.85	11.5	5.50	13.0	6.41	15.2	7.14	16.9	7.91	18.7

Provide to calculations. Update those larger than 15min

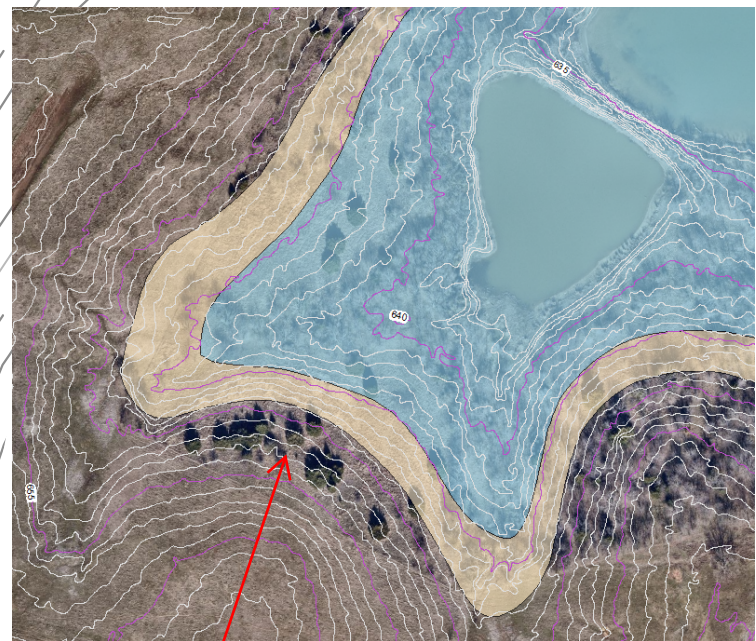


Appears shifted. Based on digital FEMA files, Zone AE is closer to contour shapes.

Show and label flowage easement (typically at contour elevation; ie 645.5)

#### LEGEND

- EXISTING MINOR CONTOUR LINE
- EXISTING MAJOR CONTOUR LINE
- MAJOR DRAINAGE AREA
- MINOR DRAINAGE AREA
- TIME OF CONCENTRATION
- PROPERTY LINE
- DRAINAGE FLOW ARROW

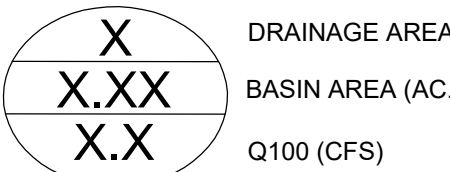

NOTE: DRAINAGE BASIN DELINEATION AND FLOW PATHS DETERMINED WITH ON THE GROUND TOPOGRAPHIC DATA AND FIELD VISITS.

THIS DOCUMENT IS RELEASED FOR THE PURPOSE OF INTERIM REVIEW UNDER THE AUTHORITY OF KEVIN J. WARE (TEXAS P.E. NO. 136599), ON 3/15/2023. IT IS NOT TO BE USED FOR CONSTRUCTION, BIDDING OR PERMIT PURPOSES.

TDLR #

**NOT FOR CONSTRUCTION IN PROGRESS**

Drawn By:	MP/MD
Checked By:	SG
Designed By:	MP/MD
Issue Record	
#	Description
	Date

DESIGN PHASE

EXISTING DRAINAGE MAP

**C-10**




CONFIDENTIAL & PROPRIETARY ©2022 EIKON Consulting Group - do not duplicate without permission

D

C

B

A

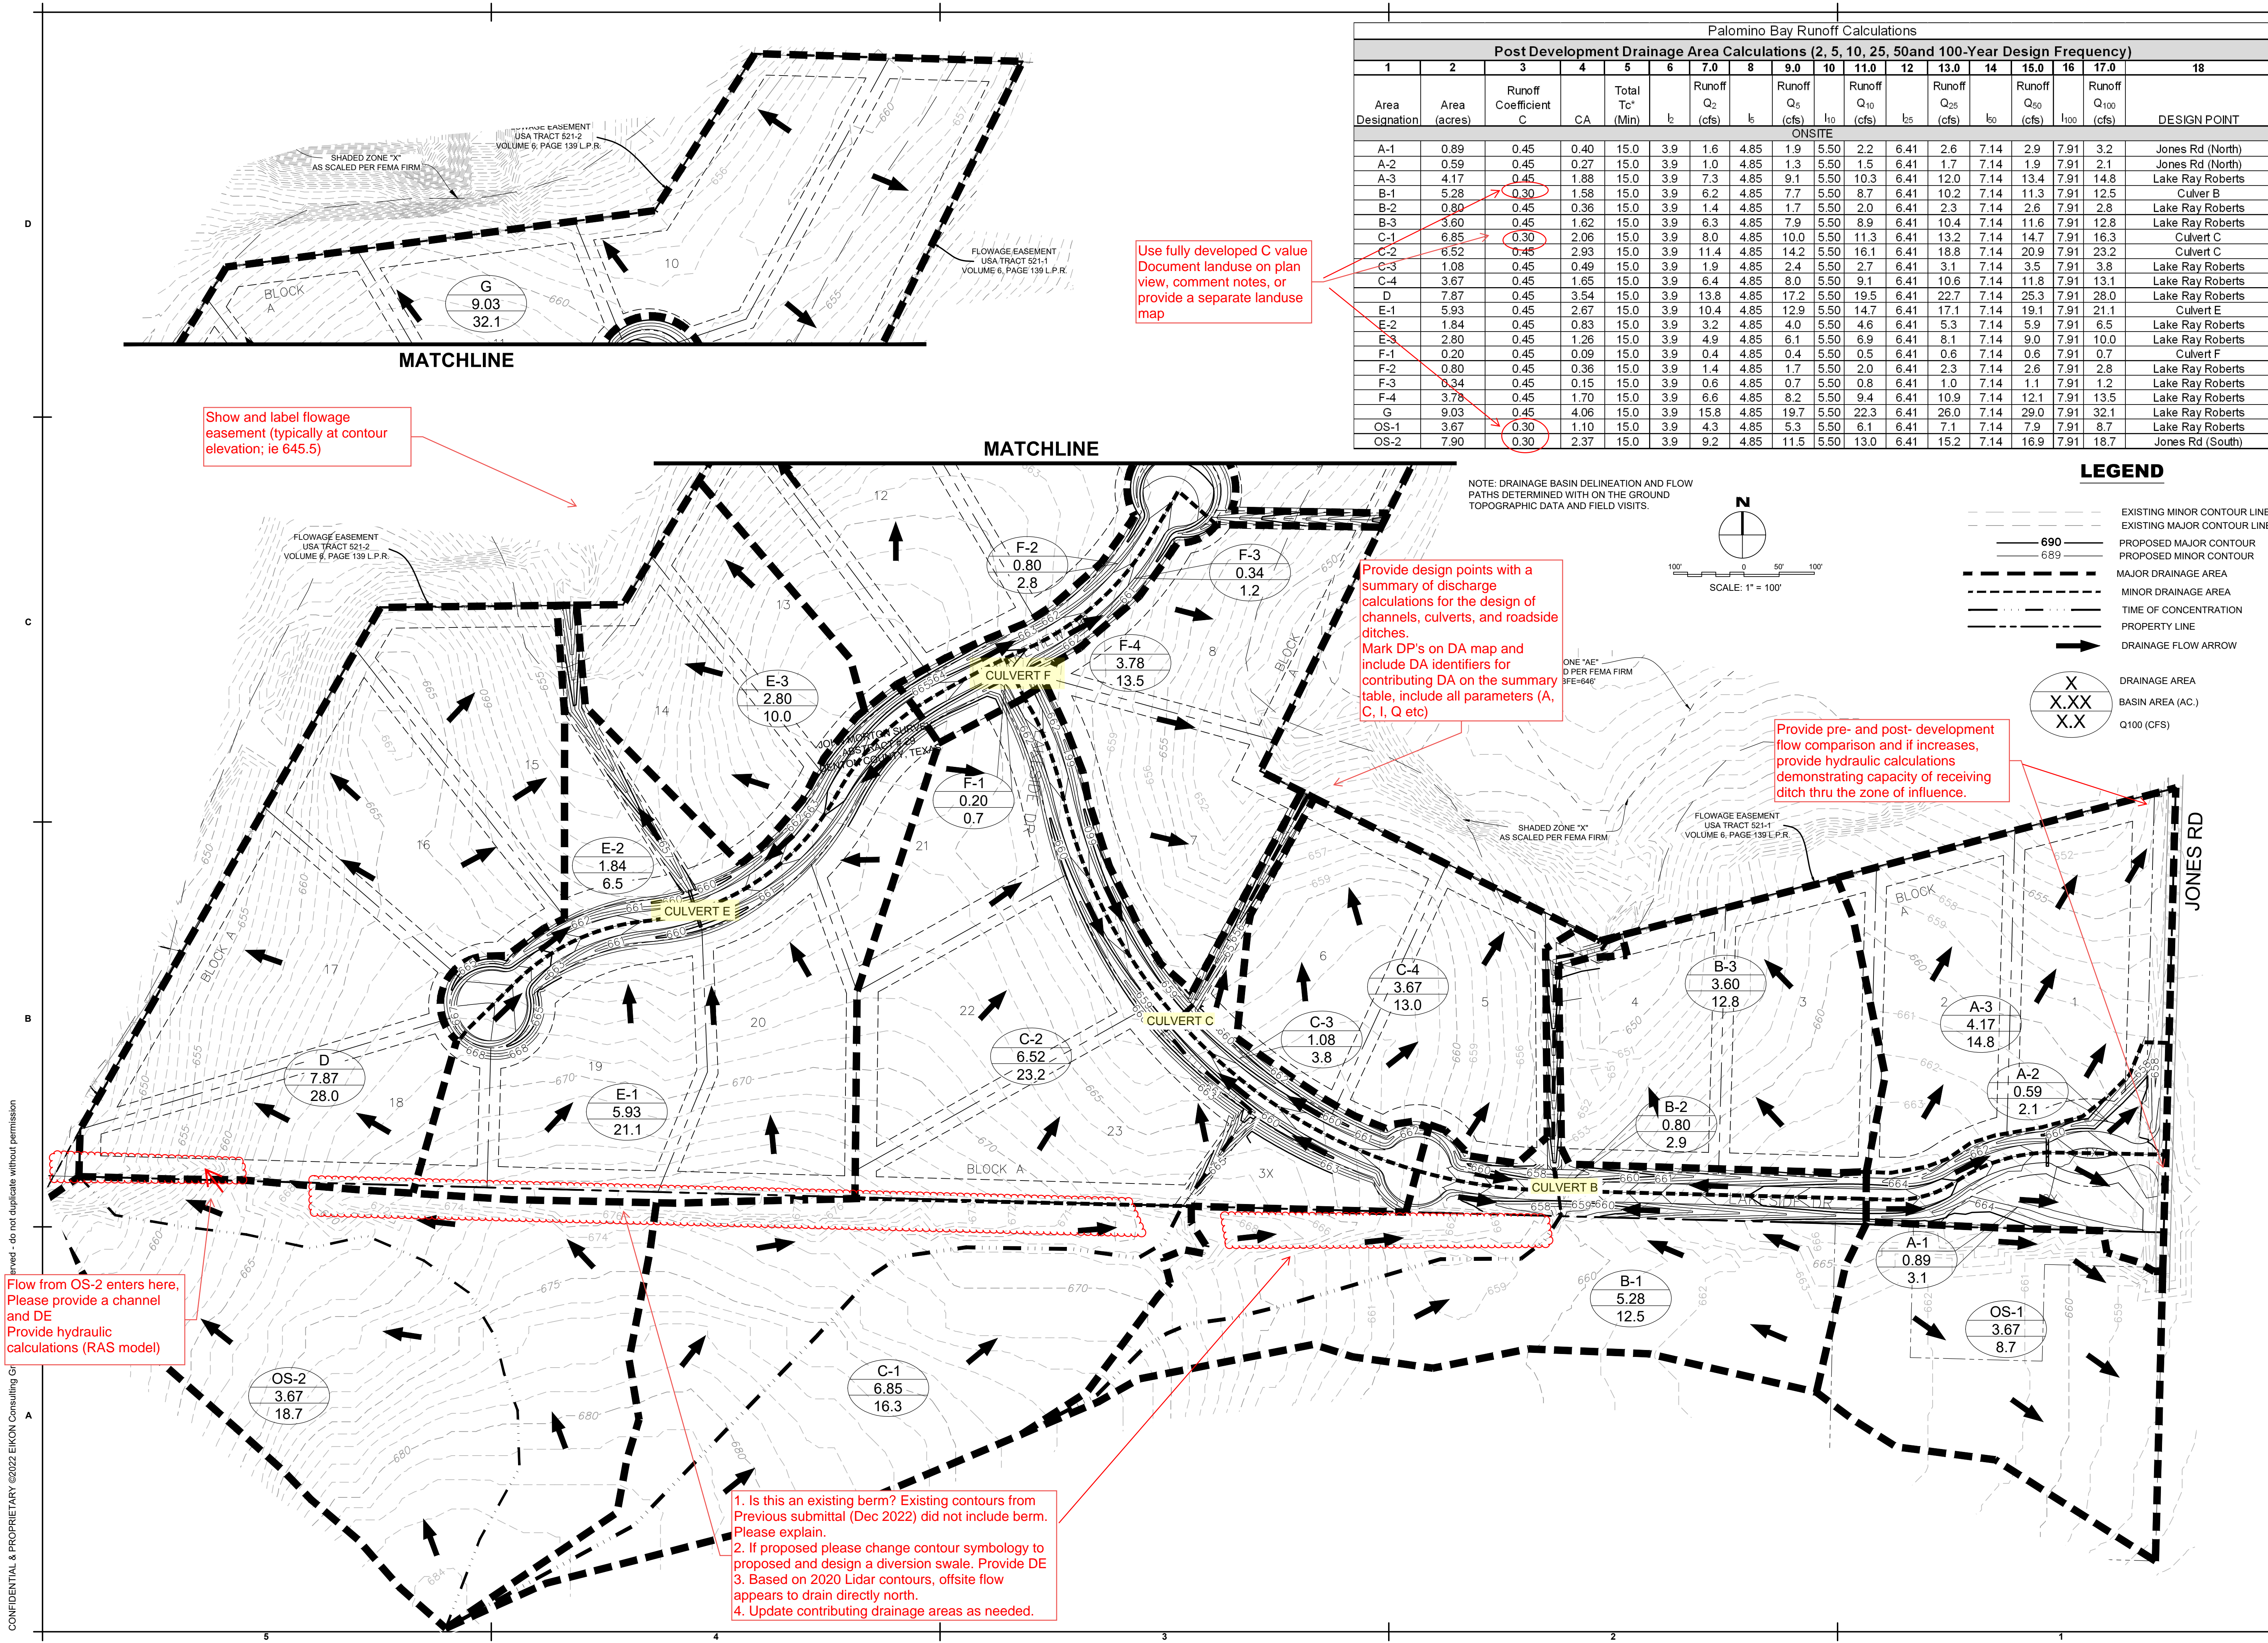


Show and label flowage easement (typically at contour elevation; ie 645.5)

Use fully developed C value Document landuse on plan view, comment notes, or provide a separate landuse map

Palomino Bay Runoff Calculations																	
Post Development Drainage Area Calculations (2, 5, 10, 25, 50and 100-Year Design Frequency)																	
1	2	3	4	5	6	7.0	8	9.0	10	11.0	12	13.0	14	15.0	16	17.0	18
Area Designation	Area (acres)	Runoff Coefficient C	CA	Total Tc* (Min)	l <sub>2</sub>	Runoff Q <sub>2</sub> (cfs)	l <sub>5</sub>	Runoff Q <sub>5</sub> (cfs)	l <sub>10</sub>	Runoff Q <sub>10</sub> (cfs)	l <sub>25</sub>	Runoff Q <sub>25</sub> (cfs)	l <sub>50</sub>	Runoff Q <sub>50</sub> (cfs)	l <sub>100</sub>	Runoff Q <sub>100</sub> (cfs)	DESIGN POINT
ONSITE																	
A-1	0.89	0.45	0.40	15.0	3.9	1.6	4.85	1.9	5.50	2.2	6.41	2.6	7.14	2.9	7.91	3.2	Jones Rd (North)
A-2	0.59	0.45	0.27	15.0	3.9	1.0	4.85	1.3	5.50	1.5	6.41	1.7	7.14	1.9	7.91	2.1	Jones Rd (North)
A-3	4.17	0.45	1.88	15.0	3.9	7.3	4.85	9.1	5.50	10.3	6.41	12.0	7.14	13.4	7.91	14.8	Lake Ray Roberts
B-1	5.28	0.30	1.58	15.0	3.9	6.2	4.85	7.7	5.50	8.7	6.41	10.2	7.14	11.3	7.91	12.5	Culvert B
B-2	0.80	0.45	0.36	15.0	3.9	1.4	4.85	1.7	5.50	2.0	6.41	2.3	7.14	2.6	7.91	2.8	Lake Ray Roberts
B-3	3.60	0.45	1.62	15.0	3.9	6.3	4.85	7.9	5.50	8.9	6.41	10.4	7.14	11.6	7.91	12.8	Lake Ray Roberts
C-1	6.85	0.30	2.06	15.0	3.9	8.0	4.85	10.0	5.50	11.3	6.41	13.2	7.14	14.7	7.91	16.3	Culvert C
C-2	6.52	0.45	2.93	15.0	3.9	11.4	4.85	14.2	5.50	16.1	6.41	18.8	7.14	20.9	7.91	23.2	Culvert C
C-3	1.08	0.45	0.49	15.0	3.9	1.9	4.85	2.4	5.50	2.7	6.41	3.1	7.14	3.5	7.91	3.8	Lake Ray Roberts
C-4	3.67	0.45	1.65	15.0	3.9	6.4	4.85	8.0	5.50	9.1	6.41	10.6	7.14	11.8	7.91	13.1	Lake Ray Roberts
D	7.87	0.45	3.54	15.0	3.9	13.8	4.85	17.2	5.50	19.5	6.41	22.7	7.14	25.3	7.91	28.0	Lake Ray Roberts
E-1	5.93	0.45	2.67	15.0	3.9	10.4	4.85	12.9	5.50	14.7	6.41	17.1	7.14	19.1	7.91	21.1	Culvert E
E-2	1.84	0.45	0.83	15.0	3.9	3.2	4.85	4.0	5.50	4.6	6.41	5.3	7.14	5.9	7.91	6.5	Lake Ray Roberts
E-3	2.80	0.45	1.26	15.0	3.9	4.9	4.85	6.1	5.50	6.9	6.41	8.1	7.14	9.0	7.91	10.0	Lake Ray Roberts
F-1	0.20	0.45	0.09	15.0	3.9	0.4	4.85	0.4	5.50	0.5	6.41	0.6	7.14	0.6	7.91	0.7	Culvert F
F-2	0.80	0.45	0.36	15.0	3.9	1.4	4.85	1.7	5.50	2.0	6.41	2.3	7.14	2.6	7.91	2.8	Lake Ray Roberts
F-3	0.34	0.45	0.15	15.0	3.9	0.6	4.85	0.7	5.50	0.8	6.41	1.0	7.14	1.1	7.91	1.2	Lake Ray Roberts
F-4	3.78	0.45	1.70	15.0	3.9	6.6	4.85	8.2	5.50	9.4	6.41	10.9	7.14	12.1	7.91	13.5	Lake Ray Roberts
G	9.03	0.45	4.06	15.0	3.9	15.8	4.85	19.7	5.50	22.3	6.41	26.0	7.14	29.0	7.91	32.1	Lake Ray Roberts
OS-1	3.67	0.30	1.10	15.0	3.9	4.3	4.85	5.3	5.50	6.1	6.41	7.1	7.14	7.9	7.91	8.7	Lake Ray Roberts
OS-2	7.90	0.30	2.37	15.0	3.9	9.2	4.85	11.5	5.50	13.0	6.41	15.2	7.14	16.9	7.91	18.7	Jones Rd (South)

NOTE: DRAINAGE BASIN DELINEATION AND FLOW PATHS DETERMINED WITH ON THE GROUND TOPOGRAPHIC DATA AND FIELD VISITS.

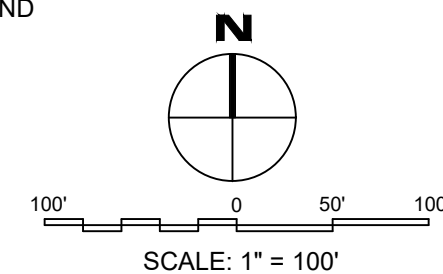

#### LEGEND

- EXISTING MINOR CONTOUR LINE
- EXISTING MAJOR CONTOUR LINE
- PROPOSED MAJOR CONTOUR
- PROPOSED MINOR CONTOUR
- MAJOR DRAINAGE AREA
- MINOR DRAINAGE AREA
- TIME OF CONCENTRATION
- PROPERTY LINE
- DRAINAGE FLOW ARROW
- DRAINAGE AREA
- BASIN AREA (AC.)
- Q100 (CFS)

Provide design points with a summary of discharge calculations for the design of channels, culverts, and roadside ditches. Mark DP's on DA map and include DA identifiers for contributing DA on the summary table, include all parameters (A, C, I, Q etc)

Provide pre- and post- development flow comparison and if increases, provide hydraulic calculations demonstrating capacity of receiving ditch thru the zone of influence.

Flow from OS-2 enters here, Please provide a channel and DE Provide hydraulic calculations (RAS model)

1. Is this an existing berm? Existing contours from Previous submittal (Dec 2022) did not include berm. Please explain.
2. If proposed please change contour symbology to proposed and design a diversion swale. Provide DE
3. Based on 2020 Lidar contours, offsite flow appears to drain directly north.
4. Update contributing drainage areas as needed.



www.eikoncg.com  
Texas Firm F-12759  
ARCHITECTS & ENGINEERS  
EIKON Consulting Group  
1405 West Chapman Drive  
Sanger, Texas 76266  
Phone 940.458.7503

THIS DOCUMENT IS RELEASED FOR THE PURPOSE OF INTERIM REVIEW UNDER THE AUTHORITY OF KEVIN J. WARE (TEXAS P.E. NO. 136599), ON 3/15/2023. IT IS NOT TO BE USED FOR CONSTRUCTION, BIDDING OR PERMIT PURPOSES.

TDLR #

NOT FOR CONSTRUCTION  
IN PROGRESS  
DENTON COUNTY TEXAS

Issued Date: 03-15-2023  
Project No: EIK052622E-2  
Drawn By: MP/MD  
Checked By: SG  
Designed By: MP/MD  
Issue Record  
# Description Date


DESIGN PHASE

PROPOSED  
DRAINAGE AREA  
MAP

C-11



PALOMINO BAY  
DR CONSTRUCTION  
N PR  
RUMES RD  
DENTON COUNTY TEXAS

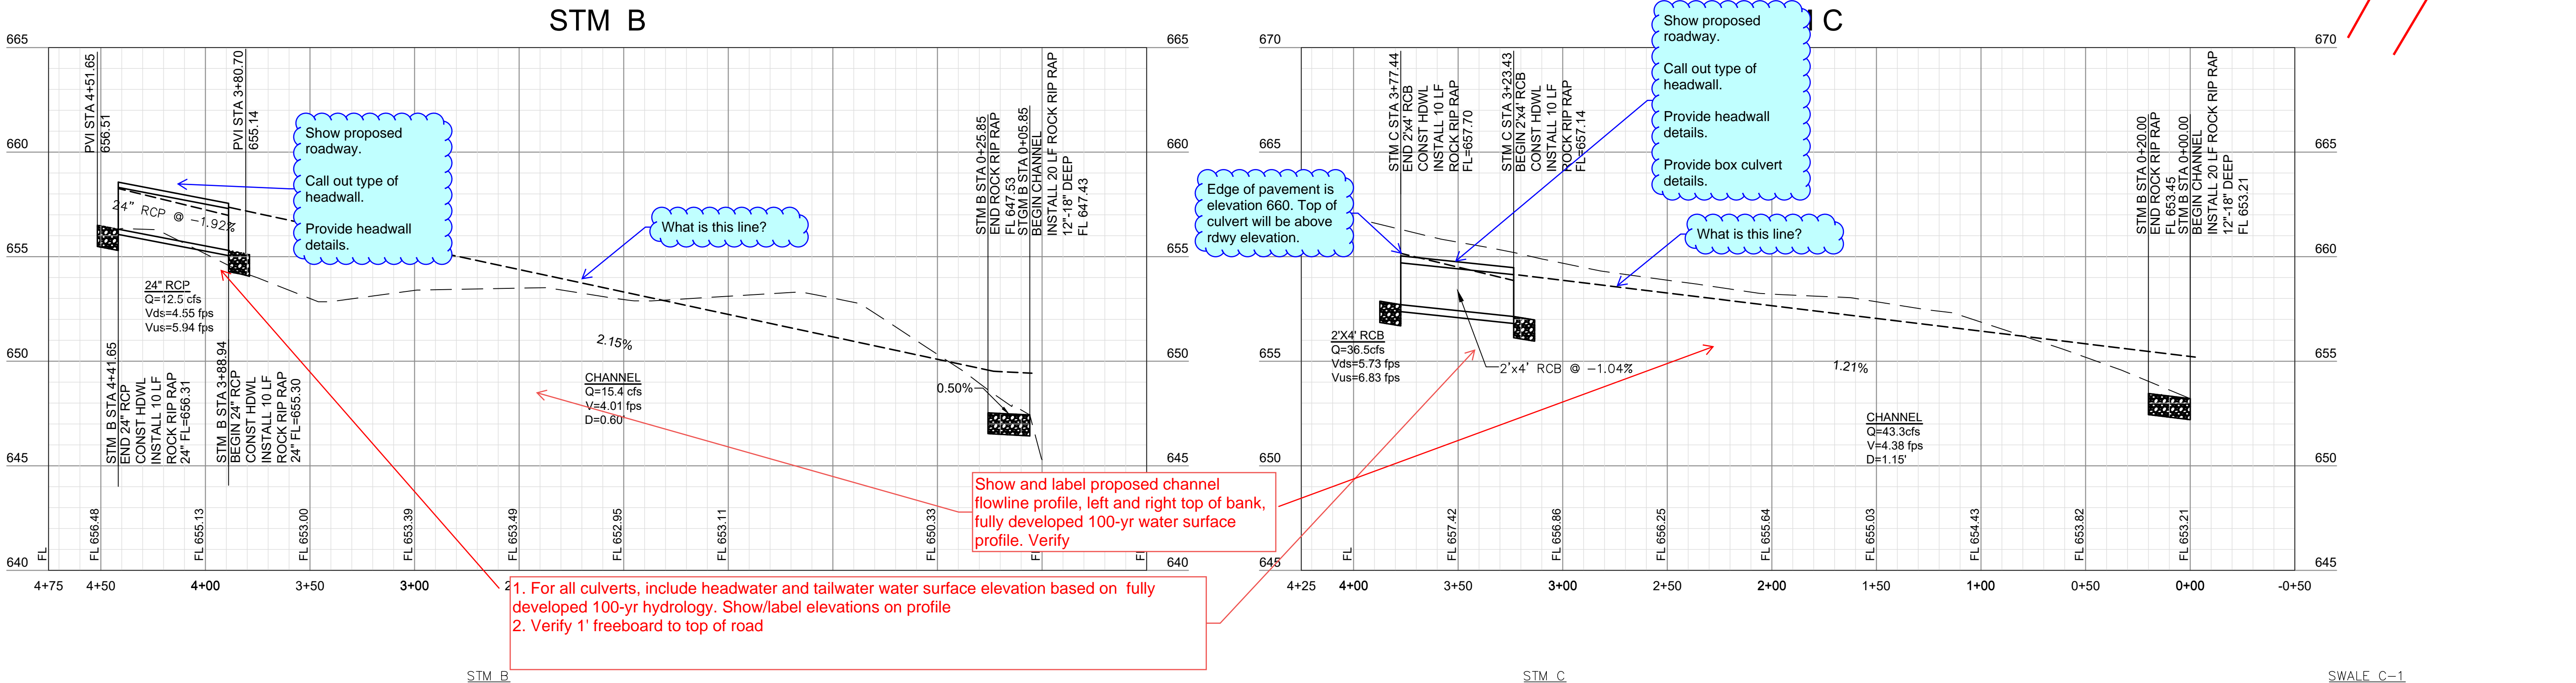

**Trapezoidal**  
 Bottom Width (ft) = 4.00  
 Side Slopes (z:1) = 4.00, 4.00  
 Total Depth (ft) = 2.00  
 Invert Elev (ft) = 647.53  
 Slope (%) = 2.15  
 N-Value = 0.030

**Highlighted**  
 Depth (ft) = 0.60  
 Q (cfs) = 15.40  
 Area (sqft) = 3.94  
 Velocity (ft/s) = 4.01  
 Wetted Perim (ft) = 8.95  
 Crt Depth, Yc (ft) = 0.63  
 Top Width (ft) = 0.80  
 EGL (ft) = 0.85

**Calculations**  
 Compute by: Known Q  
 Known Q (cfs) = 15.40






**Calculations**  
 Invert Elev Dn (ft) = 655.14  
 Pipe Length (ft) = 54.00  
 Slope (%) = 52.72  
 Invert Elev Up (ft) = 656.31  
 Rise (in) = 24.0  
 Shape = Circular  
 Span (in) = 24.0  
 No. Barrels = 1  
 n-Value = 0.013  
 Culvert Type = Circular Concrete  
 Culvert Entrance = Square edge with wall (C)  
 Coeff. K,M,c,Y,k = 0.0098, 2, 0.0398, 0.67, 0.5

**Highlighted**  
 Qtotal (cfs) = 12.50  
 Qpipe (cfs) = 12.50  
 Qovertop (cfs) = 0.00  
 Veloc Dn (ft/s) = 4.55  
 Veloc Up (ft/s) = 5.94  
 HGL Dn (ft) = 656.77  
 HGL Up (ft) = 657.58  
 Hw Elev (ft) = 658.26  
 HwD (ft) = 0.98  
 Flow Regime = Inlet Control

**Calculations**  
 Invert Elev Dn (ft) = 657.14  
 Pipe Length (ft) = 54.00  
 Slope (%) = 4.00  
 Invert Elev Up (ft) = 657.70  
 Rise (in) = 24.0  
 Shape = Box  
 Span (in) = 48.0  
 No. Barrels = 1  
 n-Value = 0.013  
 Culvert Type = Flared Wingwalls  
 Culvert Entrance = 30D to 75D wingwall flares  
 Coeff. K,M,c,Y,k = 0.026, 1, 0.0347, 0.81, 0.4

**Highlighted**  
 Qtotal (cfs) = 39.50  
 Qmax (cfs) = 39.50  
 Tailwater Elev (ft) = (dc+D)/2  
 Qovertop (cfs) = 0.00  
 Veloc Dn (ft/s) = 5.73  
 Veloc Up (ft/s) = 6.93  
 HGL Dn (ft) = 658.86  
 HGL Up (ft) = 659.15  
 Hw Elev (ft) = 660.16  
 HwD (ft) = 1.23  
 Flow Regime = Inlet Control



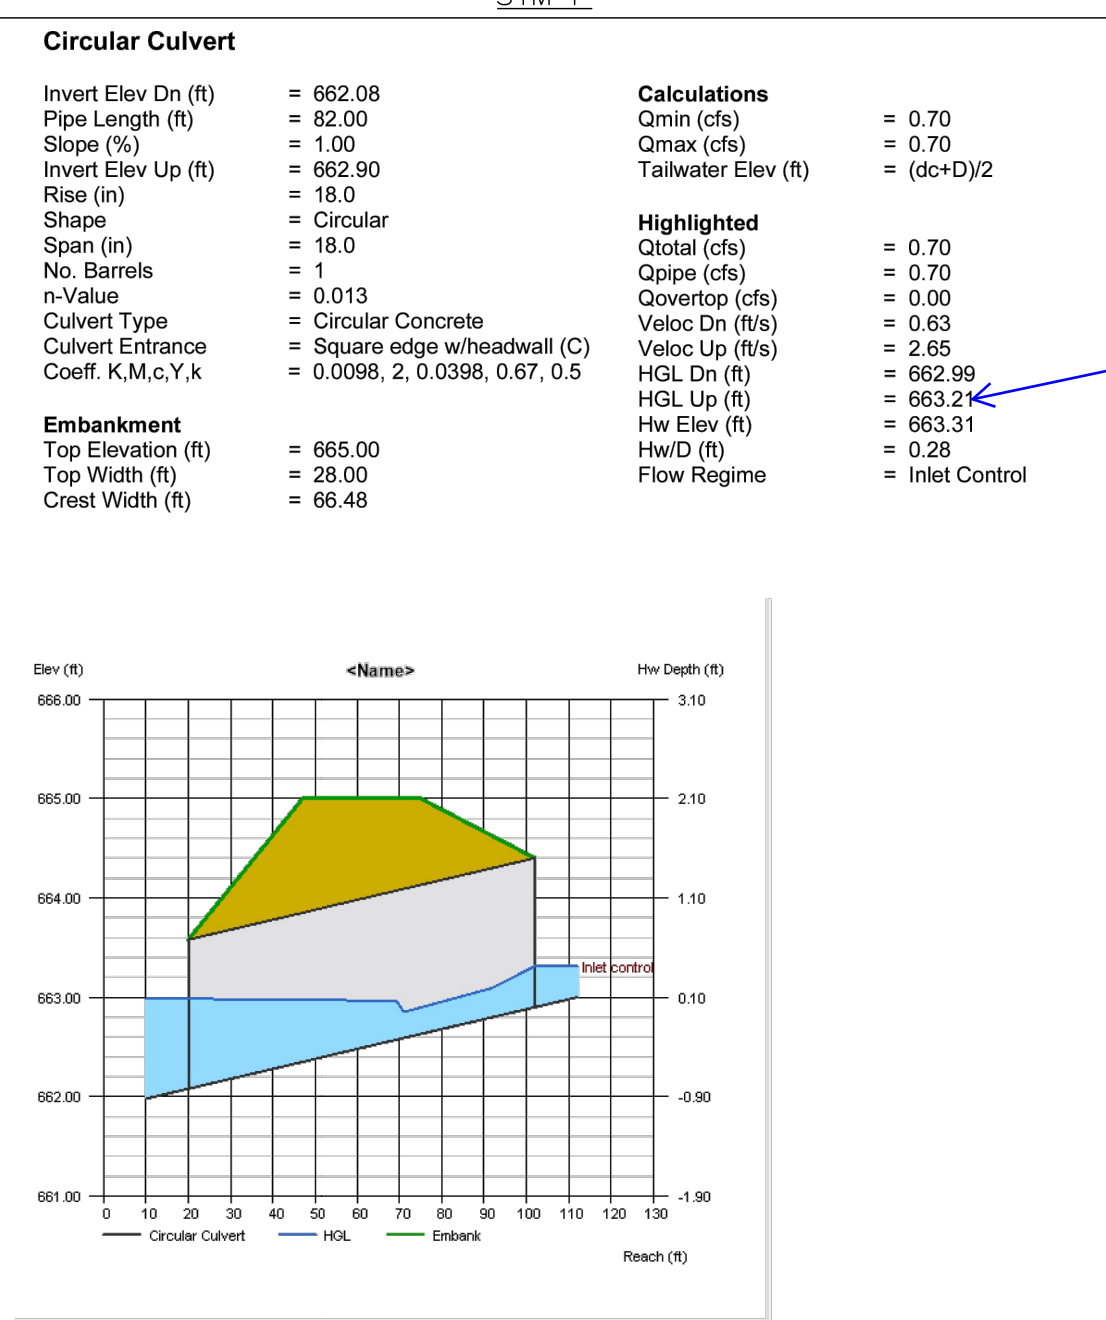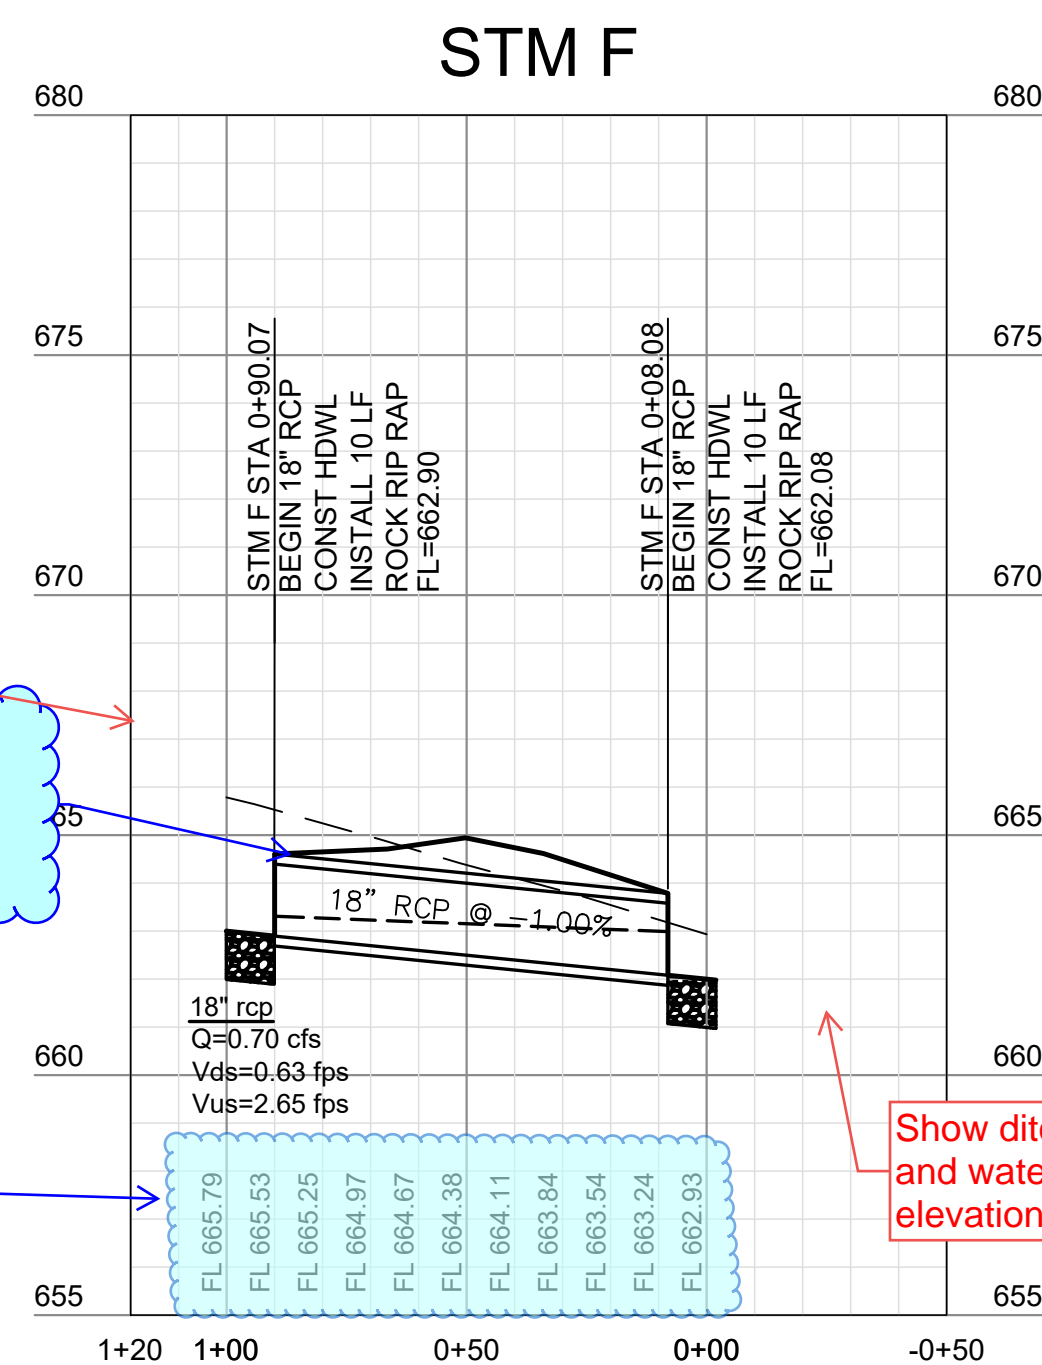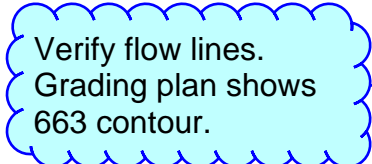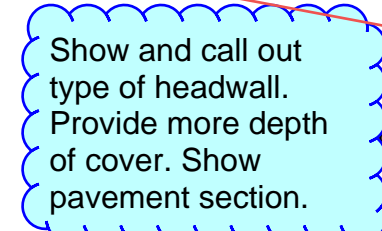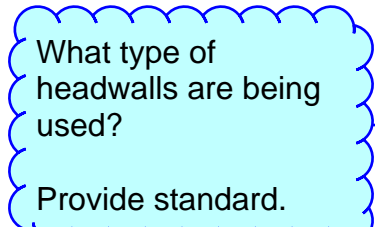


HGL is lower than the upstream invert.



# PALOMINO BAY

PALOMINO BAY  
OR CONSTRUCTION  
IN PROGRESS  
DENTON COURTESY

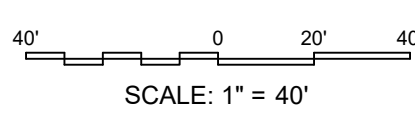

MATCH LINE SEE SHEET C-16

Min FFE must be at least 2' above channels fully developed 100-yr water surface elevation. Use wsel from upstream cross section

$$\text{MIN FFE} = 647.00'$$

MIN FFE = 647.00'

$$\text{MIN FFE} = 647.00'$$

MIN FFF = 647.00'

$$\text{MIN FFF} = 647\ 00'$$

Contours do not reflect an 8' flat bottom ditch

Complete all grading.  
Make sure proposed  
contours tie into  
existing contours.

Label existing contours and show tie-ins.  
Show and label riprap

20' DRAINAGE  
EASEMENT

Channel easement needs to include a buffer beyond top of bank for maintenance access (10' )

1. Provide typical cross section for sideyard swales
2. Show proposed flow arrows (typical)

Show and maintain a minimum 30" depth for Barrow ditches Per Denton County subdivision rules and regulations.

Proposed contour elevation 664 tying into existing el 661?

Tie all proposed contours into existing.

Typical section shows an 8' flat bottom ditch but contours do not reflect the 8'.

CONFIDENTIAL & PROPRIETARY ©2022 EIKON Consulting Group LLC. All rights reserved - do not duplicate without permission



CONFIDENTIAL & PROPRIETARY ©2022 EIKON Consulting Group LLC. All rights reserved - do not duplicate without permission

D




C

B

A

MATCH LINE SEE SHEET C-15


MATCH LINE SEE SHEET C-17

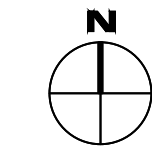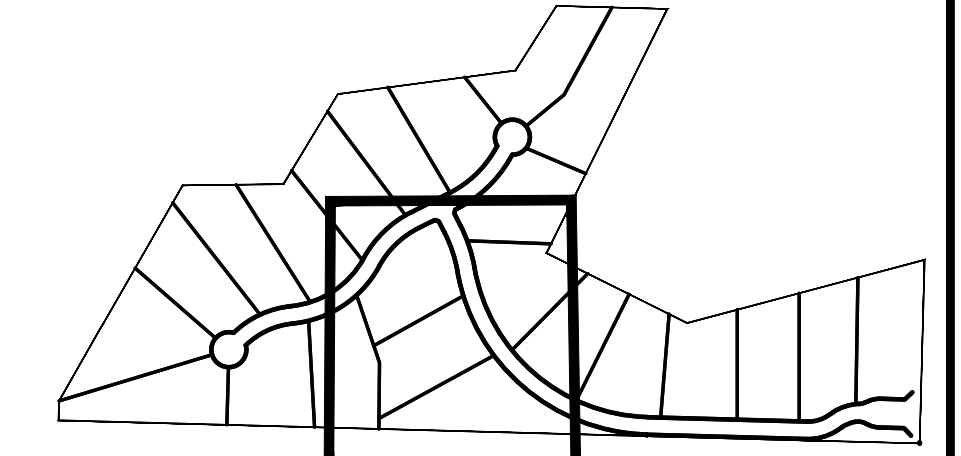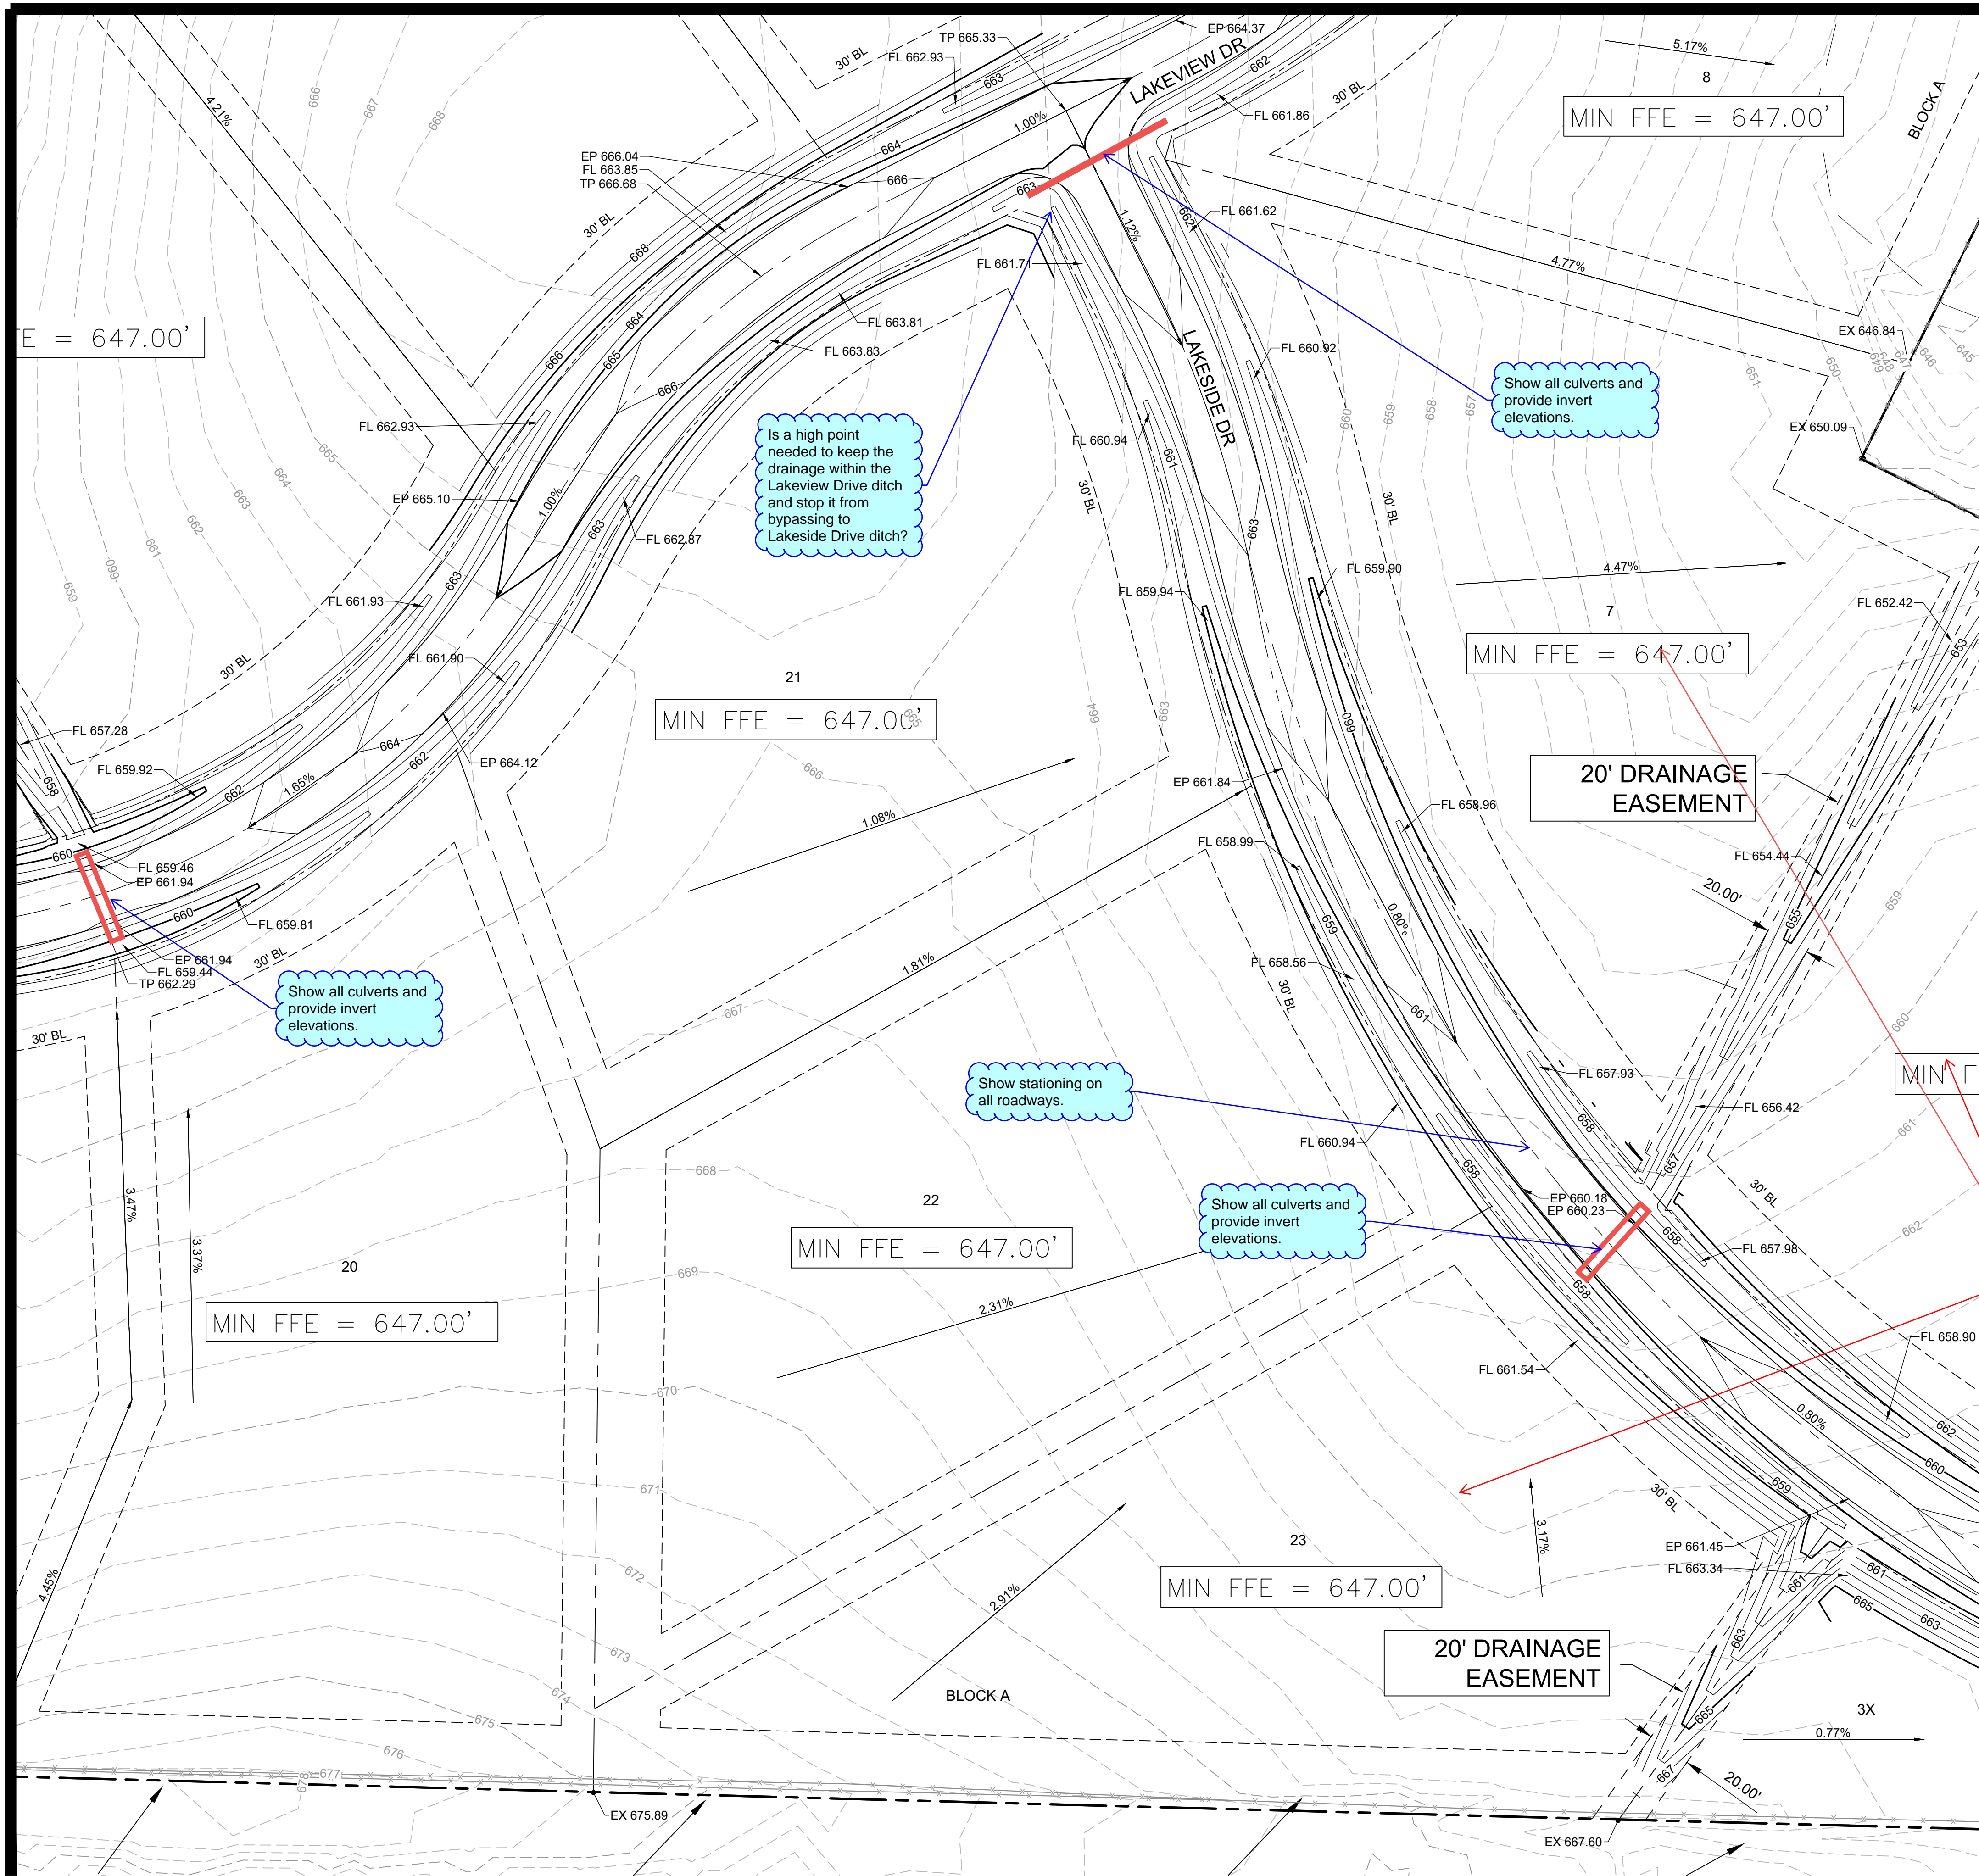

KEY MAP  
N.T.S.

LEGEND

- MATCH LINE
- PROPERTY BOUNDARY
- ADJACENT PROPERTY BOUNDARY
- PROPOSED EASEMENT
- EXISTING CONTOUR
- PROPOSED CONTOUR
- FLOOD LINE

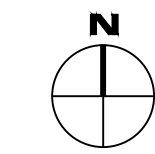

SCALE: 1" = 40'



www.eikoncg.com  
Texas Firm F-12759  
ARCHITECTS & ENGINEERS  
EIKON Consulting Group  
1405 West Chapman Drive  
Sanger, Texas 76266  
Phone 940.458.7503

THIS DOCUMENT IS RELEASED FOR THE PURPOSE OF INTERIM REVIEW UNDER THE AUTHORITY OF KEVIN J. WARE (TEXAS P.E. NO. 136599), ON 3/15/2023. IT IS NOT TO BE USED FOR CONSTRUCTION, BIDDING OR PERMIT PURPOSES.

TDLR #

NOT FOR CONSTRUCTION  
IN PROGRESS  
PALOMINO BAY  
DENTON COUNTY, TEXAS

Issued Date: 03-15-2023  
Project No: EIK052622E-2

Drawn By: MP/MD  
Checked By: SG  
Designed By: MP/MD

Issue Record  
# Description Date

DESIGN PHASE

GRADING PLAN II

C-15

Min FFE must be at least 2' above channels fully developed 100-yr water surface elevation. Use wsel from upstream cross section

C-18?

MATCH LINE SEE SHEET C-19

MIN FFE = 647.00'

MIN FFE = 647.00'

20' DRAINAGE EASEMENT

MIN FFE = 647.00'

MIN FFE = 647.00'

MIN FFE = 647.00'

20' DRAINAGE EASEMENT

MIN FFE = 647.00'

Is a high point needed to keep the drainage within the Lakeview Drive ditch and stop it from bypassing to Lakeside Drive ditch?

Show all culverts and provide invert elevations.

Show stationing on all roadways.


Show all culverts and provide invert elevations.

Show all culverts and provide invert elevations.









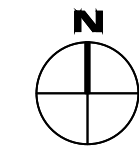

**KEY MAP**  
**N.T.S.**

MATCH LINE  
 PROPERTY BOUNDARY  
 ADJACENT PROPERTY BOUNDARY  
 PROPOSED EASEMENT  
 EXISTING CONTOUR  
 PROPOSED CONTOUR  
 FLOOD LINE

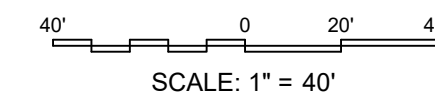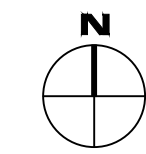

TDLR #

NOT FOR CONSTRUCTION  
IN PROGRESS

Issued Date: 03-15-2023  
Project No: EIK052622E-2

Drawn By: MP/MD  
Checked By: SG  
Designed By: MP/MD

Issue Record		
#	Description	Date

## DESIGN PHASE

### GRADING PLAN IV


**C-17**

MATCH LINE SEE SHEET C-17

MATCH LINE SEE SHEET C-19

CONFIDENTIAL & PROPRIETARY ©2022 EIKON Consulting Group LLC. All rights reserved - do not duplicate without permission




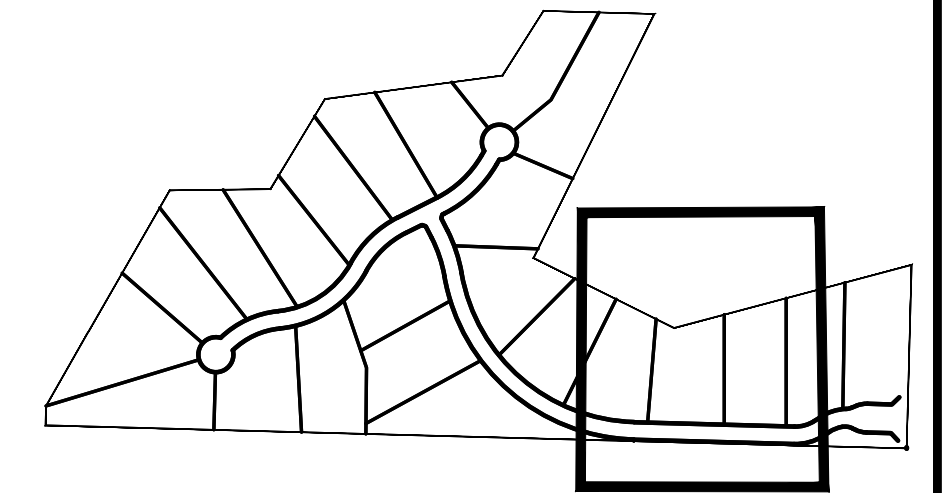

**KEY MAP**  
**N.T.S.**

### LEGEND

- 
- MATCH LINE  
 PROPERTY BOUNDARY  
 ADJACENT PROPERTY BOUNDARY  
 PROPOSED EASEMENT  
 EXISTING CONTOUR  
 PROPOSED CONTOUR  
 FLOOD LINE

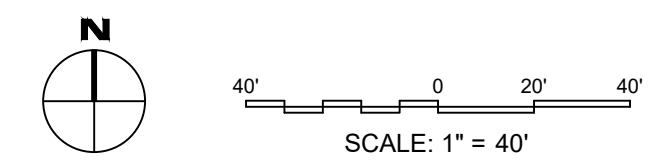

THIS DOCUMENT IS RELEASED  
FOR THE PURPOSE OF INTERIM  
REVIEW UNDER THE AUTHORITY  
OF KEVIN J. WARE  
(TEXAS P.E. NO. 136599),  
ON 3/15/2023.  
IT IS NOT TO BE USED FOR  
CONSTRUCTION, BIDDING OR  
PERMIT PURPOSES.

DRLR #

**NOT FOR CONSTRUCTION  
IN PROGRESS**

Issued Date: 03-15-2023  
Project No: EIK052622E-2

Drawn By: MP/MD  
Checked By: SG  
Designed By: MP/MD

Issue Record		
#	Description	Date


[illegible]

## DESIGN PHASE

## GRADING PLAN V


# C-18

MATCH LINE SEE SHEET C-18

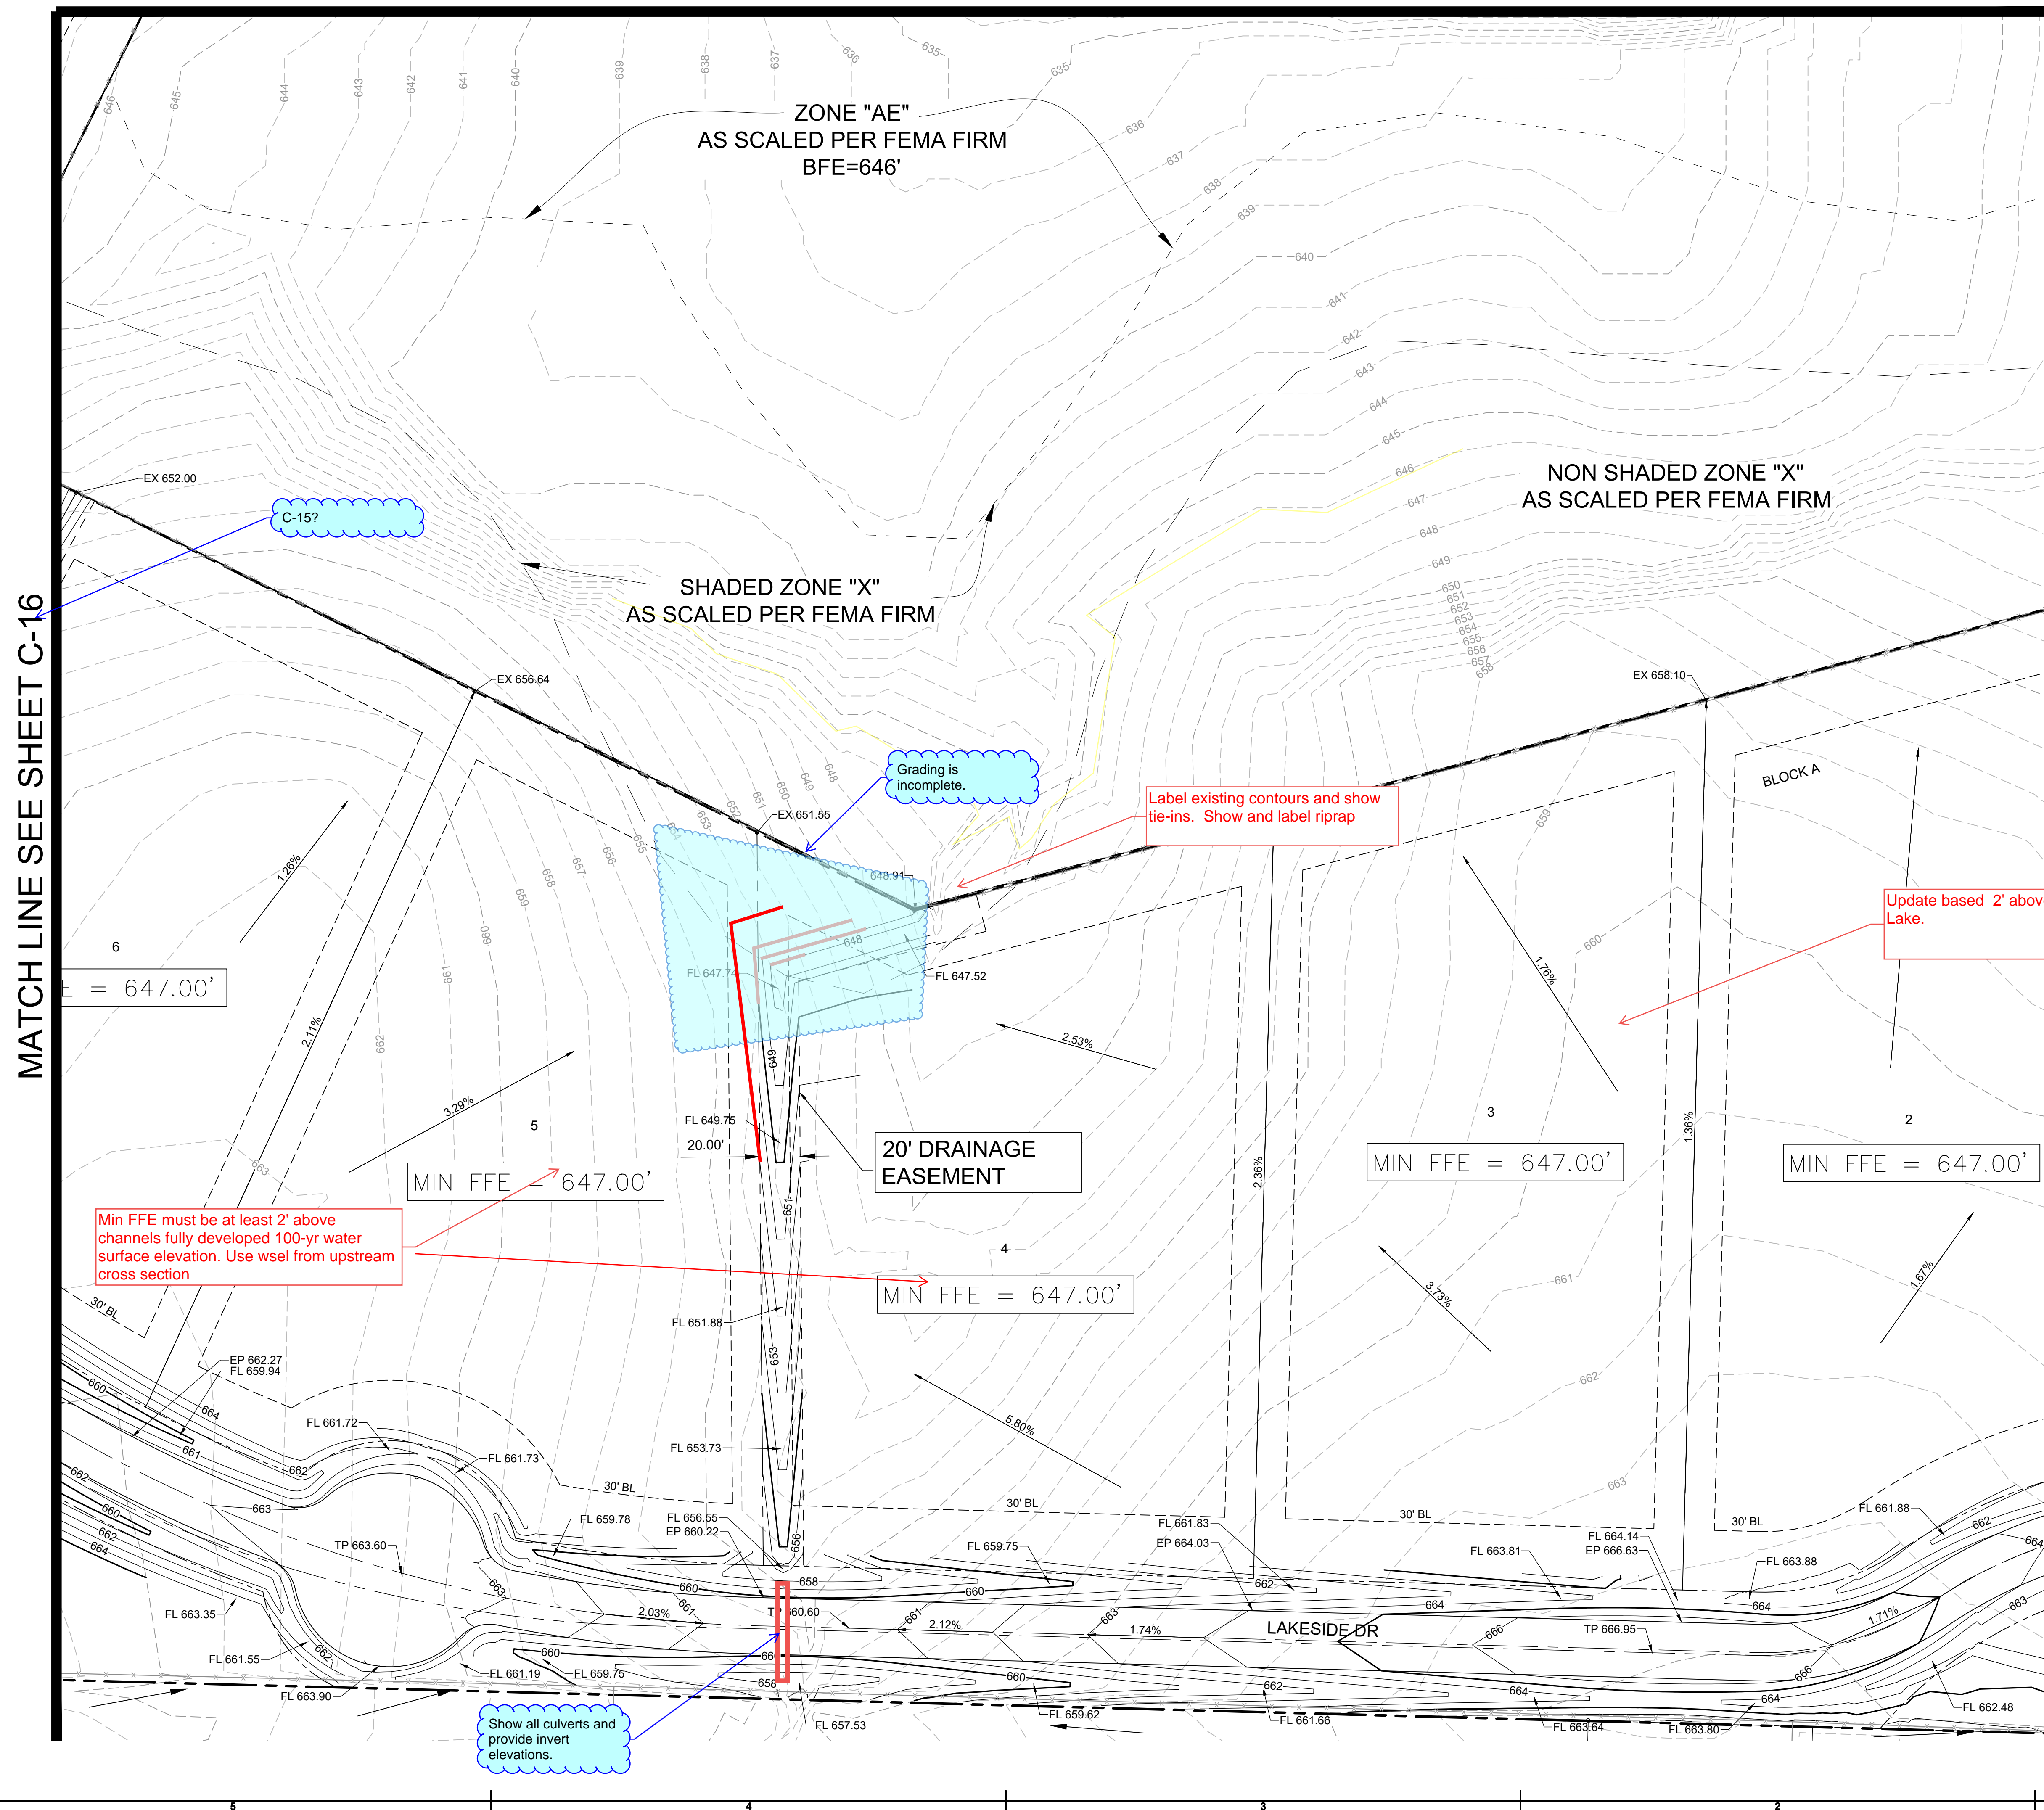




CONFIDENTIAL & PROPRIETARY ©2022 EIKON Consulting Group LLC. All rights reserved - do not duplicate without permission



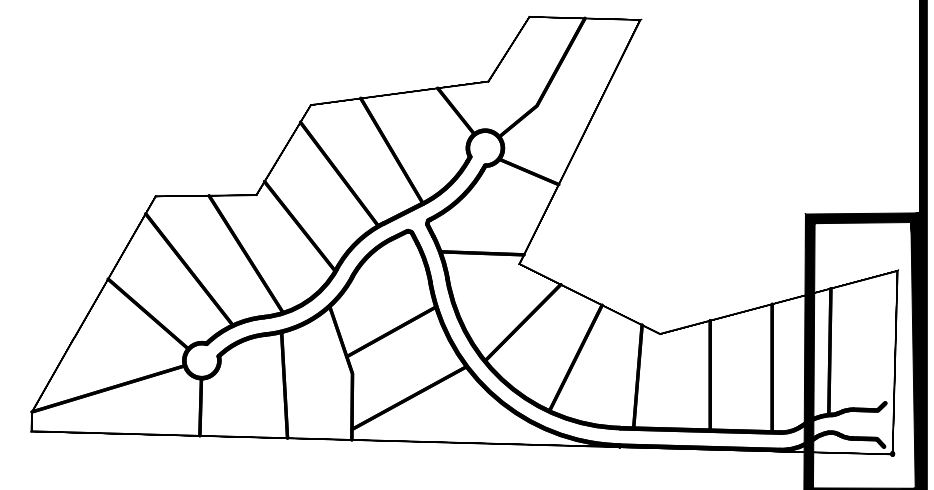

**KEY MAP**  
**N.T.S.**

## LEGEND

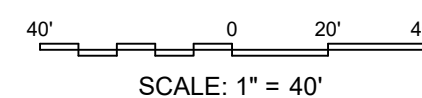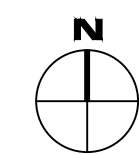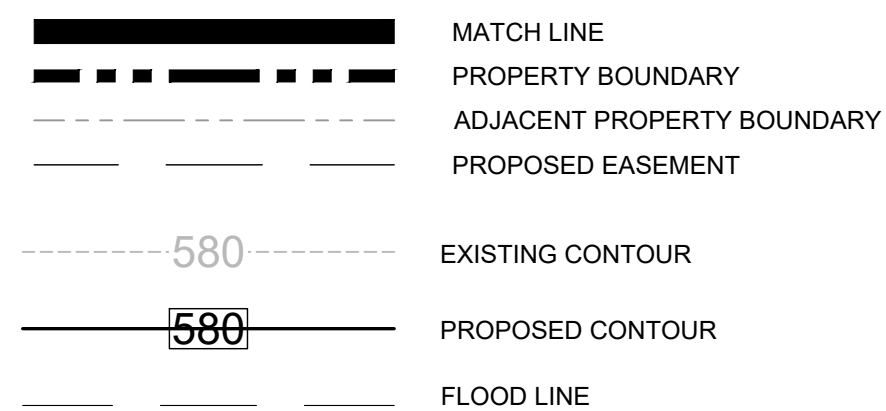

THIS DOCUMENT IS RELEASED  
FOR THE PURPOSE OF INTERIM  
REVIEW UNDER THE AUTHORITY  
OF KEVIN J. WARE  
(TEXAS P.E. NO. 136599),  
ON 3/15/2023.  
IT IS NOT TO BE USED FOR  
CONSTRUCTION, BIDDING OR  
PERMIT PURPOSES.

TDLR #

NOT FOR CONSTRUCTION  
IN PROGRESS

Issued Date: 03-15-2023  
Project No: EIK052622E-2

Drawn By: MP/MD  
Checked By: SG

## Issue Record

#	Description	Date
---	-------------	------

## DESIGN PHASE

## GRADING PLAN VI

# C-19

MATCH LINE SEE SHEET C-19

MATCH LINE SEE SHEET C-20

Update sheet number

Show and label ROW

Provide a RAS model to verify capacity of ditch. Roadside ditch must contain the fully developed 100-yr floodplain. Provide any additional DE as needed.  
If flow increased please provide pre- and post- analysis and demonstrate no adverse impacts.

Provide plan and profile for Culvert A and hydraulic calcs.

JONES ROAD  
ASPHALT

MIN FFE = 647.00'

STONE  
WALL

GATE


STON  
WALL

CONFIDENTIAL & PROPRIETARY ©2022 EIKON Consulting Group LLC. All rights reserved - do not duplicate without permission



**C-20**



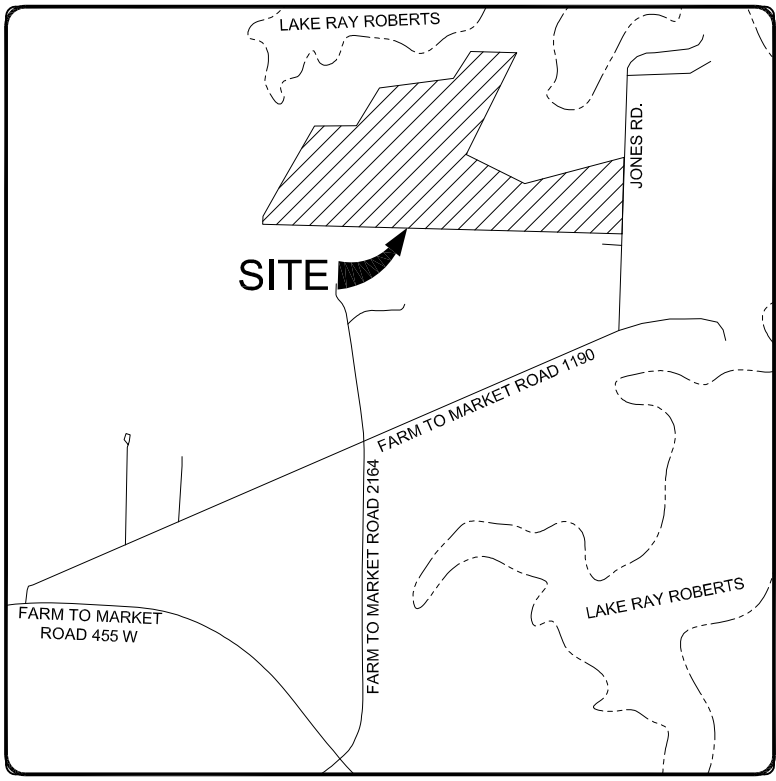

VICINITY MAP  
NOT TO SCALE

LINE TABLE		
LINE	BEARING	DISTANCE
L1	N 88°03'09" W	40.82'
L2	N 89°37'29" W	30.30'
L3	N 26°52'40" W	85.83'
L4	N 30°18'40" E	72.38'
L5	S 45°27'17" W	51.98'
L6	S 71°52'40" E	14.14'
L7	N 16°42'42" E	13.81'
L8	N 46°33'21" E	51.05'
L9	S 43°26'59" E	51.50'
L10	N 75°11'29" E	96.02'
L11	N 14°48'31" W	19.05'

LOT INFORMATION				
LOT NO.	ACREAGE	SQUARE FOOTAGE	LOT WIDTH AT FRONT BUILDING LINE	
1	2.001	87,175	176.74'	
2	2.000	87,131	209.85'	
3	2.000	87,123	212.62'	
4	2.002	87,193	244.00'	
5	2.002	87,188	322.43'	
6	2.000	87,134	250.99'	
7	2.003	87,243	476.51'	
8	2.006	87,403	349.30'	
9	2.386	103,923	131.53'	
10	2.012	87,664	136.52'	
11	2.006	87,375	306.19'	
12	2.006	88,373	172.49'	
13	2.019	87,966	209.96'	
14	2.109	91,857	256.22'	
15	2.367	103,114	181.77'	
16	2.038	88,759	182.36'	
17	2.499	108,874	130.99'	
18	2.114	92,077	125.24'	
19	2.071	90,198	372.35'	
20	2.124	92,530	192.09'	
21	2.012	87,640	601.16'	
22	2.010	87,566	220.73'	
23	2.022	88,092	225.01'	

CURVE TABLE				
CURVE	RADIUS	ARC LENGTH	CHORD LENGTH	DELTA ANGLE
C1	245.00'	135.87'	134.14'	S 72°01'16" W 31°48'33"
C2	150.00'	92.89'	91.22'	S 73°50'07" W 35°24'14"
C3	720.00'	951.62'	883.85'	N 50°35'56" W 75°43'40"
C4	500.00'	123.42'	123.10'	N 19°48'23" W 14°08'33"
C5	400.00'	229.07'	226.95'	N 46°43'00" E 32°48'41"
C6	350.00'	210.78'	207.61'	S 45°52'12" W 34°30'17"
C7	350.00'	341.00'	327.67'	S 56°31'44" W 55°49'21"
C8	300.00'	202.25'	198.44'	S 65°07'37" W 38°37'35"
C9	88.00'	71.90'	69.91'	S 88°54'23" E 46°48'41"
C10	88.00'	71.90'	69.91'	N 88°54'23" W 46°48'41"
C11	128.00'	108.52'	106.29'	N 85°01'15" E 48°34'27"
C12	128.00'	106.20'	103.18'	N 82°53'48" W 47°32'09"
C13	215.00'	177.18'	172.21'	S 64°18'01" W 47°13'02"

Update Min FFE for all lots based on the higher 2' above fully developed 100-yr wselev at Lake or at adjacent channel.

Provide floodplain easement 10' from fully developed lake water surface elevation

Label zone

Min FFE must be at least 2' above channels fully developed 100-yr water surface elevation. Use upstream cross section

Will need to coordinate width of all drainage easements once the Civil has finalized grading and confirmed width needed.

Show and label flowage easement


Call out Drainage Easement. Will need to coordinate width of all drainage easements once the Civil has finalized grading and confirmed width needed.

Will need to coordinate with Civil regarding potential need for drainage easement along roadway.

Min FFE must be at least 2' above channels fully developed 100-yr water surface elevation. Use upstream cross section

**LEGEND**

R.O.W. = RIGHT-OF-WAY  
F.F.E. = FINISH FLOOR ELEVATION  
POB = POINT OF BEGINNING  
FIR = 1/2" IRON ROD FOUND  
FIR/CAP = CAPPED IRON ROD FOUND  
PSTW = WOOD POST  
NLF = NAIL FOUND  
MAG = MAG NAIL  
CAP/IRS = CAPPED IRON ROD SET  
R.P.R.D.C.T. = REAL PROPERTY RECORDS DENTON COUNTY TEXAS  
L.P.R.D.C.T. = LIES PENDENS RECORDS DENTON COUNTY TEXAS  
B.L. = BUILDING LINE  
P.U.E. = PRIVATE UTILITY EASEMENT  
D.E. = DRAINAGE EASEMENT  
N. = NORTHING  
E. = EASTING  
NAD 83 = NORTH AMERICAN DATUM OF 1983  
C. = CENTERLINE OF ROAD

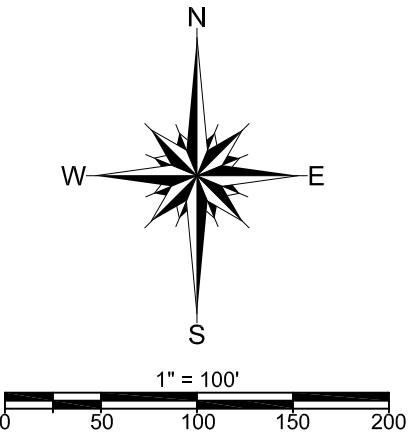


**SURVEYOR:**  
KAZ SURVEYING, INC.  
1720 WESTMINSTER STREET  
DENTON, TEXAS 76205  
PHONE: (840) 382-3446  
TBPLS FIRM #10002100

**OWNER:**  
HWY 377 PARTNERS, LTD.  
611 SOUTH MAIN ST.  
GRAPEVINE, TEXAS 76051  
PHONE: (817) 416-4843  
CONTACT: GARY HAZLEWOOD

**DEVELOPER:**  
WESTWOOD REAL ESTATE DEVELOPMENT  
1000 TEXAN TRAIL, SUITE 200  
GRAPEVINE, TEXAS 76051  
PHONE: (817) 442-0000  
CONTACT: CLINT BAKER

LAKE RAY ROBERTS LAND USE REGULATIONS R-2 RESIDENTIAL ESTATE MEDIUM DENSITY DISTRICT	
MIN. LOT AREA	2 ACRES/87,120 SQ. FT.
MIN. LOT WIDTH (@ FRONT BLDG. LINE)	125 FEET
MIN. LOT DEPTH	100 FEET
MIN. FRONT YARD	30 FEET
MIN. SIDE YARD	15 FEET/30 FEET FOR CORNER LOT ADJACENT TO STREETS
MIN. REAR YARD	30 FEET
MAX HEIGHT	35 FEET
REQUIRED PARKING	2 OFF-STREET PARKING SPACES PER DWELLING UNIT

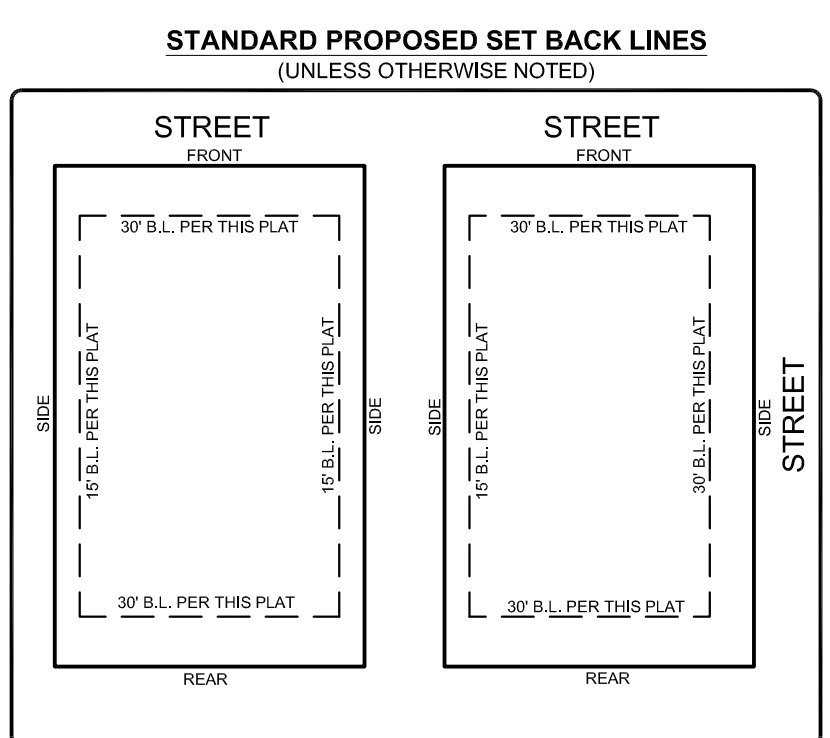

**KAZ SURVEYING**  
TX FIRM REGISTRATION # 10002100

1720 WESTMINSTER  
DENTON, TX 76205  
(940)382-3446  
JOB NUMBER: 220318  
DRAWN BY: DJJ  
DATE: 03-15-2023  
R.P.I.S.  
KENNETH A. ZOLLINGER

- GENERAL NOTES:**
- ALL CORNERS ARE MARKED WITH CAPPED 1/2" IRON RODS STAMPED "KAZ" UNLESS OTHERWISE NOTED.
  - FLOOD STATEMENT: I HAVE REVIEWED THE F.E.M.A. FLOOD INSURANCE RATE MAP FOR DENTON COUNTY, COMMUNITY NUMBER 480774, EFFECTIVE DATE 4-18-2011, AND THAT MAP INDICATES AS SCALED, THAT A PORTION OF THIS PROPERTY IS WITHIN "NON-SHADED ZONE X" DEFINED AS "AREAS DETERMINED TO BE OUTSIDE THE 0.2% ANNUAL CHANCE FLOOD (500-YEAR)", AND A PORTION OF THIS PROPERTY IS WITHIN "SHADED ZONE X" DEFINED AS "AREAS OF 0.2% ANNUAL CHANCE FLOOD AREAS OF 1% ANNUAL CHANCE FLOOD AVERAGE DEPTHS OF LESS THAN 1 FOOT OR WITH DRAINAGE AREAS LESS THAN 1 SQUARE MILE, AND AREAS PROTECTED BY LEVEES FROM 1% ANNUAL CHANCE FLOOD" AS SHOWN ON PANEL 90 G OF SAID MAP.
  - THE PURPOSE OF THIS PLAT IS TO SUBDIVIDE AN UNPLATTED TRACT OF LAND INTO TWENTY-THREE (23) RESIDENTIAL LOTS, THREE (3) PRIVATE OPEN SPACE LOTS AND TWO (2) PRIVATE STREETS.
  - NOTE: BEARINGS SHOWN HEREON ARE REFERENCED TO THE TEXAS COORDINATE SYSTEM OF 1983, NORTH CENTRAL ZONE (4202), AND ARE BASED ON THE NORTH AMERICAN DATUM OF 1983, 2011 ADJUSTMENT.
  - THE SUBJECT TRACT SHOWN IS WITHIN "SANGER EXTRATERRITORIAL JURISDICTION" (ETJ).
  - ALL LOTS COMPLY WITH THE MINIMUM SIZE REQUIREMENTS OF THE ZONING DISTRICT.
  - THIS PROPERTY MAY BE SUBJECT TO CHARGES RELATED TO IMPACT FEES IF THE APPLICANT SHOULD CONTACT THE CITY REGARDING ANY APPLICABLE FEES DUE.
  - ALL COMMON AREAS, DRAINAGE EASEMENTS, AND DETENTION FACILITIES WILL BE OWNED AND MAINTAINED BY THE HOA/POA. ANY COMMON AREA WITHIN THE CITY'S RIGHT-OF-WAY WILL REQUIRE A FACILITIES AGREEMENT, TO BE REVIEWED AND APPROVED BY THE CITY.
  - NOTICE - SELLING A PORTION OF THIS ADDITION BY METES & BOUNDS IS A VIOLATION OF CITY ORDINANCE AND STATE LAW AND IS SUBJECT TO FINES AND WITHHOLDING OF UTILITIES AND BUILDING PERMITS.
  - THIS PLAT DOES NOT ALTER OR REMOVE ANY EXISTING DEED RESTRICTIONS, IF ANY, ON THIS PROPERTY.
  - MINIMUM FINISHED FLOOR ELEVATIONS ARE AT LEAST 2 FEET ABOVE THE 100 YEAR FLOOD PLAIN.
  - ALL PRIVATE STREETS WILL BE OWNED AND MAINTAINED BY THE HOA/POA.
  - WATER IS TO BE PROVIDED BY INDIVIDUAL PRIVATE WELLS, AND SEWER IS TO BE PROVIDED BY INDIVIDUAL ON-SITE SEPTIC FACILITIES. BOTH ARE TO BE OWNED AND MAINTAINED BY THE INDIVIDUAL PROPERTY OWNER.
  - ELECTRIC SERVICE TO BE PROVIDED BY COSEV ELECTRIC, 7300 S. STEMMONS, CORINTH, TX 76201
  - NO NATURAL GAS SERVICE.

**FINAL PLAT**  
**LOTS 1-23 & LOTS 1X - 3X, BLOCK A**  
**PALOMINO BAY ADDITION**  
**23 RESIDENTIAL LOTS, 3 OPEN SPACE**  
**LOTS AND 5.638-ACRES OF**  
**RIGHT-OF-WAY DEDICATION**  
BEING 54.34 ACRES IN THE  
JOHN MORTON SURVEY, ABSTRACT NUMBER 792  
CITY OF SANGER EXTRATERRITORIAL JURISDICTION (ETJ),  
DENTON COUNTY, TEXAS