



August 1, 2024  
AVO 37449.004

Ms. Ramie Hammonds  
Development Services Director/Building Official  
City of Sanger  
201 Bolivar Street  
P.O. Box 1729  
Sanger, Texas 76266

**Re: Greystar Multifamily -Review #1**

Dear Ms. Hammonds,

Halff was requested by the City of Sanger to review the Final Plat and Civil drawings for the Greystar Muti-family Development. The submittal was prepared by Clay Moore Engineering and was received on July 18, 2024.

We have completed our review and offer the following comments:

**General Comments**

1. Please address comments on attached markups and provide annotated responses on markups. Please note, not all comments are written on letter since some comments are easier to show and explain on the markups. Please annotate markup with responses.
2. Please address drainage comments provided 4/3/24 and provide an updated flood study with the next construction plan submittal.

**Beltz Road Retail Phase 1 Final Plat**

1. Final Plat approval is contingent upon approval of the preliminary plat.
2. Call out all setbacks.
3. Verify water easement locations based on per the civil plans.
4. Per ordinance, easements shall be a minimum of 15' wide.
5. The Plat title has already been used in a previous phase. Reconcile.
6. Final plat approval is contingent upon approval of the drainage study. Comments were provided in April.
7. A separate closure report is required for final acceptance of the plat

**Collector Road Plan and Profile**

1. Clearly denote points of curvature and tangent on the roadway plan view.
2. Provide curve data.
3. The maximum slope is 2% within 100' of an intersection.



### **Paving, Striping and Signage Plans**

1. Provide striping information for the roadway.
2. Provide the geotechnical report.
3. The preliminary plat references PD 12-32-22. Clarify in the notes section.
4. Show how parking was calculated and provide enough information to verify that it matches the approved PD.

### **Fencing Plan**

1. Provide gate details. The gates must conform to ordinance 10.105(3).

### **Grading Plan**

1. A minimum slope of 0.50% towards the outlet structure is required for all detention facilities. 10.106(d)(10)(C)
2. The maximum allowable slope is exceed in near the center of the property. Reconcile.
3. Provide poind cross sections.

### **Drainage Area Map**

1. Provide a pond maintenance agreement.
2. Profile and provide HGL/hydraulic data for the proposed ditch. The design must meet requirements outlined in ordinance 10.106(d)(9)(B).
3. A revised flood study (comments returned April 3) is needed for a thorough drainage review. Pond calculations and WSEL are needed to cross check closed conduit calculations.
4. Verify the intensity for the predeveloped condition.
5. Provide more information from the previous phase so there is more information to backcheck in this plan set.
6. C-1 and D-1 only contain street pavement. Per the DCSRR  $c=0.95$ .

### **Storm Drainage Plan**

1. Some angles look too large for deflections without a fitting or manhole. Verify and revise.
2. For constructability, it is suggested to remove the 3' section of 24" pipe and up-size straight to 27" RCP. See line B comments.
3. Show water and sewer crossings on the storm profiles.
4. A minimum slope of 0.50% towards the outlet structure is required for all detention facilities.
5. It is unclear what is to be constructed in Phase 1 vs Phase 2 plats. Clarify.
6. Storm design is not consistent between phases 1 and 2.

### **Storm Drainage Profiles**

1. Provide vertical scale.
2. Show Hydraulic data at the storm outfalls. Recalculate throughout.
3. Show HGL in partial flow. it will equal normal depth. Reconcile throughout.
4. How does line C's flowline outfall tie into the proposed ground?



5. A 2' minimum of cover is desired for storm lines. Provide deload calcs specifications or provide an alternate class of RCP.
6. The minimum pipe diameter for 10' curb inlets is 21" per ordinance.

### **Storm Drainage Calculations**

1. Update calculations for RCP pipe.
2. Provide inlet calculations.
3. Dedicated detention/retention basins shall also include an additional one (1) foot of freeboard and two (2) feet of sediment storage. 10.106(d)(10)
4. Resolve area discrepancy on line B-2.

### **Water Plan**

1. Label all fittings.
2. Label deflection on line B.
3. Provide PC's, PT,s and curve data where applicable. Typical.
4. Provide the exiting water line sizes at tie ins.
5. Show the storm lines in the plan view.

### **Water Profiles**

1. Show all storm and sewer crossings. Typical.
2. Call out deflections on the line A profile.
3. Provide Vertical Scale.

### **Sanitary Sewer Profiles**

1. Provide vertical scale.
2. Grid elevations are missing on line A.
3. Show how water crossings will be TCEQ compliant..

### **Utility Plan**

4. Verify if the water line to the north is existing or proposed.
5. Show all water and storm crossings in the sewer profiles.

### **Sanitary Sewer Profiles**

1. Show water crossings and how they will comply with TCEQ standards.

### **Standard Details**

1. Provide Storm outfall details.

### **Landscape Plans**

1. Show the landscape buffer adjacent to the proposed street.



Ms. Ramie Hammonds

Page 4 of 4

2. The parking area requires 9,720 SF of landscaping per the paving plan. Please also see the parking comment and adjust landscaping as needed.
3. Provide a buffer yard adjacent to the residential area per section 48.4 of the zoning ordinance.
4. Add a note specifying that the owner is responsible for landscape maintenance.

The Engineer shall revise the plans in accordance with the above comments and/or provide a written response that addresses each comment. If you have any questions or need additional information, please do not hesitate to call me at (214) 937-3928.

Sincerely,



Jamie Akomer, PE, PMP

**HALFF**

Firm No. 0312

Attachments: Plans markups




# CIVIL CONSTRUCTION PLANS

PREPARED FOR  
GREYSTAR

SANGER MULTI-FAMILY  
DENTON COUNTY  
SANGER, TEXAS

Provide Pavement plan  
and profile for public  
street.

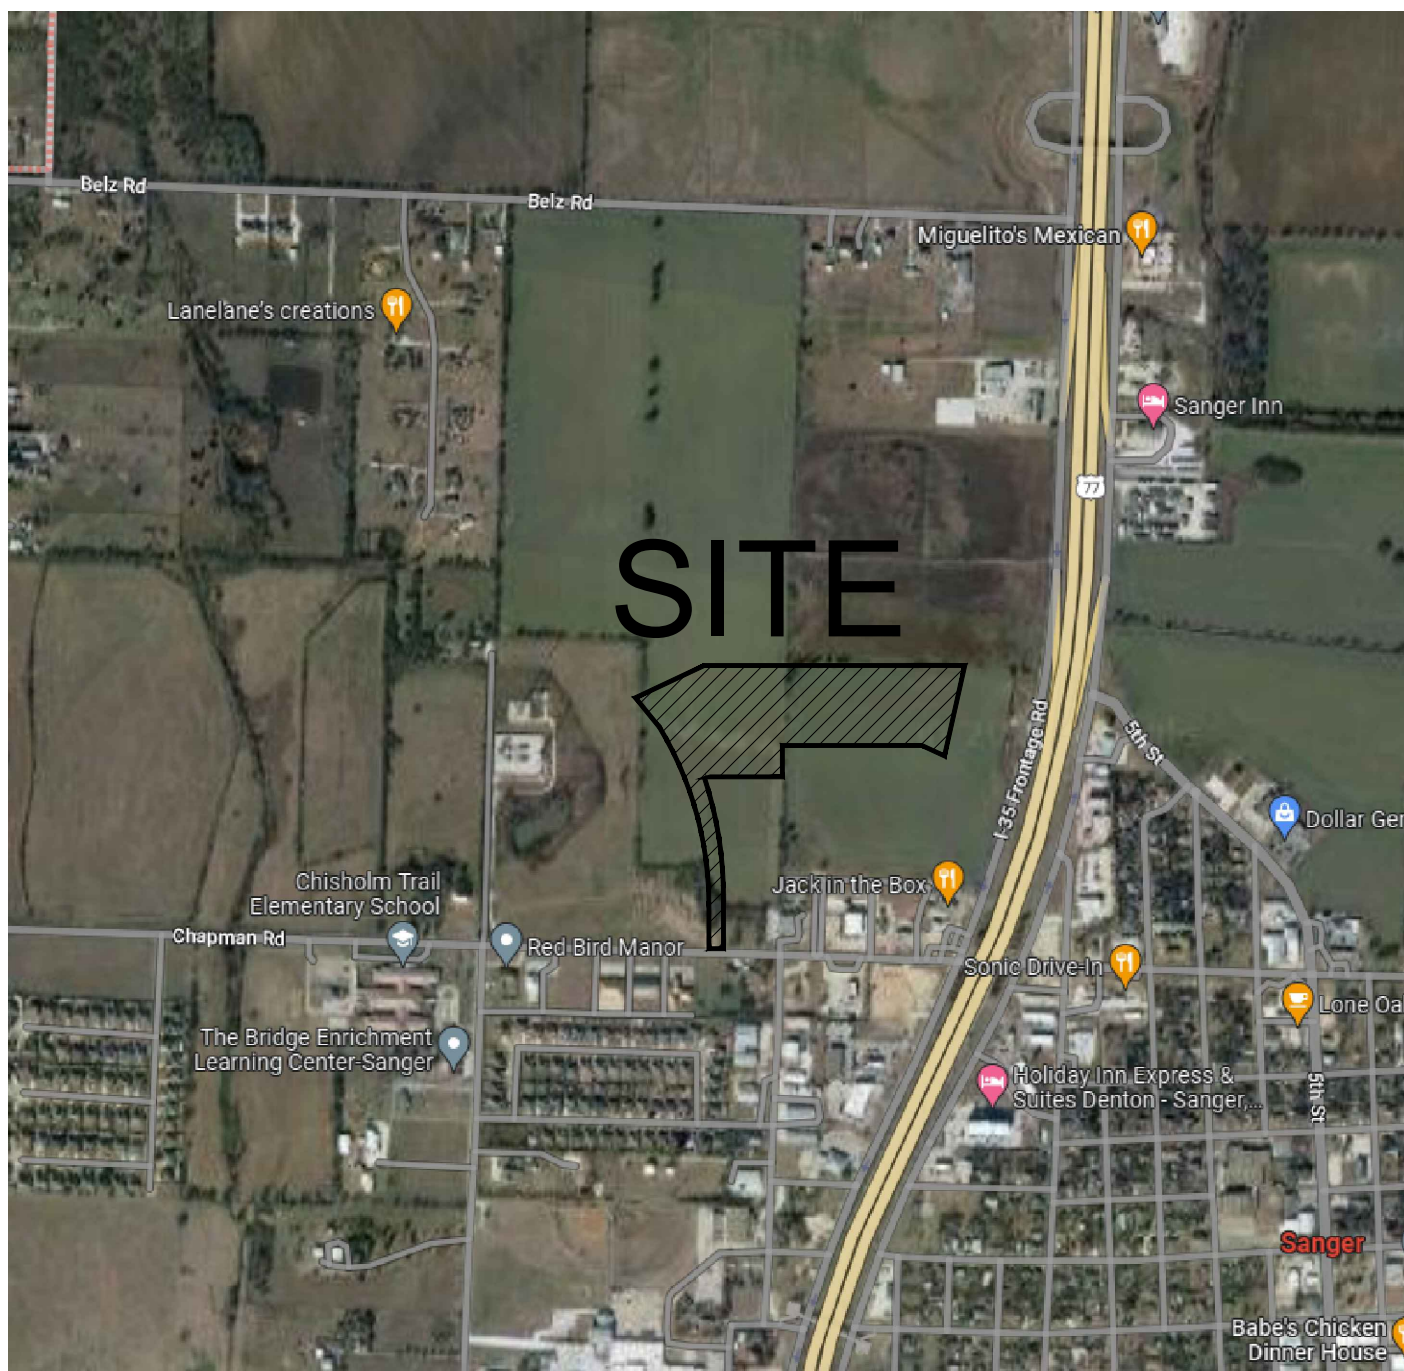

JULY 2024

ENGINEER

**CLAYMOORE**  
ENGINEERING

TEXAS REGISTRATION #14199  
1903 CENTRAL DRIVE  
SUITE #406  
BEDFORD, TX 76092  
PH. 817.281.0572  
FAX 817.281.0574  
CONTACT: MATT MOORE, PE  
EMAIL: MATT@CLAYMOOREENG.COM

**PRELIMINARY**  
FOR REVIEW ONLY  
Not for construction purposes.  
**CLAYMOORE ENGINEERING**  
ENGINEERING AND PLANNING CONSULTANTS  
Engineer\_DREW DONOSKY  
P.E. No.125651 Date 7/17/2024

Sheet List Table		
Sheet Number	Sheet Title	Drawing Comments
C-0	COVER	7/17/2024
--	FINAL PLAT 1	7/17/2024
--	FINAL PLAT 2	7/17/2024
C-1	GENERAL NOTES	7/17/2024
C-2.0	OVERALL EROSION CONTROL PLAN	7/17/2024
C-2.1	EROSION CONTROL PLAN	7/17/2024
C-2.2	EROSION CONTROL PLAN	7/17/2024
C-2.3	EROSION CONTROL PLAN	7/17/2024
C-2.4	EROSION CONTROL PLAN	7/17/2024
C-2.5	EROSION CONTROL DETAILS	7/17/2024
C-3.0	OVERALL DIMENSION CONTROL PLAN	7/17/2024
C-3.1	DIMENSION CONTROL PLAN	7/17/2024
C-3.2	DIMENSION CONTROL PLAN	7/17/2024
C-3.3	COLLECTOR ROAD PLAN AND PROFILE	7/17/2024
C-4.0	OVERALL PAVING, STRIPING AND SIGNAGE PLAN	7/17/2024
C-4.1	PAVING, STRIPING AND SIGNAGE PLAN	7/17/2024
C-4.2	PAVING, STRIPING AND SIGNAGE PLAN	7/17/2024
C-4.3	FENCE PLAN	7/17/2024
C-5.0	OVERALL GRADING PLAN	7/17/2024
C-5.1	GRADING PLAN	7/17/2024
C-5.2	GRADING PLAN	7/17/2024
C-5.3	GRADING PLAN	7/17/2024
C-5.4	GRADING PLAN	7/17/2024
C-5.5	GRADING PLAN	7/17/2024
C-5.6	GRADING PLAN	7/17/2024
C-6.0	EXISTING DRAINAGE AREAS	7/17/2024
C-6.1	PROPOSED DRAINAGE AREAS	7/17/2024
C-6.2	STORM DRAINAGE PLAN	7/17/2024
C-6.3	STORM DRAINAGE PLAN	7/17/2024
C-6.4	STORM DRAINAGE PROFILES	7/17/2024
C-6.5	STORM DRAINAGE PROFILES	7/17/2024
C-6.6	STORM DRAINAGE CALCULATIONS	7/17/2024
C-7.1	WATER PLAN	7/17/2024
C-7.2	WATER PLAN	7/17/2024
C-7.3	WATER PROFILES	7/17/2024
C-7.4	WATER PROFILES	7/17/2024
C-7.5	SANITARY SEWER PLAN	7/17/2024
C-7.6	SANITARY SEWER PLAN	7/17/2024
C-7.7	OFFSITE SANITARY SEWER PLAN	7/17/2024
C-7.8	SANITARY SEWER PROFILES	7/17/2024
C-7.9	SANITARY SEWER PROFILES	7/17/2024
C-7.10	DRY UTILITY COORDINATION PLAN	7/17/2024
C-7.11	DRY UTILITY COORDINATION PLAN	7/17/2024
C-8.1	CONSTRUCTION DETAILS 1	7/17/2024
C-8.2	CONSTRUCTION DETAILS 2	7/17/2024
C-8.3	CONSTRUCTION DETAILS 3	7/17/2024
C-8.4	CONSTRUCTION DETAILS 4	7/17/2024
LP-1	LANDSCAPE PLANTING	7/17/2024
LP-2	LANDSCAPE PLANTING	7/17/2024
LP-3	LANDSCAPE DETAILS & SPECIFICATIONS	7/17/2024
AP-1	CONCEPTUAL AMENITY PLAN	7/17/2024
AP-2	CONCEPTUAL AMENITY PLAN	7/17/2024
L-1	CONCEPTUAL LIGHTING PLAN	7/17/2024
L-2	CONCEPTUAL LIGHTING PLAN	7/17/2024

STOP!  
CALL BEFORE YOU DIG




811  
1-800-344-8377

C-0

SANGER MULTI-FAMILY PREPARED FOR GREYSTAR, SANGER, TEXAS



VICINITY MAP  
NOT TO SCALE

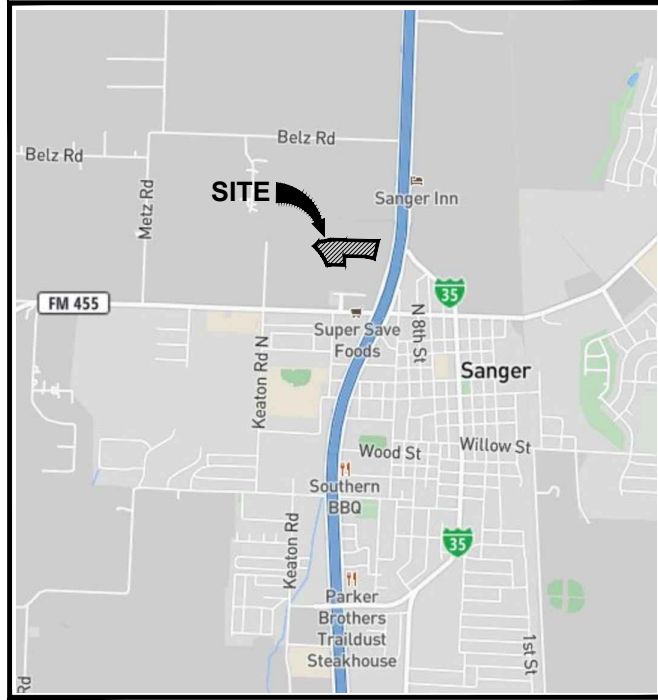

LINE TABLE		
LINE	BEARING	DISTANCE
L1	S 69°22'12" W	60.00'
L2	N 45°19'00" W	19.43'
L3	S 64°19'30" E	23.62'
L4	N 45°19'00" W	17.56'
L5	N 56°29'20" E	93.79'
L6	N 76°16'44" E	99.36'
L7	N 83°52'36" E	121.83'
L8	S 88°37'28" E	759.89'
L9	S 01°22'32" W	260.87'
L10	S 88°37'28" E	63.98'
L11	N 78°16'02" E	125.61'
L12	N 78°16'02" W	119.64'
L13	N 88°37'28" W	649.70'
L14	S 01°20'03" W	155.70'
L15	N 88°31'02" W	95.65'
L16	S 56°29'20" W	94.53'
L17	N 76°16'44" E	88.62'
L18	N 83°52'36" E	121.04'
L19	S 88°37'28" E	753.50'
L20	S 01°22'33" W	254.87'
L21	N 88°37'27" W	507.54'
L22	S 01°22'32" W	155.58'
L23	N 88°47'42" W	85.25'
L24	N 71°22'32" E	7.16'
L25	N 18°37'28" W	26.00'
L26	S 71°22'32" W	29.81'
L27	N 38°51'11" W	99.23'
L28	N 42°40'29" W	109.16'
L29	N 76°16'48" E	158.58'
L30	N 83°52'36" E	124.28'
L31	S 88°37'24" E	32.87'

LINE TABLE		
LINE	BEARING	DISTANCE
L33	S 59°16'54" E	29.87'
L34	S 88°30'31" E	17.12'
L35	N 56°27'04" E	25.62'
L36	S 88°37'24" E	233.66'
L37	S 42°31'14" E	19.94'
L38	S 88°30'31" E	16.27'
L39	N 55°51'30" E	24.79'
L40	S 88°37'24" E	246.26'
L41	S 51°50'00" E	24.61'
L42	S 88°30'31" E	23.33'
L43	S 01°19'59" W	258.63'
L44	S 87°49'39" E	76.76'
L45	S 02°10'21" W	10.00'
L46	N 87°49'39" W	80.29'
L47	S 56°52'52" W	27.38'
L48	N 88°37'24" W	229.23'
L49	N 32°15'01" W	17.34'
L50	N 88°37'28" E	12.72'
L51	S 55°13'28" W	24.22'
L52	N 88°37'24" W	161.27'
L53	S 64°55'18" W	42.46'
L54	S 01°22'32" W	19.04'
L55	N 88°37'28" W	24.41'
L56	N 55°26'11" W	103.18'
L57	S 67°10'28" W	78.28'
L58	S 29°20'45" E	6.97'
L59	S 25°09'41" W	76.28'
L60	S 22°30'27" E	179.93'
L61	S 67°29'33" W	10.00'
L62	N 22°30'27" W	184.35'
L63	N 25°09'41" E	75.55'
L64	N 29°20'45" W	33.97'

LINE TABLE		
LINE	BEARING	DISTANCE
L65	N 28°23'02" W	21.94'
L66	N 65°07'05" W	114.33'
L67	N 38°51'11" W	97.23'
L68	N 42°40'29" W	99.95'
L69	N 44°41'06" E	6.23'
L70	N 76°16'48" E	155.08'
L71	N 83°52'36" E	122.96'
L72	S 88°37'24" E	29.60'
L73	S 59°16'54" E	29.88'
L74	S 88°30'31" E	22.88'
L75	N 56°27'04" E	25.64'
L76	S 88°37'24" E	226.25'
L77	S 42°31'14" E	19.93'
L78	S 88°30'31" E	23.73'
L79	N 55°51'30" E	24.80'
L80	S 88°37'24" W	239.74'
L81	S 51°50'00" E	24.60'
L82	S 88°30'31" E	16.67'
L83	S 01°19'59" W	250.81'
L84	S 56°52'52" W	23.47'
L85	N 88°37'24" W	220.77'
L86	N 32°15'01" W	17.41'
L87	N 88°37'28" W	21.35'
L88	S 55°13'28" W	24.16'
L89	N 88°37'24" W	160.35'
L90	S 64°55'18" W	51.02'
L91	S 01°22'32" W	15.23'
L92	N 88°37'28" W	11.43'
L93	N 55°26'11" W	105.67'
L94	S 67°10'28" W	84.90'
L95	N 29°20'45" W	22.00'
L96	N 65°07'05" W	115.32'

LINE TABLE		
LINE	BEARING	DISTANCE
L97	N 71°06'36" E	97.10'
L98	N 08°37'47" E	46.40'
L99	N 08°37'47" E	22.32'
L100	N 20°55'49" W	31.72'
L101	N 20°55'49" W	21.91'
L102	N 71°06'36" E	58.53'
L103	S 88°37'28" E	56.42'
L104	S 75°37'53" E	93.64'
L105	N 12°25'30" E	76.52'
L106	N 78°15'29" W	62.50'
L107	N 01°22'32" E	306.56'
L108	S 88°37'28" E	293.13'
L109	N 54°51'19" E	22.00'
L110	S 88°37'28" E	12.60'
L111	S 54°51'19" W	25.21'
L112	S 88°37'28" E	51.42'
L113	N 41°31'28" W	27.66'
L114	N 71°01'19" E	16.41'
L115	N 22°07'49" W	48.38'
L116	N 11°49'45" E	28.07'
L117	N 78°15'29" W	138.22'
L118	N 12°25'30" E	71.66'
L119	N 88°37'28" W	43.20'
L120	S 61°12'08" W	45.87'
L121	N 37°52'14" W	93.93'
L122	N 37°52'14" W	92.74'
L123	N 88°37'28" W	271.91'
L124	S 61°12'08" W	32.73'
L125	S 01°22'32" W	36.60'



CURVE TABLE				
CURVE	ARC LENGTH	RADIUS	DELTA ANGLE	CHORD BEARING
C1	595.33'	1322.70'	25°47'17"	N 33°31'27" W
C2	268.88'	922.95'	18°41'32"	N 79°47'50" E
C3	120.72'	608.75'	11°21'45"	N 85°21'24" E
C4	621.75'	1382.70'	25°45'50"	N 33°30'43" W
C5	48.47'	30.00'	92°34'48"	N 10°11'56" E
C6	158.79'	1220.10'	7°27'24"	N 39°49'10" W
C7	104.57'	50.00'	119°49'36"	N 16°21'56" E
C8	6.63'	50.00'	7°35'52"	N 80°04'40" E
C9	6.54'	50.00'	7°29'56"	N 87°37'34" E
C10	78.54'	50.00'	90°00'00"	S 43°37'28" E
C11	47.12'	30.00'	90°00'00"	S 43°37'28" E
C12	4.70'	26.00'	10°21'26"	S 83°26'45" E
C13	45.85'	30.00'	87°33'59"	N 57°56'58" E
C14	371.37'	7421.33'	2°52'02"	N 12°43'58" E
C15	408.41'	7428.53'	3°09'00"	S 12°50'22" W
C16	4.62'	7421.30'	0°02'08"	N 14°51'06" E
C17	48.75'	30.00'	93°06'04"	N 31°43'00" W
C18	3.62'	20.00'	10°21'26"	N 83°26'45" W
C19	47.15'	30.00'	90°02'28"	S 46°21'18" W
C20	78.67'	50.00'	90°08'55"	S 49°24'31" W
C21	60.92'	50.00'	69°48'19"	N 53°36'53" W
C22	281.89'	1220.10'	13°14'16"	S 12°19'52" W
C23	47.94'	30.00'	91°33'41"	N 77°43'50" W
C24	62.48'	30.00'	119°19'54"	N 16°36'47" E
C25	3.98'	30.00'	7°35'52"	N 80°04'40" E
C26	3.93'	30.00'	7°29'56"	N 87°37'34" E
C27	47.12'	30.00'	90°00'01"	S 43°37'27" E
C28	47.12'	30.00'	89°59'59"	S 46°22'33" W
C29	78.54'	50.00'	90°00'01"	S 46°22'32" W
C30	47.03'	30.00'	89°49'46"	S 46°17'25" W
C31	36.59'	30.00'	89°52'48"	N 53°51'19" W
C32	269.76'	1257.71'	12°17'21"	N 25°03'37" W
C33	53.71'	30.00'	102°34'49"	N 20°05'07" E
C34	38.40'	30.00'	73°19'51"	N 71°57'33" W
C35	169.67'	1252.92'	7°45'33"	N 39°10'23" W

GENERAL NOTES

- The purpose of this plat is to create one lot of record.
- This property is located in **Non-Shaded Zone "X"** as scaled from the F.E.M.A. Flood Insurance Rate Map dated April 18, 2011 and is located in Community Number 480786 as shown on Map Number 48121C0210G. The location of the Flood Zone is approximate, no vertical datum was collected at the time of the survey. For the exact Flood Zone designation, please contact 1-(877) FEMA MAP.
- The bearings and grid coordinates shown on this plat are based on GPS observations utilizing the AllTerra RTK Network. North American Datum of 1983 (Adjustment Realization 2011) Texas North Central Zone 4202.
- Selling a portion of this addition by metes and bounds is a violation of City Ordinance and State Law, and is subject to fines and/or withholding of utilities and building permits. Building setbacks will be 20' from all lot lines.
- Lot to lot drainage shall not be allowed.
- All lots comply with the minimum size requirements of the zoning district.
- This property may be subject to charges related to impact fees and the applicant should contact the city regarding any applicable fees due.
- All common areas, drainage easements, and detention facilities will be owned and maintained by the HOA/property owner. Any common area within the city's right-of-way will require a facilities agreement, to be reviewed and approved by the city.
- This plat does not alter or remove existing deed restriction, if any, on this property.

LEGEND

PG. = PAGE  
VOL. = VOLUME  
CAB. = CABINET  
POB = POINT OF BEGINNING  
IRF = IRON ROD FOUND  
CIRF = CAPPED IRON ROD FOUND  
1/2" IRON ROD SET W/GREEN  
CIRS = PLASTIC CAP STAMPED  
"EAGLE SURVEYING" SET  
  
DOC. NO. = DOCUMENT NUMBER  
P.R.D.C.T. = PLAT RECORDS,  
DENTON COUNTY, TEXAS  
O.R.D.C.T. = OFFICIAL RECORDS,  
DENTON COUNTY, TEXAS  
FLMAUDE = FIRE LANE, MUTUAL ACCESS  
DRAINAGE & UTILITY EASEMENT  
WE = WATER EASEMENT  
DE = DRAINAGE EASEMENT  
UE = UTILITY EASEMENT  
EE = ELECTRIC EASEMENT  
(BTP) = BY THIS PLAT

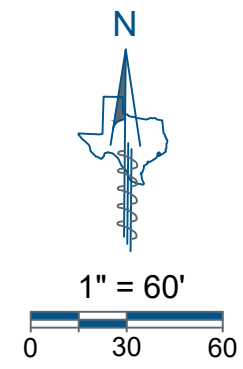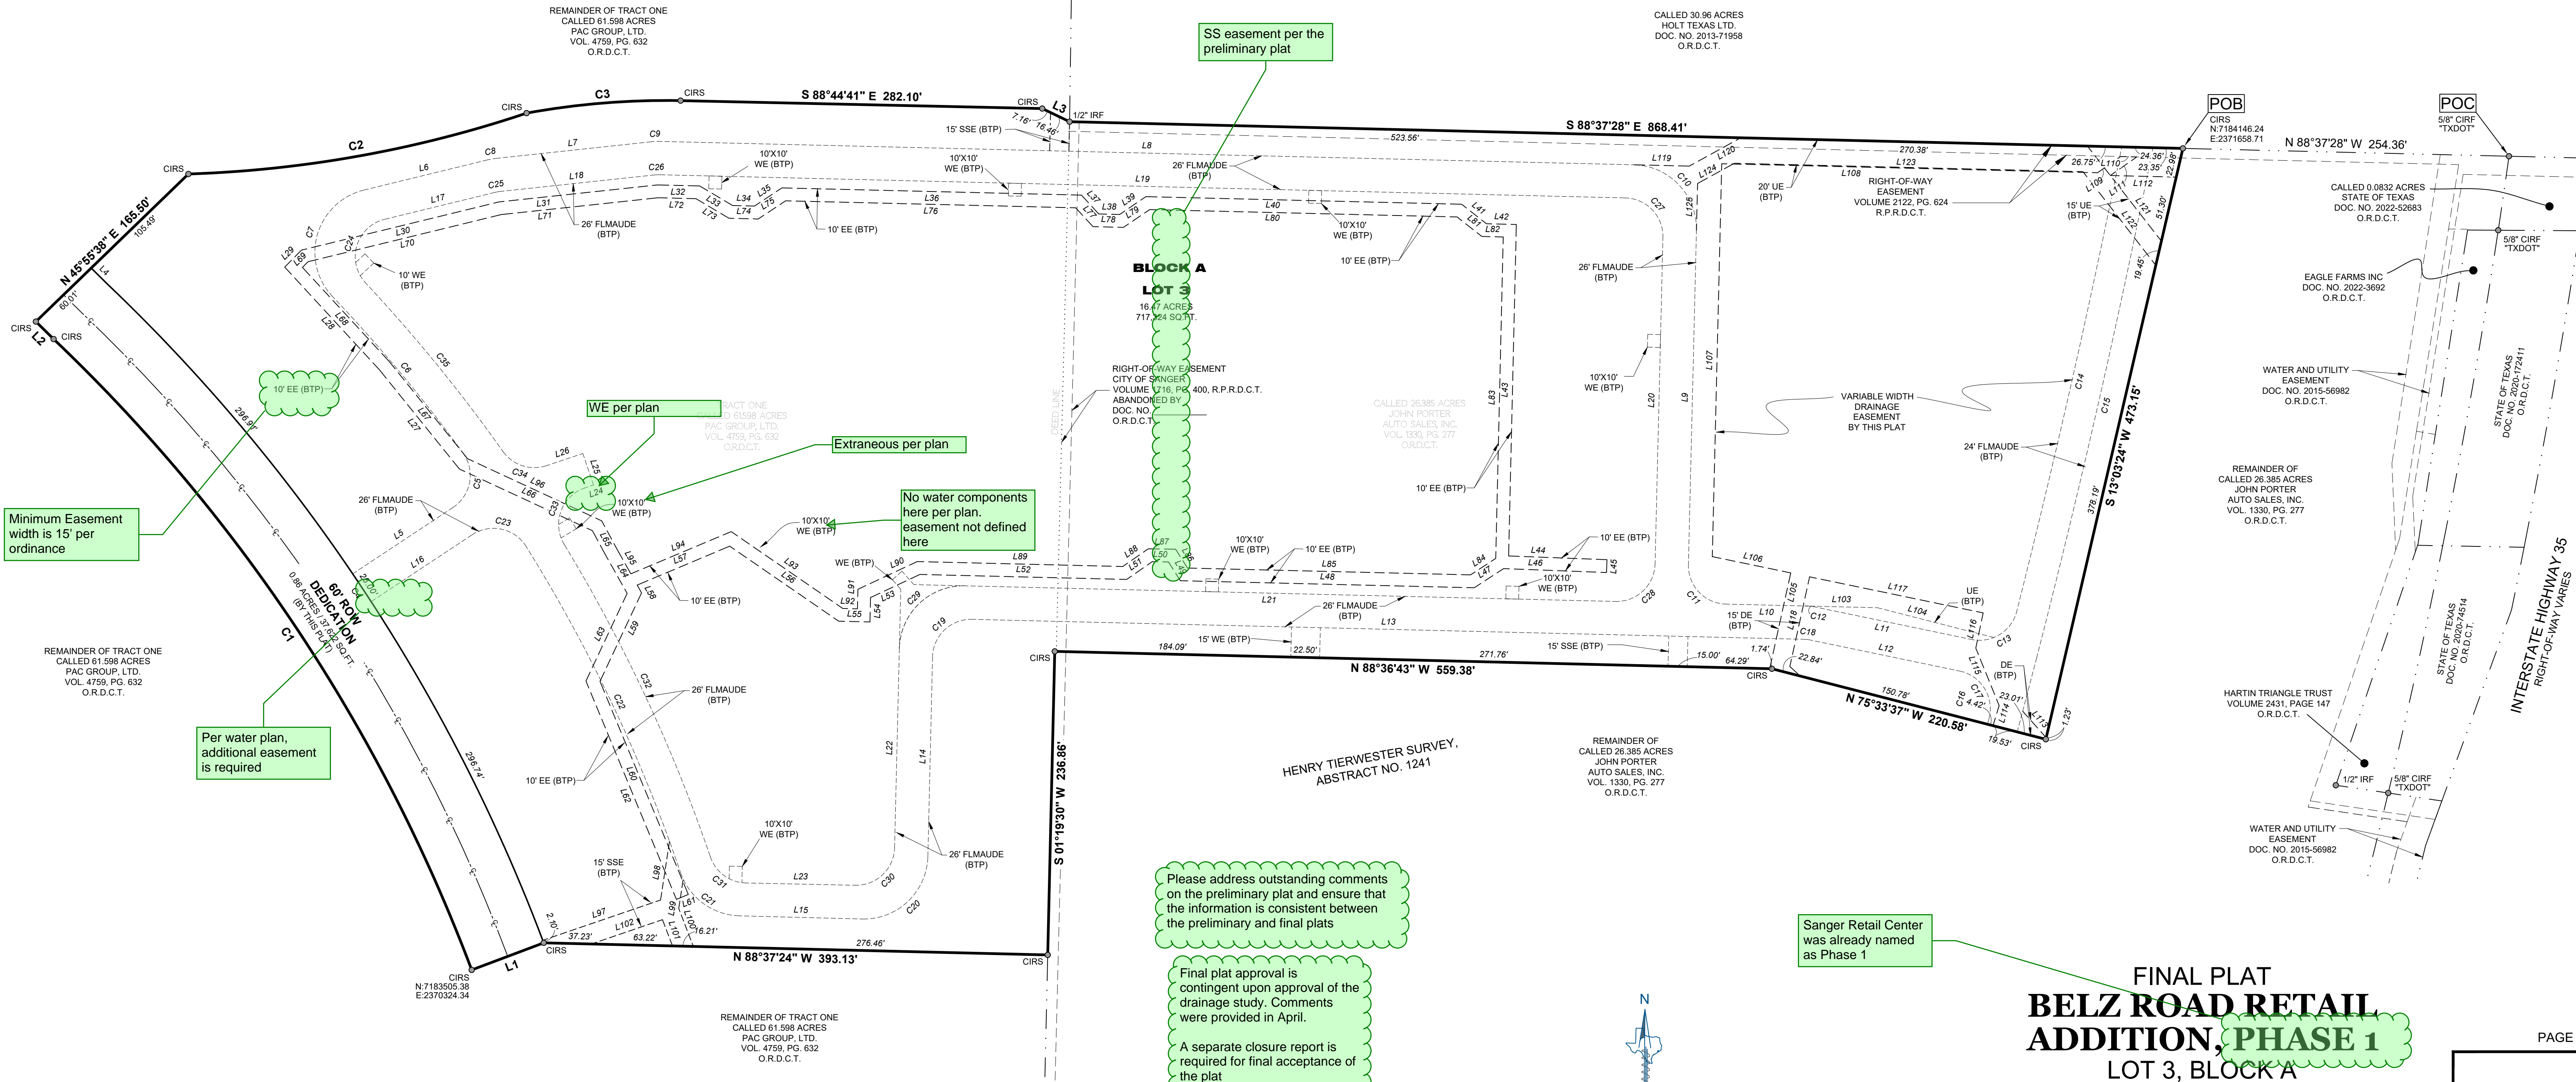



OWNER'S CERTIFICATE & DEDICATION

STATE OF TEXAS §  
COUNTY OF DENTON §

WHEREAS, **JOHN PORTER AUTO SALES, INC.** and **PAC GROUP, LTD.**, are the owners of a 17.33 acre tract or parcel of land situated in the Henry Tierwester Survey, Abstract Number 1241 in Denton County, Texas and being all of a called 26.385 acre tract of land conveyed to John Porter Auto Sales, Inc. by Warranty Deed of record in Volume 1330, Page 277 of the Official Records of Denton County, Texas, and all of a called 61.598 acre tract of land conveyed to Pac Group LTD by Warranty Deed of record in Volume 4759, Page 632 of the Official Records of Denton County, Texas, and being more particularly described by metes and bounds as follows:

**COMMENCING** at a 5/8" iron rod with plastic cap satmped "TXDOT" found in the West right-of-way line of Interstate 35E (right-of-way width varies) and the South line of a called 30.96 acre tract of land conveyed to Holt Texas LTD by Warranty Deed of record in Document Number 2013-71958 of the Official Records of Denton County, Texas, being the Northeast corner of a called 0.0832 acre tract conveyed to the State of Texas by Judgement of Court in Absence of Objection of record in Document Number 2022-52683 of the Official Records of Denton County, Texas;

**THENCE**, N88°37'28"W, along the South line of said 30.96 acre tract, being the common North line of said 26.385 acre tract, a distance of 254.36 feet to a 1/2 inch iron rod with green plastic cap stamped "EAGLE SURVEYING" set at the **POINT OF BEGINNING**;

**THENCE**, over and across said 26.385 acre tract and said 61.598 acre tract, the following thirteen (13) courses and distances:

- S 13°03'24" W a distance of 473.15' to a 1/2 inch iron rod with green plastic cap stamped "EAGLE SURVEYING" set;
- N 75°33'37" W a distance of 220.58' to a 1/2 inch iron rod with green plastic cap stamped "EAGLE SURVEYING" set;
- N 88°36'43" W a distance of 559.38' to a 1/2 inch iron rod with green plastic cap stamped "EAGLE SURVEYING" set;
- S 01°19'30" W a distance of 236.86' to a 1/2 inch iron rod with green plastic cap stamped "EAGLE SURVEYING" set;
- N 88°37'24" W a distance of 393.13' to a 1/2 inch iron rod with green plastic cap stamped "EAGLE SURVEYING" set;
- S 69°22'12" W a distance of 60.00' to a 1/2 inch iron rod with green plastic cap stamped "EAGLE SURVEYING" set;
- With a curve turning to the left with an arc length of 595.33', with a radius of 1322.70', with a chord bearing of N 33°31'27" W, with a chord length of 590.32';thence with a curve to a 1/2 inch iron rod with green plastic cap stamped "EAGLE SURVEYING" set;
- N 45°19'00" W a distance of 19.43' to a 1/2 inch iron rod with green plastic cap stamped "EAGLE SURVEYING" set;
- N 45°55'38" E a distance of 165.50' to a 1/2 inch iron rod with green plastic cap stamped "EAGLE SURVEYING" set;
- With a curve turning to the left with an arc length of 268.88', with a radius of 922.95', with a chord bearing of N 79°47'50" E, with a chord length of 267.93';thence with a curve to a 1/2 inch iron rod with green plastic cap stamped "EAGLE SURVEYING" set;
- With a reverse curve turning to the right with an arc length of 120.72', with a radius of 608.75', with a chord bearing of N 85°21'24" E, with a chord length of 120.52';thence with a reverse curve to a 1/2 inch iron rod with green plastic cap stamped "EAGLE SURVEYING" set;
- S 88°44'41" E a distance of 282.10' to a 1/2 inch iron rod with green plastic cap stamped "EAGLE SURVEYING" set;
- S 64°19'30" E a distance of 23.62' to a 1/2 inch iron rod with green plastic cap stamped "EAGLE SURVEYING" set at the Southwest corner of said 30.96 acre tract,

**THENCE**, S 88°37'28" E, along the South line of said 30.96 acre tract, being the common North line of said 26.385 acre tract, a distance of 868.41' to the point of beginning, and containing 17.33 acres or 754,946 square feet, more or less.

SATE OF TEXAS §  
COUNTY OF DENTON §

NOW THEREFORE KNOW ALL MEN BY THESE PRESENTS:

THAT, **JOHN PORTER AUTO SALES, INC.**, and **PAC GROUP, LTD.** acting herein by and through it duly authorized office, does hereby adopt this plat designating the hereinabove described property as **BELZ ROAD RETAIL ADDITION, PHASE 1, LOT 3, BLOCK A**, an addition to the City of Sanger, Texas, and does hereby dedicate to the public use forever by fee simple title, free and clear of all liens and encumbrances, all streets, thoroughfares, alleys, fire lanes, drive aisles, parks, and watercourses, and to the public use forever easements for sidewalks, storm drainage facilities, utilities, and any other property necessary to serve the plat and to implement the requirements of the subdivision regulations and other City codes and do hereby bind ourselves, our heirs, successors and assigns to warrant and to forever defend the title on the land so dedicated. Further, the undersigned covenants and agrees that he/she shall maintain all easements and facilities in a state of good repair and functional condition at all times in accordance with City codes and regulations. No buildings, fences, trees, shrubs, or other improvements or growths shall be constructed or placed upon, over, or across the easements as shown, except that landscape improvements may be installed, if approved by the City of Sanger. The City of Sanger and public entities shall have the right to access and maintain all respective easements without the necessity at any time of procuring permission from anyone.

OWNER: **JOHN PORTER AUTO SALES, INC.**

BY: \_\_\_\_\_  
Date \_\_\_\_\_

STATE OF TEXAS §  
COUNTY OF \_\_\_\_\_ §

BEFORE ME, the undersigned authority, on this day personally appeared \_\_\_\_\_, known to me to be the person whose name is subscribed to the foregoing instrument, and acknowledged to me that he executed the same for the purposes and considerations therein expressed and in the capacity therein stated.

GIVEN UNDER MY HAND AND SEAL OF THE OFFICE this \_\_\_\_\_ day of \_\_\_\_\_, 2024.

\_\_\_\_\_  
Notary Public in and for the State of Texas

OWNER: **PAC GROUP, LTD**

BY: \_\_\_\_\_  
Date \_\_\_\_\_

STATE OF TEXAS §  
COUNTY OF \_\_\_\_\_ §

BEFORE ME, the undersigned authority, on this day personally appeared \_\_\_\_\_, known to me to be the person whose name is subscribed to the foregoing instrument, and acknowledged to me that he executed the same for the purposes and considerations therein expressed and in the capacity therein stated.

GIVEN UNDER MY HAND AND SEAL OF THE OFFICE this \_\_\_\_\_ day of \_\_\_\_\_, 2024.

\_\_\_\_\_  
Notary Public in and for the State of Texas

CERTIFICATE OF SURVEYOR

STATE OF TEXAS §  
COUNTY OF DENTON §

I, **MATTHEW RAABE**, Registered Professional Land Surveyor, do hereby certify that this plat is true and correct and was prepared from an actual survey made on the ground and that the monuments shown hereon were found or placed with 1/2-inch iron rods with green plastic caps stamped "EAGLE SURVEYING" under my direction and supervision in accordance with the current provisions of the Texas Administrative Code and the Ordinances of the City of Sanger, Denton County, Texas.

PRELIMINARY

this document shall not be recorded  
for any purpose and shall not be  
used or viewed or relied upon as a  
final survey document

Matthew Raabe, R.P.L.S. # 6402

\_\_\_\_\_  
Date

STATE OF TEXAS §  
COUNTY OF TARRANT §

BEFORE ME, the undersigned authority, on this day personally appeared **MATTHEW RAABE**, known to me to be the person whose name is subscribed to the foregoing instrument, and acknowledged to me that he executed the same for the purposes and considerations therein expressed and in the capacity therein stated.

GIVEN UNDER MY HAND AND SEAL OF THE OFFICE this \_\_\_\_\_ day of \_\_\_\_\_, 2024.

\_\_\_\_\_  
Notary Public in and for the State of Texas

APPROVED AND ACCEPTED

CITY OF SANGER  
DENTON COUNTY, TEXAS

\_\_\_\_\_  
Thomas Muir  
Mayor, City of Sanger, Texas

\_\_\_\_\_  
Date

ATTEST:

\_\_\_\_\_  
Cheryl Price, City Secretary  
City of Sanger, Tx

\_\_\_\_\_  
Date

FINAL PLAT  
**BELZ ROAD RETAIL  
ADDITION, PHASE 1**  
LOT 3, BLOCK A

17.33 ACRES  
0.86 ACRES - RIGHT-OF-WAY DEDICATION

HENRY TIERWESTER SURVEY, ABSTRACT No. 1241  
CITY OF SANGER, DENTON COUNTY, TEXAS

Project 2108.092-XX	 <b>EAGLE SURVEYING, LLC</b> 222 S. Elm Street, Suite: 200 Denton, TX 76201 (940) 222-3009 TX Firm #10194177
Date 07/15/2024	
Drafter BE	

**SURVEYOR**  
Eagle Surveying, LLC  
222 S. Elm Street, Suite: 200  
Denton, TX 76201  
(940) 222-3009

**ENGINEER**  
Claymoore Engineering, Inc.  
1903 Central Drive, Suite: 406  
Bedford, TX 76021

**OWNER**  
John Porter Autos Sales, Inc.  
PO Box 178  
Sanger, TX 76266



**OWNER**  
Pac Group, Ltd.  
PO Box 877  
Sanger, TX 76266








PLOTTED BY: DAN CABALLERO  
PLOT DATE: 7/17/2024 10:00 AM  
LOCATION: Z:\PROJECTS\PROJECTS\2022-185 MALOUF SANGER\CADD\SHEETS\MULTI-FAMILY GREYSTAR\EROSION CONTROL PLAN.DWG  
LAST SAVED: 7/16/2024 8:17 AM

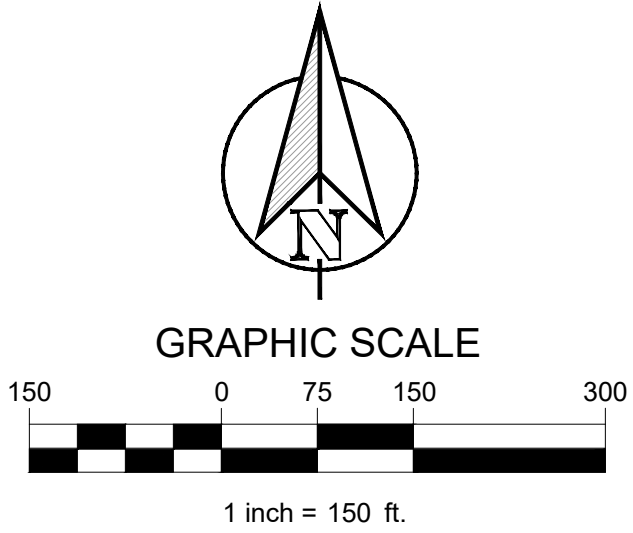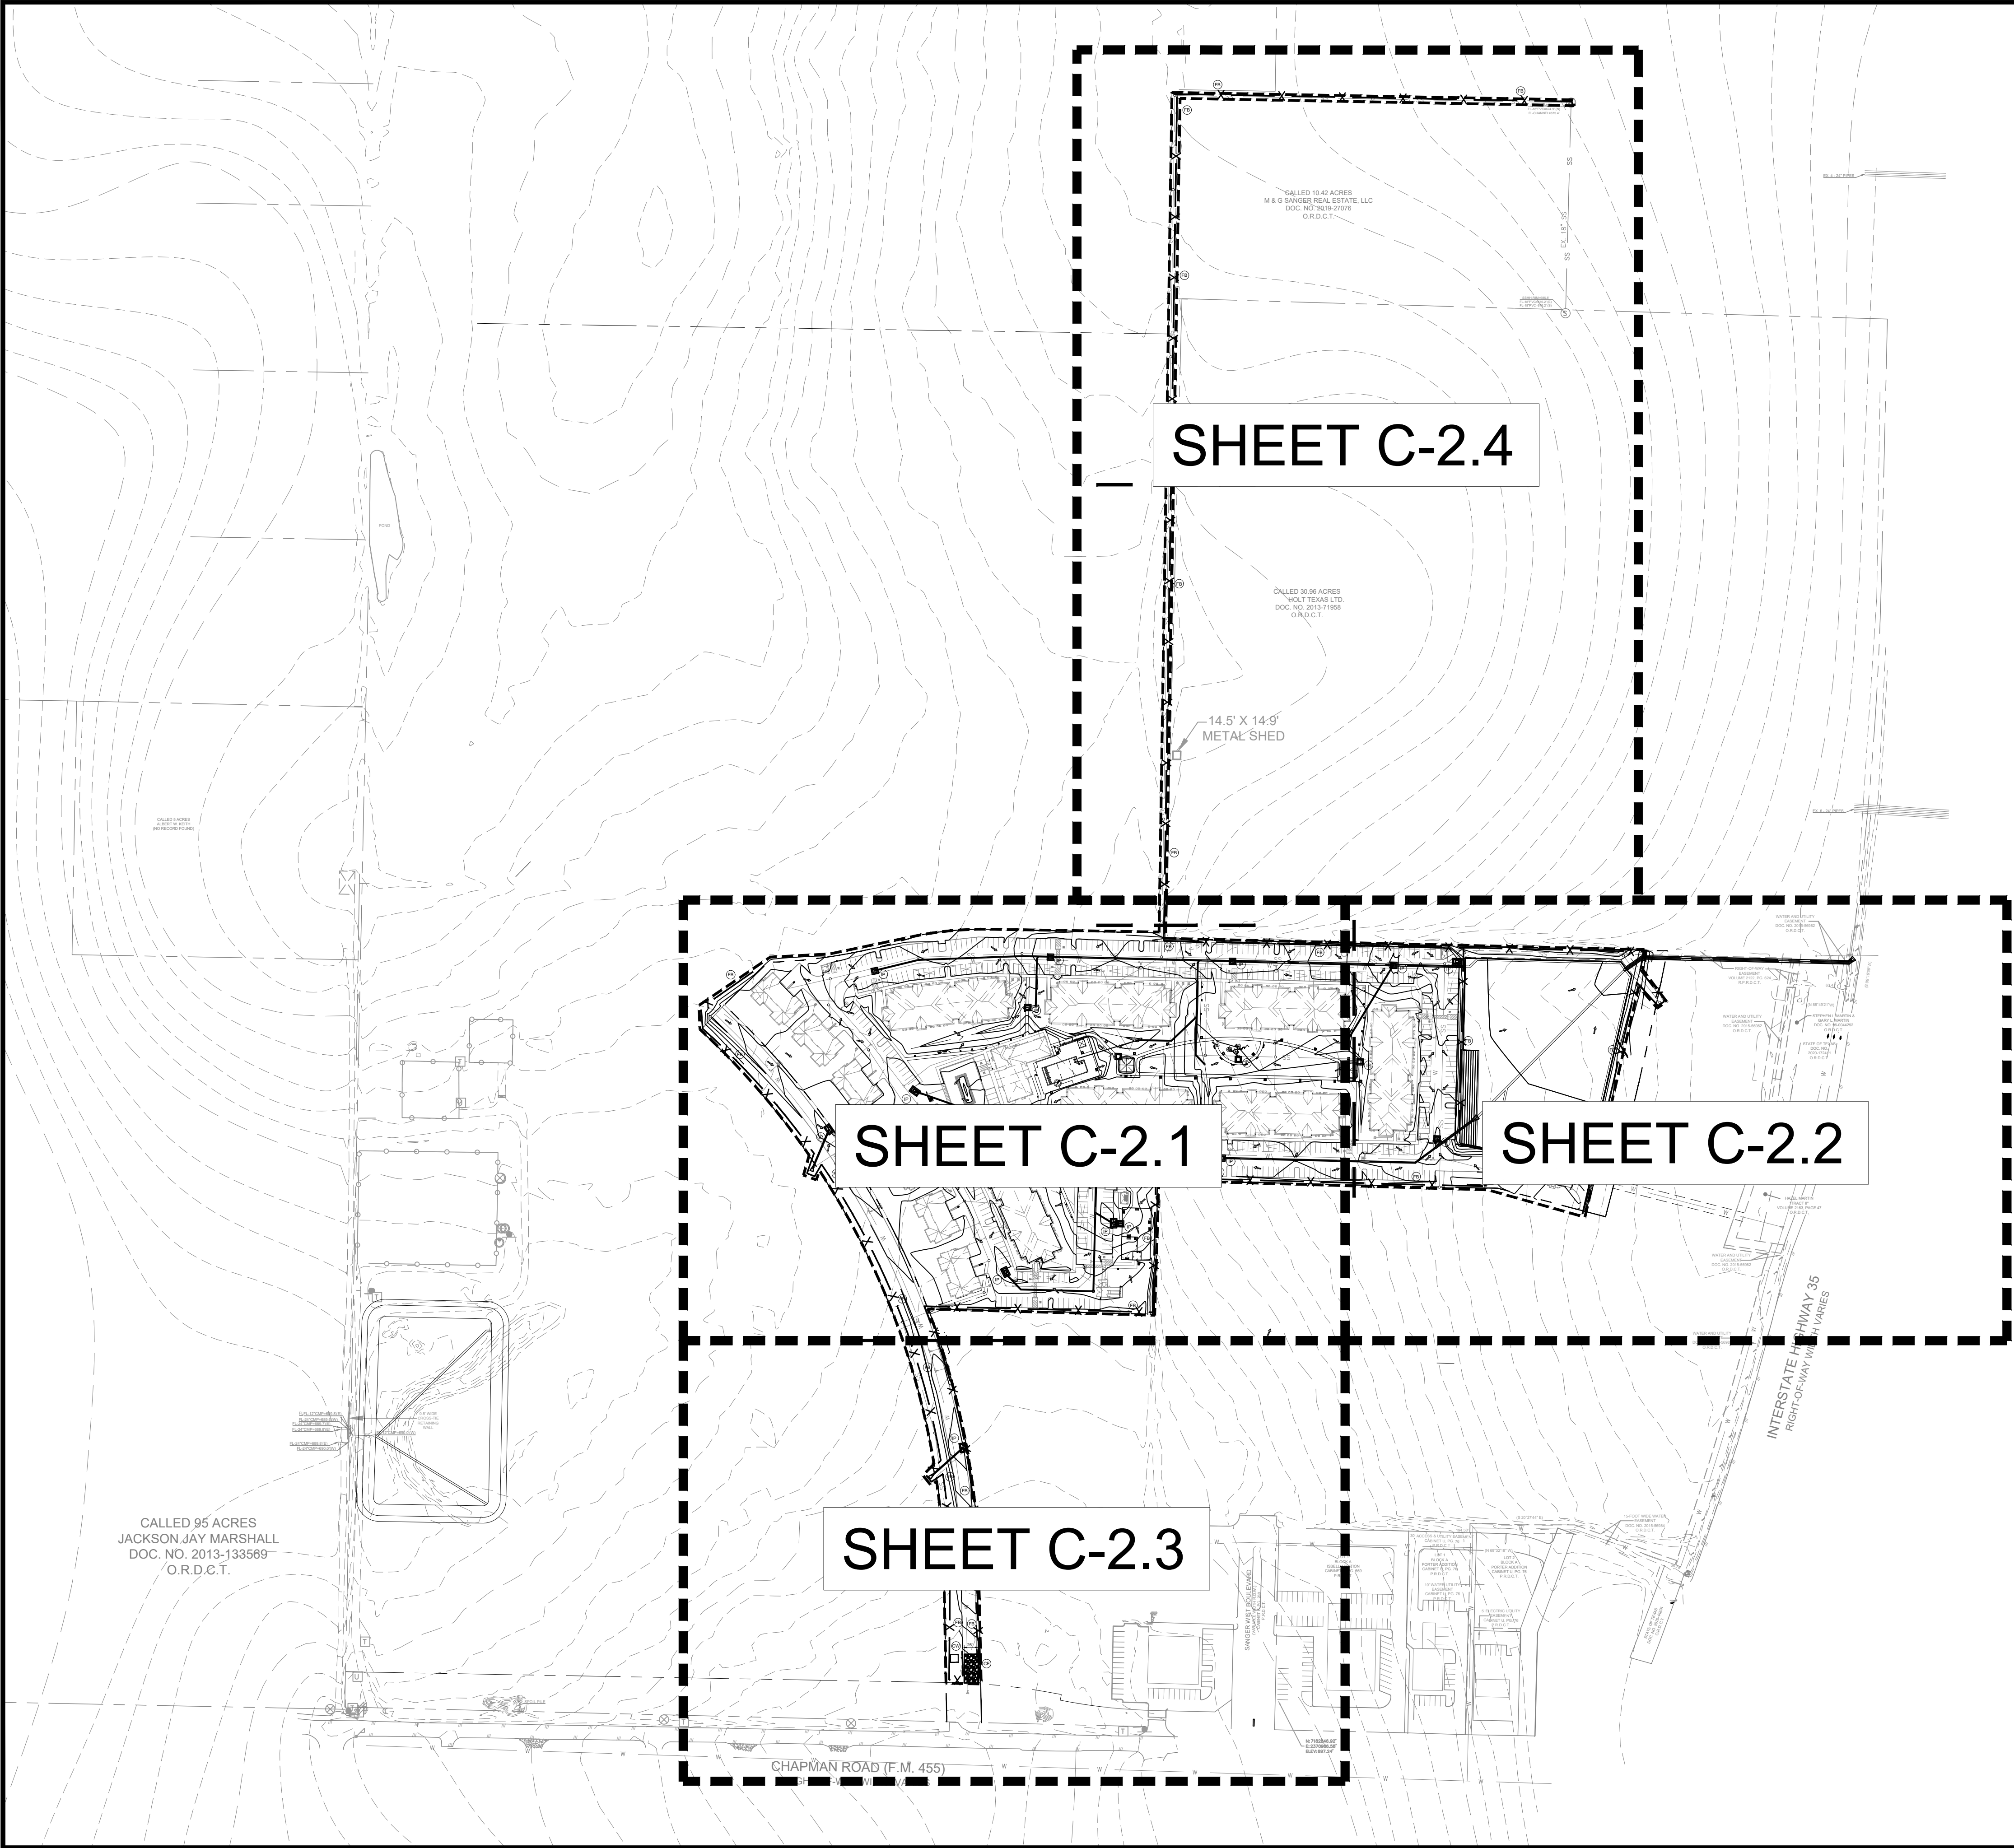

No.	DATE	REVISION	BY



PLOTTED BY: DAN CABALLERO  
PLOT DATE: 7/17/2024 10:00 AM  
LOCATION: Z:\PROJECTS\PROJECTS\2022-185 MALOUF SANGER\CADD\SHEETS\MULTI-FAMILY GREYSTAR\EROSION CONTROL PLAN.DWG  
LAST SAVED: 7/16/2024 8:17 AM

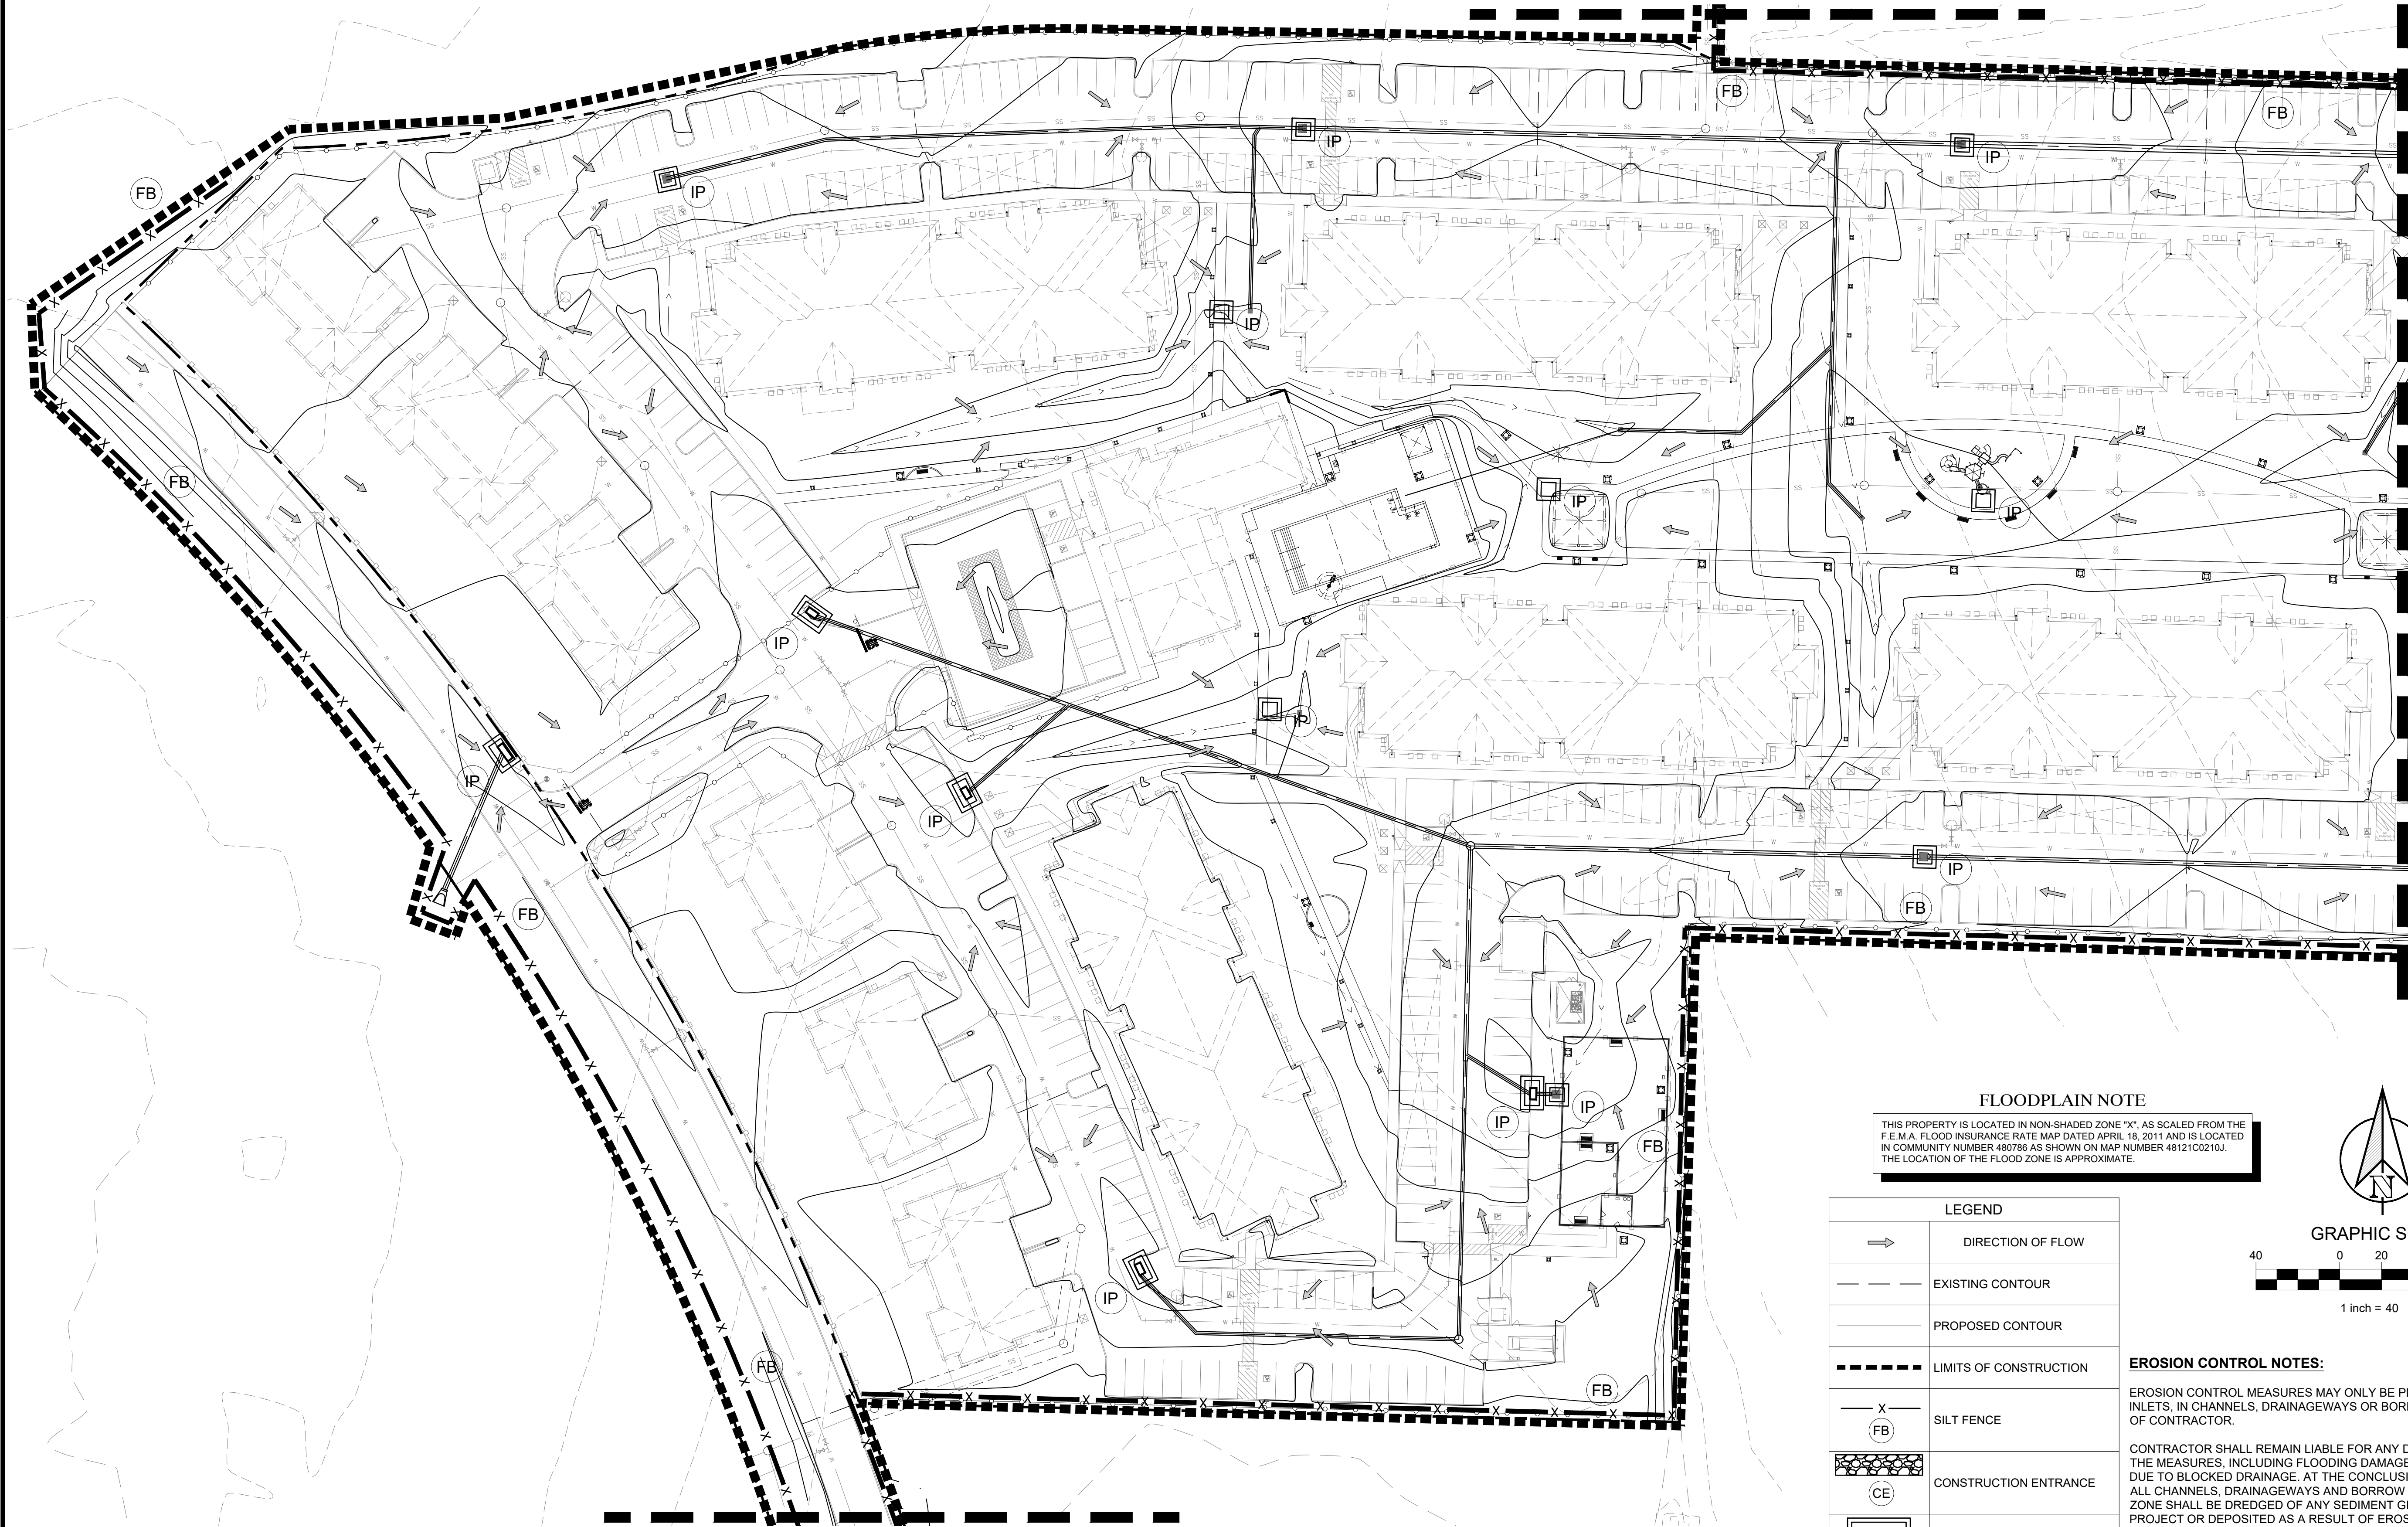

MATCHLINE SHEET C-2.3

MATCHLINE SHEET C-2.4

MATCHLINE SHEET C-2.2

**FLOODPLAIN NOTE**

THIS PROPERTY IS LOCATED IN NON-SHADED ZONE "X", AS SCALED FROM THE F.E.M.A. FLOOD INSURANCE RATE MAP DATED APRIL '18, 2011 AND IS LOCATED IN COMMUNITY NUMBER 480788 AS SHOWN ON MAP NUMBER 48121C0210J. THE LOCATION OF THE FLOOD ZONE IS APPROXIMATE.

**LEGEND**

	DIRECTION OF FLOW
	EXISTING CONTOUR
	PROPOSED CONTOUR
	LIMITS OF CONSTRUCTION
	SILT FENCE
	CONSTRUCTION ENTRANCE
	INLET PROTECTION
	CONCRETE WASHOUT AREA

**GRAPHIC SCALE**

40 0 20 40 80

1 inch = 40 ft.

**EROSION CONTROL NOTES:**

EROSION CONTROL MEASURES MAY ONLY BE PLACED IN FRONT OF INLETS, IN CHANNELS, DRAINAGEWAYS OR BORROW DITCHES AT RISK OF CONTRACTOR.

CONTRACTOR SHALL REMAIN LIABLE FOR ANY DAMAGE CAUSED BY THE MEASURES, INCLUDING FLOODING DAMAGE, WHICH MAY OCCUR DUE TO BLOCKED DRAINAGE. AT THE CONCLUSION OF ANY PROJECT, ALL CHANNELS, DRAINAGEWAYS AND BORROW DITCHES IN THE WORK ZONE SHALL BE DREDGED OF ANY SEDIMENT GENERATED BY THE PROJECT OR DEPOSITED AS A RESULT OF EROSION CONTROL MEASURES.



SOD 4 FEET BEHIND BACK OF CURB, CURLEX (ONE ROLL WIDTH) WITH SEED BEHIND SOD, PERENNIAL SEED BEHIND CURLEX.

No.	DATE	REVISION	BY



PLOTTED BY: DAN CABALLERO  
 PLOT DATE: 7/17/2024 10:00 AM  
 LOCATION: Z:\PROJECTS\PROJECTS\2022-185 MALOUF SANGER\CADD\SHEETS\MULTI-FAMILY GREYSTAR\EROSION CONTROL PLAN.DWG  
 LAST SAVED: 7/16/2024 8:17 AM

MATCHLINE SHEET C-2.1

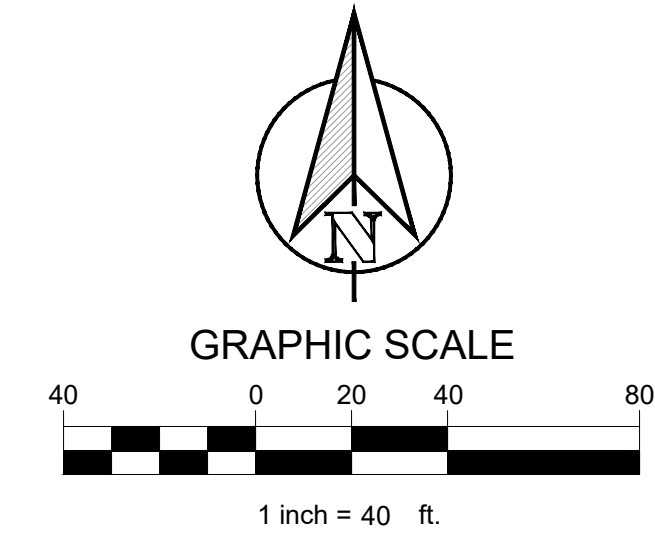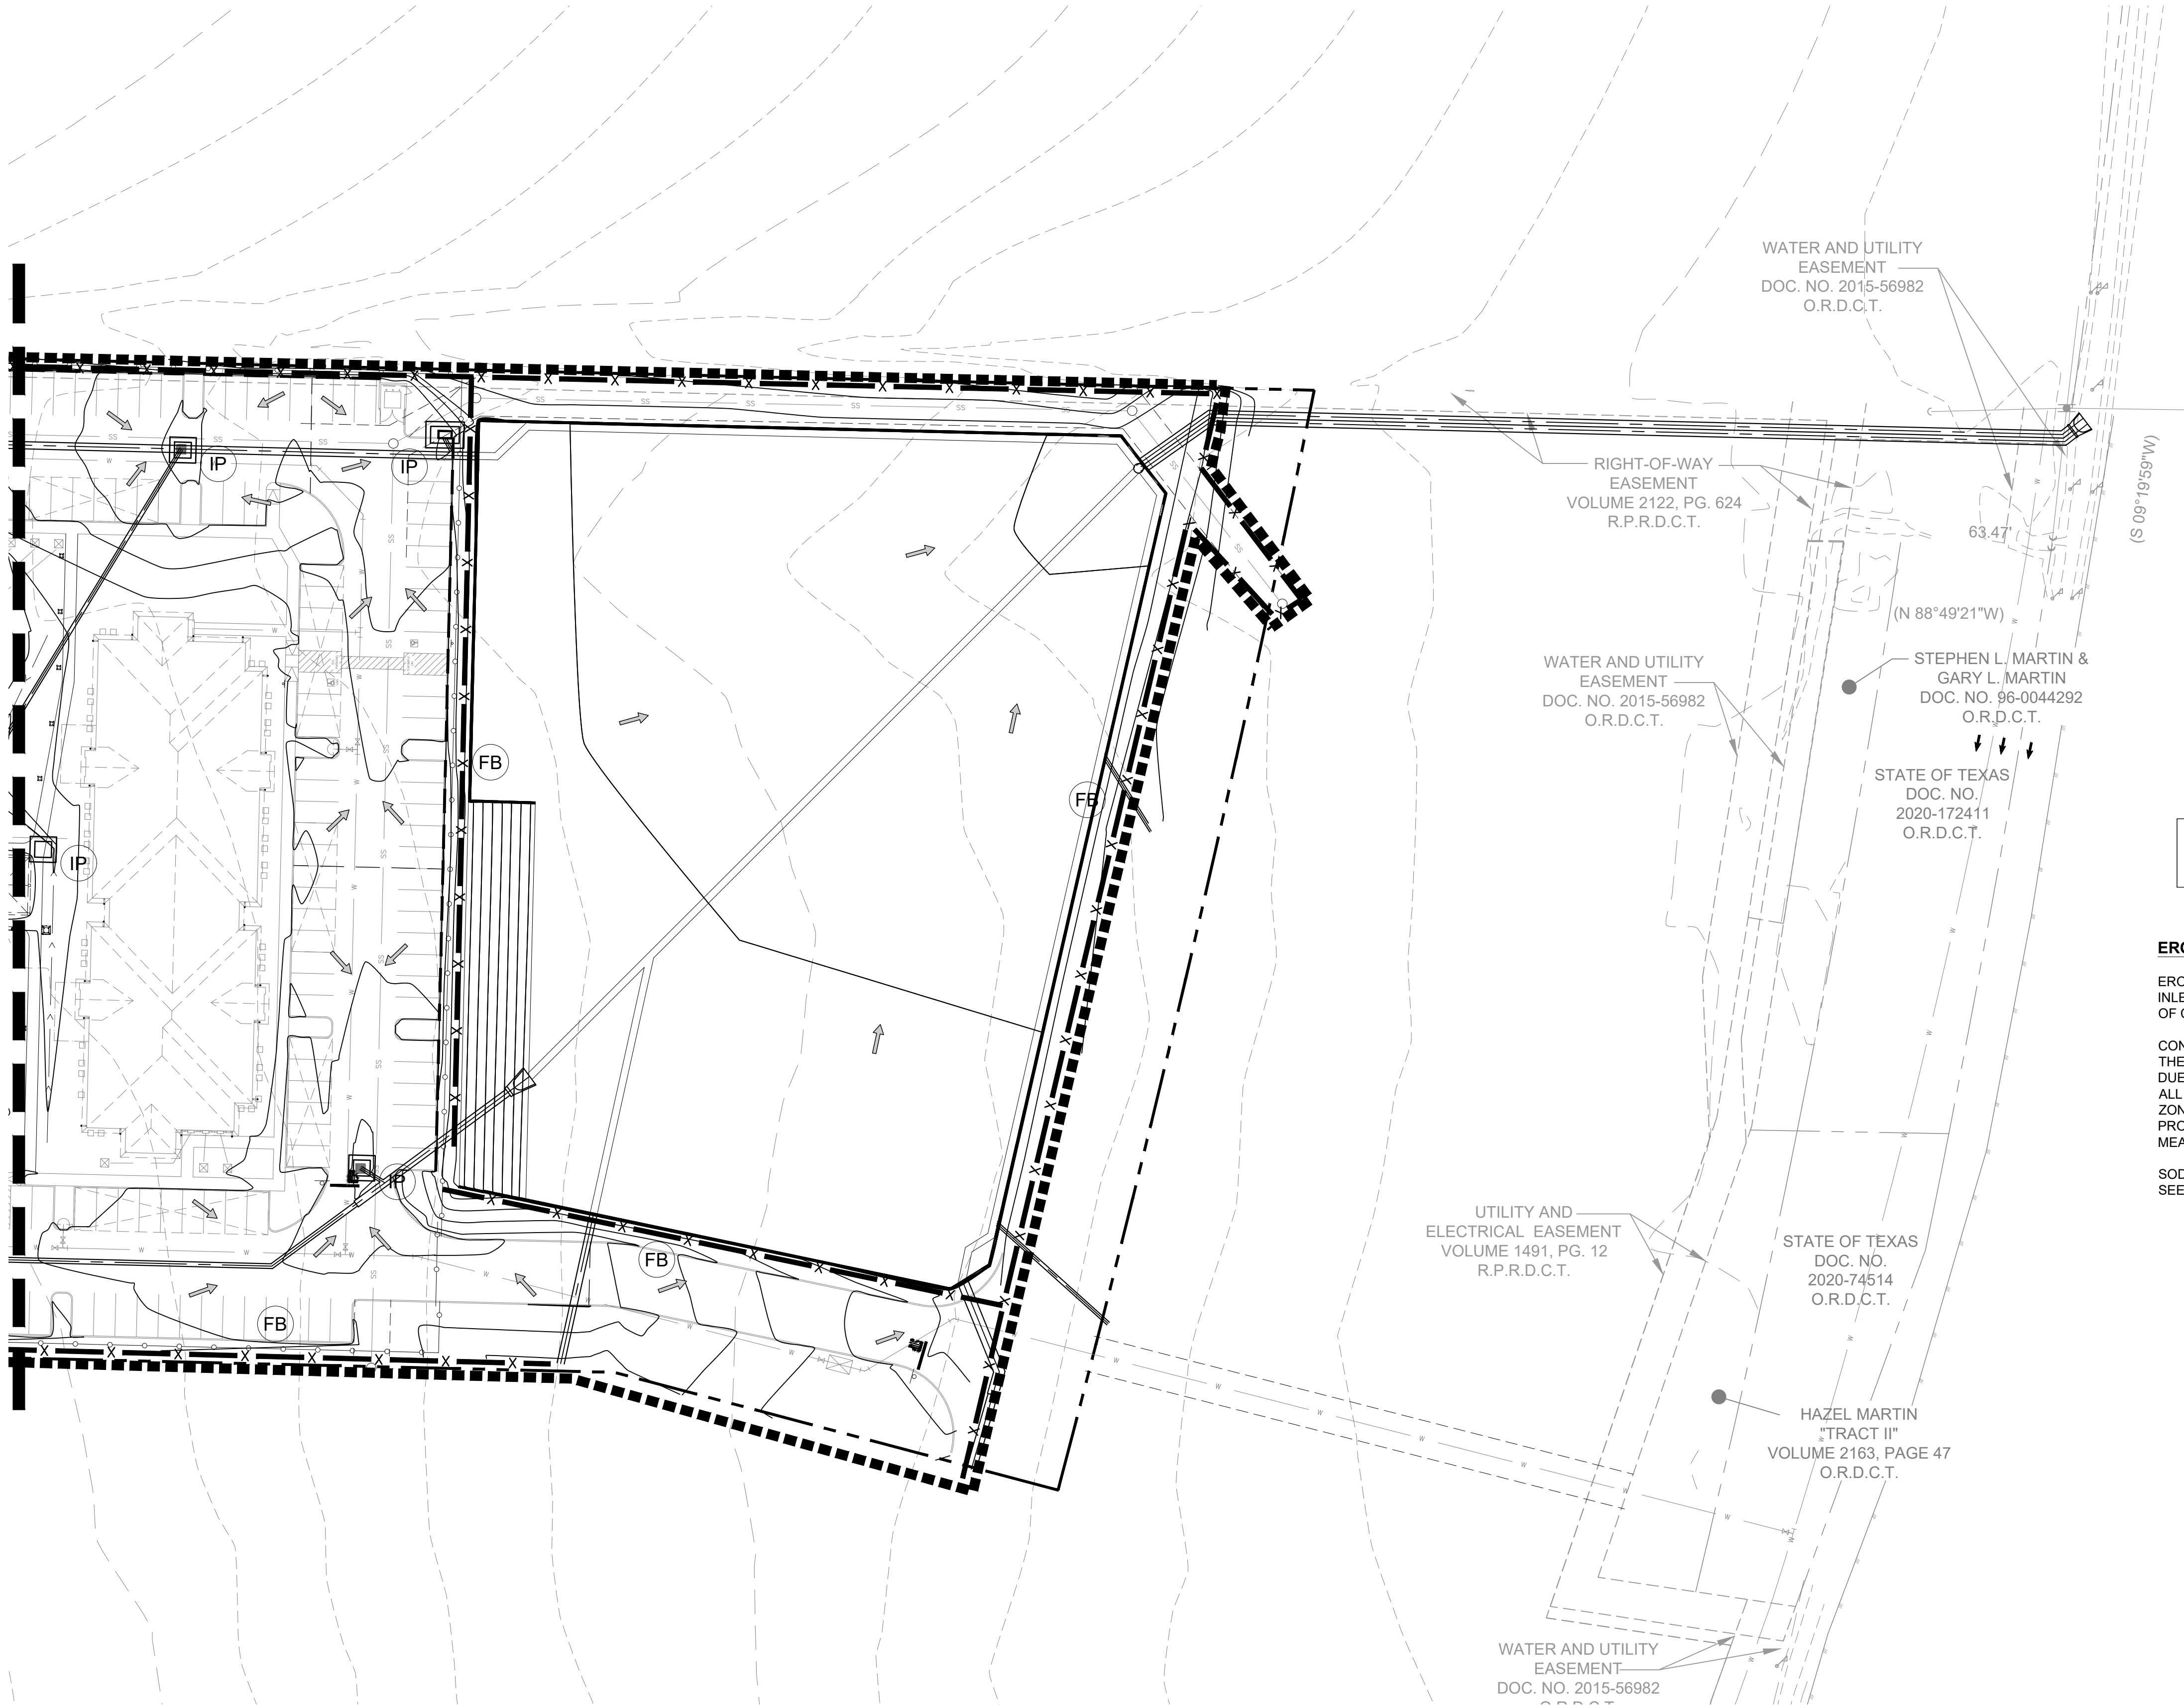

LEGEND	
	DIRECTION OF FLOW
	EXISTING CONTOUR
	PROPOSED CONTOUR
	LIMITS OF CONSTRUCTION
	SILT FENCE
	CONSTRUCTION ENTRANCE
	INLET PROTECTION
	CONCRETE WASHOUT AREA

**FLOODPLAIN NOTE**

THIS PROPERTY IS LOCATED IN NON-SHADED ZONE "X", AS SCALED FROM THE F.E.M.A. FLOOD INSURANCE RATE MAP DATED APRIL 18, 2011 AND IS LOCATED IN COMMUNITY NUMBER 480786 AS SHOWN ON MAP NUMBER 48121C0210J. THE LOCATION OF THE FLOOD ZONE IS APPROXIMATE.

**EROSION CONTROL NOTES:**

EROSION CONTROL MEASURES MAY ONLY BE PLACED IN FRONT OF INLETS, IN CHANNELS, DRAINAGEWAYS OR BORROW DITCHES AT RISK OF CONTRACTOR.

CONTRACTOR SHALL REMAIN LIABLE FOR ANY DAMAGE CAUSED BY THE MEASURES, INCLUDING FLOODING DAMAGE, WHICH MAY OCCUR DUE TO BLOCKED DRAINAGE. AT THE CONCLUSION OF ANY PROJECT, ALL CHANNELS, DRAINAGEWAYS AND BORROW DITCHES IN THE WORK ZONE SHALL BE DREDGED OF ANY SEDIMENT GENERATED BY THE PROJECT OR DEPOSITED AS A RESULT OF EROSION CONTROL MEASURES.

SOD 4 FEET BEHIND BACK OF CURB, CURLEX (ONE ROLL WIDTH) WITH SEED BEHIND SOD, PERENNIAL SEED BEHIND CURLEX.



**PRELIMINARY**  
 FOR REVIEW ONLY  
 Not for construction purposes.  
**CLAYMOORE ENGINEERING**  
 ENGINEERING AND PLANNING CONSULTANTS  
 Engineer: DREW DONOSKY  
 P.E. No.125651 Date 7/17/2024

**SANGER MULTI-FAMILY**  
**PREPARED FOR**  
**GREYSTAR**  
**SANGER, TEXAS**

NO.	DATE	REVISION	BY



PLOTTED BY: DAN CABALLERO  
 PLOT DATE: 7/17/2024 10:00 AM  
 LOCATION: Z:\PROJECTS\PROJECTS\2022-185 MALOUF SANGER\CADD\SHEETS\MULTI-FAMILY GREYSTAR\EROSION CONTROL PLAN.DWG  
 LAST SAVED: 7/16/2024 8:17 AM

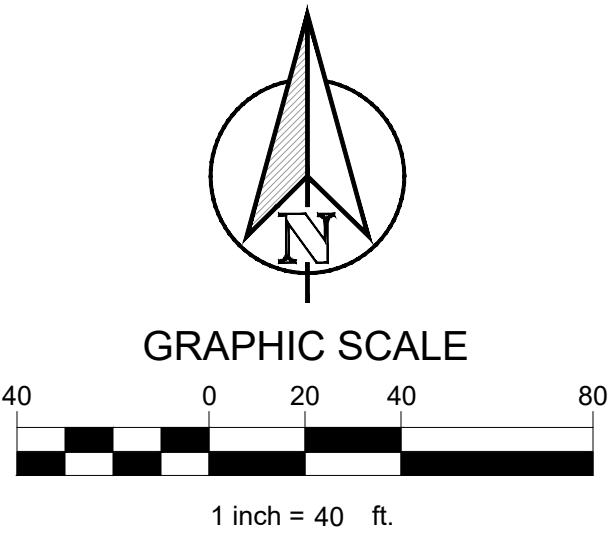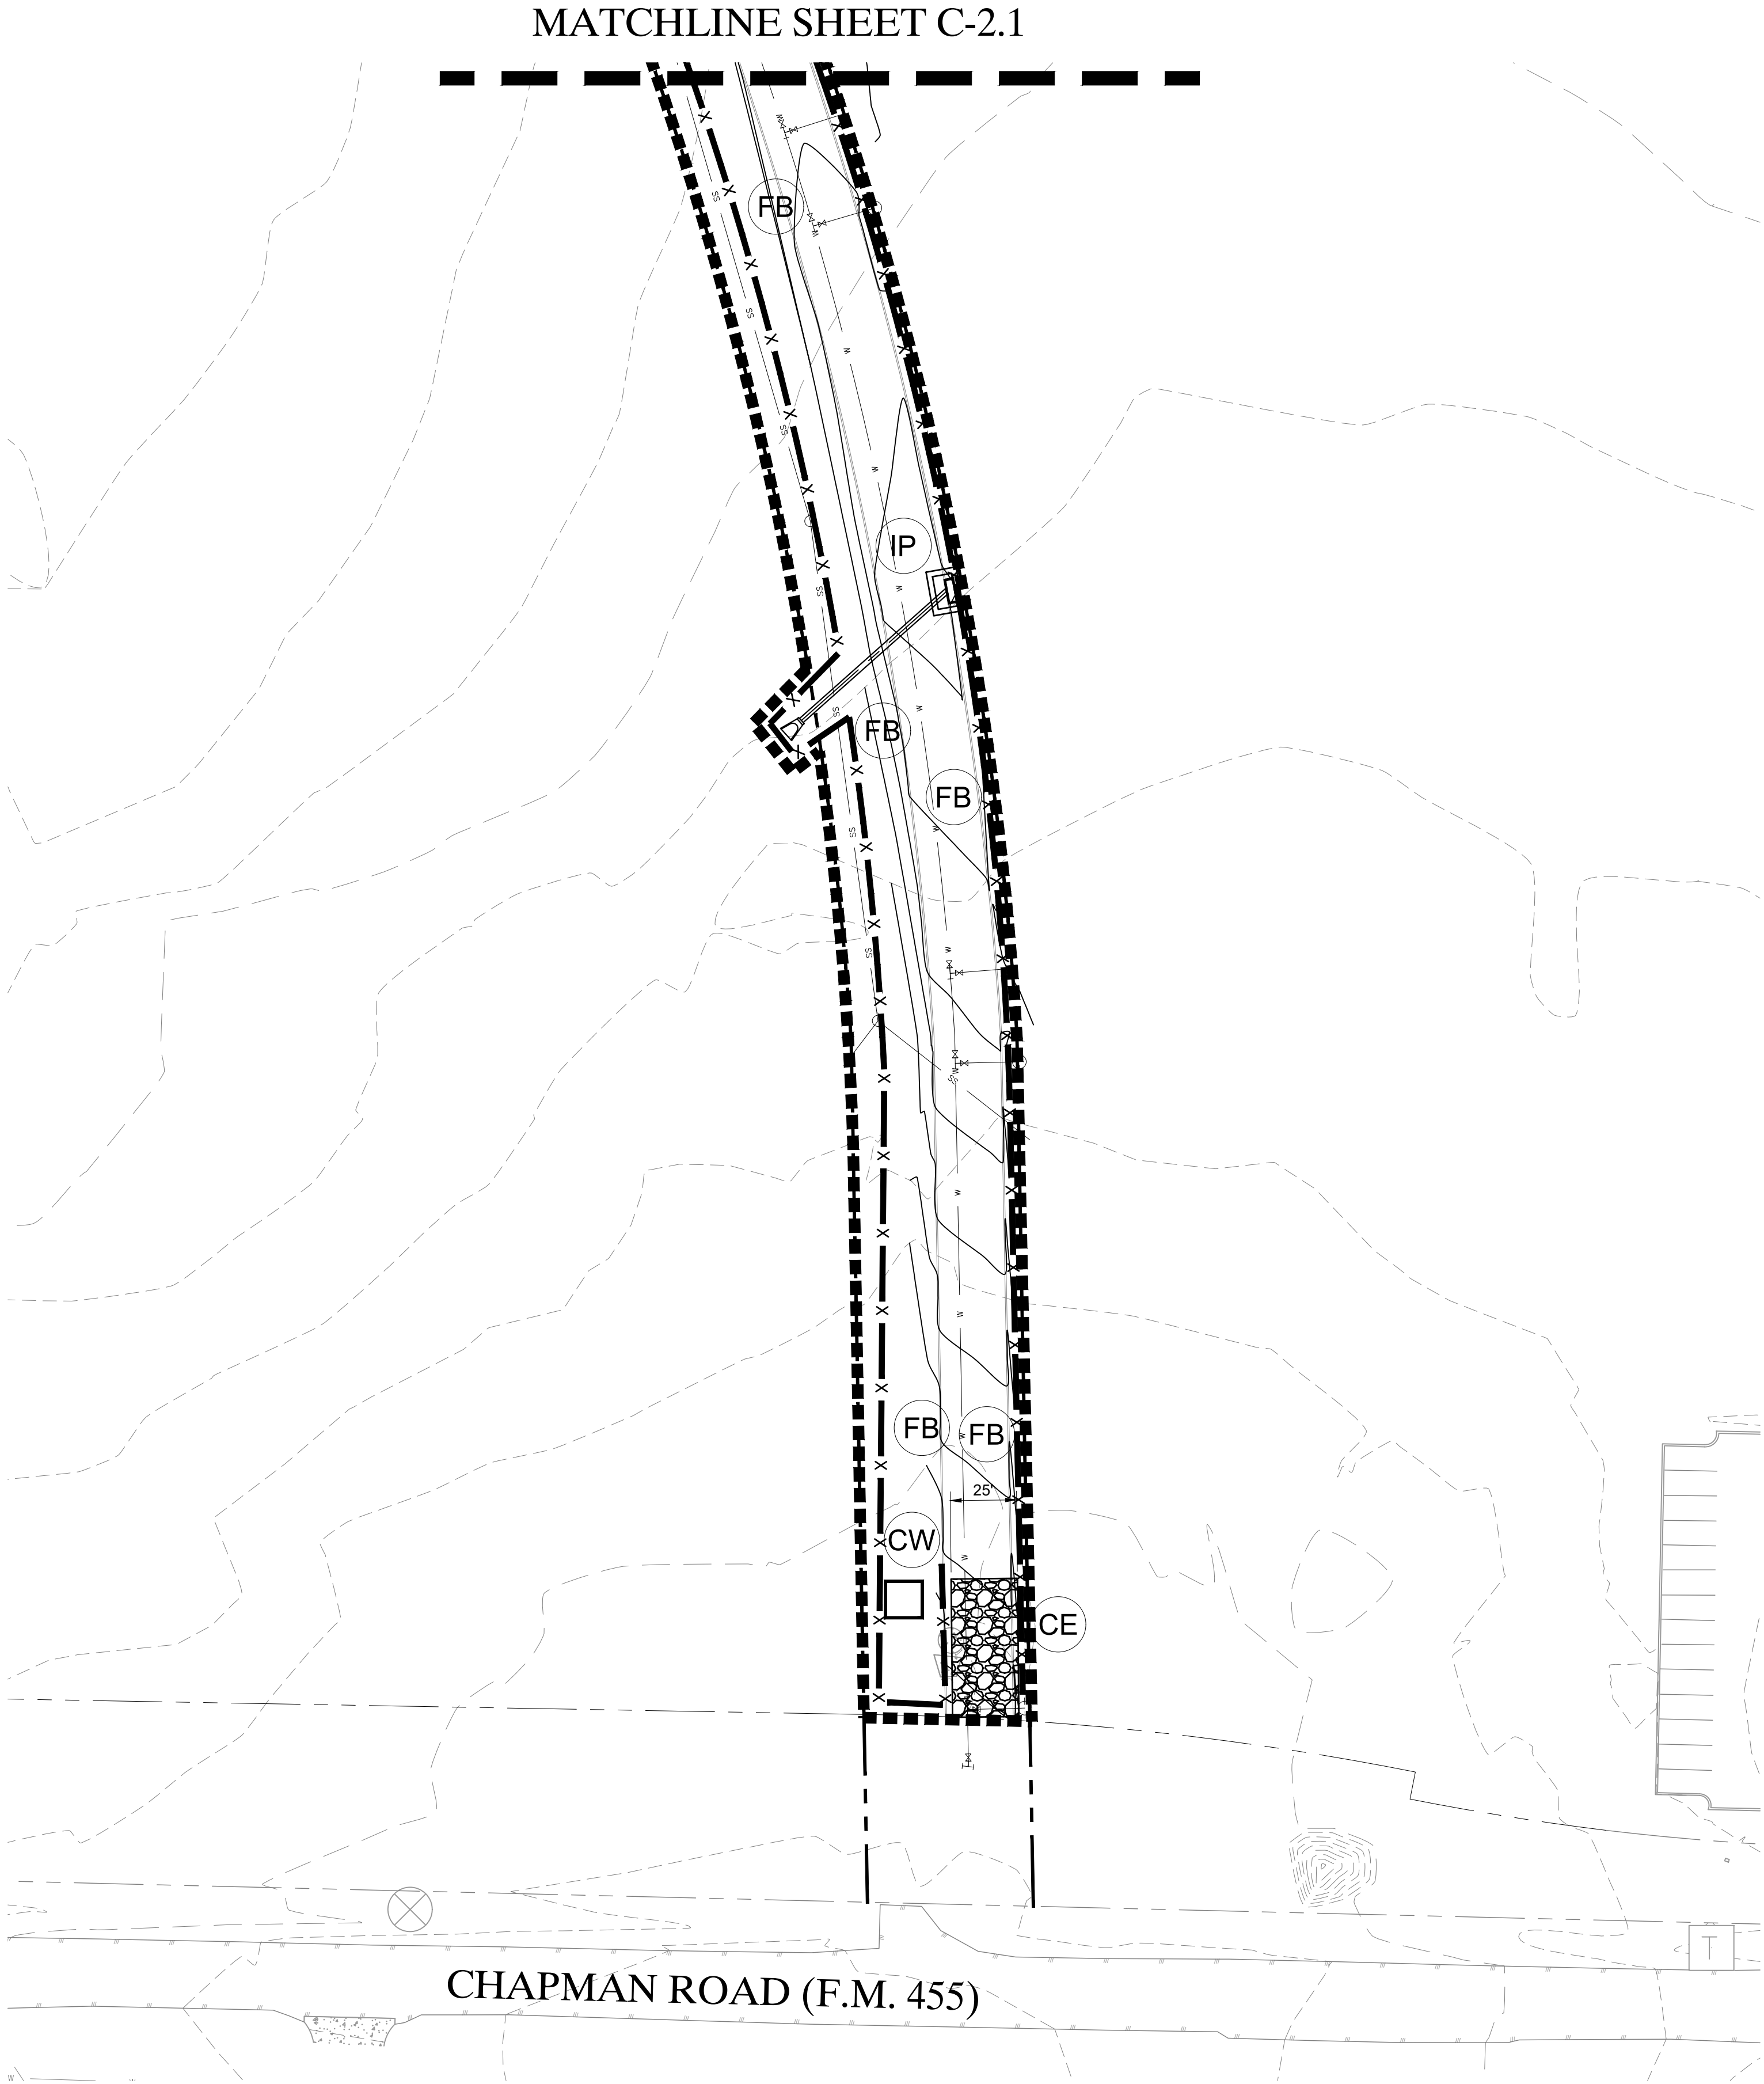

LEGEND	
	DIRECTION OF FLOW
	EXISTING CONTOUR
	PROPOSED CONTOUR
	LIMITS OF CONSTRUCTION
	SILT FENCE
	CONSTRUCTION ENTRANCE
	INLET PROTECTION
	CONCRETE WASHOUT AREA

**FLOODPLAIN NOTE**

THIS PROPERTY IS LOCATED IN NON-SHADED ZONE "X", AS SCALED FROM THE F.E.M.A. FLOOD INSURANCE RATE MAP DATED APRIL 18, 2011 AND IS LOCATED IN COMMUNITY NUMBER 480788 AS SHOWN ON MAP NUMBER 48121C0210J. THE LOCATION OF THE FLOOD ZONE IS APPROXIMATE.

**EROSION CONTROL NOTES:**

EROSION CONTROL MEASURES MAY ONLY BE PLACED IN FRONT OF INLETS, IN CHANNELS, DRAINAGEWAYS OR BORROW DITCHES AT RISK OF CONTRACTOR.

CONTRACTOR SHALL REMAIN LIABLE FOR ANY DAMAGE CAUSED BY THE MEASURES, INCLUDING FLOODING DAMAGE, WHICH MAY OCCUR DUE TO BLOCKED DRAINAGE. AT THE CONCLUSION OF ANY PROJECT, ALL CHANNELS, DRAINAGEWAYS AND BORROW DITCHES IN THE WORK ZONE SHALL BE DREDGED OF ANY SEDIMENT GENERATED BY THE PROJECT OR DEPOSITED AS A RESULT OF EROSION CONTROL MEASURES.

SOD 4 FEET BEHIND BACK OF CURB, CURLEX (ONE ROLL WIDTH) WITH SEED BEHIND SOD, PERENNIAL SEED BEHIND CURLEX.

**PRELIMINARY**  
 FOR REVIEW ONLY  
 Not for construction purposes.  
**CLAYMOORE ENGINEERING**  
 ENGINEERING AND PLANNING CONSULTANTS  
 Engineer: DREW DONOSKY  
 P.E. No.125651 Date 7/17/2024


SANGER MULTI-FAMILY  
 PREPARED FOR  
 GREYSTAR  
 SANGER, TEXAS

No.	DATE	REVISION	BY




PLOTTED BY: DAN CABALLERO  
 PLOT DATE: 7/17/2024 10:01 AM  
 LOCATION: Z:\PROJECTS\PROJECTS\2022-185 MALOUF SANGER\CADD\SHEETS\MULTI-FAMILY GREYSTAR\EROSION CONTROL PLAN.DWG  
 LAST SAVED: 7/16/2024 8:17 AM

MATCHLINE THIS SHEET

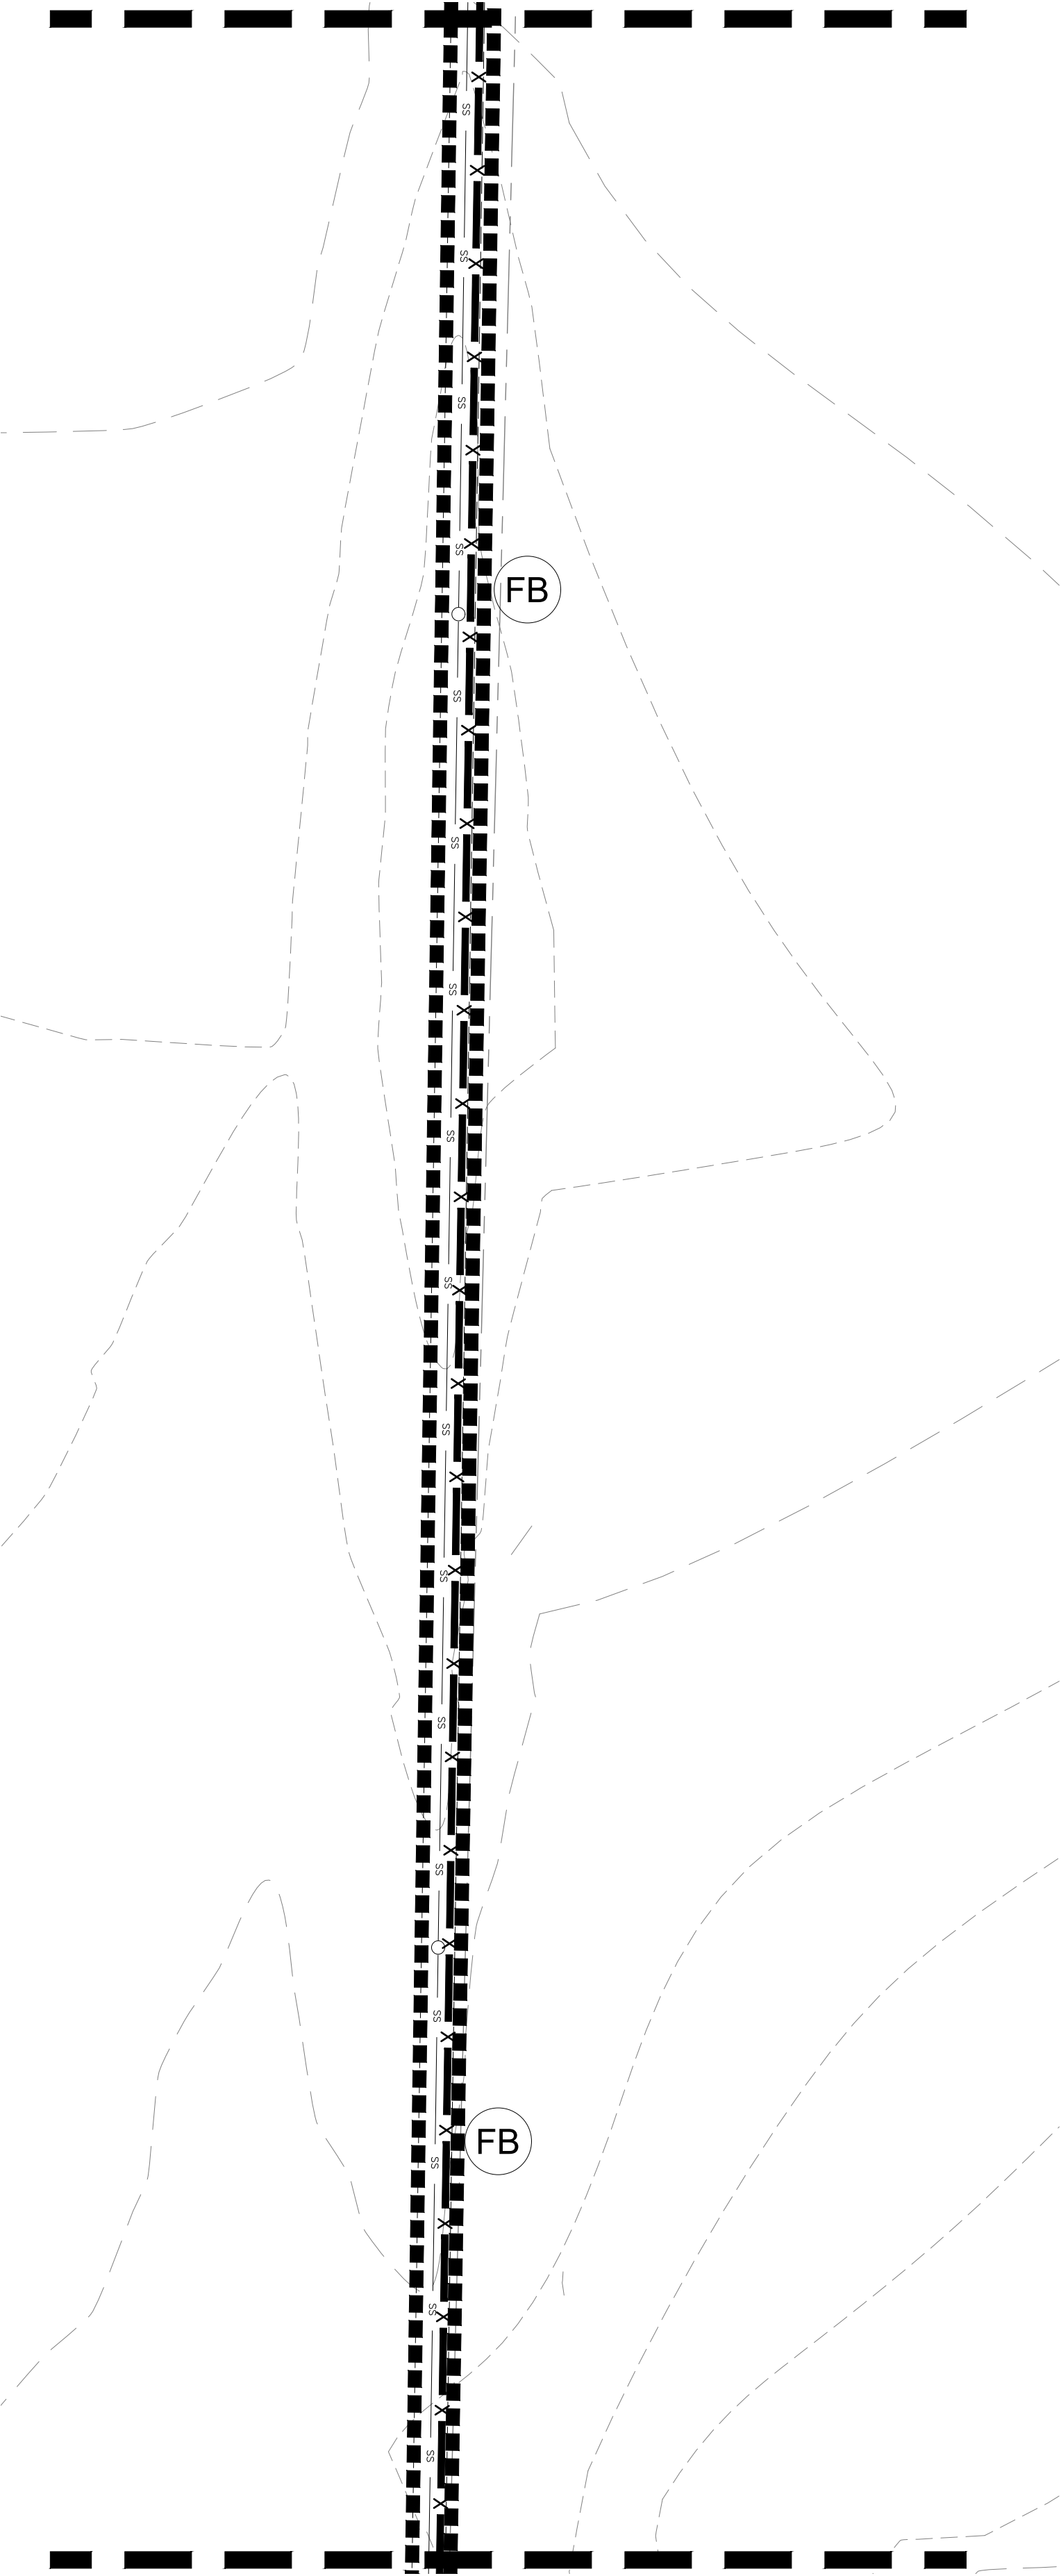

MATCHLINE SHEET C-2.1

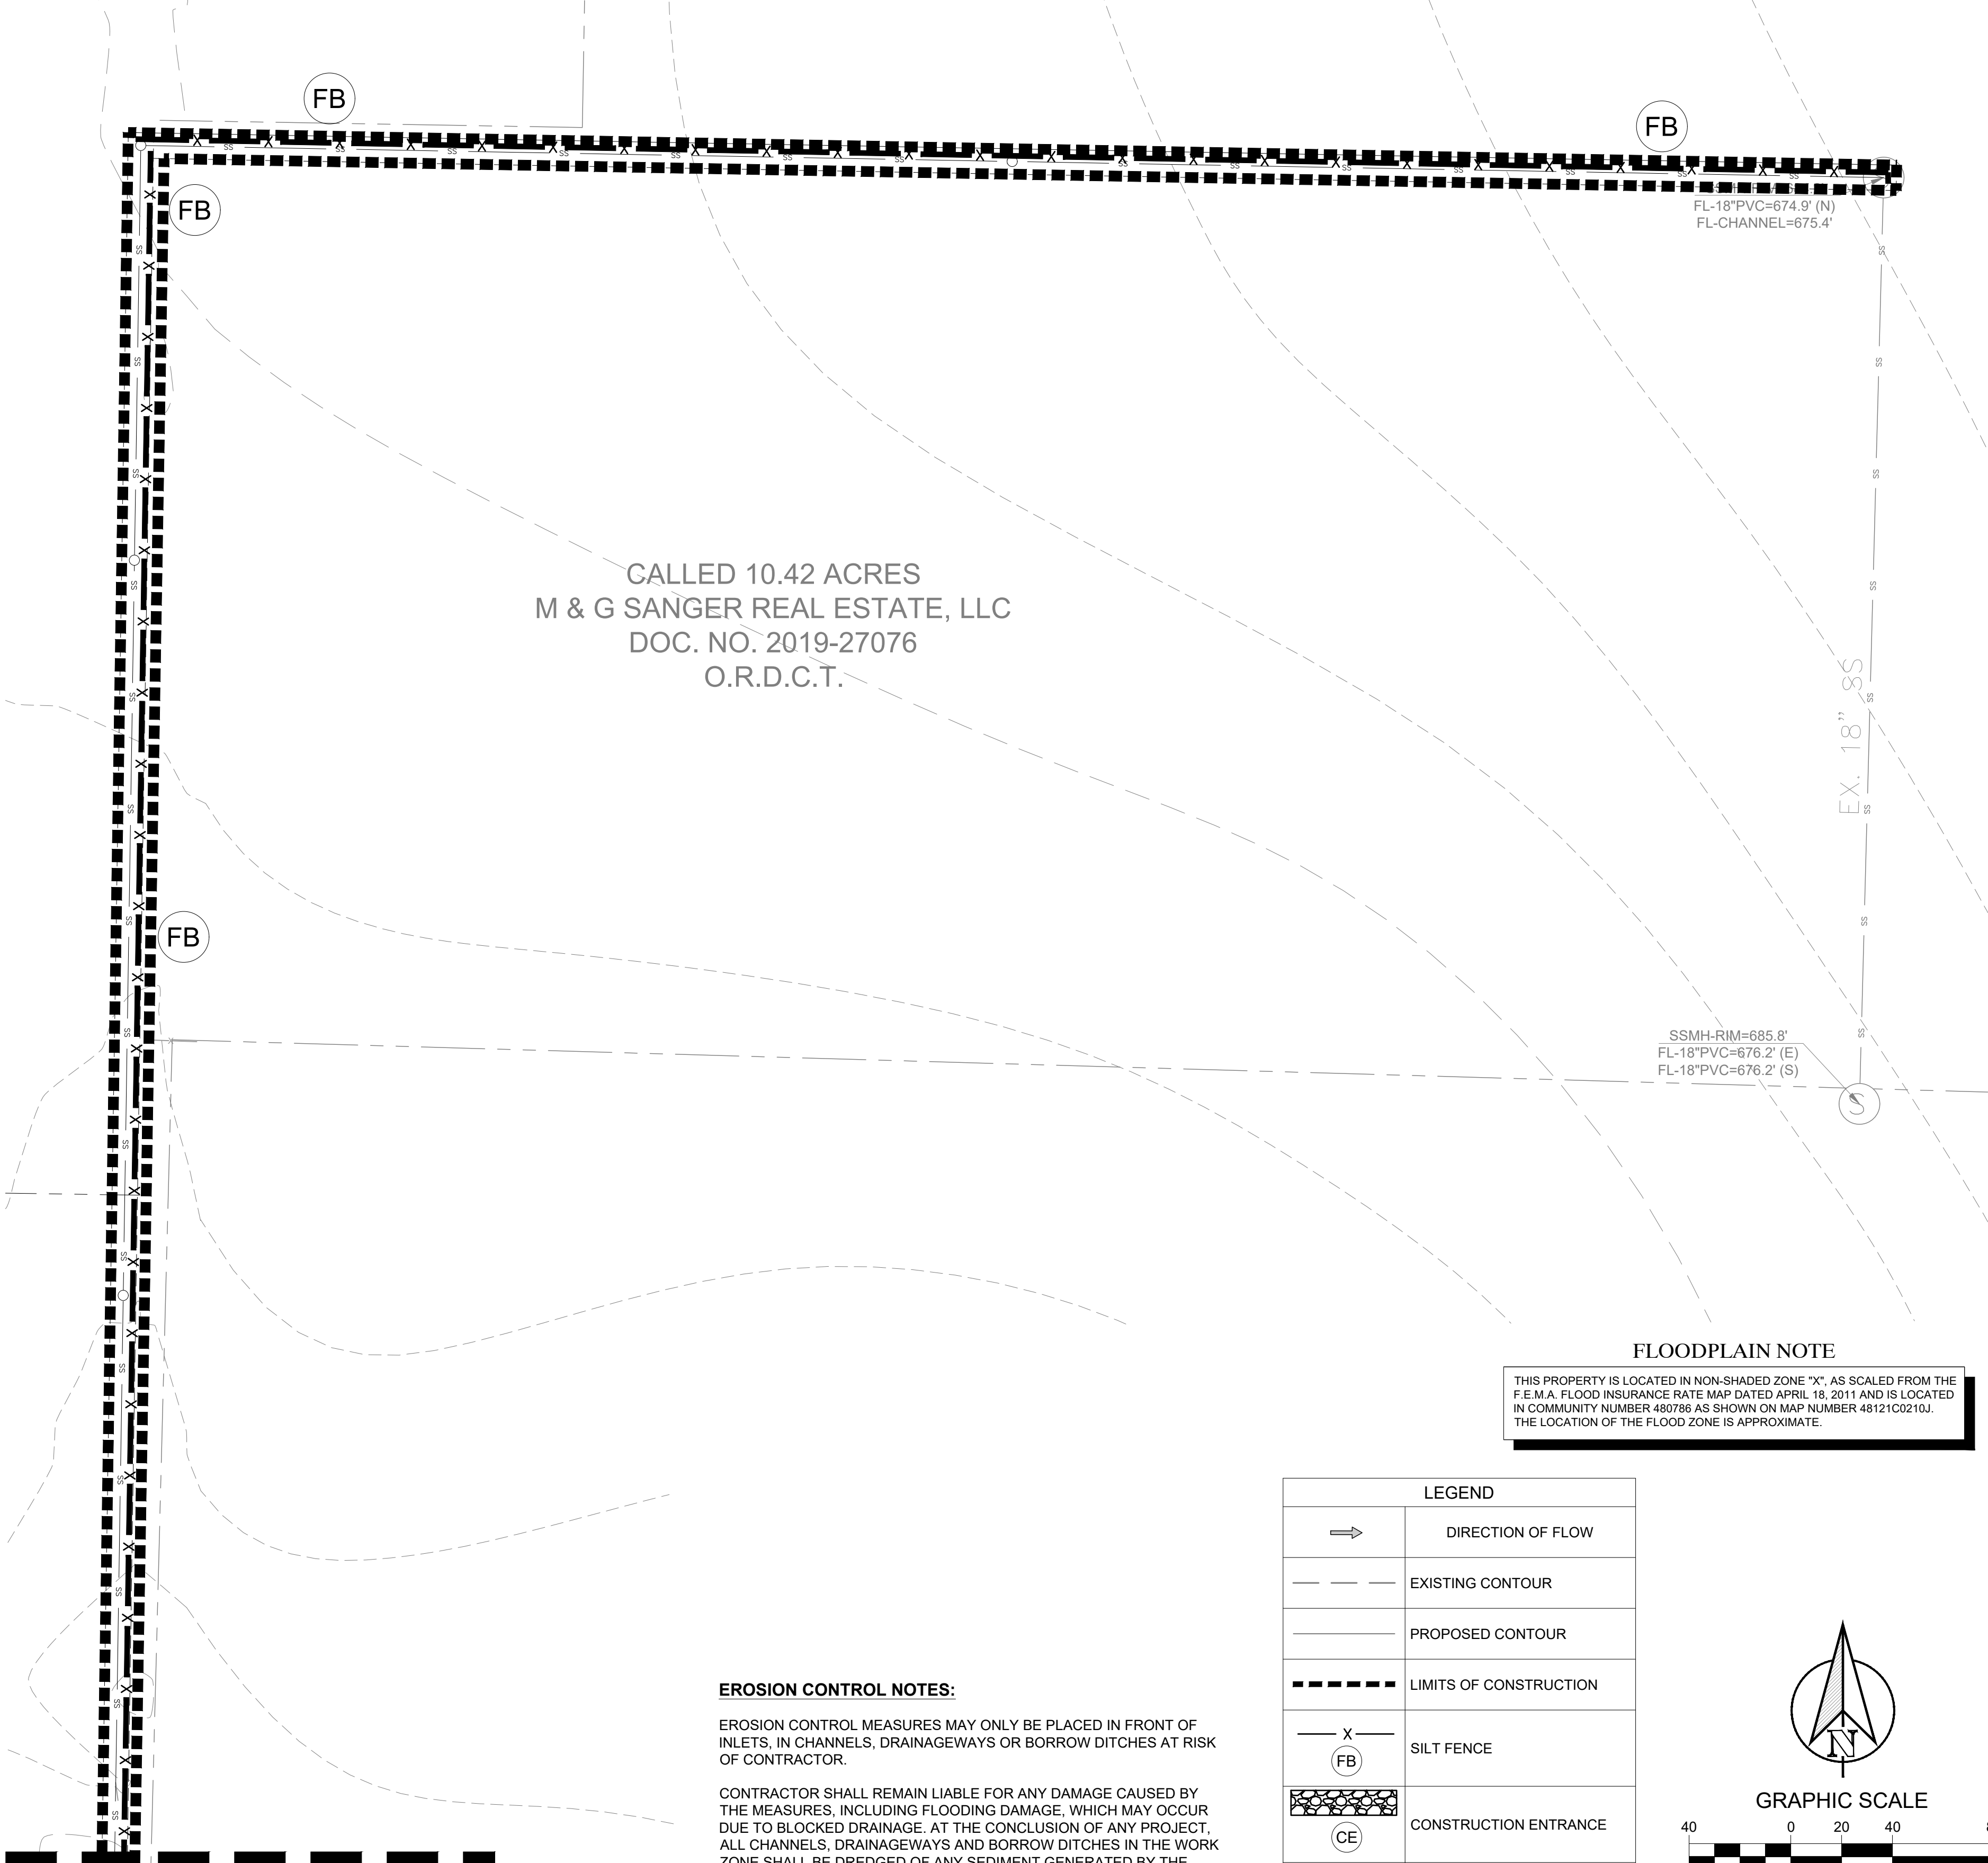


MATCHLINE THIS SHEET

EROSION CONTROL NOTES:

EROSION CONTROL MEASURES MAY ONLY BE PLACED IN FRONT OF INLETS, IN CHANNELS, DRAINAGEWAYS OR BORROW DITCHES AT RISK OF CONTRACTOR.  
  
 CONTRACTOR SHALL REMAIN LIABLE FOR ANY DAMAGE CAUSED BY THE MEASURES, INCLUDING FLOODING DAMAGE, WHICH MAY OCCUR DUE TO BLOCKED DRAINAGE. AT THE CONCLUSION OF ANY PROJECT, ALL CHANNELS, DRAINAGEWAYS AND BORROW DITCHES IN THE WORK ZONE SHALL BE DREDGED OF ANY SEDIMENT GENERATED BY THE PROJECT OR DEPOSITED AS A RESULT OF EROSION CONTROL MEASURES.  
  
 SOD 4 FEET BEHIND BACK OF CURB, CURLEX (ONE ROLL WIDTH) WITH SEED BEHIND SOD, PERENNIAL SEED BEHIND CURLEX.

LEGEND	
	DIRECTION OF FLOW
	EXISTING CONTOUR
	PROPOSED CONTOUR
	LIMITS OF CONSTRUCTION
	SILT FENCE
	CONSTRUCTION ENTRANCE
	INLET PROTECTION
	CONCRETE WASHOUT AREA

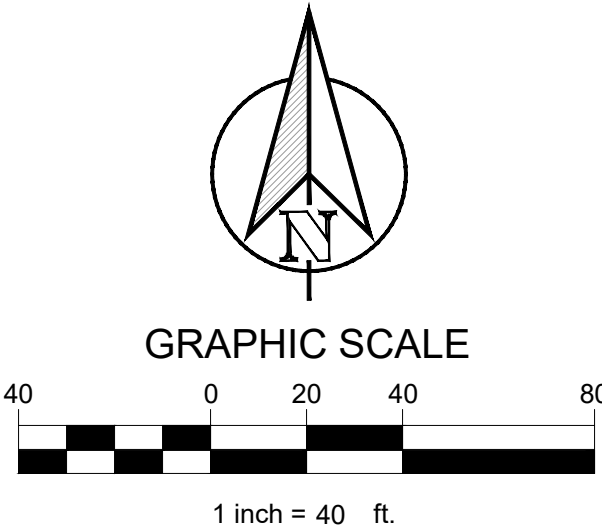

FLOODPLAIN NOTE

THIS PROPERTY IS LOCATED IN NON-SHADED ZONE "X", AS SCALED FROM THE F.E.M.A. FLOOD INSURANCE RATE MAP DATED APRIL 18, 2011 AND IS LOCATED IN COMMUNITY NUMBER 480786 AS SHOWN ON MAP NUMBER 48121C0210J. THE LOCATION OF THE FLOOD ZONE IS APPROXIMATE.


No.	DATE	REVISION	BY



PLOTTED BY: DAN CABALLERO  
 PLOT DATE: 7/17/2024 10:01 AM  
 LOCATION: Z:\PROJECTS\PROJECTS\2022-185 MALOUF SANGER\CADD\SHEETS\MULTI-FAMILY GREYSTAR\EROSION CONTROL PLAN.DWG  
 LAST SAVED: 7/16/2024 8:17 AM

### STANDARD EROSION CONTROL GENERAL NOTES

- EROSION CONTROL DEVICES AS SHOWN ON THE EROSION CONTROL PLAN FOR THE PROJECT SHALL BE INSTALLED PRIOR TO THE START OF LAND DISTURBING ACTIVITIES ON THE PROJECT.
- ALL EROSION CONTROL DEVICES ARE TO BE INSTALLED IN ACCORDANCE WITH THE APPROVED PLANS AND SPECIFICATIONS FOR THE PROJECT. CHANGES ARE TO BE APPROVED BEFORE CONSTRUCTION BY THE DESIGN ENGINEER AND THE CITY OF SANGER.
- IF THE EROSION CONTROL PLAN AS APPROVED CANNOT CONTROL EROSION AND OFF-SITE SEDIMENTATION FROM THE PROJECT THE EROSION CONTROL PLAN WILL BE REQUIRED TO BE REVISED AND/OR ADDITIONAL EROSION CONTROL DEVICES WILL BE REQUIRED ON SITE.
- IF OFF-SITE BORROW OR SPOILS SITES ARE USED IN CONJUNCTION WITH THIS PROJECT, THIS INFORMATION SHALL BE DISCLOSED AND SHOWN ON THE EROSION CONTROL PLAN. OFF-SITE BORROW AND SPOILS AREAS ARE CONSIDERED PART OF EROSION CONTROL REQUIREMENTS. THESE AREAS SHALL BE STABILIZED WITH GROUND COVER PRIOR TO FINAL APPROVAL OF THE PROJECT.
- INSPECTIONS SHALL BE MADE WEEKLY AND AFTER RAIN STORM EVENTS TO INSURE THAT THE DEVICES ARE FUNCTIONING PROPERLY. WHEN SEDIMENT OR MUD HAS CLOGGED THE VOID SPACES BETWEEN STONES OR MUD IS BEING TRACKED ONTO A PUBLIC ROADWAY THE AGGREGATE PAD MUST BE WASHED DOWN OR REPLACED. RUNOFF FROM THE WASH DOWN OPERATION SHALL NOT BE ALLOWED TO DRAIN DIRECTLY OFF SITE WITHOUT FIRST FLOWING THROUGH ANOTHER BMP TO CONTROL OFF SITE SEDIMENTATION. PERIODIC RE-GRADING OR THE ADDITION OF NEW STONE MAY BE REQUIRED TO MAINTAIN THE EFFICIENCY OF THE INSTALLATION.
- CONTRACTOR SHALL HAVE A COPY THE SWPPP ON SITE AT ALL TIMES.
- CONTRACTOR SHALL BE RESPONSIBLE FOR SUBMITTAL OF N.O.I., N.O.T. AND ANY ADDITIONAL INFORMATION REQUIRED BY THE E.P.A. CONTRACTOR SHALL COMPLY WITH ALL E.P.A. STORM WATER POLLUTION PREVENTION REQUIREMENTS.

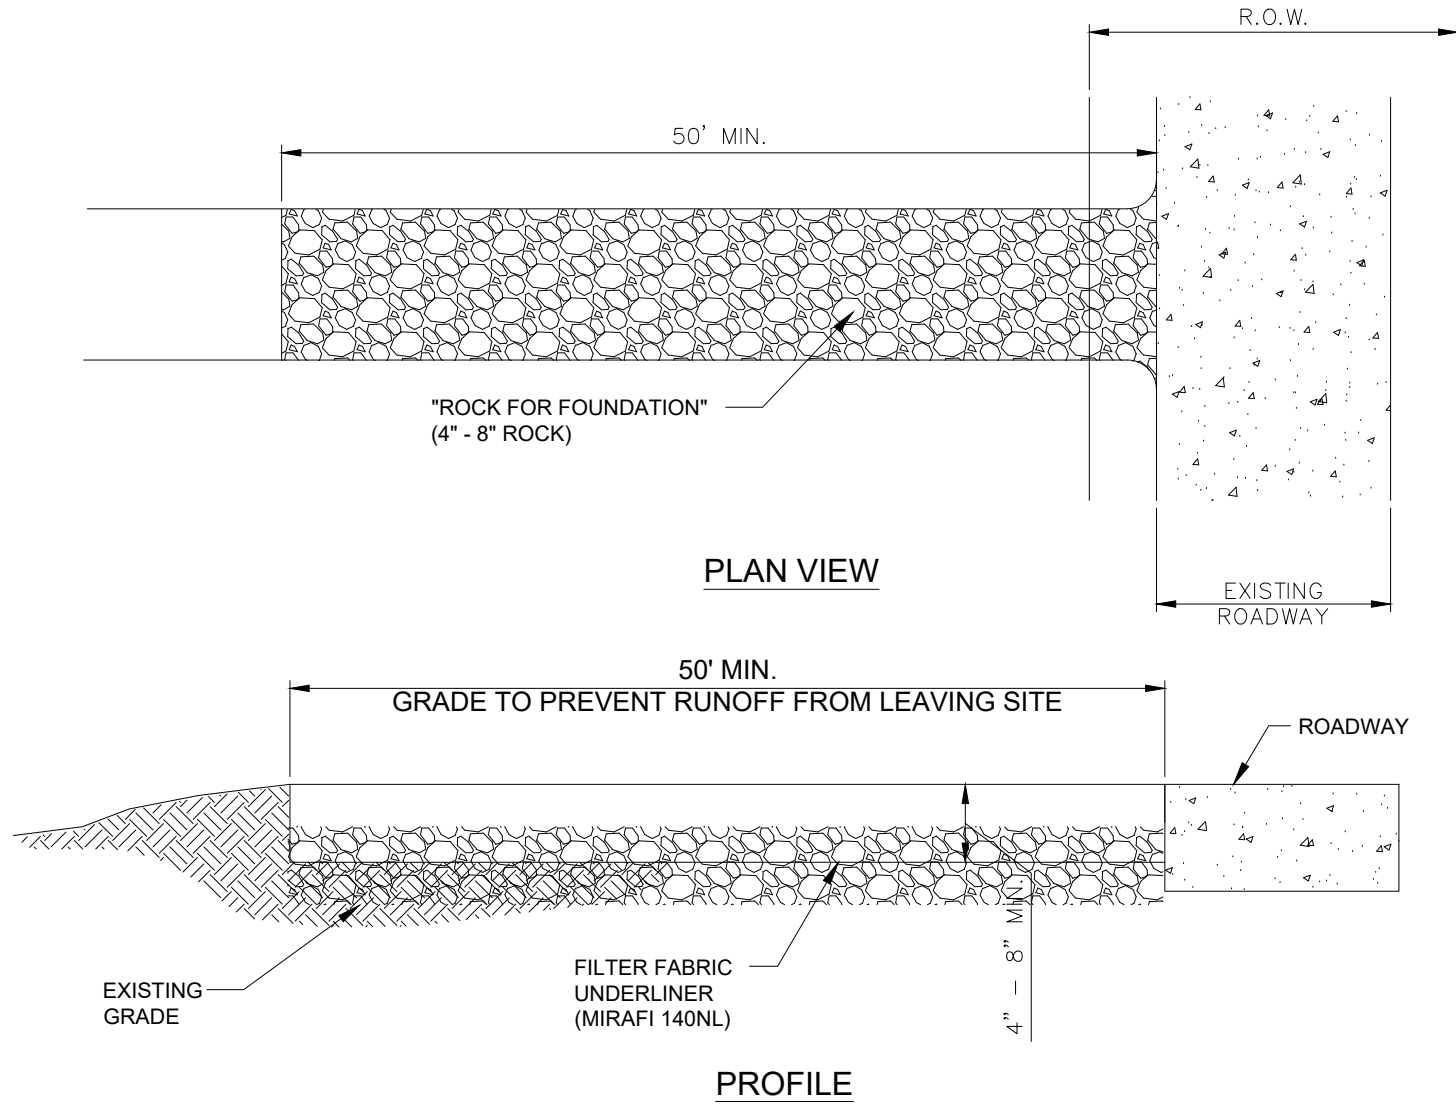


#### CONSTRUCTION ENTRANCE NOTES:

- STONE SIZE – 4" TO 8" INCHES (MIN) ROCK.
- LENGTH – AS EFFECTIVE, BUT NOT LESS THAN 50 FEET.
- THICKNESS – NOT LESS THAN 4 INCHES.
- WIDTH – NOT LESS THAN 25 FEET OF ALL POINTS OF INGRESS OR EGRESS.
- WASHING – WHEN NECESSARY, WHEELS SHALL BE CLEANED TO REMOVE SEDIMENT PRIOR TO ENTRANCE ONTO PUBLIC ROADWAY. WHEN WASHING IS REQUIRED, IT SHALL BE DONE ON AN AREA STABILIZED WITH CRUSHED STONE WHICH DRAINS INTO AN APPROVED TRAP OR SEDIMENT BASIN. ALL SEDIMENT SHALL BE PREVENTED FROM ENTERING ANY STORM DRAIN, DITCH OR WATERCOURSE USING APPROVED METHODS.
- MAINTENANCE – THE ENTRANCE SHALL BE MAINTAINED IN CONDITION WHICH WILL PREVENT TRACKING OR FLOWING OF SEDIMENT ONTO PUBLIC ROADWAYS. THIS MAY REQUIRE PERIODIC TOP DRESSING WITH ADDITIONAL STONE AS CONDITIONS DEMAND, AND REPAIR AND/OR CLEAN OUT OF ANY MEASURES USED TO TRAP SEDIMENT. ALL SEDIMENT SPILLED, DROPPED, WASHED OR TRACKED ONTO PUBLIC ROADWAY, MUST BE REMOVED IMMEDIATELY.
- DRAINAGE – ENTRANCE MUST BE PROPERLY GRADED OR INCORPORATE A DRAINAGE SWALE TO PREVENT RUNOFF FROM LEAVING THE CONSTRUCTION SITE.
- CONTRACTOR TO COORDINATE EXACT LOCATION OF THIS DETAIL.

#### CONSTRUCTION ENTRANCE

N.T.S.

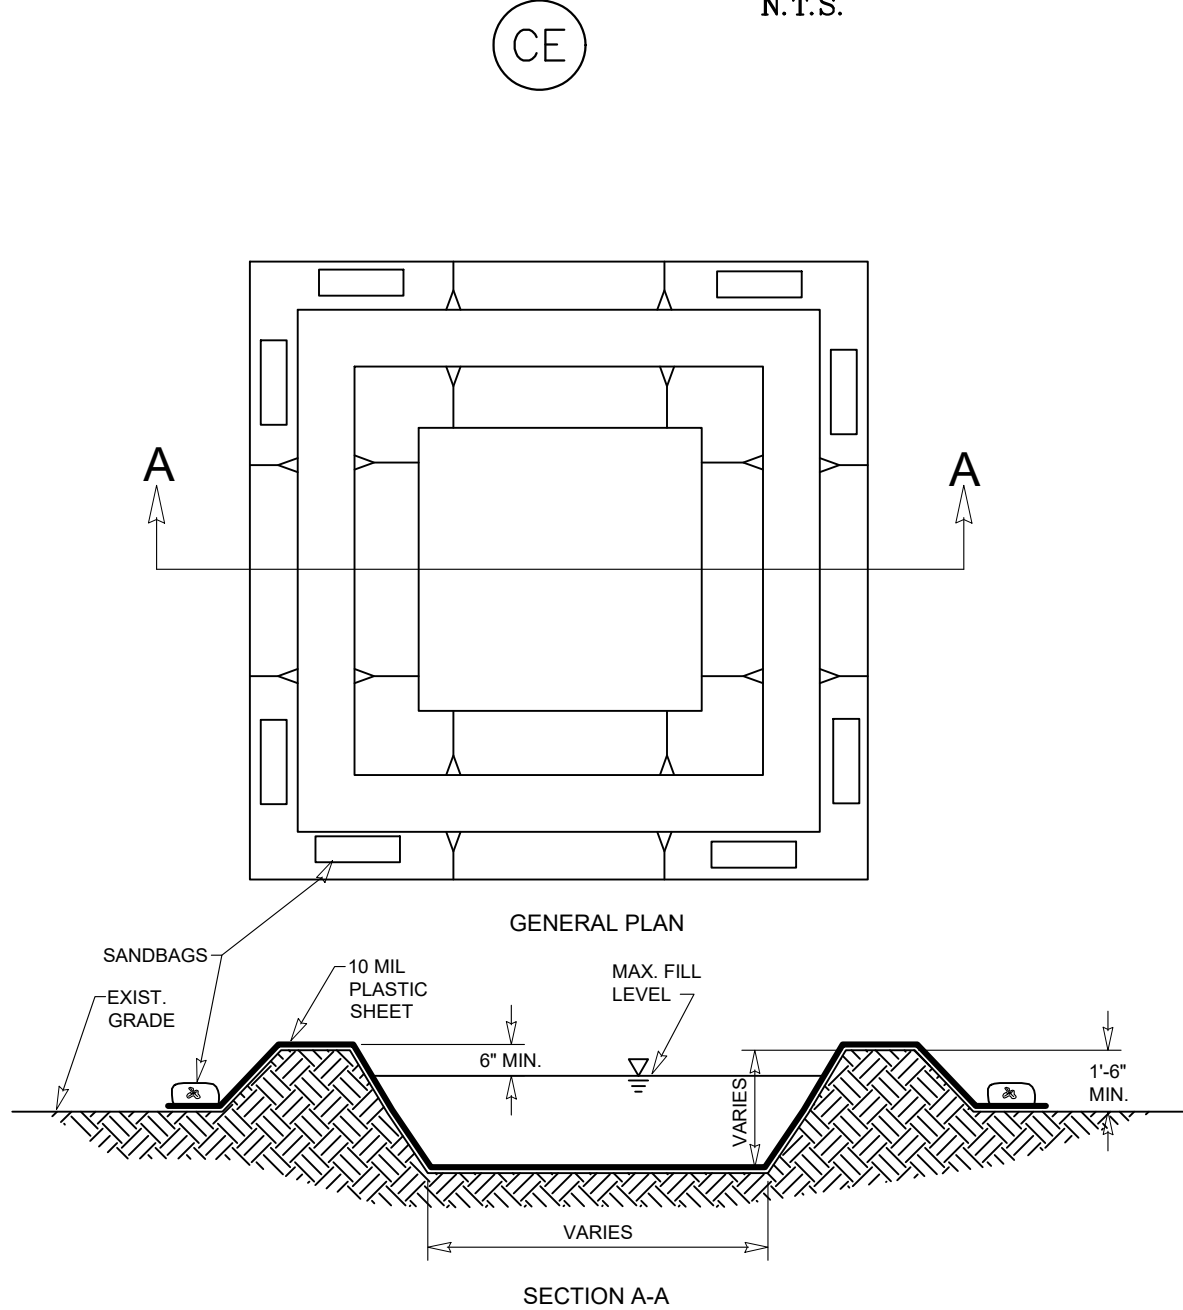


#### NOTES:

- SET LENGTH AND WIDTH AS NECESSARY TO PROVIDE ADEQUATE SPACE FOR WASHOUT ACTIVITIES.
- IF RESTRICTED BY DEPTH DUE TO BELOW GRADE APPURTENANCES, PLACE EARTHEN BERMS AT SIDE.
- USE EXCAVATED MATERIAL TO CREATE EARTHEN BERMS SURROUNDING THE AREA TO BE DESIGNATED AS CONCRETE WASHOUT.
- PLACE 10MIL OR GREATER PLASTIC SHEETING.
- SECURE SHEETING ON OUTSIDE OF BERM AREA USING SAND BAGS OR ROCK EQUIVALENT.
- DISPOSE OF CONTENTS APPROPRIATELY.

#### CONCRETE WASHOUT DETAIL

N.T.S.

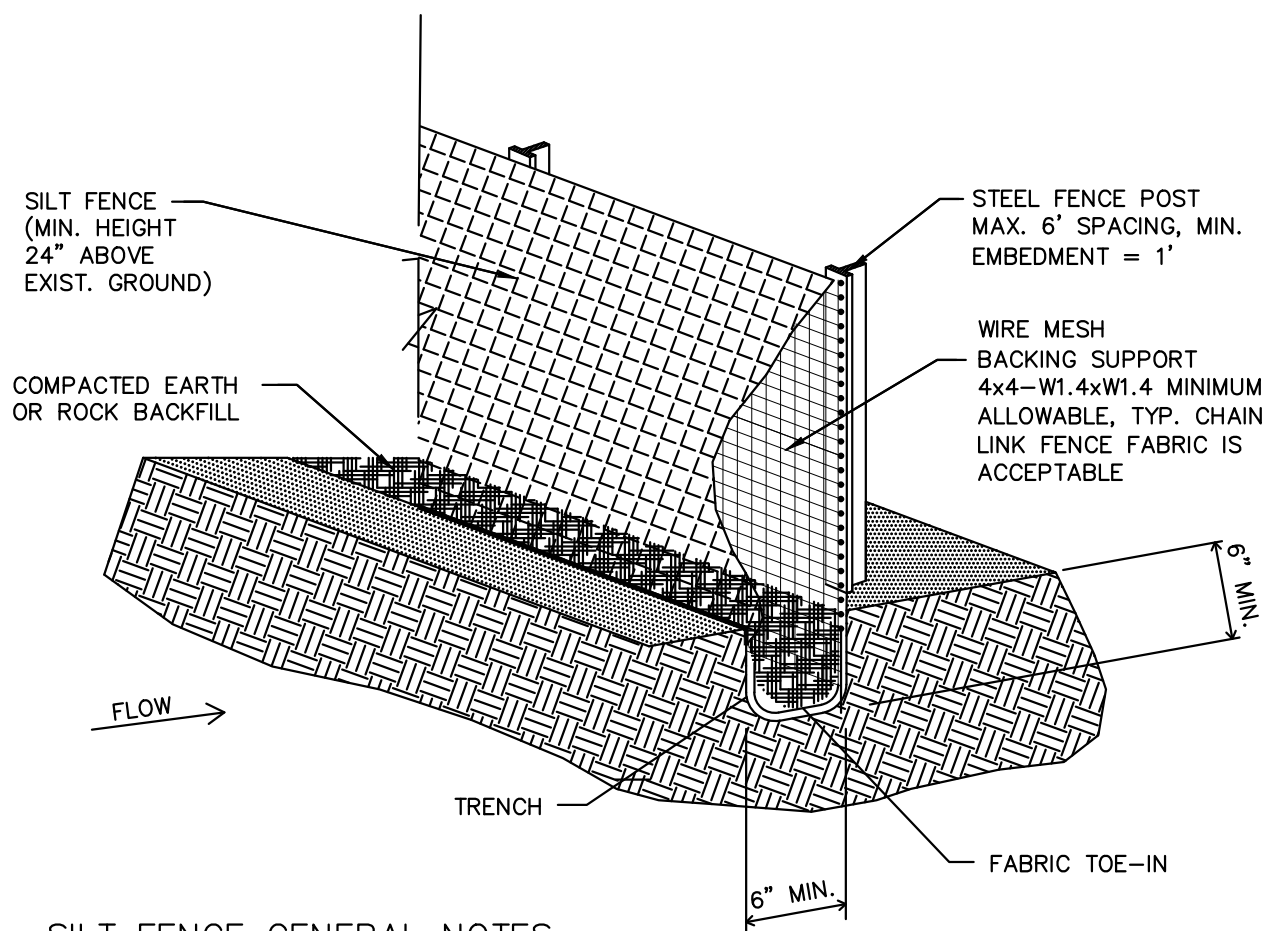


#### SILT FENCE GENERAL NOTES

- STEEL POSTS WHICH SUPPORT THE SILT FENCE SHALL BE INSTALLED ON A SLIGHT ANGLE TOWARD THE ANTICIPATED RUNOFF SOURCE. POST MUST BE EMBEDDED A MINIMUM OF ONE FOOT.
- THE TOE OF THE SILT FENCE SHALL BE TRENCHED IN WITH A SPADE OR MECHANICAL TRENCHER, SO THAT THE DOWN SLOPE FACE OF THE TRENCH IS FLAT AND PERPENDICULAR TO THE LINE OF FLOW. WHERE FENCE CANNOT BE TRENCHED IN (e.g. PAVEMENT), WEIGHT FABRIC FLAP WITH ROCK ON UPHILL SIDE TO PREVENT FLOW FROM SEEPING UNDER FENCE.
- THE TRENCH MUST BE A MINIMUM OF 6 INCHES DEEP AND 6 INCHES WIDE TO ALLOW FOR THE SILT FENCE FABRIC TO BE LAID IN THE GROUND AND BACKFILLED WITH COMPACTED MATERIAL.
- SILT FENCE SHOULD BE SECURELY FASTENED TO EACH STEEL SUPPORT POST OR TO WOVEN WIRE, WHICH IN TURN IS ATTACHED TO THE STEEL FENCE POST. THERE SHALL BE A 3 FOOT OVERLAP, SECURELY FASTENED WHERE ENDS OF FABRIC MEET.
- INSPECTION SHALL BE MADE EVERY WEEK AND AFTER EACH 1/2" RAINFALL. REPAIR OR REPLACEMENT SHALL BE MADE PROMPTLY AS NEEDED.
- SILT FENCE SHALL BE REMOVED WHEN THE SITE IS COMPLETELY STABILIZED SO AS NOT TO BLOCK OR IMPEDE STORM FLOW OR DRAINAGE.
- ACCUMULATED SILT SHALL BE REMOVED WHEN IT REACHES A DEPTH OF ONE-THIRD THE HEIGHT OF THE FENCE. THE SILT SHALL BE DISPOSED OF AT AN APPROVED SITE AND IN SUCH A MANNER AS TO NOT CONTRIBUTE TO ADDITIONAL SILTATION.
- NO STEEL POSTS SHALL BE SET WITHIN THE RIGHT-OF-WAY.

#### CONSTRUCTION OF A FILTER BARRIER

N.T.S.

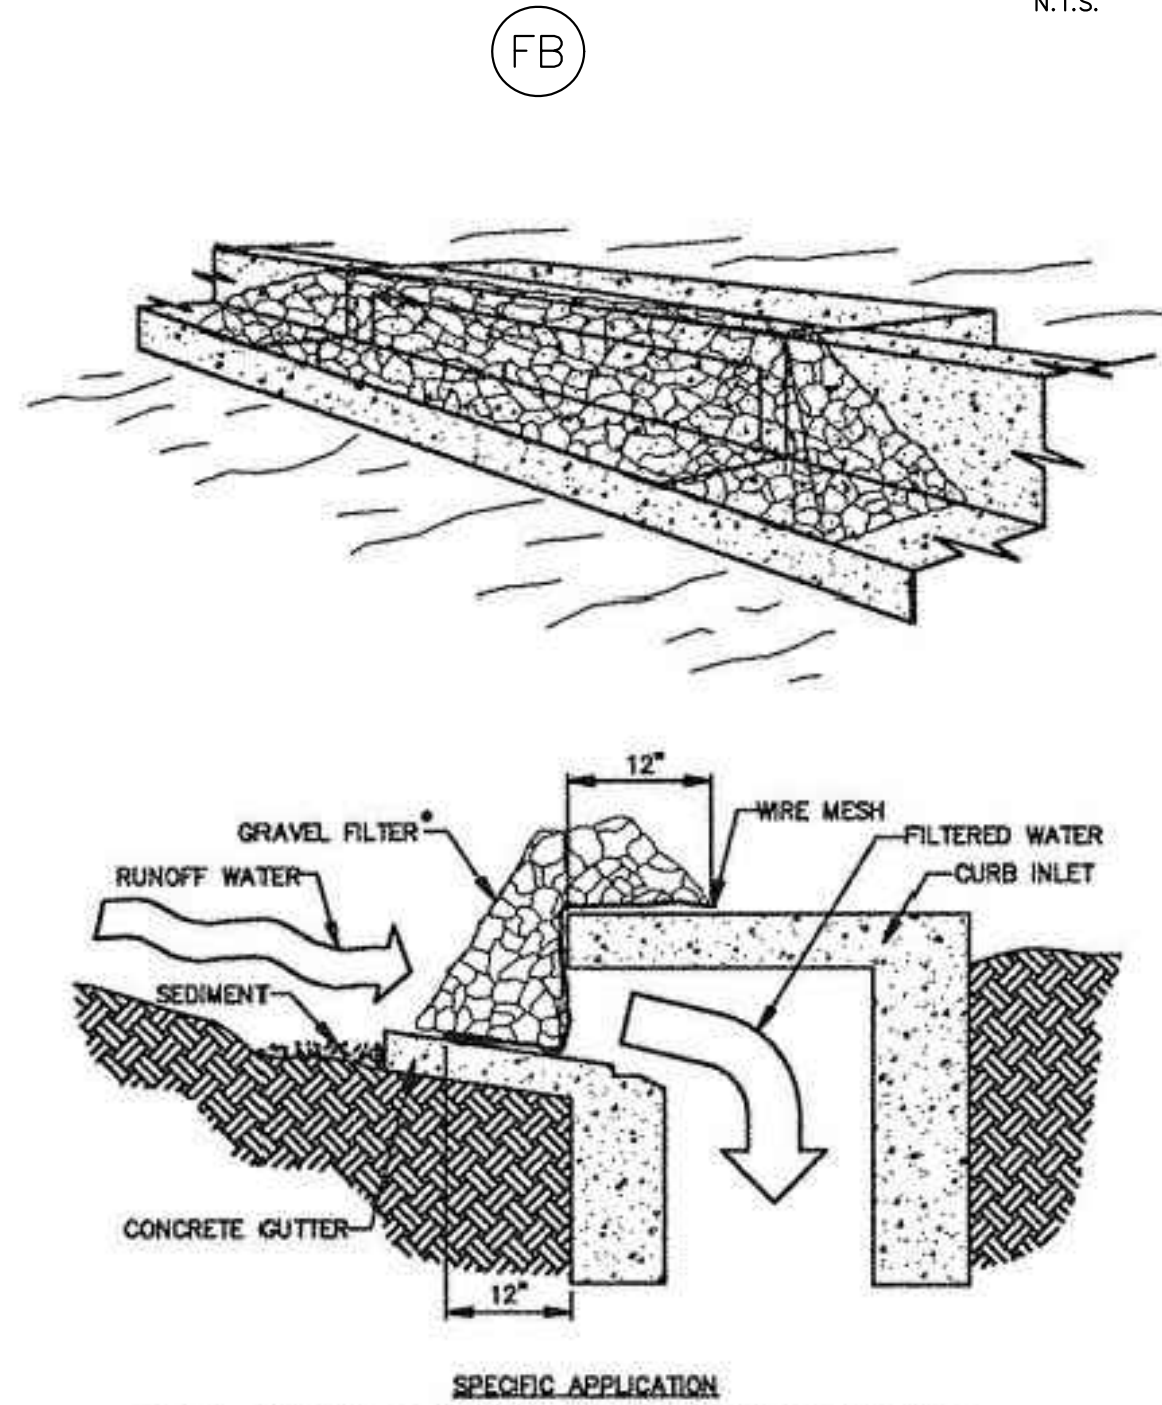

#### SPECIFIC APPLICATION

THIS METHOD OF INLET PROTECTION IS APPLICABLE AT CURB INLETS WHERE PONDING IN FRONT OF THE STRUCTURE IS NOT LIKELY TO CAUSE INCONVENIENCE OR DAMAGE TO ADJACENT STRUCTURES AND UNPROTECTED AREAS.

\* GRAVEL SHALL BE 2"-3" STONE

#### TEMPORARY GRAVEL CURB INLET SEDIMENT FILTER

N.T.S.

### EROSION CONTROL SCHEDULE AND PHASING

THE PROJECT SHALL GENERALLY CONFORM TO THE FOLLOWING:

#### PHASE 1 – DEMOLITION/GRADING

- CONSTRUCT TEMPORARY CONSTRUCTION ENTRANCE, SILT FENCE, AND TREE PROTECTION FENCE ACCORDING TO THE APPROXIMATE LOCATION SHOWN ON GRADING AND EROSION CONTROL PLAN, NOTES, AND DETAIL SHEETS.
- BEGIN CLEARING AND GRADING OF SITE.
- SEED AND REVEGETATE SLOPES WHERE SHOWN.

#### PHASE 2 – UTILITIES

- KEEP ALL STORM WATER POLLUTION PREVENTION MEASURES IN PLACE.
- INSTALL STORM DRAINS AS SPECIFIED ON PLAN SHEETS.
- INSTALL INLET PROTECTION.

#### PHASE 3 – PAVING

- KEEP ALL STORM WATER POLLUTION PREVENTION MEASURES IN PLACE. REMOVE AS NEEDED TO PAVE.
- STABILIZE SUBGRADE.
- PAVE PARKING LOT AND SIDEWALKS AS SPECIFIED ON PLAN SHEETS.
- REMOVE TEMPORARY CONSTRUCTION ENTRANCE.
- MAINTAIN INLET PROTECTION.

#### PHASE 4 – LANDSCAPING AND SOIL STABILIZATION

- REVEGETATE LOT AND PARKWAYS
- LANDSCAPE CONTRACTOR SHALL REVEGETATE ALL AREAS RESERVED FOR LANDSCAPE VEGETATIVE COVERS.
- REMOVE EROSION CONTROL DEVICES WHEN GROUND COVER ESTABLISHED.

### B.M.P. MAINTENANCE SCHEDULE

TEMPORARY STONE CONSTRUCTION ENTRANCE/EXIT:

INSPECTIONS SHALL BE MADE WEEKLY AND AFTER RAIN STORM EVENTS TO ENSURE THAT THE FACILITY IS FUNCTIONING PROPERLY. AGGREGATE PAD SHALL BE WASHED DOWN OR REPLACED WHEN SEDIMENT OR MUD HAS CLOGGED THE VOID SPACES BETWEEN THE SONES OR MUD IS BEING TRACKED ONTO THE PUBLIC ROADWAY. RUNOFF FROM WASH DOWN OPERATION SHALL BE FILTERED THROUGH ANOTHER B.M.P. PRIOR TO DRAINING OFF-SITE.

#### SILT FENCE:

INSPECTIONS SHALL BE MADE WEEKLY AND AFTER RAIN STORM EVENTS. SEDIMENT SHALL BE REMOVED FROM BEHIND THE FENCE WHEN THE DEPTH OF SEDIMENT HAS BUILT UP TO ONE-THIRD THE HEIGHT OF THE FENCE ABOVE GRADE. FENCE SHALL BE INSPECTED FOR GAPS AT BASE. INSPECT SUPPORTING POSTS AND FILTER FABRIC. REPLACE IF REQUIRED.

#### INLET PROTECTION:

INSPECTIONS SHALL BE MADE WEEKLY AND AFTER RAIN STORM EVENTS TO ENSURE THAT THE DEVICE IS FUNCTIONING PROPERLY. SEDIMENT SHALL BE REMOVED FROM THE STORAGE AREA WHEN SEDIMENT DEPTH HAS BUILT UP TO ONE-HALF THE DESIGN DEPTH. IF DE-WATERING OF THE STORAGE VOLUME IS NOT OCCURRING, CLEAN OR REPLACE THE FILTER STONE SURROUNDING THE INLET. CLEAN THE STONE SURFACE THE FIRST FEW TIMES BY RAKING. REPEATED SEDIMENT BUILD-UP WILL REQUIRE FILTER STONE REPLACEMENT.

TEXAS REGISTRATION #141199

**CLAY MOORE**  
**ENGINEERING**

PHONE #17.281.0572  
1903 CENTRAL DRIVE SUITE #408  
SEDFORD, TX 76081  
WWW.CLAYMOOREENG.COM

#### PRELIMINARY

FOR REVIEW ONLY  
Not for construction purposes.  
**CLAYMOORE ENGINEERING**  
ENGINEERING AND PLANNING CONSULTANTS

Engineer: **DREW DONOSKY**  
P.E. No.125651 Date: **7/17/2024**

**SANGER MULTI-FAMILY  
PREPARED FOR  
GREYSTAR  
SANGER, TEXAS**

### EROSION CONTROL DETAILS

DESIGN: ASD  
DRAWN: DC  
CHECKED: ASD  
DATE: 7/17/2024


SHEET

C-2.5

CASE NO. 2022-185




PLOTTED BY: DAN CABALLERO  
 PLOT DATE: 7/17/2024 10:02 AM  
 LOCATION: Z:\PROJECTS\PROJECTS\2022-185 MALOUF SANGER\CADD\SHEETS\MULTI-FAMILY GREYSTAR\C-3.3 DIMENSION CONTROL PLAN.DWG  
 LAST SAVED: 7/16/2024 3:20 PM

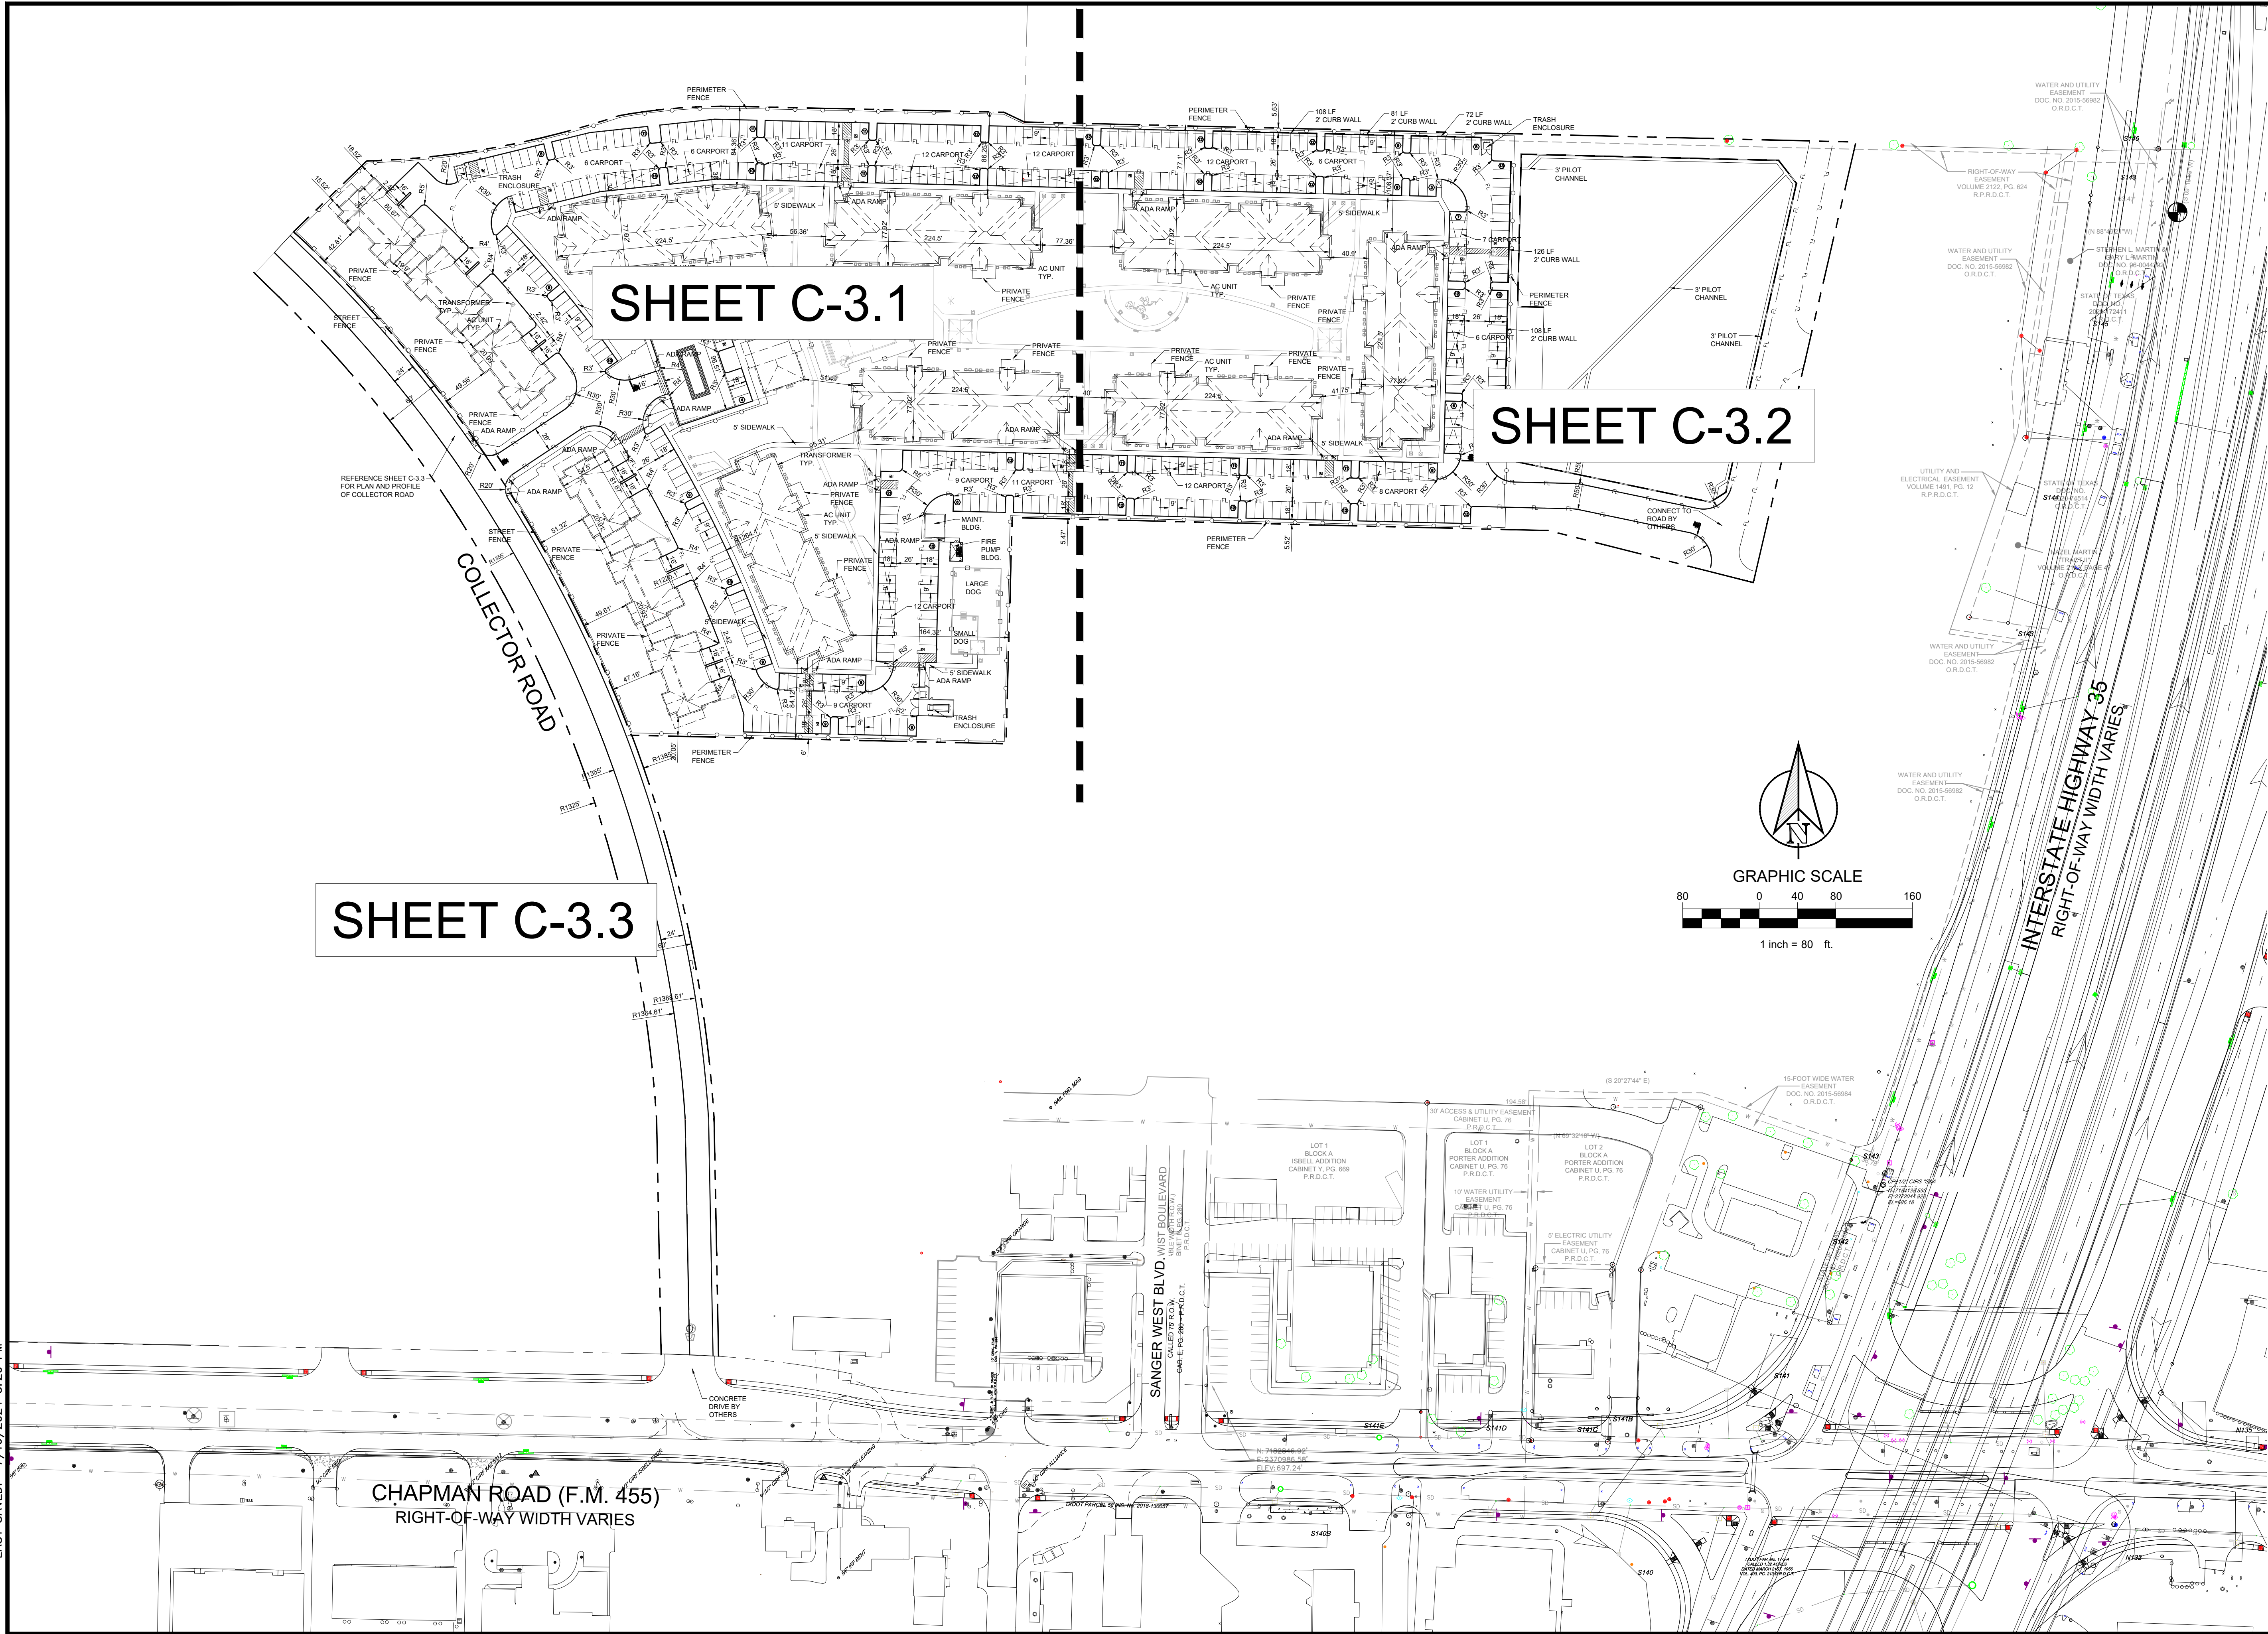


NO.	DATE	REVISION	BY



PLOTTED BY: DAN CABALLERO  
 PLOT DATE: 7/17/2024 10:02 AM  
 LOCATION: Z:\PROJECTS\PROJECTS\2022-185 MALOUF SANGER\CADD\SHEETS\MULTI-FAMILY GREYSTAR\C-3.3 DIMENSION CONTROL PLAN .DWG  
 LAST SAVED: 7/16/2024 3:20 PM

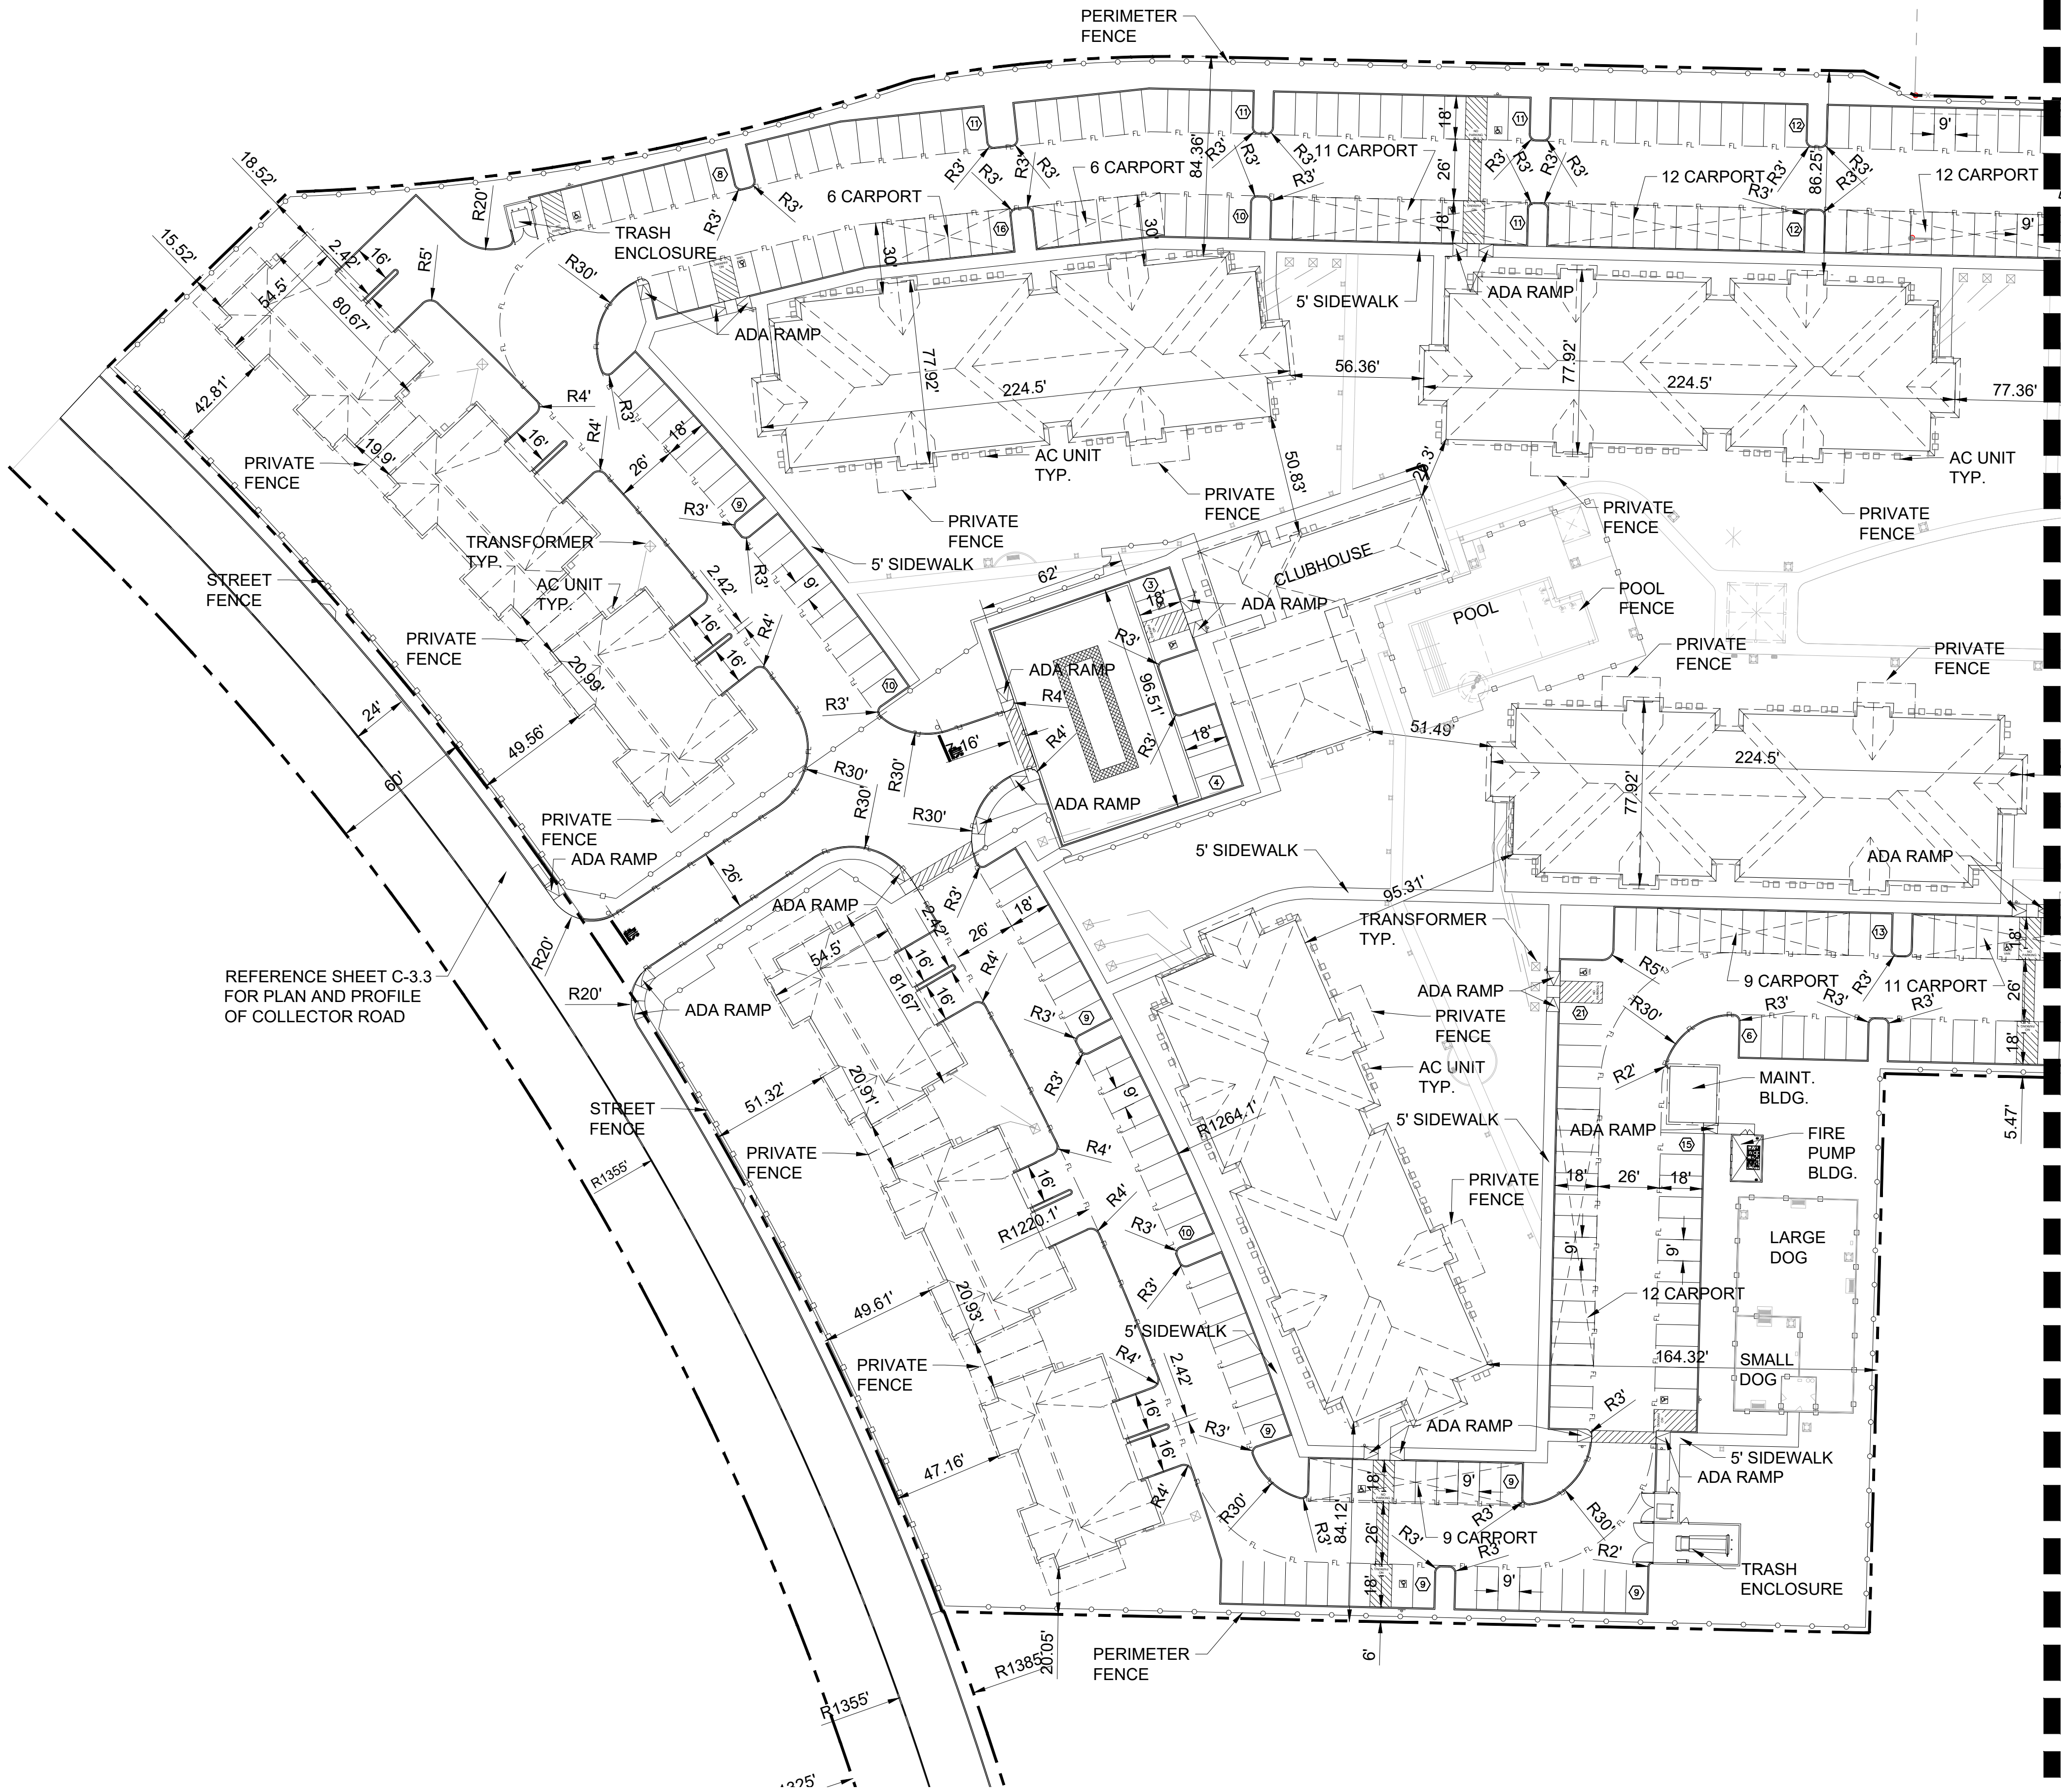

MATCHLINE SHEET C-3.2

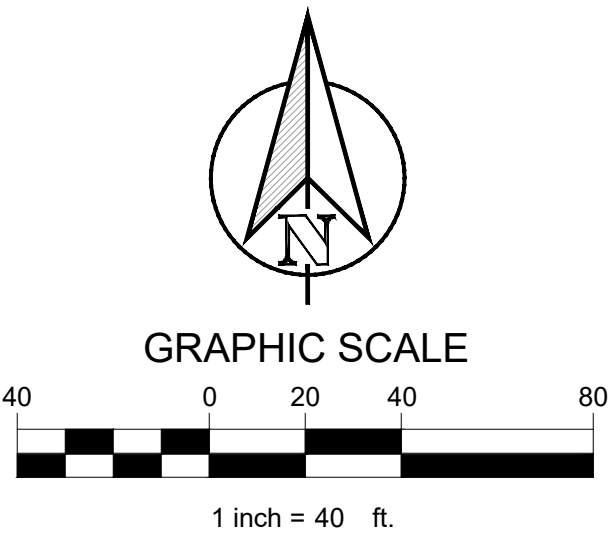

LEGEND	
	PROPOSED CONCRETE CURB AND GUTTER
	PARKING COUNT
	PROPERTY LINE
	PROPOSED FIRE LANE

- NOTES:
- ALL DIMENSIONS ARE TO FACE OF CURB UNLESS OTHERWISE NOTED.
  - REFER TO ARCHITECTURAL PLANS FOR BUILDING DIMENSIONS AND EXACT DOOR LOCATIONS.
  - NO LANDSCAPING SUCH AS TREES, HEDGES, ABOVE AND UNDERGROUND STRUCTURES SHALL BE LOCATED WITHIN EXISTING OR PROPOSED UTILITY EASEMENTS AND RIGHT OF WAY.
  - REFERENCE APPROVED ORDINANCE 12-21-22 FOR LANDSCAPING, ENTRANCE, OPEN SPACE, SCREENING, FENCING, SETBACKS, AND SIGNAGE REQUIREMENTS

PARKING	
REGULAR PARKING	470 SPACES
ADA PARKING	16 SPACES
TOTAL	486 SPACES

**PRELIMINARY**  
 FOR REVIEW ONLY  
 Not for construction purposes.  
**CLAYMOORE ENGINEERING**  
 ENGINEERING AND PLANNING CONSULTANTS  
 Engineer: DREW DONOSKY  
 P.E. No.125651 Date: 7/17/2024



**SANGER MULTI-FAMILY**  
**PREPARED FOR**  
**GREYSTAR**  
**SANGER, TEXAS**

NO.	DATE	REVISION	BY



PLOTTED BY: DAN CABALLERO  
PLOT DATE: 7/17/2024 10:02 AM  
LOCATION: Z:\PROJECTS\PROJECTS\2022-185 MALOUF SANGER\ADD\SHEETS\MULTI-FAMILY GREYSTAR\C-3.3 DIMENSION CONTROL PLAN .DWG  
LAST SAVED: 7/16/2024 3:20 PM

MATCHLINE SHEET C-3.1

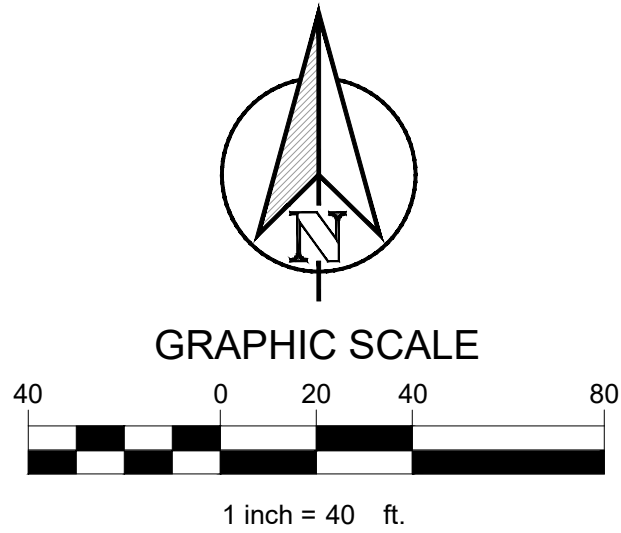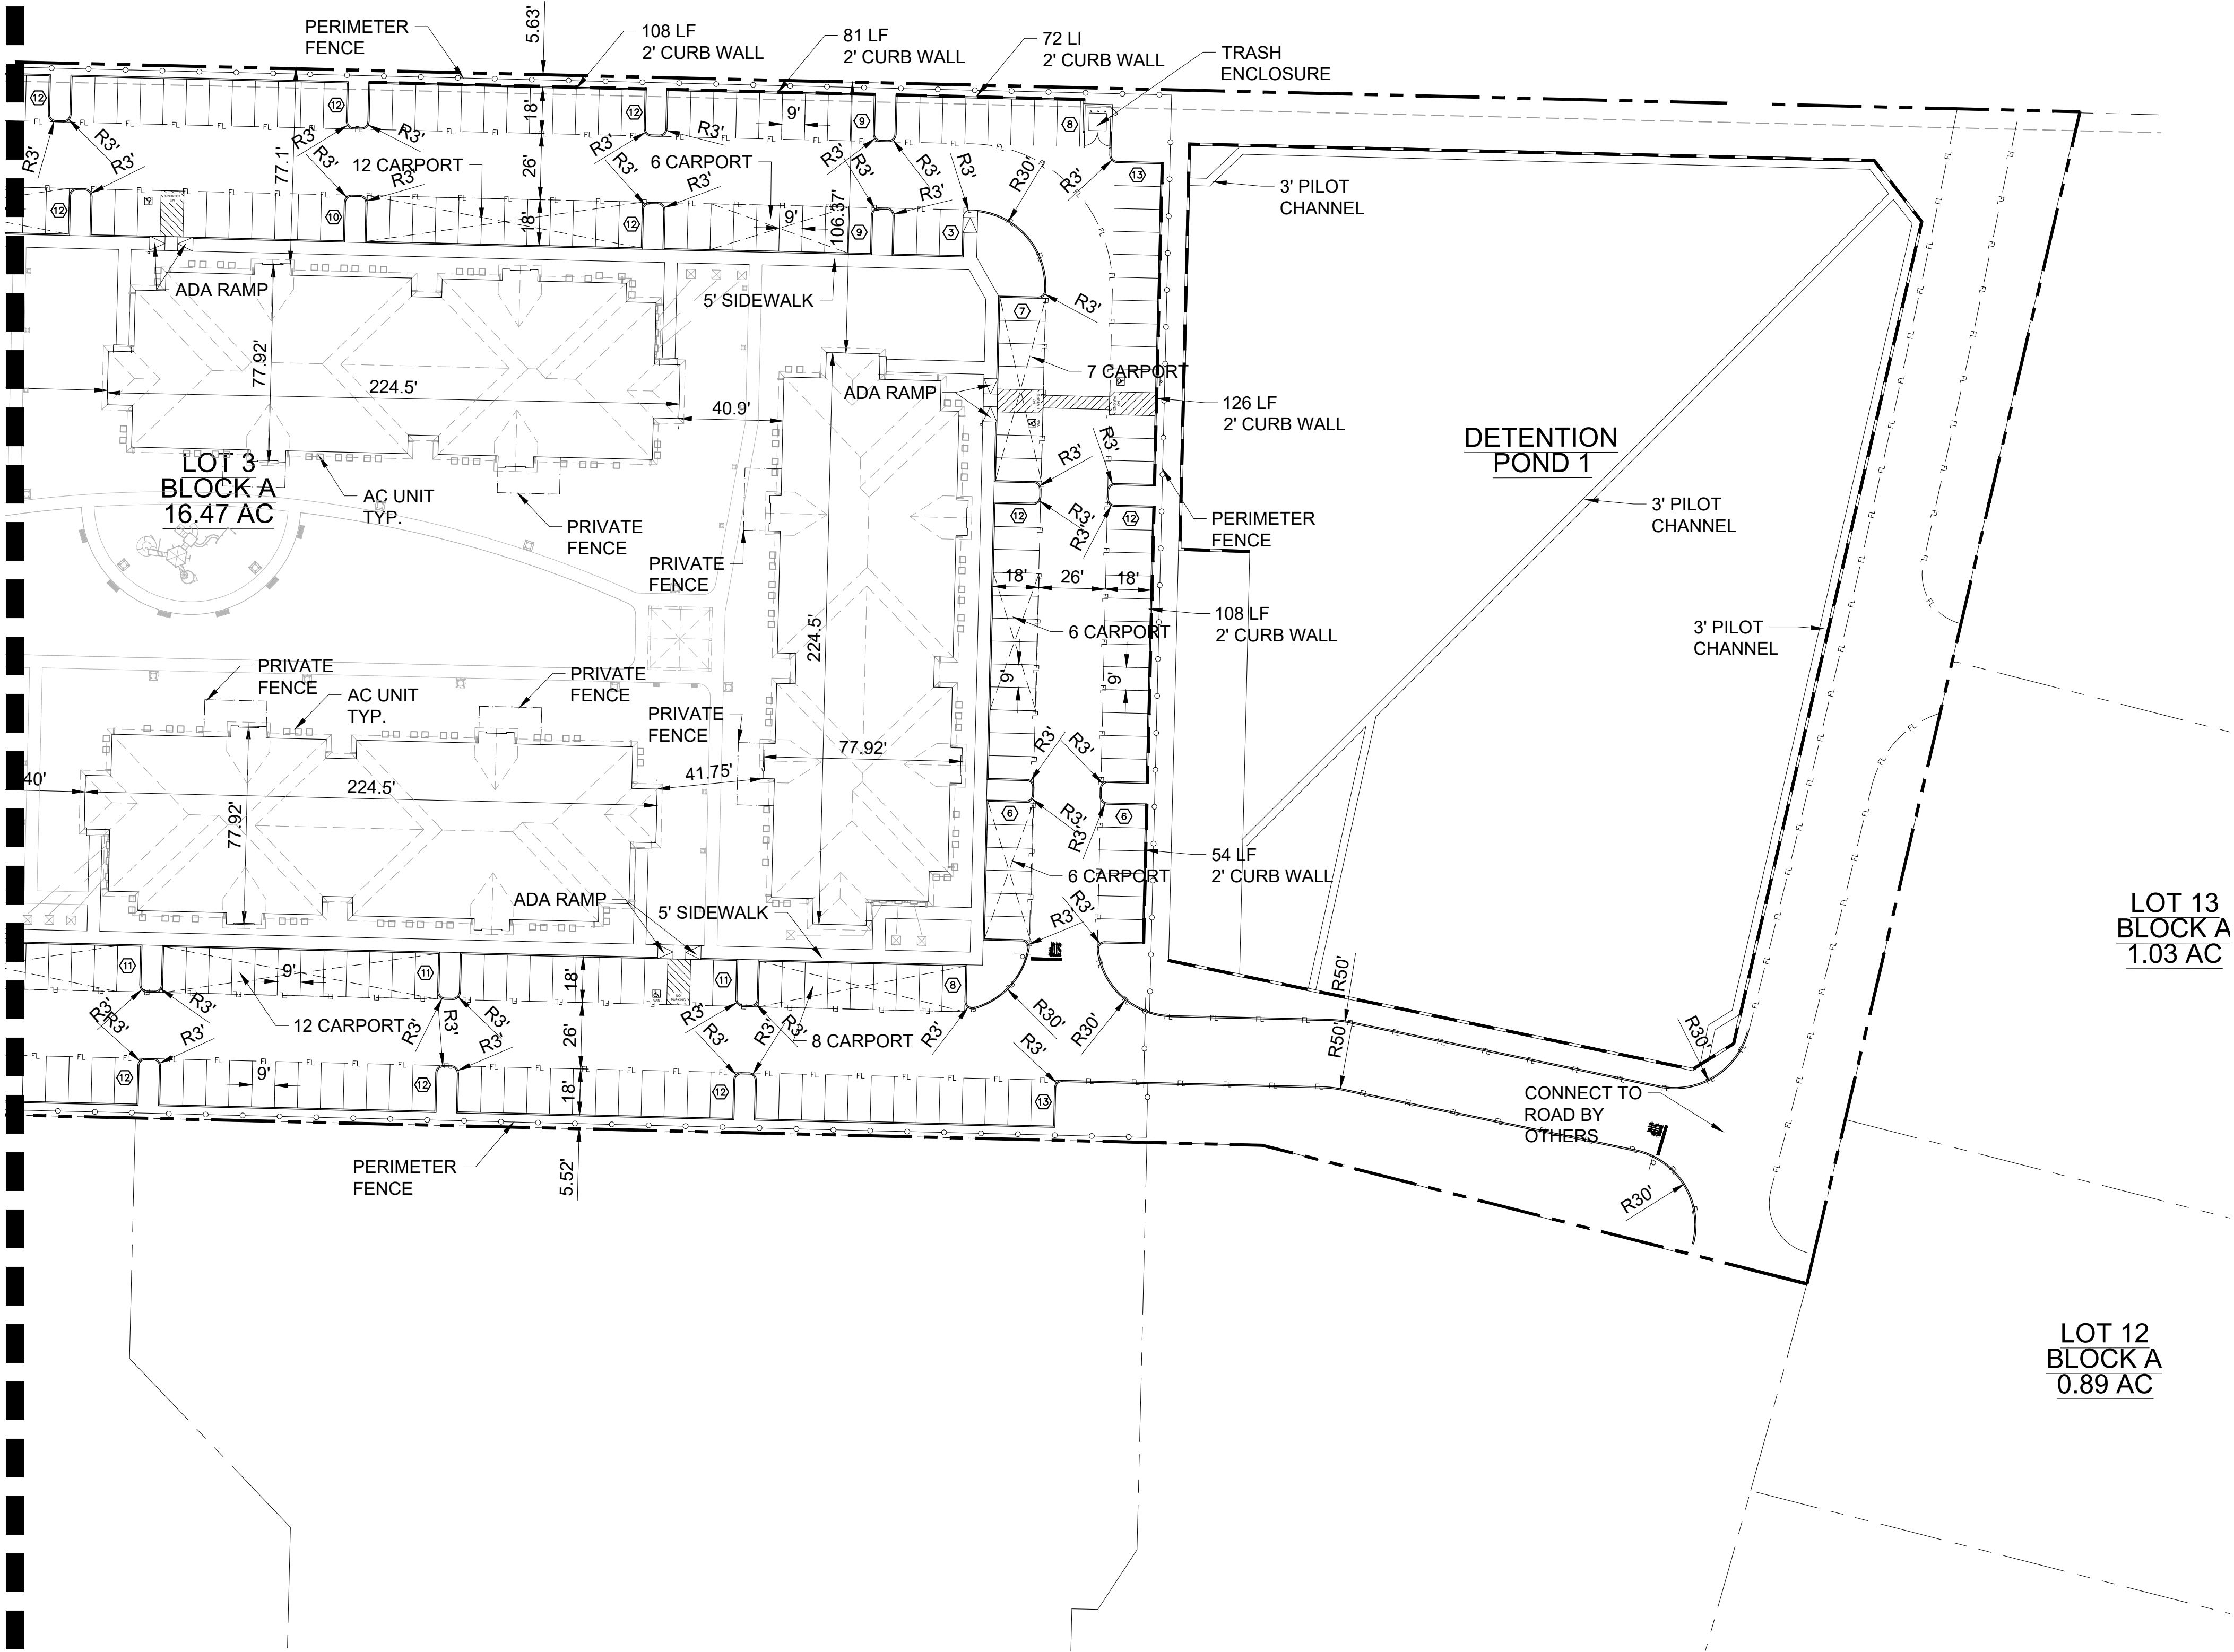



LEGEND	
	PROPOSED CONCRETE CURB AND GUTTER
	PARKING COUNT
	PROPERTY LINE
	PROPOSED FIRE LANE

- NOTES:
- ALL DIMENSIONS ARE TO FACE OF CURB UNLESS OTHERWISE NOTED.
  - REFER TO ARCHITECTURAL PLANS FOR BUILDING DIMENSIONS AND EXACT DOOR LOCATIONS.
  - NO LANDSCAPING SUCH AS TREES, HEDGES, ABOVE AND UNDERGROUND STRUCTURES SHALL BE LOCATED WITHIN EXISTING OR PROPOSED UTILITY EASEMENTS AND RIGHT OF WAY.
  - REFERENCE APPROVED ORDINANCE 12-21-22 FOR LANDSCAPING, ENTRANCE, OPEN SPACE, SCREENING, FENCING, SETBACKS, AND SIGNAGE REQUIREMENTS

**SANGER MULTI-FAMILY  
PREPARED FOR  
GREYSTAR  
SANGER, TEXAS**

No.	DATE	REVISION	BY



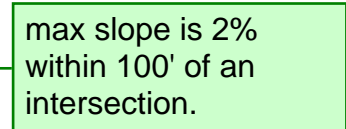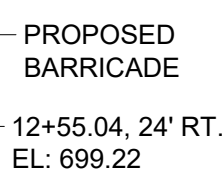

is this a PC? if so  
make sure it is  
clearly denoted


FOR REVIEW ONLY  
Not for construction purposes.  
**CLAYMOORE ENGINEERING**  
ENGINEERING AND PLANNING CONSULTANTS  
Engineer DREW DONOSKY  
P.E. No. 125651 Date 7/17/2024

[illegible]

CASE NO.	2022-185
----------	----------



PLOTTED BY: DAN CABALLERO  
 PLOT DATE: 7/17/2024 10:04 AM  
 LOCATION: Z:\PROJECTS\PROJECTS\2022-185 MALOUF SANGER\CADD\SHEETS\MULTI-FAMILY GREYSTAR\C-4.3 PAVING, STRIPING AND SIGNAGE PLAN.DWG  
 LAST SAVED: 7/15/2024 9:04 PM

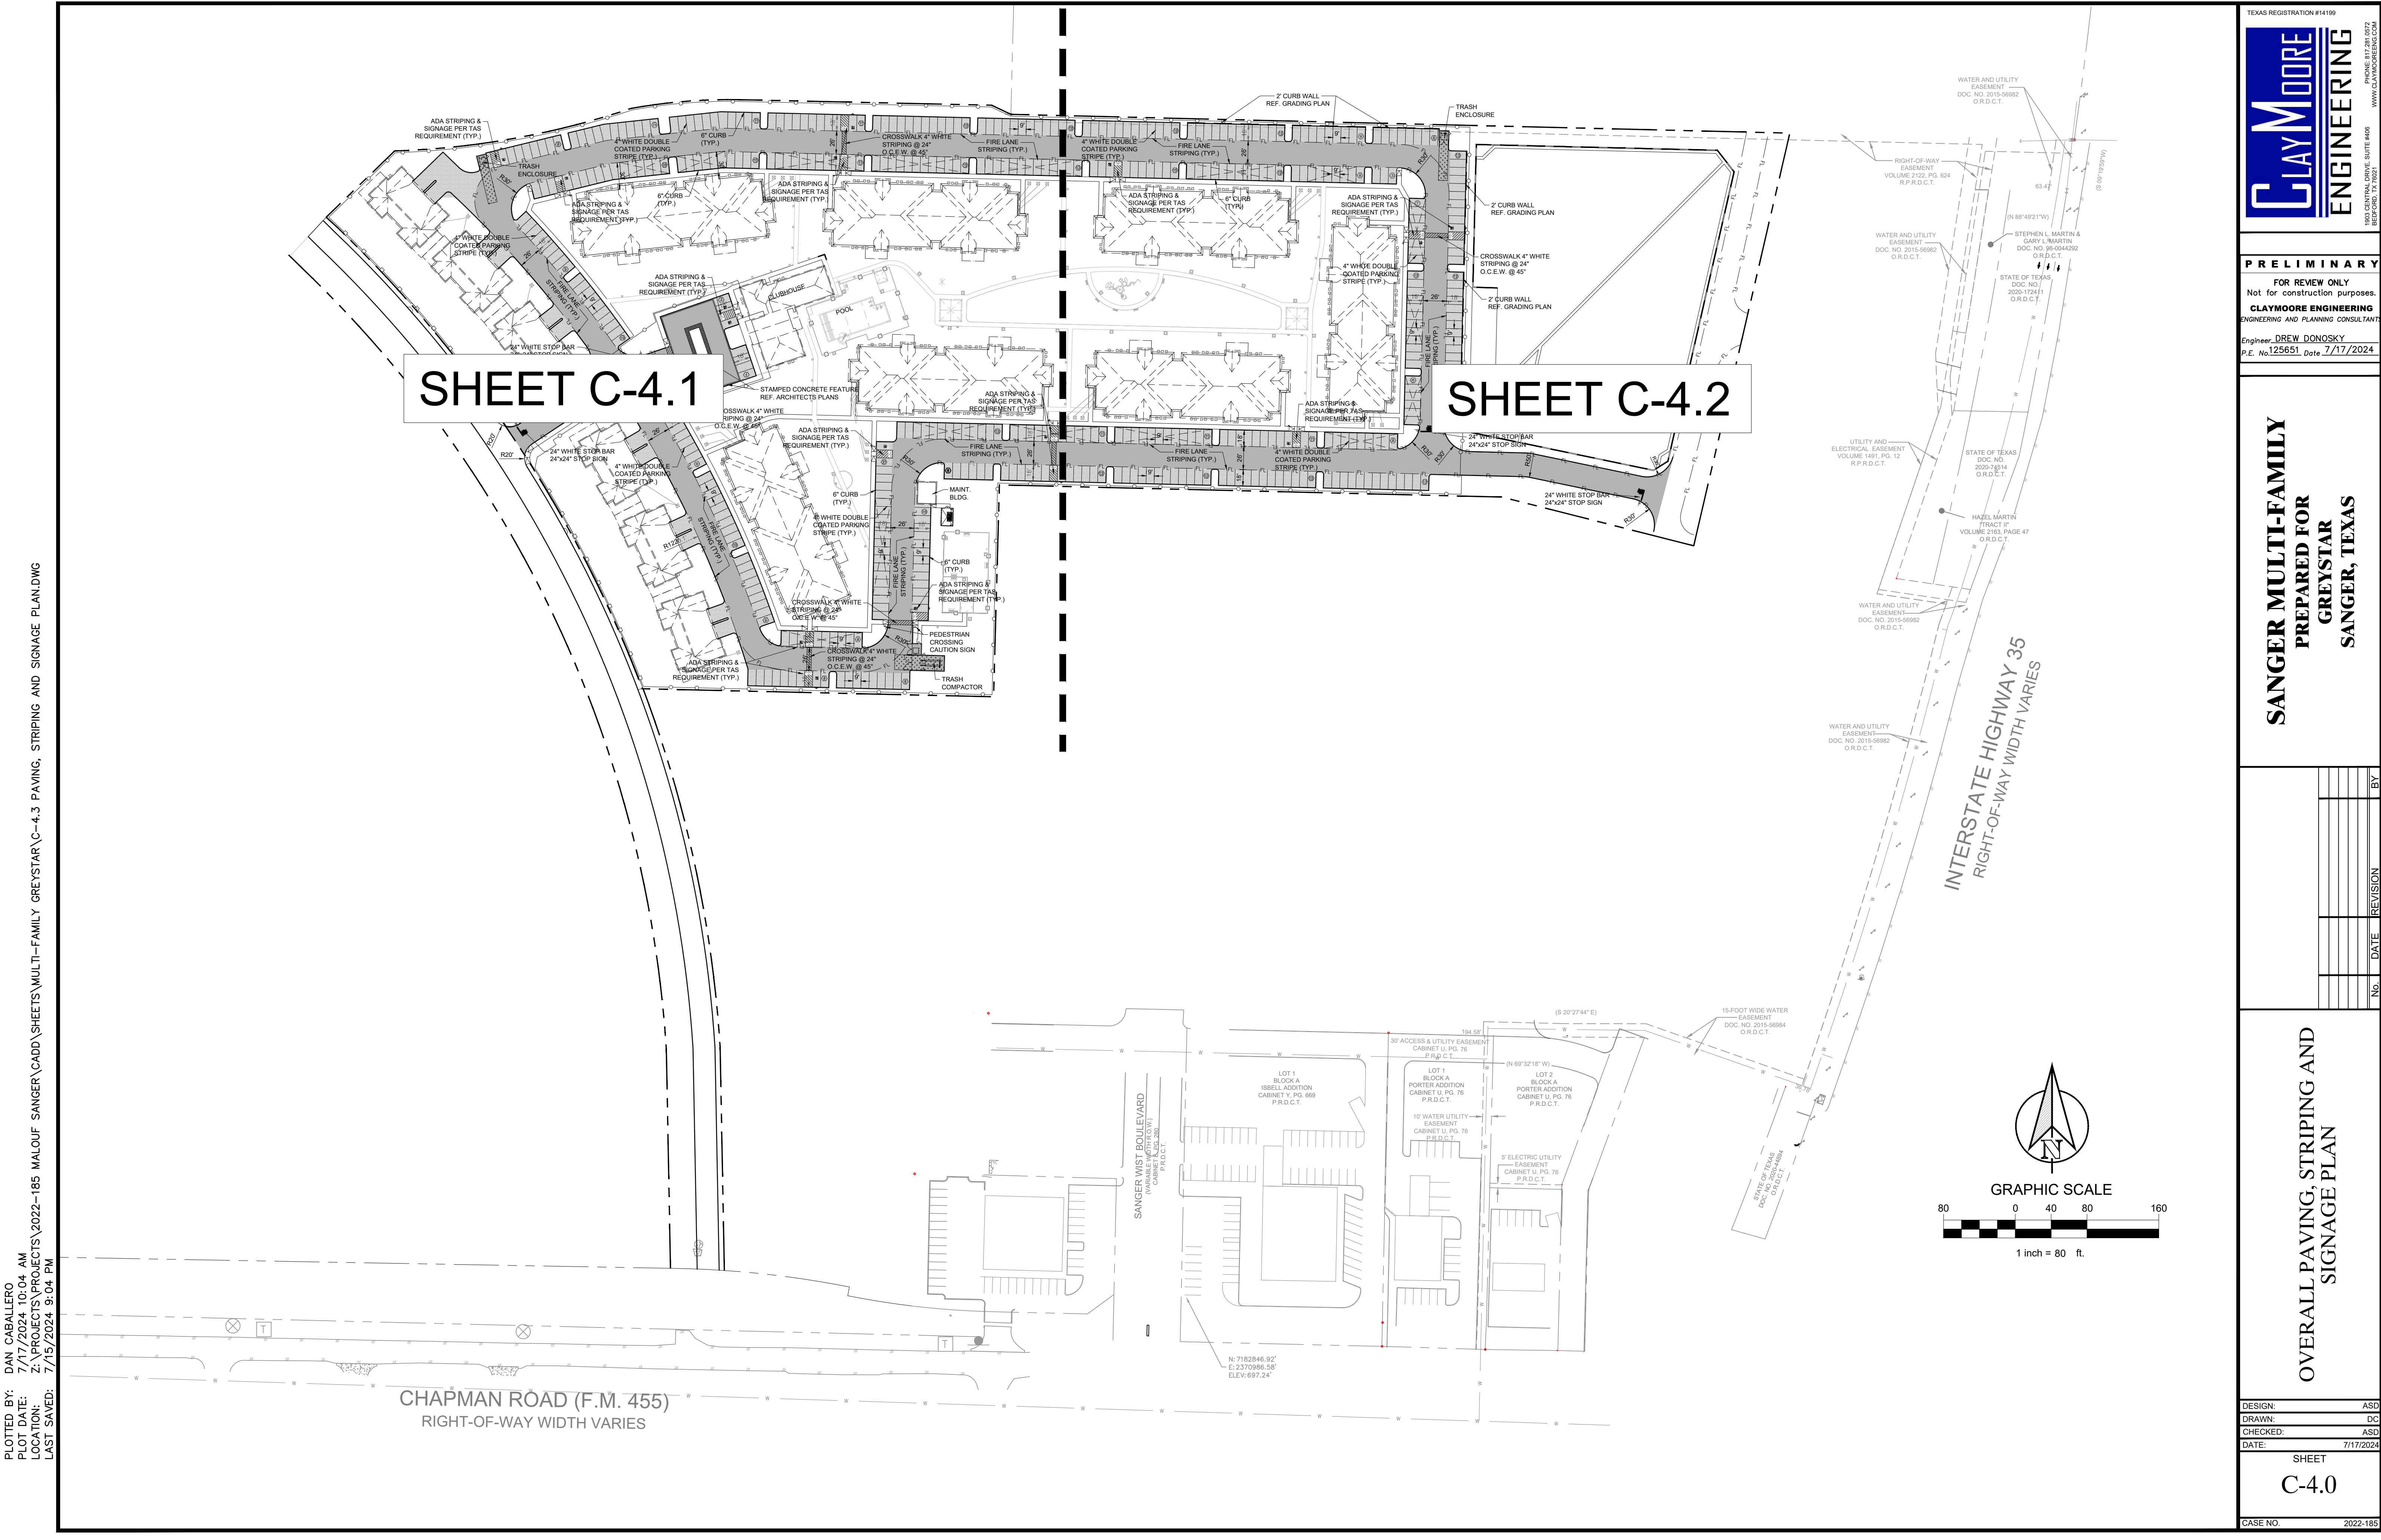

**PRELIMINARY**  
 FOR REVIEW ONLY  
 Not for construction purposes.  
**CLAYMOORE ENGINEERING**  
 ENGINEERING AND PLANNING CONSULTANTS  
 Engineer: **DREW DONOSKY**  
 P.E. No. 125651 Date: **7/17/2024**

**SANGER MULTI-FAMILY**  
**PREPARED FOR**  
**GREYSTAR**  
**SANGER, TEXAS**


NO.	DATE	REVISION	BY



PLOTTED BY: DAN CABALLERO  
 PLOT DATE: 7/17/2024 10:04 AM  
 LOCATION: Z:\PROJECTS\PROJECTS\2022-185 MALOUF SANGER\MULTI-FAMILY GREYSTAR\C-4.3 PAVING, STRIPING AND SIGNAGE PLANDWG  
 LAST SAVED: 7/15/2024 9:04 PM



MATCHLINE SHEET C-4.2

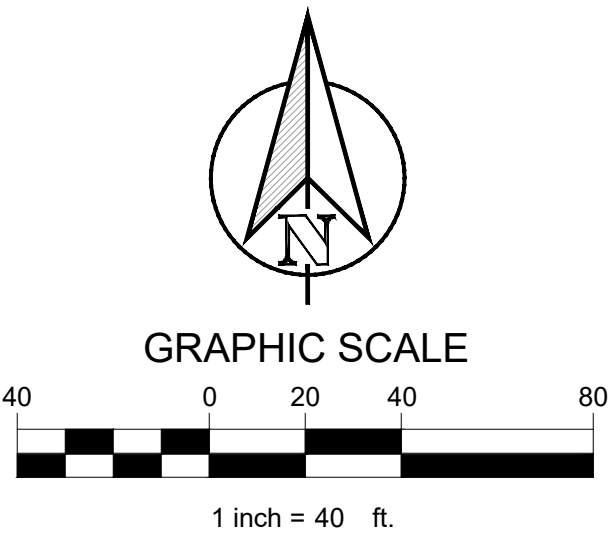

LEGEND	
	PROPOSED CONCRETE CURB AND GUTTER
	PARKING COUNT
	PROPERTY LINE
	PROPOSED FIRE LANE
	5" THICK LIGHT DUTY PAVEMENT
	6" THICK MODERATE DUTY PAVEMENT
	7" THICK HEAVY DUTY PAVEMENT

- NOTES:
- ALL DIMENSIONS ARE TO FACE OF CURB UNLESS OTHERWISE NOTED.
  - REFER TO ARCHITECTURAL PLANS FOR BUILDING DIMENSIONS AND EXACT DOOR LOCATIONS.
  - NO LANDSCAPING SUCH AS TREES, HEDGES, ABOVE AND UNDERGROUND STRUCTURES SHALL BE LOCATED WITHIN EXISTING OR PROPOSED UTILITY EASEMENTS AND RIGHT OF WAY.
  - REFERENCE APPROVED ORDINANCE 12-21-22 FOR LANDSCAPING, ENTRANCE, OPEN SPACE, SCREENING, FENCING, SETBACKS, AND SIGNAGE REQUIREMENTS

The preliminary plat references ordinance 12-32-22

PARKING	
REGULAR PARKING	465 SPACES
ADA PARKING	18 SPACES
TOTAL	483 SPACES

Show how this is calculated. Show that this matches the approved PD

what are the plans within the roadway

**PRELIMINARY**  
 FOR REVIEW ONLY  
 Not for construction purposes.  
**CLAYMOORE ENGINEERING**  
 ENGINEERING AND PLANNING CONSULTANTS  
 Engineer: DREW DONOSKY  
 P.E. No.125651 Date: 7/17/2024

**SANGER MULTI-FAMILY**  
**PREPARED FOR**  
**GREYSTAR**  
**SANGER, TEXAS**



No.	DATE	REVISION	BY

PAVING, STRIPING AND SIGNAGE  
 PLAN



PLOTTED BY: DAN CABALLERO  
PLOT DATE: 7/17/2024 10:04 AM  
LOCATION: Z:\PROJECTS\PROJECTS\2022-185 MALOUF SANGER\MULTI-FAMILY GREYSTAR\4.3 PAVING, STRIPING AND SIGNAGE PLAN.DWG  
LAST SAVED: 7/15/2024 9:04 PM

MATCHLINE SHEET C-4.1

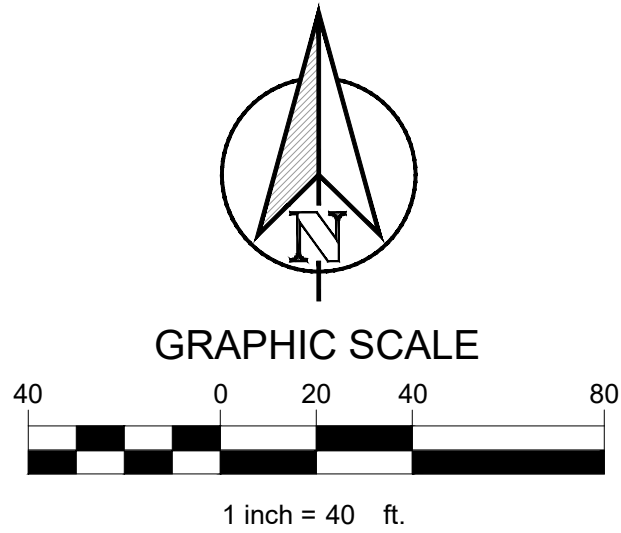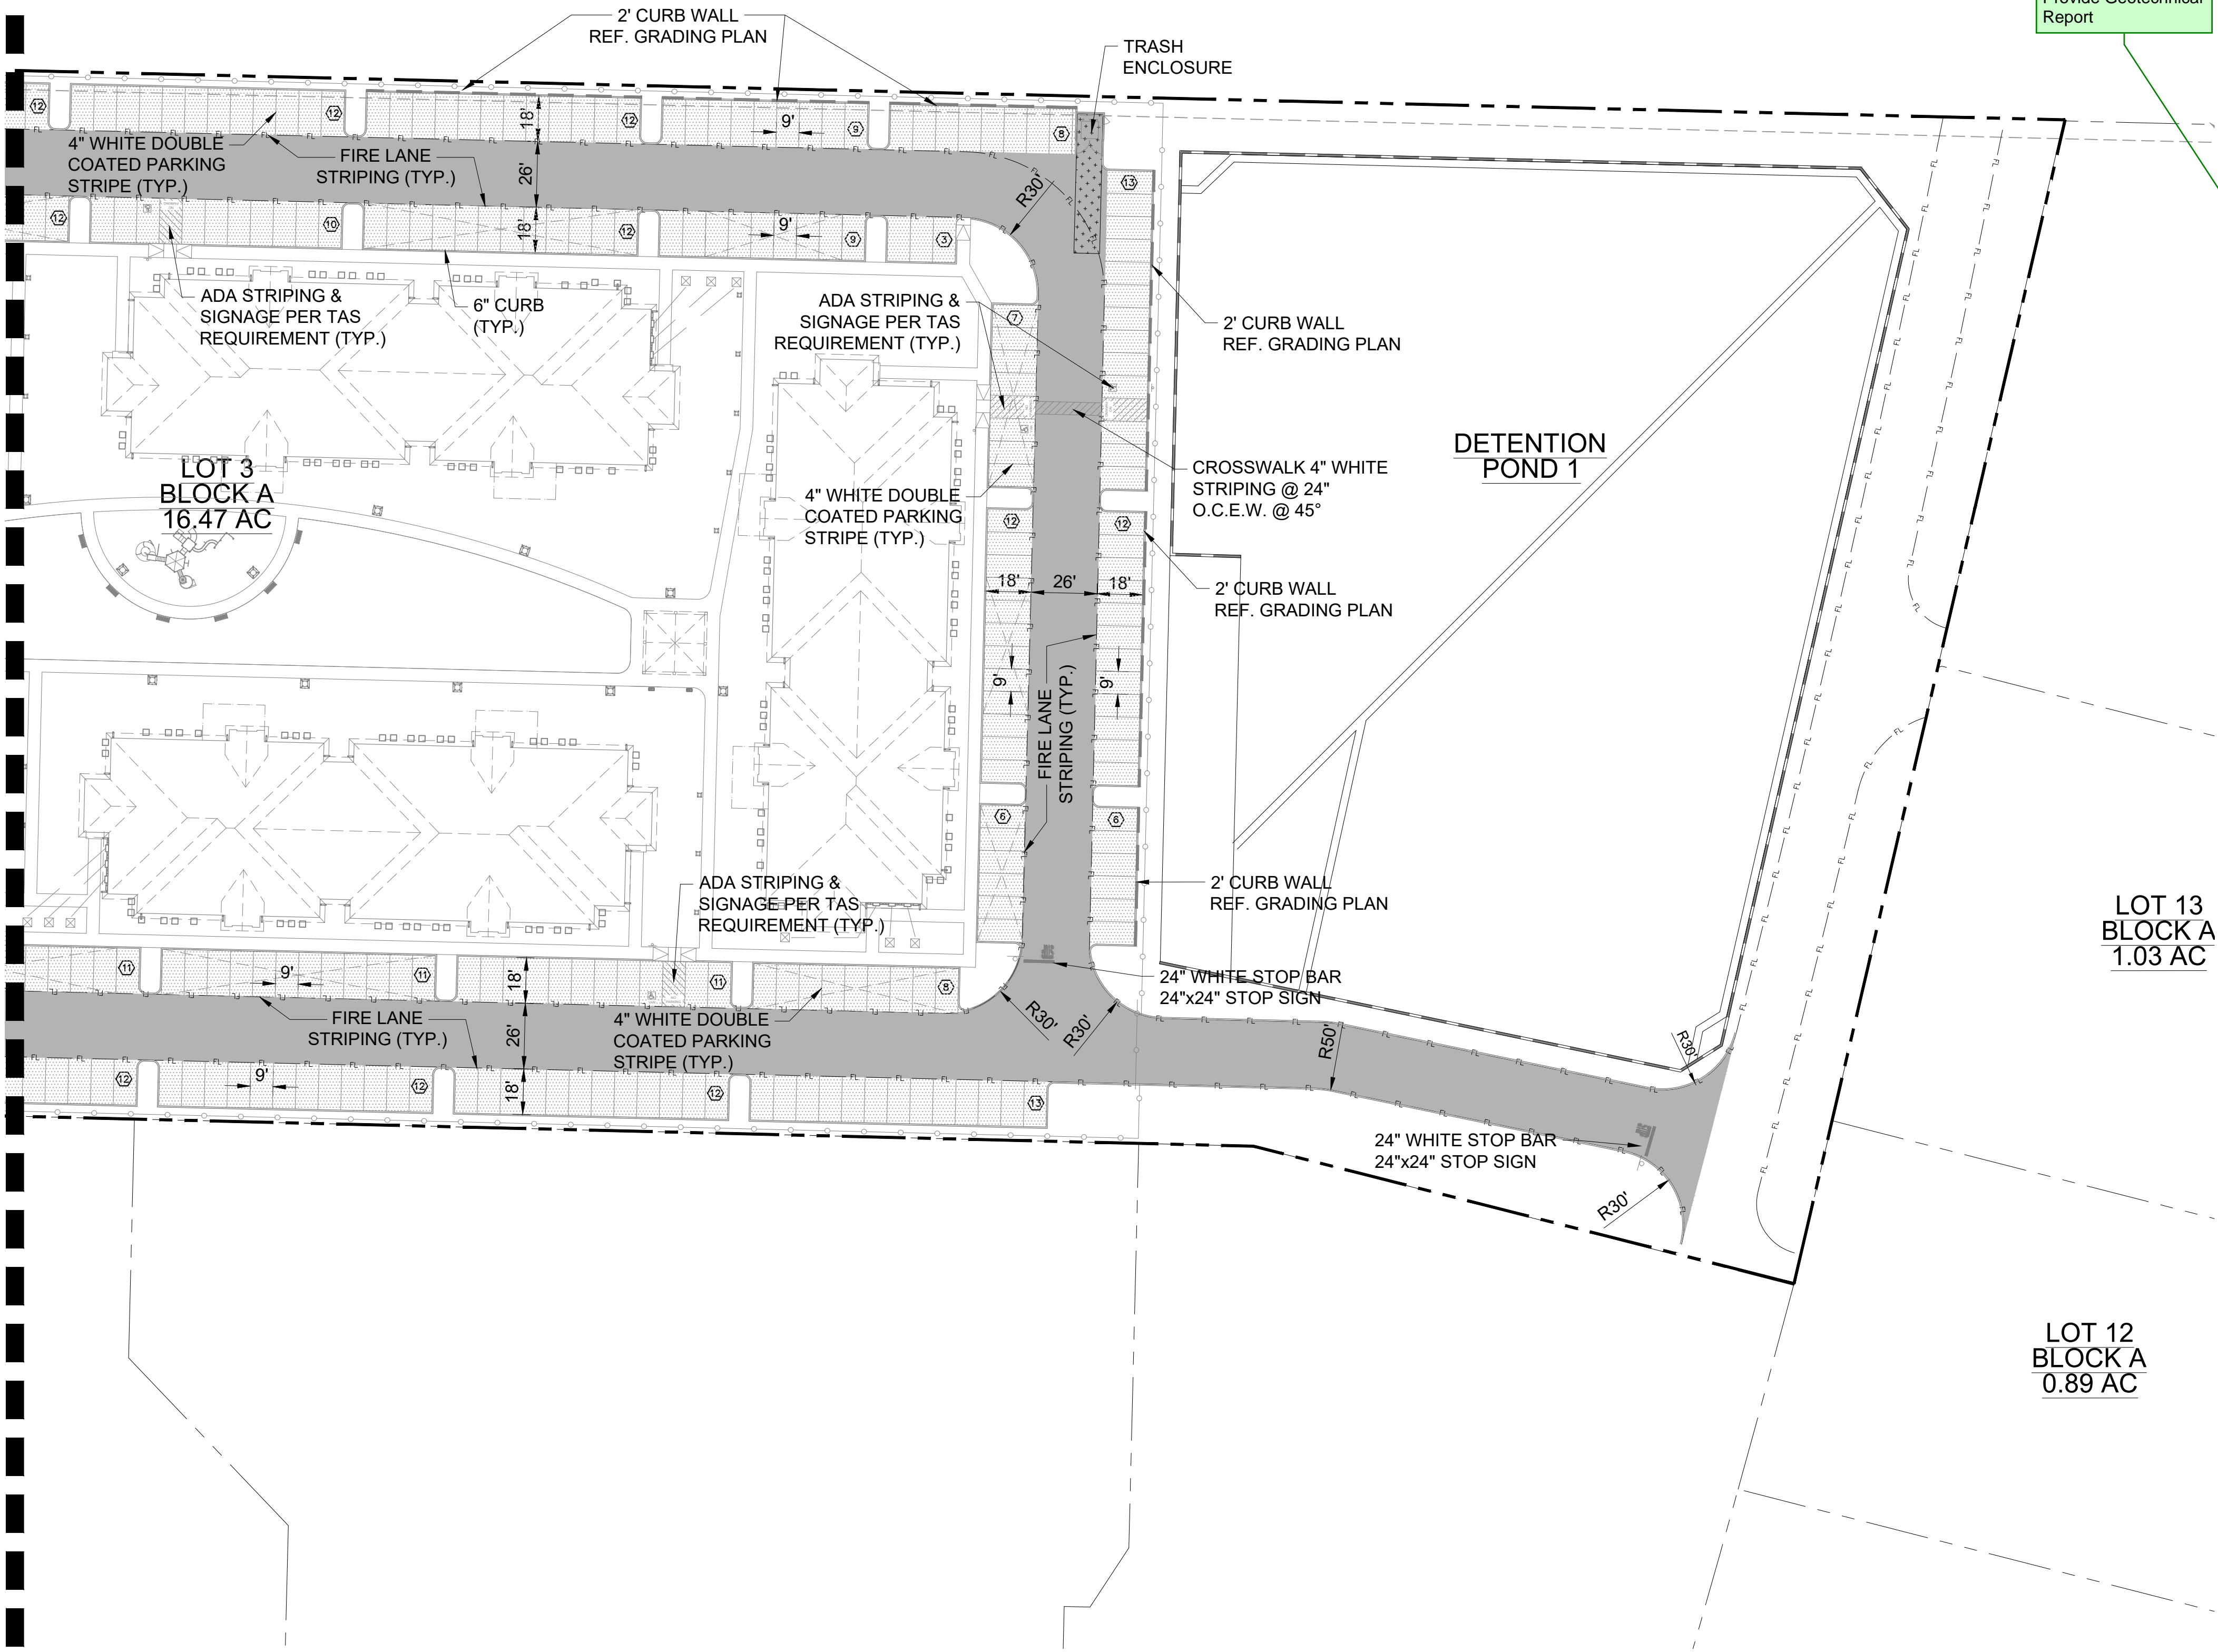

LEGEND	
	PROPOSED CONCRETE CURB AND GUTTER
	PARKING COUNT
	PROPERTY LINE
	PROPOSED FIRE LANE
	5" THICK LIGHT DUTY PAVEMENT
	6" THICK MODERATE DUTY PAVEMENT
	7" THICK HEAVY DUTY PAVEMENT

- NOTES:
- ALL DIMENSIONS ARE TO FACE OF CURB UNLESS OTHERWISE NOTED.
  - REFER TO ARCHITECTURAL PLANS FOR BUILDING DIMENSIONS AND EXACT DOOR LOCATIONS.
  - NO LANDSCAPING SUCH AS TREES, HEDGES, ABOVE AND UNDERGROUND STRUCTURES SHALL BE LOCATED WITHIN EXISTING OR PROPOSED UTILITY EASEMENTS AND RIGHT OF WAY.
  - REFERENCE APPROVED ORDINANCE 12-21-22 FOR LANDSCAPING, ENTRANCE, OPEN SPACE, SCREENING, FENCING, SETBACKS, AND SIGNAGE REQUIREMENTS

NO.	DATE	REVISION	BY




PLOTTED BY: DAN CABALLERO  
 PLOT DATE: 7/17/2024 10:05 AM  
 LOCATION: Z:\PROJECTS\PROJECTS\2022-185 MALOUF SANGER\CADD\SHEETS\MULTI-FAMILY GREYSTAR\C-4.3 FENCE PLAN.DWG  
 LAST SAVED: 7/12/2024 10:51 AM



Provide gate details.  
must conform to  
ordinance 10.105(3)

LEGEND	
	PROPOSED CONCRETE CURB AND GUTTER
	PROPERTY LINE
	PROPOSED FIRE LANE
	STREET FRONTAGE FENCE (72" HT WROUGHT IRON FENCE, MASONRY COLUMNS 24' O.C.)
	PERIMETER FENCE (72" HT WROUGHT IRON FENCE)
	POOL/DOG PARK FENCE (60" HT STEEL TUBE FENCE)
	PRIVATE YARD FENCE (42" HT STEEL TUBE FENCE)

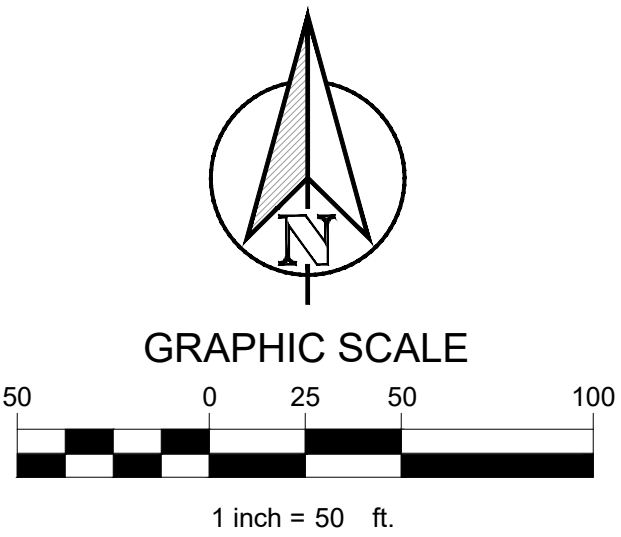

TEXAS REGISTRATION #14199

CLAYMOORE ENGINEERING

PHONE 817.281.0572  
1903 CENTRAL DRIVE, SUITE #408  
BECKFORD, TX 76001  
WWW.CLAYMOOREENG.COM

**PRELIMINARY**

FOR REVIEW ONLY  
Not for construction purposes.

**CLAYMOORE ENGINEERING**  
ENGINEERING AND PLANNING CONSULTANTS

Engineer: **DREW DONOSKY**  
P.E. No.125651 Date: **7/17/2024**

**SANGER MULTI-FAMILY  
PREPARED FOR  
GREYSTAR  
SANGER, TEXAS**

No.	DATE	REVISION	BY

FENCE PLAN


DESIGN: ASD  
DRAWN: DC  
CHECKED: ASD  
DATE: 7/17/2024

SHEET  
C-4.3

CASE NO. 2022-185






PLOTTED BY: DAN CABALLERO  
 PLOT DATE: 7/17/2024 10:06 AM  
 LOCATION: Z:\PROJECTS\PROJECTS\2022-185 MALOUF SANGER\CADD\SHEETS\MULTI-FAMILY GREYSTAR\C-3.3 GRADING PLAN.DWG  
 LAST SAVED: 7/15/2024 9:19 PM

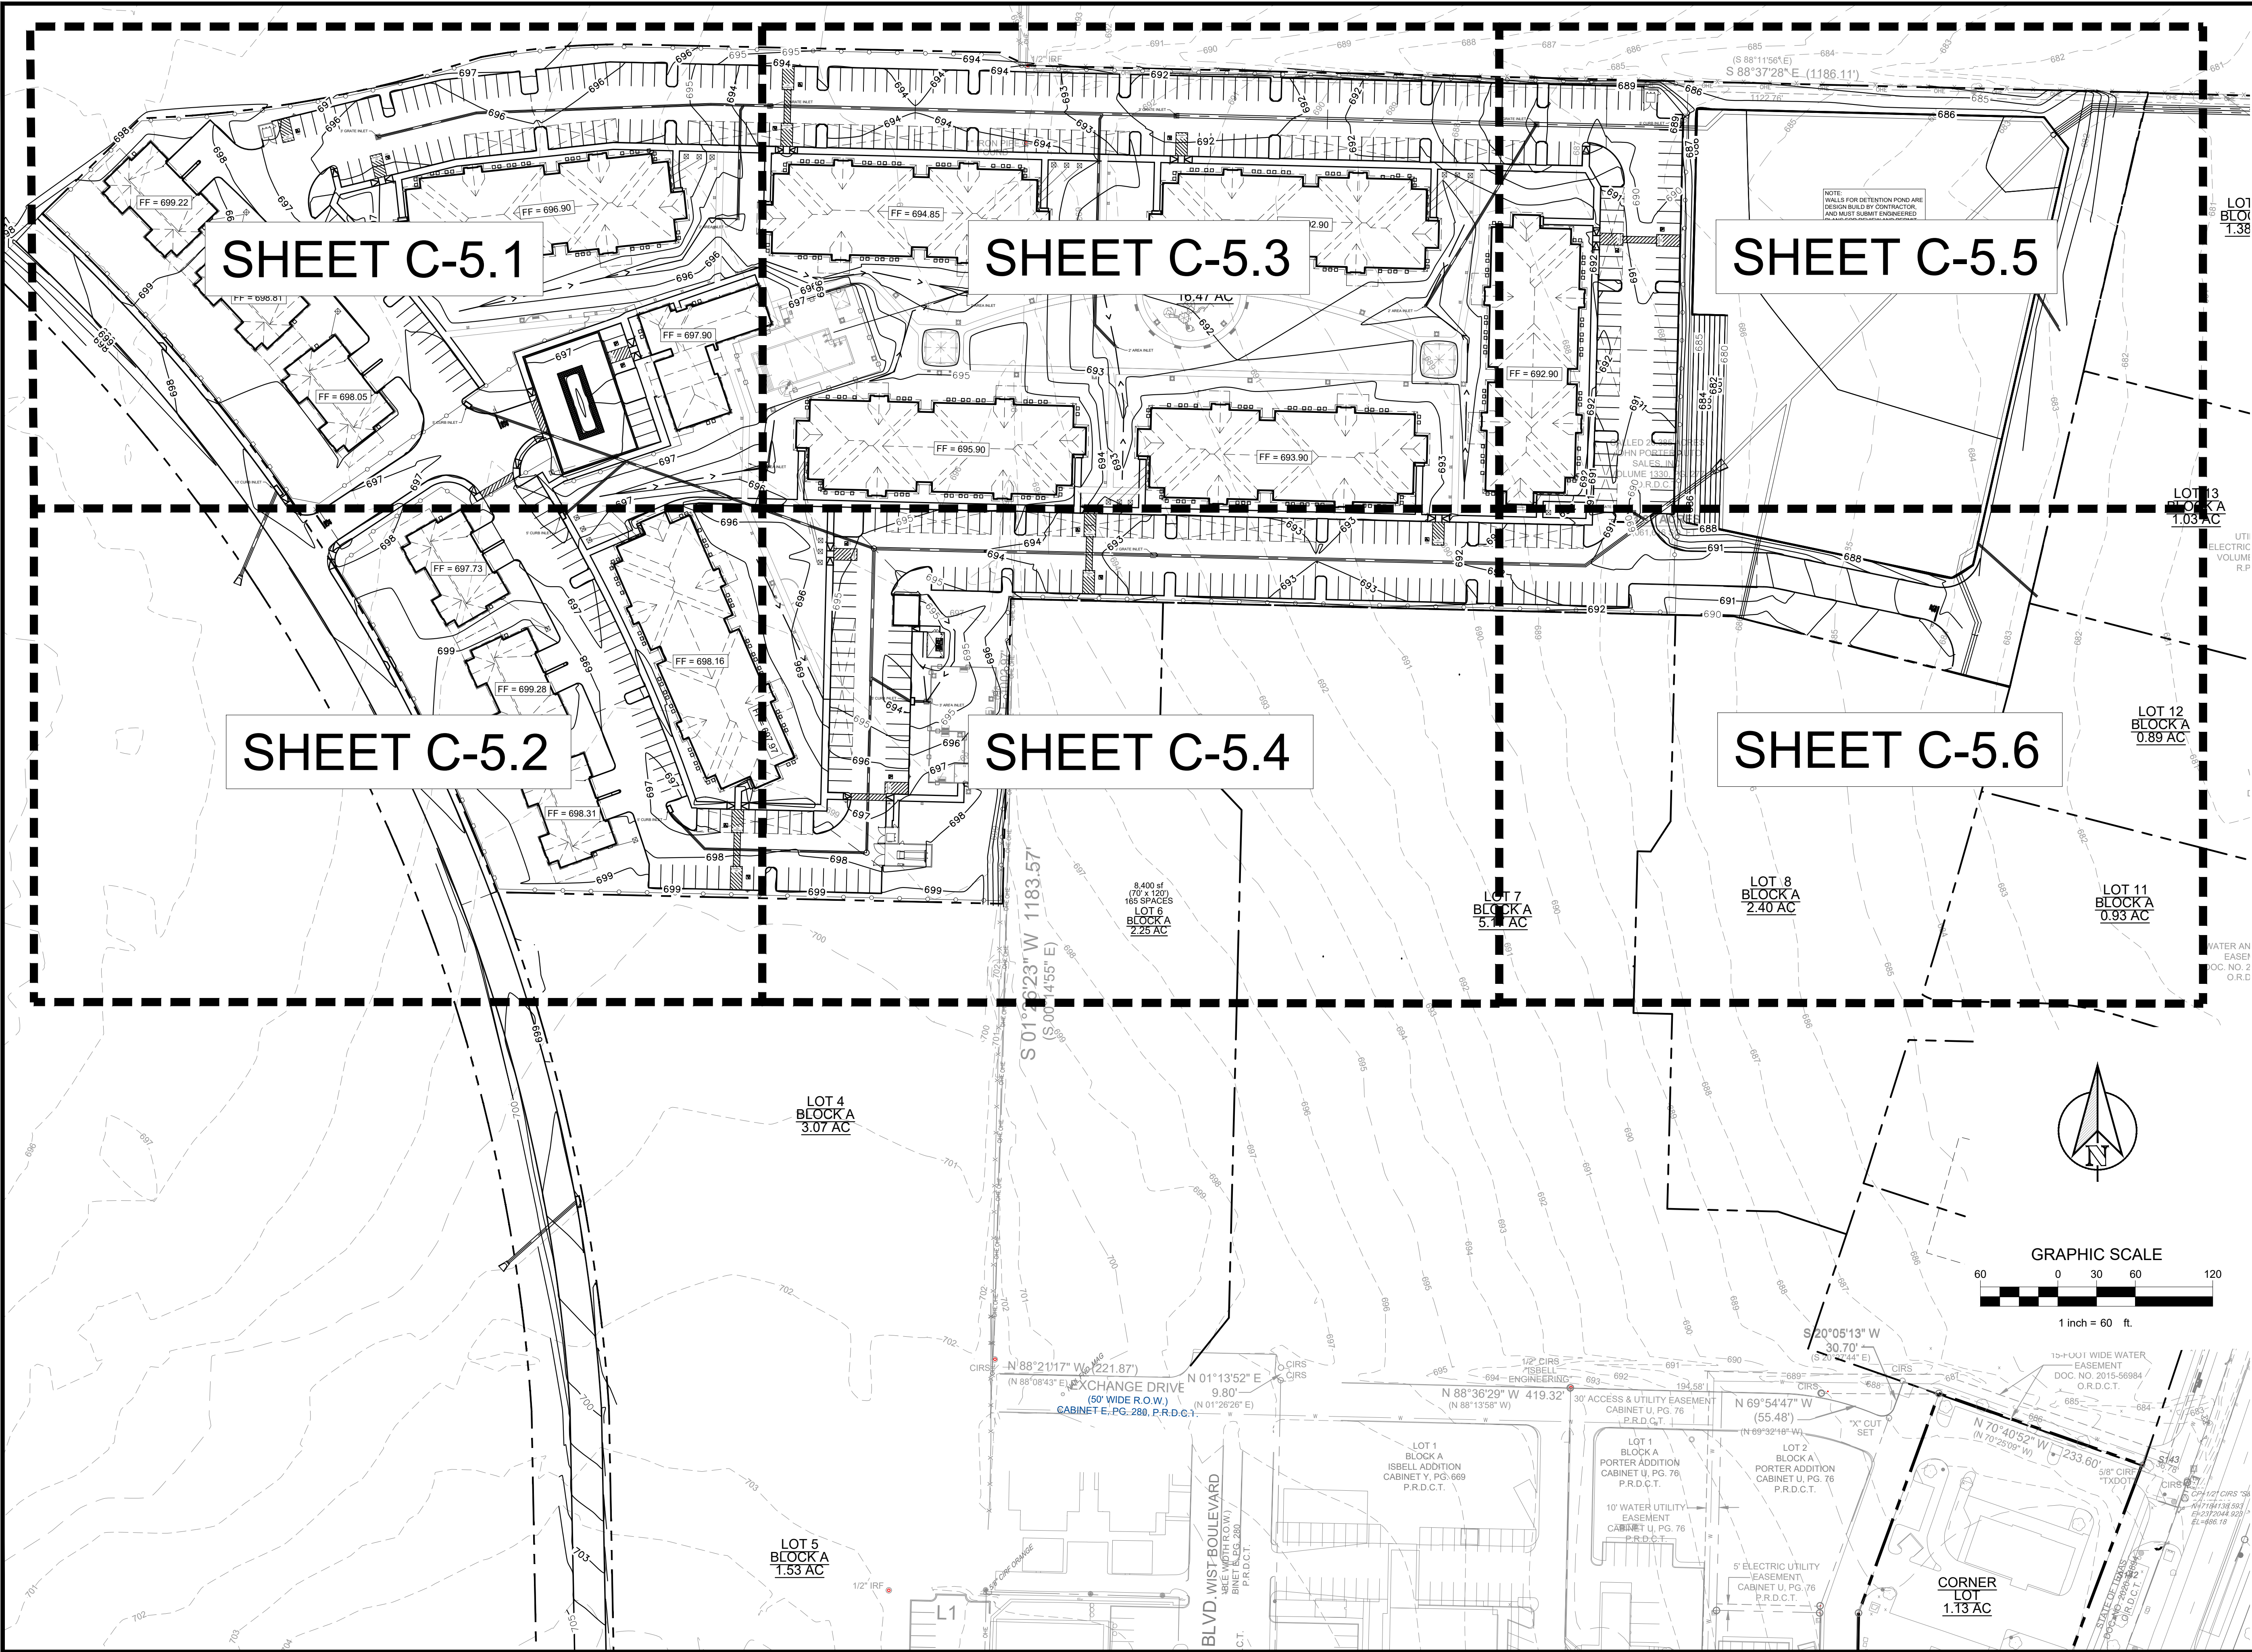

NO.	DATE	REVISION	BY



PLOTTED BY: DAN CABALLERO  
 PLOT DATE: 7/17/2024 10:06 AM  
 LOCATION: Z:\PROJECTS\PROJECTS\2022-185 MALOUF SANGER\CADD\SHEETS\MULTI-FAMILY GREYSTAR\C-3.3 GRADING PLAN.DWG  
 LAST SAVED: 7/15/2024 9:19 PM

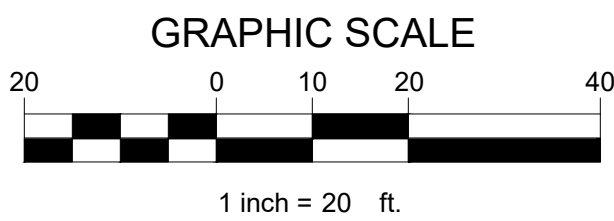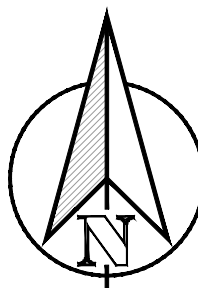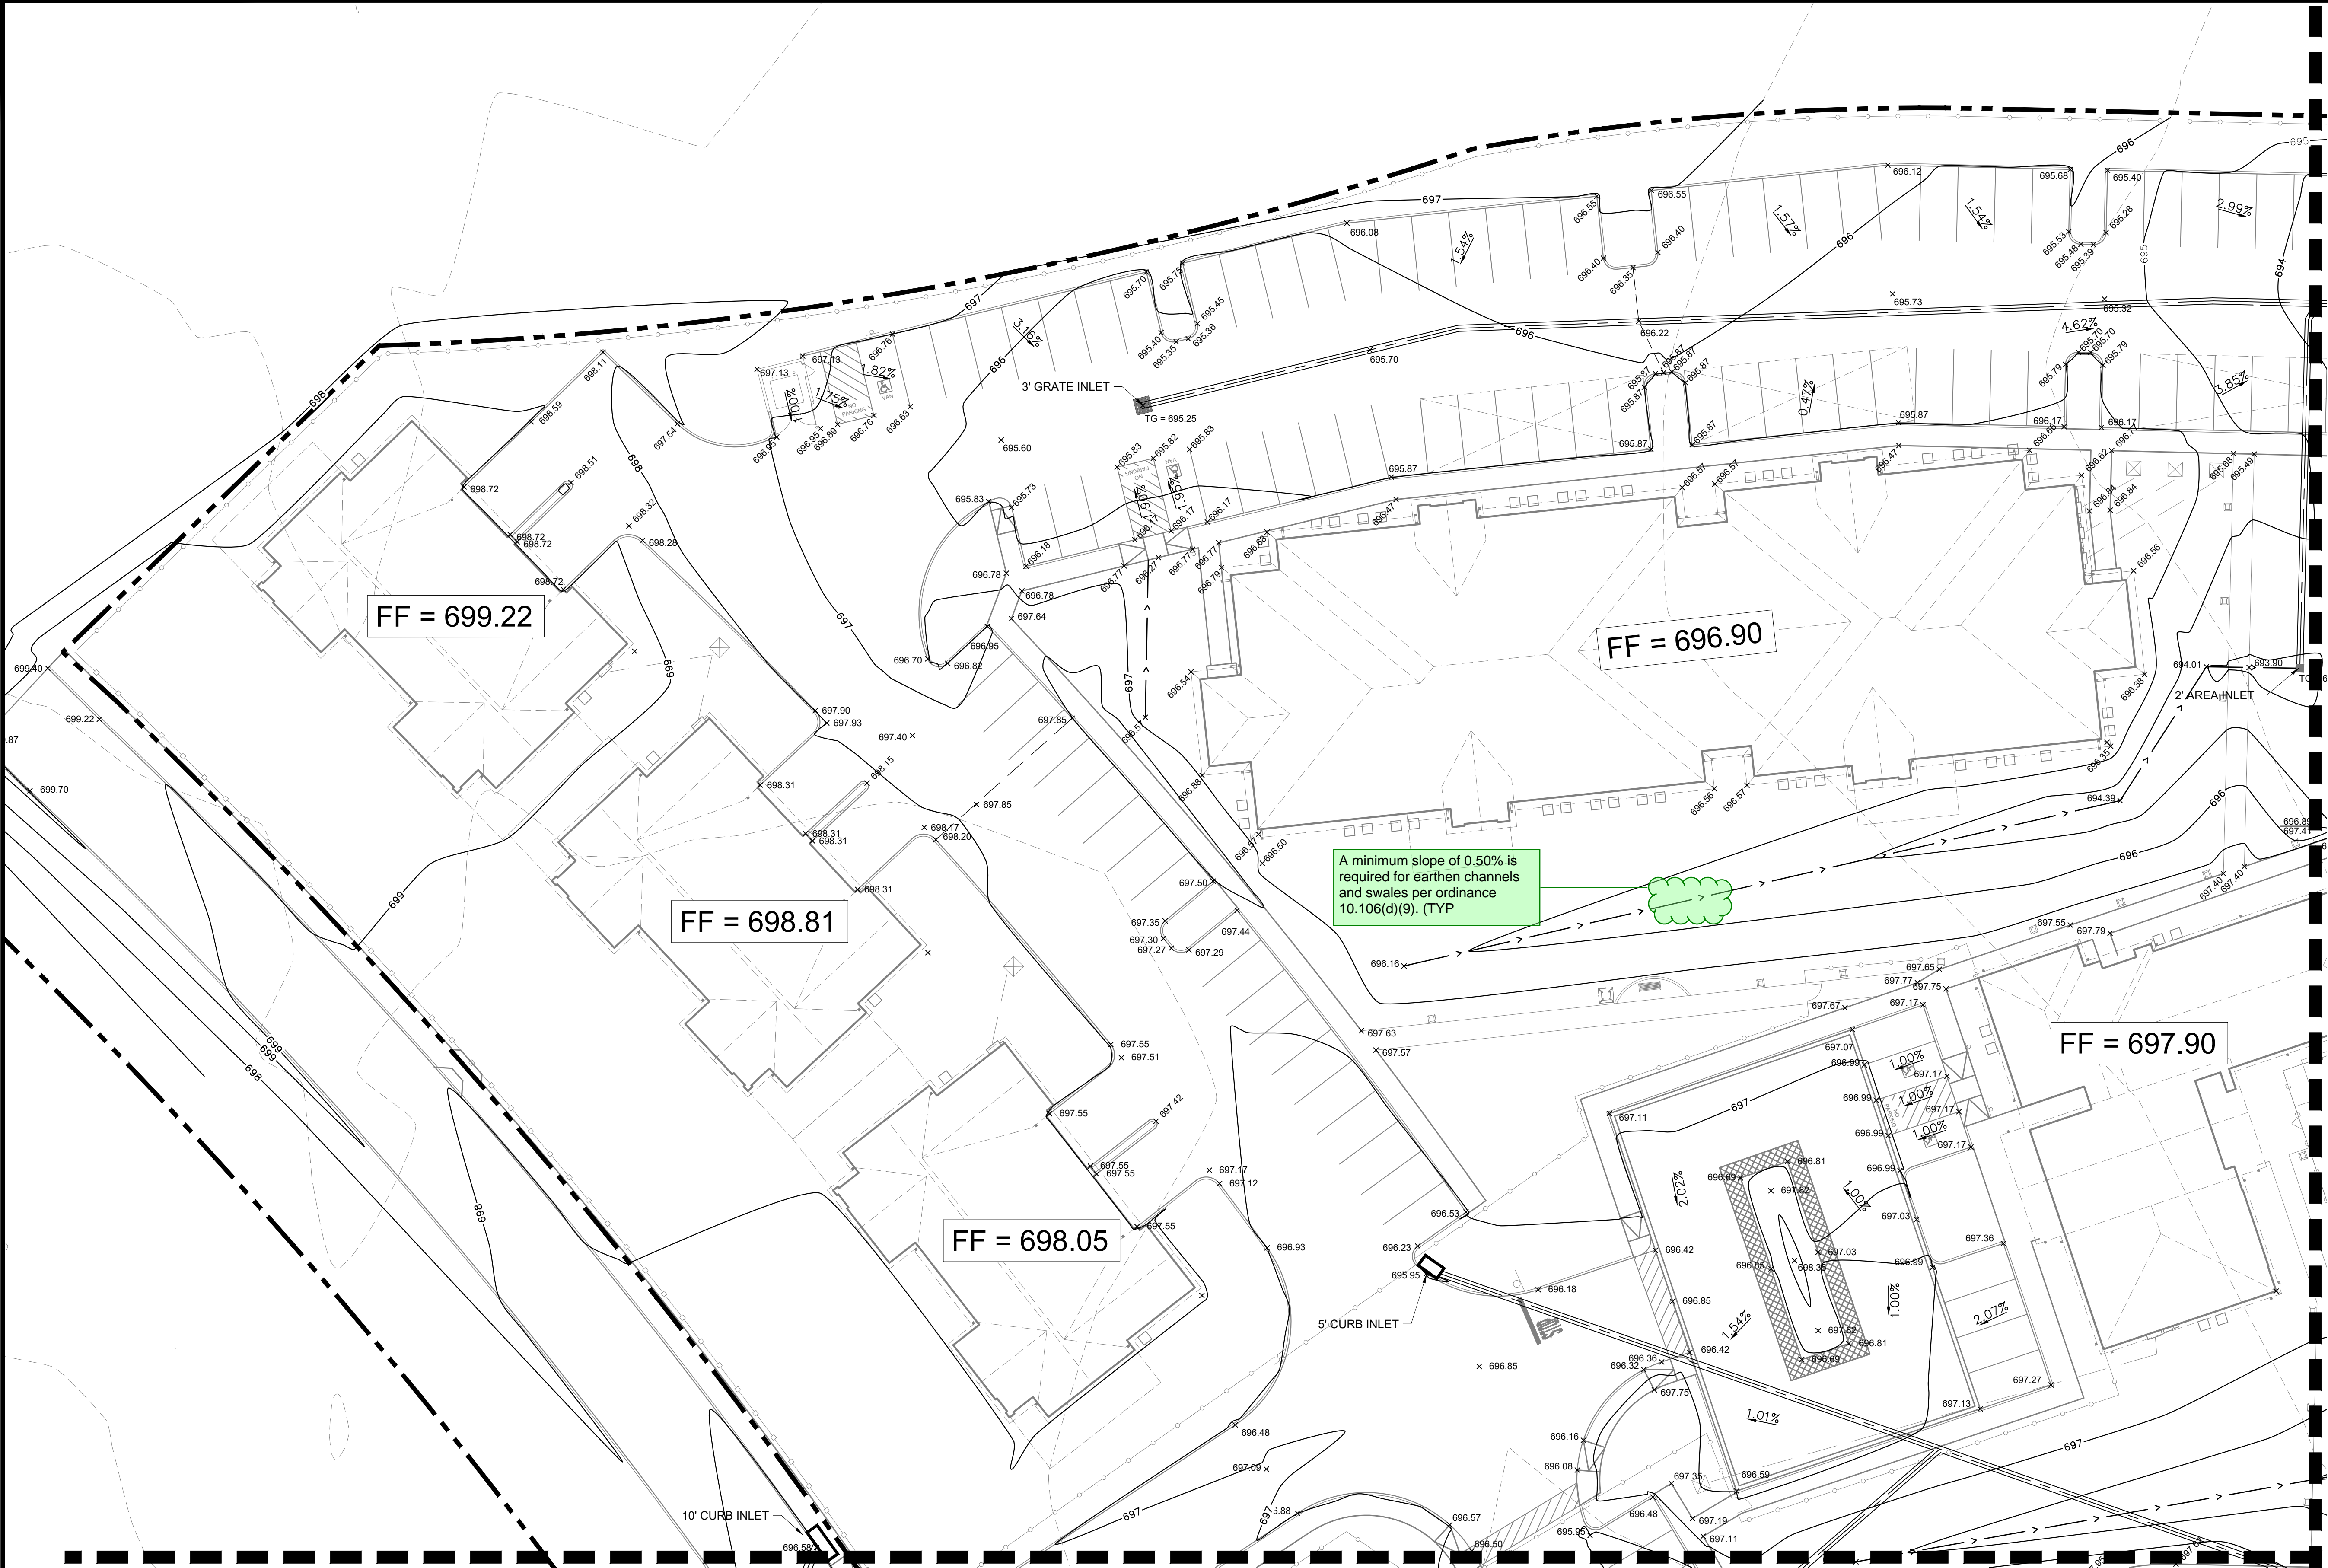

**PRELIMINARY**  
 FOR REVIEW ONLY  
 Not for construction purposes.  
**CLAYMOORE ENGINEERING**  
 ENGINEERING AND PLANNING CONSULTANTS  
 Engineer: **DREW DONOSKY**  
 P.E. No.125651 Date: **7/17/2024**


**SANGER MULTI-FAMILY**  
**PREPARED FOR**  
**GREYSTAR**  
**SANGER, TEXAS**

No.	DATE	REVISION	BY

DESIGN:	ASD
DRAWN:	DC
CHECKED:	ASD
DATE:	7/17/2024



PLOTTED BY: DAN CABALLERO  
 PLOT DATE: 7/17/2024 10:06 AM  
 LOCATION: Z:\PROJECTS\PROJECTS\2022-185 MALOUF SANGER\CADD\SHEETS\MULTI-FAMILY GREYSTAR\C-3.3 GRADING PLAN.DWG  
 LAST SAVED: 7/15/2024 9:19 PM

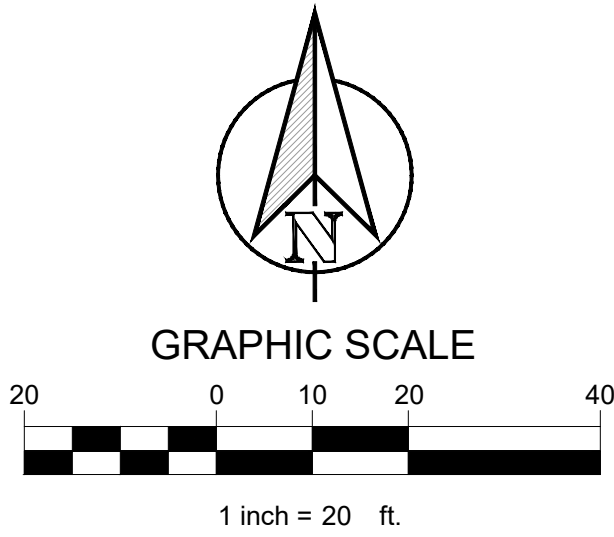

TEXAS REGISTRATION #14199  
**CLAYMOORE**  
**ENGINEERING**  
 1903 CENTRAL DRIVE, SUITE #408  
 BEFORD, TX 76001  
 PHONE: 817.281.0272  
 WWW.CLAYMOOREENG.COM

**PRELIMINARY**  
 FOR REVIEW ONLY  
 Not for construction purposes.  
**CLAYMOORE ENGINEERING**  
 ENGINEERING AND PLANNING CONSULTANTS  
 Engineer: **DREW DONOSKY**  
 P.E. No.125651 Date: **7/17/2024**

**SANGER MULTI-FAMILY**  
**PREPARED FOR**  
**GREYSTAR**  
**SANGER, TEXAS**

NO.	DATE	REVISION	BY

**GRADING PLAN**

DESIGN:	ASD
DRAWN:	DC
CHECKED:	ASD
DATE:	7/17/2024

SHEET  
**C-5.2**

CASE NO. 2022-185



**CLAYMOORE**  
**ENGINEERING**

FOR REVIEW ONLY  
Not for construction purposes.

**LAYMOORE ENGINEERING**  
ENGINEERING AND PLANNING CONSULTANTS

Drawn by DREW DONOSKY  
No. 125651 Date 7/17/2024

**SANGER MULTIFAMILY  
PREPARED FOR  
GREYSTAR  
SANGER, TEXAS**

	No.	DATE	REVISION	BY

# GRADING I LAIN

SIGN: ASD

AWN: DC


HECKED:	ASD
EE	7/17/2004

SHEET

SHEET


C-5.3

SE NO. 2022-185

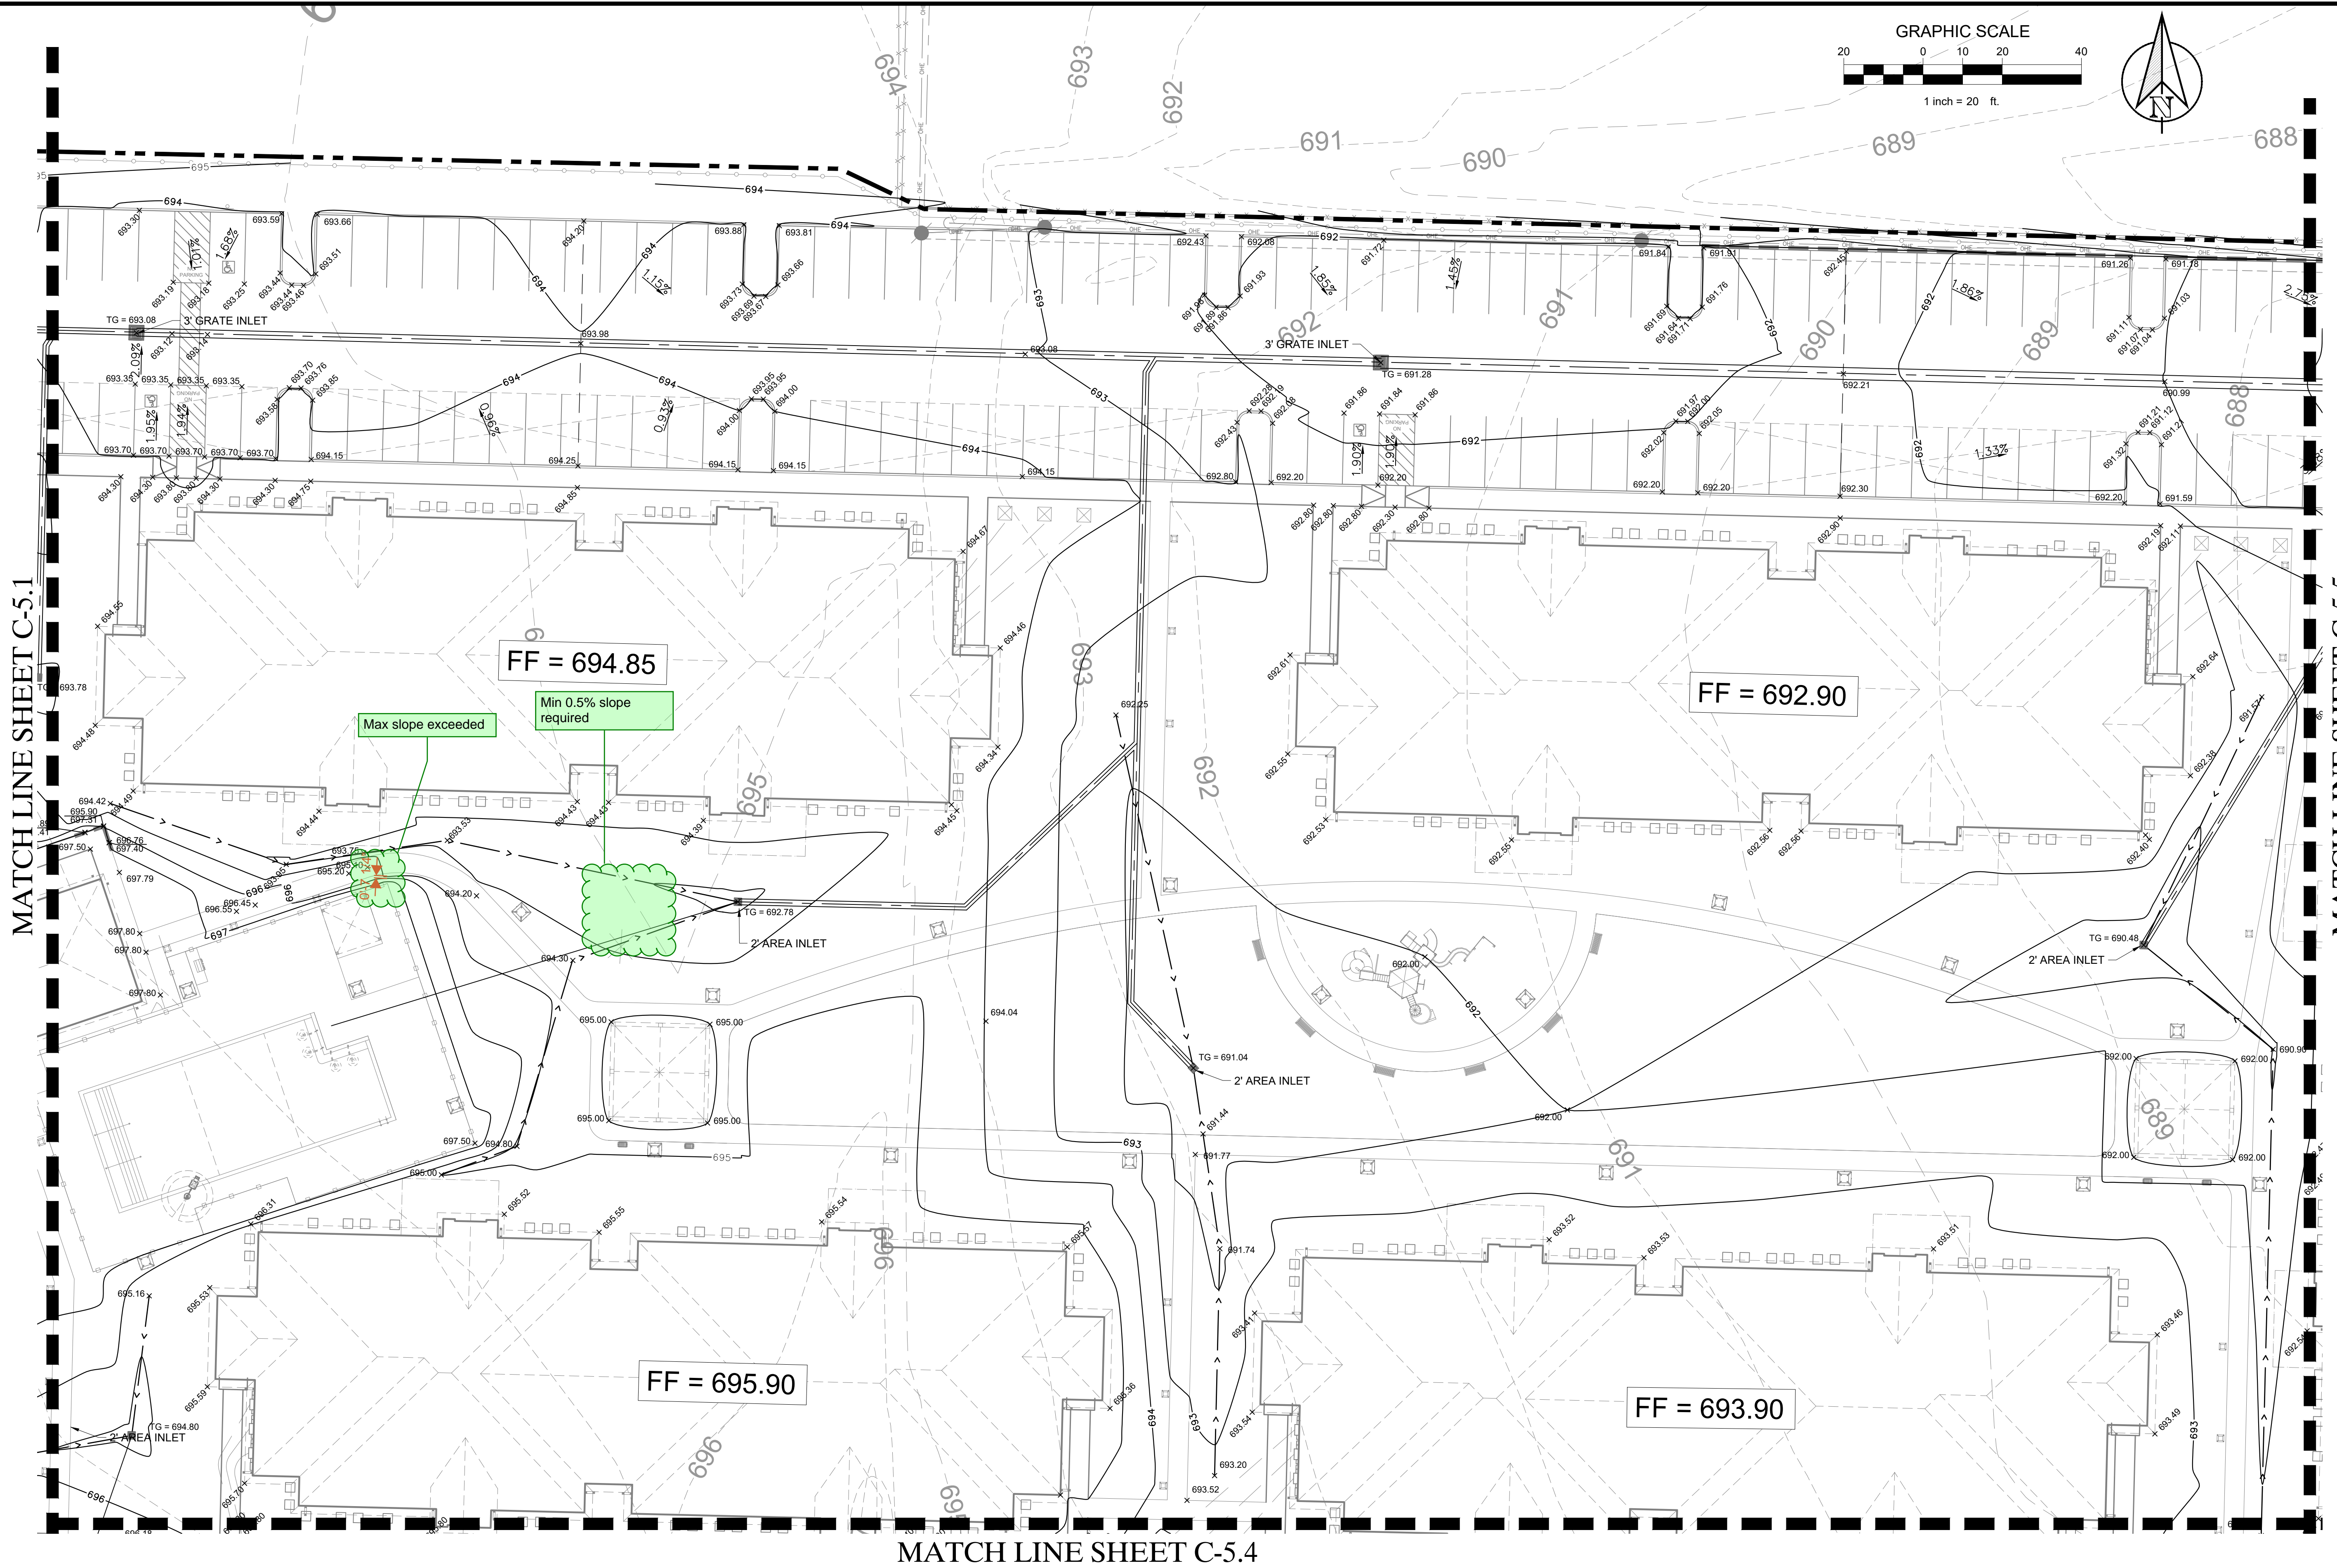

PLOTTED BY: DAN CABALLERO  
 PLOT DATE: 7/17/2024 10:07 AM  
 LOCATION: Z:\PROJECTS\PROJECTS\2022-185 MALOUF SANGER\CADD\SHEETS\MULTI-FAMILY GREYSTAR\C-3.3 GRADING PLAN.DWG  
 LAST SAVED: 7/15/2024 9:19 PM



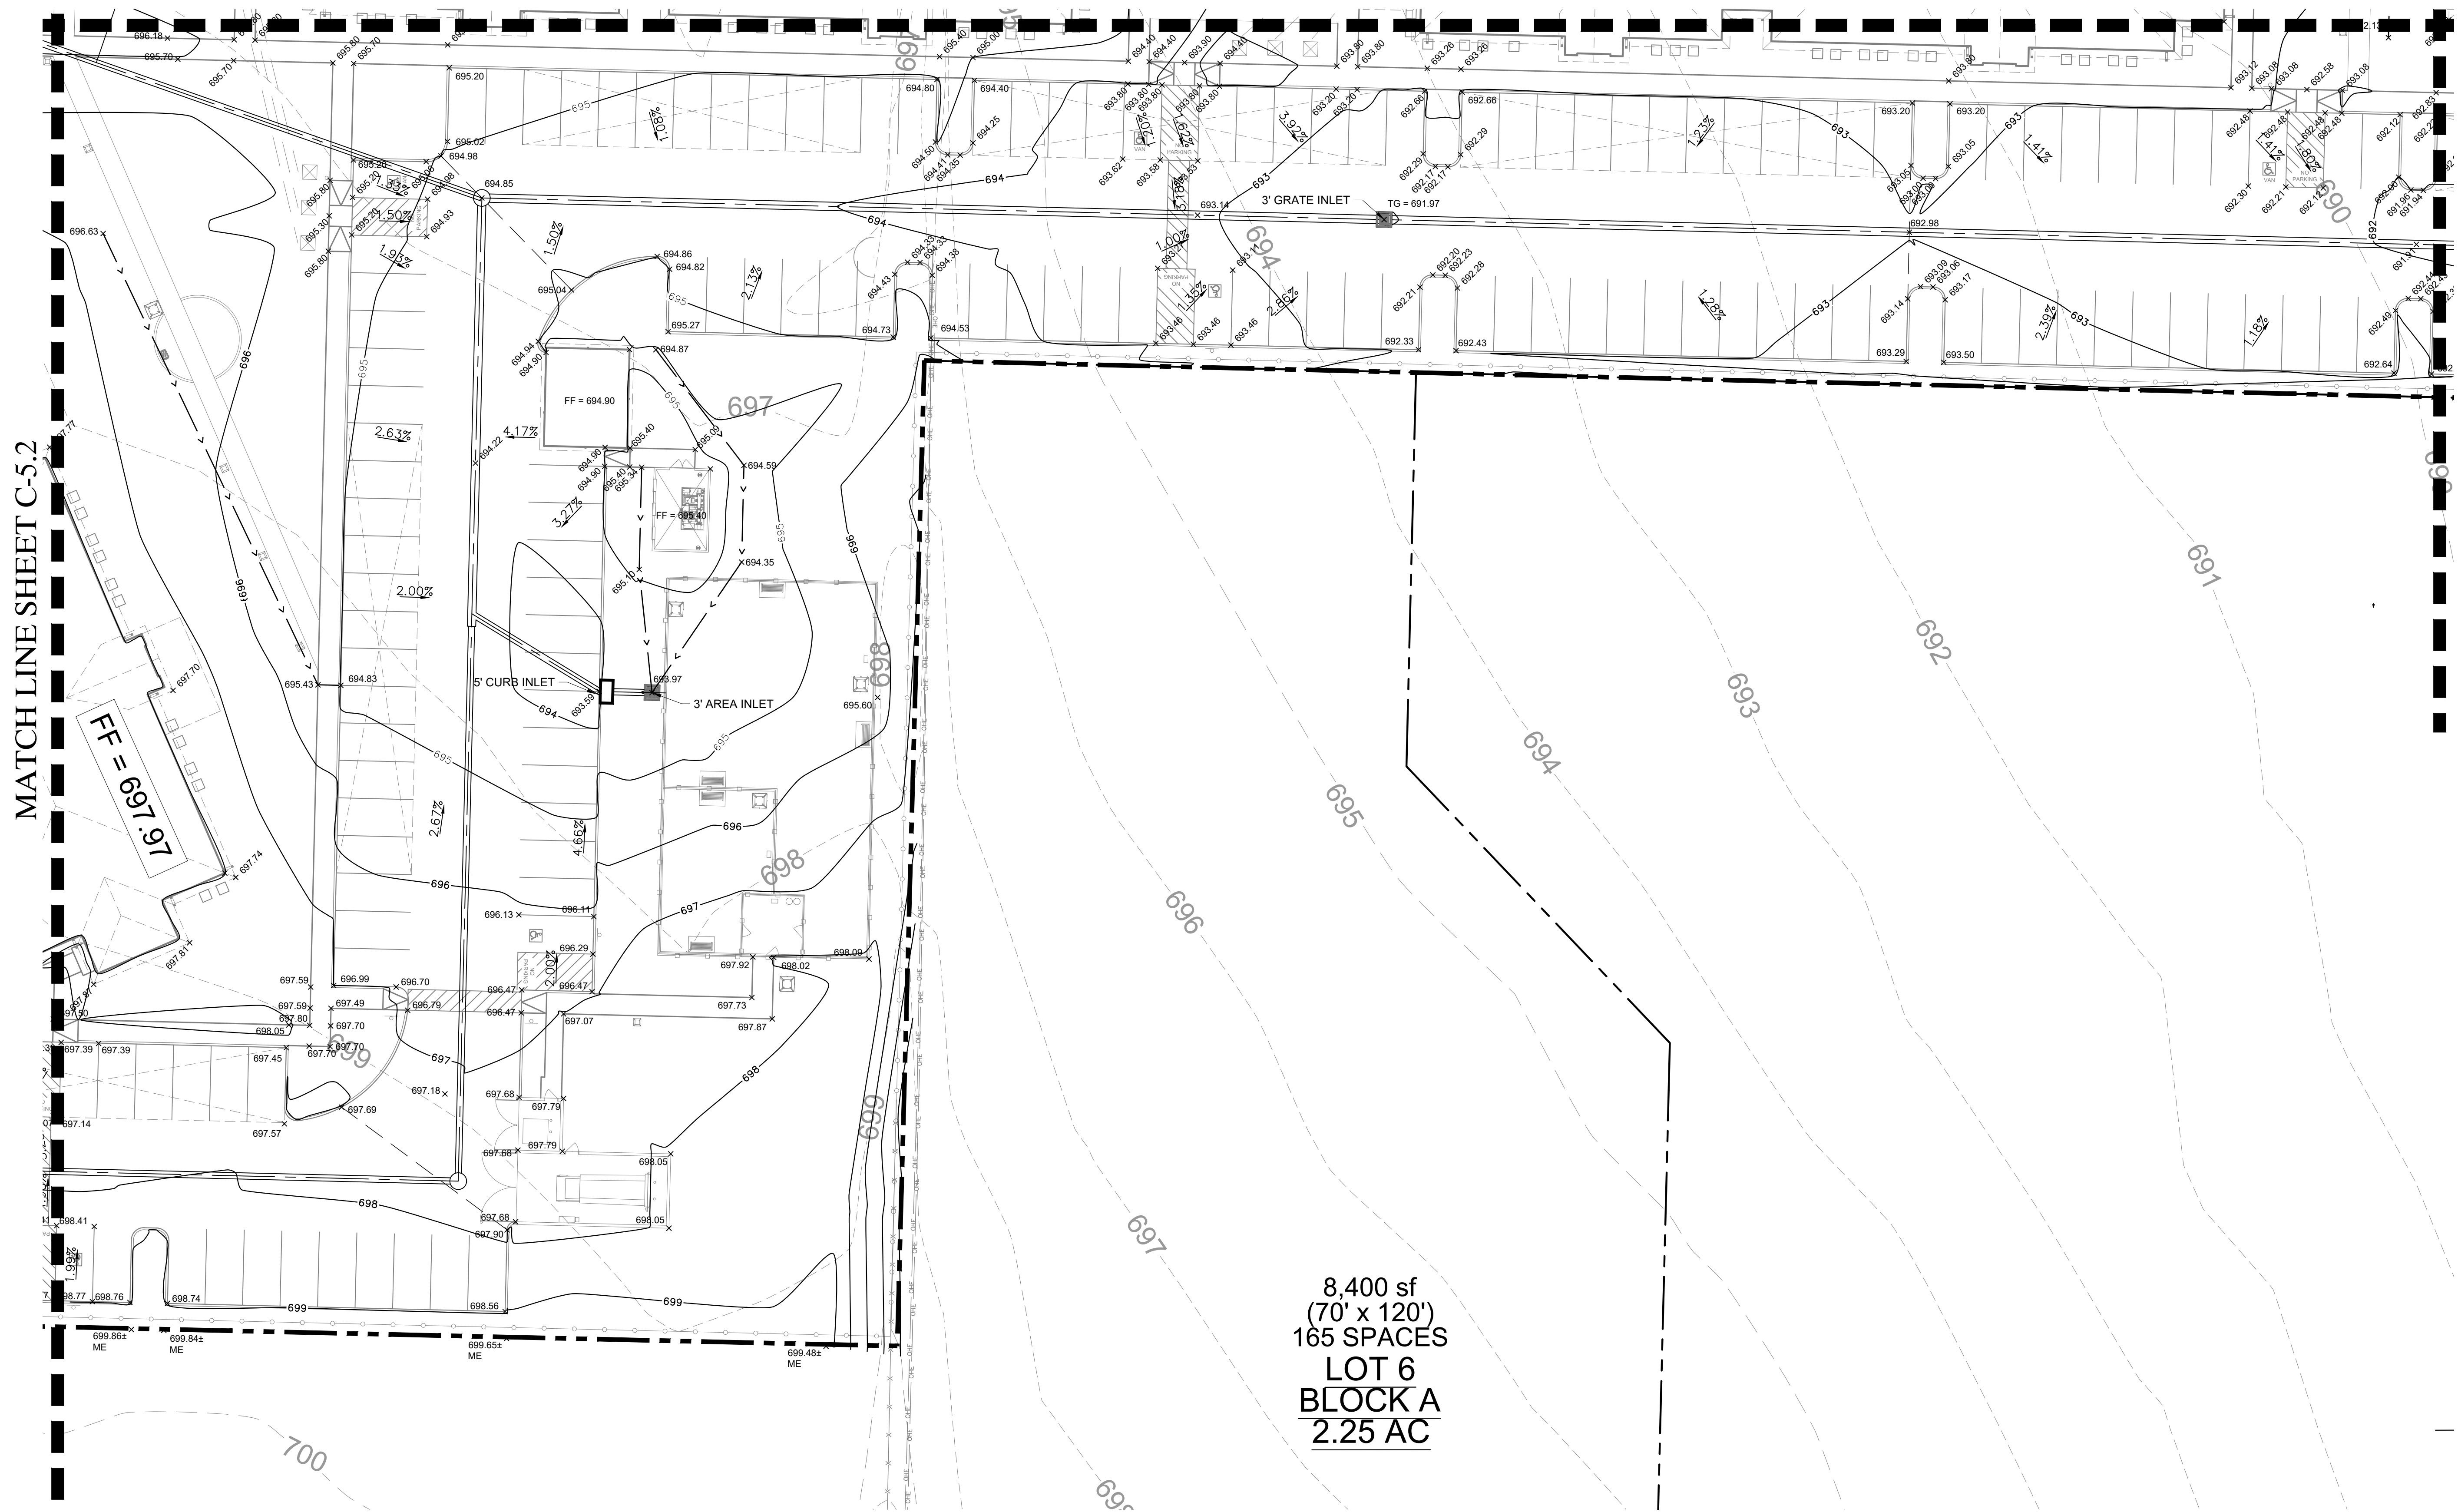

8,400 sf  
(70' x 120')  
165 SPACES  
LOT 6  
BLOCK A  
2.25 AC

MATCH LINE SHEET C-5.2

MATCH LINE SHEET C-5.6

PLOTTED BY: DAN CABALLERO  
 PLOT DATE: 7/17/2024 10:07 AM  
 LOCATION: Z:\PROJECTS\PROJECTS\2022-185 MALOUF SANGER\CADD\SHEETS\MULTI-FAMILY GREYSTAR\C-3.3 GRADING PLAN.DWG  
 LAST SAVED: 7/15/2024 9:19 PM







The logo for Clay Moore Engineering features the company name in a bold, sans-serif font. "CLAY" is in a smaller size above "MOORE", which is larger. To the right of "MOORE" is the word "ENGINEERING" in a tall, narrow, condensed font. The entire logo is set against a white background.

**CLAY MOORE**  
**ENGINEERING**


PHONE 817.281.0572  
WWW.CLAYMOOREENG.COM

FOR REVIEW ONLY  
Not for construction purposes.  
**CLAYMOORE ENGINEERING**  
ENGINEERING AND PLANNING CONSULTANTS

F.E. No. \_\_\_\_\_ Date 7/7

**SANGER MULTI-FAMILY  
PREPARED FOR  
GREYSTAR  
SANGER, TEXAS**


No.	DATE	REVISION	BY

## GRADING PLAN


DESIGN:	ASD
DRAWN:	DC
CHECKED:	ASD
DATE:	7/17/2024

SHEET  
C-5.6

CASE NO.	2022-185
----------	----------

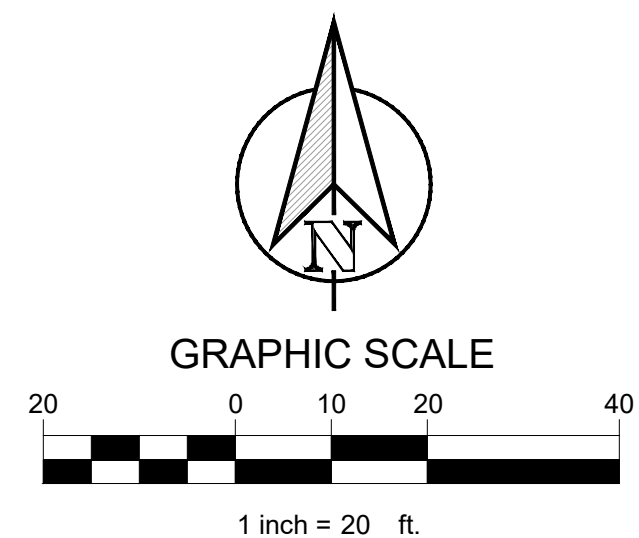

## MATCH LINE SHEET C-5.5

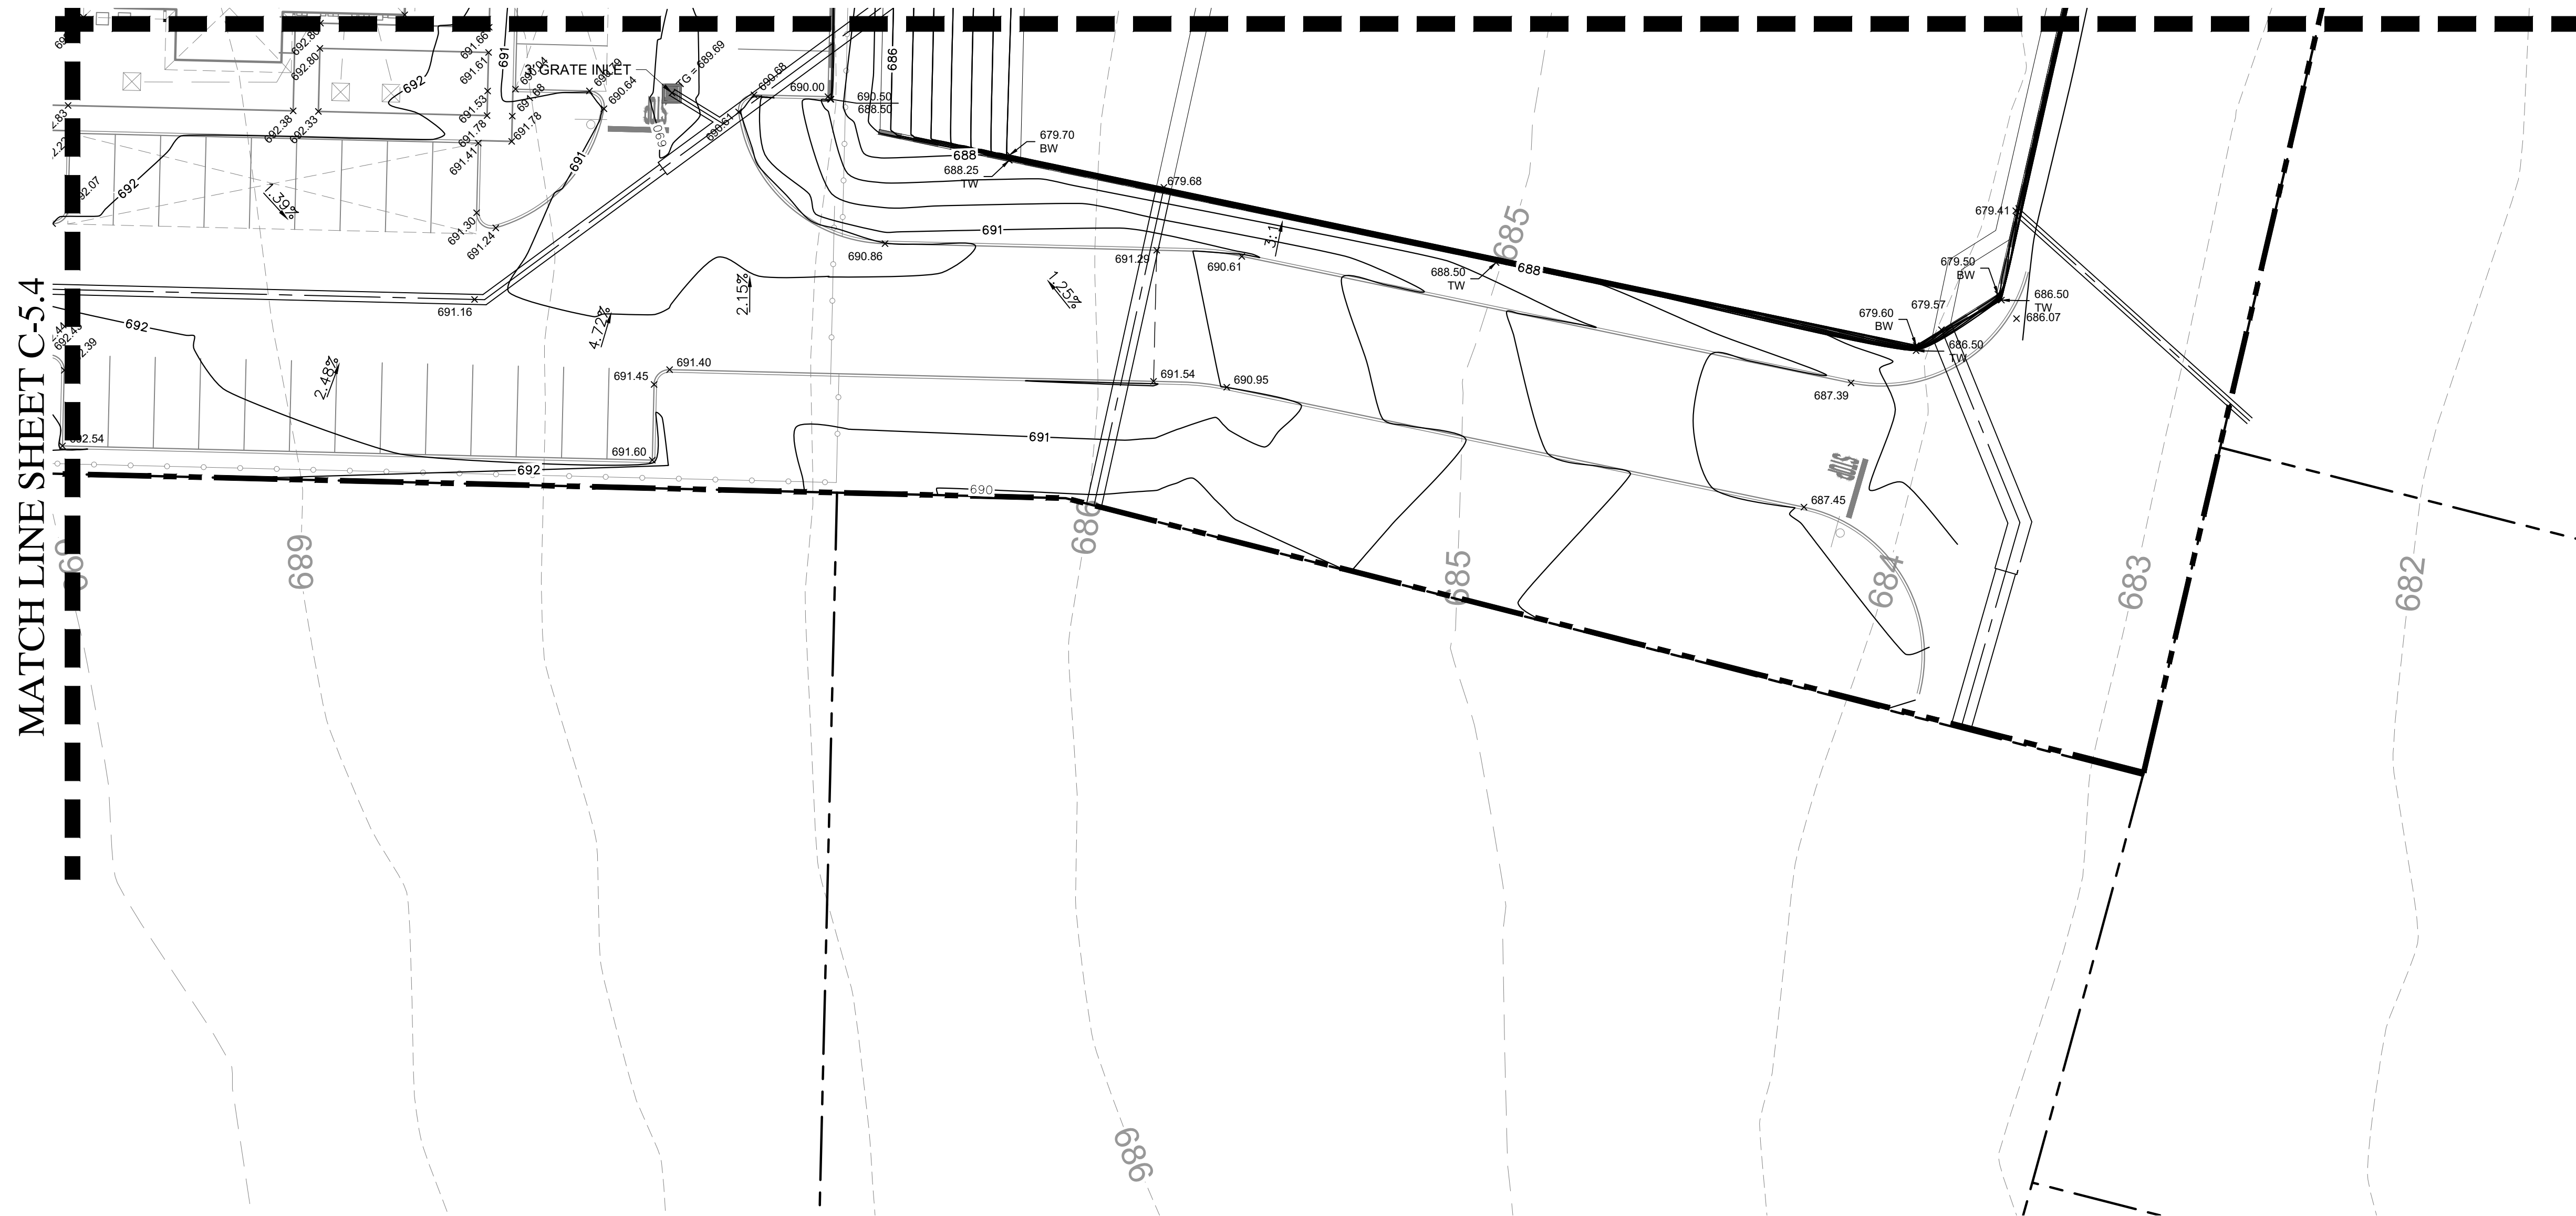


## Cut/Fill Summary

Name	Cut Factor	Fill Factor	2d Area	Cut	Fill	Net
cut fill	<b>1.000</b>	1.100	776944.02 Sq. Ft.	30713.97 Cu. Yd.	29803.40 Cu. Yd.	910.56 Cu. Yd.<Cut>
Totals			776944.02 Sq. Ft.	30713.97 Cu. Yd.	29803.40 Cu. Yd.	910.56 Cu. Yd.<Cut>

DAN CABALLERO  
PLOTTED BY: 7/17/2024 10:07 AM  
PLOT DATE:  
LOCATION: Z:\PROJECTS\PROJECTS\2022-185 MALOUF SANGER\CADD\SHEETS\MULTI-FAMILY GREYSTAR\C-3.3 GRADING PLAN.DWG  
LAST SAVED: 7/15/2024 9:19 PM



PLOTTED BY: DAN CABALLERO  
 PLOT DATE: 7/17/2024 10:08 AM  
 LOCATION: Z:\PROJECTS\PROJECTS\2022-185 MALOUF SANGER\CADD\PROJECTS\MULTI-FAMILY GREYSTAR\C-6.0 EXISTING DRAINAGE AREAS.DWG  
 LAST SAVED: 7/10/2024 5:39 PM

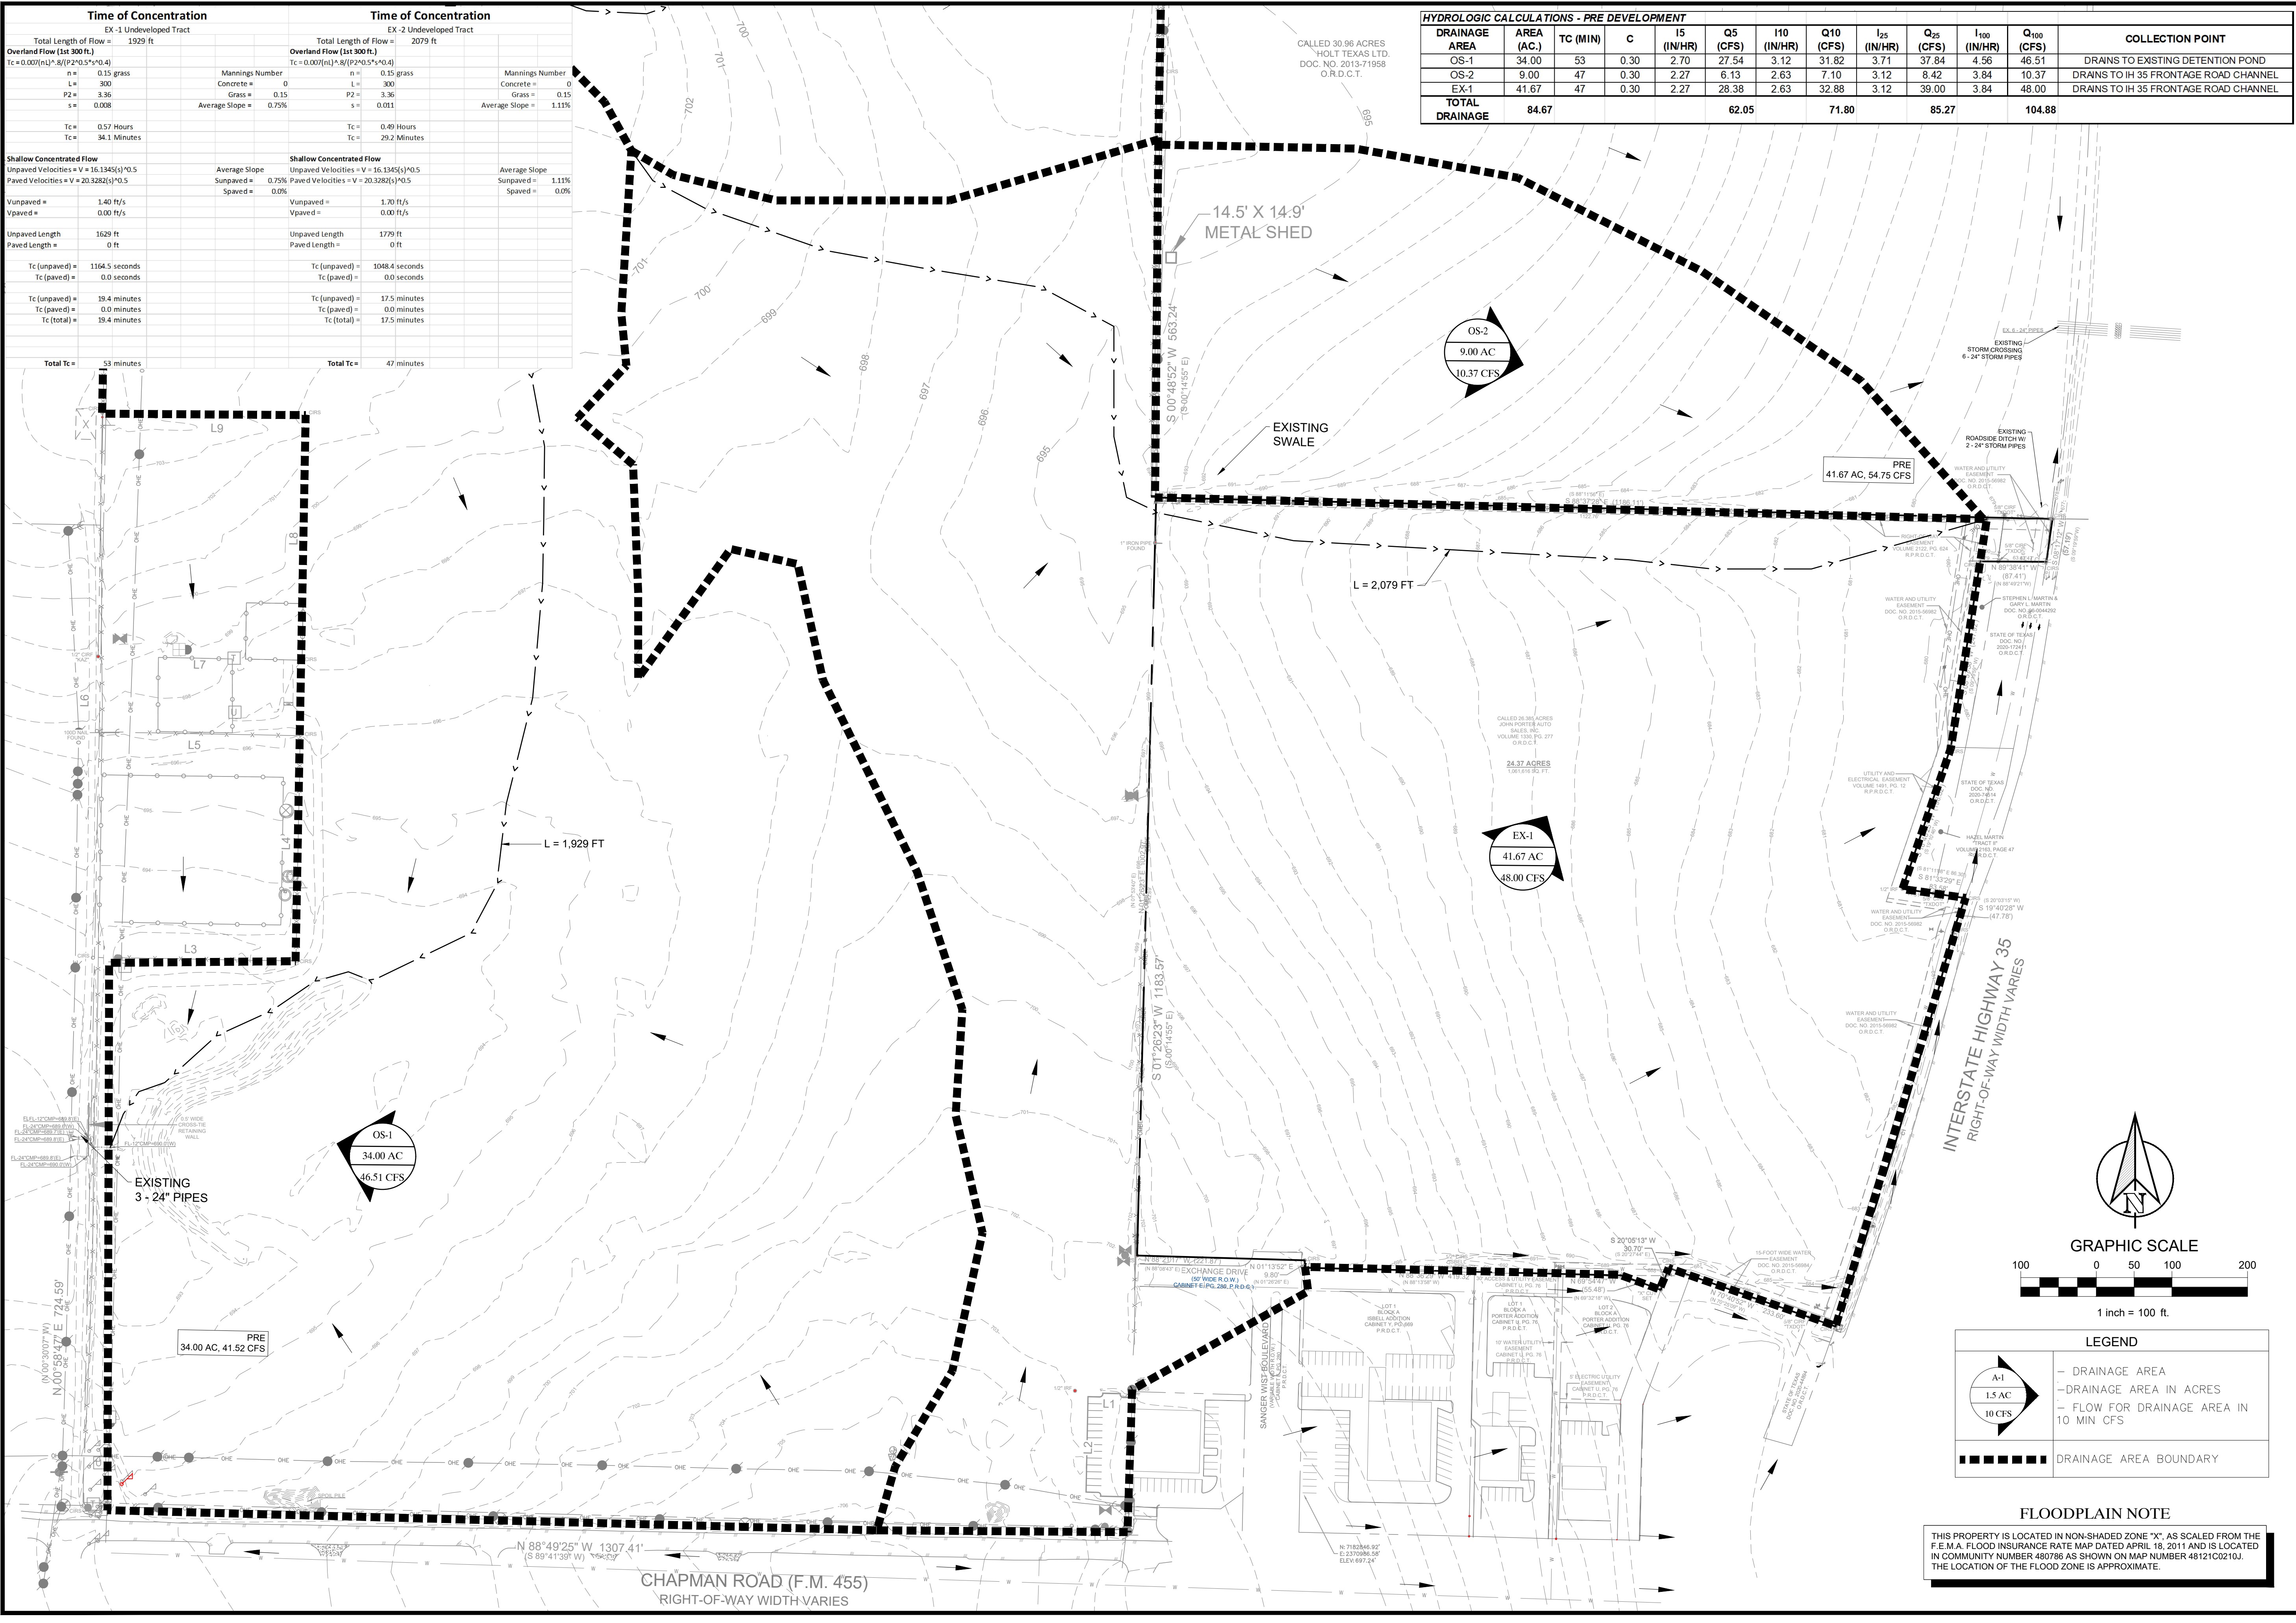

TEXAS REGISTRATION #14199  
  
 1903 CENTRAL DRIVE, SUITE #408  
 BEFORD, TX 76001  
 PHONE: 817.281.0272  
 WWW.CLAYMOOREENG.COM

**PRELIMINARY**  
 FOR REVIEW ONLY  
 Not for construction purposes.  
**CLAYMOORE ENGINEERING**  
 ENGINEERING AND PLANNING CONSULTANTS  
 Engineer: **DREW DONOSKY**  
 P.E. No.125651 Date: **7/17/2024**


**SANGER MULTI-FAMILY  
 PREPARED FOR  
 GREYSTAR  
 SANGER, TEXAS**

No.	DATE	REVISION	BY

**EXISTING DRAINAGE  
 AREAS**

DESIGN: ASD  
 DRAWN: DC  
 CHECKED: ASD  
 DATE: 7/17/2024  
 SHEET  
**C-6.0**  
 CASE NO. 2022-185



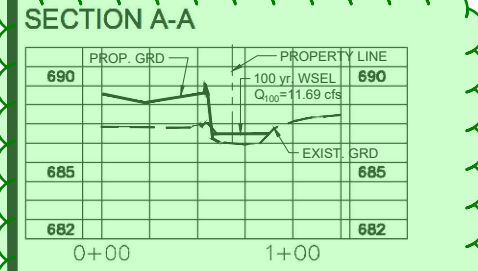

Profile and provide HGL/hydraulic data for the proposed ditch. The design must meet requirements outlined in ordinance 10.106(d)9(B)


Please provide an updated drainage study. Comments provided in April

Proposed Detention Pond Evaluation							
Elevation	Area (sf)	Ac	Elevation Difference	Incremental Volume (ft³)	Cumulative Volume (ft³)	Cumulative Volume (ac-ft)	Elevation
677.69	0	0.00					677.69
678.00	2895	0.07	0.31	449	449	0.010	678.00
679.00	48146	1.11	1.00	25521	25969	0.596	679.00
680.00	83232	1.91	1.00	83607	175266	4.024	680.00
681.00	83982	1.93	1.00	84379	259645	5.961	681.00
682.00	84776	1.95	1.00	85165	344810	7.916	682.00
683.00	85555	1.96	1.00	85946	430756	9.889	683.00
684.00	86338	1.98	1.00	86736	517492	11.880	684.00
685.00	87134	2.00	1.00	87526	605018	13.889	685.00
686.00	87919	2.02	1.00				686.00
100 YR WSE							
686.00	87919	2.02	1.00				686.00
1 FT FREEBOARD							
687.00	88704	2.04	1.00				687.00

Does not match previous sheet

Predeveloped Conditions	
Area	41.67 acres
Time (Tc)	47 minutes
C value	0.85
I-100yr	65.83 cfs
Q100yr	12.52 cfs
Bypass Flow	53.11 cfs
Release Rate	53.11 cfs
Q100yr (T)	53.11 cfs
Onsite Proposed Conditions	
Area	37.15 acres
Time (Tc)	10 minutes
Avg. C value	0.85 avg
I-100yr	11.60 in/hr
Q100yr	366.30 cfs
Required Storage Volume:	456,963 cubic-feet 10.49 acre-feet

HYDROLOGIC CALCULATIONS - POST DEVELOPMENT												COLLECTION POINT	
DRAINAGE AREA	AREA (AC.)	TC (MIN)	C	I5 (IN/HR)	Q5 (CFS)	I10 (IN/HR)	Q10 (CFS)	I25 (IN/HR)	Q25 (CFS)	I100 (IN/HR)	Q100 (CFS)		
OS-1	22.92	53	0.30	2.70	18.57	3.12	21.45	3.71	25.51	4.56	31.35	DRAINS TO EXISTING DETENTION POND	
OS-2	9.00	47	0.30	2.27	6.13	2.63	7.10	3.12	8.42	3.84	10.37	DRAINS TO IH 35 FRONTAGE ROAD CHANNEL	
OS-3	6.48	47	0.30	2.27	4.41	2.63	5.11	3.12	6.07	3.84	7.46	DRAINS TO IH 35 FRONTAGE ROAD CHANNEL	
1	0.57	10	0.70	6.70	2.67	7.90	3.15	9.20	3.67	11.60	4.63	DRAINS TO PHASE 1 COMMERCIAL PROPERTY	
2	0.15	10	0.70	6.70	0.70	7.90	0.83	9.20	0.97	11.60	1.22	DRAINS TO IH 35 FRONTAGE ROAD CHANNEL	
3	2.16	10	0.70	6.70	10.13	7.90	11.94	9.20	13.91	11.60	17.54	DRAINS TO DETENTION POND OUTLET	
A-1	0.39	10	0.70	6.70	1.83	7.90	2.16	9.20	2.51	11.60	3.17	DRAINS TO PROPOSED CURB INLET	
A-2	0.55	10	0.70	6.70	2.58	7.90	3.04	9.20	3.54	11.60	4.47	DRAINS TO PROPOSED LANDSCAPE INLET	
A-3	0.76	10	0.70	6.70	3.56	7.90	4.20	9.20	4.89	11.60	6.17	DRAINS TO PROPOSED LANDSCAPE INLET	
A-4	0.78	10	0.70	6.70	3.66	7.90	4.31	9.20	5.02	11.60	6.33	DRAINS TO PROPOSED GRATE INLET	
A-5	1.09	10	0.70	6.70	5.11	7.90	6.03	9.20	7.02	11.60	8.85	DRAINS TO PROPOSED LANDSCAPE INLET	
A-6	0.70	10	0.70	6.70	3.28	7.90	3.87	9.20	4.51	11.60	5.68	DRAINS TO PROPOSED LANDSCAPE INLET	
A-7	0.75	10	0.70	6.70	3.52	7.90	4.15	9.20	4.83	11.60	6.09	DRAINS TO PROPOSED GRATE INLET	
A-8	0.67	10	0.70	6.70	3.14	7.90	3.71	9.20	4.31	11.60	5.44	DRAINS TO PROPOSED LANDSCAPE INLET	
A-9	0.87	10	0.70	6.70	4.08	7.90	4.81	9.20	5.60	11.60	7.06	DRAINS TO PROPOSED GRATE INLET	
B-1	0.96	10	0.70	6.70	4.50	7.90	5.31	9.20	6.18	11.60	7.80	DRAINS TO PROPOSED LANDSCAPE INLET	
B-2	0.90	10	0.70	6.70	4.22	7.90	4.98	9.20	5.80	11.60	7.31	DRAINS TO PROPOSED GRATE INLET	
B-3	0.39	10	0.70	6.70	1.83	7.90	2.16	9.20	2.51	11.60	3.17	DRAINS TO PROPOSED LANDSCAPE INLET	
B-4	1.03	10	0.70	6.70	4.83	7.90	5.70	9.20	6.63	11.60	8.36	DRAINS TO PROPOSED CURB INLET	
B-5	1.12	10	0.70	6.70	5.25	7.90	6.19	9.20	7.21	11.60	9.09	DRAINS TO PROPOSED CURB INLET	
B-6	0.92	10	0.70	6.70	4.31	7.90	5.09	9.20	5.92	11.60	7.47	DRAINS TO PROPOSED CURB INLET	
B-7	0.30	10	0.70	6.70	1.41	7.90	1.66	9.20	1.93	11.60	2.44	DRAINS TO PROPOSED AREA INLET	
B-8	1.00	10	0.70	6.70	4.69	7.90	5.53	9.20	6.44	11.60	8.12	DRAINS TO PROPOSED CURB INLET	
B-9	0.02	10	0.70	6.70	0.09	7.90	0.11	9.20	0.13	11.60	0.16	DRAINS TO PHASE 1 COMMERCIAL PROPERTY	
C-1	0.45	10	0.70	6.70	2.11	7.90	2.49	9.20	2.90	11.60	3.65	DRAINS TO PROPOSED 10" CURB INLET	
D-1	0.44	10	0.70	6.70	2.06	7.90	2.43	9.20	2.83	11.60	3.57	DRAINS TO PROPOSED 10" CURB INLET	
TOTAL DRAINAGE		55.37			108.70	127.51		149.29		186.98			

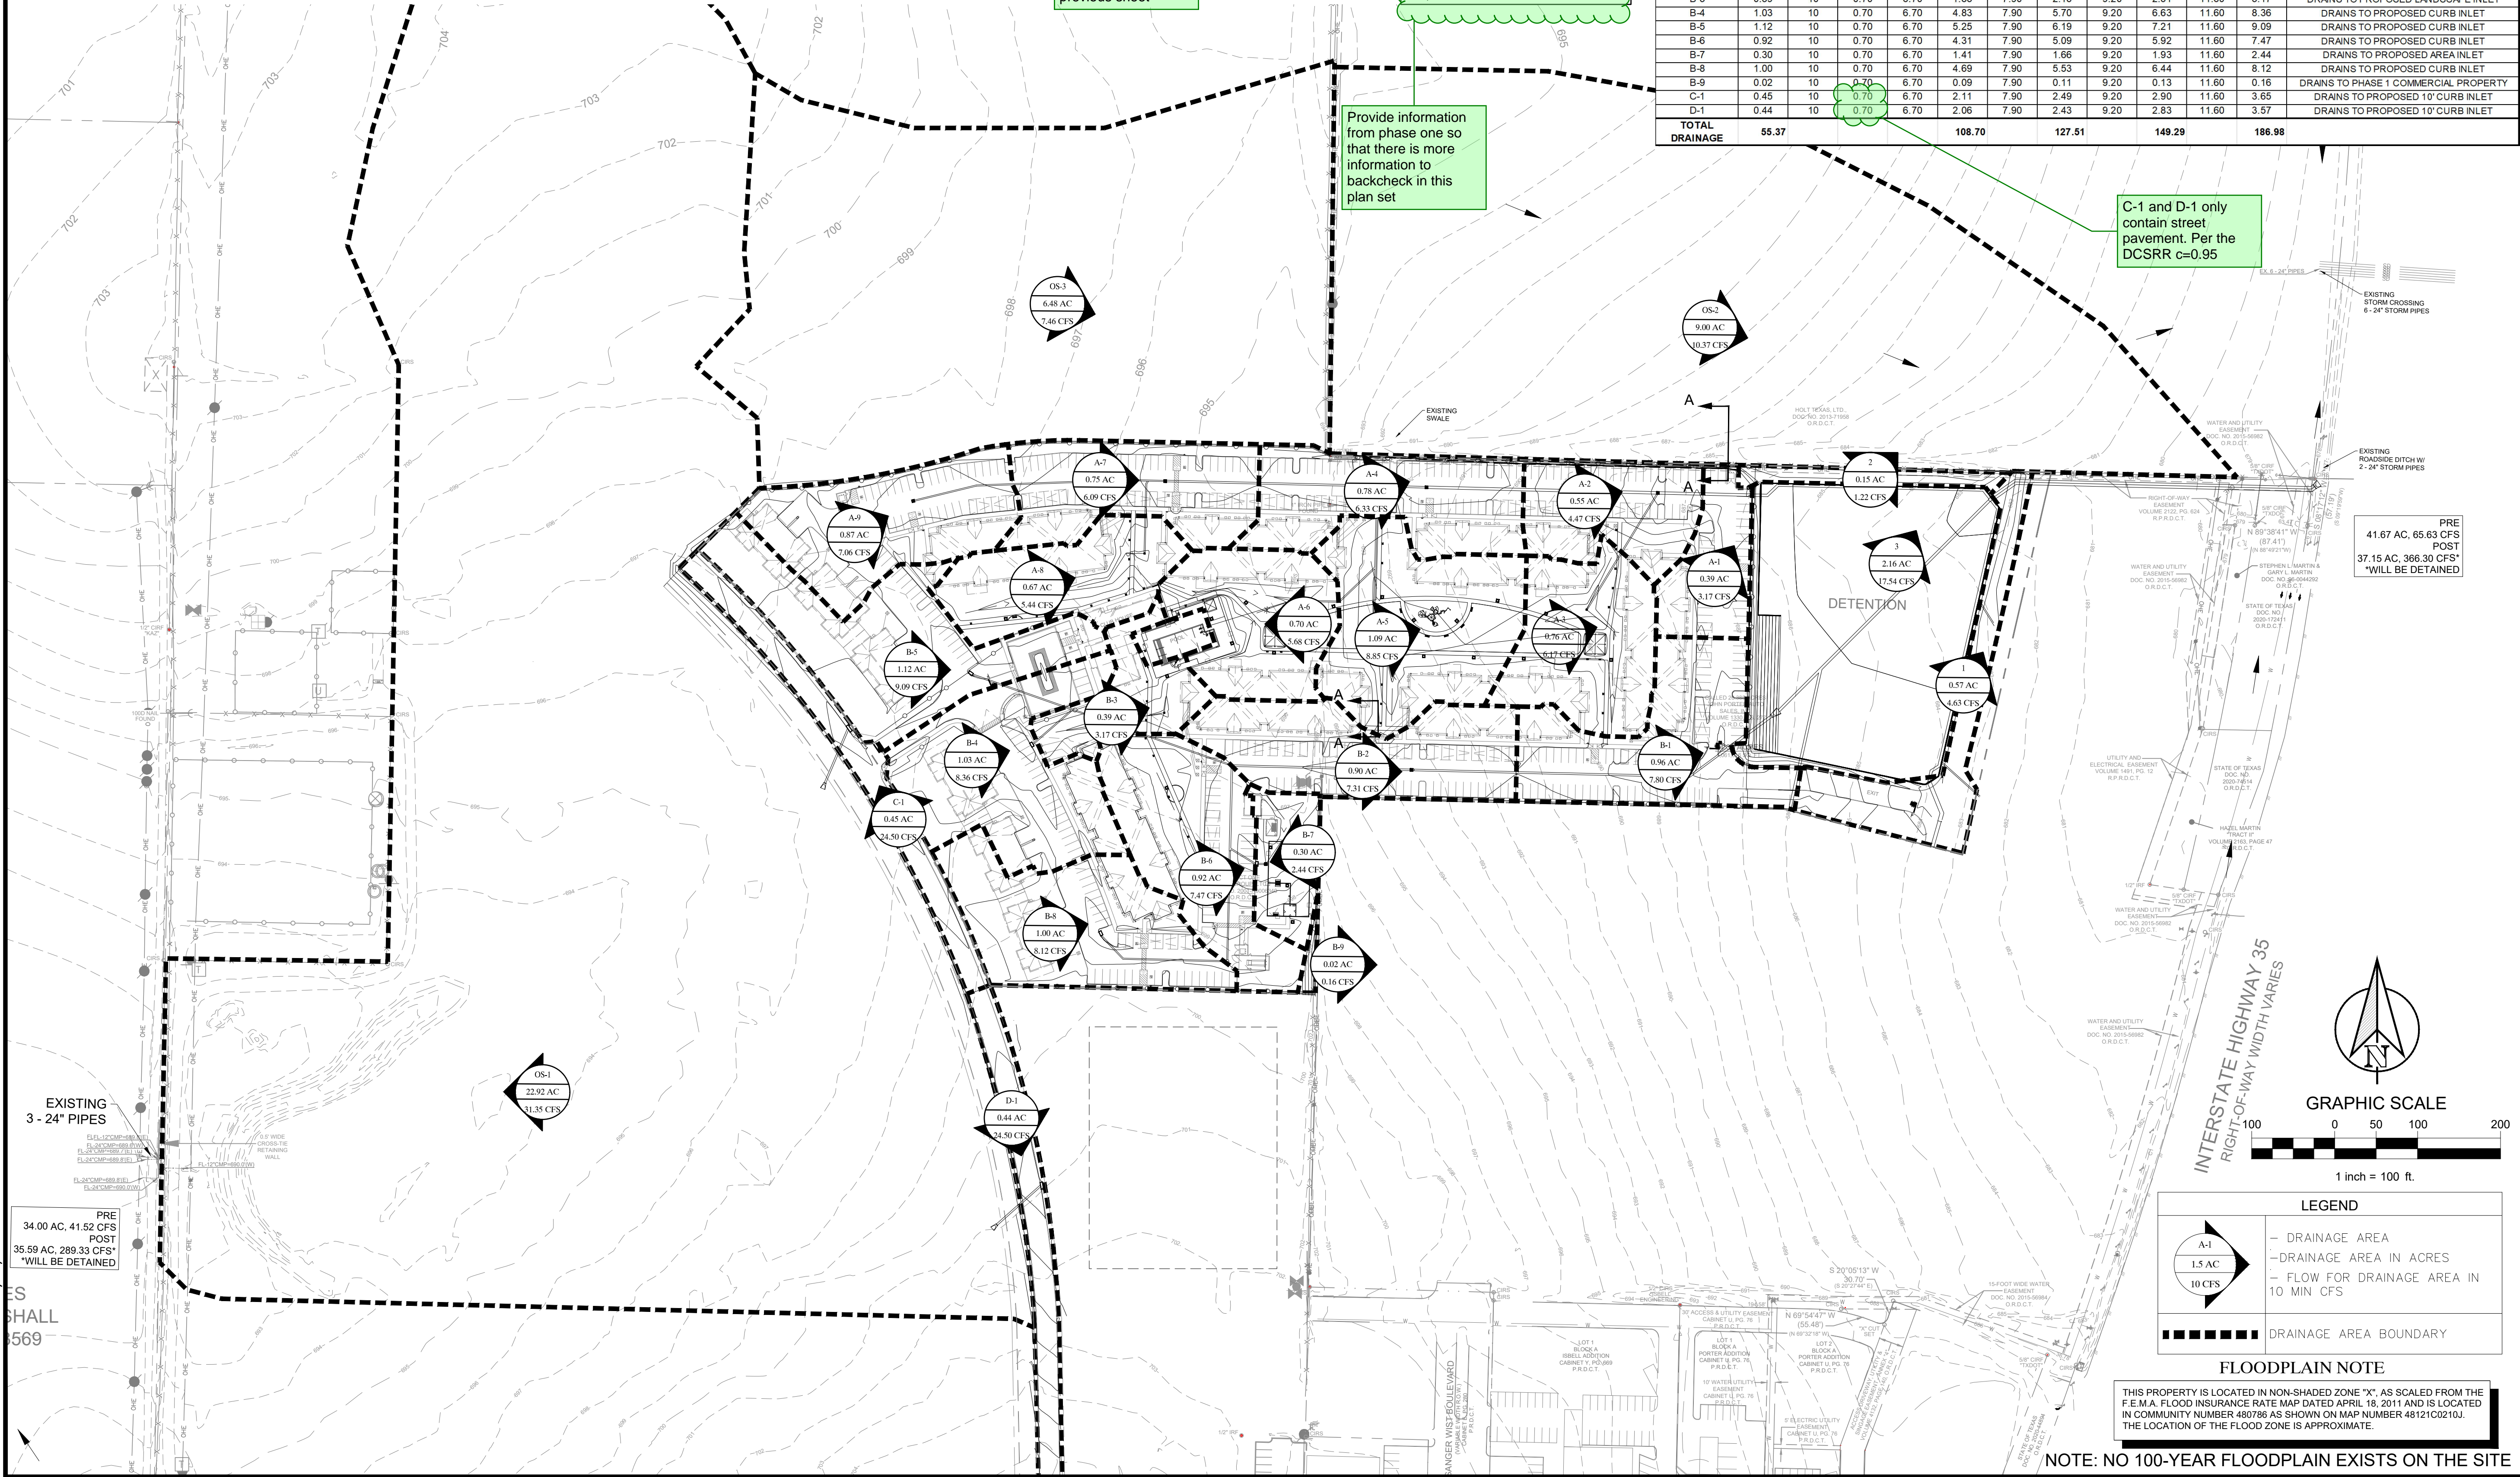

CLAY MOORE ENGINEERING

1903 CENTRAL DRIVE SUITE #408  
SEDFORD, TX 76081  
PHONE: 817.281.0272  
WWW.CLAYMOOREENGINEERING.COM

PRELIMINARY

FOR REVIEW ONLY  
Not for construction purposes.  
CLAYMOORE ENGINEERING  
ENGINEERING AND PLANNING CONSULTANTS  
Engineer: DREW DONOSKY  
P.E. No. 125651 Date: 7/17/2024

SANGER MULTI-FAMILY  
PREPARED FOR  
GREYSTAR  
SANGER, TEXAS

No.	DATE	REVISION	BY

PROPOSED DRAINAGE AREAS


DESIGN: ASD  
DRAWN: DC  
CHECKED: ASD  
DATE: 7/17/2024

SHEET  
C-6.1

CASE NO. 2022-185



<h1>STORM DRAINAGE PLAN</h1>	
DESIGN:	ASD
DRAWN:	DC
CHECKED:	ASD
DATE:	7/17/2024
<p>SHEET</p> <h2>C-6.2</h2>	
CASE NO.	2022-185

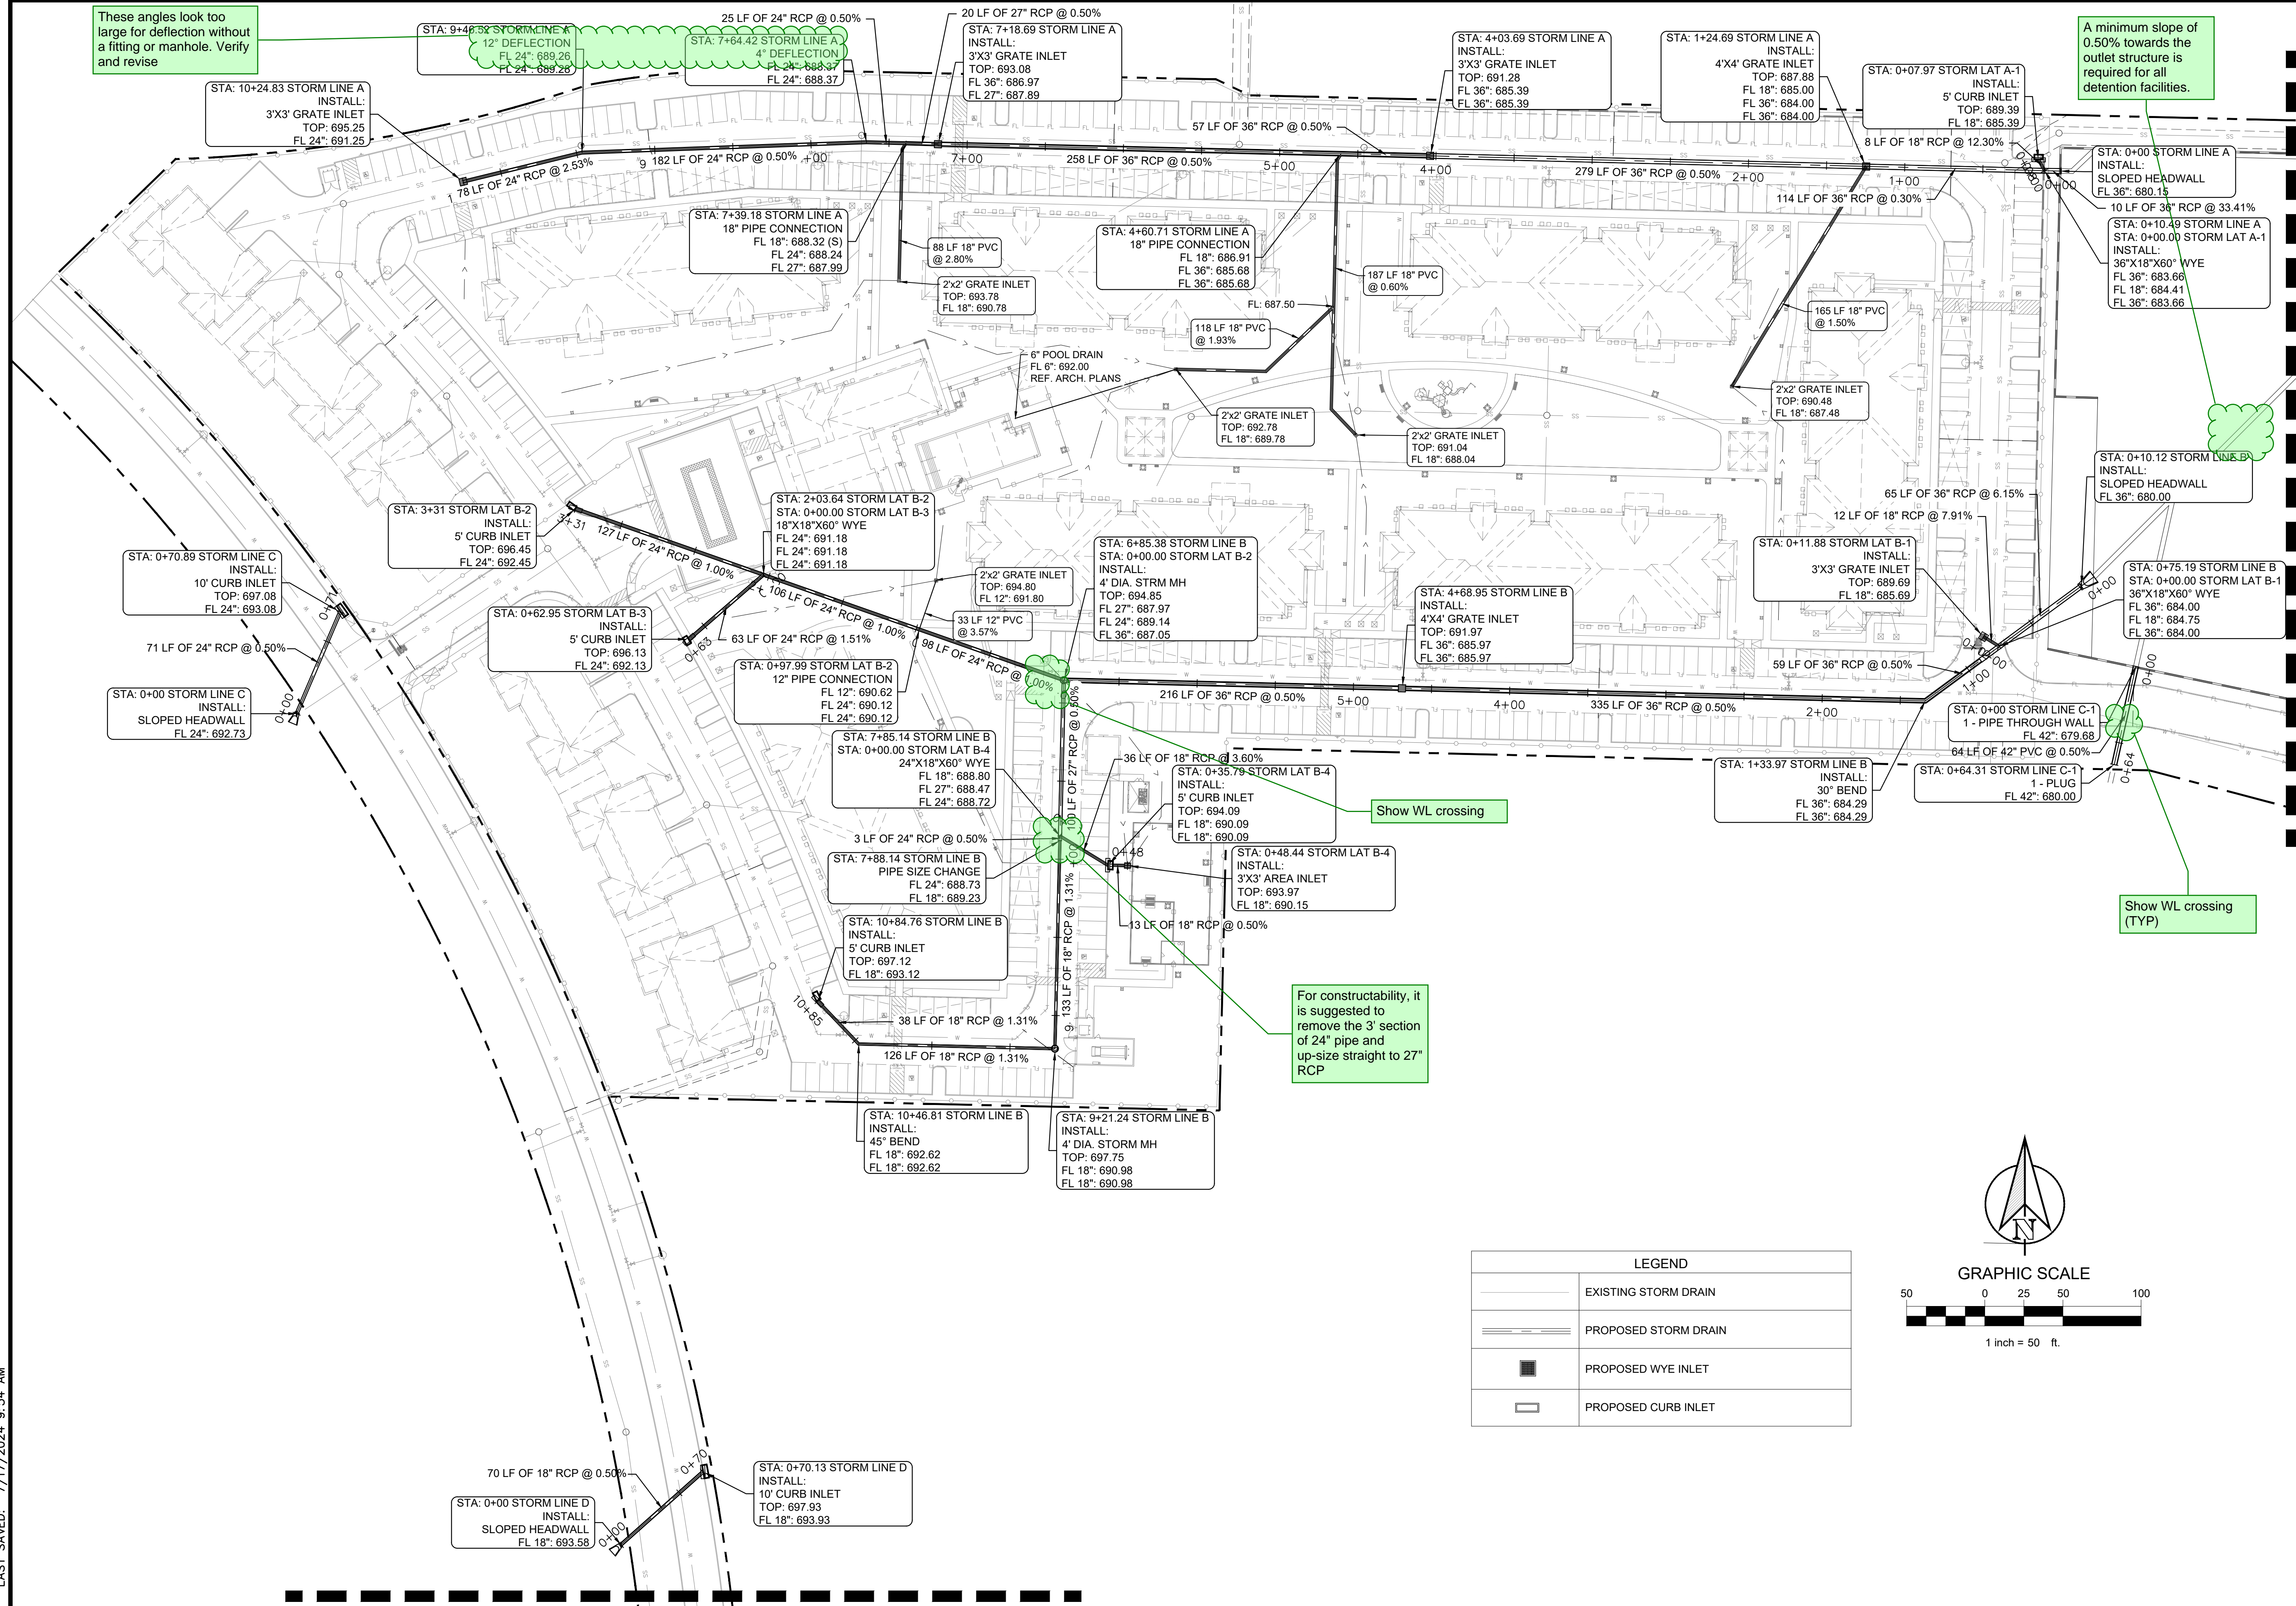


PLOTTED BY: DAN CABALLERO  
PLOT DATE: 7/17/2024 10:10 AM  
LOCATION: Z:\PROJECTS\PROJECTS\2022-185 MALOUF SANGER\CADD\SHEETS\MULTI-FAMILY GREYSTAR\C-6.4 STORM DRAINAGE PROFILES.DWG  
LAST SAVED: 7/17/2024 9:54 AM


# MATCHLINE SHEET C-6.3




PLOTTED BY: DAN CABALLERO  
 PLOT DATE: 7/17/2024 10:10 AM  
 LOCATION: Z:\PROJECTS\PROJECTS\2022-185 MALOUF SANGER\CADD\SHEETS\MULTI-FAMILY GREYSTAR\C-6.4 STORM DRAINAGE PROFILES.DWG  
 LAST SAVED: 7/17/2024 9:54 AM

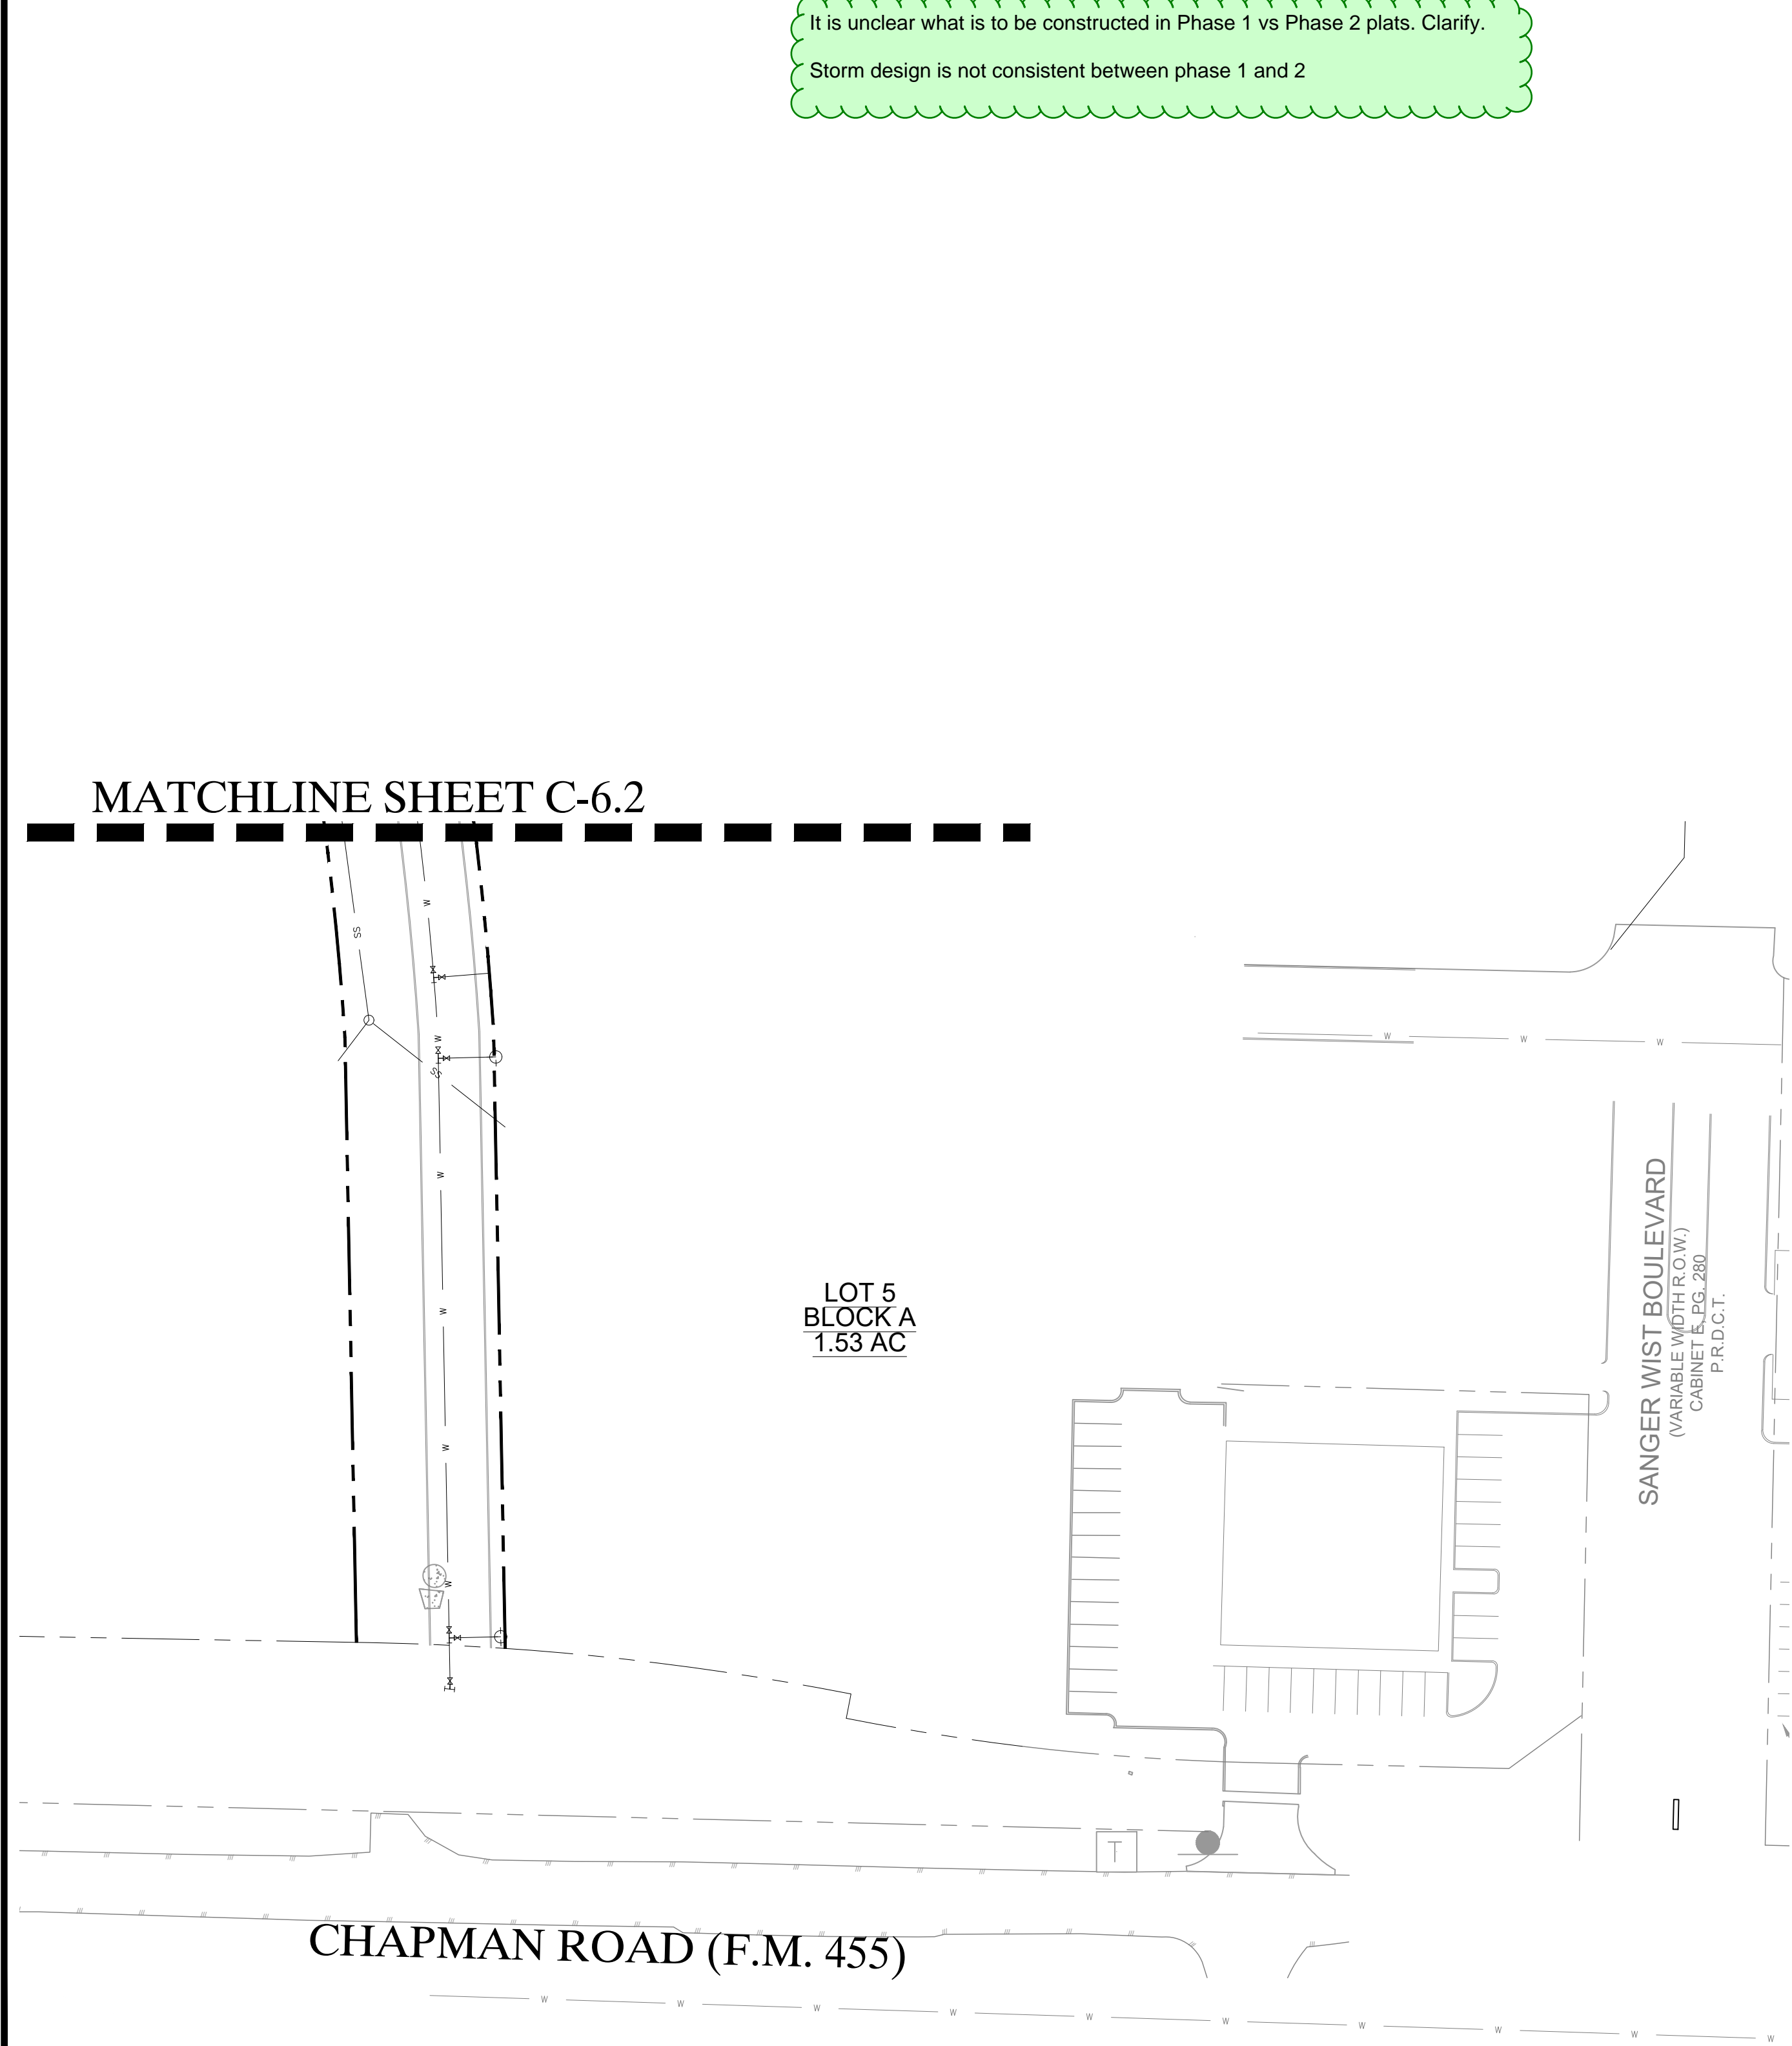

MATCHLINE SHEET C-6.2

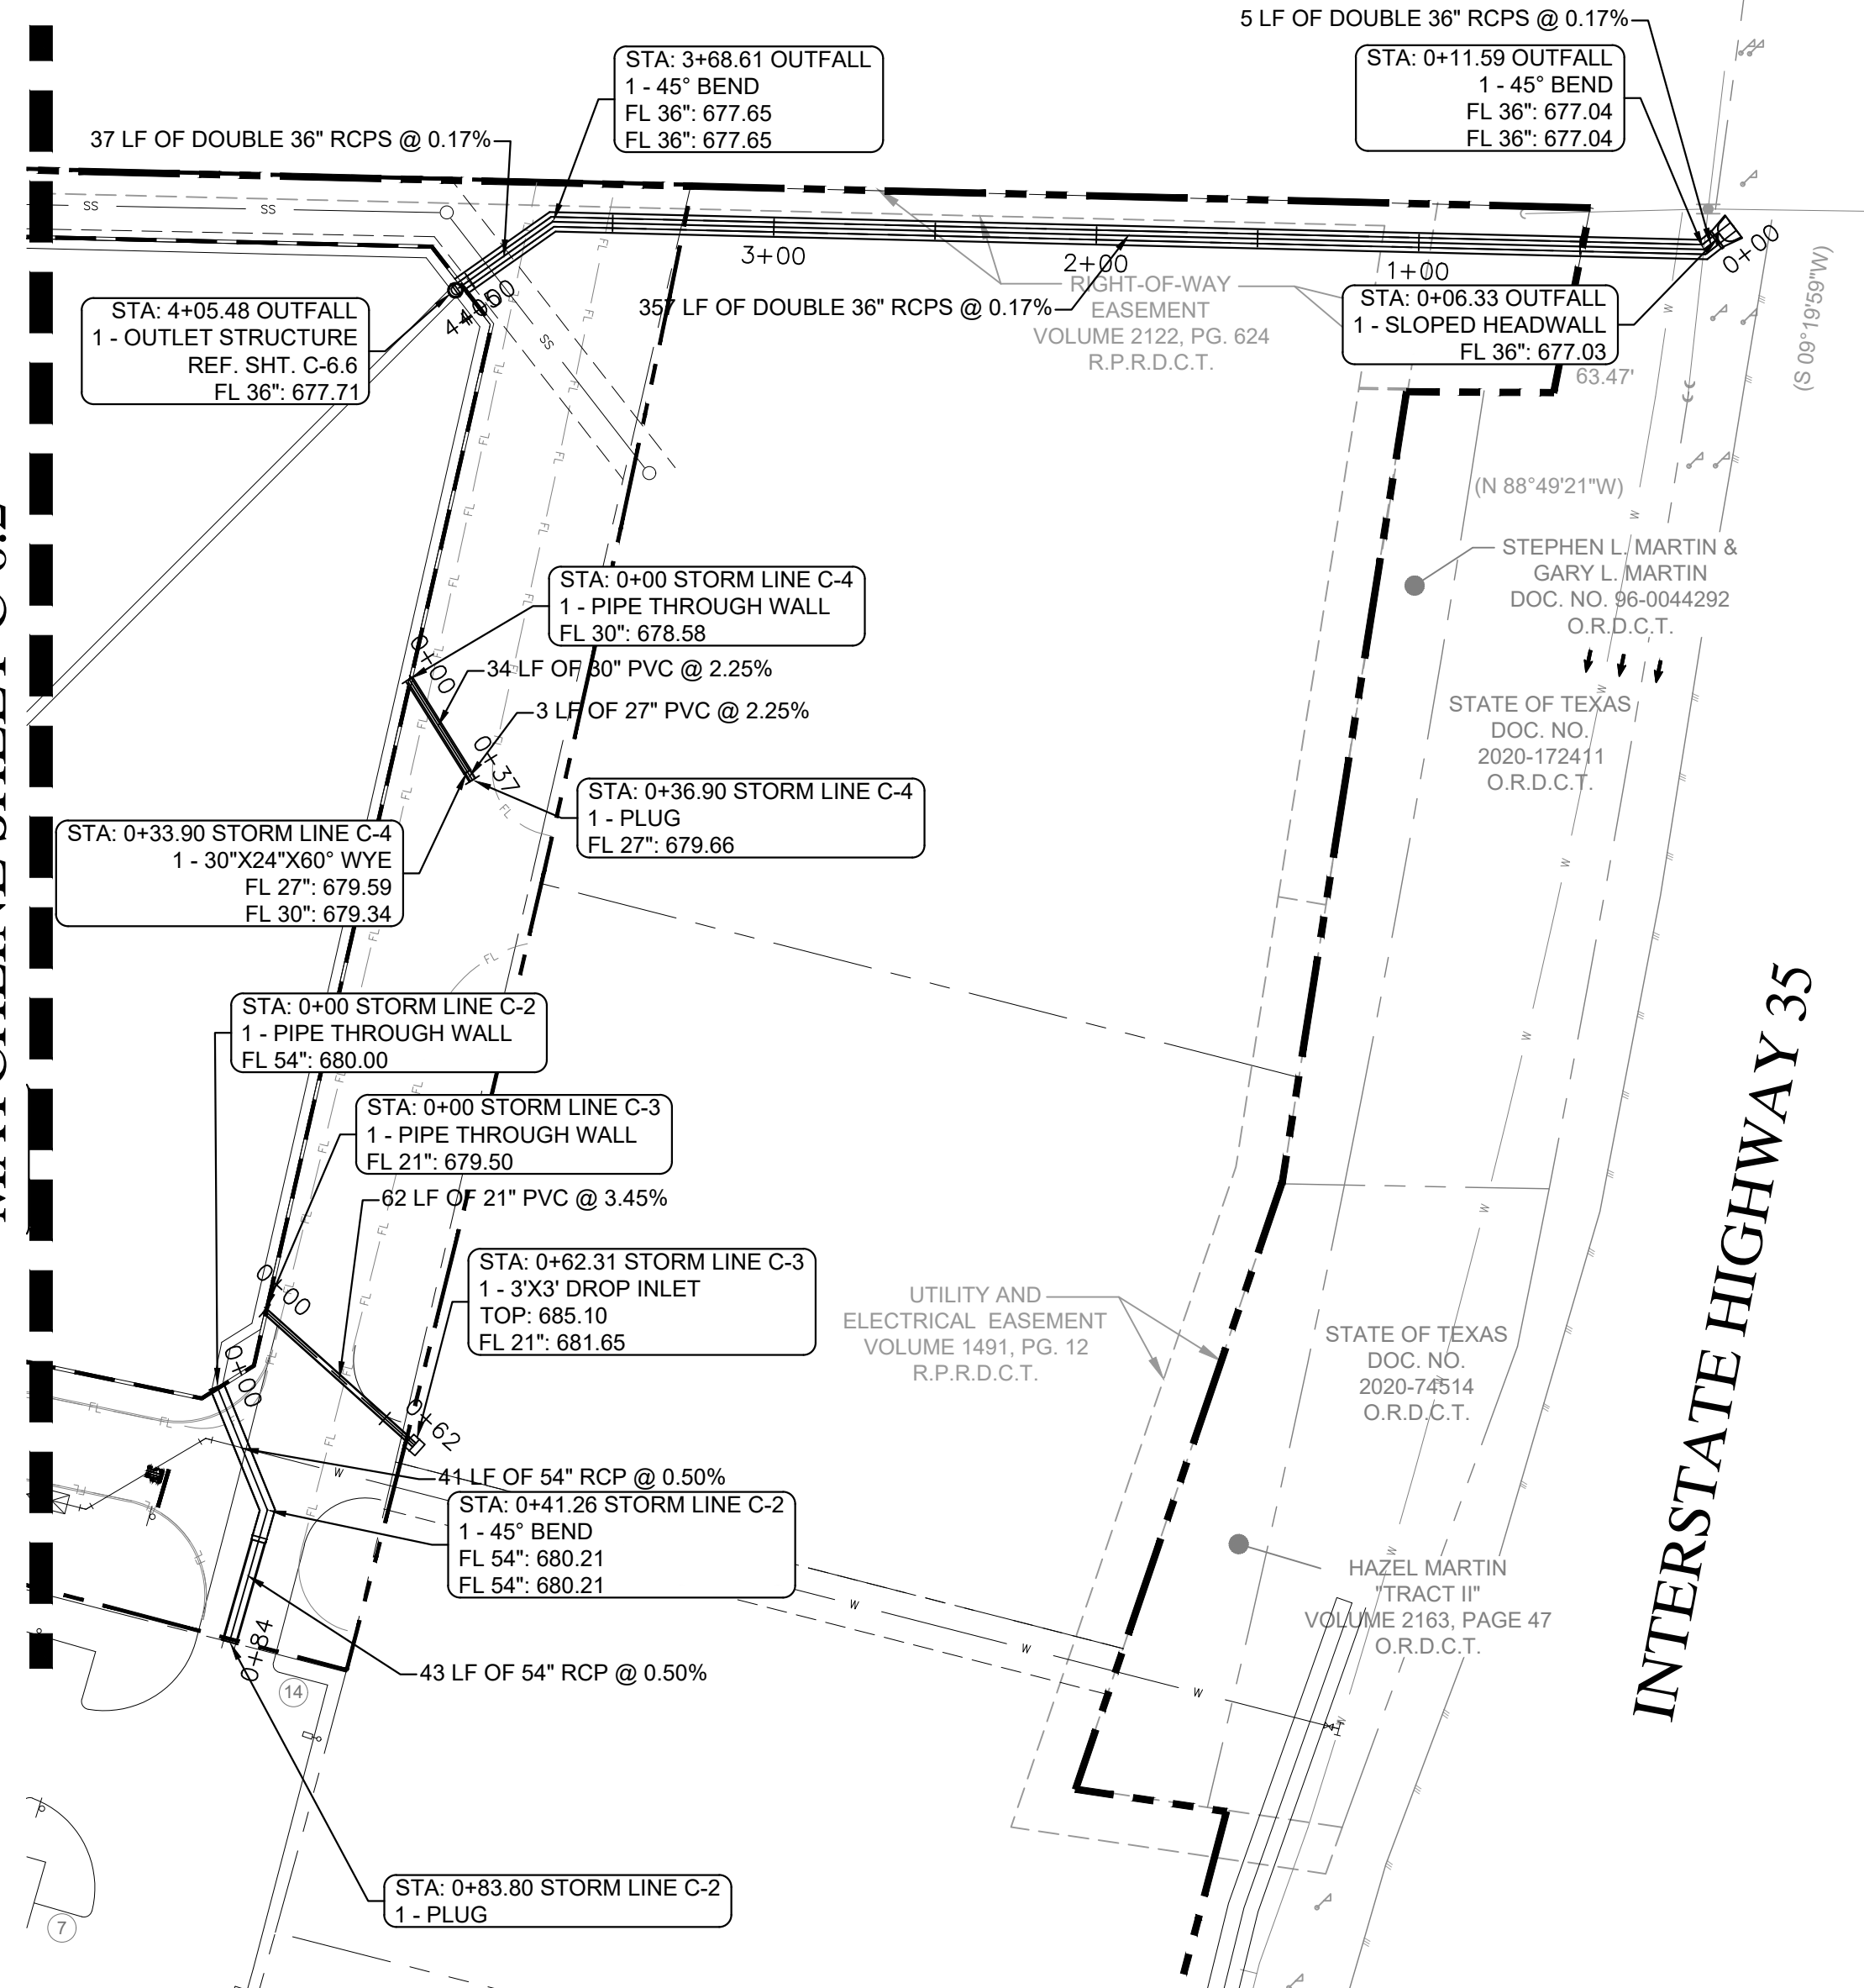

LEGEND	
	EXISTING STORM DRAIN
	PROPOSED STORM DRAIN
	PROPOSED WYE INLET
	PROPOSED CURB INLET

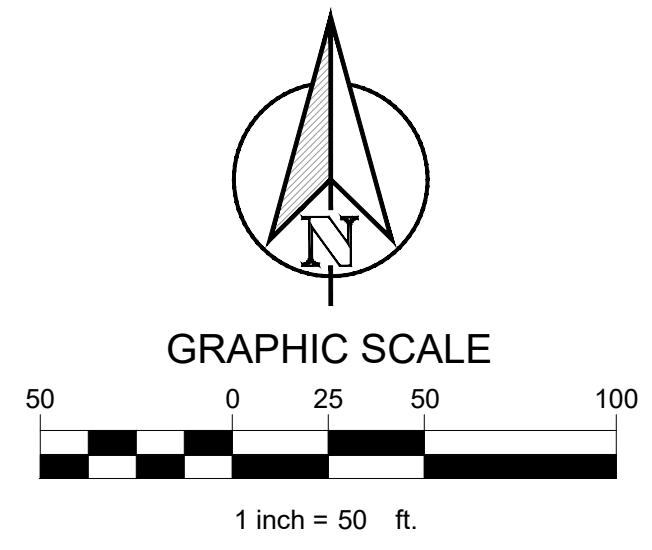

TEXAS REGISTRATION #141199

CLAYMOORE

ENGINEERING

1903 CENTRAL DRIVE, SUITE #408  
BEFORD, TX 76021  
PHONE 817.281.0572  
WWW.CLAYMOOREENG.COM

PRELIMINARY

FOR REVIEW ONLY  
Not for construction purposes.

CLAYMOORE ENGINEERING  
ENGINEERING AND PLANNING CONSULTANTS

Engineer: DREW DONOSKY  
P.E. No.125651 Date 7/17/2024

SANGER MULTI-FAMILY  
PREPARED FOR  
GREYSTAR  
SANGER, TEXAS

No.	DATE	REVISION	BY

STORM DRAINAGE PLAN


SHEET  
C-6.3

CASE NO. 2022-185





PLOTTED BY: DAN CABALLERO  
 PLOT DATE: 7/17/2024 10:11 AM  
 LOCATION: Z:\PROJECTS\PROJECTS\2022-185 MALOUF SANGER\CADD\SHEETS\MULTI-FAMILY GREYSTAR\C-6.4 STORM DRAINAGE PROFILES.DWG  
 LAST SAVED: 7/17/2024 9:54 AM


STORM LINE A

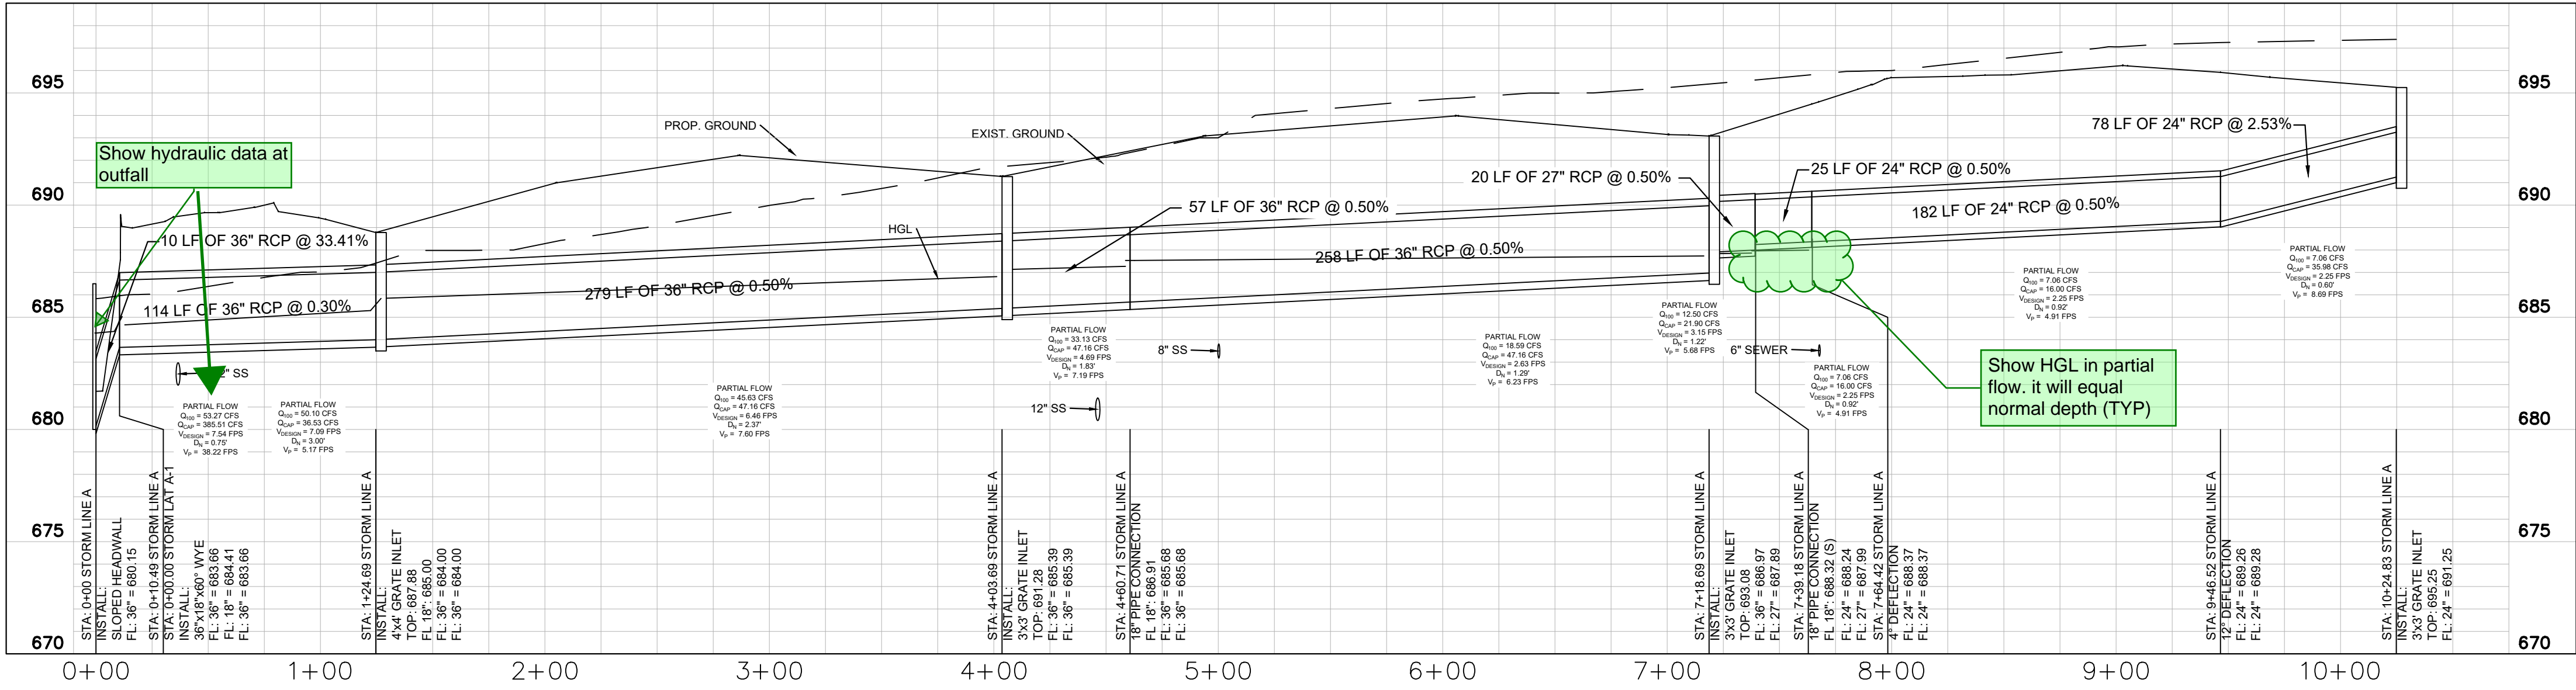


STORM LAT A-1

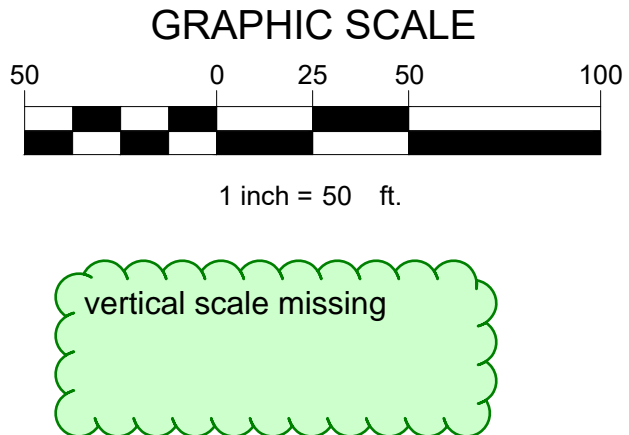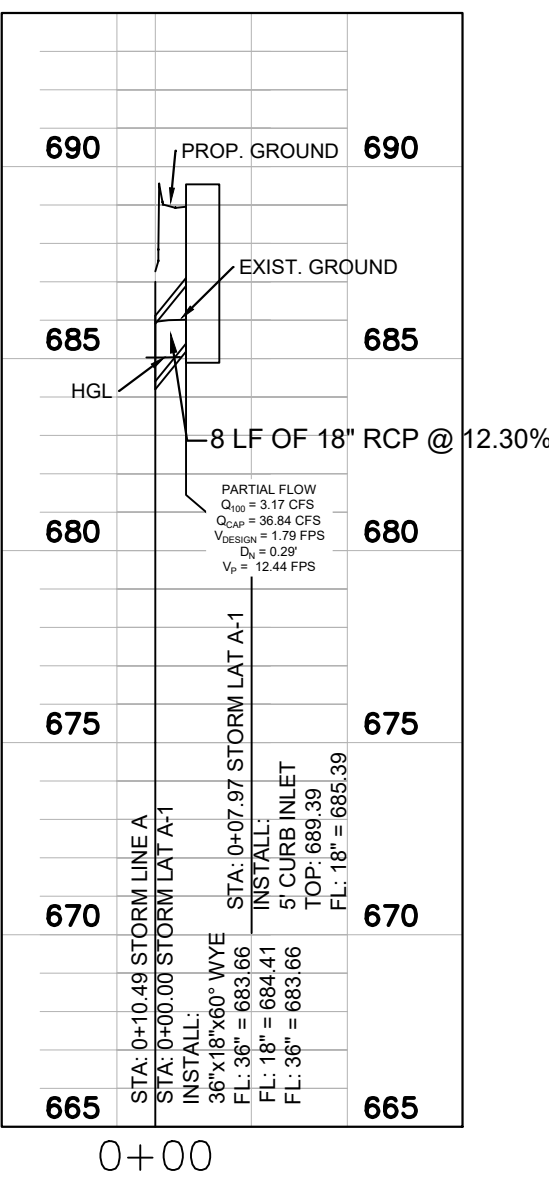


STORM LINE B

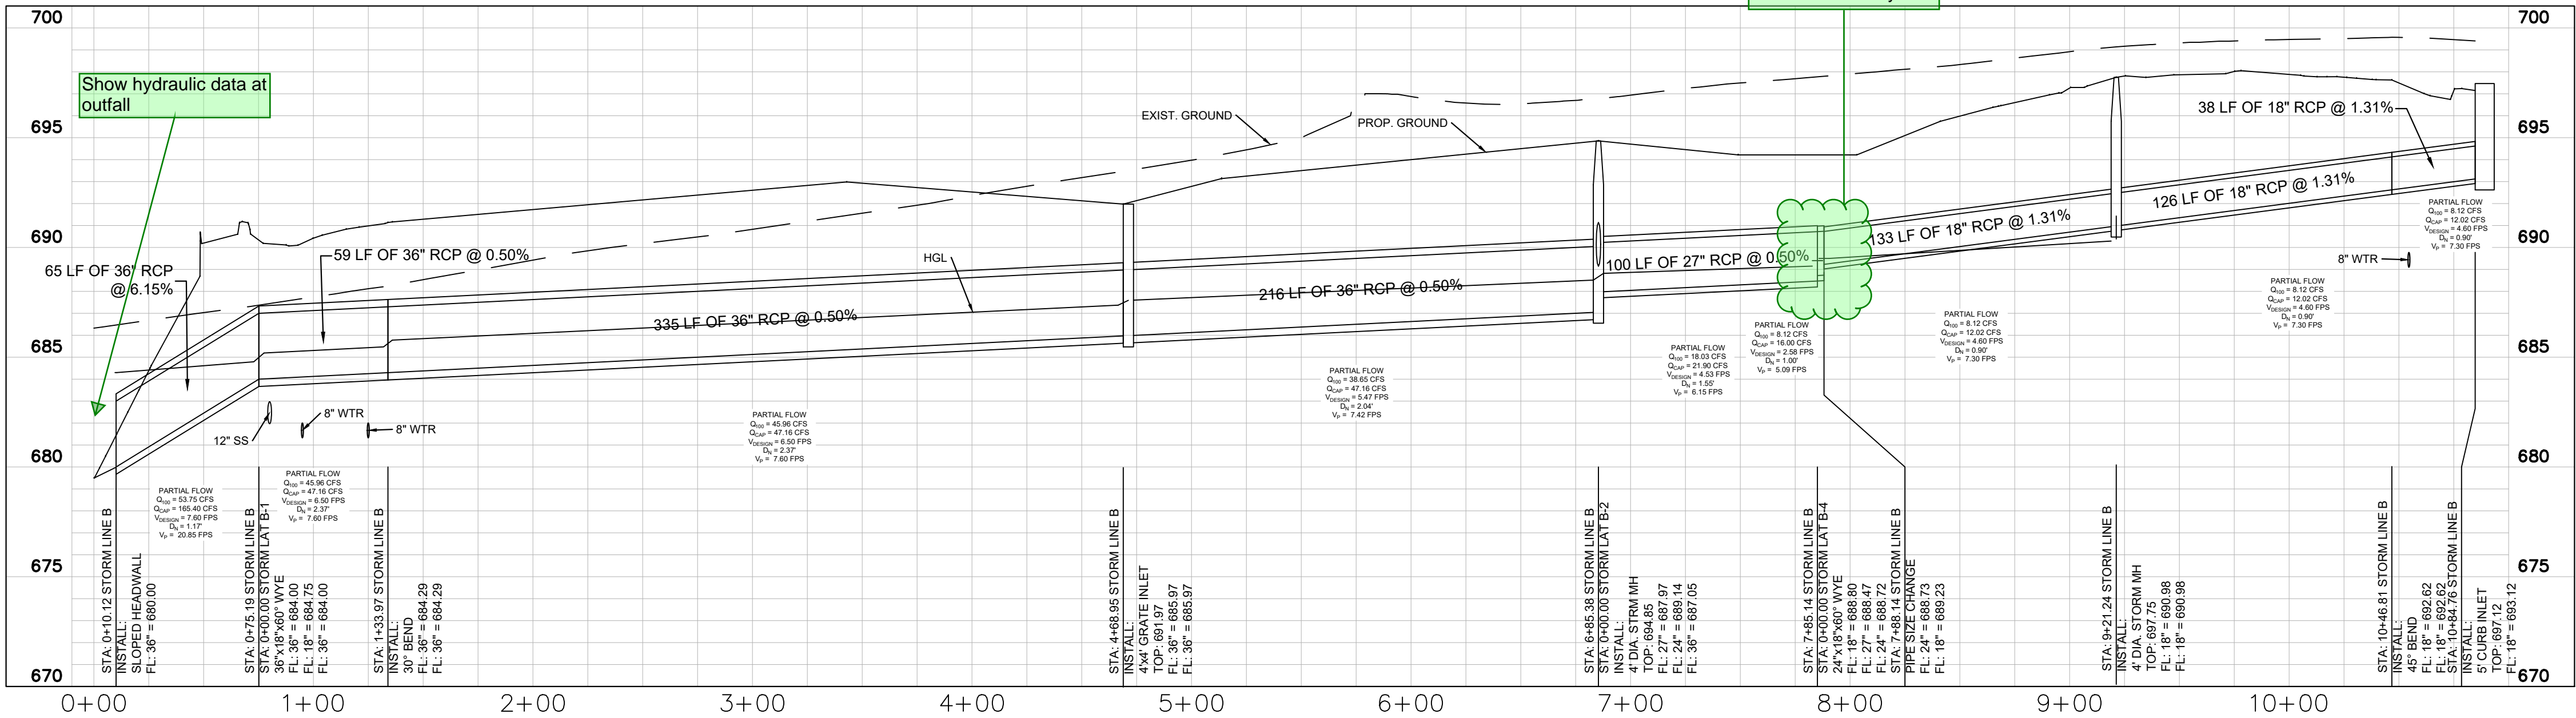


STORM LAT B-1

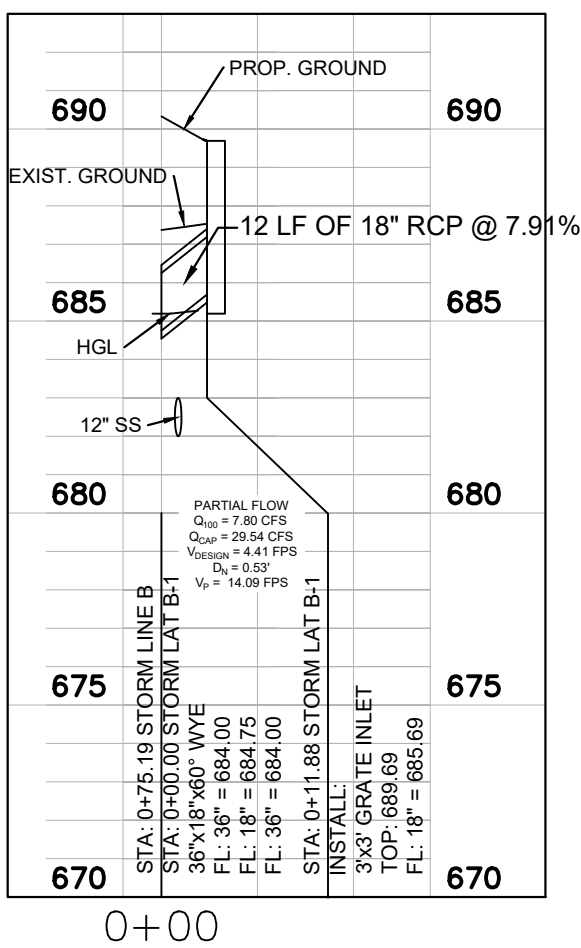


STORM LAT B-2

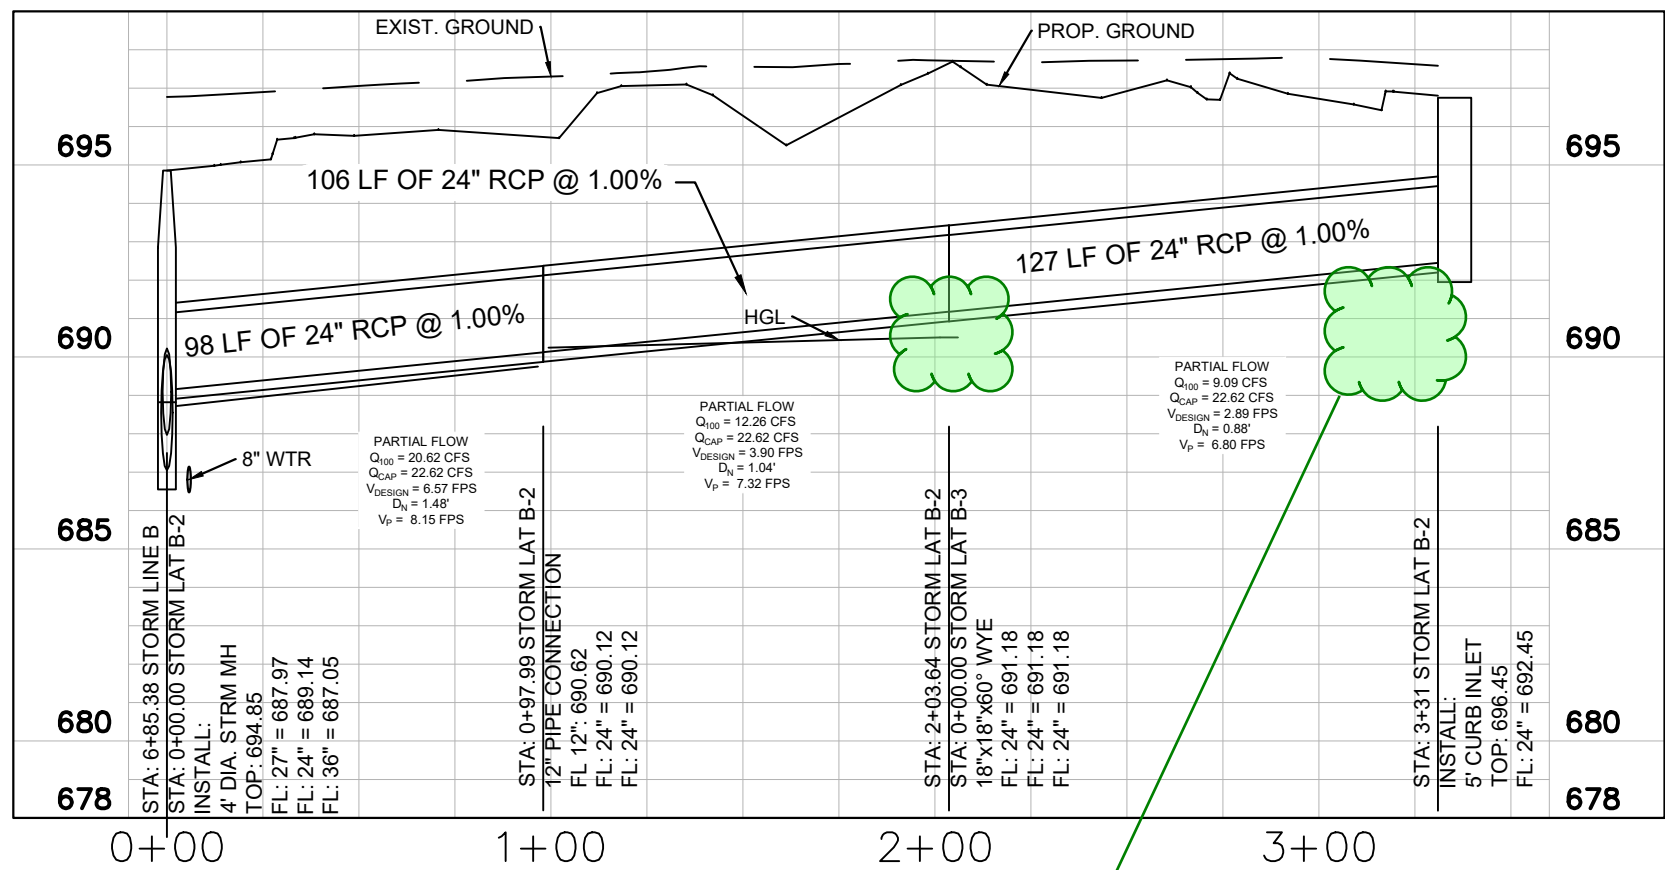


STORM LAT B-3

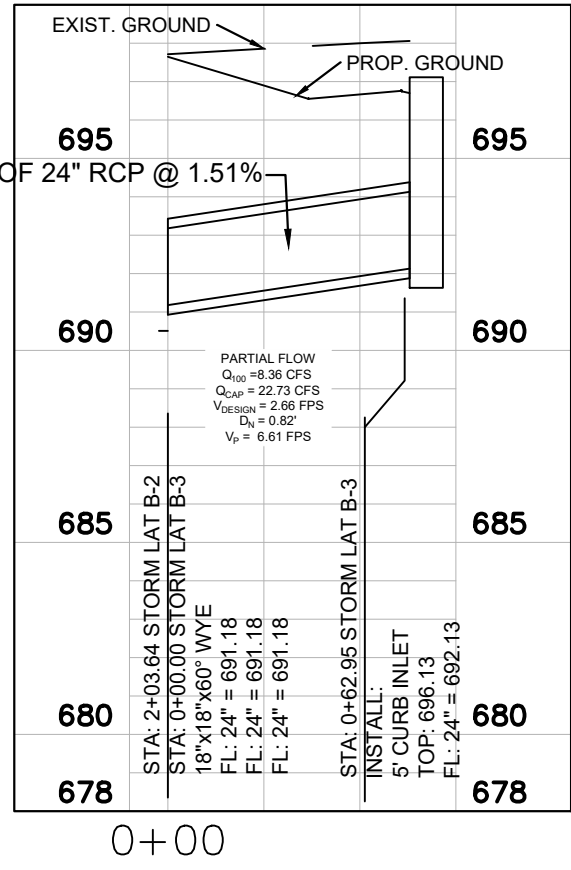


STORM LAT B-4

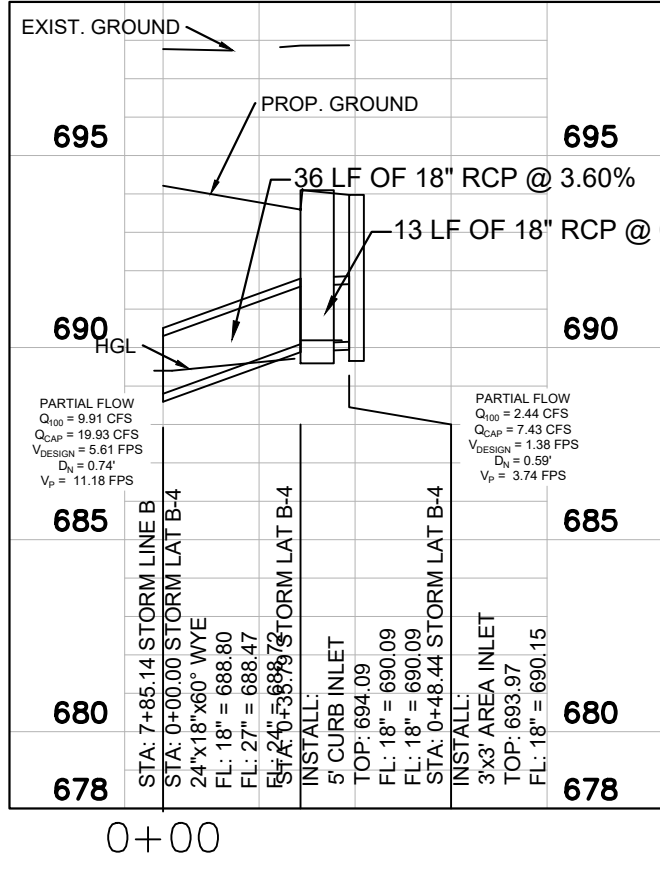

STORM LINE C

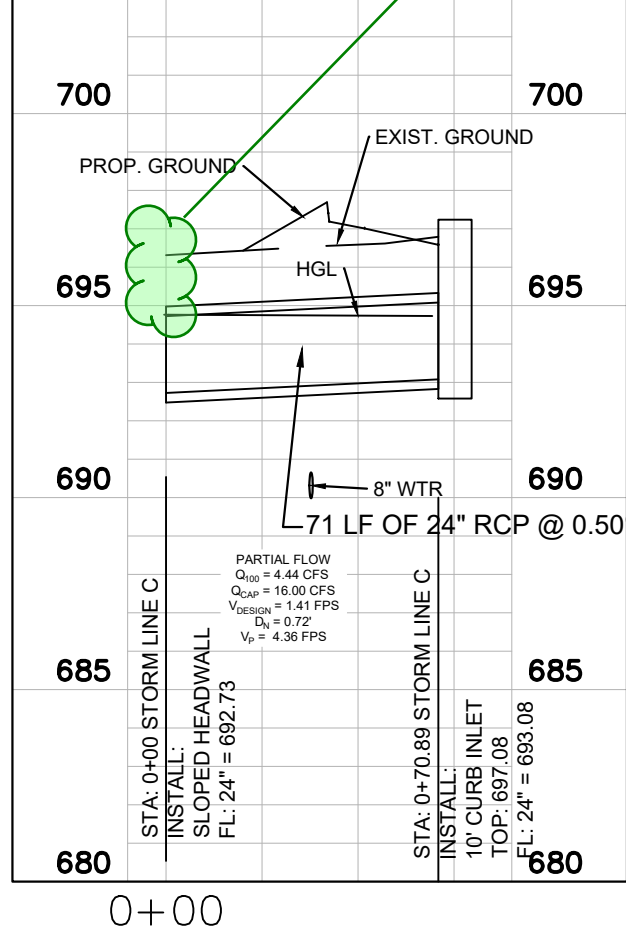

STORM LINE D

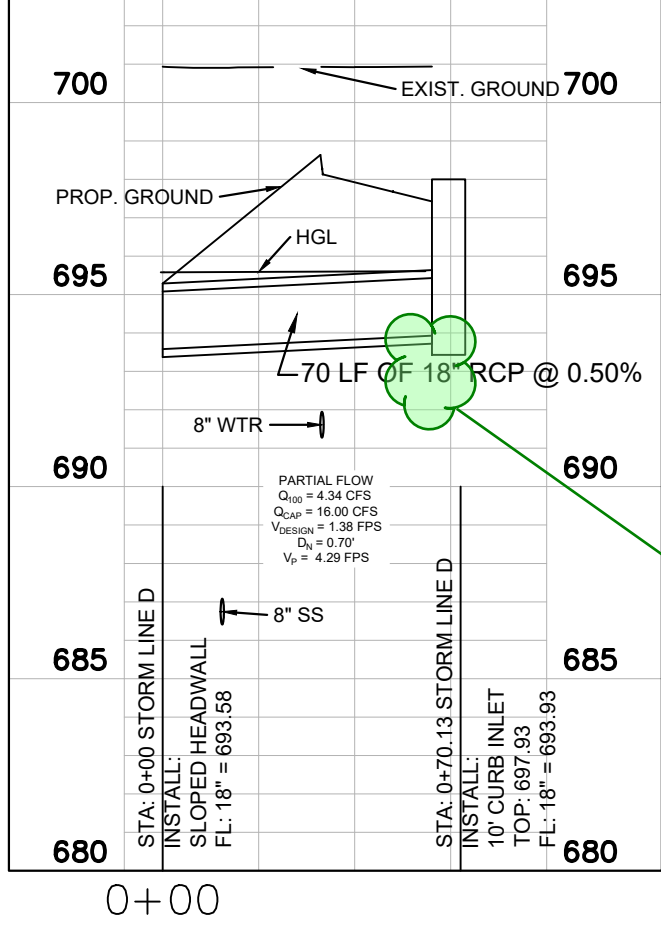


NO.	DATE	REVISION	BY




PLOTTED BY: DAN CABALLERO  
PLOT DATE: 7/17/2024 10:11 AM  
LOCATION: Z:\PROJECTS\PROJECTS\2022-185 MALOUF SANGER\CADD\SHEETS\MULTI-FAMILY GREYSTAR\C-6.4 STORM DRAINAGE PROFILES.DWG  
LAST SAVED: 7/17/2024 9:54 AM

OUTFALL

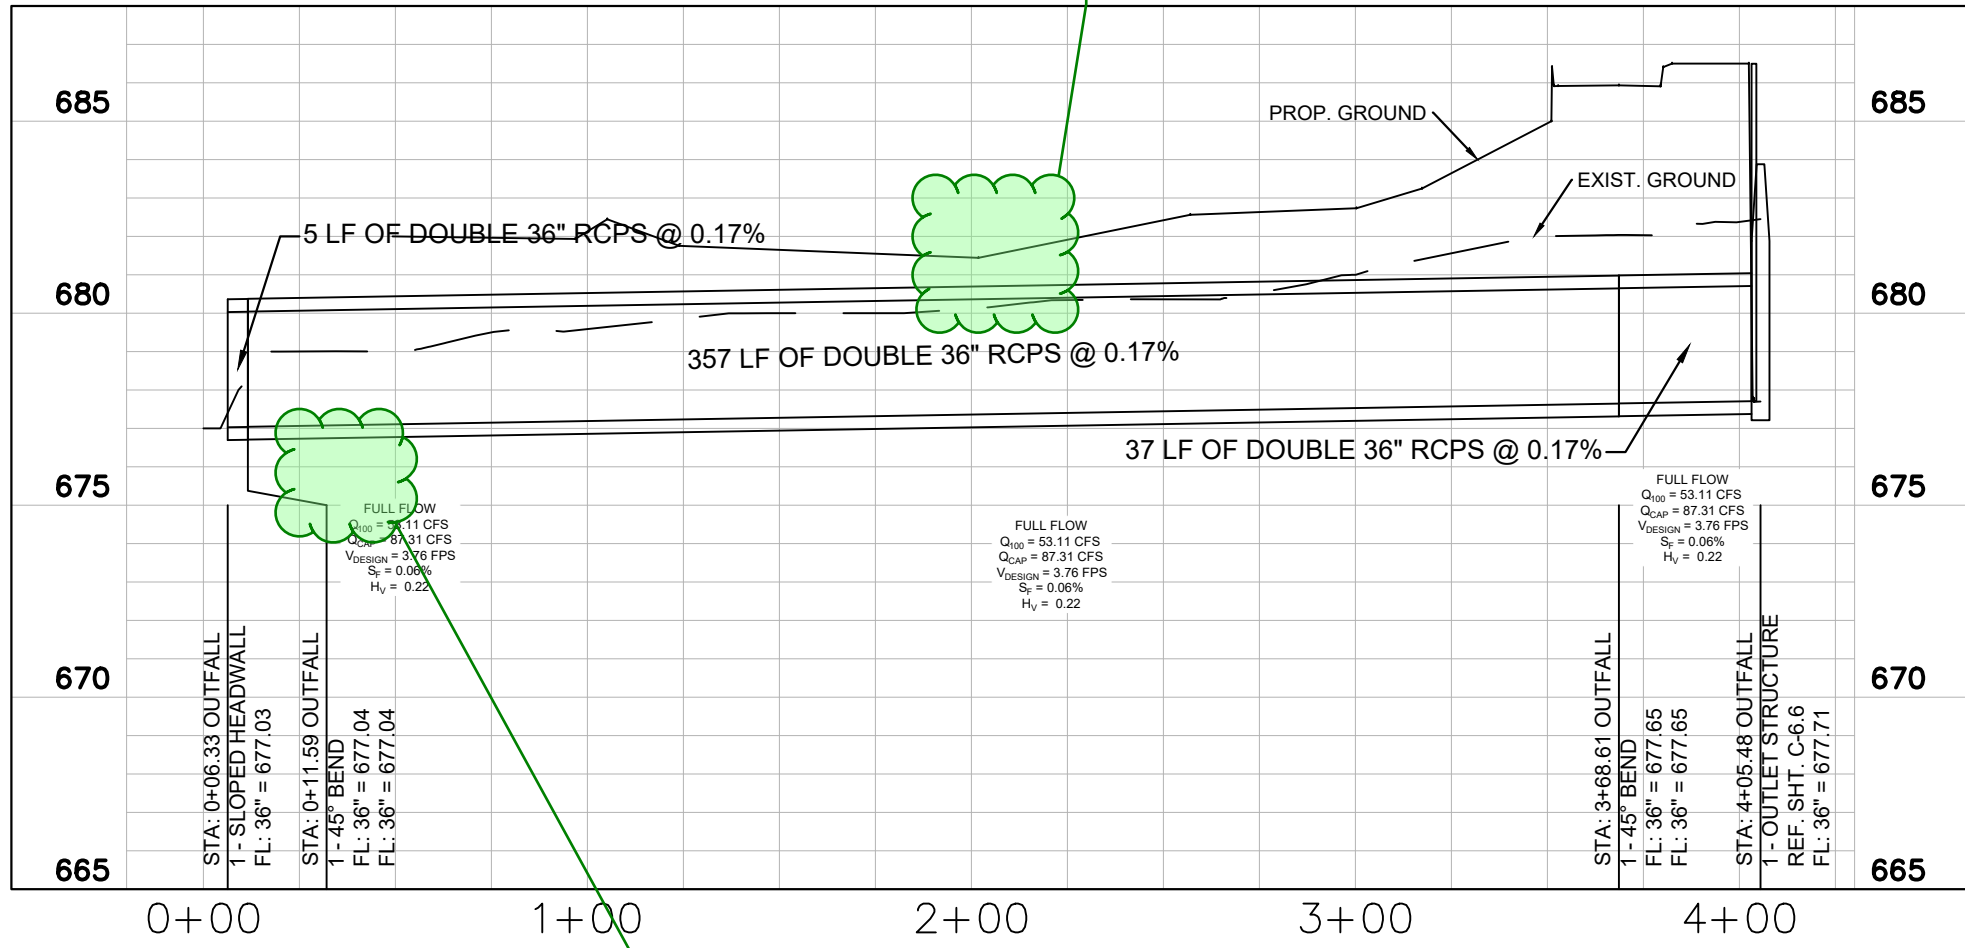


SS crossing per plan

STORM LINE C-1

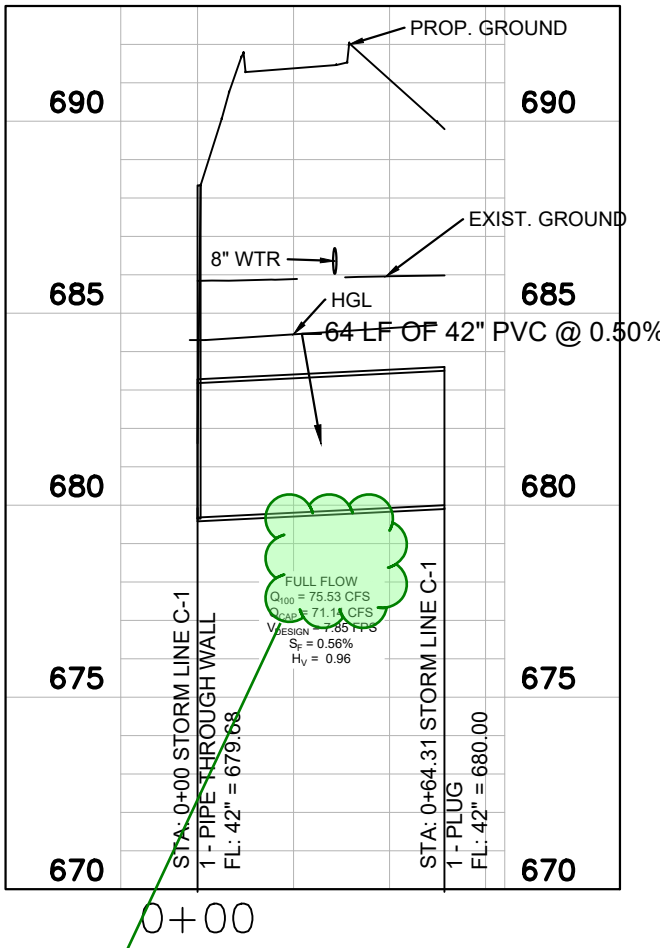


WL crossing per plan

STORM LINE C-2

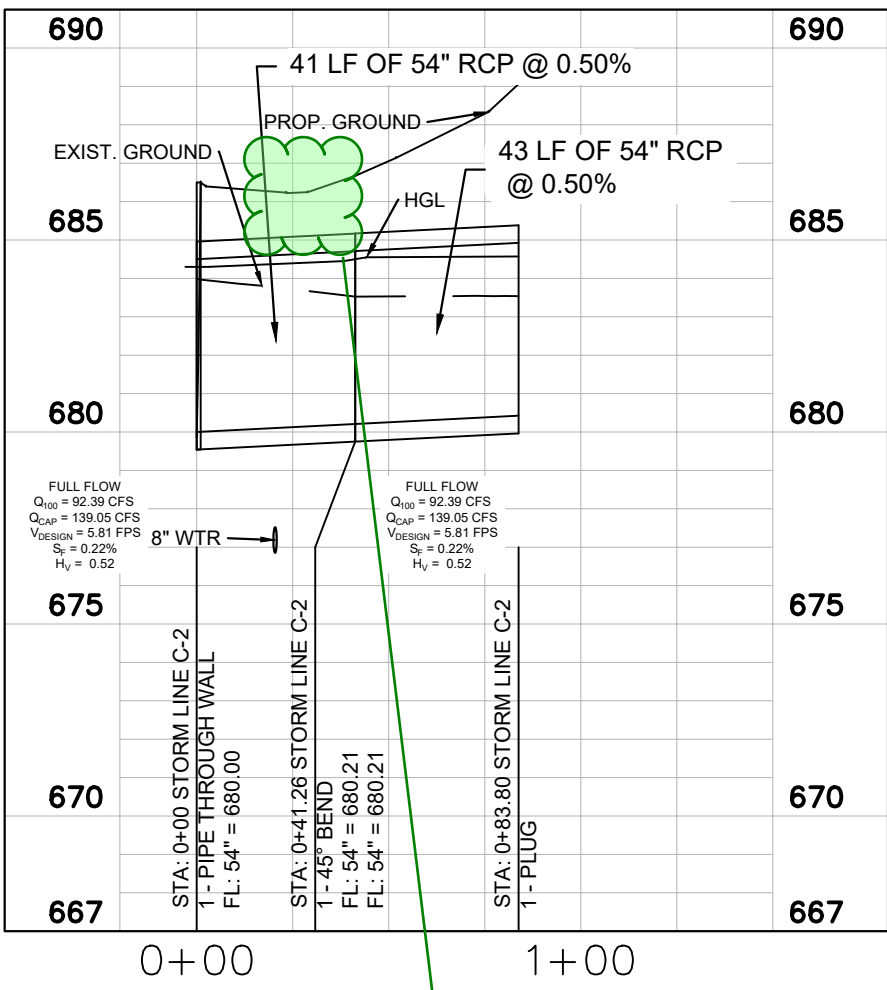



Less than 2' of cover.  
Provide class of RCP  
to be used or deload  
calcs for type III RCP

STORM LINE C-3

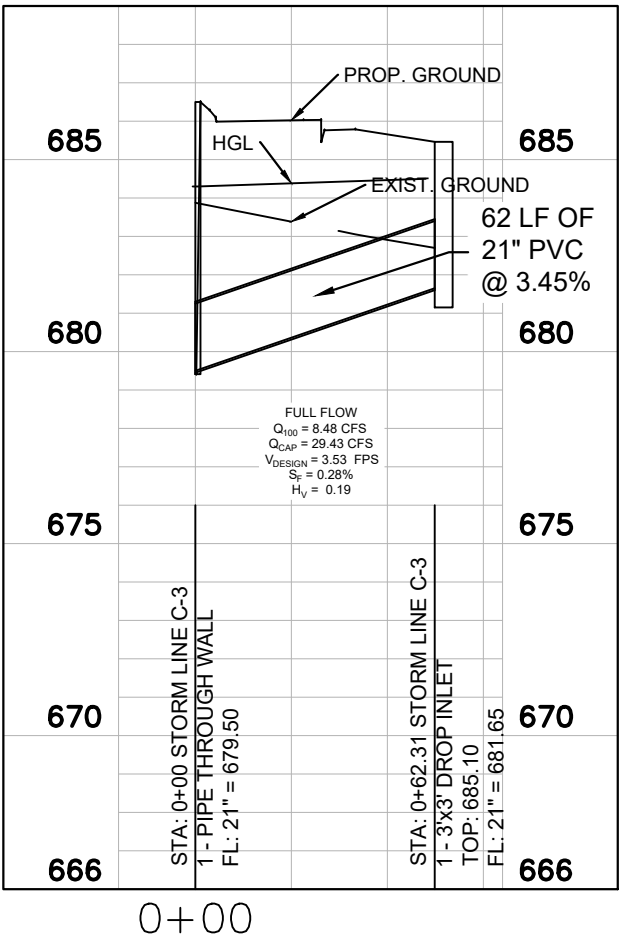

Clarify Ph1 vs Ph 2  
construction

STORM LINE C-4

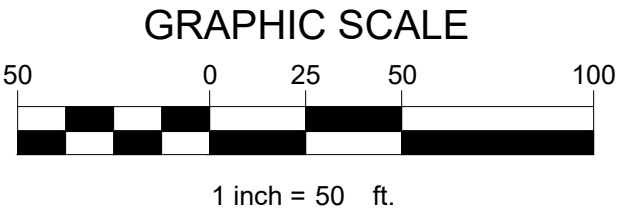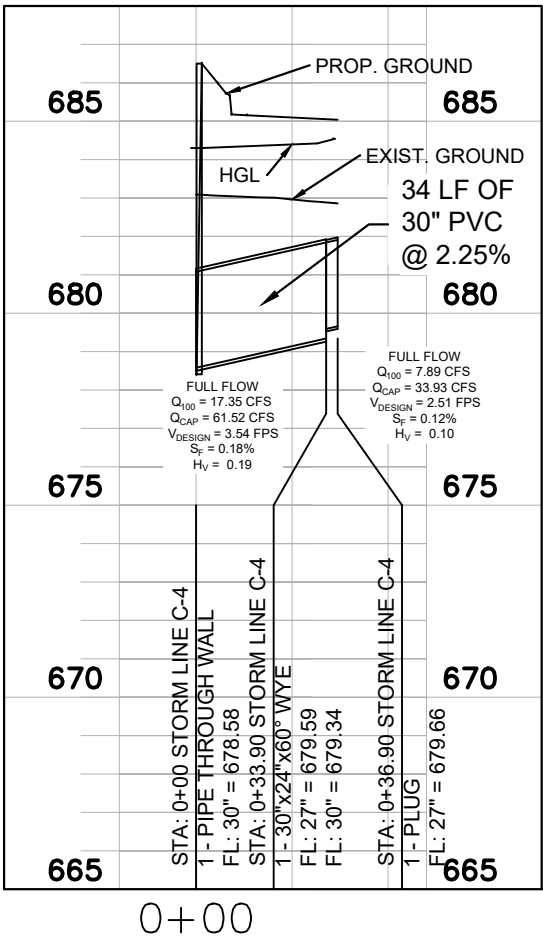

TEXAS REGISTRATION #141199

**CLAY MOORE**  
**ENGINEERING**

1903 CENTRAL DRIVE SUITE #408  
BEFORD, TX 76001  
PHONE 817.281.0572  
WWW.CLAYMOOREENG.COM

**PRELIMINARY**

FOR REVIEW ONLY  
Not for construction purposes.

**CLAYMOORE ENGINEERING**  
ENGINEERING AND PLANNING CONSULTANTS

Engineer: **DREW DONOSKY**  
P.E. No.125651 Date: **7/17/2024**

**SANGER MULTI-FAMILY  
PREPARED FOR  
GREYSTAR  
SANGER, TEXAS**

No.	DATE	REVISION	BY

**STORM DRAINAGE PROFILES**

**C-6.5**

SHEET

DESIGN: ASD  
DRAWN: DC  
CHECKED: ASD  
DATE: 7/17/2024

CASE NO. 2022-185



PLOTTED BY: DAN CABALLERO  
 PLOT DATE: 7/17/2024 10:11 AM  
 LOCATION: Z:\PROJECTS\PROJECTS\2022-185 MALOUF SANGER\CADD\SHEETS\MULTI-FAMILY GREYSTAR\C-6.4 STORM DRAINAGE PROFILES.DWG  
 LAST SAVED: 7/17/2024 9:54 AM

Proposed Detention Pond Evaluation												
Elevation	Area (sf)	Ac	Elevation Difference	Incremental Volume (ft³)	Cumulative Volume (ft³)	Cumulative Volume (ac-ft)	Elevation	ft³ per one hundredth				
677.69	0	0.00					677.69					
			0.31	449	449	0.010		14.47705				
678.00	2895	0.07					678.00					
			1.00	25521	25969	0.596		255.2067				
679.00	48146	1.11					679.00					
			1.00	65689	91659	2.104		656.89195				
680.00	83232	1.91					680.00					
			1.00	83607	175266	4.024		836.07065				
681.00	83982	1.93					681.00					
			1.00	84379	259645	5.961		843.78785				
682.00	84776	1.95					682.00					
			1.00	85165	344810	7.916		851.65431				
683.00	85555	1.96					683.00					
			1.00	85946	430756	9.889		859.46448				
684.00	86338	1.98					684.00					
			1.00	86736	517492	11.880		867.35777				
685.00	87134	2.00					685.00					
			1.00	87526	605018	13.889		875.26235				
686.00	87919	2.02					686.00					

100 YR WSE  
 1 FT FREEBOARD  
 TOP OF POND  
 1' of freeboard and 2' of sediment storage required


Drainage / Detention Calculations	
Modified Rational Method	
Required Storage Volume	456,963 cubic-feet 10.490 acre-feet
Predeveloped Conditions	
Area	41.67 acres
Time (Tc)	47 minutes
C value	0.30
I-100yr	5.25 in/hr
Q100yr	65.63 cfs
Bypass Flow	12.52 cfs
Release Rate	53.11 cfs
Q100yr (T)	53.11 cfs
Drainage Areas ROW and Bypass	
Allowable Release from Pond	
Rate of Release by Outfall Structure	
Onsite Proposed Conditions	
Area	37.15 acres
Time (Tc)	10 minutes
Avg. C value	0.85 avg
I-100yr	11.60 in/hr
Q100yr	366.30 cfs
Developed Runoff	

Runoff per Storm Event - Developed						Inflow per Storm Event			Max Allowable Outflow per Storm Event			
Time (min.)	I-100yr	C value	Area (ac)	Runoff (cfs)		Storm Event	Runoff	Inflow (ft³)	Storm	Time	Release	Outflow (ft³)
10	11.60	0.85	37.15	366.30		10	366.30	219,779	10	20	53.11	31,866
15	9.60	0.85	37.15	303.14		15	303.14	272,830	15	25	53.11	39,833
20	8.59	0.85	37.15	271.25		20	271.25	325,501	20	30	53.11	47,799
30	6.98	0.85	37.15	220.41		30	220.41	396,740	30	40	53.11	63,732
35	6.40	0.85	37.15	202.10		35	202.10	424,402	35	45	53.11	71,699
40	5.25	0.85	37.15	165.78		40	165.78	397,877	40	50	53.11	79,665
50	5.19	0.85	37.15	163.89		50	163.89	491,662	50	60	53.11	95,598
60	4.20	0.85	37.15	132.63		60	132.63	477,452	60	70	53.11	111,532
70	4.00	0.85	37.15	126.31		70	126.31	530,502	70	80	53.11	127,465
80	3.75	0.85	37.15	118.42		80	118.42	568,395	80	90	53.11	143,398
90	3.45	0.85	37.15	108.94		90	108.94	588,289	90	100	53.11	159,331
100	3.32	0.85	37.15	104.84		100	104.84	629,024	100	110	53.11	175,264
110	3.11	0.85	37.15	98.21		110	98.21	648,160	110	120	53.11	191,197
120	2.60	0.85	37.15	82.10		120	82.10	591,131	120	130	53.11	207,130
						130	0.00	-	130	140	53.11	223,063
						140	0.00	-	140	150	53.11	238,996

LINE	STA	100-YR STORM DRAIN CALCULATIONS																ROUGH- NESS n	PIPE SLOPE S <sub>o</sub> %	PIPE CAPACITY Q <sub>cap</sub> CFS	V <sub>design</sub> design/ft	V <sub>full</sub> FPS	Q/Q <sub>full</sub>	V/V <sub>full</sub>	d/D	Flow Depth FT	V <sub>partial</sub> FPS	FRICTION SLOPE S <sub>f</sub> FT/FT	H <sub>v</sub> v <sub>design</sub> <sup>2/2g</sup>	K <sub>i</sub>	H (MIN 0.1) FT	HGL					
		INCREMENTAL AREA		CUMULATIVE AREA	RUNOFF COEFFICIENT	INCREMENTAL CA	CUMULATIVE CA	INLET TIME	FLOW TIME IN PIPE	TIME OF CONCENTRATION MIN	INTENSITY I <sub>100</sub> IN/HR	DIST FT	TOTAL FLOW Q <sub>100</sub> CFS	DIA IN	SPAN FT	RISE FT	NUMBER															A Sq Ft	R	INCOMING PIPE FT	OUTGOING PIPE FT		
		ACRES	ACRES																																	INCOMING PIPE FT	OUTGOING PIPE FT
STORM LINE A	0+00.00	HEADWALL							12.73																											684.30	
	0+10.49	LAT A-1	0.39	6.56	0.70	0.27	4.59	10.00	12.73	11.60	10.49	53.27	36		3		7.07	0.750	0.013	33.41%	385.51	7.54	54.54	0.138	0.70	0.25	0.75	38.22	0.63%	0.88	0.75	0.30	684.66	684.37			
	1+24.69	GRATE INLET	1.31	6.17	0.70	0.92	4.32	10.00	12.36	11.60	114.20	50.10	36		3		7.07	0.750	0.013	0.30%	36.53	7.09	5.17	1.371	1.00	1.00	3.00	5.17	0.56%	0.78	0.50	0.54	685.84	685.30			
	4+03.69	GRATE INLET	0.78	4.86	0.70	0.55	3.40	10.00	11.74	11.60	279.00	39.46	36		3		7.07	0.750	0.013	0.50%	47.16	5.58	6.67	0.837	1.12	0.69	2.07	7.45	0.35%	0.48	0.50	0.31	687.13	686.81			
	4+60.71	LANDSCAPE DRAINS	1.79	4.08	0.70	1.25	2.86	10.00	11.61	11.60	57.02	33.13	36		3		7.07	0.750	0.013	0.50%	47.16	4.69	6.67	0.702	1.08	0.61	1.83	7.19	0.25%	0.34	0.75	0.26	687.53	687.27			
	7+18.69	GRATE INLET	0.75	2.29	0.70	0.53	1.60	10.00	10.92	11.60	257.98	18.59	36		3		7.07	0.750	0.013	0.50%	47.16	2.63	6.67	0.394	0.93	0.43	1.29	6.23	0.08%	0.11	0.50	0.10	687.83	687.73			
	7+39.18	LANDSCAPE DRAINS	0.67	1.54	0.70	0.47	1.08	10.00	10.86	11.60	20.49	12.50	27	2.25		3.98	0.563	0.013	0.50%	21.90	3.15	5.51	0.571	1.03	0.54	1.22	5.68	0.16%	0.15	0.75	0.10	687.96	687.86				
	7+64.42	DEFLECTION	0.00	0.87	0.70	0.00	0.61	10.00	10.77	11.60	25.24	7.06	24		2		3.14	0.500	0.013	0.50%	16.00	2.25	5.09	0.442	0.96	0.46	0.92	4.91	0.10%	0.08	0.25	0.10	688.09	687.99			
	9+46.52	DEFLECTION	0.00	0.87	0.70	0.00	0.61	10.00	10.62	11.60	182.10	7.06	24		2		3.14	0.500	0.013	0.50%	16.00	2.25	5.09	0.442	0.96	0.46	0.92	4.91	0.10%	0.08	0.25	0.10	688.36	688.26			
	10+24.83	GRATE INLET	0.87	0.87	0.70	0.61	0.61	10.00	10.15	11.60	78.31	7.06	24		2		3.14	0.500	0.013	2.53%	35.98	2.25	11.45	0.196	0.78	0.30	0.60	8.89	0.10%	0.08	1.50	0.12	688.56	688.44			
LAT A-1	0+00.00	LINE A							10.01																										684.66		
	0+07.97	CURB INLET	0.39	0.39	0.70	0.27	0.27	10.00	10.00	11.60	7.97	3.17	18		1.5		1.77	0.375	0.013	12.30%	36.84	1.79	20.85	0.086	0.60	0.19	0.29	12.44	0.09%	0.05	1.50	0.10	684.77	684.67			
STORM LINE B	0+00.00	HEADWALL							12.37																										684.30		
	0+75.19	LAT B-1	0.96	6.62	0.70	0.67	4.63	10.00	12.31	11.60	75.19	53.75	36		3		7.07	0.750	0.013	6.15%	165.40	7.60	23.40	0.325	0.89	0.39	1.17	20.85	0.65%	0.90	0.75	0.41	685.19	684.79			
	1+33.97	45° BEND	0.00	5.66	0.70	0.00	3.96	10.00	12.18	11.60	58.78	45.96	36		3		7.07	0.750	0.013	0.50%	47.16	6.50	6.67	0.975	1.14	0.79	2.37	7.60	0.47%	0.66	0.35	0.31	685.78	685.47			
	4+68.95	GRATE INLET	0.90	5.66	0.70	0.63	3.96	10.00	11.45	11.60	334.98	45.96	36		3		7.07	0.750	0.013	0.50%	47.16	6.50	6.67	0.975	1.14	0.79	2.37	7.60	0.47%	0.66	0.50	0.42	687.79	687.37			
	6+85.38	MANHOLE, LAT B-2	2.54	4.76	0.70	1.78	3.33	10.00	10.96	11.60	216.43	38.65	36		3		7.07	0.750	0.013	0.50%	47.16	5.47	6.67	0.820	1.11	0.68	2.04	7.42	0.33%	0.46	0.50	0.30	688.82	688.51			
	7+85.14	LAT B-4	1.22	2.22	0.70	0.85	1.55	10.00	10.69	11.60	99.76	18.03	27	2.25		3.98	0.563	0.013	0.50%	21.90	4.53	5.51	0.823	1.12	0.69	1.55	6.15	0.34%	0.32	0.75	0.24	689.40	689.15				
	7+88.14	PIPE SIZE CHANGE	0.00	1.00	0.70	0.00	0.70	10.00	10.68	11.60	3.00	8.12	24		2		3.14	0.500	0.013	0.50%	16.00	2.58	5.09	0.508	1.00	0.50	1.00	5.09	0.13%	0.10	0.25	0.10	689.50	689.40			
	9+21.24	MANHOLE	0.00	1.00	0.70	0.00	0.70	10.00	10.38	11.60	133.10	8.12	18		1.5		1.77	0.375	0.013	1.31%	12.02	4.60	6.80	0.675	1.07	0.60	0.90	7.30	0.59%	0.33	0.50	0.10	690.39	690.29			
	10+46.81	45° BEND	0.00	1.00	0.70	0.00	0.70	10.00	10.09	11.60	125.57	8.12	18		1.5		1.77	0.375	0.013	1.31%	12.02	4.60	6.80	0.675	1.07	0.60	0.90	7.30	0.59%	0.33	0.35	0.11	691.25	691.14			
	10+84.76	CURB INLET	1.00	1.00	0.70	0.70	0.70	10.00	10.00	11.60	37.95	8.12	18		1.5		1.77	0.375	0.013	1.31%	12.02	4.60	6.80	0.675	1.07	0.60	0.90	7.30	0.59%	0.33	1.50	0.49	691.97	691.48			
LAT B-1	0+00.00	LINE B							10.02																										685.19		
	0+14.46	CURB INLET	0.96	0.96	0.70	0.67	0.67	10.00	10.00	11.60	14.46	7.80	18		1.5		1.77	0.375	0.013	7.91%	29.54	4.41	16.72	0.264	0.84	0.35	0.53	14.09	0.55%	0.30	1.50	0.10	685.37	685.27			
LAT B-4	0+00.00	LINE B							10.11																										689.40		
	0+35.79	CURB INLET	0.92	1.22	0.70	0.64	0.85	10.00	10.05	11.60	35.79	9.91	18		1.5		1.77	0.375	0.013	3.60%	19.93	5.61	11.28	0.497	0.99	0.49	0.74	11.18	0.88%	0.49	0.50	0.47	690.19	689.71			
	0+48.44	GRATE INLET	0.30	0.30	0.70	0.21	0.21	10.00	10.00	11.60	12.65	2.44	18		1.5		1.77	0.375	0.013	0.50%	7.43	1.38	4.20	0.328	0.89	0.39	0.59	3.74	0.05%	0.03	1.50	0.73	690.92	690.19			
LAT B-2	0+00.00	LINE B							10.76																										688.62		
	1+12.86	LAT B-3	1.03	1.51	0.70	0.72	1.06	10.00	10.53	11.60	112.86	20.62	24		2		3.14	0.500	0.013	1.00%	22.62	6.57	7.20	0.912	1.13	0.74	1.48	8.15	0.83%	0.67	0.75	0.49	690.24	689.75			
	2+03.64	LANDSCAPE DRAIN	0.39	1.12	0.70	0.27	0.78	10.00	10.32	11.60	90.78	12.26	24		2		3.14	0.500	0.013	1.00%	22.62	3.90	7.20	0.542	1.02	0.52	1.04	7.32	0.29%	0.24	0.75	0.14	690.65	690.51			
	3+32.26	CURB INLET	1.12		0.70	0.78		10.00	10.00	11.60	128.62	9.09	24		2		3.14	0.500	0.013	1.00%	22.62	2.89	7.20	0.402	0.94	0.44	0.88	6.80	0.16%	0.13	1.50	0.35	691.21	690.85			
LAT B-3	0+00.00	LINE B							10.16																										690.24		
	0+62.95	CURB INLET	1.03	1.03	0.70	0.72	0.72	10.00	10.16	11.60	62.95	8.36	24		2		3.14	0.500	0.013	1.01%	22.73	2.66	7.24	0.368	0.91	0.41	0.82	6.61	0.14%	0.11	1.50	0.10	690.43	690.33			
STORM LINE C	0+00.00	HEADWALL							10.27																										694.73		
	0+70.89	CURB INLET	0.45	0.45	0.85	0.38	0.38	10.00	10.00	11.60	69.49	4.44	24		2		3.14	0.500	0.013	0.50%	16.00	1.41	5.09	0.277	0.86	0.36	0.72	4.36	0.04%	0.03	1.50	0.10	694.86	694.76			
STORM LINE D	0+00.00	HEADWALL							10.27																										695.58		
	0+70.13	CURB INLET	0.44	0.44	0.85	0.37	0.37	10.00	10.00	11.60	69.49	4.34	24		2		3.14	0.500	0.013	0.50%	16.00	1.38	5.09	0.271	0.84	0.35	0.70	4.29	0.04%	0.03	1.50	0.10	695.71	695.61			
STORM LINE C-1	0+00.00	HEADWALL							10.15																										684.30		
	0+64.31	FUTURE STUB	7.66	7.66	0.85	6.51		10.00	10.00	11.60	69.49	75.53	42		3.5		9.62	0.875	0.013	0.50%	71.14	7.85	7.39	1.062	1.13	0.89	3.50	8.34	0.56%	0.96	1.50	0.10	684.79	684.69			
STORM LINE C-2	0+00.00	HEADWALL							10.23																										684.30		
	0+41.26	45° BEND	0.00	9.37	0.85	0.00	7.96	10.00	10.03	11.60	69.49	92.39	54		4.5		15.90	1.125	0.013	0.50%	139.05	5.81	8.74	0.664	1.07	0.59	4.50	9.32	0.22%	0.52	0.35	0.10	684.55	684.45			
	0+51.34	FUTURE STUB	9.37	9.37	0.85	7.96	7.96	10.00	10.00	11.60	10.08	92.39	54		4.5		15.90	1.125	0.013	0.50%	139.05	5.81	8.74	0.664	1.07	0.59	4.50	9.32	0.22%	0.52	1.50	0.79	685.36	684.57			
STORM LINE C-3	0+																																				



PLOTTED BY: DAN CABALLERO  
 PLOT DATE: 7/17/2024 10:12 AM  
 LOCATION: Z:\PROJECTS\PROJECTS\2022-185 MALOUF SANGER\CADD\PROJECTS\2022-185 MALOUF SANGER\MULTI-FAMILY GREYSTAR\C-7.2 WATER PLAN.DWG  
 LAST SAVED: 7/15/2024 9:45 PM

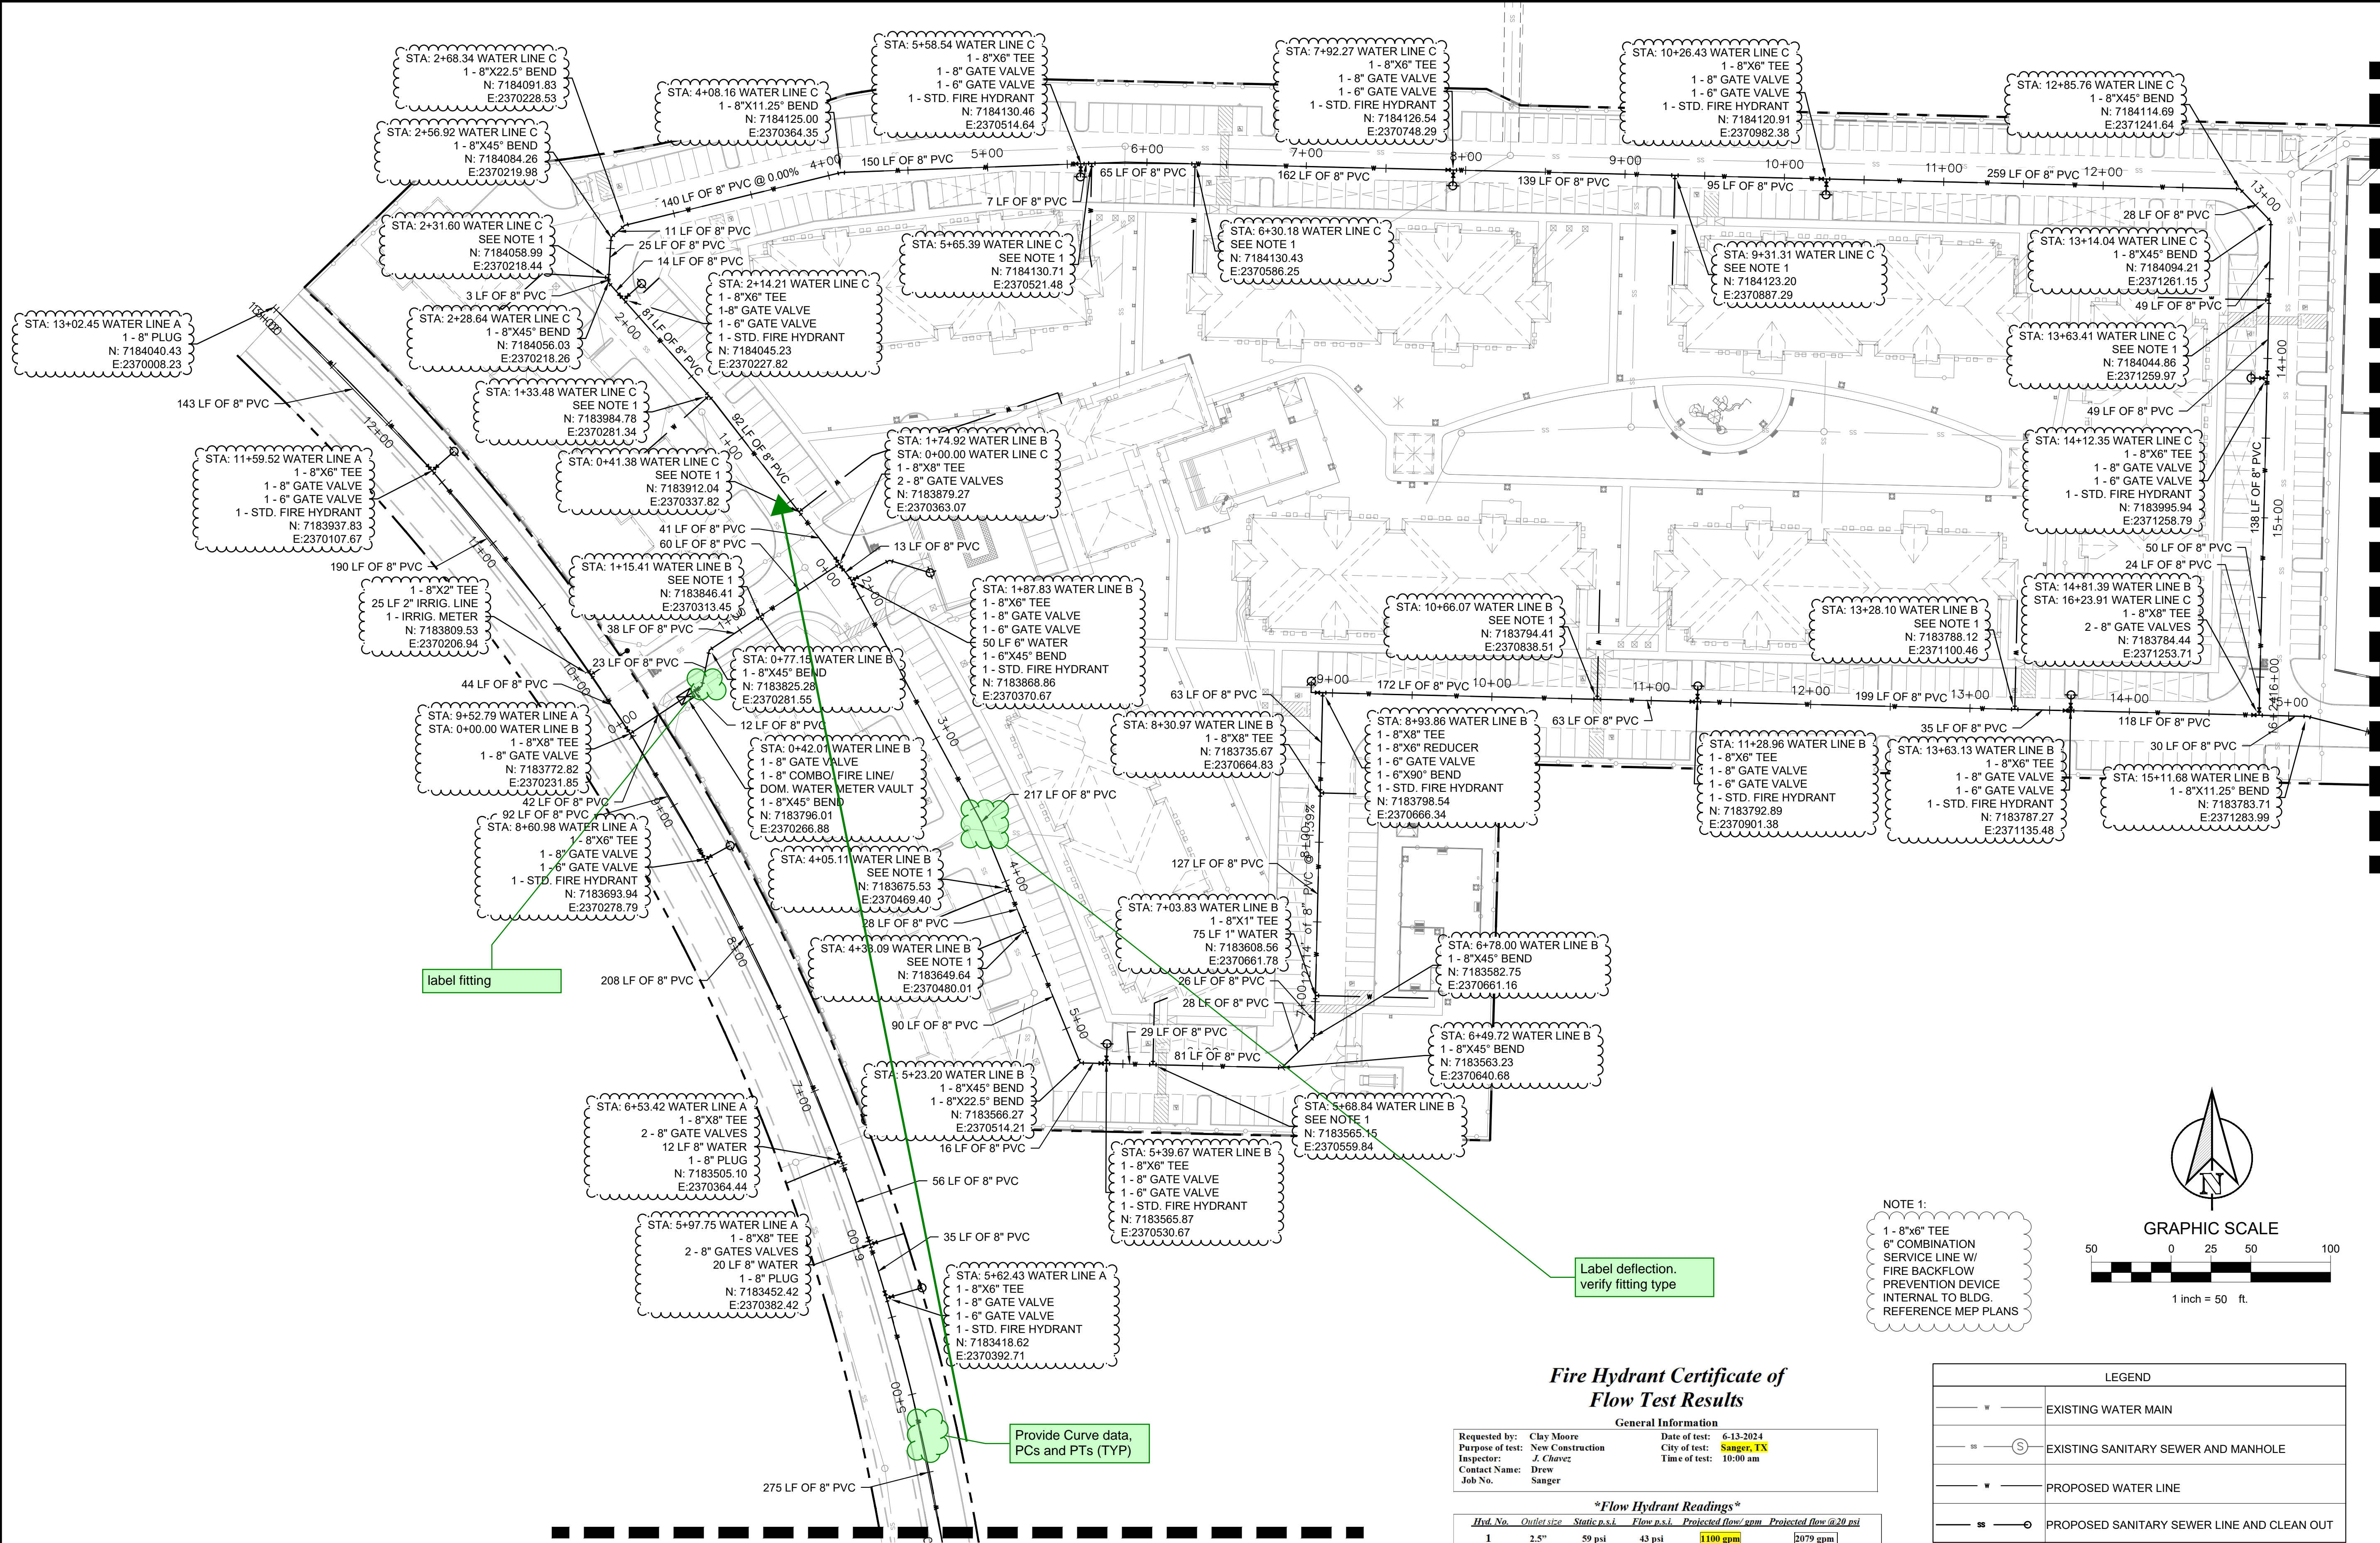


MATCHLINE SHEET C-7.2

### Fire Hydrant Certificate of Flow Test Results

General Information					
Requested by:	Clay Moore	Date of test:	6-13-2024		
Purpose of test:	New Construction	City of test:	Sanger, TX		
Inspector:	J. Chavez	Time of test:	10:00 am		
Contact Name:	Drew Sanger				
Job No.	Sanger				
*Flow Hydrant Readings*					
Hyd. No.	Outlet size	Static p.s.i.	Flow p.s.i.	Projected flow/ gpm	Projected flow @20 psi
1	2.5"	59 psi	43 psi	1100 gpm	2079 gpm
Location: Hydrant on service road north of the old Jack in the Box as per map.					
*Static / Residual Hydrant Readings*					
Hyd. No.	Static p.s.i.	Residual p.s.i.			
2	59 psi	47 psi			
Location: Hydrant at old Jack in the Box north entrance to parking lot as per map.					

NOTE 1:  
1-8"x6" TEE  
6" COMBINATION  
SERVICE LINE W/  
FIRE BACKFLOW  
PREVENTION DEVICE  
INTERNAL TO BLDG.  
REFERENCE MEP PLANS

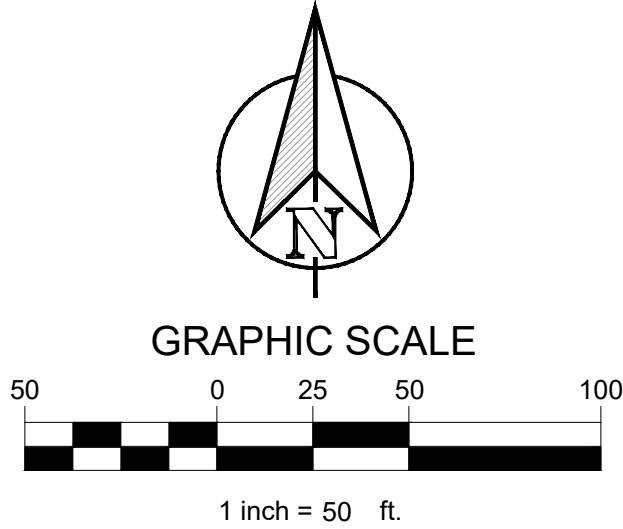

LEGEND	
— w —	EXISTING WATER MAIN
— ss — (S)	EXISTING SANITARY SEWER AND MANHOLE
— w —	PROPOSED WATER LINE
— ss — (O)	PROPOSED SANITARY SEWER LINE AND CLEAN OUT

MATCHLINE SHEET C-7.2


**PRELIMINARY**  
 FOR REVIEW ONLY  
 Not for construction purposes.  
**CLAYMOORE ENGINEERING**  
 ENGINEERING AND PLANNING CONSULTANTS  
 Engineer: **DREW DONOSKY**  
 P.E. No.125651 Date: 7/17/2024




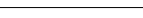
**SANGER MULTI-FAMILY**  
**PREPARED FOR**  
**GREYSTAR**  
**SANGER, TEXAS**


No.	DATE	REVISION	BY

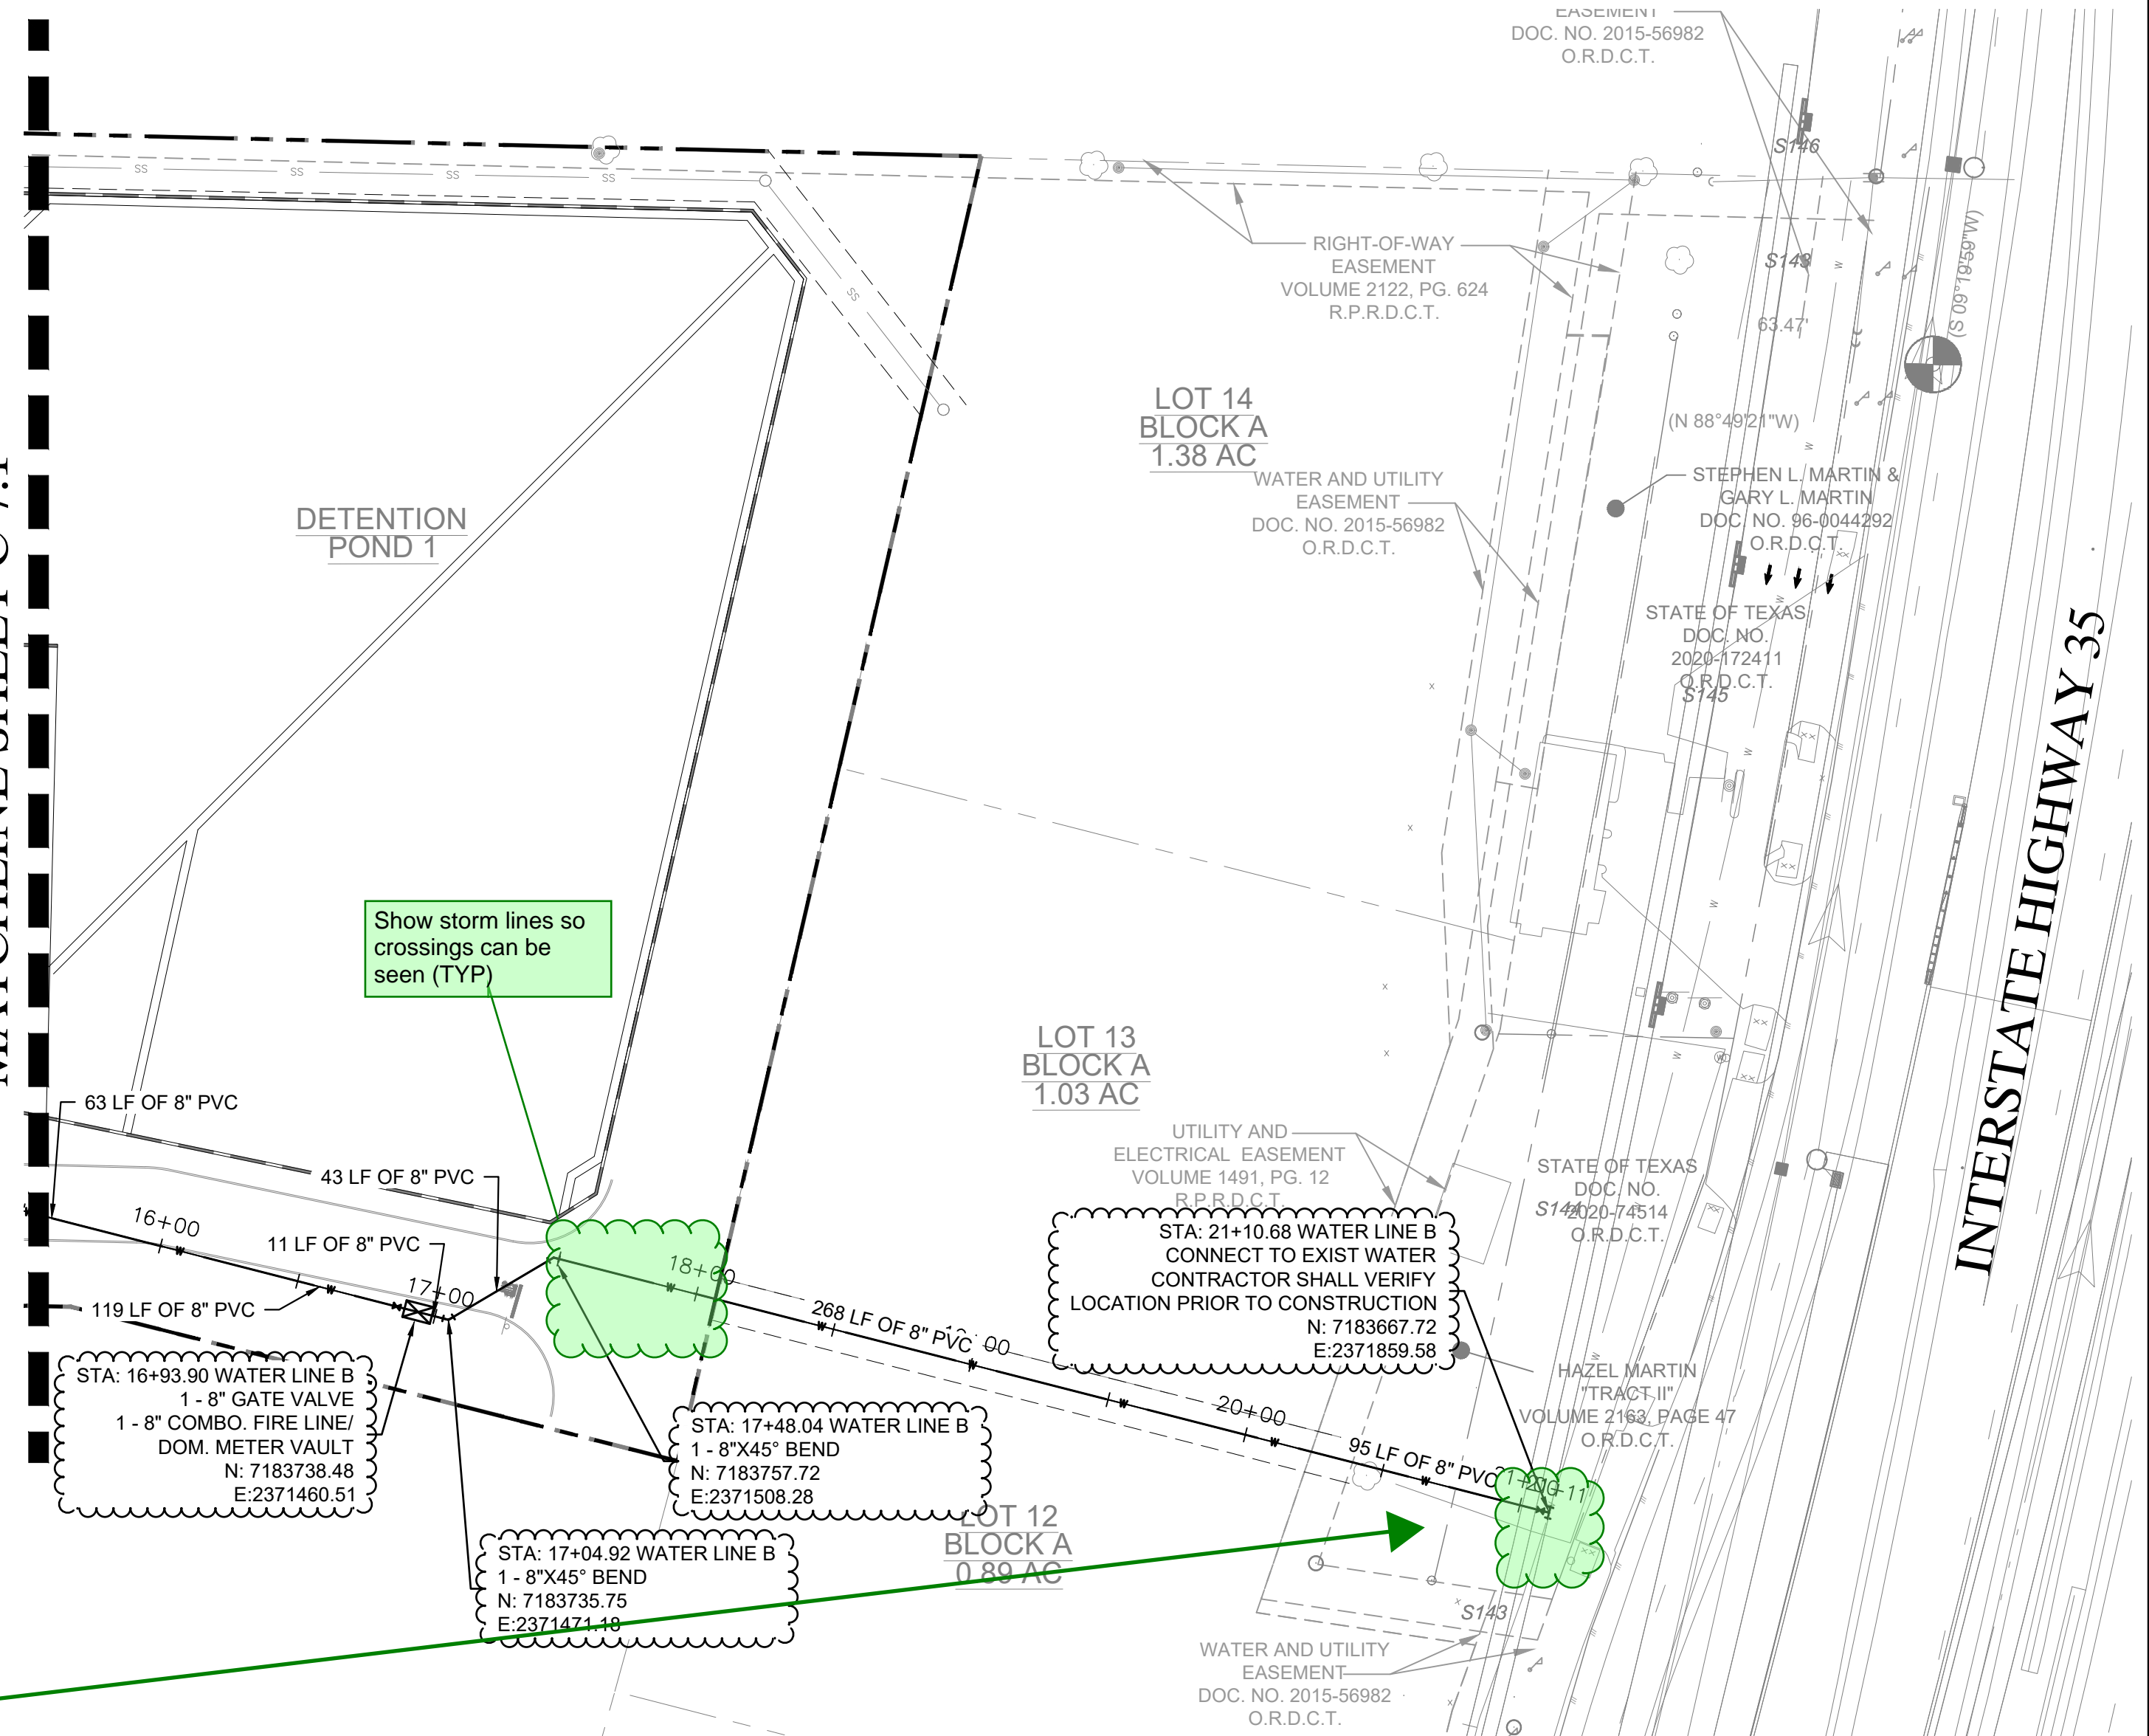

## MATCHLINE SHEET C-7.1



LEGEND	
	EXISTING WATER MAIN
	EXISTING SANITARY SEWER AND MANHOLE
	PROPOSED WATER LINE
	PROPOSED SANITARY SEWER LINE AND CLEAN OUT

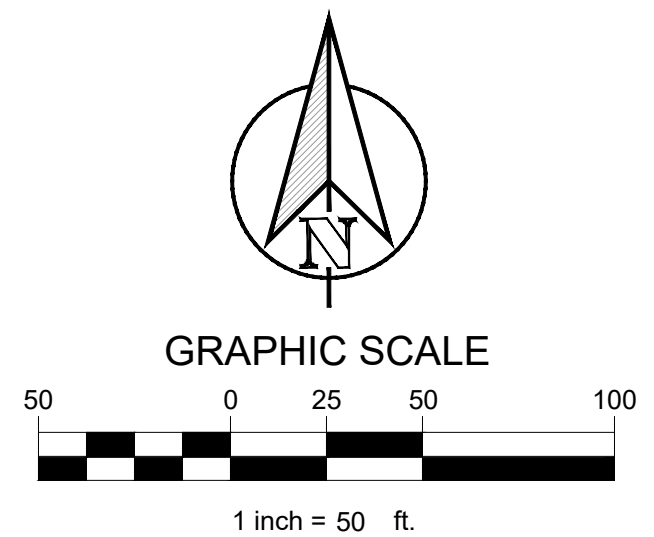


PLOTTED BY: DAN CABALLERO  
 PLOT DATE: 7/17/2024 10:12 AM  
 LOCATION: Z:\PROJECTS\PROJECTS\2022-185 MALOUF SANGER\CADD\SHEETS\MULTI-FAMILY GREYSTAR\C-7.2 WATER PLAN.DWG  
 LAST SAVED: 7/15/2024 9:45 PM




PLOTTED BY: DAN CABALLERO  
 7/17/2024 10:13 AM  
 PLOT DATE: Z:\PROJECTS\PROJECTS\2022-185 MALOUF SANGER\CADD\SHEETS\MULTI-FAMILY GREYSTAR\C-7.2 WATER PLAN.DWG  
 LOCATION: 7/15/2024 9:45 PM  
 LAST SAVED:

WATER LINE A

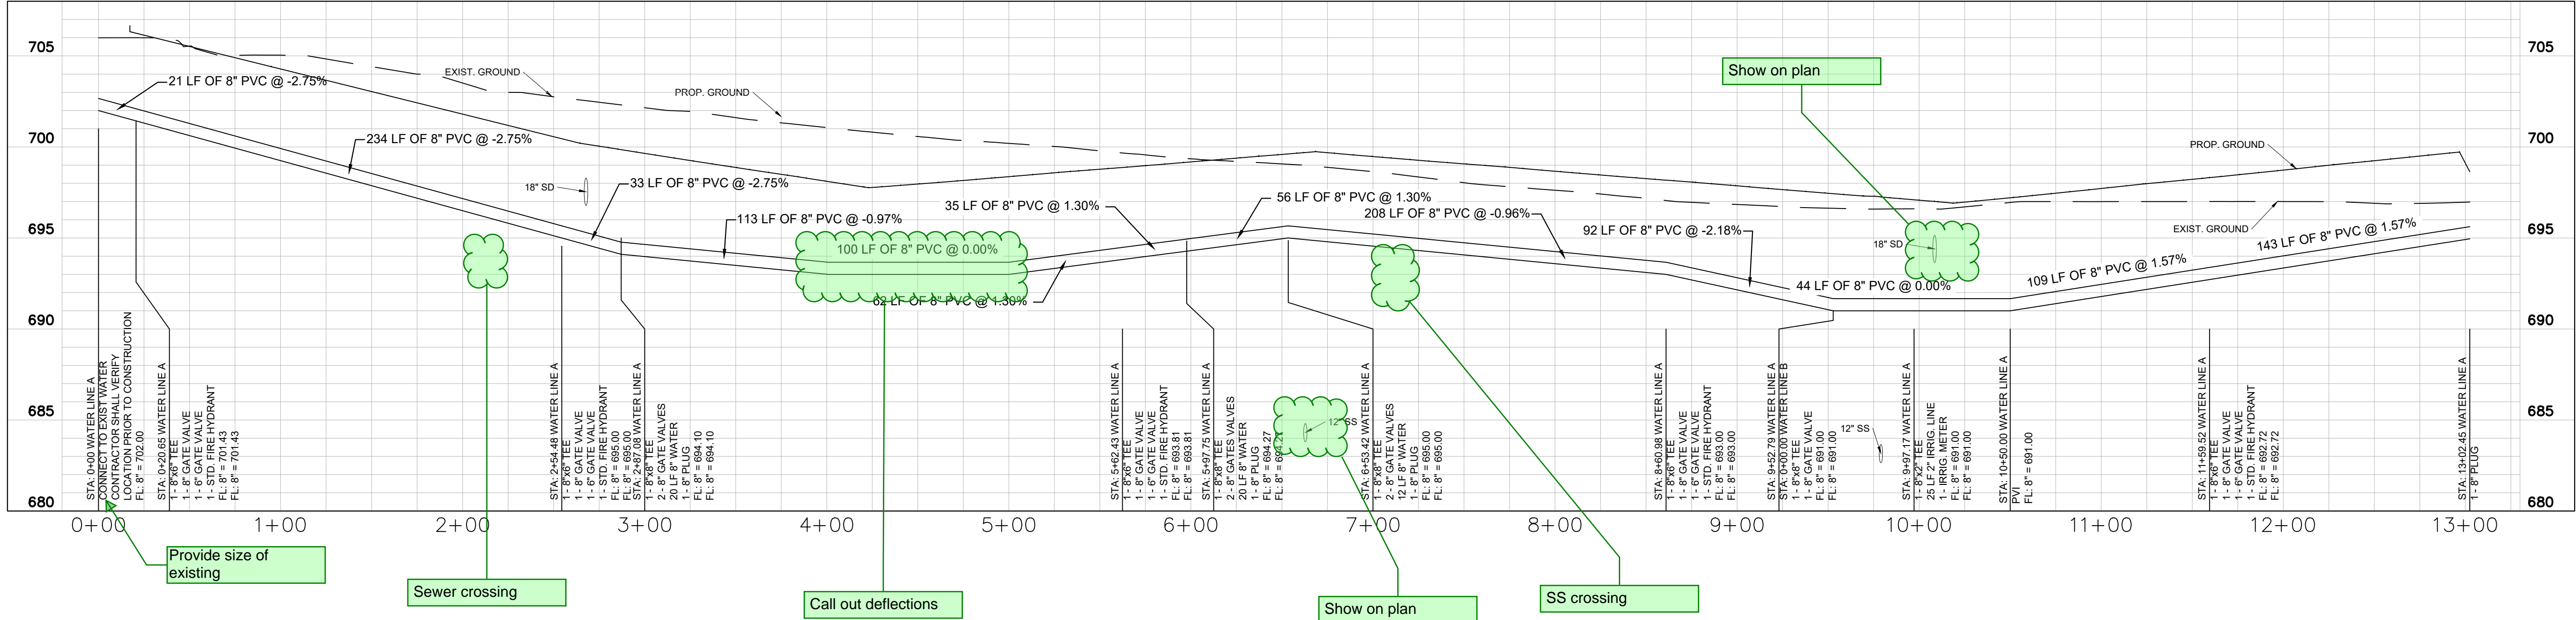


WATER LINE B

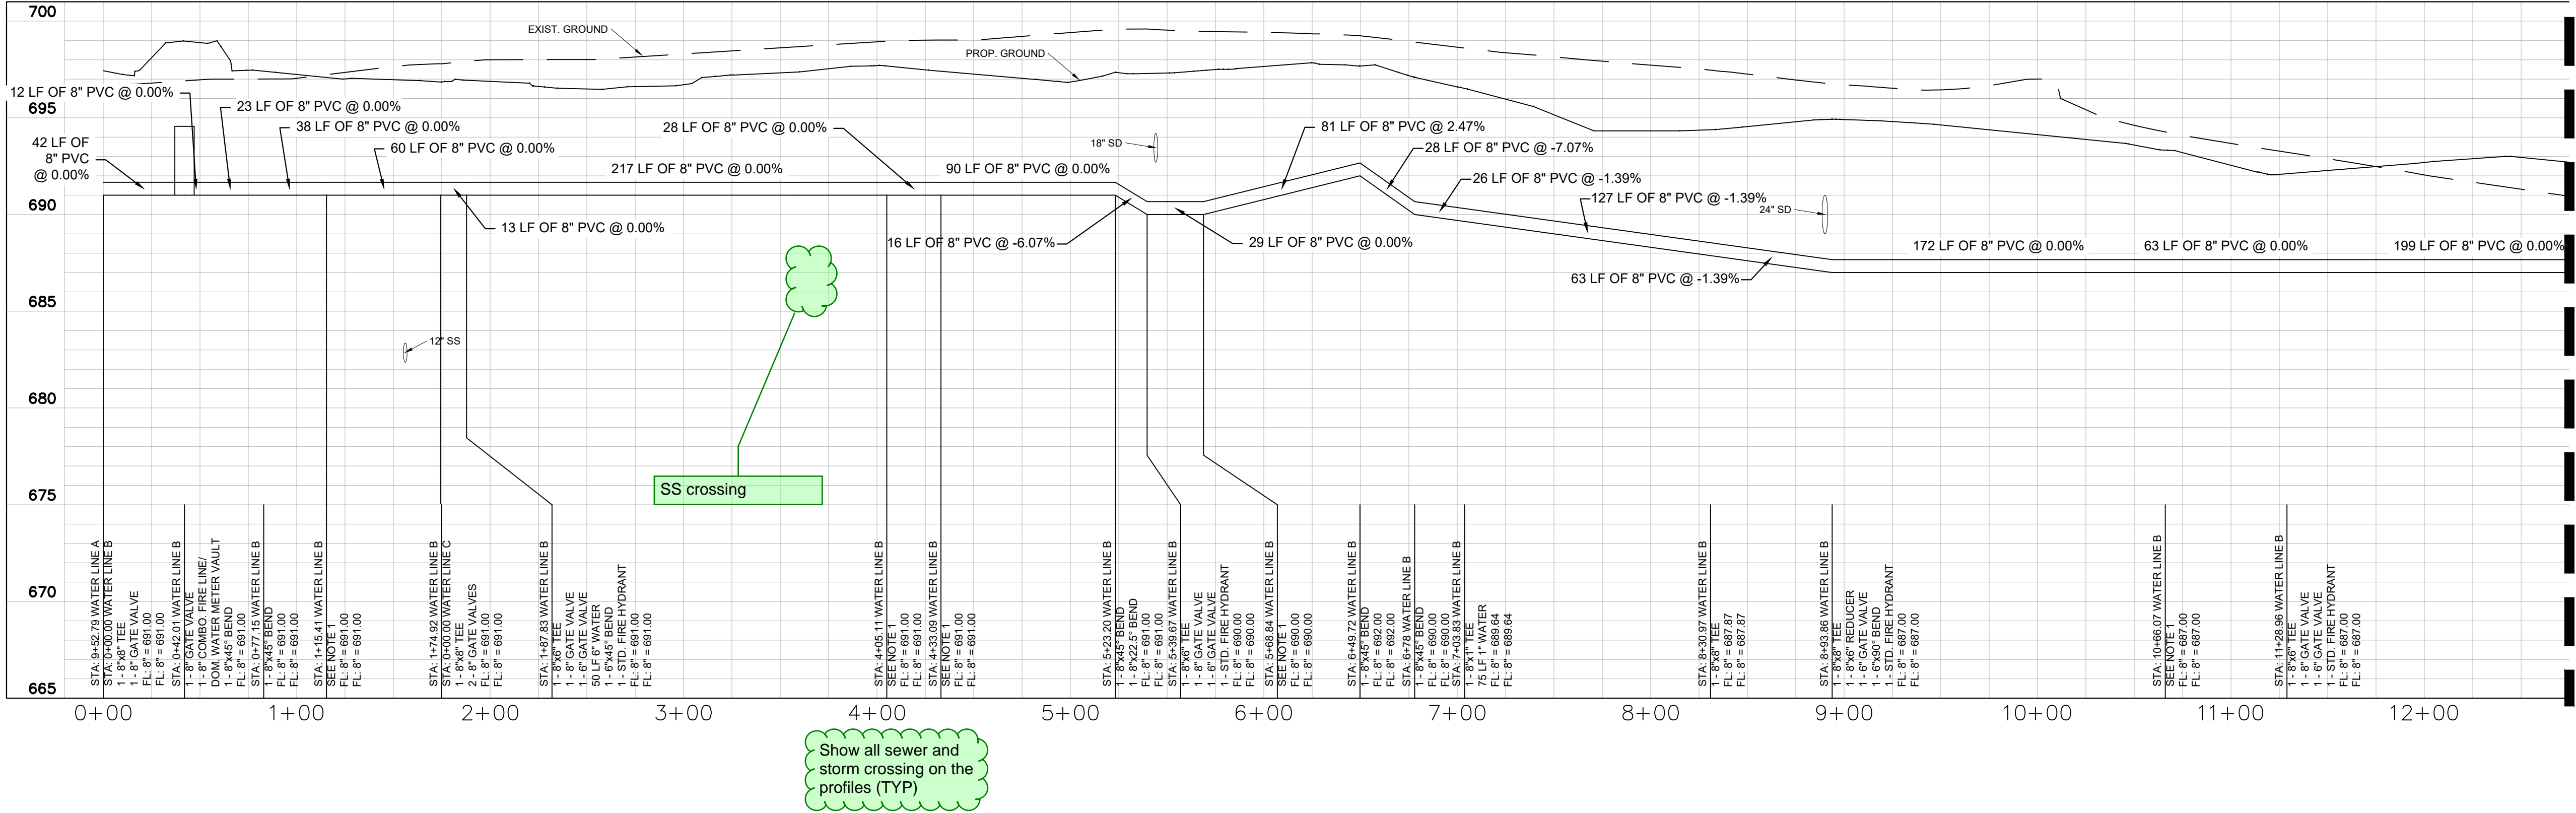

MATCHLINE SHEET C-7.4

NOTE 1:  
1 - 8"x6" TEE  
6" COMBINATION  
SERVICE LINE W/  
FIRE BACKFLOW  
PREVENTION DEVICE  
INTERNAL TO BLDG.  
REFERENCE MEP PLANS

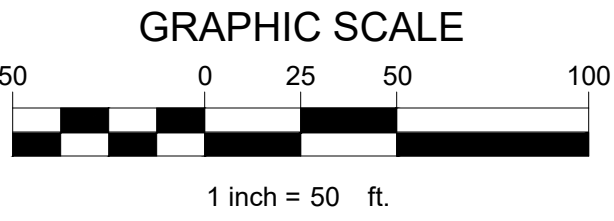

Vertical scale  
missing

TEXAS REGISTRATION #14199  
**CLAYMOORE**  
**ENGINEERING**  
 1903 CENTRAL DRIVE, SUITE #408  
 BEFORD, TX 76021  
 PHONE: 817.281.0572  
 WWW.CLAYMOOREENG.COM

**PRELIMINARY**  
 FOR REVIEW ONLY  
 Not for construction purposes.  
**CLAYMOORE ENGINEERING**  
 ENGINEERING AND PLANNING CONSULTANTS  
 Engineer: **DREW DONOSKY**  
 P.E. No.125651 Date: **7/17/2024**

**SANGER MULTI-FAMILY**  
**PREPARED FOR**  
**GREYSTAR**  
**SANGER, TEXAS**


No.	DATE	REVISION	BY

**WATER PROFILES**  
 DESIGN: ASD  
 DRAWN: DC  
 CHECKED: ASD  
 DATE: 7/17/2024  
 SHEET  
**C-7.3**  
 CASE NO. 2022-185




PLOTTED BY: DAN CABALLERO  
 PLOT DATE: 7/17/2024 10:14 AM  
 LOCATION: Z:\PROJECTS\PROJECTS\2022-185 MALOUF SANGER\CADD\SHEETS\MULTI-FAMILY GREYSTAR\C-7.2 WATER PLAN.DWG  
 LAST SAVED: 7/15/2024 9:45 PM

MATCHLINE STA. 12+50

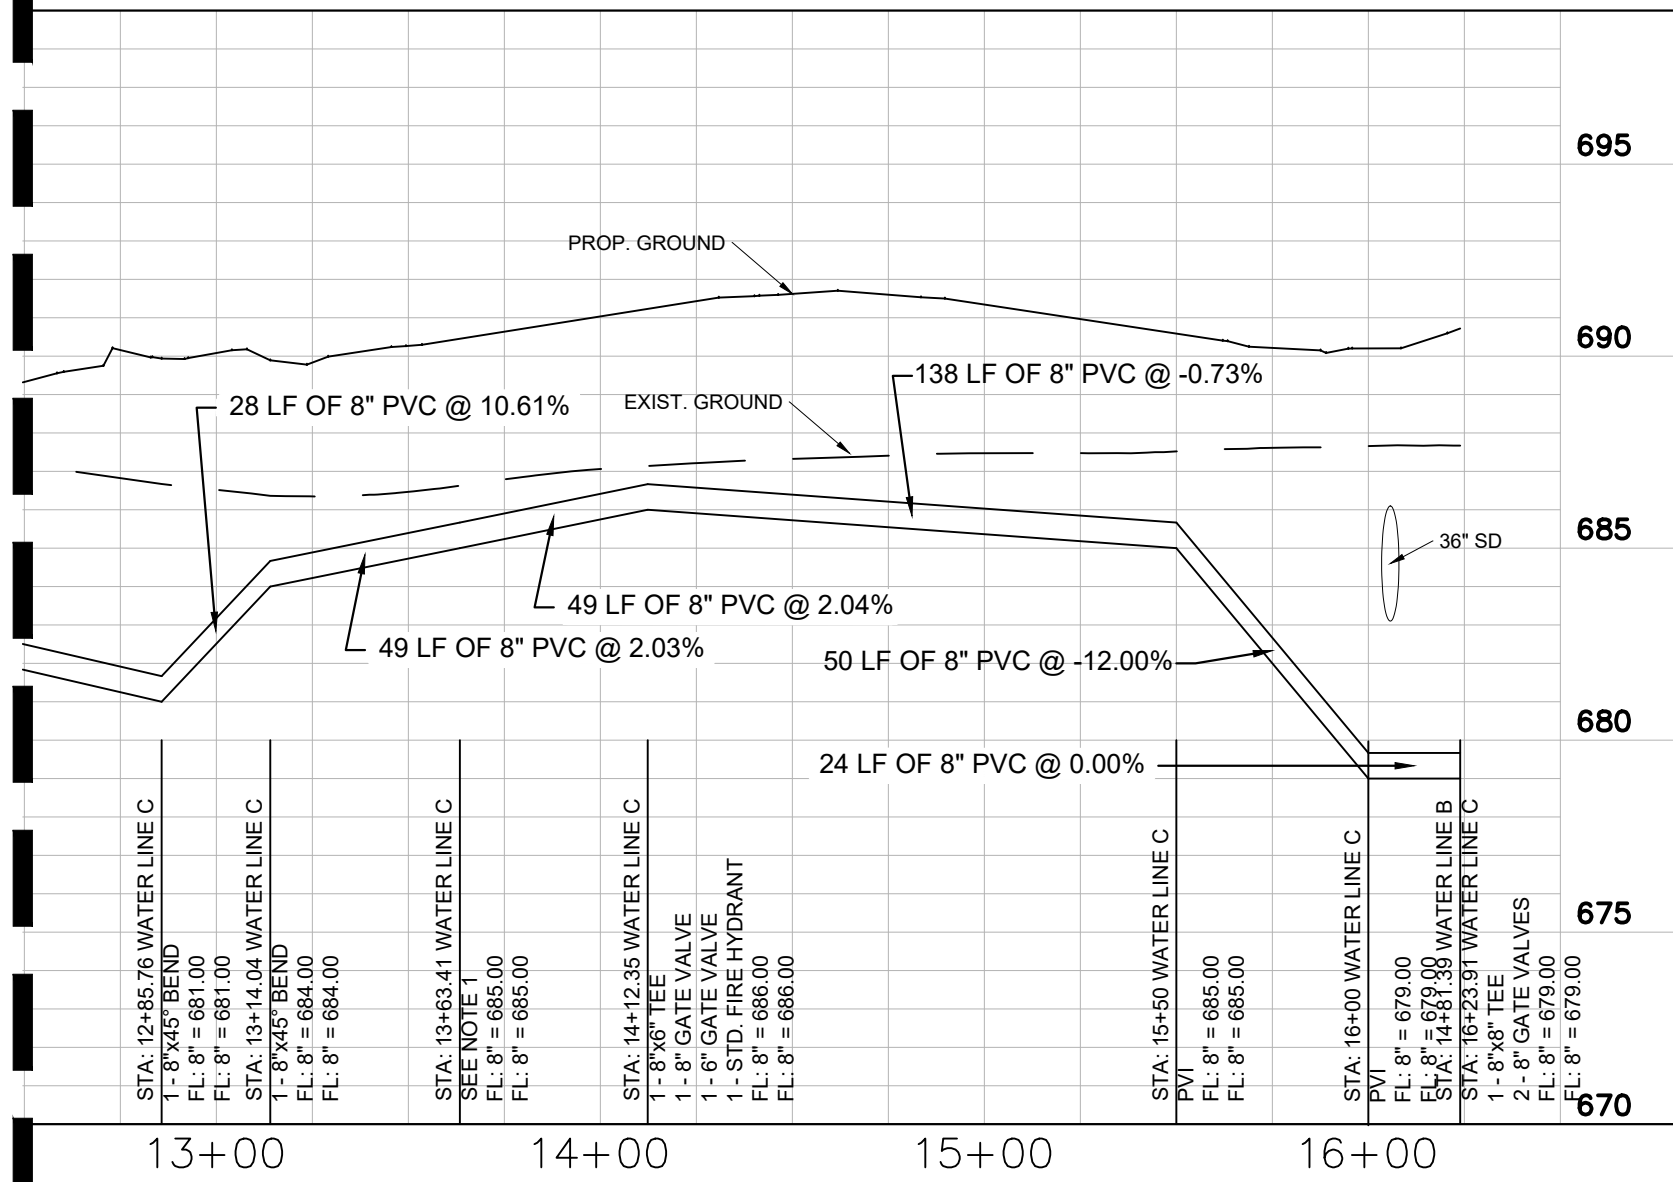


WATER LINE C

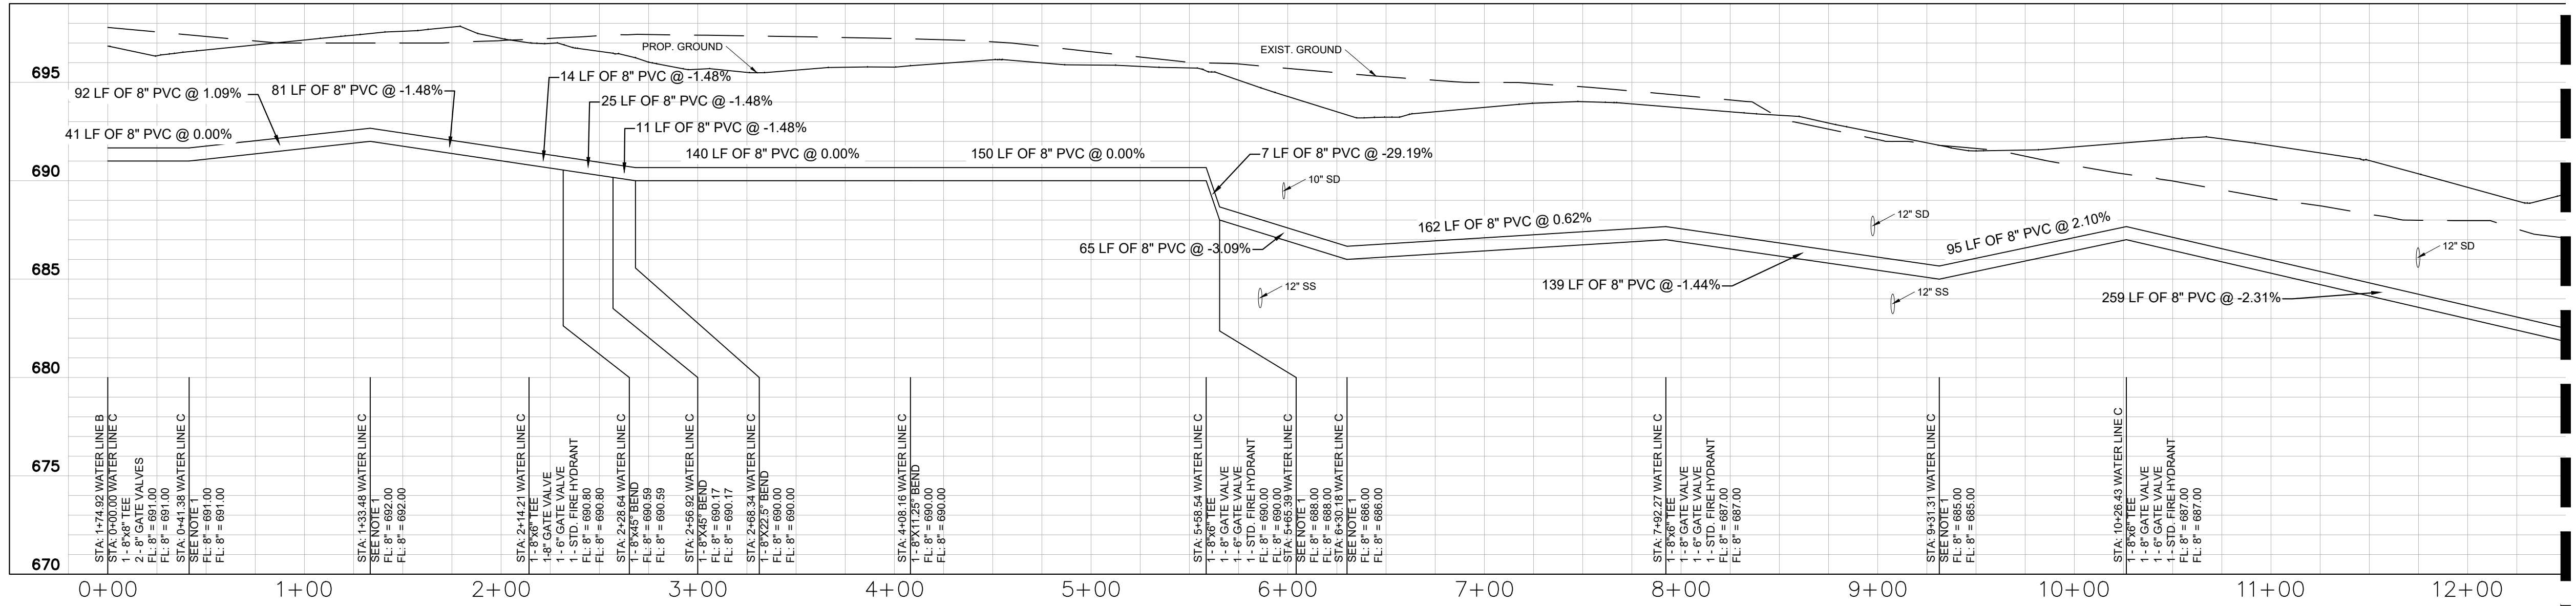


MATCHLINE STA. 12+50

MATCHLINE SHEET C-7.3

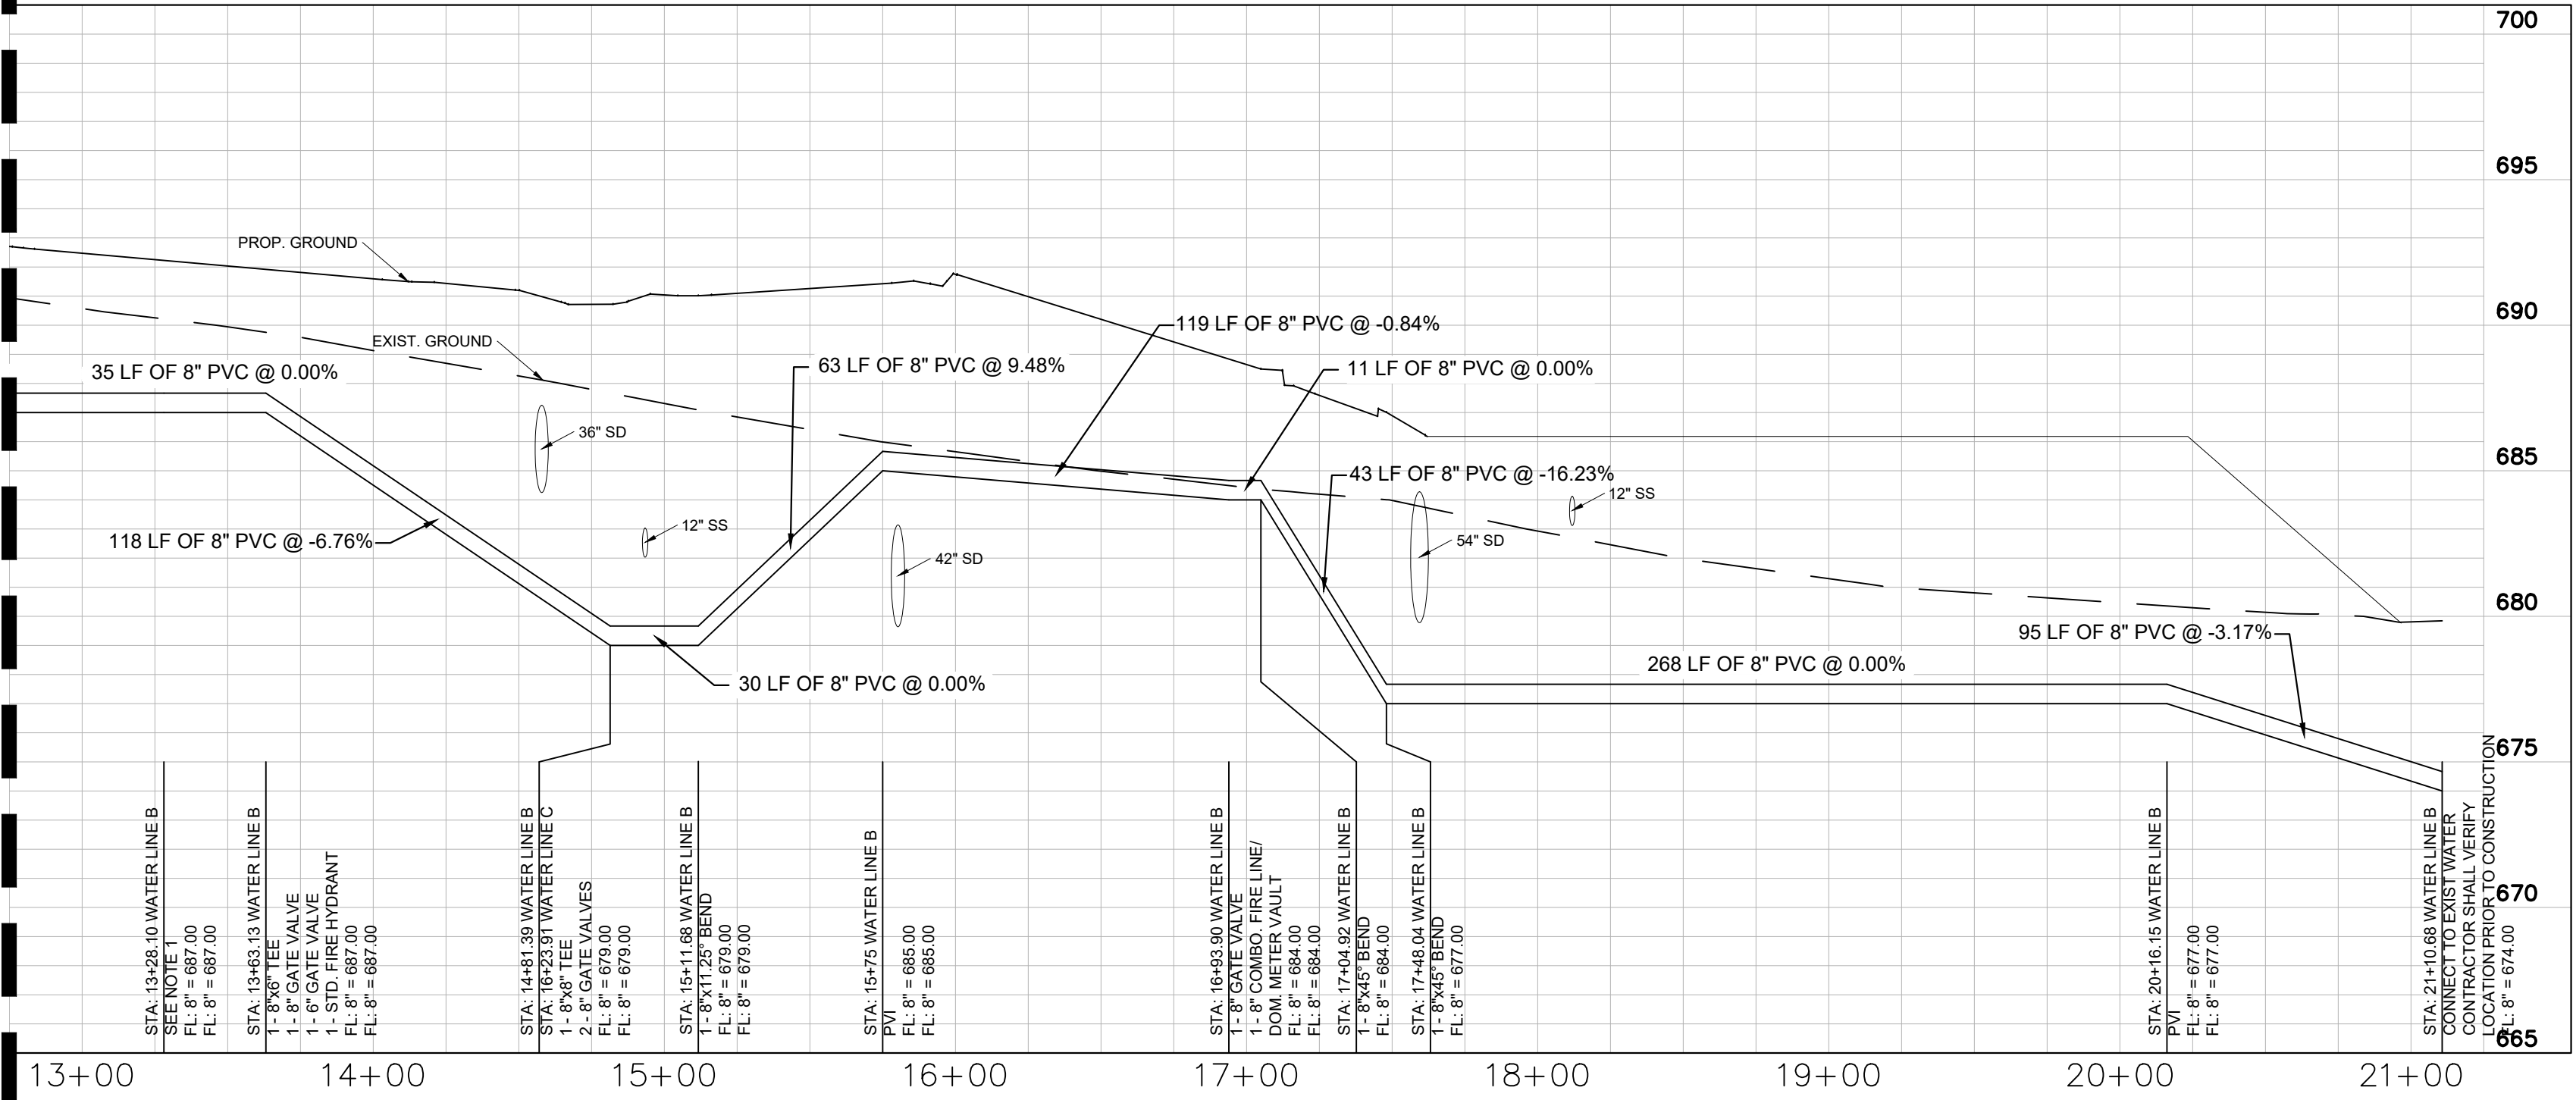

NOTE 1:  
1 - 8"x6" TEE  
6" COMBINATION  
SERVICE LINE W/  
FIRE BACKFLOW  
PREVENTION DEVICE  
INTERNAL TO BLDG.  
REFERENCE MEP PLANS

Vertical scale  
missing

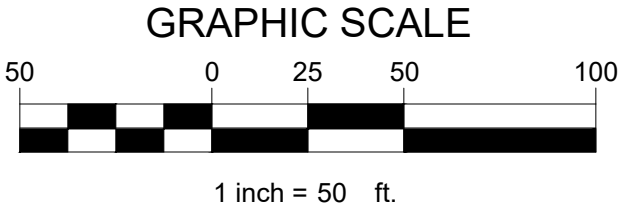

**PRELIMINARY**  
 FOR REVIEW ONLY  
 Not for construction purposes.  
**CLAYMOORE ENGINEERING**  
 ENGINEERING AND PLANNING CONSULTANTS  
 Engineer: **DREW DONOSKY**  
 P.E. No.125651 Date: 7/17/2024


**SANGER MULTI-FAMILY**  
**PREPARED FOR**  
**GREYSTAR**  
**SANGER, TEXAS**

No.	DATE	REVISION	BY

WATER PROFILES




PLOTTED BY: DAN CABALLERO  
PLOT DATE: 7/17/2024 10:15 AM  
LOCATION: Z:\PROJECTS\PROJECTS\2022-185 MALOUF SANGER\CADD\SHEETS\MULTI-FAMILY GREYSTAR\C-7.9 SANITARY SEWER PROFILES.DWG  
LAST SAVED: 7/17/2024 9:46 AM

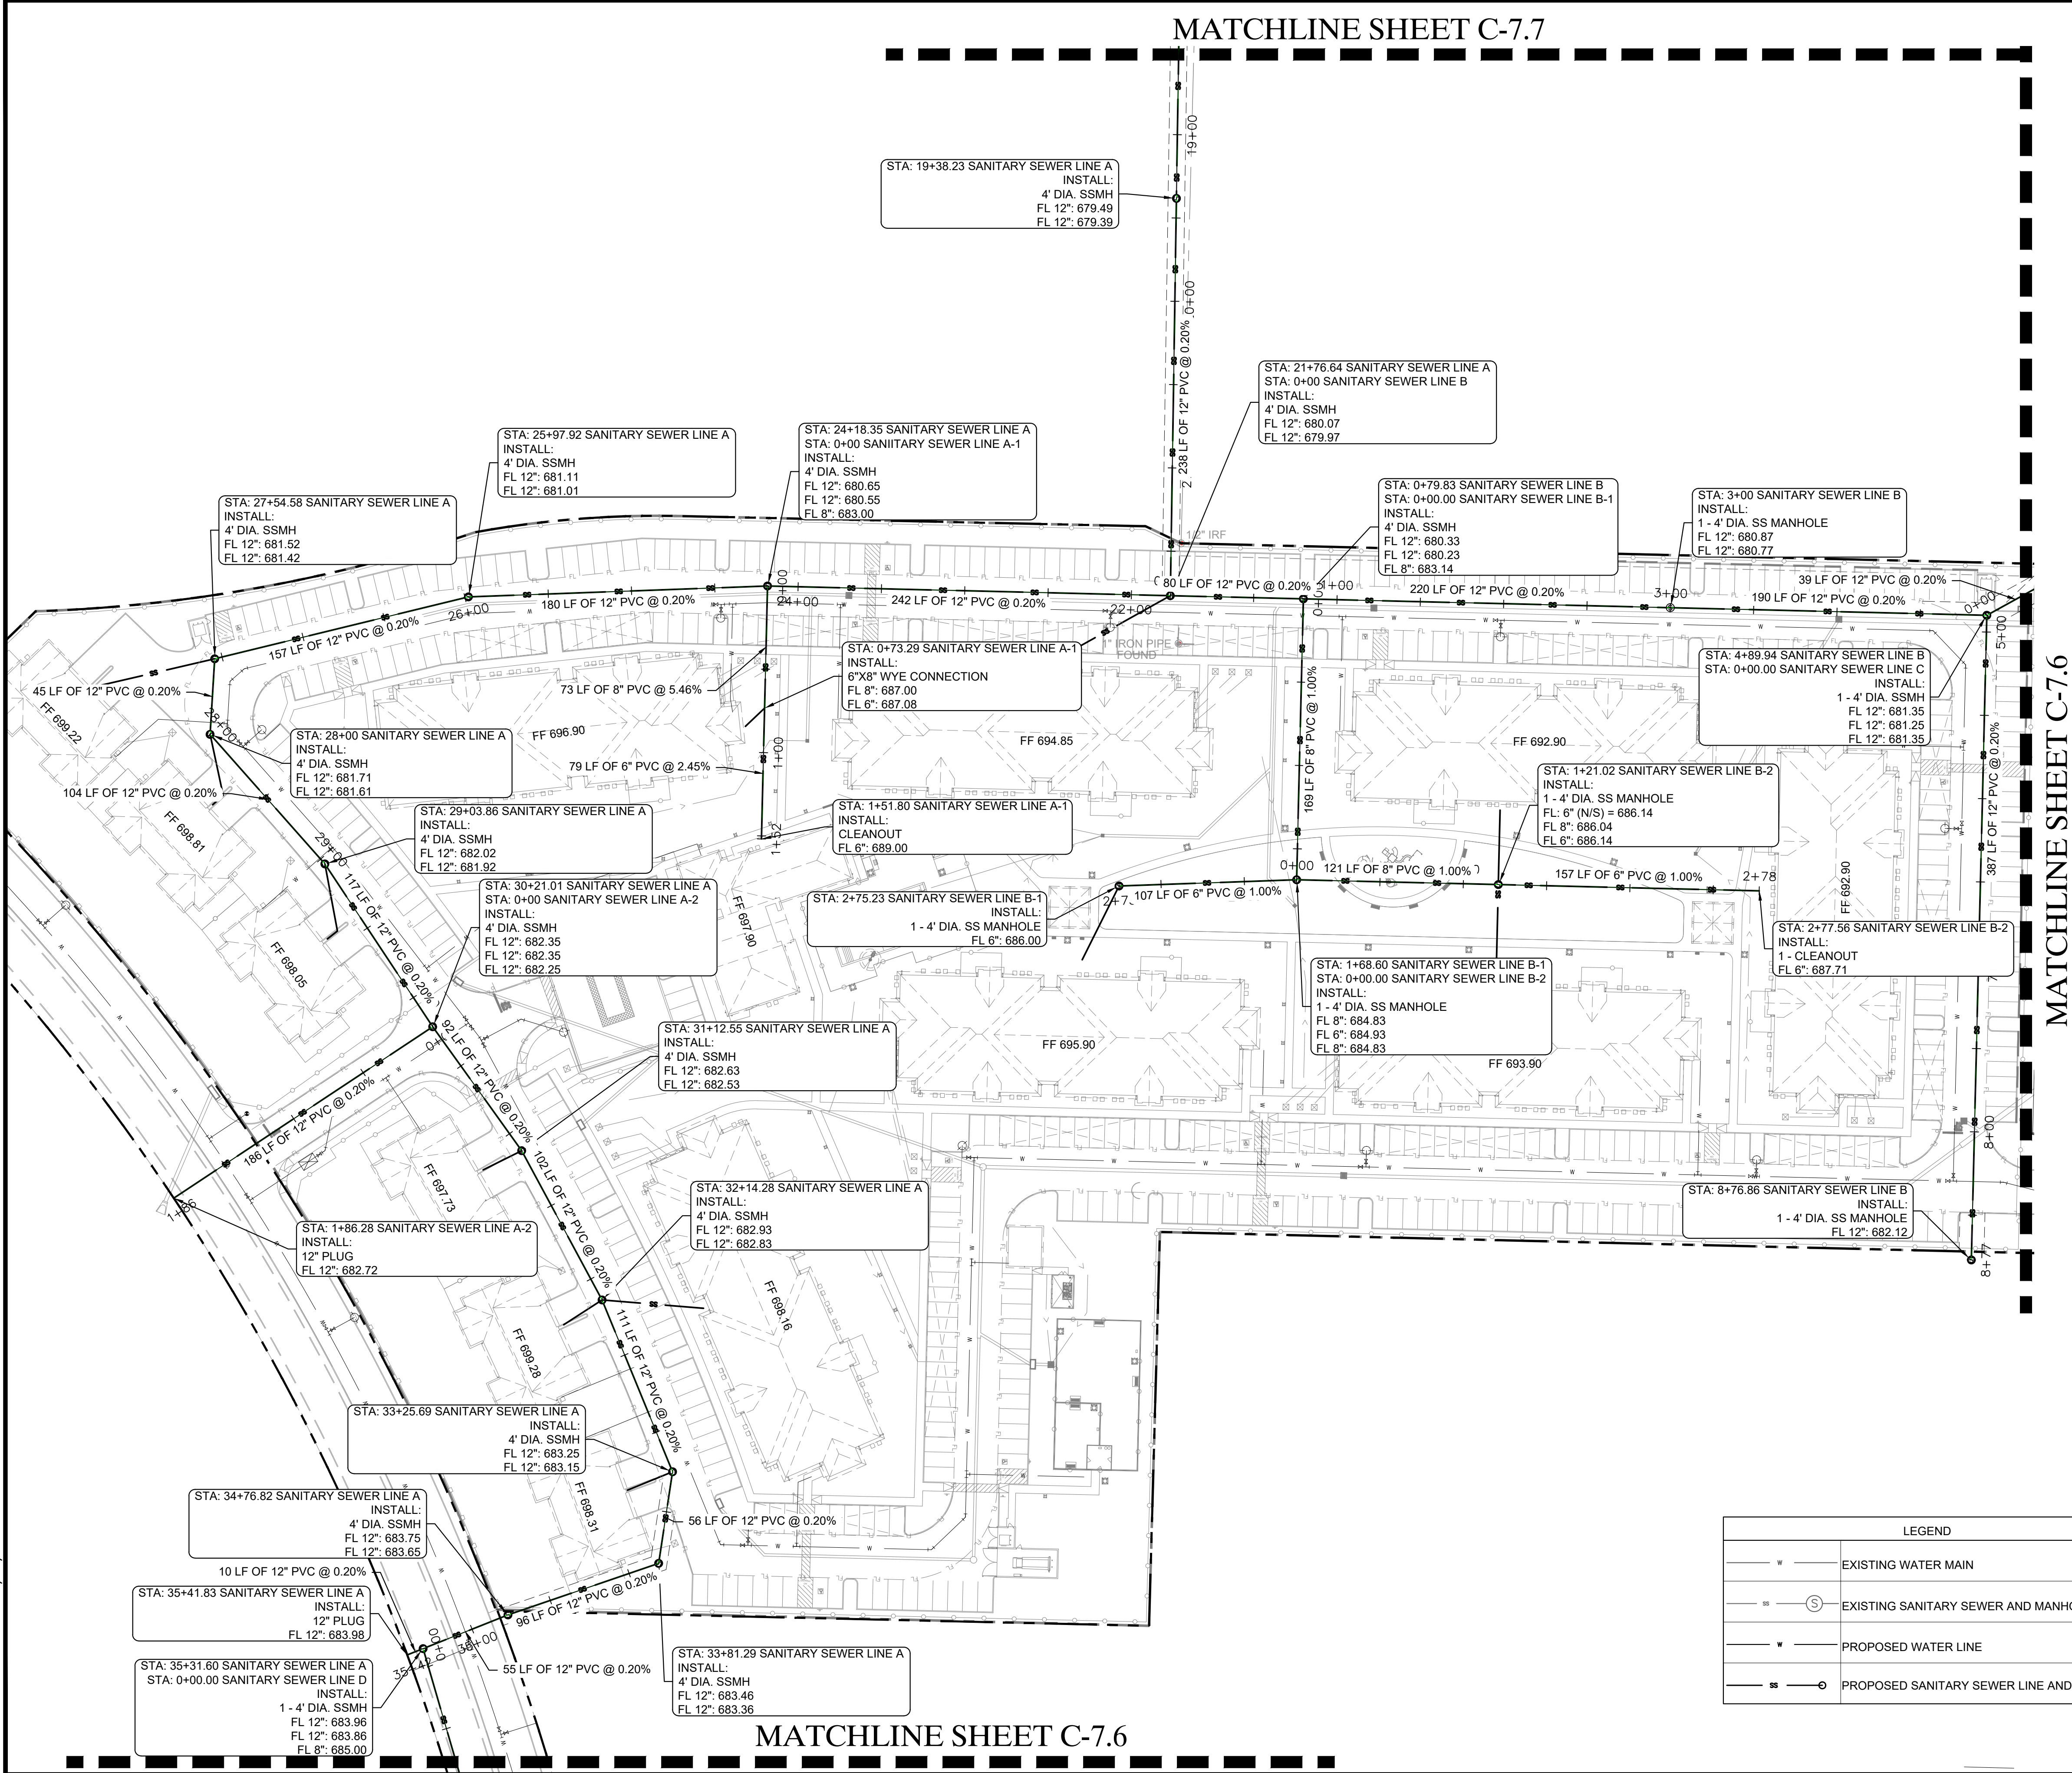

MATCHLINE SHEET C-7.6

LEGEND	
	EXISTING WATER MAIN
	EXISTING SANITARY SEWER AND MANHOLE
	PROPOSED WATER LINE
	PROPOSED SANITARY SEWER LINE AND CLEANOUT

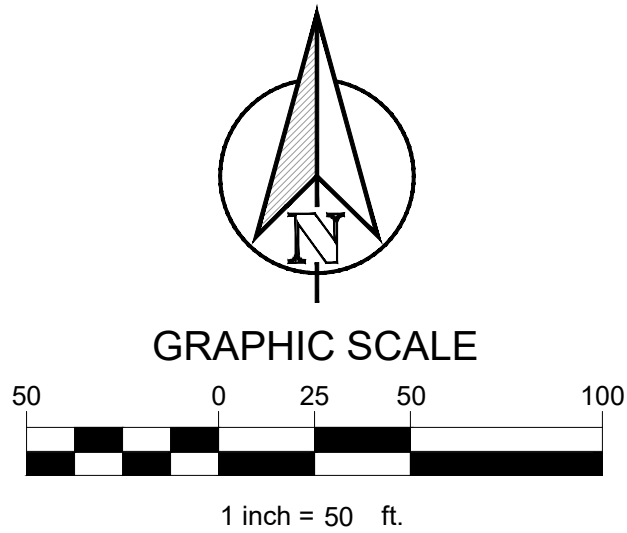

NO.	DATE	REVISION	BY





[illegible]

A north arrow pointing upwards, with a circle around it and the letter 'N' inside. Below the arrow is a graphic scale bar with alternating black and white segments. The scale is marked with 50, 0, 25, 50, and 100. Below the scale bar, it says "1 inch = 50 ft."



PLOTTED BY: DAN CABALLERO  
 PLOT DATE: 7/17/2024 10:16 AM  
 LOCATION: Z:\PROJECTS\PROJECTS\2022-185 MALOUF SANGER\CADD\SHEETS\MULTI-FAMILY GREYSTAR\C-7.9 SANITARY SEWER PROFILES.DWG  
 LAST SAVED: 7/17/2024 9:46 AM

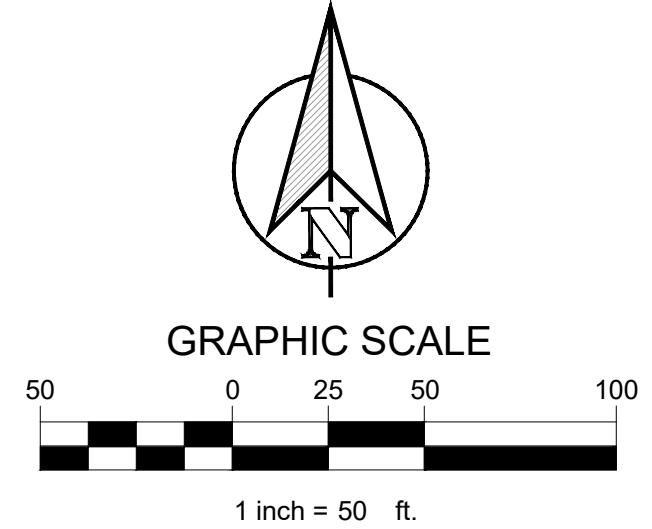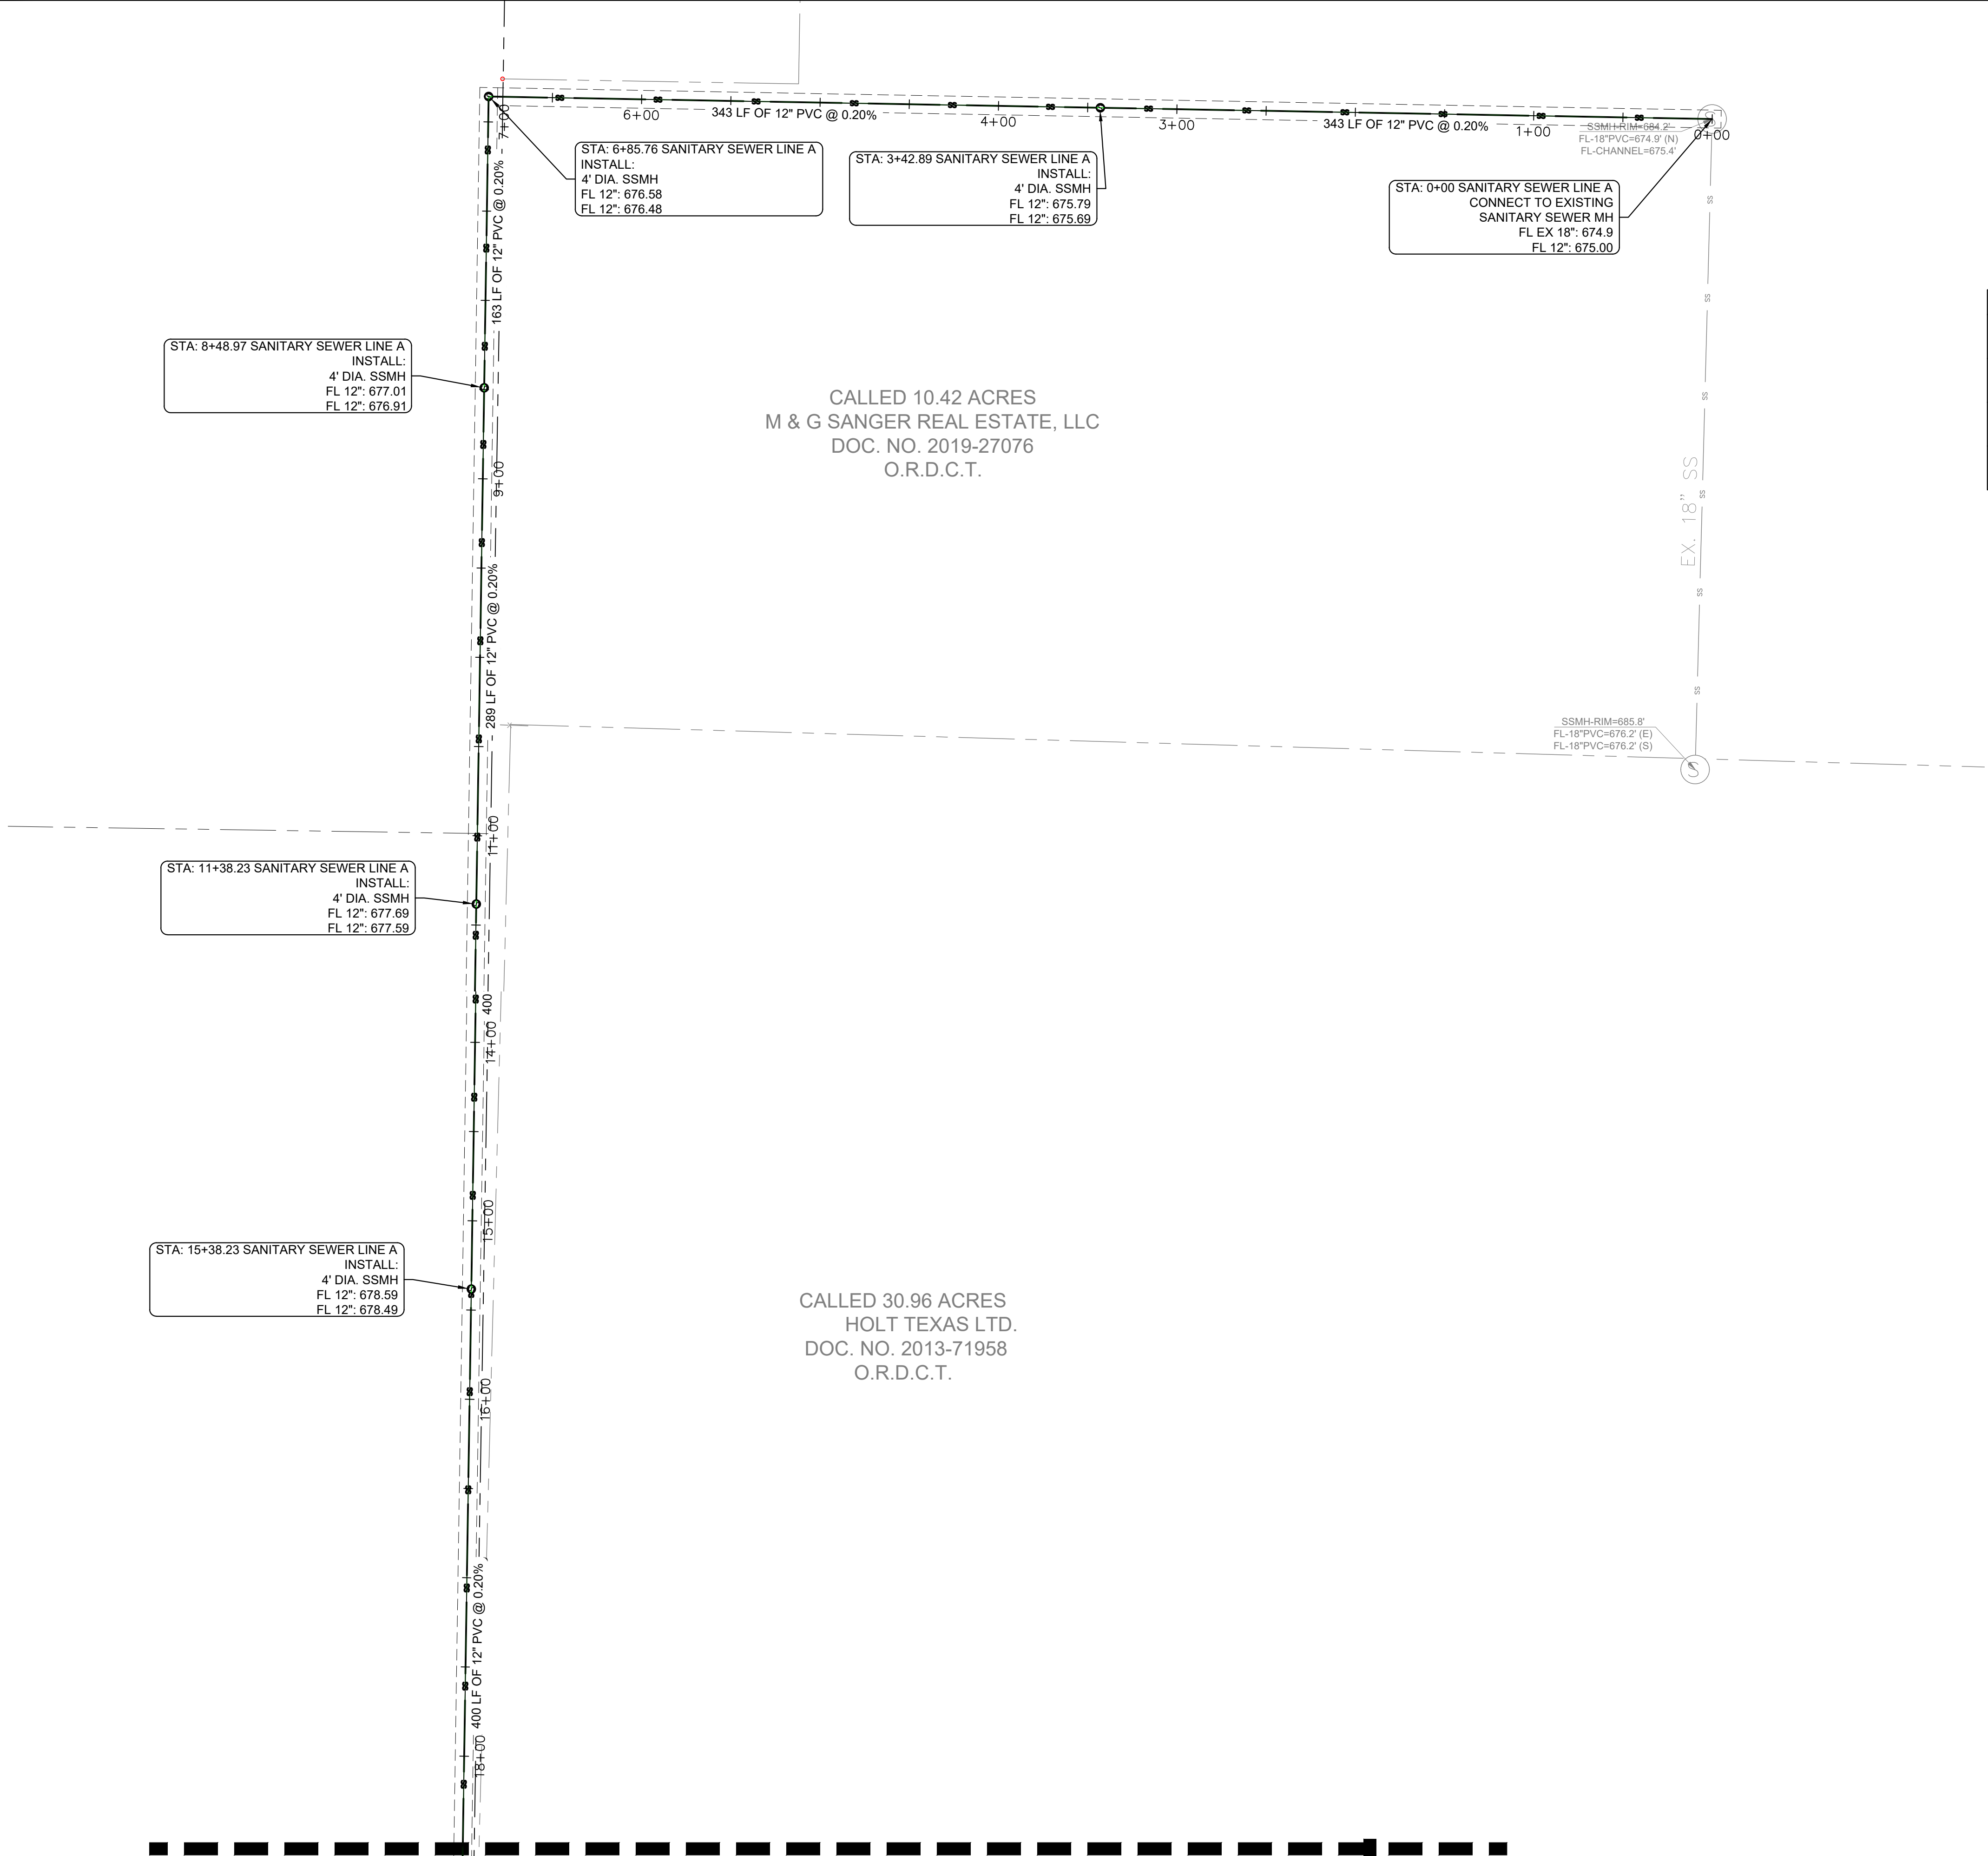

LEGEND	
	EXISTING WATER MAIN
	EXISTING SANITARY SEWER AND MANHOLE
	PROPOSED WATER LINE
	PROPOSED SANITARY SEWER LINE AND CLEAN OUT

TEXAS REGISTRATION #141199  
  
 1903 CENTRAL DRIVE, SUITE #408  
 BEFORD, TX 76001  
 PHONE 817.281.0572  
 WWW.CLAYMOOREENG.COM

**PRELIMINARY**  
 FOR REVIEW ONLY  
 Not for construction purposes.  
**CLAYMOORE ENGINEERING**  
 ENGINEERING AND PLANNING CONSULTANTS  
 Engineer: DREW DONOSKY  
 P.E. No.125651 Date 7/17/2024

SANGER MULTI-FAMILY  
 PREPARED FOR  
 GREYSTAR  
 SANGER, TEXAS

No.	DATE	REVISION	BY


OFFSITE SANITARY SEWER PLAN

DESIGN:	ASD
DRAWN:	DC
CHECKED:	ASD
DATE:	7/17/2024
SHEET	
C-7.9	
CASE NO.	2022-185

MATCHLINE SHEET C-7.5



PLOTTED BY: DAN CABALLERO  
PLOT DATE: 7/17/2024 10:16 AM  
LOCATION: Z:\PROJECTS\PROJECTS\2022-185 MALOUF SANGER\CADD\SHEETS\MULTI-FAMILY GREYSTAR\C-7.9 SANITARY SEWER PROFILES.DWG  
LAST SAVED: 7/17/2024 9:46 AM

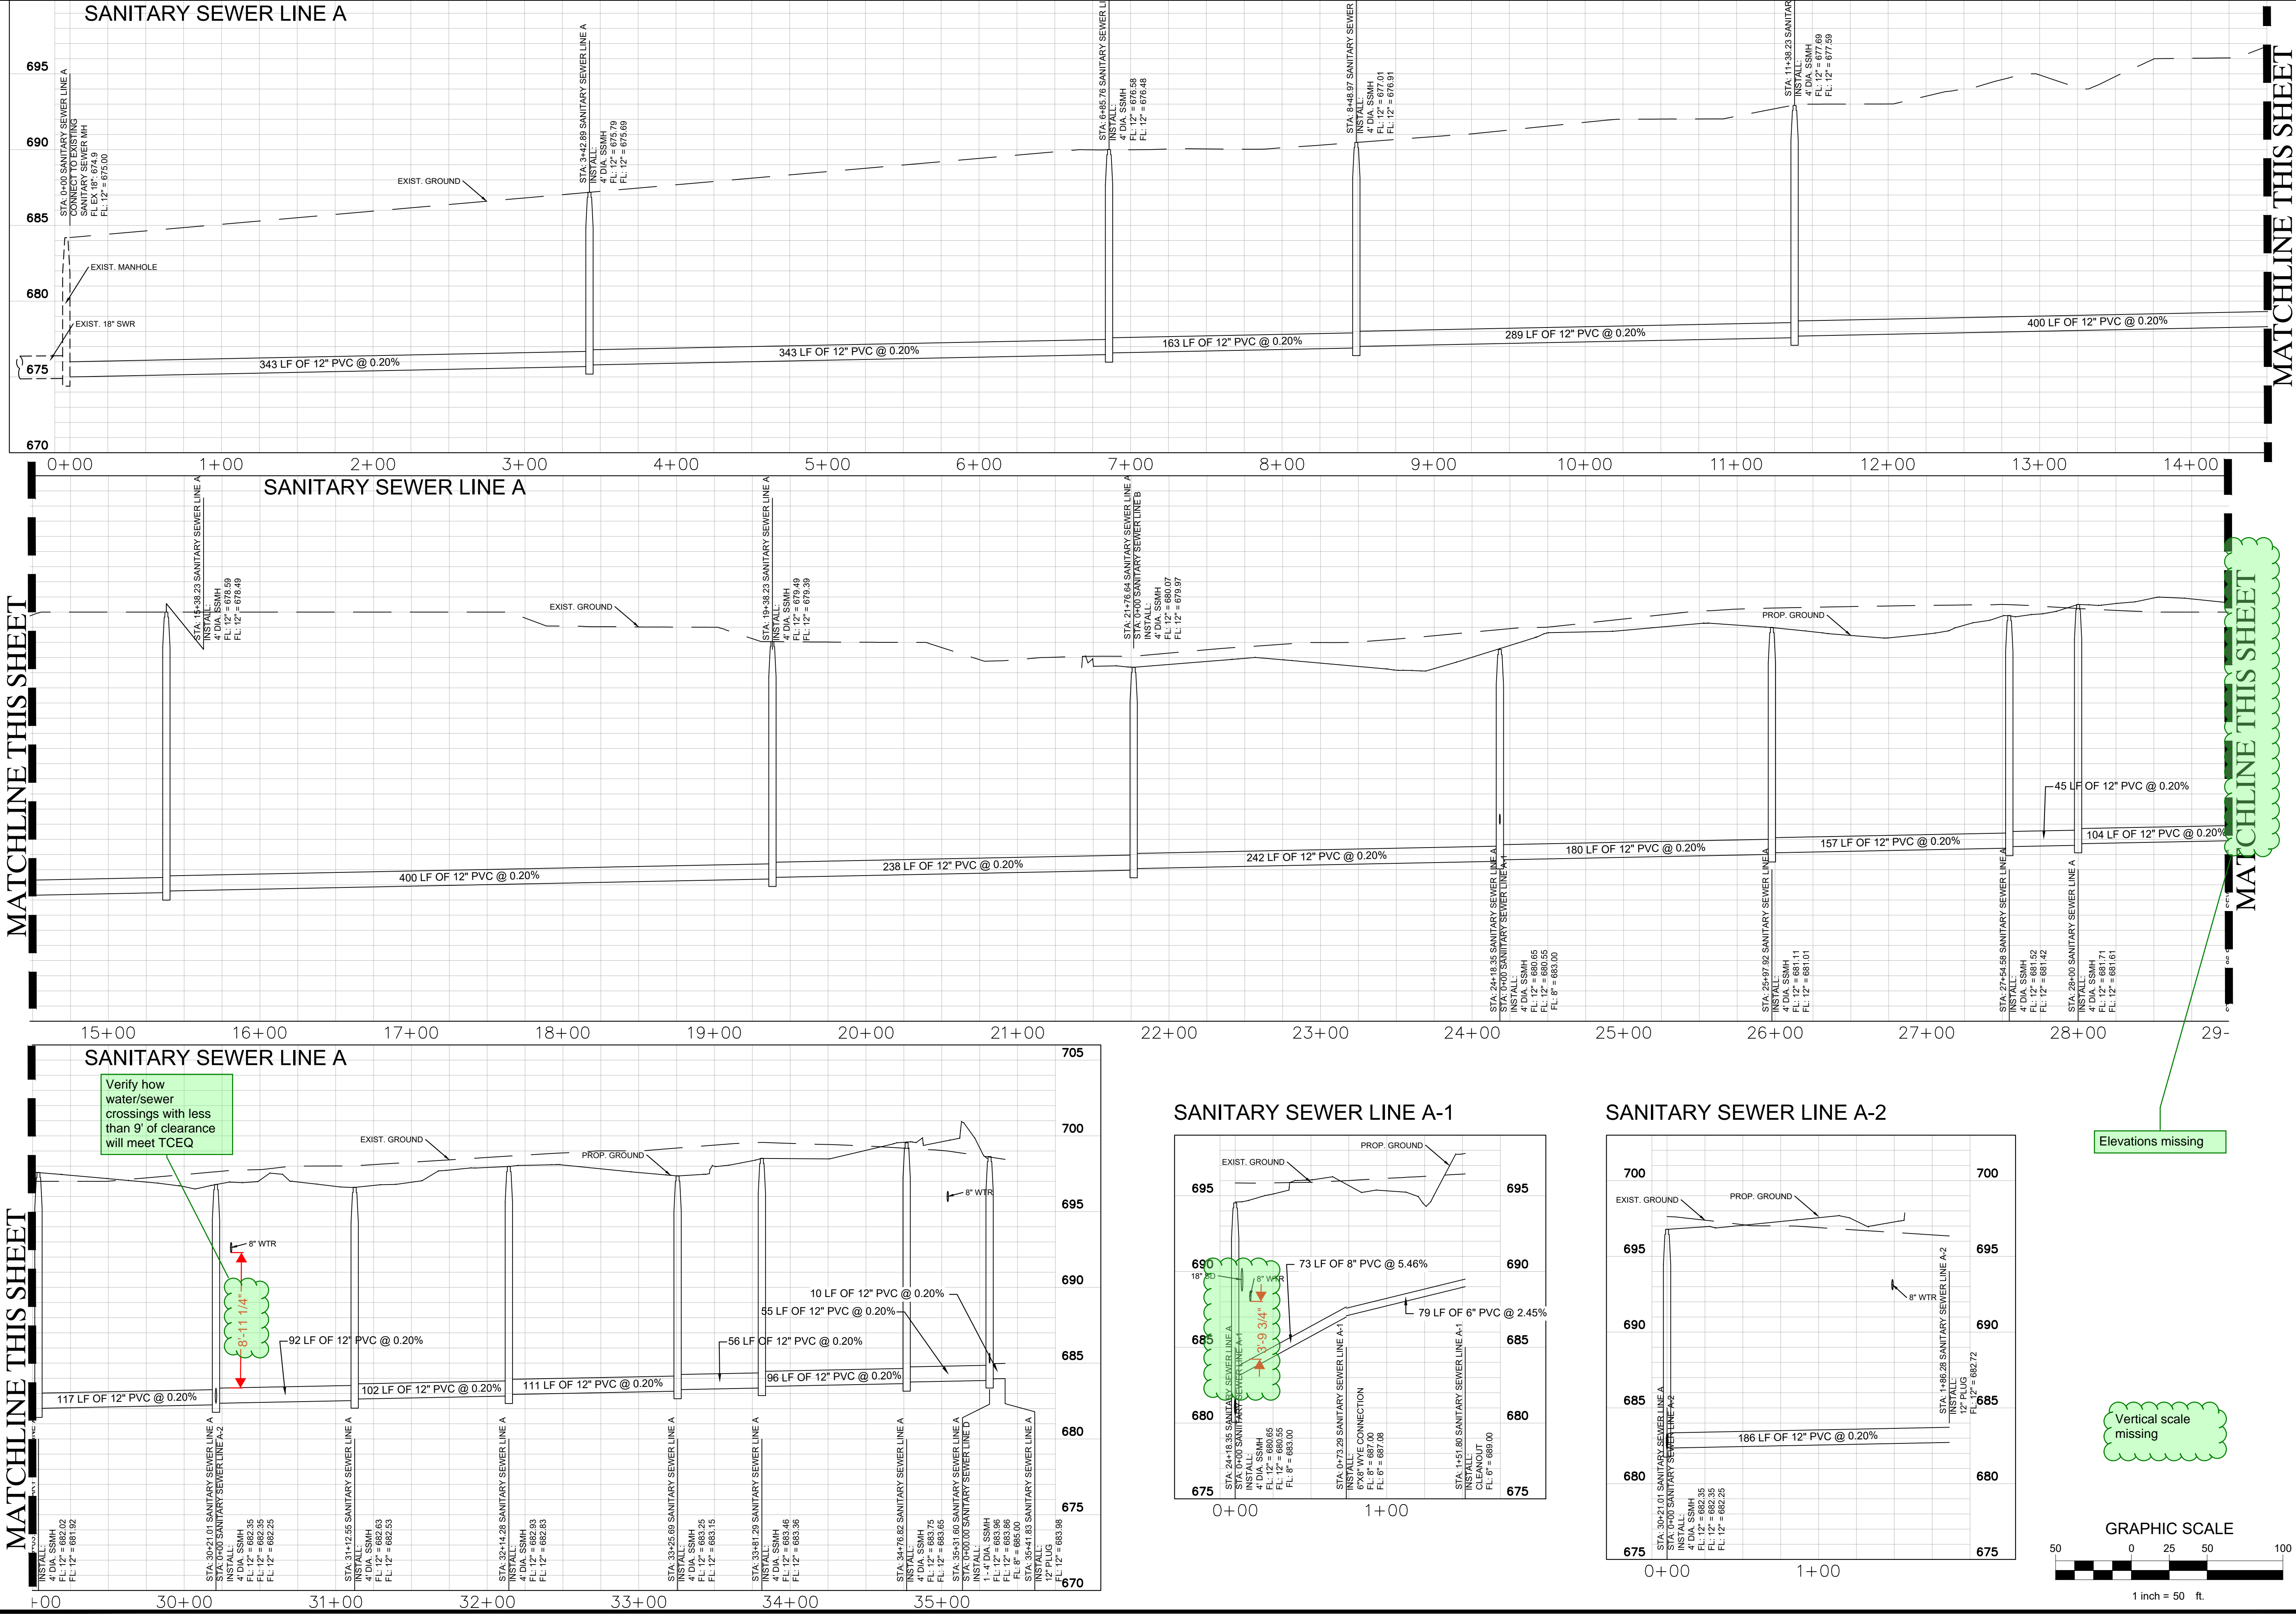


No.	DATE	REVISION	BY




PLOTTED BY: DAN CABALLERO  
 PLOT DATE: 7/17/2024 10:16 AM  
 LOCATION: Z:\PROJECTS\PROJECTS\2022-185 MALOUF SANGER\CADD\SHEETS\MULTI-FAMILY GREYSTAR\C-7.9 SANITARY SEWER PROFILES.DWG  
 LAST SAVED: 7/17/2024 9:46 AM

SANITARY SEWER LINE B

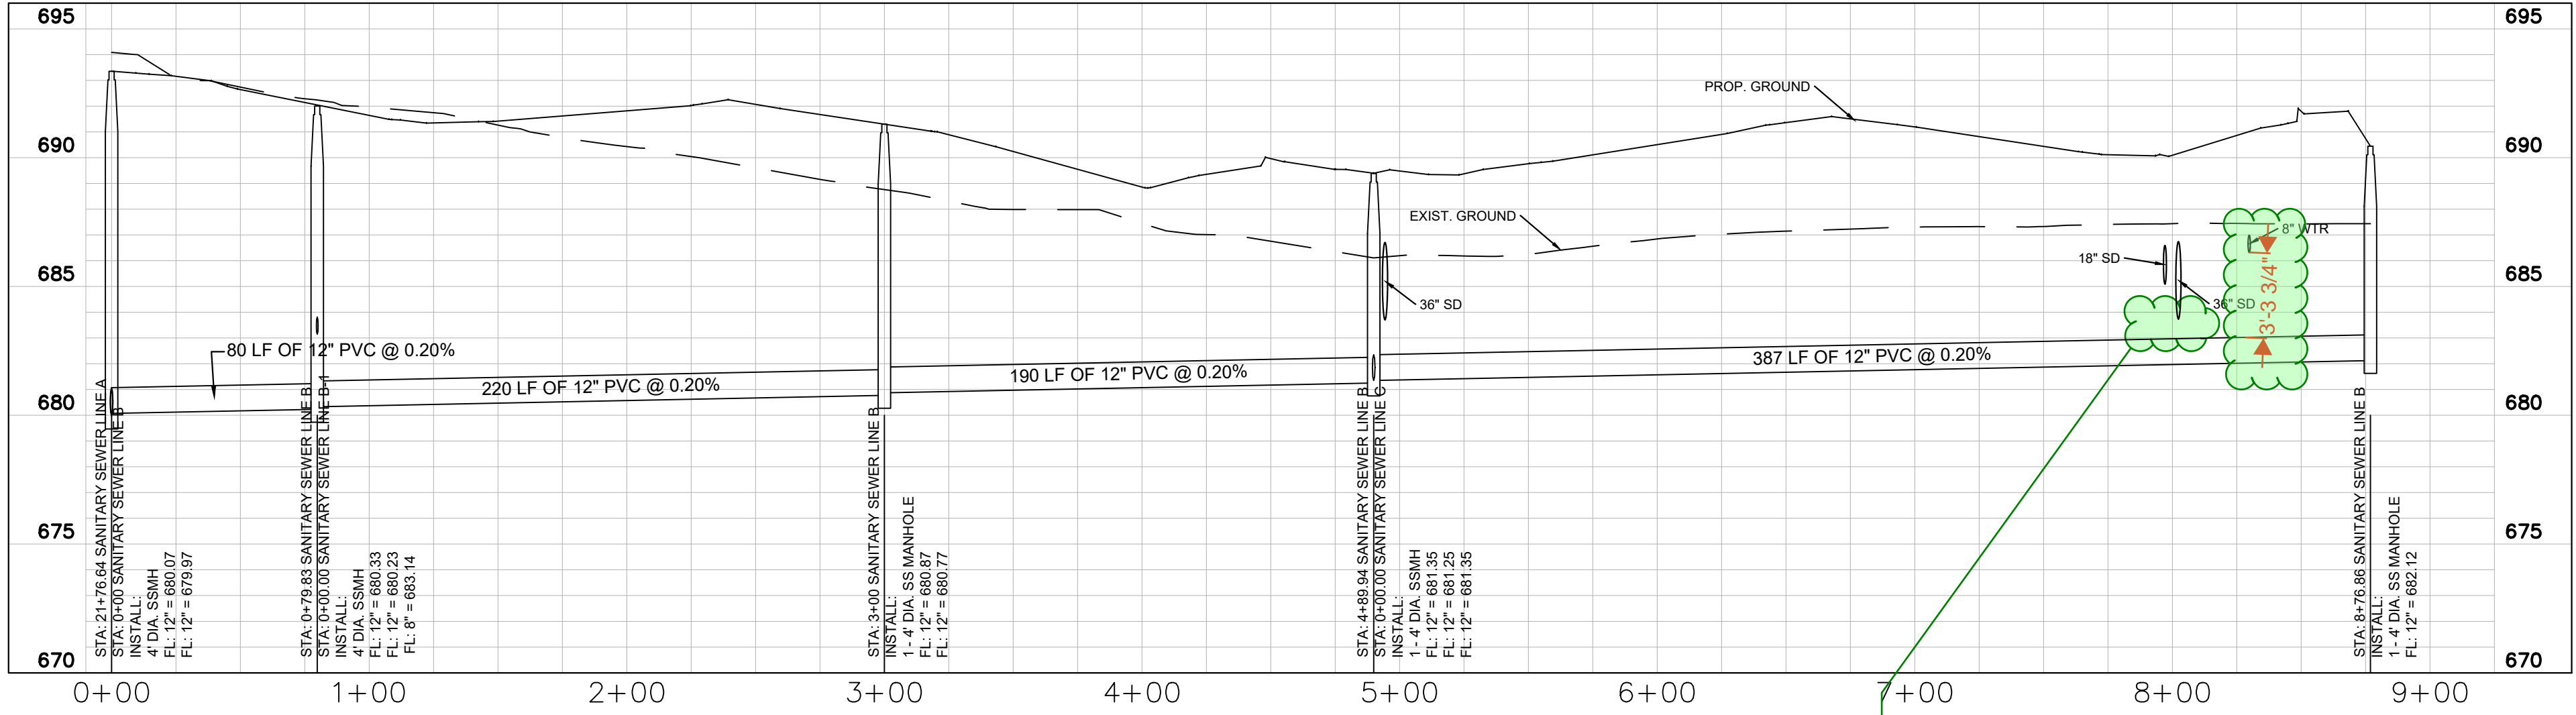


Min 2' desired. show how pipe will be properly protected with the storm install (TYP)

SANITARY SEWER LINE B-2

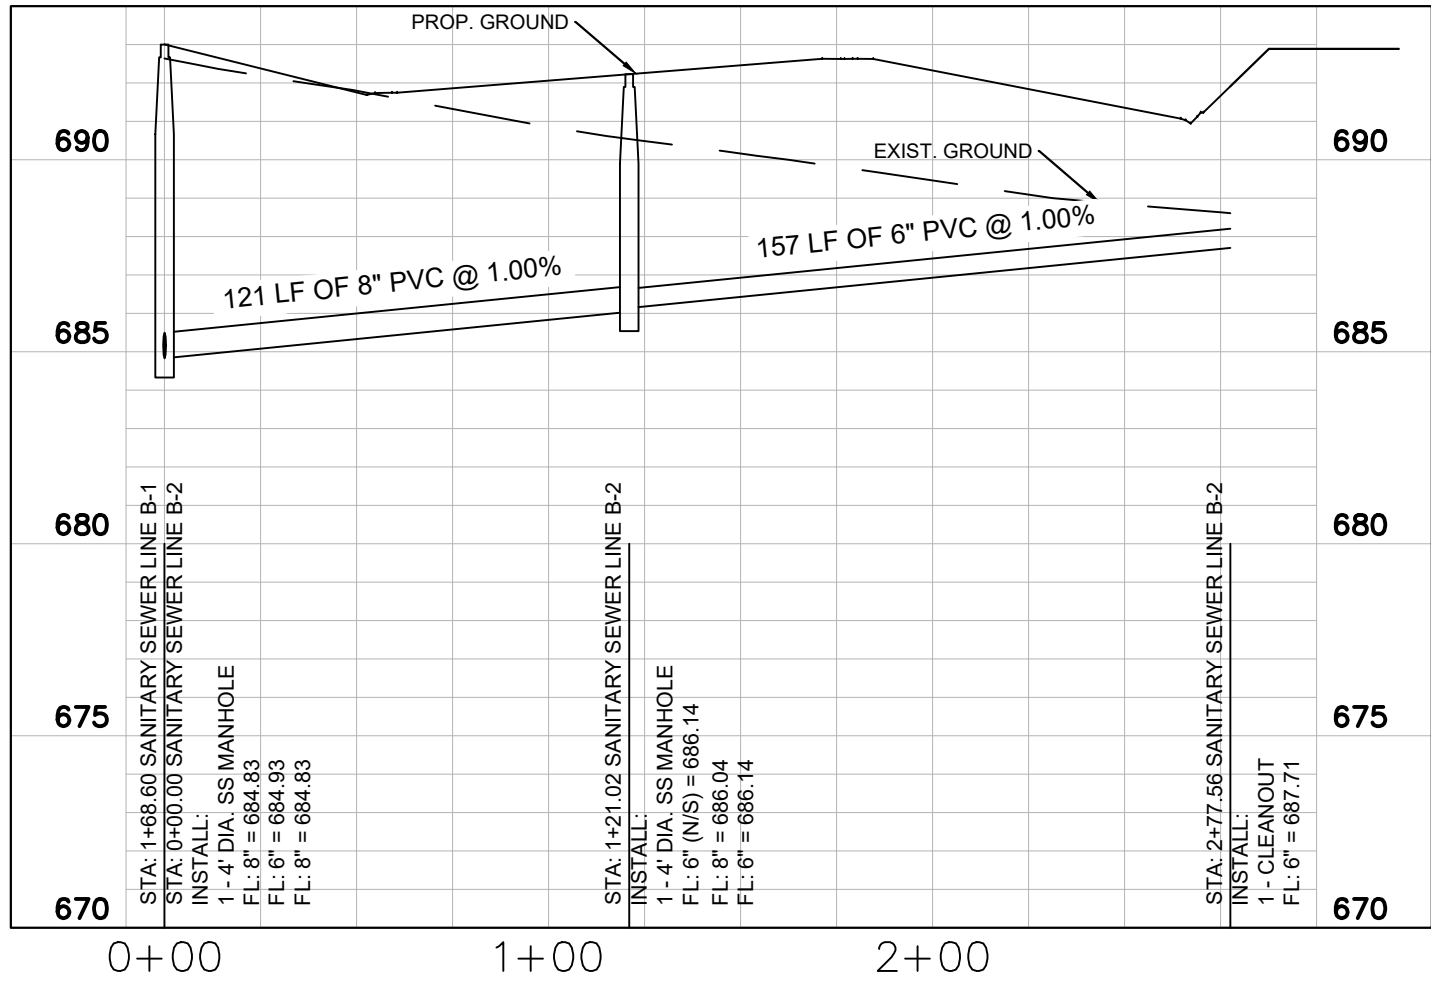


SANITARY SEWER LINE C


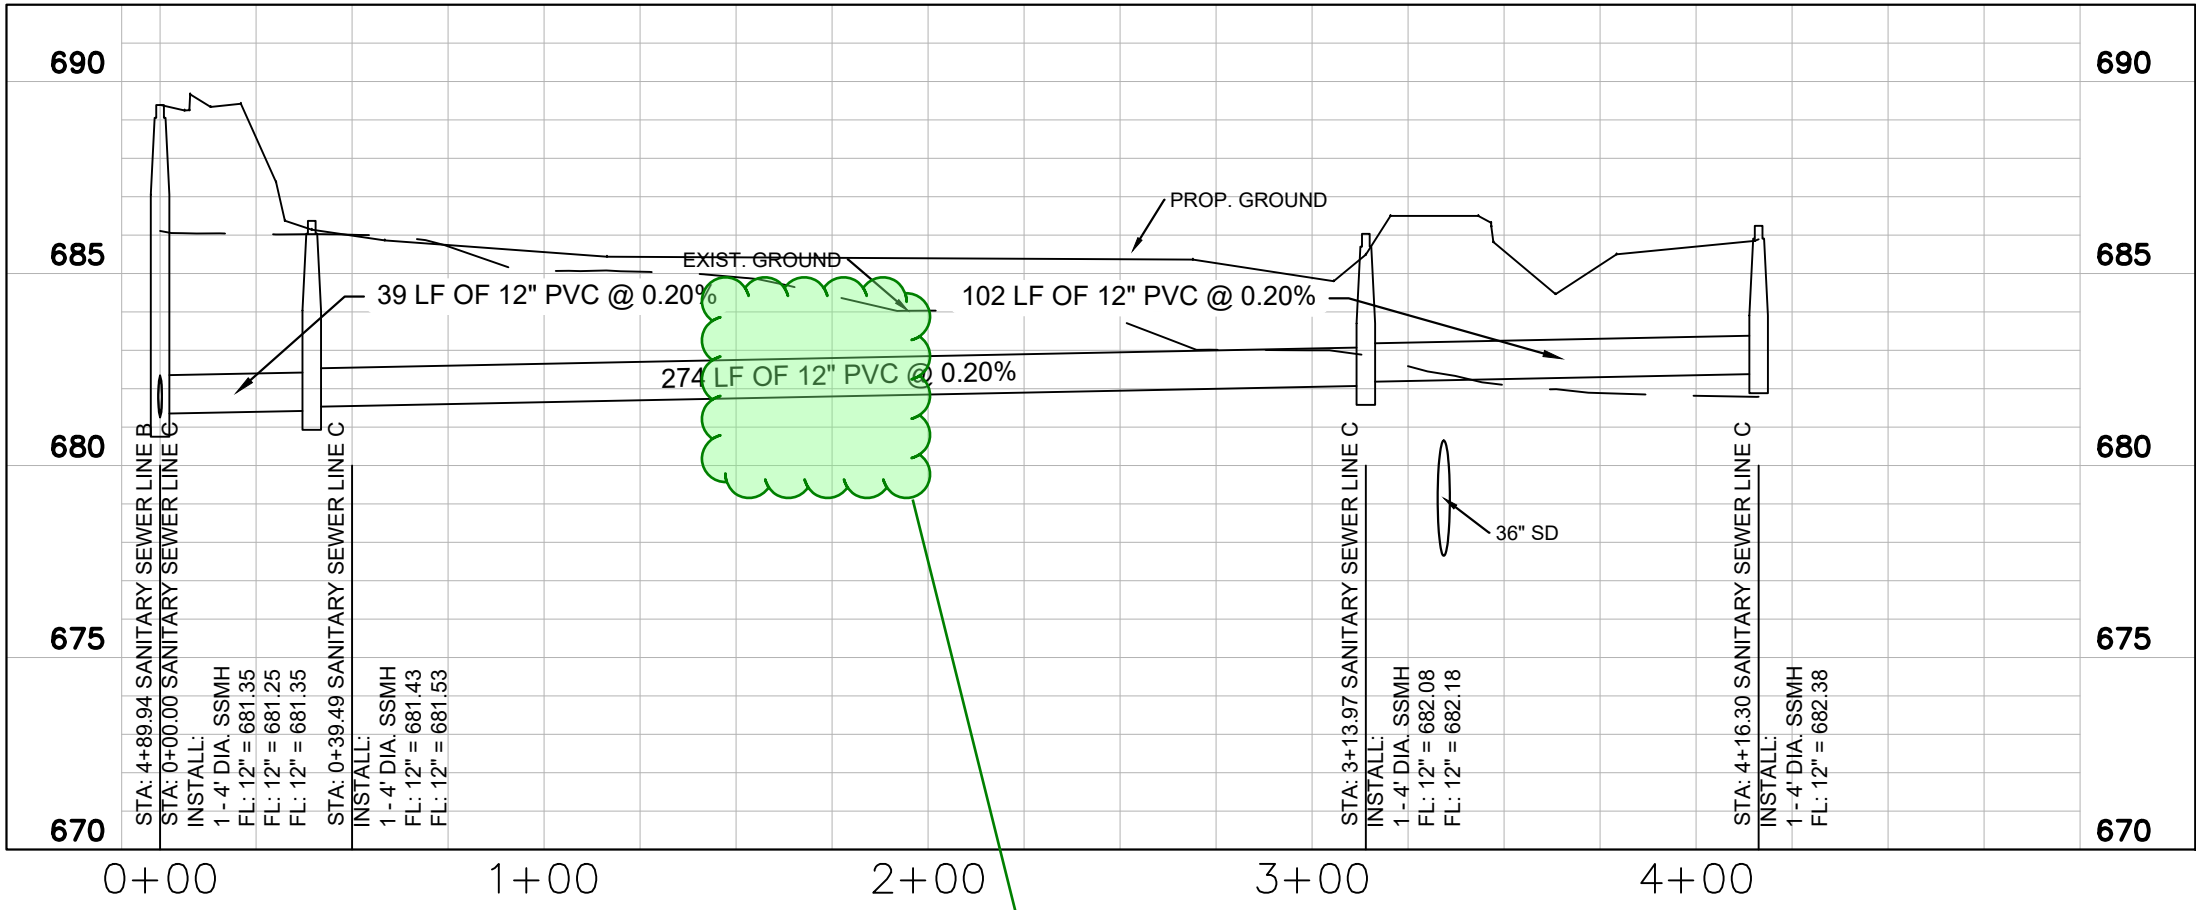


What type of embedment is to be used? Shallow line

SANITARY SEWER LINE B-1

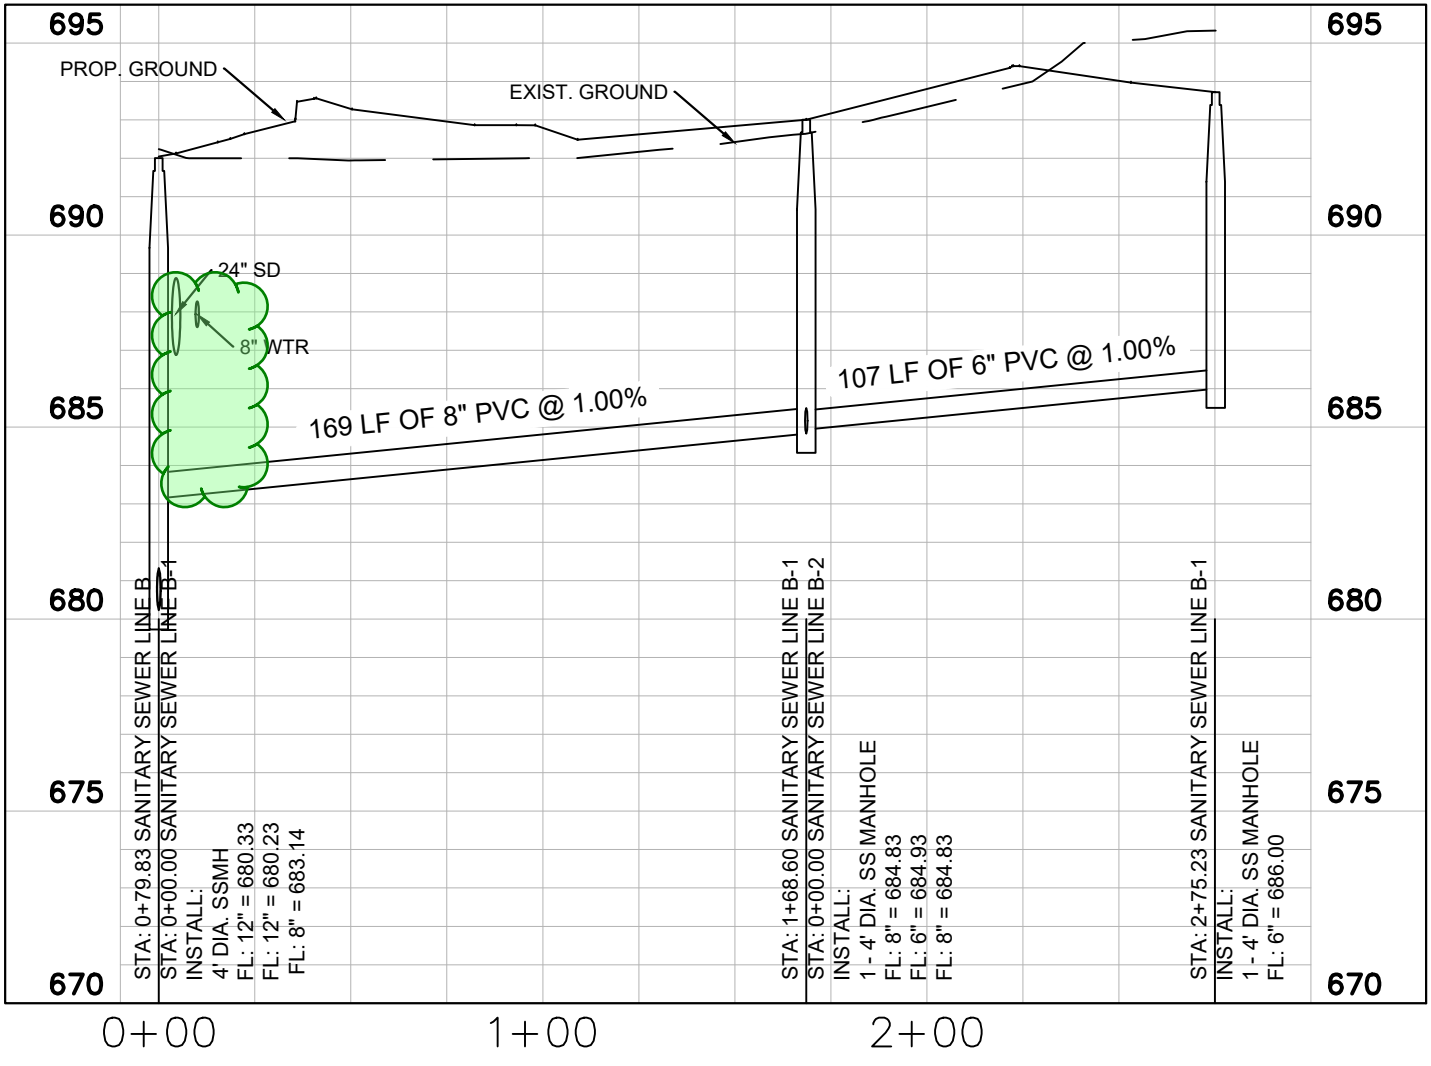

SANITARY SEWER LINE D

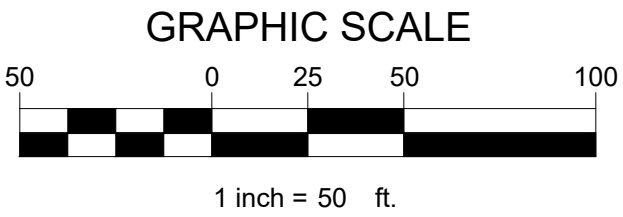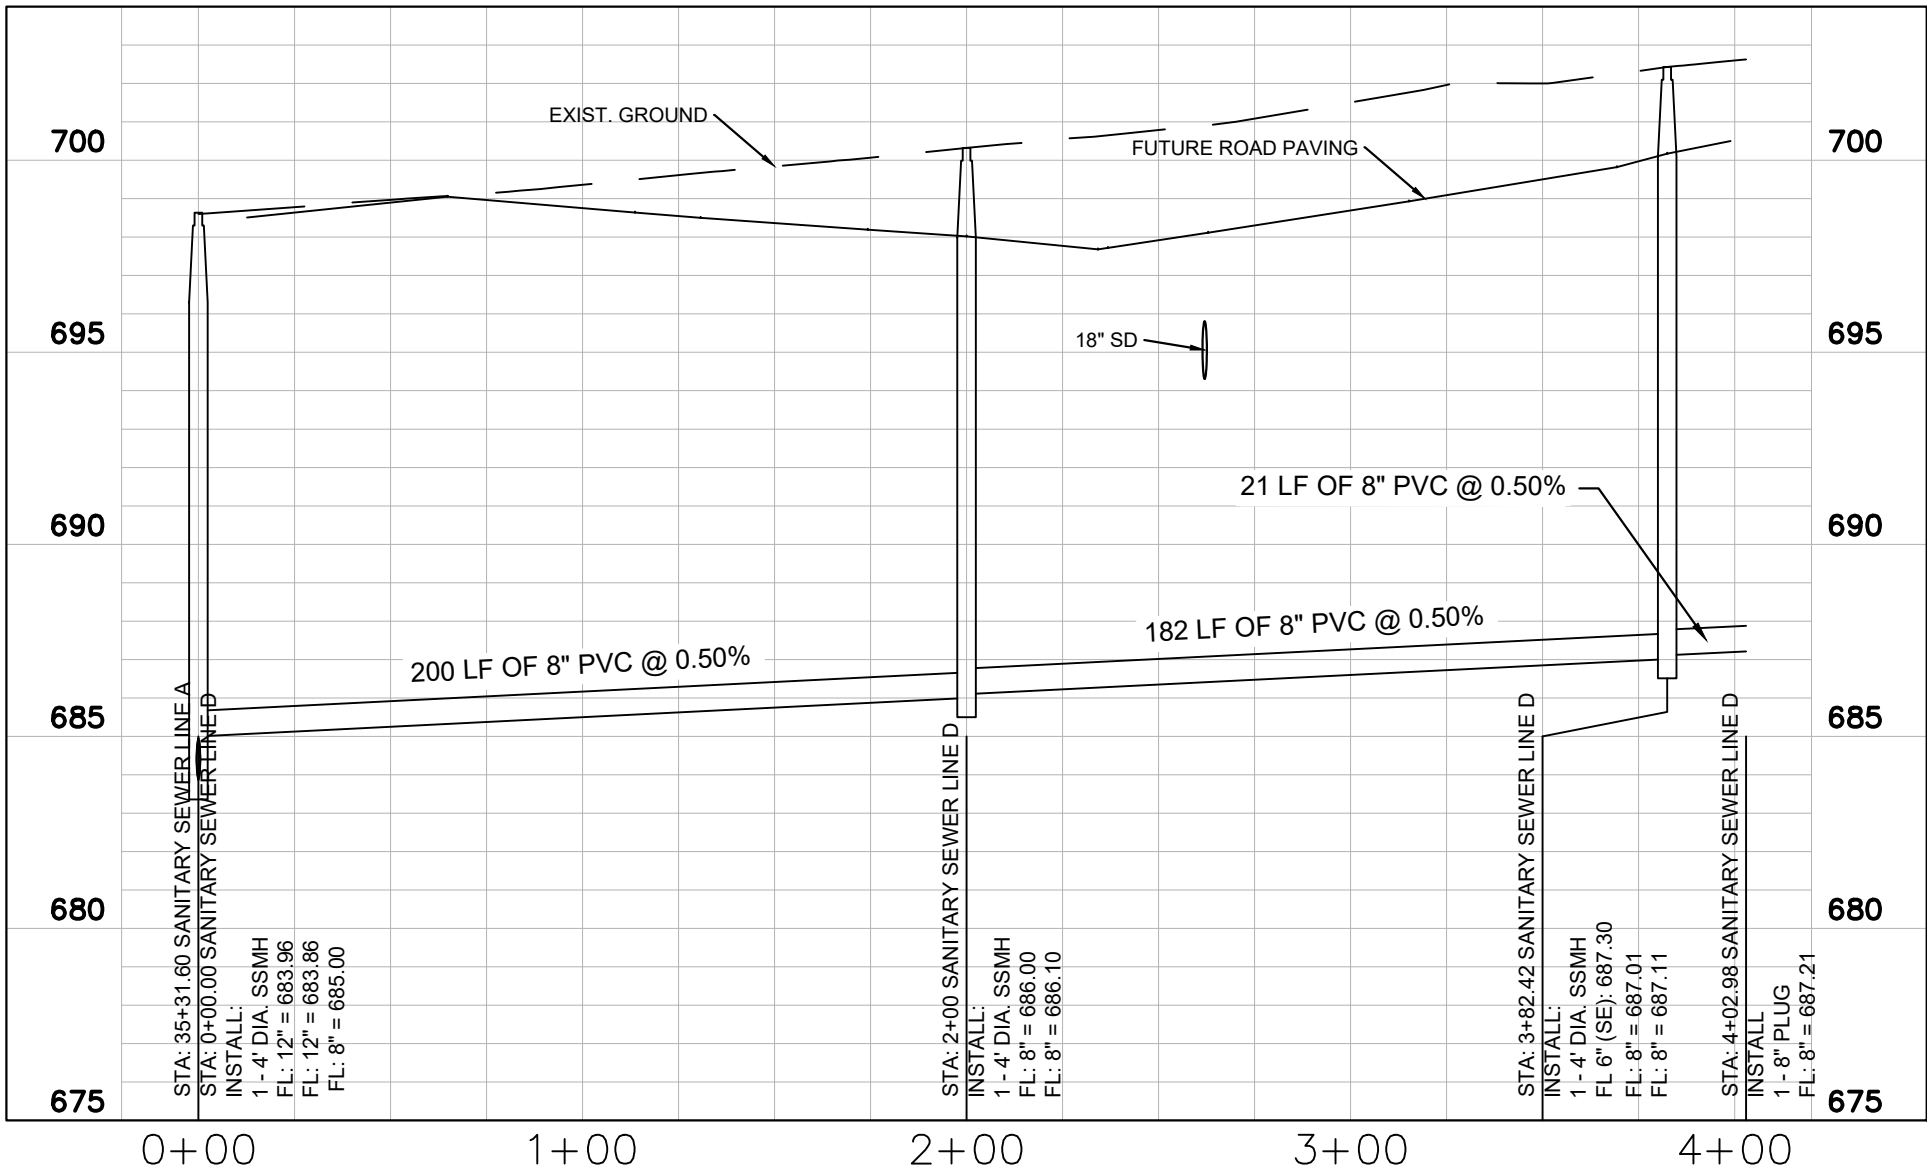


PRELIMINARY  
 FOR REVIEW ONLY  
 Not for construction purposes.  
 CLAYMOORE ENGINEERING  
 ENGINEERING AND PLANNING CONSULTANTS  
 Engineer: DREW DONOSKY  
 P.E. No.125651 Date 7/17/2024

SANGER MULTI-FAMILY  
 PREPARED FOR  
 GREYSTAR  
 SANGER, TEXAS

SANITARY SEWER PROFILES			
DESIGN:	ASD		
DRAWN:	DC		
CHECKED:	ASD		
DATE:	7/17/2024		
SHEET		BY	
C-7.9		REVISION	
CASE NO.		2022-185	



PLOTTED BY: DAN CABALLERO  
 PLOT DATE: 7/17/2024 10:17 AM  
 LOCATION: Z:\PROJECTS\PROJECTS\2022-185 MALOUF SANGER\CADD\SHEETS\MULTI-FAMILY GREYSTAR\C-7.11 DRY UTILITY COORDINATION PLAN.DWG  
 LAST SAVED: 7/16/2024 8:29 AM

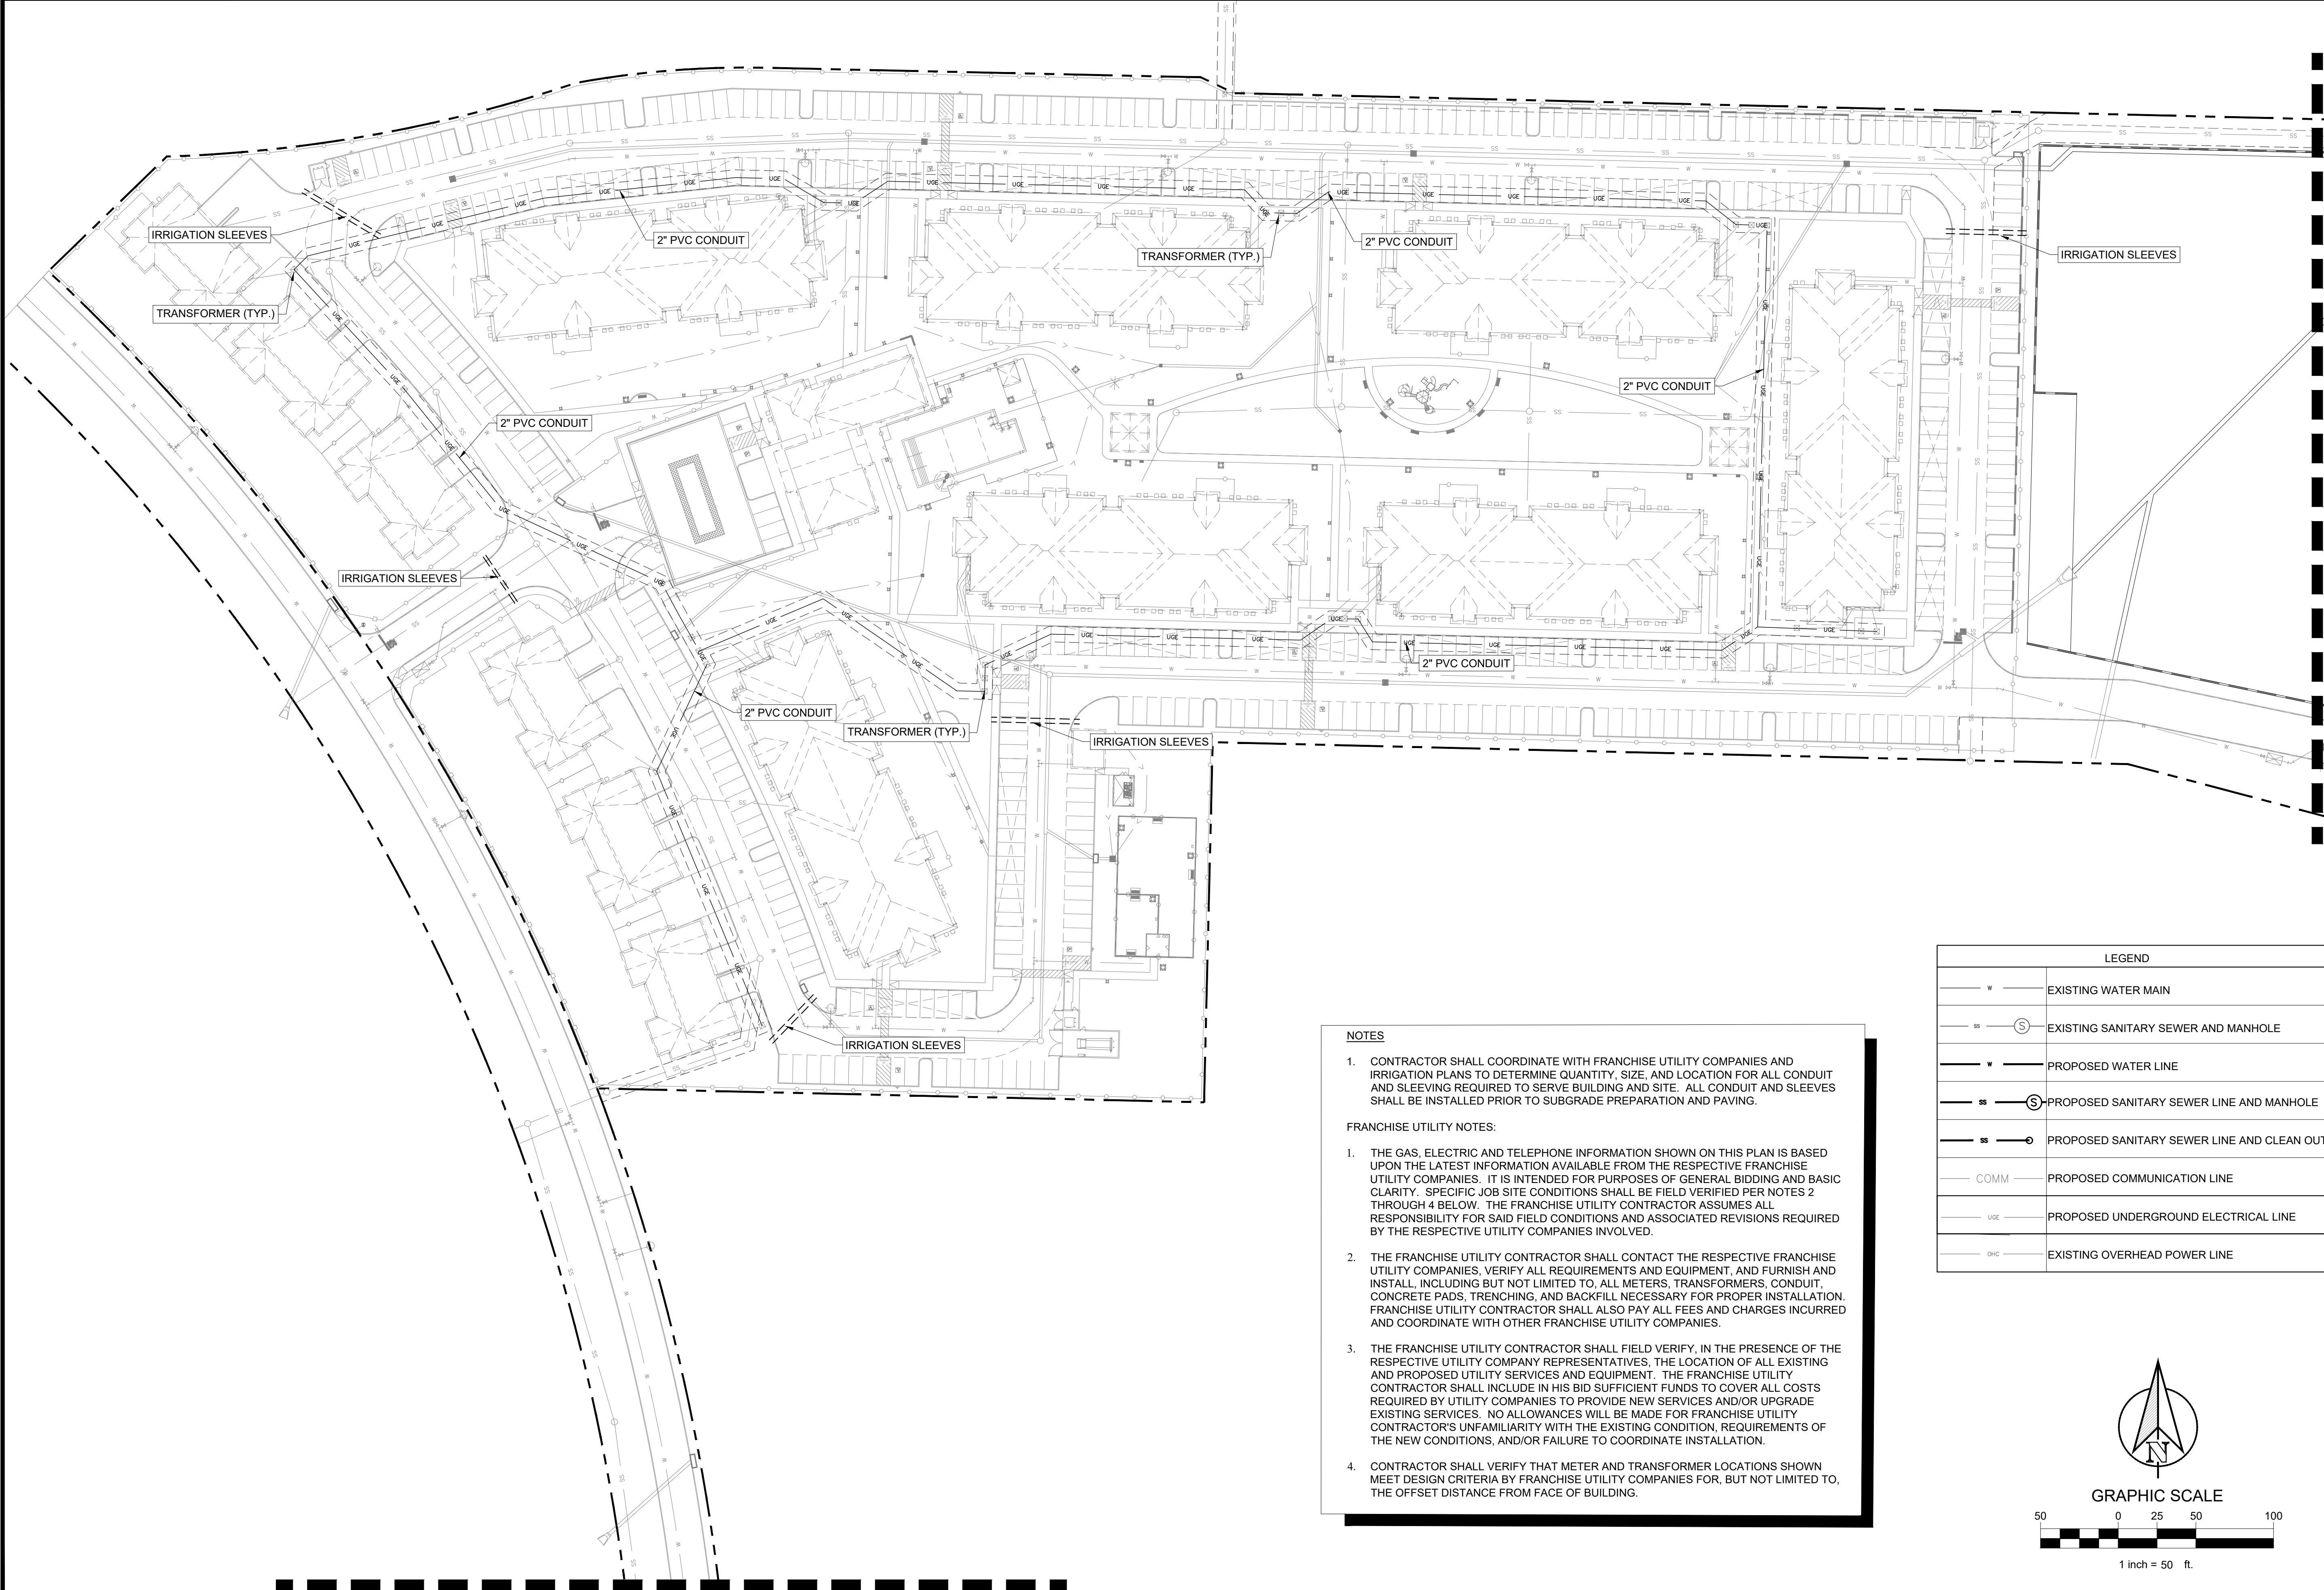


MATCHLINE SHEET C-7.11

NOTES

1. CONTRACTOR SHALL COORDINATE WITH FRANCHISE UTILITY COMPANIES AND IRRIGATION PLANS TO DETERMINE QUANTITY, SIZE, AND LOCATION FOR ALL CONDUIT AND SLEEVING REQUIRED TO SERVE BUILDING AND SITE. ALL CONDUIT AND SLEEVES SHALL BE INSTALLED PRIOR TO SUBGRADE PREPARATION AND PAVING.

FRANCHISE UTILITY NOTES:

- THE GAS, ELECTRIC AND TELEPHONE INFORMATION SHOWN ON THIS PLAN IS BASED UPON THE LATEST INFORMATION AVAILABLE FROM THE RESPECTIVE FRANCHISE UTILITY COMPANIES. IT IS INTENDED FOR PURPOSES OF GENERAL BIDDING AND BASIC CLARITY. SPECIFIC JOB SITE CONDITIONS SHALL BE FIELD VERIFIED PER NOTES 2 THROUGH 4 BELOW. THE FRANCHISE UTILITY CONTRACTOR ASSUMES ALL RESPONSIBILITY FOR SAID FIELD CONDITIONS AND ASSOCIATED REVISIONS REQUIRED BY THE RESPECTIVE UTILITY COMPANIES INVOLVED.
- THE FRANCHISE UTILITY CONTRACTOR SHALL CONTACT THE RESPECTIVE FRANCHISE UTILITY COMPANIES, VERIFY ALL REQUIREMENTS AND EQUIPMENT, AND FURNISH AND INSTALL, INCLUDING BUT NOT LIMITED TO, ALL METERS, TRANSFORMERS, CONDUIT, CONCRETE PADS, TRENCHING, AND BACKFILL NECESSARY FOR PROPER INSTALLATION. FRANCHISE UTILITY CONTRACTOR SHALL ALSO PAY ALL FEES AND CHARGES INCURRED AND COORDINATE WITH OTHER FRANCHISE UTILITY COMPANIES.
- THE FRANCHISE UTILITY CONTRACTOR SHALL FIELD VERIFY, IN THE PRESENCE OF THE RESPECTIVE UTILITY COMPANY REPRESENTATIVES, THE LOCATION OF ALL EXISTING AND PROPOSED UTILITY SERVICES AND EQUIPMENT. THE FRANCHISE UTILITY CONTRACTOR SHALL INCLUDE IN HIS BID SUFFICIENT FUNDS TO COVER ALL COSTS REQUIRED BY UTILITY COMPANIES TO PROVIDE NEW SERVICES AND/OR UPGRADE EXISTING SERVICES. NO ALLOWANCES WILL BE MADE FOR FRANCHISE UTILITY CONTRACTOR'S UNFAMILIARITY WITH THE EXISTING CONDITION, REQUIREMENTS OF THE NEW CONDITIONS, AND/OR FAILURE TO COORDINATE INSTALLATION.
- CONTRACTOR SHALL VERIFY THAT METER AND TRANSFORMER LOCATIONS SHOWN MEET DESIGN CRITERIA BY FRANCHISE UTILITY COMPANIES FOR, BUT NOT LIMITED TO, THE OFFSET DISTANCE FROM FACE OF BUILDING.

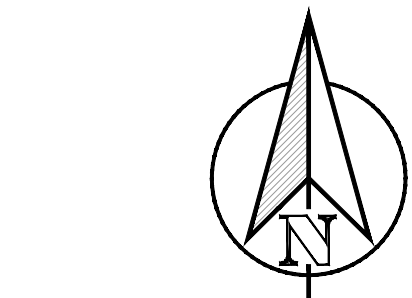

GRAPHIC SCALE



1 inch = 50 ft.

LEGEND	
	EXISTING WATER MAIN
	EXISTING SANITARY SEWER AND MANHOLE
	PROPOSED WATER LINE
	PROPOSED SANITARY SEWER LINE AND MANHOLE
	PROPOSED SANITARY SEWER LINE AND CLEAN OUT
	PROPOSED COMMUNICATION LINE
	PROPOSED UNDERGROUND ELECTRICAL LINE
	EXISTING OVERHEAD POWER LINE


**PRELIMINARY**  
 FOR REVIEW ONLY  
 Not for construction purposes.  
**CLAYMOORE ENGINEERING**  
 ENGINEERING AND PLANNING CONSULTANTS  
 Engineer: **DREW DONOSKY**  
 P.E. No.125651 Date: **7/17/2024**

**SANGER MULTI-FAMILY**  
**PREPARED FOR**  
**GREYSTAR**  
**SANGER, TEXAS**

NO.	DATE	REVISION	BY



PLOTTED BY: DAN CABALLERO  
 7/17/2024 10:18 AM  
 Z:\PROJECTS\PROJECTS\2022-185 MALOUF SANGER\CADD\SHEETS\MULTI-FAMILY GREYSTAR\C-7.11 DRY UTILITY COORDINATION PLAN.DWG  
 7/16/2024 8:29 AM  
 LAST SAVED:

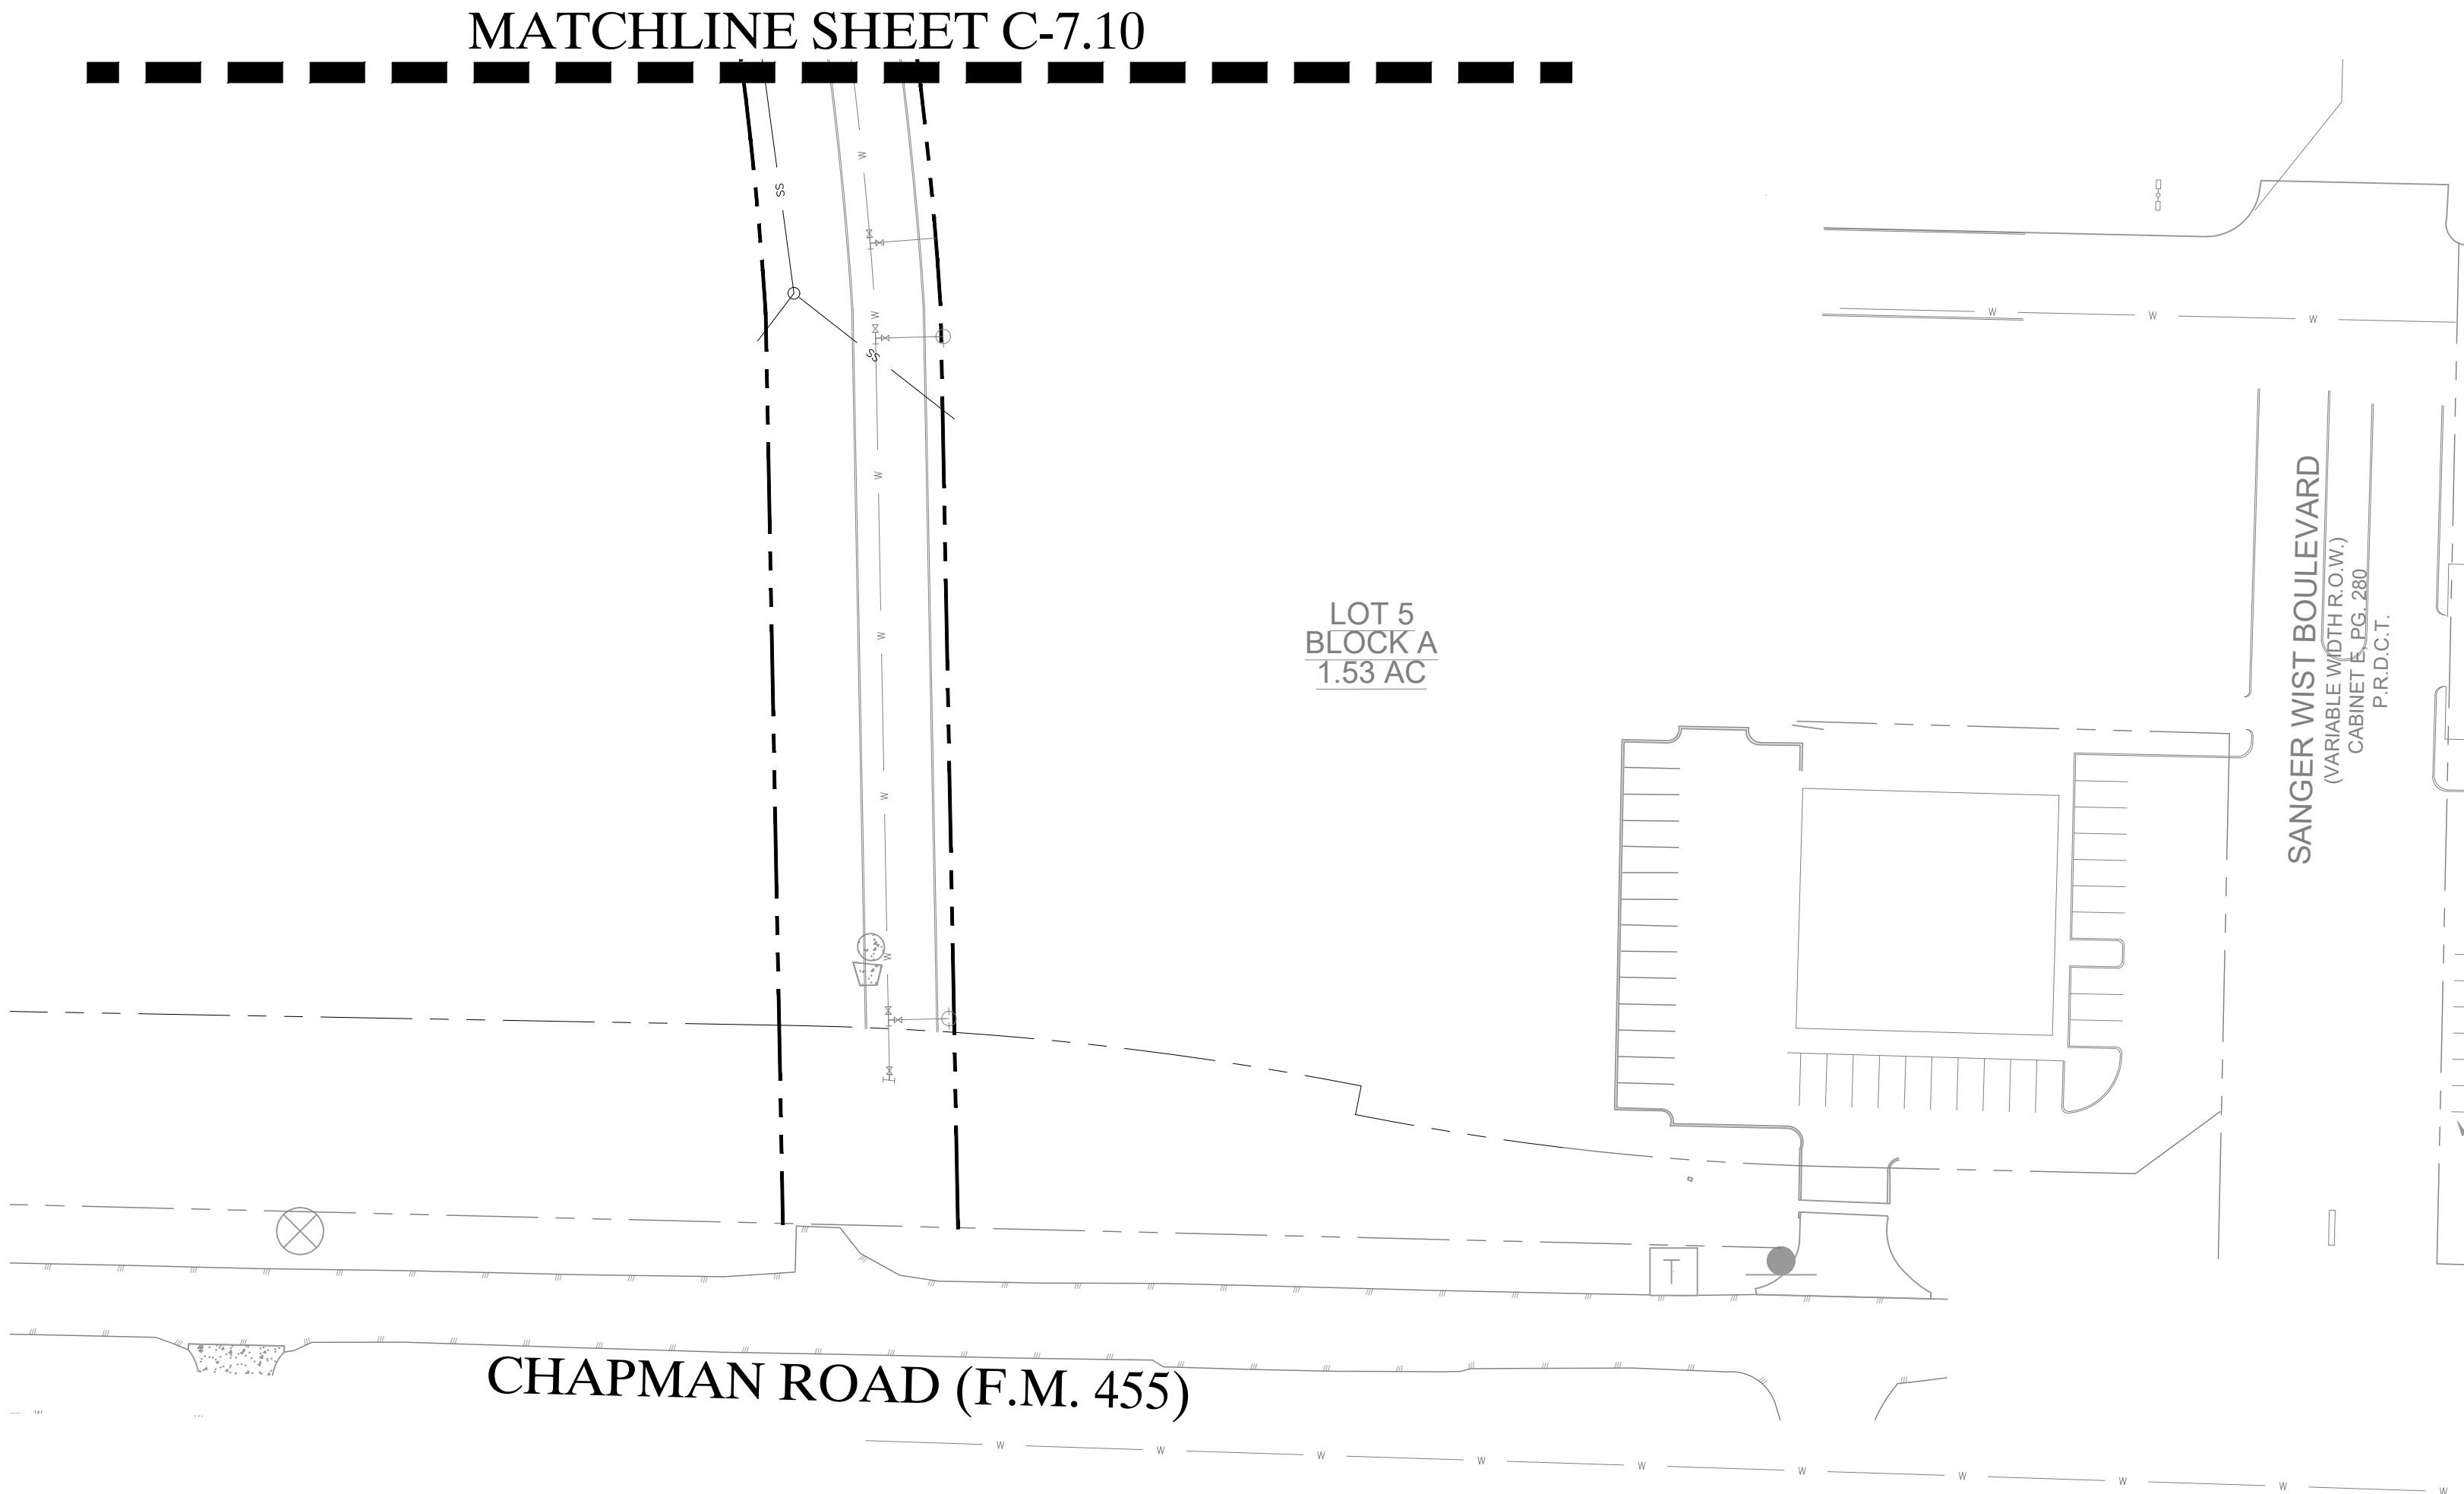


NOTES

- CONTRACTOR SHALL COORDINATE WITH FRANCHISE UTILITY COMPANIES AND IRRIGATION PLANS TO DETERMINE QUANTITY, SIZE, AND LOCATION FOR ALL CONDUIT AND SLEEVING REQUIRED TO SERVE BUILDING AND SITE. ALL CONDUIT AND SLEEVES SHALL BE INSTALLED PRIOR TO SUBGRADE PREPARATION AND PAVING.

FRANCHISE UTILITY NOTES:

- THE GAS, ELECTRIC AND TELEPHONE INFORMATION SHOWN ON THIS PLAN IS BASED UPON THE LATEST INFORMATION AVAILABLE FROM THE RESPECTIVE FRANCHISE UTILITY COMPANIES. IT IS INTENDED FOR PURPOSES OF GENERAL BIDDING AND BASIC CLARITY. SPECIFIC JOB SITE CONDITIONS SHALL BE FIELD VERIFIED PER NOTES 2 THROUGH 4 BELOW. THE FRANCHISE UTILITY CONTRACTOR ASSUMES ALL RESPONSIBILITY FOR SAID FIELD CONDITIONS AND ASSOCIATED REVISIONS REQUIRED BY THE RESPECTIVE UTILITY COMPANIES INVOLVED.
- THE FRANCHISE UTILITY CONTRACTOR SHALL CONTACT THE RESPECTIVE FRANCHISE UTILITY COMPANIES, VERIFY ALL REQUIREMENTS AND EQUIPMENT, AND FURNISH AND INSTALL, INCLUDING BUT NOT LIMITED TO, ALL METERS, TRANSFORMERS, CONDUIT, CONCRETE PADS, TRENCHING, AND BACKFILL NECESSARY FOR PROPER INSTALLATION. FRANCHISE UTILITY CONTRACTOR SHALL ALSO PAY ALL FEES AND CHARGES INCURRED AND COORDINATE WITH OTHER FRANCHISE UTILITY COMPANIES.
- THE FRANCHISE UTILITY CONTRACTOR SHALL FIELD VERIFY, IN THE PRESENCE OF THE RESPECTIVE UTILITY COMPANY REPRESENTATIVES, THE LOCATION OF ALL EXISTING AND PROPOSED UTILITY SERVICES AND EQUIPMENT. THE FRANCHISE UTILITY CONTRACTOR SHALL INCLUDE IN HIS BID SUFFICIENT FUNDS TO COVER ALL COSTS REQUIRED BY UTILITY COMPANIES TO PROVIDE NEW SERVICES AND/OR UPGRADE EXISTING SERVICES. NO ALLOWANCES WILL BE MADE FOR FRANCHISE UTILITY CONTRACTOR'S UNFAMILIARITY WITH THE EXISTING CONDITION, REQUIREMENTS OF THE NEW CONDITIONS, AND/OR FAILURE TO COORDINATE INSTALLATION.
- CONTRACTOR SHALL VERIFY THAT METER AND TRANSFORMER LOCATIONS SHOWN MEET DESIGN CRITERIA BY FRANCHISE UTILITY COMPANIES FOR, BUT NOT LIMITED TO, THE OFFSET DISTANCE FROM FACE OF BUILDING.

MATCHLINE SHEET C-7.10

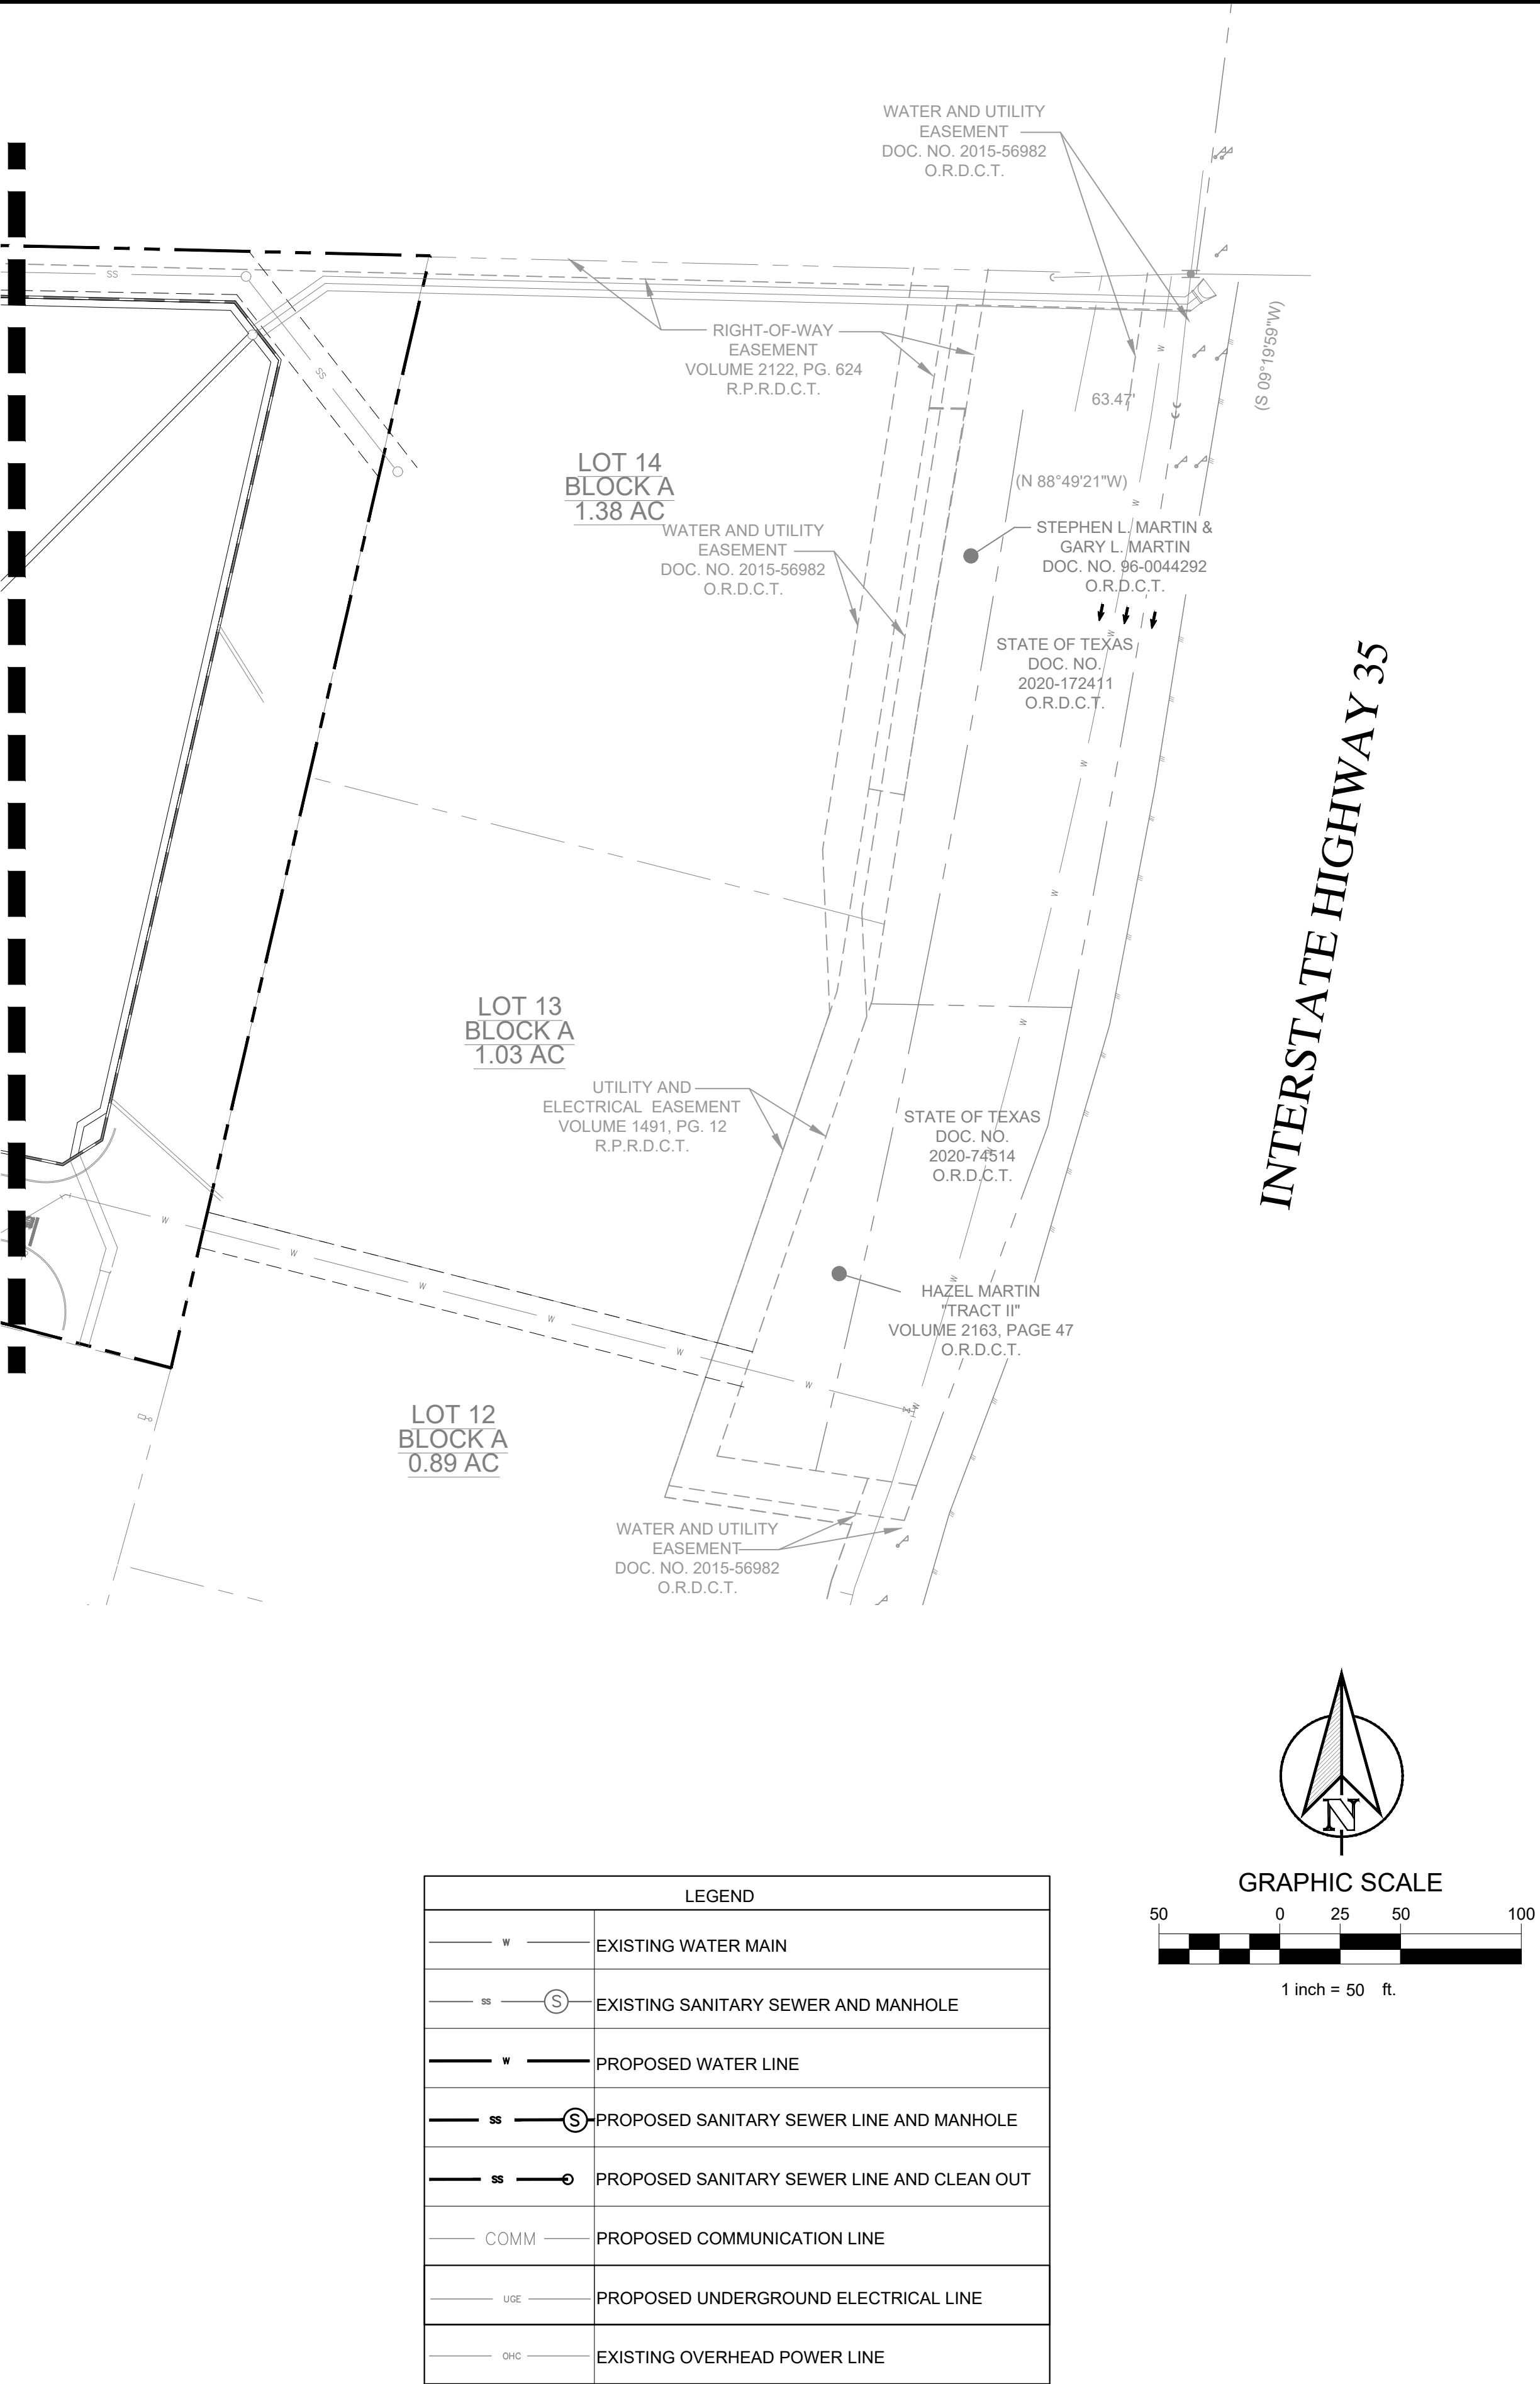


LEGEND	
W	EXISTING WATER MAIN
SS (S)	EXISTING SANITARY SEWER AND MANHOLE
W	PROPOSED WATER LINE
SS (S)	PROPOSED SANITARY SEWER LINE AND MANHOLE
SS (S)	PROPOSED SANITARY SEWER LINE AND CLEAN OUT
COMM	PROPOSED COMMUNICATION LINE
UE	PROPOSED UNDERGROUND ELECTRICAL LINE
OHC	EXISTING OVERHEAD POWER LINE


No.	DATE	REVISION	BY




PLOTTED BY: DAN CABALLERO  
 PLOT DATE: 7/17/2024 10:18 AM  
 LOCATION: Z:\PROJECTS\PROJECTS\2022-185 MALOUF SANGER\CADD\PROJECTS\MULTI-FAMILY GREYSTAR\C-31 CONSTRUCTION DETAILS 4.DWG  
 LAST SAVED: 7/16/2024 8:31 AM

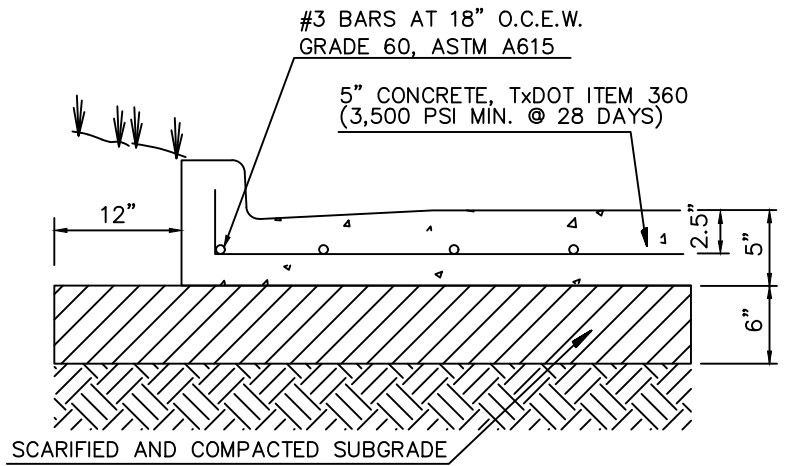

STANDARD DUTY  
CONCRETE PAVING

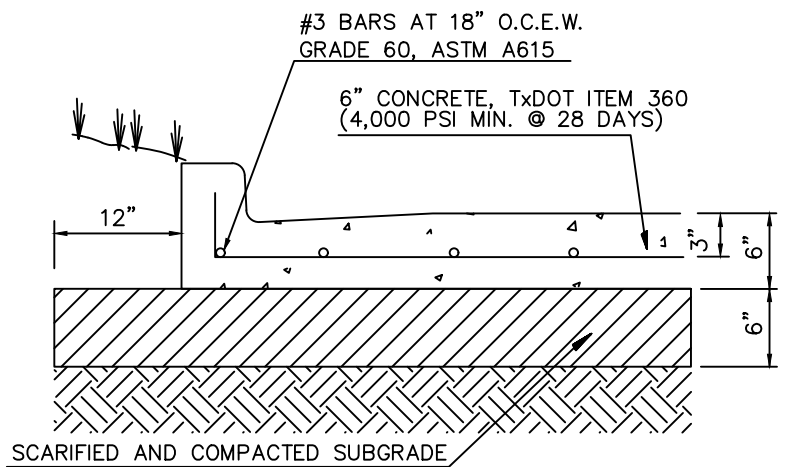

HEAVY DUTY/FIRE LANE  
CONCRETE PAVING

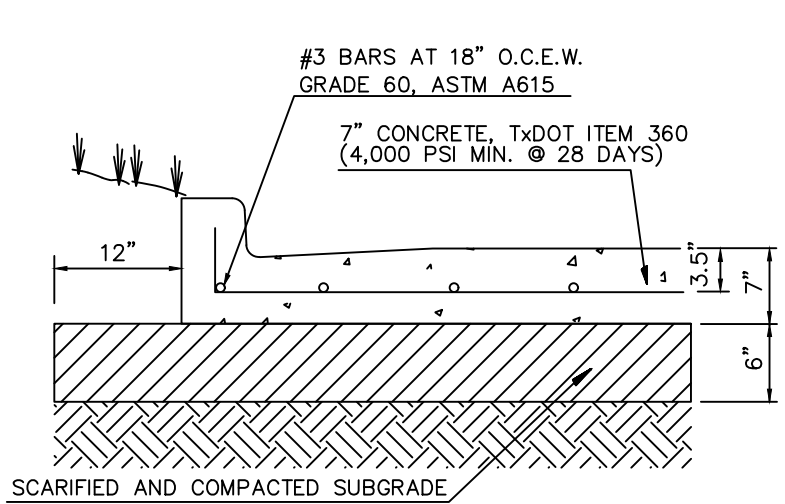


DUMPSTER  
CONCRETE PAVING

GENERAL PAVING NOTES


- SUBGRADE SHALL BE SCARIFIED TO A DEPTH OF AT LEAST 6 INCHES AND COMPACTED TO AT LEAST 95 PERCENT OF STANDARD PROCTOR MAXIMUM DENSITY (ASTM D 698) AND WITHIN A RANGE OF -1 TO +3 PERCENTAGE POINTS OF THE MATERIAL'S OPTIMUM MOISTURE CONTENT.
- CONCRETE SHALL HAVE A MINIMUM 3,500 PSI COMPRESSIVE STRENGTH AT 28 DAYS AND 4,000 PSI COMPRESSIVE STRENGTH AT 28 DAYS FOR FIRE LANES AND DUMPSTER AREA CONCRETE PAVING. CONCRETE SHALL BE DESIGNED WITH 4.5± 1.5 PERCENT ENTRAINED AIR.
- JOINTS IN CONCRETE PAVEMENT SHALL NOT EXCEED 15 FOOT SPACING.

PAVING DETAILS

SCALE: NONE

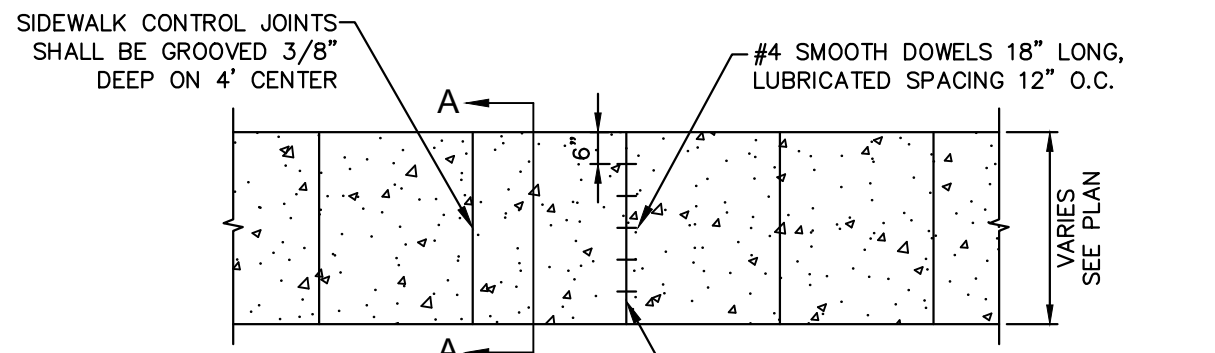


PLAN

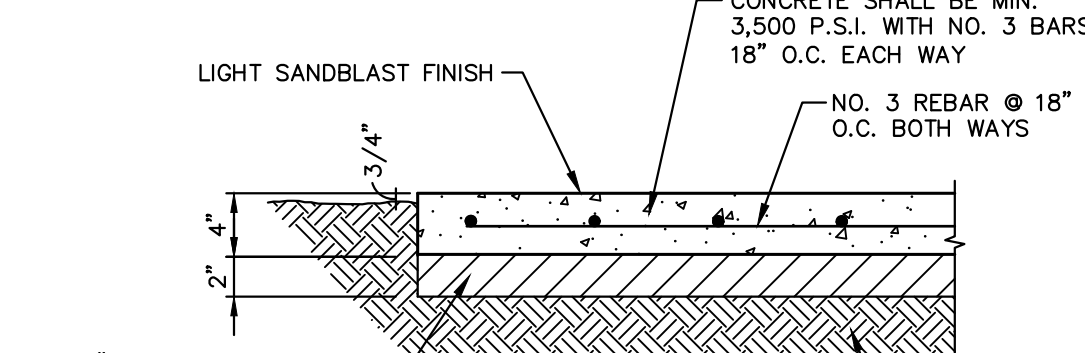


CROSS SECTION A-A

PRIVATE CONCRETE SIDEWALK DETAIL

N.T.S.

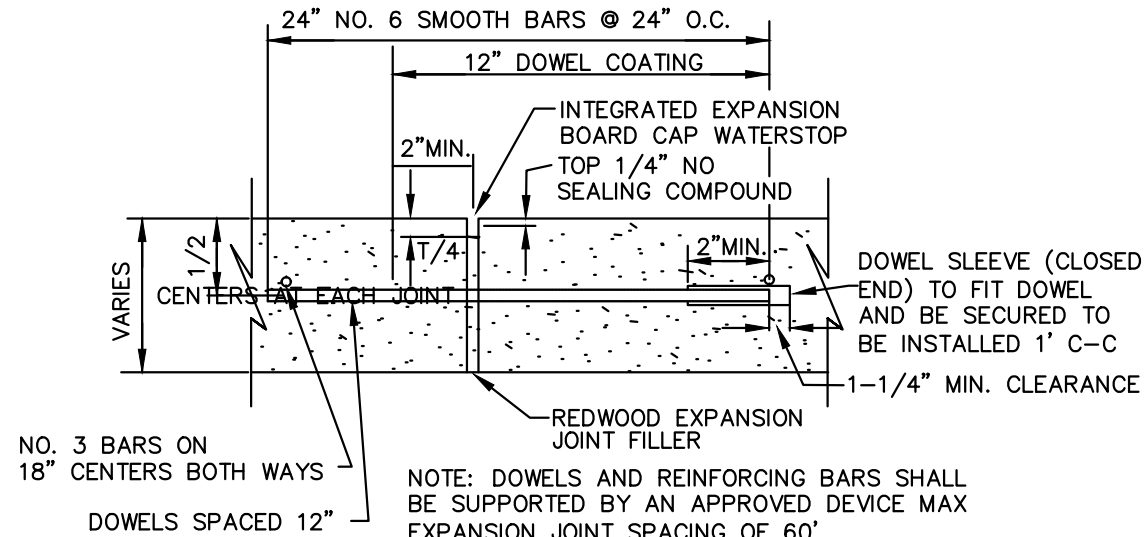


TRANSVERSE EXPANSION/  
ISOLATION JOINT DETAIL

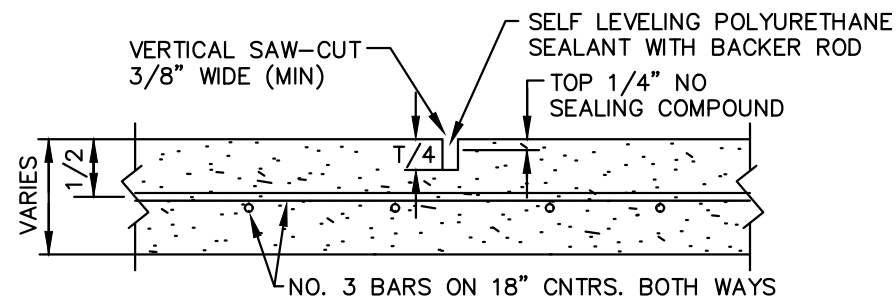


CONTRACTION JOINT DETAIL

SCALE: NONE

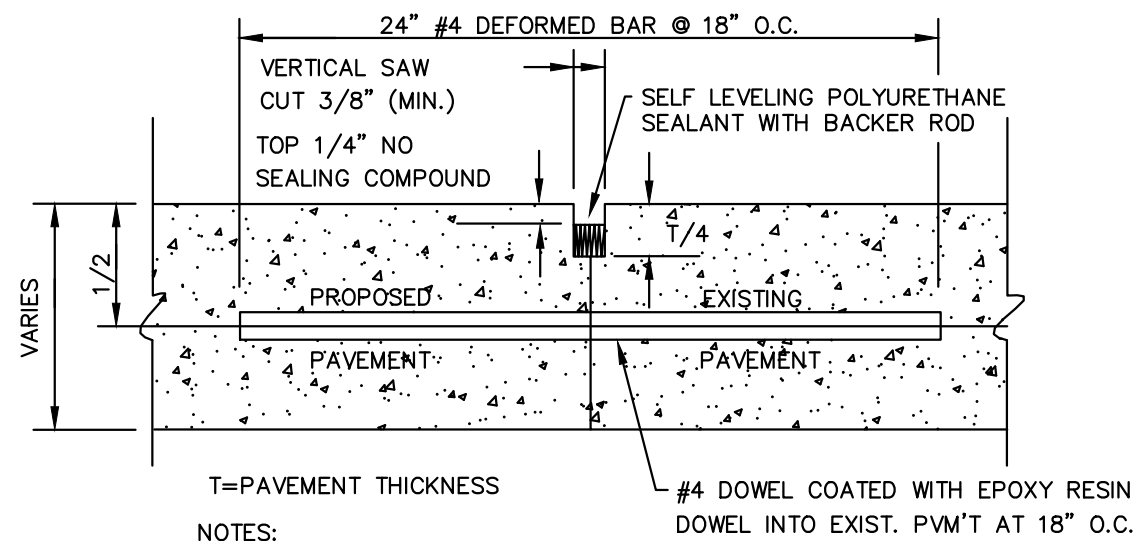


LONGITUDINAL BUTT JOINT DETAIL

SCALE: NONE

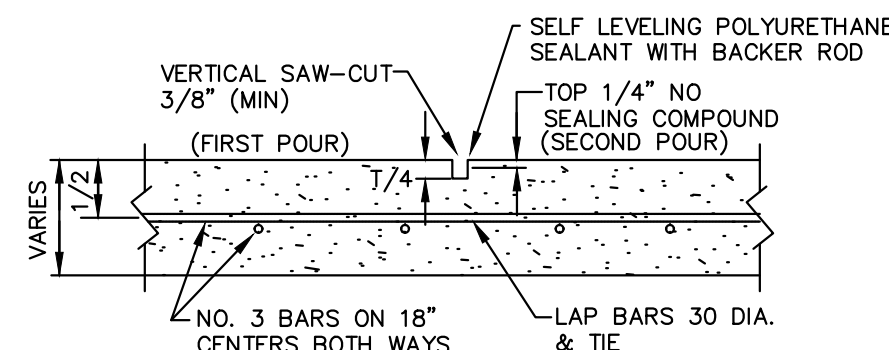

CONSTRUCTION JOINT DETAIL

SCALE: NONE

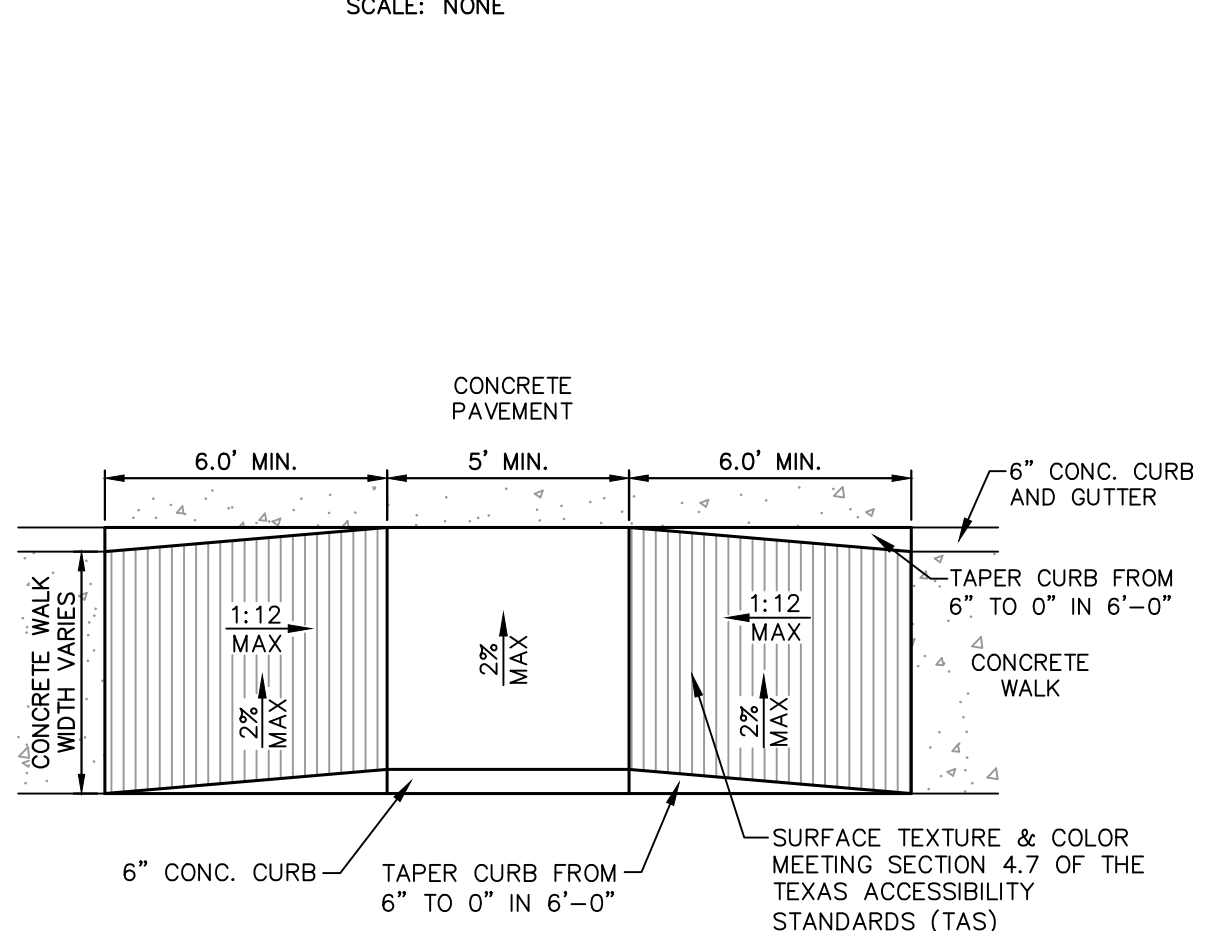


- NOTES:
- ALL HANDICAPPED SIGNAGE AND MARKINGS TO BE IN ACCORDANCE WITH FEDERAL STATE AND AND LOCAL REGULATIONS.
  - MAXIMUM SLOPE FOR HANDICAPPED ACCESSIBLE PATHS ARE 5% WITH A MAXIMUM CROSS FALL SLOPE OF 2%. THE FIRST FIVE FEET FROM THE DOOR IS NOT TO EXCEED 2% IN ANY DIRECTION.
  - TAPERED CURB AND GUTTER SECTION. MAINTAIN GUTTER FLOWLINE AS REQUIRED.
  - RAMP SHALL BE CONSTRUCTED OF 4" THICK, 3000 PSI CONCRETE WITH 6"x6" W2.9xW2.9 WELDED WIRE REINF.

NOTE:  
REFER TO GEOTECH REPORT FOR  
FURTHER INFORMATION.


ACCESS RAMP DETAIL

N.T.S.

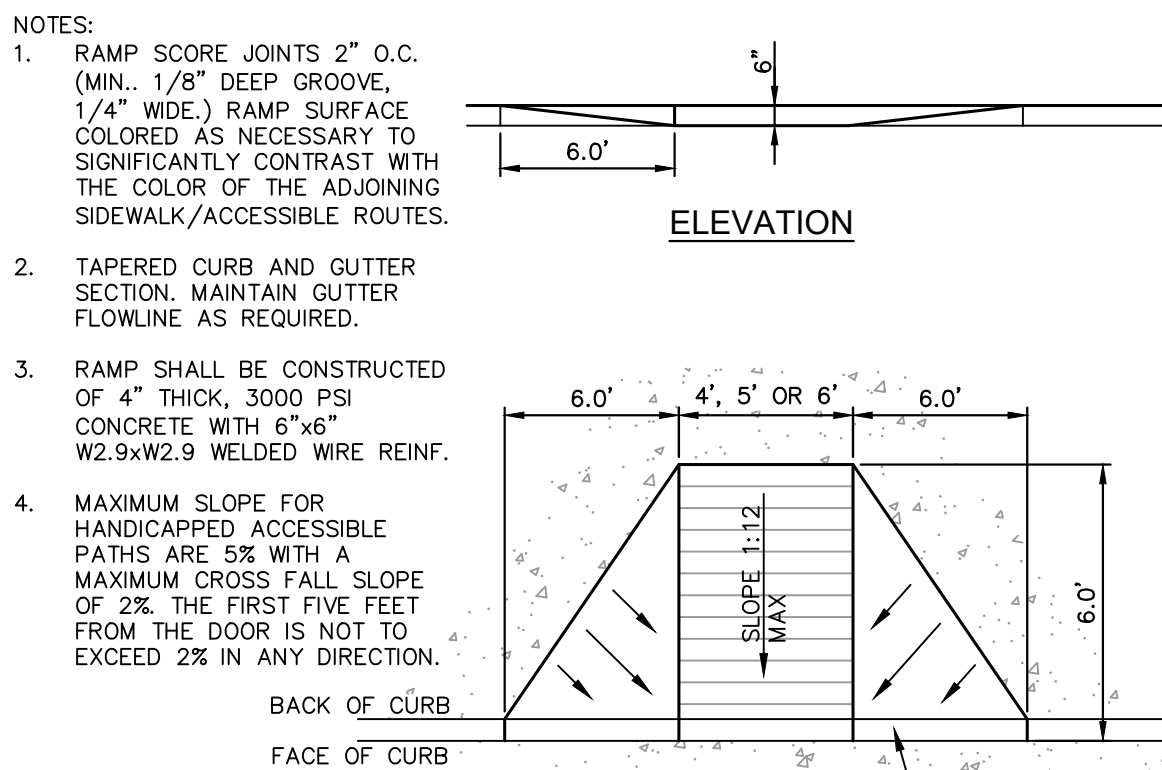

PRIVATE BARRIER FREE RAMP W/ 6" FLARES DETAIL


N.T.S.

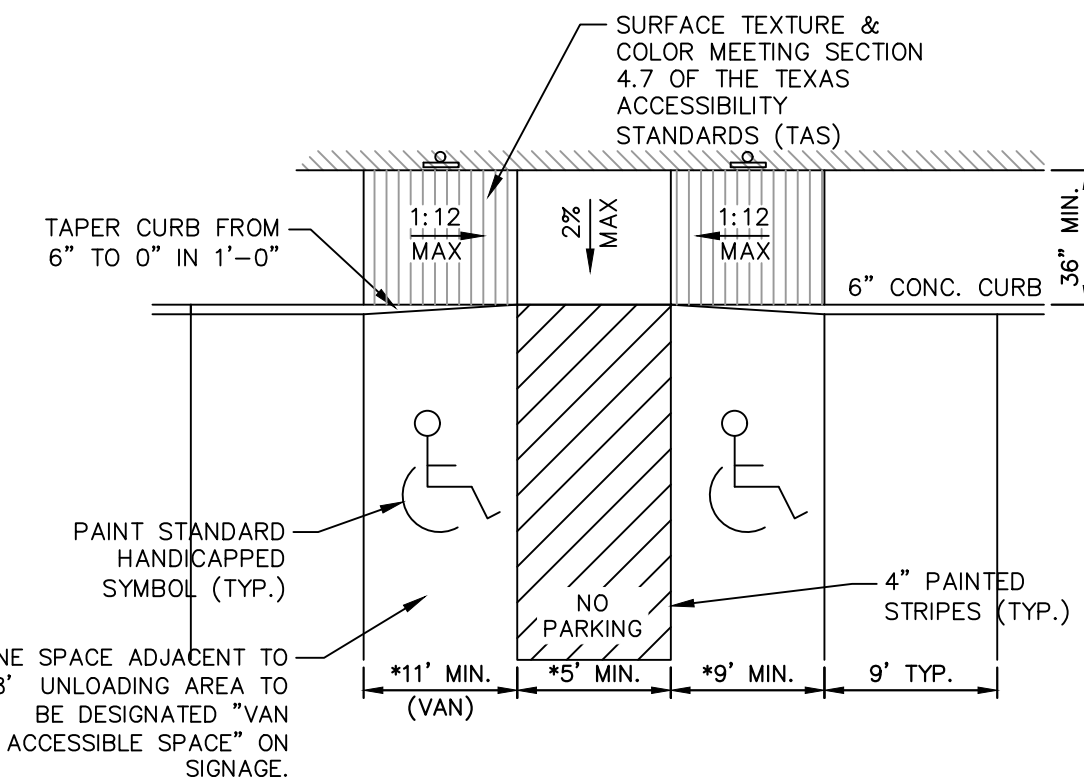

HANDICAPPED PARKING DETAIL

N.T.S.


- NOTES:
- \* DIMENSIONS MAY VARY REFER TO DIMENSIONAL CONTROL PLAN
  - SIGNAGE AND MARKINGS TO BE IN ACCORDANCE WITH FEDERAL STATE AND LOCAL REGULATIONS.
  - MAXIMUM SLOPE FOR HANDICAPPED ACCESSIBLE PATHS ARE 5% WITH A MAXIMUM CROSS FALL SLOPE OF 2%. THE FIRST FIVE FEET FROM THE DOOR IS NOT TO EXCEED 2% IN ANY DIRECTION.
  - HANDICAPPED SIGNS, INSTALL 2' FROM BACK OF CURB (TYP. EACH SPACE). SIGNAGE TO BE IN ACCORDANCE WITH TEXAS DEPARTMENT OF LICENSING AND REGULATION TEXAS ACCESSIBILITY STANDARDS (TAS) PER 4.6.4
  - THE WORDS "NO PARKING" ARE REQUIRED TO BE PAINTED ON ANY ACCESSIBLE AISLES ADJACENT TO THE PARKING SPACE. MINIMUM LETTER HEIGHT OF 12" AND MINIMUM STROKE WIDTH IS 2". CENTERED IN AISLES.

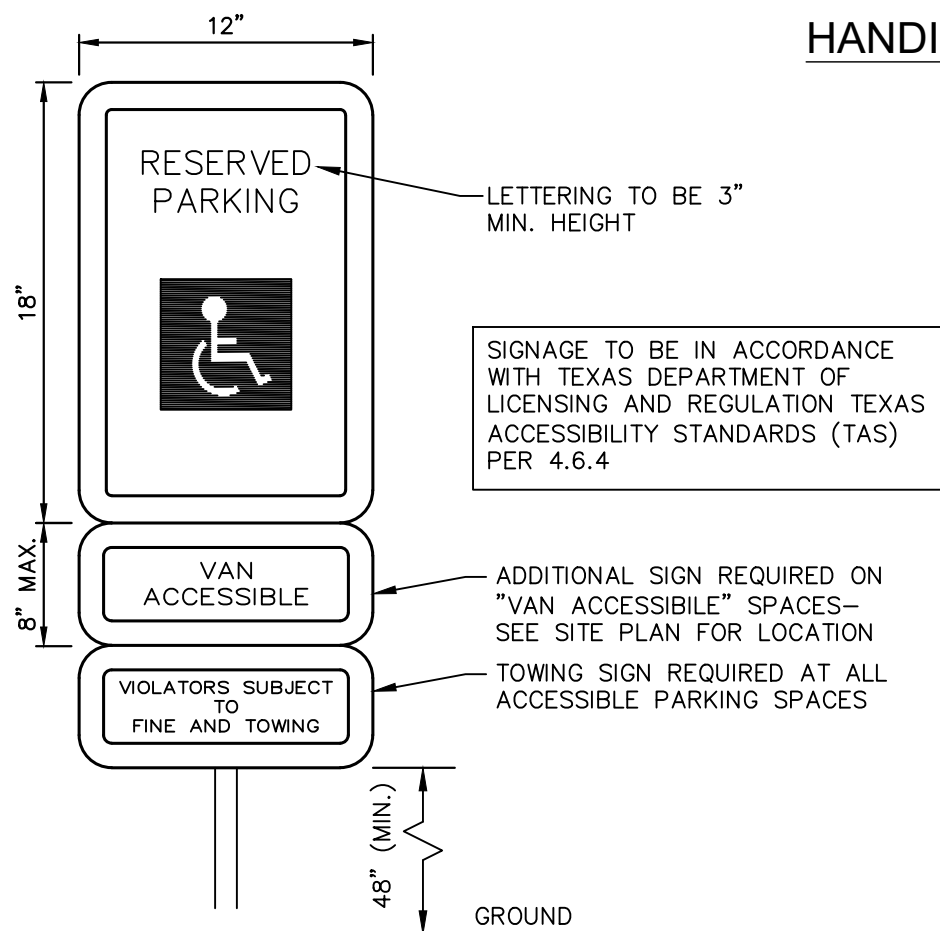

- NOTES:
- A SIGN IDENTIFYING THE CONSEQUENCES OF PARKING ILLEGALLY IN A PAVED ACCESSIBLE PARKING SPACE MUST AT A MINIMUM:
  - STATE "VIOLATORS SUBJECT TO FINE AND TOWING" IN A LETTER HEIGHT OF AT LEAST 1 INCH;
  - BE MOUNTED ON A POLE, POST, WALL OR FREESTANDING BOARD;
  - BE NO MORE THAN EIGHT (8) INCHES BELOW A SIGN REQUIRED BY TEXAS ACCESSIBILITY STANDARDS, 506.6;
  - AND BE INSTALLED SO THAT THE BOTTOM EDGE OF THE SIGN IS NO LOWER THAN 48 INCHES AND NO HIGHER THAN 80 INCHES ABOVE GROUND LEVEL.


DISABLED SIGN DETAIL

N.T.S.

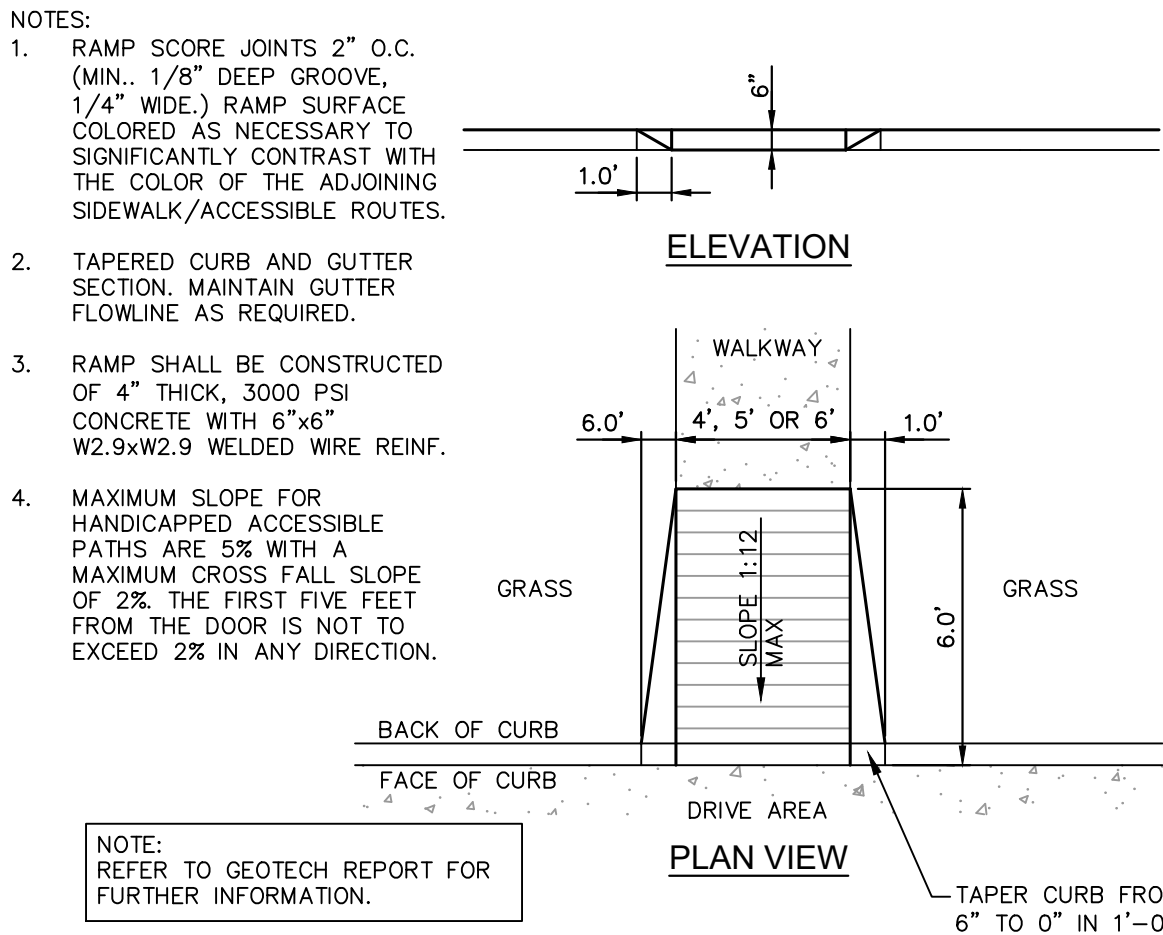


PRIVATE BARRIER FREE RAMP W/ 1" FLARES DETAIL

N.T.S.

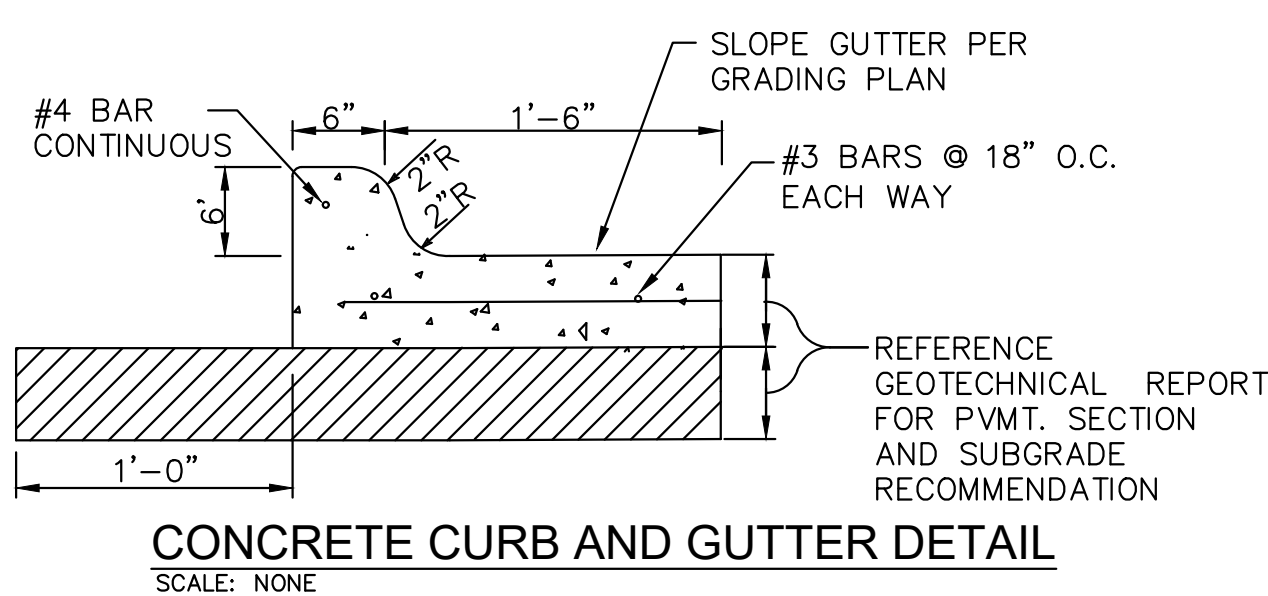

CONCRETE CURB AND GUTTER DETAIL

SCALE: NONE

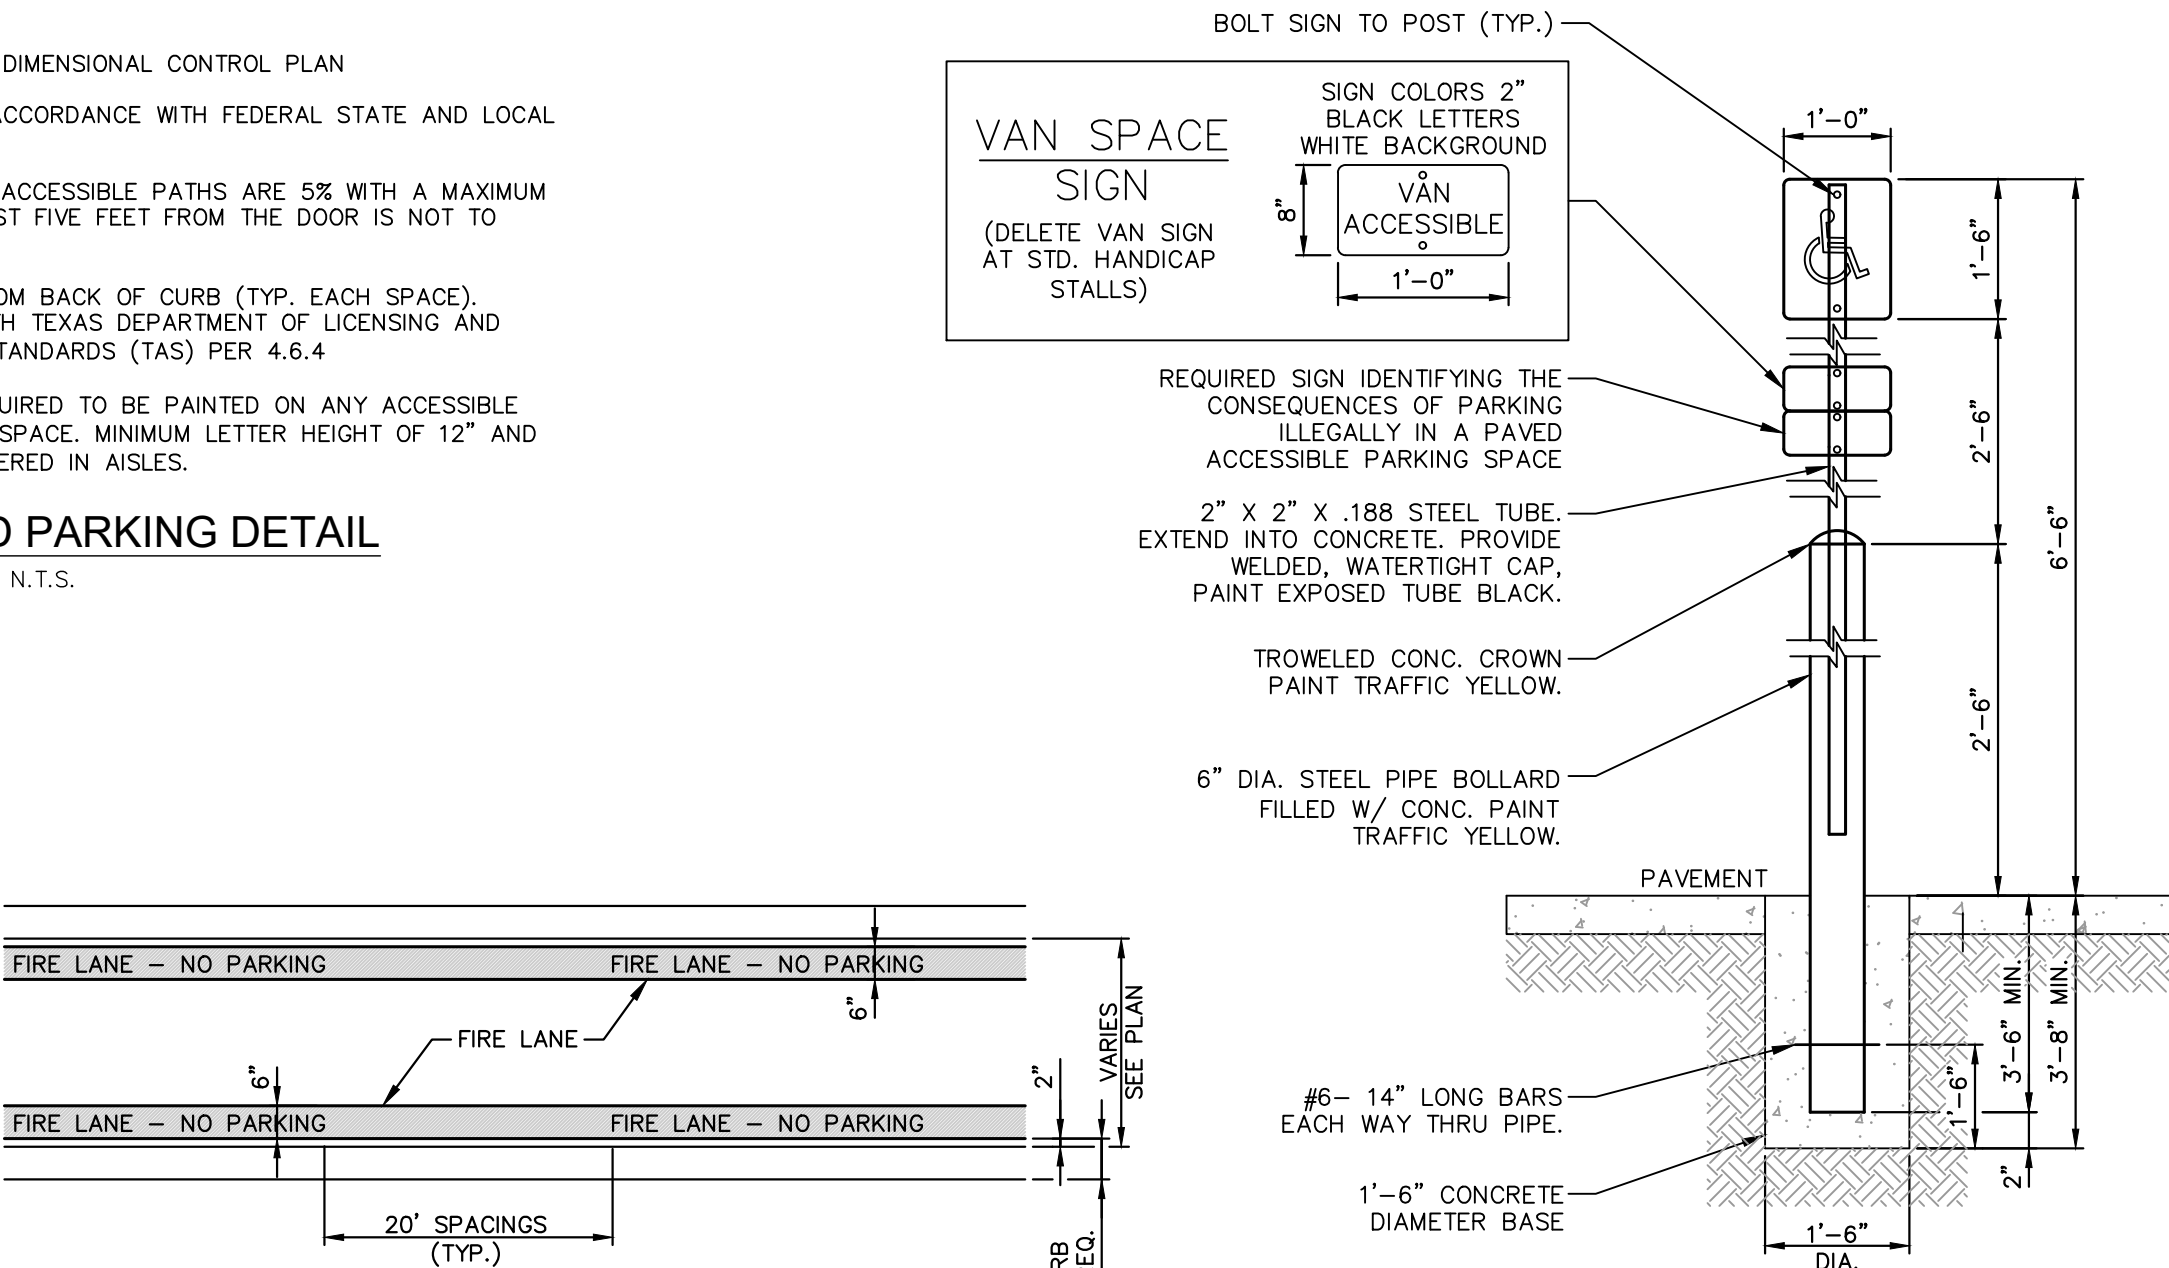

- NOTES:
- SIGN COLORS  
1.1. BACKGROUND: WHITE  
1.2. SYMBOL: BLUE
  - PROVIDE SIGNAGE AT END OF STALL AT LOCATIONS W/ ACCESSIBLE DESIGNATION TO ACT AS BUMPER STOP.
  - 1'-0"x1'-6"x .080" ALUM. HANDICAPPED PARKING SIGN. SIGN TO READ "RESERVED PARKING" W/ IDENTIFICATION SYMBOL, BOLT TO STEEL TUBE W/ 3/8" CADMIUM PLATED BOLTS, NUTS & WASHERS.
  - HANDICAP SIGNAGE TO BE IN ACCORDANCE WITH TEXAS DEPARTMENT OF LICENSING AND REGULATION TEXAS ACCESSIBILITY STANDARDS (TAS) PER 4.6.4

"HANDICAPPED PARKING" SIGN POST DETAIL

N.T.S.

PRELIMINARY

FOR REVIEW ONLY  
 Not for construction purposes.  
**CLAYMOORE ENGINEERING**  
 ENGINEERING AND PLANNING CONSULTANTS  
 Engineer: DREW DONOSKY  
 P.E. No. 125651, Date: 7/17/2024

SANGER MULTI-FAMILY  
 PREPARED FOR  
 GREYSTAR  
 SANGER, TEXAS

NO.	DATE	REVISION	BY

CONSTRUCTION DETAILS 1


DESIGN: ASD  
 DRAWN: DC  
 CHECKED: ASD  
 DATE: 7/17/2024

SHEET


C-8.1




PLOTTED BY: DAN CABALLERO  
 PLOT DATE: 7/17/2024 10:18 AM  
 LOCATION: Z:\PROJECTS\PROJECTS\2022-185 MALOUF SANGER\CADD\SHETS\MULTI-FAMILY GREYSTAR\C-31 CONSTRUCTION DETAILS 4.DWG  
 LAST SAVED: 7/16/2024 8:31 AM

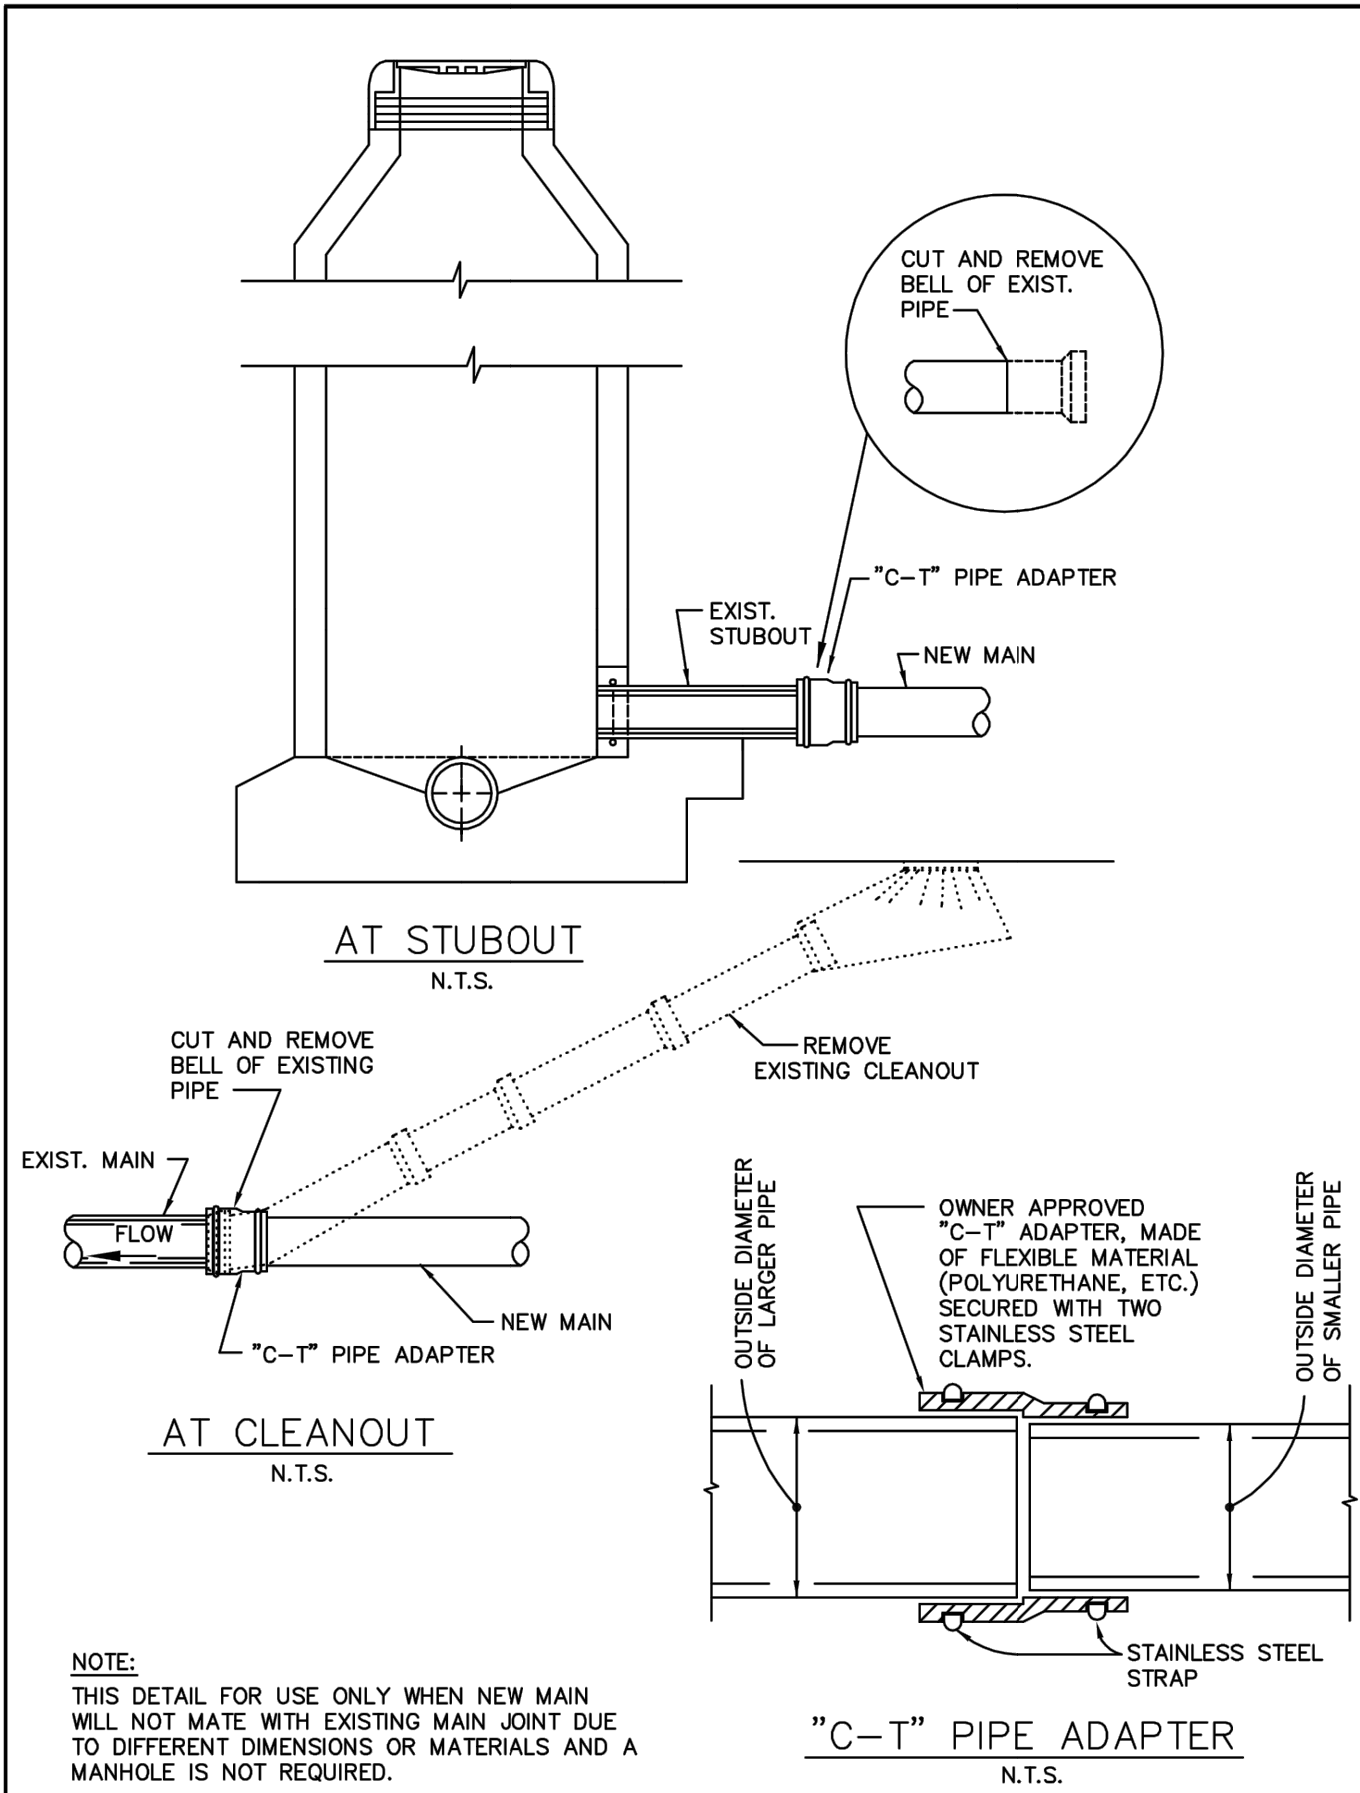


WASTEWATER MAIN TIE-IN AT CLEANOUT OR M.H. STUBOUT	North Central Texas Council of Governments	STANDARD SPECIFICATION REFERENCE 502.10
	DATE OCT. '04	STANDARD DRAWING NO. 5010

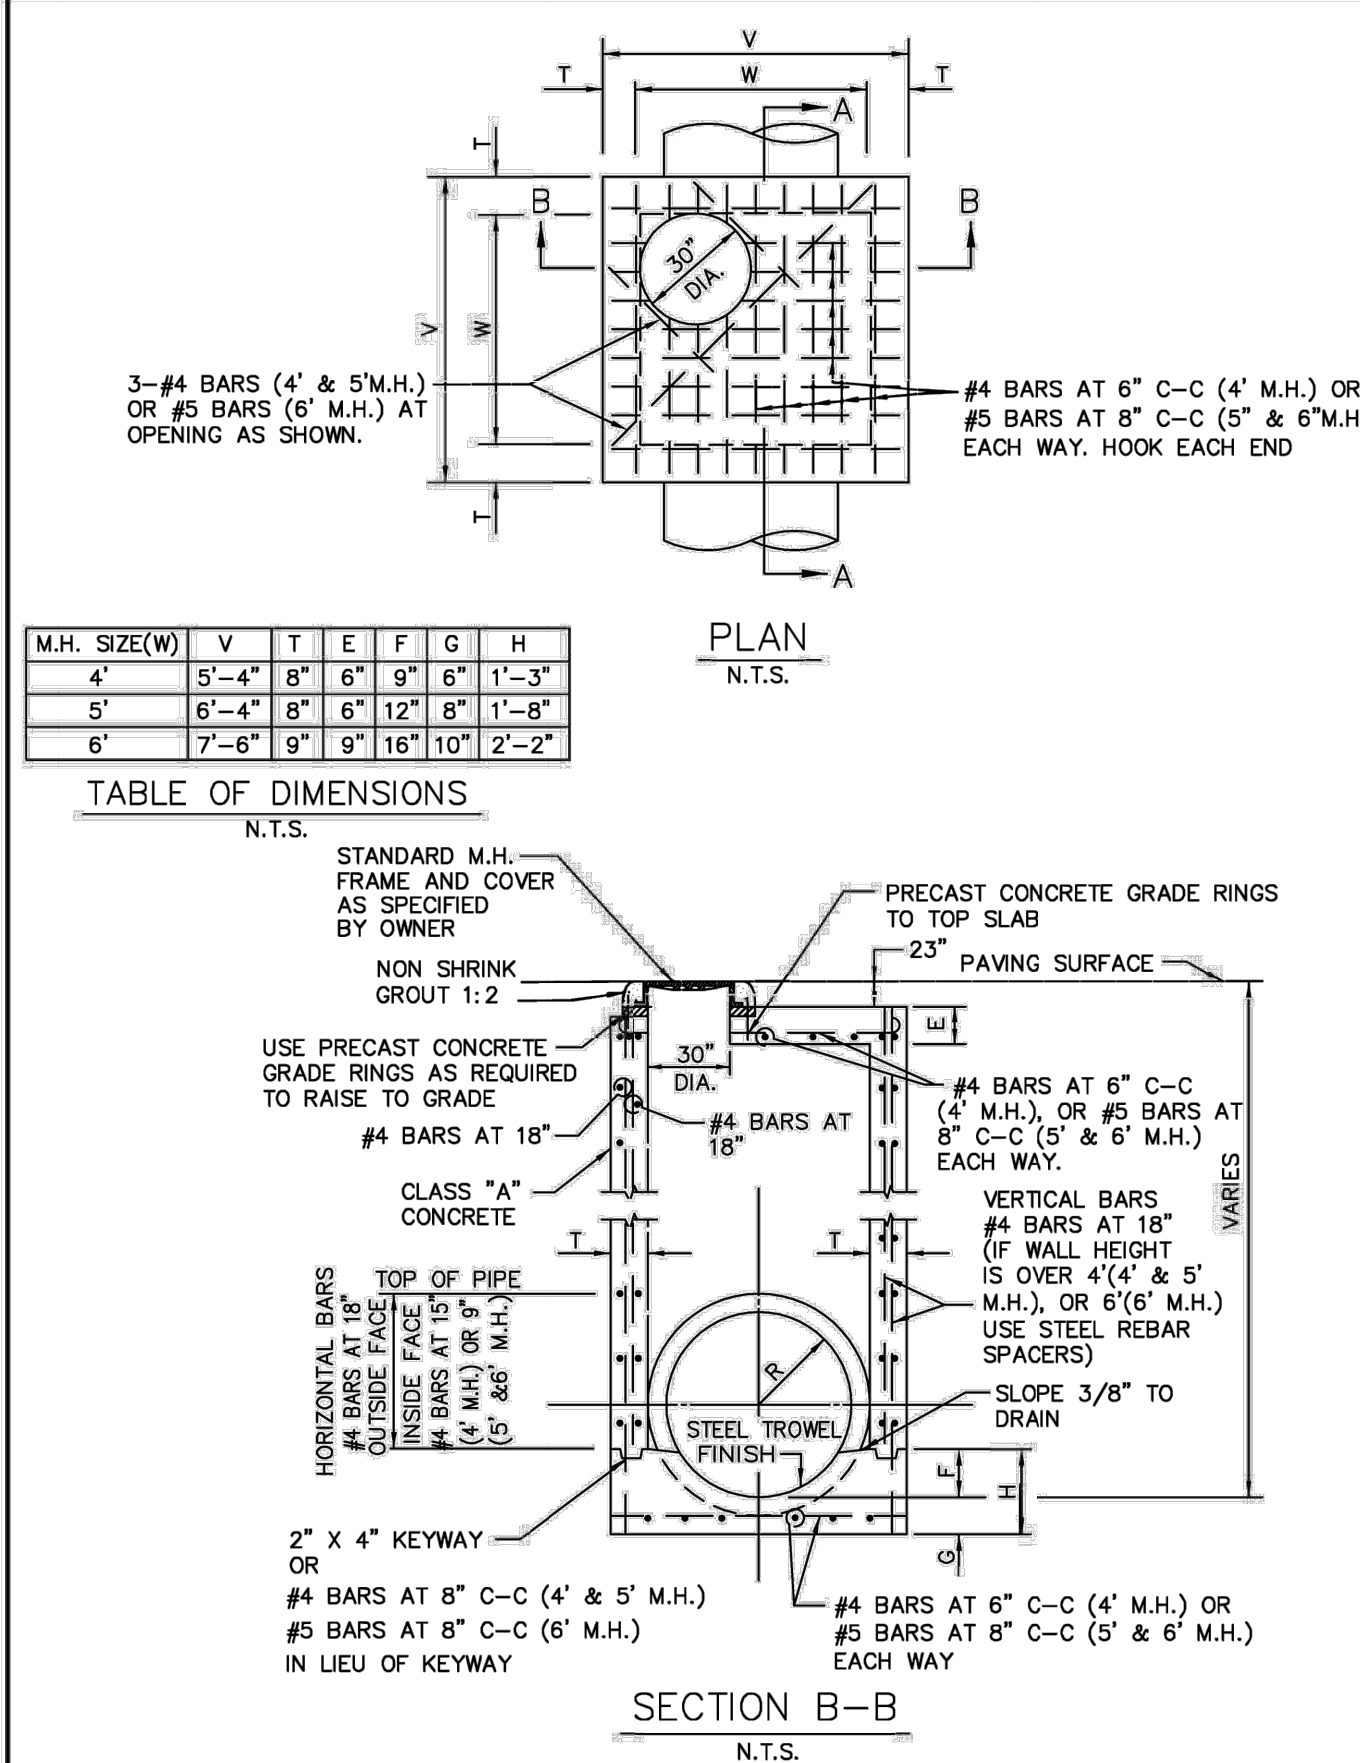


STORM WATER MANHOLE 4', 5', OR 6' SQUARE	North Central Texas Council of Governments	STANDARD SPECIFICATION REFERENCE 502.14.1*
	DATE OCT. '04	STANDARD DRAWING NO. 6010A

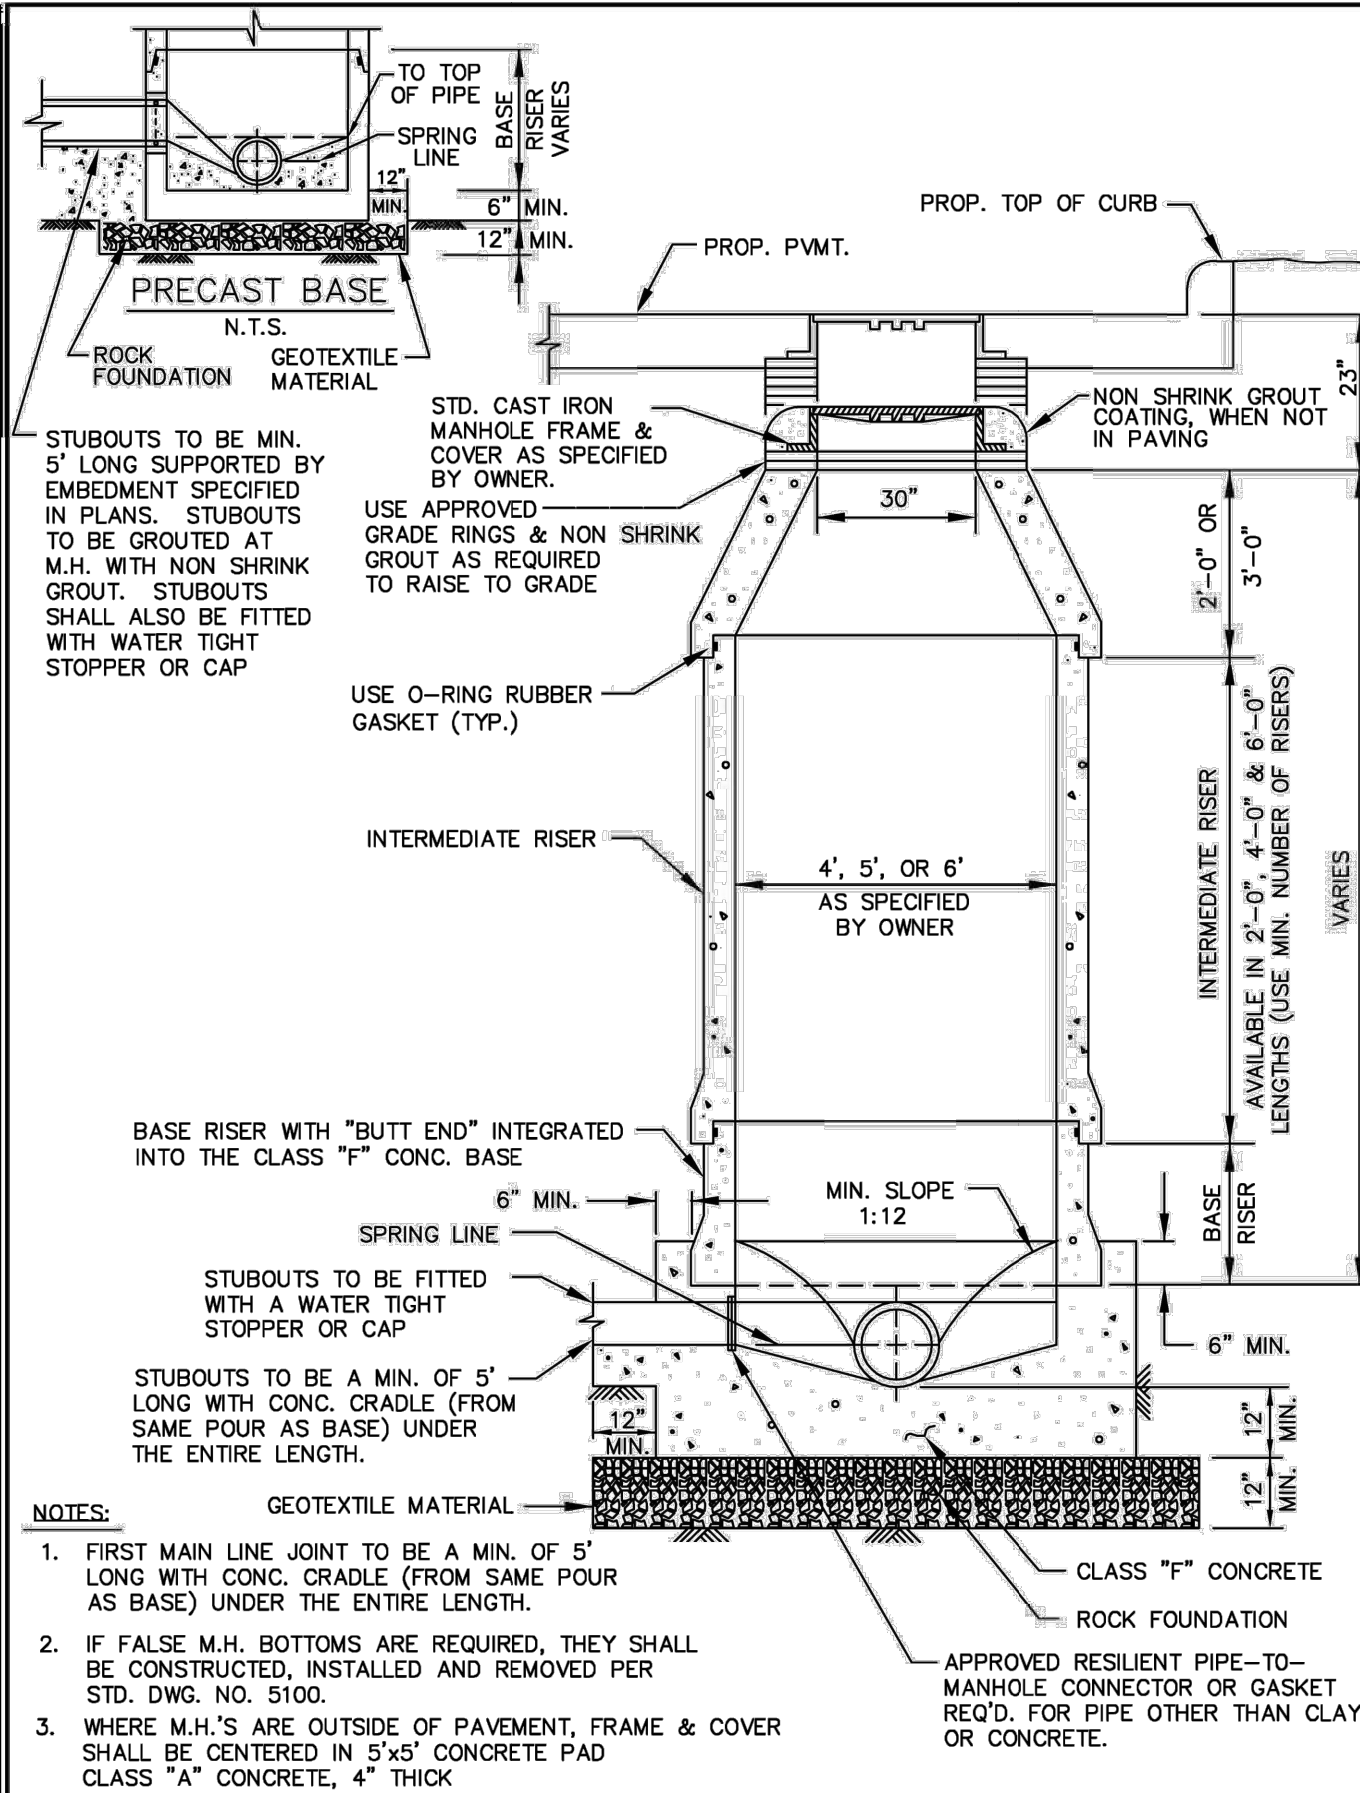


WASTEWATER MANHOLE PRECAST	North Central Texas Council of Governments	STANDARD SPECIFICATION REFERENCE 502.1.4.12*
	DATE OCT. '04	STANDARD DRAWING NO. 5020

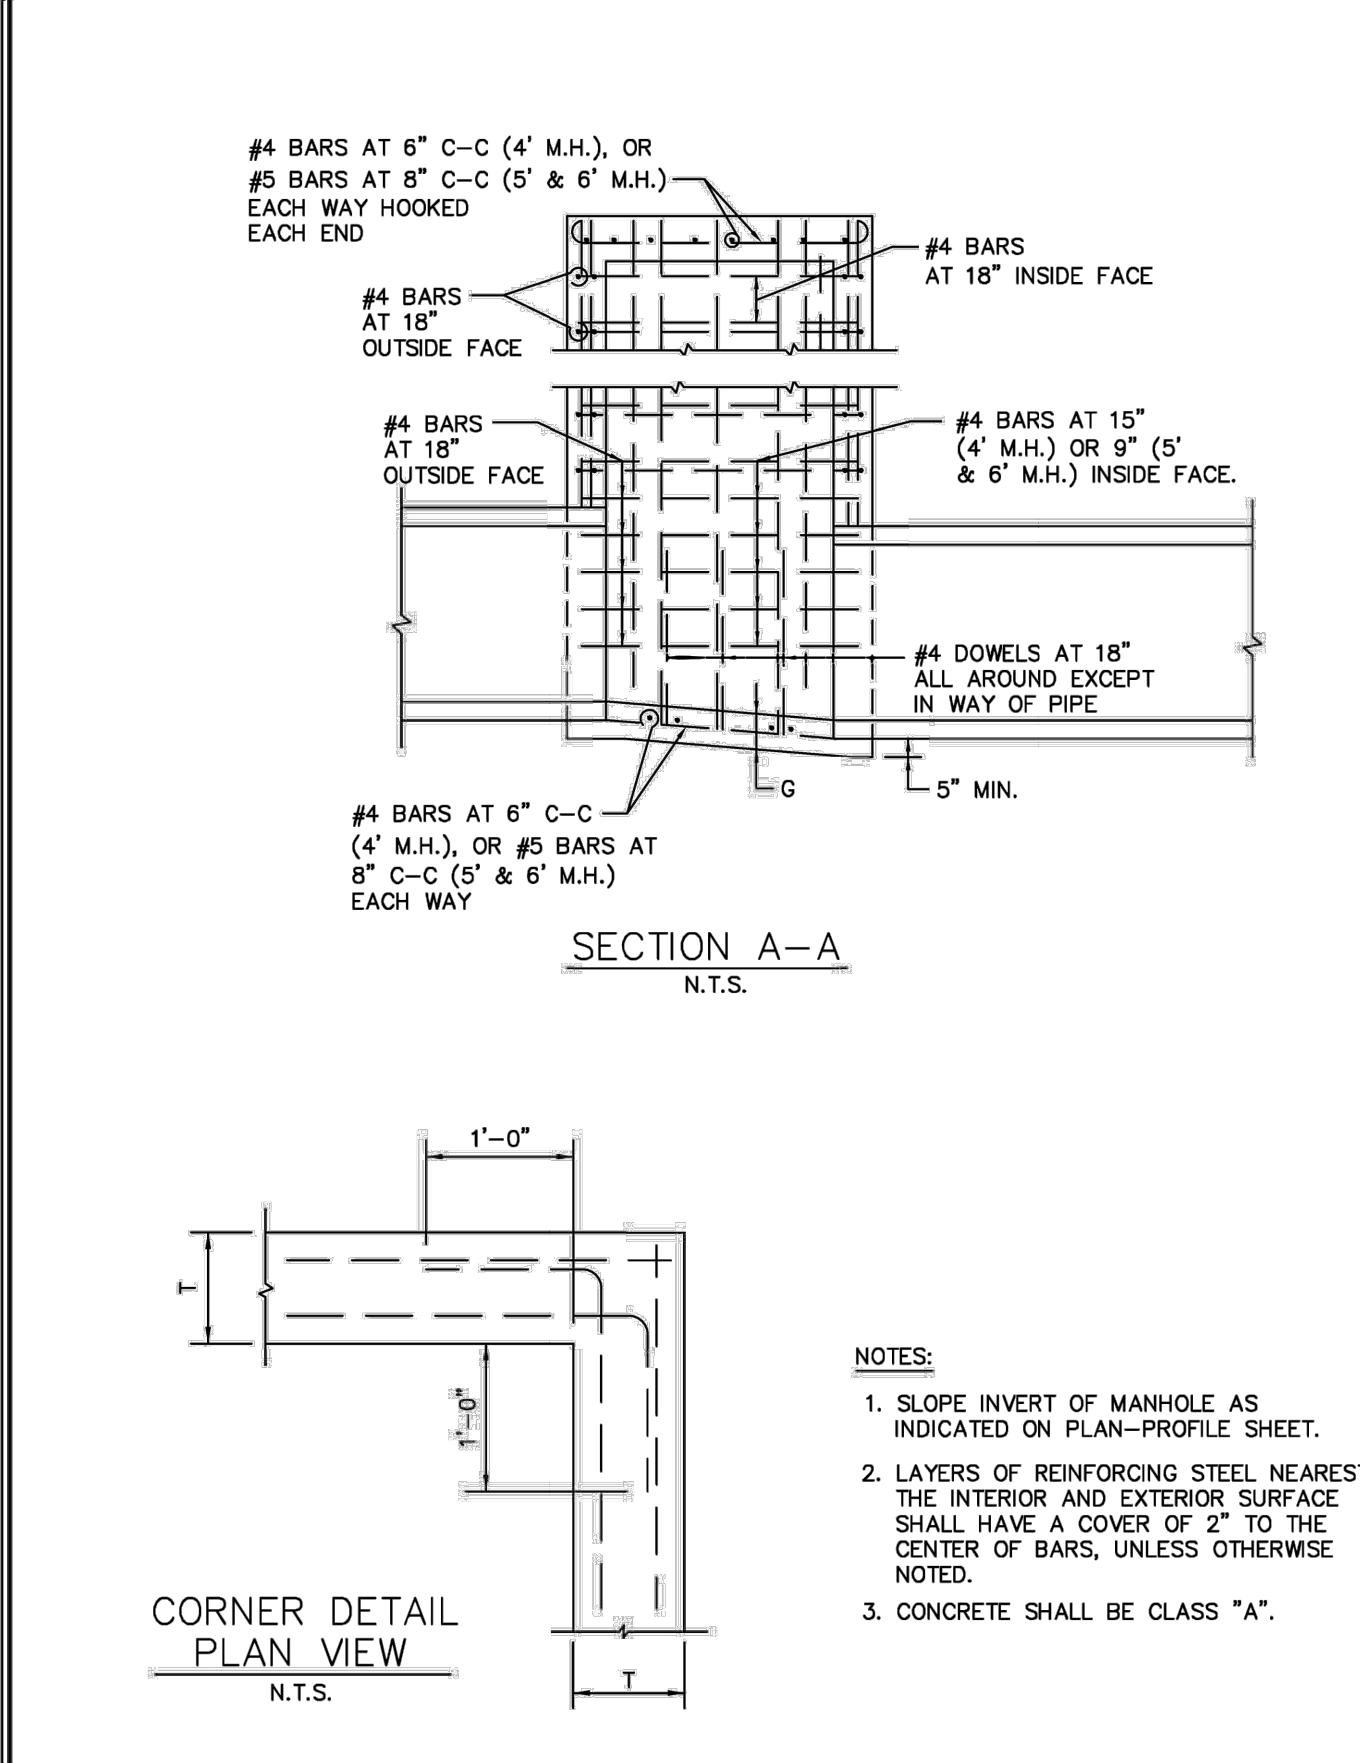


STORM WATER MANHOLE 4', 5', OR 6' SQUARE	North Central Texas Council of Governments	STANDARD SPECIFICATION REFERENCE 502.14.1*
	DATE OCT. '04	STANDARD DRAWING NO. 6010B

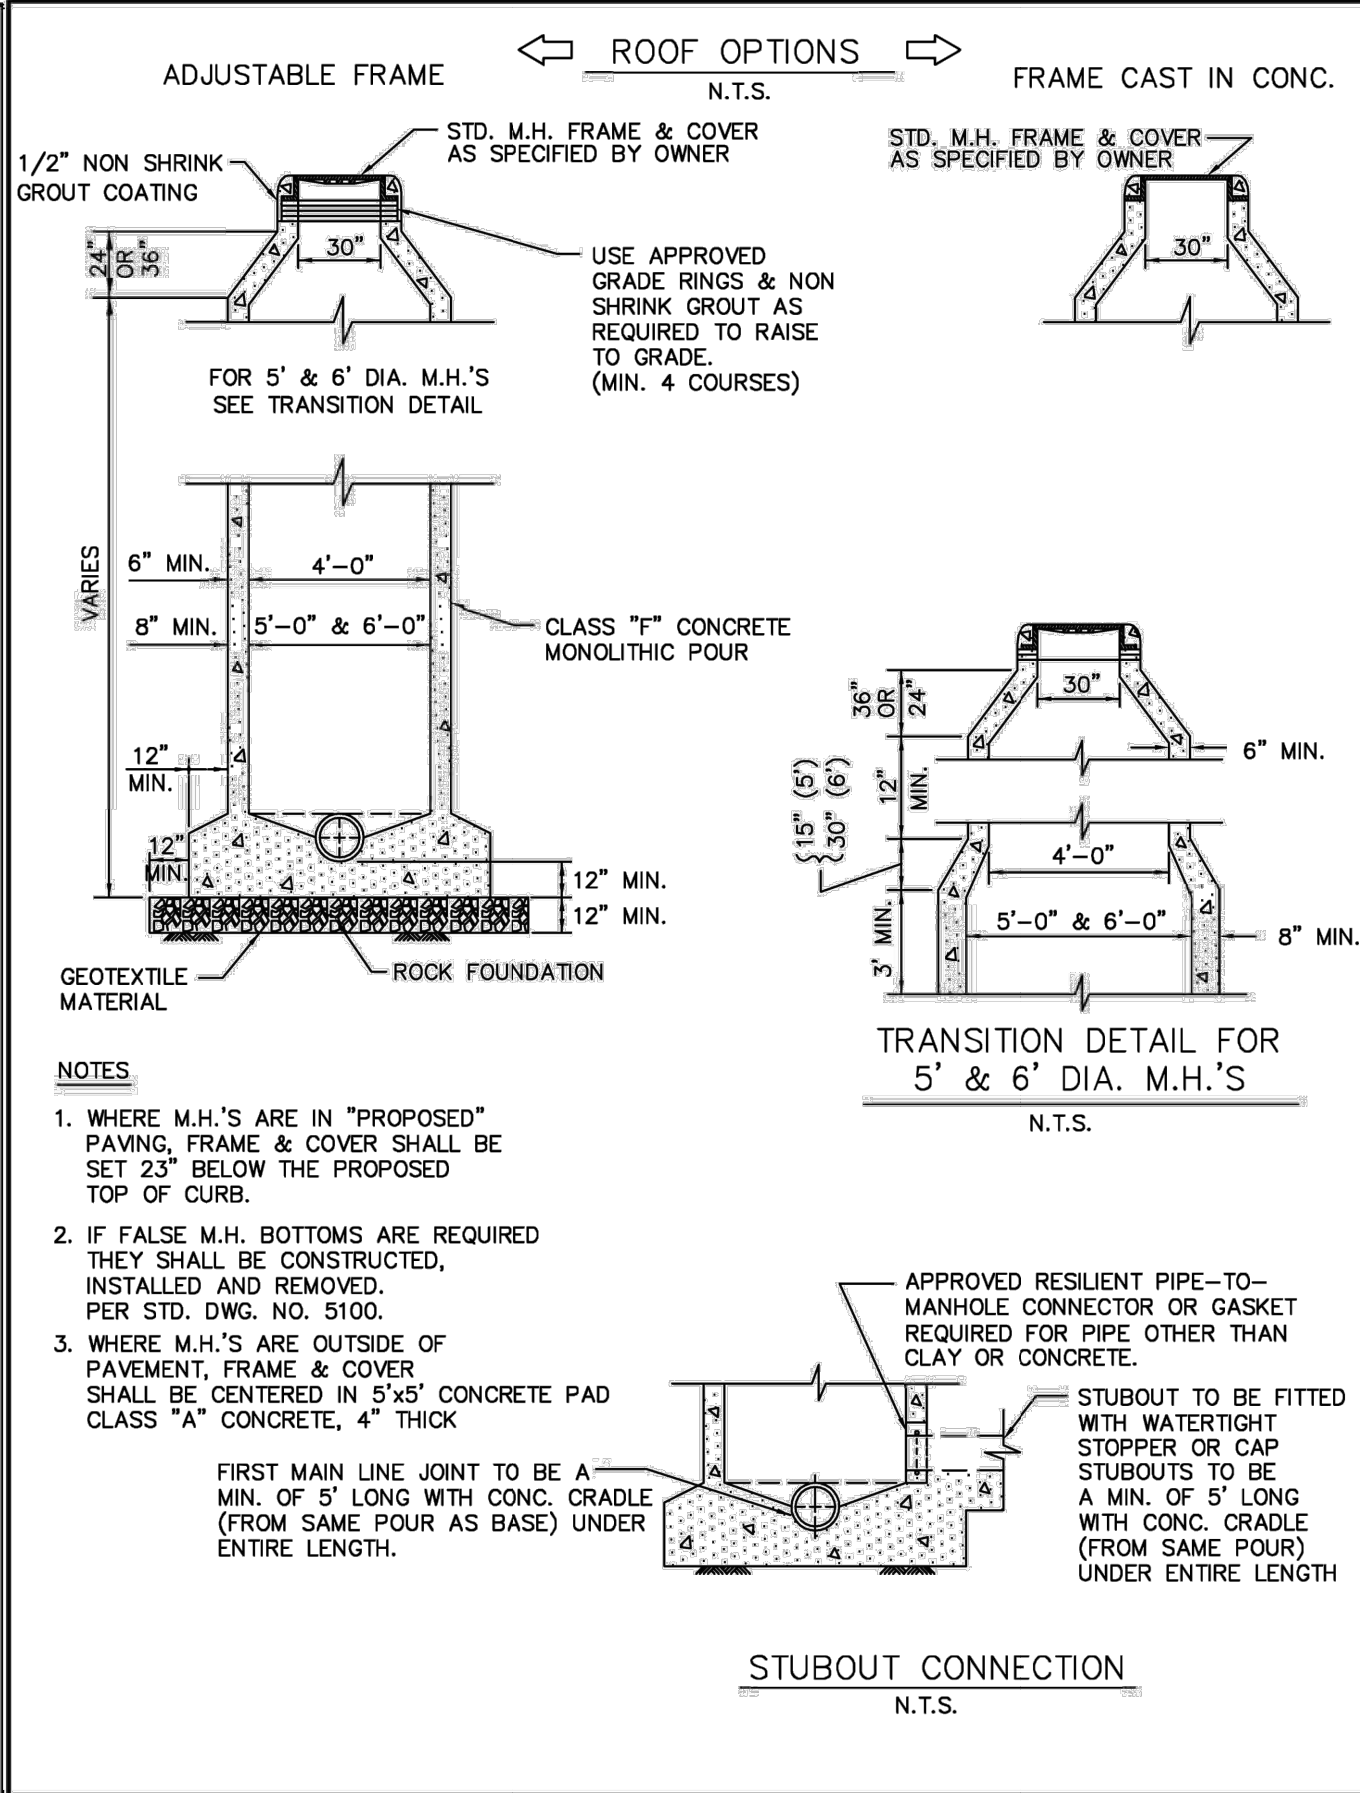


WASTEWATER MANHOLE CAST-IN-PLACE	North Central Texas Council of Governments	STANDARD SPECIFICATION REFERENCE 502.14.1.1*
	DATE OCT. '04	STANDARD DRAWING NO. 5030

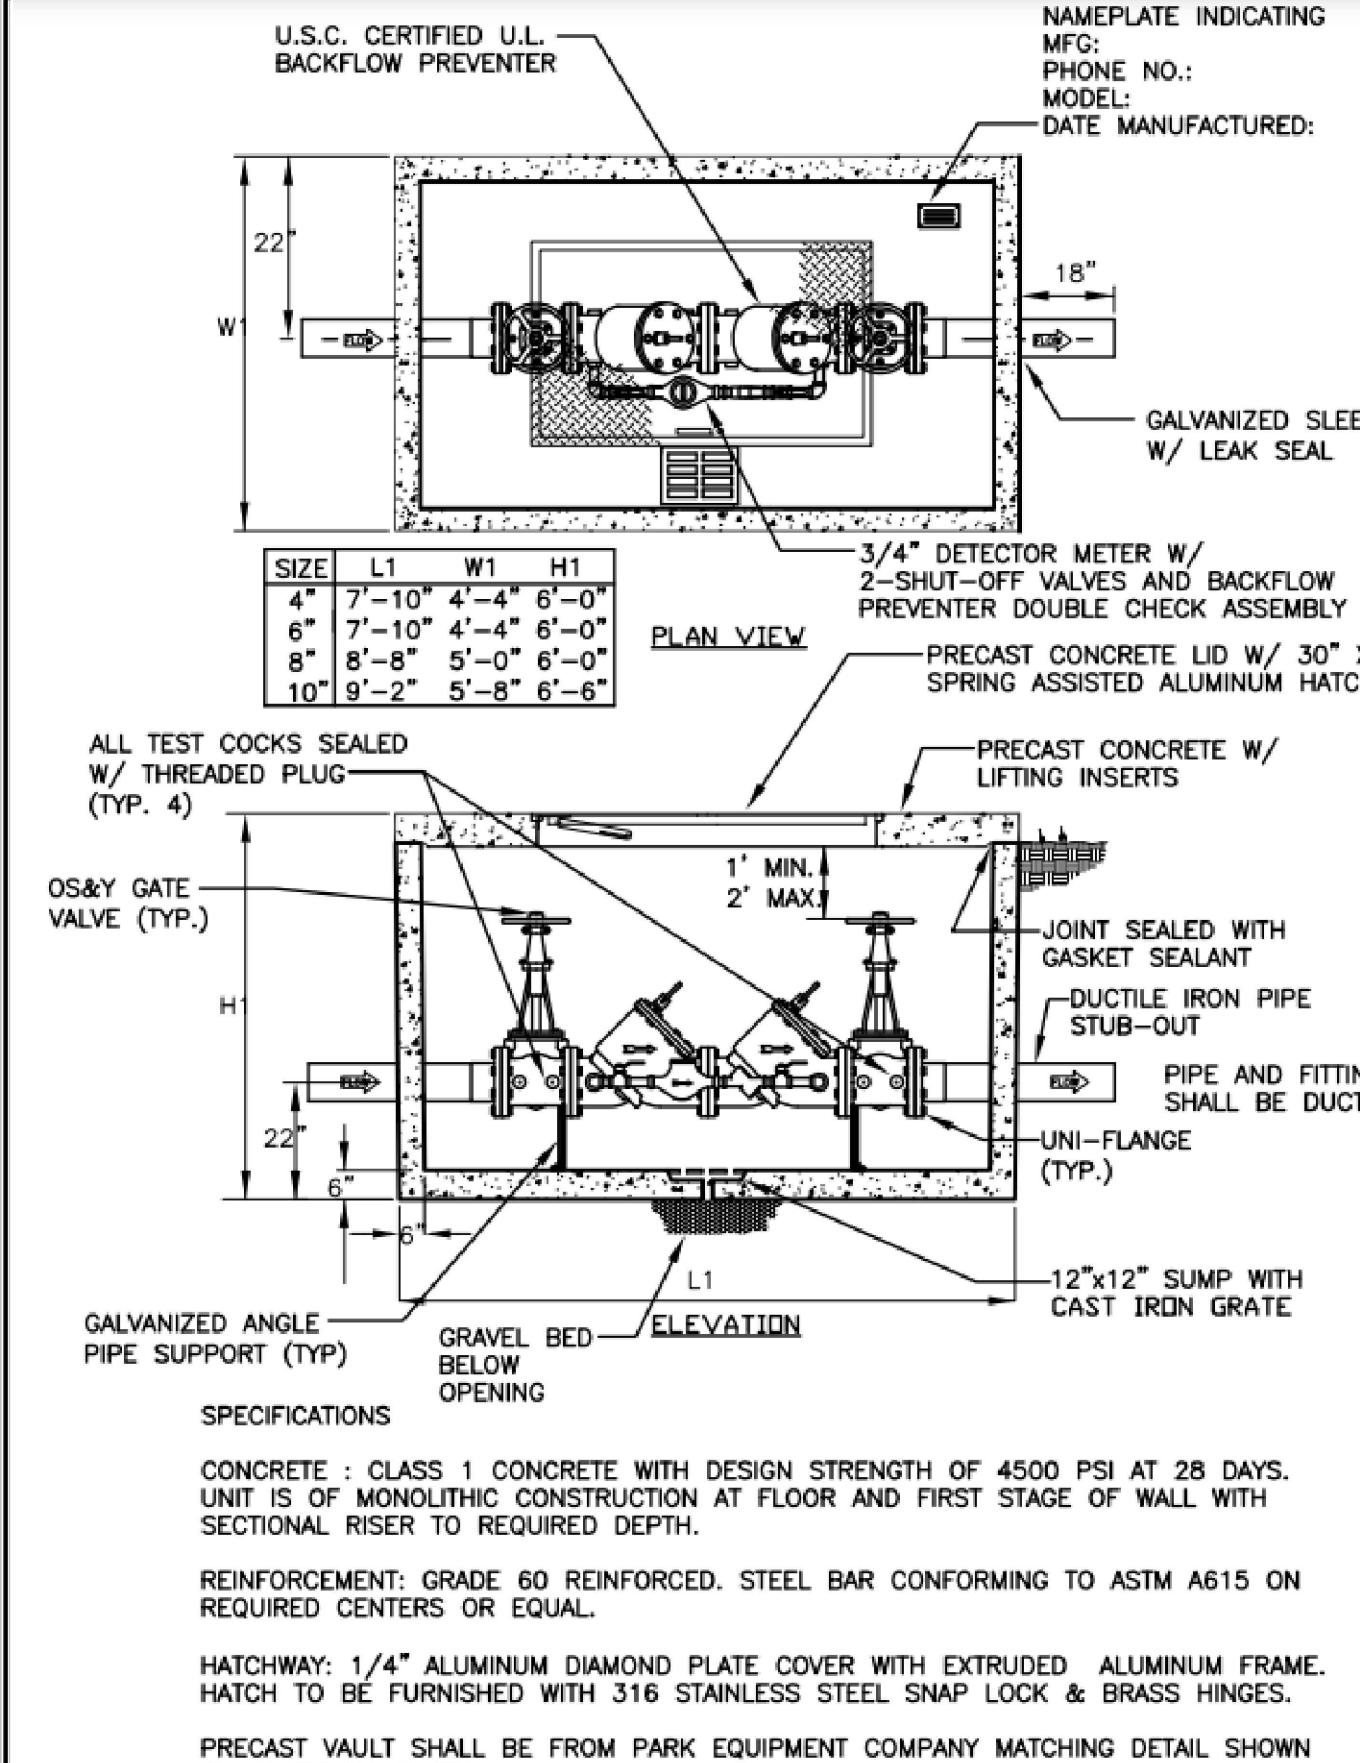

DOUBLE DETECTOR CHECK FIRE VAULT	North Central Texas Council of Governments	STANDARD SPECIFICATION REFERENCE 502.14.1*
	DATE OCT. '04	STANDARD DRAWING NO. 6010B

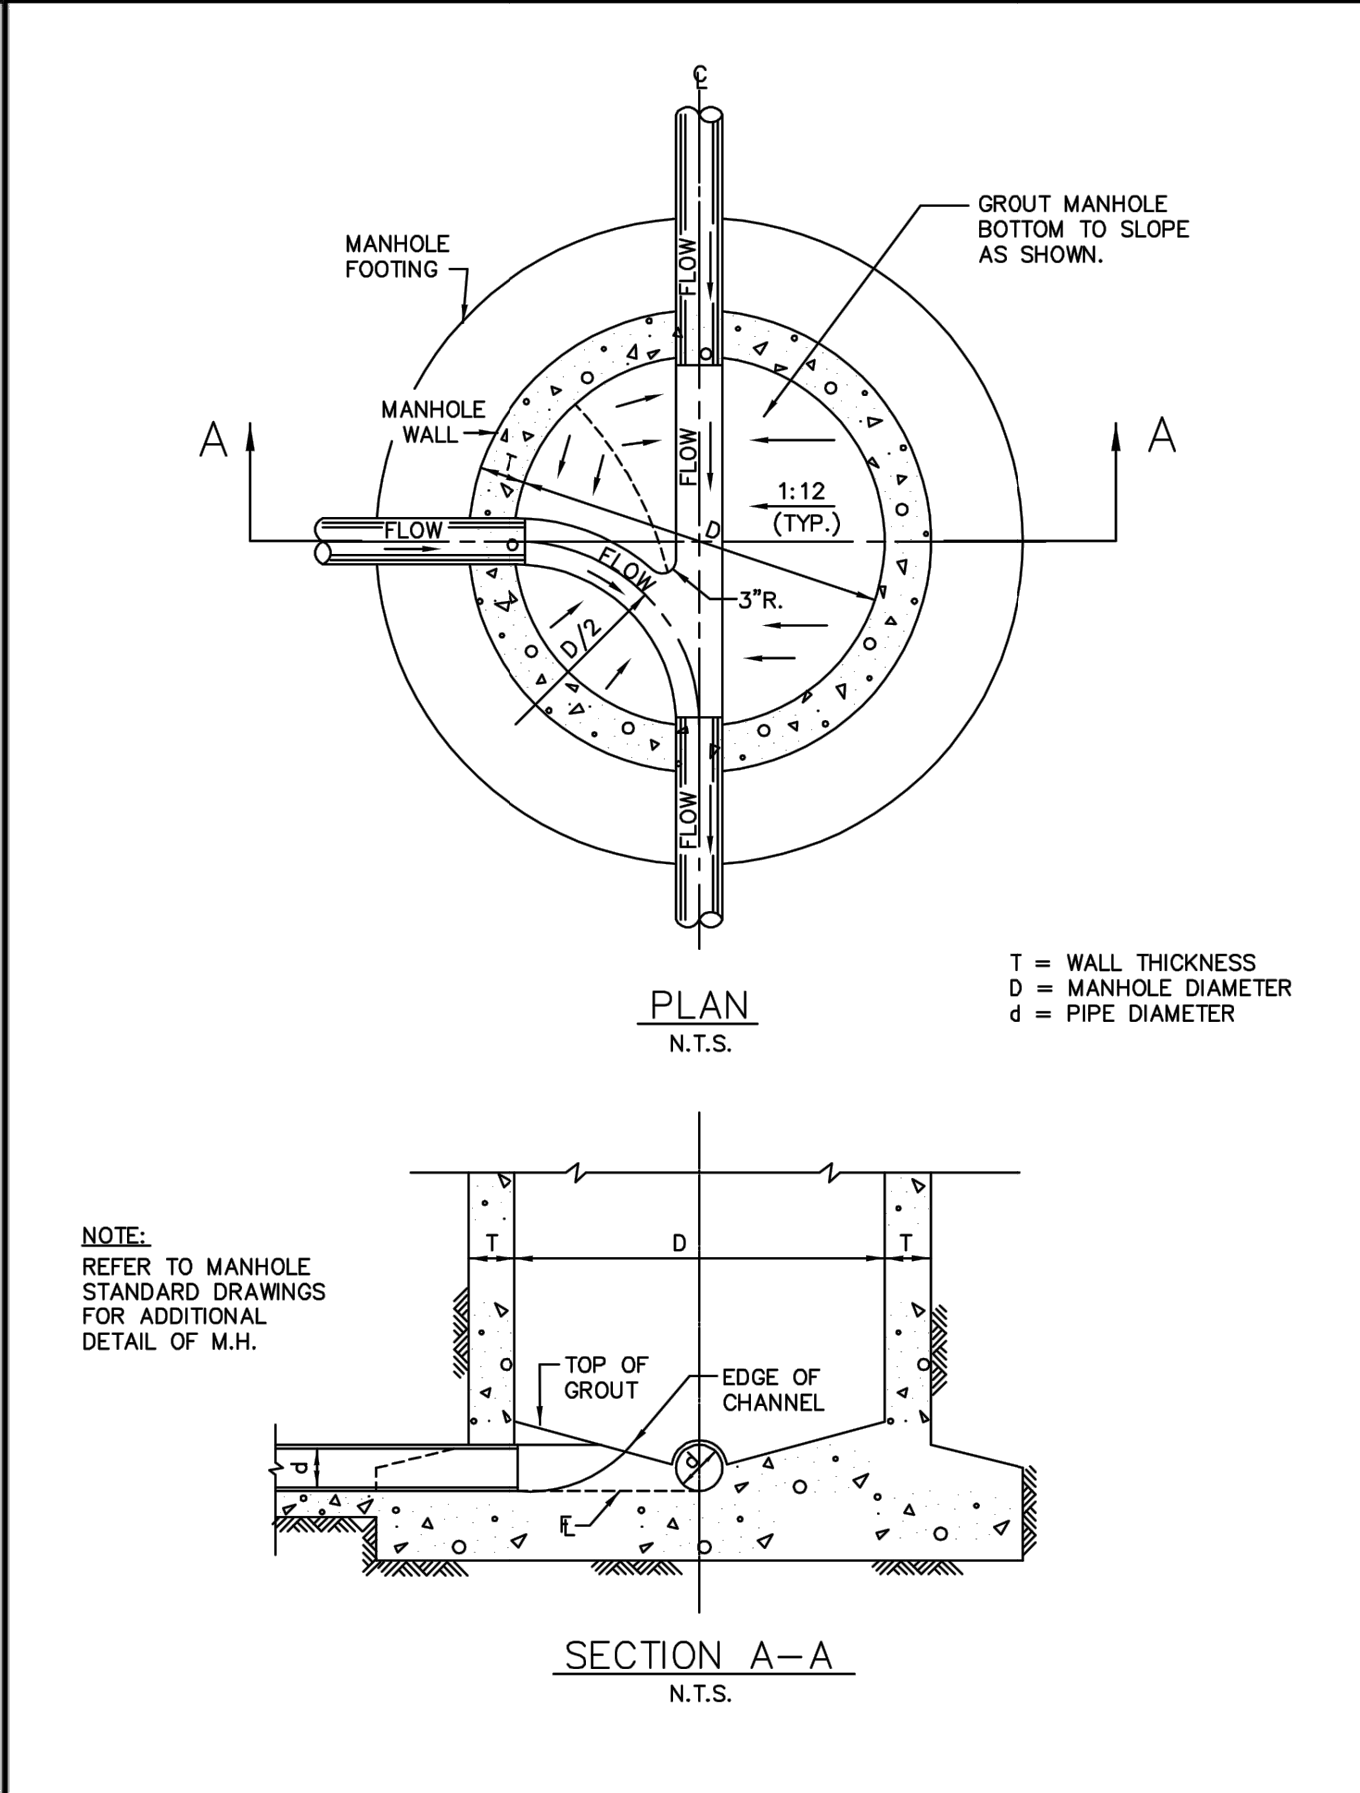



WASTEWATER MANHOLE LINE INTERSECTION	North Central Texas Council of Governments	STANDARD SPECIFICATION REFERENCE 502.1
	DATE OCT. '04	STANDARD DRAWING NO. 5090

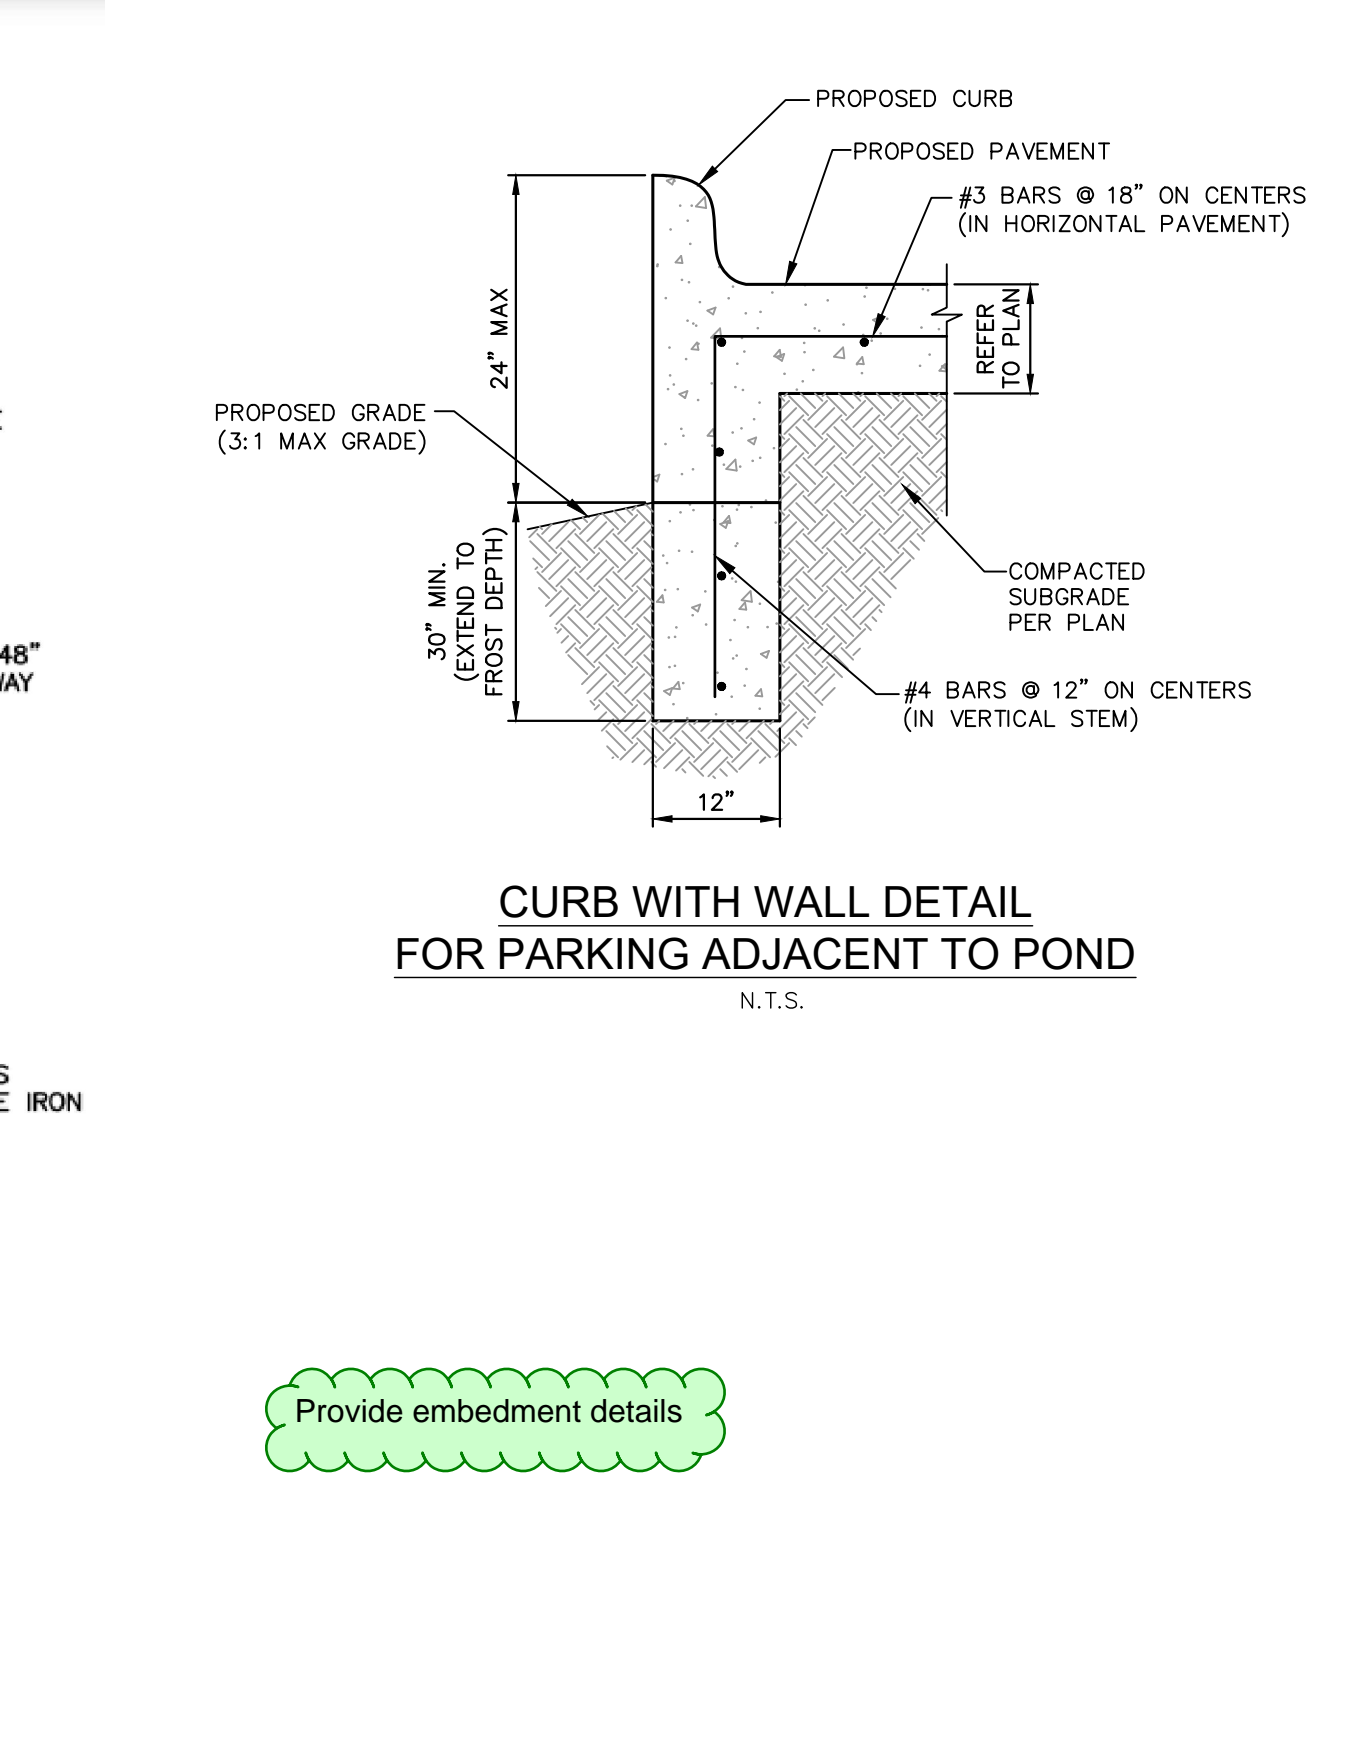


NO.	DATE	REVISION	BY



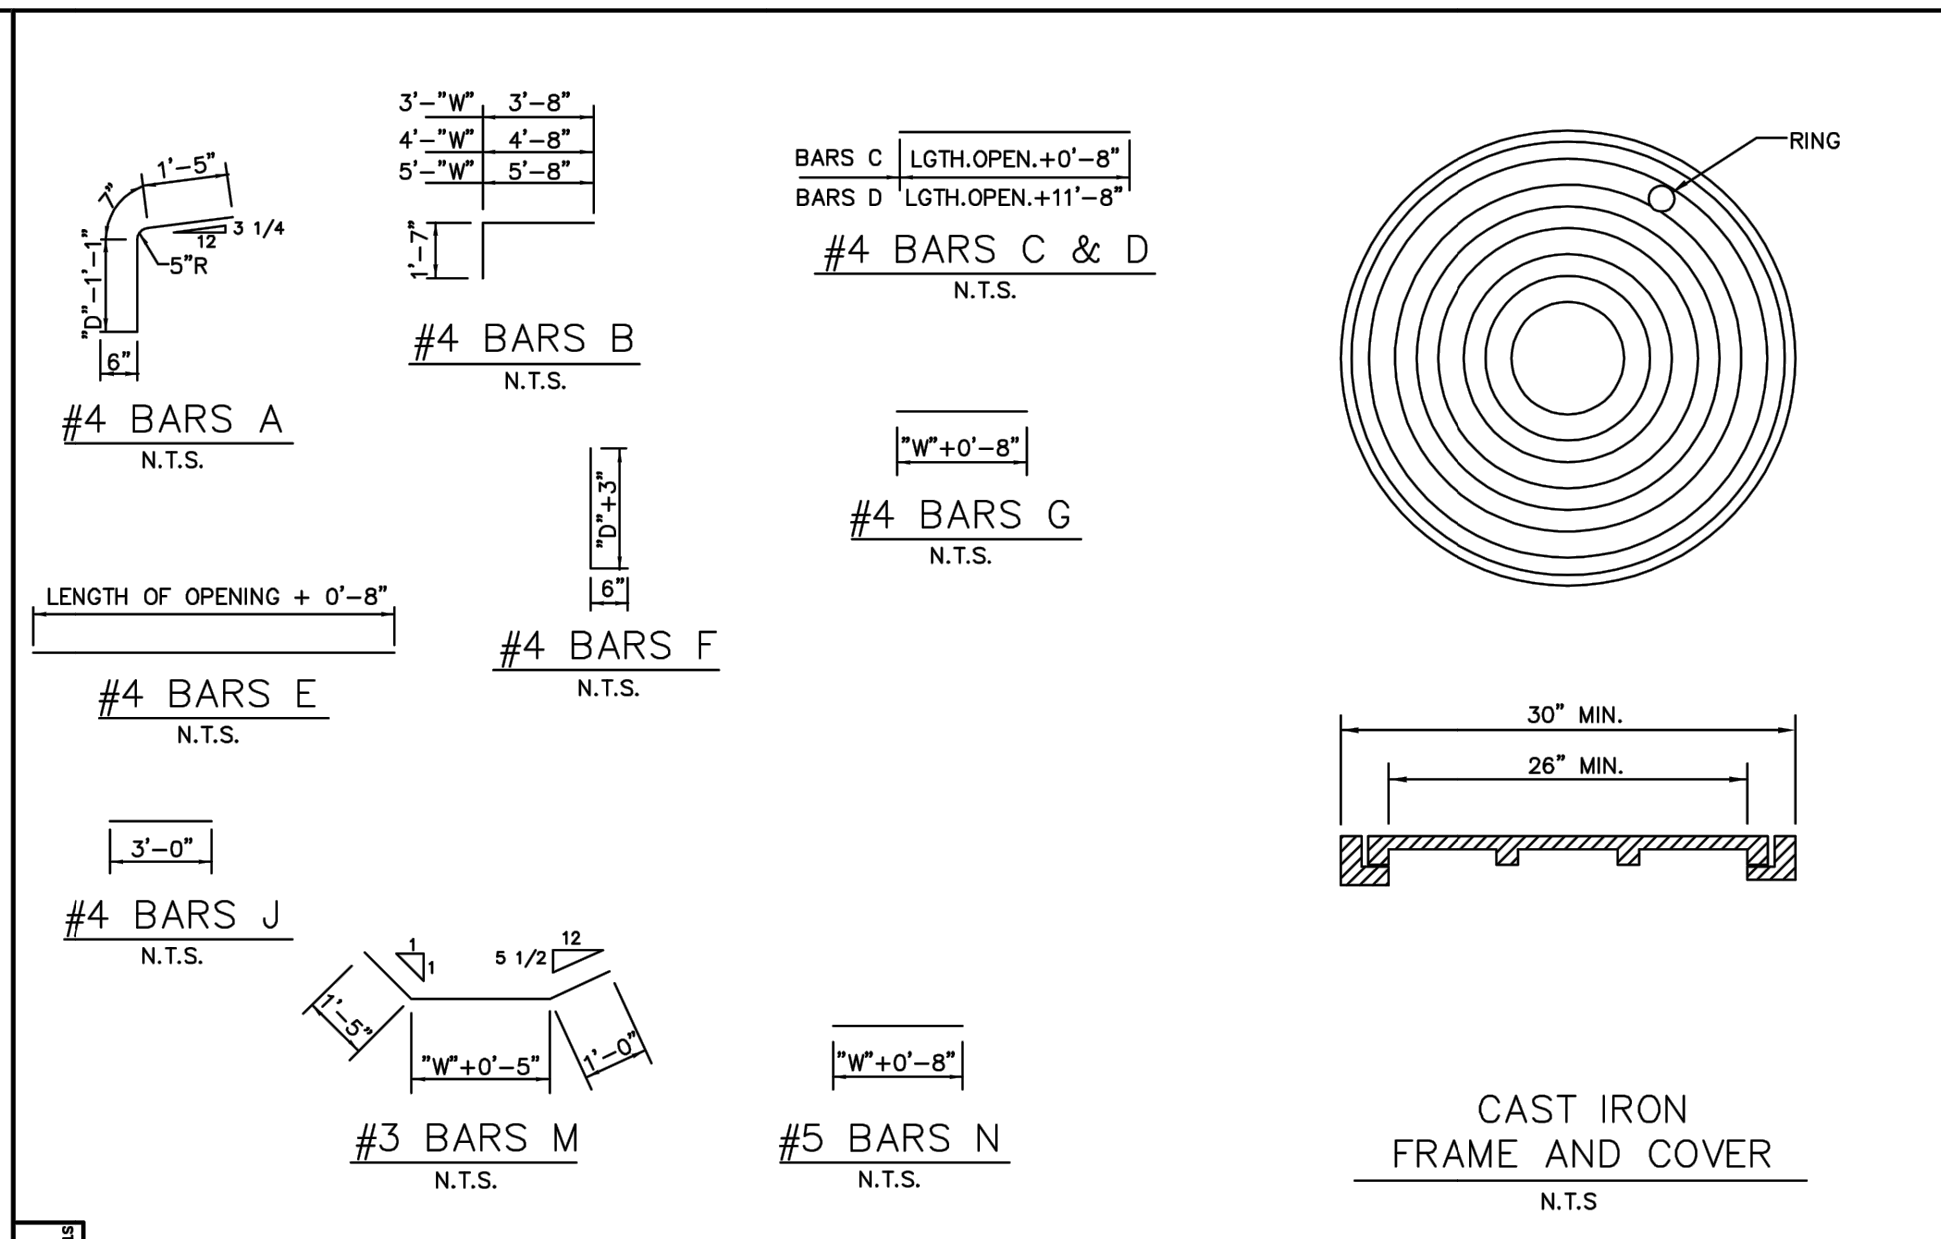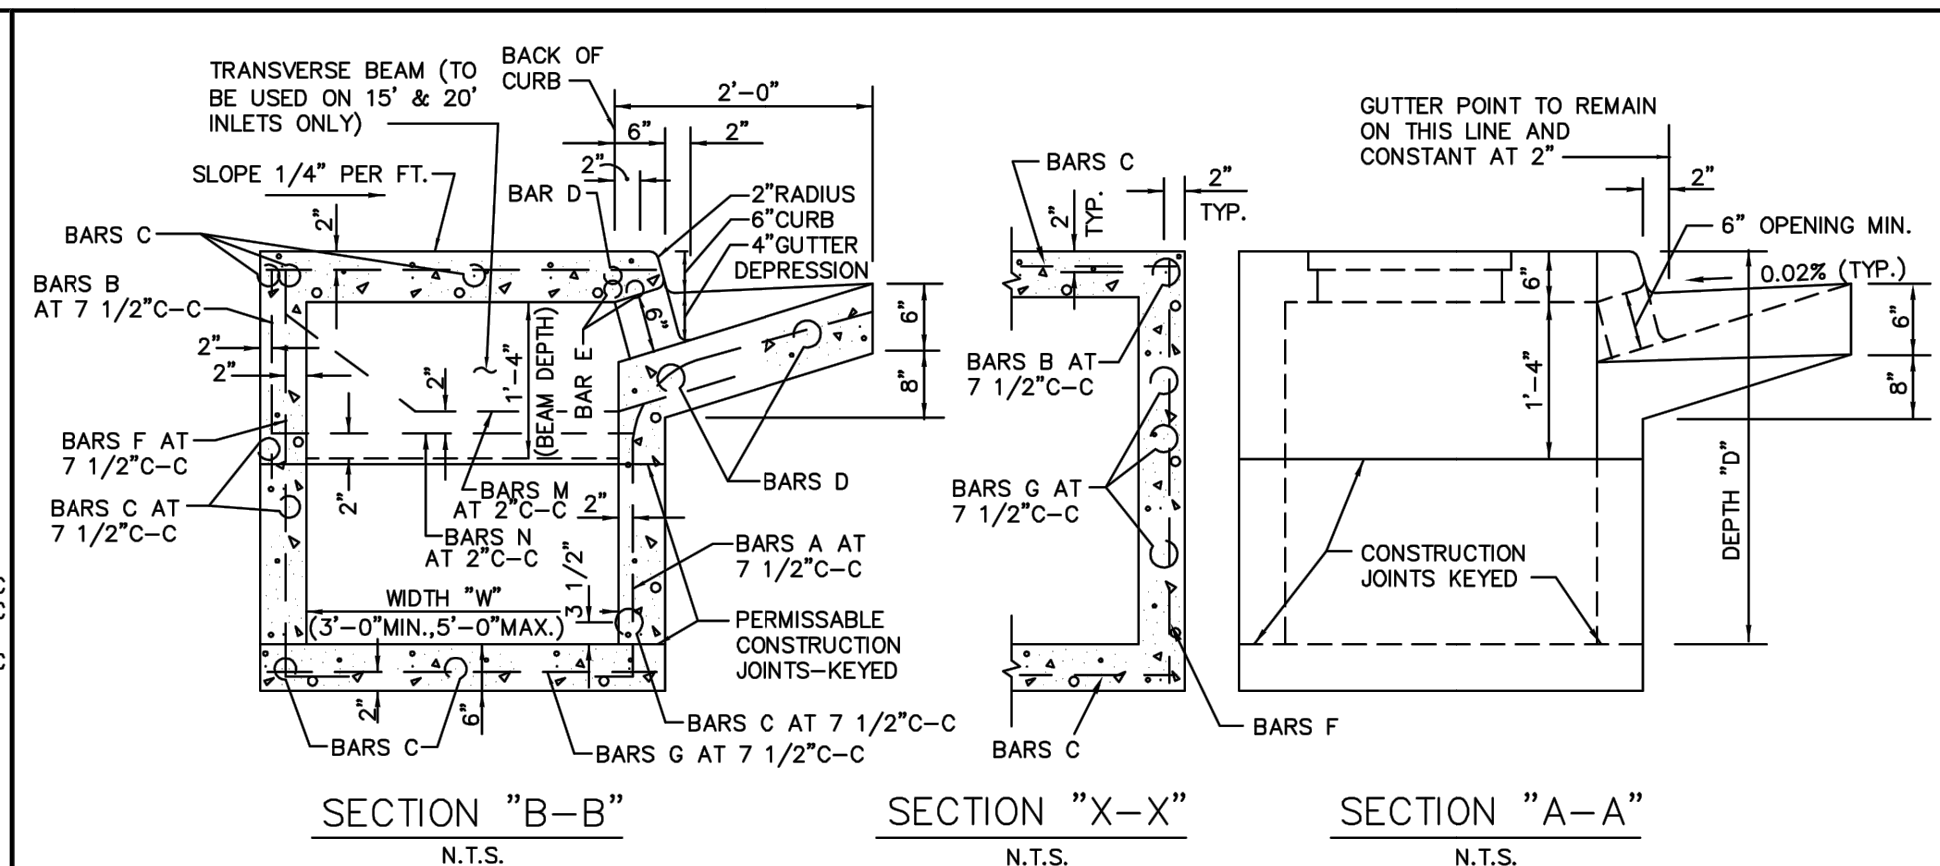

N.T.S. 6020A	CURB INLET	North Central Texas Council of Governments 	STANDARD SPECIFICATION REFERENCE 702	
	5', 10', 15' OR 20' OPENING		DATE: OCT. '04	STANDARD DRAWING NO. 6020A

STANDARD DRAWING NO. 6020B 18	CURB INLET	North Central Texas Council of Governments 	STANDARD SPECIFICATION REFERENCE 702
	CROSS SECTION & INLET THROAT		DATE OCT. '04


STANDARD DRAWING NO. <b>6020C</b> 13	CURB INLET		North Central Texas Council of Governments 	STANDARD SPECIFICATION REFERENCE <b>702</b>	
	REBAR & M.H. FRAME & COVER			DATE OCT. '04	STANDARD DRAWING NO. <b>6020C</b>


DEPTH "D"		SUMMARY OF QUANTITIES FOR CURB INLETS																						
		5'-0" OPENING						10'-0" OPENING			15'-0" OPENING			20'-0" OPENING										
		WIDTH 3'-0"		WIDTH 4'-0"		WIDTH 5'-0"		WIDTH 3'-0"		WIDTH 4'-0"	WIDTH 5'-0"	WIDTH 3'-0"		WIDTH 4'-0"	WIDTH 5'-0"	WIDTH 3'-0"		WIDTH 4'-0"		WIDTH 5'-0"				
	CONC. C.Y.	STEEL LBS.	CONC. C.Y.	STEEL LBS.	CONC. C.Y.	STEEL LBS.	CONC. C.Y.	STEEL LBS.	CONC. C.Y.	STEEL LBS.	CONC. C.Y.	STEEL LBS.	CONC. C.Y.	STEEL LBS.	CONC. C.Y.	STEEL LBS.	CONC. C.Y.	STEEL LBS.	CONC. C.Y.	STEEL LBS.	CONC. C.Y.	STEEL LBS.		
3'-6"	2.62	306	2.95	332	328	373	4.12	479	4.64	521	5.20	564	5.69	667	6.40	721	7.10	775	7.20	846	8.11	909	9.03	976
3'-9"	2.70	309	3.04	341	338	373	4.25	494	4.78	536	5.34	579	5.87	687	6.58	741	7.30	796	7.42	874	8.34	937	9.27	1010
4'-0"	2.78	328	3.14	364	349	399	4.38	518	4.92	565	5.49	610	6.05	712	6.77	776	7.49	835	7.64	890	8.58	951	9.51	1046
4'-3"	2.87	334	3.23	370	359	406	4.51	526	5.06	573	5.64	619	6.22	729	6.95	787	7.69	847	7.87	922	8.81	990	9.75	1068
4'-6"	2.95	356	3.32	394	369	431	4.64	558	5.20	607	5.79	655	6.40	770	7.14	830	7.88	891	8.09	973	9.04	1043	9.99	1115
4'-9"	3.03	361	3.41	410	379	438	4.77	566	5.34	616	5.94	665	6.57	780	7.32	841	8.07	903	8.31	986	9.27	1056	10.23	1129
5'-0"	3.12	367	3.51	416	390	445	4.90	574	5.47	624	6.09	674	6.75	791	7.51	853	8.27	915	8.53	999	9.50	1070	10.47	1144
5'-3"	3.20	383	3.60	424	400	465	5.03	600	5.61	652	6.23	704	6.93	827	7.69	890	8.46	955	8.76	1044	9.73	1118	10.71	1194
5'-6"	3.28	389	3.69	430	410	472	5.16	608	5.75	661	6.38	713	7.1	837	7.88	901	8.66	967	8.98	1057	9.97	1131	10.95	1208
5'-9"	3.37	405	3.78	451	420	495	5.29	635	5.89	690	6.53	744	7.28	874	8.07	940	8.85	1007	9.20	1092	10.27	1178	11.19	1258
6'-0"	3.45	415	3.88	460	430	504	5.42	646	6.03	702	6.68	757	7.45	888	8.25	954	9.05	1022	9.42	1119	10.43	1196	11.43	1276
6'-3"	3.53	425	3.97	470	441	515	5.55	661	6.17	718	6.83	773	7.63	908	8.44	975	9.24	1044	9.64	1147	10.66	1232	11.67	1305
6'-6"	3.62	437	4.06	486	451	532	5.68	681	6.31	739	6.97	797	7.81	935	8.62	1005	9.43	1057	9.87	1178	10.89	1258	11.92	1340
6'-9"	3.70	441	4.15	496	461	537	5.81	688	6.45	747	7.12	806	7.98	945	8.81	1051	9.63	1066	10.09	1191	11.12	1272	11.25	1355
7'-0"	3.78	460	4.25	510	471	560	5.94	716	6.59	777	7.27	837	8.16	991	8.99	1053	9.82	1126	10.31	1237	11.35	1319	12.40	1404
7'-3"	3.86	465	4.34	516	481	567	6.07	724	6.72	785	7.42	846	8.33	992	9.18	1065	10.02	1138	10.53	1249	11.59	1339	12.64	1418
7'-6"	3.95	477	4.43	529	491	570	6.24	766	6.86	804	7.57	866	8.51	1016	9.36	1089	10.21	1163	10.75	1290	11.82	1365	12.88	1451
7'-9"	4.03	491	4.53	544	502	597	6.33	762	7.00	826	7.71	890	8.67	1040	9.55	1116	10.41	1193	10.98	1313	12.05	1399	13.12	1498
8'-0"	4.12	496	4.62	550	512	604	6.46	770	7.14	834	7.86	899	8.86	1051	9.73	1129	10.60	1205	11.20	1325	12.28	1412	13.36	1510
8'-3"	4.20	504	4.71	559	522	613	6.59	784	7.28	849	8.01	915	9.04	1069	9.92	1149	10.80	1228	11.42	1353	12.51	1440	13.60	1529
8'-6"	4.28	519	4.80	576	532	632	6.71	804	7.42	816	8.16	938	9.21	1107	10.10	1176	10.99	1257	11.64	1385	12.74	1474	13.84	1565
8'-9"	4.37	528	4.90	586	542	643	6.84	819	7.56	886	8.31	954	9.39	1119	10.29	1199	11.18	1280	11.87	1410	12.97	1500	14.08	1592
9'-0"	4.45	545	4.99	605	563	664	6.97	842	7.70	912	8.46	982	9.56	1148	10.47	1231	11.38	1313	12.09	1447	13.21	1549	14.32	1631
9'-3"	4.53	554	5.08	614	5.63	674	7.10	858	7.84	929	8.60	999	9.74	1169	10.66	1252	11.57	1335	12.31	1474	13.44	1563	14.56	1660
9'-6"	4.62	568	5.17	630	5.73	692	7.23	878	7.97	950	8.75	1022	9.92	1195	10.84	1280	11.17	1365	12.53	1505	13.67	1601	14.80	1796
10'-0"	4.78	582	5.36	645	5.93	708	7.49	900	8.11	974	9.05	1048	10.99	1227	11.21	1312	12.16	1399	12.98	1546	14.13	1642	15.29	1939

NOTE:  
FOR CONVENIENCE, DEPTHS OF INLETS SHOWN IN ABOVE TABLES ARE IN INCREMENTS OF 3 INCHES BUT ANY DEPTHS OTHER THAN THOSE SHOWN ABOVE MAY BE USED WHEREVER DEEMED NECESSARY. QUANTITIES FOR OTHER DEPTHS FALLING WITHIN THE LIMITS OF THE TABLE MAY BE FOUND BY INTERPOLATION.

NOTE:  
FOR CONVENIENCE, DEPTHS OF INLETS SHOWN IN ABOVE TABLES ARE IN INCREMENTS OF 3 INCHES BUT ANY DEPTHS OTHER THAN THOSE SHOWN ABOVE MAY BE USED WHEREVER DEEMED NECESSARY. QUANTITIES FOR OTHER DEPTHS FALLING WITHIN THE LIMITS OF THE TABLE MAY BE FOUND BY INTERPOLATION.

STANDARD DRAWING NO. 6020D	CURB INLET	 North Central Texas Council of Governments	STANDARD SPECIFICATION REFERENCE 702
	BILL OF REINFORCING STEEL		DATE OCT. '04


STANDARD 6020E FOR CURBING QUANTITIES	CURB INLET		North Central Texas Council of Governments 	STANDARD SPECIFICATION REFERENCE 702	
	SUMMARY OF QUANTITIES			DATE OCT. '04	STANDARD DRAWING NO. 6020E

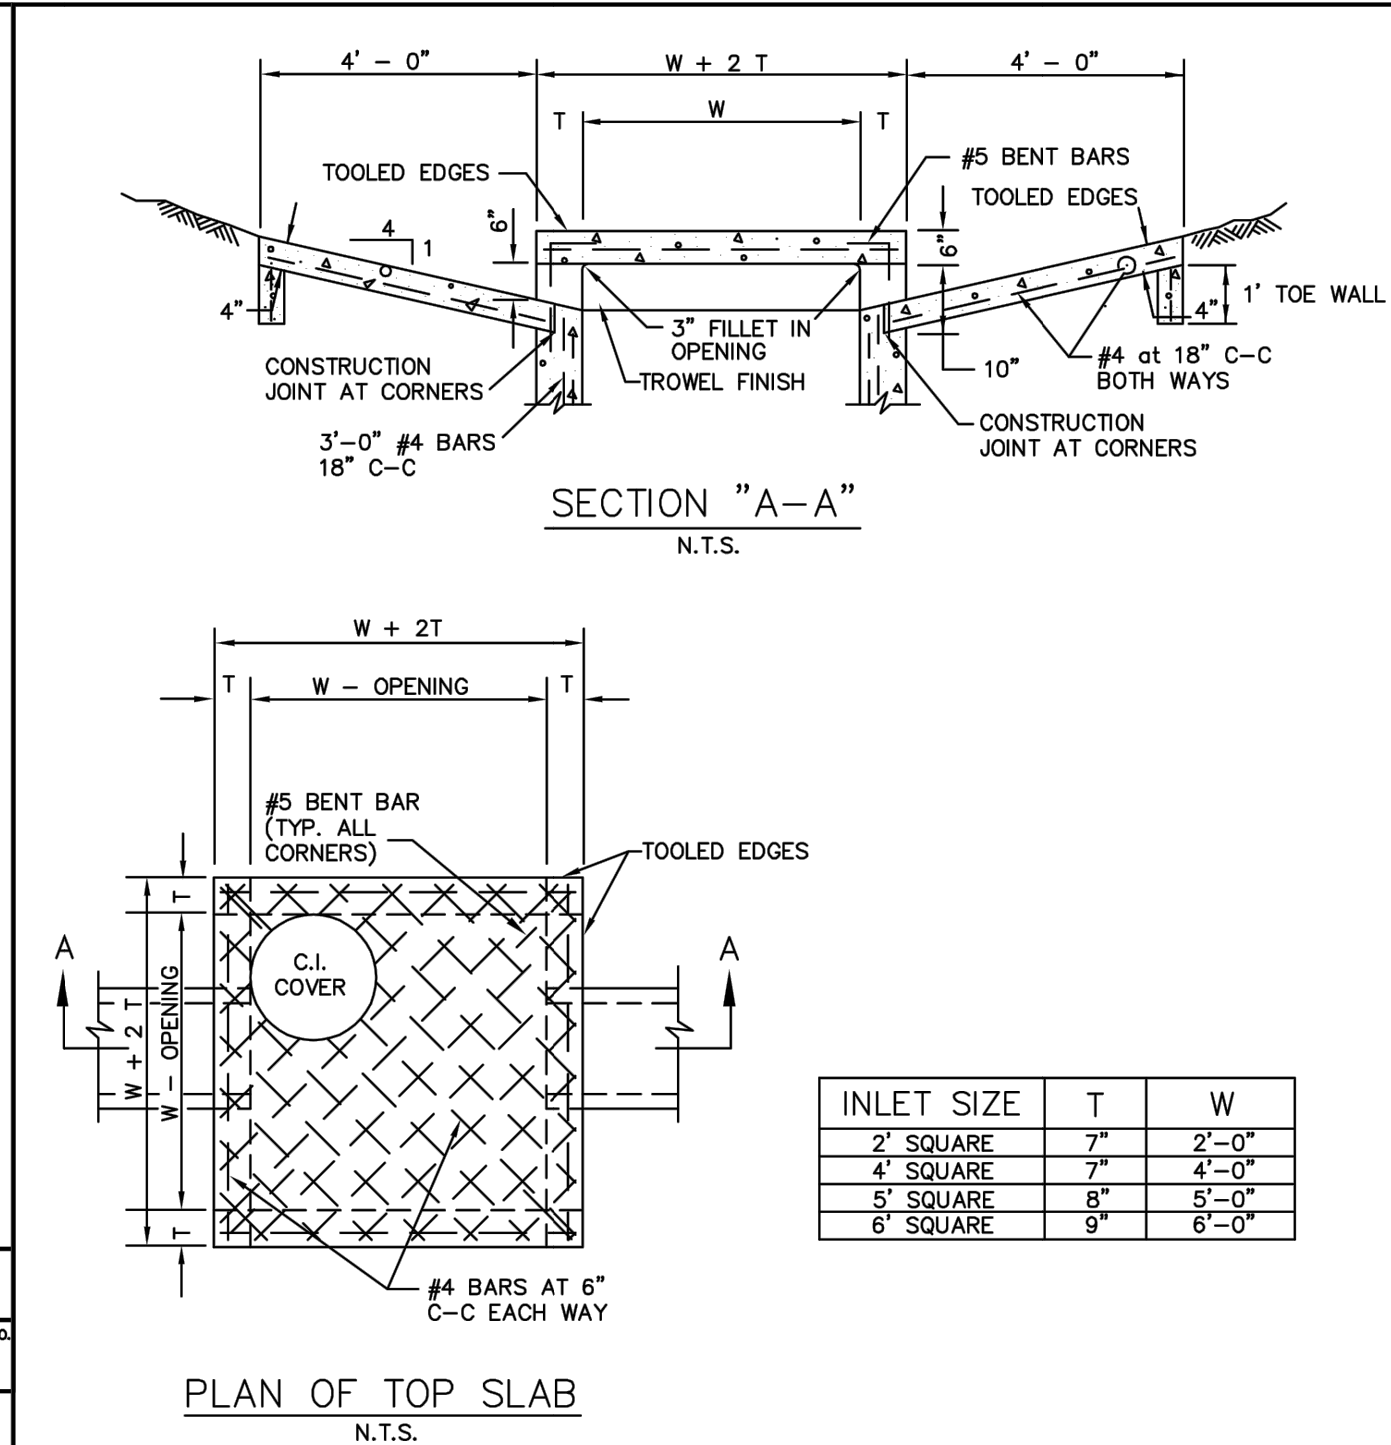


INLET SIZE	T	W
2' SQUARE	7"	2'-0"
4' SQUARE	7"	4'-0"
5' SQUARE	8"	5'-0"
6' SQUARE	9"	6'-0"

NOTES:

1. MATERIAL AND WORKSMANSHIP SHALL CONFORM WITH THE REQUIREMENTS OF NCTCOG STANDARD SPECIFICATIONS FOR STANDARD CONCRETE MANHOLES, MINIMUM CLASS "A" CONCRETE.
2. LAYERS OF REINFORCING STEEL NEAREST THE INTERIOR AND EXTERIOR SURFACES SHALL HAVE A COVER OF 2" TO THE CENTER OF BARS, UNLESS OTHERWISE NOTED.
3. FOR DETAILS OF REINFORCING OF LOWER PORTIONS OF INLET SEE APPROPRIATE SQUARE MANHOLE DETAILS.
4. DEPTH OF DROP INLET FROM FINISHED GRADE TO FLOW LINE OF INLET IS VARIABLE. APPROXIMATE DEPTH WILL BE SHOWN ON PLAN OF EACH INLET.
5. ALL STANDARD DROP INLETS SHALL HAVE ONE OPENING ON EACH SIDE UNLESS OTHERWISE SHOWN ON PLANS.
6. DECK MAY BE REINFORCED SAME AS 4" SQUARE MANHOLE.


<p style="text-align: center;">DROP INLET</p> <p style="text-align: center;">2', 4', 5' OR 6' SQUARE</p>		<p>STANDARD SPECIFICATION REFERENCE</p> <p style="text-align: center;">702</p>	
		<p>DATE</p> <p>OCT. '04</p>	<p>STANDARD DRAWING NO.</p> <p style="text-align: center;">6040</p>

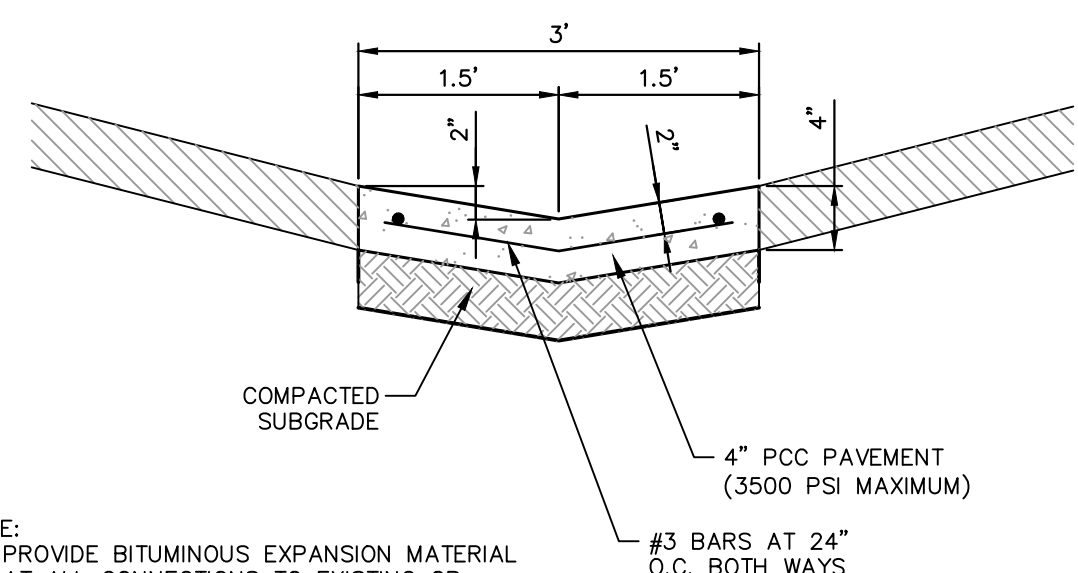

- NOTE:
1. PROVIDE BITUMINOUS EXPANSION MATERIAL AT ALL CONNECTIONS TO EXISTING OR PROPOSED IMPROVEMENTS AND AT ALL GRADE CHANGES. PROVIDE CONTRACTION JOINTS AT SPACES EQUAL TO WIDTH. PROVIDE REDWOOD EXPANSION JOINTS AT 32' SPACING.
  2. ALL SUBGRADES SHALL BE COMPACTED TO 95% MAXIMUM DENSITY PER AASHTO T-99 (STANDARD PROCTOR).

## CONCRETE PILOT CHANNEL DETAIL

N.T.S.

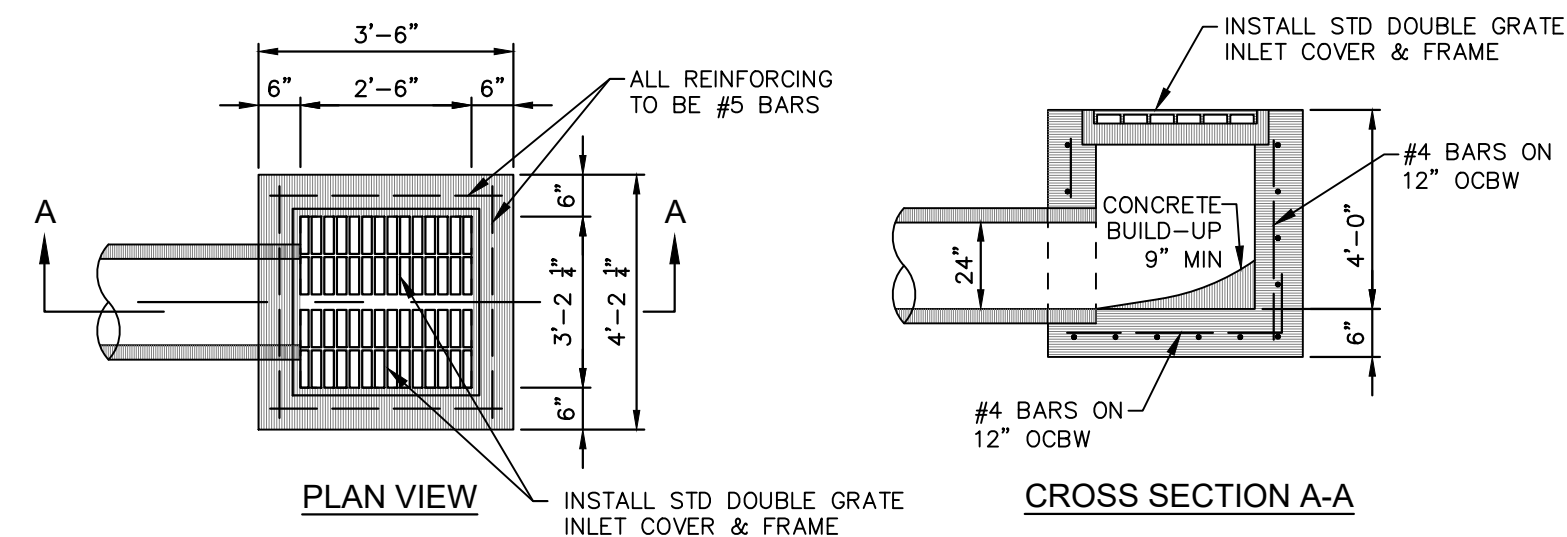

- NOTES:**
1. ALL LAPS AND EXTENSIONS OF REINFORCING BARS SHALL BE 30 BAR DIAMETERS UNLESS OTHERWISE NOTED.
  2. PIPE MAY BE PLACED IN ANY WALL, BUT SHALL NOT ENTER ANY CORNER, OR BOTTOM.
  3. CONCRETE TO BE MIN. 4200 PSI.

## GRATE INLET DETAIL

N.T.S.

- Provide headwall details for storm outfalls












PLOTTED BY: ERIC SHERLEY  
 PLOT DATE: 7/12/2024 2:21 PM  
 LOCATION: P:\SHARED\PROJECTS\2023\GREYSTAR MFR - SANGER TX\REF\22X34 MF.DWG  
 LAST SAVED: 7/12/2024 2:08 PM


MATCHLINE - SEE SHEET LP-1

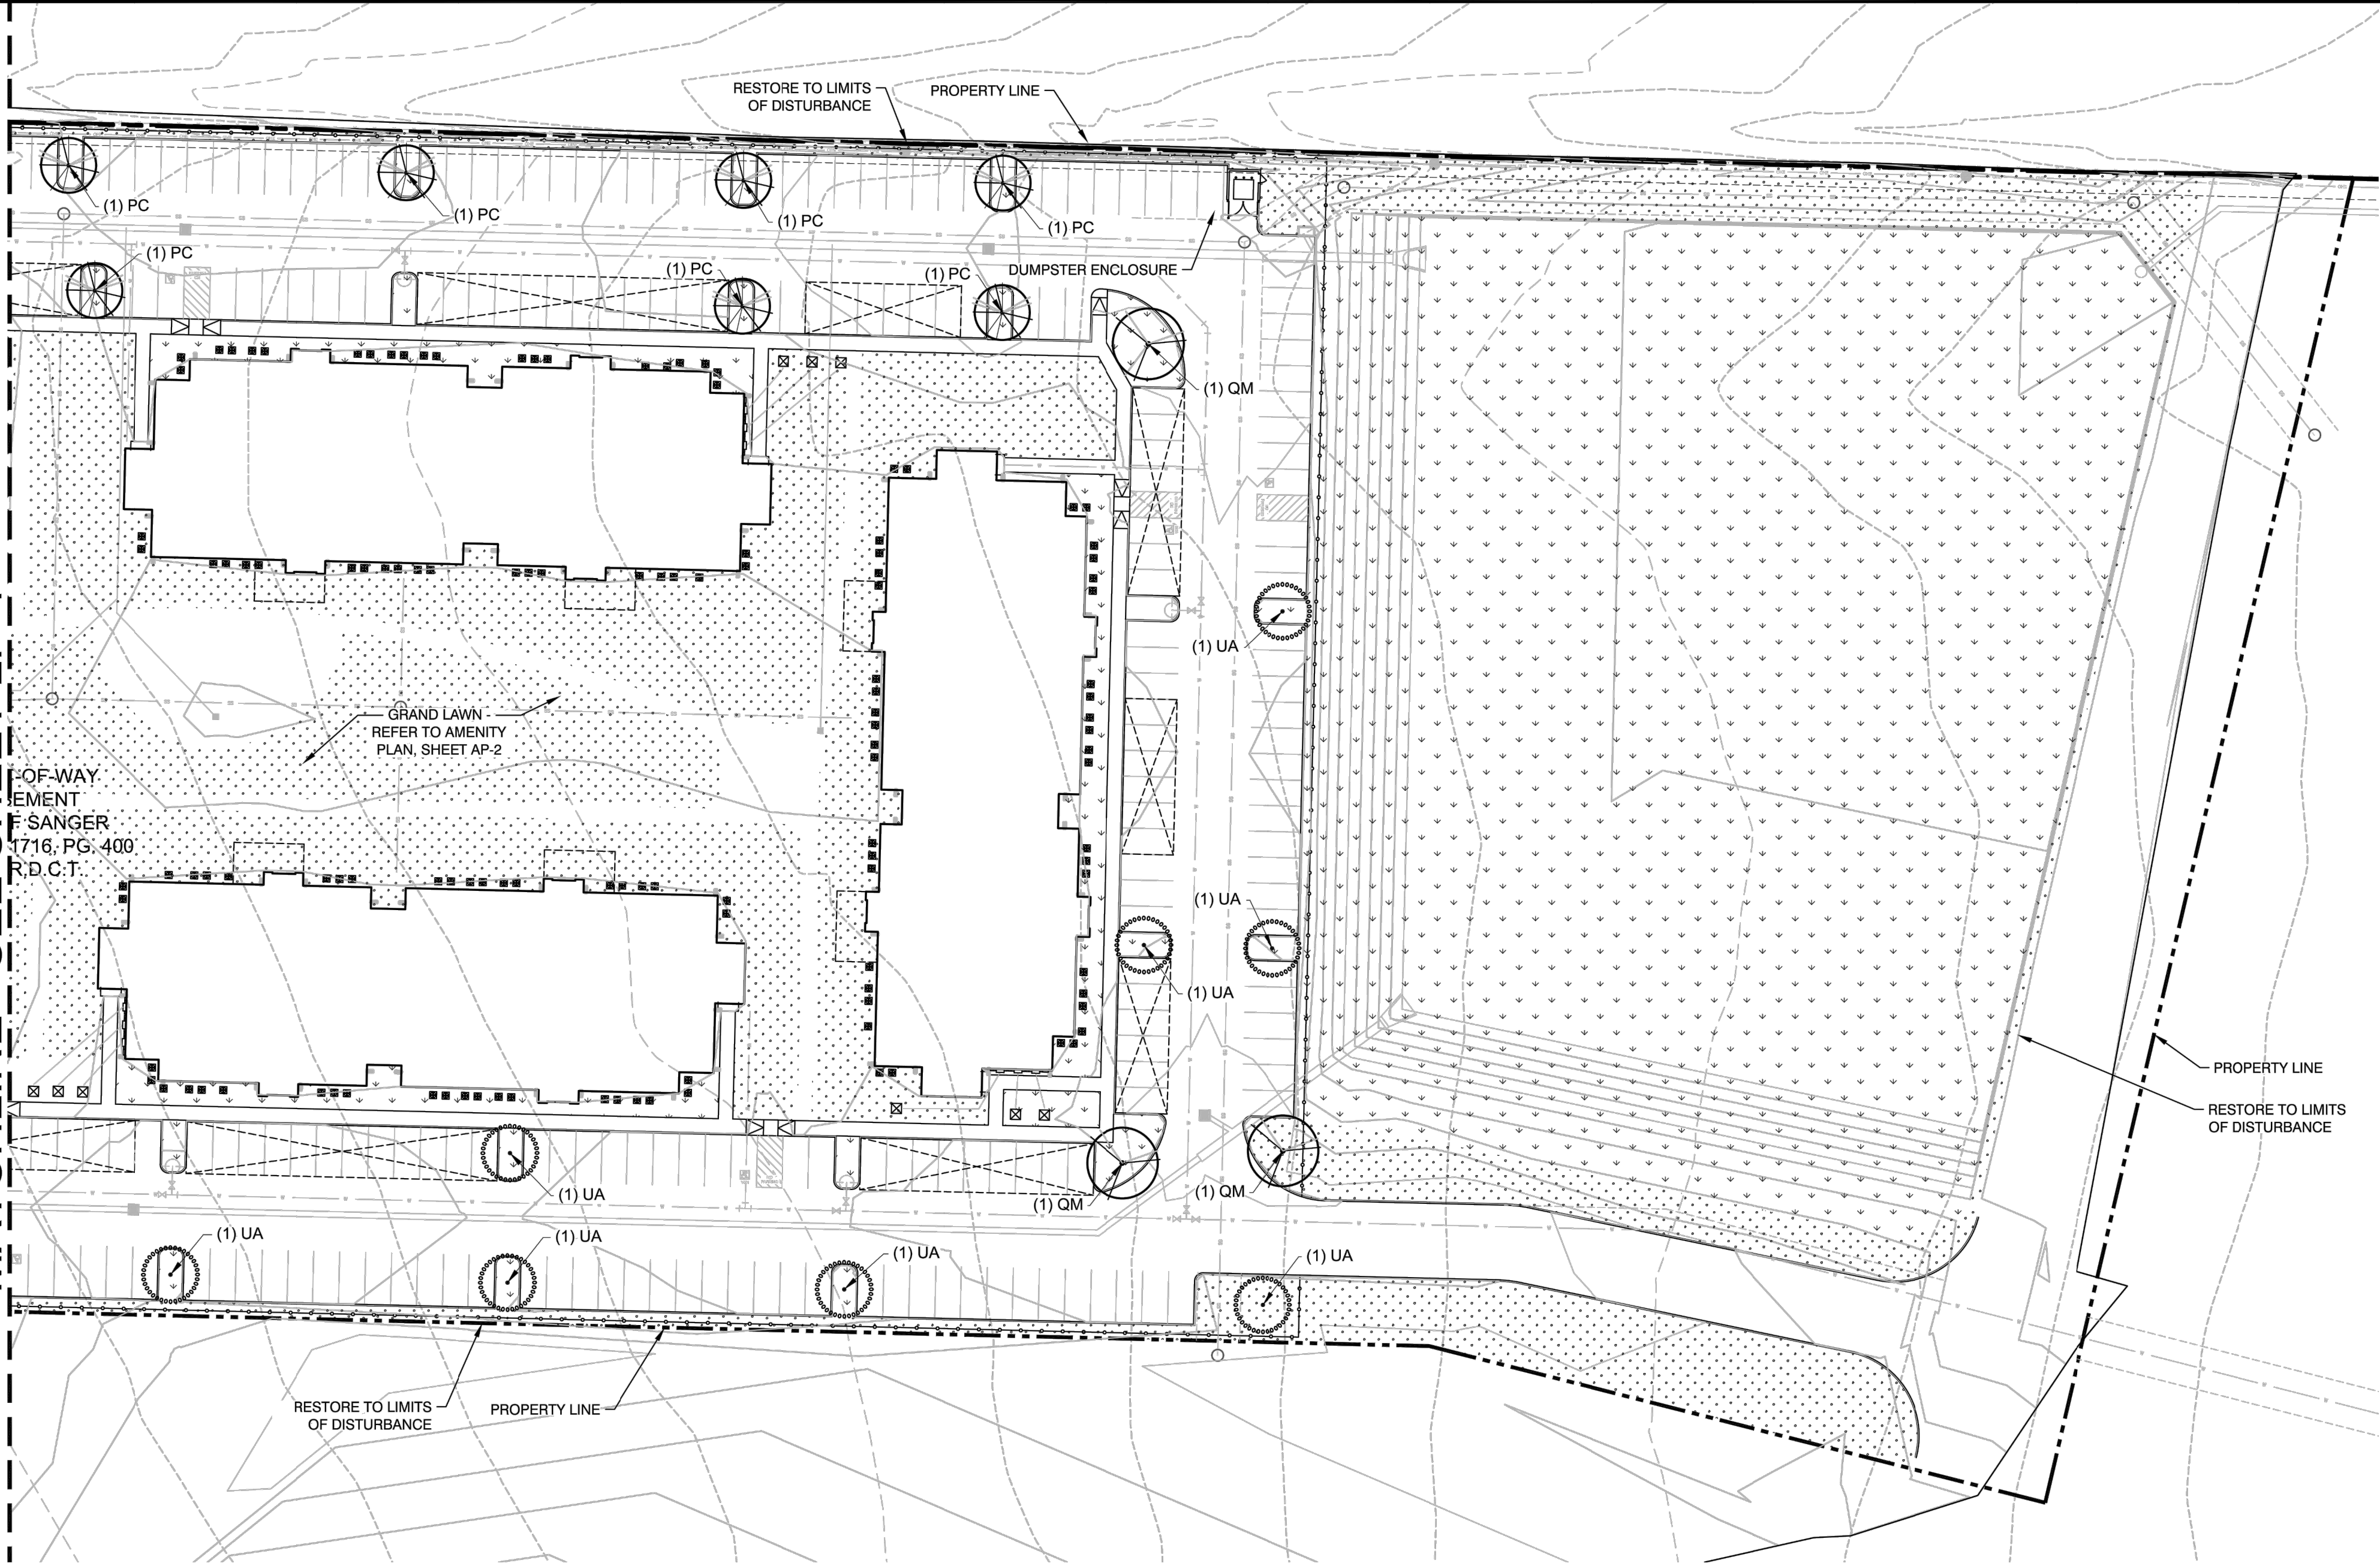

PLANT SCHEDULE

SYMBOL	CODE	QTY	BOTANICAL / COMMON NAME	CAL.	CONT.	SIZE
TREES						
	AS	9	Acer saccharum `Caddo` Caddo Maple	3" Cal.	Cont. or B&B	10'-12'
	PC	17	Pistacia chinensis Chinese Pistache	3" Cal.	Cont. or B&B	10'-12'
	QM	12	Quercus muehlenbergii Chinquapin Oak	3" Cal.	Cont. or B&B	10'-12'
	QV	7	Quercus virginiana Southern Live Oak	3" Cal.	Cont. or B&B	10'-12'
	UA	10	Ulmus parvifolia `Allee` Allee Lacebark Elm	3" Cal.	Cont. or B&B	10'-12'

SYMBOL	CODE	QTY	BOTANICAL / COMMON NAME	CONT	SPACING	SIZE
GROUND COVERS						
	BG	176,588 sf	Cynodon dactylon Bermuda Grass	Hydromulch		
	CT	147,227 sf	Cynodon dactylon `Tif 419` Bermuda Grass	sod		

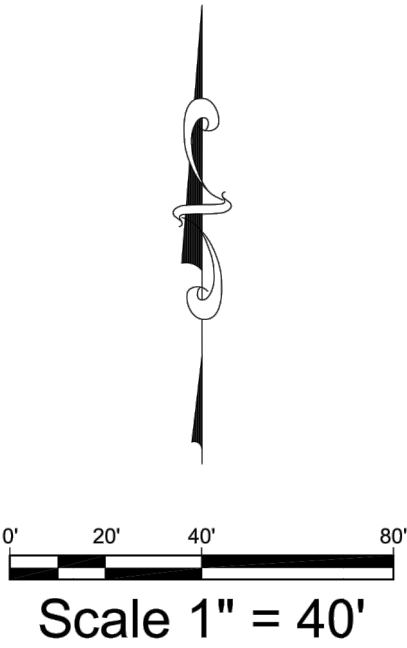

BENCHMARKS:  
 NO. 1  
 "X"-CUT AT THE TERMINUS OF THE EXISTING 15' WIDE SIDEWALK ON THE WEST SIDE OF COOK LANE, +/- 455' SOUTH OF THE INTERSECTION OF COOK LANE AND PROSPER TRAIL  
 ELEV: 635.56'  
 NO. 2  
 SQUARE CUT ON THE SOUTH END OF A HEADWALL ON THE EAST SIDE OF COOK LANE, +/- 1050' SOUTH OF THE INTERSECTION OF COOK LANE AND PROSPER TRAIL  
 ELEV: 636.18'

EVERGREEN  
 DESIGN GROUP  
 www.EvergreenDesignGroup.com

TEXAS REGISTRATION #14199  
  
 CLAY MOORE  
 ENGINEERING  
 1903 CENTRAL DRIVE, SUITE #408  
 BEAUFORT, TX 76017  
 PHONE: 817.281.0072  
 WWW.CLAYMOOREENG.COM

REGISTERED LANDSCAPE ARCHITECT  
 ERIC M. SHERLEY  
 STATE OF TEXAS  
 07/15/2024

SANGER MULTI-FAMILY  
 PREPARED FOR  
 GREYSTAR  
 SANGER, TEXAS

NO.	DATE	REVISION	BY

LANDSCAPE PLANTING

DESIGN: EMS  
 DRAWN: EMS  
 CHECKED: RM  
 DATE: 7/12/2024  
 SHEET  

# LP-2

CASE NO. 2022-185



## GENERAL

#### A. QUALIFICATIONS OF LANDSCAPE CONTRACTOR

1. ALL LANDSCAPE WORK SHOWN ON THESE PLANS SHALL BE PERFORMED BY A SINGLE FIRM SPECIALIZING IN LANDSCAPE PLANTING.
2. A LIST OF SUCCESSFULLY COMPLETED PROJECTS OF THIS TYPE, SIZE AND NATURE MAY BE REQUESTED BY THE OWNER FOR FURTHER QUALIFICATION MEASURES.
3. THE LANDSCAPE CONTRACTOR SHALL HOLD A VALID NURSERY AND FLORAL CERTIFICATE ISSUED BY THE TEXAS DEPARTMENT OF AGRICULTURE OR A VALID PESTICIDE APPLICATOR LICENSE ISSUED BY THE TEXAS DEPARTMENT OF AGRICULTURE OR THE TEXAS STRUCTURAL PEST CONTROL BOARD.
4. THE LANDSCAPE CONTRACTOR SHALL HOLD A VALID CONTRACTOR'S LICENSE ISSUED BY THE APPROPRIATE LOCAL JURISDICTION.
- SCOPE OF WORK
1. WORK COVERED BY THESE SECTIONS INCLUDES THE FURNISHING AND PAYMENT OF ALL MATERIALS, LABOR, SERVICES, EQUIPMENT, LICENSES, TAXES AND ANY OTHER ITEMS THAT ARE NECESSARY FOR THE EXECUTION, INSTALLATION AND COMPLETION OF ALL WORK SPECIFIED HEREIN AND / OR SHOWN ON THE LANDSCAPE PLANS, NOTES, AND DETAILS.
2. ALL WORK SHALL BE PERFORMED IN ACCORDANCE WITH ALL APPLICABLE LAWS, CODES AND REGULATIONS GOVERNING THE AUTHORIZATION OF LANDSCAPE PLANTING AND THE LANDSCAPE PLANTING PERMITS REQUIRED BY FEDERAL, STATE AND LOCAL AUTHORITIES IN SUPPLY, TRANSPORTATION AND INSTALLATION OF MATERIALS.
3. THE LANDSCAPE CONTRACTOR SHALL VERIFY THE LOCATION OF ALL UNDERGROUND UTILITY LINES (WATER, SEWER, ELECTRICAL, TELEPHONE, GAS, CABLE, TELEVISION, ETC.) PRIOR TO THE START OF ANY WORK.


## PRODUCTS

- A. ALL MANUFACTURED PRODUCTS SHALL BE NEW.
- B. CONTAINER AND BALLED-AND-BURLAPPED PLANTS:
1. FURNISH NURSERY-GROWN PLANTS WITH ANSI Z601.1-2014. PROVIDE WELL-SHAPED, FULLY BRANCHED, HEALTHY, VIGOROUS STOCK FREE OF DISEASE, INSECTS, EGGS, LARVAE, AND DEFECTS SUCH AS KNOTS, SUN SCALD, INJURIES, ABRASIONS, AND DISFIGUREMENT. ALL PLANTS WITHIN A SPECIES SHALL HAVE SIMILAR SIZE, AND SHALL BE OF A FORM TYPICAL FOR THE SPECIES. ALL TREES SHALL BE OBTAINED FROM SOURCES WITHIN 200 MILES OF THE PROJECT. THE PLANTS MUST BE GROWN IN CONTAINERS OR CLIPS.
2. ROOT SYSTEMS SHALL BE HEALTHY, DENSELY BRANCHED ROOT SYSTEMS, NON-POT-BOUND, FREE FROM ENCIRCLING AND/OR GIRDLING ROOTS, AND FREE FROM ANY OTHER ROOT DEFECTS (SUCH AS J-SHAPED ROOTS). PLANTS MAY BE BURLAPPED OR BURLAPPED AND BURLAPPED (B&B), UNLESS SPECIFIED ON THE PLANTING LEGEND. BARE-ROOT TREES ARE NOT ACCEPTABLE.
3. ANY PLANTER DEEMED UNACCEPTABLE BY THE LANDSCAPE ARCHITECT OR OWNER SHALL BE IMMEDIATELY REMOVED FROM THE SITE AND BE REPLACED WITH AN ACCEPTABLE PLANT OF LIKE TYPE AND SIZE AT THE CONTRACTOR'S OWN EXPENSE. ANY PLANTER APPEARING UNACCEPTABLE TO THE LANDSCAPE ARCHITECT DETERMINED TO STILL BE ALIVE, SHALL NOT BE ACCEPTED. THE LANDSCAPE ARCHITECT AND OWNER SHALL BE THE SOLE JUDGES AS TO THE ACCEPTABILITY OF PLANT MATERIAL.
4. ALL TREES SHALL BE WELL-FORMED, UNLESS OTHERWISE SPECIFIED. TREES WITH CENTRAL LEADERS WILL NOT BE ACCEPTED IF LEADER IS DAMAGED OR REMOVED. PRUNE ALL DAMAGED TWIGS AFTER PLANTING. CALIPER MEASUREMENTS FOR STANDARD (SINGLE TRUNK) TREES SHALL BE AS FOLLOWS: SIX INCHES ABOVE THE TRUNK FLARE FOR TREES UP TO AND INCLUDING FOUR INCHES IN CALIPER, AND TWELVE INCHES ABOVE THE ROOT FLARE FOR TREES EXCEEDING FOUR INCHES IN CALIPER.
5. MULTI-TRUNK TREES SHALL BE MEASURED BY THEIR OVERALL HEIGHT, MEASURED FROM THE TOP OF THE ROOT BALL, WHERE CALIPER MEASUREMENTS ARE USED; THE CALIPER SHALL BE CALCULATED AS ONE-HALF OF THE SUM OF THE CALIPER OF THE CALIPER OF THE TRUNKS.
6. ANY TREE OR SHRUB SHOWN TO HAVE EXCESS SOIL PLACED ON TOP OF THE ROOT BALL, SO THAT THE ROOT FLARE HAS BEEN COMPLETELY COVERED, SHALL BE REJECTED.
- C. SOIL: SOIL SHALL BE WELL-AERATED AND FREE OF ROCKS, LIMBS, OR OTHER FOREIGN MATTER ON THE PLANS. SOIL SHALL BE CUT FROM HEALTHY, MATURE TURF WITH SOIL THICKNESS OF 3/4" TO 1". EACH PALLET OF SOIL SHALL BE ACCOMPANIED BY A CERTIFICATE FROM SUPPLIER STATING THE COMPOSITION OF THE SOIL.
- D. SEED: PROVIDE BLEND OF SPECIES AND VARIETIES AS NOTED ON THE PLANS, WITH MAXIMUM PERCENTAGES OF PURITY, GERMINATION, AND VIGOR. SEED SHALL BE STORED AND HANDLED AS INDICATED ON PLANS. EACH BAG OF SEED SHALL BE ACCOMPANIED BY A TAG FROM THE SUPPLIER INDICATING THE COMPOSITION OF THE SEED.
- E. TOPSOIL: SANDY TO CLAY LOAM TOPSOIL, FREE OF STONES LARGER THAN 1/2 INCH, FOREIGN MATTER, PLANTS, ROOTS, AND LIMBS.
- F. COMPOST: WELL-COMPOSTED, STABLE, AND WOOD-FREE ORGANIC MATTER, pH RANGE OF 5.5 TO 8; MOISTURE CONTENT 35 TO 35 PERCENT BY WEIGHT; 100 PERCENT PASSING THROUGH 3/4-INCH SIEVE; SOLUBLE SALT CONTENT OF 5 TO 10 DISINTEGRATION; NO TOXICITY TO PLANTS; NO INHIBITION OF PLANT GROWTH; AND FREE OF SUBSTANCES TOXIC TO PLANTINGS.
- G. NO MIXTURE OR ANIMAL-BASED PRODUCTS SHALL BE USED.
- H. PLANTING MIXTURE FOR POTS: AN EQUAL PART MIXTURE OF TOPSOIL, SAND AND COMPOST. INCORPORATE "GELSCAPE", AS MADE BY AMBERG, INC., (800) 832-8788, AT THE RATE OF 3 LB PER CUBIC YARD OF PLANTING MIX.
- I. FERTILIZER: GRANULAR, NON-BURNING, NON-TOXIC, NON-CORROSIVE, NON-FLAMMABLE, AND FREE OF OTHER NUTRIENTS IN PROPORTIONS, AMOUNTS, AND RELEASE RATES RECOMMENDED IN A SOIL REPORT FROM A QUALIFIED SOIL-TESTING AGENCY (SEE BELOW).
- J. SOIL MANIPULATION: SPRINKLES: AS MANUFACTURED BY THE LUTZ CORP., (800) 203-7740, OR APPROVED EQUAL.
- K. MULCH: SIZE AND TYPE AS INDICATED ON PLANS, FREE FROM DELETERIOUS MATERIALS AND SUITABLE AS A TOP DRESSING OF TREES AND SHRUBS.
- L. TREE STAKING AND GUYING
1. STAKES: 6' LONG GREEN METAL T-POSTS
2. GUY AND TIE WIRE: ASTM A 641, CLASS 1, GALVANIZED-STEEL WIRE, 1/2-INCH, TWISTED, 0.106 INCH DIAMETER.
3. STUMP CHAFING GARD: REINFORCED NYLON OR CANVAS AT LEAST 1-2 INCH WIDE, WITH GROMMETS TO TIE TO TREE TRUNK.
- M. STEEL EDGING: PROFESSIONAL STEEL EDGING, 14 GAUGE THICK X 4 INCHES WIDE, FACTORY PAINTED DARK GREEN. ACCEPTABLE MANUFACTURERS INCLUDE COL-MET OR APPROVED EQUAL.
- N. PRE-EMERGENT HERBICIDES: ANY GRANULAR, NON-STAINING PRE-EMERGENT HERBICIDE THAT IS LABELED FOR THE SPECIFIC ORNAMENTALS OR TURF ON WHICH IT WILL BE UTILIZED. PRE-EMERGENT HERBICIDES SHALL BE APPLIED PER THE MANUFACTURER'S LABELED RATES.

## METHODS


- S. SOIL PREPARATION**
- 1. BEFORE STARTING WORK, THE LANDSCAPE CONTRACTOR SHALL VERIFY THAT THE GRADE OF ALL LANDSCAPE AREAS IS WITHIN THE FINISH GRADE. THE CONTRACTOR SHALL NOTIFY THE OWNER IMMEDIATELY SHOULD ANY DISCREPANCIES EXIST.**
- 2. SOIL TESTING:**
- a. AFTER FINISH GRADES HAVE BEEN ESTABLISHED, THE CONTRACTOR SHALL HAVE SOIL SAMPLES FROM THE PROJECT'S LANDSCAPE AREAS AND AN ESTABLISHED SOIL TESTING LABORATORY. EACH SAMPLE SUBMITTED TO THE LAB SHALL CONTAIN NO LESS THAN ONE QUART OF SOIL, TAKEN FROM BETWEEN THE SOIL SURFACE AND 6" DEPTH. IF NO SAMPLE LOCATIONS ARE INDICATED ON THE PLANS, THE CONTRACTOR SHALL TAKE A MINIMUM OF 10 SAMPLES FROM 10 DIFFERENT LOCATIONS FOR TESTING.
- b. THE CONTRACTOR SHALL HAVE THE SOIL TESTING LABORATORY PROVIDE RESULTS FOR THE FOLLOWING: SOIL TEXTURAL CLASS, GENERAL SOIL FERTILITY, pH, ORGANIC MATTER CONTENT, SALT (CEC), LIME, SODIUM ADSORPTION RATIO (SAR) AND BORON CONTENT.
- c. THE CONTRACTOR SHALL ALSO SUBMIT THE PROJECT'S PLANT LIST TO THE LABORATORY ALONG WITH THE SOIL SAMPLES.
- d. THE SOIL REPORT PRODUCED BY THE LABORATORY SHALL CONTAIN RECOMMENDATIONS FOR THE FOLLOWING (AS APPROPRIATE): SEEDING, SOIL PREPARATION AND MIX, MIX RECOMMENDATIONS FOR GENERAL ORNAMENTAL, TURF, PERENNIALS AND NARROW LEED, AS WELL AS FERTILIZER APPLICATIONS AND RECOMMENDATIONS FOR ANY OTHER SOIL RELATED ISSUES. THE REPORT SHALL ALSO PROVIDE A FERTILIZER PROGRAM FOR THE ESTABLISHMENT PERIOD AND FOR LONG-TERM MAINTENANCE.
- 3. THE CONTRACTOR SHALL FOLLOW THE RECOMMENDATIONS AND FERTILIZER APPLICATIONS FOR THE RECOMMENDATIONS. ANY CHANGE IN COST DUE TO THE SOIL REPORT RECOMMENDATIONS, EITHER INCREASE OR DECREASE, SHALL BE SUBMITTED TO THE OWNER WITH THE REPORT.**
- 4. FOR BIDDING PURPOSES ONLY, THE SOIL PREPARATION SHALL CONSIST OF THE FOLLOWING:**
- a. "TURF, INCORPORATE TOP 2" OF SOIL TO THE TOP 8" OF SOIL BY MEANS OF ROTOTILLING AFTER CROSS-GRIPPING.
- i. NITROGEN STABILIZED ORGANIC AMENDMENT - 4 CU. YDS. PER 1,000 S.F.
- ii. PREPLANT 1" OF FERTILIZER (10-20-10 OR SIMILAR, SLOW RELEASE, ORGANIC) - 15 LBS PER 1,000 S.F.
- b. "CLAY BUSTER" OR EQUAL - USE MANUFACTURER'S RECOMMENDED RATE
- c. TREES, SHRUBS, AND PERENNIALS: INCORPORATE THE FOLLOWING AMENDMENTS INTO THE TOP 8" OF SOIL BY MEANS OF ROTOTILLING AFTER CROSS-GRIPPING:
- i. NITROGEN STABILIZED ORGANIC AMENDMENT - 4 CU. YDS. PER 1,000 S.F.
- ii. 12-12-12 FERTILIZER (OR SIMILAR, ORGANIC, SLOW RELEASE) - 10 LBS. PER CU. YD.
- iii. "CLAY BUSTER" OR EQUAL - USE MANUFACTURER'S RECOMMENDED RATE
- iv. IRON SULPHATE - 2 LBS. PER CU. YD.
- 5. IN THE CONTEXT OF THESE PLANS, NOTES, AND SPECIFICATIONS, "FINISH GRADE" REFERS TO THE FINAL ELEVATION OF THE SOIL SURFACE (NOT TOP OF MULCH) AS INDICATED ON THE GRADING PLANS.**
- a. BEFORE STARTING WORK, THE LANDSCAPE CONTRACTOR SHALL VERIFY THAT THE MOORE GRADES OF ALL LANDSCAPE AREAS ARE WITHIN +0.1" OF FINISH GRADE. THE CONTRACTOR SHALL NOTIFY THE OWNER IMMEDIATELY SHOULD ANY DISCREPANCIES EXIST.**
- b. INSTRUCTION TO TURF AREA AND PLANTING BED PREPARATION.**
- CONSTRUCT AND MAINTAIN FINISH GRADES AS SHOWN ON GRADING PLANS, AND CONSTRUCT AND MAINTAIN SLOPES AS RECOMMENDED ON GRADING REPORT. ALL LANDSCAPE AREAS SHALL HAVE POSITIVE DRAINAGE AWAY FROM STRUCTURES AT THE MINIMUM SLOPE SPECIFIED IN THE REPORT AND ON THE GRADING PLANS, AND AREAS OF POTENTIAL PONDING SHALL BE REGRADED TO BLEND IN WITH THE SURROUNDING GRADES AND ELIMINATE PONDING POTENTIAL.**
- THE LANDSCAPE CONTRACTOR SHALL NOT EXPORT OR IMPORT OR NOT THE EXPORT OF ANY SOIL WILL BE NEEDED, TAKING INTO ACCOUNT THE ROUGH GRADE PROVIDED, THE AMOUNT OF SOIL AMENDMENTS TO BE ADDED (BASED ON A SOIL TEST, PER SPECIFICATIONS), AND THE FINISH GRADES TO BE ESTABLISHED.**
- ENSURE THAT THE SOIL AMENDMENTS ARE PLACED AT LEAST 6" BELOW THE FINISH GRADE AND OTHER LINKING SURFACES. AFTER INSTALLING SOIL AMENDMENTS, IS 6" BELOW THE ADJACENT FINISH SURFACE, IN ORDER TO ALLOW FOR PROPER MULCH DEPTH. TAPER THE SOIL SURFACE TO MEET FINISH GRADE, AS SPECIFIED ON THE GRADING PLANS, AT APPROXIMATELY 18" AWAY FROM THE WALKS.**
- ENSURE THAT THE SOIL AMENDMENTS ARE PLACED AT LEAST 6" ADJACENT TO WALKS AND OTHER WALKING SURFACES. AFTER INSTALLING SOIL AMENDMENTS, IS 6" BELOW THE FINISH SURFACE OF THE WALKS. TAPER THE SOIL SURFACE TO MEET FINISH GRADE, AS SPECIFIED ON THE GRADING PLANS, AT APPROXIMATELY 18" AWAY FROM THE WALKS.**
- f. SHOULD ANY CONFLICTS AND/OR DISCREPANCIES ARISE BETWEEN THE GRADING PLANS, GEOTECHNICAL REPORT, THESE NOTES AND PLANS, AND ACTUAL CONDITIONS, THE CONTRACTOR SHALL IMMEDIATELY BRING SUCH ITEMS TO THE ATTENTION OF THE LANDSCAPE ARCHITECT, GENERAL CONTRACTOR, AND OWNER.**
- ONCE SOIL PREPARATION, LANDSCAPE CONTRACTOR SHALL BE RESPONSIBLE TO ENSURE THAT THERE ARE NO DEBRIS, TRASH, OR STONES LARGER THAN 1" REMAINING IN THE TOP 6" OF SOIL.**

- 1. THE CONTRACTOR SHALL PROVIDE SUBMITTALS AND SAMPLES, IF REQUIRED, TO THE LANDSCAPE ARCHITECT, AND RECEIVE COMMENTS FROM THE ARCHITECT BEFORE WORK COMMENCES.**
- 2. SUBMITTALS SHALL INCLUDE PHOTOS OF PLANTS WITH A RULER OR MEASURING STICK FOR SCALE, PHOTOS OR SAMPLES OF ANY REQUIRED MULCHES, AND SOIL TEST RESULTS AND PREPARATION RECOMMENDATIONS FROM THE TESTING LAB (INCLUDING COMPOST AND FERTILIZER RATES AND TYPES, AND OTHER AMENDMENTS FOR TREE SHRUB, TURF, AND SEED AREAS AS WELL AS BE APPROPRIATE).**
- 3. SUBMITTALS SHALL ALSO INCLUDE MANUFACTURER CUT SHEETS FOR PLANTING ACCESSORIES SUCH AS TREE STAKES AND TIES, EDGING, AND LANDSCAPE FABRICS (IF ANY).**
- 4. WHERE MULTIPLE ITEMS ARE SHOWN ON A PAGE, THE CONTRACTOR SHALL CLEARLY INDICATE THE ITEM BEING CONSIDERED.**
- C. GENERAL PLANTING**
1. REMOVE ALL NURSERY TAGS AND STAKES FROM PLANTS.
  2. BACKFILL IN AREAS WHERE PLANTED OR ORNAMENTAL GRASSES, APPLY PRE-EMERGENT HERBICIDES AT THE MANUFACTURER'S RECOMMENDED RATE.
  3. TRENCING NEAR EXISTING TREES:
    - a. CONTRACTOR SHALL NOT DISTURB ROOTS 1'-1/2" AND LARGER IN DIAMETER WITHIN THE CRITICAL ROOT ZONE (CRZ) OF THE TREE. CRZ SHALL BE MAINTAINED AND SHALL EXERCISE ALL POSSIBLE CARE AND PRECAUTIONS TO AVOID INJURY TO TREE ROOTS, TRUNKS, AND BRANCHES. THE CRZ IS DEFINED AS A CIRCULAR AREA EXTENDING OUTWARD FROM THE TREE TRUNK, WITH A RADIUS EQUAL TO 1" FOR EVERY 1" OF TRUNK DIAMETER-AT-BREAST-HEIGHT (4.5 ABOVE THE AVERAGE GRADE AT THE TRUNK).
    - b. ALL EXCAVATION WITHIN THE CRZ SHALL BE PROTECTED USING HAND TOOLS. NO MACHINE EXCAVATION OR TRENCING OF ANY KIND SHALL BE ALLOWED WITHIN THE CRZ.
    - c. ALTER ALIGNMENT OF PIPE TO AVOID TREE ROOTS 1'-1/2" AND LARGER IN DIAMETER. WHERE TREE ROOTS 1'-1/2" AND LARGER IN DIAMETER ARE ENCOUNTERED IN THE FIELD, TUNNEL UNDER SUCH ROOTS, WRAP EXPOSED ROOTS WITH PROTECTIVE LAYERS OF BURLAP AND KEEP MOIST. CLOSE ALL TRENCHES WITHIN THE CANOPY DRIP LINES WITHIN 24 HOURS.
    - d. ALL SEVERED ROOTS SHALL BE HAND PRUNED WITH SHARP TOOLS AND ALLOWED TO AIR-DRY. DO NOT USE ANY SORT OF SEALERS OR WOUND PANTS.
- C. TREE PLANTING**
1. TREE PLANTING HOLES SHALL BE EXCAVATED TO MINIMUM WIDTH OF TWO TIMES THE WIDTH OF THE ROOTBALL, AND TO A DEPTH EQUAL TO THE DEPTH OF THE ROOTBALL LESS TWO TO FOUR INCHES.
  2. REMOVE THE SOIL FROM THE EXISTING ROOTBALL AND PLACE IN BAGS OR COARSE COURSES.
  3. ANY GLAZING THAT MAY HAVE BEEN CAUSED DURING THE EXCAVATION OF THE HOLE.
  4. FOR CONTAINER AND BOX TREES, TO REMOVE ANY POTENTIALLY GIRDLING ROOTS AND OTHER ROOT DEFECTS, THE CONTRACTOR SHALL SHAVE A 1" LAYER OFF OF THE SIDES AND BOTTOM OF THE ROOTBALL OF ALL TREES BEFORE PLACING INTO THE EXISTING PIT. DO NOT "FEASE" ROOTS OUT FROM THE ROOTBALL.
  4. INSTALL THE TREE ON UNDISTURBED SUBGRADE SO THAT THE TOP OF THE ROOTBALL IS TWO TO FOUR INCHES ABOVE THE SURROUNDING GRADE.
  5. BACKFILL THE TREE WITH SOIL FROM THE EXISTING TOPSOIL FROM ON-SITE. ROCKS LARGER THAN 1" DIA. AND ALL OTHER DEBRIS SHALL BE REMOVED FROM THE SOIL PRIOR TO THE BACKFILL. SHOULD ADDITIONAL SOIL BE REQUIRED TO ACCOMPLISH THIS TASK, USE STORED TOPSOIL FROM ON-SITE OR IMPORT ADDITIONAL TOPSOIL FROM OFF-SITE AT NO ADDITIONAL COST TO THE OWNER. IMPORTED TOPSOIL SHALL BE OF SIMILAR TEXTURAL CLASS AND COMPARABLE TO THE EXISTING TOPSOIL.
  6. TREES SHALL NOT BE STAKED UNLESS LOCAL CONDITIONS (SUCH AS HEAVY WINDS OR SLOPES) REQUIRE STAKES TO KEEP TREES UPRIGHT. SHOULD STAKING BE REQUIRED, THE TOTAL NUMBER OF TREE STAKES (BEYOND THE MINIMUMS LISTED BELOW) WILL BE LEFT TO THE LANDSCAPE CONTRACTOR'S DISCRETION. SHOULD ANY TREES NOT LEAN, THE CONTRACTOR SHALL STRAIGHTEN THE TREE, OR REPLACE IT SHOULD IT BECOME DAMAGED. TREE STAKING SHALL ADHERE TO THE FOLLOWING GUIDELINES:
    - a. 1"-2" TREES TWO STAKES PER TREE
    - b. 2'-4" TREES THREE STAKES PER TREE
    - c. TREES OVER 4" CALIPER TWO STAKES PER TREE
    - d. MULTI-TRUNK TREES THREE STAKES PER TREE MINIMUM, QUANTITY AND POSITIONS AS NEEDED TO STABILIZE THE TREE
    - e. #15 CONT. - 24" BOX TREES TWO STAKES PER TREE
    - f. 36"-48" BOX TREES THREE STAKES PER TREE
    - g. OVER 48" BOX TREES GUY AS NEEDED
    - h. MULTI-TRUNK TREES THREE STAKES PER TREE MINIMUM, QUANTITY AND POSITIONS AS NEEDED TO STABILIZE THE TREE
  7. UPON COMPLETION OF PLANTING, CONSTRUCT AN EARTH WATERING BASIN AROUND THE TREE. COVER THE INTERIOR OF THE TREE RING WITH THE WEED BARRIER CLOTH AND TOPDRESS WITH MULCH (TYPE AND DEPTH PER PLANS).
- D. SHRUB, PERENNIAL, AND GROUNDCOVER PLANTING**
1. DIG THE PLANTING HOLES TWICE AS WIDE AND 2" LESS DEEP THAN EACH PLANTS' ROOTBALL. INSTALL THE PLANT IN THE HOLE. BACKFILL AROUND THE PLANT WITH MULCH AMENDED PER SOIL TEST RECOMMENDATIONS. DO NOT OVERLAP THE WEED BARRIER CLOTH, OVERLAPPING IT AT THE ENDS. UTILIZE STEEL STAPLES TO KEEP THE WEED BARRIER CLOTH IN PLACE.
  3. WHEN PLANTING IS COMPLETE, INSTALL MULCH (TYPE AND DEPTH PER PLANS) OVER ALL PLANTING BEDS, COVERING THE ENTIRE PLANTING AREA.
- E. SODDING**
1. SOD VARIETY TO BE AS SPECIFIED ON THE LANDSCAPE PLAN.
  2. LAY SOD WITHIN 24 HOURS FROM THE TIME OF STRIPPING. DO NOT LAY IF THE GROUND IS FROZEN.
  3. LAY THE SOD TO FORM A SOLID MASS WITH TIGHTLY FITTED JOINTS. BUTT ENDS AND SIDES OF SOD STRIPS - DO NOT OVERLAP.
  4. ROLL THE SOD TO ENSURE GOOD CONTACT OF THE SOD'S ROOT SYSTEM WITH THE SOIL UNDERNEATH.
  5. WATER THE SOD THOROUGHLY WITH A FINE SPRAY IMMEDIATELY AFTER PLANTING TO OBTAIN AT LEAST SIX INCHES OF PENETRATION INTO THE SOIL BELOW THE SOD.
- F. HYDROMULCHING**
1. TURF HYDROMULCH MIX (PER 1,000 SF) SHALL BE AS FOLLOWS:
    - a. WINTER MIX (OCTOBER 1 - MARCH 31)
      - 50# CELLULOSE FIBER MULCH
      - 2# UNHILLED BERMUDA SEED
      - 2# ANNUAL RYE SEED
      - 15# 15-15-15 WATER SOLUBLE FERTILIZER
    - b. SUMMER MIX (APRIL 1 - SEPTEMBER 30)
      - 50# CELLULOSE FIBER MULCH
      - 2# HILLED BERMUDA SEED
      - 15# 15-15-15 WATER SOLUBLE FERTILIZER
  2. SEED HYDROMULCH MIX (PER 1,000 SF) SHALL BE AS FOLLOWS:
    - a. GENERAL
      - 50# CELLULOSE FIBER MULCH
      - 15# 15-15-15 WATER SOLUBLE FERTILIZERSEE RATE PER LEGEND
- G. DRILL SEEDING**
1. ALL SEED SHALL BE DRILL SEED AT THE RATES SHOWN ON THE PLANS, WITH A HYDROMULCH MIX APPLIED AFTER SEEDING.
  2. THE HYDROMULCH MIX (PER 1,000 SF) SHALL BE AS FOLLOWS:
    - 50# CELLULOSE FIBER MULCH
    - 15# 15-15-15 WATER SOLUBLE FERTILIZER
    - 4# ORGANIC BINDER
- H. MULCH**
1. INSTALL MULCH TOPDRESSING, TYPE AND DEPTH PER MULCH NOTE, IN ALL PLANTING AREAS AND TREE RINGS. DO NOT INSTALL MULCH OVER EXISTING MULCH OR WITHIN 12" OF HABITABLE STRUCTURES. EXCEPT AS MAY BE NOTED ON THESE PLANS, MULCH COVER WITHIN 6" OF CONCRETE WALKS AND CURBS SHALL NOT PROTRUDE ABOVE THE FINISH SURFACE OF THE WALKS AND CURBS. MULCH COVER WITHIN 12" OF WALLS SHALL BE AT LEAST 3" LOWER THAN THE TOP OF WALL.
- I. CLEAN UP**
1. DURING LANDSCAPE PREPARATION AND PLANTING, KEEP ALL PAVEMENT CLEAN AND ALL WORK AREAS IN A NEAT, ORDERLY CONDITION.
  2. DISPOSED LEGALLY OF ALL EXCAVATED MATERIALS OFF THE PROJECT SITE.
- J. INSPECTION AND ACCEPTANCE**
1. UPON COMPLETION OF THE WORK, THE LANDSCAPE CONTRACTOR SHALL PROVIDE THE SITE CLEAN, FREE OF DEBRIS AND TRASH, AND SUITABLE FOR USE AS INTENDED. THE LANDSCAPE CONTRACTOR SHALL THEN REQUEST ACCEPTANCE BY THE OWNER TO THE SITE INSPECTOR OF THE PLANTING.
  2. WHEN THE INSPECTOR'S REVIEW DOES NOT COMPLY WITH THE CONTRACT DOCUMENTS, THE LANDSCAPE CONTRACTOR SHALL REPLACE AND/OR REPAIR THE REJECTED WORK TO THE OWNER'S SATISFACTION WITHIN 24 HOURS.
  3. THE LANDSCAPE MAINTENANCE PERIOD WILL NOT COMMENCE UNTIL THE LANDSCAPE WORK HAS BEEN RE-INSPECTED BY THE OWNER AND FOUND TO BE ACCEPTABLE. AT THAT TIME, A WRITTEN NOTICE OF FINAL ACCEPTANCE WILL BE ISSUED BY THE OWNER, AND THE MAINTENANCE AND GUARANTEE PERIODS WILL COMMENCE.
- K. LANDSCAPE MAINTENANCE**
1. THE LANDSCAPE CONTRACTOR SHALL BE RESPONSIBLE FOR THE MAINTENANCE OF ALL WORK SHOWN ON THESE PLANS FOR 90 DAYS BEYOND FINAL ACCEPTANCE OF ALL LANDSCAPE WORK BY THE OWNER. LANDSCAPE MAINTENANCE SHALL INCLUDE WEEKLY SITE VISITS FOR THE FOLLOWING ACTIONS (AS APPROPRIATE): PROPER PRUNING, RESTAURING OVERGROWN TREES, AND TRIMMING OF PLANTS THAT HAVE SETTLED. MOWING AND AERATION OF LAWNS, WEEDING, RESEEDING AREAS WHICH HAVE NOT GERMINATED WELL, TREATING FOR INSECTS AND DISEASES, REPLACEMENT OF MULCH, REMOVAL OF LITTER, REPAIRS TO THE IRRIGATION SYSTEM DUE TO FAULTY PIPING, AND/OR WINDING AND/OR WINDING. THE CONTRACTOR SHALL BE RESPONSIBLE FOR WATERING THESE AREAS AND OBTAINING A FULL, HEALTHY STAND OF PLANTS AT NO ADDITIONAL COST TO THE OWNER.
  2. TO ACHIEVE FINAL ACCEPTANCE AT THE END OF THE MAINTENANCE PERIOD, ALL OF THE FOLLOWING CONDITIONS MUST OCCUR:
    - a. THE LANDSCAPE SHALL SHOW ACTIVE, HEALTHY GROWTH (WITH EXCEPTIONS MADE FOR SEASONAL DORMANCY). ALL PLANTS NOT MEETING THIS CONDITION SHALL BE REJECTED AND REPLACED BY HEALTHY PLANT MATERIAL PRIOR TO FINAL ACCEPTANCE.
    - b. ALL HARDSCAPE SHALL BE CLEANED PRIOR TO FINAL ACCEPTANCE.
    - c. SODDED AREAS MUST BE ACTIVELY GROWING AND MUST REACH A MINIMUM HEIGHT OF 1 1/2 INCHES BEFORE FIRST MOWING. HYDROMULCHED AREAS SHALL SHOW ACTIVE, HEALTHY GROWTH. BARE AREAS LARGER THAN TWELVE SQUARE INCHES MUST BE RESEED OR RESEED (AS APPROPRIATE) PRIOR TO FINAL ACCEPTANCE. ALL SODDED TURF SHALL BE RESEED OR RESEED (AS APPROPRIATE) PRIOR TO FINAL ACCEPTANCE.
- L. WARRANTY PERIOD, PLANT GUARANTEE AND REPLACEMENTS**
1. THE LANDSCAPE CONTRACTOR SHALL GUARANTEE ALL TREES, SHRUBS, PERENNIALS, SOD, SEEDLINGS/HYDROMULCHED AREAS, AND IRRIGATION SYSTEMS FOR A PERIOD OF ONE YEAR FROM THE DATE OF THE OWNER'S FINAL ACCEPTANCE. THE CONTRACTOR SHALL BE RESPONSIBLE FOR REPLACING ANY PLANTS THAT DIE DUE TO THE EXPENSE AND TO THE SATISFACTION OF THE OWNER, ANY PLANTS WHICH DIE IN THAT TIME, OR REPAIR ANY PORTIONS OF THE IRRIGATION SYSTEM WHICH OPERATE IMPROPERLY.
  2. AFTER THE INITIAL MAINTENANCE PERIOD AND DURING THE GUARANTEE PERIOD, THE LANDSCAPE CONTRACTOR SHALL ONLY BE RESPONSIBLE FOR REPLACEMENT OF PLANTS WHEN PLANT DEATH CANNOT BE ATTRIBUTED DIRECTLY TO OVERWATERING OR OTHER DAMAGE BY HUMAN ACTIONS.
- M. PROVIDE A MINIMUM OF (2) COPIES OF RECORD DRAWINGS TO THE OWNER UPON COMPLETION OF WORK. A RECORD DRAWING IS A RECORD OF THE WORK DONE, AND THE RECORD DRAWING IS DOCUMENTED THROUGH CHANGE ORDERS, APPENDIX, OR CONTRACTOR/CONSULTANT DRAWING MARKUPS.**

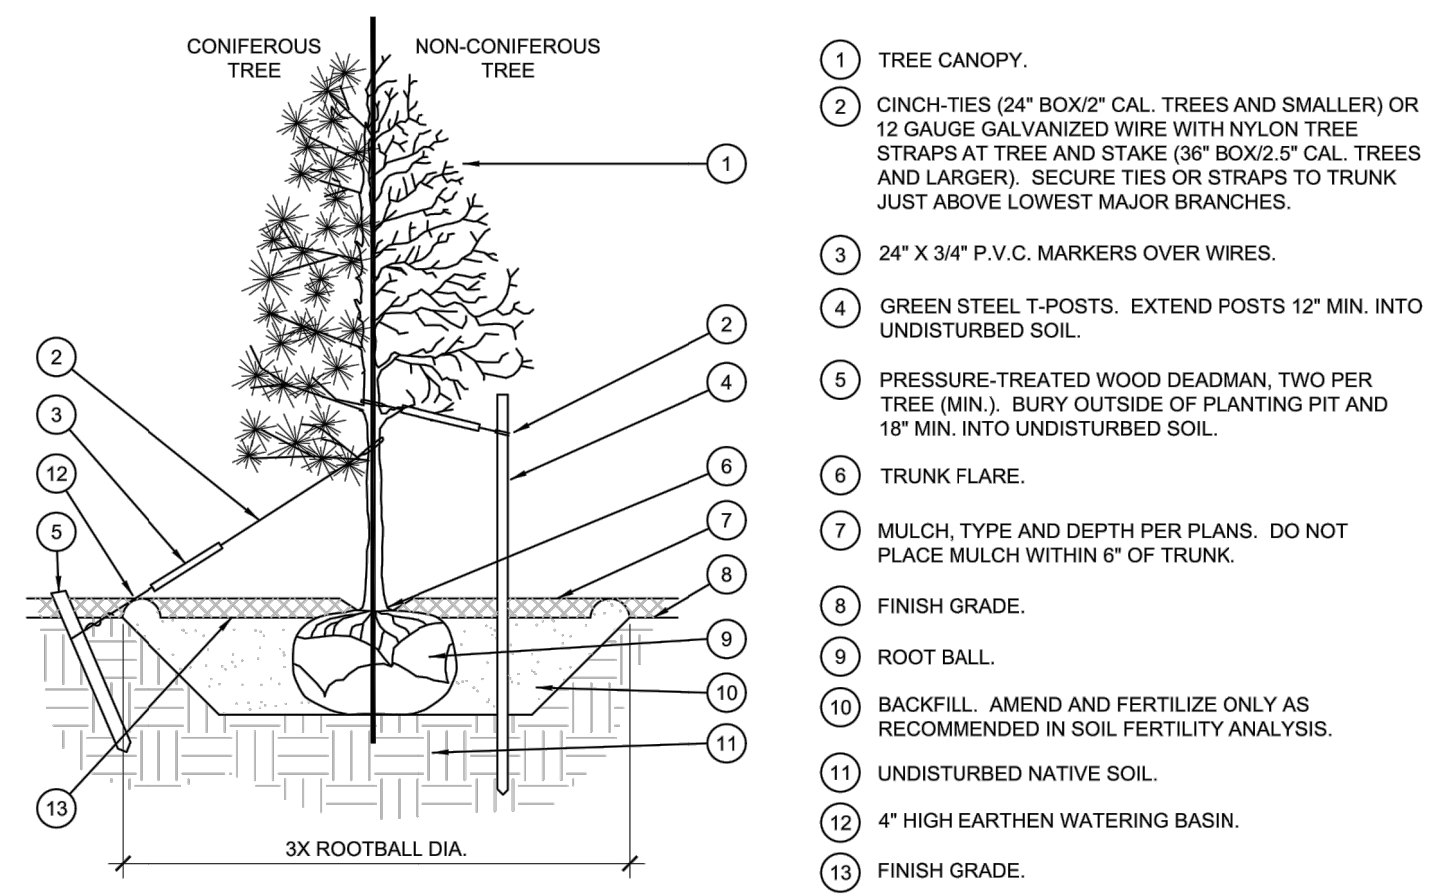


NOTES:

1. SCARIFY SIDES OF PLANTING PIT PRIOR TO SETTING TREE.
2. REMOVE EXCESS SOIL APPLIED ON TOP OF THE ROOTBALL THAT COVERS THE ROOT BALL. THE PLANTING HOLE DEPTH SHALL BE EQUAL TO THE ROOTBALL DEPTH PLUS 10% OF TURBIDED SOIL. AND THE ROOT FLARE IS 2" 4" ABOVE FINISH GRADE.
3. FOR 8/63 TREES, CUT OFF BOTTOM 1/3 OF WIRE BASKET BEFORE PLACING IN HOLE. FOR 10/63 TREES, CUT OFF BOTTOM 1/2 OF WIRE BASKET AFTER TREE IS SET IN HOLE. REMOVE ALL NYLON TIES, TWINE, ROPE, AND OTHER PACKING MATERIAL. REMOVE AS MUCH BURLAP FROM AROUND ROOTBALL AS IS PRACTICAL.
4. REMOVE ALL BURLAP FROM AROUND ROOTBALL.
5. FOR TREES 36" BOX/2 5/8" CAL. AND LARGER, USE THREE STAKES OR DEADEN (AS APPROPRIATE), SPACED EVENLY AROUND TREE.
6. STAKING SHALL BE TIGHT ENOUGH TO PREVENT TRUNK FROM BENDING, BUT LOOSE ENOUGH TO ALLOW SOME TRUNK MOVEMENT IN WIND.

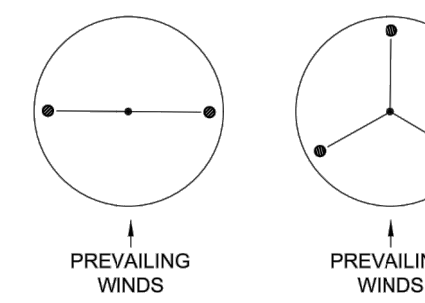

## TREE PLANTING

SCALE: NOT TO SCALE

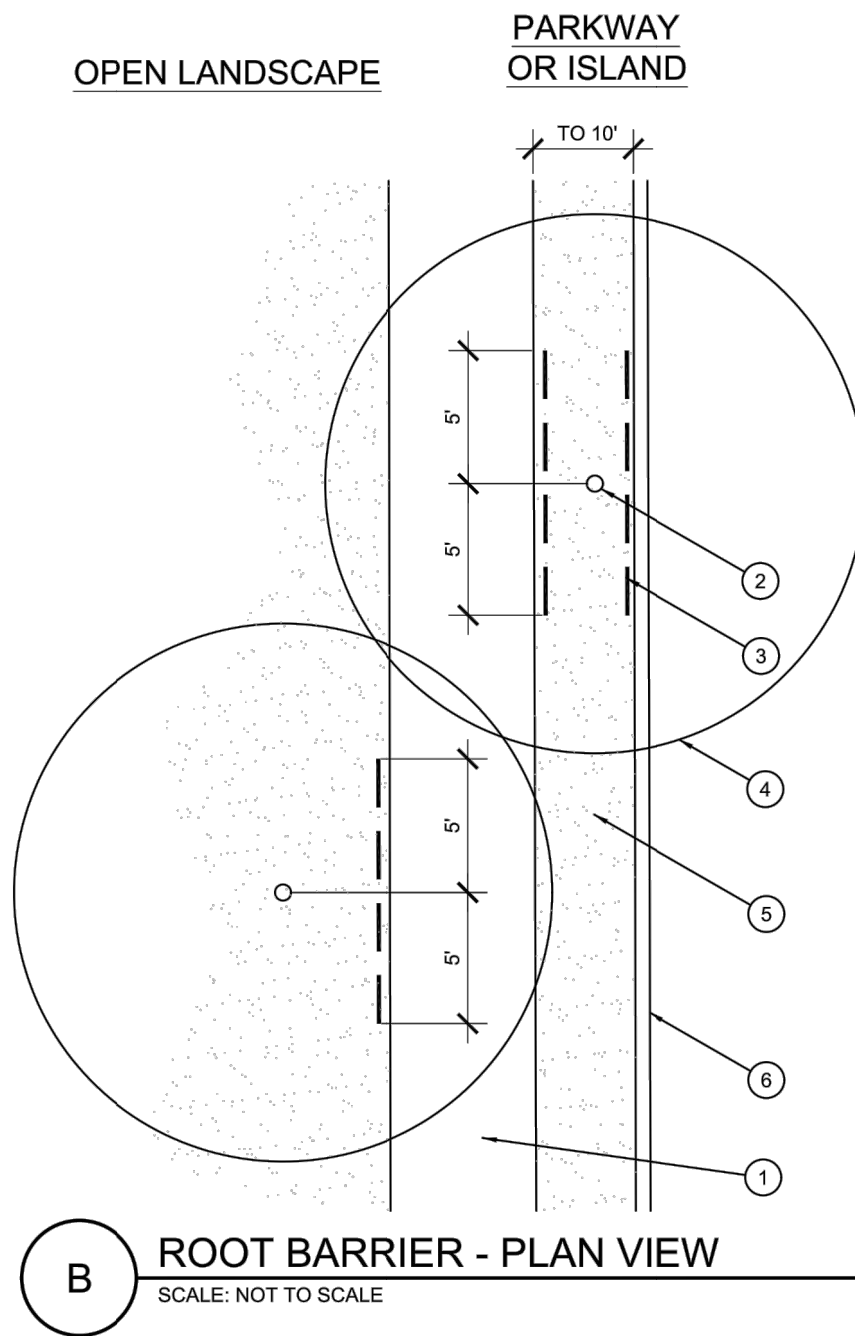

- 1 TYPICAL WALKWAY OR PAVING
- 2 TREE TRUNK
- 3 LINEAR ROOT BARRIER MATERIAL. SEE PLANTING NOTES FOR TYPE AND MANUFACTURER. INSTALL PER MANUFACTURER'S SPECIFICATIONS.
- 4 TREE CANOPY
- 5 TYPICAL PLANTING AREA
- 6 TYPICAL CURB AND GUTTER

NOTES:

- 1) INSTALL ROOT BARRIERS NEAR ALL NEWLY-PLANTED TREES THAT ARE LOCATED WITHIN FIVE (5) FEET OF PAVING OR CURBS.
- 2) BARRIERS SHALL BE LOCATED IMMEDIATELY ADJACENT TO HARDSCAPE. UNDER NO CIRCUMSTANCES SHALL THE CONTRACTOR USE ROOT BARRIERS OF A TYPE THAT COMPLETELY ENCIRCLE THE ROOTBALL.

### ROOT BARRIER - PLAN VIEW

SCALE: NOT TO SCALE

TEXAS REGISTRATION #14199

**CLAYMOORE**

**ENGINEERING**

PHONE: 817.284.0072  
WWW.CLAYMOREENG.COM

10 CENTRAL DRIVE, SUITE #408  
FLORENCE, TX 76033



07/15/2024

**SANGER MULTI-FAMILY  
PREPARED FOR  
GREYSTAR  
SANGER, TEXAS**

[illegible]

## LANDSCAPE PLANTING DETAILS & SPECIFICATIONS



DESIGN:	EMS
DRAWN:	EMS
CHECKED:	RM
DATE:	7/12/2024

**SHEET**


# LP-3

CASE NO.	2022-185
----------	----------

- Add not to specify that the owner is responsible for landscape maintenance

ERIC SHEPLEY  
PLOTTED BY: 7/12/2024 2:21 PM  
PLOT DATE: P:\SHARED\PROJECTS\2023\GREYSTAR MFR - SANGER TX\XREF\X22X34 MF.DWG  
LOCATION: 7/12/2024 2:08 PM  
LAST SAVED:




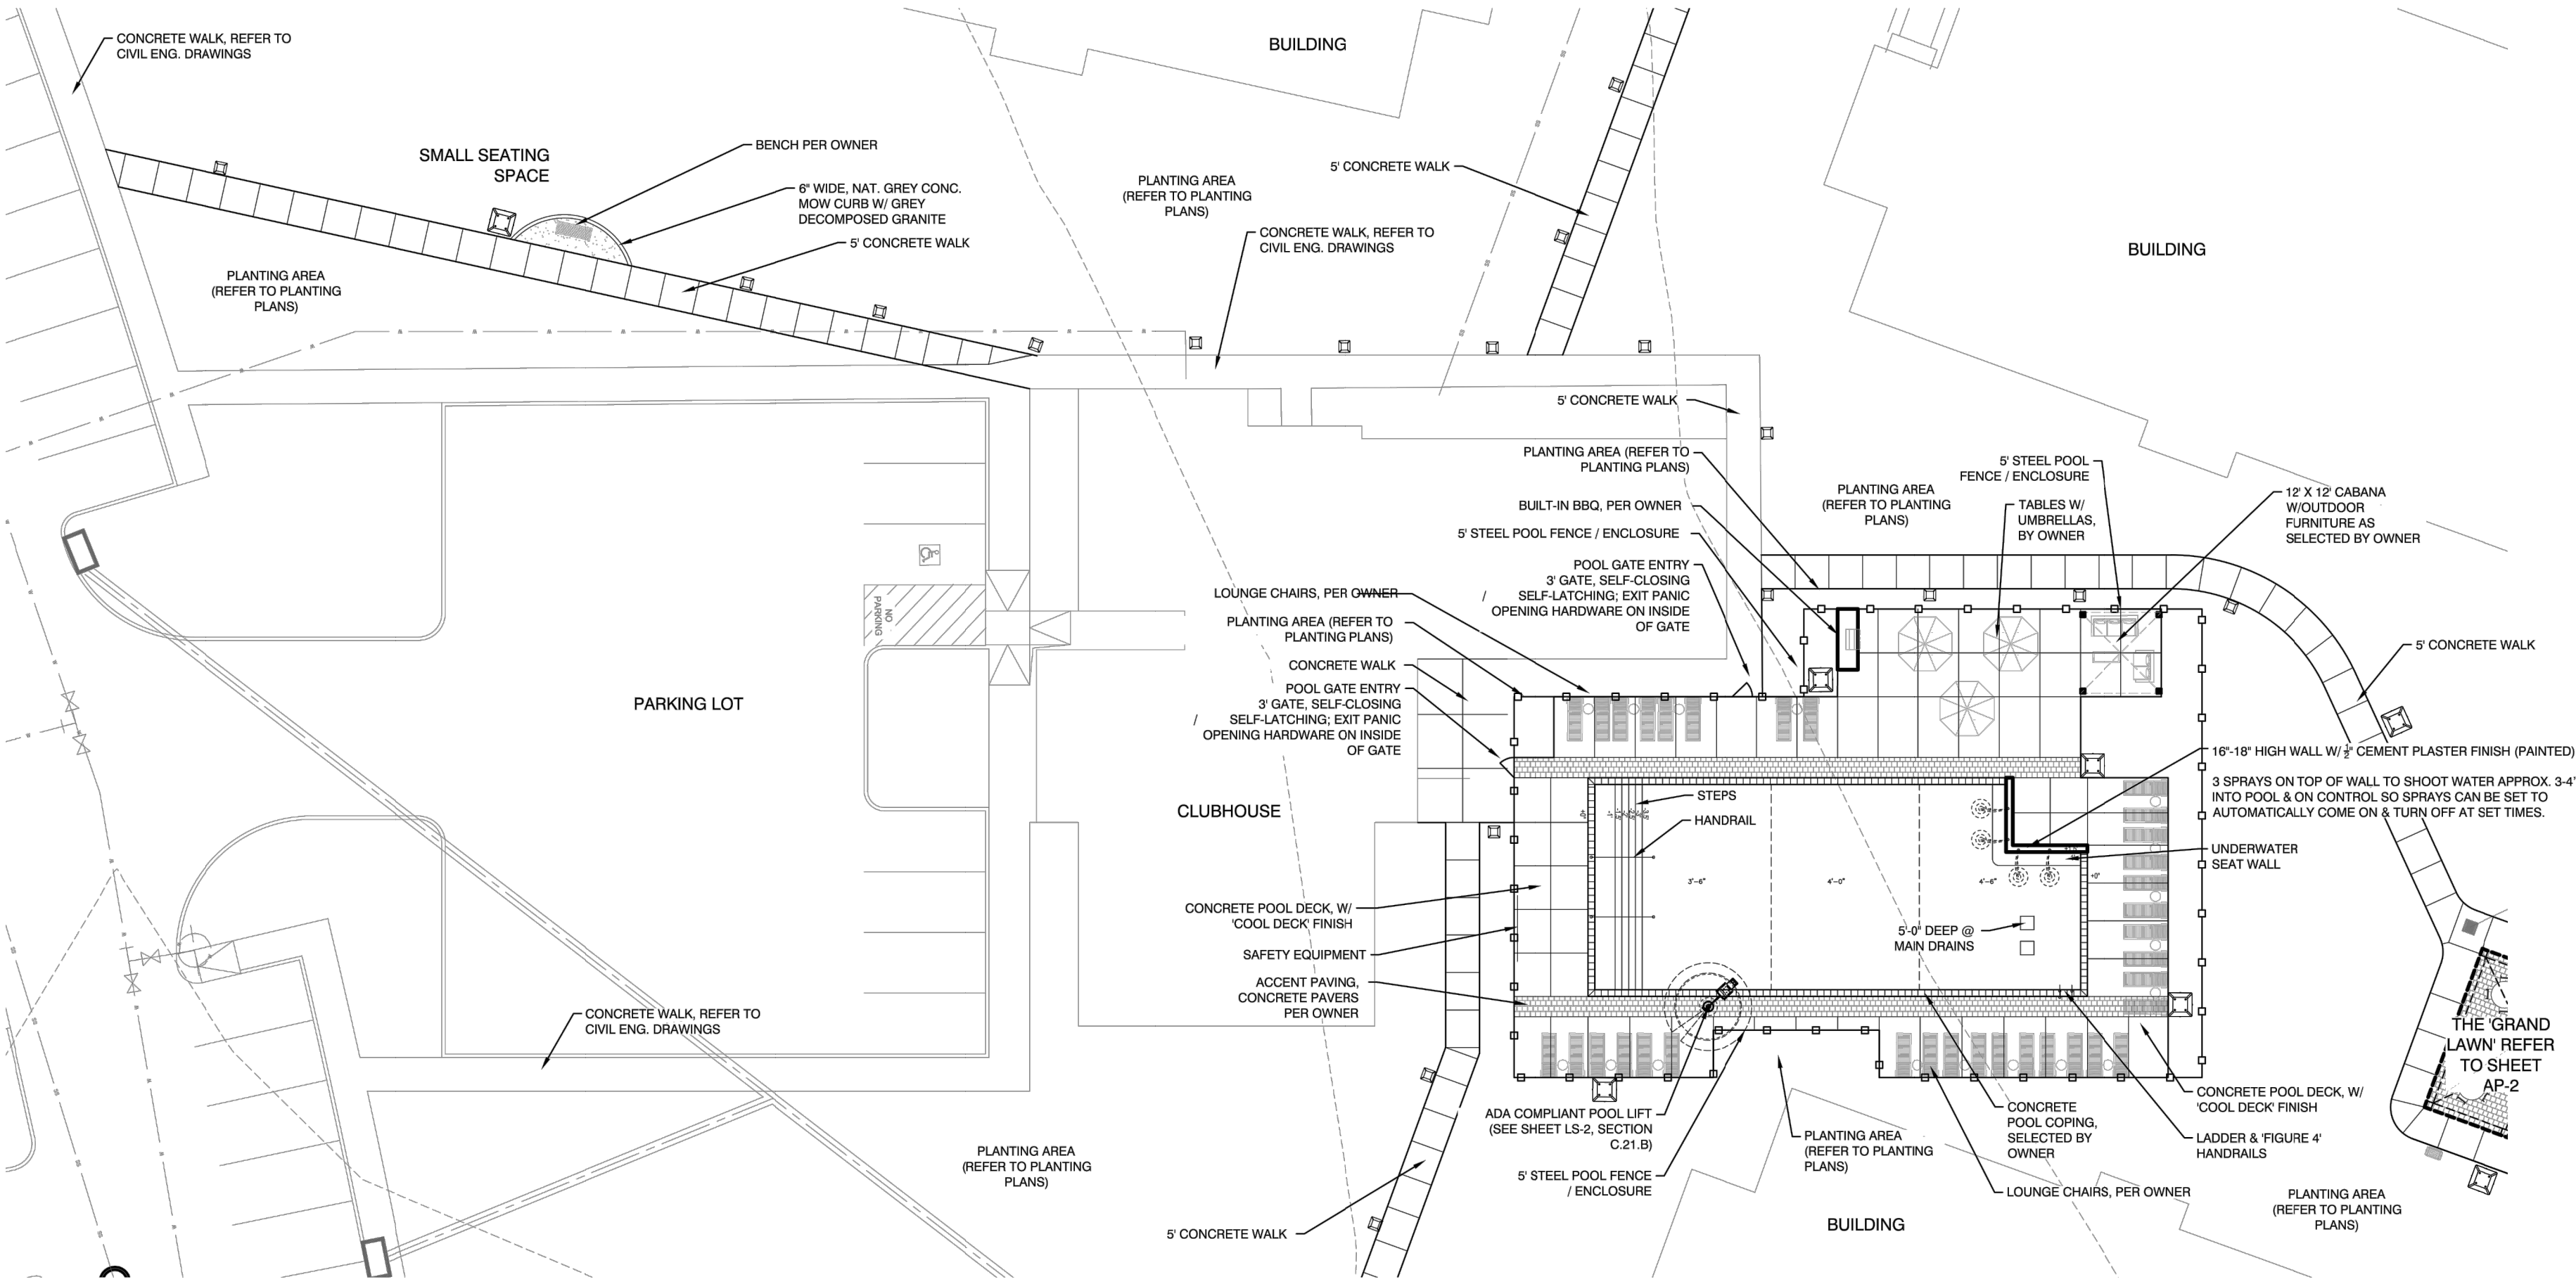

POOL DECK & SMALL SEATING SPACE

GENERAL NOTES

- CONTRACTOR SHALL VERIFY WITH OWNER'S REPRESENTATIVE THAT PLANS ARE CURRENT AND APPROVED.
- WORK SHALL BE IN ACCORDANCE WITH THE REQUIREMENTS OF THE LOCAL JURISDICTIONS.
- THESE PLANS ARE BASED ON IMPROVEMENT PLANS BY CLAYMOORE ENGINEERING.
- THE GEOTECHNICAL SOILS ENGINEERING REPORT IS A PART OF THESE CONSTRUCTION DOCUMENTS. THE CONTRACTOR SHALL COMPLY WITH THE REPORT'S RECOMMENDATIONS AS THEY RELATE TO HIS WORK.
- THE CONTRACTOR SHALL OBTAIN ALL NECESSARY AND/OR REQUIRED PERMITS AND PAY ALL RELATED FEES AND/OR TAXES REQUIRED TO INSTALL THE WORK ON THESE PLANS.
- THE CONTRACTOR SHALL BE APPROPRIATELY LICENSED AS REQUIRED BY THE STATE IN WHICH THE WORK TAKES PLACE.
- A SEPARATE PLUMBING PERMIT AND INSPECTION WILL BE REQUIRED FROM THE BUILDING INSPECTION DEPARTMENT FOR THE INSTALLATION OF IRRIGATION SYSTEMS SHOWN ON THIS DRAWING.
- THE CONTRACTOR SHALL NOTIFY THE OWNER'S REPRESENTATIVE PRIOR TO BEGINNING THE WORK AND SHALL BE RESPONSIBLE FOR COORDINATING WITH THE OWNER, LANDSCAPE ARCHITECT, GOVERNING AGENCIES AND OTHER TRADES.
- CONTRACTOR SHALL NOTIFY LANDSCAPE ARCHITECT IMMEDIATELY OF ANY ERRORS, OMISSIONS OR DISCREPANCIES IN EXISTING CONDITIONS OR WITHIN THE PLANS PRIOR TO BEGINNING THE WORK.
- UNIT PRICES FOR ALL IMPROVEMENTS SHALL BE ESTABLISHED AS A PART OF THE CONTRACT WITH THE PROJECT OWNER AND PRIOR TO BEGINNING WORK, TO ACCOMMODATE ADDITIONS AND/OR DELETIONS OF MATERIAL AND/OR LABOR.
- DETERMINATION OF "EQUAL" SUBSTITUTIONS SHALL BE MADE ONLY BY THE LANDSCAPE ARCHITECT.
- LANDSCAPE ARCHITECT SHALL BE NOTIFIED NO LESS THAN 48 HOURS IN ADVANCE OF ANY SITE OBSERVATIONS OR MEETINGS.
- SITE OBSERVATIONS AND MEETINGS SHALL INCLUDE:
  - A. PRE-CONSTRUCTION CONFERENCE
  - B. SELECTION AND TAGGING OF SPECIMEN TREES AT NURSERIES
  - C. LANDSCAPE GRADING PRIOR TO PLANTING
  - D. LAYOUT AND INSTALLATION OF HARDSCAPE AND LANDSCAPE STRUCTURES IN RELATION TO DESIGN INTENT
  - E. PLANT MATERIAL QUALITY AND INSTALLATION AT THE PROJECT SITE
  - F. OBSERVATION TO ESTABLISH 90-DAY MAINTENANCE PERIOD (PRE-MAINTENANCE)
  - G. FINAL OBSERVATION AT THE END OF THE 90-DAY MAINTENANCE PERIOD (FINAL)NOTE: "LANDSCAPE" SHALL REFER TO ALL IMPROVEMENTS WITHIN THIS SET OF DOCUMENTS THAT HAVE BEEN DESIGNED BY THIS OFFICE.
- SITE OBSERVATIONS BY THE LANDSCAPE ARCHITECT DURING ANY PHASE OF THIS PROJECT DOES NOT RELIEVE THE CONTRACTOR OF HIS PRIMARY RESPONSIBILITY TO PERFORM ALL WORK IN ACCORDANCE WITH THE PLANS, SPECIFICATIONS AND GOVERNING CODES.
- CONTRACTOR SHALL BE BACKCHARGED FOR LANDSCAPE ARCHITECT'S TIME WHEN OBSERVATIONS ARE CALLED FOR AND IT IS FOUND THAT THE WORK IS NOT SIGNIFICANTLY READY UPON OBSERVATION OR THE APPOINTMENT IS NOT KEPT. TIME WILL BE CHARGED ON AN HOURLY BASIS, PLUS TRANSPORTATION, FOOD AND LODGING COSTS, IF ANY, AT THE THEN EXISTING HOURLY RATE FOR THE PERSONNEL PROVIDING THE OBSERVATIONS.
- THIS FIRM DOES NOT PRACTICE OR CONSULT IN THE FIELD OF SAFETY ENGINEERING. THIS FIRM DOES NOT DIRECT THE CONTRACTOR'S OPERATIONS, AND IS NOT RESPONSIBLE FOR THE SAFETY OF PERSONNEL OTHER THAN OUR OWN ON THE SITE; THE SAFETY OF OTHERS IS THE RESPONSIBILITY OF THE CONTRACTOR. THE CONTRACTOR SHOULD NOTIFY THE OWNER IF HE CONSIDERS ANY OF THE RECOMMENDED ACTIONS PRESENTED HEREIN TO BE UNSAFE.

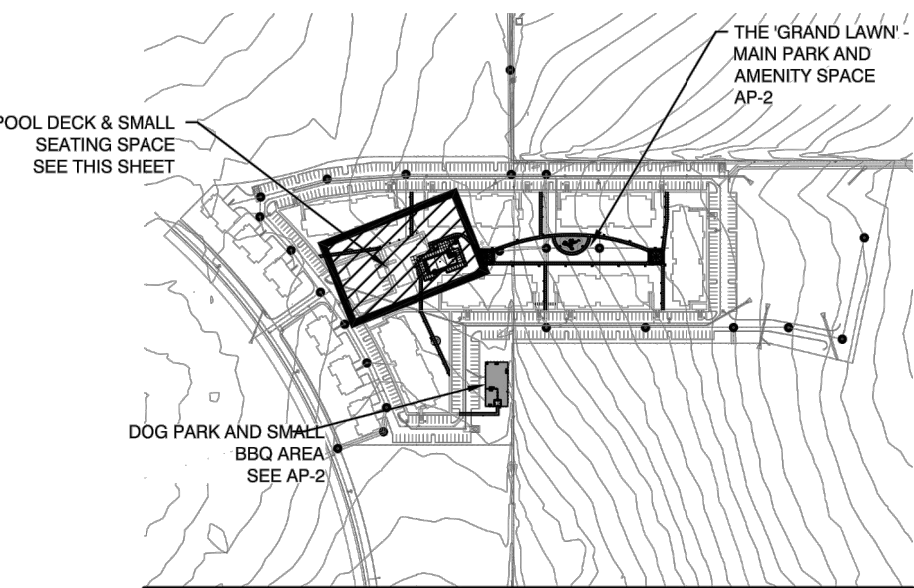

KEY MAP

THIS LAYOUT PLAN AND ASSOCIATED SPECIFICATIONS ARE PROVIDED TO SHOW DESIGN INTENT ONLY. POOL CONTRACTOR IS RESPONSIBLE TO PROVIDE ENGINEERED AQUATIC DRAWINGS IN COMPLIANCE WITH ALL APPLICABLE JURISDICTIONAL CODES.

NOTES

ALL PLANTERS AROUND THE POOL STRUCTURE SHALL BE FULLY ENCLOSED TO PREVENT WATER FROM ENTERING THE SUBGRADE BELOW/AROUND THE POOL. PLANTERS SHALL BE CONSTRUCTED TO HAVE A 36" MINIMUM DEPTH OF SOIL FOR HEALTHY PLANT GROWTH, PLUS GRAVEL BOTTOM WITH FRENCH DRAIN TO REMOVE EXCESS WATER. 'FRENCH-DRAINS' SHALL BE CONNECTED TO A PIPE TO GRAVITY FLOW WATER TO A SUITABLE OUTFLOW LOCATION.

POOL SHELL, DECKING, ENCLOSED PLANTERS, ETC., DESIGNED BY STRUCTURAL ENGINEER AND COMPLYING TO GEOTECHNICAL REPORT PREPARED FOR THIS PROJECT AND AS PARTIALLY REPRODUCED ON THIS SHEET.

DECKING SCORING AND EXPANSION JOINT PATTERNS SHOWN ARE INTENDED AS GUIDELINES ONLY. DUE TO THE REQUIREMENTS OF THE GEOTECHNICAL REPORT, THE POOL CONTRACTOR AND THEIR STRUCTURAL ENGINEER SHALL REVIEW THIS LAYOUT AND REVISE AS APPROPRIATE WITH OWNER APPROVAL. SPECIAL PAVINGS SHOWN SHALL ALSO BE REVIEWED AND REVISED AS NECESSARY TO COMPLY TO CONSTRAINTS OF THE REPORT AND THE DESIRES OF THE OWNER.

HOSE BIBS SHALL BE PROVIDED AROUND THE PERIMETER OF THE DECK AREA AT INTERVALS SUCH THAT ALL PARTS OF THE DECK CAN BE REACHED WITH A 100-FOOT HOSE.

**GRADING & DRAINAGE NOTES:**  
1) SEE CIVIL ENGINEERING PLANS FOR FINISH GRADING ON DECK AND AROUND POOL.  
2) TYPICAL SLOPE AWAY FROM POOL EDGE ACROSS POOL DECK SHOULD NOT EXCEED 2.0% IN ANY DIRECTION, REPORT ANY VARIANCE TO THIS TO ENGINEER AND OWNER FOR CORRECTION.

**GATE LATCH NOTES:**  
1) GATE MUST HAVE A SELF-CLOSING AND SELF-LATCHING DEVICE.  
2) GATE MUST HAVE HARDWARE ENABLING IT TO BE LOCKED, AT THE OPTION OF WHOEVER CONTROLS THE GATE, BY A PADLOCK OR A BUILT-IN LOCK OPERATED BY KEY, CARD, OR COMBINATION.  
3) GATE MUST OPEN OUTWARD AWAY FROM THE POOL YARD.  
4) GATE LATCH MUST BE INSTALLED AT LEAST 60 INCHES ABOVE THE GROUND.  
5) GATE LATCH MAY BE INSTALLED LOWER THAN 60 INCHES IF THE LATCH IS INSTALLED ON THE POOL YARD SIDE OF THE GATE ONLY AND IS AT LEAST THREE INCHES BELOW THE TOP OF THE GATE, AND THE GATE OR ENCLOSURE HAS NO OPENING GREATER THAN ONE-HALF INCH IN ANY DIRECTION WITHIN 18 INCHES FROM THE LATCH, INCLUDING THE SPACE BETWEEN THE GATE AND THE GATE POST TO WHICH THE GATE LATCHES.  
6) A GATE LATCH MAY BE LOCATED 42 INCHES OR HIGHER ABOVE THE GROUND IF THE GATE CANNOT BE OPENED EXCEPT BY KEY, CARD, OR COMBINATION ON BOTH SIDES OF THE GATE.

GEOTECHNICAL REPORT RECOMMENDATIONS (FOR REFERENCE)

THE FOLLOWING IS PROVIDE SECTION OF THE GEOTECHNICAL REPORT PREPARED BY ALPHA TESTING DATED 10/27/22. THE BELOW IS FOR REFERENCE ONLY, PLEASE REFER TO SECTION 6.6 OF THE MOST CURRENT GEOTECHNICAL REPORT FOR ADDITIONAL INFORMATION AND TO ENSURE THE RECOMMENDATIONS ARE CURRENT:


BASED ON THE INFORMATION PROVIDED TO US, WE ANTICIPATE THE SWIMMING POOL WILL BE LOCATED IN THE VICINITY OF BORING B-1. ROCK (LIMESTONE) WAS ENCOUNTERED AT A DEPTH AS SHALLOW AS 2 FT BELOW THE EXISTING GROUND SURFACE IN THIS BORING. THE SWIMMING POOL/POOL DECK AREA COULD BE SUBJECTED TO POTENTIAL SEASONAL MOVEMENT UP TO ABOUT 1 1/2 INCHES BASED ON THE SOIL CONDITIONS ENCOUNTERED IN THIS AREA. SUBGRADE IMPROVEMENT IN THE SWIMMING POOL, AND POOL DECK AREAS SHOULD CONFORM TO THE RECOMMENDATIONS DISCUSSED IN SECTION 6.2 (USING ON-SITE SOIL (MAX PI OF 25) AND/OR SELECT FILL TO RAISE SITE GRADES).

THE PROPOSED SWIMMING POOL WALLS WILL BE SUBJECT TO LATERAL EARTH PRESSURES INDUCED BY THE SOIL RETAINED BY THOSE WALLS. IF THE POOL IS CONSTRUCTED USING "GUNITE" TECHNIQUES, THEN THE RETAINED SOIL WILL BE THE ON-SITE CLAYEY SOILS ENCOUNTERED IN THE BORINGS. AS SUCH, THE EQUIVALENT FLUID DENSITY WILL BE DICTATED BY THAT NATURAL SOIL. LATERAL PRESSURES EXERTED BY COMPETENT LIMESTONE ROCK WILL BE NEGLIGIBLE.

IF THE SOILS ARE MASS-EXCAVATED AND THE SWIMMING POOL IS FORMED AND PLACED, THEN THE BACKFILL CAN CONSIST OF FREE DRAINING GRANULAR SOILS SUCH AS CLEAN, FREE-DRAINING SAND OR GRAVEL, WHICH WILL ALLOW THE EQUIVALENT FLUID DENSITY EXERTED ON THE POOL WALLS TO BE CONTROLLED TO SOME EXTENT. IF THE POOL WALLS ARE BACKFILLED, THEN A DRAINAGE SYSTEM COMPRISED OF SLOTTED OR PERFORATED PVC PIPE ENCASED BY CLEAN SAND OR GRAVEL THAT IS COMPLETELY WRAPPED IN FILTER FABRIC SHOULD BE CONSIDERED FOR BEHINDWALL CONSTRUCTION TO FURTHER CONTROL THE EQUIVALENT FLUID DENSITY. VERTICAL FACE DRAINS ARE COMMONLY USED TO PROVIDE SOME DRAINAGE AND REDUCE HYDROSTATIC FORCES BEHIND EARTH-FORMED RETAINING STRUCTURES. HOWEVER, WITHOUT A FREE-DRAINING MATERIAL PLACED WITHIN THE ENTIRE ACTIVE ZONE BEHIND THE WALL, HYDROSTATIC FORCES CAN STILL DEVELOP. THE "ACTIVE ZONE" CONSISTS OF THE AREA BEHIND THE WALL WITHIN A BOUNDARY CREATED BY A 45-DEGREE ANGLE DRAWN FROM THE HEEL OF THE WALL AND EXTENDING UPWARD TO THE GROUND SURFACE.

THE EQUIVALENT FLUID PRESSURES PROVIDED IN TABLE C MAY BE USED FOR THE DESIGN OF THE SWIMMING POOL WALLS AT THIS SITE DEPENDING UPON THE DESIGN RESTRAINT CONDITION AND UPON WHETHER OR NOT SUBSURFACE WATER CAN BE EFFECTIVELY DRAINED FROM BEHIND THE WALL. THE FLUID PRESSURES DO NOT ACCOUNT FOR ANY SURCHARGE LOADS. THE "ACTIVE" RESTRAINT CONDITION ASSUMES THE TOP OF WALL WILL rotate. CONVERSELY, THE "AT-REST" RESTRAINT CONDITION ASSUMES THE TOP OF THE WALL WILL NOT MOVE. THE "AT-REST" CONDITION MAY BE MORE APPROPRIATE FOR SWIMMING POOL WALLS.

WE RECOMMEND THAT THE WALLS OF THE POOL BE DESIGNED ASSUMING NO PRESSURE FROM THE WATER IN THE POOL (THAT IS, AN EMPTY POOL). WE ANTICIPATE THAT FLATWORK OR A 2-FT THICK CLAY CAP WILL BE CONSTRUCTED OVER THE GRANULAR BACKFILL AND WILL SERVE AS A PROTECTIVE COVER TO REDUCE SURFACE WATER FROM INFILTRATING INTO THE BACKFILL MATERIALS. THE RECOMMENDATIONS PRESENTED IN THIS SECTION ARE TO BE USED FOR EQUIVALENT FLUID PRESSURES TO AID IN DESIGNING THE POOL. A SPECIAL POOL DESIGNER AND 1) ENGINEER SHOULD BE CONSULTED.

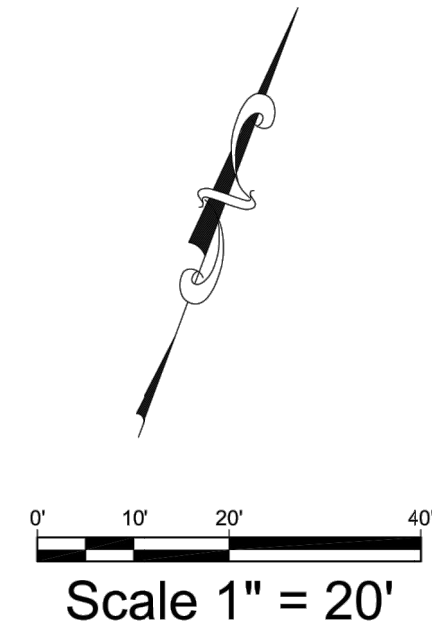

Scale 1" = 20'



DESIGN: EMS  
DRAWN: EMS  
CHECKED: RM  
DATE: 7/12/2024


SHEET  
**AP-1**

CASE NO. 2022-185


NO.	DATE	REVISION	BY



PLOTTED BY: SHARON STACHECKI  
PLOT DATE: 7/12/2024 2:26 PM  
LOCATION: P:\SHARED\PROJECTS\2023\GREYSTAR MFR - SANGER TX\GREYSTAR MF SANGER TX 2024-07-12 AP.DWG  
LAST SAVED: 7/12/2024 2:22 PM

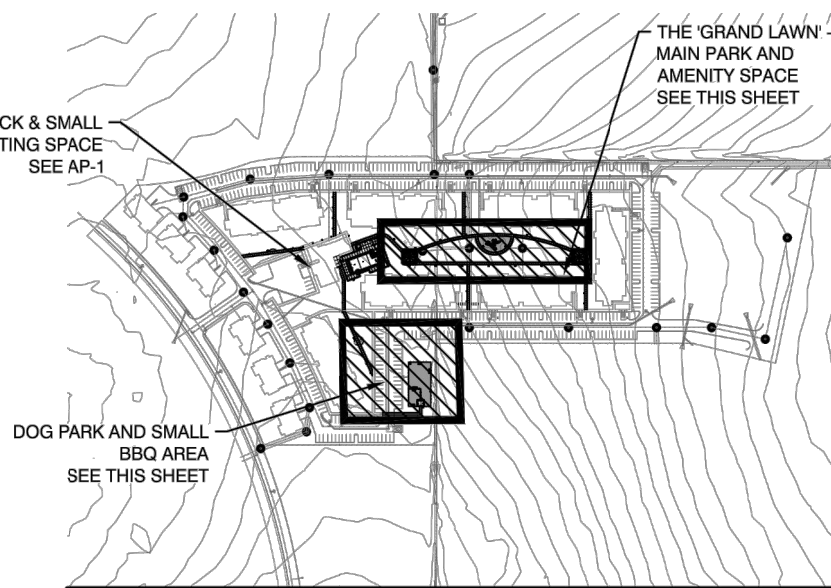


KEY MAP

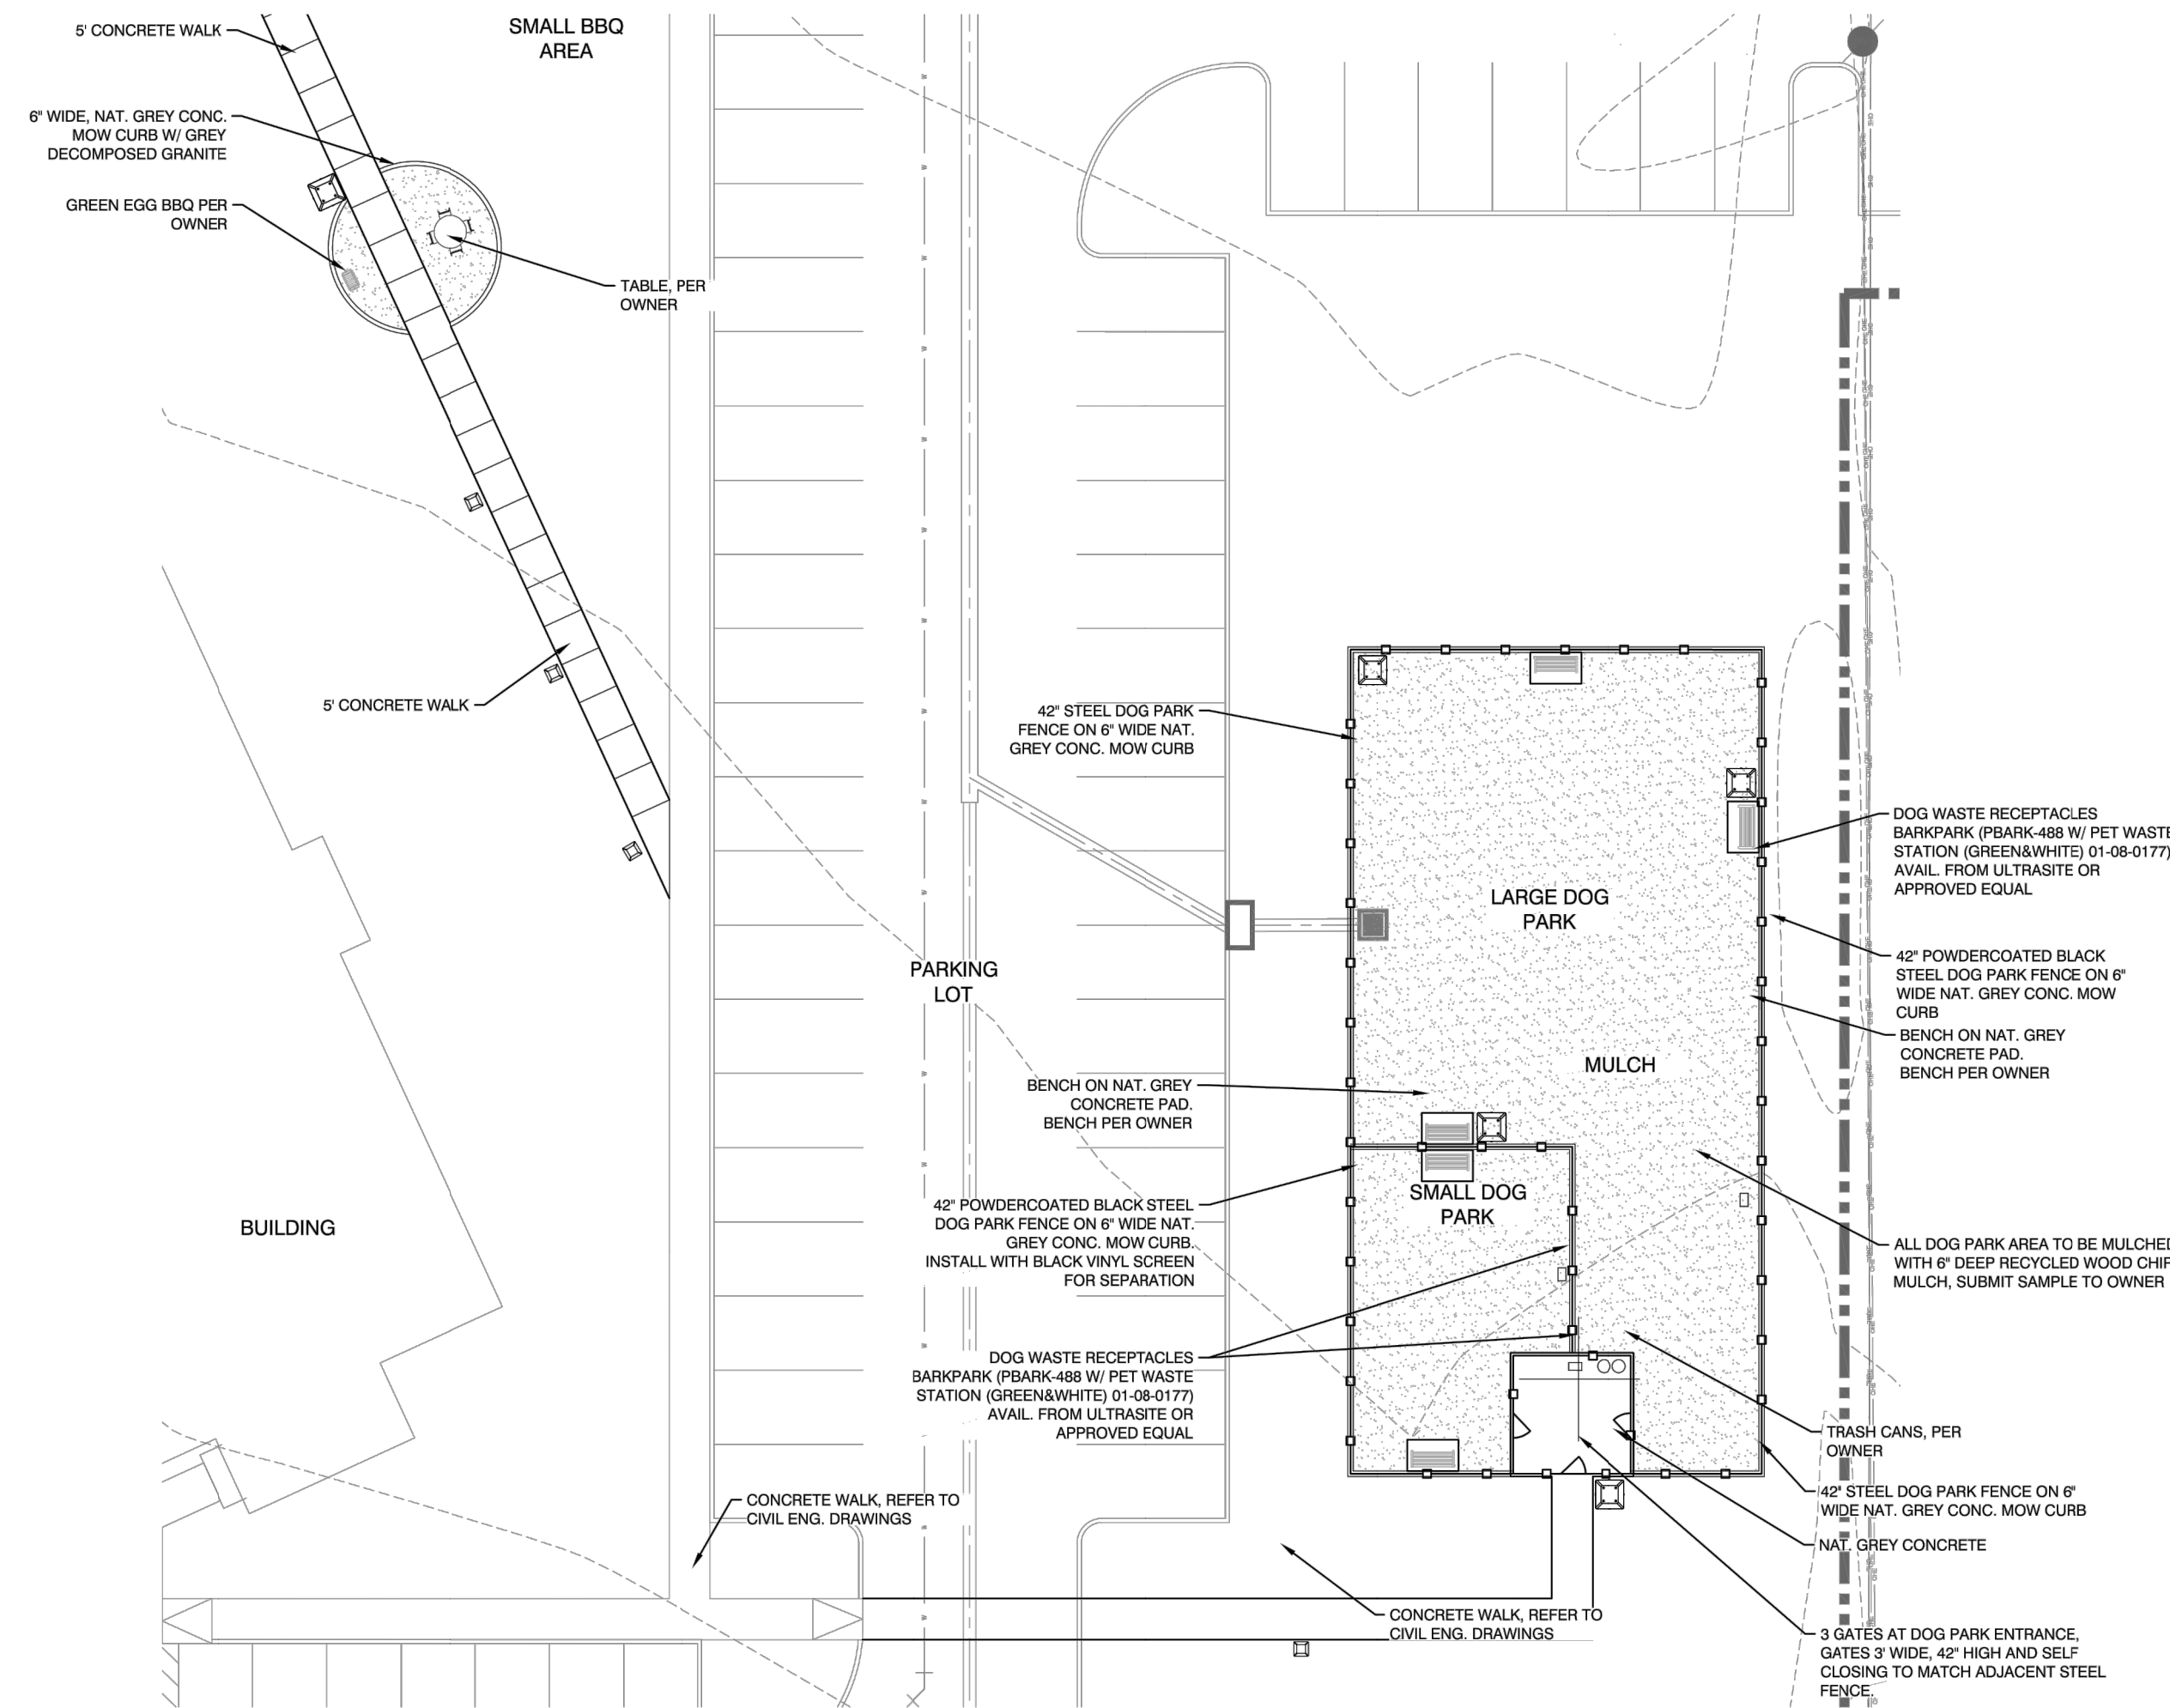


DOG PARK AND SMALL BBQ AREA

THE 'GRAND LAWN' - MAIN PARK AND AMENITY SPACE

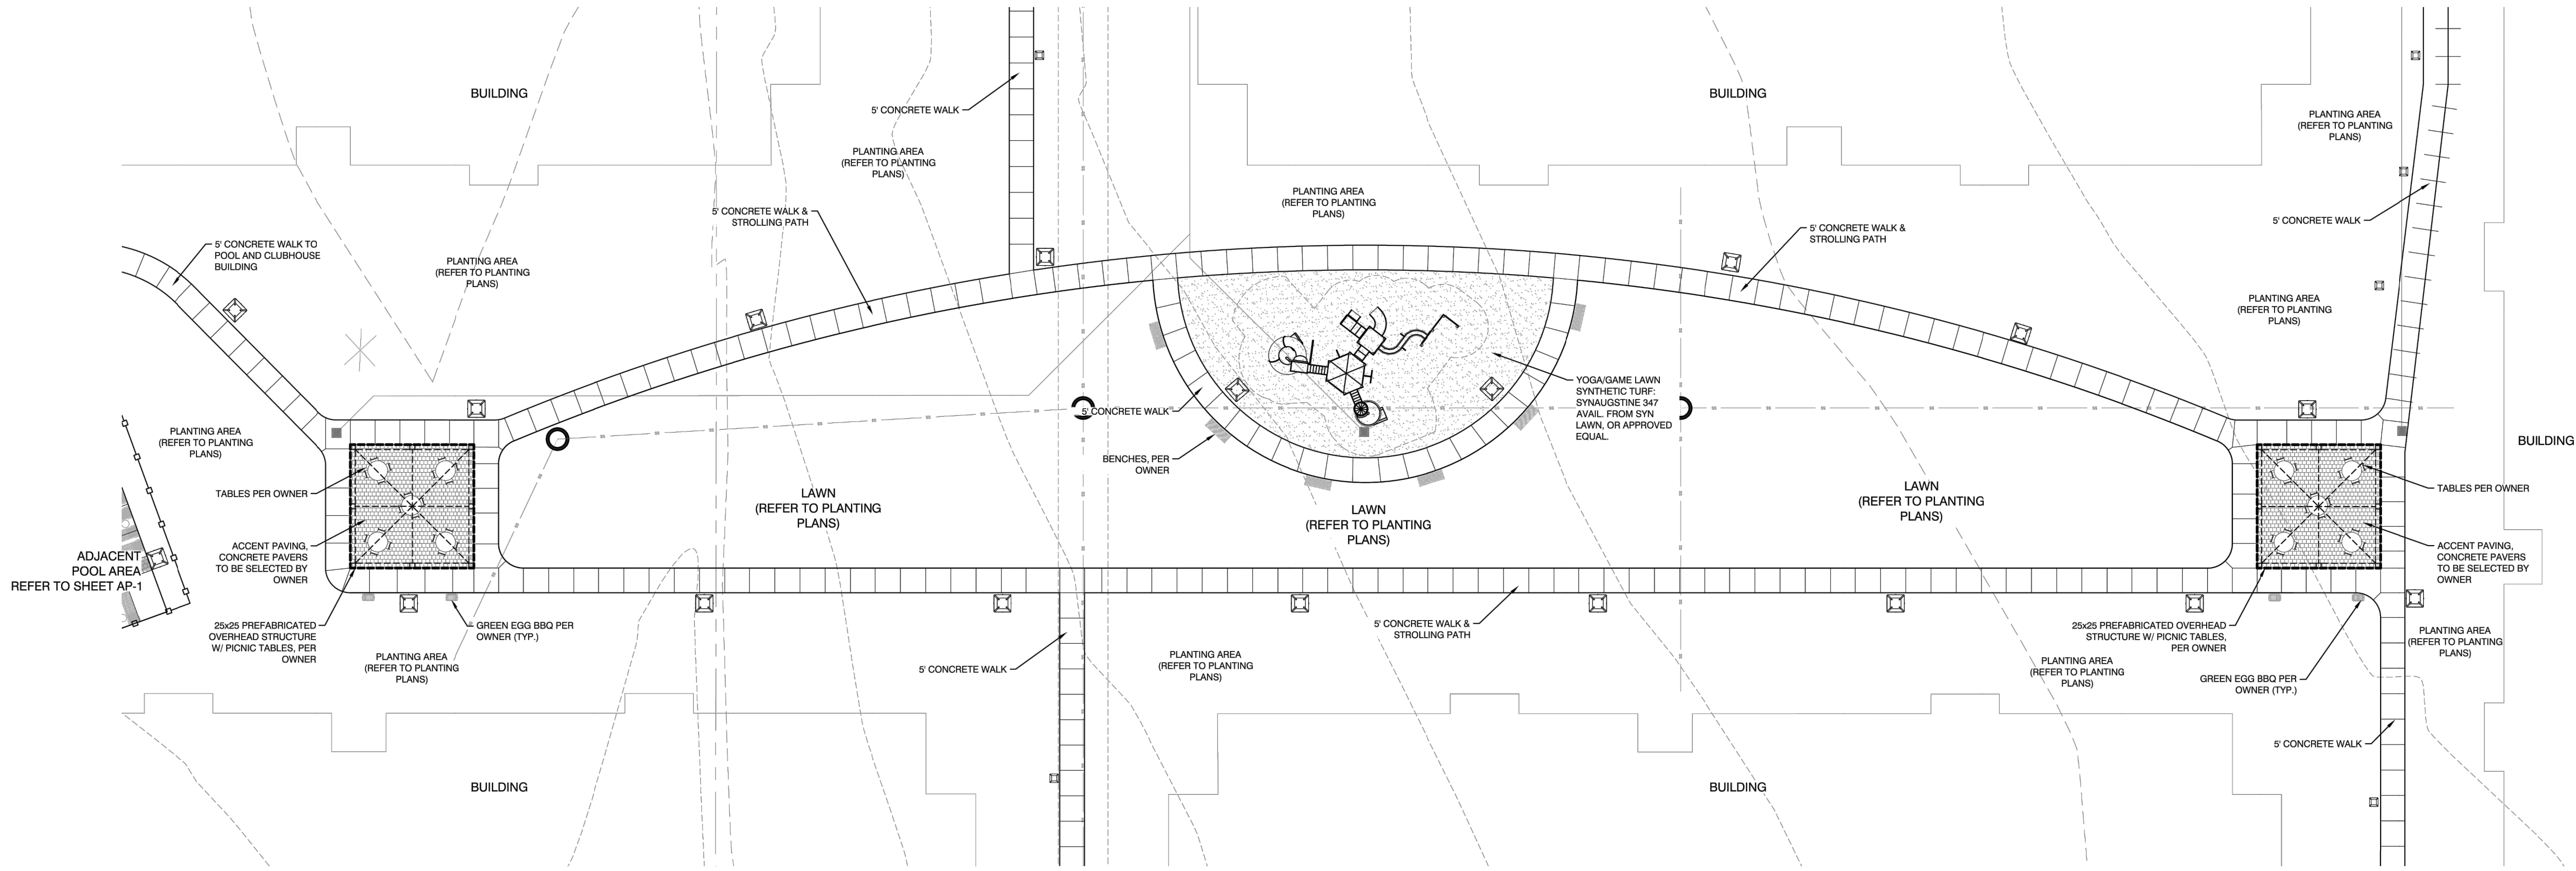

GENERAL NOTES

1. CONTRACTOR SHALL VERIFY WITH OWNER'S REPRESENTATIVE THAT PLANS ARE CURRENT AND APPROVED.
2. WORK SHALL BE IN ACCORDANCE WITH THE REQUIREMENTS OF THE LOCAL JURISDICTIONS.
3. THESE PLANS ARE BASED ON IMPROVEMENT PLANS BY CLAYMOORE ENGINEERING.
4. THE GEOTECHNICAL SOILS ENGINEERING REPORT IS A PART OF THESE CONSTRUCTION DOCUMENTS. THE CONTRACTOR SHALL COMPLY WITH THE REPORT'S RECOMMENDATIONS AS THEY RELATE TO HIS WORK.
5. THE CONTRACTOR SHALL OBTAIN ALL NECESSARY AND/OR REQUIRED PERMITS AND PAY ALL RELATED FEES AND/OR TAXES REQUIRED TO INSTALL THE WORK ON THESE PLANS.
6. THE CONTRACTOR SHALL BE APPROPRIATELY LICENSED AS REQUIRED BY THE STATE IN WHICH THE WORK TAKES PLACE.
7. A SEPARATE PLUMBING PERMIT AND INSPECTION WILL BE REQUIRED FROM THE BUILDING INSPECTION DEPARTMENT FOR THE INSTALLATION OF IRRIGATION SYSTEMS SHOWN ON THIS DRAWING.
8. THE CONTRACTOR SHALL NOTIFY THE OWNER'S REPRESENTATIVE PRIOR TO BEGINNING THE WORK AND SHALL BE RESPONSIBLE FOR COORDINATING WITH THE OWNER, LANDSCAPE ARCHITECT, GOVERNING AGENCIES AND OTHER TRADES.
9. CONTRACTOR SHALL NOTIFY LANDSCAPE ARCHITECT IMMEDIATELY OF ANY ERRORS, OMISSIONS, OR DISCREPANCIES IN EXISTING CONDITIONS OR WITHIN THE PLANS PRIOR TO BEGINNING THE WORK.
10. UNIT PRICES FOR ALL IMPROVEMENTS SHALL BE ESTABLISHED AS A PART OF THE CONTRACT WITH THE PROJECT OWNER AND PRIOR TO BEGINNING WORK, TO ACCOMMODATE ADDITIONS AND/OR DELETIONS OF MATERIAL AND/OR LABOR.
11. DETERMINATION OF "EQUAL" SUBSTITUTIONS SHALL BE MADE ONLY BY THE LANDSCAPE ARCHITECT.
12. LANDSCAPE ARCHITECT SHALL BE NOTIFIED NO LESS THAN 48 HOURS IN ADVANCE OF ANY SITE OBSERVATIONS OR MEETINGS.
13. SITE OBSERVATIONS AND MEETINGS SHALL INCLUDE:
  - A. PRE-CONSTRUCTION CONFERENCE
  - B. SELECTION AND TAGGING OF SPECIMEN TREES AT NURSERIES
  - C. LANDSCAPE GRADING PRIOR TO PLANTING
  - D. LAYOUT AND INSTALLATION OF HARDSCAPE AND LANDSCAPE STRUCTURES IN RELATION TO DESIGN INTENT
  - E. PLANT MATERIAL QUALITY AND INSTALLATION AT THE PROJECT SITE
  - F. OBSERVATION TO ESTABLISH 90-DAY MAINTENANCE PERIOD (PRE-MAINTENANCE)
  - G. FINAL OBSERVATION AT THE END OF THE 90-DAY MAINTENANCE PERIOD (FINAL)NOTE: "LANDSCAPE" SHALL REFER TO ALL IMPROVEMENTS WITHIN THIS SET OF DOCUMENTS THAT HAVE BEEN DESIGNED BY THIS OFFICE.
14. SITE OBSERVATIONS BY THE LANDSCAPE ARCHITECT DURING ANY PHASE OF THIS PROJECT DOES NOT RELIEVE THE CONTRACTOR OF HIS PRIMARY RESPONSIBILITY TO PERFORM ALL WORK IN ACCORDANCE WITH THE PLANS, SPECIFICATIONS AND GOVERNING CODES.
15. CONTRACTOR SHALL BE BACKCHARGED FOR LANDSCAPE ARCHITECT'S TIME WHEN OBSERVATIONS ARE CALLED FOR AND IT IS FOUND THAT THE WORK IS NOT SIGNIFICANTLY READY UPON OBSERVATION OR THE APPOINTMENT IS NOT KEPT. TIME WILL BE CHARGED ON AN HOURLY BASIS, PLUS TRANSPORTATION, FOOD AND LODGING COSTS, IF ANY, AT THE THEN EXISTING HOURLY RATE FOR THE PERSONNEL PROVIDING THE OBSERVATIONS.
16. THIS FIRM DOES NOT PRACTICE OR CONSULT IN THE FIELD OF SAFETY ENGINEERING. THIS FIRM DOES NOT DIRECT THE CONTRACTOR'S OPERATIONS, AND IS NOT RESPONSIBLE FOR THE SAFETY OF PERSONNEL OTHER THAN OUR OWN ON THE SITE; THE SAFETY OF OTHERS IS THE RESPONSIBILITY OF THE CONTRACTOR. THE CONTRACTOR SHOULD NOTIFY THE OWNER IF HE CONSIDERS ANY OF THE RECOMMENDED ACTIONS PRESENTED HEREIN TO BE UNSAFE.

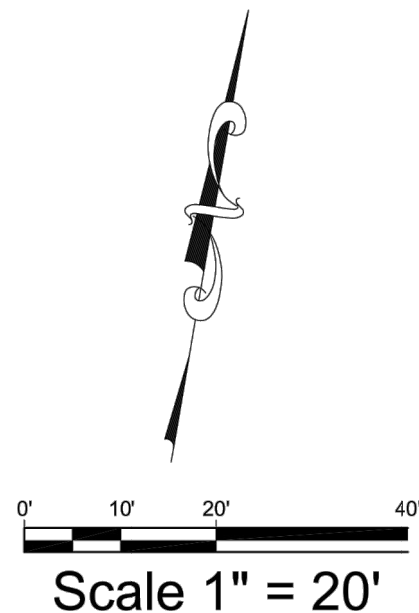

DESIGN: EMS  
DRAWN: EMS  
CHECKED: RM  
DATE: 7/12/2024

SHEET  
**AP-2**

CASE NO. 2022-185

AMENITY PLAN


NO.	DATE	REVISION	BY

**SANGER MULTI-FAMILY  
PREPARED FOR  
GREYSTAR  
SANGER, TEXAS**







PLOTTED BY: SHARON STACHECKI  
 PLOT DATE: 7/12/2024 2:26 PM  
 LOCATION: P:\SHARED\PROJECTS\2023\GREYSTAR MFR - SANGER TX\GREYSTAR MF SANGER TX 2024-07-12 AP.DWG  
 LAST SAVED: 7/12/2024 2:22 PM

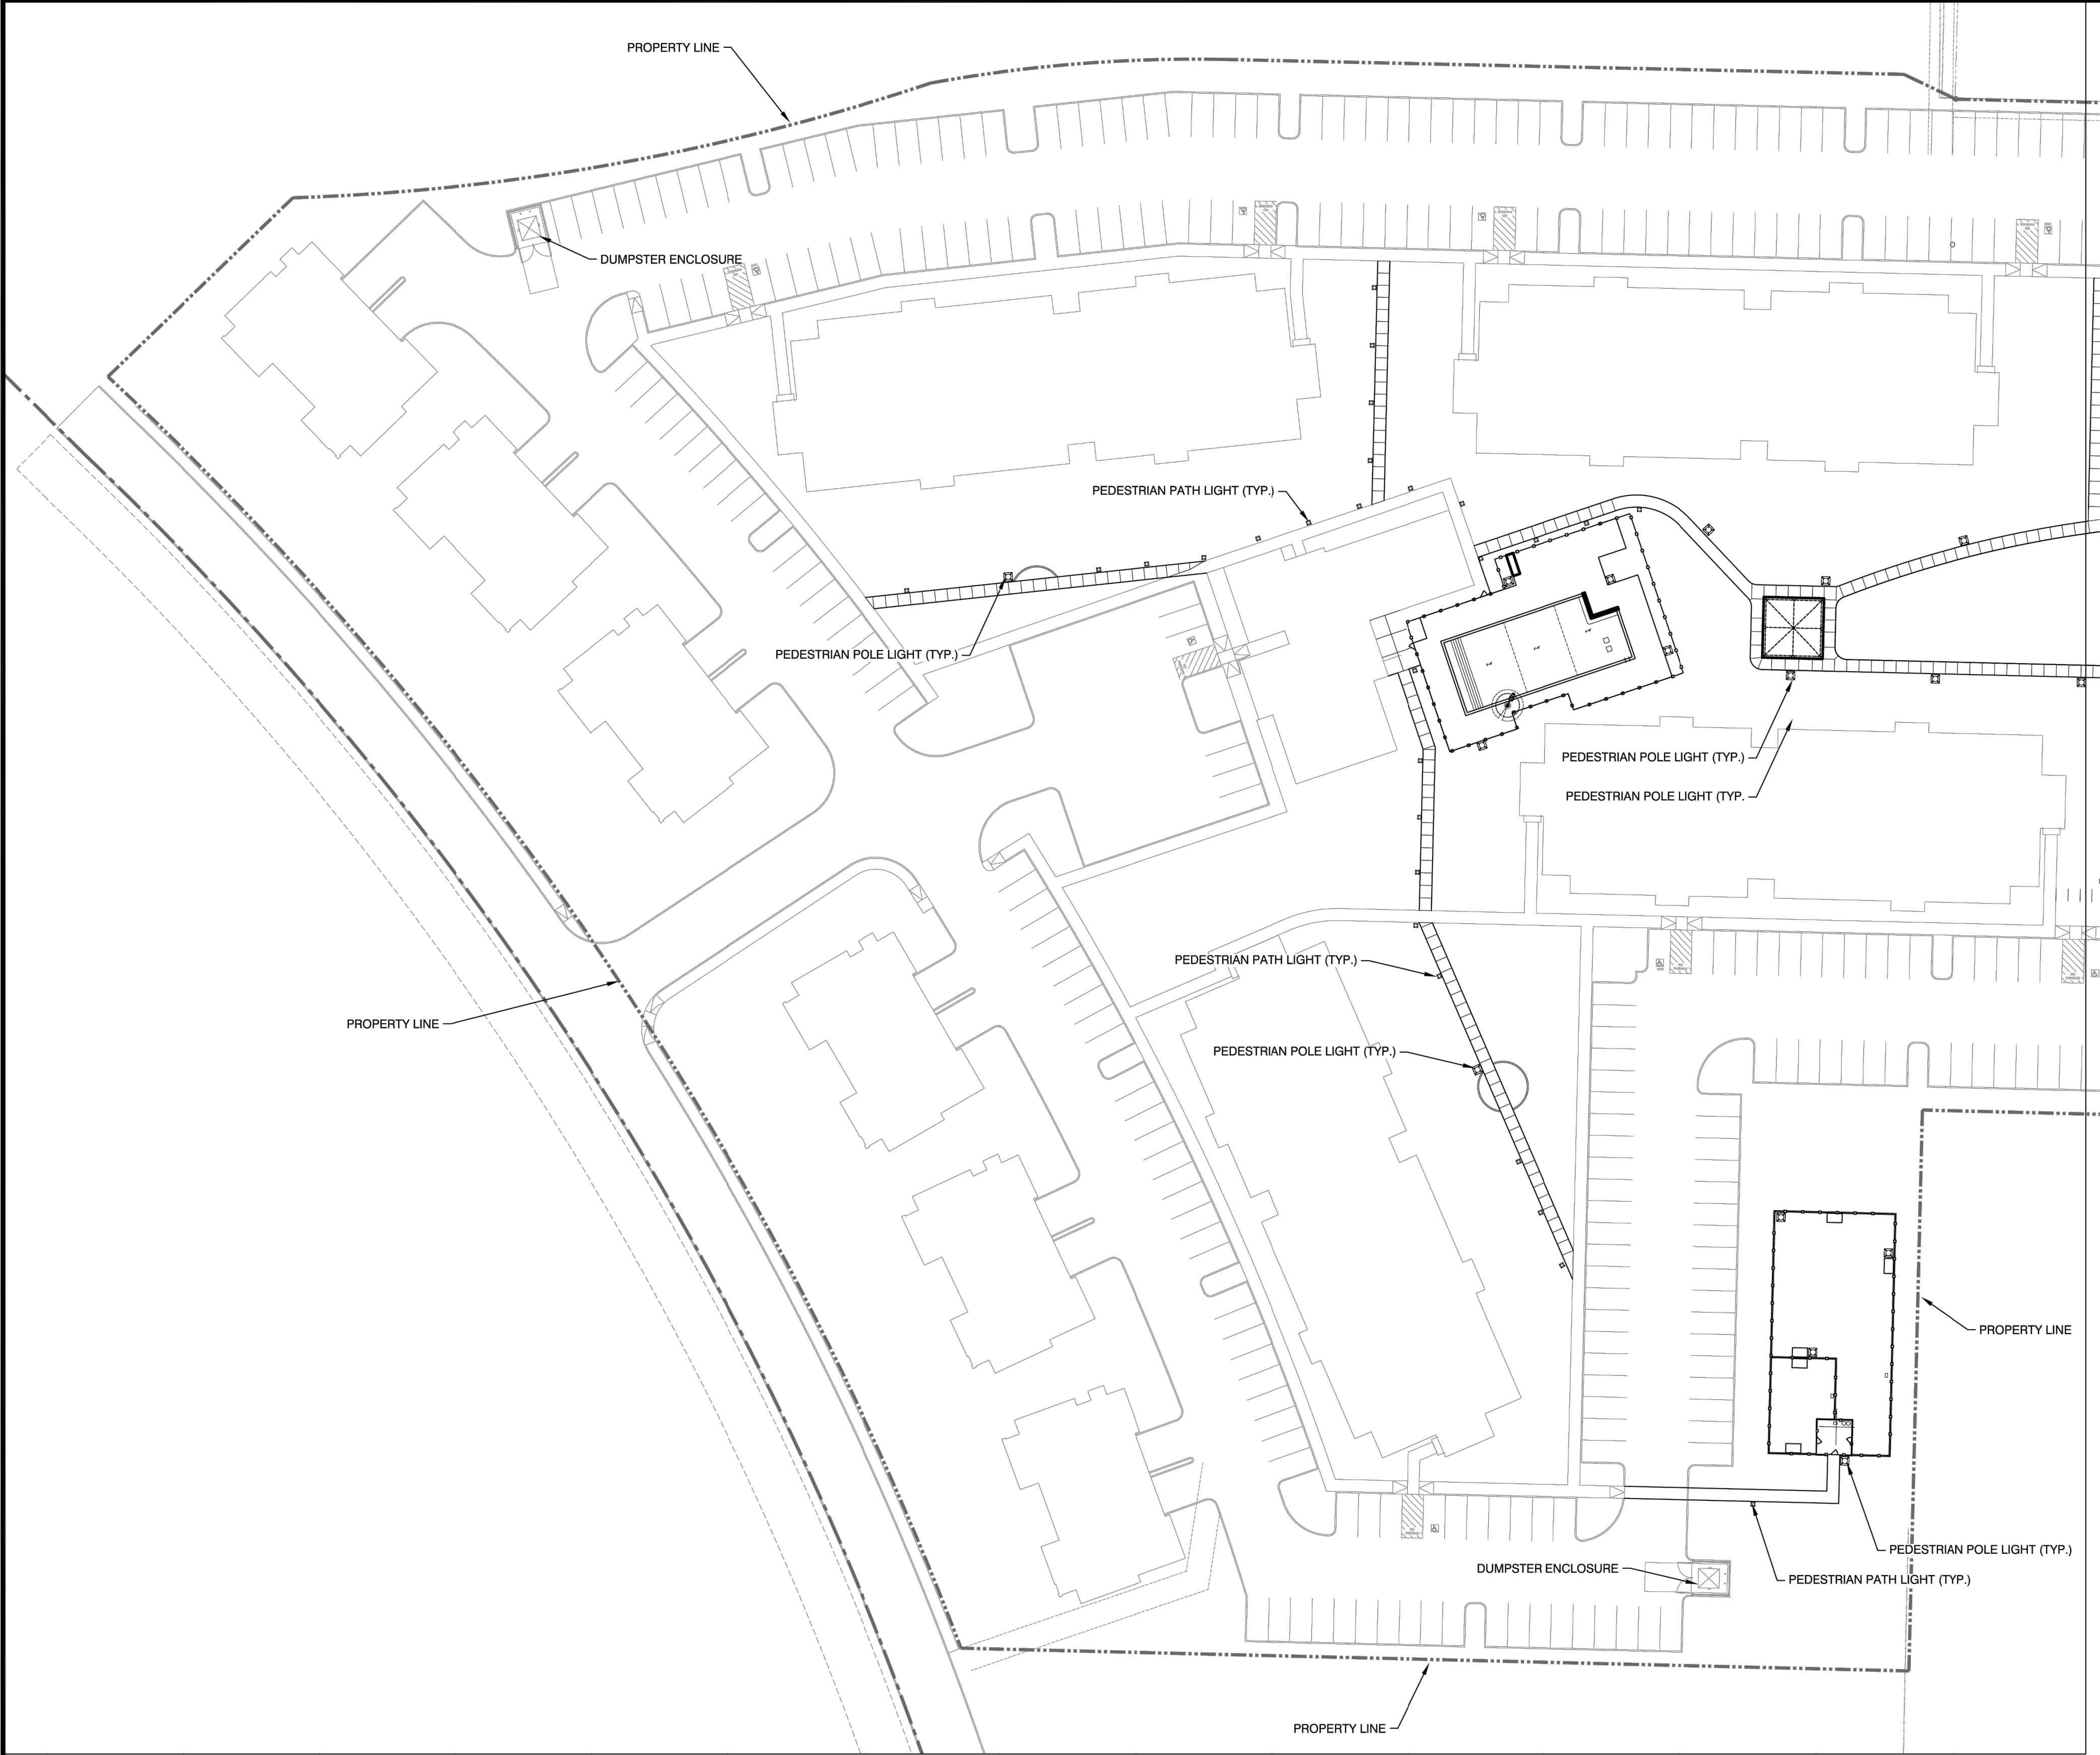

MATCHLINE - SEE SHEET L-2

CONCEPTUAL LIGHTING LEGEND

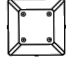DESCRIPTION	QTY
 PEDESTRIAN POLE LIGHT - ASHBERY POLE LIGHT AVAILABLE FROM LANDSCAPE FORMS, OR APPROVED EQUAL. 12' POLE HEIGHT, USE BOTH TYPE 3 AND TYPE 5 LIGHT DISTRIBUTION, COLOR TBS	28
 PEDESTRIAN PATH LIGHT - ASHBERY PATH LIGHT AVAILABLE FROM LANDSCAPE FORMS, OR APPROVED EQUAL. 3' POLE HEIGHT, USE TYPE 5 LIGHT DISTRIBUTION, COLOR TBS	41

CONCEPTUAL LIGHTING NOTES

1. LIGHTING PLAN IS FOR CONCEPTUAL USE ONLY. ALL LIGHTING PLACEMENT AND LIGHT LEVELS SHALL BE CONFIRM BY ELECTRICAL ENGINEER OR LIGHTING DESIGNER TO ENSURE COMPLIANCE WITH LIGHT REQUIREMENTS.
2. ALL WIRING, TRANSFORMERS, AND ELECTRICAL CONNECTIONS ARE BY OTHERS.
3. ALL LIGHTING SHALL BE DIRECTED AWAY FROM ADJACENT RESIDENTIAL BUILDINGS.
4. ALL LIGHTING SHALL BE LED LIGHTING WITH 3000K (WARM WHITE) BULBS
5. ALL LIGHTING SHALL BE UL LISTED AND INTERNATIONAL DARK-SKY APPROVED.


CONCEPTUAL LIGHTING IMAGES



PEDESTRIAN POLE LIGHT



PEDESTRIAN PATH LIGHT

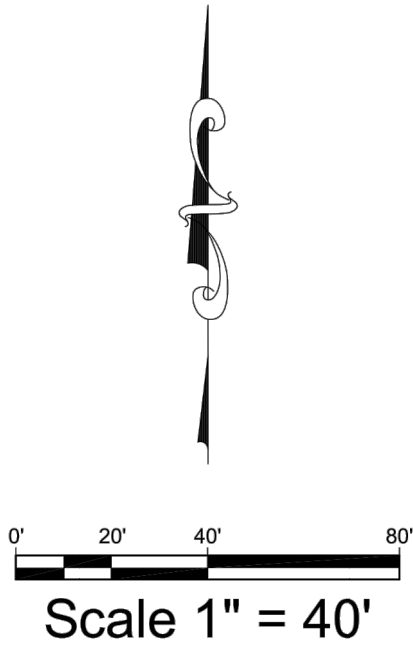



EVERGREEN  
DESIGN GROUP

(800) 680-6630  
15455 Dallas Pkwy., Ste 600  
Addison, TX 75001  
www.EvergreenDesignGroup.com

TEXAS REGISTRATION #141199

**CLAY MOORE**  
ENGINEERING

PHONE 817.281.0072  
WWW.CLAYMOOREENG.COM  
1903 CENTRAL DRIVE, SUITE #408  
BEDFORD, TX 76021

REGISTERED LANDSCAPE ARCHITECT

**SHARON M. STACHECKI**

1982

STATE OF TEXAS

07/12/2024

SANGER MULTI-FAMILY  
PREPARED FOR  
GREYSTAR  
SANGER, TEXAS

No.	DATE	REVISION	BY

CONCEPTUAL LIGHTING PLAN


DESIGN: EMS  
DRAWN: EMS  
CHECKED: RM  
DATE: 7/12/2024

SHEET  
**L-1**

CASE NO. 2022-185



PLOTTED BY: SHARON STACHECKI  
 PLOT DATE: 7/12/2024 2:27 PM  
 LOCATION: F:\SHARED\PROJECTS\2023\GREYSTAR MFR - SANGER TX\GREYSTAR MF SANGER TX 2024-07-12 AP.DWG  
 LAST SAVED: 7/12/2024 2:22 PM

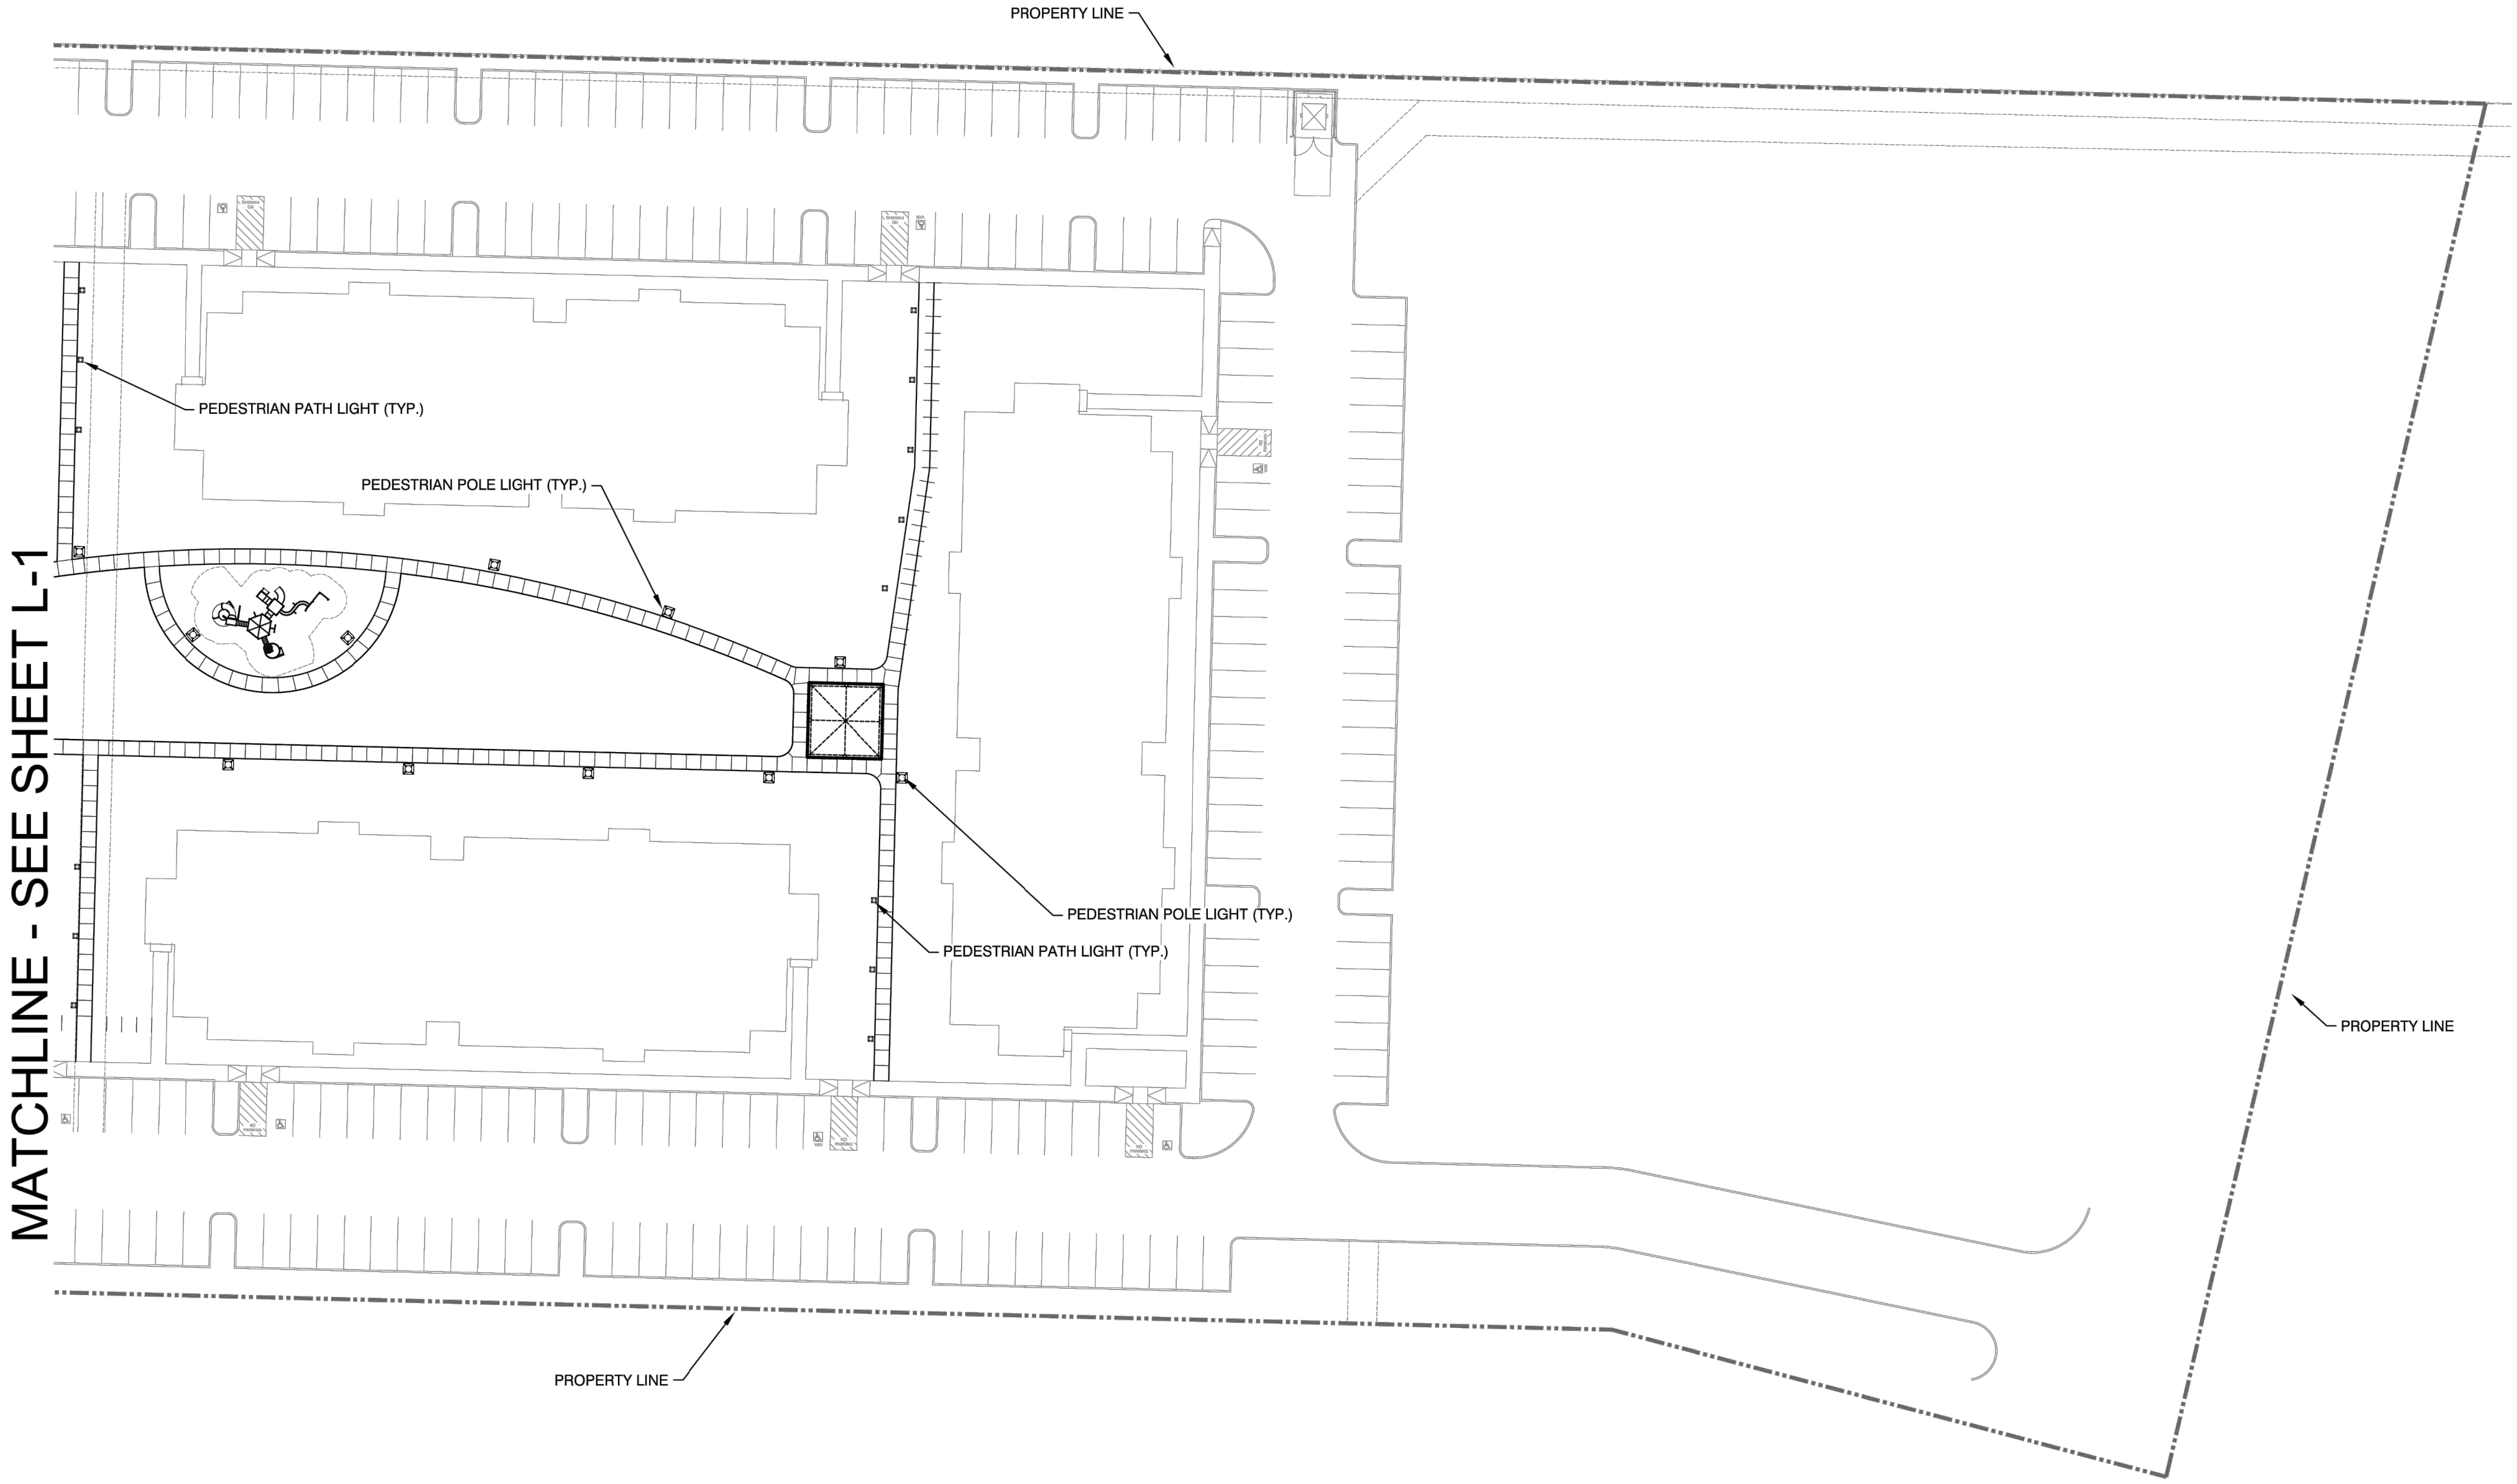

CONCEPTUAL LIGHTING LEGEND		
DESCRIPTION		QTY
PEDESTRIAN POLE LIGHT - ASHBERY POLE LIGHT AVAILABLE FROM LANDSCAPE FORMS, OR APPROVED EQUAL. 12' POLE HEIGHT, USE BOTH TYPE 3 AND TYPE 5 LIGHT DISTRIBUTION, COLOR TBS		28
PEDESTRIAN PATH LIGHT - ASHBERY PATH LIGHT AVAILABLE FROM LANDSCAPE FORMS, OR APPROVED EQUAL. 3' POLE HEIGHT, USE TYPE 5 LIGHT DISTRIBUTION, COLOR TBS		41

- CONCEPTUAL LIGHTING NOTES
- LIGHTING PLAN IS FOR CONCEPTUAL USE ONLY. ALL LIGHTING PLACEMENT AND LIGHT LEVELS SHALL BE CONFIRM BY ELECTRICAL ENGINEER OR LIGHTING DESIGNER TO ENSURE COMPLIANCE WITH LIGHT REQUIREMENTS.
  - ALL WIRING, TRANSFORMERS, AND ELECTRICAL CONNECTIONS ARE BY OTHERS.
  - ALL LIGHTING SHALL BE DIRECTED AWAY FROM ADJACENT RESIDENTIAL BUILDINGS.
  - ALL LIGHTING SHALL BE LED LIGHTING WITH 3000K (WARM WHITE) BULBS
  - ALL LIGHTING SHALL BE UL LISTED AND INTERNATIONAL DARK-SKY APPROVED.



Scale 1" = 40'

EVERGREEN  
DESIGN GROUP

(800) 680-6630  
15455 Dallas Pkwy., Ste 600  
Addison, TX 75001  
www.EvergreenDesignGroup.com

TEXAS REGISTRATION #141199

CLAY MOORE  
ENGINEERING

1903 CENTRAL DRIVE, SUITE #408  
BEDFORD, TX 76021

PHONE: 817.281.0072  
WWW.CLAYMOOREENG.COM

07/12/2024

SANGER MULTI-FAMILY  
PREPARED FOR  
GREYSTAR  
SANGER, TEXAS

No.	DATE	REVISION	BY

CONCEPTUAL LIGHTING PLAN

DESIGN: EMS  
 DRAWN: EMS  
 CHECKED: RM  
 DATE: 7/12/2024

SHEET  
**L-2**

CASE NO. 2022-185