



December 23, 2024
AVO 37449.004

Ms. Ramie Hammonds
Development Services Director/Building Official
City of Sanger
201 Bolivar Street
P.O. Box 1729
Sanger, Texas 76266

Re: **Blue Star Industrial Addition -Review #1**

Dear Ms. Hammonds,

Halff Associates, Inc. was requested by the City of Sanger to review the Final Plat and Civil Plans for Blue Star Industrial Addition Phase 2. The submittal was prepared by Animas Civil Engineering and was received December 10, 2024.

We have completed our review and offer the following comments:

Please address comments on attached markups and provide annotated responses on markups. Please note, not all comments are written on letter since some comments are easier to show and explain on the markups. Please annotate markup with responses.

Final Plat

1. This final plat is not in accordance with the preliminary plat, but generally, the drainage plan does conform to the accepted drainage study.
2. Callout/show drainage easement for proposed SD lines. drainage infrastructure cannot be lumped into a general utility easement
3. The name, address and phone number of all utilities providing service to the development is required. A signature from each provider or a will-serve letter, signifying their ability to provide service to the subdivision is required.
4. Include certificate for designated city official signatures on all final plats

Civil Plan Comments

Cover Sheet Comments

1. The final plat is not in accordance with the preliminary plat, but generally, the drainage plan does conform to the accepted drainage study.
2. Confirm detention facility is online and functioning as intended, else provide an interim drainage plan/study.
3. See comment on page number on the sheet, see markup.



Paving Plan and Dimension Control Comments

1. All steel reinforcing shall be deformed No. 4 bars on eighteen-inch (18") centers both ways per Ordinance § 10.106(b)(2)(B)(ii)
2. Collector streets and alleys shall, at a minimum, be designed and constructed with eight-inch (8") thickness of four thousand (4,000) p.s.i. reinforced concrete pavement on a compacted sub-base. All steel reinforcing shall be deformed No. 4 bars on eighteen-inch (18") centers both ways per Ordinance § 10.106(b)(2)(B)(ii)
3. Where the plasticity index of the soil is twelve (12) or greater, stabilization of the subbase with an eight-inch (8") thickness of six percent (6%) hydrated lime by weight will be required per Ordinance § 10.106(b)(2)(B)(iii)
4. Per Denton County Fire Code, fire lanes shall have a minimum interior turning radius of thirty (30) feet and exterior turning radius of fifty (50) feet. Please review and revise all turning radii to meet minimums
5. Driveway returns onto commercial and industrial property shall be a minimum of fifteen feet (15') and a maximum of twenty-five feet (25') except in special cases per § 10.106(b)(3)(C)(ii)

Grading Plan Comments

1. Is there an agreement for the offsite grading?
2. A previous plan review associated with the pond and Lot 2 called for rip rap at the confluence of these channels. Confirm rip rap has been installed and/or provide additional rip rap as needed for this project if existing rip rap is not adequate. ~100 cfs at 6fps or greater is expected to discharge here, please protect
3. Provide offsite flow arrows

Drainage Area Map Comments

1. Please provide 5, 10, 25, and 100 yr calcs
2. Intensity from 2020 iSWM hydrology manual? please note source. to be consistent with accepted drainage study, recommend using intensity data in from accepted study (2014 iSWM hydrology manual).
3. See comments related to surcharge for circled inlets (see markups)
4. There appear to be two sheets labelled C-6.01, the DAM should be C-4.01
5. The areas around Drainage areas A2 and A3 appears to be flowing offsite, please verify and revise drainage areas according

Storm Drain Plan Comments

1. Water out of the inlet per calcs. Confirm this surcharge does not overflow to adjacent lot. Else revise SD to remove surcharge. See markups.
2. Is the GV included in any lowering?



3. Recommend adding a junction/manhole for access at least every 500'
4. Show min 10' DE on all proposed SD and show on plat.
5. Minimum pipe size for 10-foot curb inlets is 21" per § 10.106(d)(5)(C). Please upsize laterals to 21"
6. For areas outside the platted boundary a DE by separate instrument must be recorded. DE should include any energy dissipation (rip rap) and extend min 25' beyond the rip rap.

Storm Drain Plan and Profile Comments

1. Show headwall and energy dissipation (rip rap)
2. Provide rip rap calcs to support apron length, width, and thickness
3. Note the source of the staging water surface elevation
4. Label separation distances between SD and SS/W - all crossings
5. Water out of the inlet? Confirm this surcharge does not overflow to adjacent lot. See markups.
6. The hydraulic grade line shall in no case be closer to the surface of the ground or street than one (1) foot per § 10.106(d)(6)(D)(ii). Please review and revise.
7. HGL for SD Lat B-4 not consistent with calcs. please review/revise. See markups.

Hydraulic Calculations Comments

1. The minimum velocities in conduit shall be 2.5 feet per second per § 10.106(d)(6)(B)(i)
2. The maximum velocity in the pipe shall not exceed 12 feet per second per § 10.106(d)(6)(B)(ii)

Utility Plan Comments

1. The manholes shall be placed at points of change in alignment, grade, size of sewer, the intersection of sewers; at the right-of-way lines of major and secondary thoroughfares, whether existing or proposed, and the end of all sanitary sewer mains subject to extension per § 10.106(f)(1)(A)(iii)
2. Ensure all TCEQ crossing requirements are met

Erosion Control Comments

1. Please add SF at the toe of all graded slopes to reduce sediment. See markups.
2. Please show or ensure SF is added behind the curb once curb is installed to minimize sediment on the street. See markups.
3. Consider installing a rock filter dam at the outflow for erosion control

Paving Details

1. Please provide pavement repair details



Drainage Details

1. Please provide bedding detail for SD.

Utility Details

1. Please provide water line embedment detail

Landscape Comments

1. Please show that minimum landscaping requirements for non-residential uses per ordinance § 14A-48.5.2 I-1 and I-2 Industrial Districts have been met. Include narrative per ordinance on the plans to verify requirements have been met.

If you have any questions or need additional information, please do not hesitate to call me at (817) 764-7498.

Sincerely,


A handwritten signature in blue ink, appearing to read "Samson Lotigo", with a stylized flourish at the end.

Samson Lotigo, PE

HALFF ASSOCIATES, INC.

Firm No. 0312

Attachments: Plans markups

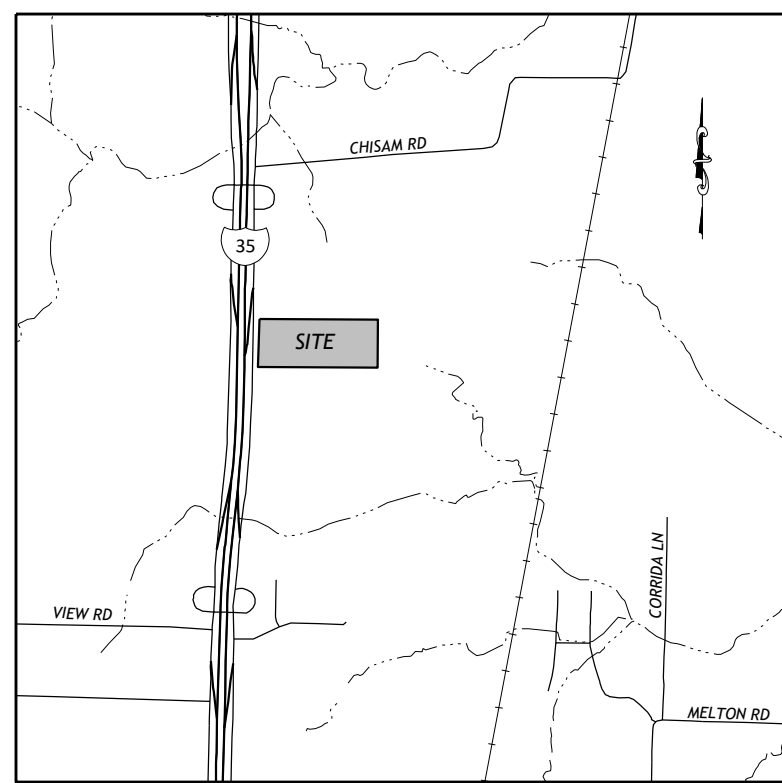


* VICINITY MAP * (NOT TO SCALE)

- * LEGEND ***
- CIRF IRON ROD FOUND WITH CAP
 - CIRS 5/8" IRON ROD WITH CAP STAMPED "SPOONER 5922" SET
 - MON. MONUMENT
 - INS. NO. INSTRUMENT NUMBER
 - O.P.R.D.C.T. OFFICIAL PUBLIC RECORDS, DENTON COUNTY, TEXAS
 - EX. EXISTING
 - P.F.C. POINT FOR CORNER
 - SSMH SANITARY SEWER MANHOLE

E1 EX. WATER ESMT. INS. NO. 2022-122553, O.P.R.D.C.T.

E2 EX. DRAINAGE ESMT. INS. NO. 2022-122553, O.P.R.D.C.T.

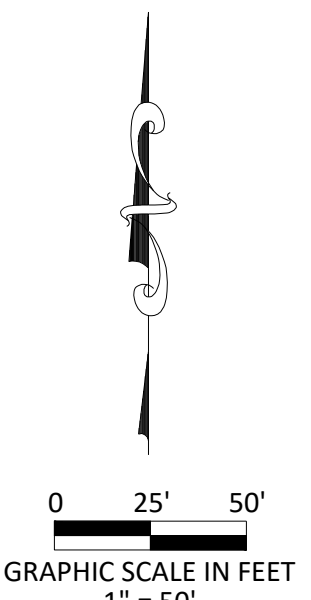

INTERSTATE HIGHWAY 35 (VARIABLE WIDTH PUBLIC R.O.W.)

CALLED 3.6610 ACRES STATE OF TEXAS INS. NO. 2020-141152, O.P.R.D.C.T.

CALLED 1.6470 ACRES STATE OF TEXAS INS. NO. 2022-170941, O.P.R.D.C.T.

POINT OF BEGINNING "X" CUT FOUND N: 7,199,172.14 E: 2,372,793.16 (NAD83+GRID)

*** OWNER'S CERTIFICATION ***

STATE OF TEXAS § COUNTY OF DENTON §

WHEREAS SANGER TEXAS INDUSTRIAL, LLC, is the sole owners of a 14.2225 acre tract of land located in the Jose Maria Ruiz Survey, Abstract No. 1066, City of Sanger, Denton County, Texas, said 14.2225 acre tract of land being a portion of a called 211.36 acre tract of land conveyed to SANGER TEXAS INDUSTRIAL, LLC, by deed thereof filed for record in Denton County Clerk's Instrument Number (D.C.C.I.No.) 2022-122553, Official Public Records, Denton County, Texas (O.P.R.D.C.T.), said 14.2225 acre tract of land being more particularly described by metes and bounds as follows:

BEGINNING at an X-cut in concrete found at the northwest lot corner of Lot 2, Block A, Blue Star Industrial Addition, being an addition to the said City and State, according to the plat thereof filed for record in D.C.C.I. No. 20220525000223, O.P.R.D.C.T., said beginning point being on the common property line of the said 211.36 acre tract and a called 3.6610 acre tract of land conveyed to the State of Texas, by deed thereof filed for record in D.C.C.I. No. 2020-141152, O.P.R.D.C.T., said common property line being the east right-of-way line of Interstate Highway 35 (a variable width public right-of-way with state controlled access), said beginning point also being at the beginning of a curve to the left having a radius of 16,615.00 feet;

THENCE along the west property line of the said 211.36 acre tract, along the said east right-of-way line of Interstate Highway 35, and along said curve to the left, an arc length of 500.15 feet, and across a chord which bears North 01°41'55" East, a chord length of 500.13 feet to a 5/8-inch iron rod with a cap stamped "SPOONER 5922" set (hereinafter referred to as an iron rod set), from which a 5/8 inch iron rod with a 2-inch pink plastic cap stamped "TEXAS DEPARTMENT OF TRANSPORTATION" found at the north property corner of the said 3.6610 acre tract, same being a northwest property corner of the said 211.36 acre tract, bears North 00°45'55" West, a distance of 994.78 feet;

THENCE over and across the said 211.36 acre tract the following courses and distances:

- South 89°37'16" East, a distance of 1,234.56 feet to an iron rod set;
- South 00°22'44" West, a distance of 500.00 feet to a point for corner on an existing sanitary sewer manhole lid found at the northeast lot corner of said Lot 2;

THENCE North 89°37'16" West, along the north lot line of said Lot 2, a distance of 1,246.08 feet to the POINT OF BEGINNING, containing 14.2225 acres (619,533 square feet) of land more or less.

1. This final plat is not in accordance with the preliminary plat, but generally, the drainage plan does conform to the accepted drainage study.

2. callout/show private drainage easements for proposed SD lines. drainage infrastructure cannot be lumped into a general utility easement.

1. The name, address and phone number of all utilities providing service to the development is required. A signature from each provider or a will-serve letter, signifying their ability to provide service to the subdivision is required.

2. Include certificate for designated city official signatures on all final plats

REMAINDER OF CALLED 211.36 ACRES SANGER TEXAS INDUSTRIAL, LLC INS. NO. 2022-122553, O.P.R.D.C.T.

LOT 5, BLOCK A 14.2225 ACRES (619,533 SQ. FT.)

PORTION OF CALLED 211.36 ACRES SANGER TEXAS INDUSTRIAL, LLC INS. NO. 2022-122553, O.P.R.D.C.T.

LOT 2, BLOCK A BLUE STAR INDUSTRIAL ADDITION INS. NO. 20220525000223, O.P.R.D.C.T.

REMAINDER OF CALLED 211.36 ACRES SANGER TEXAS INDUSTRIAL, LLC INS. NO. 2022-122553, O.P.R.D.C.T.

Show water and drainage easement

*** GENERAL NOTES ***

- The bearings shown hereon are referenced to the Texas Coordinate System of 1983, Texas North Central Zone 4202, and are based on the North American Datum of 1983, 2011 Adjustment. All areas shown hereon are calculated based on surface measurements.
- This survey was prepared without the benefit of a Title Commitment prepared by a title company. The easements shown hereon are the only easements known by Spooner & Associates and does not imply that any other easements, covenants, restrictions, or other matters of record do not affect the subject property. No other research was performed by Spooner & Associates, Inc.
- According to the Flood Insurance Rate Map published by the Federal Emergency Management Agency, Department of Homeland Security and by graphic plotting only, the subject property appears to be located in Zone "X" (areas determined to be outside the 0.2 % annual chance floodplain) as shown on Map No. 48121C0070G; map revised April 18, 2011, for Denton County and incorporated areas.
- All lots comply with the minimum size requirements of the zoning district.
- This property may be subject to change related to impact fees and the applicant should contact the City regarding any applicable fees due.
- All common areas, drainage easements, and detention facilities will be owned and maintained by the HOA/POA. Any common area within the City's right-of-way will require a facilities agreement, to be reviewed and approved by the City.
- Notice-selling a portion of this addition by metes and bounds is a violation of City Ordinance and State Law and is subject to fines and withholding of utilities and building permits.
- This plat does not alter or remove existing deed restrictions, if any, on this property.
- The purpose of this plat is to establish a new lot and easements for the development of the property.

OWNER: SANGER TEXAS INDUSTRIAL, LLC
C/O BLUE STAR LAND LP
1 COWBOYS WAY
FRISCO, TEXAS 75034

ENGINEER: ANIMAS CIVIL ENGINEERING
P.O. BOX 828974
RICHARDSON, TX 75083
(214) 803-1099
ATTN: MICHAEL DOGGETT, P.E.

SURVEYOR: SPOONER AND ASSOCIATES, INC.
309 BYERS STREET, #100
EULESS, TEXAS 76039
(817) 685-8448
ATTN: ERIC SPOONER, RPLS

Approved for Preparation of Final Plat

City of Sanger, TX Planning and Zoning Date

CITY OF SANGER PROJECT NO. _____ FINAL PLAT

LOT 5, BLOCK A BLUE STAR INDUSTRIAL ADDITION

BEING A PLAT OF A 14.2225 ACRE TRACT OF LAND LOCATED IN THE JOSE MARIA RUIZ SURVEY, ABSTRACT NO. 1066, CITY OF SANGER, DENTON COUNTY, TEXAS, SAID 14.2225 ACRE TRACT BEING A PORTION OF A CALLED 211.36 ACRE TRACT OF LAND CONVEYED TO SANGER TEXAS INDUSTRIAL, LLC, BY DEED THEREOF FILED FOR RECORD IN DENTON COUNTY CLERK'S INSTRUMENT NO. 2022-122553, O.P.R.D.C.T.

1 INDUSTRIAL LOT 14.2225 ACRES ~ ZONED I-1 December 2024

THIS DOCUMENT IS PRELIMINARY FOR REVIEW PURPOSES ONLY ERIC S. SPOONER, R.P.L.S. December 15, 2022

STATE OF TEXAS §

COUNTY OF TARRANT §

THAT, I, Eric S. Spooner, a Registered Professional Land Surveyor, in the State of Texas, do hereby certify that this plat is true and correct and was prepared from an actual survey of the property made on the ground under my supervision.

Surveyed on the ground during the month of October, 2024.

Eric S. Spooner, R.P.L.S. Date Texas Registration No. 5922


STATE OF TEXAS §

COUNTY OF TARRANT §

BEFORE ME, the undersigned, a Notary Public in and for the said County and State, on this day personally appeared ERIC S. SPOONER, known to me to be the person whose name is subscribed to the foregoing instrument and acknowledged to me that he/she executed the same for the purpose and consideration therein expressed, and in the capacity therein stated.

GIVEN UNDER MY HAND AND SEAL OF OFFICE, on this the ___ day of ___, 2024.

Notary Public, State of Texas

 


CONSTRUCTION PLANS FOR BLUE STAR INDUSTRIAL BLDG. L LOT 5R, BLOCK A, BLUE STAR ADDITION

INTERSTATE HIGHWAY 35
THE TOWN OF SANGER
DENTON COUNTY, TEXAS

Stormwater Comments
12/20/2024
Erin Storey
estorey@halff.com

1. The final plat is not in accordance with the preliminary plat, but generally, the drainage plan does conform to the accepted drainage study.
2. confirm detention facility is online and functioning as intended, else provide an interim drainage plan/study

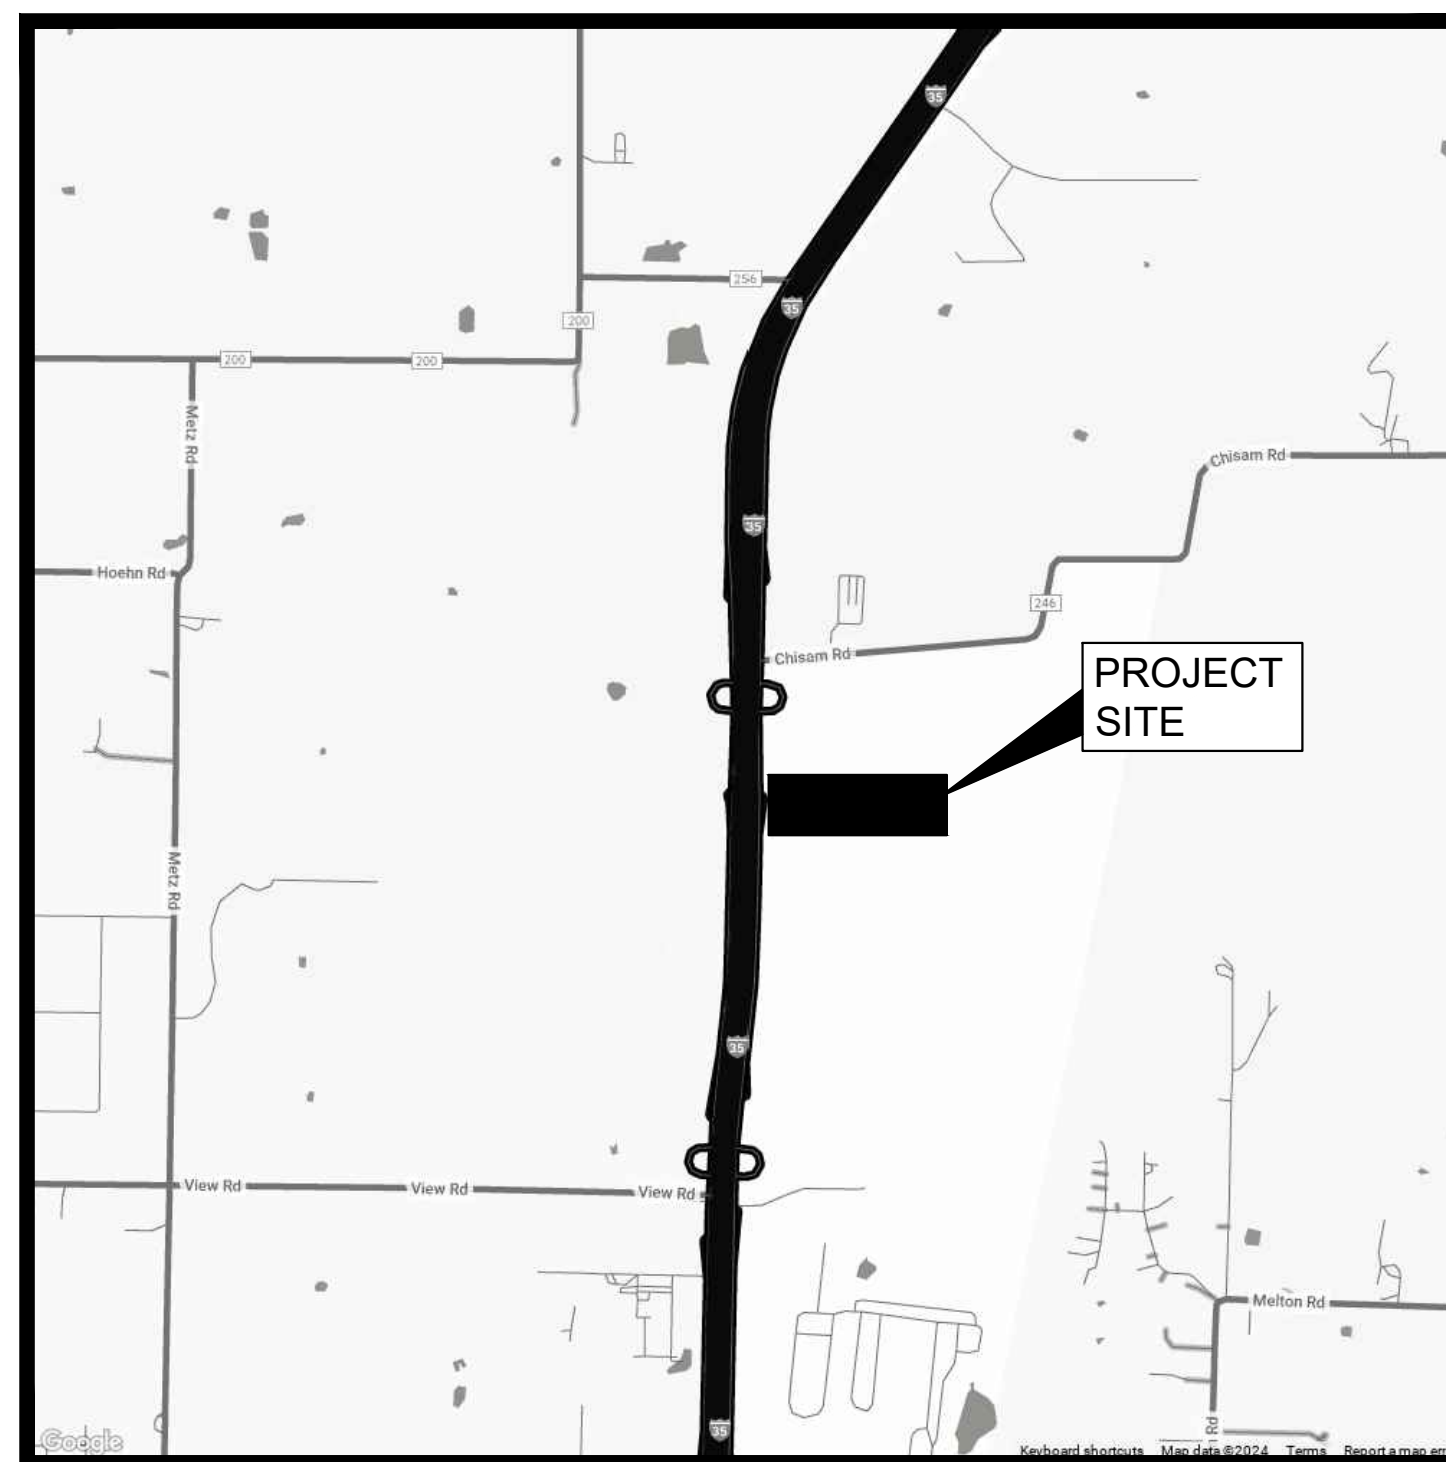

VICINITY MAP
N.T.S.


see comment on page number on the sheet

Sheet List Table	
Sheet Number	Sheet Title
C-1.00	COVER SHEET
C-1.01	KEYMAP
C-1.02	FINAL PLAT
C-2.01	PAVING AND DIMENSION CONTROL PLAN
C-2.02	PAVING AND DIMENSION CONTROL PLAN
C-3.01	GRADING PLAN
C-3.02	GRADING PLAN
C-4.01	DRAINAGE AREA MAP
C-5.01	STORM PLAN
C-5.02	STORM PLAN
C-5.03	STORM PROFILES
C-5.04	STORM PROFILES
C-5.05	STORM PROFILES
C-5.06	DRAINAGE CALCULATIONS
C-6.01	UTILITY PLAN
C-6.02	UTILITY PLAN
C-7.01	EROSION CONTROL PLAN
C-8.01	EROSION CONTROL DETAILS
C-8.02	PAVING DETAILS
C-8.03	DRAINAGE DETAILS
C-8.04	DRAINAGE DETAILS
C-8.05	UTILITY DETAILS
C-8.06	UTILITY DETAILS
L-1	LANDSCAPE PLAN
L-2	LANDSCAPE PLAN
L-3	LANDSCAPE PLAN
L-4	PLANTING DETAILS
L-5	PLANTING SPECS
L-6	TURF SPECS

ARCHITECT:
COLT MALLOY, ASSOC. AIA,
PROJECT MANAGER
CORE ARCHITECTS
(479) 903-7417
CDMALLOY@CORE-ARCH.COM

DEVELOPER:
JOE HICKMAN
SANGER TEXAS INDUSTRIAL, LLC
c/o BLUE STAR LAND, LP
1 COWBOYS WAY
FRISCO, TX 75034
(214) 437-3651
JOEHICKMAN@DALLASCOWBOYS.NET

ENGINEER:
ANIMAS CIVIL ENGINEERING, LLC.
MICHAEL DOGGETT, P.E.
P.O. BOX 830974
RICHARDSON, TEXAS 75083
(214) 803-1099
Michael@AnimasCivil.com

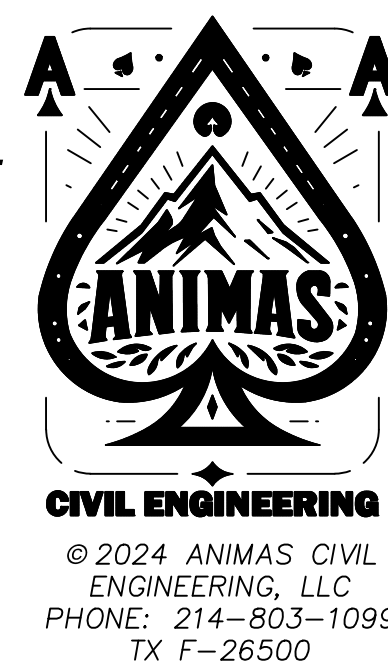


DECEMBER 2024

NO.	REVISIONS	DATE	BY
© 2024 ANIMAS CIVIL ENGINEERING, LLC PHONE: 214-803-1099 TX F-26500			
PROJECT NAME: BLUE STAR INDUSTRIAL BLDG. L SANGER, TEXAS			
SHEET TITLE: COVER SHEET			
ACE PROJECT: 01101			
DATE DECEMBER 2024			
SCALE AS SHOWN			
DRAWN BY: MD			
SHEET NUMBER C-1.00			


C:\Users\mdoggett\OneDrive\Documents\Projects\0101-Blue Star Industrial Sanger\CAD\Plan Sheets\Cover Sheet.dwg

Saturday, December 7, 2024 2:47:53 PM

INTERSTATE HIGHWAY 35
(VARIABLE WIDTH PUBLIC R.O.W.)

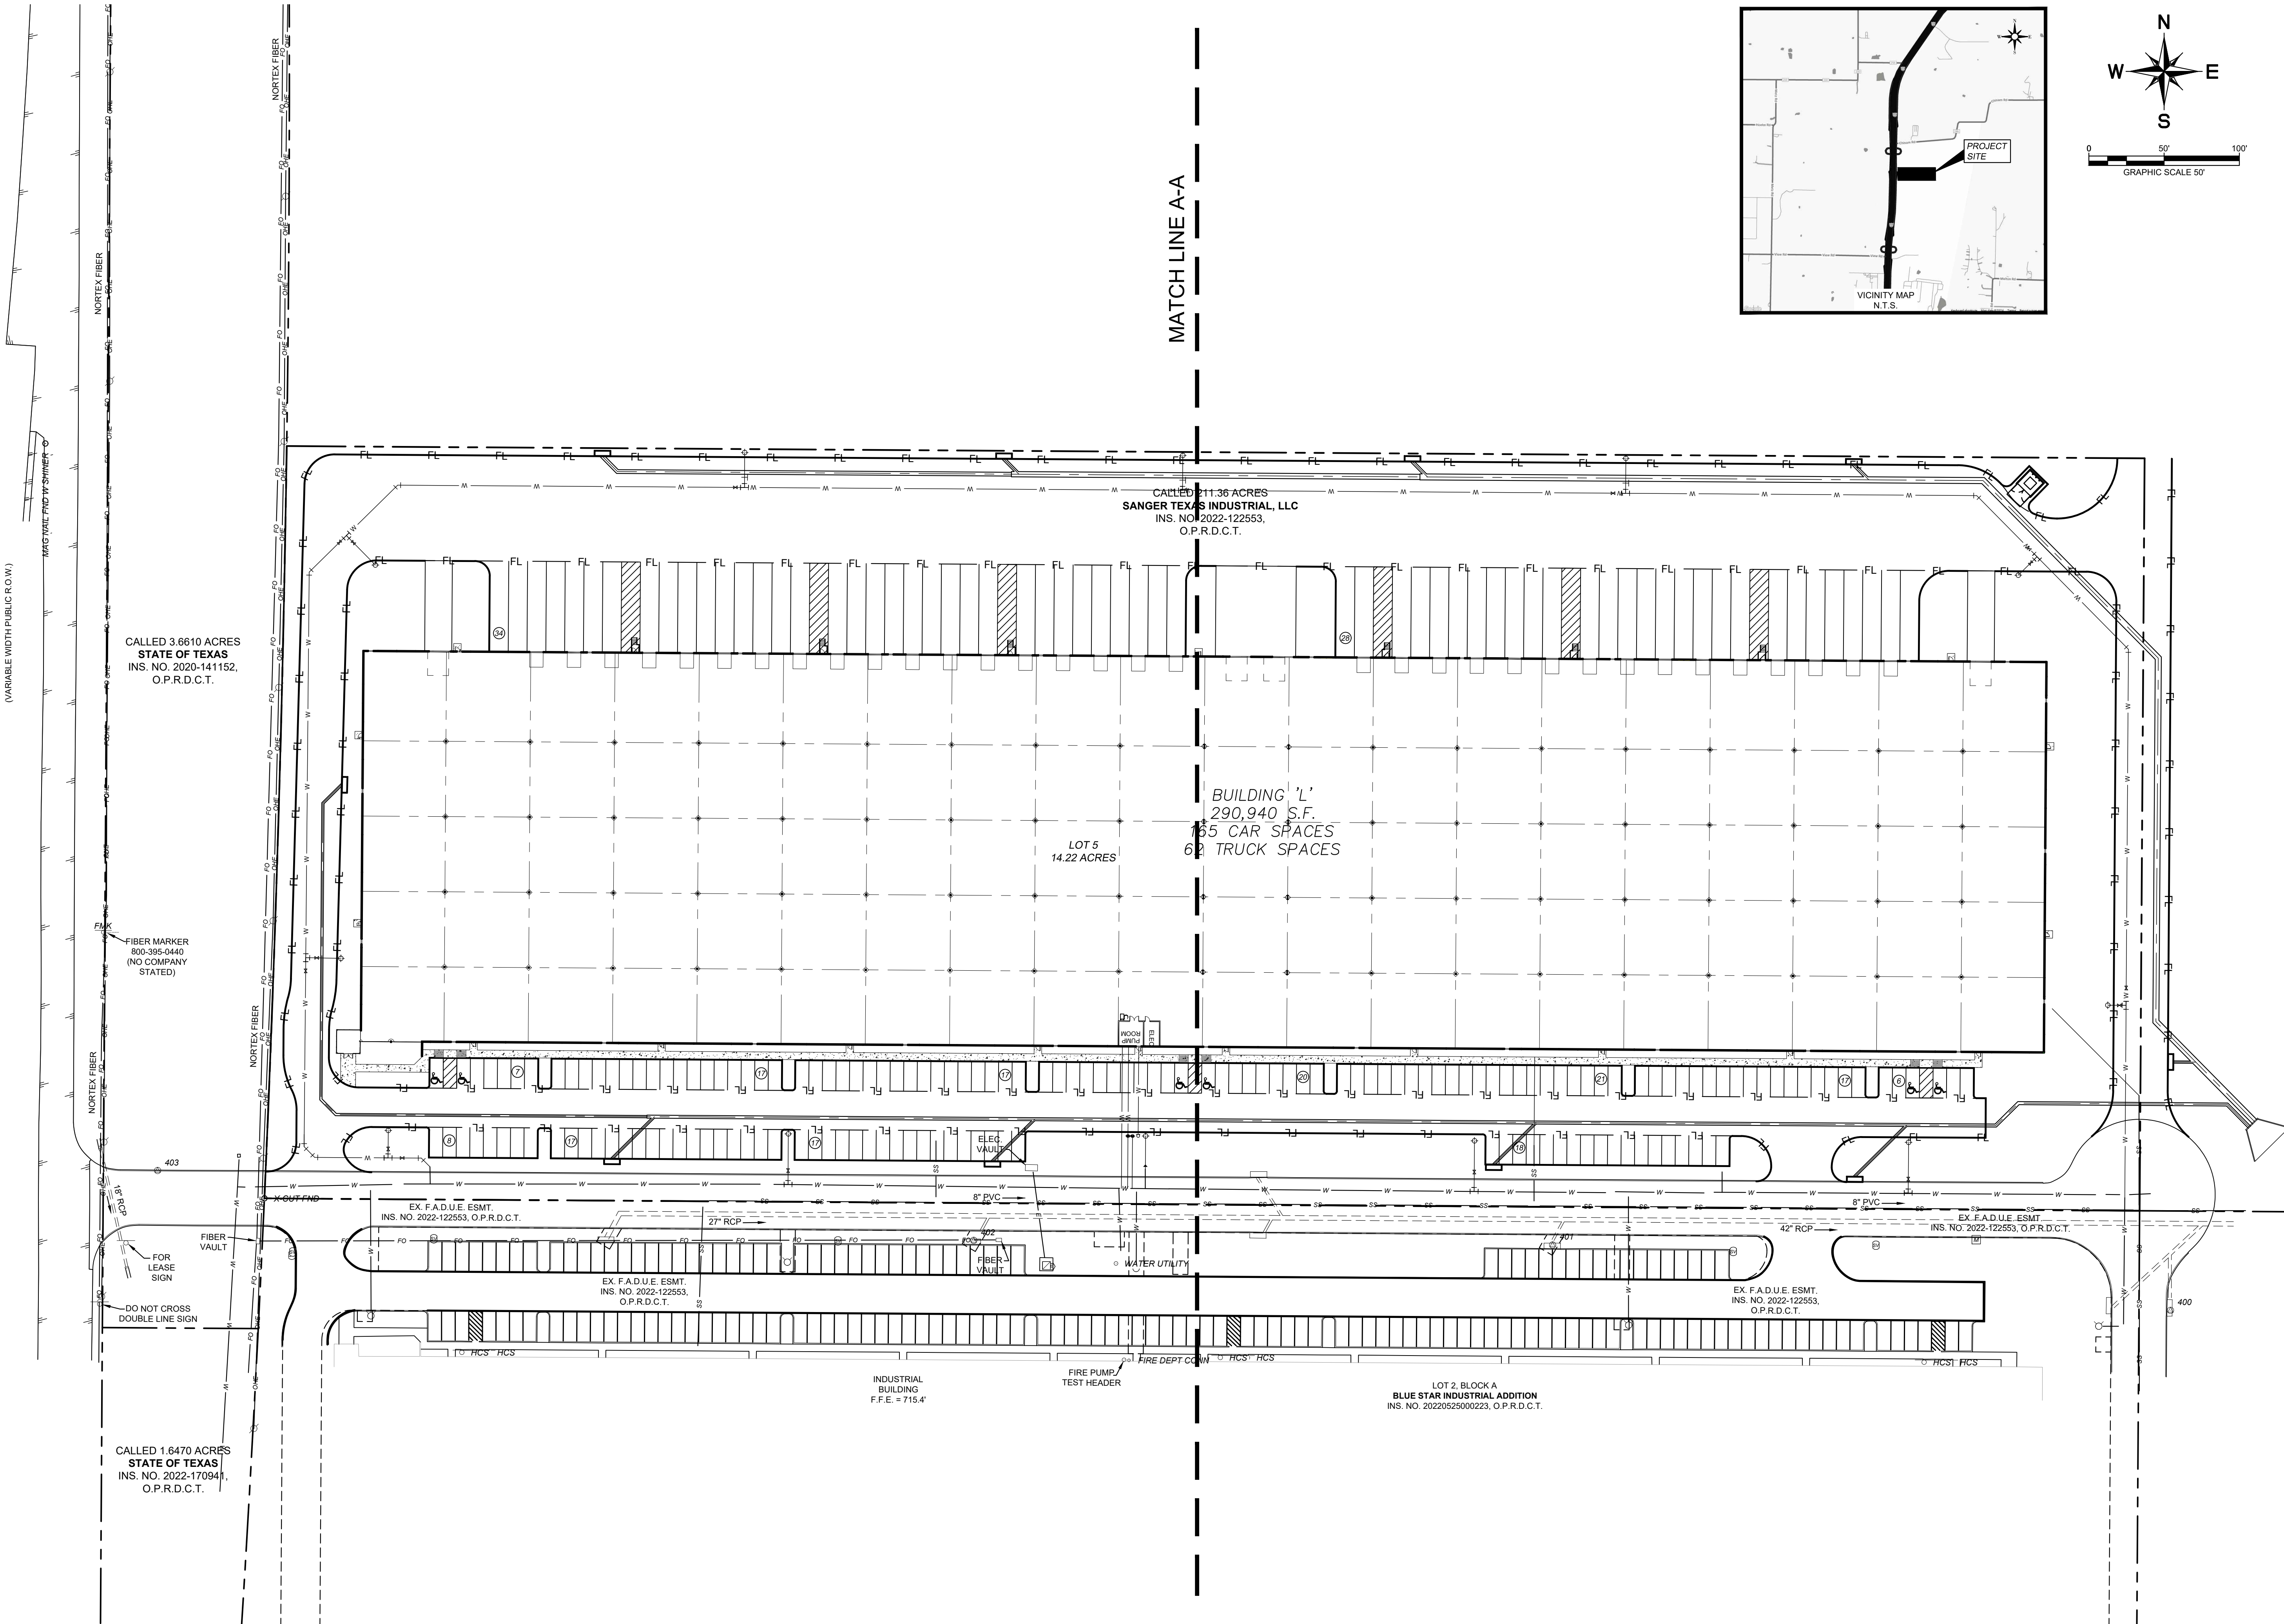

NO.	REVISIONS	DATE	BY
© 2024 ANIMAS CIVIL ENGINEERING, LLC PHONE: 214-803-1099 TX F-26500			
PROJECT NAME: BLUE STAR INDUSTRIAL BLDG. L SANGER, TEXAS			
SHEET TITLE: KEYMAP			
ACE PROJECT: 01101			
DATE DECEMBER 2024			
SCALE AS SHOWN			
DRAWN BY: MD			
SHEET NUMBER C-1.01			

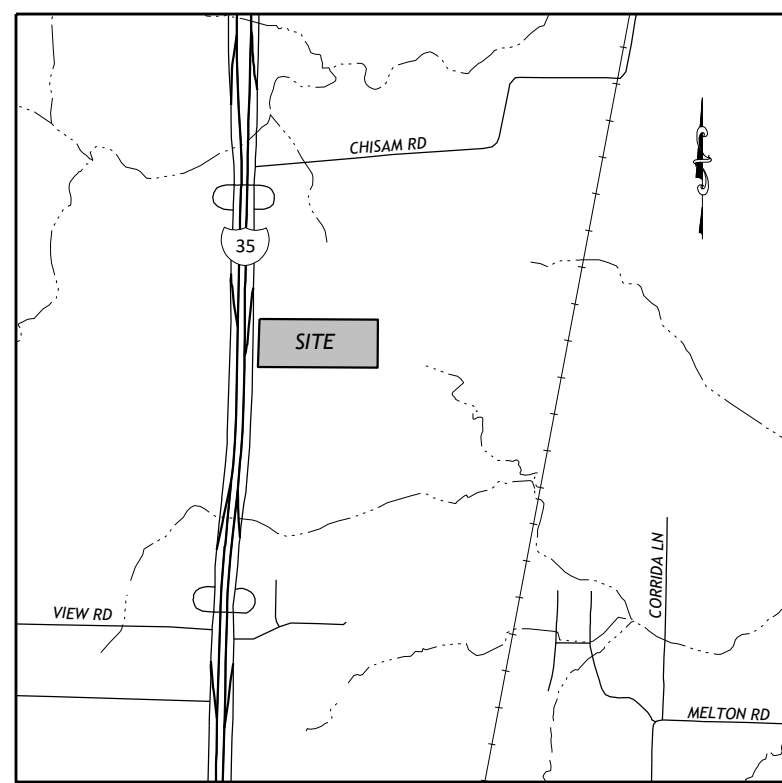


* VICINITY MAP * (NOT TO SCALE)

- * LEGEND ***
- CIRF IRON ROD FOUND WITH CAP
 - CIRS 5/8" IRON ROD WITH CAP STAMPED "SPOONER 5922" SET
 - MON. MONUMENT
 - INS. NO. INSTRUMENT NUMBER
 - O.P.R.D.C.T. OFFICIAL PUBLIC RECORDS, DENTON COUNTY, TEXAS
 - EX. EXISTING
 - P.F.C. POINT FOR CORNER
 - SSMH SANITARY SEWER MANHOLE

E1
EX. WATER ESMT.
INS. NO. 2022-122553,
O.P.R.D.C.T.

E2
EX. DRAINAGE ESMT.
INS. NO. 2022-122553,
O.P.R.D.C.T.

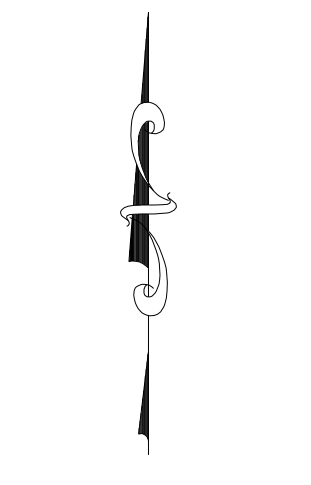

0 25' 50'
GRAPHIC SCALE IN FEET
1" = 50'

INTERSTATE HIGHWAY 35
(VARIABLE WIDTH PUBLIC R.O.W.)

CALLED 3.6610 ACRES
STATE OF TEXAS
INS. NO. 2020-141152,
O.P.R.D.C.T.

POINT OF BEGINNING
"X" CUT FOUND
N: 7,199,172.14
E: 2,372,793.16
(NAD83-GRID)

CALLED 1.6470 ACRES
STATE OF TEXAS
INS. NO. 2022-170941,
O.P.R.D.C.T.

*** OWNER'S CERTIFICATION ***

STATE OF TEXAS §
COUNTY OF DENTON §

WHEREAS SANGER TEXAS INDUSTRIAL, LLC, is the sole owners of a 14.2225 acre tract of land located in the Jose Maria Ruiz Survey, Abstract No. 1066, City of Sanger, Denton County, Texas, said 14.2225 acre tract of land being a portion of a called 211.36 acre tract of land conveyed to SANGER TEXAS INDUSTRIAL, LLC, by deed thereof filed for record in Denton County Clerk's Instrument Number (D.C.C.I.No.) 2022-122553, Official Public Records, Denton County, Texas (O.P.R.D.C.T.), said 14.2225 acre tract of land being more particularly described by metes and bounds as follows:

BEGINNING at an X-cut in concrete found at the northwest lot corner of Lot 2, Block A, Blue Star Industrial Addition, being an addition to the said City and State, according to the plat thereof filed for record in D.C.C.I. No. 20220525000223, O.P.R.D.C.T., said beginning point being on the common property line of the said 211.36 acre tract and a called 3.6810 acre tract of land conveyed to the State of Texas, by deed thereof filed for record in D.C.C.I. No. 2020-141152, O.P.R.D.C.T., said common property line being the east right-of-way line of Interstate Highway 35 (a variable width public right-of-way with state controlled access), said beginning point also being at the beginning of a curve to the left having a radius of 16,615.00 feet;

THENCE along the west property line of the said 211.36 acre tract, along the said east right-of-way line of Interstate Highway 35, and along said curve to the left, an arc length of 500.15 feet, and across a chord which bears North 01°41'55" East, a chord length of 500.13 feet to a 5/8-inch iron rod with a cap stamped "SPOONER 5922" set (hereinafter referred to as an iron rod set), from which a 5/8 inch iron rod with a 2-inch pink plastic cap stamped "TEXAS DEPARTMENT OF TRANSPORTATION" found at the north property corner of the said 3.6610 acre tract, same being a northwest property corner of the said 211.36 acre tract, bears North 00°45'55" West, a distance of 994.78 feet;

THENCE over and across the said 211.36 acre tract the following courses and distances:

- South 89°37'16" East, a distance of 1,234.56 feet to an iron rod set;
- South 00°22'44" West, a distance of 500.00 feet to a point for corner on an existing sanitary sewer manhole lid found at the northeast lot corner of said Lot 2;

THENCE North 89°37'16" West, along the north lot line of said Lot 2, a distance of 1,246.08 feet to the POINT OF BEGINNING, containing 14.2225 acres (619,533 square feet) of land more or less.

1. This final plat is not in accordance with the preliminary plat, but generally, the drainage plan does conform to the accepted drainage study.
2. callout/show private drainage easements for proposed SD lines. drainage infrastructure cannot be lumped into a general utility easement.

1. The name, address and phone number of all utilities providing service to the development is required. A signature from each provider or a will-serve letter, signifying their ability to provide service to the subdivision is required.
2. Include certificate for designated city official signatures on all final plats

REMAINDER OF CALLED 211.36 ACRES
SANGER TEXAS INDUSTRIAL, LLC
INS. NO. 2022-122553,
O.P.R.D.C.T.

LOT 5, BLOCK A
14.2225 ACRES
(619,533 SQ. FT.)

PORTION OF CALLED 211.36 ACRES
SANGER TEXAS INDUSTRIAL, LLC
INS. NO. 2022-122553,
O.P.R.D.C.T.

LOT 2, BLOCK A
BLUE STAR INDUSTRIAL ADDITION
INS. NO. 20220525000223, O.P.R.D.C.T.

*** GENERAL NOTES ***

- The bearings shown hereon are referenced to the Texas Coordinate System of 1983, Texas North Central Zone 4202, and are based on the North American Datum of 1983, 2011 Adjustment. All areas shown hereon are calculated based on surface measurements.
- This survey was prepared without the benefit of a Title Commitment prepared by a title company. The easements shown hereon are the only easements known by Spooner & Associates and does not imply that any other easements, covenants, restrictions, or other matters of record do not affect the subject property. No other research was performed by Spooner & Associates, Inc.
- According to the Flood Insurance Rate Map published by the Federal Emergency Management Agency, Department of Homeland Security and by graphic plotting only, the subject property appears to be located in Zone "X" (areas determined to be outside the 0.2 % annual chance floodplain) as shown on Map No. 48121C0070G; map revised April 18, 2011, for Denton County and incorporated areas.
- All lots comply with the minimum size requirements of the zoning district.
- This property may be subject to change related to impact fees and the applicant should contact the City regarding any applicable fees due.
- All common areas, drainage easements, and detention facilities will be owned and maintained by the HOA/POA. Any common area within the City's right-of-way will require a facilities agreement, to be reviewed and approved by the City.
- Notice-selling a portion of this addition by metes and bounds is a violation of City Ordinance and State Law and is subject to fines and withholding of utilities and building permits.
- This plat does not alter or remove existing deed restrictions, if any, on this property.
- The purpose of this plat is to establish a new lot and easements for the development of the property.

OWNER:
SANGER TEXAS INDUSTRIAL, LLC
C/O BLUE STAR LAND LP
1 COWBOYS WAY
FRISCO, TEXAS 75034

ENGINEER:
ANIMAS CIVIL ENGINEERING
PO BOX 828974
RICHARDSON, TX 75083
(214) 803-1099
ATTN: MICHAEL DOGGETT, P.E.

SURVEYOR:
SPOONER AND ASSOCIATES, INC.
309 BYERS STREET, #100
EULESS, TEXAS 76039
(817) 685-8448
ATTN: ERIC SPOONER, RPLS

Approved for Preparation of Final Plat
City of Sanger, TX Planning and Zoning Date

STATE OF TEXAS §
COUNTY OF TARRANT §

THAT, I, Eric S. Spooner, a Registered Professional Land Surveyor, in the State of Texas, do hereby certify that this plat is true and correct and was prepared from an actual survey of the property made on the ground under my supervision.
Surveyed on the ground during the month of October, 2024.

Eric S. Spooner, R.P.L.S.
Texas Registration No. 5922

STATE OF TEXAS §
COUNTY OF TARRANT §

BEFORE ME, the undersigned, a Notary Public in and for the said County and State, on this day personally appeared ERIC S. SPOONER, known to me to be the person whose name is subscribed to the foregoing instrument and acknowledged to me that he/she executed the same for the purpose and consideration therein expressed, and in the capacity therein stated.

GIVEN UNDER MY HAND AND SEAL OF OFFICE, on this the ___ day of ___, 2024.


Notary Public, State of Texas



THIS DOCUMENT IS
PRELIMINARY
FOR REVIEW PURPOSES ONLY
ERIC S. SPOONER, R.P.L.S.
December 15, 2022

CITY OF SANGER
PROJECT NO. _____
FINAL PLAT
LOT 5, BLOCK A
BLUE STAR
INDUSTRIAL ADDITION

BEING A PLAT OF A 14.2225 ACRE TRACT OF LAND LOCATED IN THE JOSE MARIA RUIZ SURVEY, ABSTRACT NO. 1066, CITY OF SANGER, DENTON COUNTY, TEXAS, SAID 14.2225 ACRE TRACT BEING A PORTION OF A CALLED 211.36 ACRE TRACT OF LAND CONVEYED TO SANGER TEXAS INDUSTRIAL, LLC, BY DEED THEREOF FILED FOR RECORD IN DENTON COUNTY CLERK'S INSTRUMENT NO. 2022-122553, O.P.R.D.C.T.

1 INDUSTRIAL LOT
14.2225 ACRES ~ ZONED I-1
December 2024

 

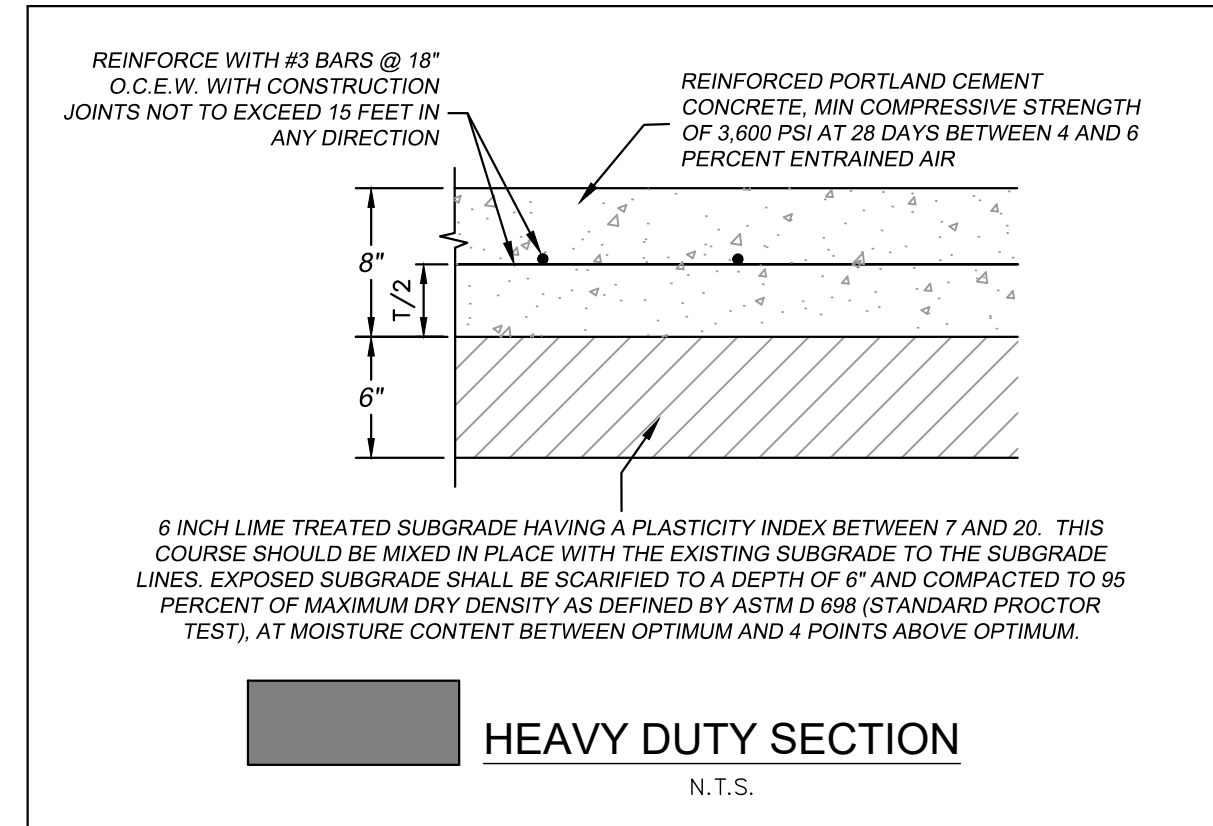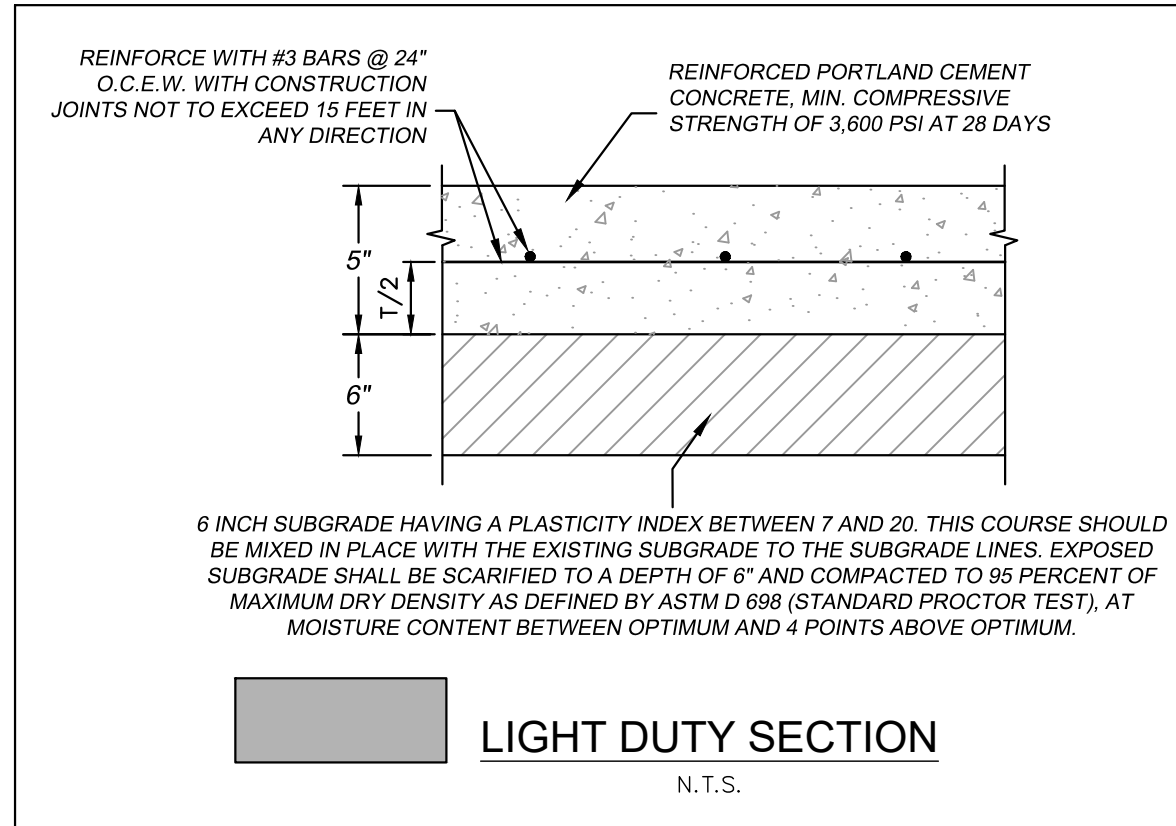




*THESE SECTIONS BELOW ARE SHOWN FOR REFERENCE ONLY. PAVEMENT DESIGN AND SOIL PREPARATION RECOMMENDATIONS BY RONE ENGINEERS (REPORT NO. 22-26269 DATED APRIL 2022) SHALL BE ADHERED TO FOR BOTH MATERIALS AND PRACTICE OF INSTALLATION

NOTES

- CONTRACTOR SHALL REFER TO ARCHITECTURAL PLANS FOR EXACT BUILDING FOOT PRINT DIMENSIONS.
- ALL DIMENSIONS ARE FROM THE FACE OF CURB, FACE OF BUILDING, OR PROPERTY LINE UNLESS NOTED OTHERWISE.
- ALL CURB RADII ARE 2' UNLESS NOTED OTHERWISE.
- CONTRACTOR SHALL REFER TO ARCHITECTURAL PLANS AND FINAL GEOTECH REPORT FOR BUILDING SUB GRADE PREPARATION REQUIREMENTS.
- CONTRACTOR SHALL REFER TO ARCHITECTURAL PLANS FOR DUMPSTER ENCLOSURE CONSTRUCTION SPECIFICATIONS.
- CONTRACTOR SHALL REFER TO M.E.P. AND LANDSCAPE PLANS FOR CONDUIT PLACEMENT PRIOR TO PAVING.

LEGEND

- PROPERTY LINE
- SIDEWALK PAVEMENT
- ACCESSIBLE PARKING SYMBOL
- ACCESSIBLE ROUTE
- PROPOSED TRANSFORMER LOCATION
- NUMBER OF PARKING SPACES PER ROW
- EXISTING LIGHT POLE
- EXISTING FIRE HYDRANT
- EXISTING SAN. SWR. MANHOLE
- WATER METER
- FH
- FDC
- SANITARY SEWER MANHOLE
- EXISTING SIGN
- TYP.

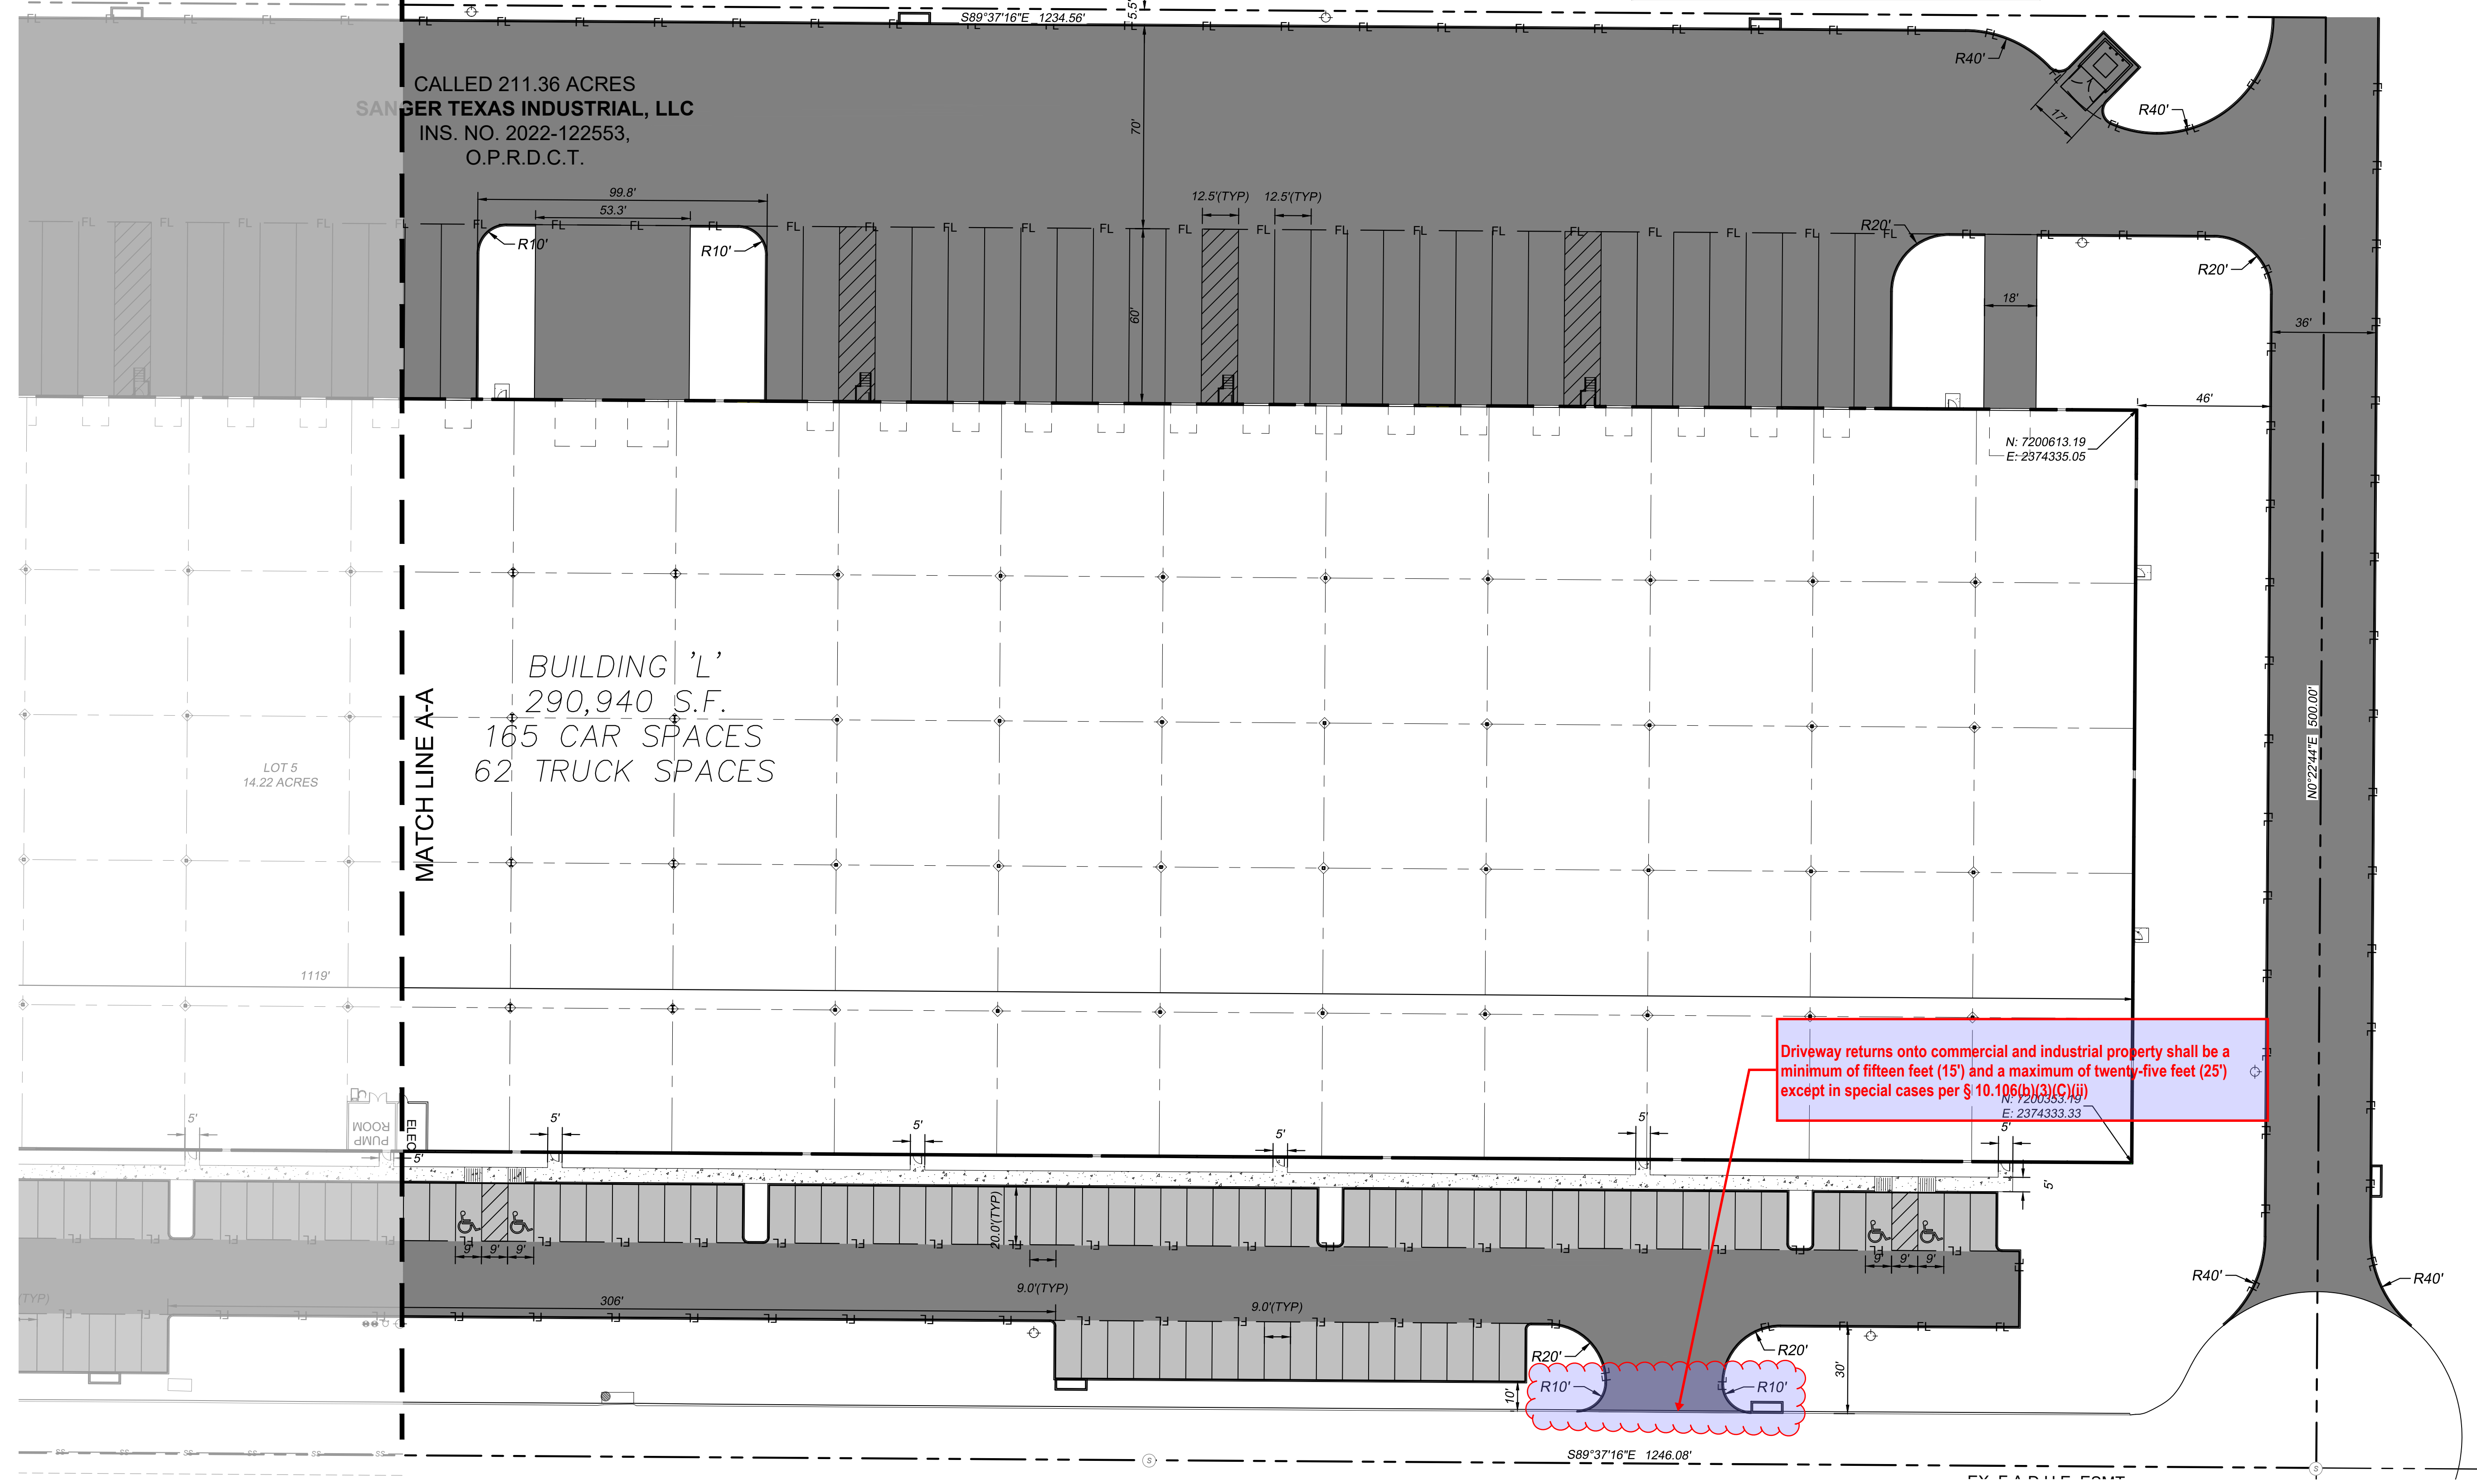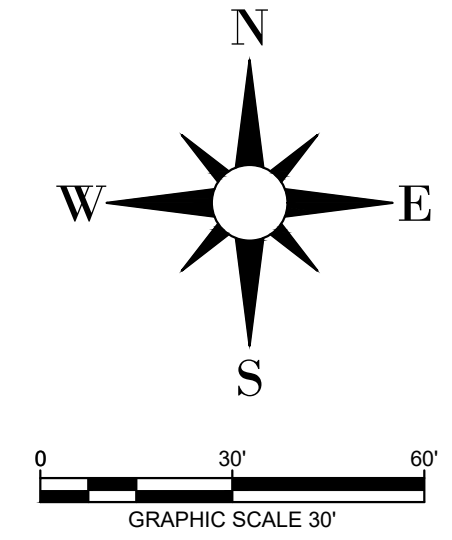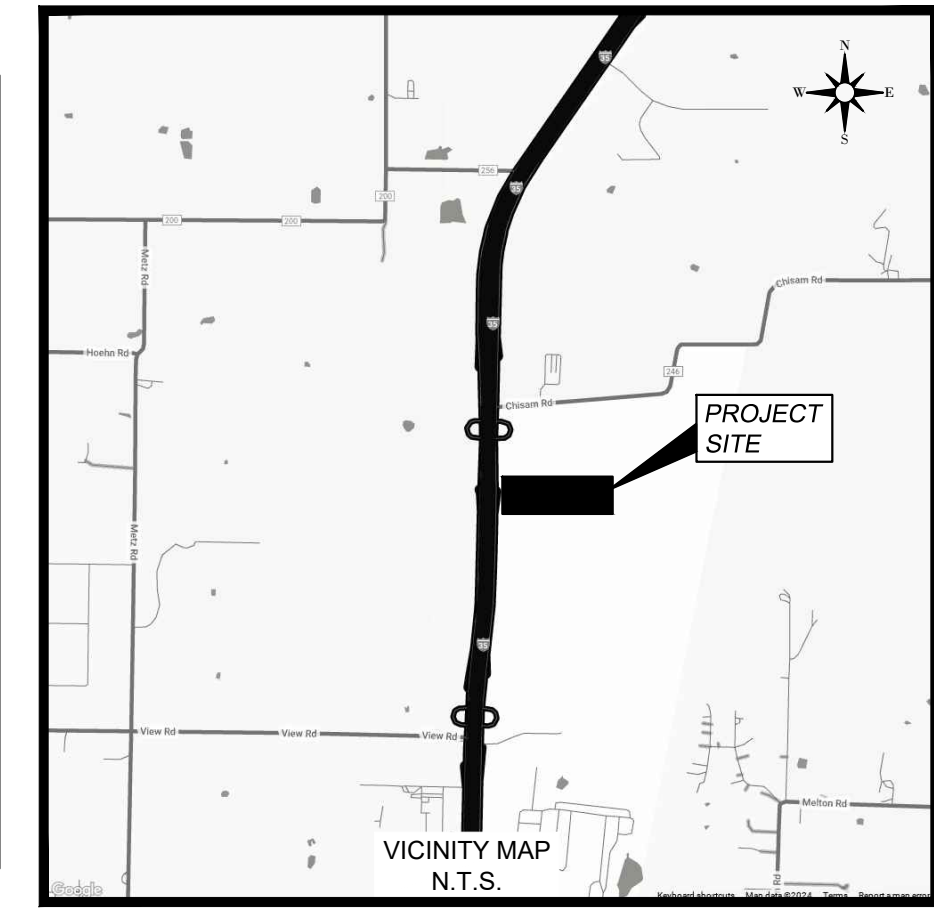

NO.	REVISIONS	DATE	BY

ANIMAS
CIVIL ENGINEERING
© 2024 ANIMAS CIVIL ENGINEERING, LLC
PHONE: 214-803-1099
TX F-26500

PROJECT NAME:
BLUE STAR INDUSTRIAL BLDG. L SANGER, TEXAS

SHEET TITLE:
PAVING AND DIMENSION CONTROL PLAN

ACE PROJECT:	01101
DATE	DECEMBER 2024
SCALE	AS SHOWN
DRAWN BY:	MD
SHEET NUMBER	C-2.02

C:\Users\mdogg\OneDrive\Documents\Projects\01101-Blue Star Industrial Sanger\CAD\Plan Sheets\Grading\Plan.dwg
Saturday, December 7, 2024 2:48:54 PM

0 ACRES
TEXAS
0-141152,
C.T.

1. Provide offsite flow arrows

Is there an agreement for the offsite grading?





Know what's below.
Call before you dig.

GRADING NOTES

- SPOT ELEVATIONS ARE TO TOP OF PAVEMENT UNLESS OTHERWISE NOTED.
- CONTRACTOR SHALL REFER TO ARCHITECTURAL PLANS FOR SUBGRADE PREPARATIONS SPECIFICATIONS FOR ALL PROPOSED BUILDINGS.
- ALL FILL MATERIAL SHALL BE COMPACTED PER GEOTECH RECOMMENDATION. REFER TO PAVING SECTION DETAILS FOR SUBGRADE PREPARATION REQUIREMENTS UNDER ALL PAVED AREAS. (REFER TO GEOTECH REPORT)
- CONTRACTOR SHALL VERIFY ALL SIDEWALKS HAVE A MAXIMUM LONGITUDINAL SLOPE OF 5% AND A MAXIMUM CROSS SLOPE OF 2%. IF THE CONTRACTOR IDENTIFIES SLOPES GREATER, CONTRACTOR SHALL NOTIFY ENGINEER PRIOR TO CONSTRUCTION.
- SPOT ELEVATIONS IDENTIFIED AS "MATCH EXISTING" SHALL BE FIELD VERIFIED. CONTRACTOR SHALL NOTIFY CIVIL ENGINEERING CONSULTANT (CEC) OF ANY DISCREPANCIES PRIOR TO PROCEEDING WITH GRADING ACTIVITIES.

LEGEND

	PROPERTY LINE
	PROPOSED CONTOUR
	EXISTING CONTOUR
	PROPOSED TOP OF CURB ELEVATION
	PROPOSED TOP OF PAVEMENT ELEVATION
	MATCH EXISTING

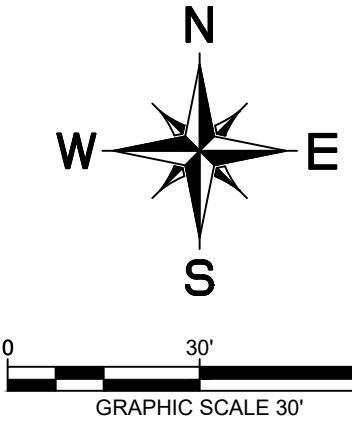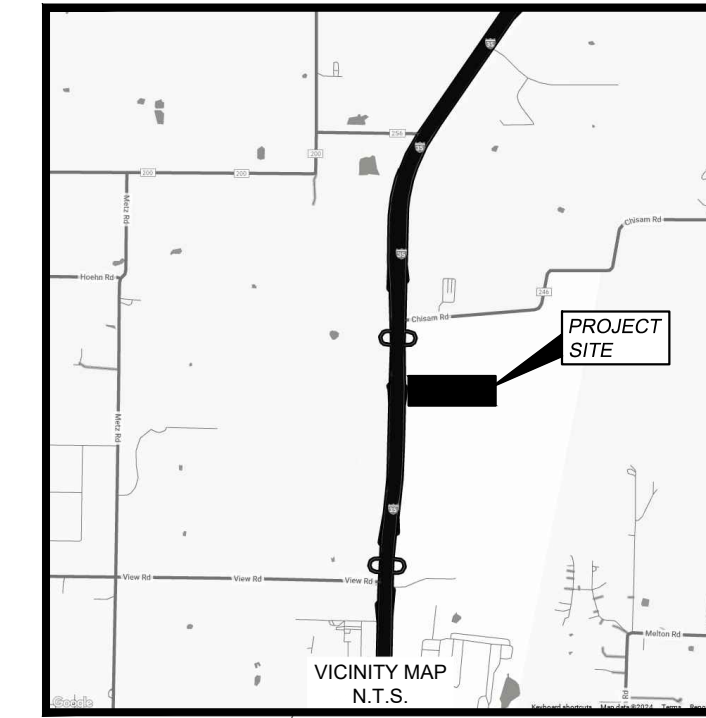


CALLED 211.36 ACRES
SANGER TEXAS INDUSTRIAL, LLC
INS. NO. 2022-122553,
O.P.R.D.C.T.

BUILDING 'L'
290,940 S.F.
165 CAR SPACES
62 TRUCK SPACES

FF: 715.00

LOT 5
14.22 ACRES

MATCH LINE A-A




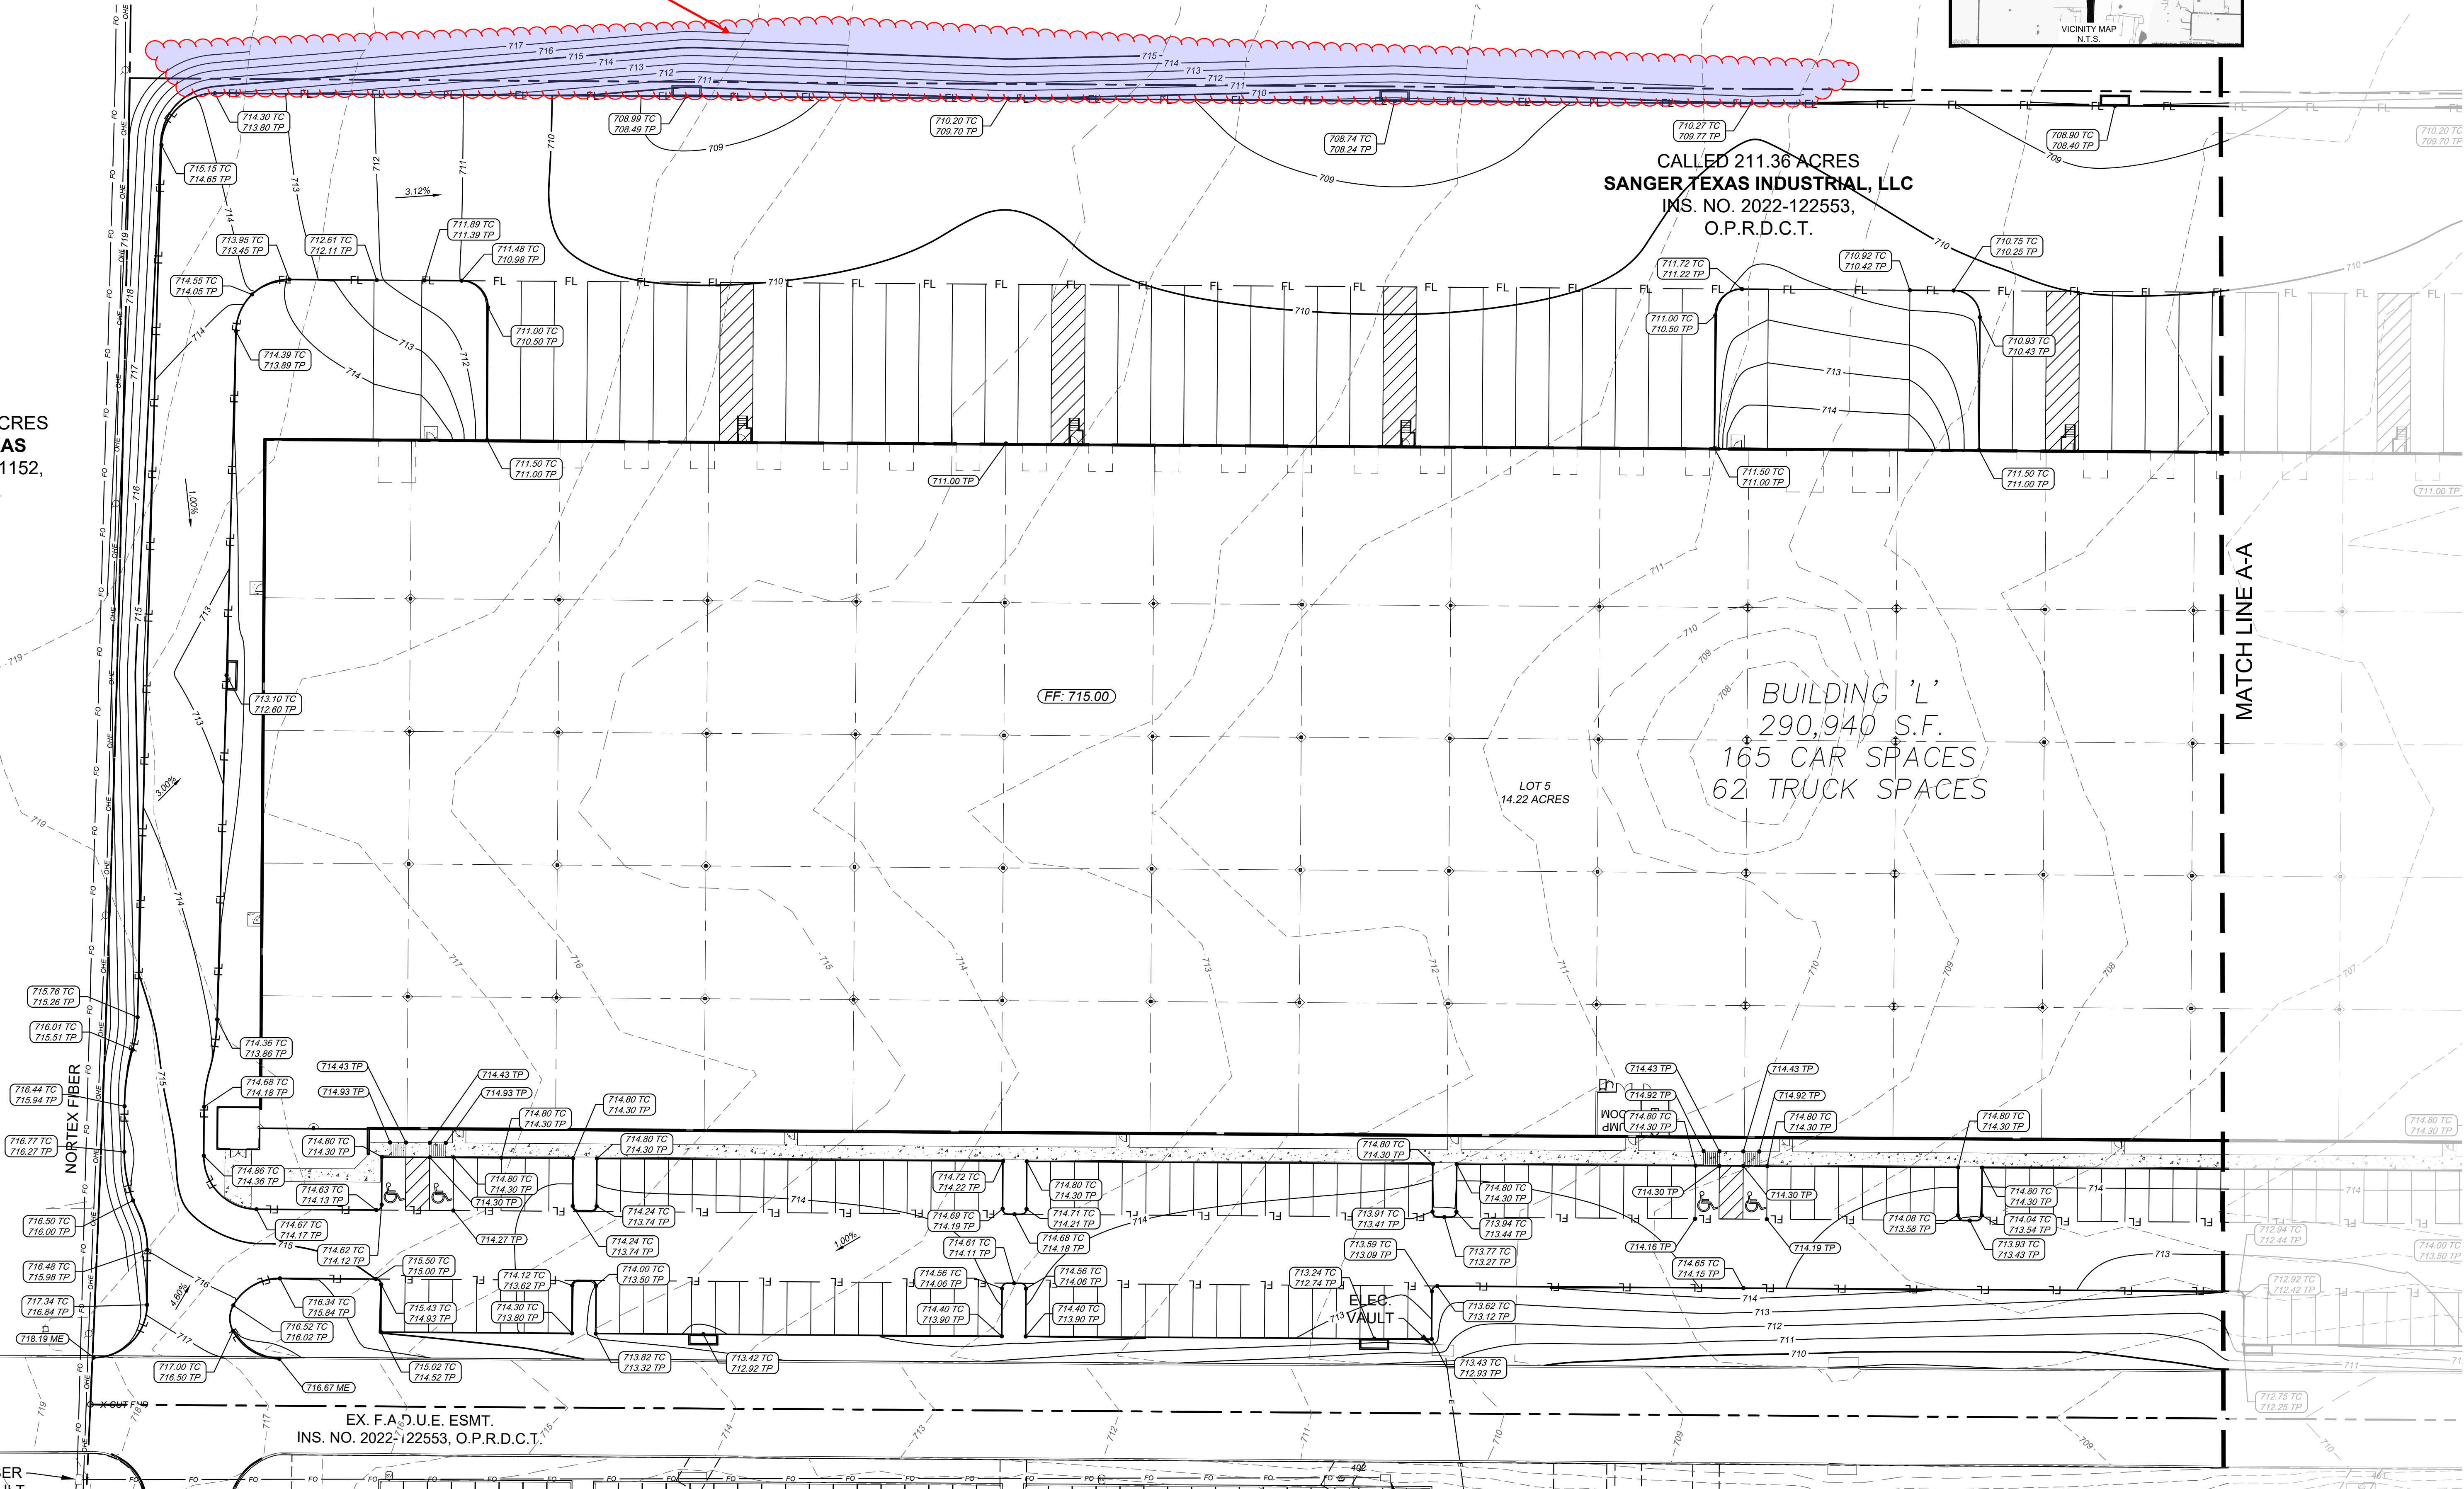


EX. F.A.D.U.E. ESM.T.
INS. NO. 2022-122553, O.P.R.D.C.T.


NO.	REVISIONS	DATE	BY
© 2024 ANIMAS CIVIL ENGINEERING, LLC PHONE: 214-803-1099 TX F-26500			
PROJECT NAME: BLUE STAR INDUSTRIAL BLDG. L SANGER, TEXAS			
SHEET TITLE: GRADING PLAN			
ACE PROJECT: 01101 DATE: DECEMBER 2024 SCALE: AS SHOWN DRAWN BY: MD SHEET NUMBER: C-3.01			

1. please provide 5, 10, 25, and 100 yr calcs
 2. intensity from 2020 ISWM hydrology manual? please note source. to be consistent with accepted drainage study, use intensity data in from accepted study (2014 ISWM hydrology manual).
 3. see comments related to surcharge for circled inlets

DRAINAGE AREA TABLE						
DRAINAGE AREA NO.	AREA (ac)	RUNOFF COEFFICIENT "C"	RAINFALL INTENSITY "I" 100 (in/hr)	TIME OF CONCENTRATION (minutes)	TOTAL FLOW Q100 (cfs)	COLLECTION POINT
A1	0.27	0.90	9.58	10.0	2.3	CURB INLET
A2	0.70	0.90	9.58	10.0	6.0	CURB INLET
A3	0.55	0.90	9.58	10.0	4.7	CURB INLET
A4	0.68	0.90	9.58	10.0	5.8	CURB INLET
A5	0.45	0.90	9.58	10.0	3.9	CURB INLET
B1	0.81	0.90	9.58	10.0	7.0	CURB INLET
B2	0.80	0.90	9.58	10.0	6.9	CURB INLET
B3	0.87	0.90	9.58	10.0	7.5	CURB INLET
B4	0.87	0.90	9.58	10.0	7.5	CURB INLET
B5	0.93	0.90	9.58	10.0	8.0	CURB INLET
OFF-1	0.25	0.90	9.58	10.0	2.2	EX. SWALE
OFF-2	1.48	0.90	9.58	10.0	12.8	AREA B5
RD-1	1.67	0.90	9.58	10.0	14.4	ROOF DRAIN
RD-2	1.67	0.90	9.58	10.0	14.4	ROOF DRAIN
RD-3	1.67	0.90	9.58	10.0	14.4	ROOF DRAIN
RD-4	1.67	0.90	9.58	10.0	14.4	ROOF DRAIN

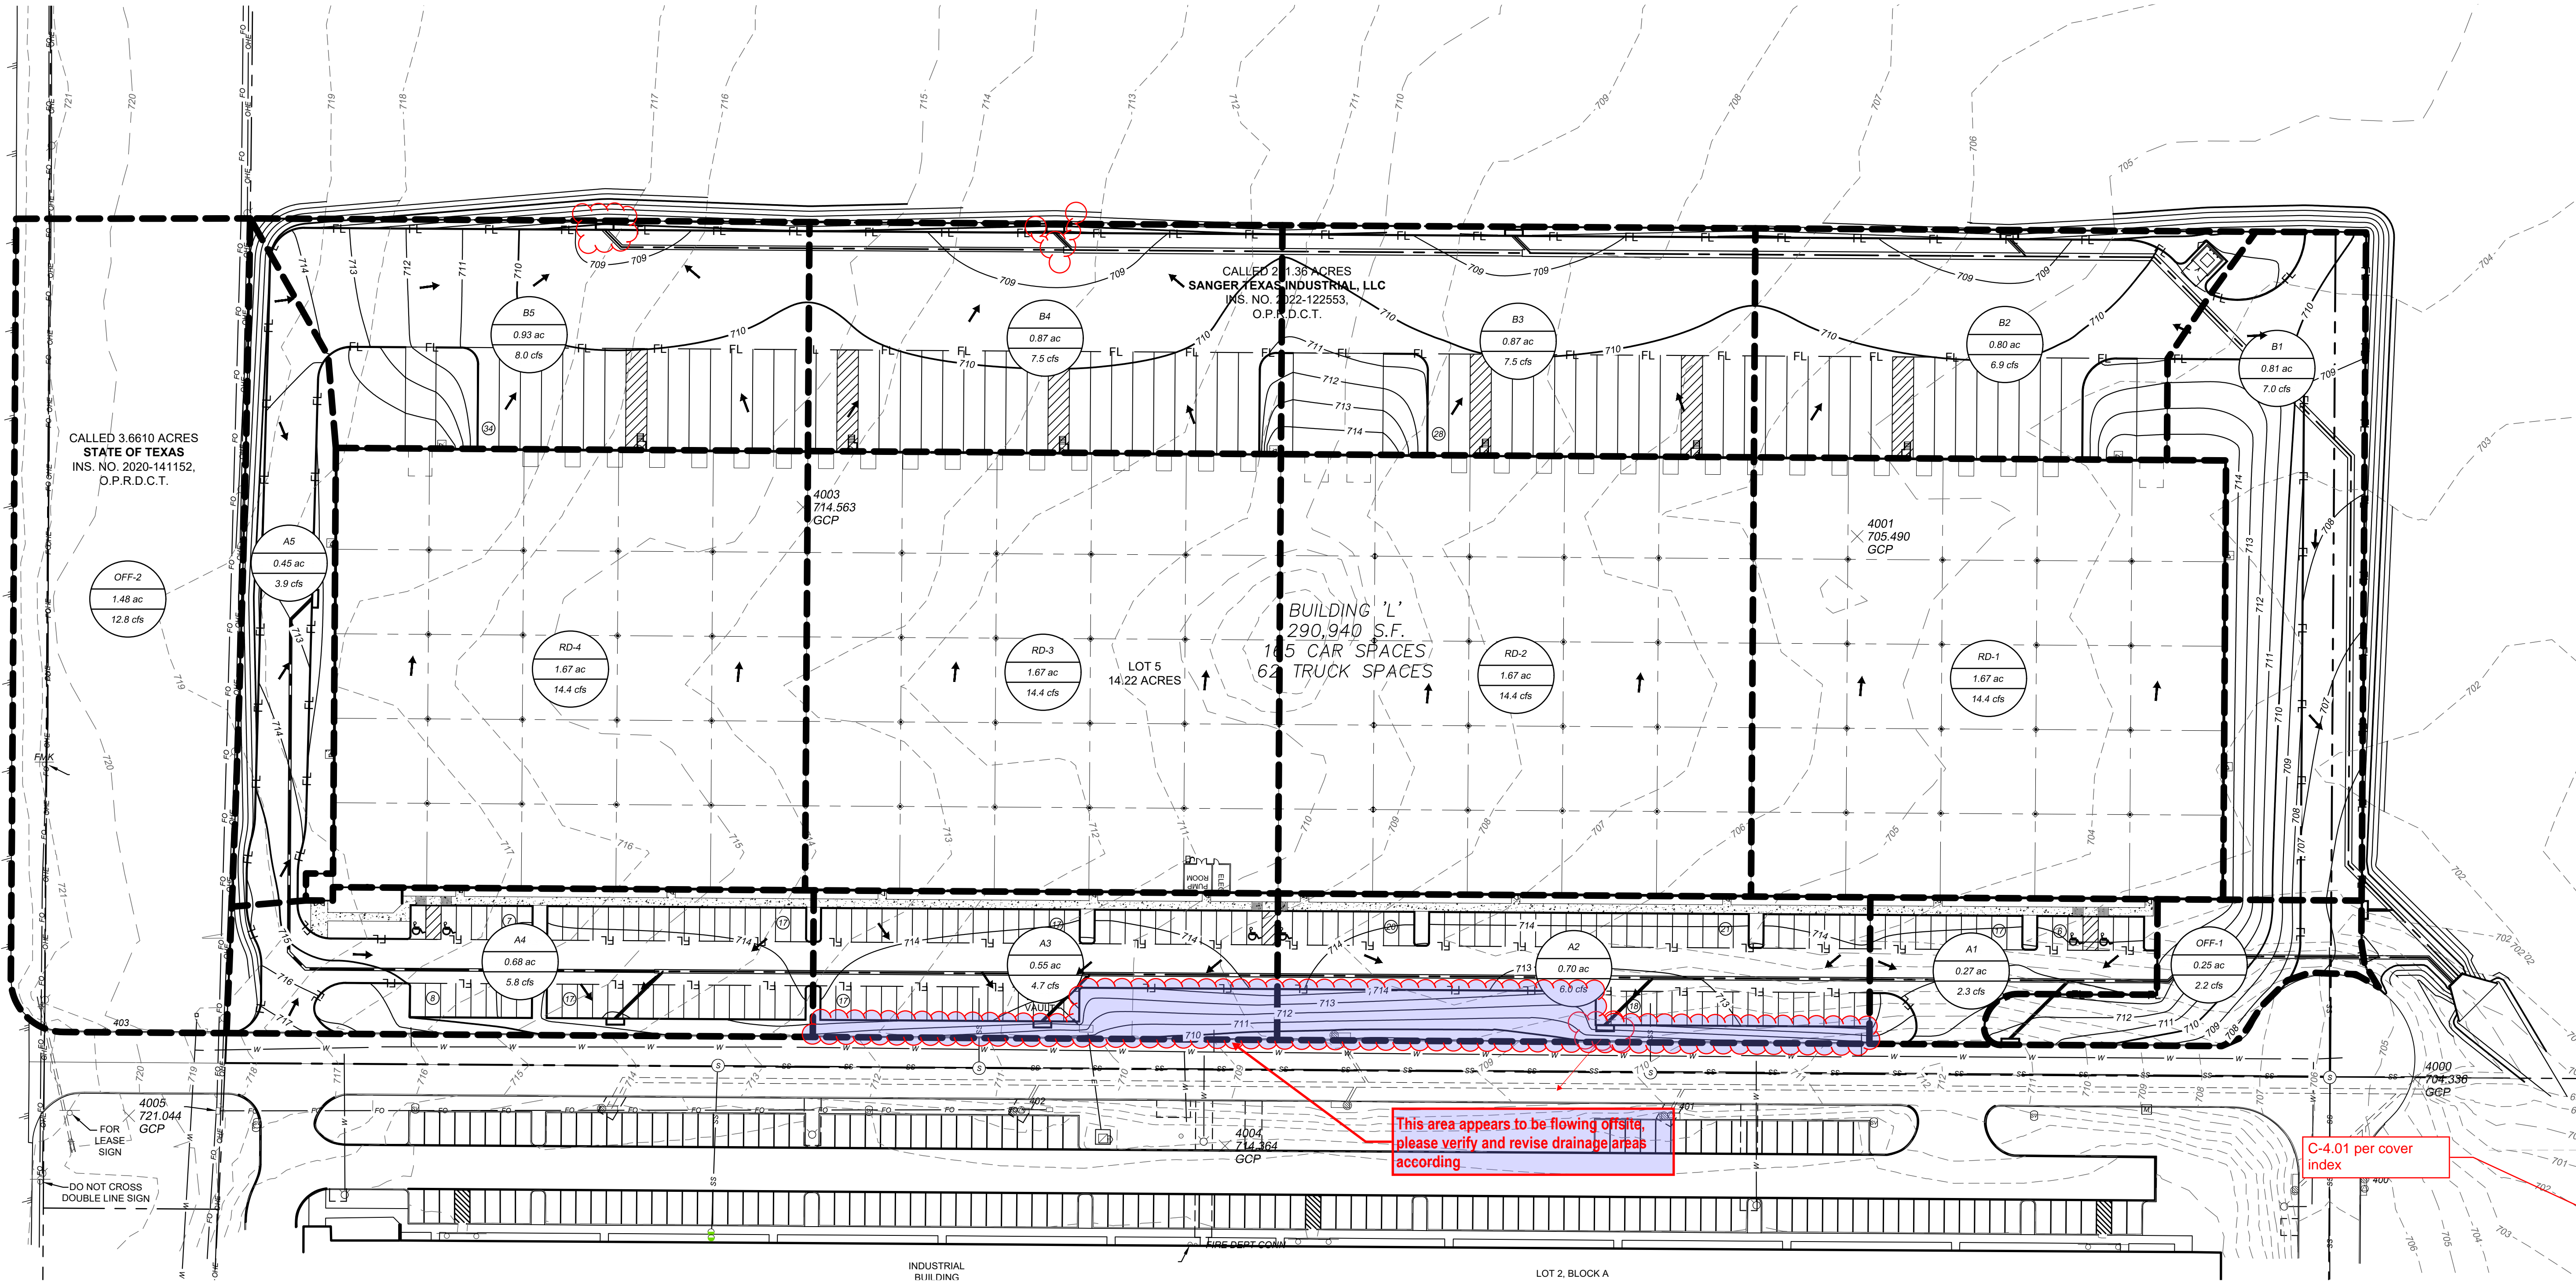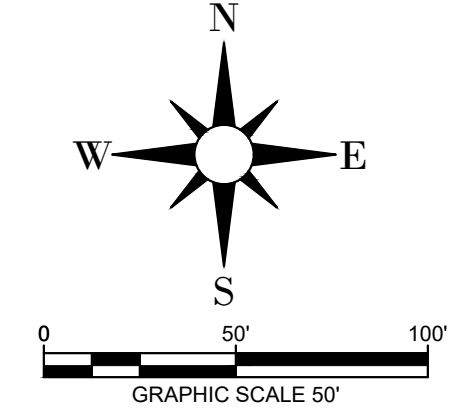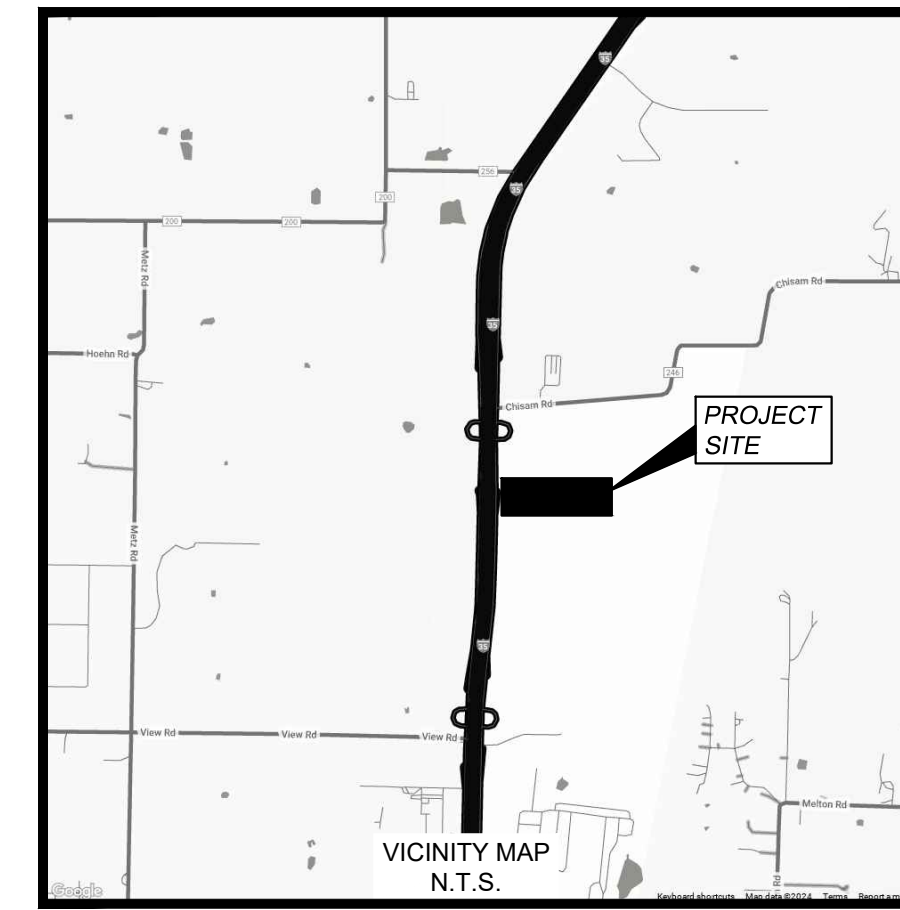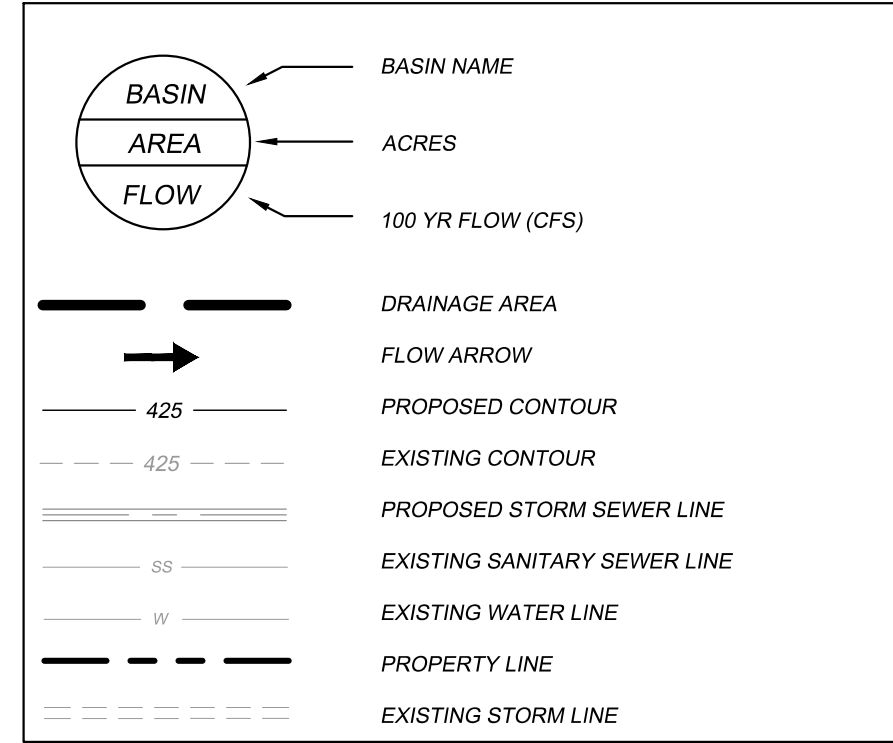

NO.	REVISIONS	DATE	BY
© 2024 ANIMAS CIVIL ENGINEERING, LLC PHONE: 214-803-1099 TX F-26500			
PROJECT NAME: BLUE STAR INDUSTRIAL BLDG. L SANGER, TEXAS			
SHEET TITLE: DRAINAGE AREA MAP			
ACE PROJECT: 01101 DATE: DECEMBER 2024 SCALE: AS SHOWN DRAWN BY: MD SHEET NUMBER: C-6.01			

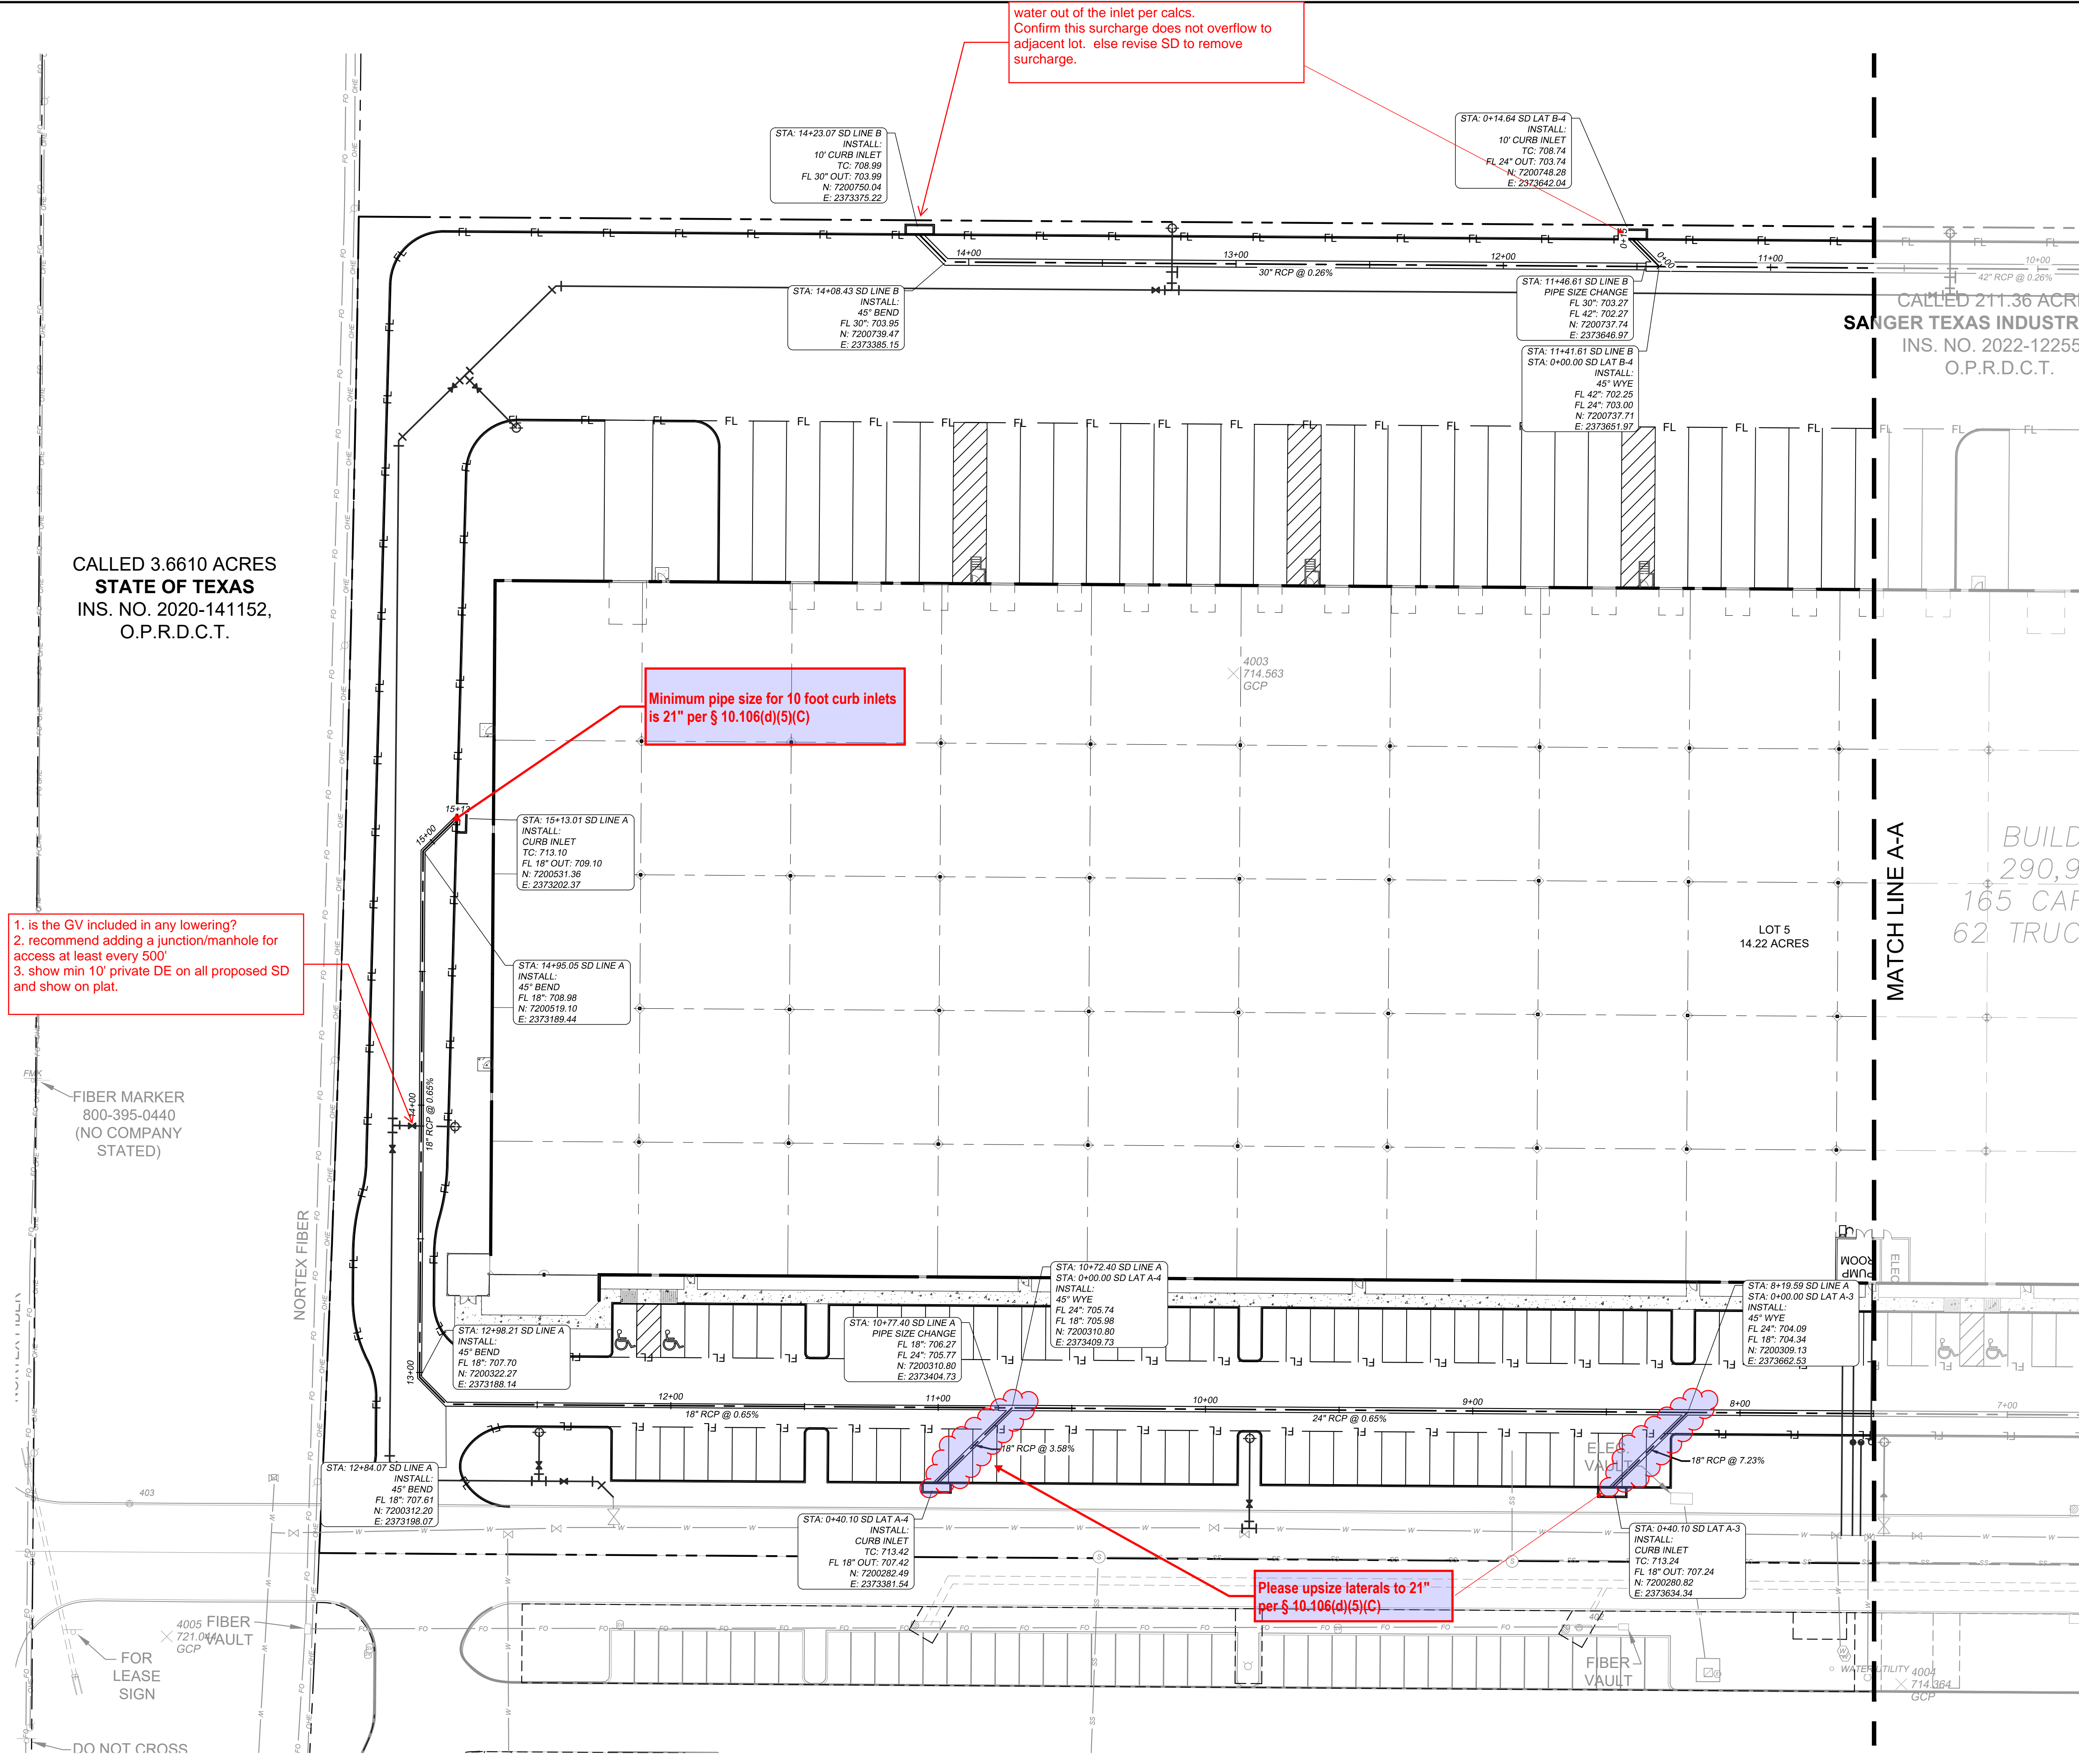

CALLLED 3.6610 ACRES
 STATE OF TEXAS
 INS. NO. 2020-141152,
 O.P.R.D.C.T.



CALLLED 211.36 ACRE
 SANGER TEXAS INDUSTRI
 INS. NO. 2022-12255,
 O.P.R.D.C.T.

LOT 5
 14.22 ACRES

BUILD
 290,9
 165 CAR
 62 TRUCI



Know what's below.
 Call before you dig.

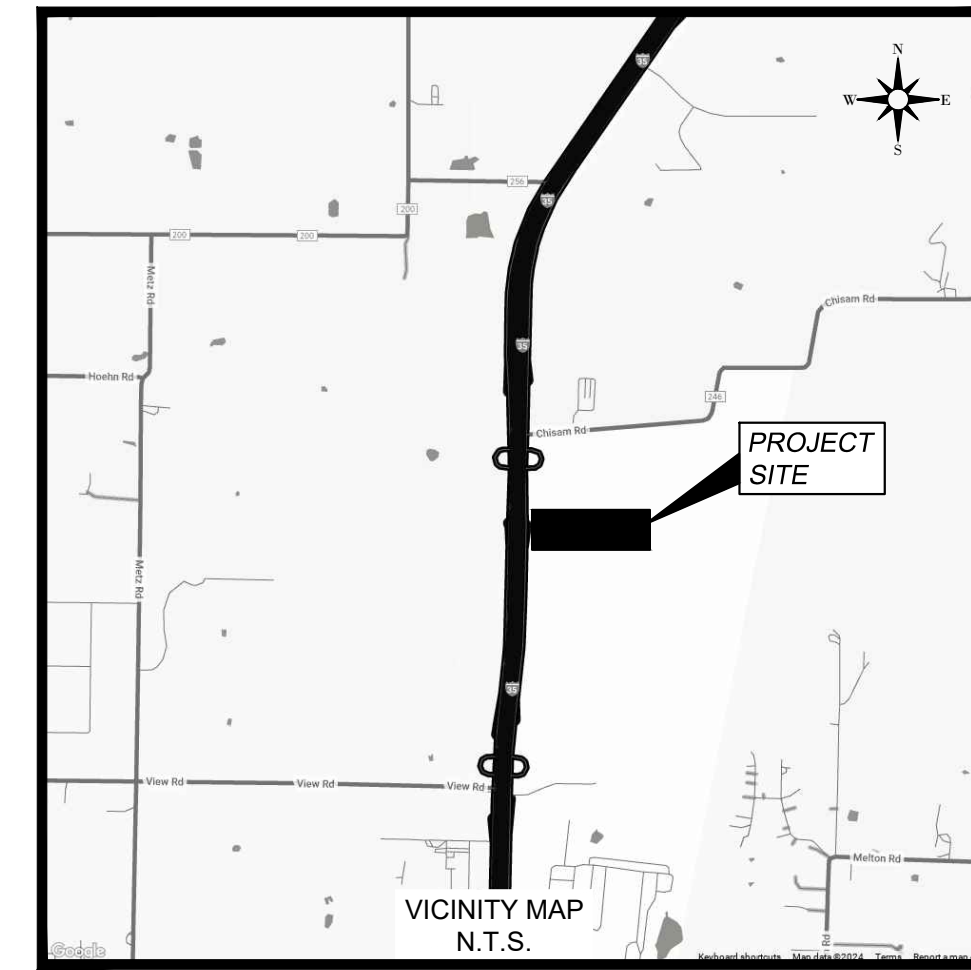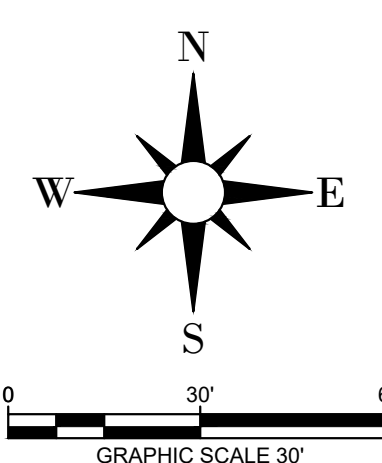


LEGEND

	PROPERTY LINE
	PROPOSED STORM LINE
	PROPOSED SANITARY SEWER LINE
	PROPOSED WATER LINE
	EXISTING STORM LINE
	EXISTING OVERHEAD ELECTRIC
	EXISTING WATER LINE
	EXISTING SEWER LINE
	PROPOSED SANITARY SEWER MANHOLE (SS MH)
	PROPOSED FIRE HYDRANT (FH)
	PROPOSED FIRE DEPARTMENT CONNECTION (FDC)
	EXISTING FIRE HYDRANT
	EXISTING STORM MANHOLE
	EXISTING SAN. SWR. MANHOLE



STORM DRAINAGE NOTES:

- THE CONTRACTOR IS SPECIFICALLY CAUTIONED THAT THE LOCATION AND/OR ELEVATION OF EXISTING UTILITIES AS SHOWN ON THESE PLANS IS BASED ON RECORDS OF THE VARIOUS UTILITY COMPANIES, AND WHERE POSSIBLE, MEASUREMENTS TAKEN IN THE FIELD. THE INFORMATION IS NOT TO BE RELIED ON AS BEING EXACT OR COMPLETE. THE CONTRACTOR MUST CALL THE APPROPRIATE UTILITY COMPANIES AT LEAST 72 HOURS BEFORE ANY EXCAVATION TO REQUEST EXACT FIELD LOCATION OF UTILITIES.
- CONTRACTOR SHALL FIELD VERIFY THE EXACT HORIZONTAL AND VERTICAL LOCATIONS OF ALL EXISTING UTILITIES IN FIELD PRIOR TO COMMENCING CONSTRUCTION. NOTIFY ENGINEER IMMEDIATELY OF ANY DISCREPANCIES.
- STORM PIPE SHALL BE AS FOLLOWS UNLESS OTHERWISE NOTED:
 A) RCP - ASTM C76 CLASS III - REQUIRED IN PUBLIC RIGHT OF WAY AND AT CONNECTION POINTS TO PUBLIC STORM SEWER.
 B) HDPE - AASHTO M252 TYPE S, M294 TYPE S R ASTM F 2306 SMOOTH WALL
- ALL EXISTING AND PROPOSED PIPES AND STRUCTURES ARE TO BE CLEANED OUT AT THE COMPLETION OF CONSTRUCTION TO REMOVE ALL SILT AND DEBRIS.
- ALL STORM PIPE ENTERING STRUCTURES SHALL BE GROUTED TO ASSURE CONNECTION AT STRUCTURE IS WATERTIGHT.
- ALL STORM SEWER MANHOLES IN PAVED AREAS SHALL BE FLUSH WITH PAVEMENT, AND SHALL HAVE TRAFFIC BEARING RING & COVERS. MANHOLES IN UNPAVED AREAS SHALL BE 6" ABOVE FINISH GRADE. LIDS SHALL BE LABELED "STORM SEWER".
- ALL STORM STRUCTURES SHALL HAVE A SMOOTH UNIFORM POURED MORTAR INVERT FROM INVERT IN TO INVERT OUT.

NO.	REVISIONS	DATE	BY
© 2024 ANIMAS CIVIL ENGINEERING, LLC PHONE: 214-803-1099 TX F-26500			
PROJECT NAME: BLUE STAR INDUSTRIAL BLDG. L SANGER, TEXAS			
SHEET TITLE: STORM PLAN			
ACE PROJECT: 01101			
DATE DECEMBER 2024			
SCALE AS SHOWN			
DRAWN BY: MD			
SHEET NUMBER C-5.01			

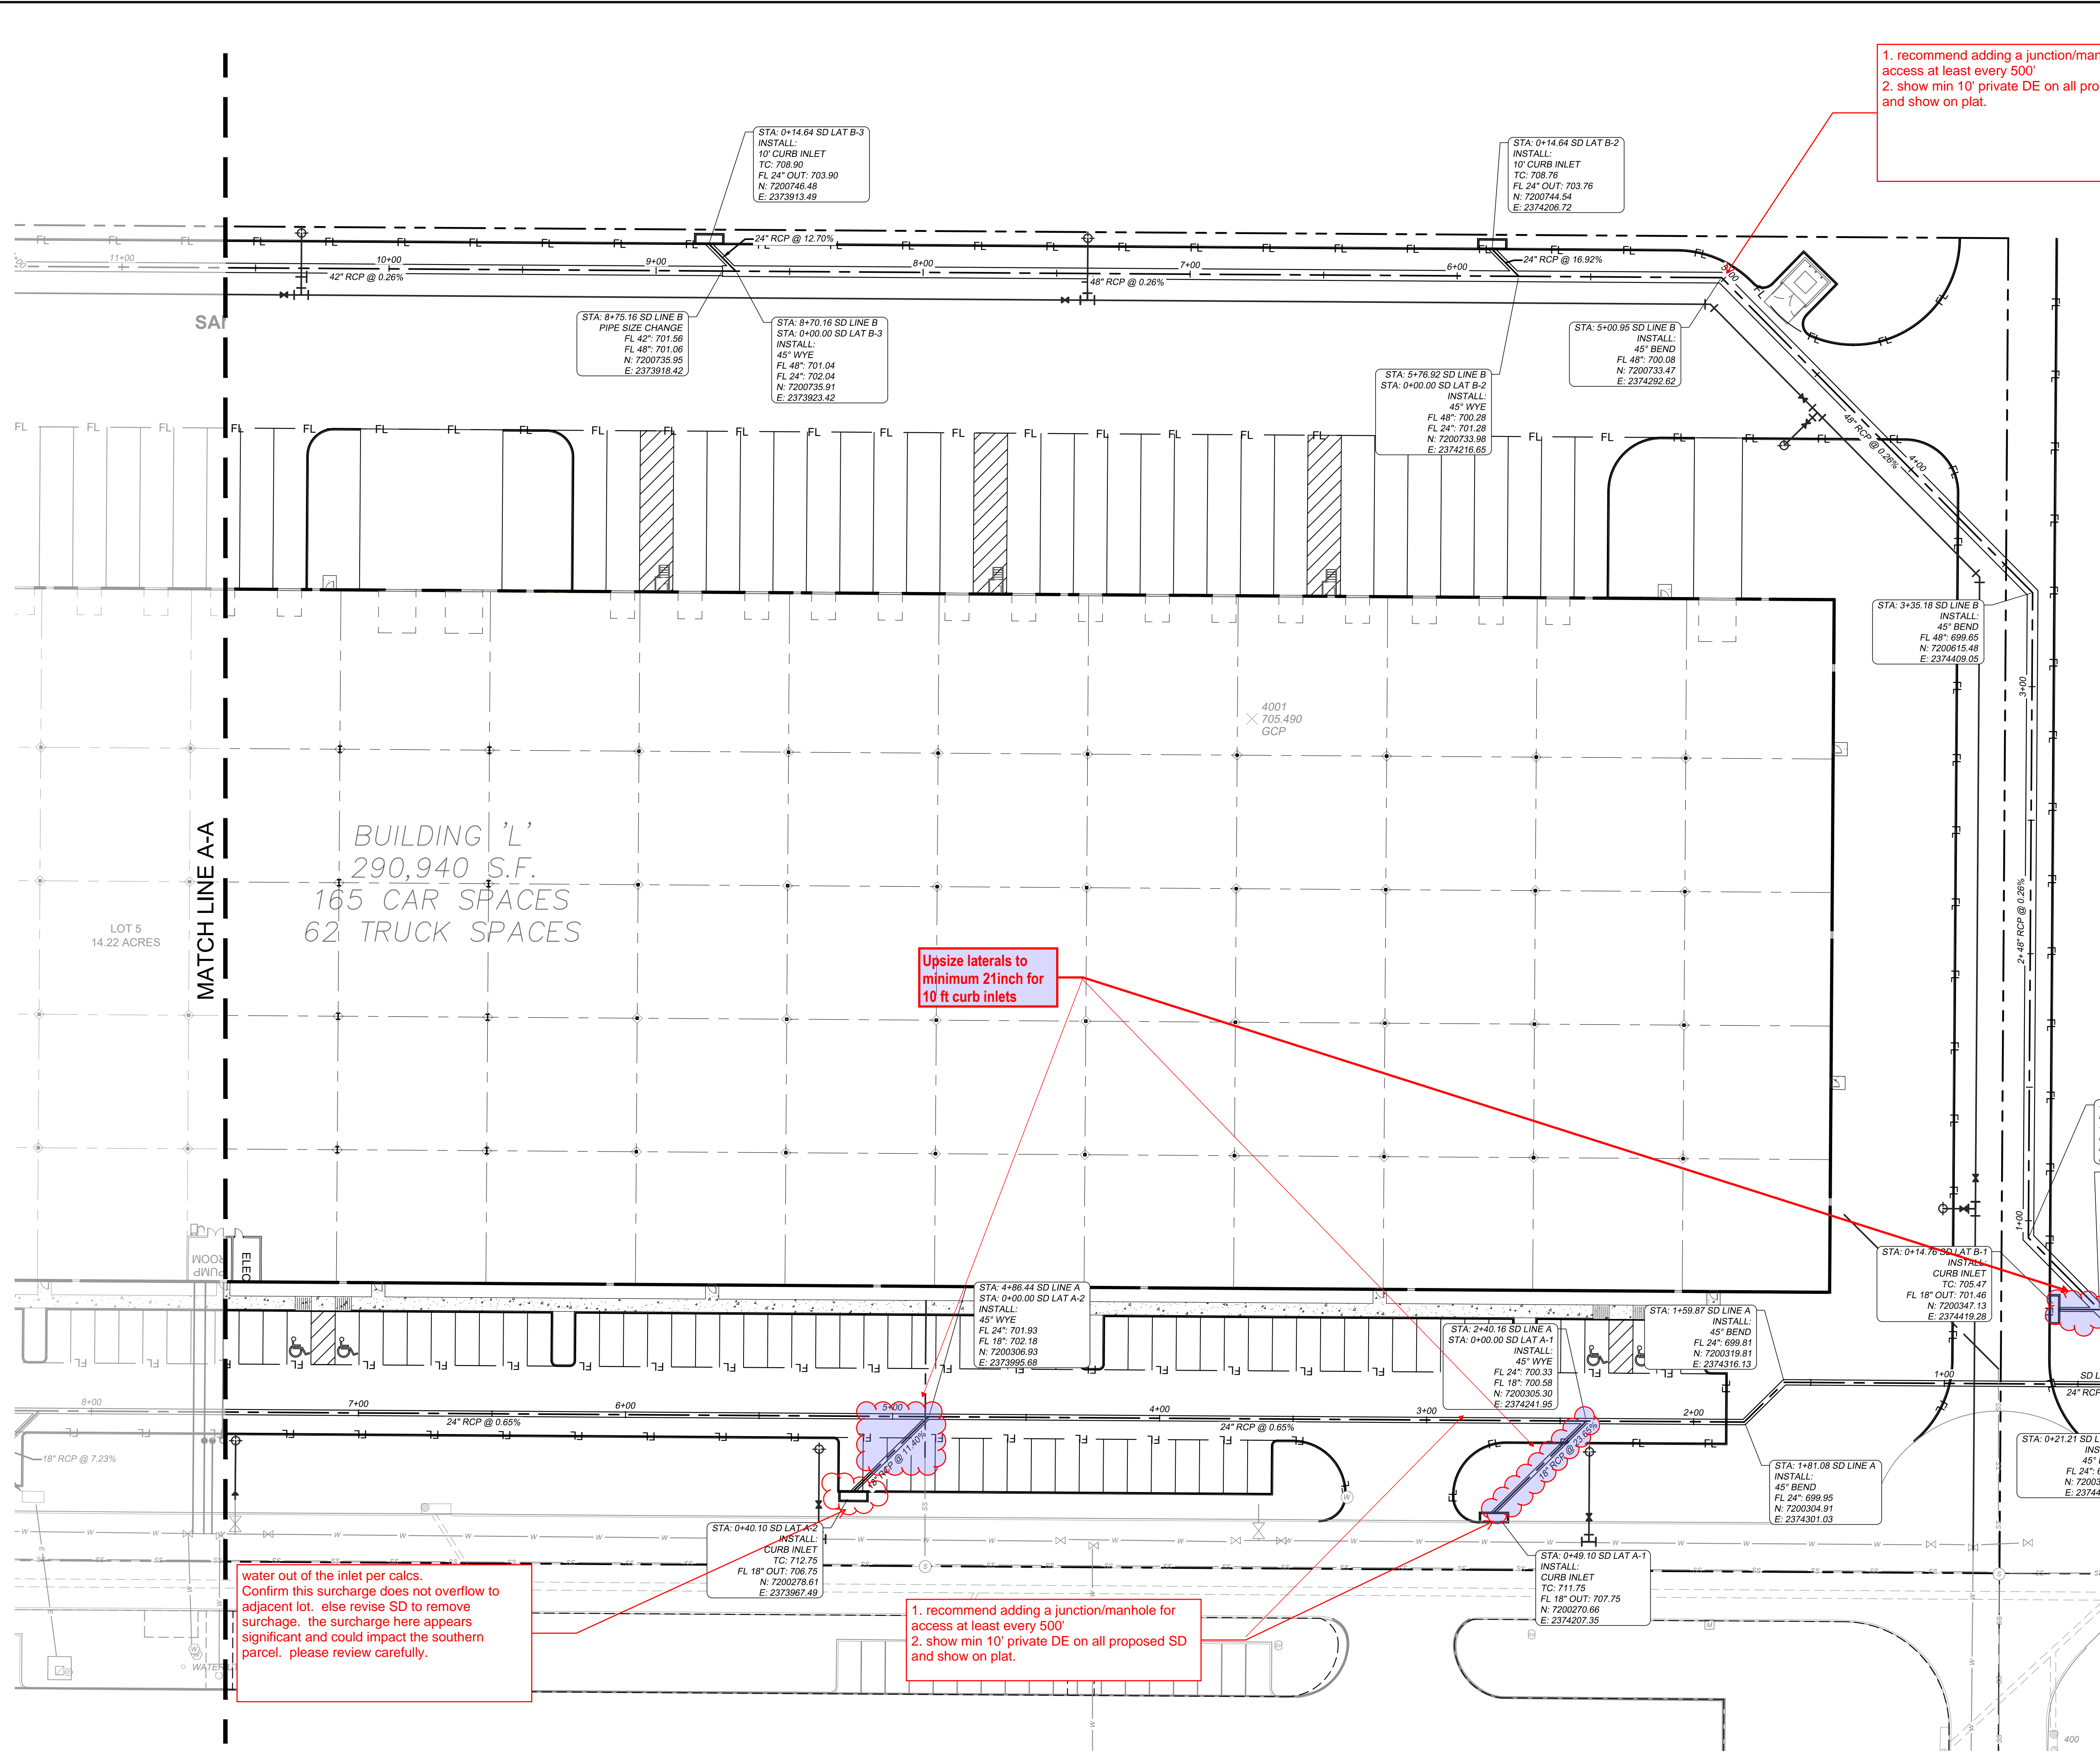

1. recommend adding a junction/manhole for access at least every 500'
 2. show min 10' private DE on all proposed SD and show on plat.

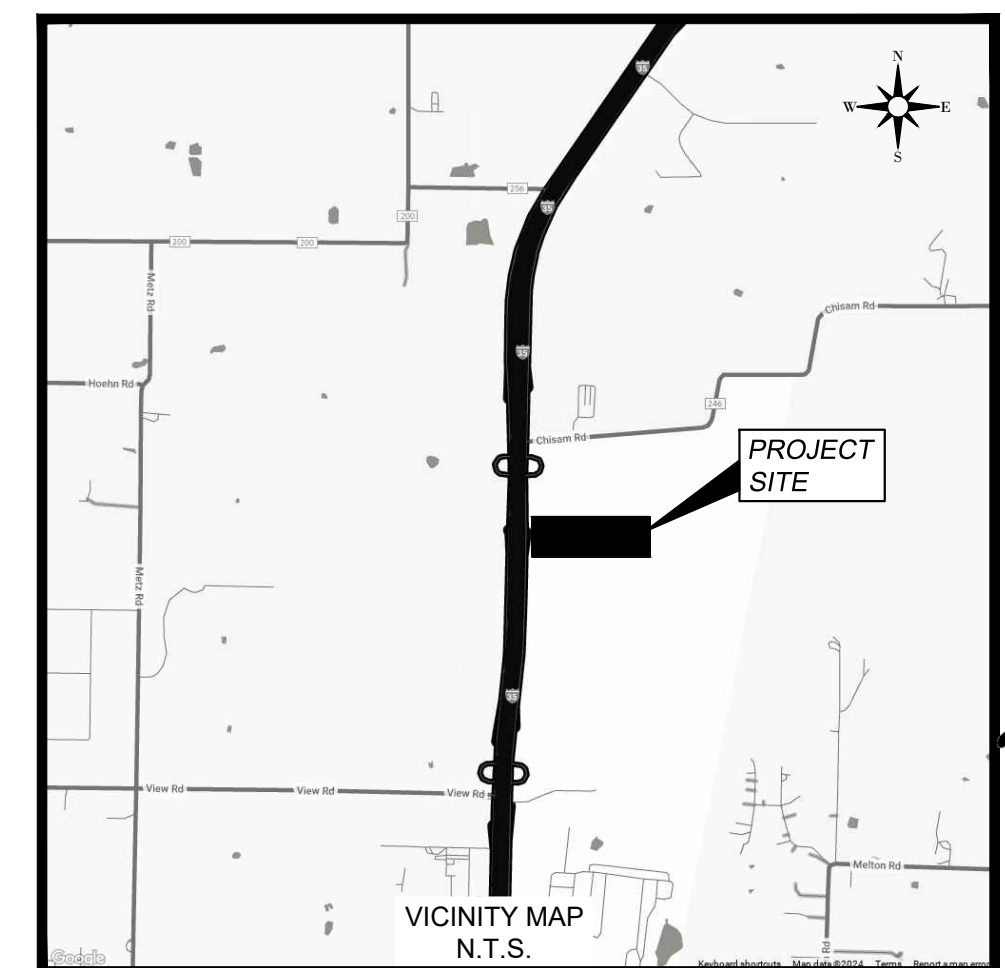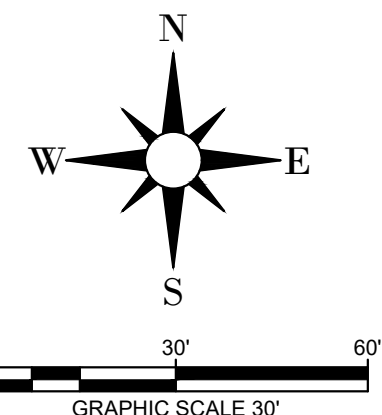

LEGEND

	PROPERTY LINE
	PROPOSED STORM LINE
	PROPOSED SANITARY SEWER LINE
	PROPOSED WATER LINE
	EXISTING STORM LINE
	EXISTING OVERHEAD ELECTRIC
	EXISTING WATER LINE
	EXISTING SEWER LINE
	PROPOSED SANITARY SEWER MANHOLE (SS MH)
	PROPOSED FIRE HYDRANT (FH)
	PROPOSED FIRE DEPARTMENT CONNECTION (FDC)
	EXISTING FIRE HYDRANT
	EXISTING STORM MANHOLE
	EXISTING SAN. SWR. MANHOLE

STORM DRAINAGE NOTES:

- THE CONTRACTOR IS SPECIFICALLY CAUTIONED THAT THE LOCATION AND/OR ELEVATION OF EXISTING UTILITIES AS SHOWN ON THESE PLANS IS BASED ON RECORDS OF THE VARIOUS UTILITY COMPANIES, AND WHERE POSSIBLE, MEASUREMENTS TAKEN IN THE FIELD. THE INFORMATION IS NOT TO BE RELIED ON AS BEING EXACT OR COMPLETE. THE CONTRACTOR MUST CALL THE APPROPRIATE UTILITY COMPANIES AT LEAST 72 HOURS BEFORE ANY EXCAVATION TO REQUEST EXACT FIELD LOCATION OF UTILITIES.
- CONTRACTOR SHALL FIELD VERIFY THE EXACT HORIZONTAL AND VERTICAL LOCATIONS OF ALL EXISTING UTILITIES IN FIELD PRIOR TO COMMENCING CONSTRUCTION. NOTIFY ENGINEER IMMEDIATELY OF ANY DISCREPANCIES.
- STORM PIPE SHALL BE AS FOLLOWS UNLESS OTHERWISE NOTED:
 A) RCP - ASTM C78 CLASS III - REQUIRED IN PUBLIC RIGHT OF WAY AND AT CONNECTION POINTS TO PUBLIC STORM SEWER.
 B) HDPE - AASHTO M252 TYPE S, M294 TYPE S ASTM F 2306 SMOOTH WALL
- ALL EXISTING AND PROPOSED PIPES AND STRUCTURES ARE TO BE RECORDED BY THE CONTRACTOR FOR AREAS OUTSIDE THE PLATTED BOUNDARY A PRIVATE DE BY SEPARATE INSTRUMENT MUST BE RECORDED. DE SHOULD INCLUDE ANY ENERGY DISSIPATION (RIP RAP) AND EXTEND MIN 25' BEYOND THE RIP RAP.
- ALL STORM STRUCTURES SHALL HAVE A SMOOTH UNIFORM POURED MORTAR INVERT FROM INVERT IN TO INVERT OUT.

water out of the inlet per calcs. Confirm this surcharge does not overflow to adjacent lot. else revise SD to remove surcharge. the surcharge here appears significant and could impact the southern parcel. please review carefully.

1. recommend adding a junction/manhole for access at least every 500'
 2. show min 10' private DE on all proposed SD and show on plat.

Upsize laterals to minimum 21inch for 10 ft curb inlets

BUILDING 'L'
 290,940 S.F.
 165 CAR SPACES
 62 TRUCK SPACES

PROJECT NAME:
BLUE STAR INDUSTRIAL BLDG. L SANGER, TEXAS

SHEET TITLE:
STORM PLAN

ACE PROJECT:
01101

DATE
DECEMBER 2024

SCALE
AS SHOWN

DRAWN BY:
MD


SHEET NUMBER
C-5.02

PROFESSIONAL ENGINEER
 MICHAEL T. DOGGETT
 98628
 12/17/2024

ANIMAS CIVIL ENGINEERING
 © 2024 ANIMAS CIVIL ENGINEERING, LLC
 PHONE: 214-803-1099
 TX F-26500


NO.	REVISIONS	DATE	BY

SD LINE A

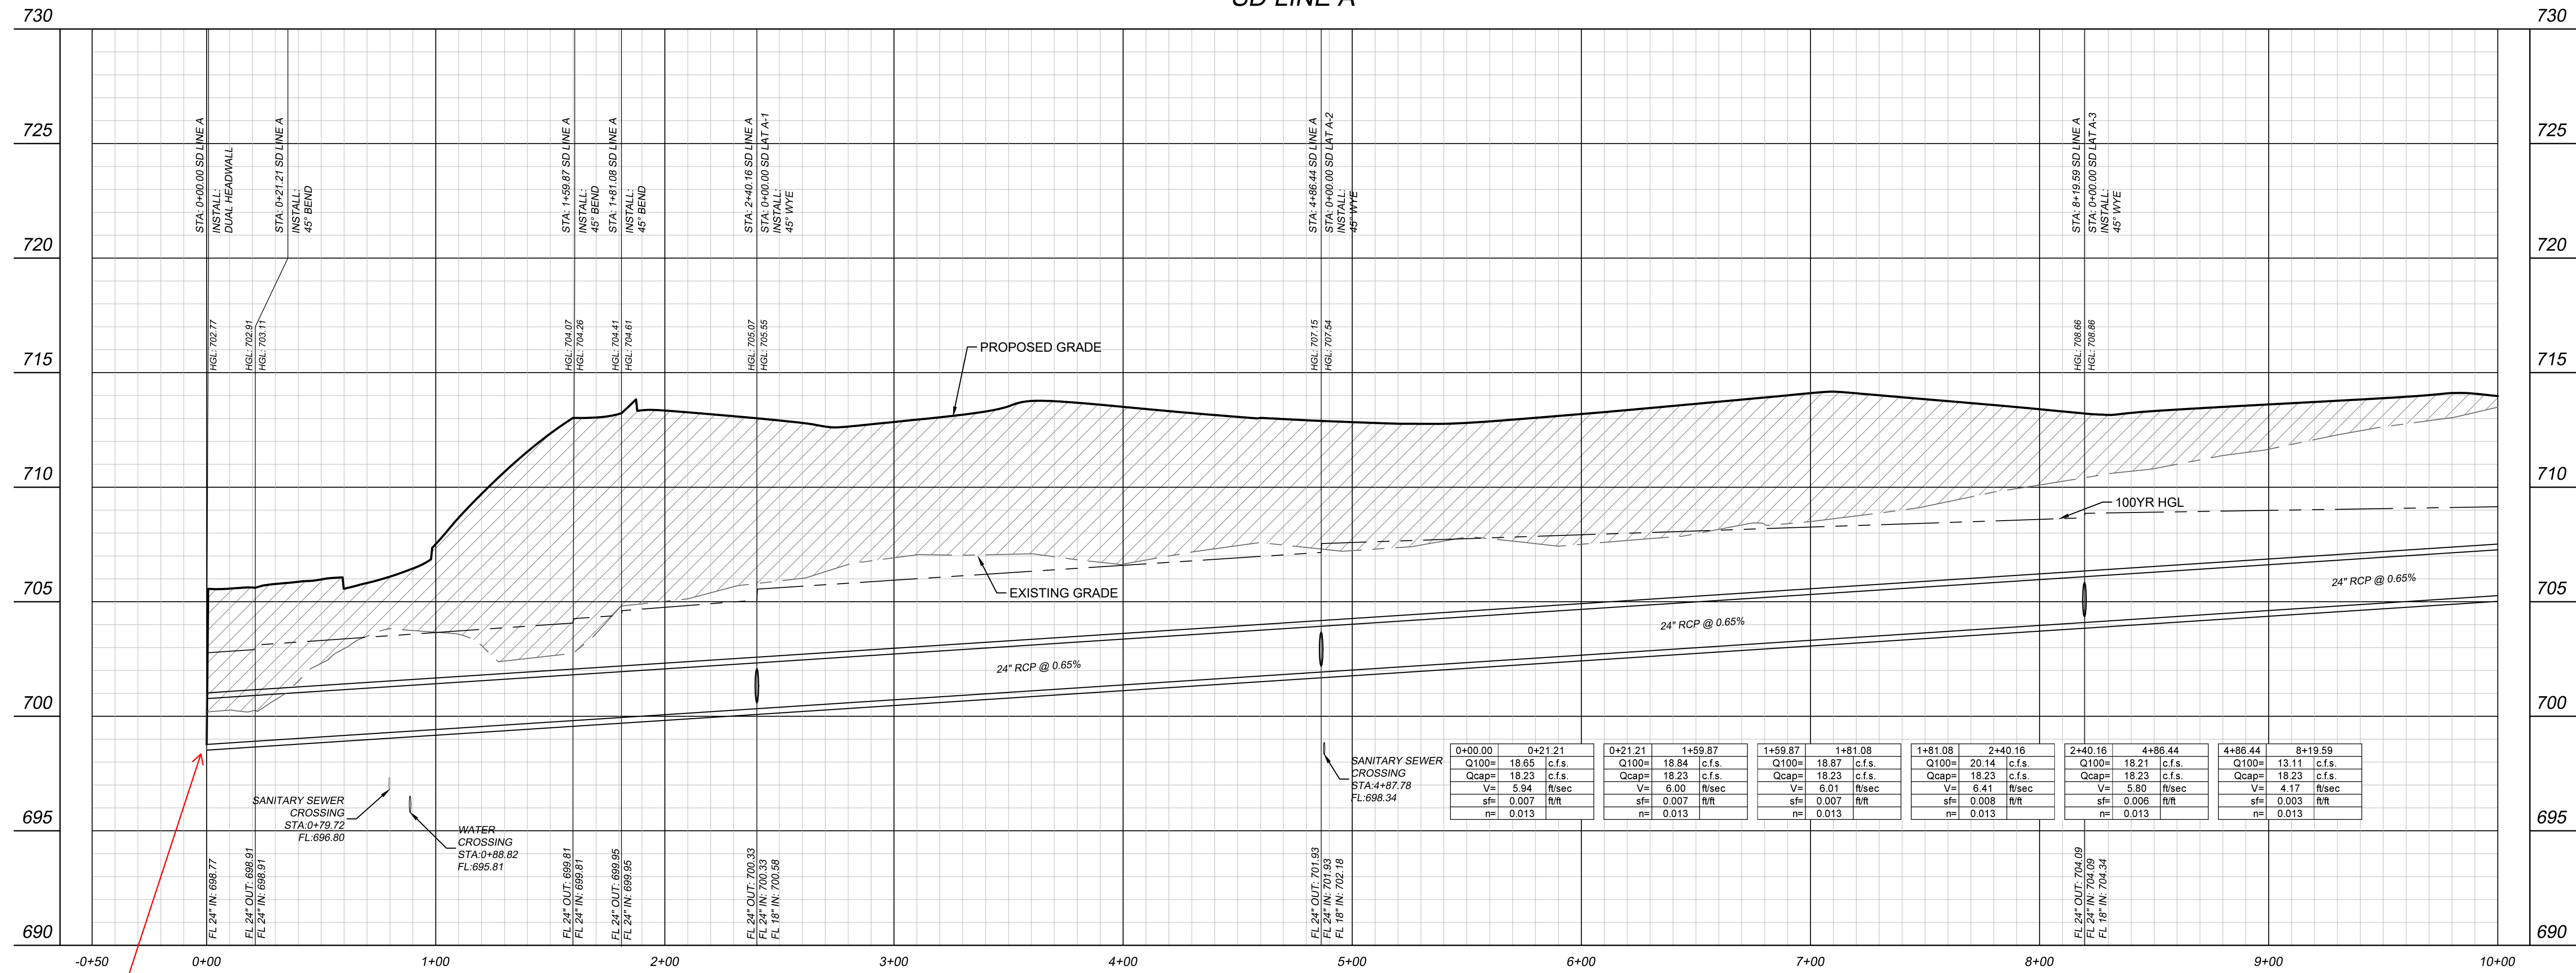

1. show headwall and energy dissipation (rip rap)
2. provide rip rap calcs to support apron length, width, and thickness
3. note the source of the stating water surface elevation
4. label separation distances between SD and SS/W - all crossings

SD LINE A

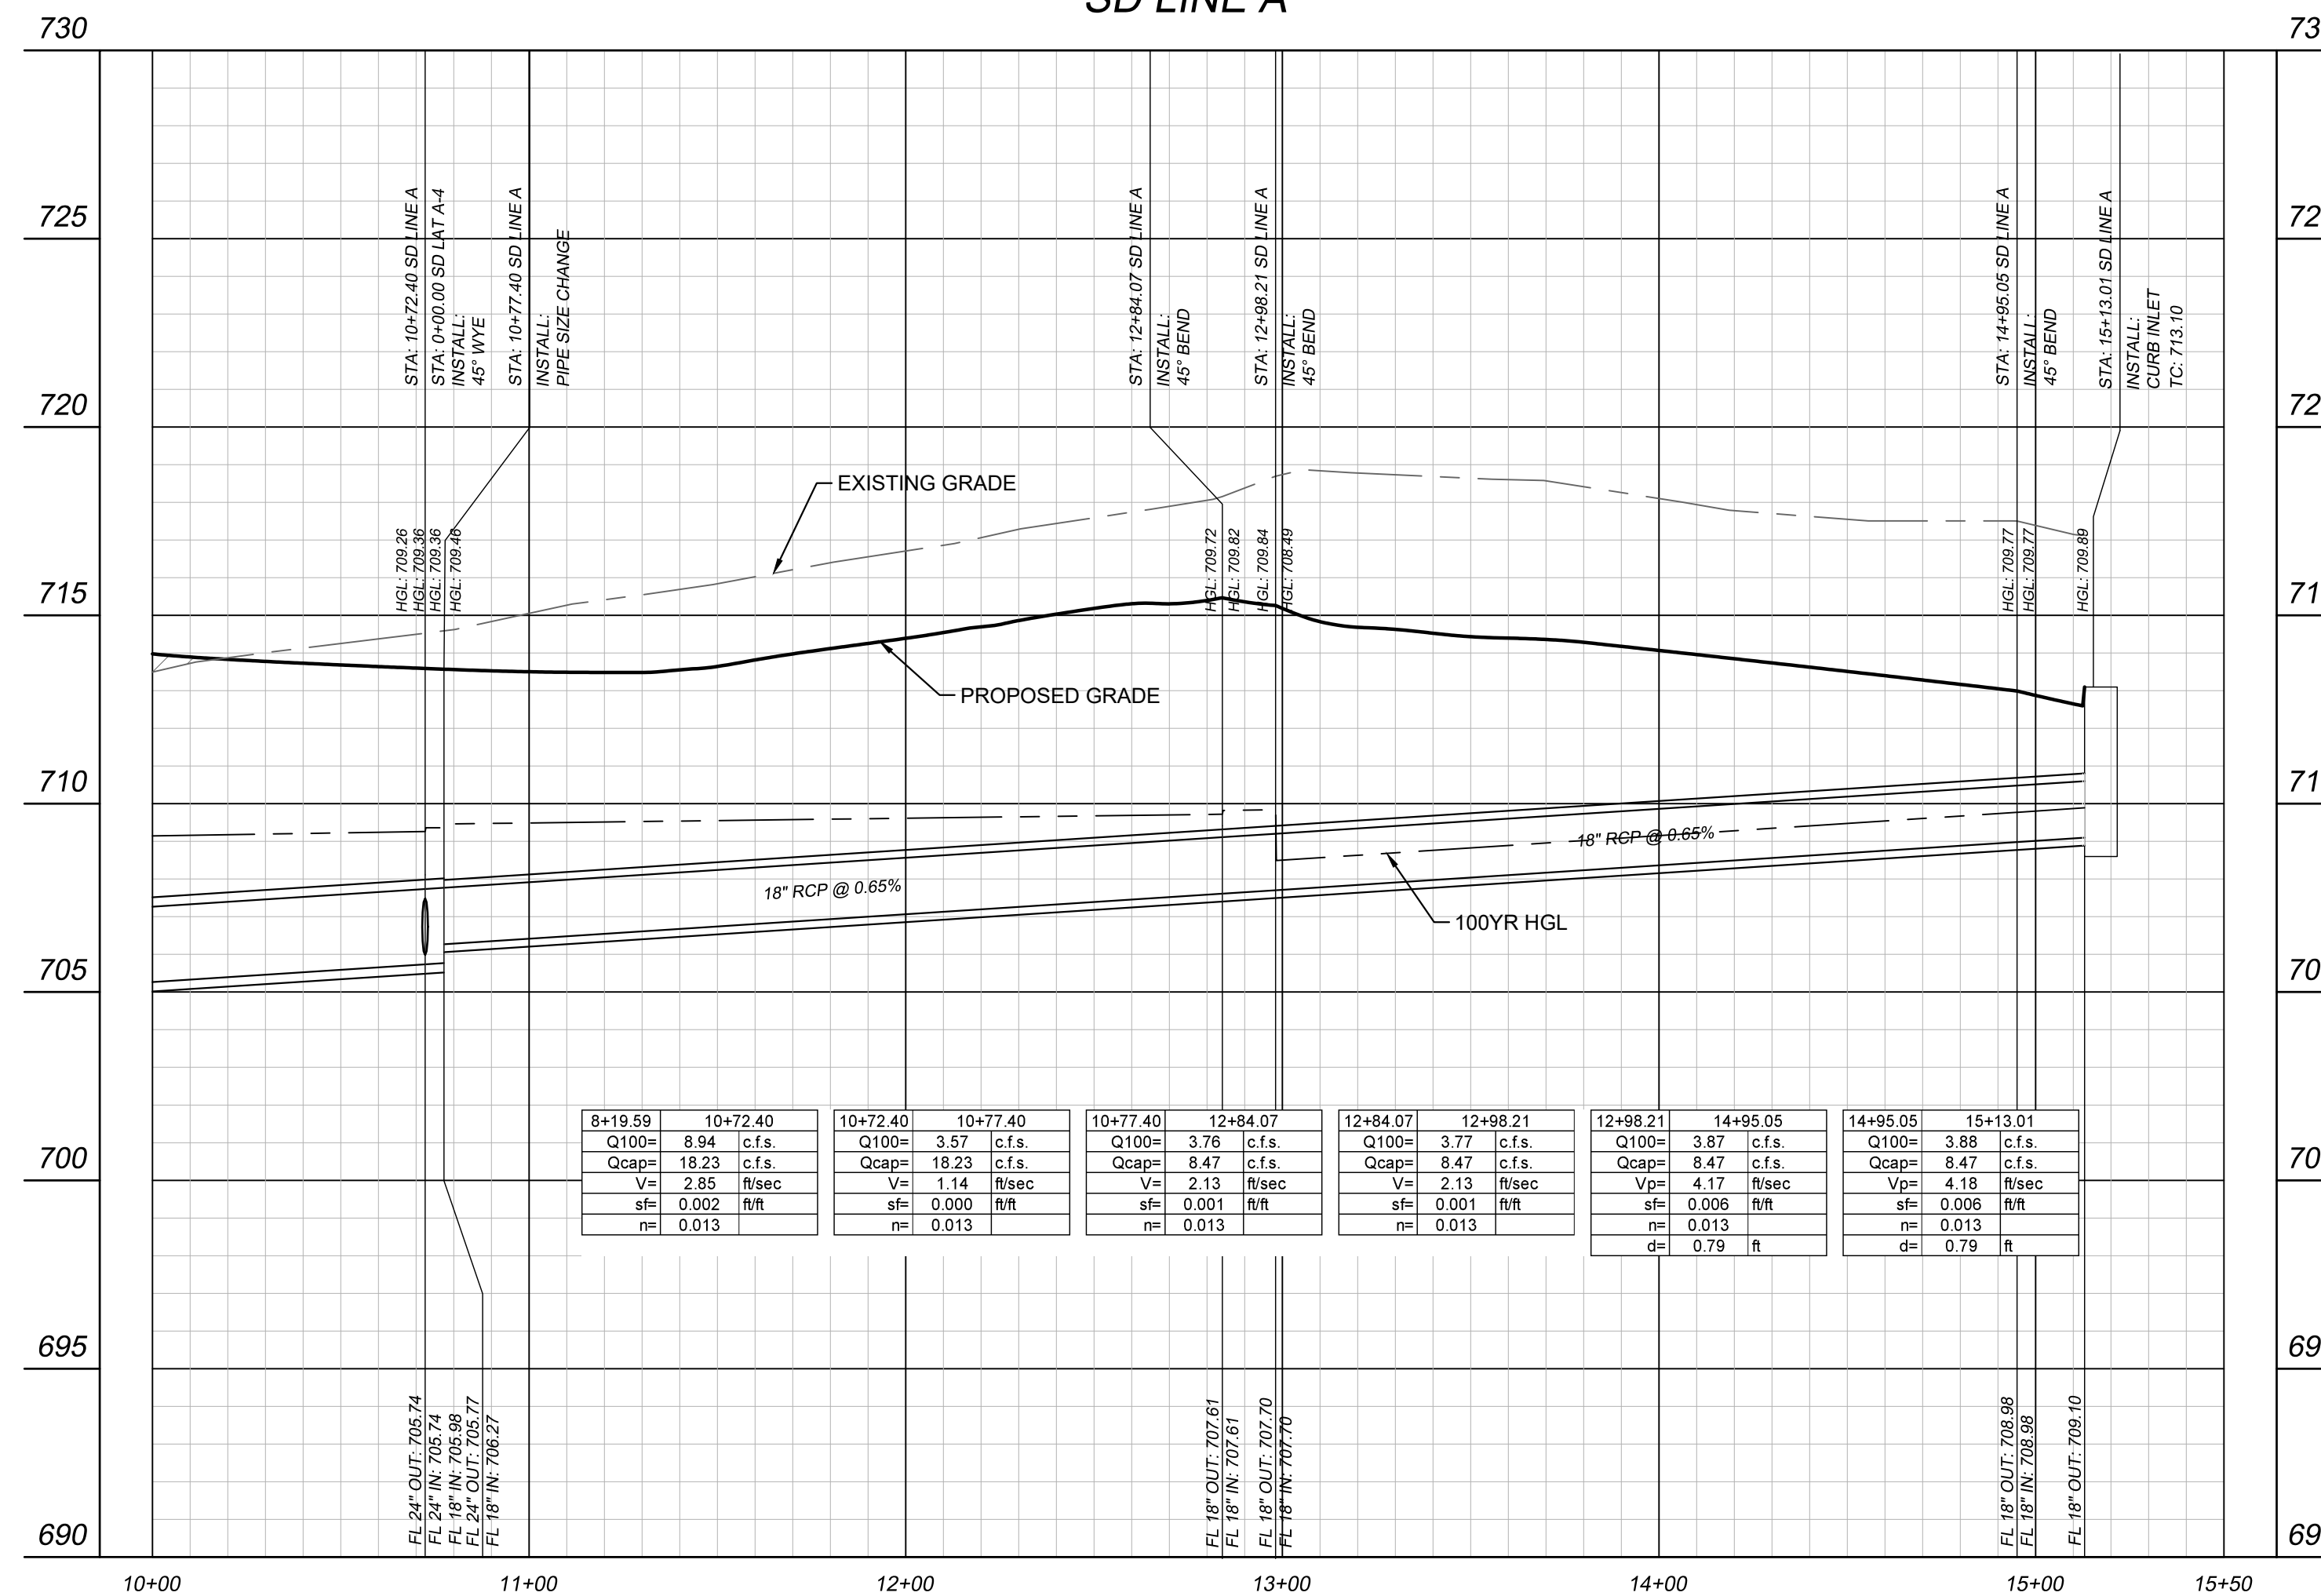

PROFILE SCALE
1"=40' HORIZONTAL
1" = 4' VERTICAL

NO.	REVISIONS	DATE	BY

ANIMAS
CIVIL ENGINEERING

© 2024 ANIMAS CIVIL ENGINEERING, LLC
PHONE: 214-803-1099
TX F-26500

PROJECT NAME:
BLUE STAR INDUSTRIAL BLDG. L SANGER, TEXAS

SHEET TITLE:
STORM PROFILES


ACE PROJECT:
01101

DATE
DECEMBER 2024

SCALE
AS SHOWN


DRAWN BY:
MD

SHEET NUMBER
C-5.03

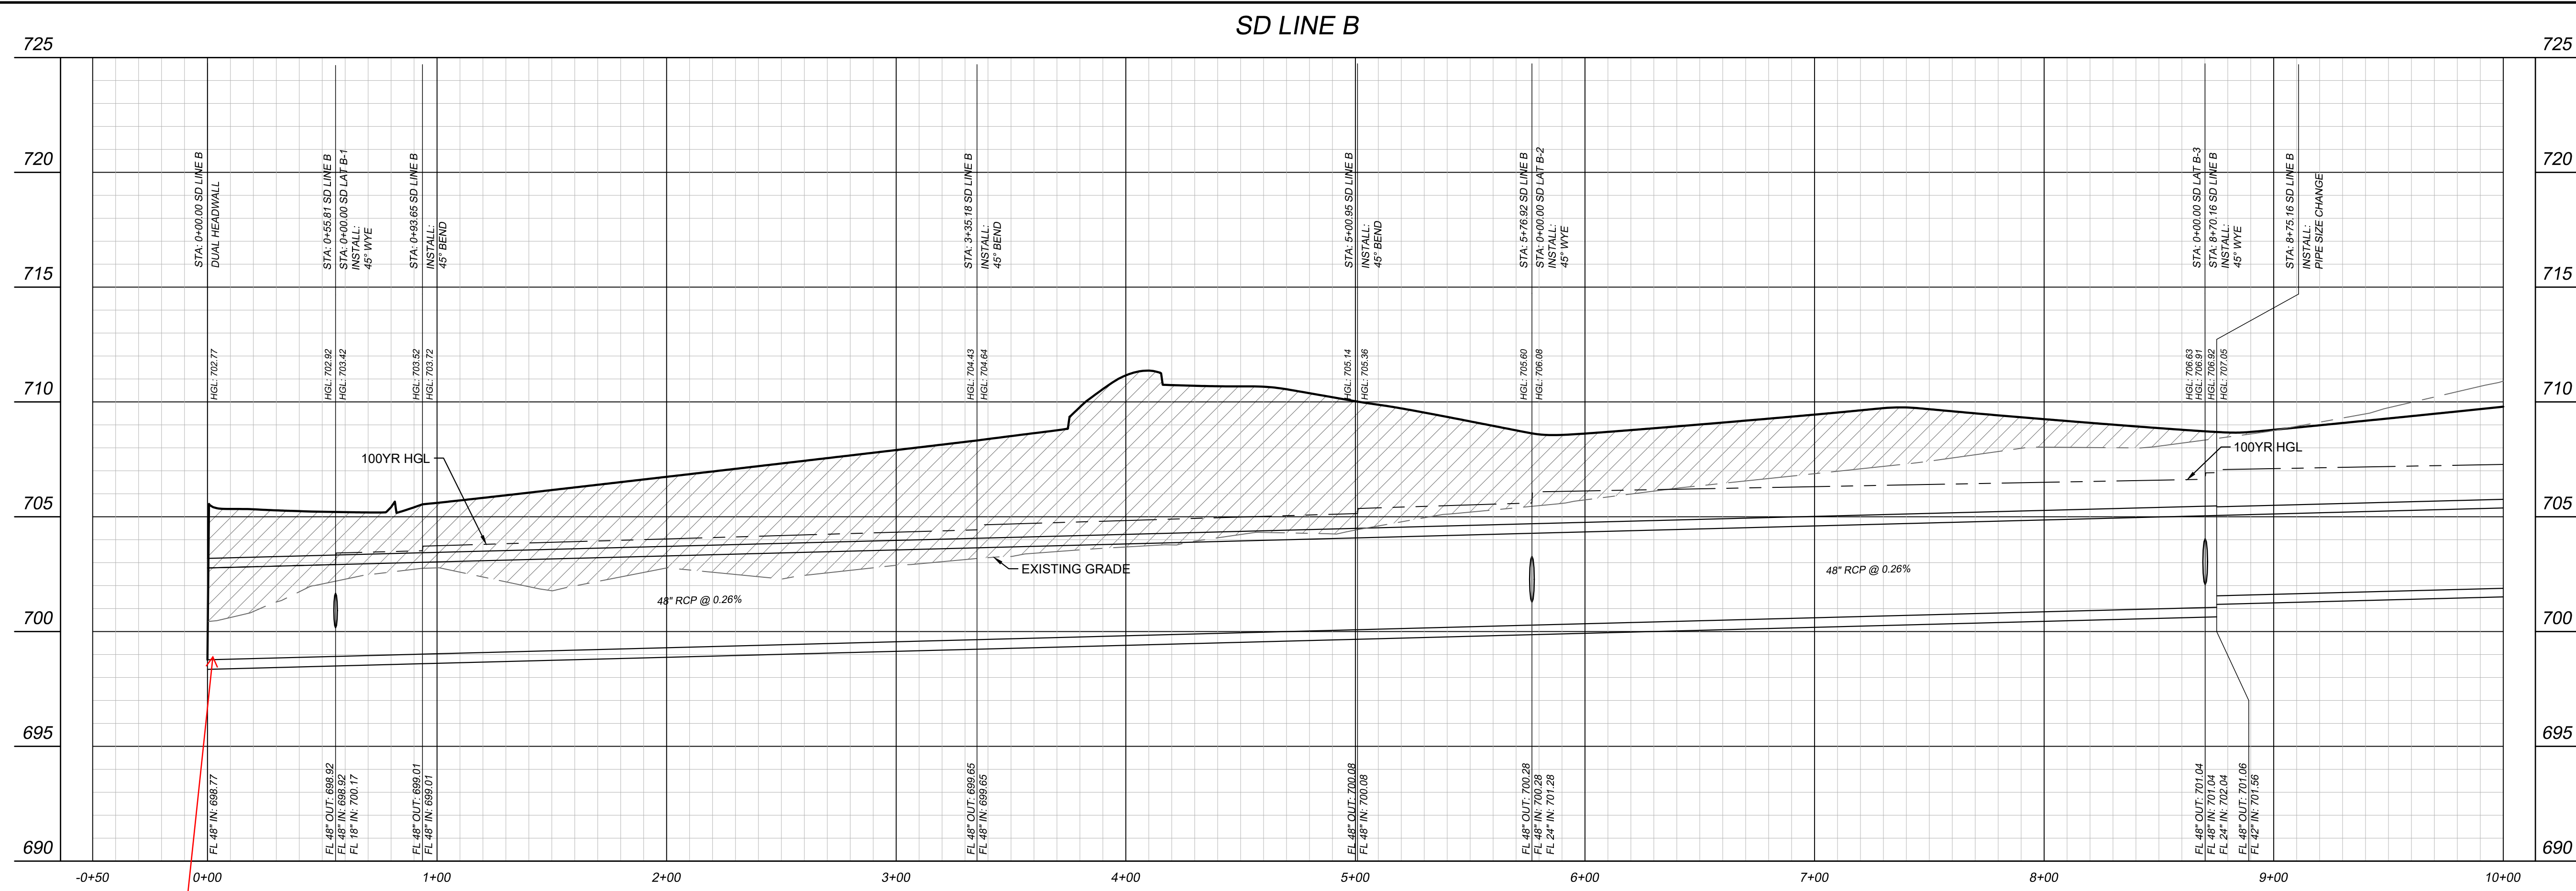

0+00.00	0+55.81	0+93.65	3+35.18	5+00.95	5+00.95	5+76.92	8+70.16	8+75.16
Q100= 82.42 c.f.s.	Q100= 76.35 c.f.s.	Q100= 77.80 c.f.s.	Q100= 77.80 c.f.s.	Q100= 78.93 c.f.s.	Q100= 81.19 c.f.s.	Q100= 81.19 c.f.s.	Q100= 61.89 c.f.s.	Q100= 41.43 c.f.s.
Qcap= 73.42 c.f.s.	Qcap= 73.42 c.f.s.	Qcap= 73.42 c.f.s.	Qcap= 73.42 c.f.s.	Qcap= 73.42 c.f.s.	Qcap= 73.42 c.f.s.	Qcap= 73.42 c.f.s.	Qcap= 73.42 c.f.s.	Qcap= 73.42 c.f.s.
V= 6.56 ft/sec	V= 6.08 ft/sec	V= 6.19 ft/sec	V= 6.19 ft/sec	V= 6.27 ft/sec	V= 6.46 ft/sec	V= 6.46 ft/sec	V= 4.93 ft/sec	V= 3.30 ft/sec
sf= 0.003 ft/R	sf= 0.003 ft/R	sf= 0.003 ft/R	sf= 0.003 ft/R	sf= 0.003 ft/R	sf= 0.003 ft/R	sf= 0.003 ft/R	sf= 0.002 ft/R	sf= 0.001 ft/R
n= 0.013	n= 0.013	n= 0.013	n= 0.013	n= 0.013	n= 0.013	n= 0.013	n= 0.013	n= 0.013
d= 4.50 ft	d= 4.50 ft	d= 4.50 ft	d= 4.50 ft	d= 4.50 ft	d= 4.50 ft	d= 4.50 ft	d= 4.50 ft	d= 4.50 ft

- show headwall and energy dissipation (rip rap)
- provide rip rap calcs to support apron length, width, and thickness
- note the source of the stating water surface elevation
- label separation distances between SD and SS/W - all crossings

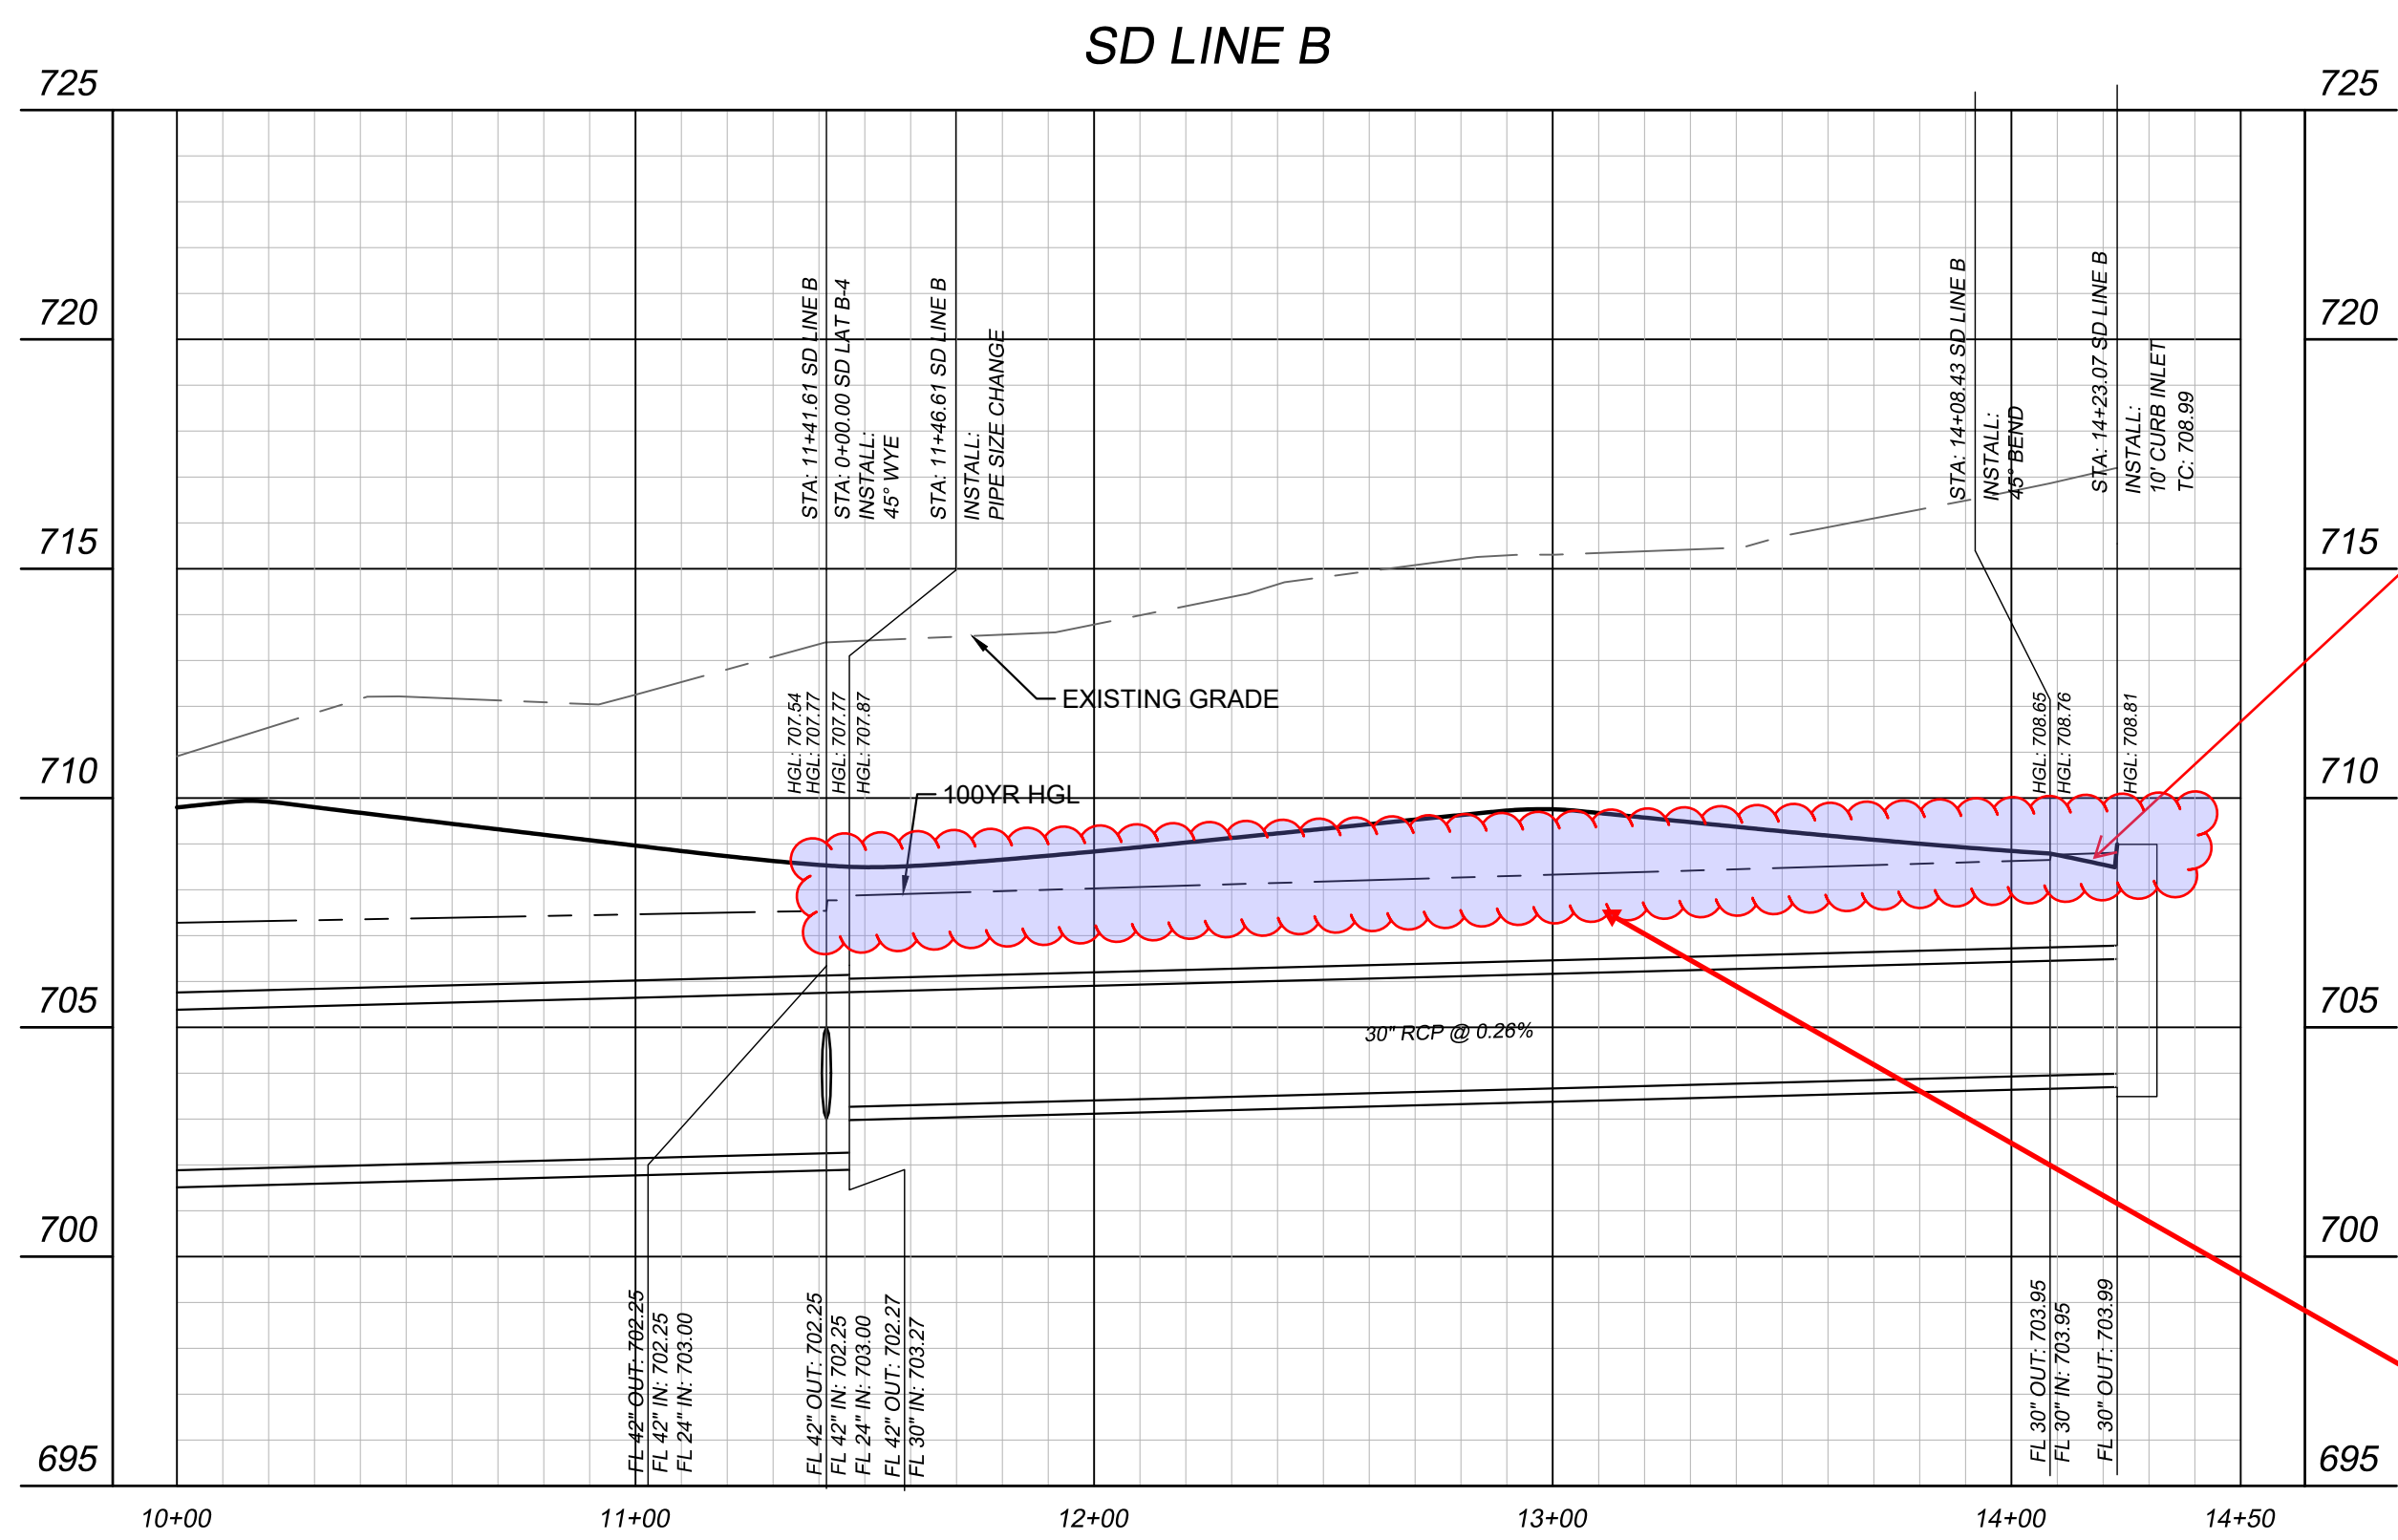

8+75.16	11+41.61	11+41.61	11+46.61	11+46.61	14+08.43	14+23.07
Q100= 42.81 c.f.s.	Q100= 21.67 c.f.s.	Q100= 22.38 c.f.s.	Q100= 22.38 c.f.s.	Q100= 22.42 c.f.s.	Q100= 20.97 c.f.s.	Q100= 20.97 c.f.s.
Qcap= 51.43 c.f.s.	Qcap= 51.43 c.f.s.	Qcap= 51.43 c.f.s.	Qcap= 51.43 c.f.s.	Qcap= 51.43 c.f.s.	Qcap= 20.97 c.f.s.	Qcap= 20.97 c.f.s.
V= 4.45 ft/sec	V= 2.25 ft/sec	V= 2.25 ft/sec	V= 2.25 ft/sec	V= 4.56 ft/sec	V= 4.57 ft/sec	V= 4.57 ft/sec
sf= 0.002 ft/R	sf= 0.000 ft/R	sf= 0.000 ft/R	sf= 0.000 ft/R	sf= 0.003 ft/R	sf= 0.003 ft/R	sf= 0.003 ft/R
n= 0.013	n= 0.013	n= 0.013	n= 0.013	n= 0.013	n= 0.013	n= 0.013

water out of the inlet?
Confirm this surcharge does not overflow to adjacent lot

The hydraulic grade line shall in no case be closer to the surface of the ground or street than one (1) foot per § 10.106(d)(6)(D)(ii). Please review and revise.

PROFILE SCALE
1"=40' HORIZONTAL
1"= 4' VERTICAL

NO.	REVISIONS	DATE	BY

ANIMAS
CIVIL ENGINEERING
© 2024 ANIMAS CIVIL ENGINEERING, LLC
PHONE: 214-803-1099
TX F-26500

PROJECT NAME:
BLUE STAR INDUSTRIAL BLDG. L SANGER, TEXAS

SHEET TITLE:
STORM PROFILES









ACE PROJECT:
01101

DATE
DECEMBER 2024

SCALE
AS SHOWN

DRAWN BY:
MD

SHEET NUMBER
C-5.04

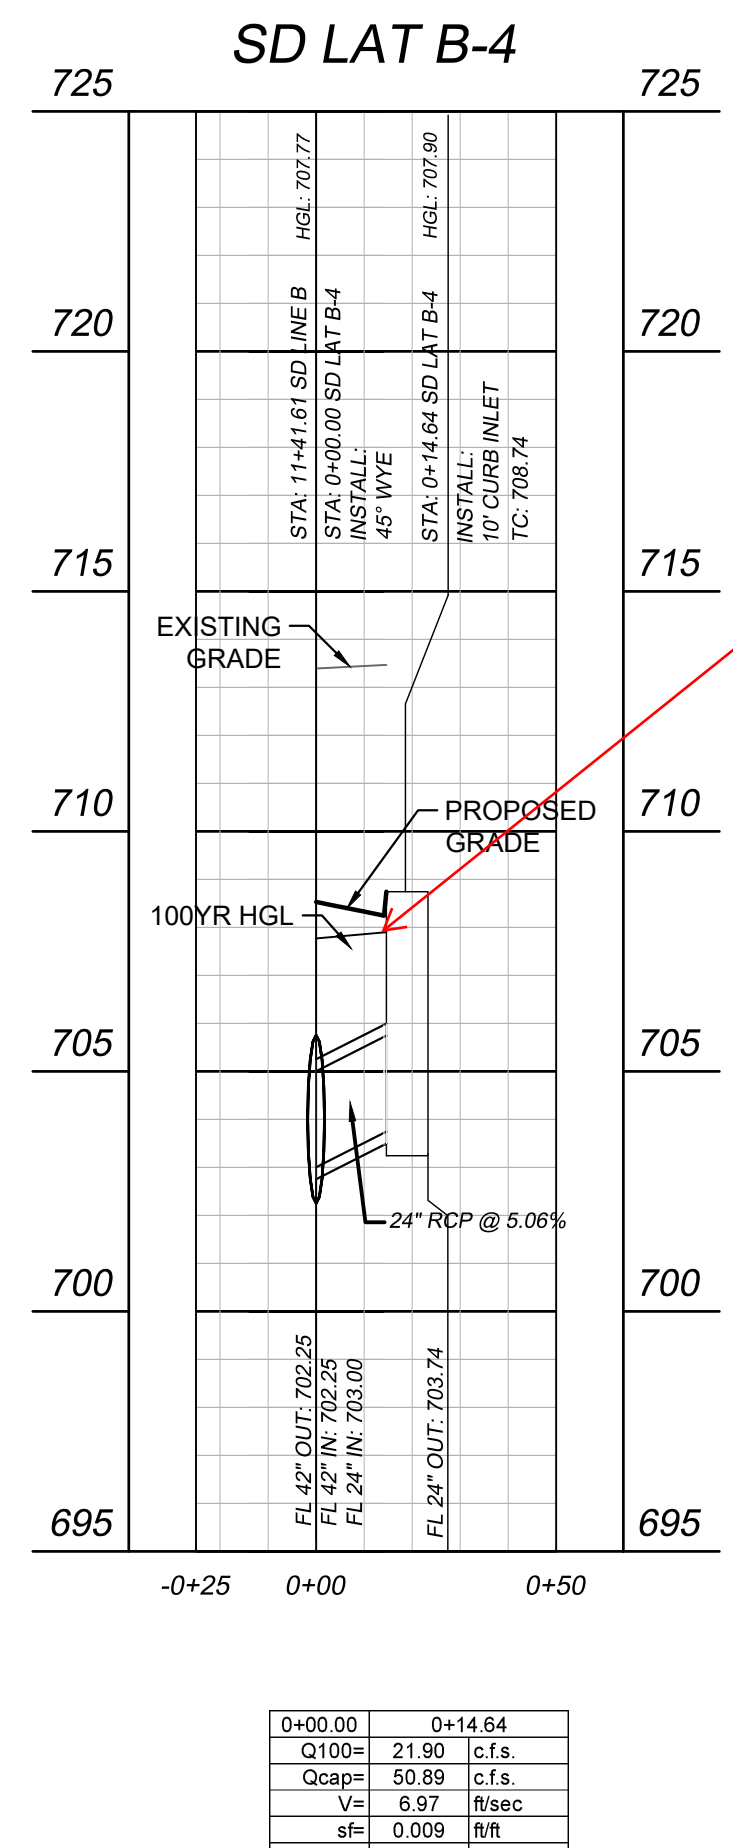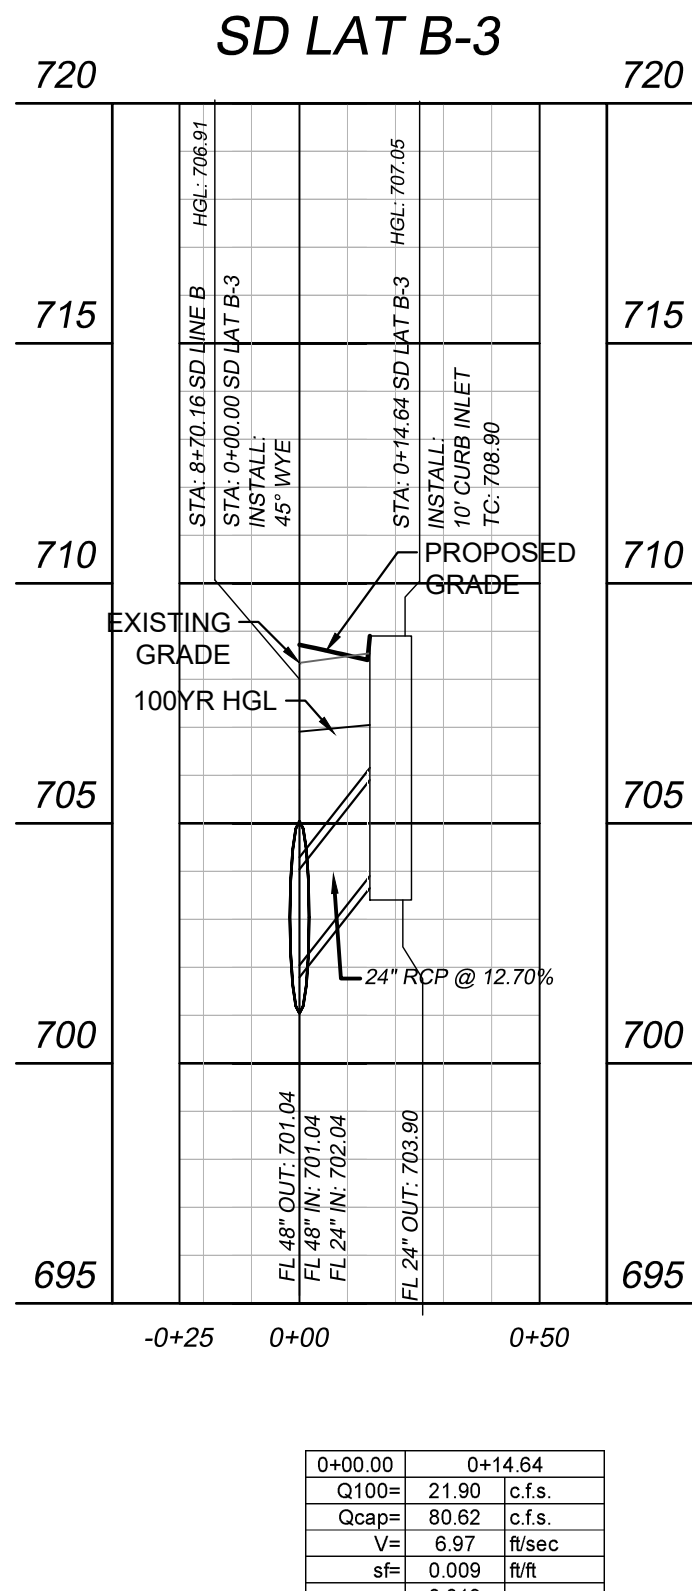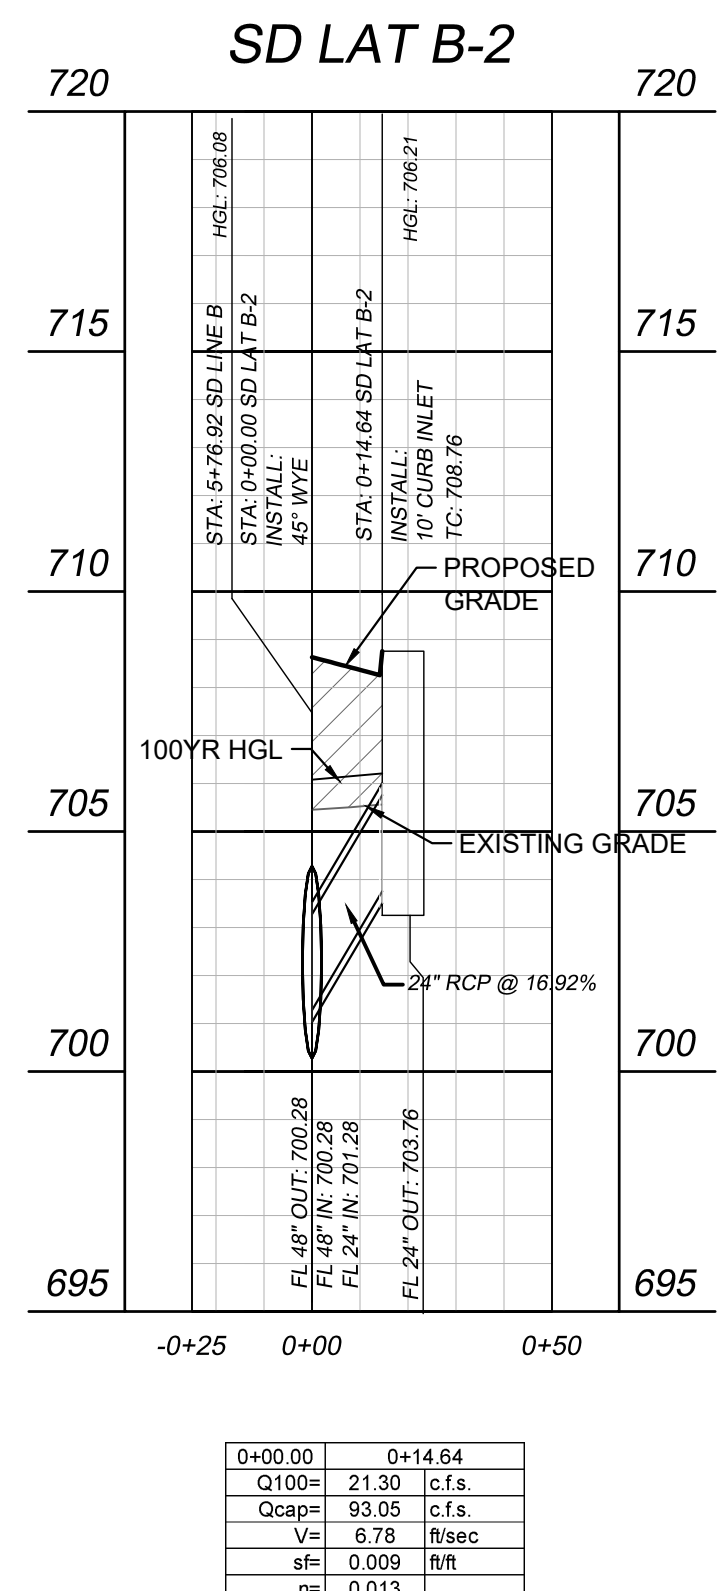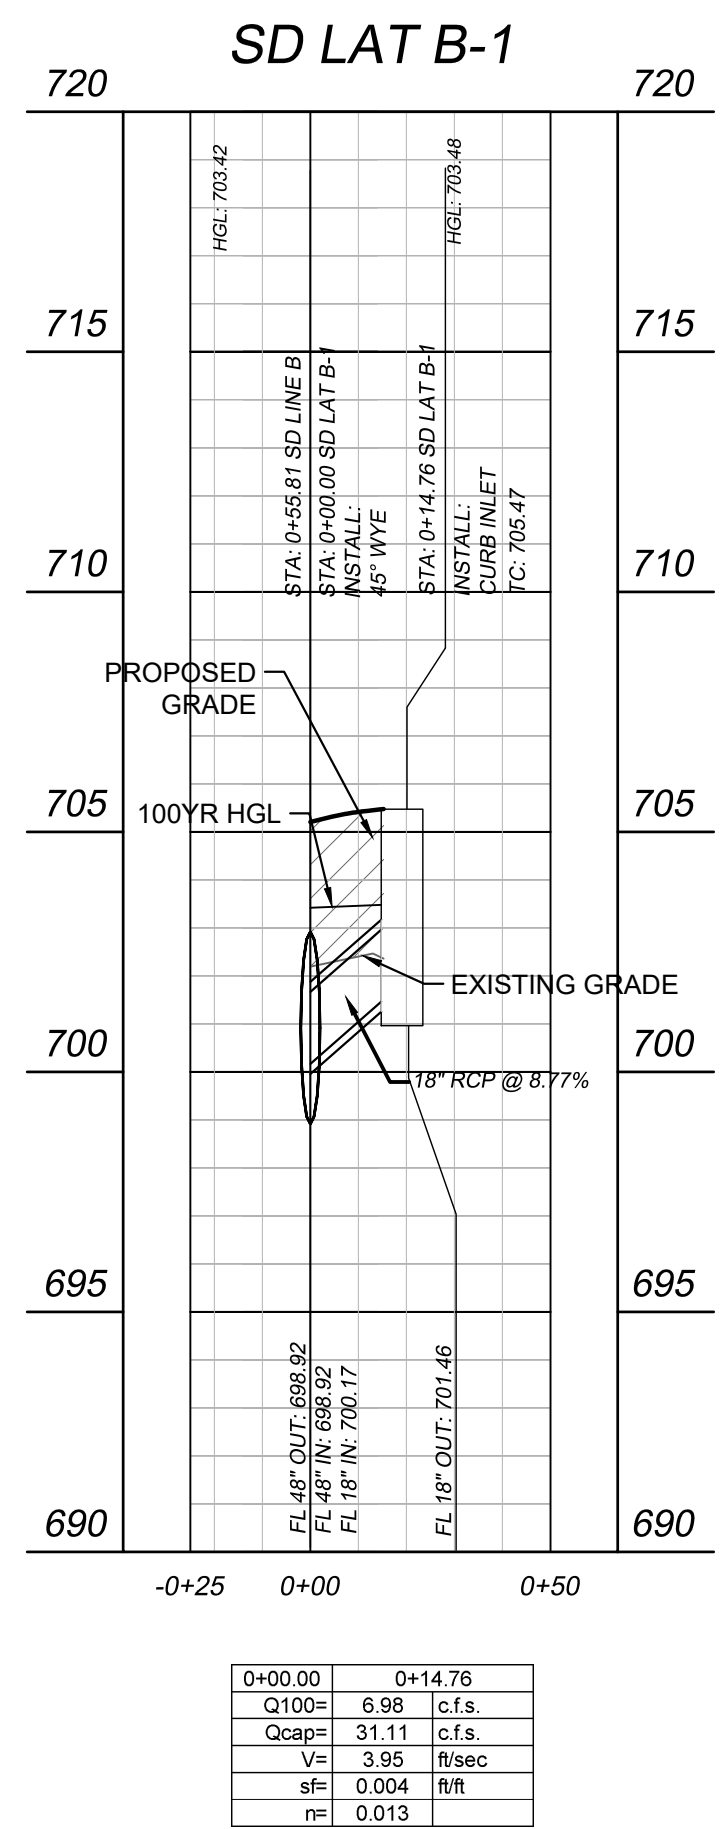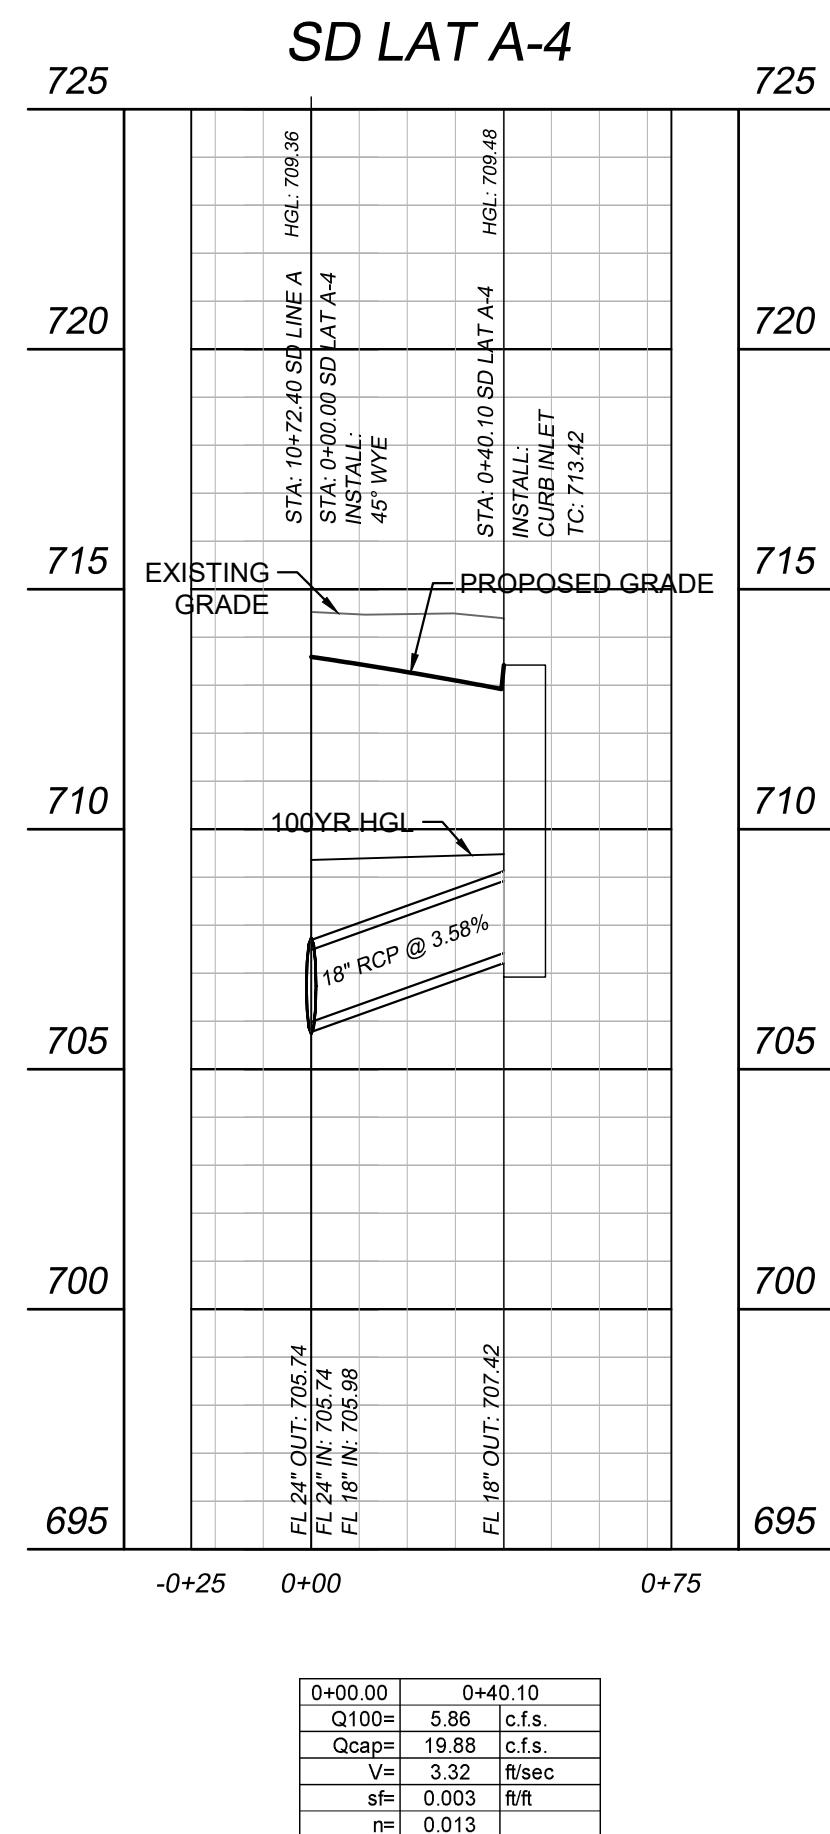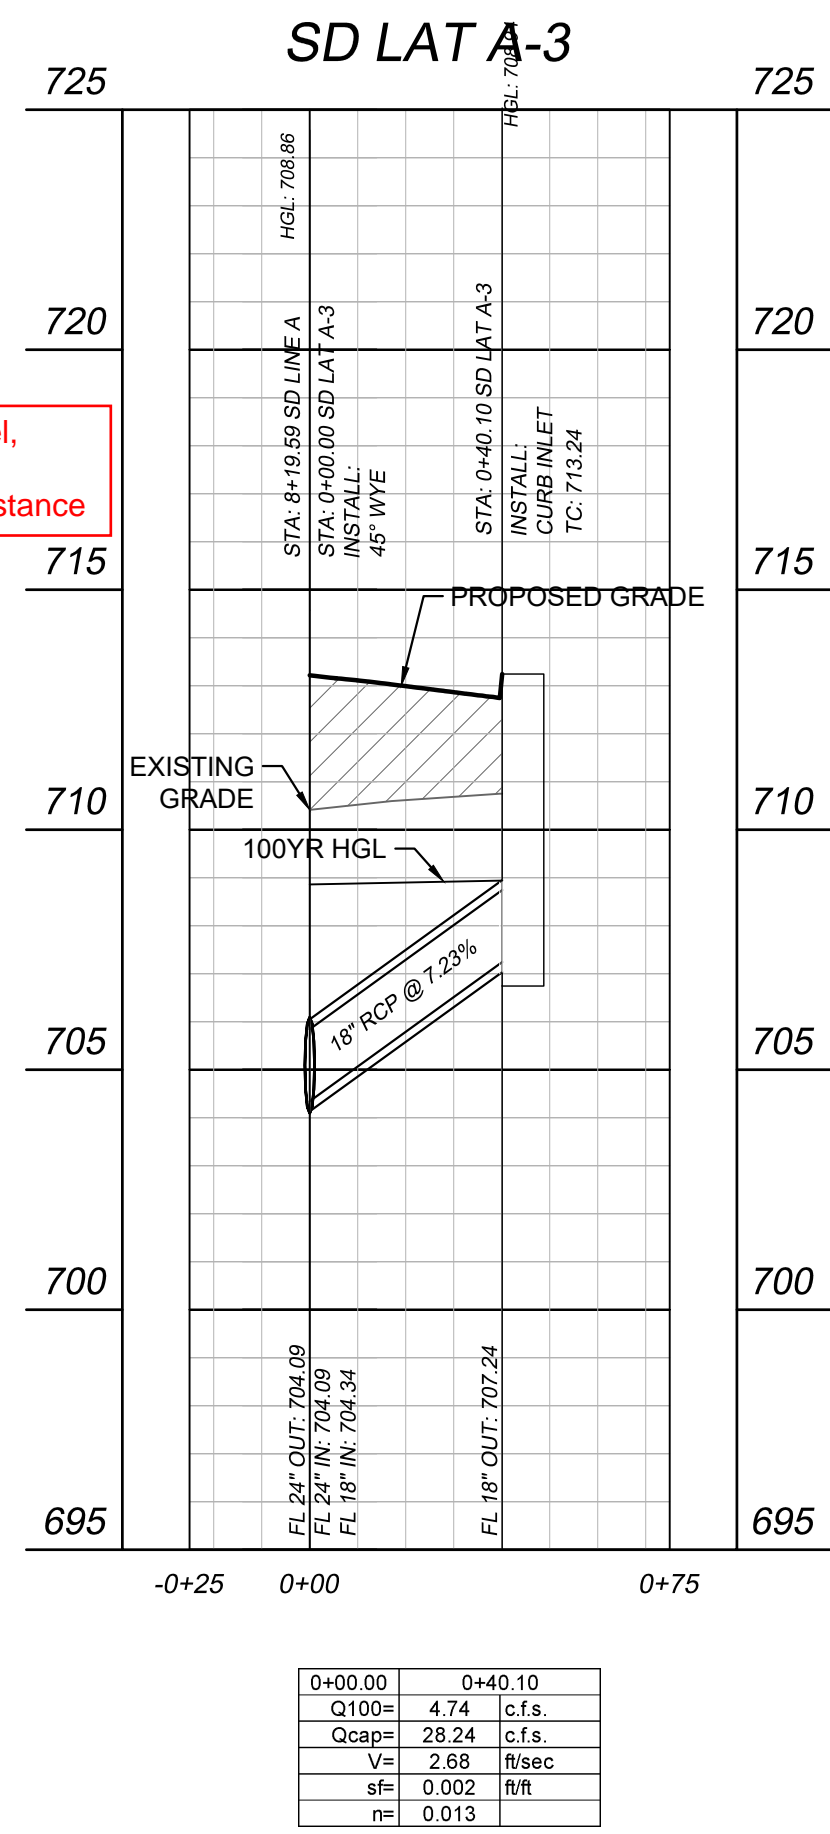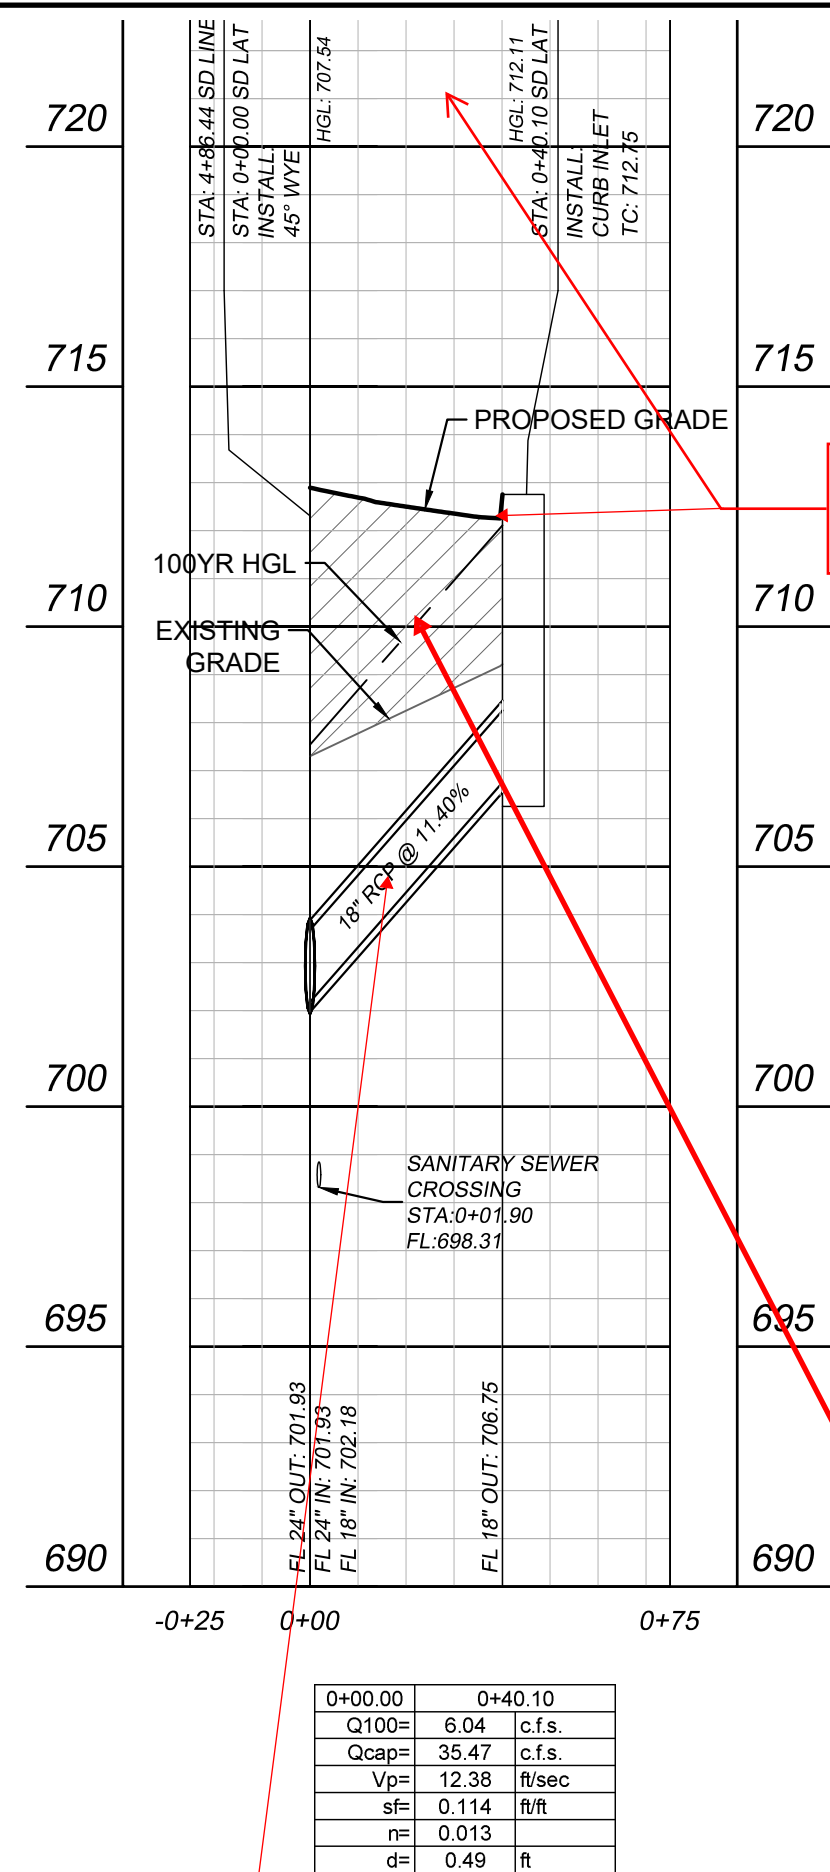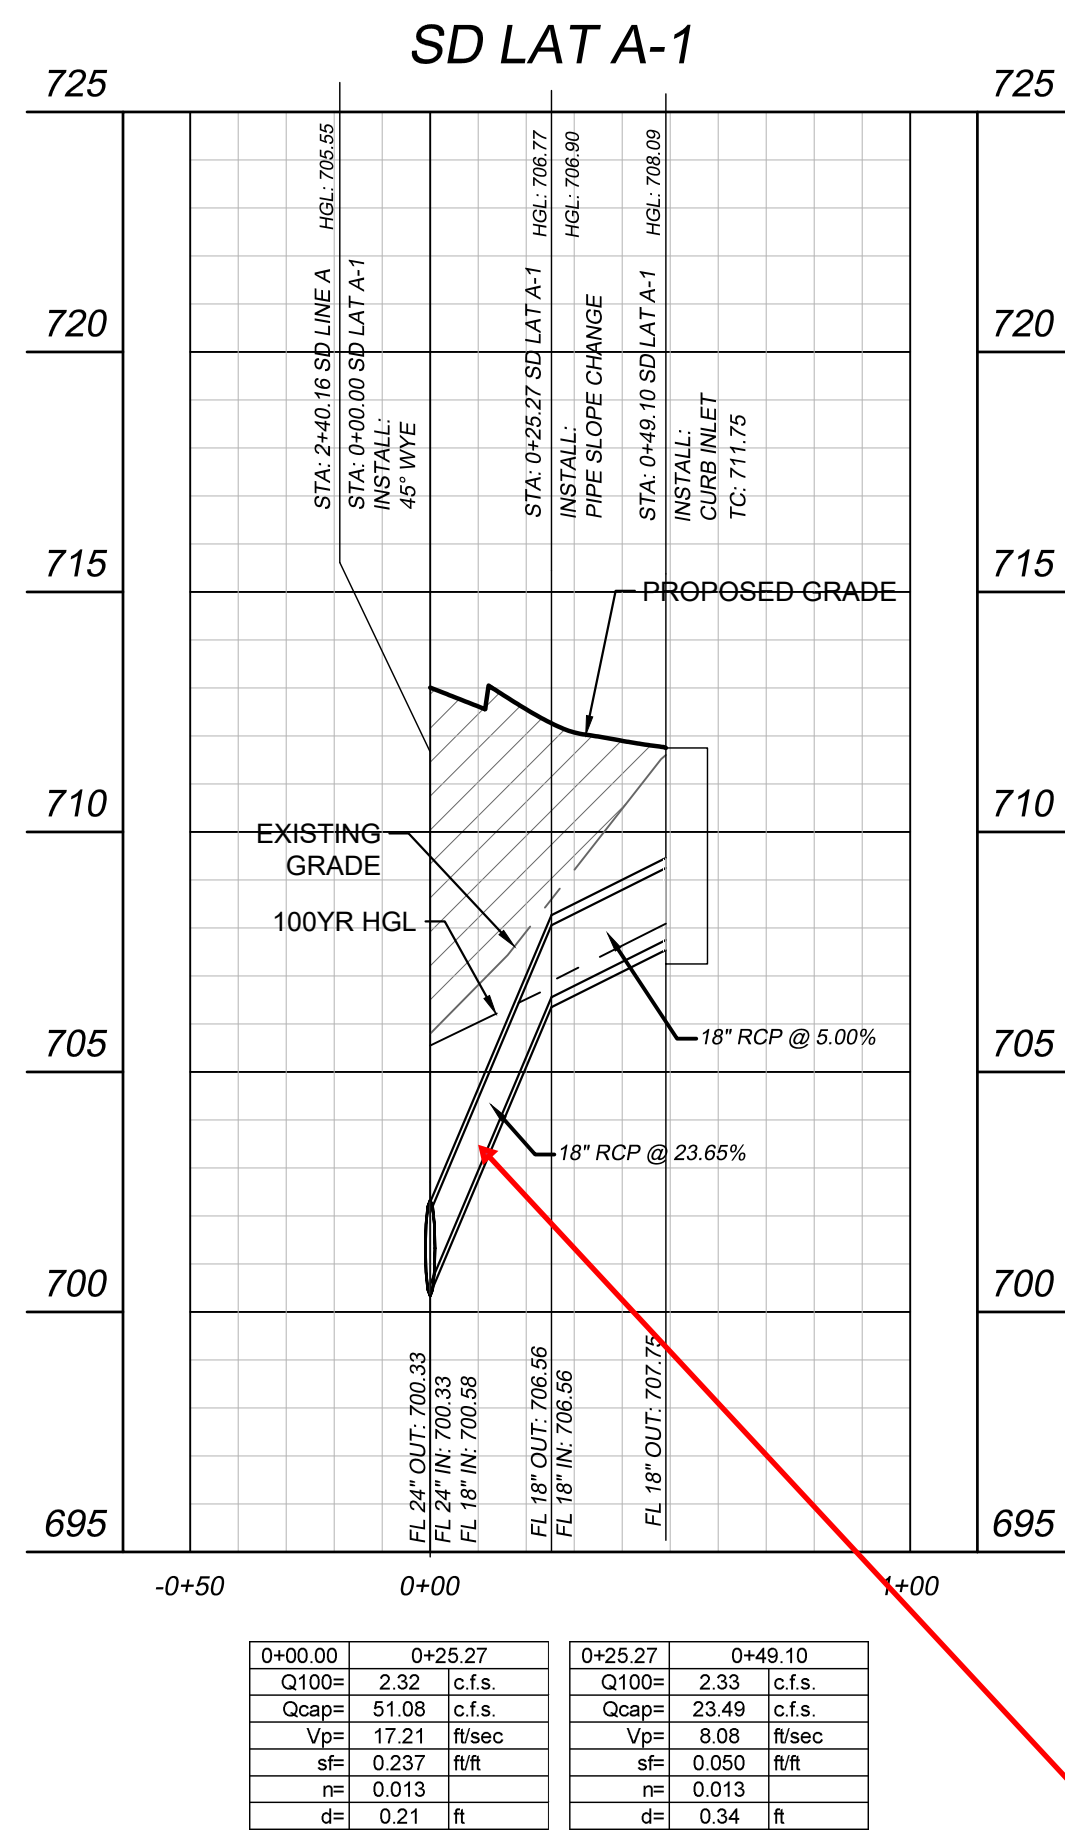

Recommend deepening inlet slightly to reduce slopes and velocity to under 12fps

The hydraulic grade line shall in no case be closer to the surface of the ground or street than one (1) foot per § 10.106(d)(6)(D)(ii). Please review and revise.

hgl not consistent with calcs, please review/revise.


PROFILE SCALE
1"=40' HORIZONTAL
1" = 4' VERTICAL

NO.	REVISIONS	DATE	BY
© 2024 ANIMAS CIVIL ENGINEERING, LLC PHONE: 214-803-1099 TX F-26500			
PROJECT NAME: BLUE STAR INDUSTRIAL BLDG. L SANGER, TEXAS			
SHEET TITLE: STORM PROFILES			
ACE PROJECT: 01101			
DATE DECEMBER 2024			
SCALE AS SHOWN			
DRAWN BY: MD			
SHEET NUMBER C-5.05			

STORM DRAIN HYDRAULIC CALCULATIONS TABLE

FROM	TO	PIPE LENGTH feet	DRAINAGE AREA			RUNOFF COEFF. "C"	INCR- MENTAL "CA"	TOTAL "CA"	TIME OF CONCENTRATION			5-YEAR INTENSITY (IN/HR)	100-YEAR INTENSITY (IN/HR)	Q5 RUNOFF (CFS)	Q100 RUNOFF (CFS)	INLET BYPASS (CFS)	Q PIPE (CFS)	PIPE SIZE (IN)	n	Sf (FT/FT)	HGL						HEADLOSS CALCULATIONS						DESIGN HGL Elev.	INVERT ELEV.		T/C ELEV. (FT)	COMMENTS
			INCREMENTAL NO.	AREA	TOTAL AREA				INLET (MIN)	TRAVEL (MIN)	TOTAL (MIN)										D/S Elev.	U/S Elev.	V1(IN) ft/sec	V2(OUT) ft/sec	V1^2/2g (FT)	V2^2/2g (FT)	Kj	KjV1^2/2G (FT)	Hk	FROM (FT)	TO (FT)						
1	2	3	4	5	6	7	8	9	10	11	12	13	14	15	16	17	18	19	20	21	22	23	24	25	26	27	28	29	30	31	32	33	34				
LINE A																																					
14+95.05	15+13.01	17.96	A5	0.450	0.450	0.90	0.405	0.405	10.00	0.00	10.00	5.71	9.58	2.31	3.88	0.00	3.88	18	0.013	0.0065	709.77	709.89	0.00	4.18	0.00	0.27	1.25	0.00	0.34	710.23	708.98	709.10	713.10	CURB INLET			
12+98.21	14+95.05	196.84		0.450	0.90		0.405	0.405	10.00	0.07	10.07	5.69	9.56	-	-	0.00	3.87	18	0.013	0.0065	708.49	709.77	4.18	4.17	0.27	0.27	0.35	0.09	0.10	709.77	707.70	708.98	712.99	45° BEND			
12+84.07	12+98.21	14.14		0.450	0.90		0.405	0.405	10.00	0.86	10.86	5.53	9.31	-	-	0.00	3.77	18	0.013	0.0013	709.82	709.84	4.17	2.13	0.27	0.07	0.35	0.09	0.10	708.49	707.61	707.70	715.26	45° BEND			
10+77.40	12+84.07	206.67		0.450	0.90		0.405	0.405	10.00	0.97	10.97	5.51	9.27	-	-	0.00	3.76	18	0.013	0.0013	709.46	709.72	2.13	2.13	0.07	0.07	0.35	0.02	0.10	709.82	706.27	707.61	715.47	45° BEND			
10+72.40	10+77.40	5.00		0.450	0.90		0.405	0.405	10.00	2.59	12.59	5.21	8.81	-	-	0.00	3.57	24	0.013	0.0002	709.36	709.36	2.13	1.14	0.07	0.02	0.10	0.01	0.10	709.46	705.74	705.77	713.67	PIPE SIZE CHANGE			
8+19.59	10+72.40	252.81	A4	0.680	1.130	0.90	0.612	1.017	10.00	2.66	12.66	5.20	8.79	3.18	5.38	0.00	8.94	24	0.013	0.0016	708.86	709.26	1.14	2.85	0.02	0.13	0.75	0.02	0.10	709.36	704.09	705.74	713.59	45° WYE, LAT A4			
4+86.44	8+19.59	333.15	A3	0.550	1.680	0.90	0.495	1.512	10.00	4.14	14.14	4.95	8.41	2.45	4.16	0.00	13.11	24	0.013	0.0034	707.54	708.66	2.85	4.17	0.13	0.27	0.75	0.09	0.20	708.86	701.93	704.09	713.22	45° WYE, LAT A3			
2+40.16	4+86.44	246.28	A2	0.700	2.380	0.90	0.630	2.142	10.00	5.47	15.47	4.76	8.10	3.00	5.10	0.00	18.21	24	0.013	0.0065	705.55	707.15	4.17	5.80	0.27	0.52	0.75	0.20	0.39	707.54	700.33	701.93	712.89	45° WYE, LAT A2			
1+81.08	2+40.16	59.08	A1	0.270	2.650	0.90	0.243	2.385	10.00	6.18	16.18	4.66	7.94	1.13	1.93	0.00	20.14	24	0.013	0.0079	704.61	705.07	5.80	6.41	0.52	0.64	0.75	0.39	0.48	705.55	699.95	700.33	713.01	45° WYE, LAT A1			
1+59.87	1+81.08	21.21		2.650	0.90		2.385	10.00	6.34	16.34	4.64	7.91	-	-	0.00	18.87	24	0.013	0.0070	704.26	704.41	6.41	6.01	0.64	0.56	0.35	0.22	0.20	704.61	699.95	699.95	713.23	45° BEND				
0+21.21	1+59.87	138.66		2.650	0.90		2.385	10.00	6.40	16.40	4.63	7.90	-	-	0.00	18.84	24	0.013	0.0069	703.11	704.07	6.01	6.00	0.56	0.56	0.35	0.20	0.20	704.26	698.91	699.95	713.02	45° BEND				
0+00.00	0+21.21	21.21		2.650	0.90		2.385	10.00	6.78	16.78	4.58	7.82	-	-	0.00	18.65	24	0.013	0.0068	702.77	702.91	6.00	5.94	0.56	0.55	0.35	0.20	0.19	703.11	698.77	698.91	705.74	45° BEND				
LINE B																																					
14+08.43	14+23.07	14.64	B5, RD-4	2.600	2.600	0.90	2.340	2.340	10.00	0.00	10.00	5.71	9.58	13.36	22.42	0.00	22.42	30	0.013	0.0030	708.76	708.81	0.00	4.57	0.00	0.32	1.25	0.00	0.41	709.21	703.95	703.99	708.99	CURB INLET			
11+46.61	14+08.43	261.82		2.600	0.90		2.340	2.340	10.00	0.05	10.05	5.70	9.56	-	-	0.00	22.38	30	0.013	0.0030	707.87	708.65	4.57	4.56	0.32	0.32	0.35	0.11	0.11	708.76	703.27	703.95	708.79	45° BEND			
11+41.61	11+46.61	5.00		2.600	0.90		2.340	2.340	10.00	1.01	11.01	5.50	9.26	-	-	0.00	21.67	42	0.013	0.0005	707.77	707.77	4.56	2.25	0.32	0.08	0.10	0.03	0.10	707.87	702.25	702.27	708.50	PIPE SIZE CHANGE			
8+75.16	11+41.61	266.45	B4, RD-3	2.540	5.140	0.90	2.286	4.626	10.00	1.05	11.05	5.49	9.25	12.56	21.14	0.00	42.81	42	0.013	0.0018	707.05	707.54	2.25	4.45	0.08	0.31	0.75	0.06	0.23	707.77	701.56	702.25	708.53	45° WYE, LAT B-4			
8+70.16	8+75.16	5.00		5.140	0.90		4.626	4.626	10.00	2.05	12.05	5.31	8.96	-	-	0.00	41.43	48	0.013	0.0008	706.91	706.92	4.45	3.30	0.31	0.17	0.10	0.03	0.14	707.05	701.04	701.06	708.69	PIPE SIZE CHANGE			
5+76.92	8+70.16	293.24	B3, RD-2	2.540	7.680	0.90	2.286	6.912	10.00	2.07	12.07	5.30	8.95	12.12	20.46	0.00	61.89	48	0.013	0.0019	706.08	706.63	3.30	4.93	0.17	0.38	0.75	0.13	0.28	706.91	700.28	701.04	708.72	45° WYE, LAT B-3			
5+00.95	5+76.92	75.97	B2, RD-1	2.470	10.150	0.90	2.223	9.135	10.00	3.06	13.06	5.13	8.68	11.40	19.30	0.00	81.19	48	0.013	0.0032	705.36	705.60	4.93	6.46	0.38	0.65	0.75	0.28	0.49	706.08	700.08	700.28	708.63	45° WYE, LAT B-2			
3+35.18	5+00.95	165.77		10.150	0.90		9.135	9.135	10.00	3.26	13.26	5.10	8.63	-	-	0.00	78.83	48	0.013	0.0030	704.64	705.14	6.46	6.27	0.65	0.61	0.35	0.23	0.21	705.36	699.65	700.08	710.01	45° BEND			
0+93.65	3+35.18	241.53		10.150	0.90		9.135	9.135	10.00	3.70	13.70	5.02	8.52	-	-	0.00	77.80	48	0.013	0.0029	703.72	704.43	6.27	6.19	0.61	0.60	0.35	0.21	0.21	704.64	699.01	699.65	708.68	45° BEND			
0+55.81	0+93.65	37.84		10.150	0.90		9.135	9.135	10.00	4.35	14.35	4.92	8.36	-	-	0.00	76.35	48	0.013	0.0028	703.42	703.52	6.19	6.08	0.60	0.57	0.35	0.21	0.20	703.72	698.92	699.01	706.55	45° BEND			
0+00.00	0+55.81	55.81	B1	0.810	10.960	0.90	0.729	9.864	10.00	4.45	14.45	4.91	8.33	3.58	6.07	0.00	82.42	48	0.013	0.0026	702.77	702.92	6.08	6.56	0.57	0.67	0.75	0.43	0.50	703.42	698.77	698.92	706.31	45° WYE, LAT B-1			
LAT A1																																					
0+25.27	0+49.10	23.83	A1	0.270	0.270	0.90	0.243	0.243	10.00	0.00	10.00	5.71	9.58	1.39	2.33	0.00	2.33	18	0.013	0.0500	706.90	708.09	0.00	8.08	0.00	1.01	1.25	0.00	1.27	709.36	706.56	707.75	711.75	CURB INLET			
0+00.00	0+25.27	25.27		0.270	0.90		0.243	0.243	10.00	0.05	10.05	5.70	9.56	-	-	0.00	2.32	18	0.013	0.2365	705.55	706.77	8.08	17.21	1.01	4.61	0.10	0.10	0.46	706.90	700.58	706.56	712.26	PIPE SLOPE CHANGE			
LAT A2																																					
0+00.00	0+40.10	40.10	A2	0.700	0.700	0.90	0.630	0.630	10.00	0.00	10.00	5.71	9.58	3.60	6.04	0.00	6.04	18	0.013	0.1140	707.54	712.11	0.00	12.38	0.00	2.38	1.25	0.00	2.98	715.09	702.18	706.75	712.75	CURB INLET			
LAT A3																																					
0+00.00	0+40.10	40.10	A3	0.550	0.550	0.90	0.495	0.495	10.00	0.00	10.00	5.71	9.58	2.83	4.74	0.00	4.74	18	0.013	0.0020	708.86	708.94	0.00	2.68	0.00	0.11	1.25	0.00	0.14	709.08	704.34	707.24	713.24	CURB INLET			
LAT A4																																					
0+00.00	0+40.10	40.10	A4	0.680	0.680	0.90	0.612	0.612	10.00	0.00	10.00	5.71	9.58	3.49	5.86	0.00	5.86	18	0.013	0.0031	709.36	709.48	0.00	3.32	0.00	0.17	1.25	0.00	0.21	709.69	705.98	707.42	713.42	CURB INLET			
LAT B1																																					
0+00.00	0+14.76	14.76	B1	0.810	0.810	0.90	0.729	0.729	10.00	0.00	10.00	5.71	9.58	4.16	6.98	0.00	6.98	18	0.013	0.0044	703.42	703.48	0.00	3.95	0.00	0.24	1.25	0.00	0.30	703.79	700.17	701.46	705.46	CURB INLET			
LAT B2																																					
0+00.00	0+14.64	14.64	B2, RD-1	2.470	2.470	0.90	2.223	2.223	10.00	0.00	10.00	5.71	9.58	12.69	21.30	0.00	21.30	24	0.013																		

INTERSTATE HIGHWAY 35 (VARIABLE WIDTH PUBLIC R.O.W.)

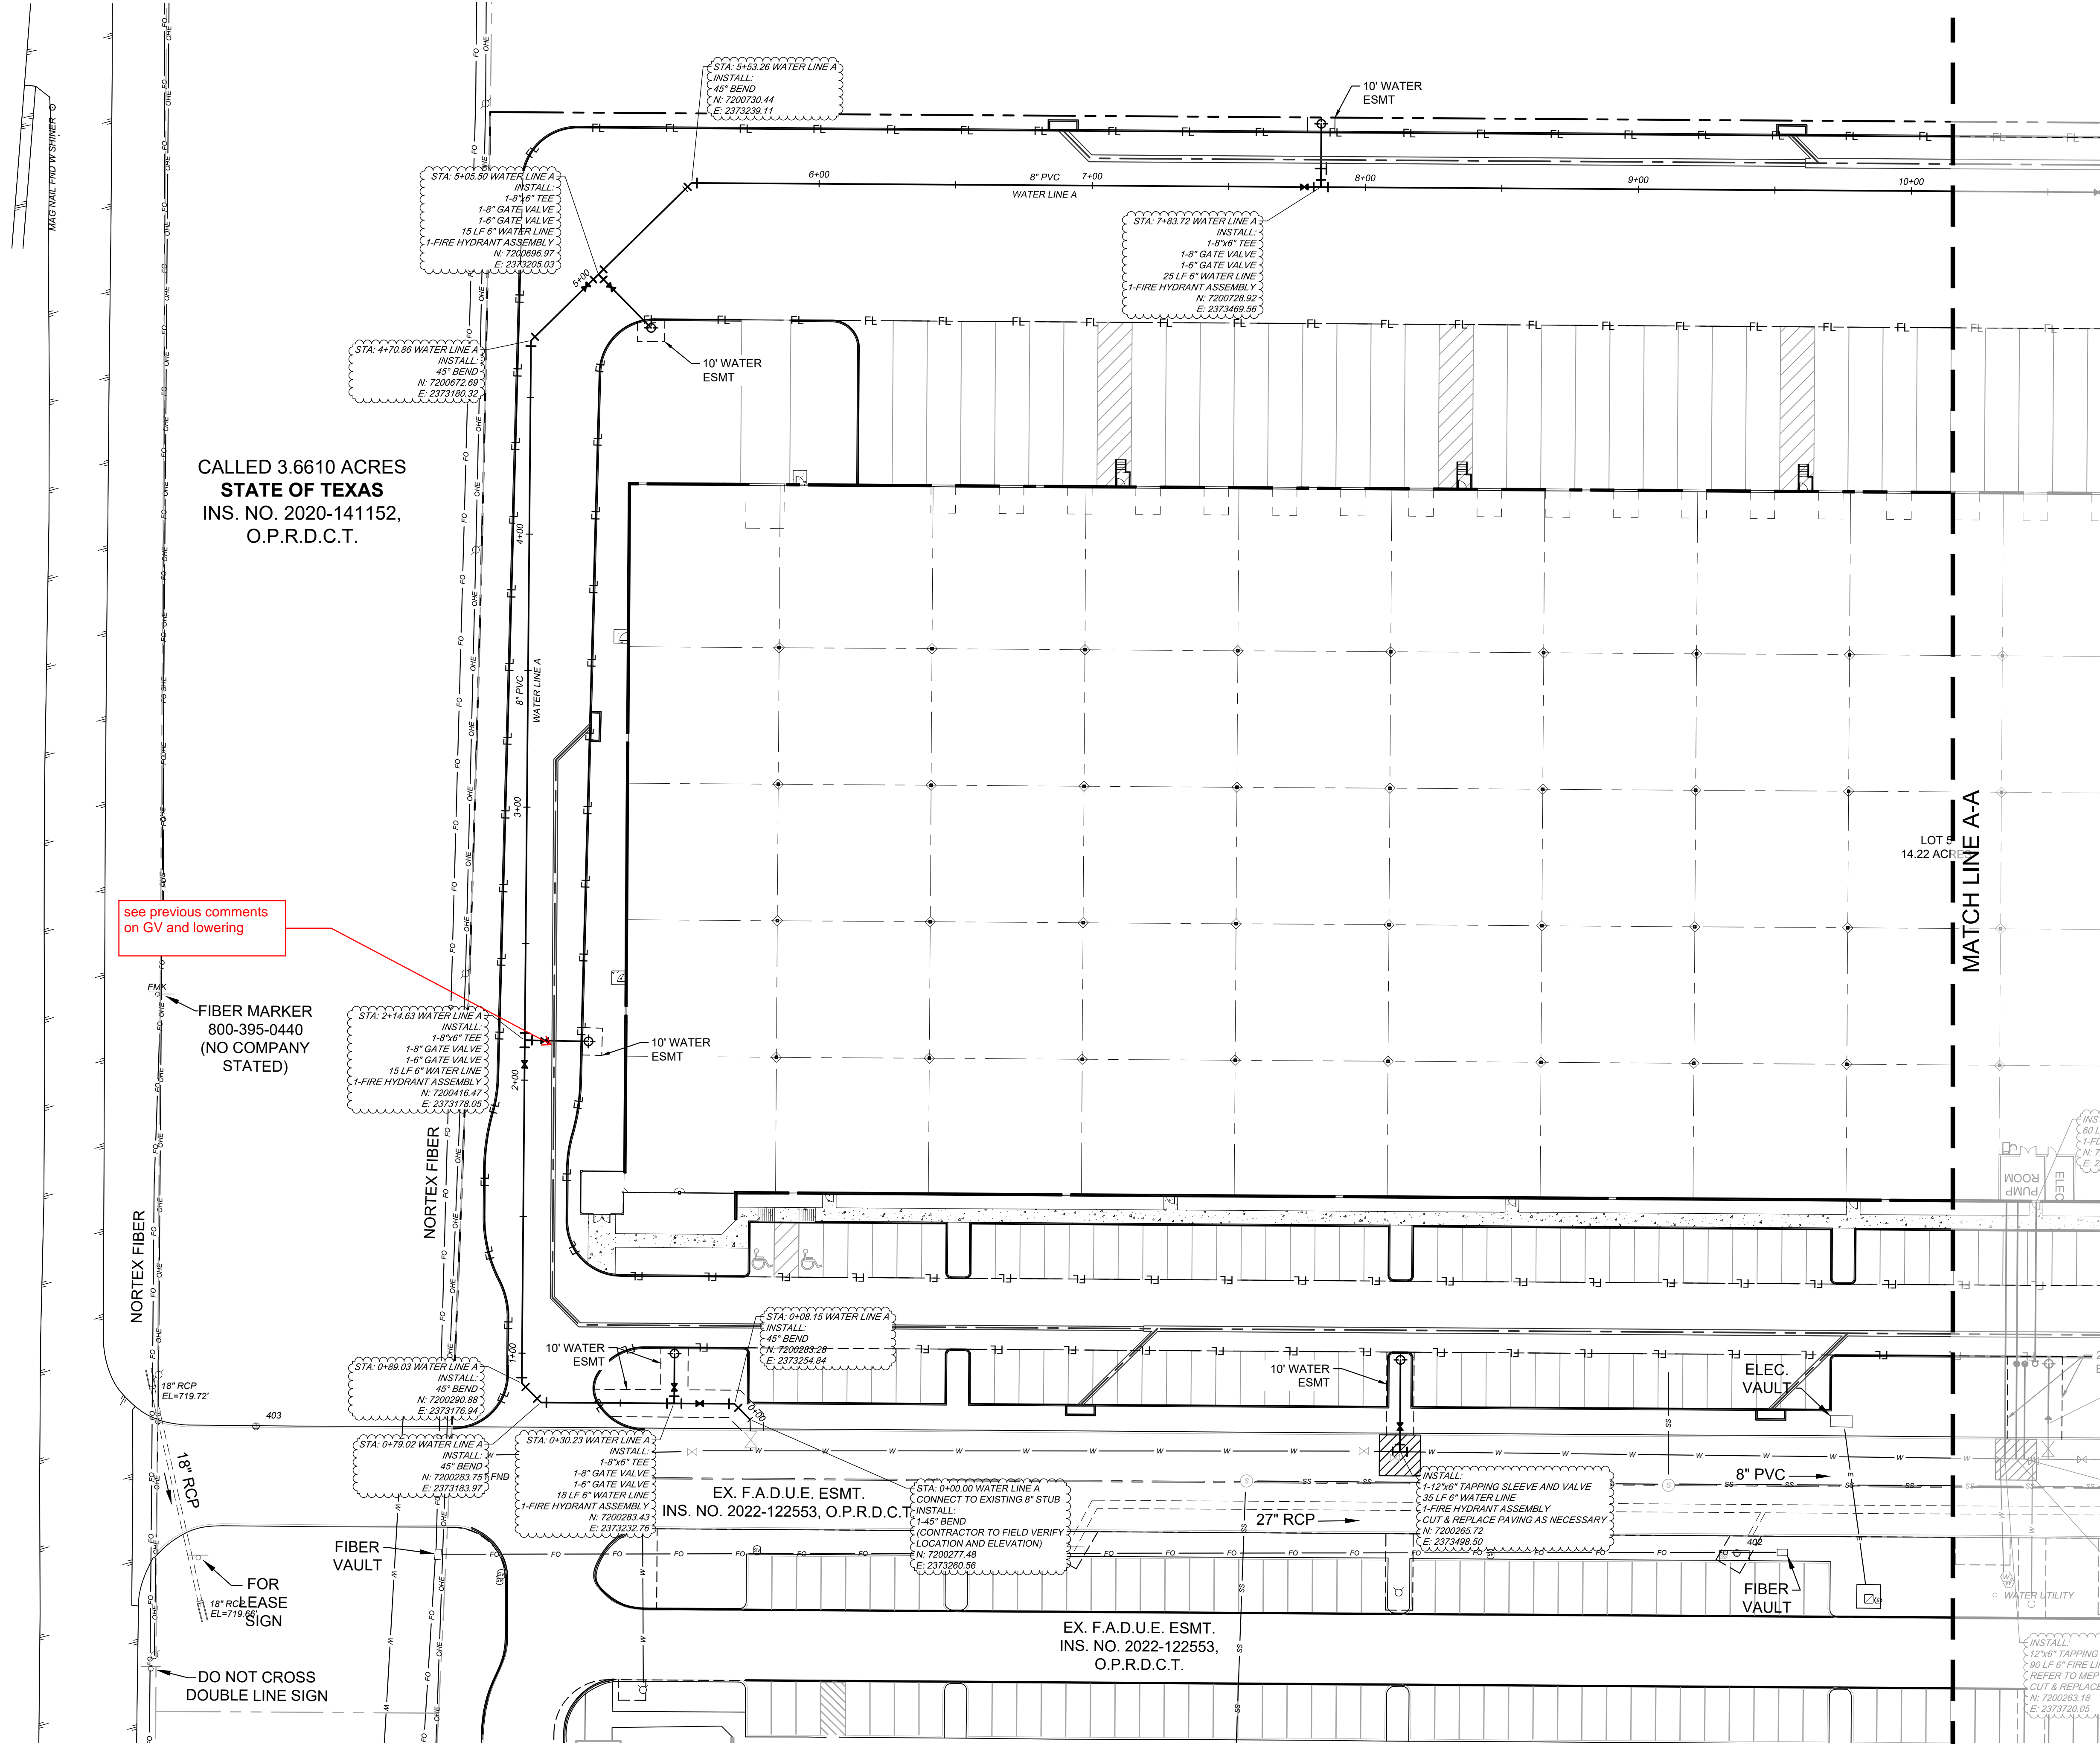

CALLED 3.6610 ACRES
STATE OF TEXAS
INS. NO. 2020-141152,
O.P.R.D.C.T.

see previous comments
on GV and lowering

FIBER MARKER
800-395-0440
(NO COMPANY
STATED)

FOR
18" RCP
EASE
SIGN



DO NOT CROSS
DOUBLE LINE SIGN

EX. F.A.D.U.E. ESMT.
INS. NO. 2022-122553, O.P.R.D.C.T.

EX. F.A.D.U.E. ESMT.
INS. NO. 2022-122553,
O.P.R.D.C.T.



Know what's below.
Call before you dig.

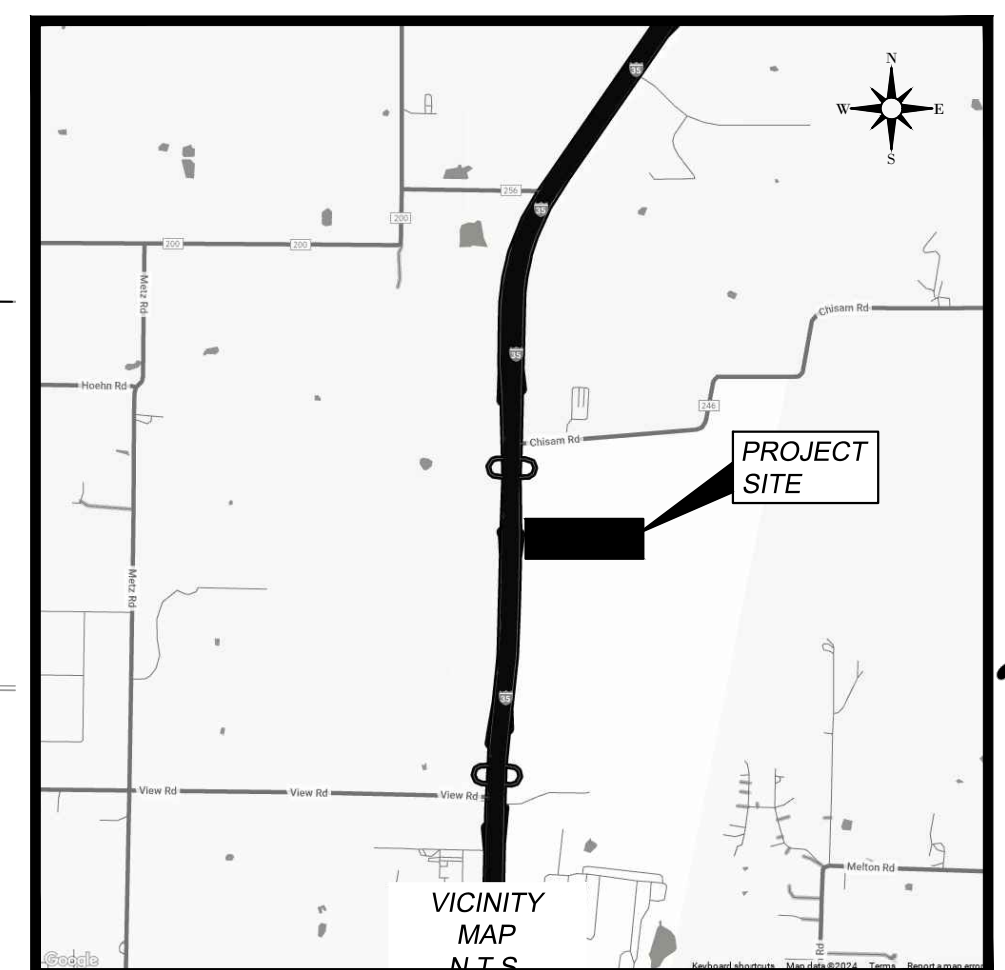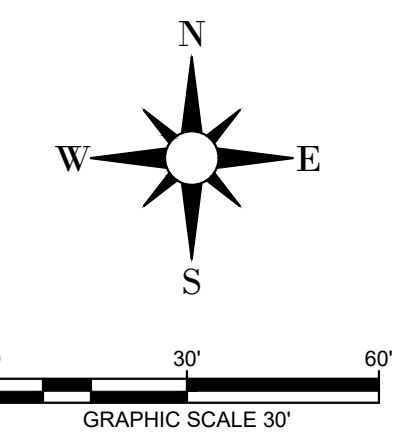

LEGEND

- PROPERTY LINE
- - - SETBACK LINE
- - - PROPOSED EASEMENT
- SS --- PROPOSED SANITARY SEWER LINE
- W --- PROPOSED WATER LINE
- PROPOSED STORM SEWER LINE
- FL --- PROPOSED FIRE LANE
- OP --- EXISTING OVERHEAD POWER LINE
- EXISTING CABLE LINE
- GAS --- EXISTING GAS LINE
- W --- EXISTING WATER LINE
- SS --- EXISTING SANITARY SEWER LINE
- ⊕ --- PROPOSED FIRE HYDRANT (FH)
- ⊕ --- PROPOSED FIRE DEPARTMENT CONNECTION (FDC)
- ⊕ --- PROPOSED WATER METER
- ⊕ --- PROPOSED WATER VALVE
- ⊕ --- EXISTING FIRE HYDRANT
- ⊕ --- EXISTING STORM MANHOLE
- ⊕ --- EXISTING SAN. SWR. MANHOLE
- ⊕ --- EXISTING SIGN

UTILITY NOTES

1. SEE MEP PLANS FOR ALL UTILITY CONNECTIONS INTO BUILDING.
2. WATER AND SEWER LINES SHALL STUB 5 FEET FROM BUILDING FOR SERVICE CONNECTIONS UNLESS OTHERWISE NOTED.
3. REFER TO DETAILS FOR WATER METER, METER BOX, VALVES, VALVE BOXES AND SERVICE INSTALLATION.
4. REFER TO DETAILS FOR TRENCHING, BEDDING, BACK FILL, AND TRENCH COMPACTION REQUIREMENTS.
5. WATER AND SANITARY SEWER PIPE SHALL BE CONSTRUCTED OF SLIP-ON OR MECHANICAL JOINT CAST OR DUCTILE IRON PIPE, ASBESTOS-CEMENT PRESSURE PIPE, PRETREATED CONCRETE PIPE, OR PVC PIPE.

CAUTION!
THE CONTRACTOR SHALL FIELD VERIFY THE HORIZONTAL AND VERTICAL LOCATIONS OF ALL EXISTING UTILITIES PRIOR TO START OF CONSTRUCTION AND SHALL NOTIFY THE CONSTRUCTION MANAGER AND ENGINEER OF ANY CONFLICTS DISCOVERED. CONTRACTOR IS RESPONSIBLE FOR PROTECTING EXISTING UTILITIES (SHOWN OR NOT SHOWN) WITHIN SCOPE OF CONSTRUCTION. IF ANY EXISTING UTILITIES ARE DAMAGED, THE CONTRACTOR SHALL REPLACE THEM AT HIS OWN EXPENSE. CALL 811 AT LEAST 72 HOURS PRIOR TO COMMENCING CONSTRUCTION IN VICINITY.

NO.	REVISIONS	DATE	BY
© 2024 ANIMAS CIVIL ENGINEERING, LLC PHONE: 214-803-1099 TX F-26500			
PROJECT NAME: BLUE STAR INDUSTRIAL BLDG. L SANGER, TEXAS			
SHEET TITLE: UTILITY PLAN			
ACE PROJECT: 01101			
DATE DECEMBER 2024			
SCALE AS SHOWN			
DRAWN BY: MD			
SHEET NUMBER C-6.01			

BMP MAINTENANCE SCHEDULE

TEMPORARY STONE CONSTRUCTION ENTRANCE/EXIT:
 INSPECTIONS SHALL BE MADE WEEKLY AND AFTER RAIN STORM EVENTS TO ENSURE THAT THE FACILITY IS FUNCTIONING PROPERLY. AGGREGATE PAD SHALL BE WASHED DOWN OR REPLACED WHEN SEDIMENT OR MUD HAS CLOGGED THE VOID SPACES BETWEEN THE STONES OR MUD IS BEING TRACKED ONTO THE PUBLIC ROADWAY. RUNOFF FROM WASHDOWN OPERATION SHALL BE FILTERED THROUGH ANOTHER B.M.P. PRIOR TO DRAINING OFF-SITE. CONSTRUCTION ENTRANCE LOCATIONS SHOWN ARE RECOMMENDED LOCATIONS AND MAY BE RELOCATED AT THE CONTRACTOR'S DISCRETION.

SILT FENCE:
 INSPECTIONS SHALL BE MADE WEEKLY AND AFTER RAIN STORM EVENTS. SEDIMENT SHALL BE REMOVED FROM BEHIND THE FENCE WHEN THE DEPTH OF SEDIMENT HAS BUILT UP TO ONE-THIRD THE HEIGHT OF THE FENCE ABOVE GRADE. FENCE SHALL BE INSPECTED FOR GAPS AT BASE. INSPECT SUPPORTING POSTS AND FILTER FABRIC. REPLACE IF REQUIRED.

CURB INLET/GRATE INLET/WYE INLET:
 INSPECTIONS SHALL BE MADE WEEKLY AND AFTER ALL RAIN EVENTS TO ENSURE THAT THE DEVICE IS FUNCTIONING PROPERLY. REMOVE SEDIMENT FROM THE STORAGE AREA SURROUNDING THE INLET/GRATE WHEN THE DEPTH OF SEDIMENT HAS BUILT UP TO ONE-HALF OF THE PROTECTION HEIGHT. DEVICE SHALL BE INSPECTED FOR GAPS AT BASE, AND SHALL BE REPLACED AS NEEDED.

EROSION CONTROL SCHEDULE AND PHASING

THE PROJECT SHALL GENERALLY CONFORM TO THE FOLLOWING:

PHASE A - GRADING
 1. CONSTRUCT TEMPORARY CONSTRUCTION ENTRANCE, SILT FENCE, DIKE, AND TREE PROTECTION FENCE
 ACCORDING TO THE APPROXIMATE LOCATION AND SHOWN ON GRADING AND EROSION CONTROL PLAN NOTES AND DETAIL SHEET.
 2. BEGIN CLEARING AND GRADING OF SITE.
 3. SEED AND REVEGETATE SLOPES WHERE SHOWN.

PHASE B - UTILITIES
 1. KEEP ALL STORM WATER POLLUTION PREVENTION MEASURES IN PLACE.
 2. INSTALL STORM DRAINS, SANITARY SEWER, AND WATER AS SPECIFIED ON PLAN SHEETS.




PHASE C - PAVING
 1. KEEP ALL STORM WATER POLLUTION PREVENTION MEASURES IN PLACE. REMOVE AS NEEDED TO PAVE.
 2. STABILIZE SUBGRADE.
 3. PAVE STREETS AND SIDEWALKS AS SPECIFIED ON PLAN SHEETS.
 4. RE-INSTALL ANY STORM WATER POLLUTION PREVENTION MEASURES REMOVED FOR PAVING OPERATIONS.

PHASE D - LANDSCAPING AND SOIL STABILIZATION
 1. REVEGETATE LOT AND PARKWAYS.
 2. LANDSCAPE CONTRACTOR SHALL REVEGETATE ALL AREAS RESERVED FOR LANDSCAPE VEGETATIVE COVERS.
 3. REMOVE EROSION CONTROL DEVICES WHEN MINIMUM 70% GROUND COVER IS ESTABLISHED.
 VEGETATION MUST BE ESTABLISHED BEFORE STRUCTURAL CONTROLS REMOVED.

SITE MAP GENERAL NOTES

- CONTRACTOR IS SOLELY RESPONSIBLE FOR SELECTION, IMPLEMENTATION, MAINTENANCE, AND EFFECTIVENESS OF ALL SWPPP CONTROLS. CONTROLS SHOWN ON THIS SITE MAP ARE SUGGESTED CONTROLS ONLY.
- CONTRACTOR SHALL RECORD INSTALLATION, MAINTENANCE OR MODIFICATION, AND REMOVAL DATES FOR EACH BMP EMPLOYED (WHETHER CALLED OUT ON ORIGINAL SWPPP OR NOT) DIRECTLY ON THE SITE MAP.
- DRAINAGE PATTERNS ARE SHOWN ON THIS PLAN BY PROPOSED AND EXISTING CONTOURS, FLOW ARROWS AND/OR SLOPES.
- TEMPORARY AND PERMANENT STABILIZATION PRACTICES AND BMP'S SHALL BE INSTALLED AT THE EARLIEST POSSIBLE TIME DURING THE CONSTRUCTION SEQUENCE. AS AN EXAMPLE, PERIMETER SILT FENCE SHALL BE INSTALLED BEFORE COMMENCEMENT OF ANY GRADING ACTIVITIES. OTHER BMP'S SHALL BE INSTALLED AS SOON AS PRACTICABLE AND SHALL BE MAINTAINED UNTIL FINAL SITE STABILIZATION IS ATTAINED. CONTRACTOR SHALL ALSO REFERENCE CIVIL AND LANDSCAPE PLANS SINCE PERMANENT STABILIZATION IS PROVIDED BY LANDSCAPING, THE BUILDING(S), AND SITE PAVING.
- BMP'S HAVE BEEN LOCATED AS INDICATED ON THIS PLAN IN ACCORDANCE WITH GENERALLY ACCEPTED ENGINEERING PRACTICES IN ORDER TO MINIMIZE SEDIMENT TRANSFER. FOR EXAMPLE, SILT FENCES LOCATED AT TOE OF SLOPE AND INLET PROTECTION FOR INLETS RECEIVING SEDIMENT FROM SITE RUN-OFF.
- SANITARY SEWER EFFLUENT IS DISPOSED OF VIA AN ONSITE SEWER SYSTEM CONNECTED TO A MUNICIPAL SEWER SYSTEM.

LEGEND

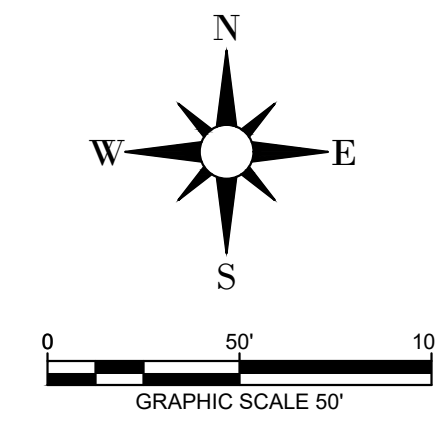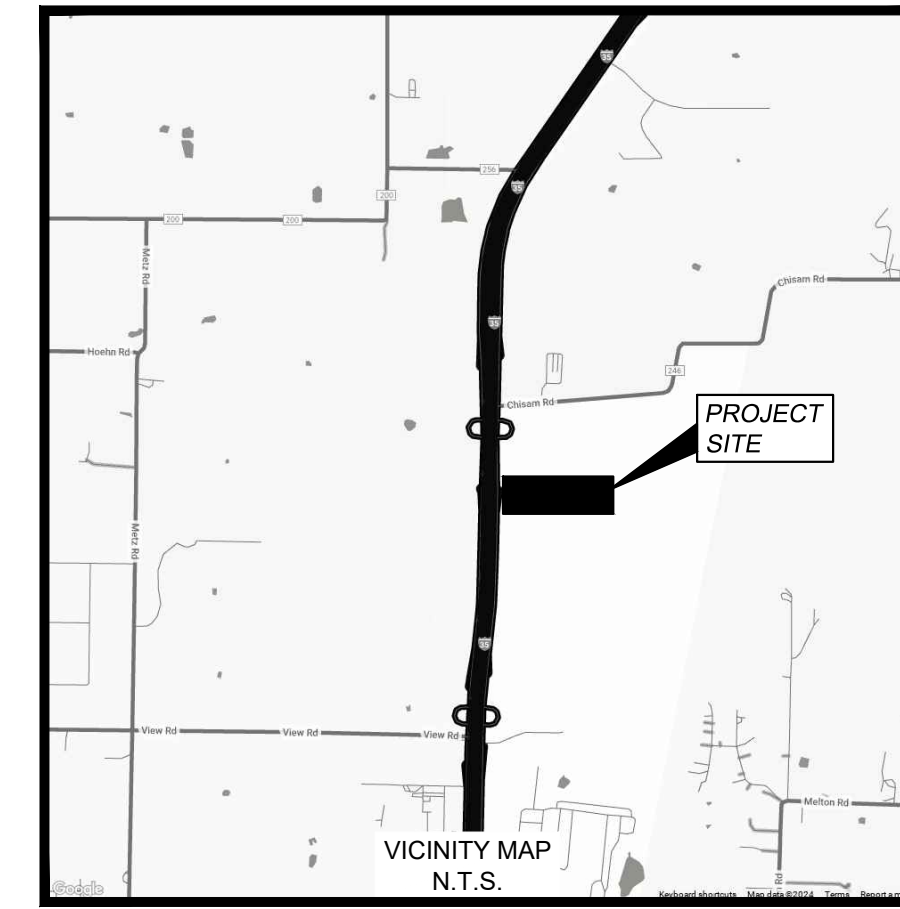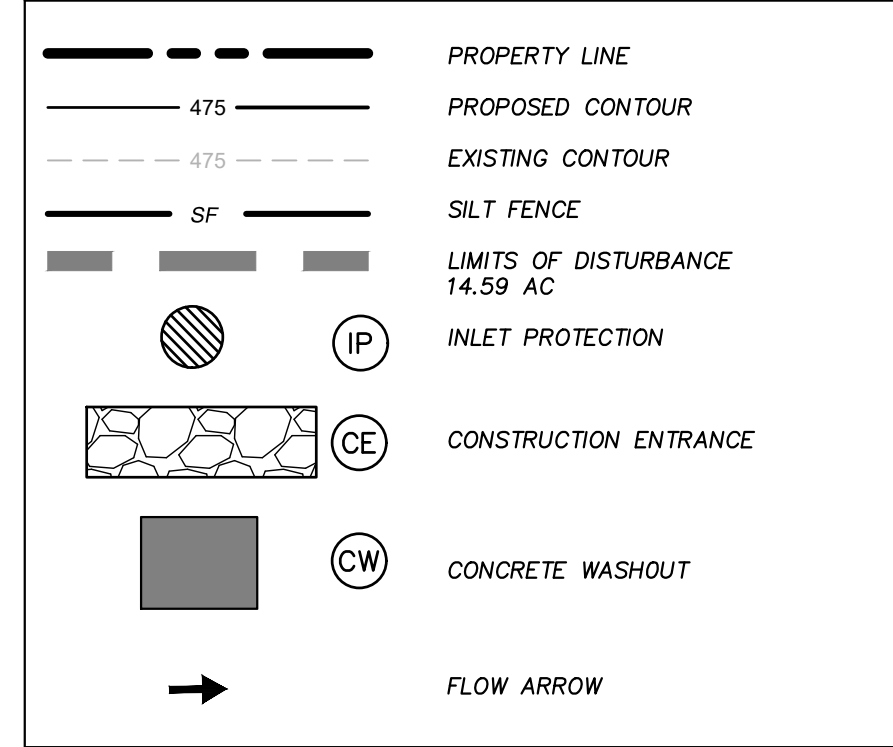

Know what's below.
Call before you dig.

INTERSTATE HIGHWAY 35
(VARIABLE WIDTH PUBLIC R.O.W.)

CALLLED 3.6810 ACRES
STATE OF TEXAS
INS. NO. 2020-141152,
O.P.R.D.C.T.

CALLLED 211.38 ACRES
SANGER TEXAS INDUSTRIAL, LLC
INS. NO. 2022-122553,
O.P.R.D.C.T.

BUILDING 'L'
290,940 S.F.
165 CAR SPACES
62 TRUCK SPACES


4003
714.563
GCP

please show or ensure
SF is added behind the
curb once curb is
installed to minimize
sediment on the street


please add SF at the toe
of all graded slopes to
reduce sediment

Consider installing a
rock filter dam at the
outflow for erosion
control


NO.	REVISIONS	DATE	BY
CIVIL ENGINEERING © 2024 ANIMAS CIVIL ENGINEERING, LLC PHONE: 214-803-1099 TX F-26500			
PROJECT NAME: BLUE STAR INDUSTRIAL BLDG. L SANGER, TEXAS			
SHEET TITLE: EROSION CONTROL PLAN			
ACE PROJECT: 01101 DATE: DECEMBER 2024 SCALE: AS SHOWN DRAWN BY: MD			
SHEET NUMBER C-07.01			

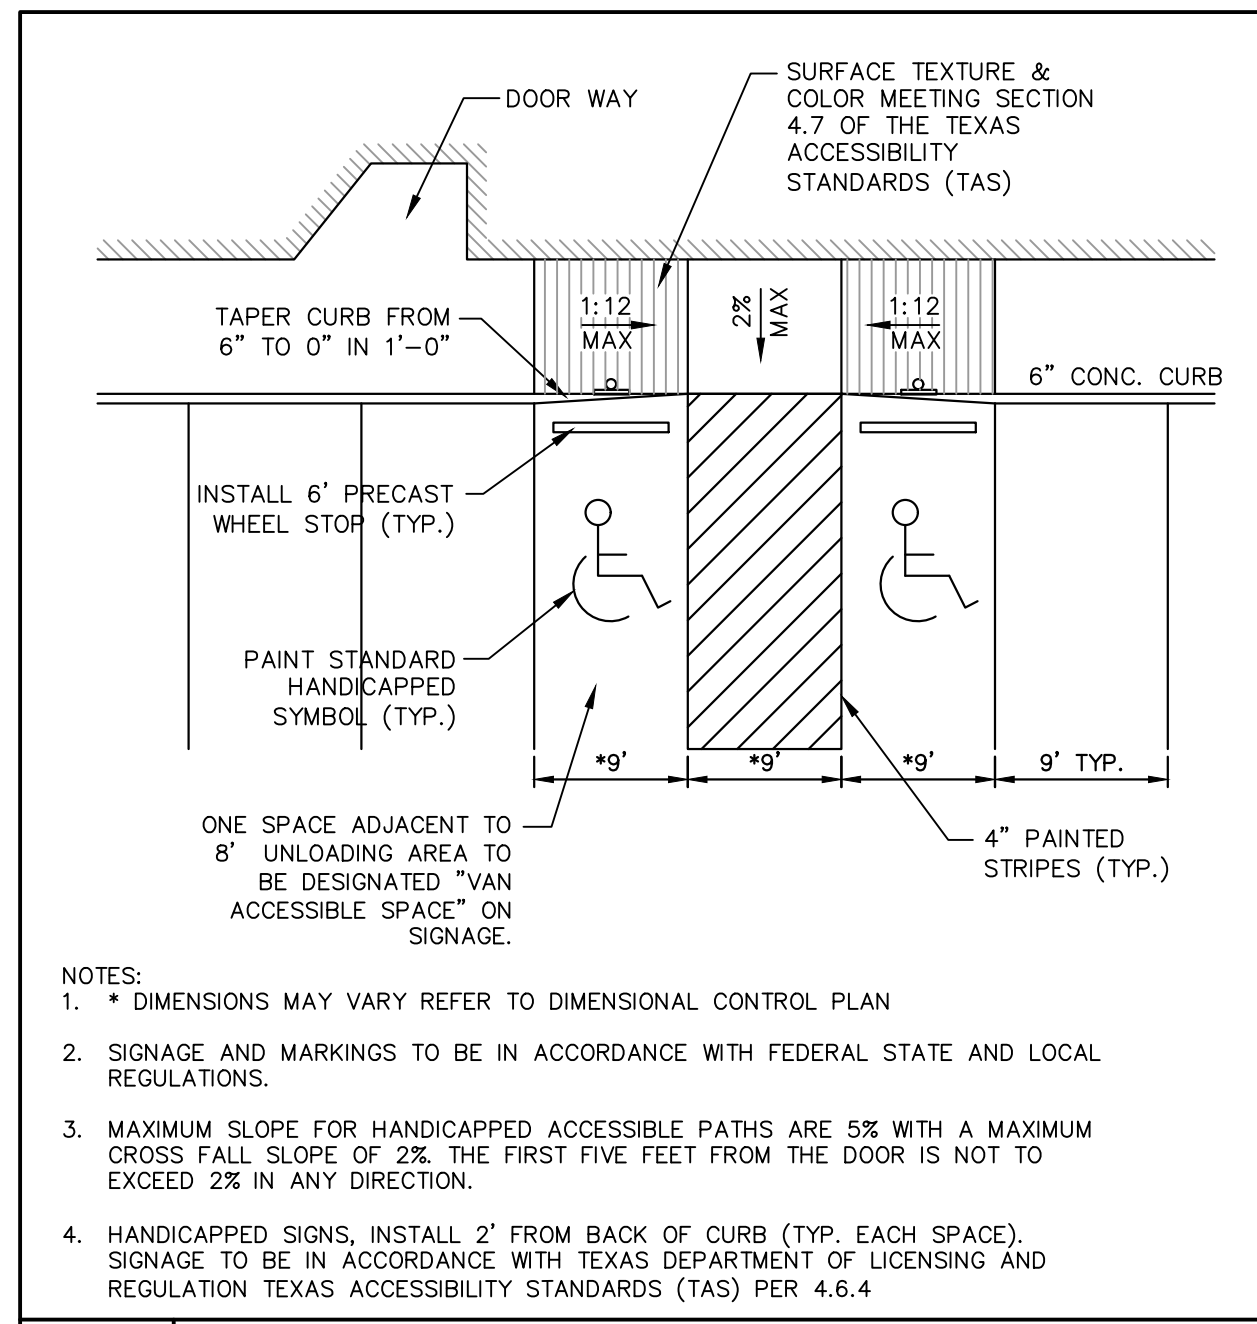


HANDICAPPED PARKING DETAIL
N.T.S.

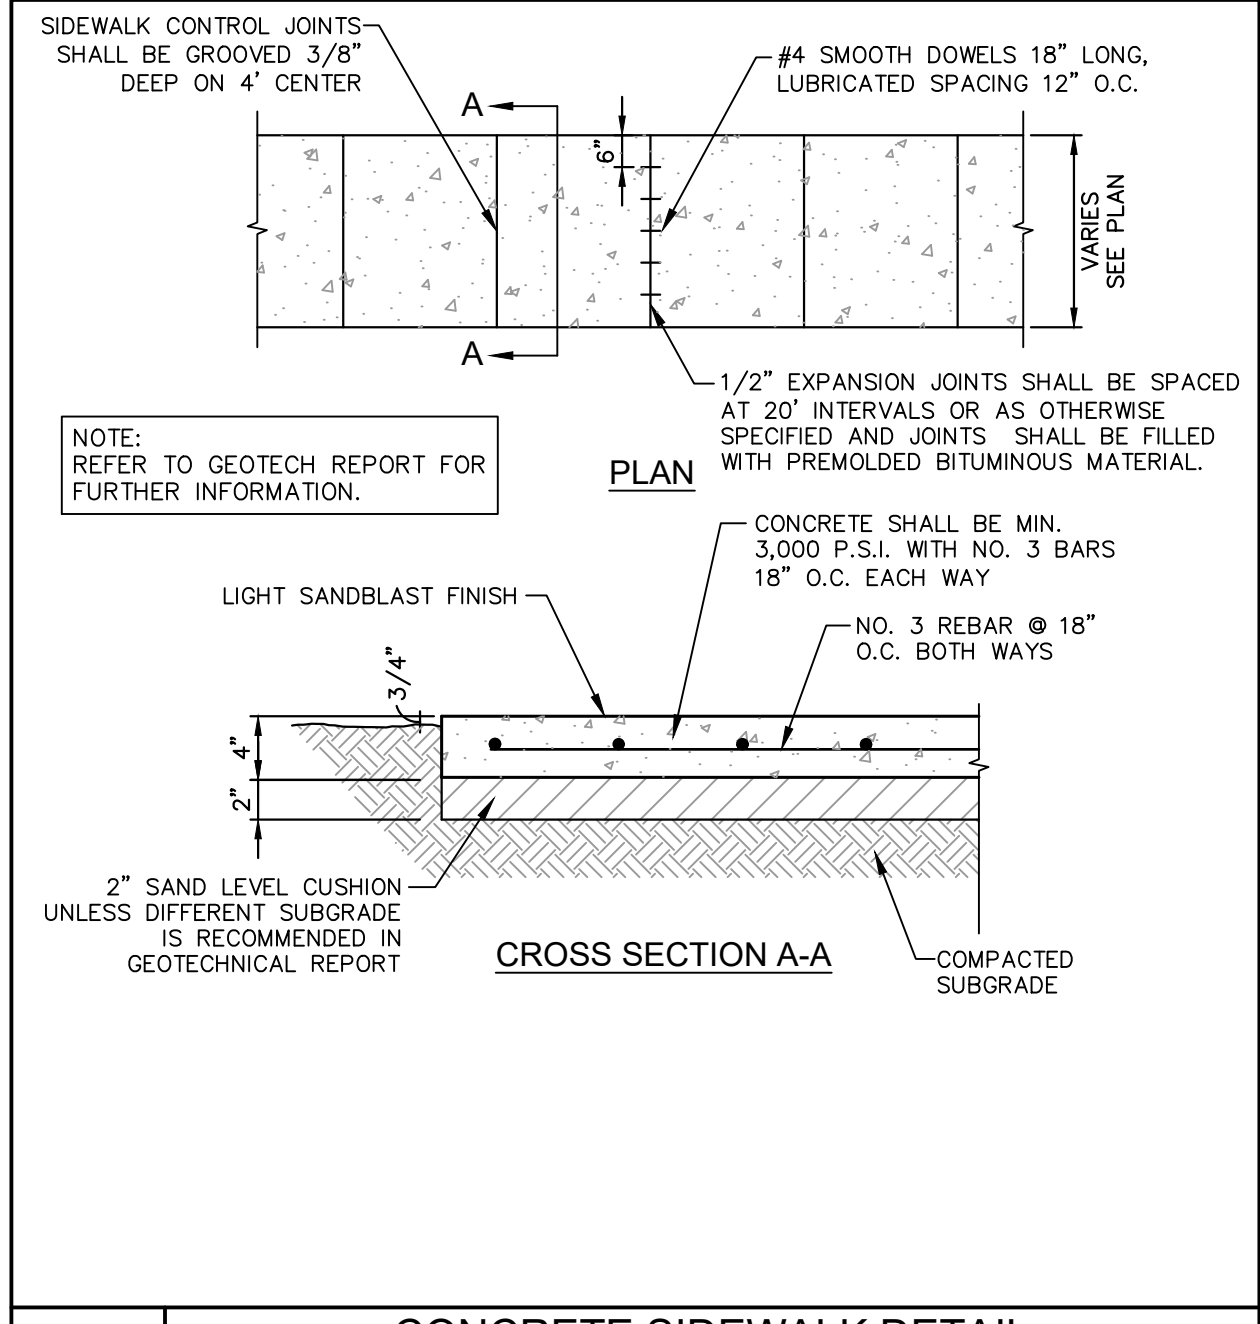


CONCRETE SIDEWALK DETAIL
N.T.S.

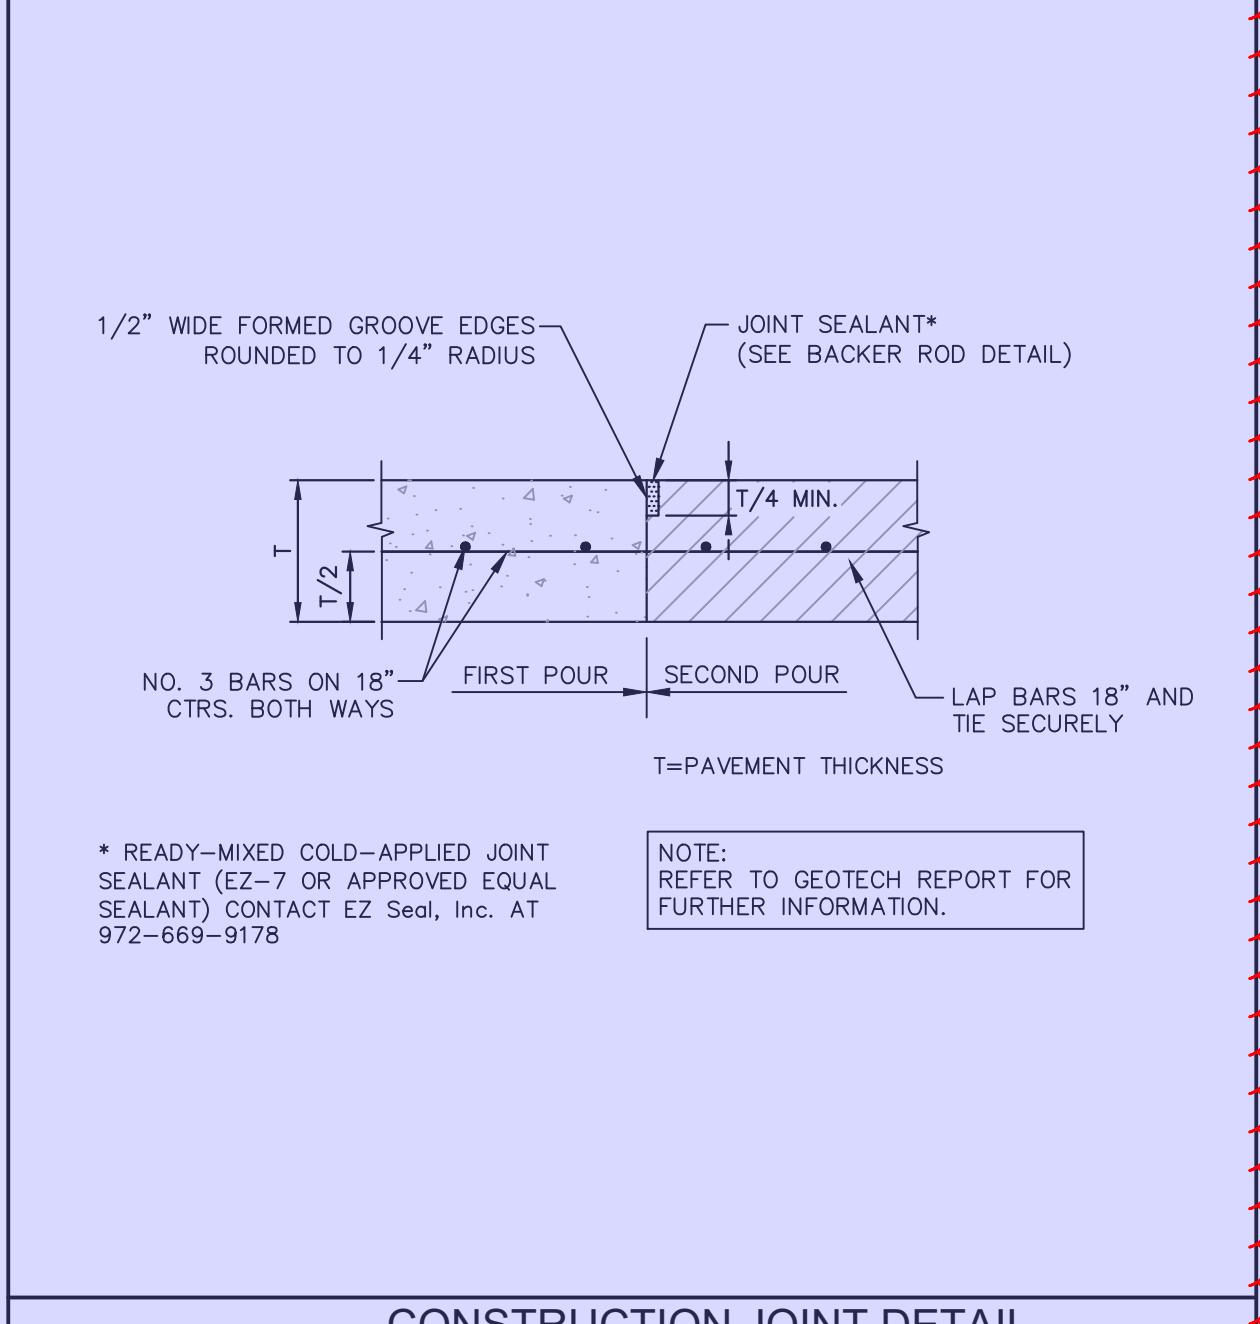


CONSTRUCTION JOINT DETAIL
N.T.S.

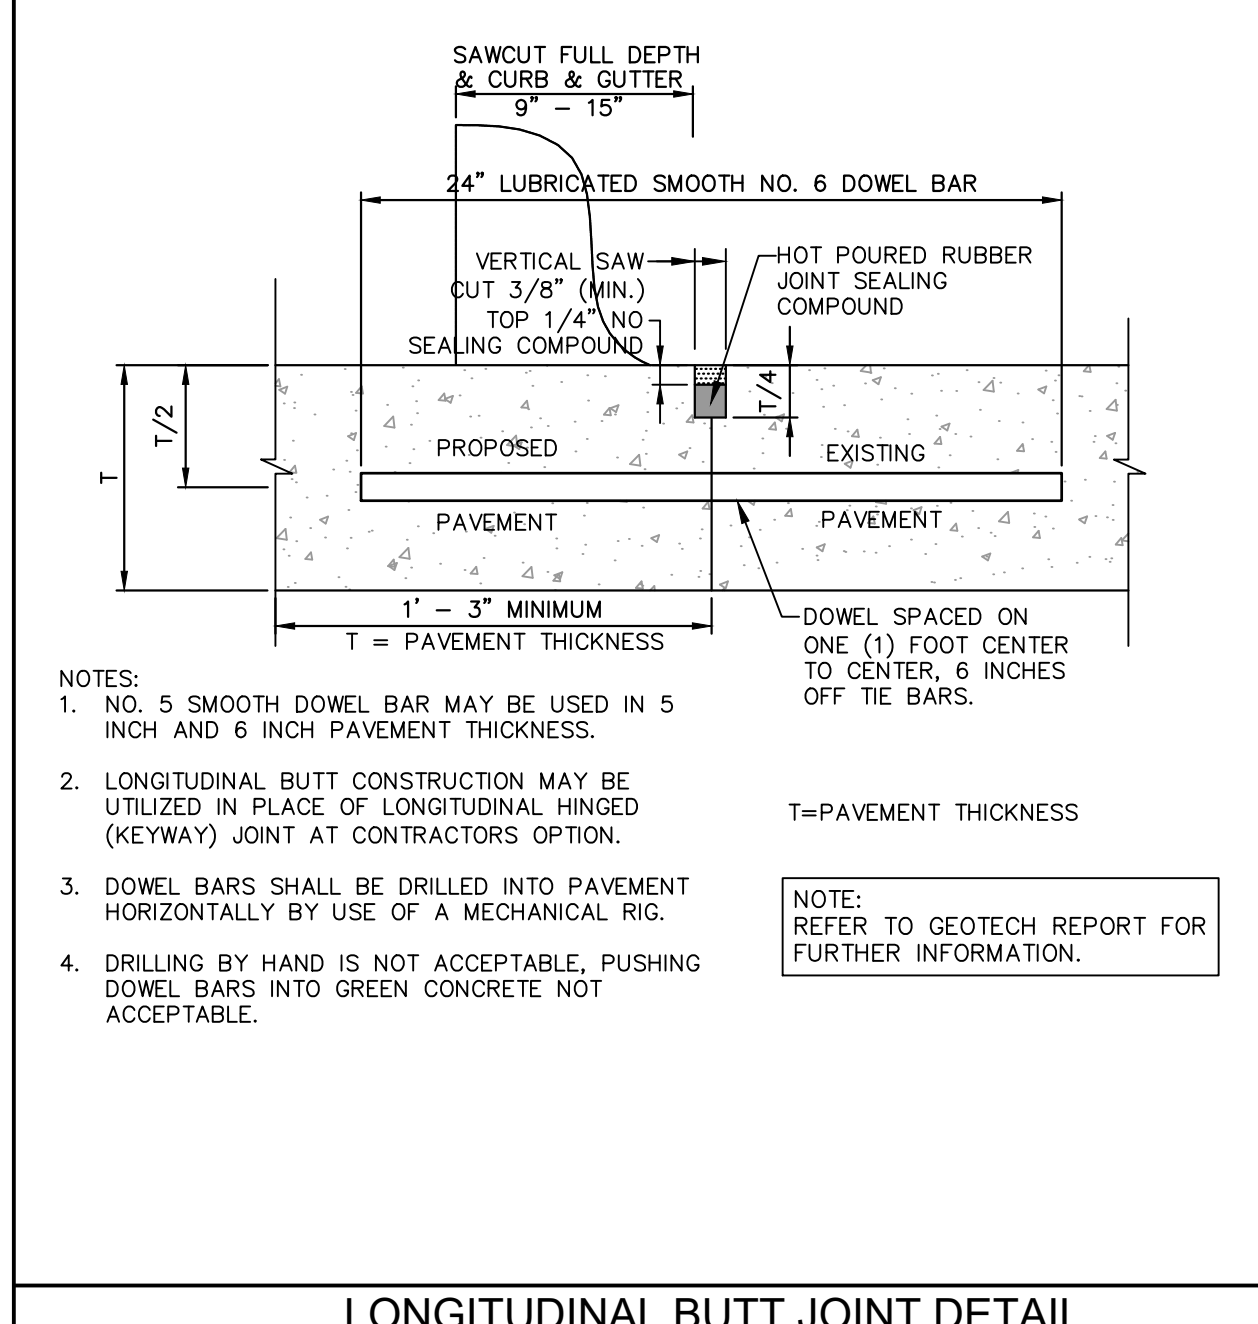


LONGITUDINAL BUTT JOINT DETAIL
N.T.S.

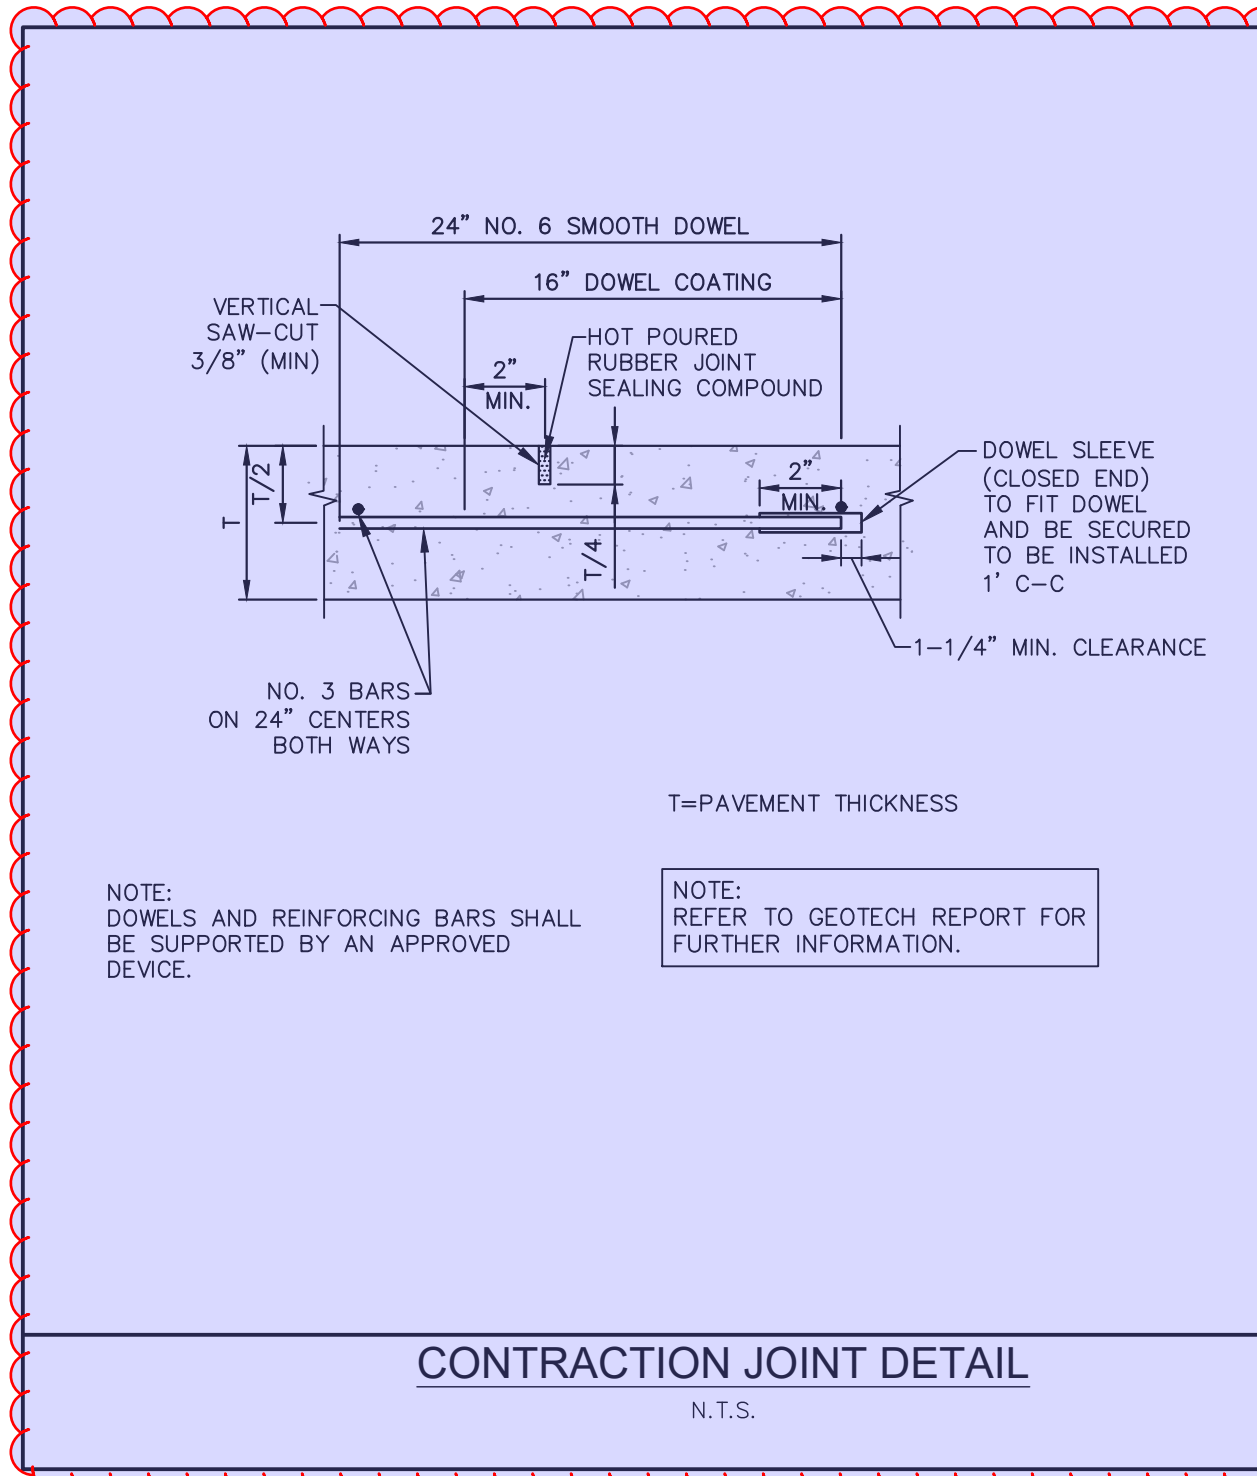


CONTRACTION JOINT DETAIL
N.T.S.

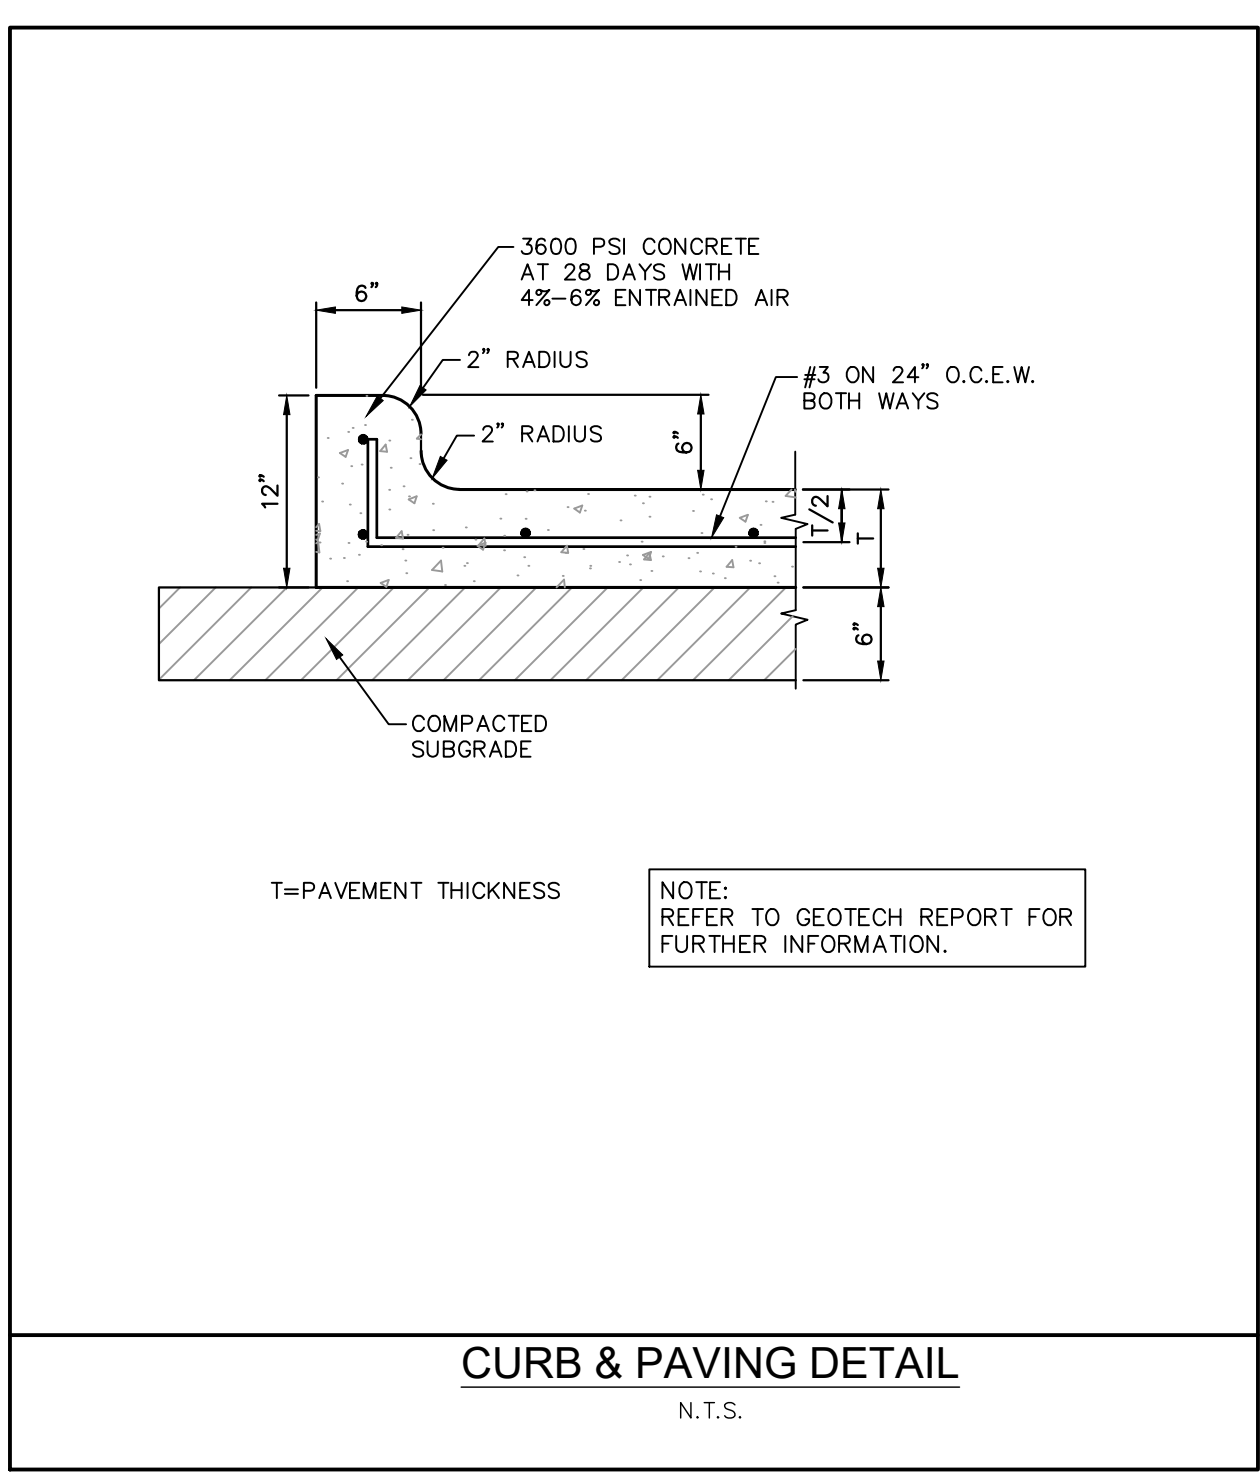

CURB & PAVING DETAIL
N.T.S.

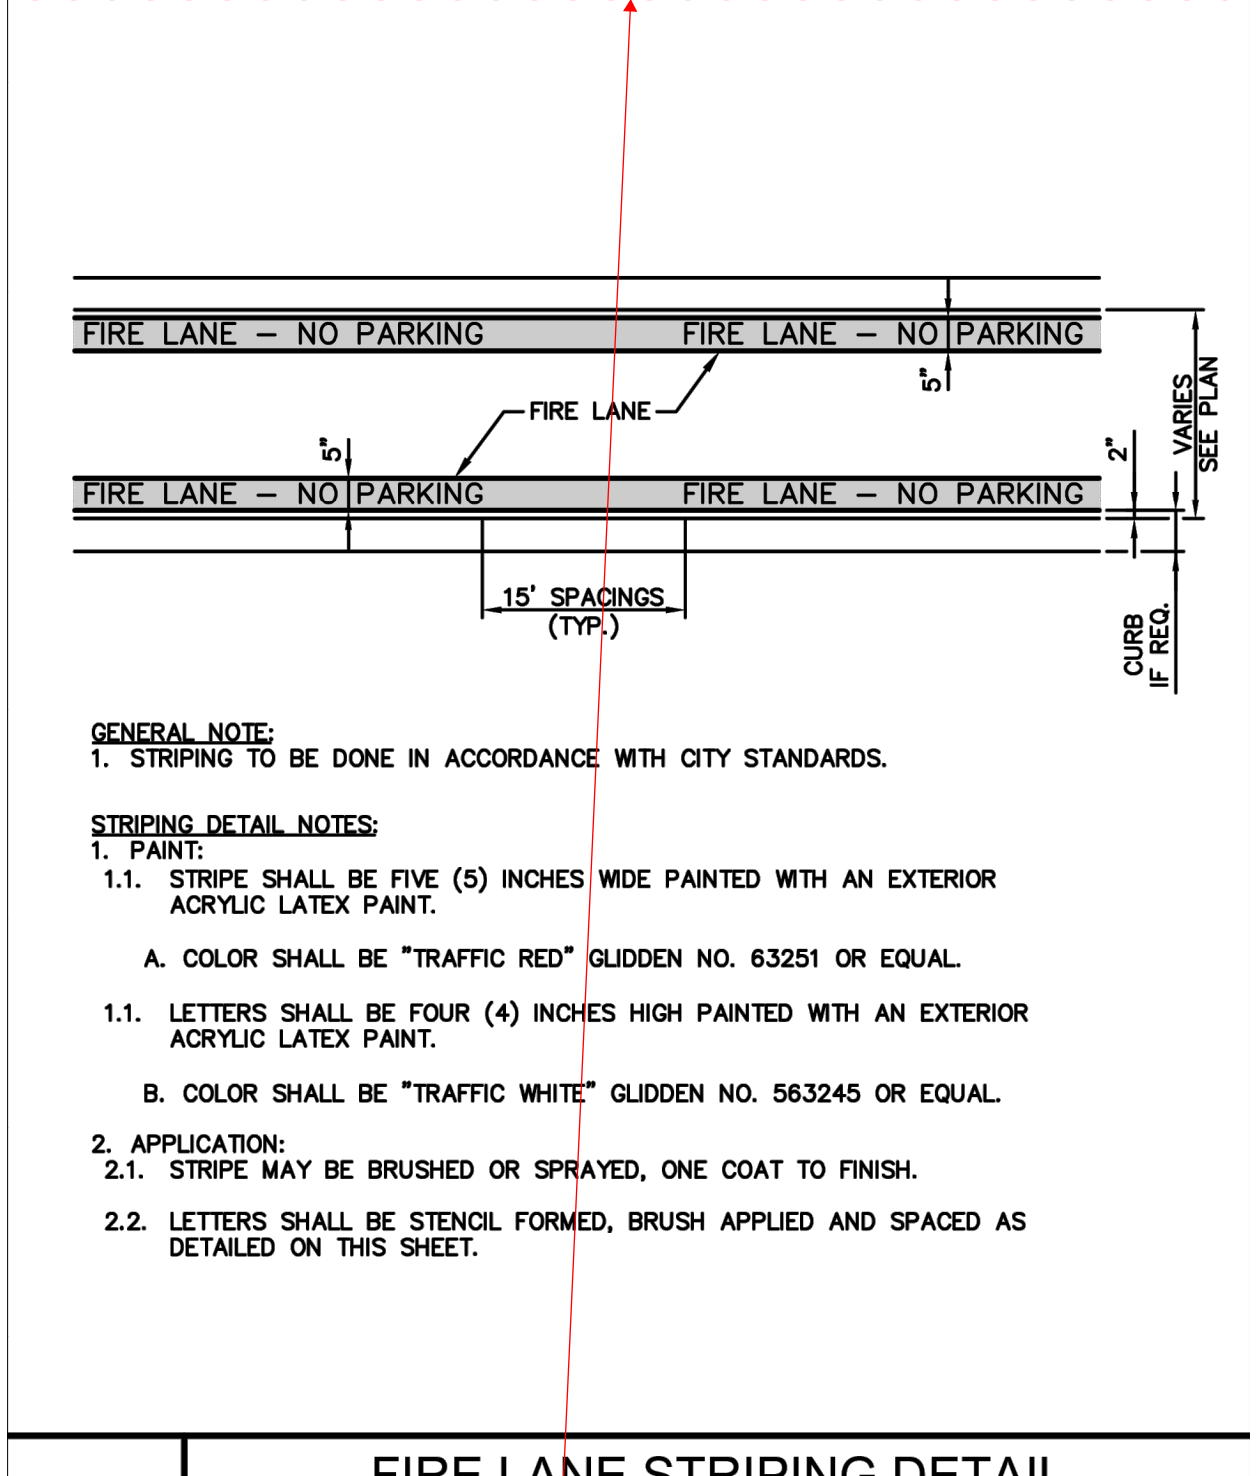

FIRE LANE STRIPING DETAIL
N.T.S.

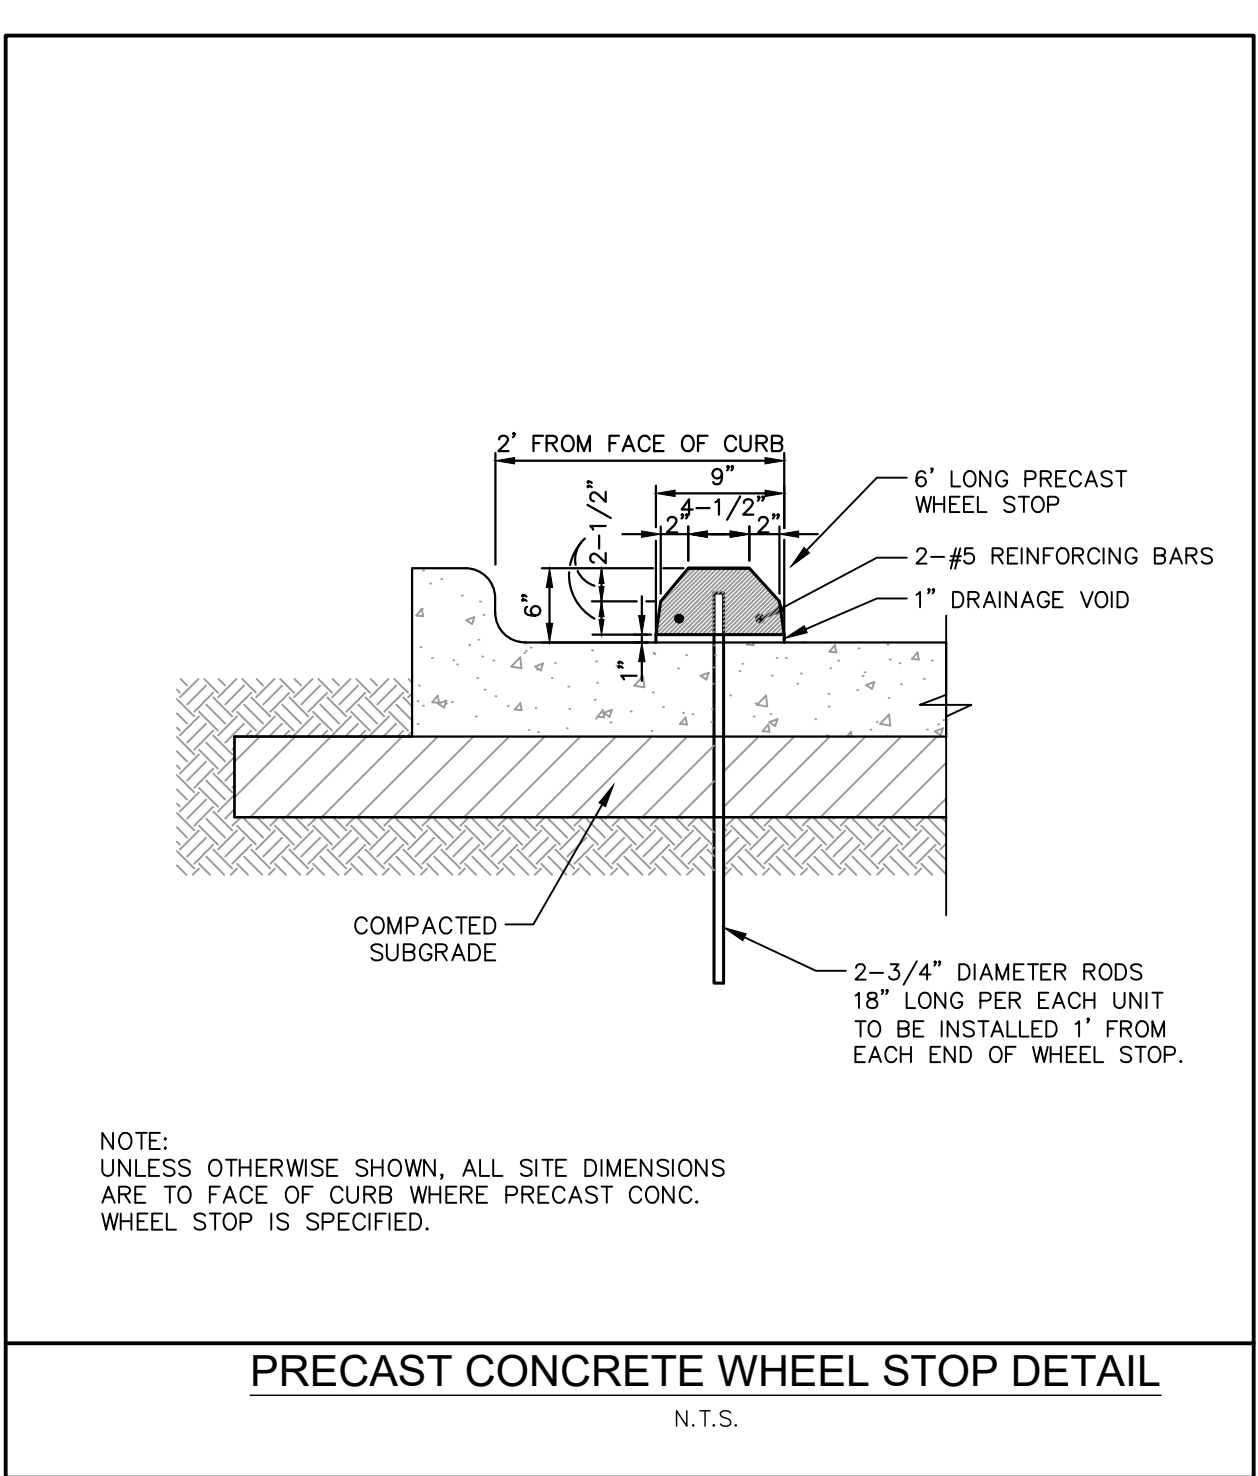


PRECAST CONCRETE WHEEL STOP DETAIL
N.T.S.

Please provide pavement repair details

Duplicate details. Please delete one

NO.	REVISIONS	DATE	BY
© 2024 ANIMAS CIVIL ENGINEERING, LLC PHONE: 214-803-1099 TX F-26500			
PROJECT NAME: BLUE STAR INDUSTRIAL BLDG. L SANGER, TEXAS			
SHEET TITLE: PAVING DETAILS			
ACE PROJECT: 01101 DATE DECEMBER 2024 SCALE AS SHOWN DRAWN BY: MD SHEET NUMBER C-8.02			

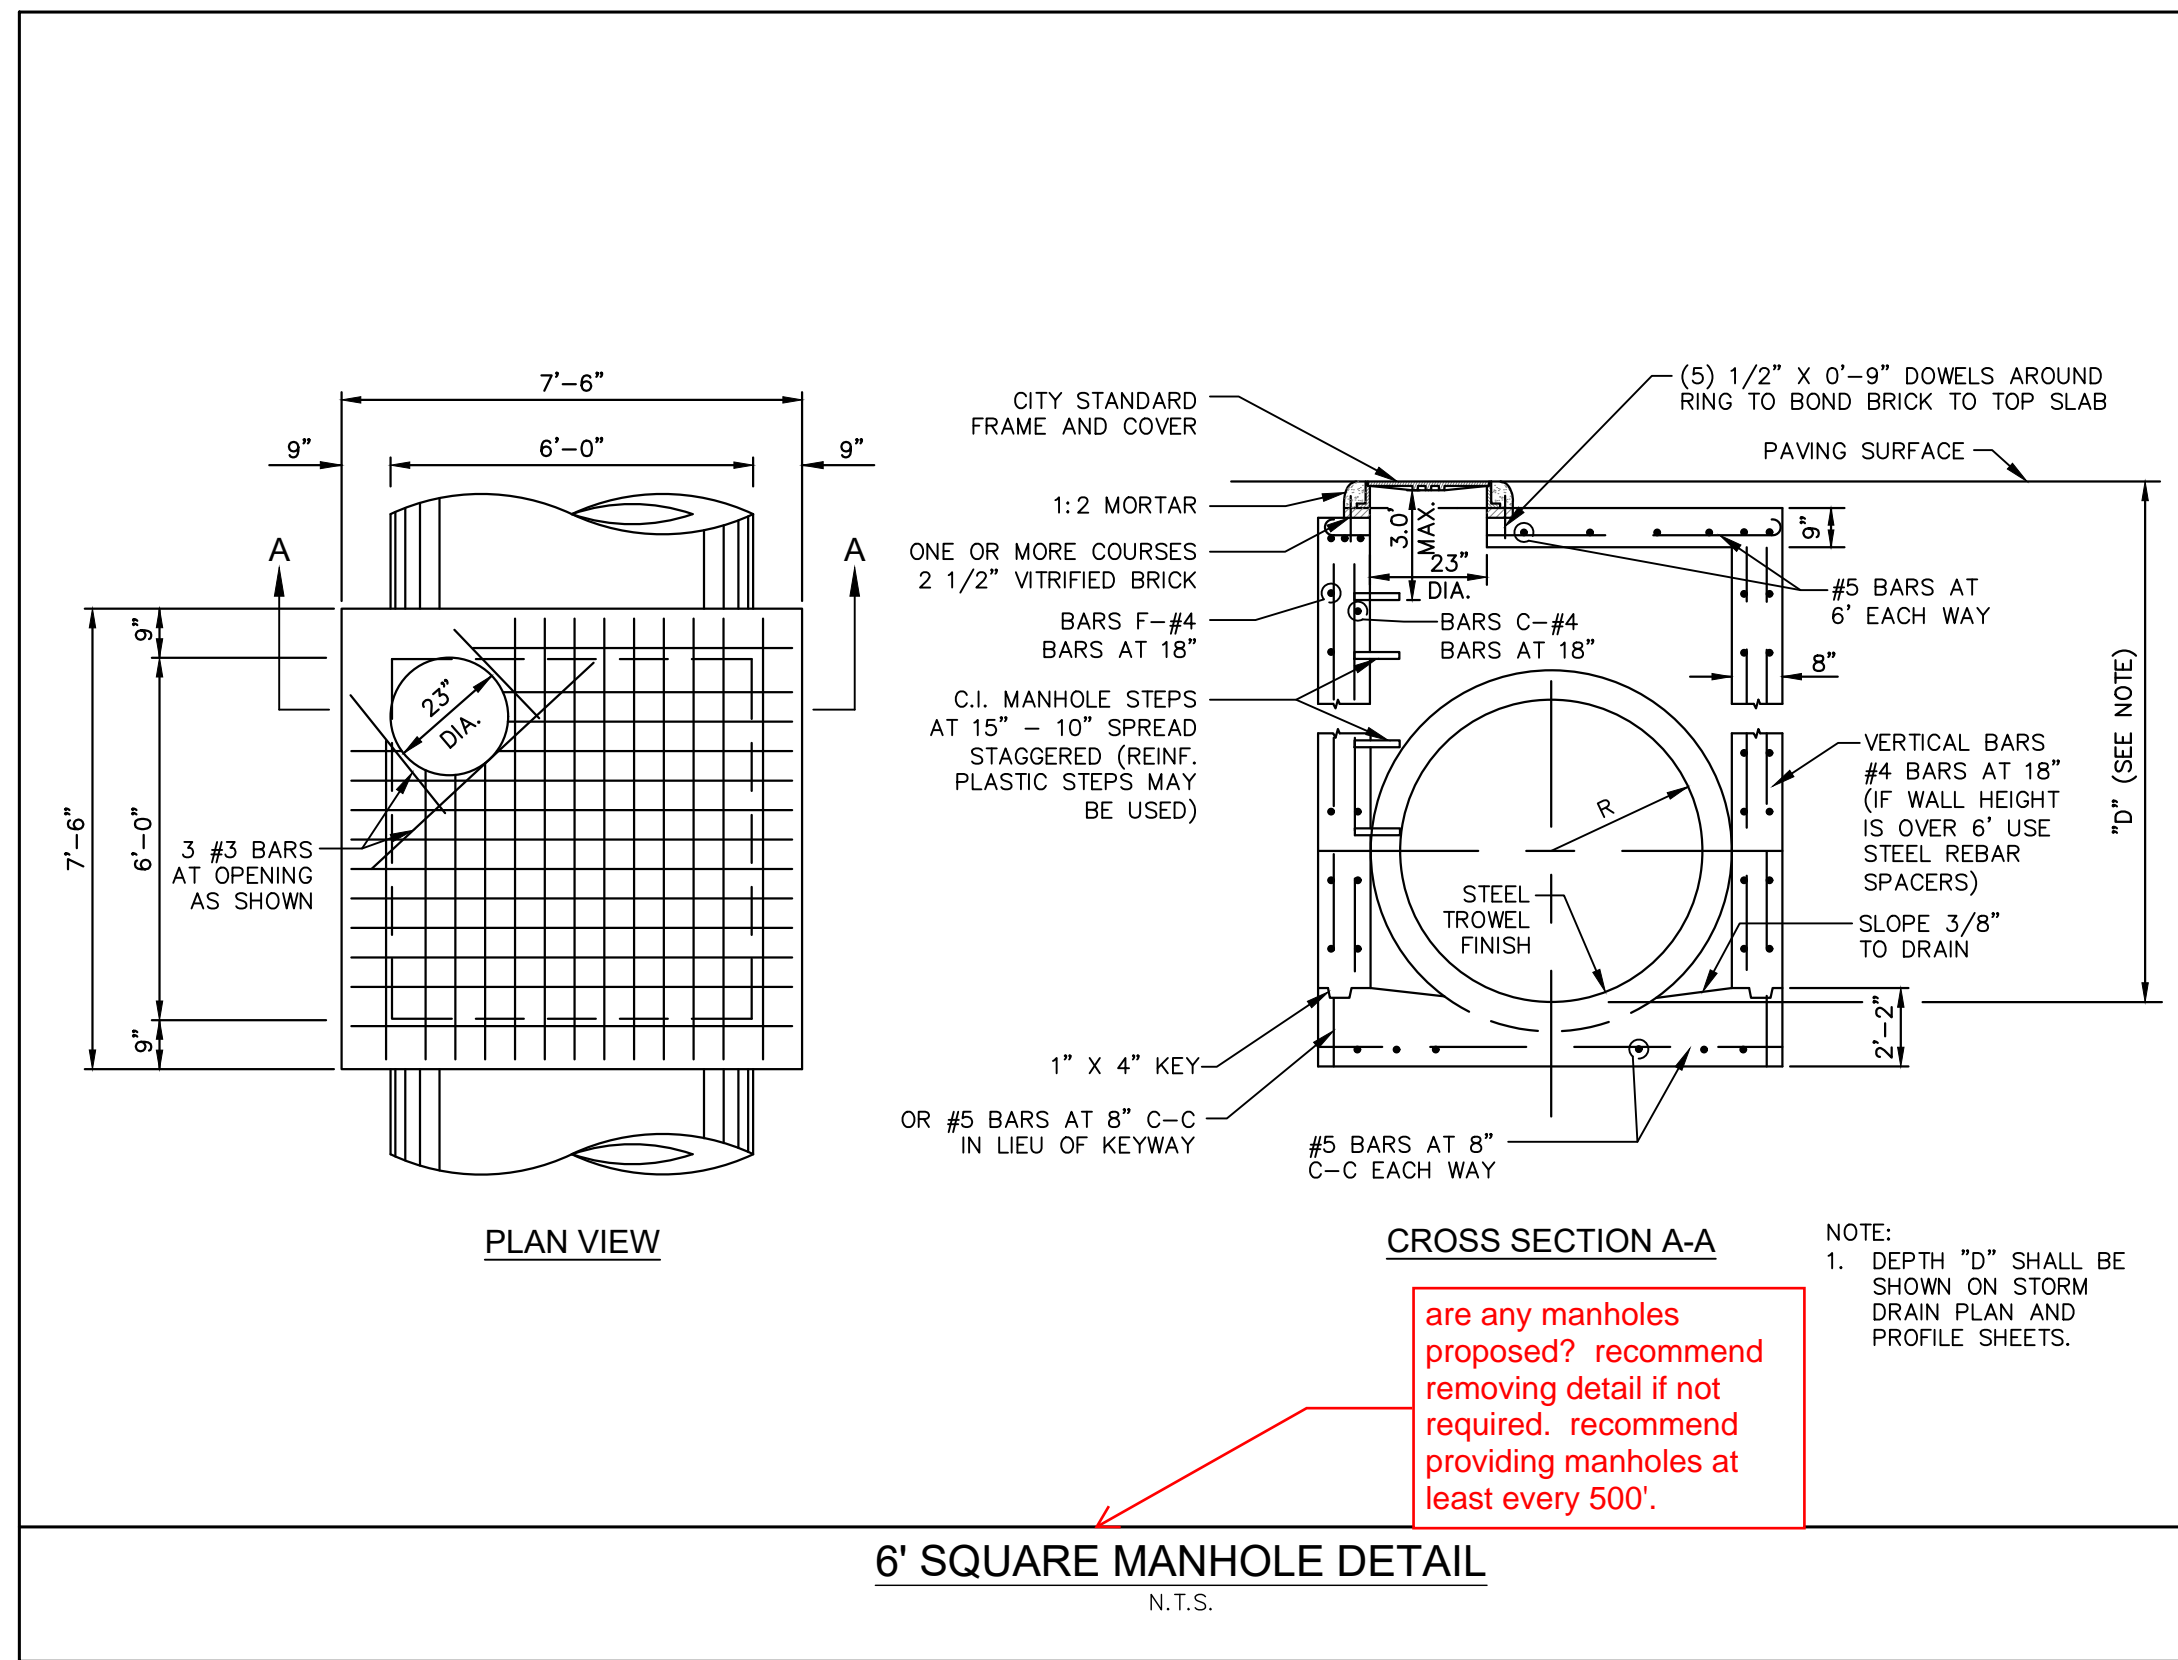

are any manholes proposed? recommend removing detail if not required. recommend providing manholes at least every 500'.




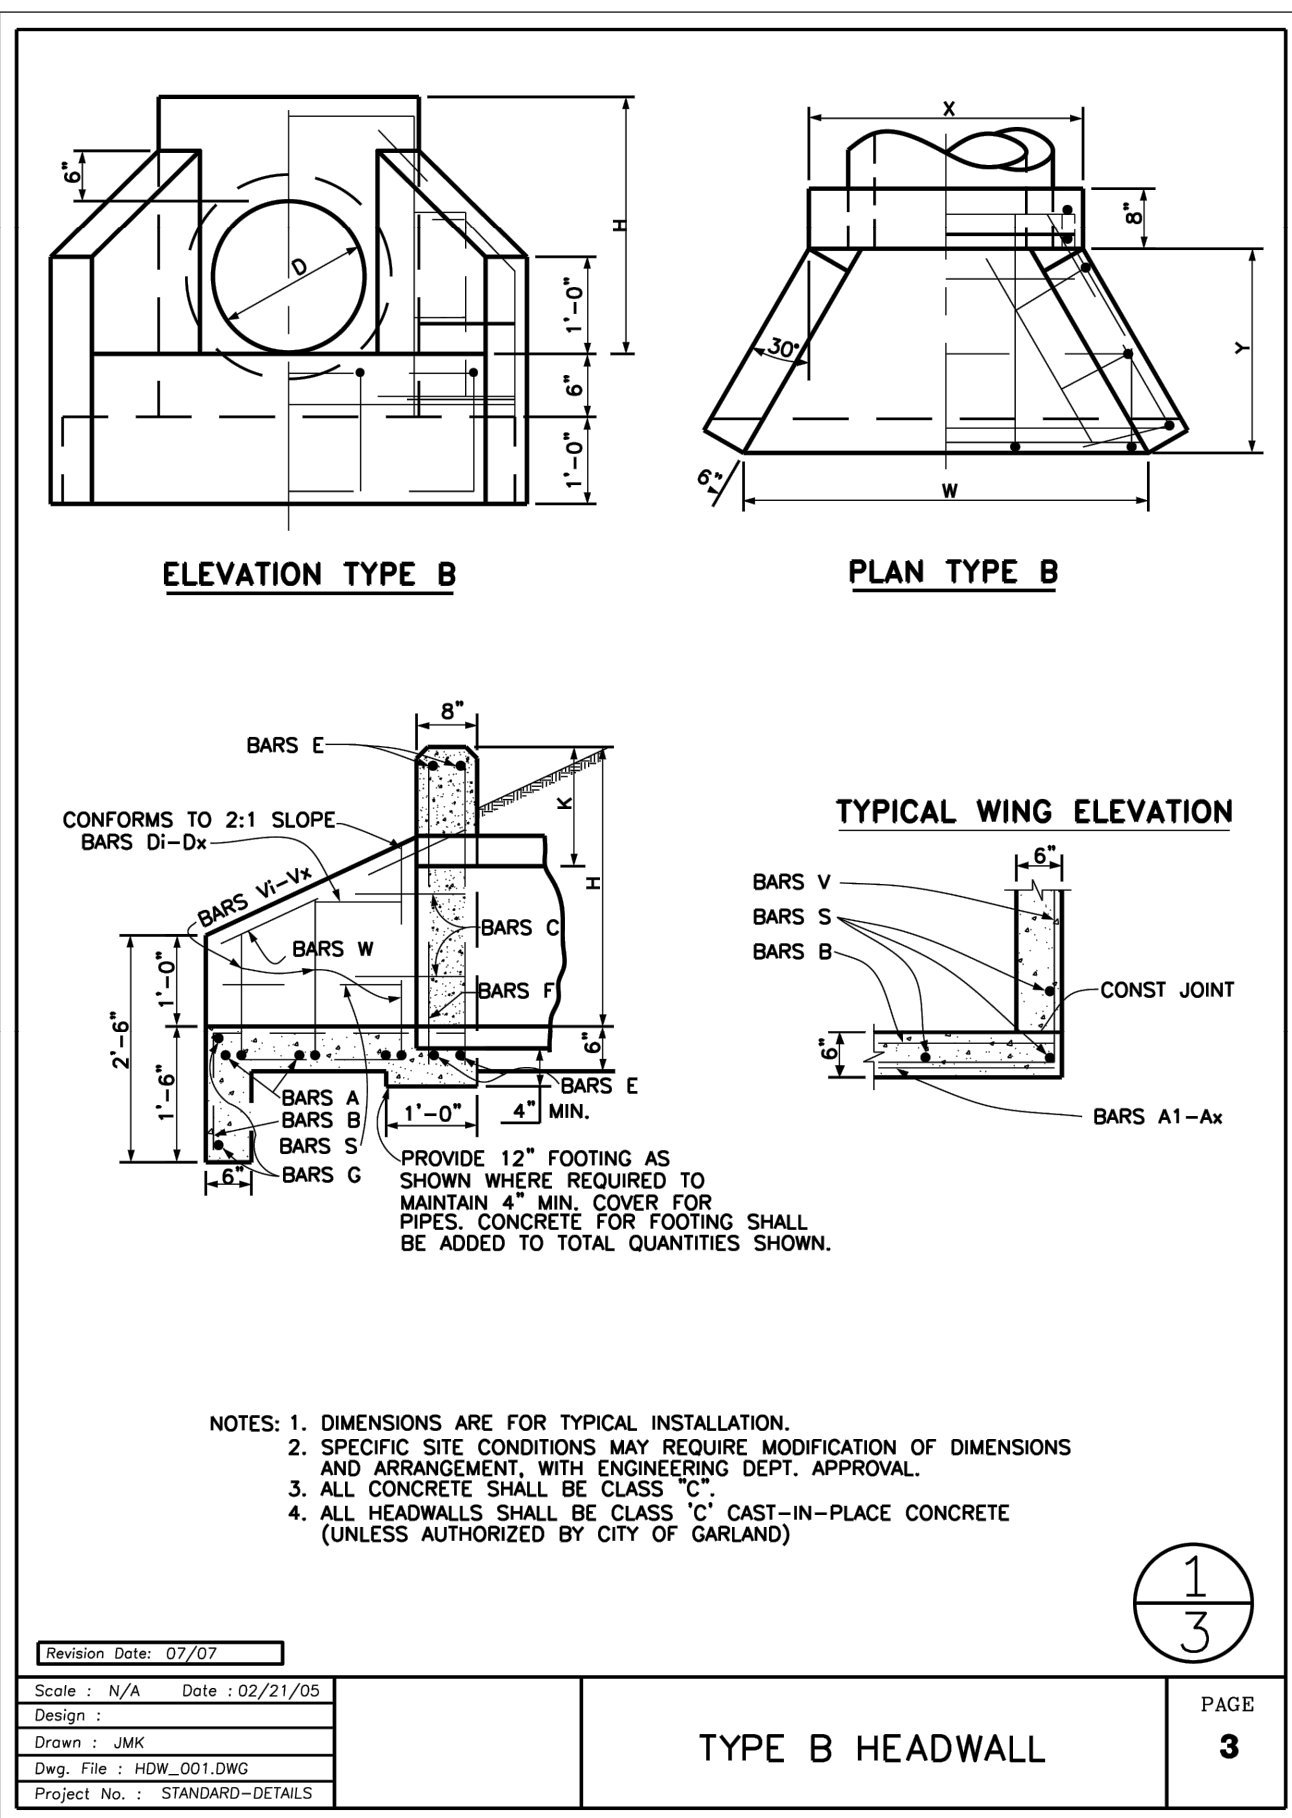



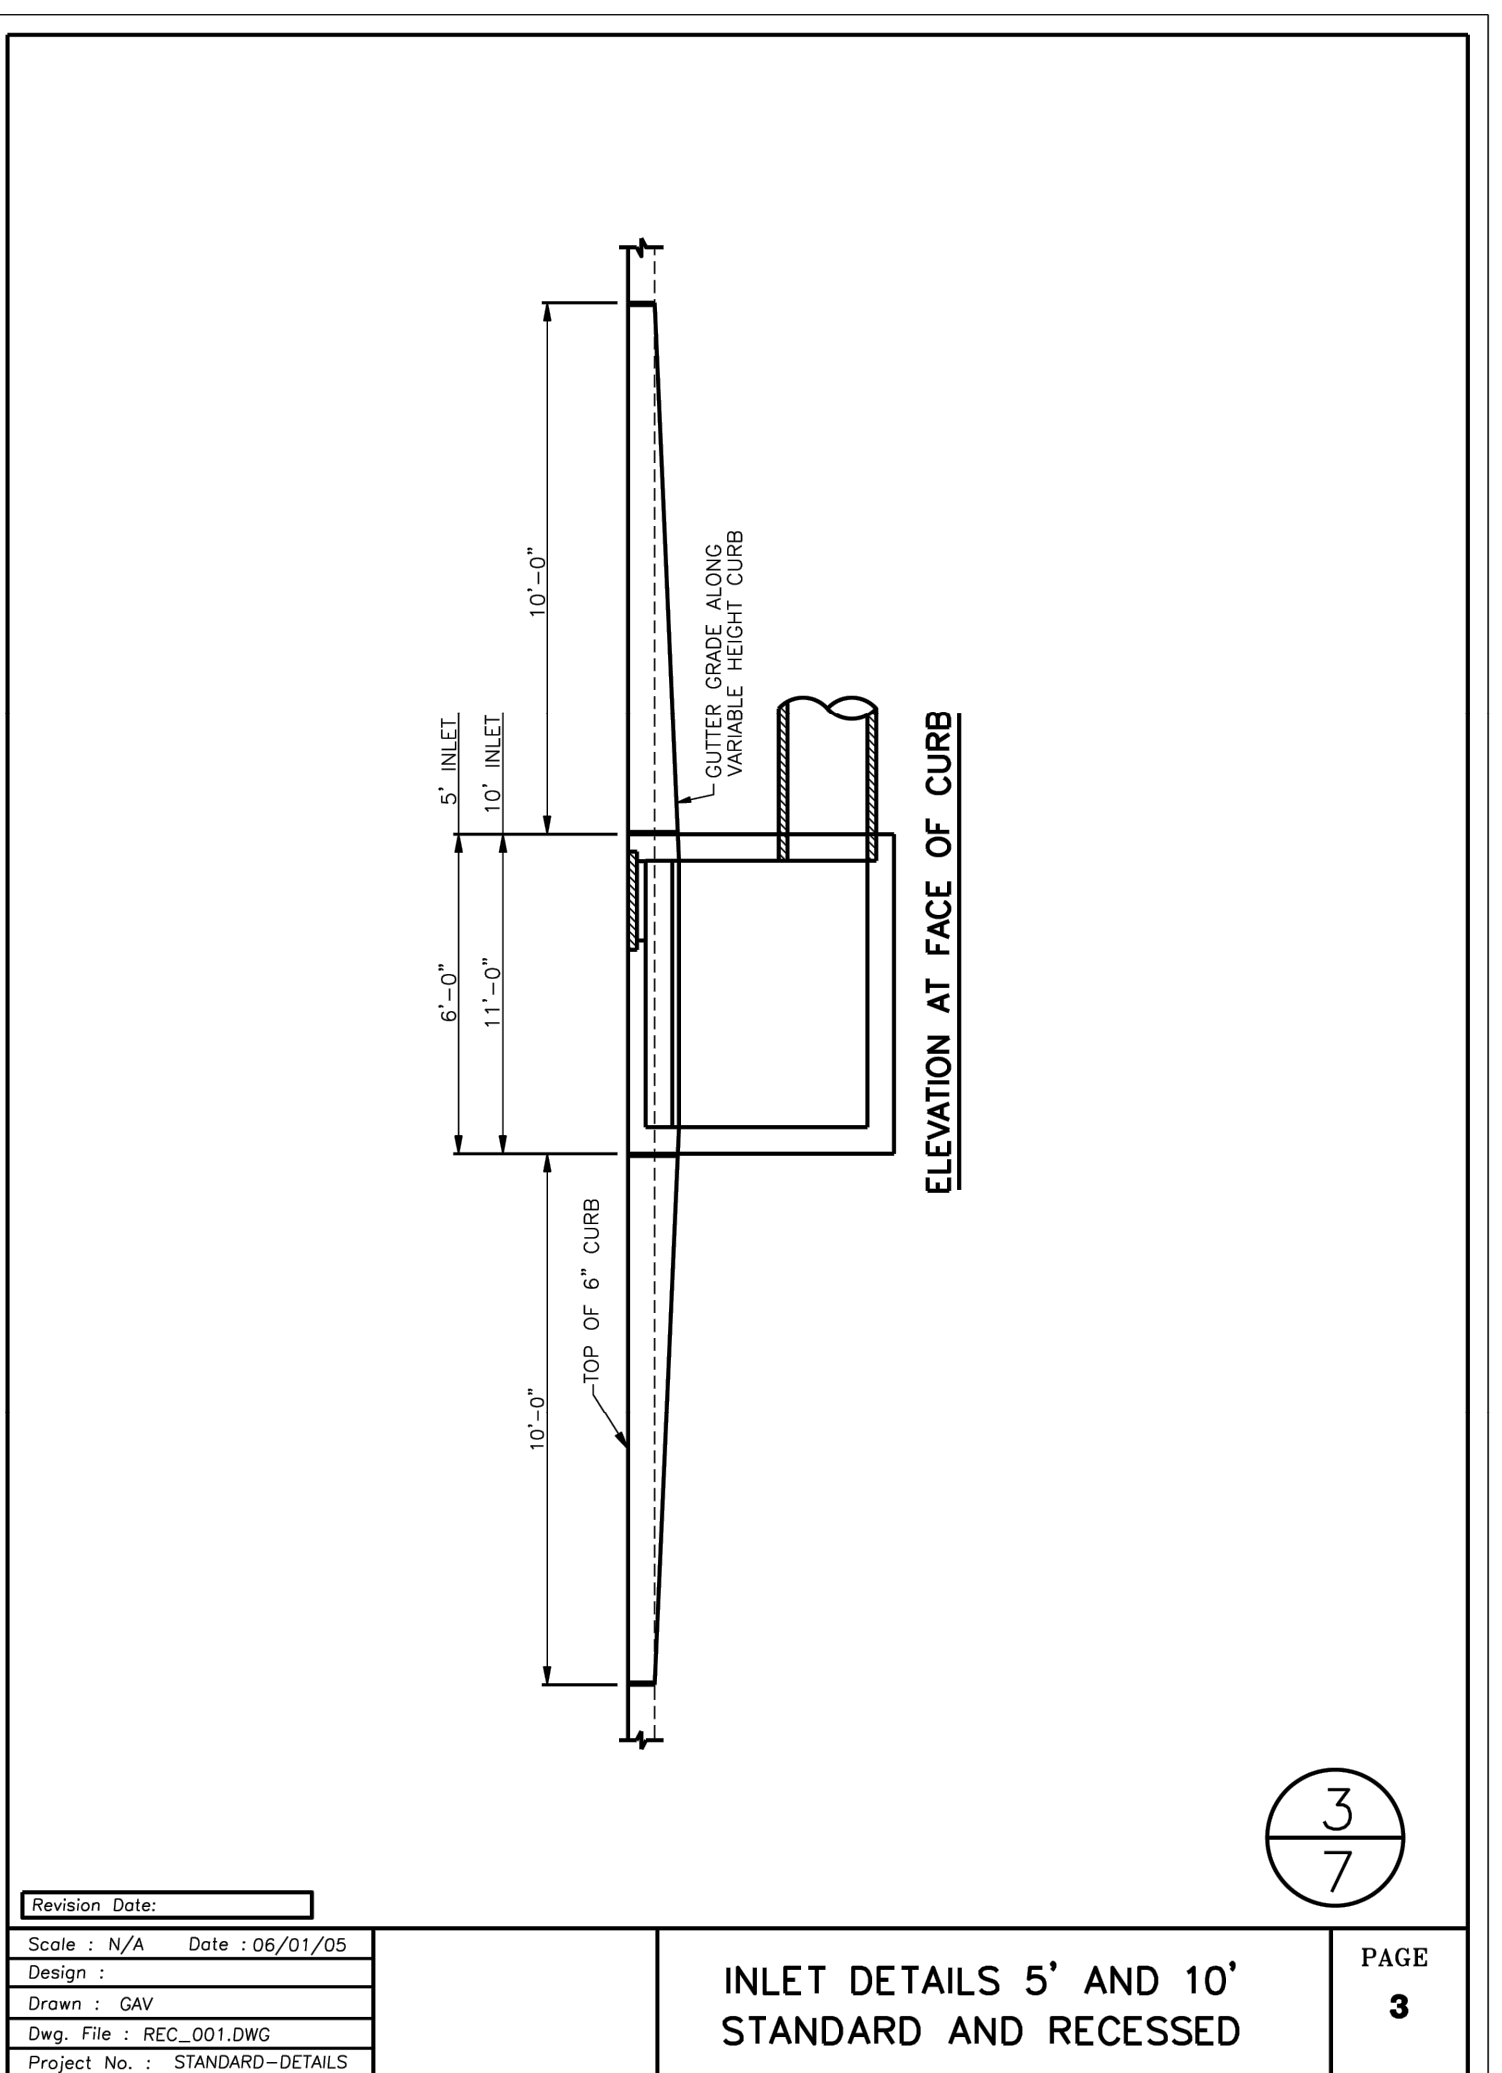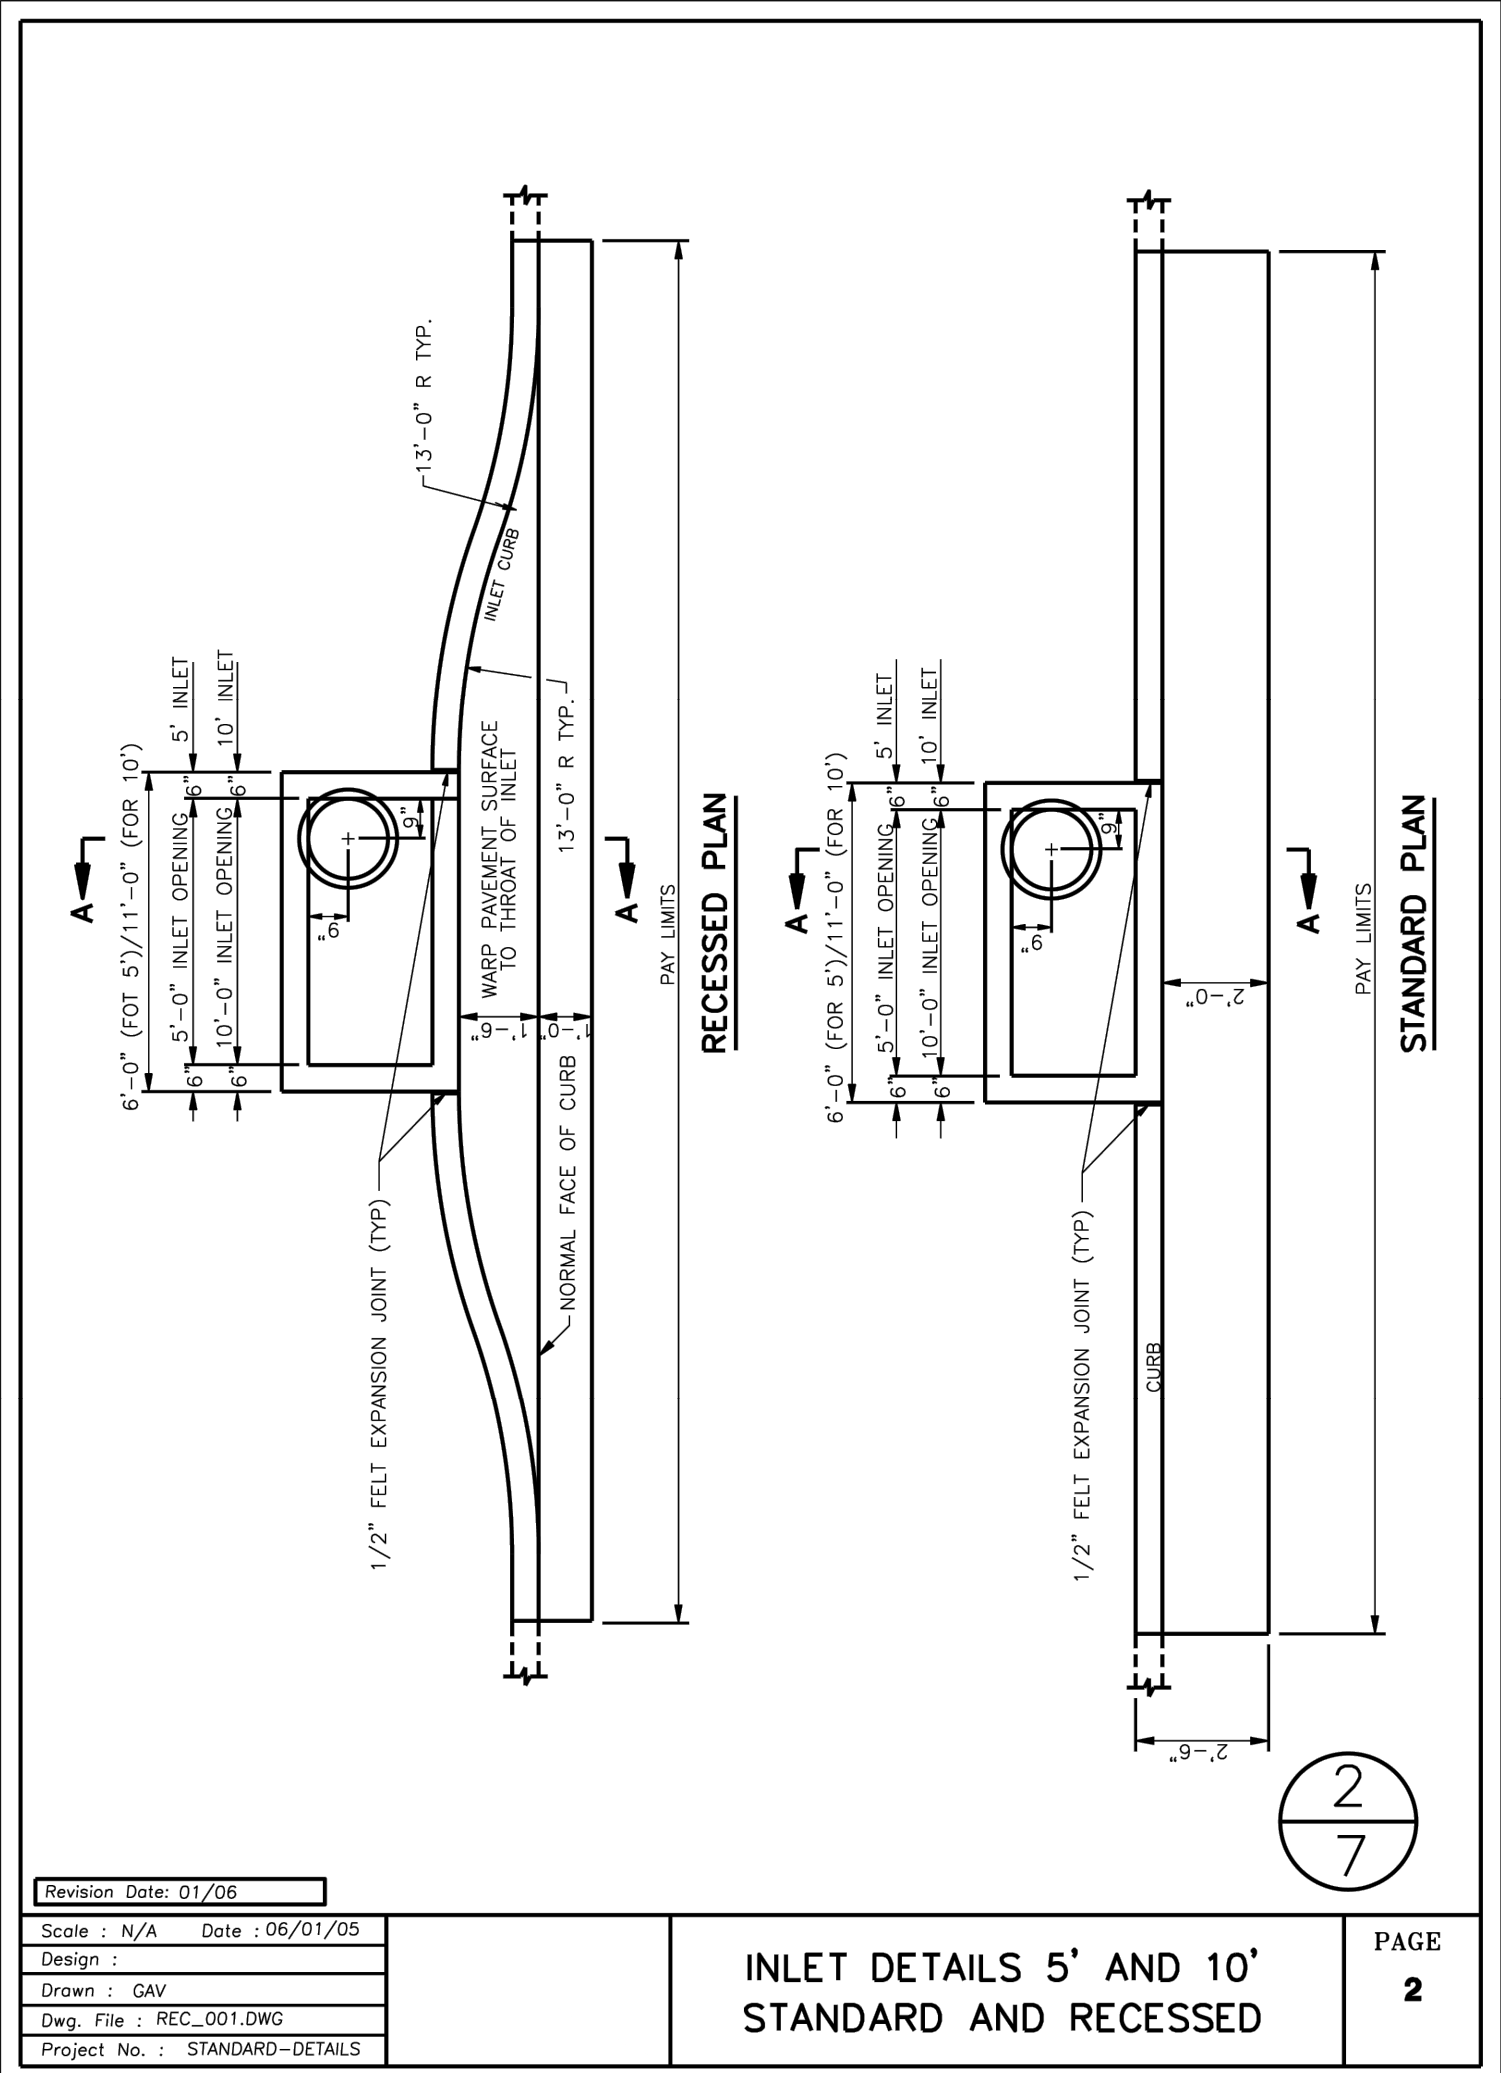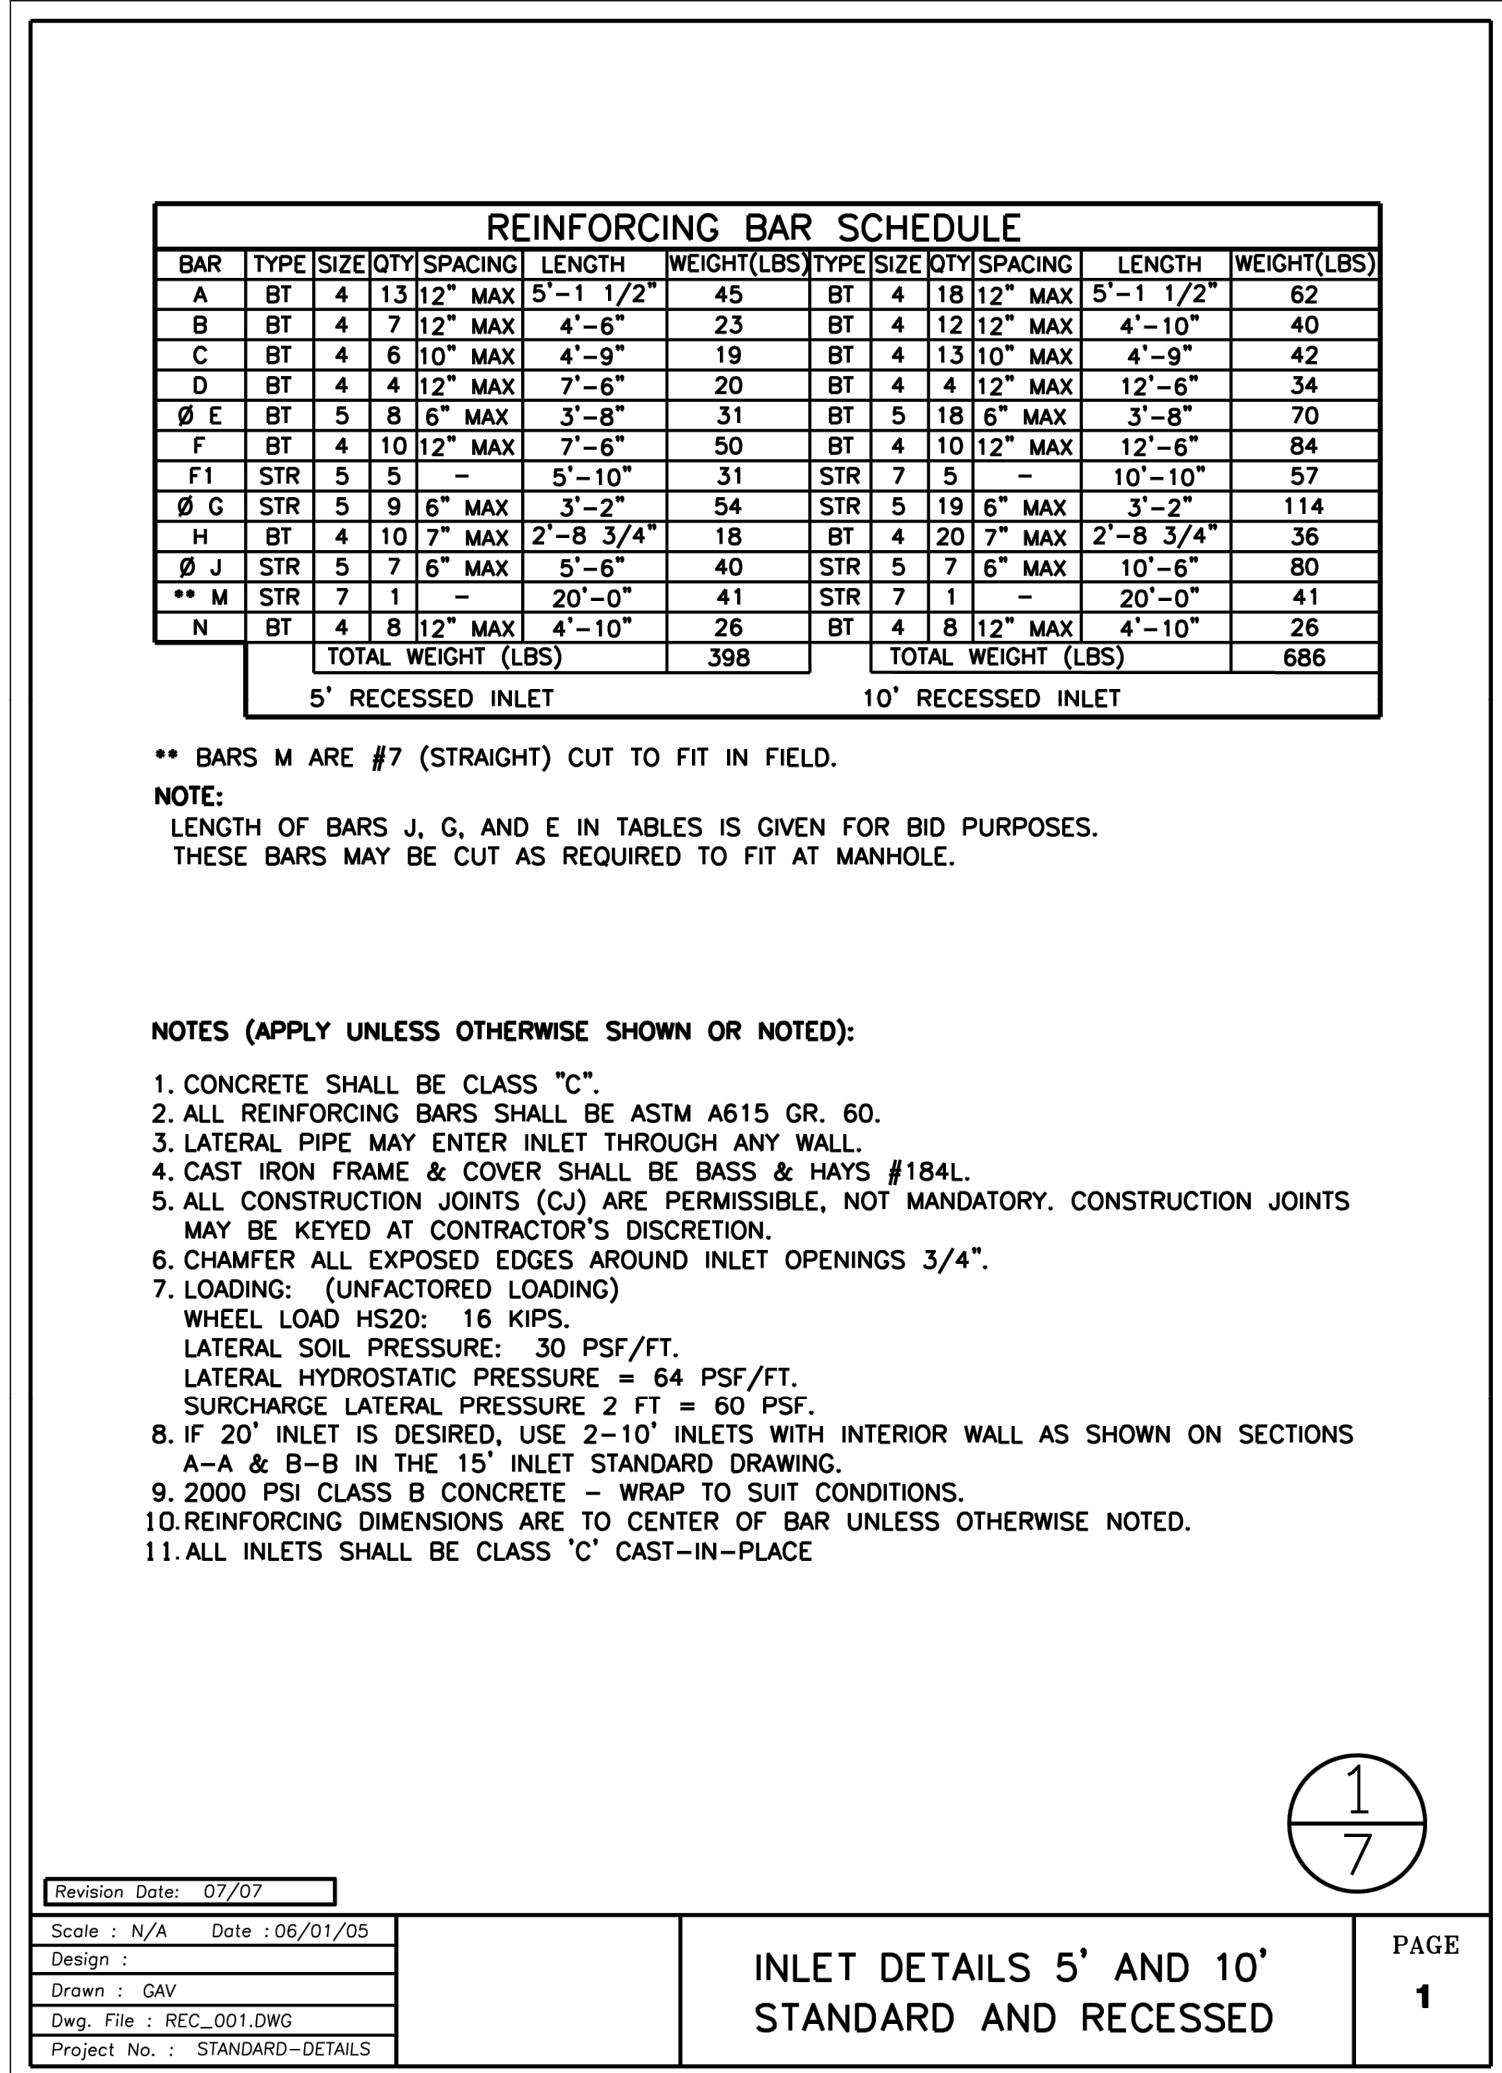

PROJECT NAME: BLUE STAR INDUSTRIAL BLDG. L SANGER, TEXAS

SHEET TITLE: DRAINAGE DETAILS

ACE PROJECT: 01101

DATE: DECEMBER 2024

SCALE: AS SHOWN






DRAWN BY: MD

SHEET NUMBER: C-8.03


PROFESSIONAL ENGINEER: MICHAEL T. DOGGETT 98628 12/17/2024

CIVIL ENGINEERING: ANIMAS CIVIL ENGINEERING, LLC PHONE: 214-803-1099 TX F-26500

REVISIONS: DATE BY

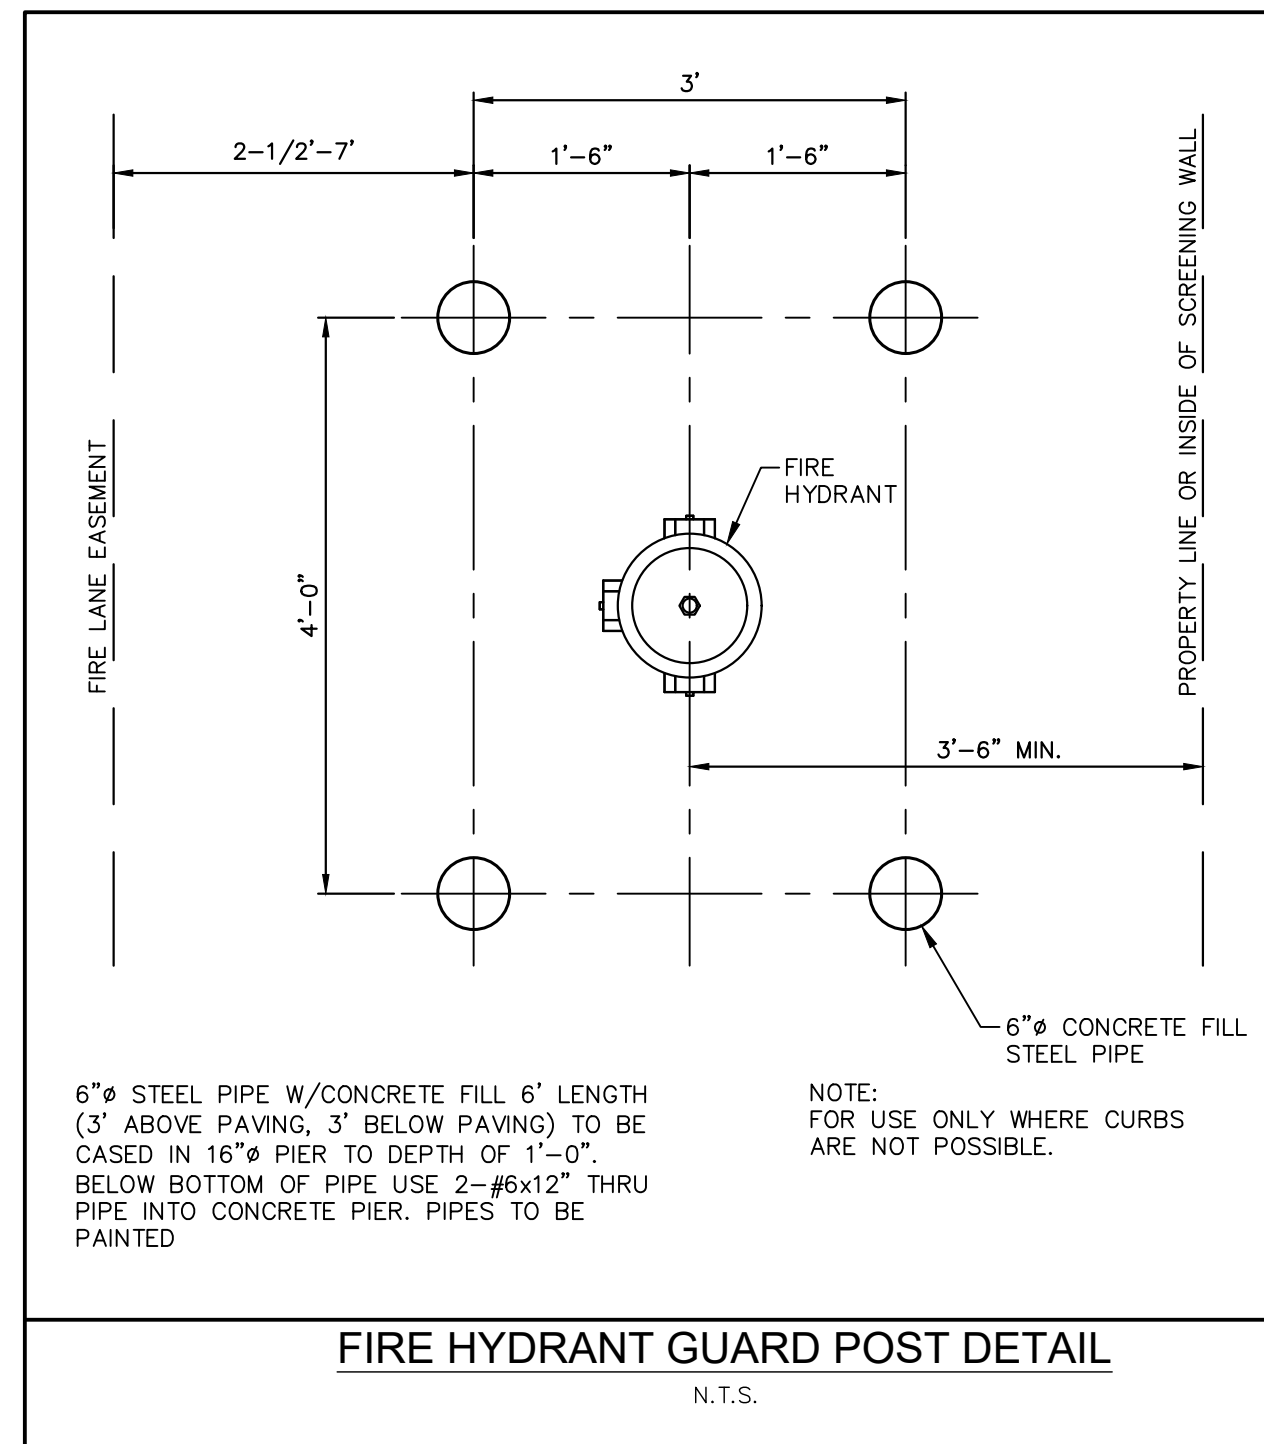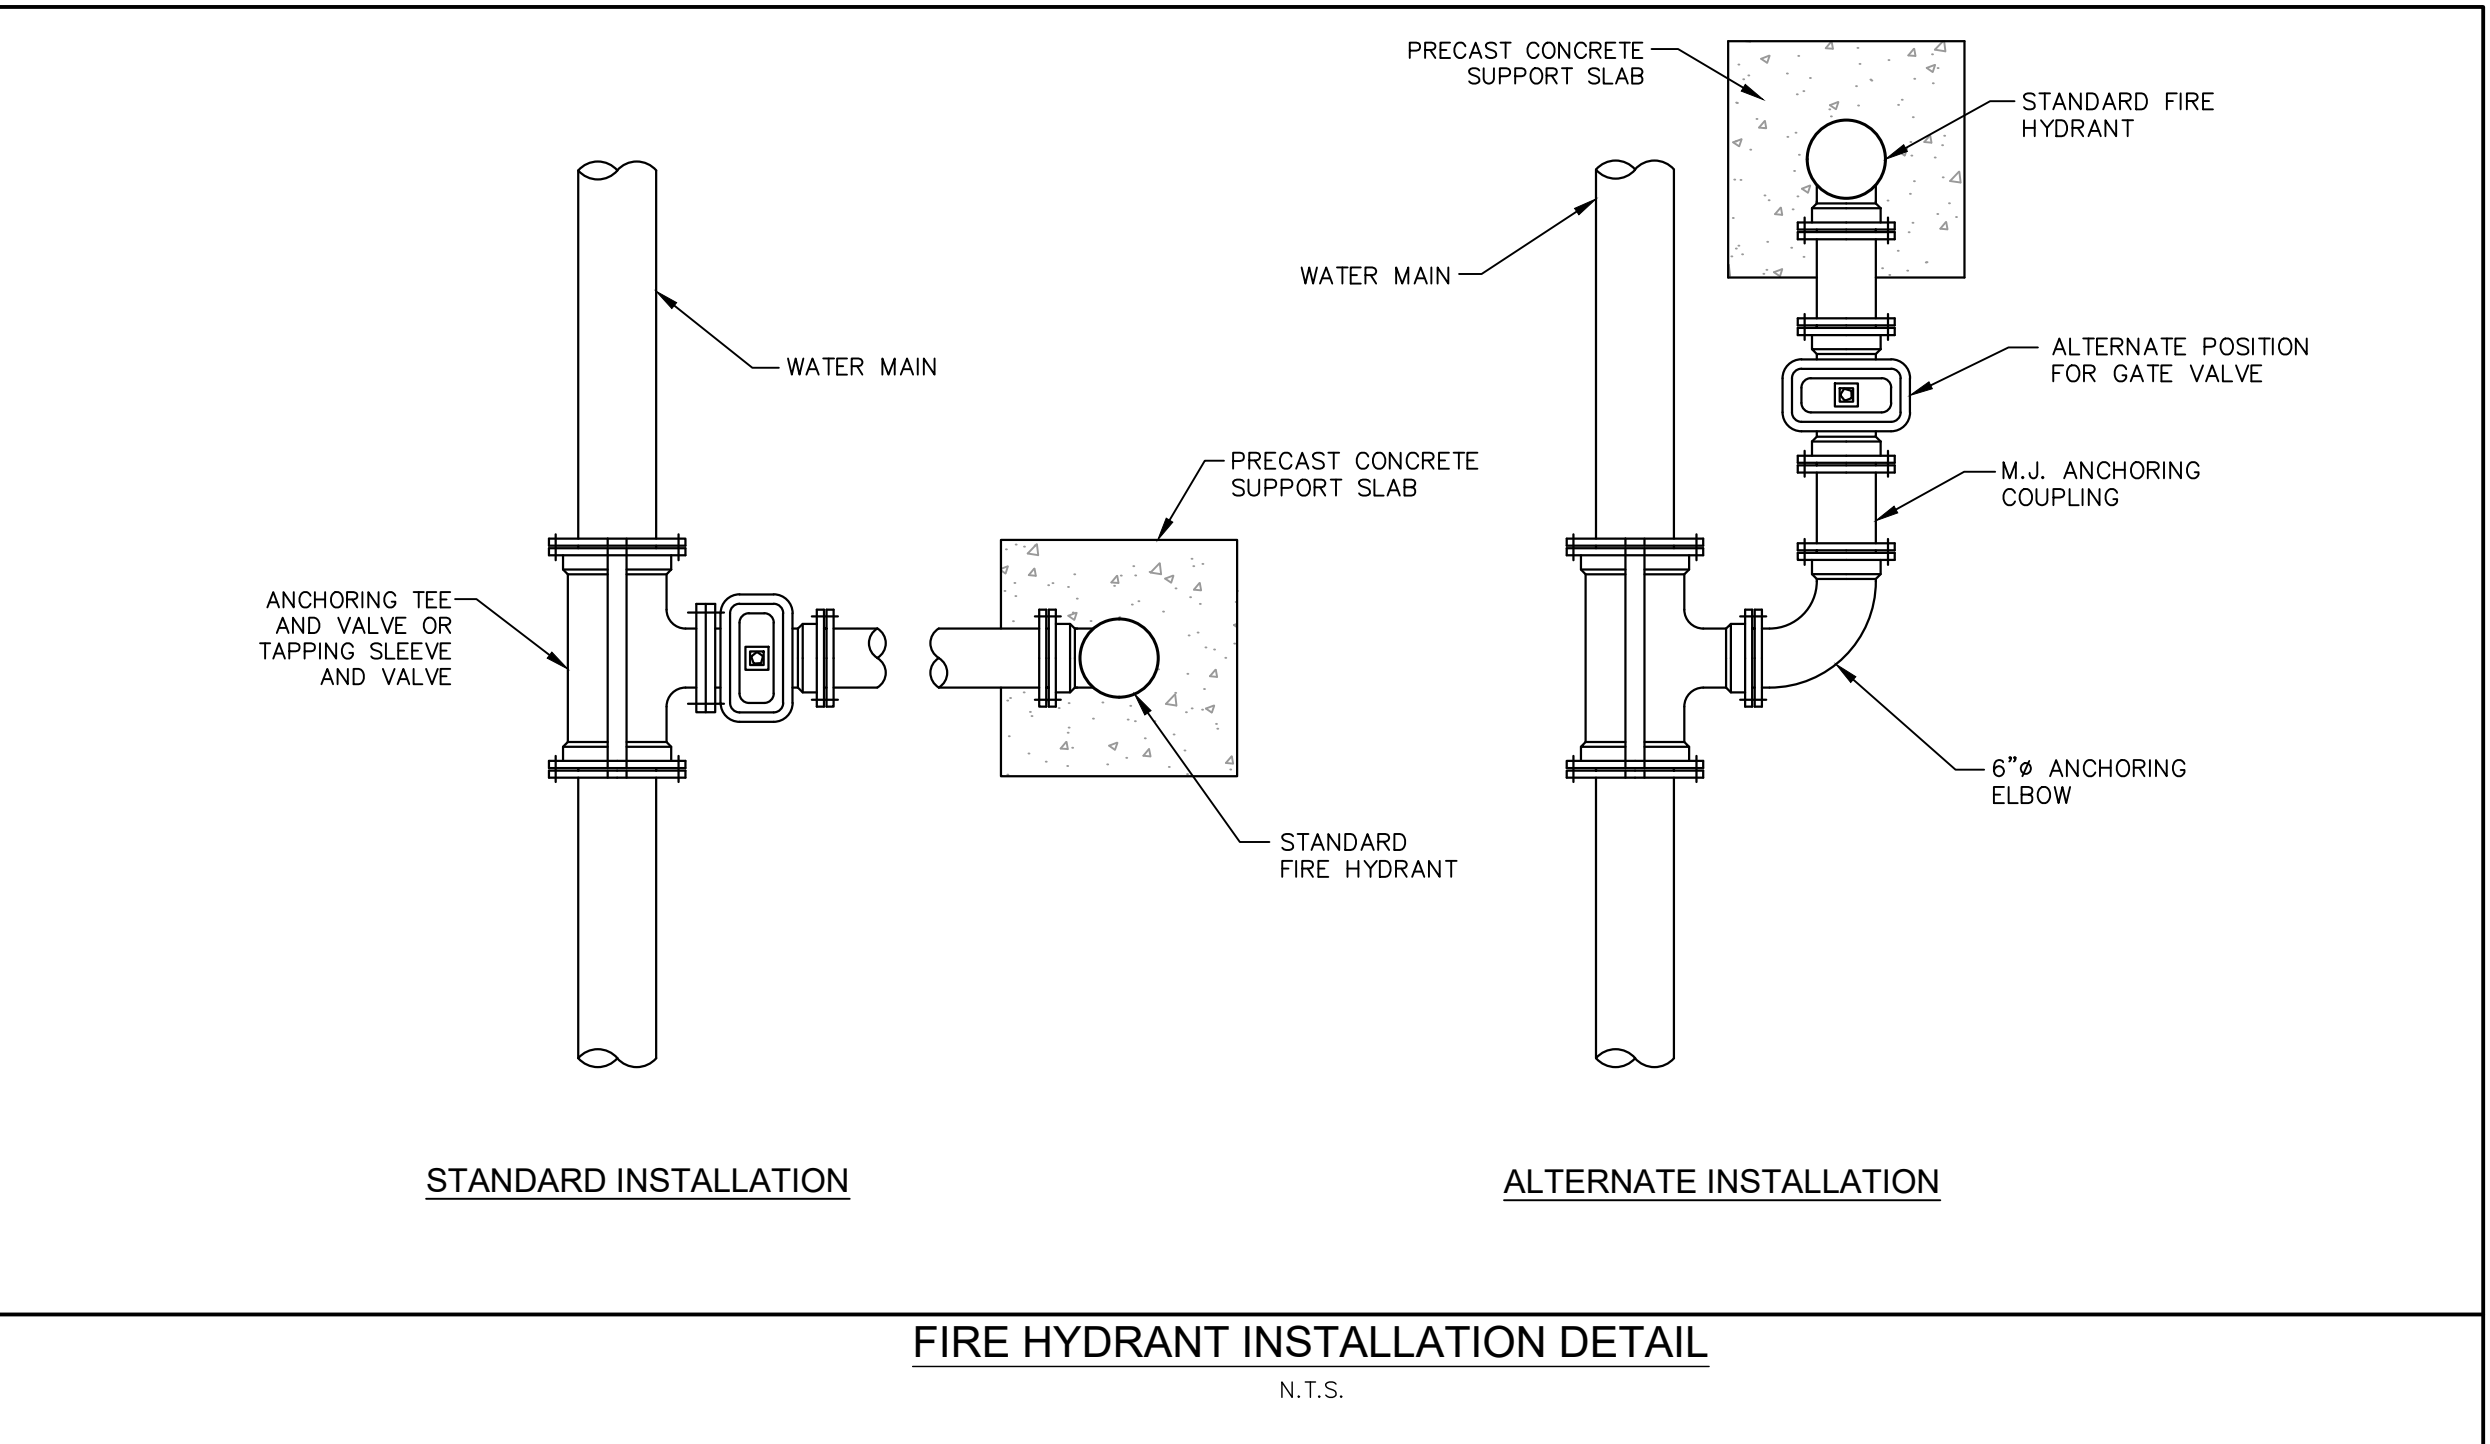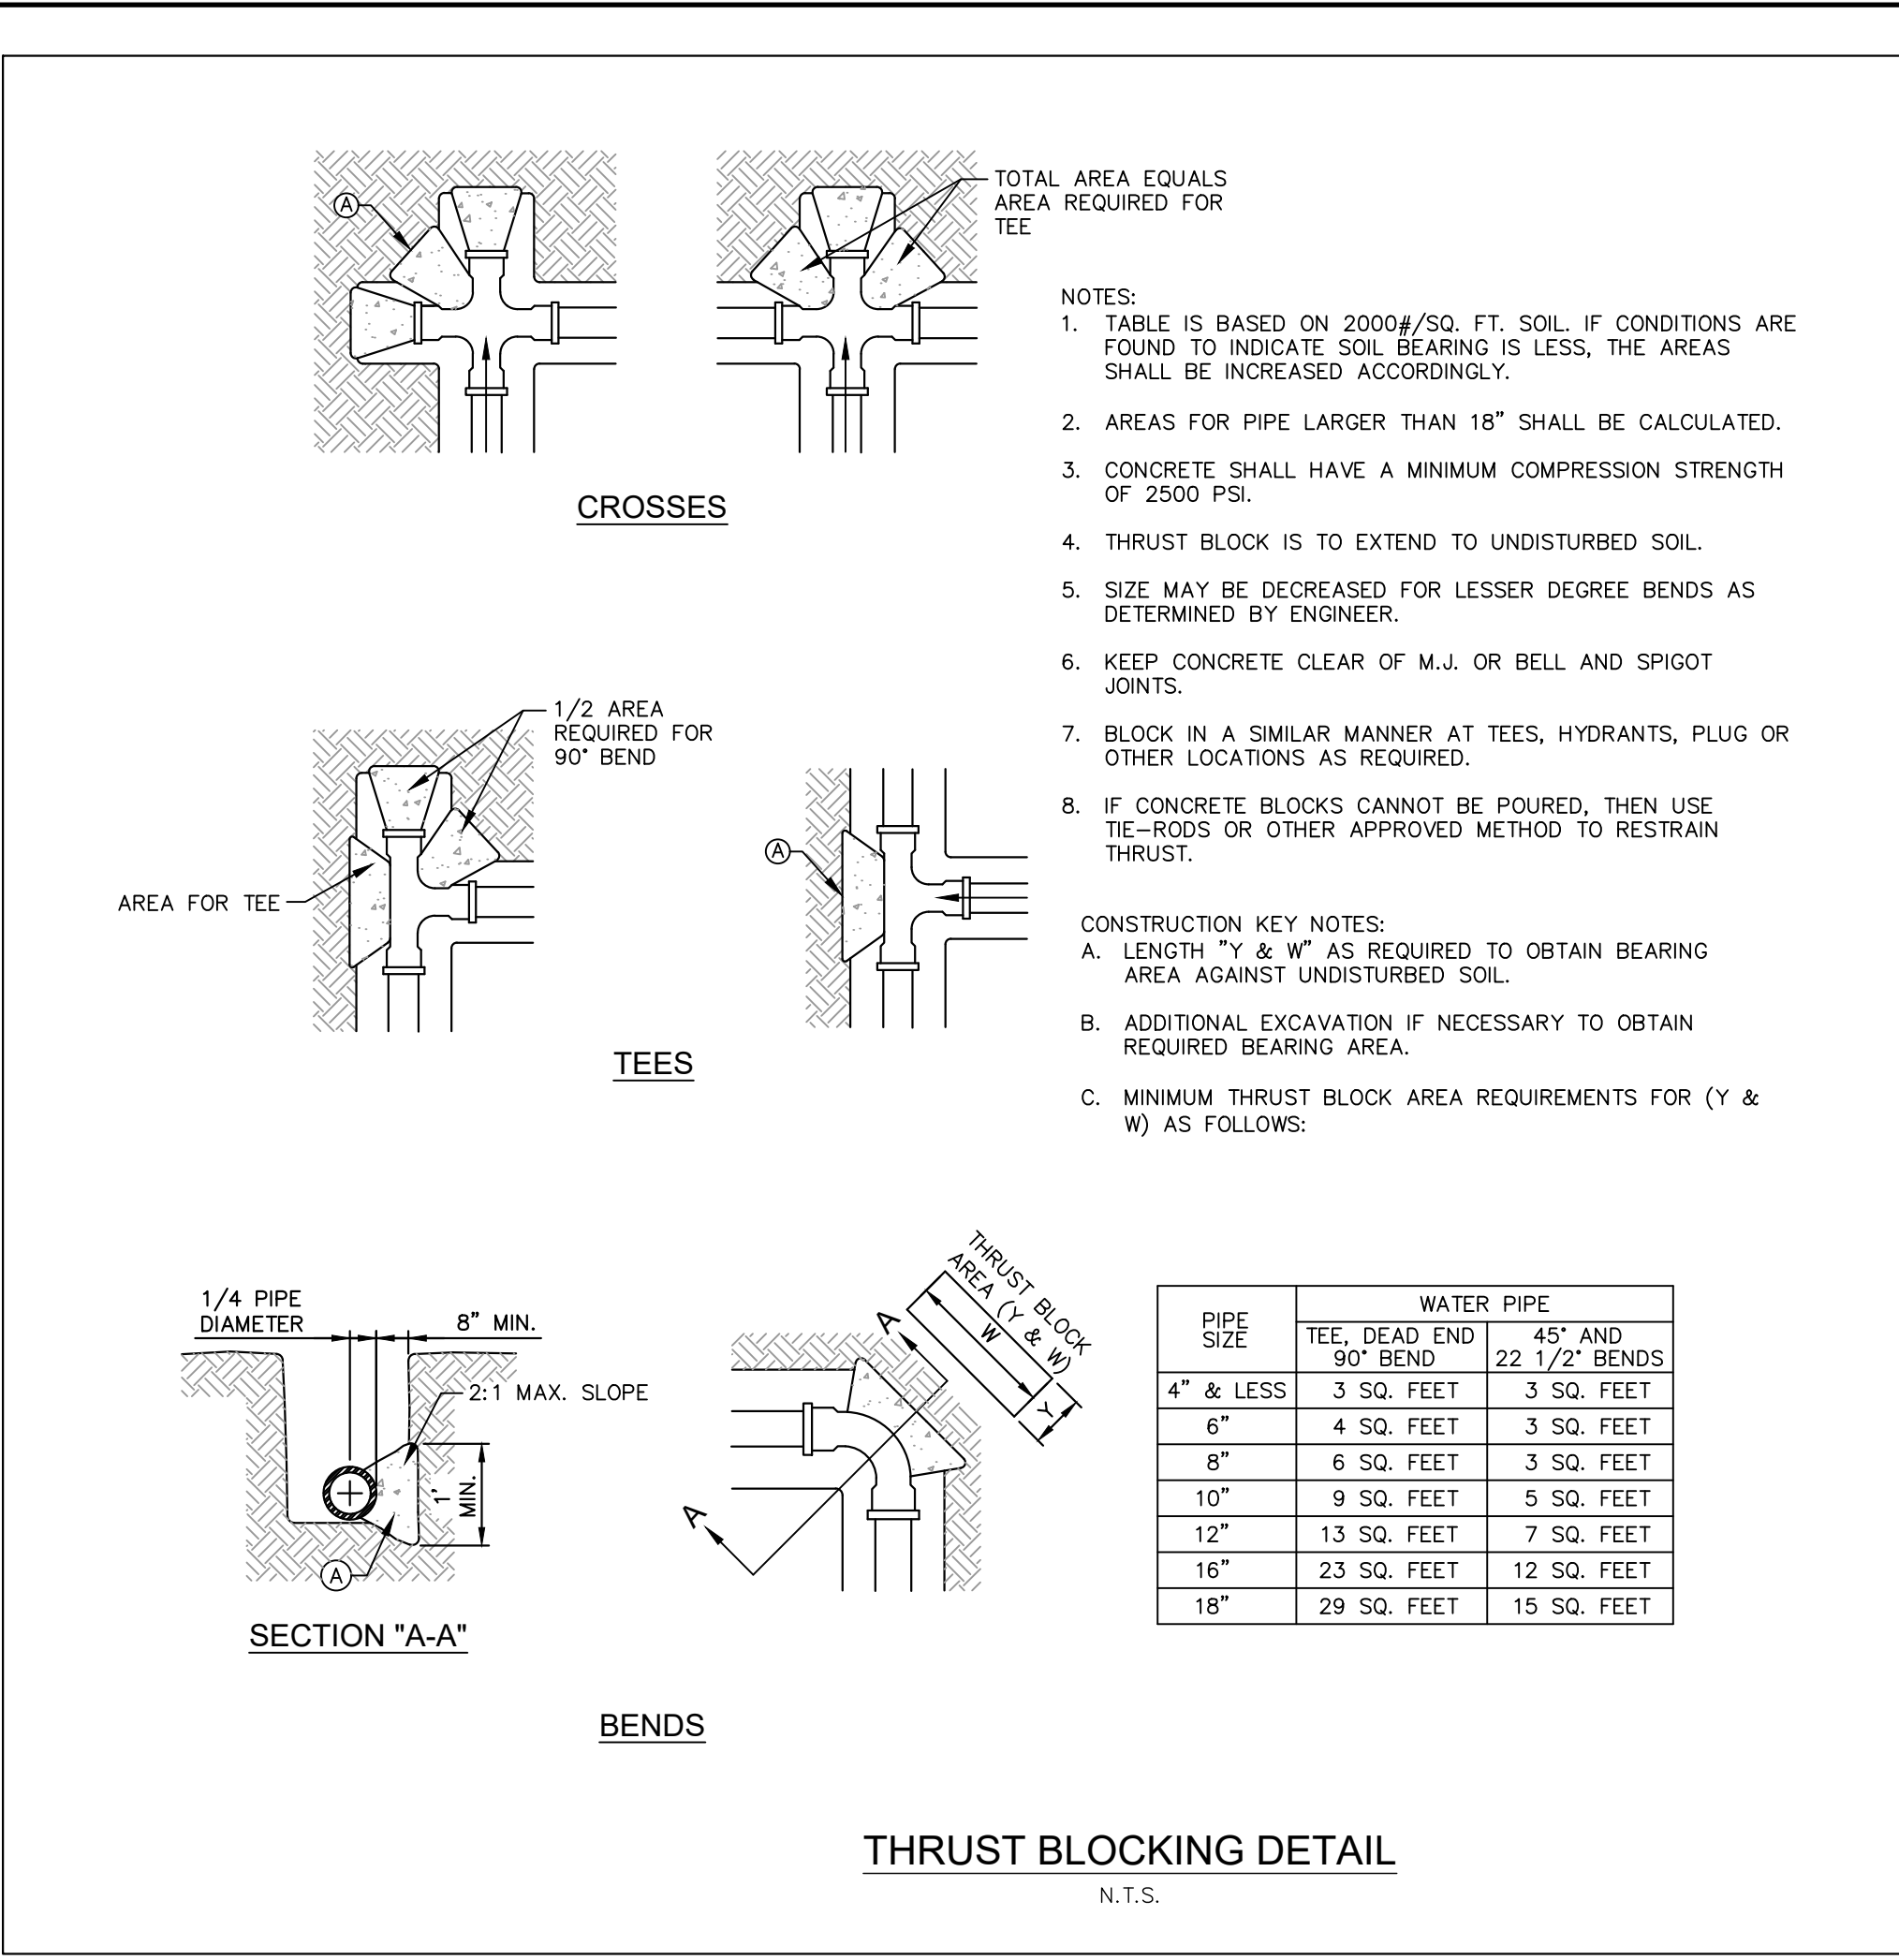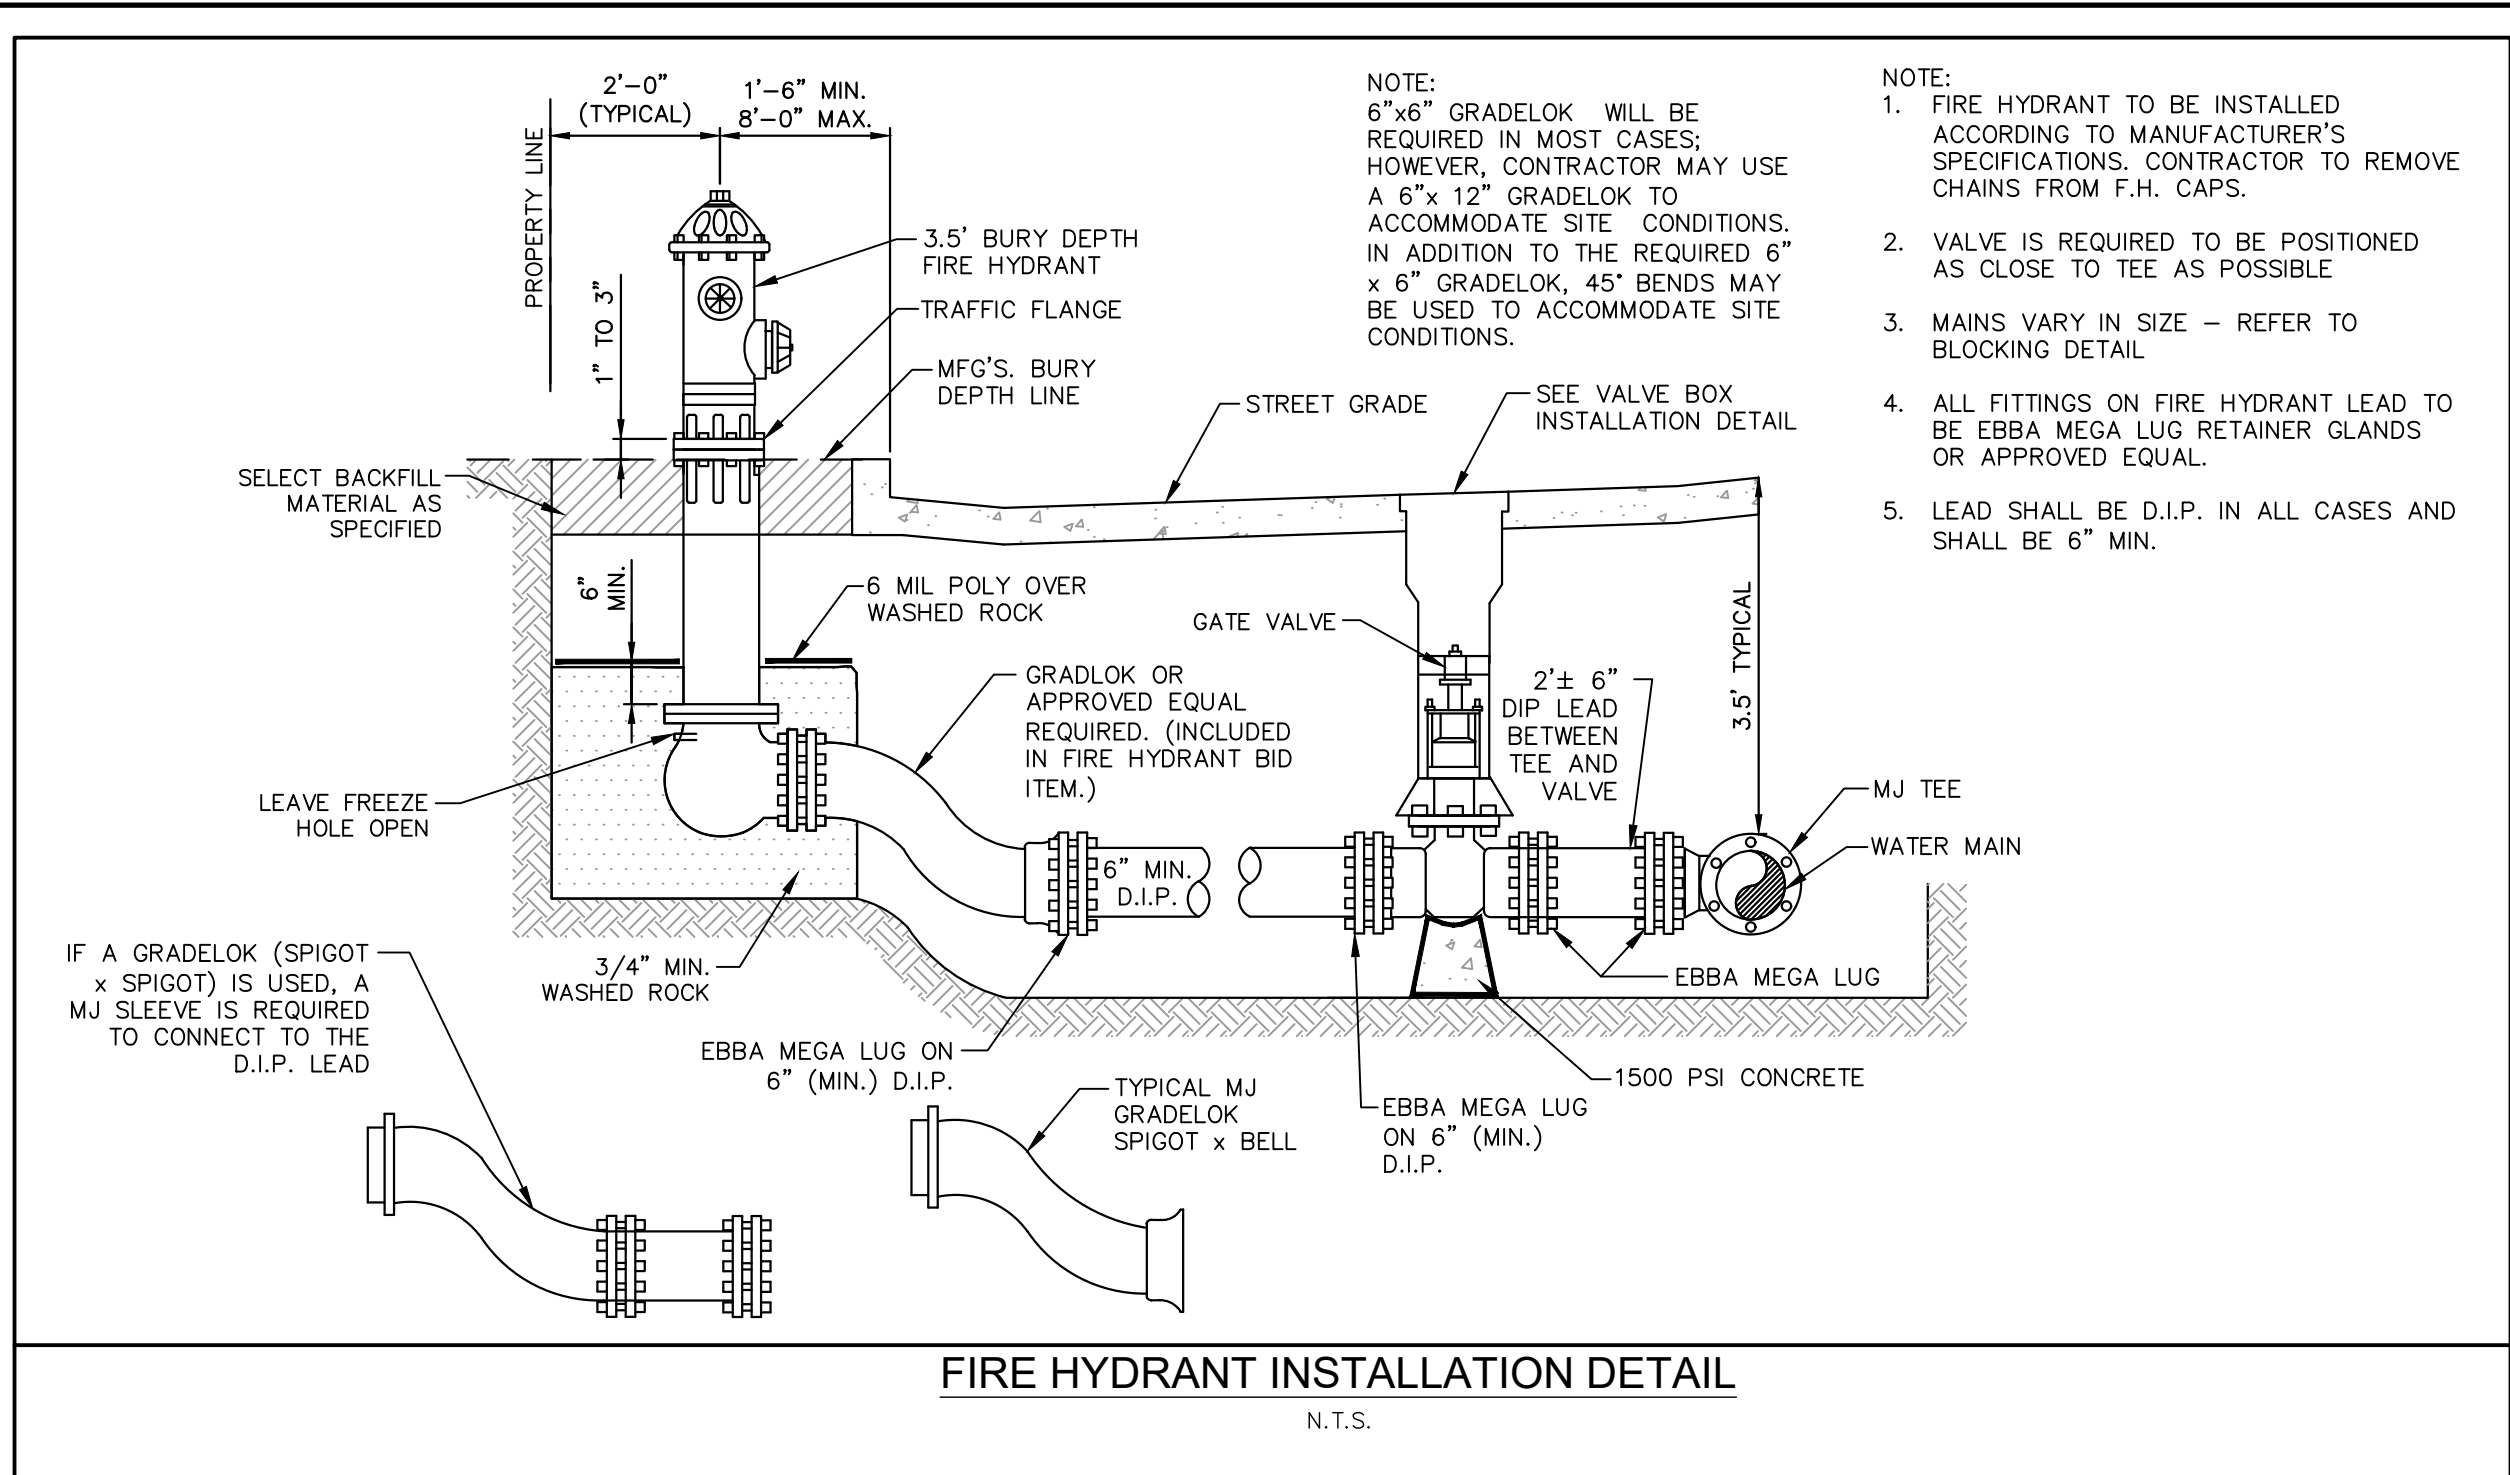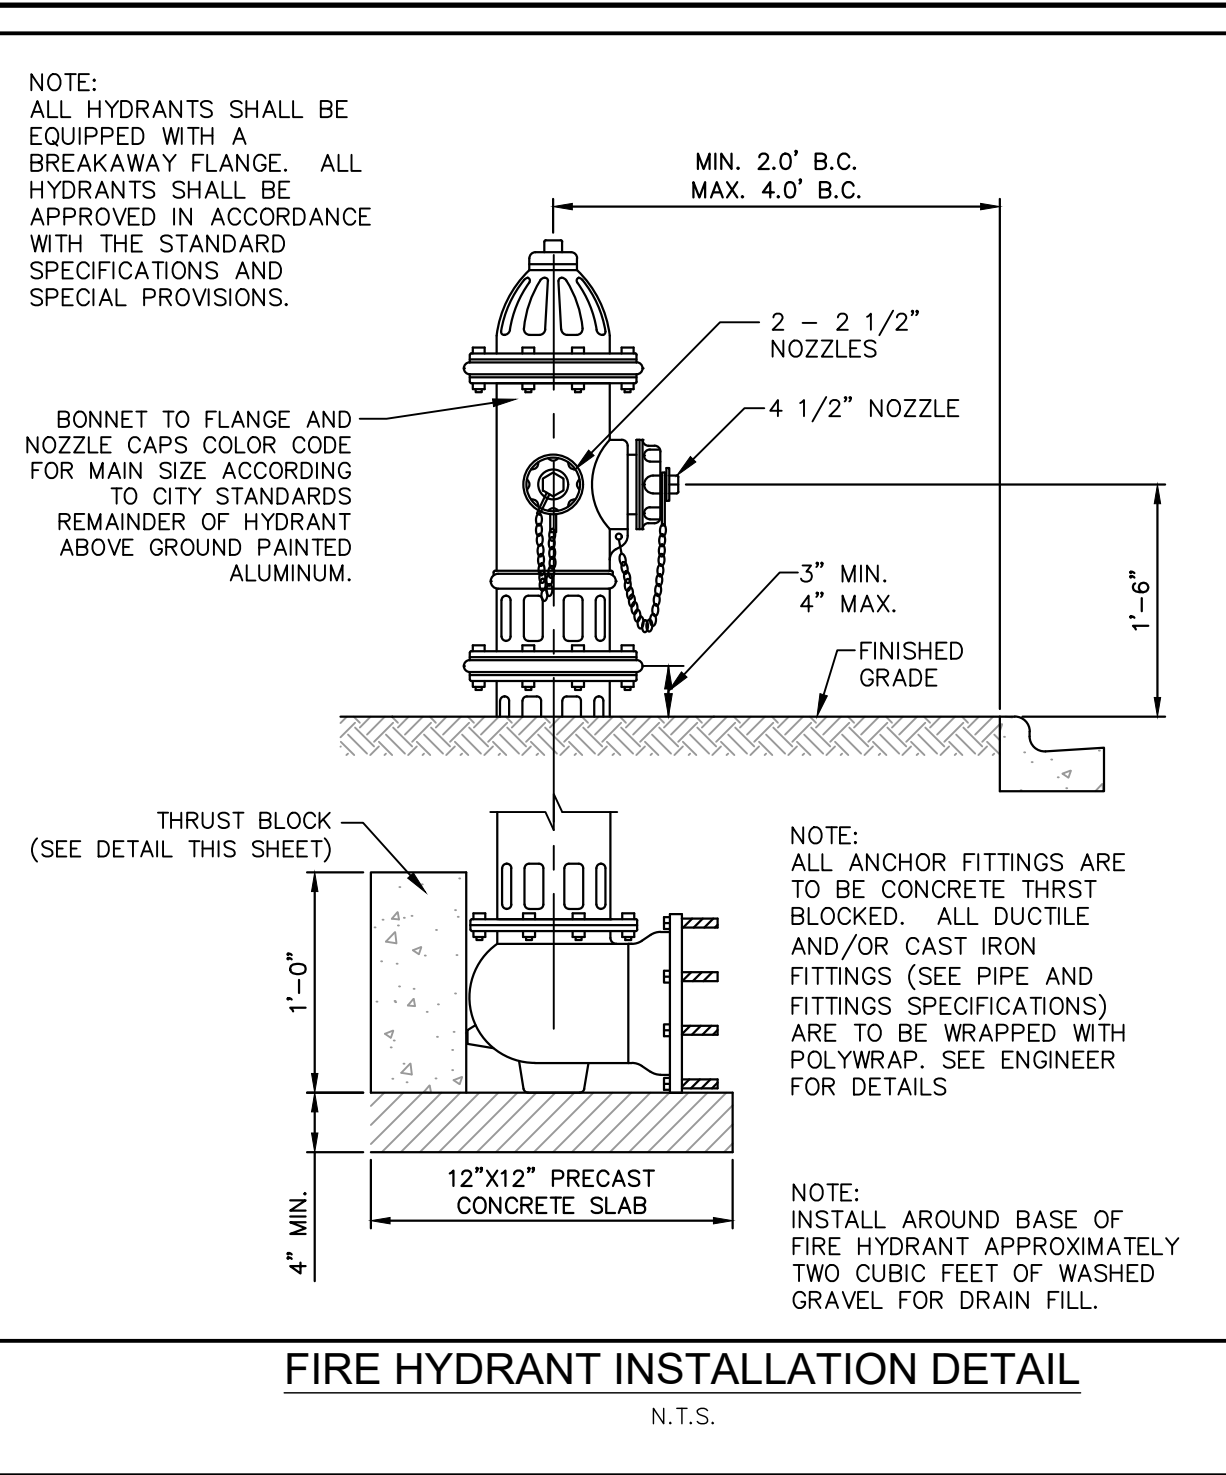

Please provide water line embedment detail

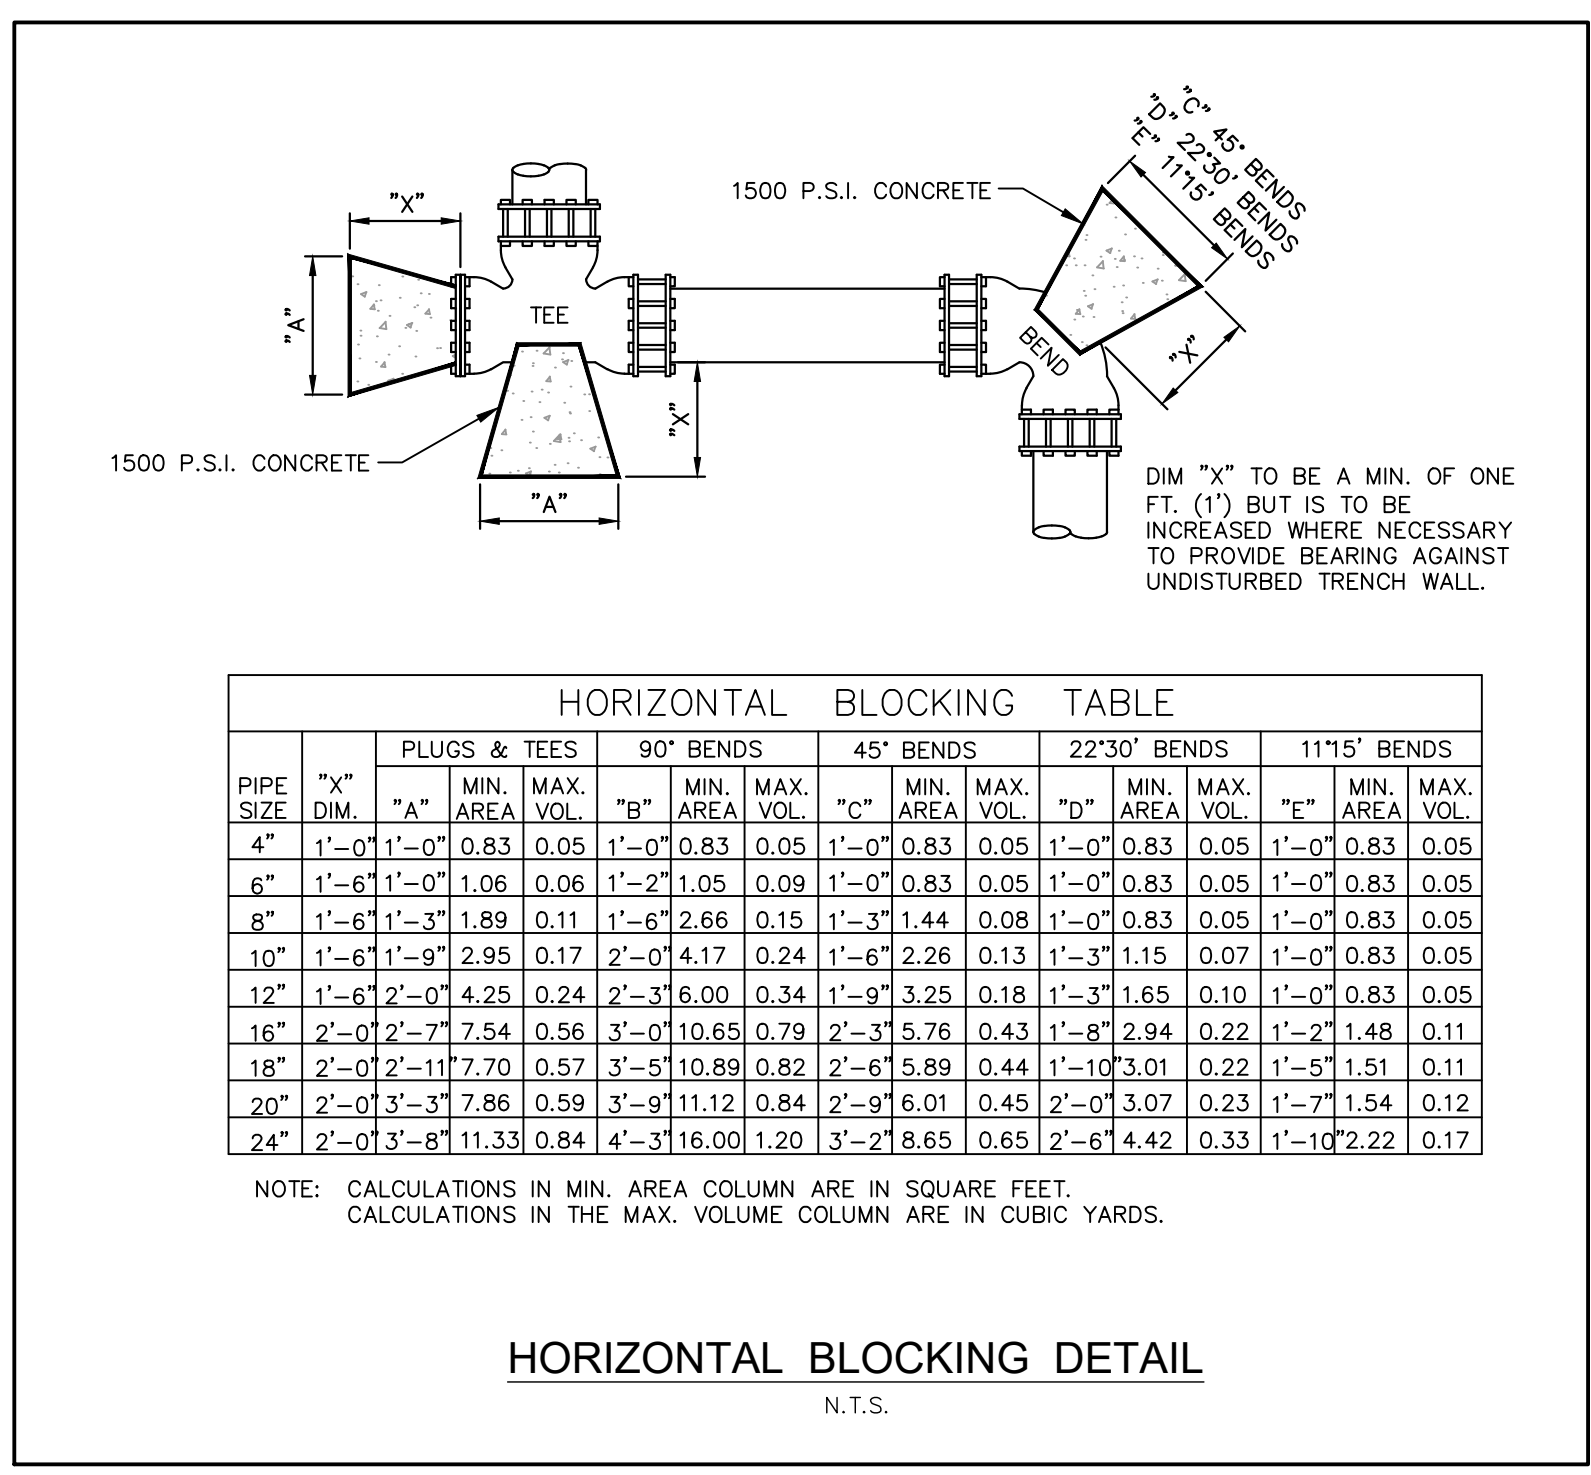

NO.	REVISIONS	DATE	BY

PROJECT NAME: BLUE STAR INDUSTRIAL BLDG. L SANGER, TEXAS

SHEET TITLE: UTILITY DETAILS

ACE PROJECT: 01101

DATE: DECEMBER 2024








SCALE: AS SHOWN

DRAWN BY: MD

SHEET NUMBER: C-8.05

MICHAEL T. DOGGETT
98628
LICENSED PROFESSIONAL ENGINEER
12/17/2024

ANIMAS CIVIL ENGINEERING
© 2024 ANIMAS CIVIL ENGINEERING, LLC
PHONE: 214-803-1099
TX F-26500

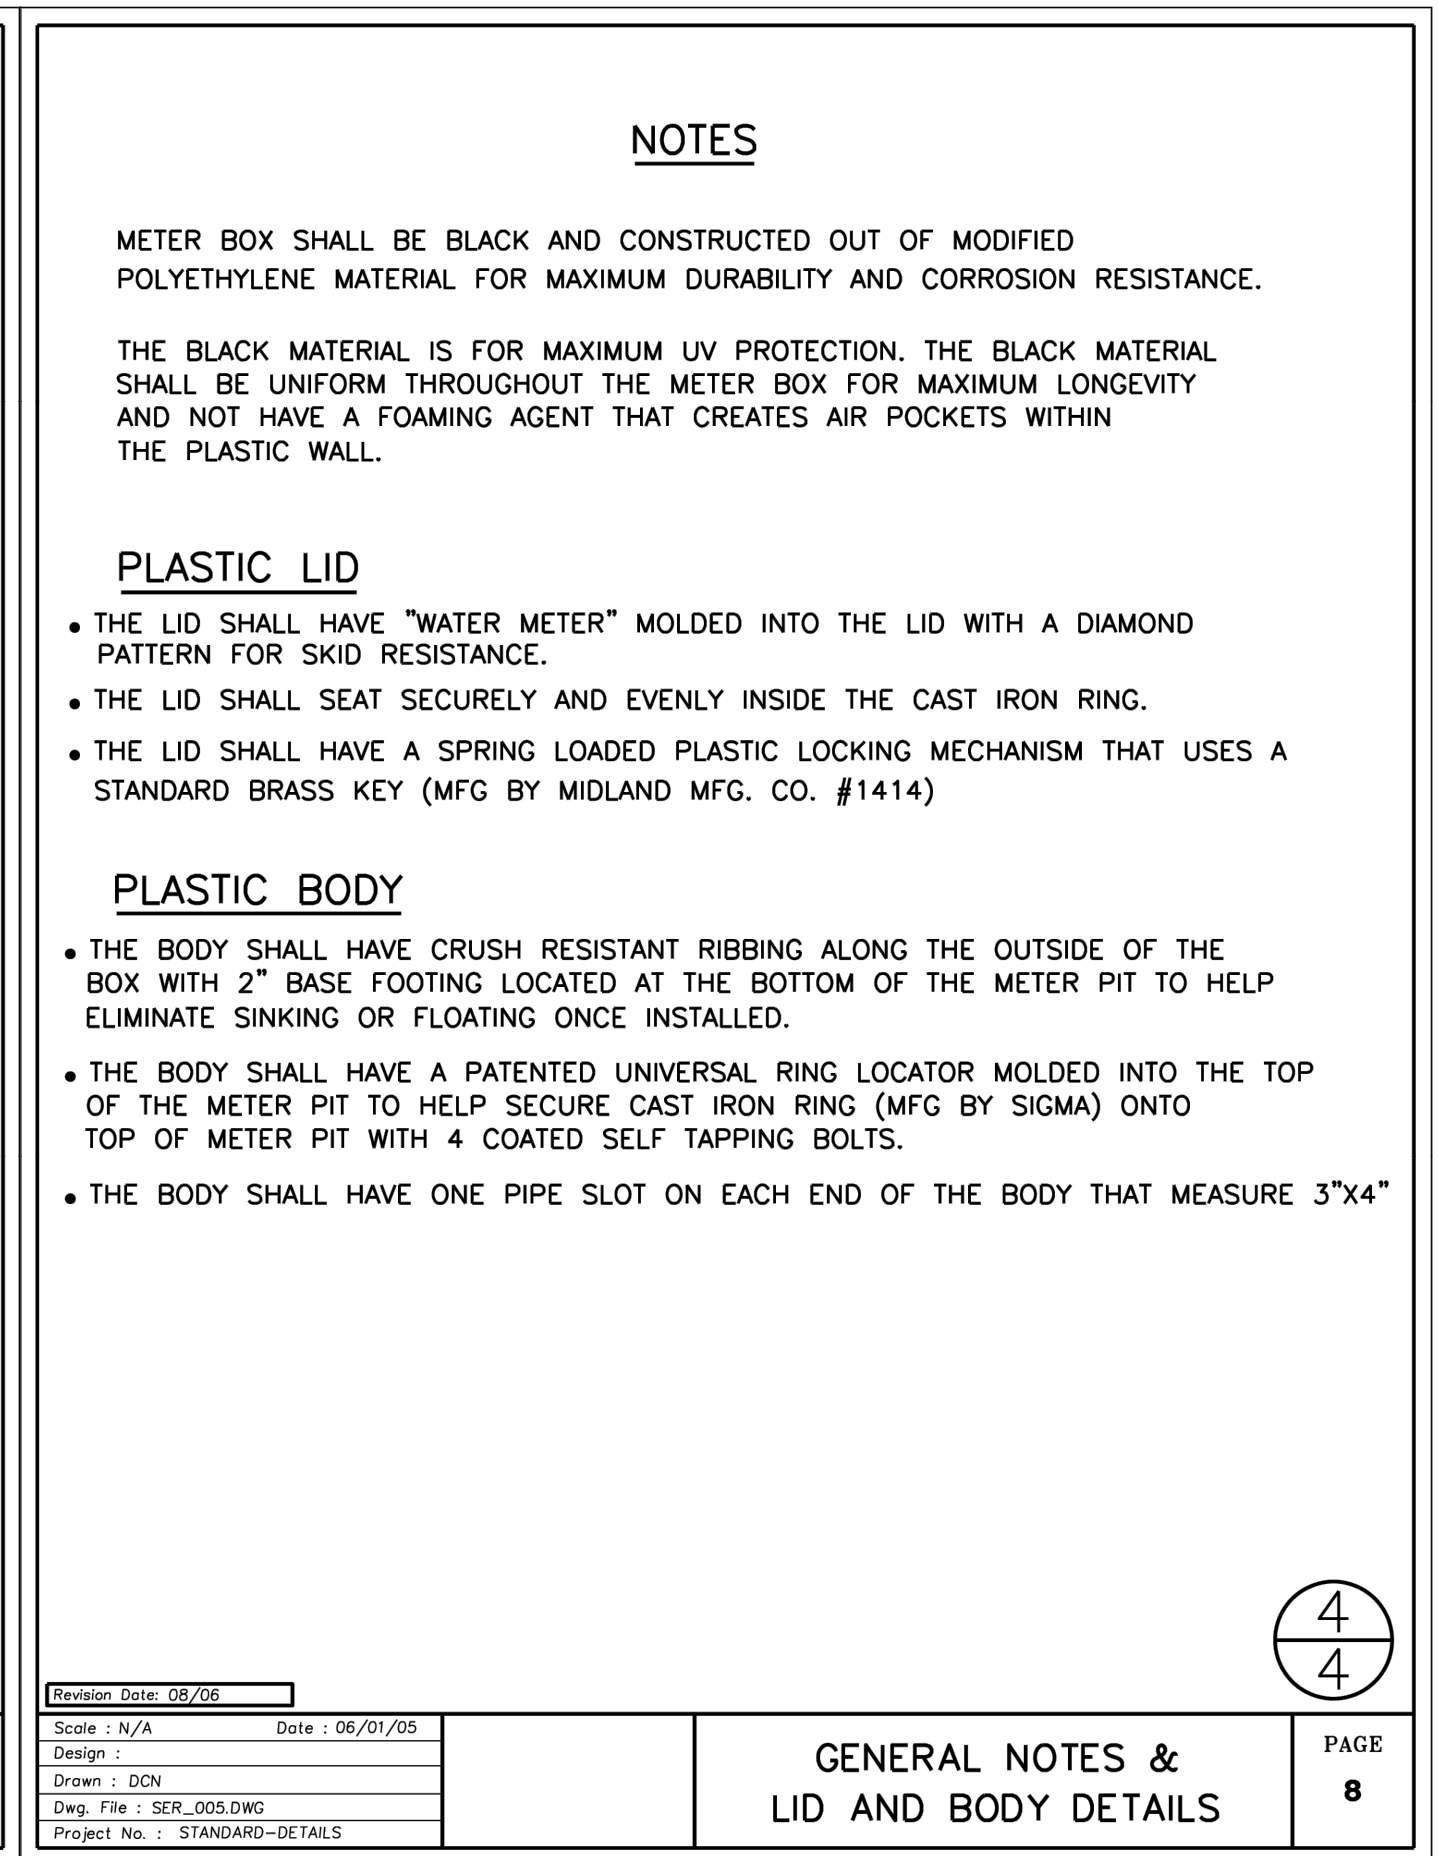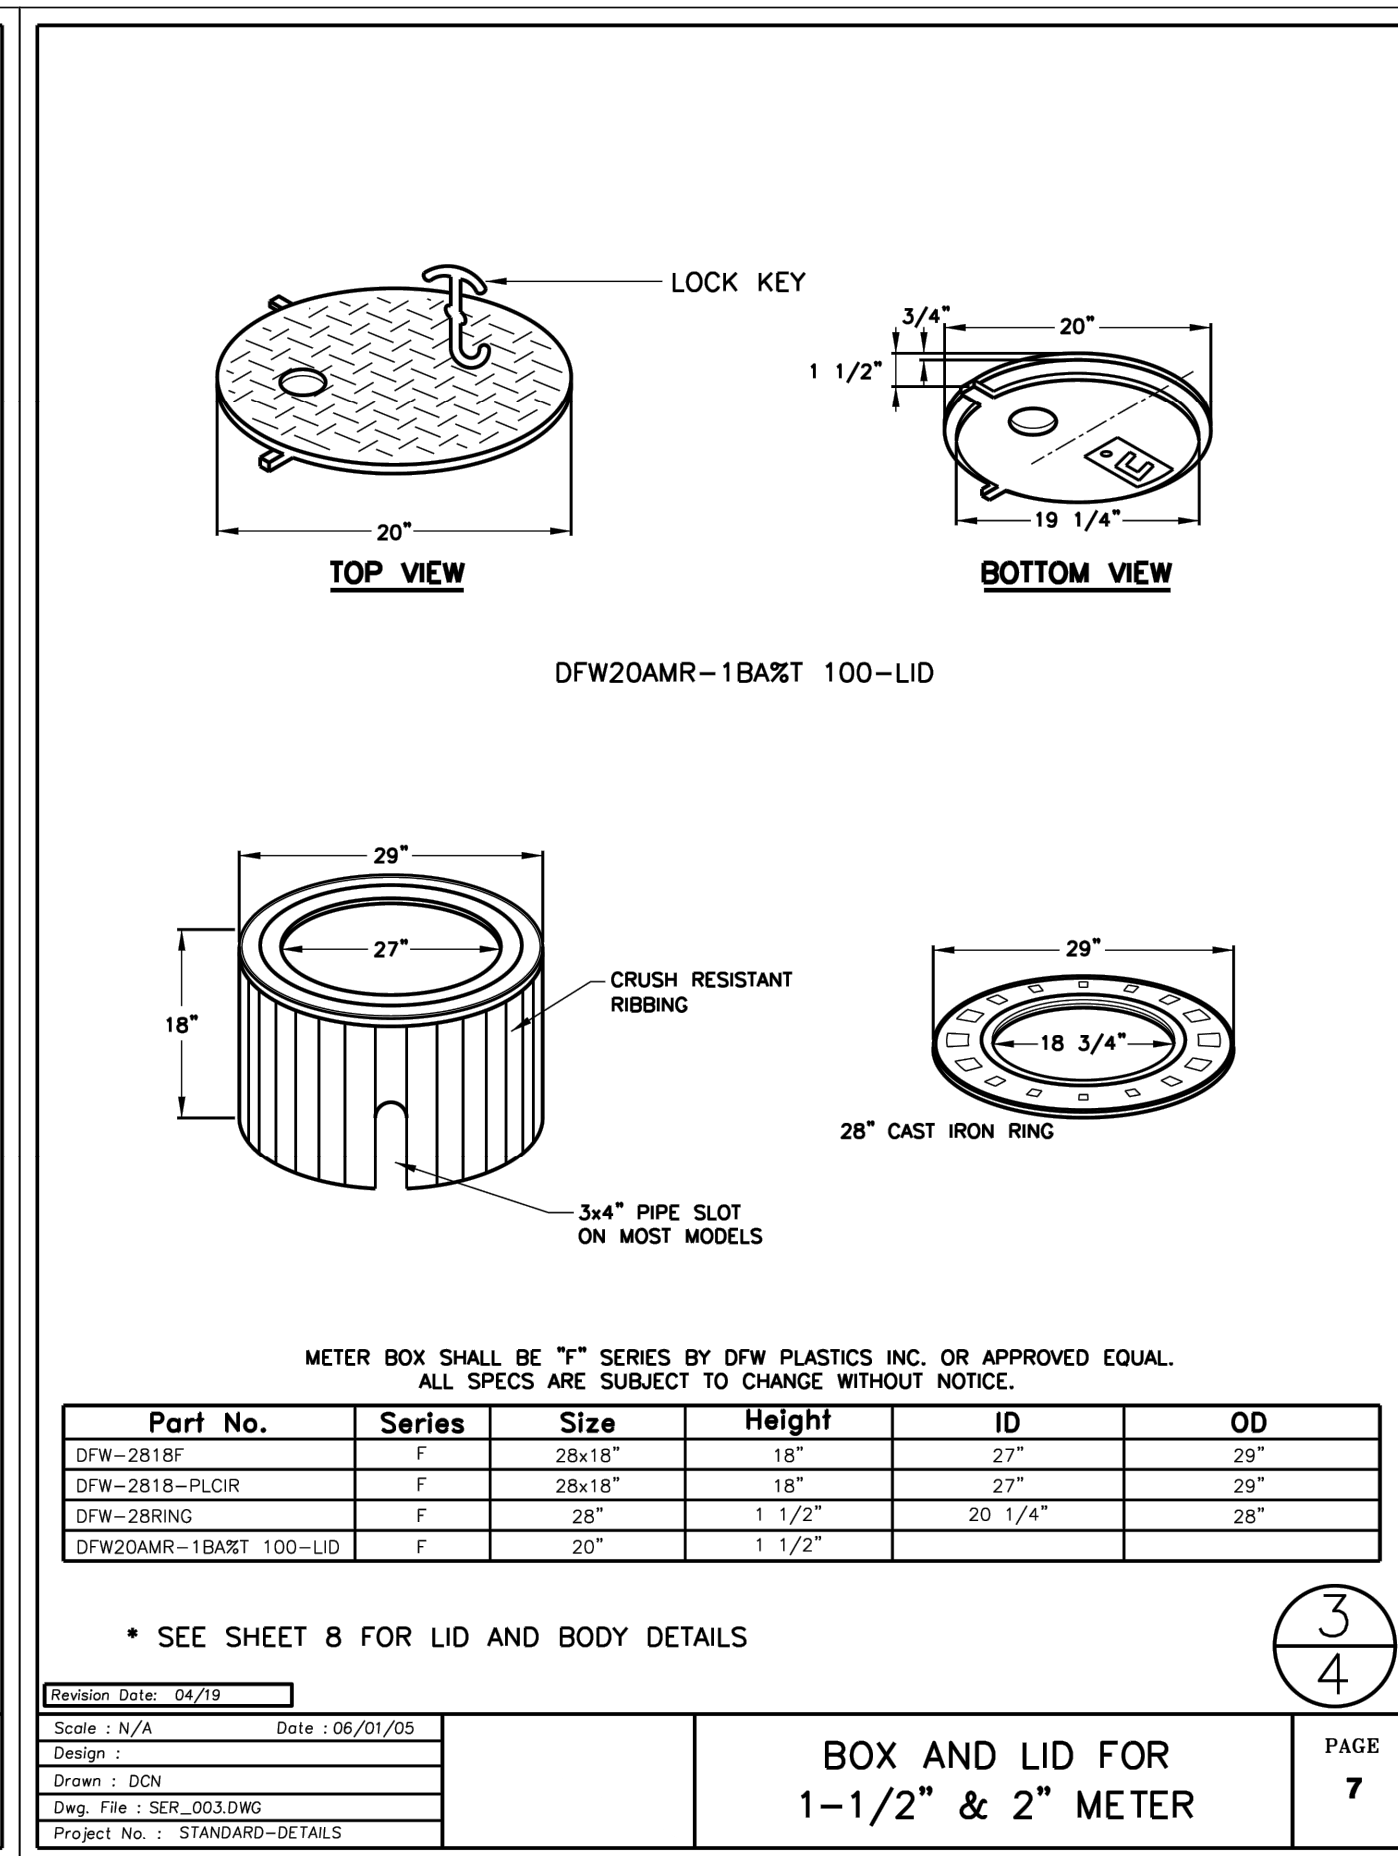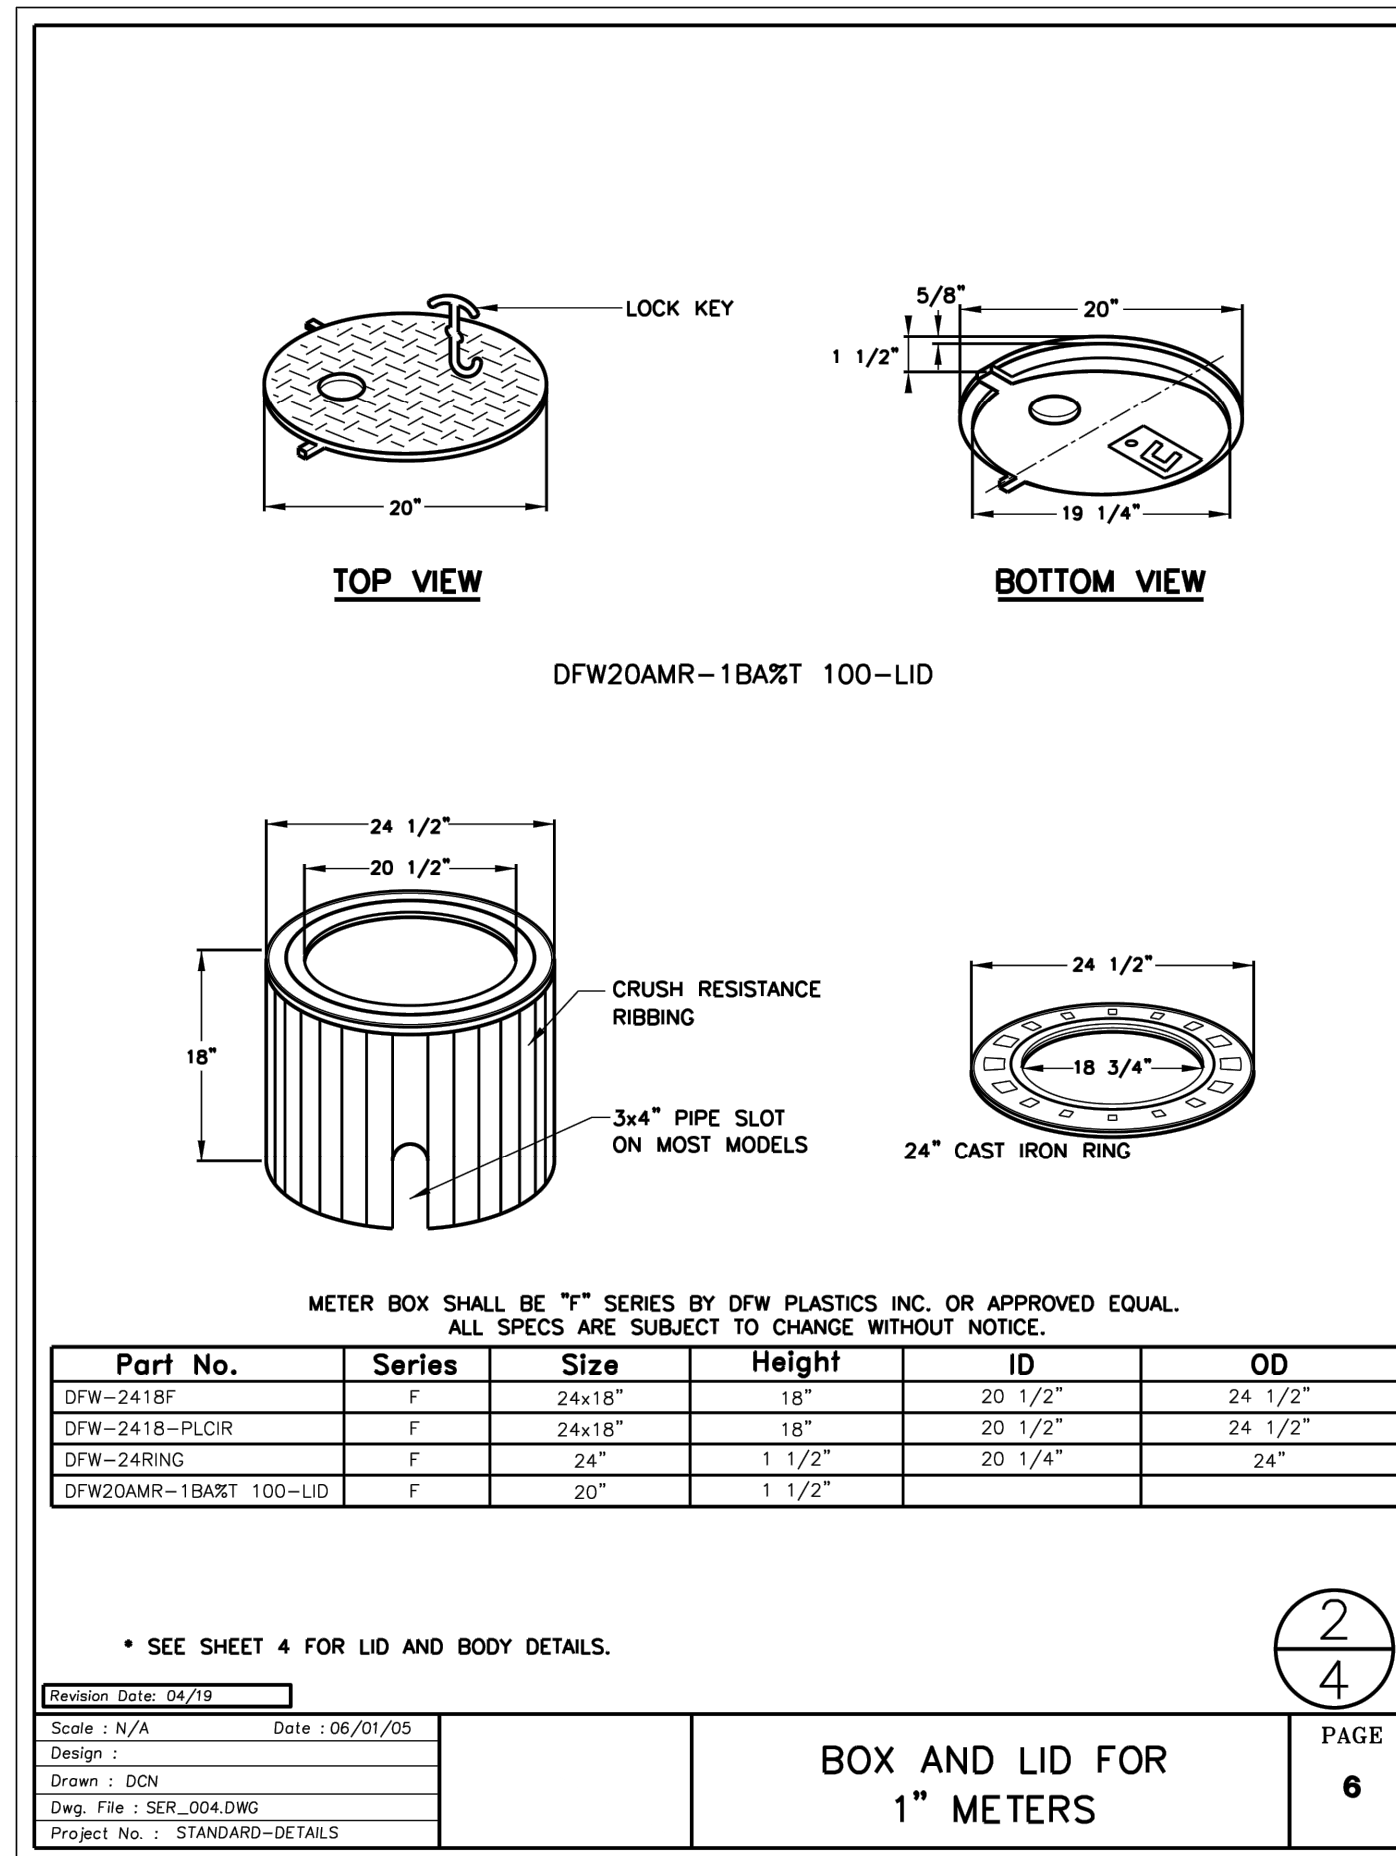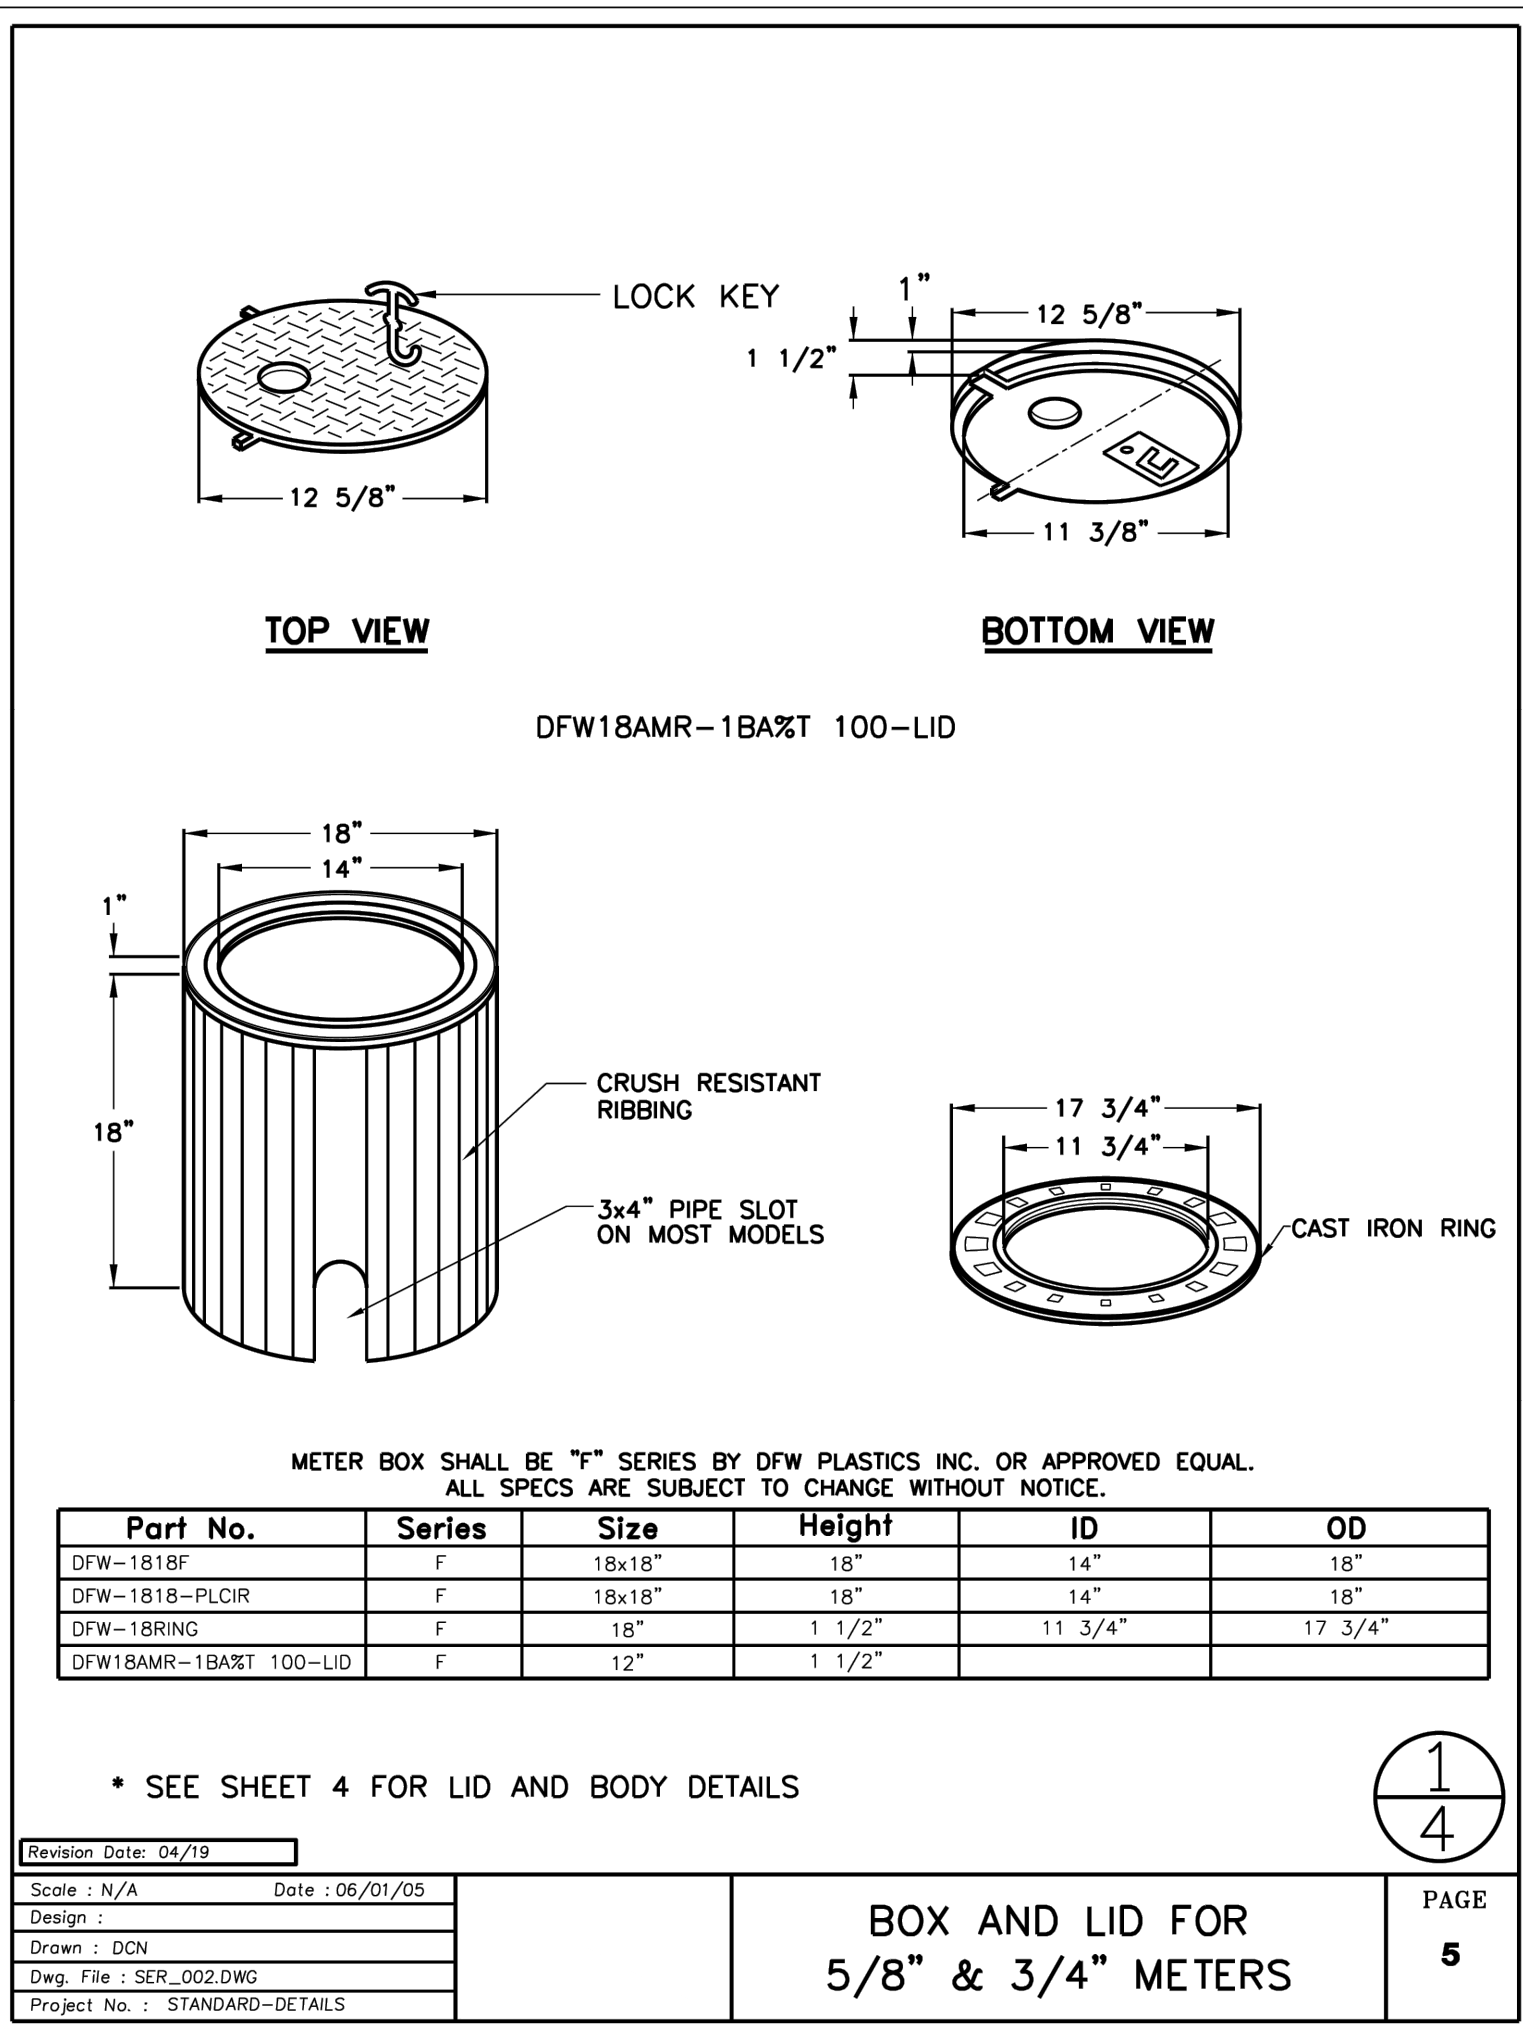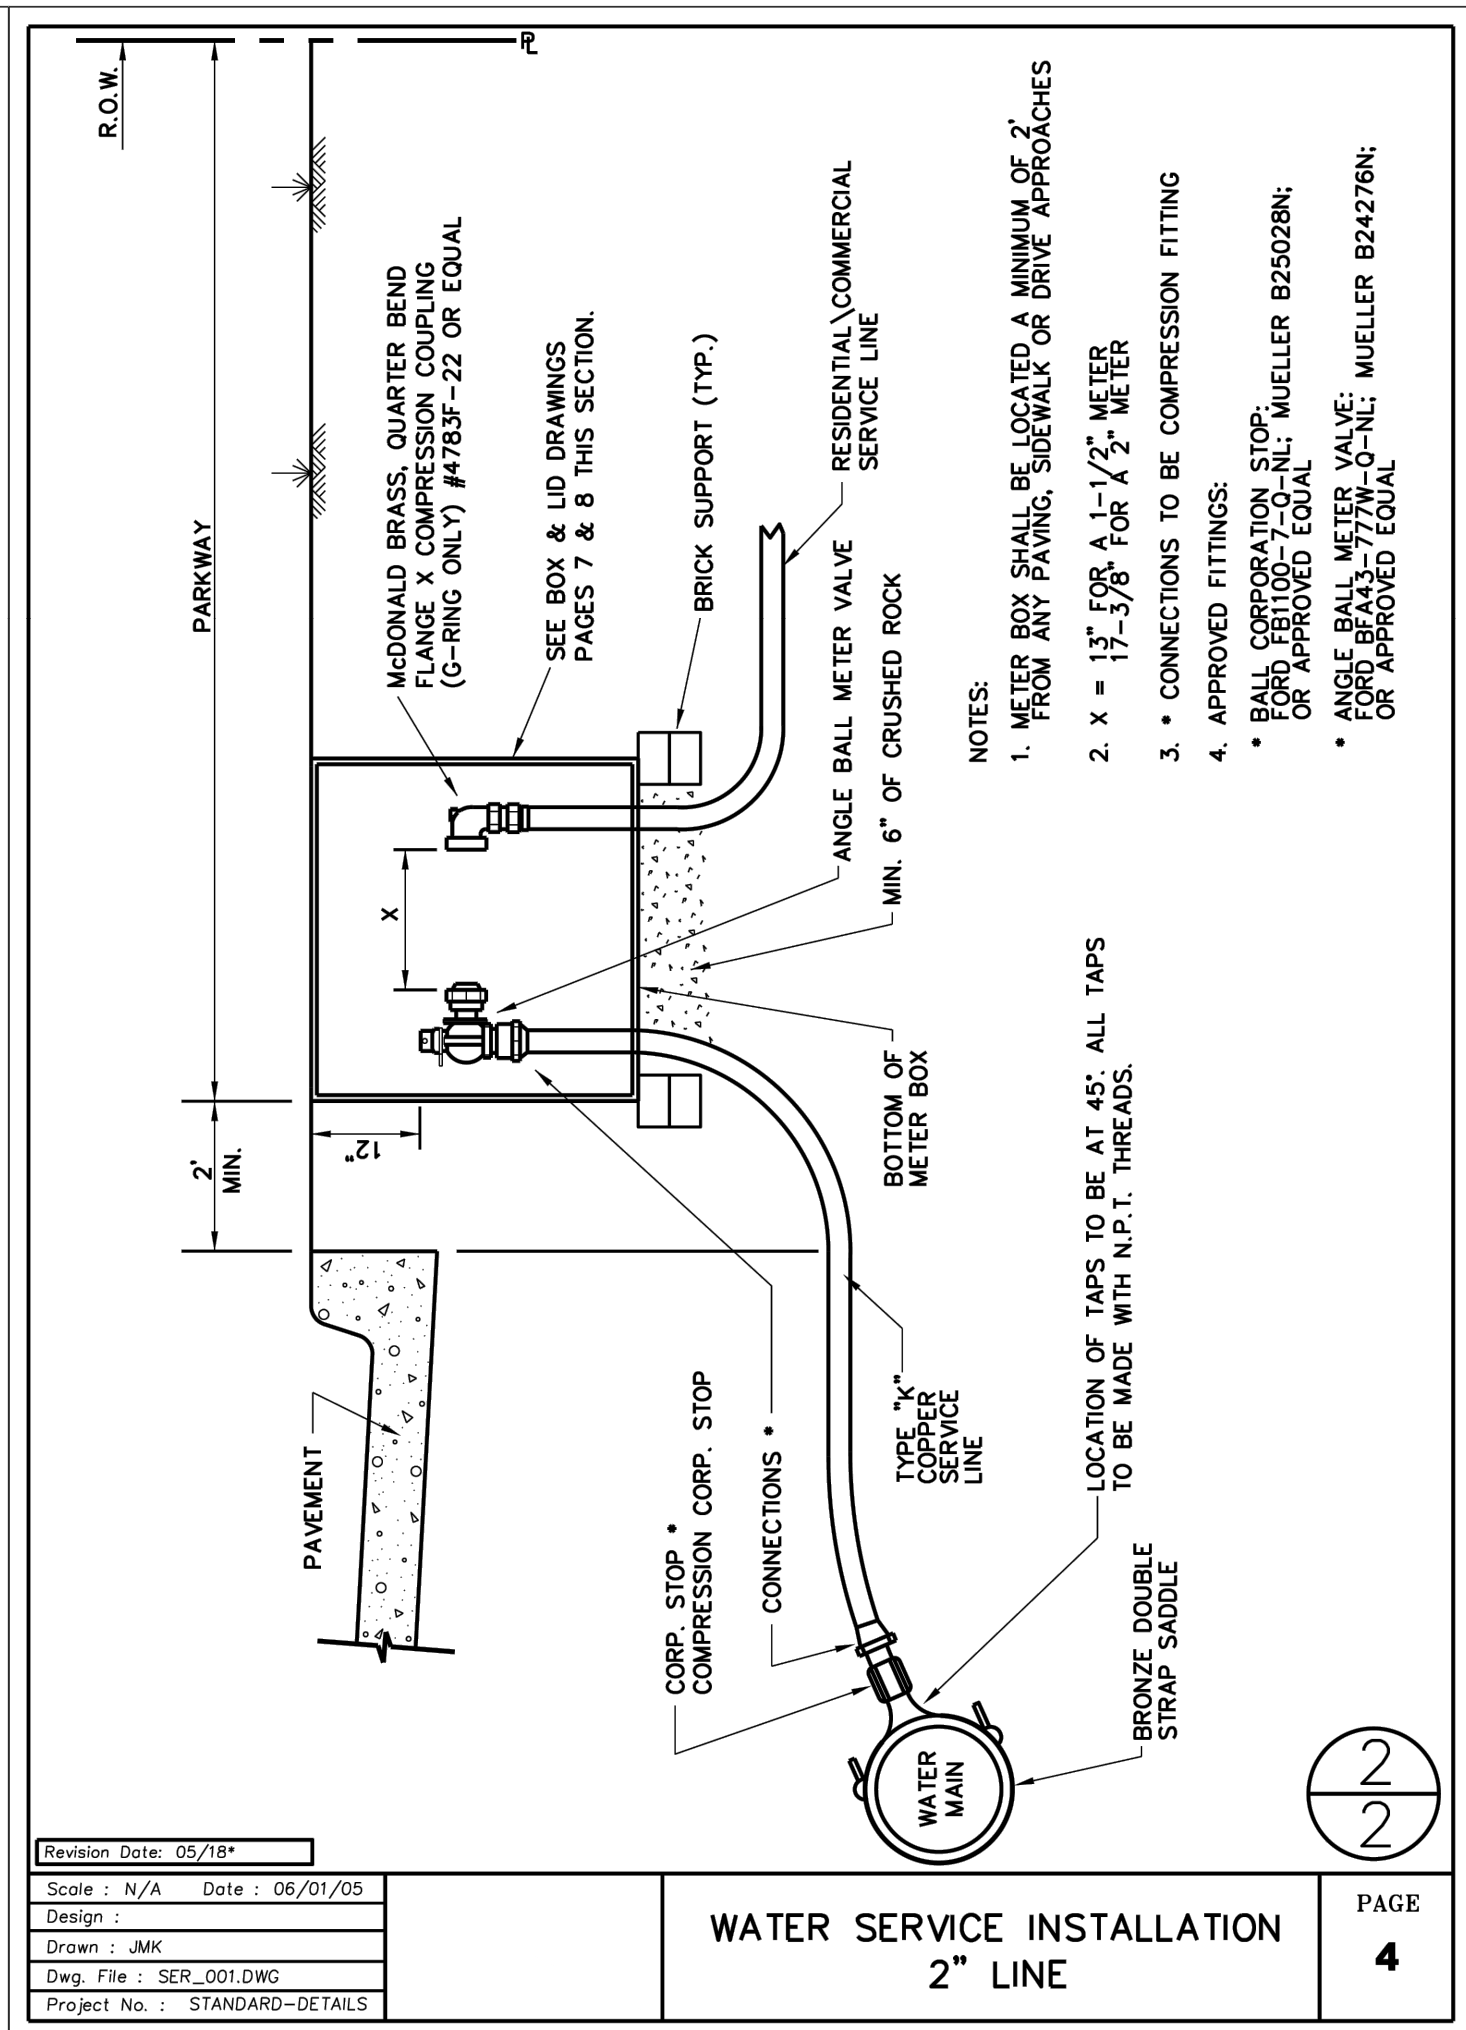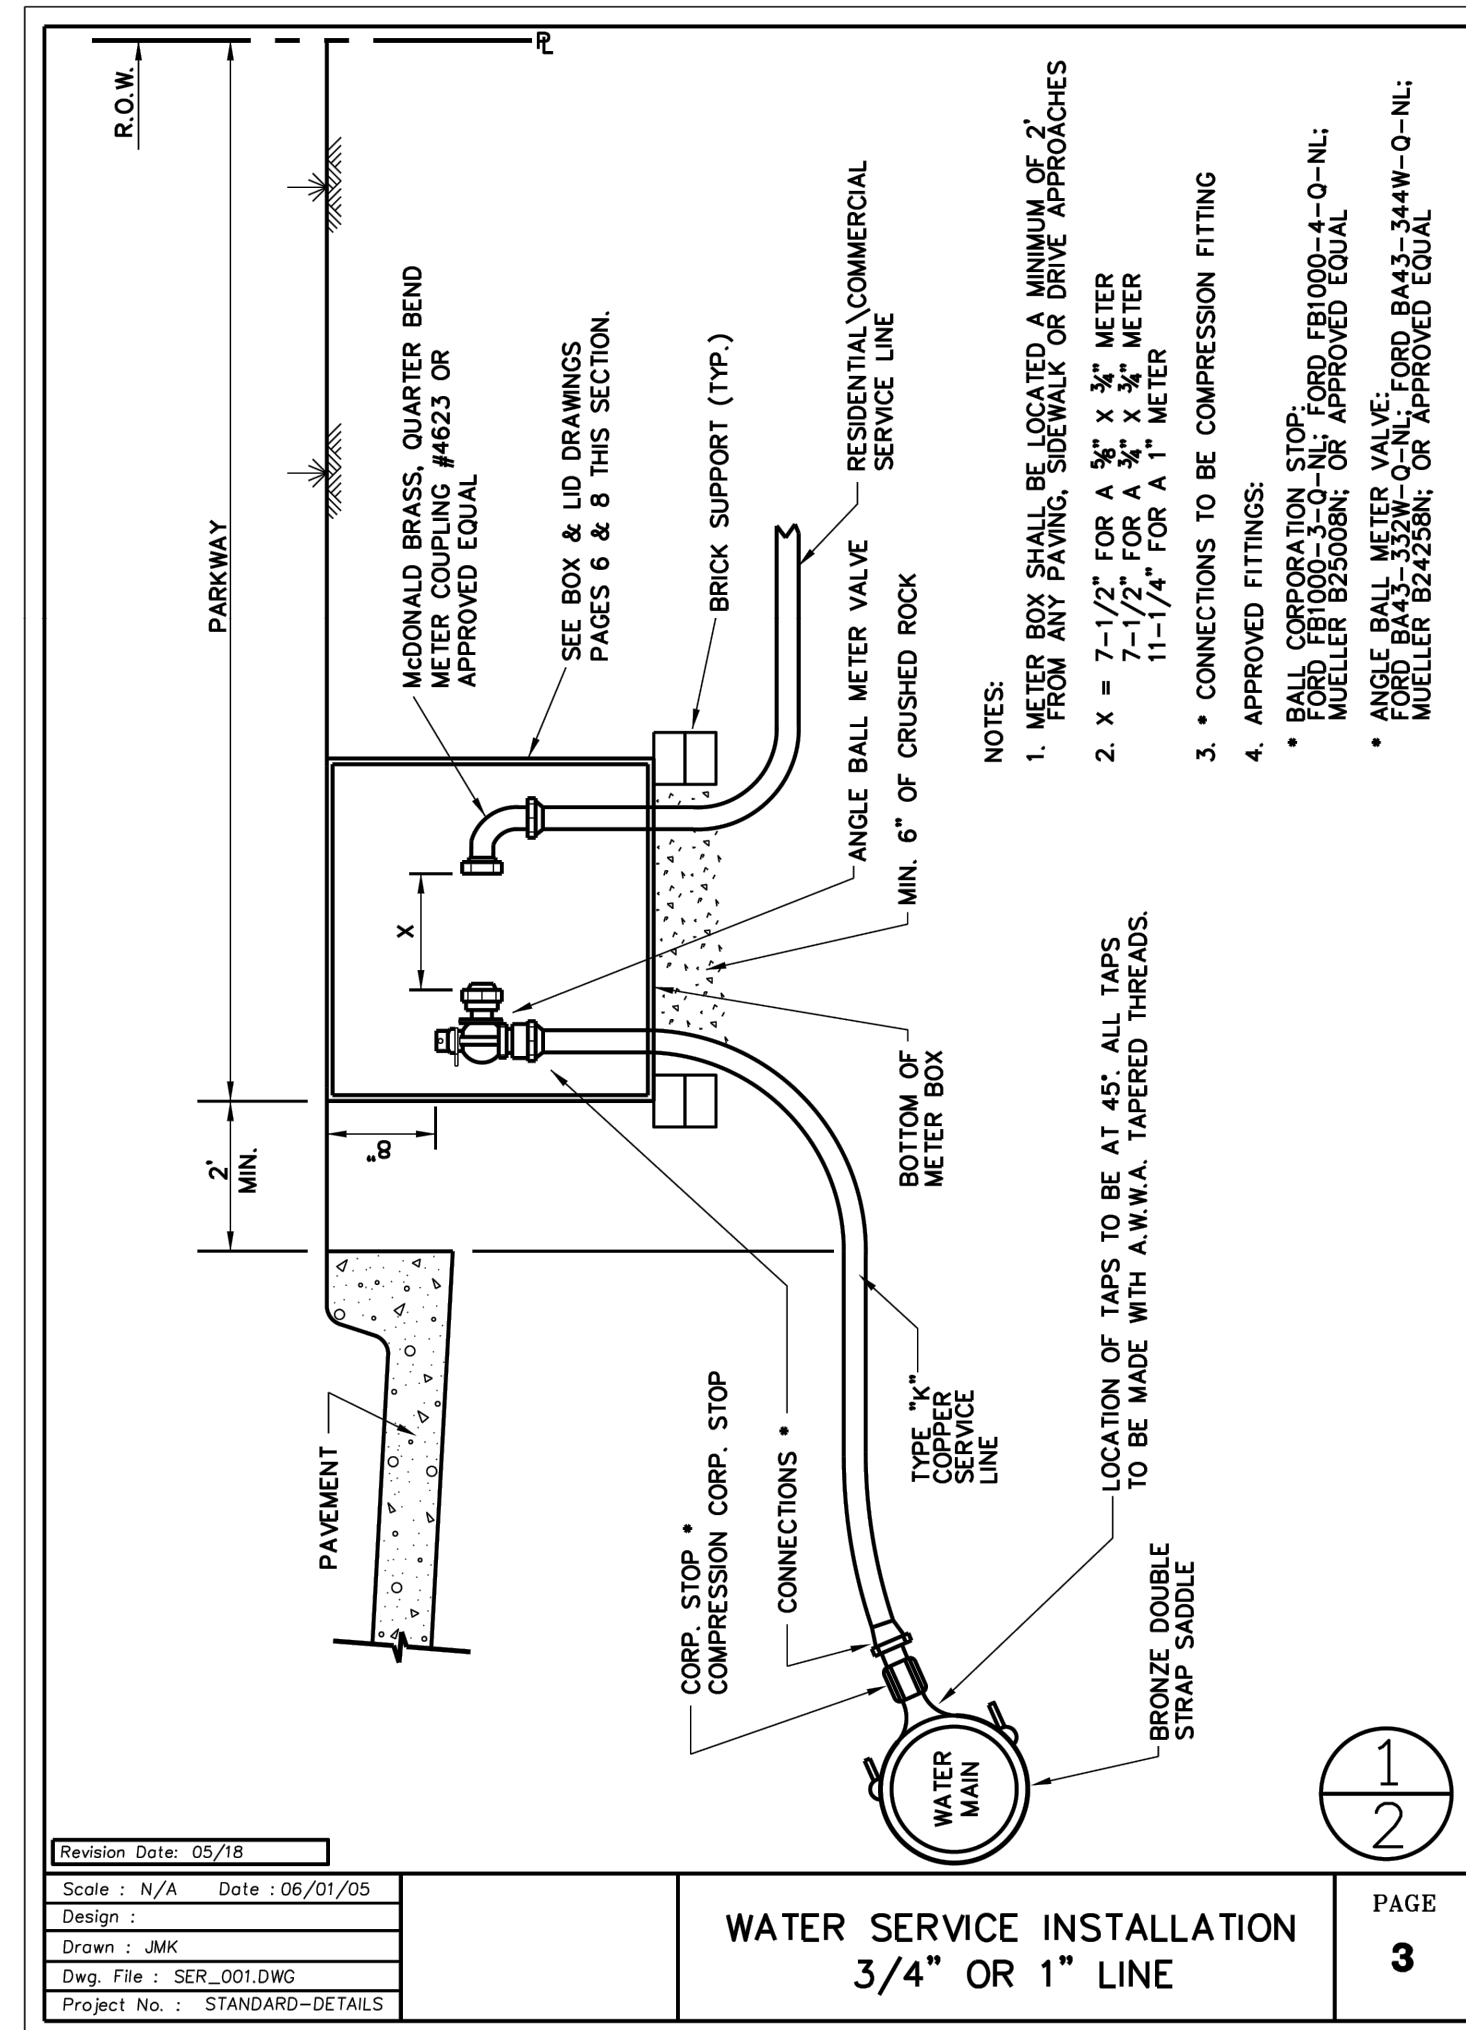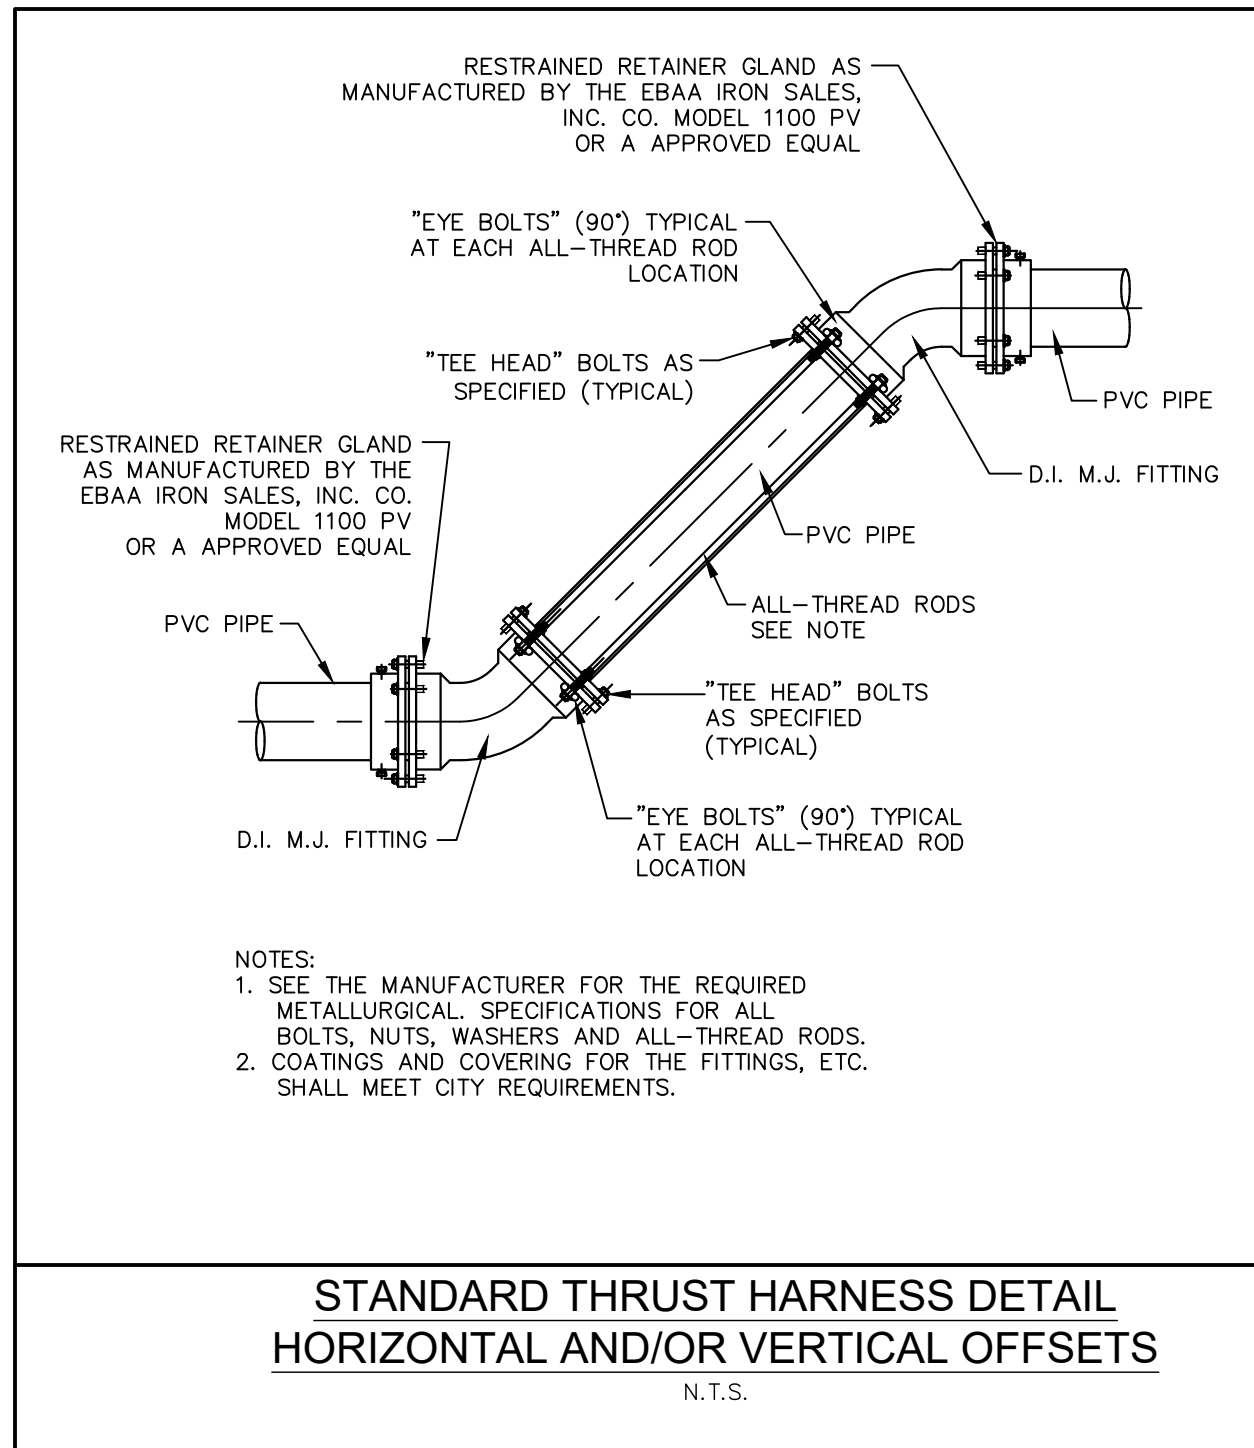

PROJECT NAME: BLUE STAR INDUSTRIAL BLDG. L SANGER, TEXAS

SHEET TITLE: UTILITY DETAILS

ACE PROJECT: 01101

DATE: DECEMBER 2024

SCALE: AS SHOWN


DRAWN BY: MD

SHEET NUMBER: C-8.06


PROFESSIONAL ENGINEER: MICHAEL T. DOGGETT 98628

© 2024 ANIMAS CIVIL ENGINEERING, LLC

TX F-26500

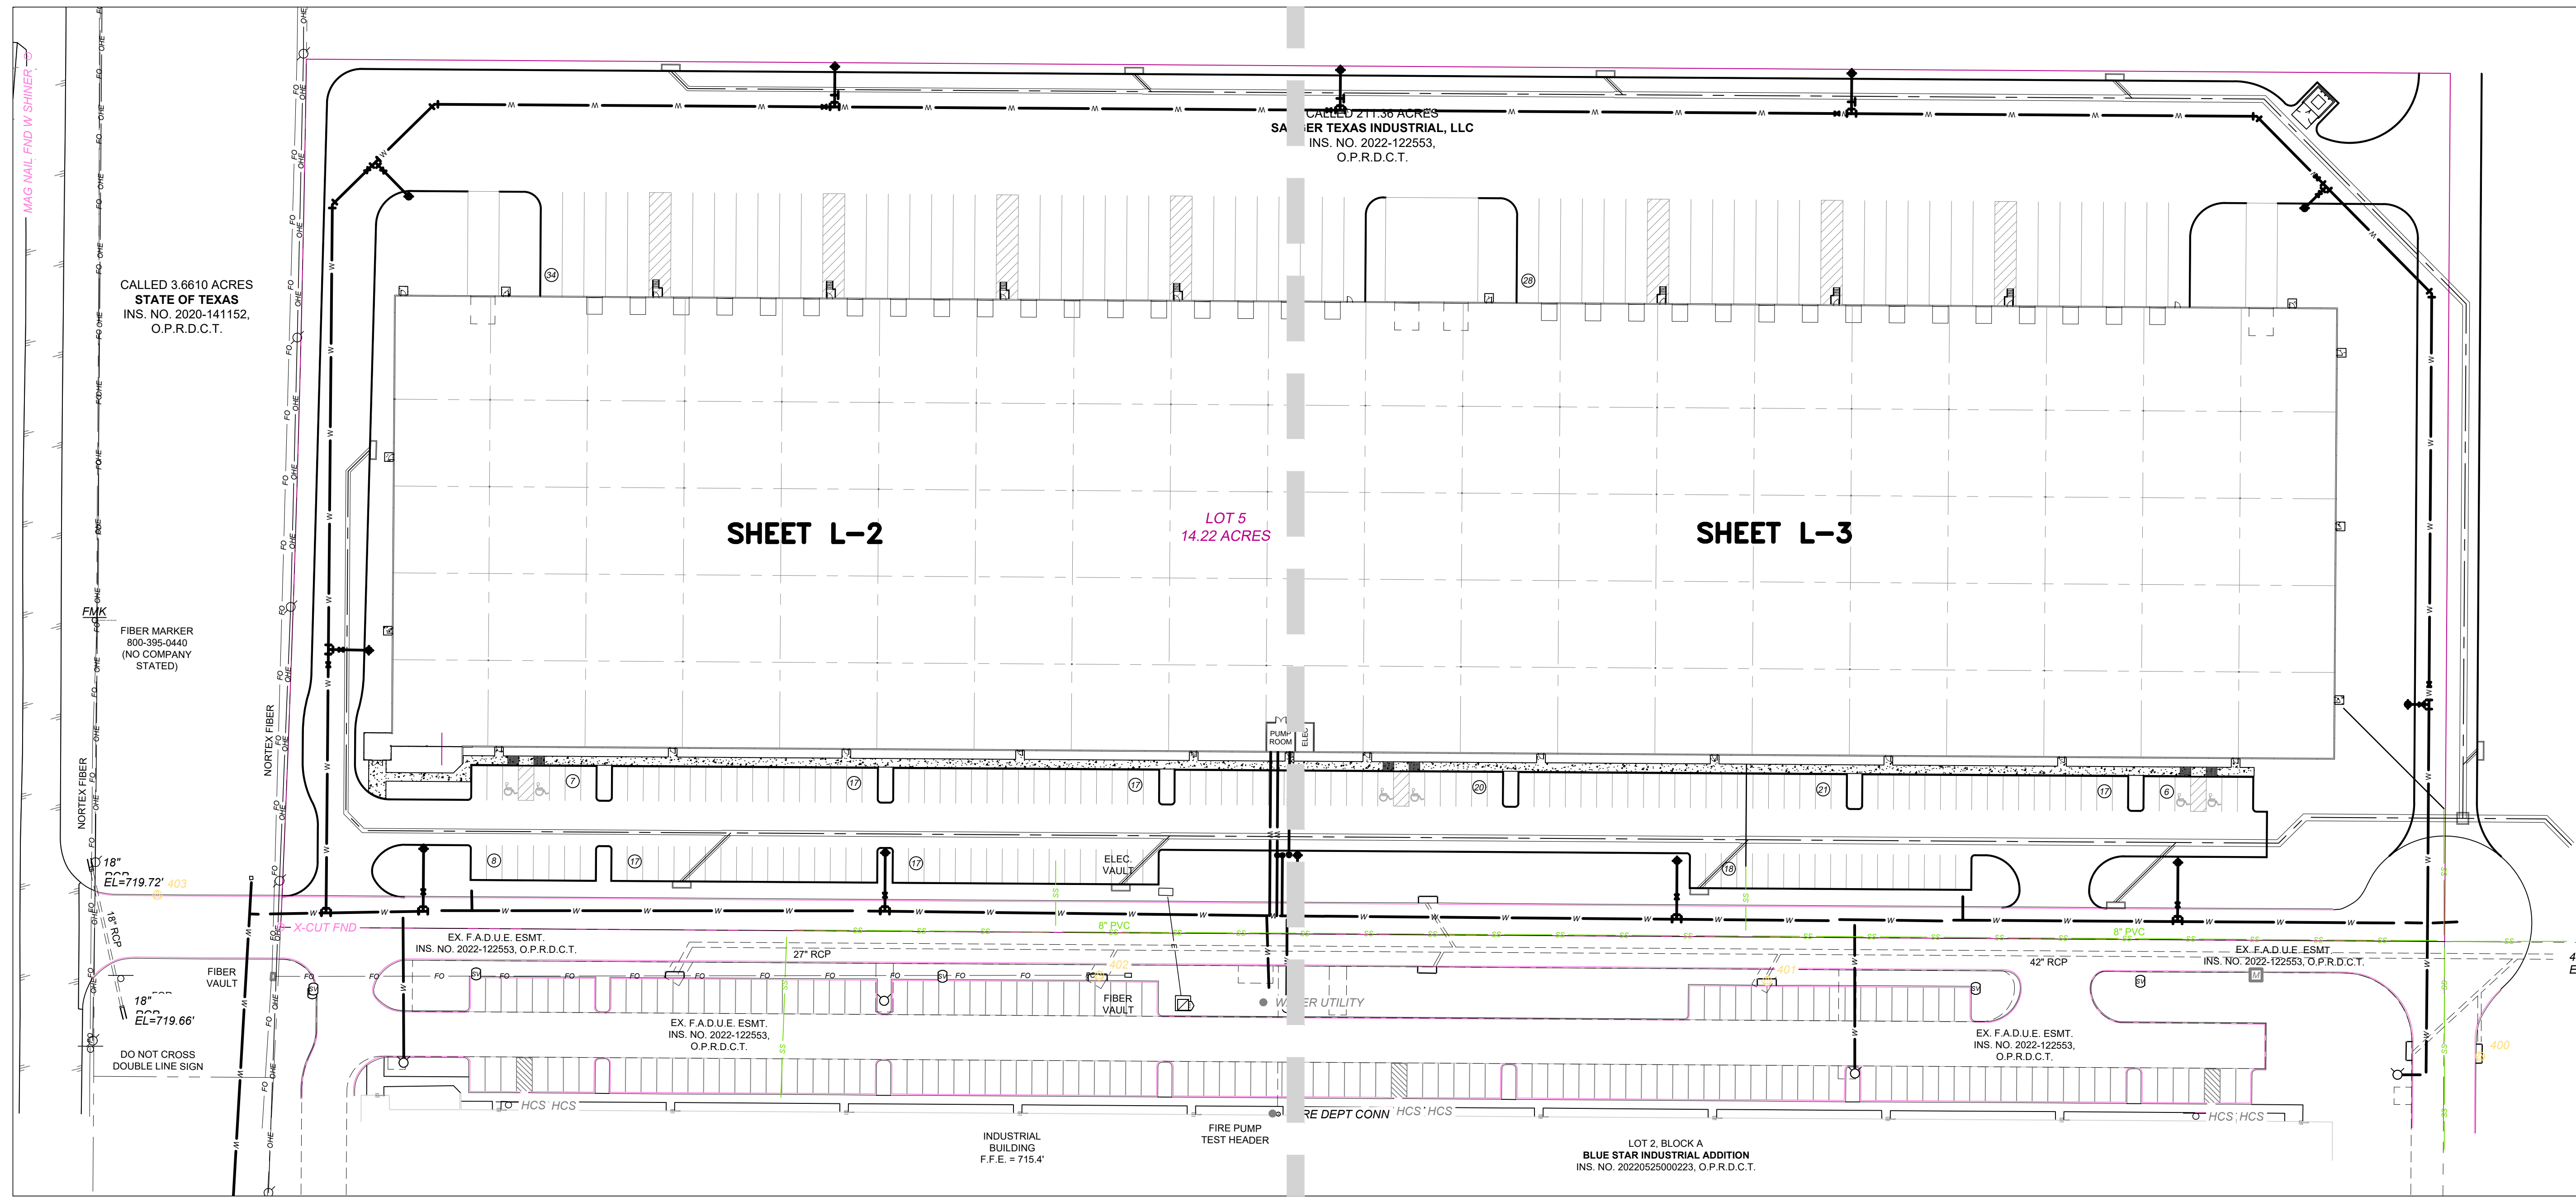

NOTE:
NO LANDSCAPE PLANTINGS
WITHIN 3' OF PARKING
LOT CURBS.

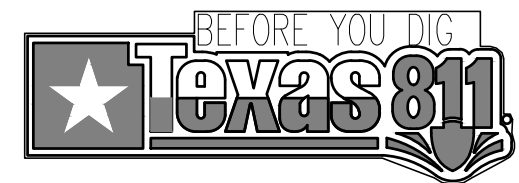


CAUTION!!!
UNDERGROUND UTILITIES ARE LOCATED IN THIS AREA. 48 HOURS PRIOR TO ANY CONSTRUCTION ACTIVITIES, CONTACT LINE LOCATES FOR FRANCHISE UTILITY INFO. CALL BEFORE YOU DIG:
TEXAS EXCAVATION SAFETY SYSTEM (TESS) 1-800-344-8377
TEXAS ONE CALL SYSTEMS 1-800-245-4545
LONE STAR NOTIFICATION CENTER 1-800-669-8344 EXT. 5



PLANTING NOTES:

1. PLANT SIZE, TYPE, AND CONDITION SUBJECT TO APPROVAL OF OWNER'S REPRESENTATIVE.
2. ALL PLANT MATERIAL TO BE NURSERY GROWN STOCK.
3. CONTRACTOR RESPONSIBLE FOR MAINTENANCE OF ALL PLANT MATERIAL UNTIL PROJECT ACCEPTANCE.
4. ALL CONTAINER GROWN PLANTS TO HAVE FULL, VIGOROUS ROOT SYSTEM, COMPLETELY ENCOMPASSING CONTAINER.
5. ALL PLANTS WELL ROUNDED AND FULLY BRANCHED. ALL TREES WITH SPREAD 2/3 OF HEIGHT.
6. CONTRACTOR TO PROVIDE OWNER WITH PREFERRED MAINTENANCE SCHEDULE OF ALL PLANTS AND LAWNS.
7. MAINTAIN/PROTECT VISIBILITY TRIANGLE WITH PLANT MATERIAL PER CITY STANDARDS AT ALL ENTRANCES TO SITE.
8. PREP ENTIRE WIDTH OF ALL DEFINED PLANTING BEDS WITH MIX AS OUTLINED IN SPECS. WHERE SHRUBS ARE LOCATED ALONG CURB, SET SHRUBS BACK FROM CURB 3 FT.
9. SEE DETAIL SHEET FOLLOWING FOR PLANTING DETAILS.
10. CONTRACTOR RESPONSIBLE FOR LOCATION OF ALL UTILITIES, INCLUDING BUT NOT LIMITED TO TELEPHONE, TELECABLE, ELECTRIC, GAS, WATER AND SEWER. ANY DAMAGE TO UTILITIES TO BE REPAIRED BY CONTRACTOR AT NO COST TO OWNER.
11. EXISTING TREES ARE SHOWN TO REMAIN. CONTRACTOR SHALL PRUNE ONLY ON APPROVAL OF CITY ARBORIST. WORK TO INCLUDE REMOVAL OF ALL SUCKER GROWTH; DEAD AND DISEASED BRANCHES AND LIMBS; VINES, BRIARS AND OTHER INVASIVE GROWTH; AND ALL INTERFERING BRANCHES. MAKE ALL CUTS FLUSH TO REMAINING LIMB. RETAIN NATURAL SHAPE OF PLANT. ALL WORK SUBJECT TO APPROVAL OF OWNER'S REPRESENTATIVE.
12. QUANTITIES ARE PROVIDED AS A COURTESY AND NOT INTENDED FOR BID PURPOSES. CONTRACTOR TO VERIFY PRIOR TO PRICING.
13. INSTALL EDGING BETWEEN LAWN AND PLANTING BEDS. REFER TO SPECIFICATIONS. FILE ALL CORNERS SMOOTH.
14. INSTALL CURLEX BLANKET (OR EQUAL) PER MANUFACTURERS INSTRUCTIONS ON ALL GROUNDCOVER/SHRUB BEDS WITH A SLOPE OF 4:1 OR GREATER.
15. AT TIME OF PLAN PREPARATION, SEASONAL PLANT AVAILABILITY CANNOT BE DETERMINED. IT IS THE RESPONSIBILITY OF THE CONTRACTOR TO SECURE AND RESERVE ALL B&B PLANTS WHEN AVAILABLE IN CASE ACTUAL INSTALLATION OCCURS DURING THE OFF-SEASON. PURCHASE AND HOLD B&B PLANTS FOR LATE SEASON INSTALLATION.
16. BERM ALL PARKING LOT ISLANDS AS SHOWN ON ENCLOSED DETAIL SHEET. (BERMS MAY NOT BE SHOWN ON GRADING PLAN.)
17. PRIOR TO PLANTING, CONTRACTOR SHALL STAKE TREE LOCATIONS FOR APPROVAL BY OWNER.

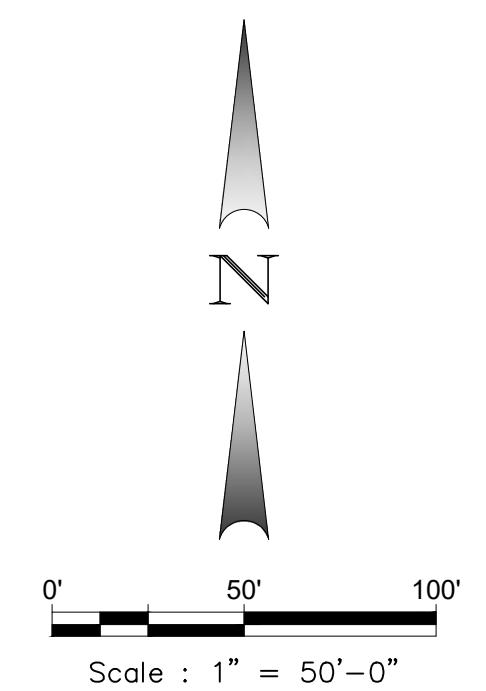

FAIN • CUPPETT
LANDSCAPE ARCHITECTS, LLC
1921 MAPLEWOOD DR
WEATHERFORD, TX 76087 682-215-9151
PARKS AND OPEN SPACE PLANNING • LANDSCAPE ARCHITECTURE • IRRIGATION DESIGN

THIS ELECTRONIC DRAWING FILE IS RELEASED UNDER THE AUTHORITY OF GREG CUPPETT, LANDSCAPE ARCHITECT REGISTRATION NUMBER 2072 ON 11/18/24 WHO MAINTAINS THE ORIGINAL FILE. THIS ELECTRONIC DRAWING FILE MAY BE USED AS A BACKGROUND DRAWING. PURSUANT TO RULE 3.103(F) OF THE RULES AND REGULATIONS OF THE TEXAS BOARD OF ARCHITECTURAL EXAMINERS, THE USER OF THIS ELECTRONIC DRAWING FILE AGREES TO ASSUME ALL RESPONSIBILITY FOR ANY MODIFICATION TO OR USE OF THIS DRAWING FILE THAT IS INCONSISTENT WITH THE REQUIREMENTS OF THE RULES AND REGULATIONS OF THE TEXAS BOARD OF ARCHITECTURAL EXAMINERS. NO PERSON MAY MAKE MODIFICATIONS TO THIS ELECTRONIC DRAWING FILE WITHOUT THE LANDSCAPE ARCHITECT'S EXPRESS WRITTEN PERMISSION.

LANDSCAPE PLAN



BLUE STAR
INDUSTRIAL PHASE 2
SANGER, TEXAS

MAG NAIL FND W SHINER

CALLED 3.6610 ACRES
STATE OF TEXAS
INS. NO. 2020-141152,
O.P.R.D.C.T.

QUE MON (3)
3" Cal.
MYR DON (37)
5 gal.

ULM CRA (4)
3" Cal.
ABE GRA (90)
5 gal.

FIBER MARKER
800-395-0440
(NO COMPANY
STATED)

MYR DON (21)
5 gal.
QUE MON (3)
3" Cal.

ULM CRA (5)
3" Cal.

EX. F.A.D.U.E. ESMT.
INS. NO. 2022-122553, O.P.R.D.C.T.


EX. F.A.D.U.E. ESMT.
INS. NO. 2022-122553,
O.P.R.D.C.T.

INDUSTRIAL
BUILDING
F.F.E. = 715.4'

LOT 5
14.22 ACR

MATCHLINE, SHEET L-3

NOTE:
NO LANDSCAPE PLANTINGS
WITHIN 3' OF PARKING
LOT CURBS.

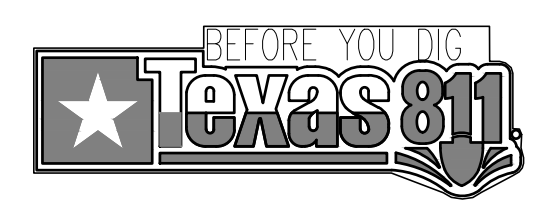

CAUTION!!!
UNDERGROUND UTILITIES ARE LOCATED IN
THIS AREA. 48 HOURS PRIOR TO ANY
CONSTRUCTION ACTIVITIES, CONTACT LINE
LOCATES FOR FRANCHISE UTILITY INFO.
CALL BEFORE YOU DIG:
TEXAS EXCAVATION SAFETY SYSTEM (TESS)
1-800-344-8377
TEXAS ONE CALL SYSTEMS
1-800-245-4545
LONE STAR NOTIFICATION CENTER
1-800-669-8344 EXT. 5




BEFORE
YOU DIG...



BLUE STAR
INDUSTRIAL PHASE 2
SANGER, TEXAS

FAIN • CUPPETT
LANDSCAPE ARCHITECTS, LLC
1921 MAPLEWOOD DR
WEATHERFORD, TX 76087 882-215-9151
PARKS AND OPEN SPACE PLANNING - LANDSCAPE ARCHITECTURE - IRRIGATION DESIGN

THIS ELECTRONIC DRAWING FILE IS RELEASED UNDER THE AUTHORITY OF GREG CUPPETT, LANDSCAPE ARCHITECT REGISTRATION NUMBER 2072 ON 11/18/24 WHO MAINTAINS THE ORIGINAL FILE. THIS ELECTRONIC DRAWING FILE MAY BE USED AS A BACKGROUND DRAWING. PURSUANT TO RULE 3.100(F) OF THE RULES AND REGULATIONS OF THE TEXAS BOARD OF ARCHITECTURAL EXAMINERS, THE USER OF THIS ELECTRONIC DRAWING FILE AGREES TO ASSUME ALL RESPONSIBILITY FOR ANY MODIFICATION TO OR USE OF THIS DRAWING FILE THAT IS INCONSISTENT WITH THE REQUIREMENTS OF THE RULES AND REGULATIONS OF THE TEXAS BOARD OF ARCHITECTURAL EXAMINERS. NO PERSON MAY MAKE MODIFICATIONS TO THIS ELECTRONIC DRAWING FILE WITHOUT THE LANDSCAPE ARCHITECT'S EXPRESS WRITTEN PERMISSION.

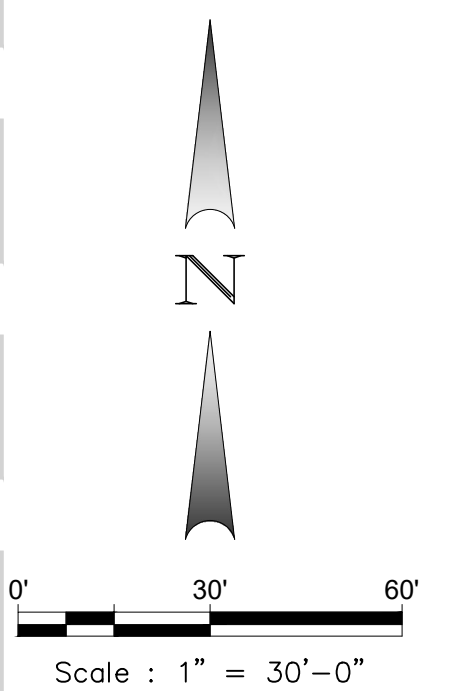

SEE PLANT LEGEND SHEET L-4

FIRE PUMP
TEST HEAD


LANDSCAPE PLAN

L-2

MATCHLINE, SHEET L-2

CALLED 211.36 ACRES
SANGER TEXAS INDUSTRIAL, LLC
INS. NO. 2022-122553,
O.P.R.D.C.T.

NOTE:
NO LANDSCAPE PLANTINGS
WITHIN 3' OF PARKING
LOT CURBS.

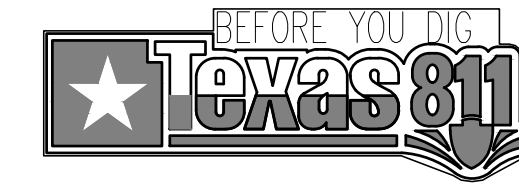

CAUTION!!!
UNDERGROUND UTILITIES ARE LOCATED IN
THIS AREA. 48 HOURS PRIOR TO ANY
CONSTRUCTION ACTIVITIES, CONTACT LINE
LOCATES FOR FRANCHISE UTILITY INFO.
CALL BEFORE YOU DIG!
TEXAS EXCAVATION SAFETY SYSTEM (TESS)
1-800-344-8377
TEXAS ONE CALL SYSTEMS
1-800-245-4545
LONE STAR NOTIFICATION CENTER
1-800-669-8344 EXT. 5




BEFORE
YOU DIG...

Please show that minimum landscaping requirements for non-residential uses per ordinance § 14A-48.5.2 I-1 and I-2 Industrial Districts have been met. Include narrative per ordinance on the plans to verify requirements have been met.




BLUE STAR
INDUSTRIAL PHASE 2
SANGER, TEXAS

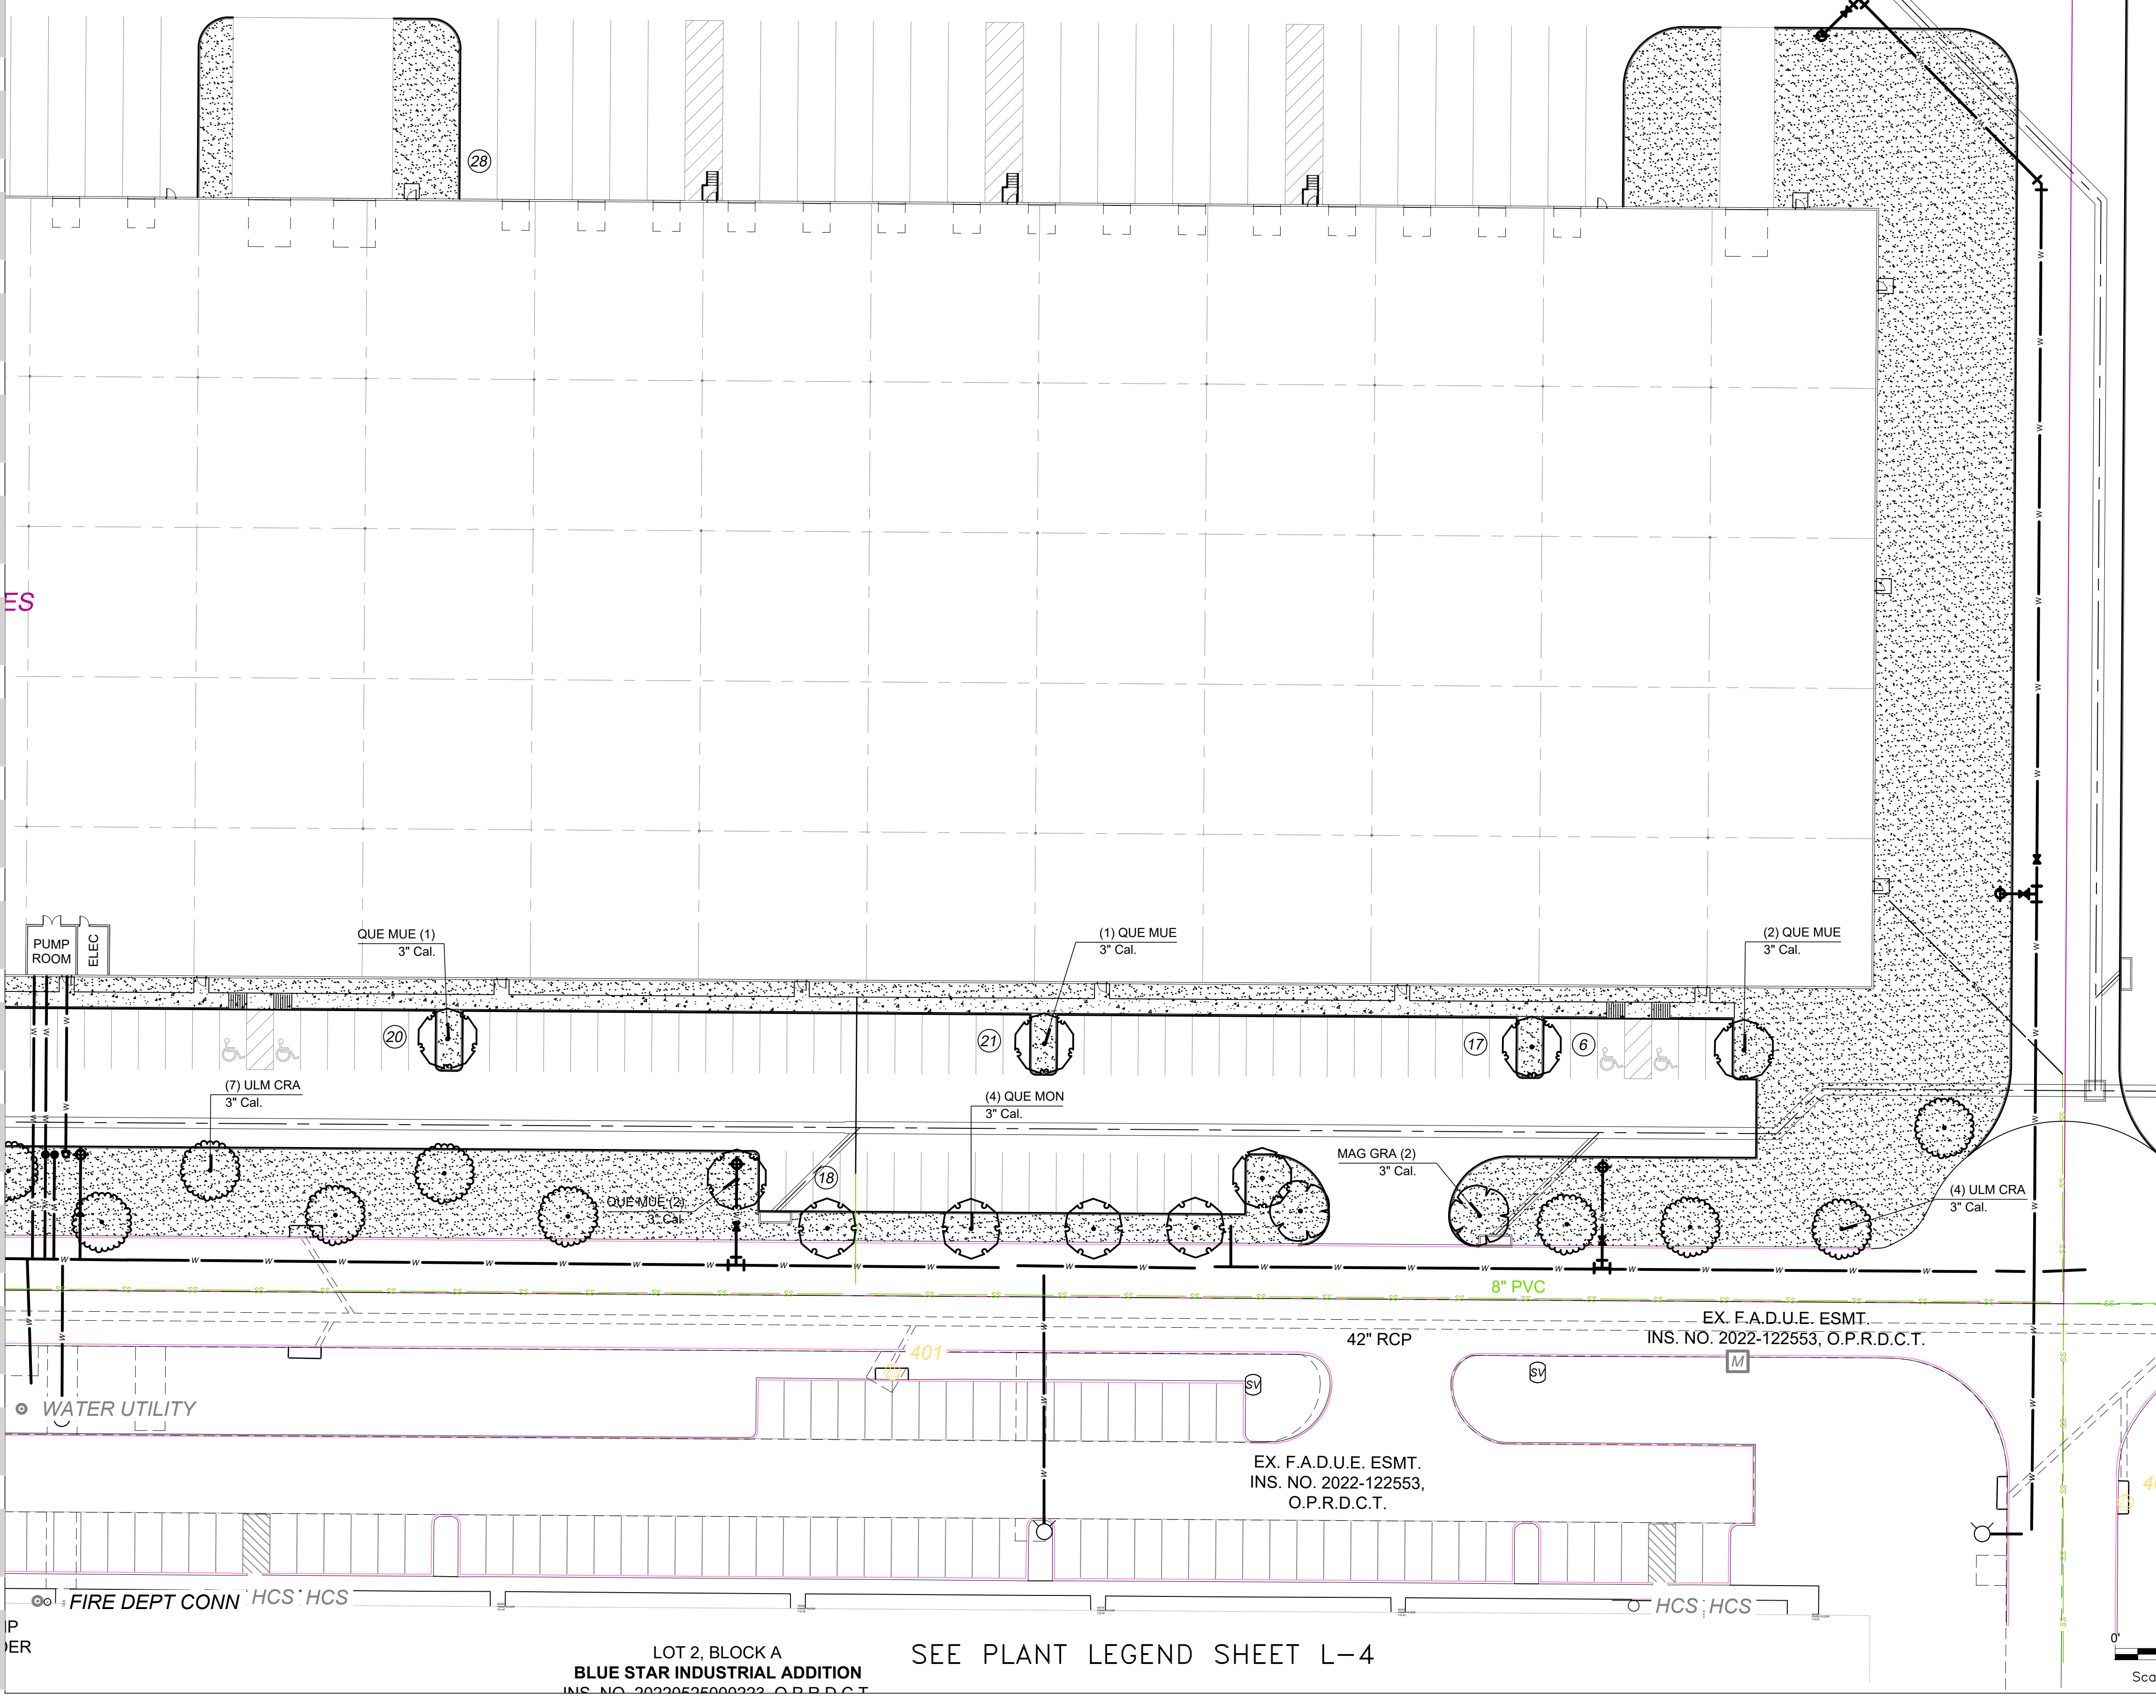

FAIN • CUPPETT
LANDSCAPE ARCHITECTS, LLC
1921 MAPLEWOOD DR
WEATHERFORD, TX 76087 682-215-9151
PARKS AND OPEN SPACE PLANNING • LANDSCAPE ARCHITECTURE • IRRIGATION DESIGN

THIS ELECTRONIC DRAWING FILE IS RELEASED UNDER THE AUTHORITY OF GREG CUPPETT, LANDSCAPE ARCHITECT REGISTRATION NUMBER 2072 ON 11/18/24 WHO MAINTAINS THE ORIGINAL FILE. THIS ELECTRONIC DRAWING FILE MAY BE USED AS A BACKGROUND DRAWING. PURSUANT TO RULE 3.103(F) OF THE RULES AND REGULATIONS OF THE TEXAS BOARD OF ARCHITECTURAL EXAMINERS. THE USER OF THIS ELECTRONIC DRAWING FILE AGREES TO ASSUME ALL RESPONSIBILITY FOR ANY MODIFICATION TO OR USE OF THIS DRAWING FILE THAT IS INCONSISTENT WITH THE REQUIREMENTS OF THE RULES AND REGULATIONS OF THE TEXAS BOARD OF ARCHITECTURAL EXAMINERS. NO PERSON MAY MAKE MODIFICATIONS TO THIS ELECTRONIC DRAWING FILE WITHOUT THE LANDSCAPE ARCHITECT'S EXPRESS WRITTEN PERMISSION.

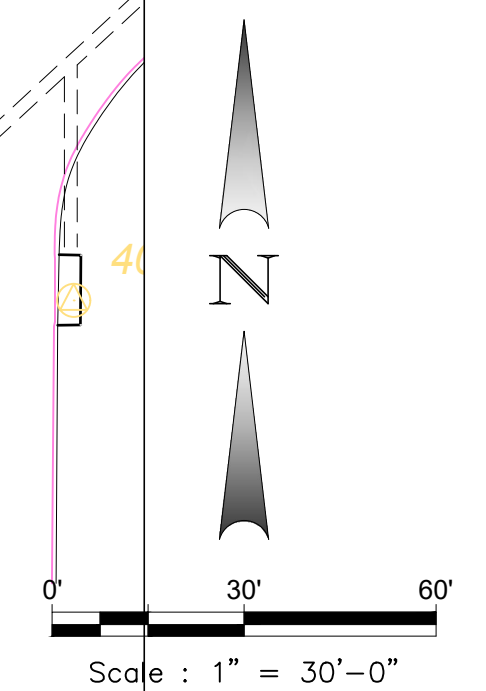


LANDSCAPE PLAN

LOT 2, BLOCK A
BLUE STAR INDUSTRIAL ADDITION
INS. NO. 2022-122553, O.P.R.D.C.T.
SEE PLANT LEGEND SHEET L-4

L-3

Contact Information:
TREE STAKE SOLUTIONS
 www.treestakesolutions.com
JEFF TULEY
 903-676-6143

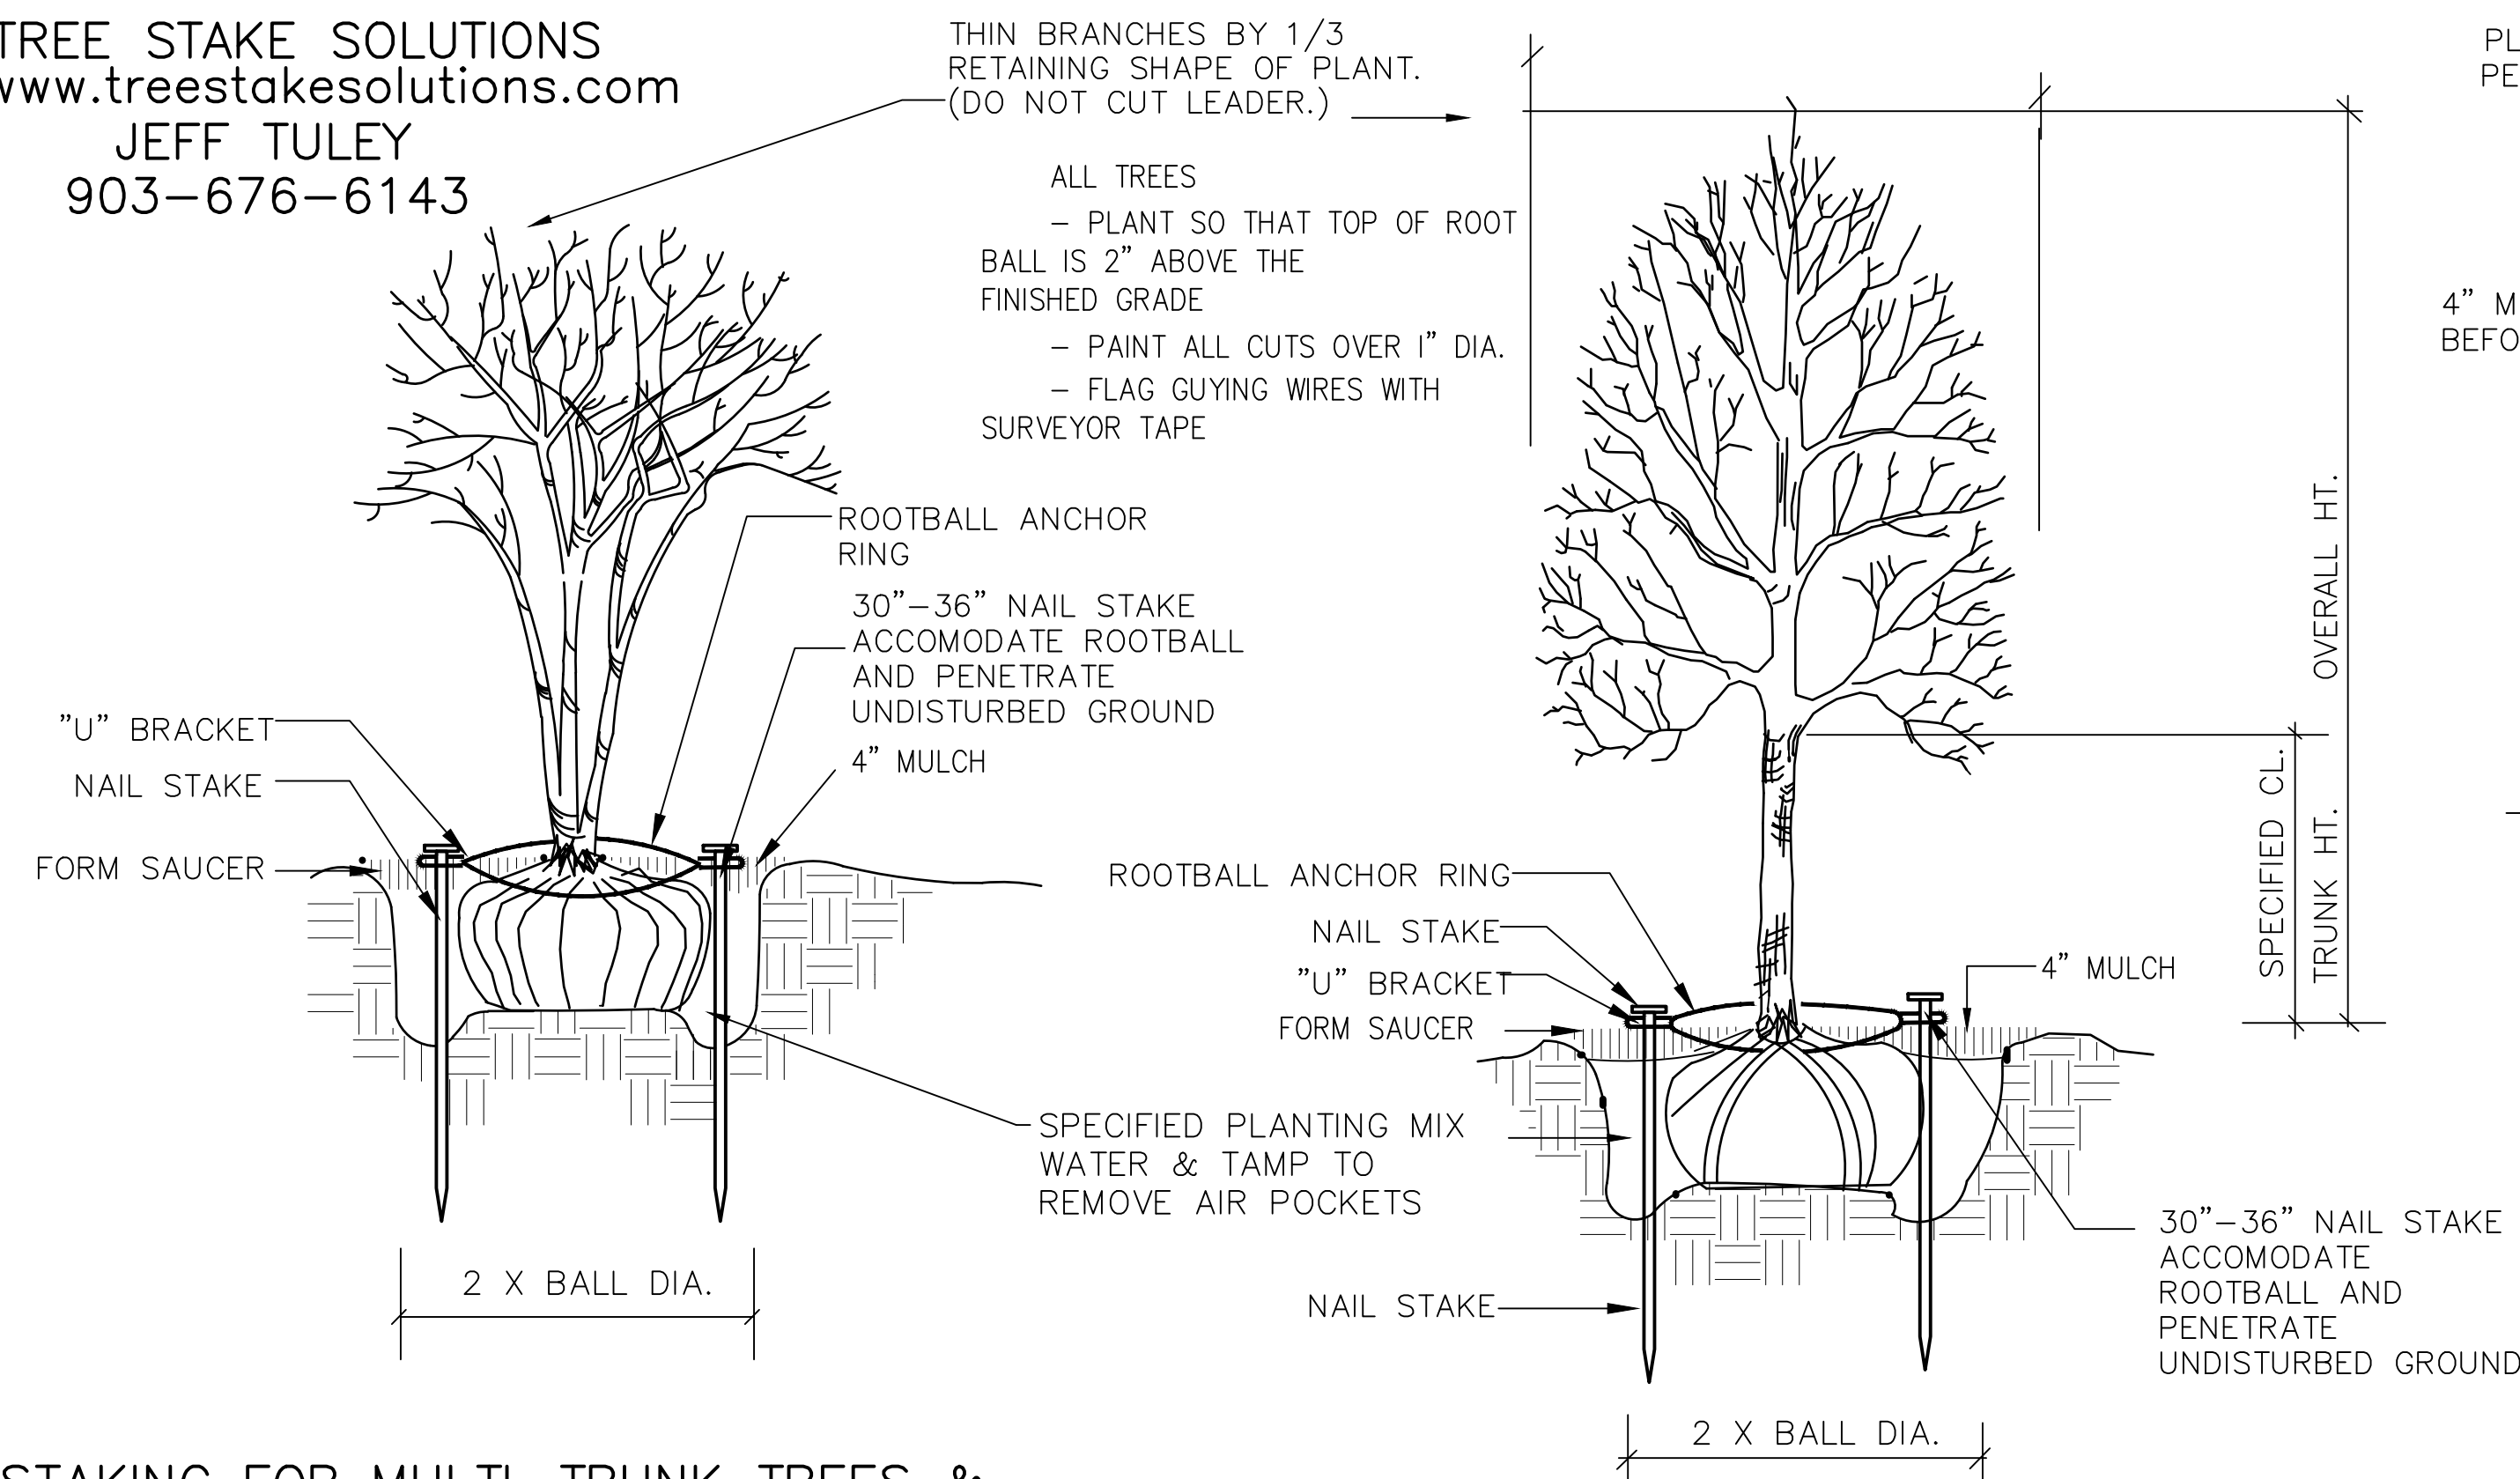


STAKING FOR MULTI-TRUNK TREES & TREES 2" CAL. & UNDER


SCALE: NOT TO SCALE

SAFETY STAKE BY TREE STAKE SOLUTIONS

SCALE: NOT TO SCALE

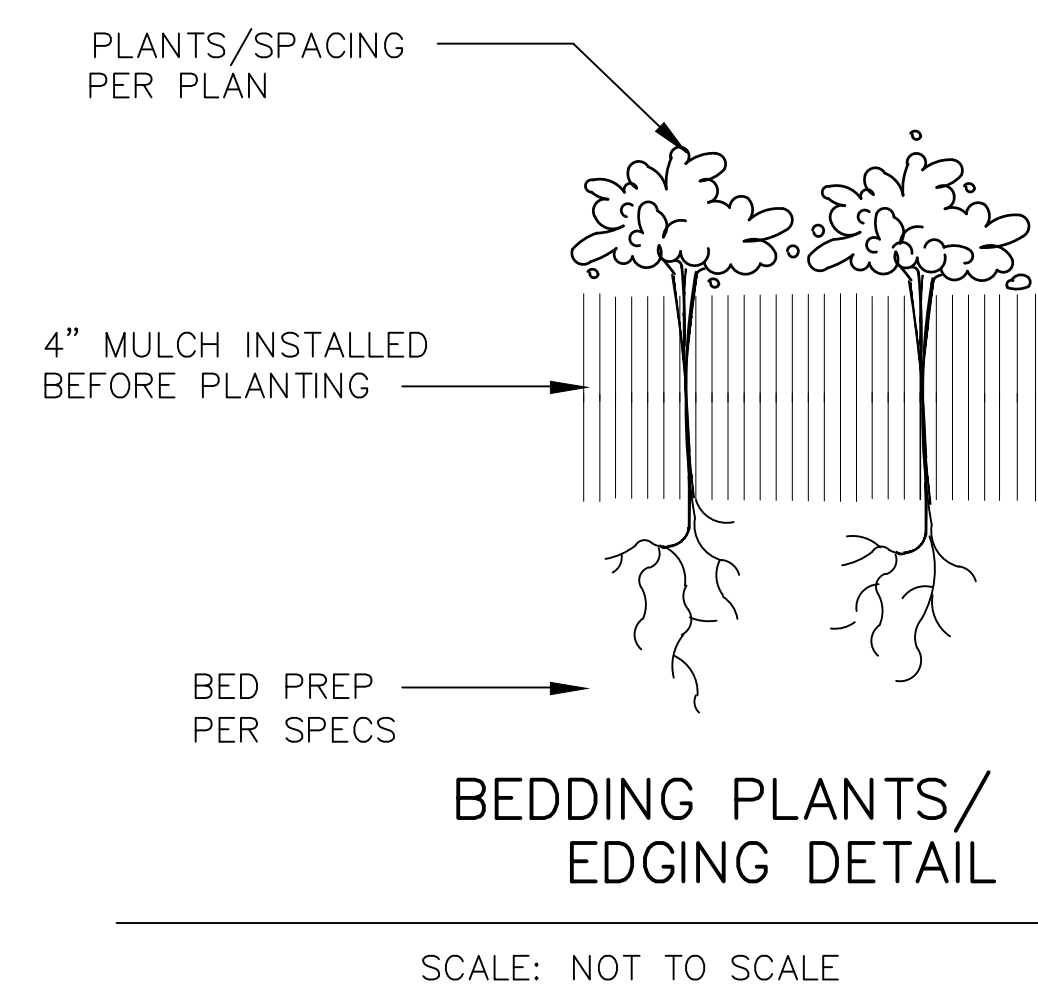


SCALE: NOT TO SCALE

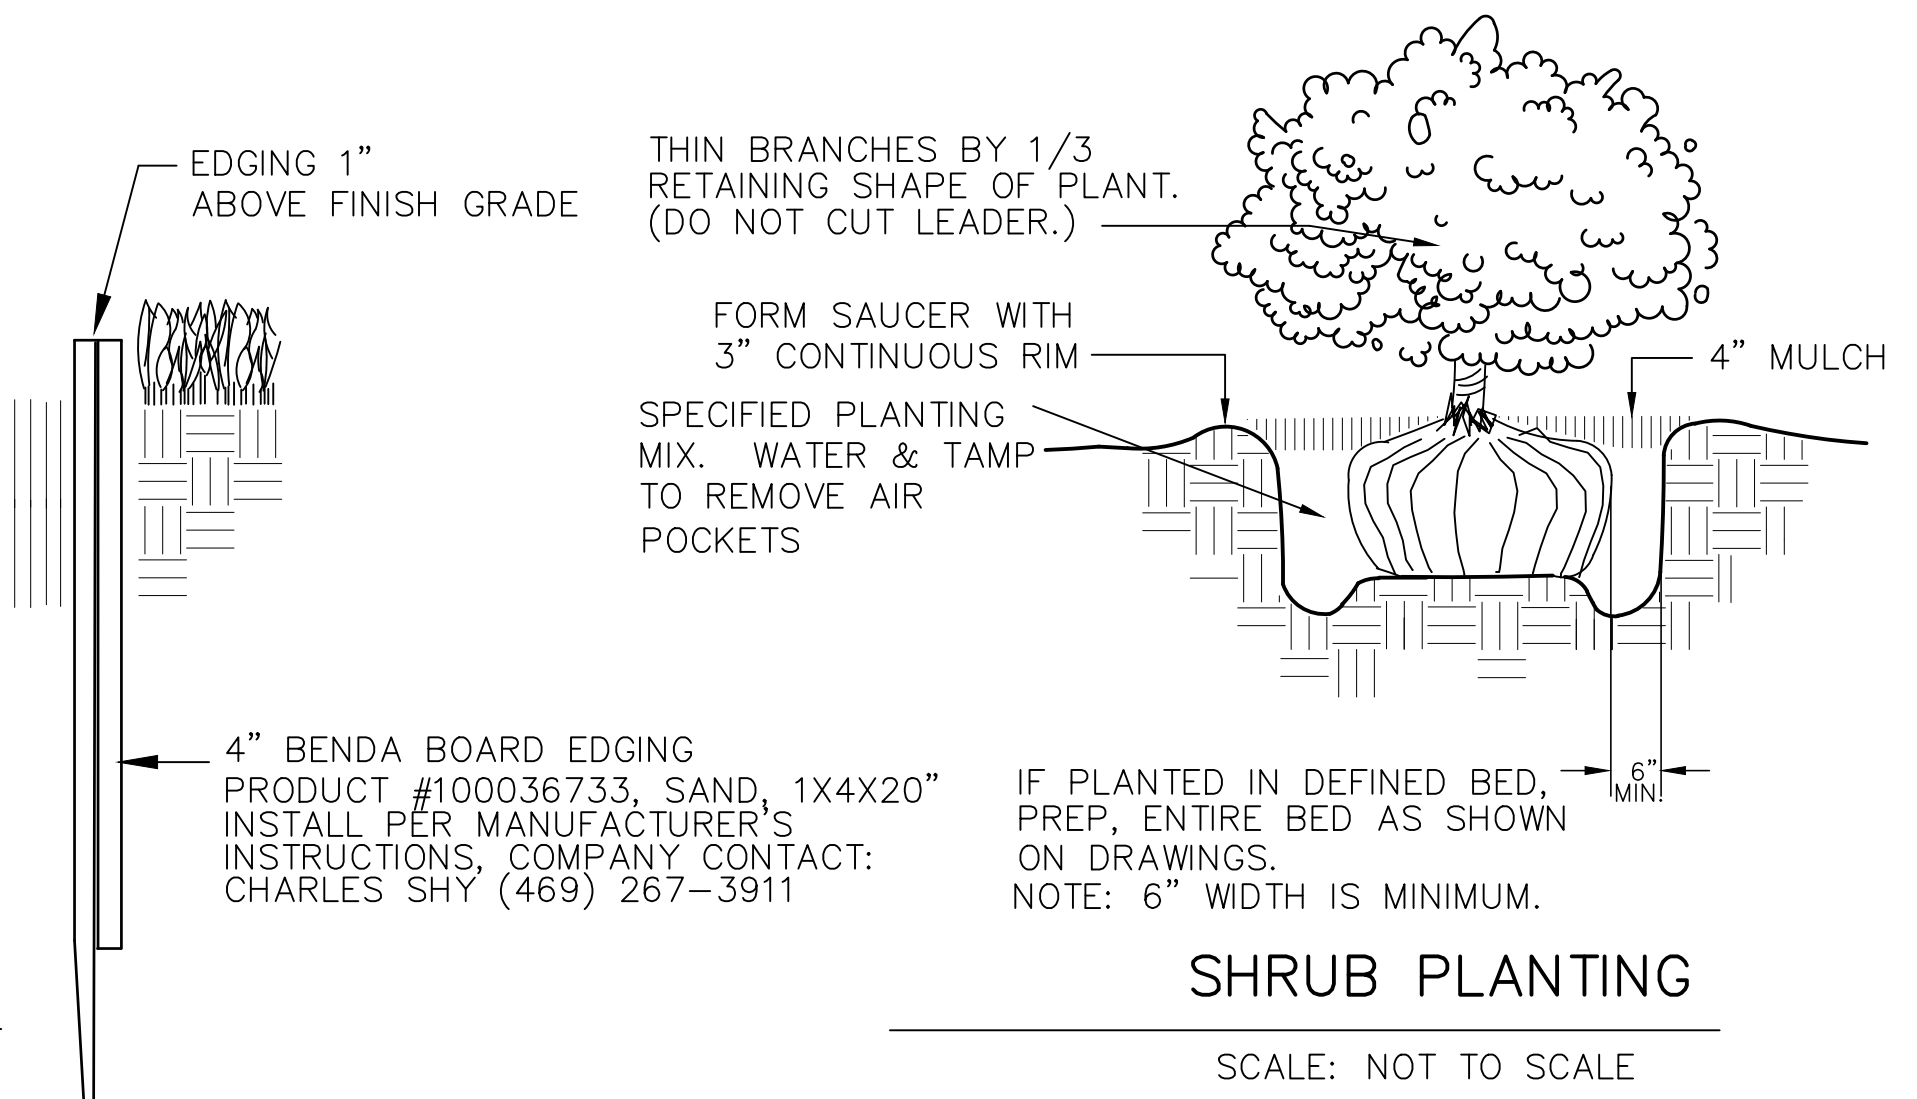


SHRUB PLANTING

SCALE: NOT TO SCALE

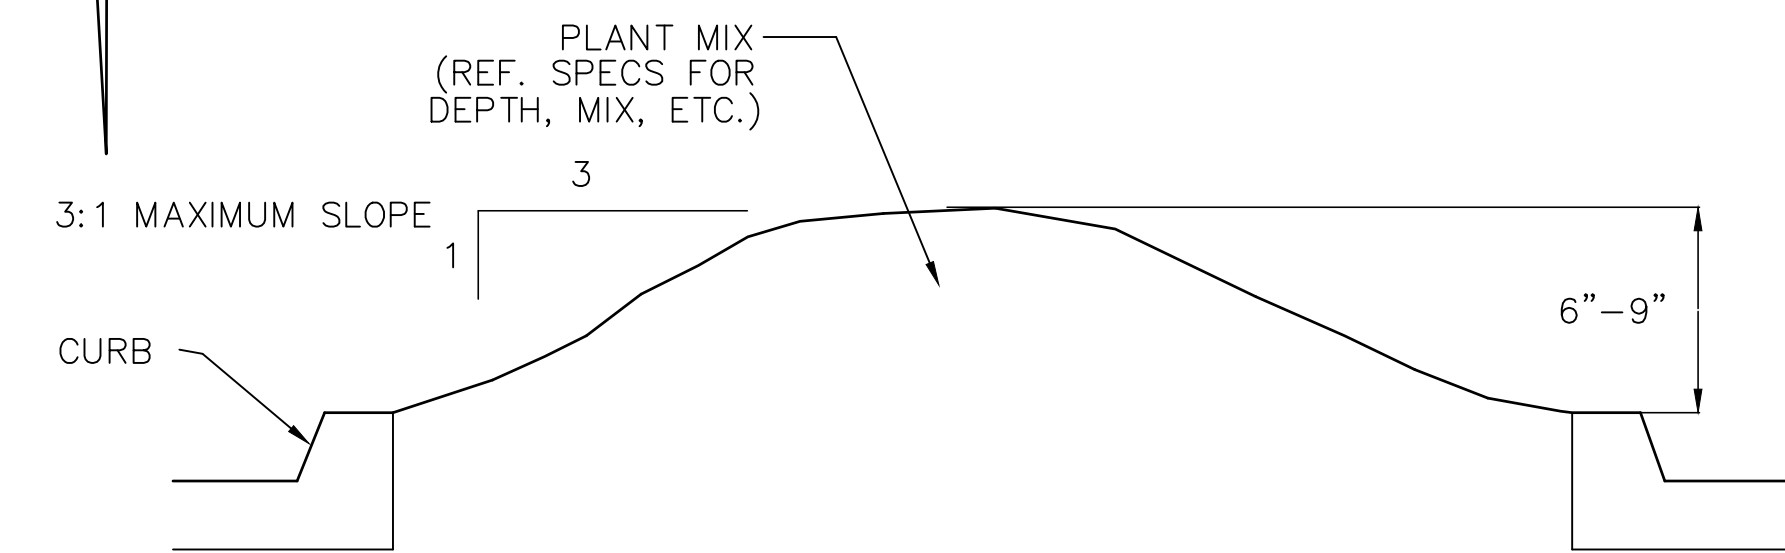

TYPICAL PARKING LOT ISLAND MOUNDING

SCALE: NOT TO SCALE

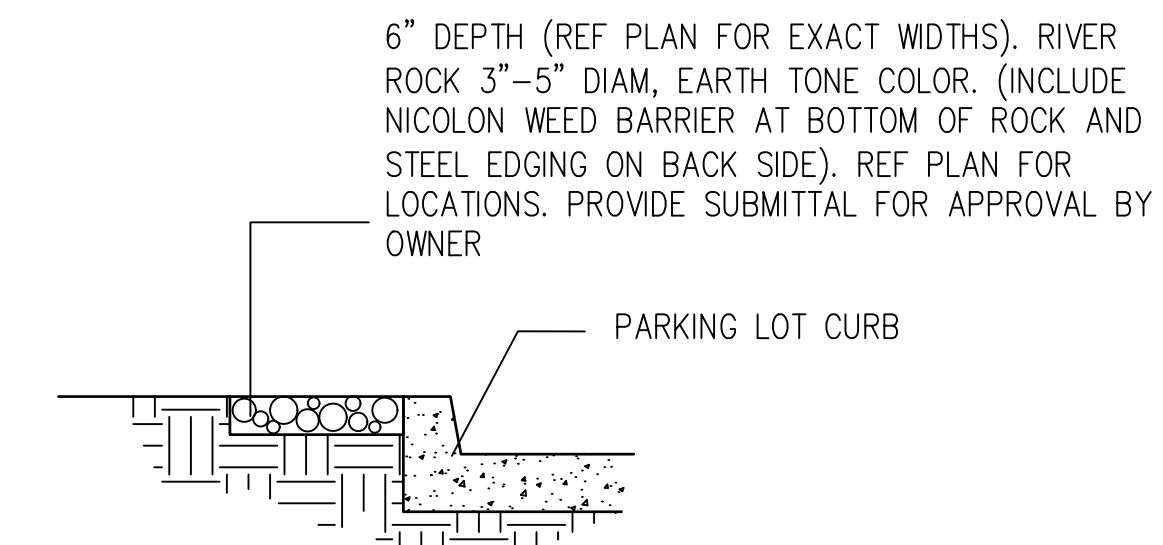

RIVER ROCK STRIP

SCALE: NOT TO SCALE


PLANT SCHEDULE

SYMBOL	CODE	QTY	BOTANICAL NAME	COMMON NAME	SIZE	HEIGHT	SPACING	REMARKS
TREES								
	MAG GRA	6	Magnolia grandiflora	Southern Magnolia	3" Cal.	12' Height Min	As Shown	
	QUE MUE	10	Quercus muehlenbergii	Chinkapin Oak	3" Cal.	14' Min. Ht.	As Shown	
	QUE MON	14	Quercus polymorpha 'Monterey'	Monterey Mexican White Oak	3" Cal.	12' Height Min	As Shown	
	ULM CRA	20	Ulmus crassifolia	Cedar Elm	3" Cal.	12' Height Min	As Shown	
SHRUBS								
	ABE GRA	90	Abelia x grandiflora	Glossy Abelia	5 gal.	24" min.	36" O.C.	
	MYR DON	58	Myrica cerifera 'Don's Dwarf'	Don's Dwarf Wax Myrtle	5 gal.	24" min.	36" O.C.	
SYMBOL	CODE	QTY	BOTANICAL NAME	COMMON NAME	SIZE	HEIGHT	SPACING	REMARKS
GROUND COVERS								
	CYN DAC	73,227 sf	Cynodon dactylon	Bermudagrass	Solid Sod			

FAIN • CUPPETT
LANDSCAPE ARCHITECTS, LLC
 1921 MAPLEWOOD DR
 WEATHERFORD, TX 76087 682-215-9151
PARKS AND OPEN SPACE PLANNING • LANDSCAPE ARCHITECTURE • IRRIGATION DESIGN

THIS ELECTRONIC DRAWING FILE IS RELEASED UNDER THE AUTHORITY OF GREG CUPPETT, LANDSCAPE ARCHITECT REGISTRATION NUMBER 2072 ON 11/18/24 WHO MAINTAINS THE ORIGINAL FILE. THIS ELECTRONIC DRAWING FILE MAY BE USED AS A BACKGROUND DRAWING. PURSUANT TO RULE 3.103(F) OF THE RULES AND REGULATIONS OF THE TEXAS BOARD OF ARCHITECTURAL EXAMINERS. THE USER OF THIS ELECTRONIC DRAWING FILE AGREES TO ASSUME ALL RESPONSIBILITY FOR ANY MODIFICATION TO OR USE OF THIS DRAWING FILE THAT IS INCONSISTENT WITH THE REQUIREMENTS OF THE RULES AND REGULATIONS OF THE TEXAS BOARD OF ARCHITECTURAL EXAMINERS. NO PERSON MAY MAKE MODIFICATIONS TO THIS ELECTRONIC DRAWING FILE WITHOUT THE LANDSCAPE ARCHITECT'S EXPRESS WRITTEN PERMISSION.

PLANTING DETAILS

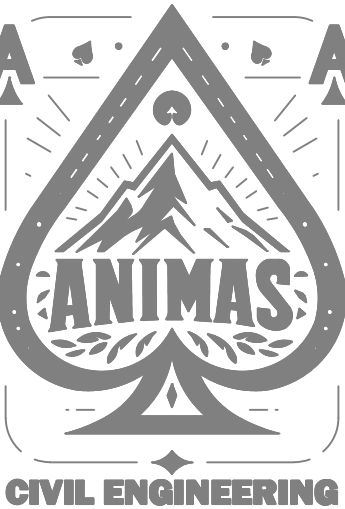

BLUE STAR
INDUSTRIAL PHASE 2
SANGER, TEXAS

SECTION 02830

TREES SHRUBS, AND GROUNDCOVERS

PART I GENERAL

1.01 DESCRIPTION OF WORK

A. Scope

1. Bed prep
2. Metal edging
3. Topsoil
4. Planting
5. Mulching
6. Guarantee

B. Related Work Specified Elsewhere

1. General Requirements – All locations
2. Section 02740 – Irrigation Trenching
3. Section 02750 – Irrigation
4. Section 02800 – Lawns

1.02 QUALITY ASSURANCE

A. Contractor Qualifications

Minimum of three (3) years experience on projects of similar characteristics and size.

B. Reference Standards:

1. American Joint Committee Of Horticultural Nomenclature: Standardized Plant Names, Second Edition, 1942;
2. American Association Of Nurserymen: American Standard For Nursery Stock, 1973

C. Substitutions

1. Substitutions accepted only upon written approval of Landscape Architect and Owner.
2. Submit substitutions possessing same characteristics as indicated on plans and specifications.

D. Inspection and Testing

1. The project Owner's representative reserves the right to inspect and tag plants at the place of growth with the Contractor.
2. Inspection at place of growth does not preclude the right of rejection due to improper digging or handling.
3. Owner's representative reserves the right to request soil samples and analysis of soil and plant mix. Remove or correct unacceptable soil. Cost of testing by Contractor.

1.03 SUBMITTALS

A. Certificates

1. Submit State and Federal certificates of inspection with invoice. (Only if required by Landscape Architect.)
2. File certificates with Owner's representative prior to material acceptance.

1.04 PRODUCT DELIVERY, STORAGE, & HANDLING

A. Preparation of Delivery

1. Balled & Burlaped (B&B) Plants

- a. Dig and prepare for shipment in manner that will not damage roots, branches, shape, and future development after replanting.
- b. Ball with firm, natural ball of soil, wrapped tightly with burlap covering entire ball.
- c. Ball size and ratios: conform to American Association of Nurserymen standards unless otherwise shown on plant list.

2. Pack plant material to protect against climatic & seasonal damage, as well as breakage injuries during transit.
3. Securely cover plant tops with ventilated tarpaulin or canvas to minimize wind-whipping and drying in transit.
4. Pack and ventilate to prevent sweating of plants during transit. Give special attention to insure prompt delivery and careful handling to point of delivery at job site.

B. Delivery

1. Deliver fertilizer, fertilizer tablets, peat, mulch, soil additives, and amendment materials to site in original, unopened containers, bearing manufacturer's guaranteed chemical analysis, name, trade name, trademark, and conformance to State law.
2. Deliver plants with legible identification and size labels on example plants.
3. Protect during delivery to prevent damage to root ball or desiccation of leaves.
4. Notify Owner's representative of delivery schedule in advance so plant material may be inspected upon arrival at job site.
5. Deliver plants to job site only when areas are prepared.

C. Storage

1. Protect roots of plant material from drying or other possible injury with wetted mulch or other acceptable material.
2. Protect from weather.
3. Maintain and protect plant material not to be planted immediately upon delivery.

D. Handling

1. Do not drop plants.
2. Do not damage ball, trunk, or crown.
3. Lift and handle plants from bottom of container or ball.

1.05 JOB CONDITIONS

E. Planting Season Perform actual planting only when weather and soil conditions are suitable in accordance with locally acceptable practices.

F. Protection Before excavations are made, take precautionary measures to protect areas trucked over and where soil is temporarily stacked.

1.06 GUARANTEE

A. Guarantee new plant material for one year after acceptance of final installation (ie Final Acceptance of project).

B. Make replacement (one per plant) during one year guarantee period at appropriate season with original plant type, size and planting mixture.

C. Repair damage to other plants, lawns, & irrigation caused during plant replacement at no cost to Owner.

D. Use only plant replacements of indicated size and species.

E. Ten days before end of guarantee period, notify Owner's representative in writing for year end inspection. Failure to do so, shall automatically extend guarantee until notification is received.

PART II PRODUCTS

2.01 MATERIALS

A. Plant Materials

1. Hardy under climatic conditions similar to locality of project.
2. True to botanical and common name variety.
3. Sound, healthy, vigorous, well branched, and densely foliated when in leaf; with healthy well-developed root system.
4. Free from disease, insects, and defects such as knots, sun-scald, windburn, injuries, disfigurement, or abrasions.
5. Conform to measurements after pruning with branches in normal positions.
6. Conform to American Association of Nurserymen standards unless shown differently on plant list.
7. Trees:
 - a. Single, straight trunks, unless indicated otherwise
 - b. Trees with weak, thin trunks not capable of support will not be accepted.
 - c. All multi-stem trees are to have a minimum of three stems, similar in size and shape, with a spread of approximately 2/3 of the height. All yaupons to be female. Grape myrtle color selection by Landscape Architect.
8. Nursery grown stock only.
9. Subject to approval of Landscape Architect.
10. Seasonal color
 - a. Annuals in 4" pots or as specified
 - b. Perennials in 4" pots, clumps, bulbs as specified

B. Topsoil

1. Natural, fertile, friable soils having a textural classification of loam or sandy loam possessing characteristics of soils in vicinity which produce heavy growth of crops, grass, or other vegetation.
2. Free of subsoil, brush, organic litter, objectionable weeds, clods, shale, stones 1/4 diameter or larger, stumps, roots or other material harmful to grading, planting, plant growth, or maintenance operations.
3. Presence of vegetative parts of Bermuda grass (Cynodon dactylon), Johnson grass, nut grass (Cyperus rotundus), and other hard to eradicate weeds or grass will be cause for rejection of topsoil.
4. Test topsoil (cost by Contractor):
 - a. Available nitrogen
 - b. Available phosphorus
 - c. Available potash
 - d. Iron
 - e. Ph: 5.5 to 7.0
 - f. Decomposed organic matter: 6-10%

C. Mulch

1. Top Dressing Mulch – Shredded cypress or hard wood only
2. Mulch for soil prep – Shredded pine bark
3. In pre-packaged bags only; bulk shredded material is unacceptable.

D. Peat Moss Commercially available baled peat moss or approved equivalent.

E. Staking Material

1. Stakes for tree support

- a. Tree Stake for trees or equivalent.
- b. To be removed after one year.

F. Water

1. Free of oils, acids, alkali, salt, and other substances harmful to plant growth
2. Location: Furnish temporary hoses and connections on site.

G. Sand Washed builders sand

H. Antidesicant – "Wilt-proof" or equal.

I. Edging – 3/16" X 4" green, new and unused; with stakes.

2.02 MIXES

A. Planting Mixture

- Existing topsoil – 50%
3. Shredded pine bark – 50%
 4. Fertilizer 10:20:10 at 30 lb./1000 SF

B. Planting Mix for Annuals/Perennials

1. Prepare above mix
2. Add 2" of sand

C. Azalea mix: solid peat moss in hole 9" wider than root ball each direction. Plant in solid peat moss and provide mound at base of plant to allow for drainage.

D. Japanese maple, dogwood, camellias: Provide 50/50 peat moss to topsoil mix, raise for drainage.

PART III – EXECUTION

3.01 UTILITIES – verify location of all utilities prior to initiating construction; repair any damage caused by construction at no cost to owner.

3.02 INSPECTION

- A. Inspect plants for injury and insect infestation; prune prior to installation.
- B. Inspect site to verify suitable job conditions.

3.03 FIELD MEASUREMENTS

- A. Location of all trees and shrubs to staked in the field and approved by Owner's representative prior to installation.
- B. Location of all groundcover and seeding limits as shown on plans.

3.04 EXCAVATION FOR PLANTING

A. Pits

1. Shape – Vertical hand scarified sides and flat bottom.
2. Size for trees – 2 feet wider or twice the root ball, whichever is greater.
3. Size for shrubs – Size of planting bed as shown on drawings.
4. Rototill soil mix thoroughly, full depth of 12".
5. NOTE: If beds are proposed beneath drip line of existing tree canopy, pocket prep plants. Do not roto-till beneath existing trees.

B. Obstructions Below Ground

1. Remove rock or underground obstructions to depth necessary to permit planting.
2. If underground obstructions cannot be removed, notify Owner's representative for instruction.

C. Excess Soil Dispense of unacceptable or excess soil away from the project site at Contractor's expense.

3.05 PLANTING

A. General

1. Set plants 2" above existing grade to allow for settling.
2. Set plants plumb and rigidly braced in position until planting mixture has been tamped solidly around ball.
3. Apply soil in accordance with standard industry practice for the region.
4. Thoroughly settle by water jetting and tamping soil in 6" lifts.
5. Prepare 3" dish outside root ball after planting.
6. Thoroughly water all beds and plants.
7. Stake trees and large shrubs as indicated on plans.
8. Apply anti-desicant according to manufacturer's instructions.
9. Apply commercially manufactured root stimulator as directed by printed instruction.
10. Plant and fertilize bedding plants per trade standards.
11. Apply 3" mulch top dressing.
12. Provide weed mat and twelve inches (12") of amended topsoil to planting areas to ensure optimum plant health.

B. Balled Plants

1. Place in pit of planting mixture that has been hand tamped prior to placing plant.
2. Place with burlap intact to ground line. Top of ball to be 2" above surrounding soil to allow for settling.
3. Remove binding at top of ball and lay top of burlap back 6".
4. Do not pull wrapping from under ball, but cut all binding cord.
5. Do not plant if ball is cracked or broken before or during planting process or if stem or trunk is loose.
6. Backfill with planting mixture in 6" lifts.

C. Container Grown Plants

1. Place in pit on planting mixture that has been hand tamped prior to placing plant.
2. Cut cans on two sides with an acceptable can cutter, and remove root ball from can.

Do not injure root ball.

3. Carefully remove plants without injury or damage to root balls.
4. Backfill with planting mixture in 6" lifts.

D. Mulching

1. Cover planting bed evenly with 4" of mulch to hide drip irrigation system, retain soil moisture and minimize weed growth.
2. Water immediately after mulching.
3. Where mulch has settled, add additional mulch to regain 3" thickness.
4. Hose down planting area with fine spray to wash leaves of plants.

D. Pruning

1. Prune minimum necessary to remove injured twigs and branches, dead wood, and succors; remove approximately 1/3 of twig growth as directed by landscape architect; do not cut leaders or other major branches of plant unless directed by landscape architect.
2. Make cuts flush, leaving no stubs.
3. Paint cuts over 1" diameter with approved tree wound paint.
4. Do not prune evergreens except to remove injured branches.

3.06 EDGING

- A. Stake edging alignment with string line prior to installation. Use framing square to insure right angles are true.
- B. Install all edging straight and true as indicated on drawings. Where edging layout is circular in design, maintain true and constant radii as shown.
- C. When required on slopes, make vertical cuts (approximately 6" on center) on bottom of edging to allow bending without crimping edging.
- D. Install edging so that approximately 1" is exposed on lawn side. Edging should not be visible from bed side after application of mulch.
- E. Align edging with architectural features (ie pavement joints, windows, columns, wall, etc.) when drawings indicate.
- F. Bend all corners, do not cut corners.
- G. Interlock all pieces with pre-fabricated connectors.
- H. Install with all stakes on inside of planting bed.
- I. Remove, file off all sharp corners and burrs.

3.07 CLEAN-UP

A. Sweep and wash all paved surfaces.

Remove all planting and construction debris from site, including rocks, trash and all other miscellaneous materials.

3.08 MAINTENANCE

A. Contractor responsible for routine, and regular maintenance of site until Final Acceptance is awarded by Owner. Work includes:

1. Weeding (weekly)
2. Watering (as required)
3. Pruning
4. Spraying
5. Fertilizing
6. Mulching
7. Mowing (weekly)

B. Provide Owner and Landscape Architect with preferred maintenance schedule in writing. Schedule shall include the above-listed tasks and shall address all frequencies, rates, times, levels, etc.



BLUE STAR
 INDUSTRIAL PHASE 2
 SANGER, TEXAS



THIS ELECTRONIC DRAWING FILE IS RELEASED UNDER THE AUTHORITY OF GREG CUPPETT, LANDSCAPE ARCHITECT REGISTRATION NUMBER 2072 ON 11/18/24 WHO MAINTAINS THE ORIGINAL FILE. THIS ELECTRONIC DRAWING FILE MAY BE USED AS A BACKGROUND DRAWING. PURSUANT TO RULE 3.103(F) OF THE RULES AND REGULATIONS OF THE TEXAS BOARD OF ARCHITECTURAL EXAMINERS. THE USER OF THIS ELECTRONIC DRAWING FILE AGREES TO ASSUME ALL RESPONSIBILITY FOR ANY MODIFICATION TO OR USE OF THIS DRAWING FILE THAT IS INCONSISTENT WITH THE REQUIREMENTS OF THE RULES AND REGULATIONS OF THE TEXAS BOARD OF ARCHITECTURAL EXAMINERS. NO PERSON MAY MAKE MODIFICATIONS TO THIS ELECTRONIC DRAWING FILE WITHOUT THE LANDSCAPE ARCHITECT'S EXPRESS WRITTEN PERMISSION.

PLANTING SPECS

SECTION 02800

FINISH GRADING, LAWN WORK, WILD FLOWERS

PART I - GENERAL

1.01 DESCRIPTION

- A. Work includes turf establishment (sod, hydromulch, etc.) as described on drawings.
- B. Make required analysis and material tests for topsoil, fertilizers, and other materials of similar character per current methods of the Association of Official Agricultural Chemists, when required.
- C. Grass seed shall conform to tolerances for germination and purity per applicable standards of U.S. Department of Agriculture.
- D. The turf contractor shall have a stand of grass established prior to substantial completion of the project. If this is not possible due to time of year or schedule, he shall maintain and protect the seeded areas until the grass is established.

PART II - PRODUCTS

2.01 TOPSOIL MATERIAL

- A. Topsoil material (stockpiled, as specified in Specifications) has been saved for use in finish grading. After sifting out all plant growth, rubbish, and stones, use for areas designated to receive grass. If stockpiled topsoil is not sufficient quantity to complete work, furnish acceptable topsoil from another approved source to provide four inches (4") of topsoil for grass areas unless otherwise noted on drawings. Grass areas shall be defined as the graded areas disturbed during construction not to be paved or built upon.
- B. Acceptable topsoil material shall be defined as natural, fertile, agricultural soil, capable of sustaining vigorous plant growth, uniform composition throughout admixture of subsoil, free of stones, lumps, plants, and their roots, sticks, or other extraneous matter; do not deliver while in a frozen or muddy condition.

2.02 FERTILIZER

- A. Provide a commercial balanced fertilizer delivered to the job in bags labeled with manufacturer's guaranteed analysis. Store in weatherproof storage, place in such a manner that its effectiveness will not be impaired.
- B. Fertilizer shall be a grade containing the percentages of plant food elements by weight as specified elsewhere in these specifications.
- C. Availability of various elements shall be per Standards of the Association of Official Agricultural Chemists.

2.03 GRASS SEED

- A. Grass seed shall be of the previous season's crop and the date of analysis shown on each bag shall be within nine (9) months of the time of delivery to the project. When requested by the Owner or Representative, the seeding contractor shall furnish a sample of seed from each bag for testing.
- B. The seed shall comply with all provisions of the U.S. Department of Agriculture as to labeling, purity, and germination.

2.04 MULCHING

- A. Dry straw or hay of good quality, free of seeds of competing plants and at such rate of 1 1/2 - 2 tons per acre; or,
- B. Wood cellulose or cane fiber mulch at a rate of 1,000 pounds per acre when the slope is 3/4:1 and steeper; or,
- C. A combination of good quality dry straw or hay free of seeds of competing plants at a rate of 2 1/2 tons per acre and wood cellulose or cane fiber mulch at a rate of 500 pounds per acre. This combination shall be used when the slope is flatter than 3/4:1; or,
- D. Sericea lespedza seed bearing hay at a rate of 3 tons per acre. This mulch may be applied green or air dried, but must contain mature seed.
- E. Manufactured mulch materials, such as soil retention blankets, erosion control netting, or others that may be required on special areas of high water concentration or unstable soils. When these materials are used, follow the manufacturer's recommendations for installation.

2.05 HYDRO-MULCHING

- Wood cellulose fiber or cane fiber mulch will be applied with hydraulic seeding and fertilizing equipment. All slurry ingredients shall be mixed to form a homogeneous slurry and spray applied within one hour after the mixture is made.
- When wood cellulose or cane fiber mulch is used at the 500 pound per acre rate, straw or hay mulch with asphalt emulsion is applied over this to complete the mulch.
- Wood cellulose or cane fiber mulch at the 1,000 pound per acre rate is used alone where other mulch material will not stick.
- Wood cellulose or cane fiber mulch is self anchoring.

PART III - EXECUTION

3.01 RESPONSIBILITY

The site grading contractor will be responsible to stockpile acceptable topsoil in a sufficient quantity to provide four inches (4") minimum cover for all grass areas, including but not limited to all curbed islands, and topsoil planting mounds/berms at the appropriate height and width as defined and shown on the landscaping and/or planting drawings. The topsoil and grass areas shall be further defined as any area disturbed during the grading and construction process.

The site grading contractor, shall be responsible to spread the topsoil within all perimeter graded areas and future building areas only.

The site grading contractor shall be responsible for backfilling of all curbed islands and planting mounds/berms. They shall also be responsible for removal of all stones, roots, and raking of all topsoil areas that are to be seeded and/or planted. It will also be the site grading contractor's responsibility to provide fertilizer, grass seed, and any additional topsoil required and mulching.

3.02 GRASS SEEDING

- A. Remove stones, roots, rubbish and other deleterious materials from topsoiled areas that are to be seeded.
- B. Immediately prior to sowing seed, scarify ground as necessary; rake until surface is smooth and friable. Sow seed evenly, lightly wood rake into 02800-3 C. ground, then roll ground with suitable roller; water thoroughly with fine spray. During any weather, keep lawn watered with sprinklers or other approved methods. Re-seed any areas not doing well or damaged. At intervals as may be required according to seasonal conditions, mow and water grass and execute necessary weeding until acceptable and full stand of grass has been obtained.
- D. Provide permanent grass seeding for lawn areas so indicated. Seed in accordance with the following schedule (unless otherwise directed by Owner or Owner's Representative::

- 1. Sow areas ready for seeding between March 1 and October 1 with Hulled Common Bermuda at a rate of 85 pounds per acre.

- 2. Sow areas ready for seeding between October 1 and March 1 with Unhulled Common Bermuda at a rate of 90 pounds per acre, and Annual Rye Grass at the rate of 50 pounds per acre.

- 3. Apply fertilizer at a rate of 20/25 pounds per 1,000 square feet.

3.03 WILD FLOWERS

- A. Areas indicated on plans to receive wild flower coverage shall be fine graded, fertilized, and prepared in a manner similar to traditional turf establishment.
- B. Area to be hydromulched with seed mix as follows:

Tickseed	10 pounds/acre
Cosmos	15 pounds/acre
Or-Eyed Daisy	5 pounds/acre
Side Oats Grama	4 pounds/acre
Showy Primrose	0.5 pounds/acre
Plains Coreopsis	2 pounds/acre
Black Eyed Susan	2 pounds/acre
Indian Blanket	10 pounds/acre
Texas Bluebonnet	4 pounds/acre
Little Bluestem	4 pounds/acre

3.04 MULCH

- A. All areas to be seeded shall be mulched.
- B. Mulch materials shall be applied uniformly over the seeded area. Mulch shall be straw and shall be at the rate of 1 1/2 - 2 tons per acre.
- B. Mulch shall be anchored with an emulsified asphalt binder at the rate of 10 gallons per 1,000 square feet.

3.05 PROTECTION

Provide, at no additional cost to Owner, fencing, railing, wire or other types of protection for topsoiled and seeded areas against trespassing and damage. If lawns are damaged prior to Final Acceptance, treat or replace them as directed. Remove protection when so directed.

3.06 MAINTENANCE

Provide maintenance from start of work until Final Acceptance. Maintenance includes watering of lawns, weeding, mowing, edging, repairs of wash-outs and gullies, repairs to protection, and other necessary work of maintenance. Maintain slopes against erosion.

3.07 REHYDROMULCHING

The Owner's representative will designate areas to be replanted. Areas on which a stand of growing grass is not present in a reasonable length of time, (Bermuda grass seed should be germinating in 6-8 days) shall be prepared, reseeded and remulched, as specified for original planting at no additional cost to Owner. A stand shall be defined as live plants from seed occurring at a rate of not less than 1,000 growing plants per square foot. Replanting required because of faulty operations and negligence on the part of the Contractor shall be performed without cost to Owner.

3.08 FINAL CLEAN-UP

- A. At time of final inspection of work, and before final acceptance, clean paved areas that are soiled or stained by operations of work of this section. Clean by sweeping or washing, and remove all defacements or stains.
- B. Remove construction equipment, excess material and tools. Cart away from site any debris resulting from work of this section and dispose of as directed.

SECTION 02922 SODDING

PART I - GENERAL

1.01 DESCRIPTION

- A. Work Included
 - 1. Sod bed preparation
 - 2. Fertilizing
 - 3. Sodding
 - 4. Miscellaneous management practices
- B. Related Work Specified Elsewhere
 - 1. Finish Grading, Section 02800
 - 2. Lawns and Grasses, Section 02930

1.02 REFERENCE STANDARDS

- A. Standardized Plant Names

American Joint Committee of Horticultural Nomenclature, Second Edition, 1942.
- B. Texas Highway Department - Standard Specifications for Construction, Item 164, Seeding for Erosion Control.

1.03 SUBMITTALS

- A. Vendors Certification That Sod Meets Texas State Sod Law
 - 1. Include labeling requirements.
 - 2. Include purity and type.

1.04 PRODUCT DELIVERY, STORAGE AND HANDLING

- A. Sod:
 - 1. Previous season's crop with date of analysis on each bag.
 - 2. Furnish and deliver each variety in separate bags or containers.
 - 3. Sod to be cut no more than three days before delivery.

B. Fertilizer:

- 1. Unopened bags labeled with the analysis.
- 2. Conform to Texas Fertilizer Law.

1.05 JOB CONDITIONS

- A. Planting Season:
 - 1. Only during suitable weather and soil conditions.
 - 2. As specifically authorized by the Owner's Representative.
- B. Schedule - Only after all other construction is complete.
- C. Protect and Maintain Sodded Areas
 - 1. From traffic and all other use.
 - 2. Until sodding is complete and accepted.

PART II - PRODUCTS

2.01 MATERIALS

- A. Sod:
 - 1. Sod: As specified on drawings, weed, insect, and disease free having a minimum of 1 inch of topsoil attached to the roots and cut no more than three days prior to installation.
 - 2. The sod shall be cut in strips of at least 1/2 sq. yd. and not more than 1 sq. yd. Sod shall be cut into strips not less than 12" in width or more than 9' in length. At the time of harvest, the top growth shall not exceed 3" in length.
 - 3. All sod shall conform to the laws of the State and shall be obtained from sources meeting the approval of the Department of Agriculture, Division of Entomology.

B. Fertilizer:

- 1. Uniform in composition, free flowing.
- 2. Suitable for application in approved equipment.
- 3. Analysis of 16-20-0, 16-8-8 or as directed.

C. Water:

- 1. Free of oil, acid, alkali, salts or other substances harmful to growth of grasses.

PART III - EXECUTION

3.01 SOD BED PREPARATION

- A. Cultivate to a depth of four (4") inches by diking and tilling with a power tiller.

B. Clear surfaces of all materials:

- 1. Stumps, stones, and other objects larger than one inch (1").
- 2. Roots, brush, wire, stakes, etc.
- 3. Any objects that may interfere with sodding or maintenance.

C. Prepare sod bed:

- 1. Remove soil clods larger than one inch (1").
- 2. Grade areas to smooth, even surface, removing ridges and filling depressions. Final grade to be below finish grade of curbing and edging as shown on details. All grades shall meet approval of Owner's Representative before sodding.

3.02 SODDING

A. Sodding:



- 1. Lightly water prepared grade, lay sod with staggered joints and with edges touching. Topdress with topsoil at edges if necessary to provide smooth surface. On slopes of 2 to 1 and greater, fasten sod in place with wood pegs (two each piece) or other approved method. Sod damaged by storage or during installation shall be rejected. Following settling, topdress with screened, approved topsoil.
- 2. Water and fertilize at 5 lbs. per 1,000 sq. ft.
- 3. Sod shall not be placed during a drought, nor during periods when sod is not normally placed in the area, and shall not be placed on frozen ground. No dry or frozen sod is acceptable.
- 4. The contractor shall keep all sodded areas moist and growing until Final Acceptance. All areas shall be maintained in an acceptable condition until acceptance by Owner.

B. Rolling:

- 1. After placing sod, roll with a hand roller, weighing not more than 100 lbs. per foot of width, in two directions.
- 2. Eliminate all air pockets; finished surface should be free of excessive undulations.

3.05 MAINTENANCE AND MANAGEMENT

- A. Includes protection, replanting, maintaining grades, repair of erosion damage. Also includes weekly mowing at 1 1/2" height until final acceptance.
- B. Resodding:
 - 1. Resod damaged or unacceptable areas.
 - 2. Ruts, ridges, and other surface irregularities shall be corrected.

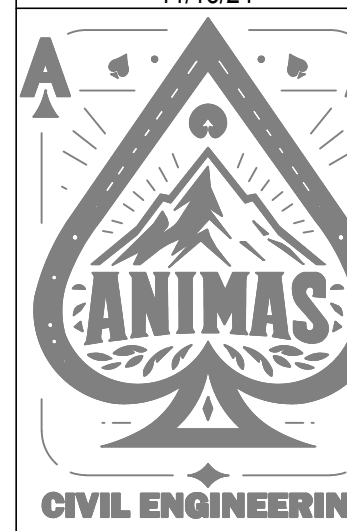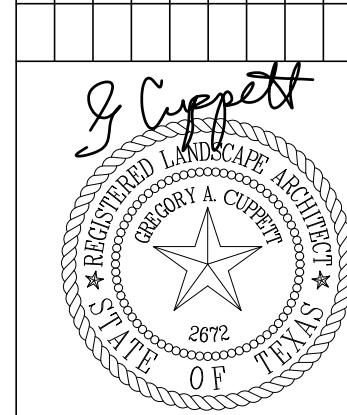

BLUE STAR
INDUSTRIAL PHASE 2
SANGER, TEXAS



THIS ELECTRONIC DRAWING FILE IS RELEASED UNDER THE AUTHORITY OF GREG CUPPETT, LANDSCAPE ARCHITECT REGISTRATION NUMBER 2672 ON 11/18/24 WHO MAINTAINS THE ORIGINAL FILE. THIS ELECTRONIC DRAWING FILE MAY BE USED AS A BACKGROUND DRAWING. PURSUANT TO RULE 3.100(F) OF THE RULES AND REGULATIONS OF THE TEXAS BOARD OF ARCHITECTURAL EXAMINERS, THE USER OF THIS ELECTRONIC DRAWING FILE AGREES TO ASSUME ALL RESPONSIBILITY FOR ANY MODIFICATION TO OR USE OF THIS DRAWING FILE THAT IS INCONSISTENT WITH THE REQUIREMENTS OF THE RULES AND REGULATIONS OF THE TEXAS BOARD OF ARCHITECTURAL EXAMINERS. NO PERSON MAY MAKE MODIFICATIONS TO THIS ELECTRONIC DRAWING FILE WITHOUT THE LANDSCAPE ARCHITECT'S EXPRESS WRITTEN PERMISSION.

TURF SPECS