



December 6, 2022 AVO 37449.004

Ms. Ramie Hammonds Development Services Director/Building Official City of Sanger 201 Bolivar Street P.O. Box 1729 Sanger, Texas 76266

Re: Metz View Addition – Final plat

First Review

Dear Ms. Hammonds,

Halff Associates, Inc. was requested by the City of Sanger to provide a first review of the Metz View Addition Final Plat. The Civil Plans are called Ridgeview Addition. The property is located at the northeast corner of Metz Road and View Road and is within the City of Sanger City E.T.J. The Final Plat was prepared by KAZ Surveying, Inc. and is dated November 11, 2022.

A preliminary review of the document was performed and the following comments apply:

General Comments:

- 1. This replat is in the City of Sanger ETJ. The City of Sanger has an interlocal agreement with Denton County regarding platting, review of construction plans and construction inspection. All City of Sanger and well as Denton County standards, codes, and requirements shall apply with the more restrictive standard governing. See City Code and DCSRR Section IV, Paragraph 11.
- 2. Final Plat will not be approved until Civil Plans have been accepted.

Metz View Addition Final Plat:

- 1. Metz Road is shown as a 4 lane Minor Arterial on the Denton County Thoroughfare Plane which requires 80 to 100' ROW. Coordinate with Denton County and provide written documentation if they are requiring 80' or 100' ROW.
- 2. View Road is shown as a 2 lane Minor Arterial on the Denton County Thoroughfare Plane which requires 70' ROW (35' dedication).

Ms. Ramie Hammonds December 6, 2022 Page 2 of 3

- 3. Provide Building set backs of 30' per Denton County Subdivision Rules and Regulations.
- 4. Note: Drainage easements adjacent to roadways may not be fenced and must be left so that access can be obtained for maintenance purposes.

Please note there is a separate review and letter for the Hydrology and Hydraulics of the project. The Surveyor/Owner shall revise the plans to address the above-stated comments. If you have any questions or need additional information, please do not hesitate to call me at (817) 764-7480.


Sincerely,

HALFF ASSOCIATES, INC.

TBPELS Firm No. 312

Steven D. Templer, P.E.

Attachments: markups

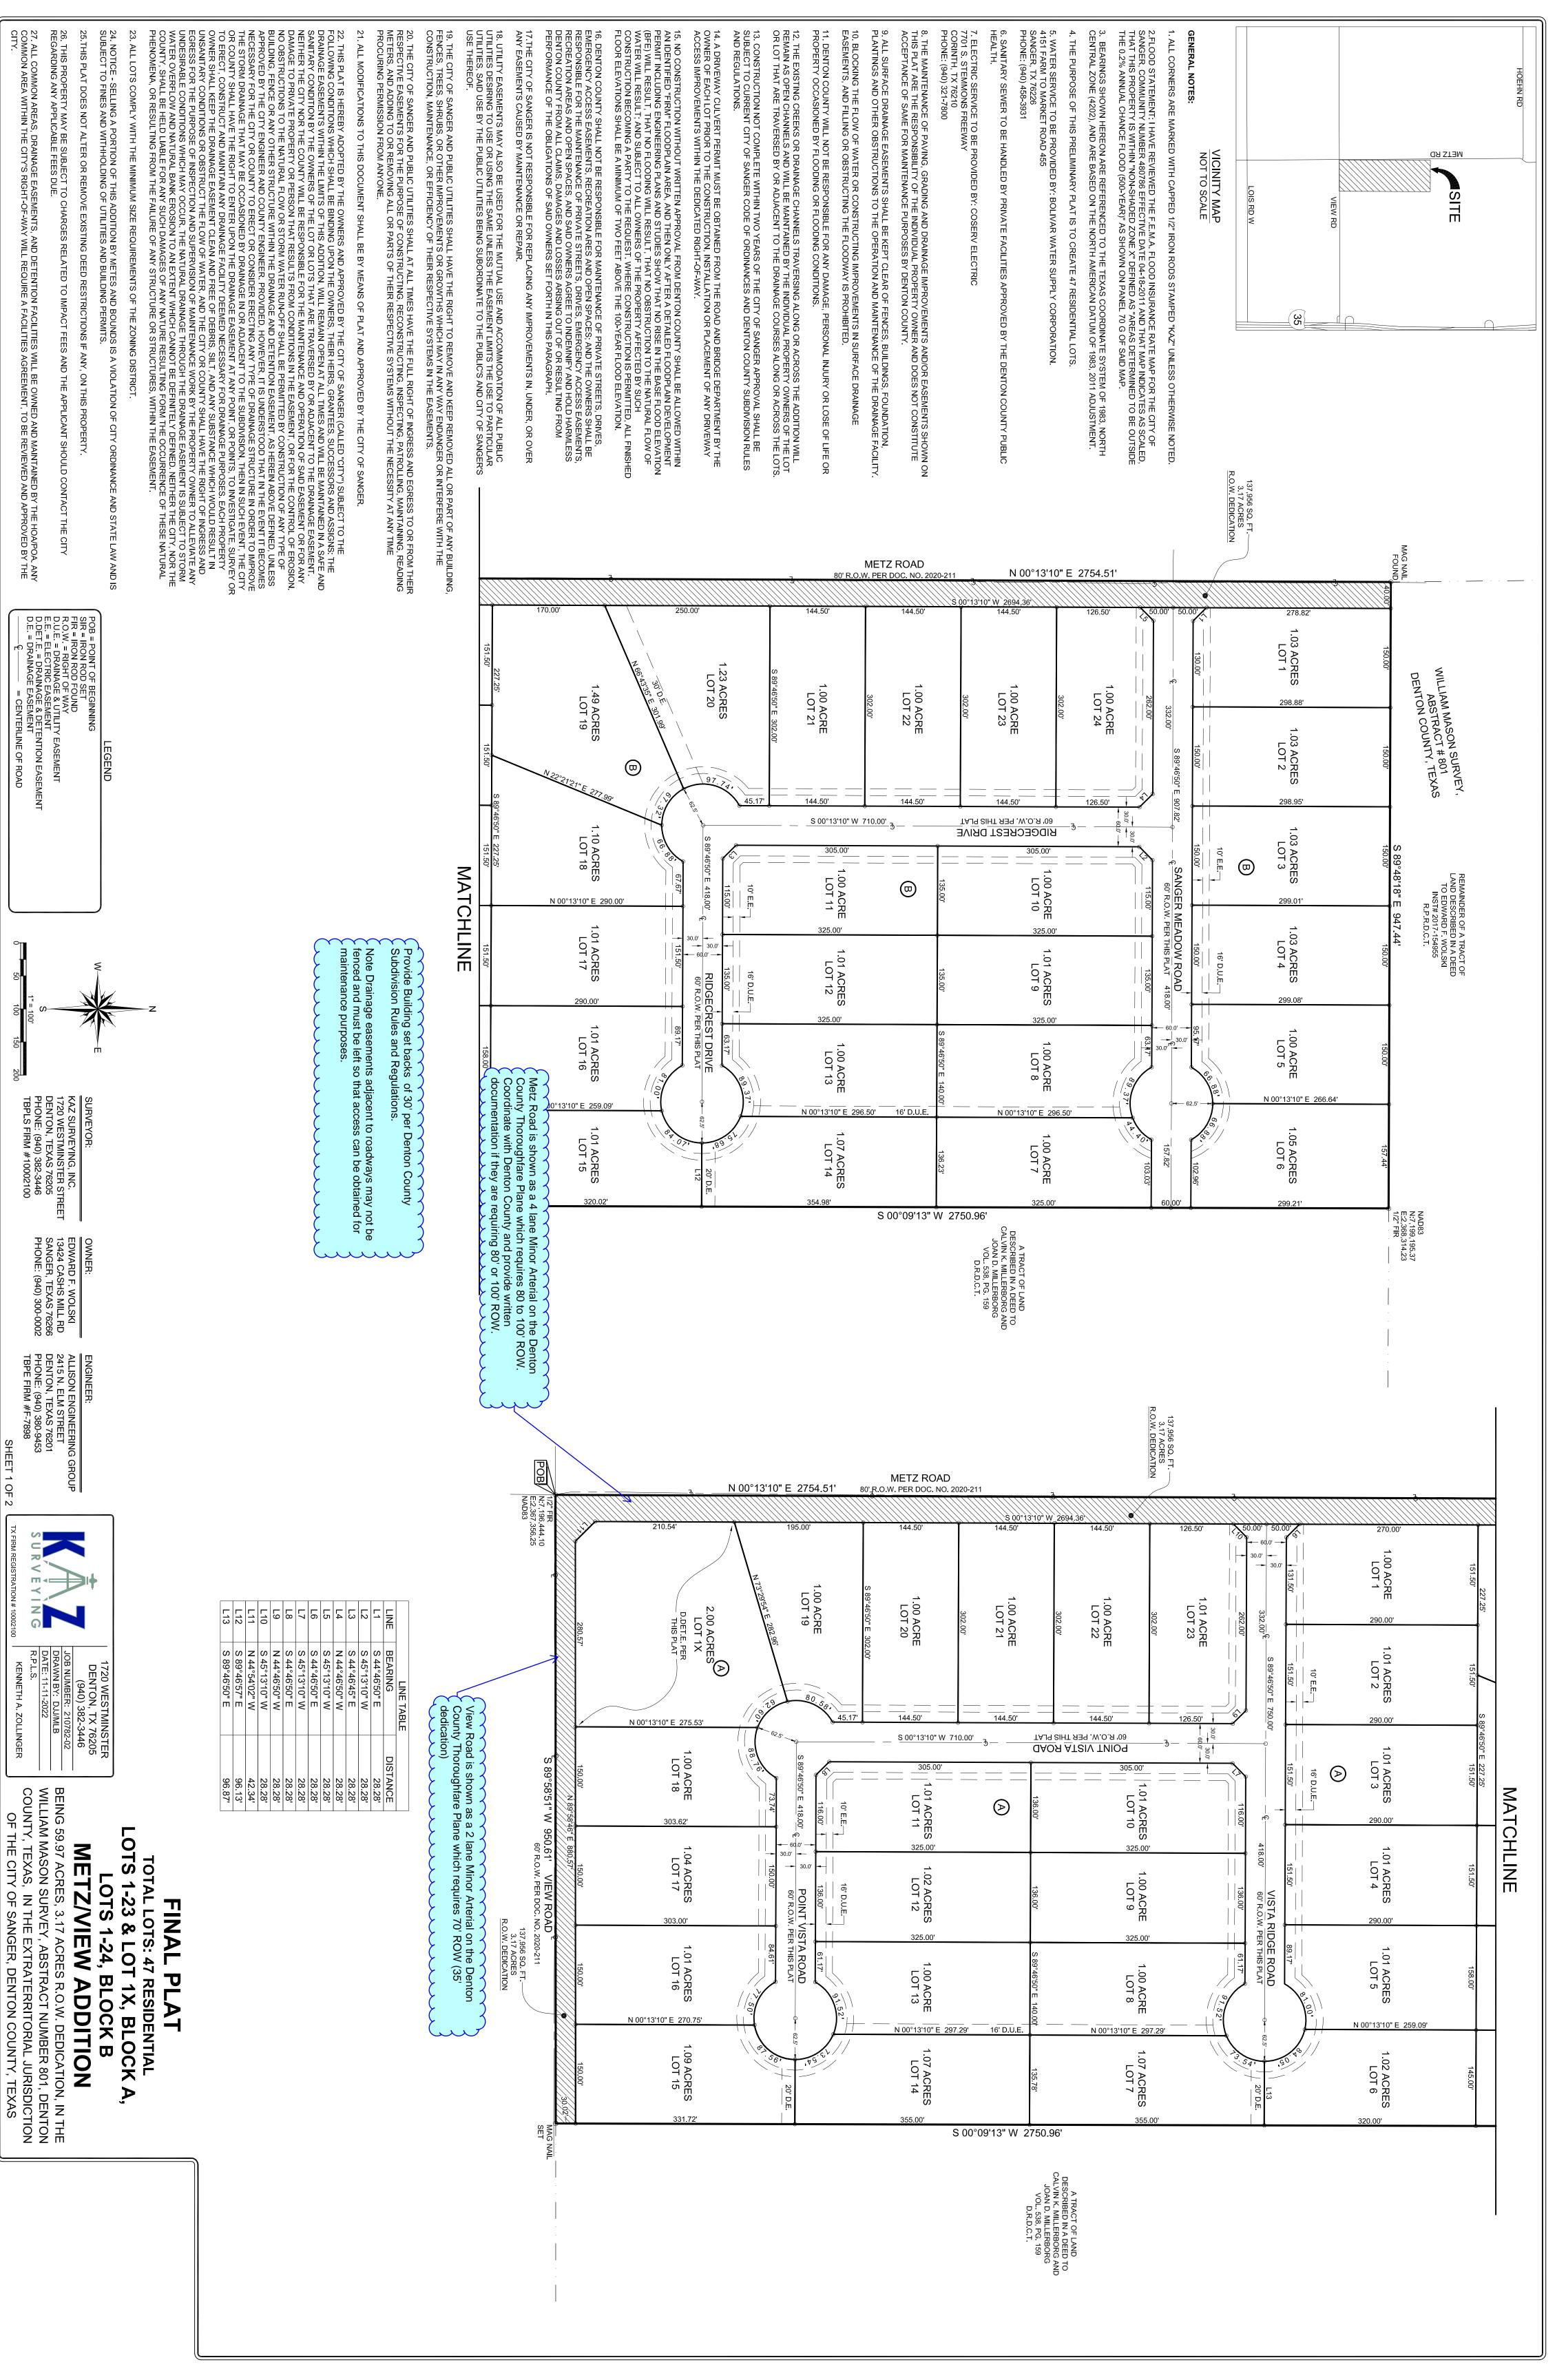

27. ALL COMMON AREAS, DRAINAGE EASEMENTS, AND DETENTION FACILITIES WILL BE OWNED AND MAINTAINED BY THE HOA/POA. ANY COMMON AREA WITHIN THE CITY'S RIGHT-OF-WAY WILL REQUIRE A FACILITIES AGREEMENT, TO BE REVIEWED AND APPROVED BY THE CITY.

KENNETH A. ZOLLINGER

MY COMMISSION EX

NOTARY PUBLIC, DE

NTON COUNTY, TEXAS

ERRORS, OMISSIONS OR OTHER ACTS OF NEGLIGENCE IN THE PREPARATION SAME.
PONSIBILITY FOR THE DRAINAGE DESIGN AND WILL DEFEND AND HOLD MLESS DENTON COUNTY FROM ANY CLAIM OR LITIGATION ARISING OUT OF
PERTY SHOWN. I FURTHER DECLARE THAT I WILL ACCEPT FULL
T TO THE BEST OF MY KNOWLEDGE, INFORMATION, AND BELIEF AND BASED IN THE INFORMATION PROVIDED, THE DRAINAGE IMPROVEMENTS SHOWN ON
, A TEXAS LICENSED ENGINEER, DO HEREBY AFFIRM

APPROVED AND ACCEPTED	
CHAIRMAN, PLANNING & ZONING COMMISSION CITY OF SANGER, TEXAS	DATE
MAYOR CITY OF SANGER, TEXAS	DATE
ATTESTED BY:	
CITY SECRETARY CITY OF SANGER, TEXAS	DATE

KAZ SURVEYING, INC. 1720 WESTMINSTER STREET DENTON, TEXAS 76205 PHONE: (940) 382-3446 TBPLS FIRM #10002100

OWNER:

EDWARD F. WOLSKI
13424 CASHS MILL RD
SANGER, TEXAS 76266
PHONE: (940) 300-0002

ENGINEER:

ALLISON ENGINEERING GROUP
2415 N. ELM STREET
DENTON, TEXAS 76201
PHONE: (940) 380-9453
TBPE FIRM #F-7898

SHEET 2 OF 2 m∢⊏

KENNETH A. ZOLLINGER

1720 WESTMINSTER
DENTON, TX 76205
(940) 382-3446
JOB NUMBER: 210782-02
DRAWN BY: DJJ/MLB
DATE: 11-11-2022
R.P.L.S.

METZ/VIEW ADDITION

OWNER'S CERTIFICATION

STATE OF TEXAS COUNTY OF DENTON

WHEREAS; EDWARD F. WOLSKI, the undersigned owner of the land shown on this plat within all that certain tract of land situated in the William Mason Survey, Abstract Number 801, Denton County, Texas, and being a part of a tract of land described in the deed to Edward F. Wolski, recorded in Document Number 2017-154955, Real Property Records, Denton County, Texas, and being more particularly described as follows:

BEGINNING at a 1/2 inch iron rod found for the Southwest corner of the herein described tract, same being near the intersection of the centerline of Metz Road and the centerline of View Road

BEGINNING at a 1/2 inch iron rod found for the Southwest corner of the herein described tract, same being near the intersection of the centerline of Metz Road and the centerline of Vie THENCE North 00 degrees 13 minutes 10 seconds East, along said centerline of Metz Road, a distance of 2,754.51 feet to a mag nail found at the Northwest corner of said herein desc tract, same being the Southwest corner of the remainder of Wolski tract of land; terline of Metz Road and the centerline of View Road;

THENCE South 89 degrees 48 minutes 18 seconds East, departing said centerline of Metz Road, a distance of 947.44 feet to a 1/2 inch iron rod found for the Northeast corner of said herein described tract, same being the Northwest corner of a tract of land described in a deed to land described in a deed to Calvin K. Millerborg and Joan D. Millerborg, recorded in Volume 538, Page 159, Deed Records, Denton County, Texas;

THENCE South 00 degrees 09 minutes 13 seconds West, along the common line of said herein described tract and said Millerborg tract, a distance of 2,750.96 feet to a mag nail set stamped "KAZ SURVEYING" for the Southeast corner of said herein described tract, same being near the centerline of said View Road;

THENCE South 89 degrees 58 minutes 51 seconds West, departing said comr containing 2,612,407 square feet or 59.97 acres of land, more or less. non line and along said centerline of View Road, a distance of 950.61 feet to the POINT OF BEGINNING and

OWNER'S DEDICATION

STATE OF TEXAS
COUNTY OF DENTON

NOW THEREFORE KNOW ALL MEN BY THESE PRESENTS:

THAT, Edward F. Wolski, acting herein by and through its duly authorized officer, does hereby adopt this plat designating the hereinabove described property as Lots 1-23 & Lot 1X, Block A and Lots 1-24, Block B of Metz/View Addition, an addition to the City of Sanger, Texas, and does hereby dedicate to the public use forever by fee simple title, free and clear of all liens and encumbrances, all streets, thoroughfares, alleys, fire lanes, drive aisles, parks, and watercourses, and to the public use forever easements for sidewalks, storm drainage facilities, utilities and any other property necessary to serve the plat and to implement the requirements of the subdivision regulations and other City codes and do hereby bind ourselves, our heirs, successors and assigns to warrant and to forever defend the title on the land so dedicated. Further, the undersigned covenants and agrees that he/she shall maintain all easements and facilities in a state of good repair and functional condition at all times in accordance with City codes and regulations. No buildings, fences, trees, shrubs, or other improvements or growths shall be constructed or placed upon, over, or across the easements as shown, except that landscape improvements may be installed, if approved by the City of Sanger. The City of Sanger and public utility entities shall have the right to access and maintain all respective easements without the necessity at any time of procuring permission from anyone.

STATE OF TEXAS
COUNTY OF DENTON BEFORE ME, THE UNDERSIGNED, A NOTARY PUBLIC IN AND FOR SAID COUNTY AND STATE, ON THIS DAY PERSONALLY APPEARED EDWARD F. WOLSKI, KNOWN TO ME TO BE THE PERSON WHOSE NAME IS SUBSCRIBED TO THE FOREGOING INSTRUMENT AND ACKNOWLEDGED TO ME THAT HE EXECUTED THE SAME FOR THE PURPOSES AND CONSIDERATIONS THEREIN. EDWARD F. WOLSKI,

WITNESS MY HAND AND SEAL OF OFFICE THIS THE DAY OF

NOTARY PUBLIC IN AND FOR THE STATE OF COUNTY

MY COMMISSION EXPIRES ON

STATE OF TEXAS
COUNTY OF DENTON

I, KENNETH A. ZOLLINGER, REGISTERED PROFESSIONAL LAND SURVEYOR, DO HEREBY CERTIFY THAT THIS PLAT WAS PREPARED FROM AND ACTUAL SURVEY MADE ON THE GROUND AND THAT THE MONUMENTS SHOWN HEREON WERE FOUND OR PLACED WITH 1/2" IRON RODS CAPPED "KAZ" UNDER MY DIRECTION AND SUPERVISION IN ACCORDANCE WITH THE ORDINANCES OF THE CITY OF SANGER, DENTON COUNTY, TEXAS.

CERTIFICATE OF SURVEYOR

KENNETH A. A. ZOLLINGEER.P.L.S.

STATE OF TEXAS
COUNTY OF DENTON

MINETIA ZOLLINGER

3312

FESSION OF

SURVEY

BEFORE ME, THE UNDERSIGNED AUTHORITY, ON THIS DAY PERSONALLY APPEARED KENNETH A. ZOLLINGER, KNOWN TO ME TO BE THE PERSON WHOSE NAME IS SUBSCRIBED TO THE FOREGOING INSTRUMENT, AND ACKNOWLEDGED TO ME THAT HE EXECUTED THE SAME FOR THE PURPOSES AND CONSIDERATIONS THEREIN EXPRESSED AND IN THE CAPACITY THEREIN STATED.

GIVEN UNDER MY HAND AND SEAL OF THE OFFICE THIS

TOTAL LOTS: 47 RESIDENTIAL LOTS 1-23 & LOT 1X, BLOCK A, LOTS 1-24, BLOCK B FINAL PLAT

BEING 59.97 ACRES, 3.17 ACRES R.O.W. DEDICATION, IN THE WILLIAM MASON SURVEY, ABSTRACT NUMBER 801, DENTON COUNTY, TEXAS, IN THE EXTRATERRITORIAL JURISDICTION OF THE CITY OF SANGER, DENTON COUNTY, TEXAS