



December 21, 2023
AVO 37449.004

Ms. Ramie Hammonds
Development Services Director/Building Official
City of Sanger
201 Bolivar Street
P.O. Box 1729
Sanger, Texas 76266

Re: **Lane Ranch Addition Preliminary Plat -Review #1**

Dear Ms. Hammonds,

Halff Associates, Inc. was requested by the City of Sanger to review the Preliminary Plat for Lane Ranch Addition. The submittal was prepared by Middleton and Associates, LLC and was received May 16, 2023.

We have completed our review and offer the following comments:

Please address comments on attached markups and provide annotated responses on markups. Please note, not all comments are written on letter since some comments are easier to show and explain on the markups. Please annotate markup with responses. Please address all flood study comments provided in a separate letter.

Preliminary Plat Comments

1. Reference the zoning ordinance and provide setback information for all lots.
2. See comments to see additional easement requirements per the preliminary plans.
3. Provide street names throughout the preliminary plat and plans.
4. Per ordinance dimension the ROW and show width from the Centerline.
5. Show the existing easement based on the plans.
6. Show the proposed sewer easement by separate instrument.

Preliminary Water Plan Comments

1. The maximum fire hydrant spacing is 500' per ordinance 5.701(a). Reconcile throughout.

Preliminary Drainage Comments

1. What happens to the street drainage in McReynolds Road? Are cross culverts required? Clarify.



Flood Study

1. The Flood Study is still under review.
2. The Flood Study doesn't have detailed modeling for Lane Ranch Addition. Need additional information on existing ponds, expansion area, available depth, etc. Both existing ponds and proposed ponds shall be included into the hydrologic models and analysis. Time of concentration calculations need to incorporate the ponds as well.
3. To meet the downstream assessment requirements, the study area needs to extend further downstream to meet the 10% rule.
4. The Hydraulic model also needs to extend downstream to be beyond the confluence of Tributary 2 and 2.1. Upstream extension is also needed to show no adverse impact by the massive fill activity in 100-year floodplain.

If you have any questions or need additional information, please do not hesitate to call me at (214) 937-3928.

Sincerely,

A handwritten signature in black ink, appearing to read "Jamie Akomer".

Jamie Akomer, PE, PMP
HALFF ASSOCIATES, INC.
Firm No. 0312
Attachments: Plat markups

LEGEND

IRS	IRON ROD SET
IRF	IRON ROD FOUND
U.E.	UTILITY EASEMENT
D.E.	DRAINAGE EASEMENT
F.E.	FRANCHISE EASEMENT
S.B.	SETBACK
O.P.R.C.C.T.	OFFICIAL PUBLIC RECORDS OF COLLIN COUNTY, TEXAS
D.R.C.C.T.	DEED RECORDS OF DENTON COUNTY, TEXAS
DOC. NO.	DOCUMENT NUMBER
MFF	MIN. FINISHED FLOOR
FH	FIRE HYDRANT
MB	MAILBOX

- PLAT NOTES:**
1. DEDICATED RIGHT-OF-WAY AREA IS 41.02 ACRES.
 2. ALL OPEN SPACE AREAS WILL EITHER BE DEDICATED TO THE HOA OR AS PARKLAND TO THE CITY.
 3. MINIMUM FINISHED FLOOR ELEVATIONS ARE AT LEAST 2 FEET ABOVE THE 100 YEAR FLOOD PLAIN.
 4. THE DRAINAGE EASEMENTS SHOWN IN THE FLOOD ZONE IS MEANT TO ENCOMPASS THE FULLY DEVELOPED 100 YEAR FLOODPLAIN PER THE FLOOD STUDY.
 5. REFER TO FLOOD STUDY BY CARDINAL STRATEGIES FOR LANE RANCH DATED 4-22-24 FOR ALL FULLY DEVELOPED FLOODPLAIN AND HYDROLOGY INFORMATION.

STREET NOTES:

ROW WIDTH	P.W.M. WIDTH
LANE RANCH DR. 60'	41' B-B
LAKE RIDGE DR. 60'	37' B-B
BUTTERFIELD DR. 60'	37' B-B
RES. STREETS 50'	31' B-B

1. STREET ROW DEDICATION 50.79 ACRES

RESIDENTIAL LOT NOTES:

MIN. LOT SIZE	LOT AREA	ZONING
ESTATES LOTS 60'X120'	7,200 S.F.	R-1
MANOR LOTS 50'X120'	6,000 S.F.	R-1
GARDEN LOTS 40'X120'	4,800 S.F.	R-1
TOWN HOUSE 24'X100'	2,400 S.F.	TH

1. LOTS WITH "X" DESIGNATOR WILL BE OWNED BY THE HOA.

Reference zoning ordinance and provide all setback information.

PROPERTY OWNERS

NGUYEN, HIEN T & DUYET
3608 WYNOKA DR.
CARROLLTON, TX, 75007-2792
469-900-7133
nguyenhelen15@gmail.com

DUALBOND HOLDINGS LLC
JONATHAN WANG
101 FOREST BEND DR.
CORPELL, TX, 75019-2040
214-316-2256
wangjtc@verizon.net

SANGER TOWN CENTER LLC
JONATHAN WANG
101 FOREST BEND DR.
CORPELL, TX, 75019-2040
214-316-2256
wangjtc@verizon.net

MARION PROPERTY HOLDINGS, LLC
JONATHAN WANG
101 FOREST BEND DR.
CORPELL, TX, 75019-2040
214-316-2256
wangjtc@verizon.net

DEVELOPER
JTWSON DEVELOPMENT LLC
CASEY MCGINNIS
4029 VENETO DRIVE
FRISCO, TX, 75033
214-232-6180
mcmginnisdevelopment@gmail.com


SURVEYOR
JOHN COHEN & ASSOC., INC.
PHIL CORNETT
10147 CR 135
FLINT, TEXAS
903-581-2238
www.txsurveyors.com

FLOOD NOTE

According to the Federal Emergency Management Agency, Flood Insurance Rate Map Community Panel No. 48121 C 0210G dated April 11, 2011, a portion of this property is within Flood Zone A.



Flood Zone AE scaled per LOMR dated June 26, 2018.

This flood statement does not imply that the property and/or the structure thereon will be free from flooding or flood damage. On rare occasions, greater floods can and will occur and flood heights may be increased by man-made or natural causes. This flood statement shall not create liability on the part of the Engineer.

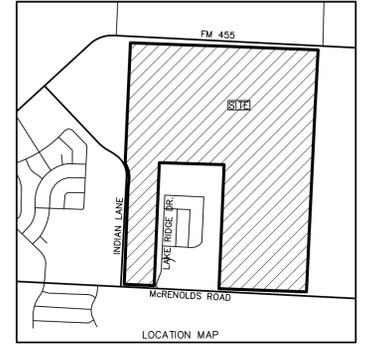

PRELIMINARY PLAT FOR REVIEW PURPOSES ONLY
APPROVED FOR PREPARATION OF FINAL PLAT
CITY OF SANGER, TX _____ DATE _____
PLANNING & ZONING COMMISSION

MILLER FAMILY TRUST
DOC. NO. 94-0089291
(DRDCT)

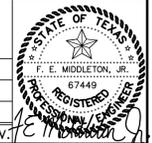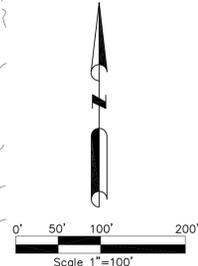

No.	DATE	REVISION	APPROV.

5-15-24

**Middleton PROJECT ENGINEER:
& Associates, LLC.**

CONSULTING CIVIL ENGINEERS & LAND PLANNERS
TBP# #F-10900 © Copyright 2024
2785 ROCKBROOK DRIVE, SUITE 105
LEWISVILLE, TEXAS 75067 (972) 393-9800

PRELIMINARY PLAT
LANE RANCH ADDITION
813 RESIDENTIAL LOTS - 27 HOA LOTS
3 GENERAL BUSINESS LOTS
RUBEN BEBEE SURVEY, ABST. NO. 29
303.412 ACRES - 41.02 ACRES ROW
CITY OF SANGER DENTON COUNTY TEXAS


Drawing File: 0001032PPT.DWG DATE: 5-15-24 SCALE: 1"=100'
Project No. 0001032 SHEET NO: 6

LEGEND

IRS	IRON ROD SET
IRF	IRON ROD FOUND
U.E.	UTILITY EASEMENT
D.E.	DRAINAGE EASEMENT
F.E.	FRANCHISE EASEMENT
S.B.	SETBACK
O.P.R.C.C.T.	OFFICIAL PUBLIC RECORDS OF COLLIN COUNTY, TEXAS
D.R.C.C.T.	DEED RECORDS OF DENTON COUNTY, TEXAS
DOC. NO.	DOCUMENT NUMBER
MFF	MIN. FINISHED FLOOR
FH	FIRE HYDRANT
MB	MAILBOX



SANGER TOWN CENTER LLC
DOC. NO. 2017-48301
(DRDCT)

MARION HILLS APARTMENTS, LLC
DOC. NO. 2017-92008
(DRDCT)

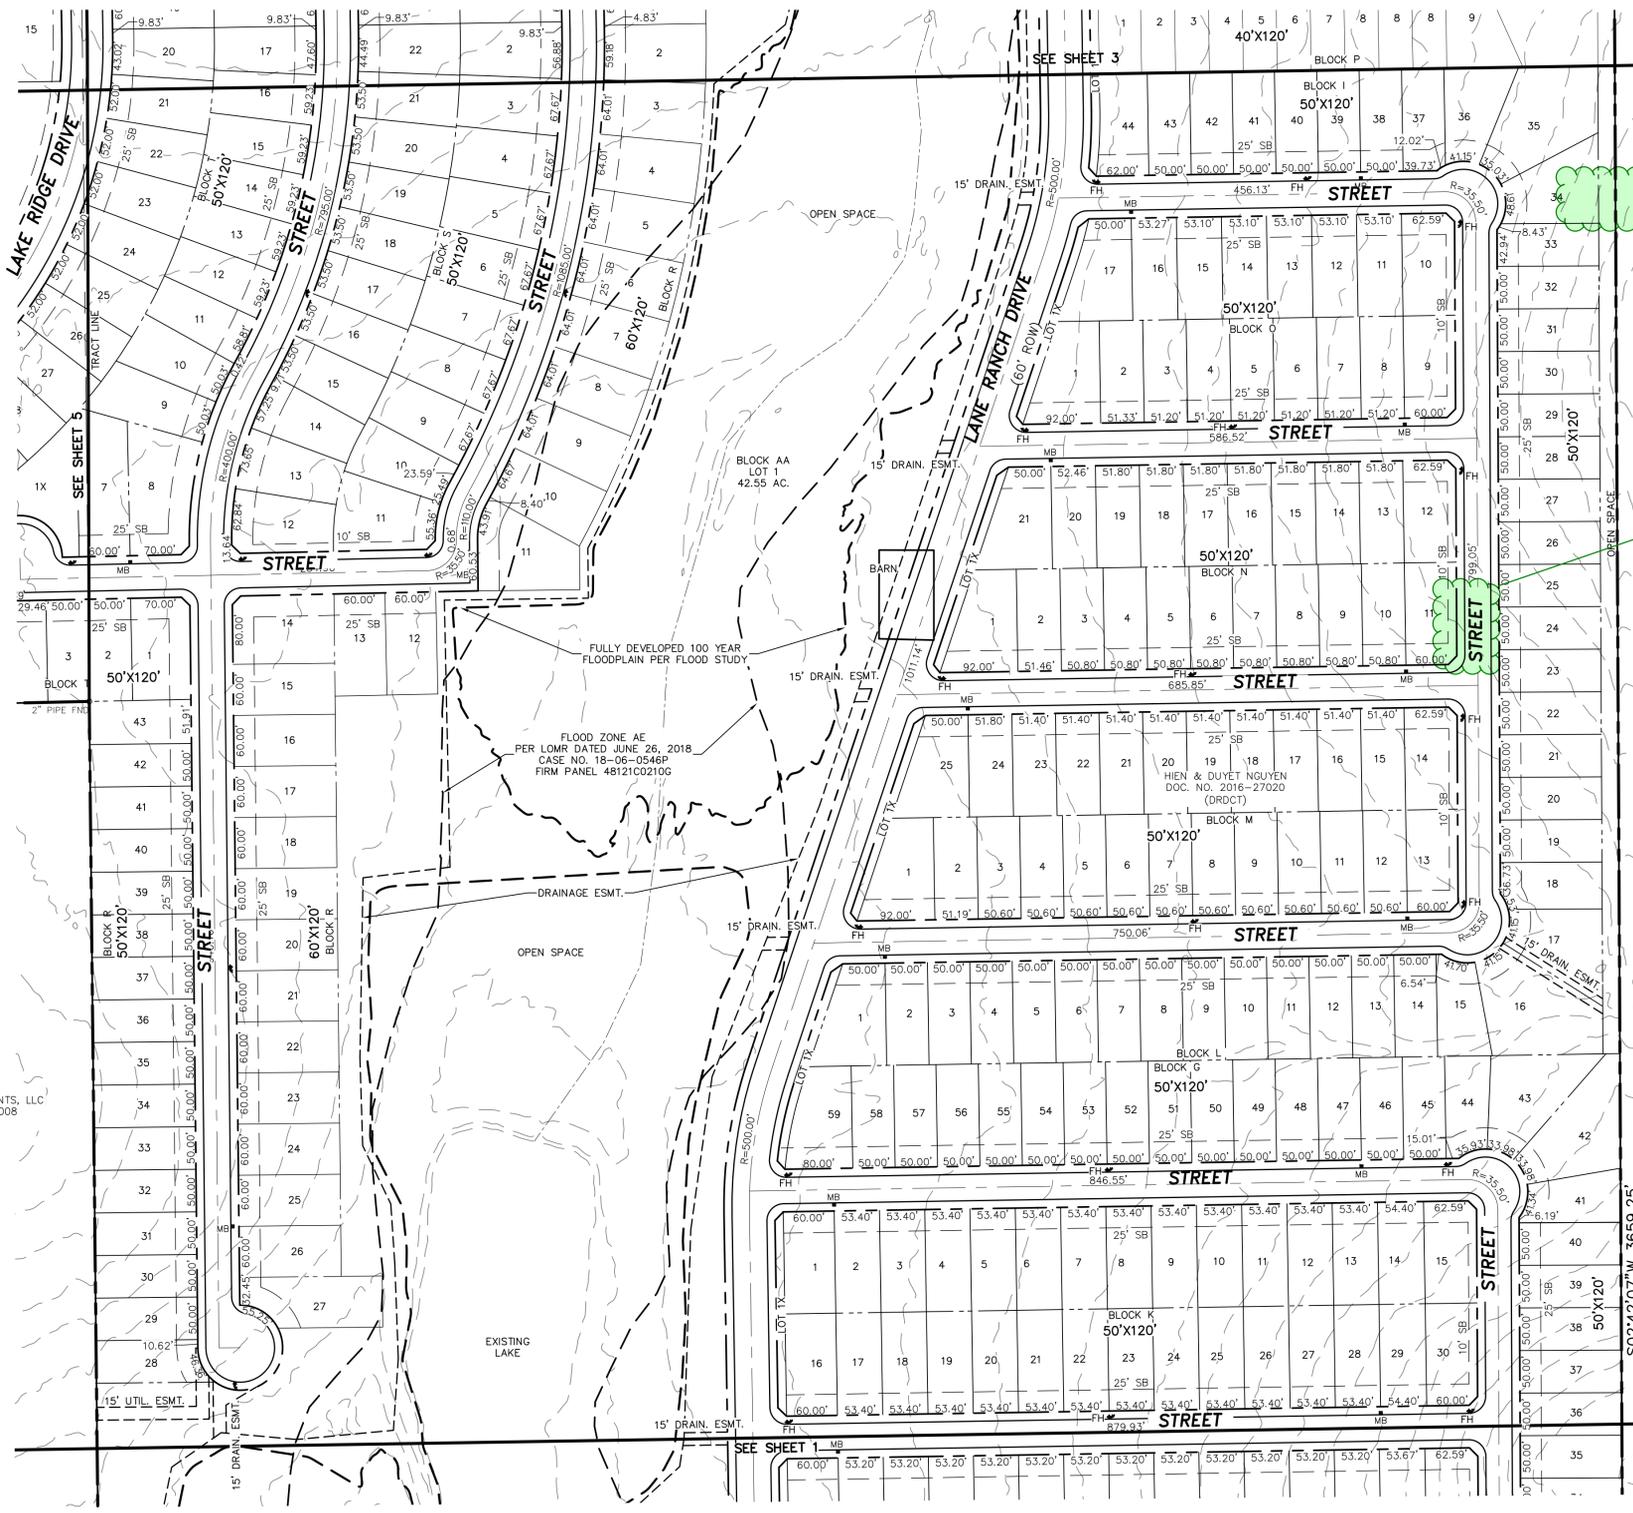


Per Drainage Plan
dedicate easement
drainage for swale
(TYP)

Provide street names
per plat checklist

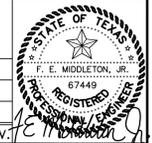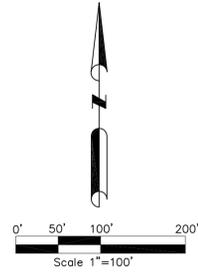

No.	DATE	REVISION	APPROV.
			5-15-24

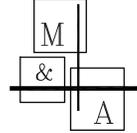

**Middleton PROJECT ENGINEER:
& Associates, LLC.**


CONSULTING CIVIL ENGINEERS & LAND PLANNERS
TBP# #F-10900 © Copyright 2024
2785 ROCKBROOK DRIVE, SUITE 105
LEWISVILLE, TEXAS 75067 (972) 393-9800

PRELIMINARY PLAT
LANE RANCH ADDITION
813 RESIDENTIAL LOTS - 27 HOA LOTS
3 GENERAL BUSINESS LOTS
RUBEN BEBEE SURVEY, ABST. NO. 29
303.412 ACRES - 41.02 ACRES ROW
CITY OF SANGER DENTON COUNTY TEXAS

Drawing File: 0001032PPT.DWG	DATE: 5-15-24	SCALE: 1"=100'	SHEET NO.: 2
Project No. 0001032			6



- LEGEND
- IRS IRON ROD SET
 - IRF IRON ROD FOUND
 - U.E. UTILITY EASEMENT
 - D.E. DRAINAGE EASEMENT
 - F.E. FRANCHISE EASEMENT
 - S.B. SETBACK
 - O.P.R.C.C.T. OFFICIAL PUBLIC RECORDS OF COLLIN COUNTY, TEXAS
 - D.R.D.C.T. DEED RECORDS OF DENTON COUNTY, TEXAS
 - DOC. NO. DOCUMENT NUMBER
 - MFF MIN. FINISHED FLOOR
 - FH FIRE HYDRANT
 - MB MAILBOX

SANGER TOWN CENTER LLC
DOC. NO. 2017-48301
(DRDCT)

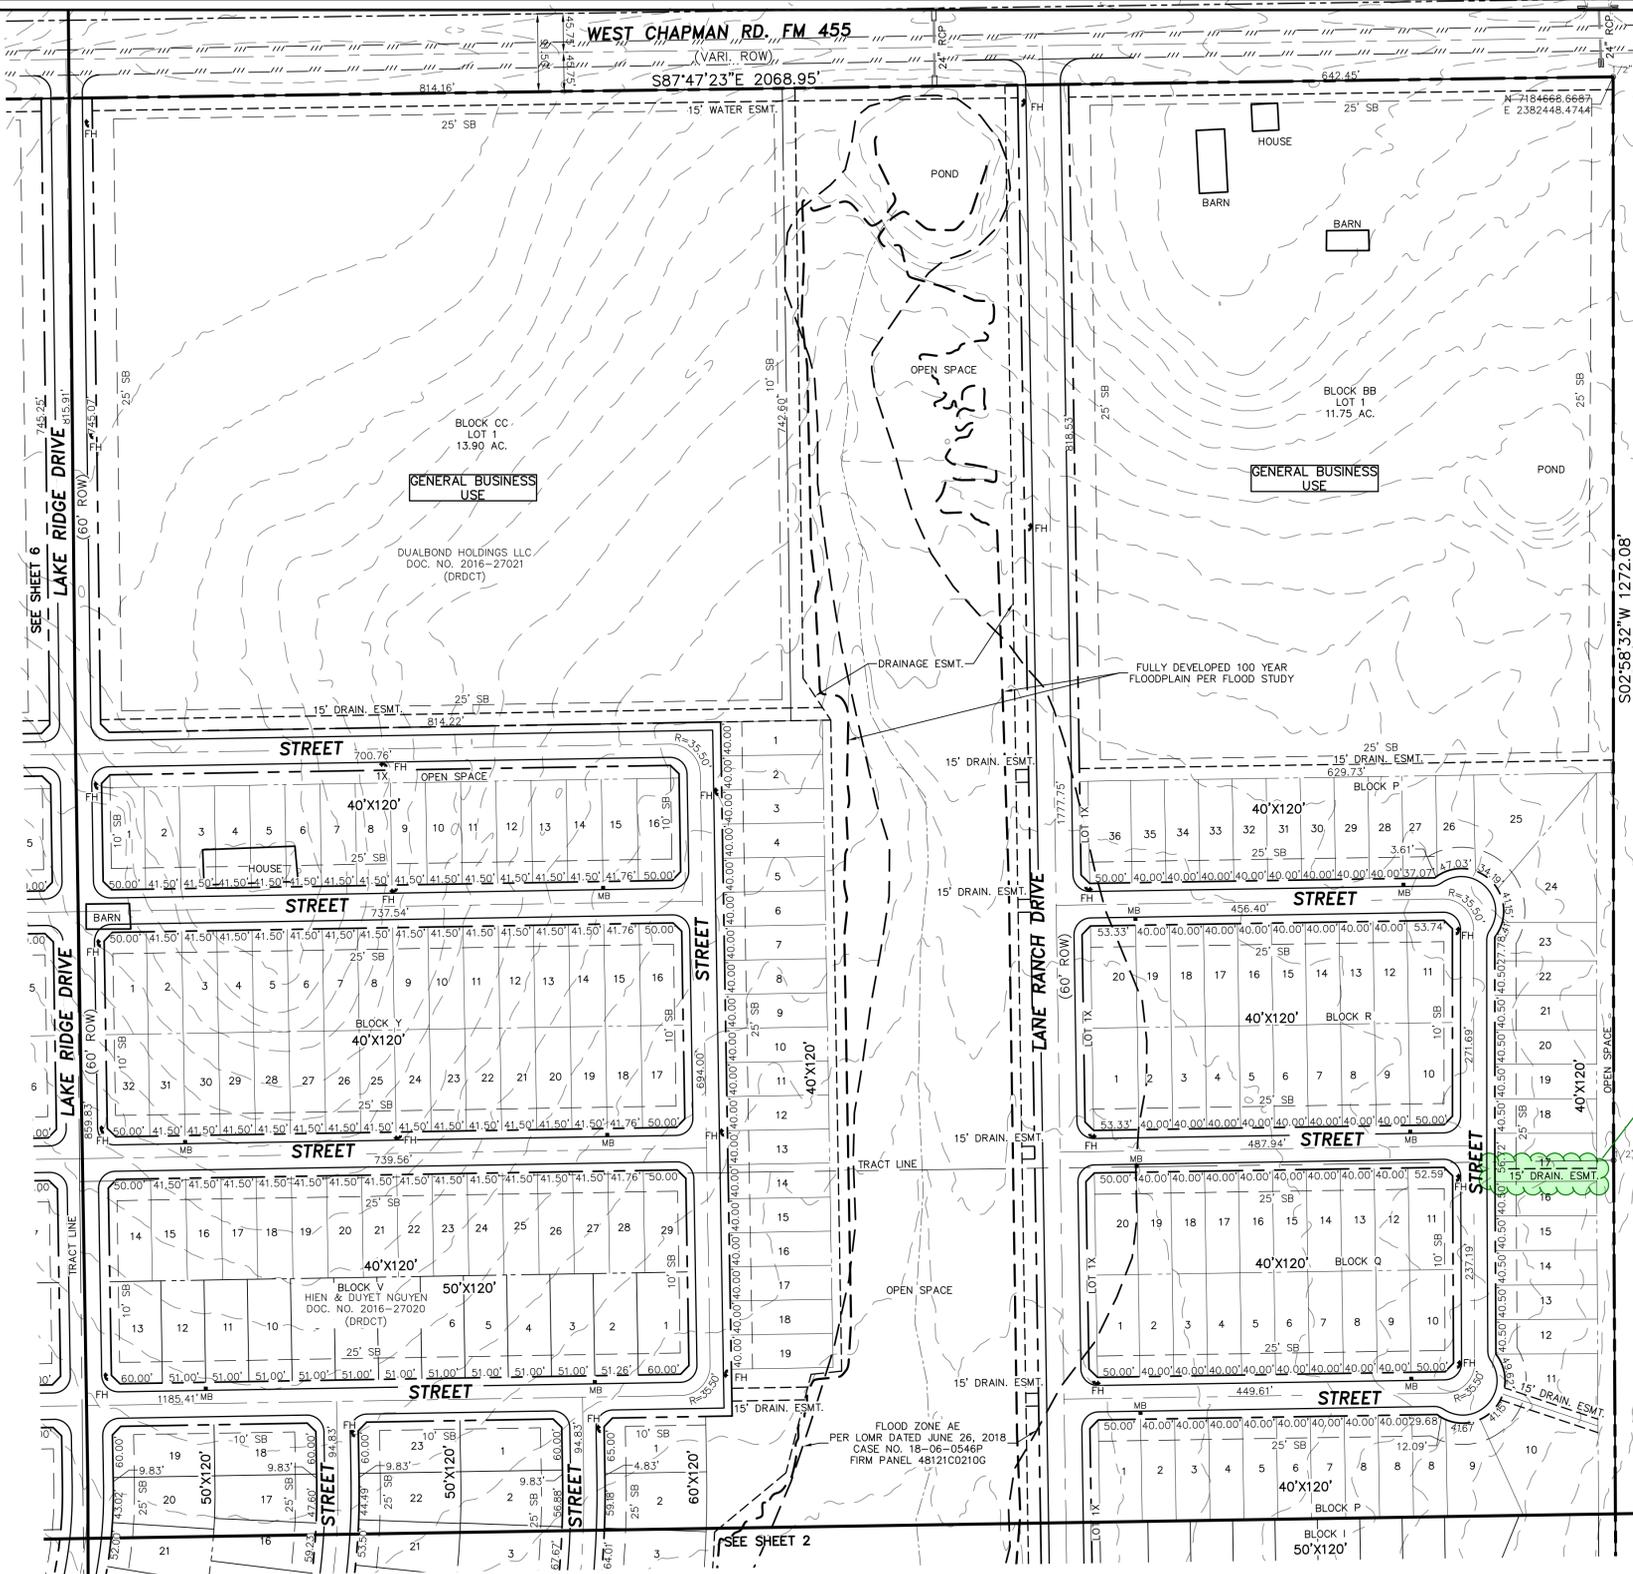


FLOOD ZONE AE
PER LOMR DATED JUNE 26, 2018
CASE NO. 18-06-0546P
FIRM PANEL 48121C0210G

Show both edges of
drainage easement

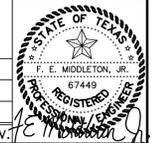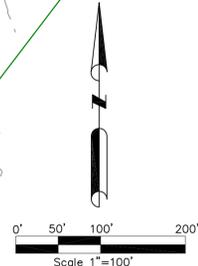

No.	DATE	REVISION	APPROV.

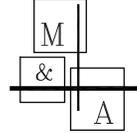

**Middleton PROJECT ENGINEER:
& Associates, LLC.**

CONSULTING CIVIL ENGINEERS & LAND PLANNERS
TBP# #F-10900 © Copyright 2024
2785 ROCKBROOK DRIVE, SUITE 105
LEWISVILLE, TEXAS 75067 (972) 393-9800

PRELIMINARY PLAT
LANE RANCH ADDITION
813 RESIDENTIAL LOTS - 27 HOA LOTS
3 GENERAL BUSINESS LOTS
RUBEN BEBEE SURVEY, ABST. NO. 29
303.412 ACRES - 41.02 ACRES ROW
CITY OF SANGER DENTON COUNTY TEXAS

Drawing File: 0001032PPT.DWG	DATE: 5-15-24	SCALE: 1"=100'	SHEET NO.: 3
Project No. 0001032			6



- LEGEND**
- IRS IRON ROD SET
 - IRF IRON ROD FOUND
 - U.E. UTILITY EASEMENT
 - D.E. DRAINAGE EASEMENT
 - F.E. FRANCHISE EASEMENT
 - S.B. SETBACK
 - O.P.R.C.C.T. OFFICIAL PUBLIC RECORDS OF COLLIN COUNTY, TEXAS
 - D.R.D.C.T. DEED RECORDS OF DENTON COUNTY, TEXAS
 - DOC. NO. DOCUMENT NUMBER
 - MFF MIN. FINISHED FLOOR
 - FH FIRE HYDRANT
 - MB MAILBOX



HIEN & DUyet NGUYEN
DOC. NO. 2016-27020
(DRDCT)

Per plan, sewer easement by separate instrument

label Drainage easement

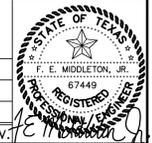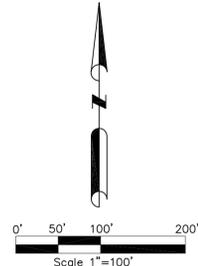


No.	DATE	REVISION	APPROV.

**Middleton PROJECT ENGINEER:
& Associates, LLC.**
CONSULTING CIVIL ENGINEERS & LAND PLANNERS
TBP# #F-10900 © Copyright 2024
2785 ROCKBROOK DRIVE, SUITE 105
LEWISVILLE, TEXAS 75067 (972) 393-9800

PRELIMINARY PLAT
LANE RANCH ADDITION
813 RESIDENTIAL LOTS - 27 HOA LOTS
3 GENERAL BUSINESS LOTS
RUBEN BEBEE SURVEY, ABST. NO. 29
303.412 ACRES - 41.02 ACRES ROW
CITY OF SANGER DENTON COUNTY TEXAS

Drawing File: 0001032PPT.DWG	DATE: 5-15-24	SCALE: 1"=100'	SHEET NO: 5
Project No. 0001032			6

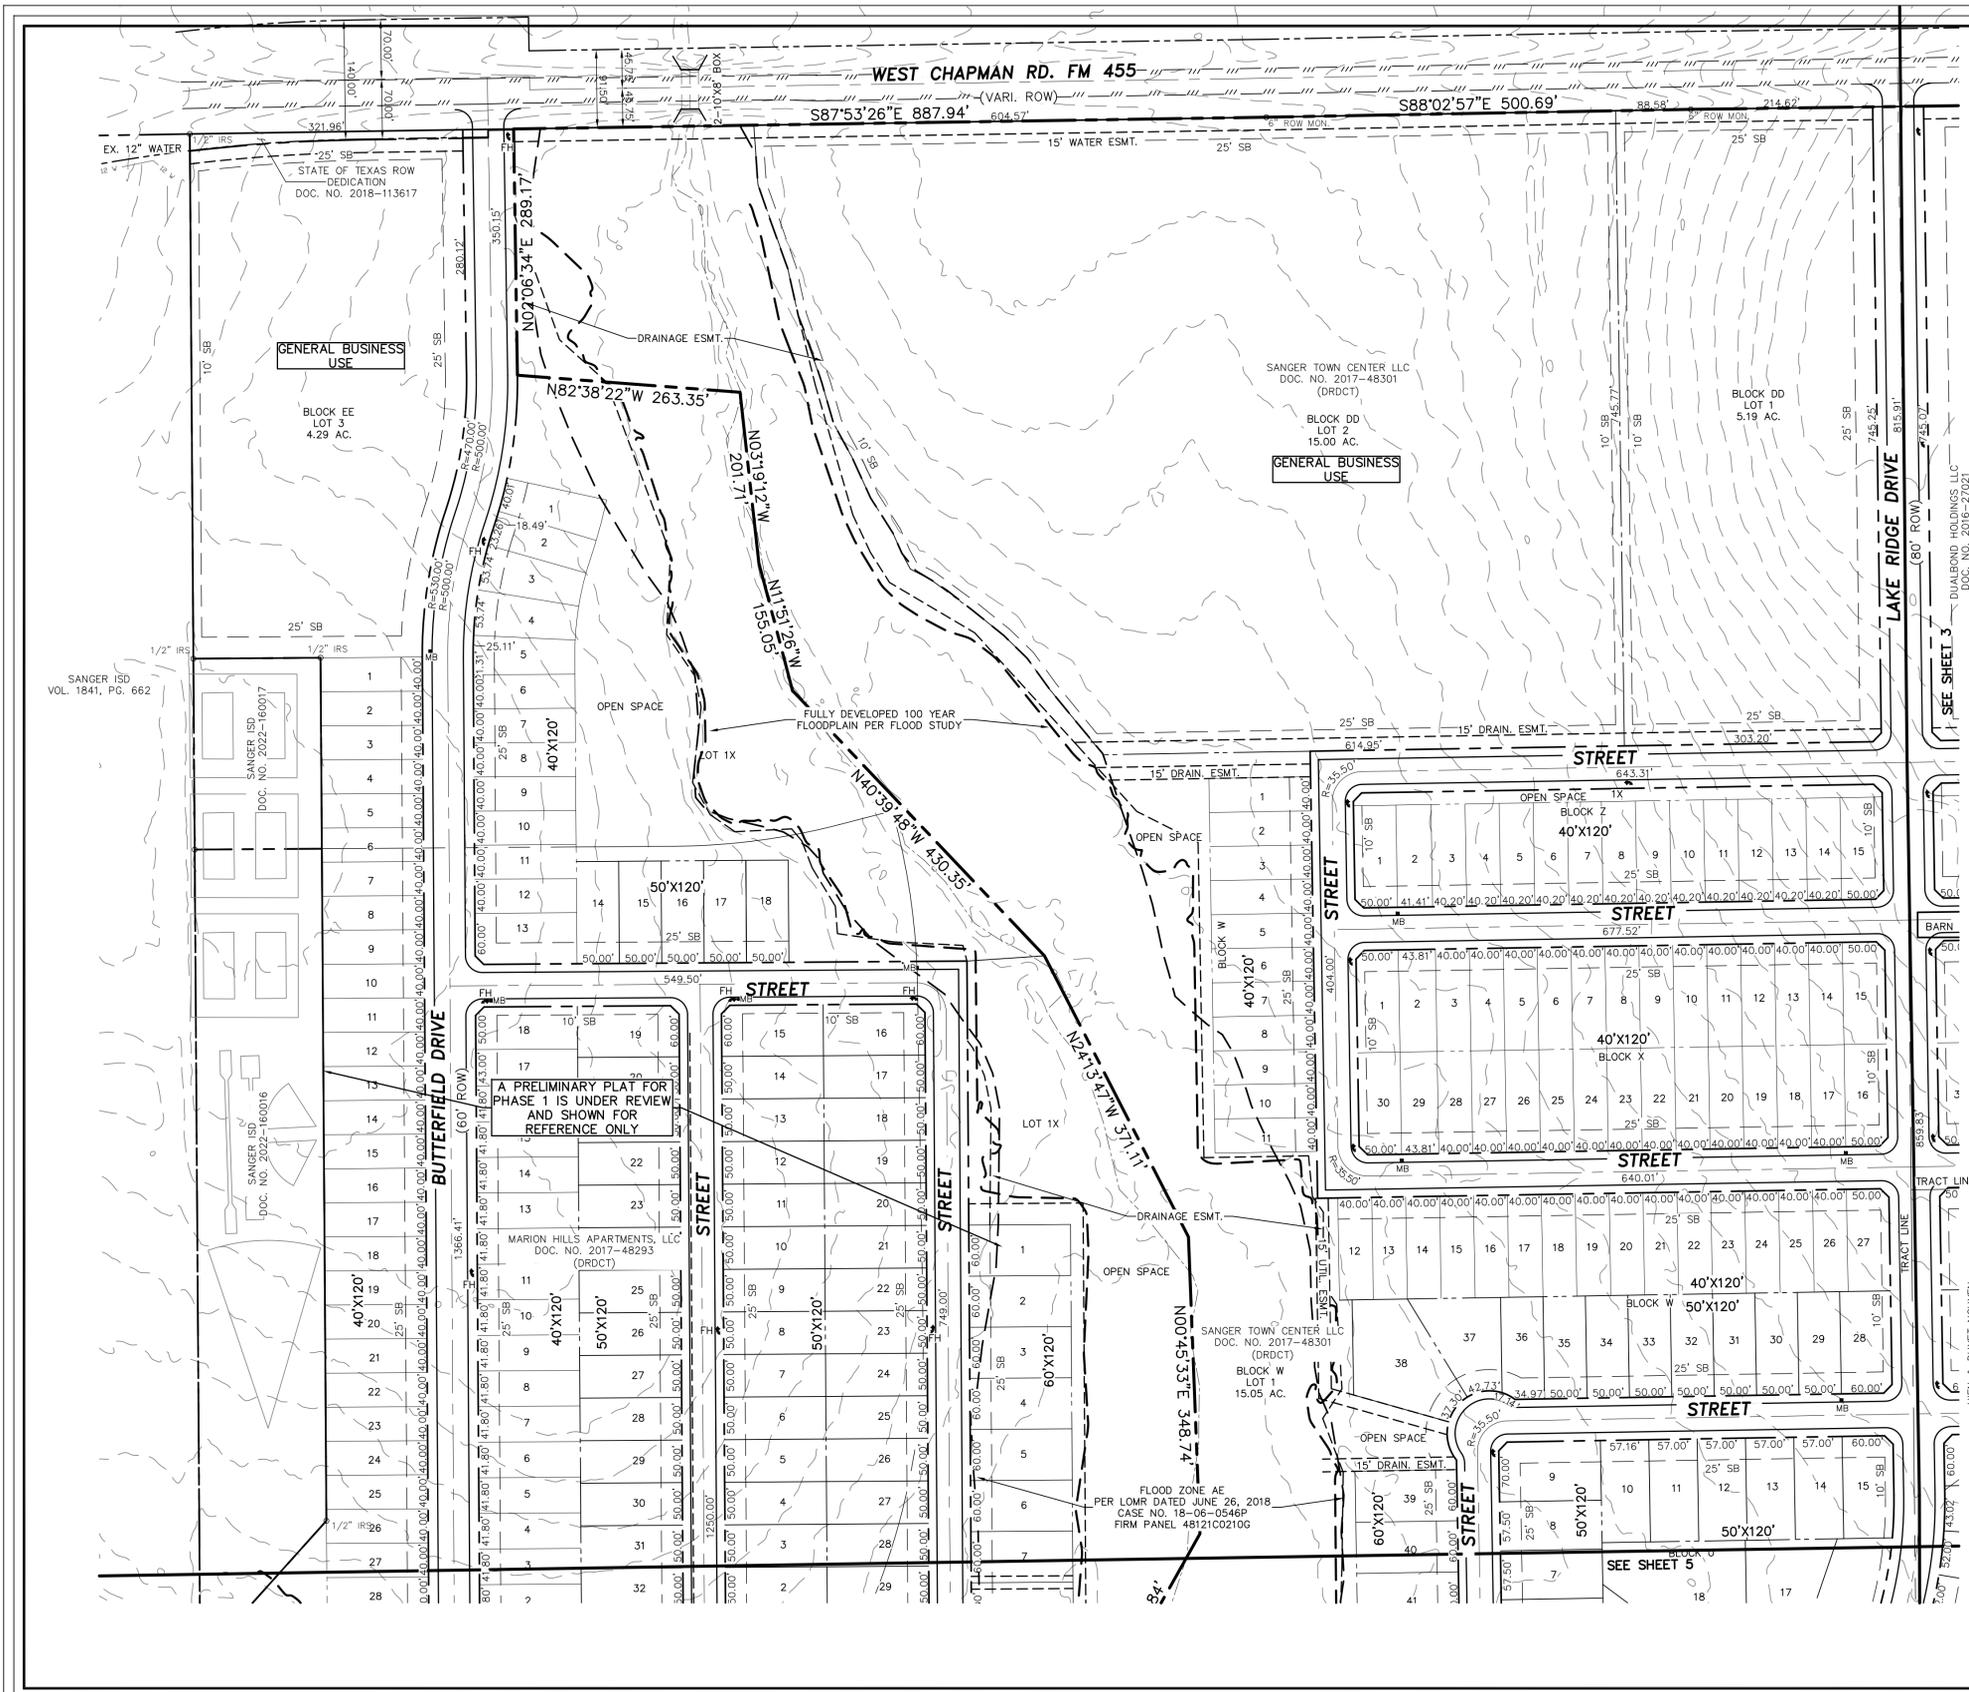

LEGAL DESCRIPTION
EAST TRACT

All that certain lot, tract, or parcel of land, being part of the Rueben Bebee Survey, Abstract No. 29, Denton County, Texas, and being all of that tract of land described in a deed to Hien & Duyet Nguyen recorded in Document No. 2016-27020 Real Property Records of Denton County, Texas (RPRDCT) and all of that tract of land described in a deed to Sanger Town Center LLC recorded in Document No. 2016-27021 (RPRDCT) and all of that tract of land described in a deed to Sanger Town Center LLC recorded in Document No. 2017-48301 (RPRDCT) and a part of that tract of land described in a deed to Marion Hills Apartments, LLC recorded in Document No. 2017-48293 (RPRDCT), being more completely described as follows, to-wit:

BEGINNING at 1/2" iron rod set for the southeast corner of the Hien & Duyet Nguyen tract and the north right-of-way line of McReynolds Road;

THENCE with the north right-of-way line of McReynolds Road North 87°54'58" West a distance of 1,789.63 feet to a 1/2" iron rod set for the southwest corner of the Hien & Duyet Nguyen tract and the southeast corner of a tract of land described in a deed to Winston Grove Apartments, LLC recorded in Document No. 2018-13037 (RPRDCT);

THENCE North 2°23'22" East a distance of 2,526.23 feet to 1/2" iron rod set for the northeast corner of a tract of land described in a deed to Marion Hills Apartments, LLC recorded in Document No. 2017-92008 (RPRDCT);

THENCE North 88°13'32" West a distance of 1,215.40 feet to a 1/2" iron rod set for corner;

THENCE North 24°21'53" East a distance of 163.11 feet to a 1/2" iron rod set for corner;

THENCE North 27°00'44" East a distance of 346.28 feet to a 1/2" iron rod set for corner;

THENCE North 32°24'46" East a distance of 333.84 feet to a 1/2" iron rod set for corner;

THENCE North 0°45'33" East a distance of 348.74 feet to a 1/2" iron rod set for corner;

THENCE North 24°13'47" West a distance of 371.11 feet to a 1/2" iron rod set for corner;

THENCE North 40°39'48" West a distance of 430.35 feet to a 1/2" iron rod set for corner;

THENCE North 11°51'26" West a distance of 155.05 feet to a 1/2" iron rod set for corner;

THENCE North 3°19'12" West a distance of 201.71 feet to a 1/2" iron rod set for corner;

THENCE North 82°38'22" West a distance of 263.35 feet to a 1/2" iron rod set for corner;

THENCE North 2°06'34" East a distance of 289.17 feet to a 1/2" iron rod set for south right-of-way line of West Chapman Road and the north line of the Sanger Town Center LLC as follows:

South 87°53'26" East a distance of 887.94 feet to a 6" ROW monument found corner;

South 88°02'57" East a distance of 500.69 feet to a 6" ROW monument found corner;

South 87°47'23" East a distance of 2,068.95 feet to a 1/2" iron rod set for the northeast corner of the Dualbond Holdings, LLC Tract and the northwest corner of a tract of land described in a deed to Miller Family Trust recorded in Document No. 94-0089391 (RPRDCT);

THENCE with the west line of the Miller Family Trust tract South 2°58'32" West a distance of 1,272.08 feet to a 1/2" iron rod set for corner;

THENCE South 2°42'07" West a distance of 3,659.25 feet to the place of beginning, containing 267.181 acres, or 11,638,422 square feet of land.

LEGAL DESCRIPTION
WEST TRACT

All that certain lot, tract, or parcel of land, being part of the Rueben Bebee Survey, Abstract No. 29, Denton County, Texas, and being a part of that tract of land described in a deed to Sanger Town Center LLC recorded in Document No. 2017-48301 (RPRDCT) and a part of that tract of land described in a deed to Marion Hills Apartments, LLC recorded in Document No. 2017-48293 (RPRDCT), being more completely described as follows, to-wit:

BEGINNING 1/2" iron rod set for the southwest corner of the Sanger Town Center LLC tract and the intersection of the north right-of-way line of McReynolds Road and the east right-of-way line of Indian Lane recorded in Document No. 2004-145888 (RPRDCT);

THENCE with the east right-of-way line of Indian Lane as follows:

North 2°15'10" East a distance of 1,935.36 feet to a 1/2" iron rod set for corner;

North 5°39'58" East a distance of 200.32 feet to a 1/2" iron rod set for corner;

North 2°02'56" East a distance of 26.11 feet to the beginning of a curve to the left, having a radius of 550.39 feet, a chord of North 12° 56' 21" West - 283.57 feet, a distance of 286.80 feet to a 1/2" iron rod set for corner;

THENCE North 56°02'48" East a distance of 120.23 feet to the beginning of a curve to the left having a radius of 530.00 feet, a chord of North 39° 06' 05" East - 308.94 feet, a distance of 313.49 feet to a 1/2" iron rod set for corner;

THENCE South 45°08'24" East a distance of 307.06 feet to a 1/2" iron rod set for corner;

THENCE South 15°47'38" East a distance of 171.25 feet to a 1/2" iron rod set for corner;

THENCE South 52°47'15" East a distance of 53.75 feet to a 1/2" iron rod set for corner;

THENCE South 87°34'57" East a distance of 76.30 feet to a 1/2" iron rod set for corner in the west line of the Marion Hills Apartments, LLC tract;

THENCE South 2°25'03" West a distance of 2,355.02 feet to a 1/2" iron rod set for the southwest corner of Lake Ridge Estates, Phase 1 on an addition to the City of Sanger recorded in Cabinet V, Page 752 of the Plat Records of Denton County, Texas (PRDCT) and the north right-of-way line of McReynolds Road;

THENCE with the north right-of-way line of McReynolds Road North 87°25'44" West a distance of 612.45 feet to the place of beginning, containing 36.231 acres, or 1,578,202 square feet of land.

No.	DATE	REVISION	APPROVAL


5-15-24

**Middleton PROJECT ENGINEER:
& Associates, LLC.**


CONSULTING CIVIL ENGINEERS & LAND PLANNERS
TBP# 1-10900 © Copyright 2024
2785 ROCKBROOK DRIVE, SUITE 105
LEWISVILLE, TEXAS 75067 (972) 393-9800

PRELIMINARY PLAT
LANE RANCH ADDITION
813 RESIDENTIAL LOTS - 27 HOA LOTS
3 GENERAL BUSINESS LOTS
RUEBEN BEBEE SURVEY, ABST. NO. 29
303.412 ACRES - 41.02 ACRES ROW
CITY OF SANGER DENTON COUNTY TEXAS


Drawing File: 0001032PPT.DWG	DATE: 5-15-24	SCALE: 1"=100'	SHEET NO: 6
Project No. 0001032			

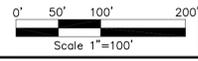


SANITARY SEWER NOTES:
 1. UNLESS OTHERWISE LABELED ALL SANITARY SEWER LINES ARE 8" PVC.

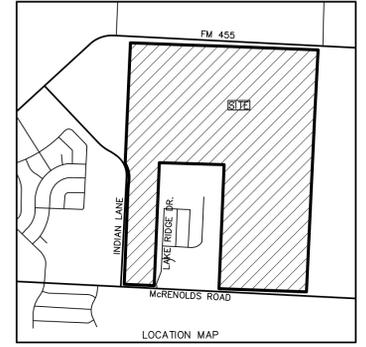

- LEGEND
- - - - - Ex. Water
 - - - - - Ex. Sanitary Sewer
 - - - - - Prop. Sanitary Sewer
 - - - - Prop. Sewer Manhole

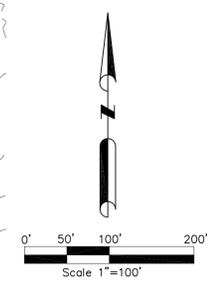

No.	DATE	REVISION	APPROV.
			5-15-24

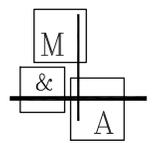

**Middleton PROJECT ENGINEER:
& Associates, LLC.**

CONSULTING CIVIL ENGINEERS & LAND PLANNERS
 TBP# #F-10900 © Copyright 2024
 2785 ROCKBROOK DRIVE, SUITE 105
 LEWISVILLE, TEXAS 75067 (972) 393-9800

PRELIMINARY SEWER PLAN
 LANE RANCH ADDITION
 813 RESIDENTIAL LOTS - 27 HOA LOTS
 3 GENERAL BUSINESS LOTS
 RUEBEN BEBEE SURVEY, ABST. NO. 29
 303.412 ACRES - 41.02 ACRES ROW
 CITY OF SANGER DENTON COUNTY TEXAS

Drawing File: 0001032PPT-SS.DWG	DATE: 5-15-24	SCALE: 1"=100'	SHEET NO: 1
Project No. 0001032			6

50'x50' ENSERCH MEASURING STATION ESMT. DOC. #94-R0019695
 APPARENT 25' GAS ESMT. NO RECORDING INFO

WINSTON GROVE APARTMENTS, LLC
 DOC. NO. 2018-13037 (DRDCT)

LAKE RIDGE ESTATES, PHASE 3
 DOC. NO. 2019-367 (DRDCT)

MARION HILLS APARTMENTS, LLC
 DOC. NO. 2017-92008 (DRDCT)

FLOOD ZONE AE
 PER LOMR DATED JUNE 26, 2018
 CASE NO. 18-06-0546P
 FIRM PANEL 48121C0210G

HIEN & DUyet NGUYEN
 DOC. NO. 2016-27023 (DRDCT)

MILLER FAMILY TRUST
 DOC. NO. 94-0089291 (DRDCT)

COORDINATION WILL BE MADE BETWEEN MARION HILLS AND LANE RANCH FOR SEWER EXTENSION

LEGEND	
	Ex. Water
	Ex. Sanitary Sewer
	Prop. Sanitary Sewer
	Prop. Sewer Manhole

SANGER TOWN CENTER LLC
DOC. NO. 2017-48301
(DRDCT)



MILLER FAMILY TRUST
DOC. NO. 94-0089291
(DRDCT)



FLOOD ZONE AE
PER LOMR DATED JUNE 26, 2018
CASE NO. 18-05-0546P
FIRM PANEL 48121C0210G

HIEN & DUYET NGUYEN
DOC. NO. 2016-27020
(DRDCT)


LAKE RIDGE ESTATES, PHASE 3
DOC. NO. 2019-367
(ORDCT)

MARION HILLS APARTMENTS, LLC
DOC. NO. 2017-92008
(DRDCT)

COORDINATION WILL BE MADE
BETWEEN MARION HILLS AND
LANE RANCH FOR SEWER
EXTENSION

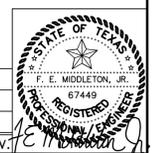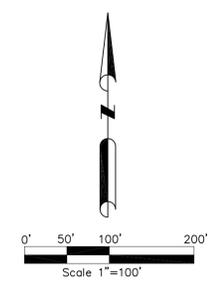

No.	DATE	REVISION	APPROV.

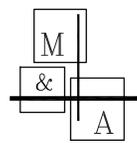



Middleton & Associates, LLC.
PROJECT ENGINEER:

CONSULTING CIVIL ENGINEERS & LAND PLANNERS
TBP# #F-10900 © Copyright 2024
2785 ROCKBROOK DRIVE, SUITE 105
LEWISVILLE, TEXAS 75067 (972) 393-9800

PRELIMINARY SEWER PLAN
LANE RANCH ADDITION
813 RESIDENTIAL LOTS - 27 HOA LOTS
3 GENERAL BUSINESS LOTS
RUEBEN BEBEE SURVEY, ABST. NO. 29
303.412 ACRES - 41.02 ACRES ROW
CITY OF SANGER DENTON COUNTY TEXAS

Drawing File: 0001032PPT-SS.DWG	DATE: 5-15-24	SCALE: 1"=100'	SHEET NO.: 2
Project No. 0001032			6

LEGEND	
	Ex. Water
	Ex. Sanitary Sewer
	Prop. Sanitary Sewer
	Prop. Sewer Manhole

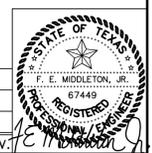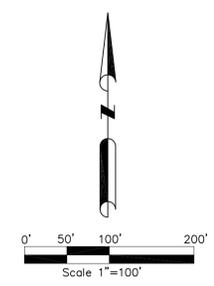


No.	DATE	REVISION	APPROV.

Middleton & Associates, LLC. PROJECT ENGINEER:
 CONSULTING CIVIL ENGINEERS & LAND PLANNERS
 TBP# 10900 © Copyright 2024
 2785 ROCKBROOK DRIVE, SUITE 105
 LEWISVILLE, TEXAS 75067 (972) 393-9800



PRELIMINARY SEWER PLAN
 LANE RANCH ADDITION
 813 RESIDENTIAL LOTS - 27 HOA LOTS
 3 GENERAL BUSINESS LOTS
 RUEBEN BEBEE SURVEY, ABST. NO. 29
 303.412 ACRES - 41.02 ACRES ROW
 CITY OF SANGER DENTON COUNTY TEXAS

Drawing File: 0001032PPT-SS.DWG	DATE: 5-15-24	SCALE: 1"=100'	SHEET NO.: 4
Project No. 0001032			6

LEGEND	
	Ex. Water
	Ex. Sanitary Sewer
	Prop. Sanitary Sewer
	Prop. Sewer Manhole

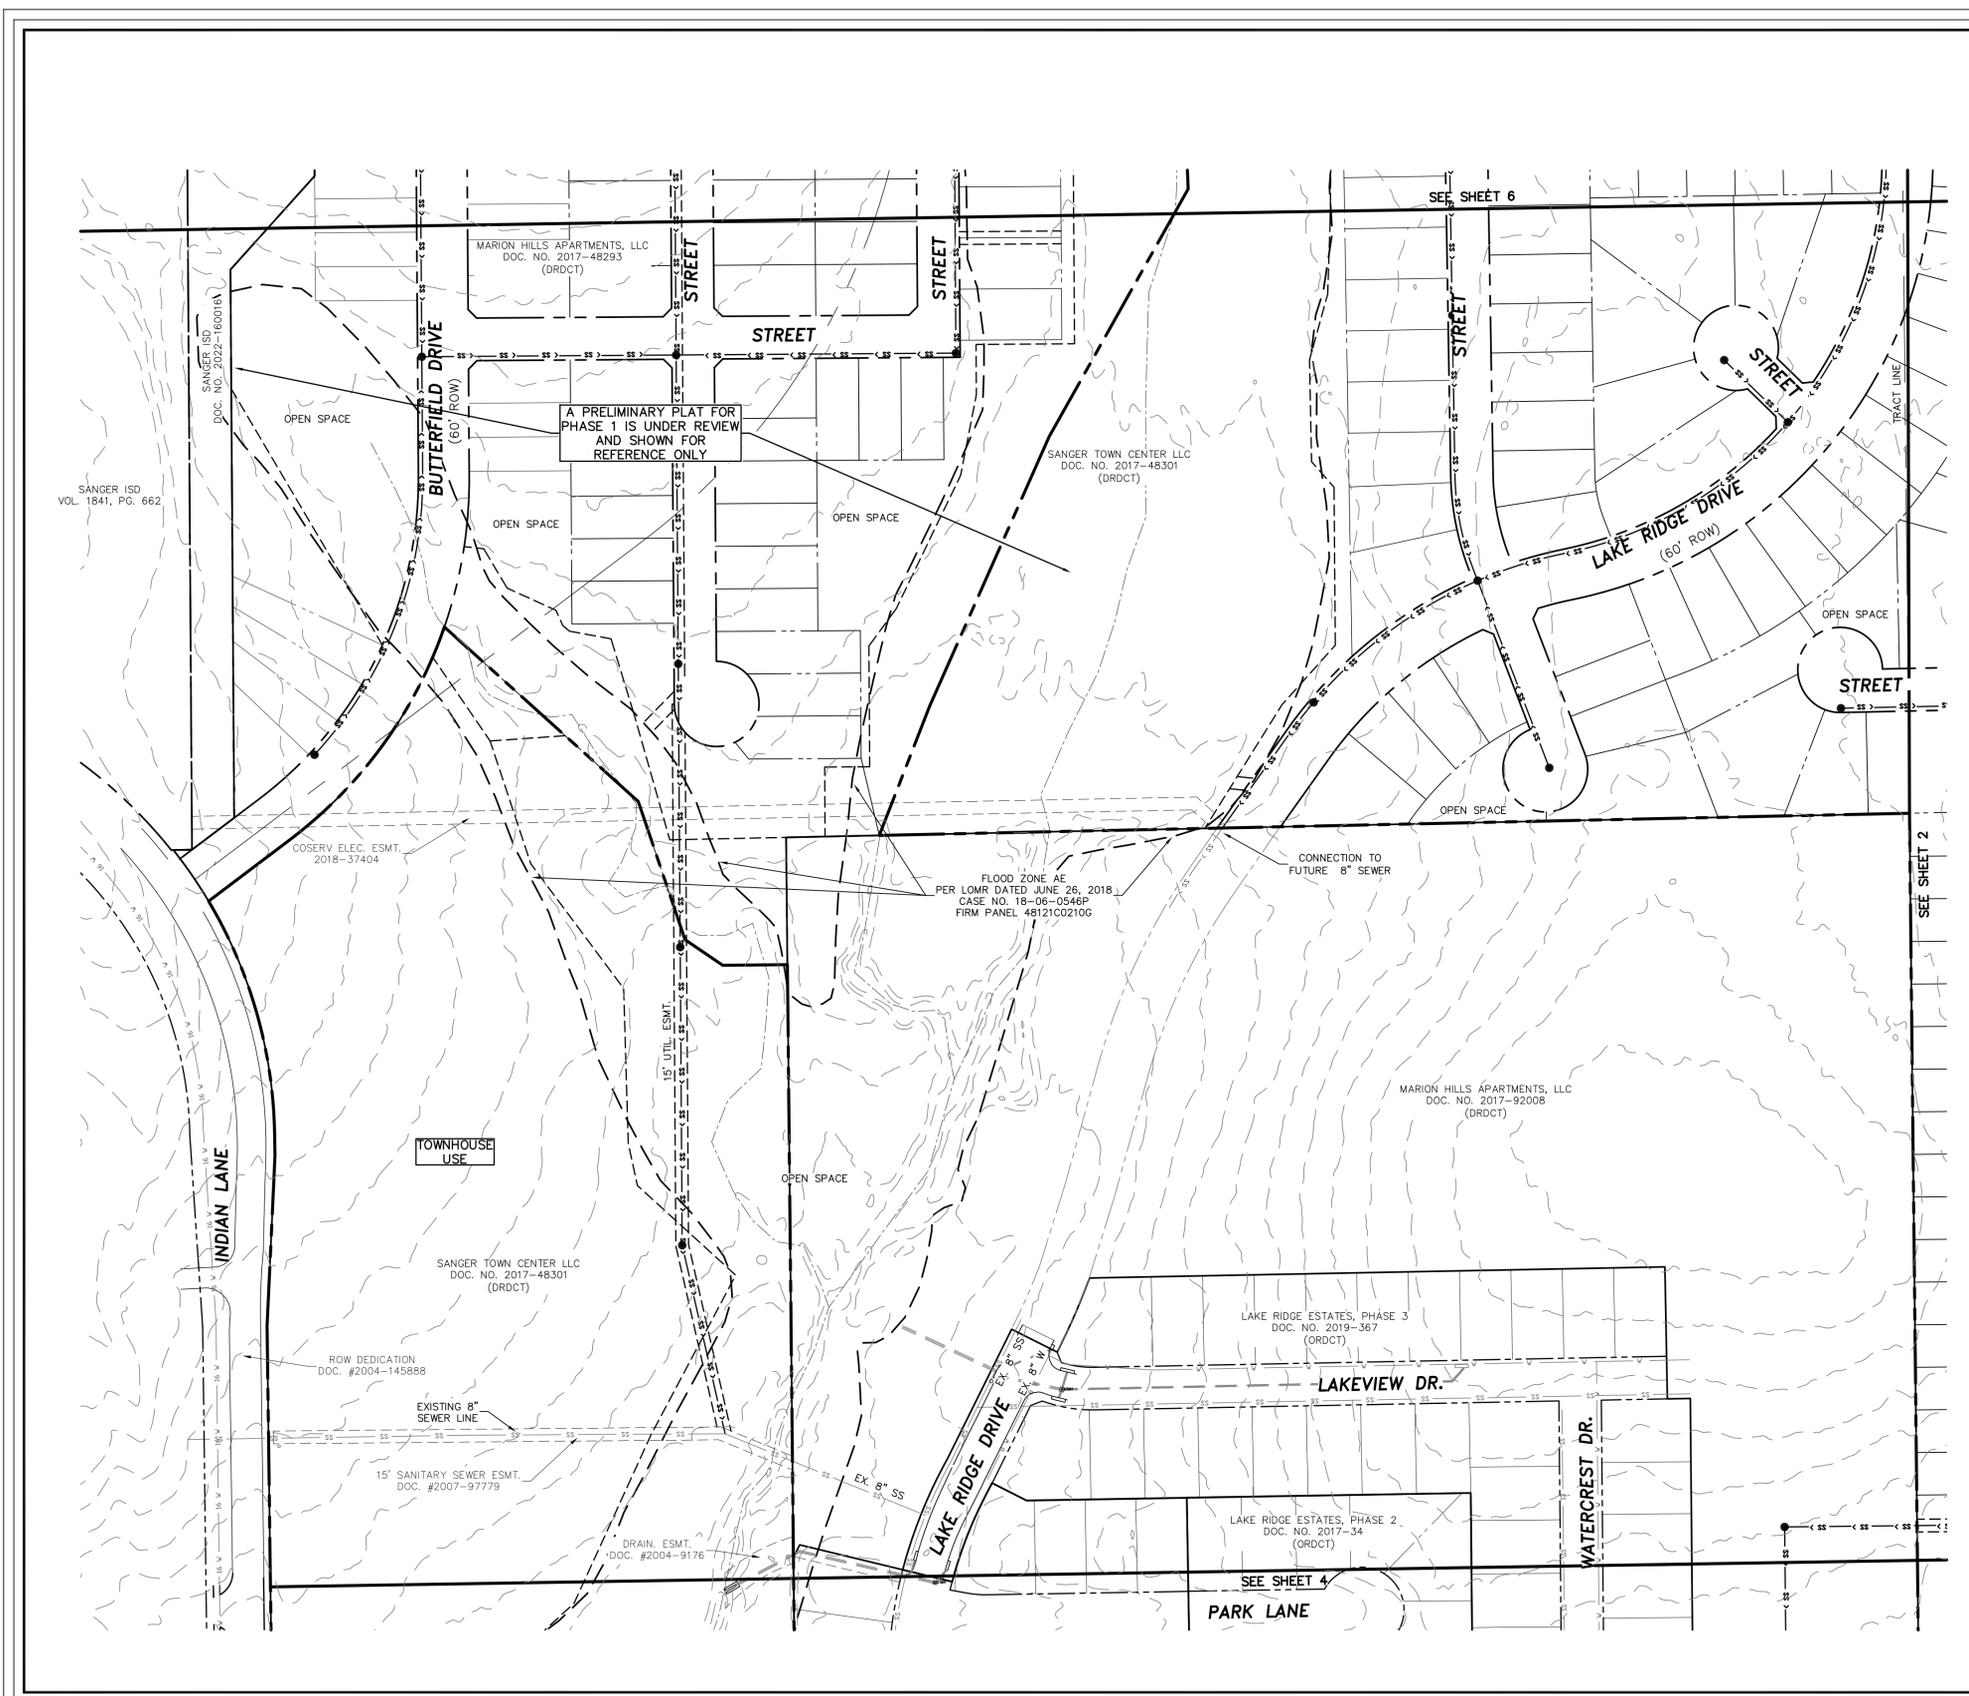

HIEN & DUYET NGUYEN
DOC. NO. 2016-27020
(DRDCT)

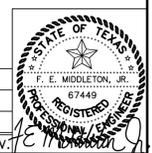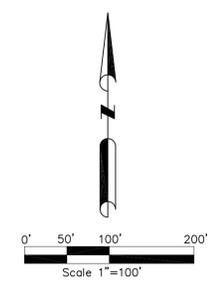

No.	DATE	REVISION	APPROV.

**Middleton PROJECT ENGINEER:
& Associates, LLC.**
CONSULTING CIVIL ENGINEERS & LAND PLANNERS
TBP# #F-10900 © Copyright 2024
2785 ROCKBROOK DRIVE, SUITE 105
LEWISVILLE, TEXAS 75067 (972) 393-9800

PRELIMINARY SEWER PLAN
LANE RANCH ADDITION
813 RESIDENTIAL LOTS - 27 HOA LOTS
3 GENERAL BUSINESS LOTS
RUEBEN BEBEE SURVEY, ABST. NO. 29
303.412 ACRES - 41.02 ACRES ROW
CITY OF SANGER DENTON COUNTY TEXAS



Drawing File: 0001032PPT-SS.DWG	DATE: 5-15-24	SCALE: 1"=100'	SHEET NO.: 5
Project No. 0001032			6

MARION HILLS APARTMENTS, LLC
 DOC. NO. 2017-92008
 (DRDCT)

BLOCK AA
 LOT 1
 42.55 AC.
 FLOOD ZONE AE
 PER LOMR DATED JUNE 26, 2018
 CASE NO. 18-06-0546P
 FIRM PANEL 48121C0210G


HIEN & DUYET NGUYEN
 DOC. NO. 2016-27023
 (DRDCT)

WINSTON GROVE
 APARTMENTS, LLC
 DOC. NO. 2018-13037
 (DRDCT)

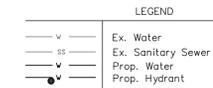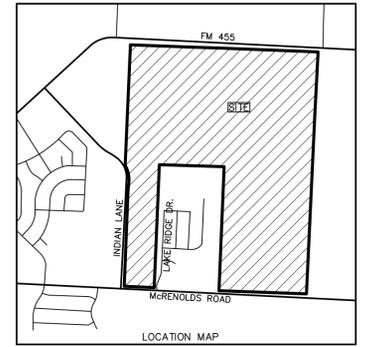

MILLER FAMILY TRUST
 DOC. NO. 94-0089291
 (DRDCT)

Max spacing is 500'
 per ordinance
 5.701(a) (TYP)

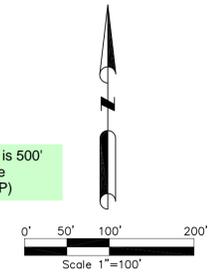

No.	DATE	REVISION	APPROV.

**Middleton PROJECT ENGINEER:
 & Associates, LLC.**
 CONSULTING CIVIL ENGINEERS & LAND PLANNERS
 TBP# #F-10900 © Copyright 2024
 2785 ROCKBROOK DRIVE, SUITE 105
 LEWISVILLE, TEXAS 75067 (972) 393-9800

PRELIMINARY WATER PLAN
 LANE RANCH ADDITION
 813 RESIDENTIAL LOTS - 27 HOA LOTS
 3 GENERAL BUSINESS LOTS
 RUEBEN BEBEE SURVEY, ABST. NO. 29
 303.412 ACRES - 41.02 ACRES ROW
 CITY OF SANGER DENTON COUNTY TEXAS

Drawing File: 0001032PPT-WAT.DWG	DATE: 5-15-24	SCALE: 1"=100'	SHEET NO.: 1
Project No. 0001032			6



50'X50' ENSERCH MEASURING STATION ESMT. DOC. #94-R0019695



LEGEND	
	Ex. Water
	Ex. Sanitary Sewer
	Prop. Water
	Prop. Hydrant

SANGER TOWN CENTER LLC
DOC. NO. 2017-48301
(DRDCT)


MARION HILLS APARTMENTS, LLC
DOC. NO. 2017-92008
(DRDCT)

MILLER FAMILY TRUST
DOC. NO. 94-0089291
(DRDCT)

FLOOD ZONE AE
PER LOMR DATED JUNE 26, 2018
CASE NO. 18-06-0546P
FIRM PANEL 48121C0210G

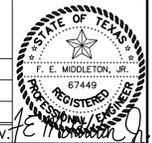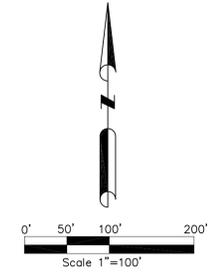

No.	DATE	REVISION	APPROV.

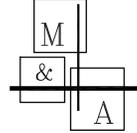



Middleton PROJECT ENGINEER:
& Associates, LLC.

CONSULTING CIVIL ENGINEERS & LAND PLANNERS
TBP# #F-10900 © Copyright 2024
2785 ROCKBROOK DRIVE, SUITE 105
LEWISVILLE, TEXAS 75067 (972) 393-9800

PRELIMINARY WATER PLAN
LANE RANCH ADDITION
813 RESIDENTIAL LOTS - 27 HOA LOTS
3 GENERAL BUSINESS LOTS
RUBEN BEBEE SURVEY, ABST. NO. 29
303.412 ACRES - 41.02 ACRES ROW
CITY OF SANGER DENTON COUNTY TEXAS

Drawing File: 0001032PPT-WAT.DWG	DATE: 5-15-24	SCALE: 1"=100'	SHEET NO.: 2
Project No. 0001032			6

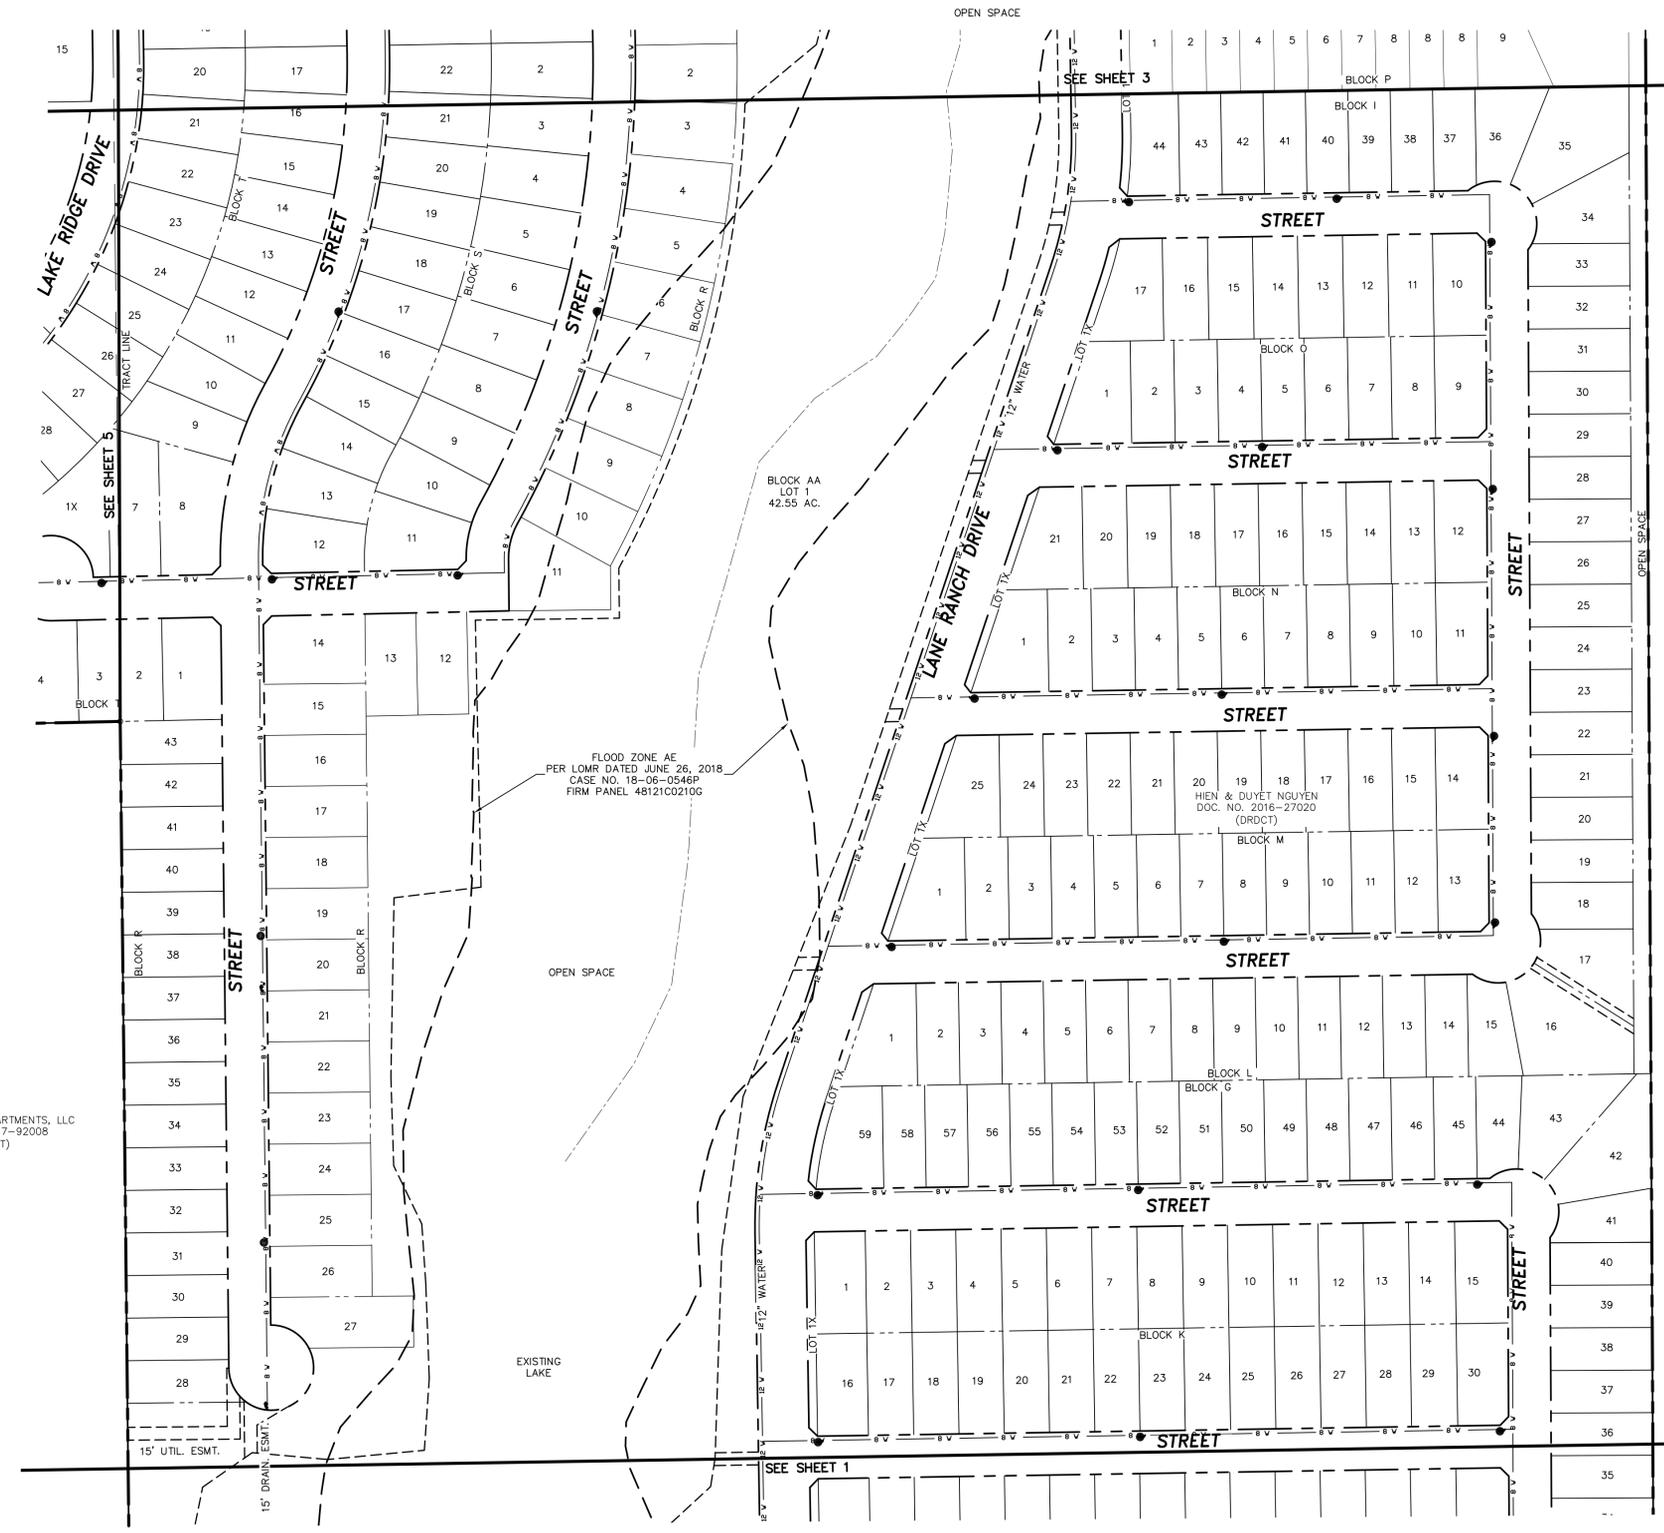

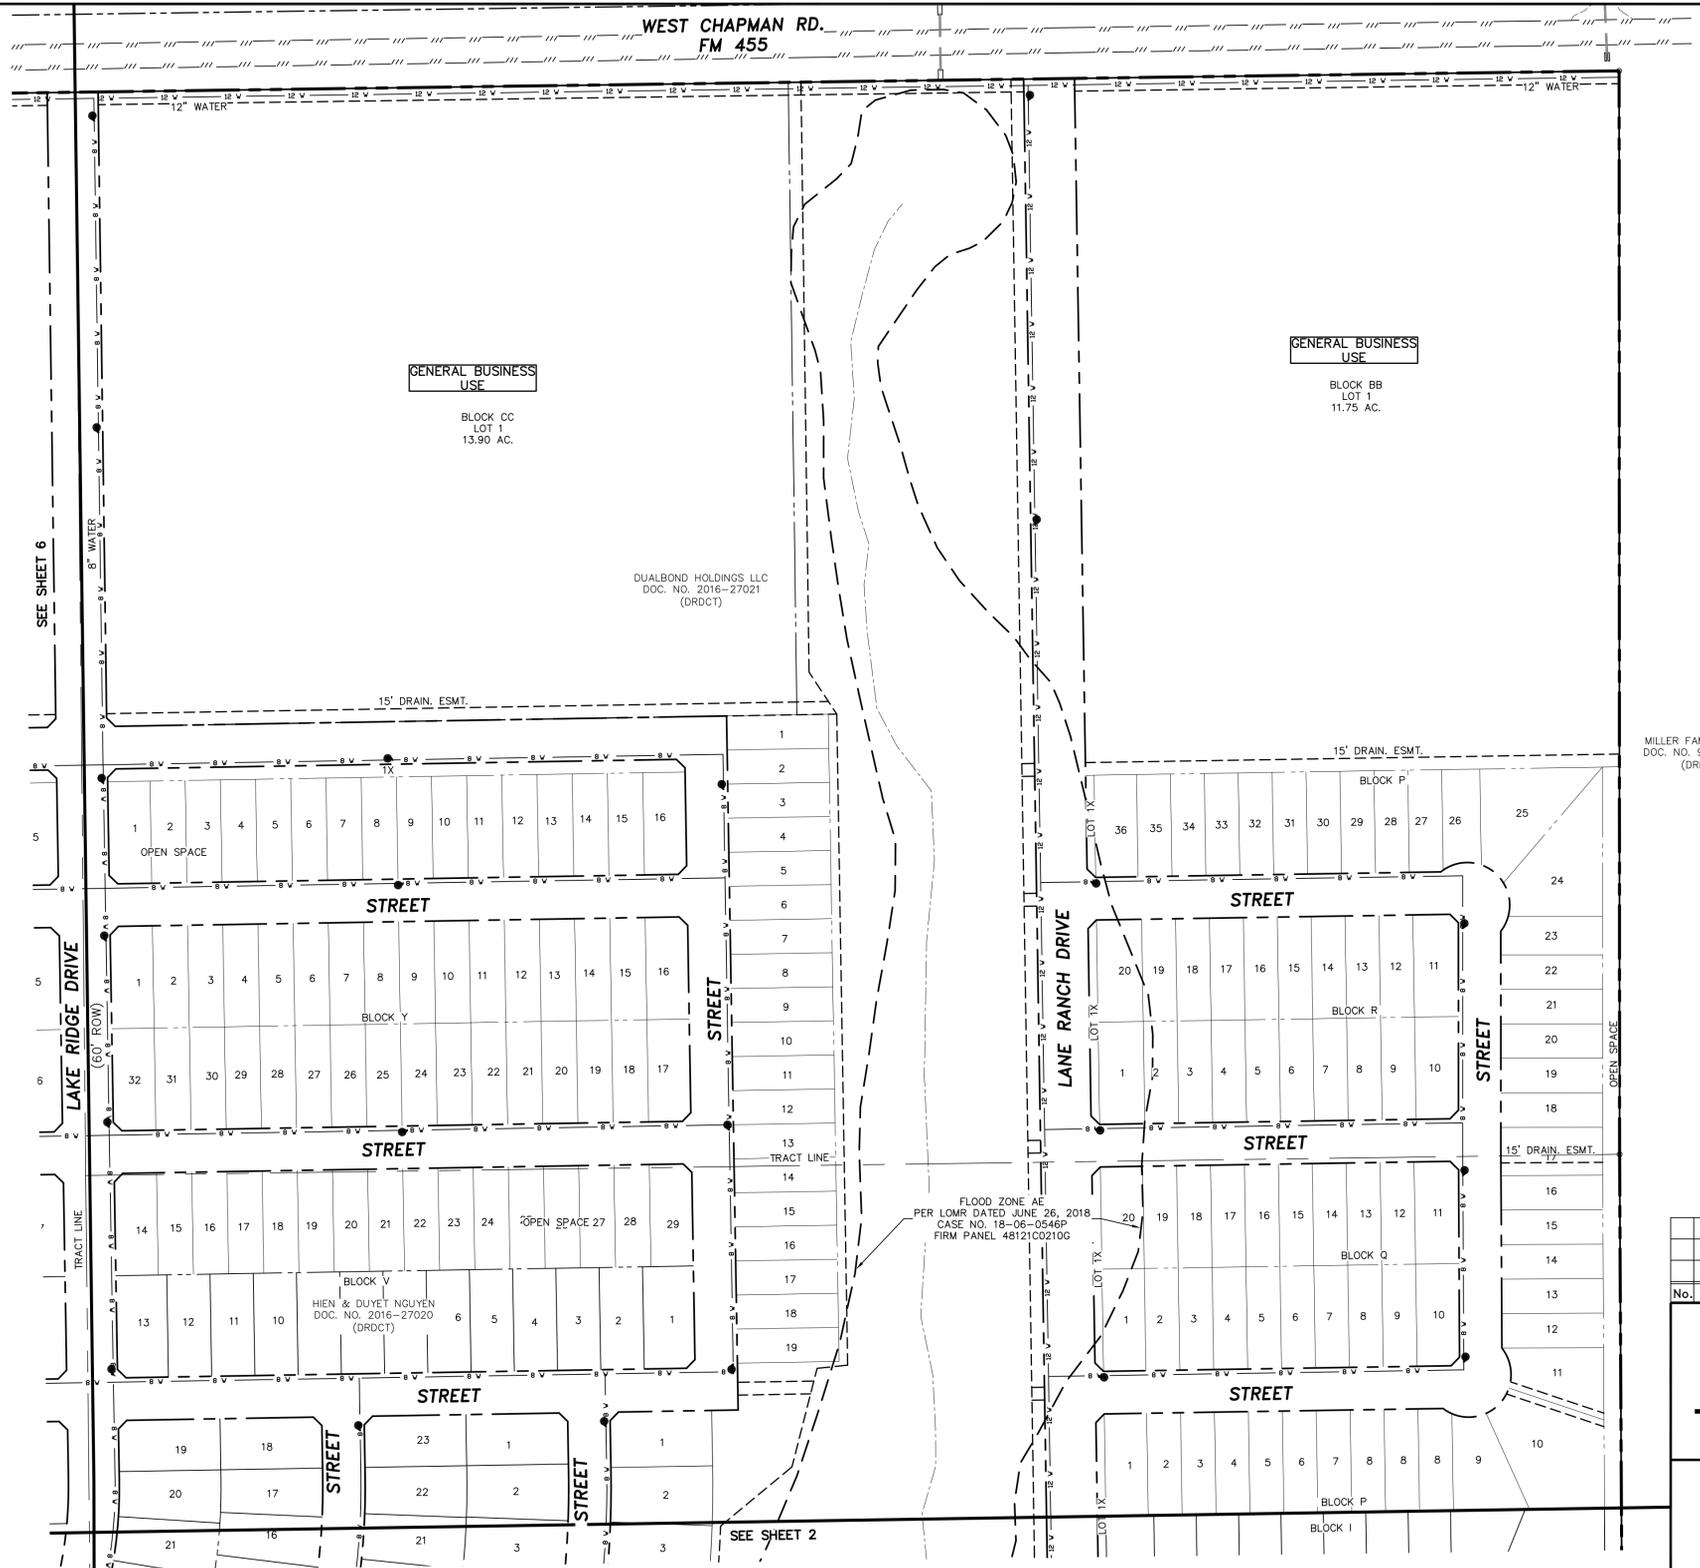

LEGEND


	Ex. Water
	Ex. Sanitary Sewer
	Prop. Water
	Prop. Hydrant

SANGER TOWN CENTER LLC
DOC. NO. 2017-48301
(DRDCT)


DUALBOND HOLDINGS LLC
DOC. NO. 2016-27021
(DRDCT)

MILLER FAMILY TRUST
DOC. NO. 94-0089291
(DRDCT)

FLOOD ZONE AE
PER LOMR DATED JUNE 26, 2018
CASE NO. 18-08-0546P
FIRM PANEL 48121C0210G

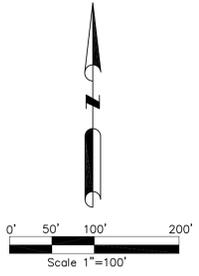

No.	DATE	REVISION	APPROV.

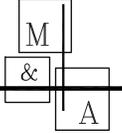



Middleton & Associates, LLC. PROJECT ENGINEER:
5-15-24

CONSULTING CIVIL ENGINEERS & LAND PLANNERS
TBP# #F-10900 © Copyright 2024
2785 ROCKBROOK DRIVE, SUITE 105
LEWISVILLE, TEXAS 75067 (972) 393-9800

PRELIMINARY WATER PLAN
LANE RANCH ADDITION
813 RESIDENTIAL LOTS - 27 HOA LOTS
3 GENERAL BUSINESS LOTS
RUBEN BEBEE SURVEY, ABST. NO. 29
303.412 ACRES - 41.02 ACRES ROW
CITY OF SANGER DENTON COUNTY TEXAS

Drawing File: 0001032PPT-WAT.DWG	DATE: 5-15-24	SCALE: 1"=100'	SHEET NO.: 3
Project No. 0001032			6

LEGEND	
— v —	Ex. Water
— ss —	Ex. Sanitary Sewer
— w —	Prop. Water
— h —	Prop. Hydrant

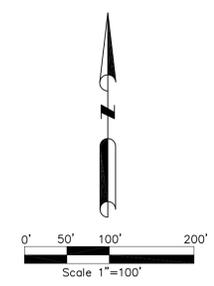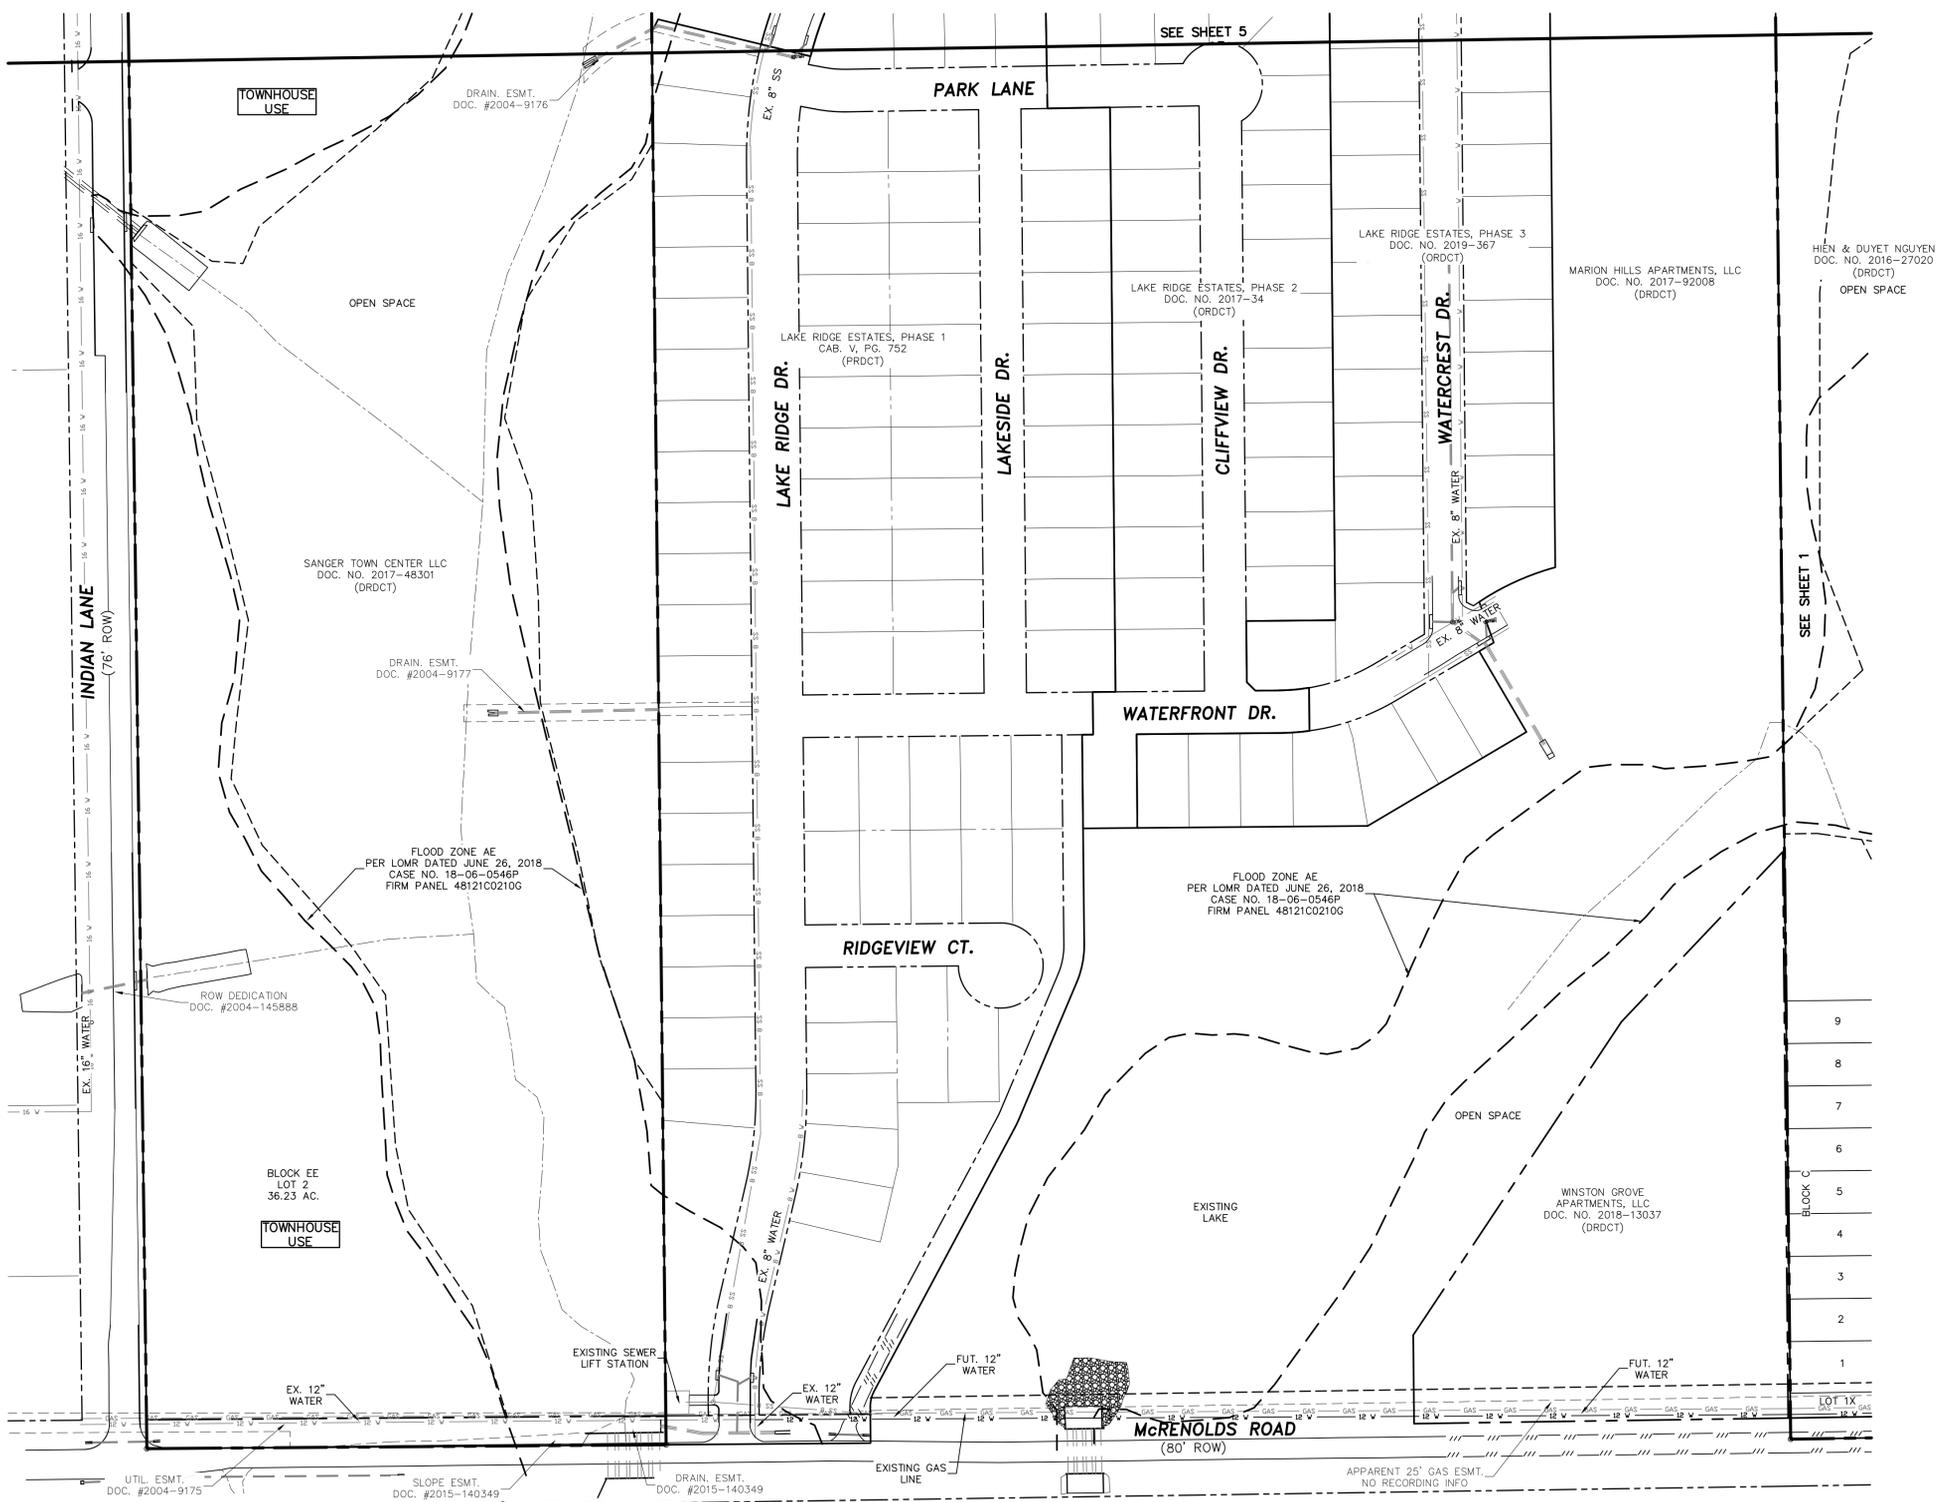


No.	DATE	REVISION	APPROV.

**Middleton PROJECT ENGINEER:
& Associates, LLC.**
CONSULTING CIVIL ENGINEERS & LAND PLANNERS
TBP# #F-10900 © Copyright 2024
2785 ROCKBROOK DRIVE, SUITE 105
LEWISVILLE, TEXAS 75067 (972) 393-9800



PRELIMINARY WATER PLAN
LANE RANCH ADDITION
813 RESIDENTIAL LOTS - 27 HOA LOTS
3 GENERAL BUSINESS LOTS
RUEBEN BEBEE SURVEY, ABST. NO. 29
303.412 ACRES - 41.02 ACRES ROW
CITY OF SANGER DENTON COUNTY TEXAS

Drawing File: 0001032PPT-WAT.DWG	DATE: 5-15-24	SCALE: 1"=100'	SHEET NO.: 4
Project No. 0001032			6


LEGEND	
	Ex. Water
	Ex. Sanitary Sewer
	Prop. Water
	Prop. Hydrant

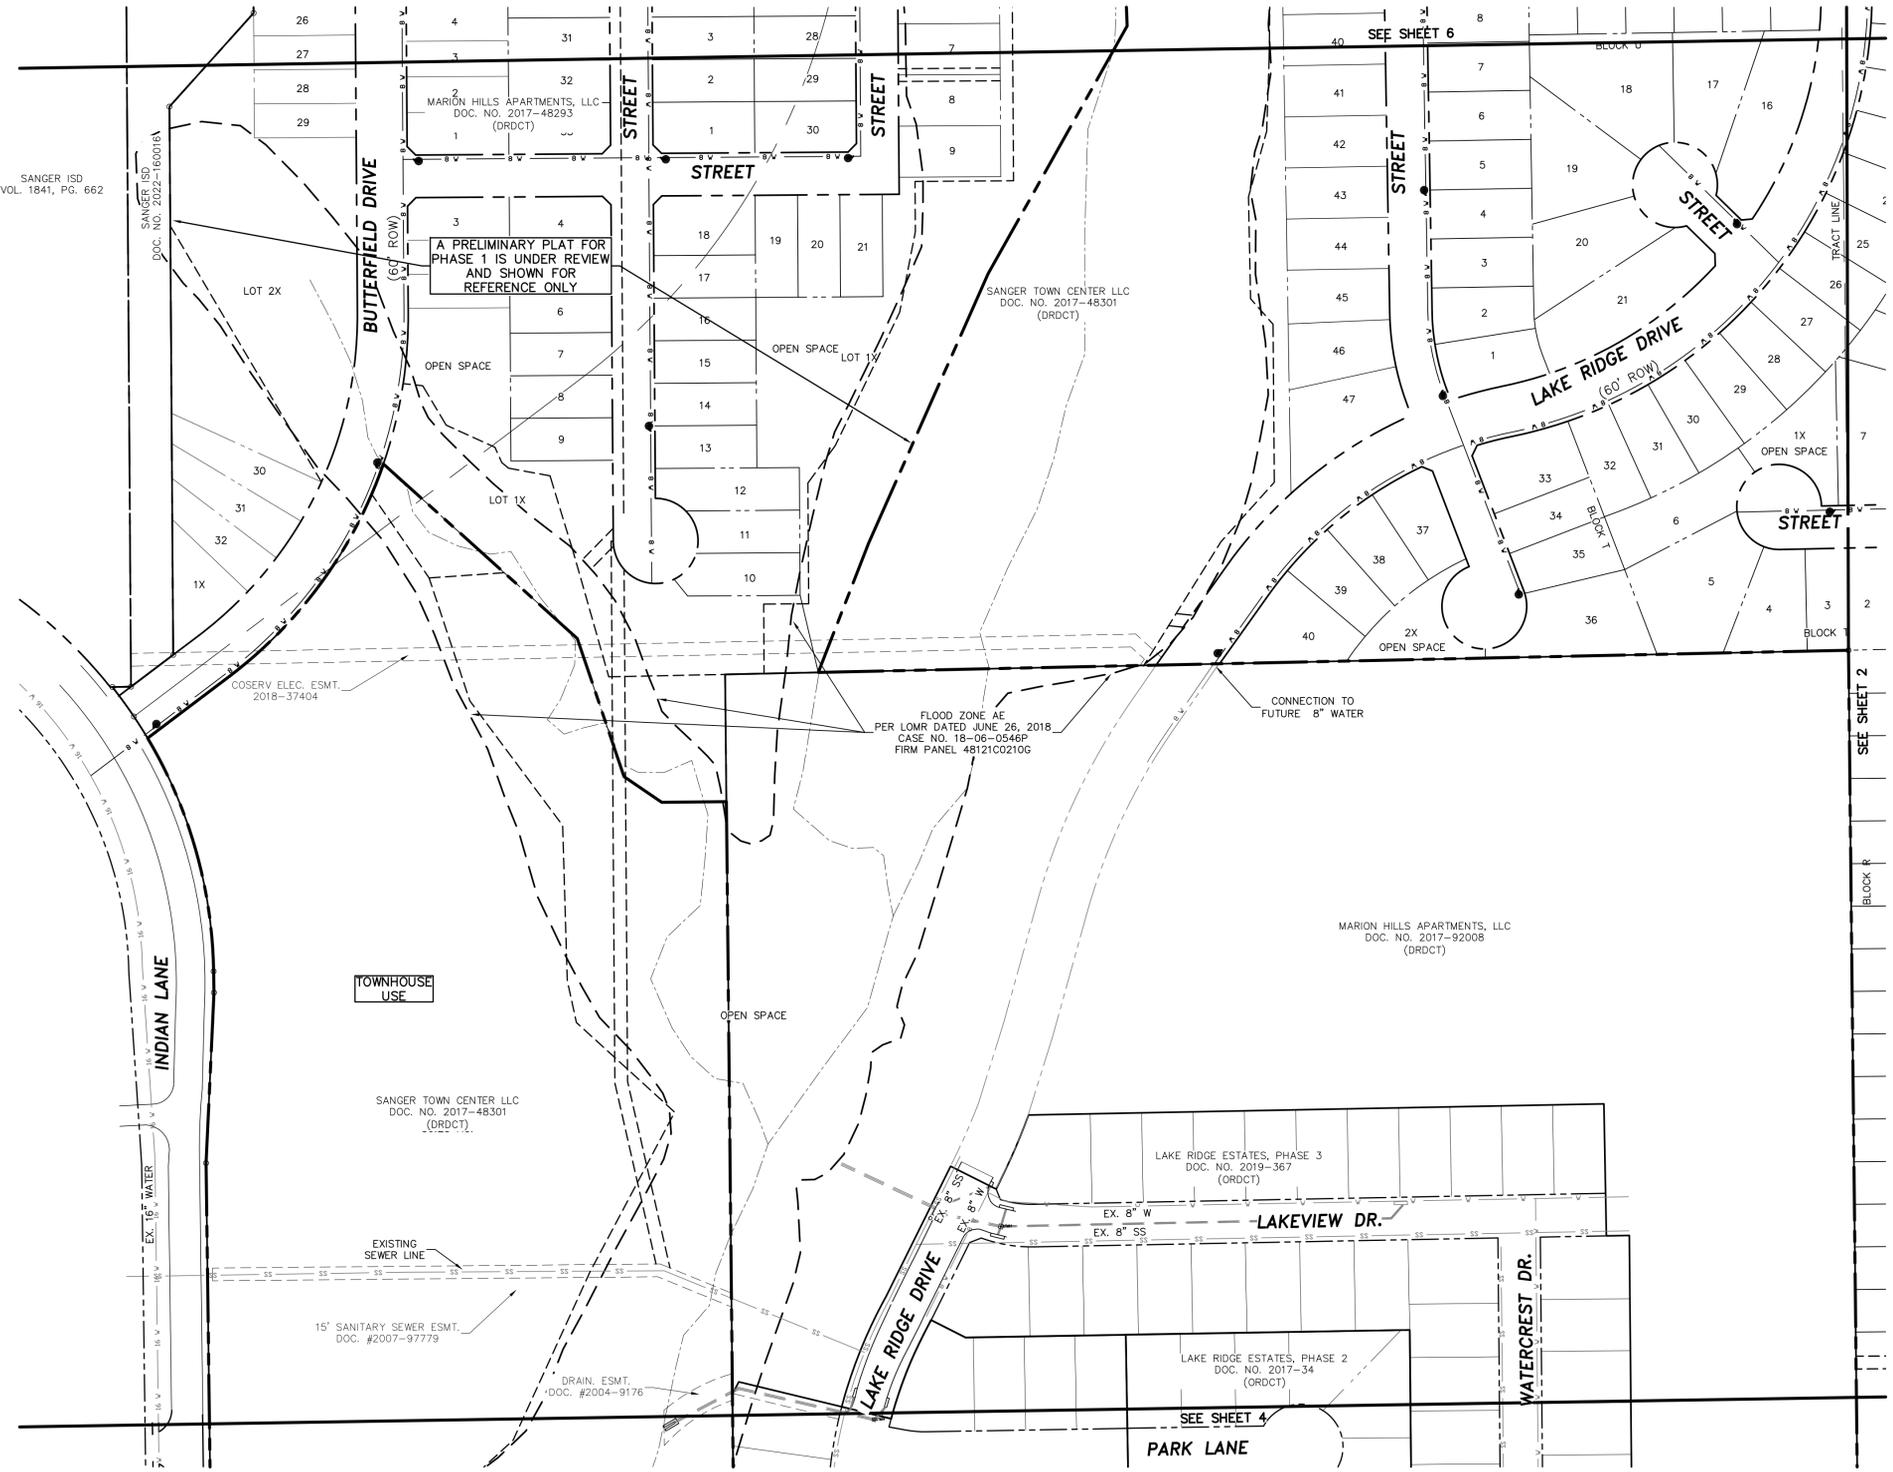

HIEN & DUyet NGUYEN
DOC. NO. 2016-27020
(DRDCT)

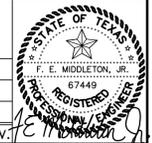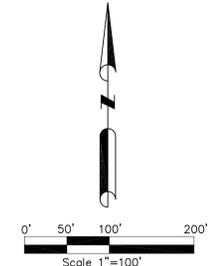

No.	DATE	REVISION	APPROV.

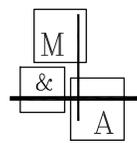

Middleton & Associates, LLC.
PROJECT ENGINEER:

CONSULTING CIVIL ENGINEERS & LAND PLANNERS
TBP# #F-10900 © Copyright 2024
2785 ROCKBROOK DRIVE, SUITE 105
LEWISVILLE, TEXAS 75067 (972) 393-9800

PRELIMINARY WATER PLAN
LANE RANCH ADDITION
813 RESIDENTIAL LOTS - 27 HOA LOTS
3 GENERAL BUSINESS LOTS
RUEBEN BEBEE SURVEY, ABST. NO. 29
303.412 ACRES - 41.02 ACRES ROW
CITY OF SANGER DENTON COUNTY TEXAS

Drawing File: 0001032PPT-WAT.DWG	DATE: 5-15-24	SCALE: 1"=100'	SHEET NO.: 5
Project No. 0001032			6




MARION HILLS APARTMENTS, LLC
 DOC. NO. 2017-92008
 (DRDCT)

FLOOD ZONE AE
 PER LOMR DATED JUNE 26, 2018
 CASE NO. 18-06-0546P
 FIRM PANEL 48121C0210G


HIEN & DUYET NGUYEN
 DOC. NO. 2016-27023
 (DRDCT)

WINSTON GROVE
 APARTMENTS, LLC
 DOC. NO. 2018-13037
 (DRDCT)

15' UTIL. ESMT.
 (BY SEP. INST.)

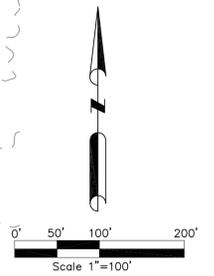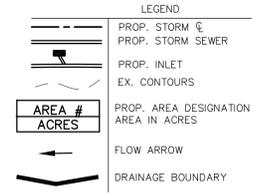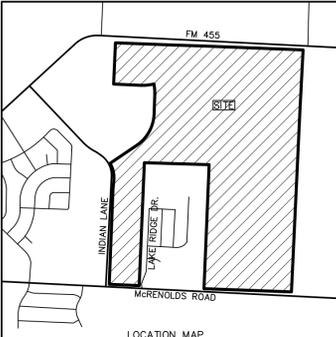

No.	DATE	REVISION	APPROV.
			5-15-24

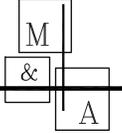

**Middleton PROJECT ENGINEER:
 & Associates, LLC.**
 CONSULTING CIVIL ENGINEERS & LAND PLANNERS
 TYPE #F-10900 © Copyright 2024
 2785 ROCKBROOK DRIVE, SUITE 105
 LEWISVILLE, TEXAS 75067 (972) 393-9800


PRELIMINARY DRAINAGE PLAN
 LANE RANCH ADDITION
 813 RESIDENTIAL LOTS - 27 HOA LOTS
 3 GENERAL BUSINESS LOTS
 RUEBEN BEBEE SURVEY, ABST. NO. 29
 303.412 ACRES - 41.02 ACRES ROW
 CITY OF SANGER DENTON COUNTY TEXAS

Drawing File: 0001032PPT-STM.DWG	DATE: 5-15-24	SCALE: 1"=100'	SHEET NO: 1
Project No. 0001032			6

APPARENT 25' GAS ESMT. NO RECORDING INFO
 EXISTING STORM PIPE 9.23 AC.
 50'X50' ENSERCH MEASURING STATION ESMT. DOC. #94-R0019695



SANGER TOWN CENTER LLC
DOC. NO. 2017-48301
(DRDCT)

MARION HILLS APARTMENTS, LLC
DOC. NO. 2017-92008
(DRDCT)

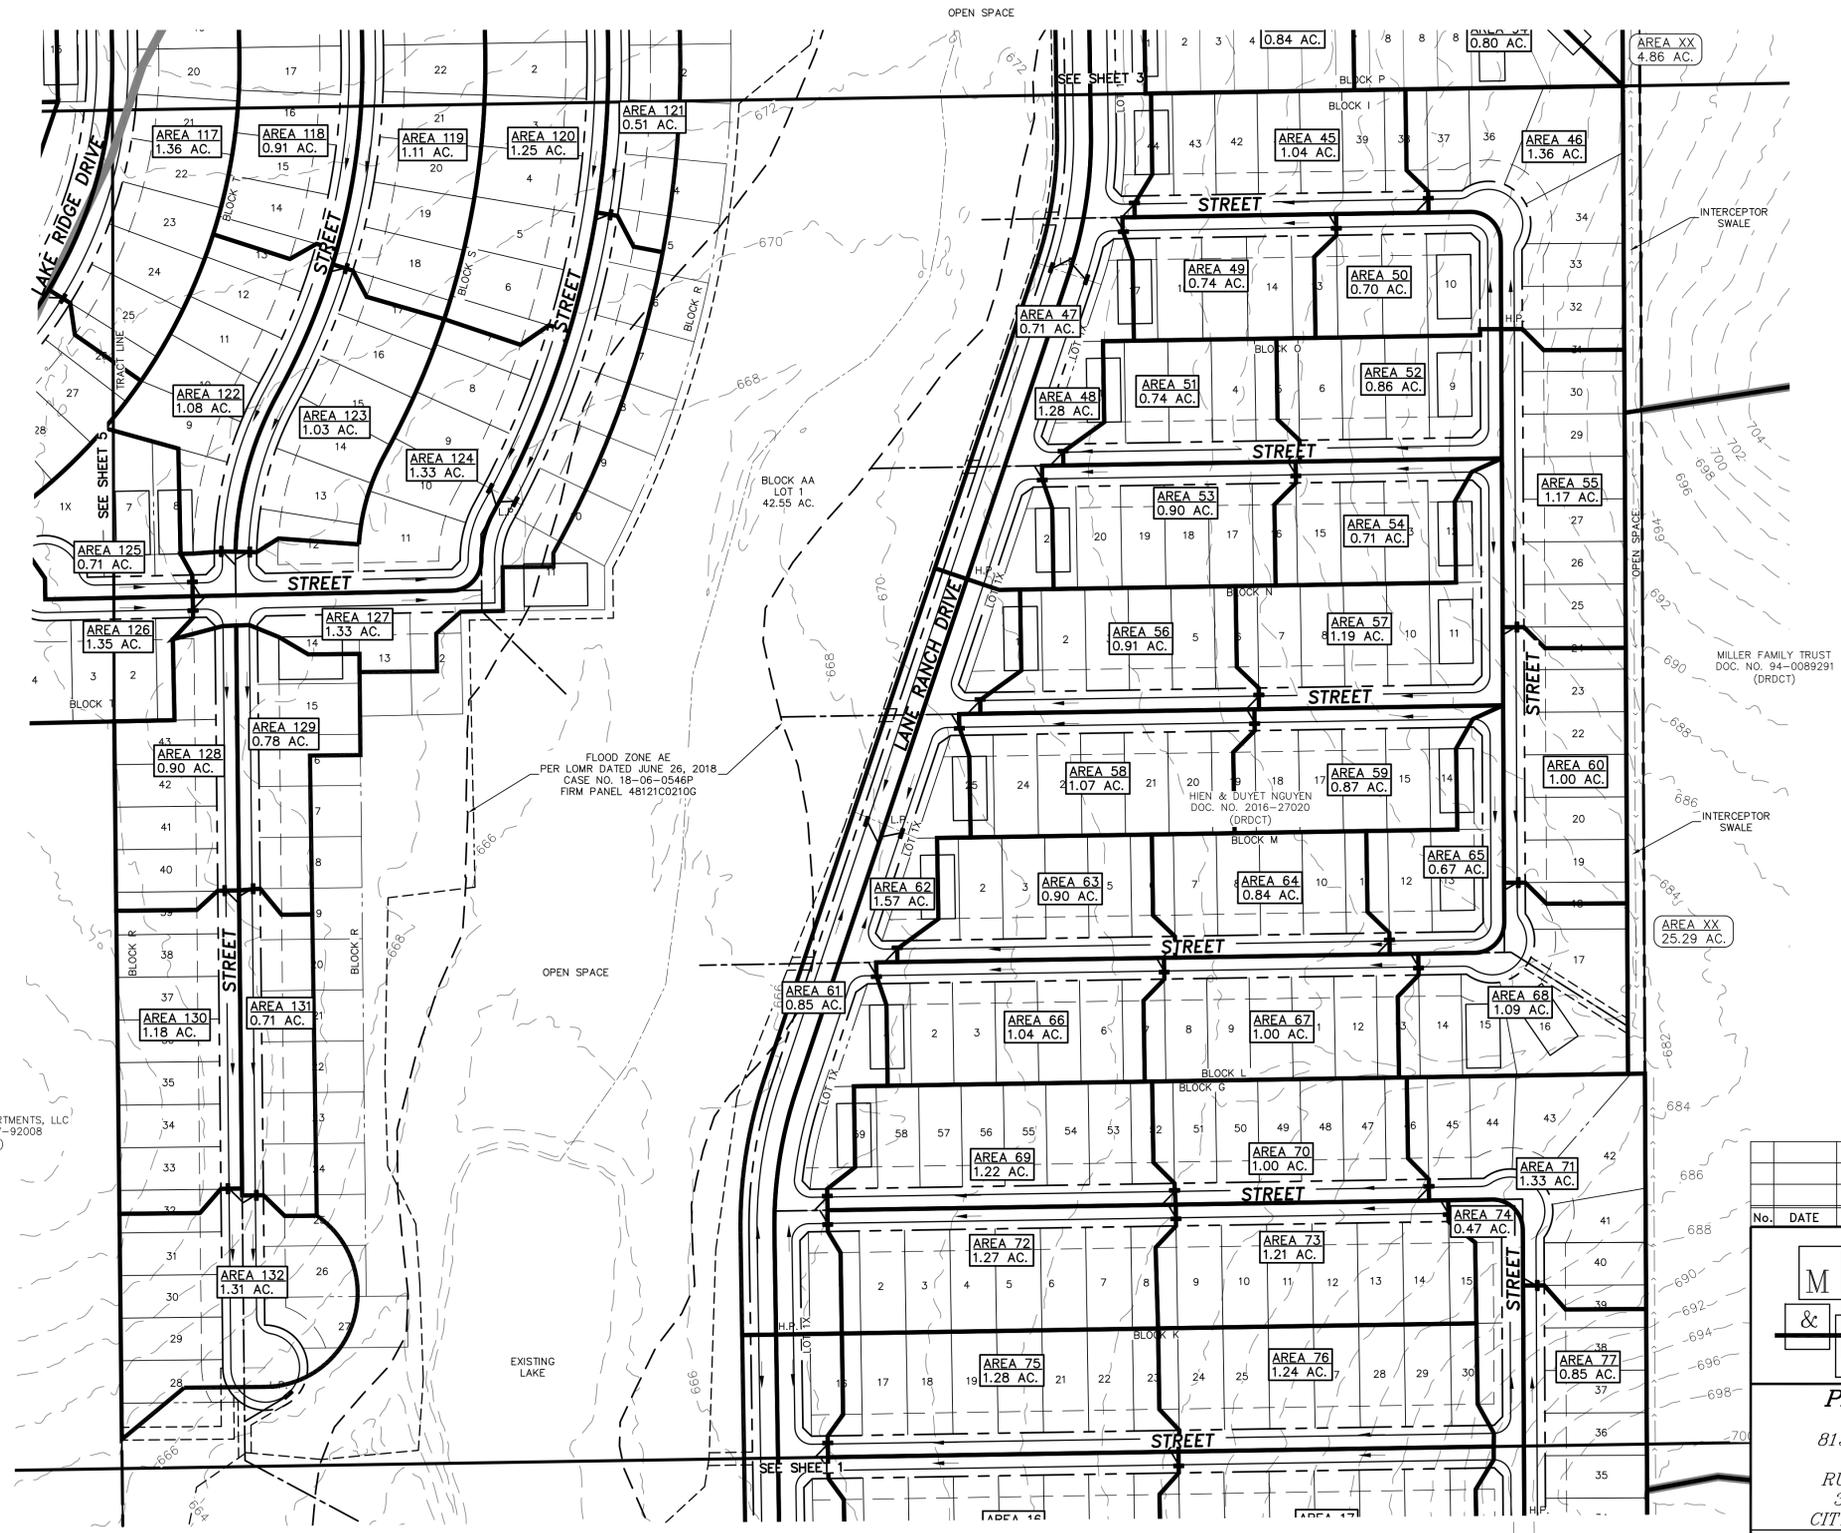


LEGEND

	PROP. STORM SEWER
	PROP. STORM INLET
	EX. CONTOURS
	PROP. AREA DESIGNATION AREA IN ACRES
	FLOW ARROW
	DRAINAGE BOUNDARY

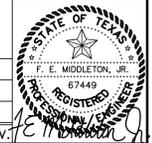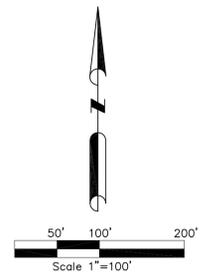

No.	DATE	REVISION	APPROV.
			5-15-24

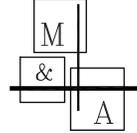


Middleton & Associates, LLC. PROJECT ENGINEER:

CONSULTING CIVIL ENGINEERS & LAND PLANNERS
TYPE #F-10900 © Copyright 2024
2785 ROCKBROOK DRIVE, SUITE 105
LEWISVILLE, TEXAS 75067 (972) 393-9800

PRELIMINARY DRAINAGE PLAN
LANE RANCH ADDITION
813 RESIDENTIAL LOTS - 27 HOA LOTS
3 GENERAL BUSINESS LOTS
RUBEN BEBEE SURVEY, ABST. NO. 29
303.412 ACRES - 41.02 ACRES ROW
CITY OF SANGER DENTON COUNTY TEXAS

Drawing File: 0001032PPT-STM.DWG	DATE: 5-15-24	SCALE: 1"=100'	SHEET NO.: 2
Project No. 0001032			6

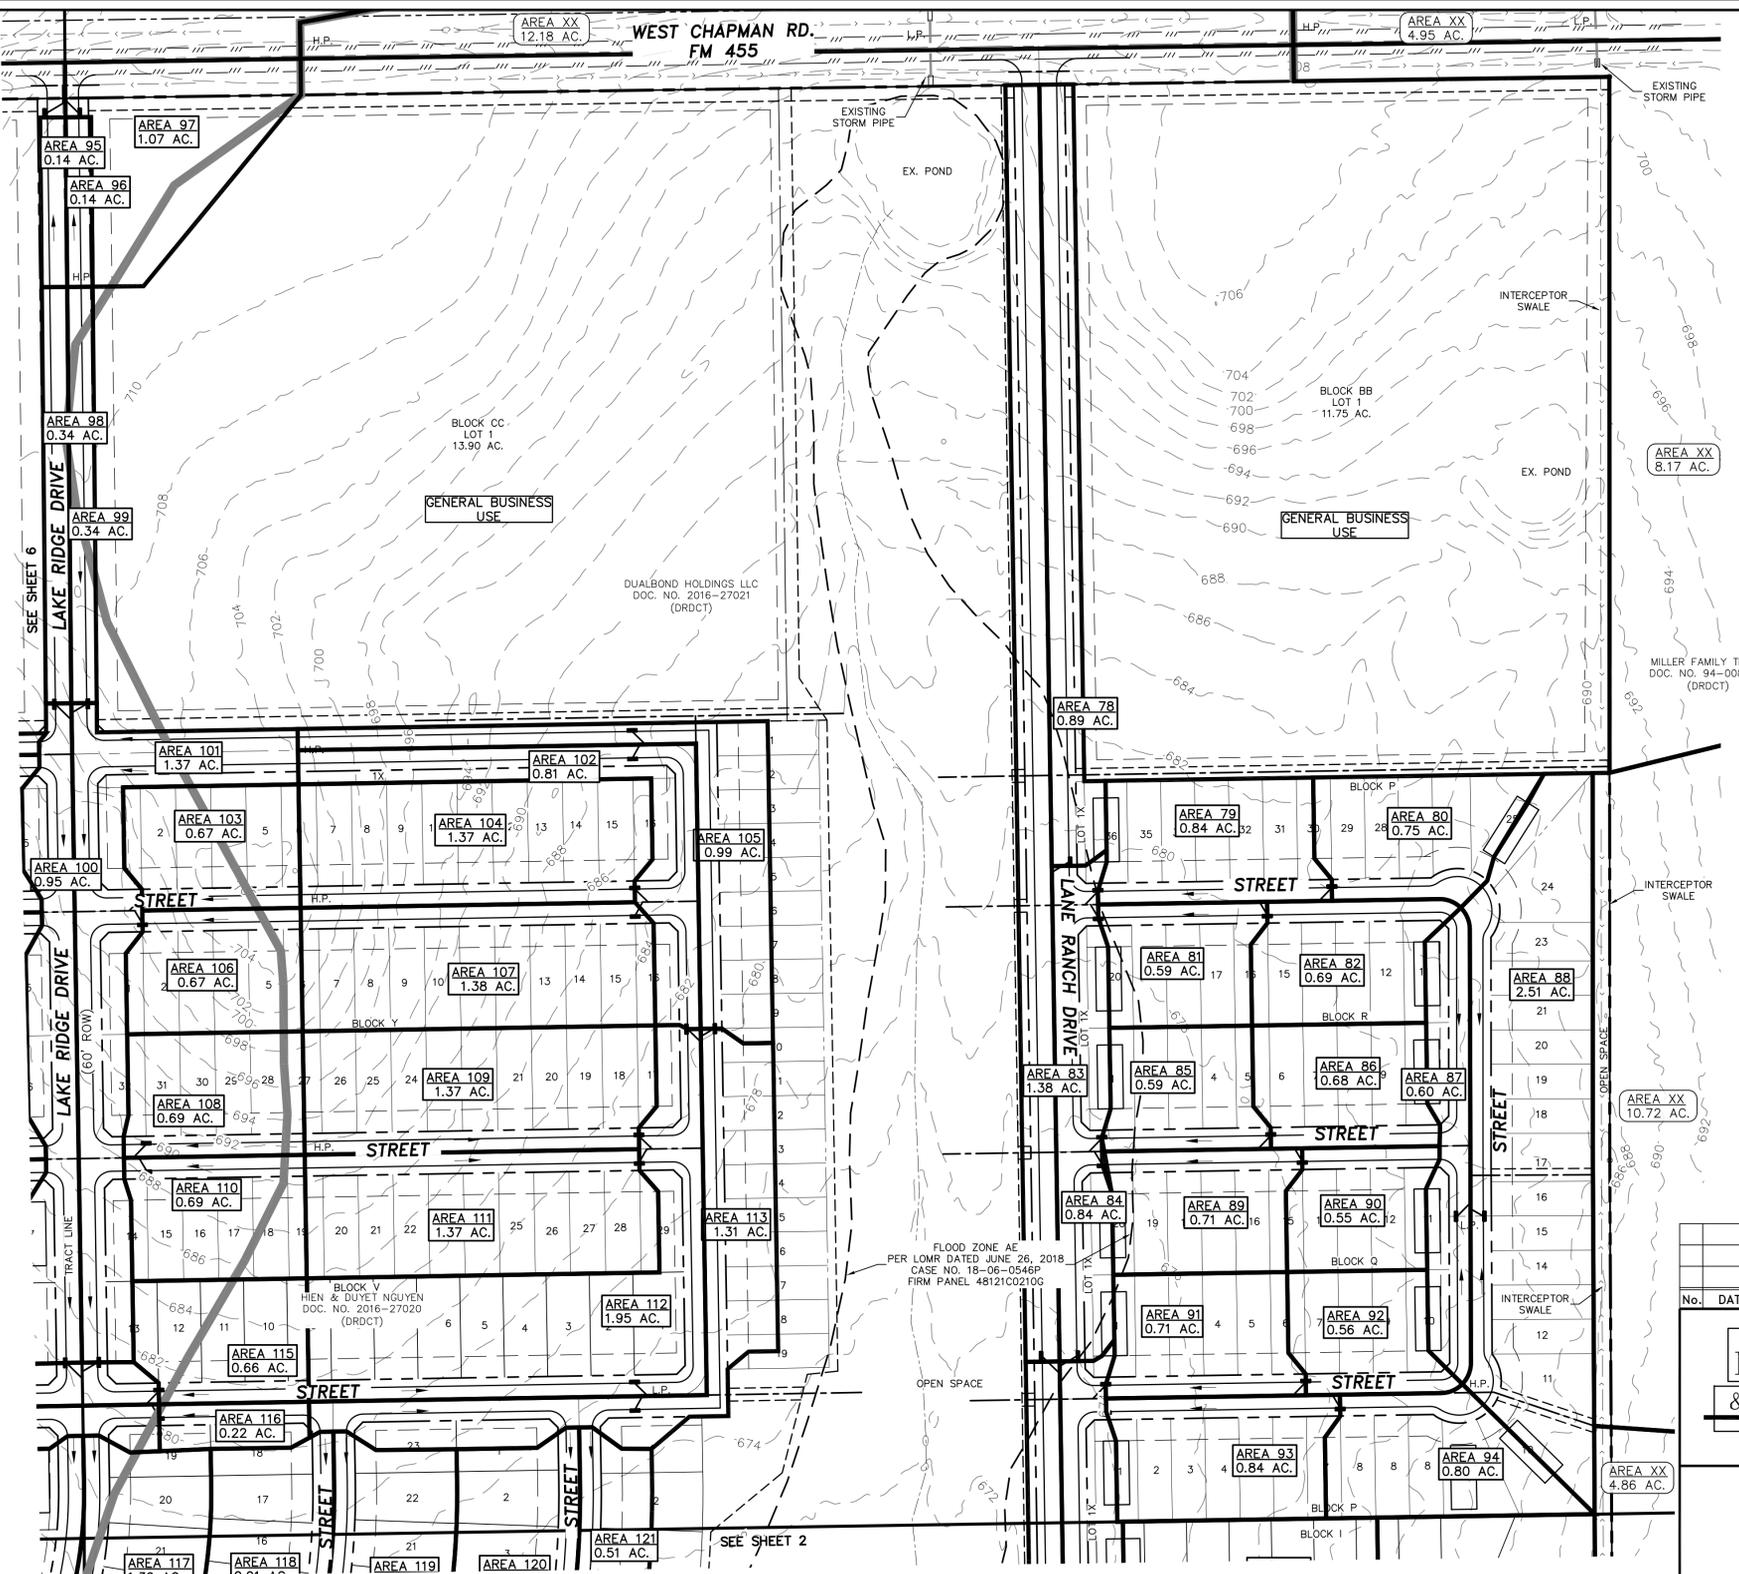



SANGER TOWN CENTER LLC
DOC. NO. 2017-48301
(DRDCT)

BLOCK V
HIEN & DUHET NGUYEN
DOC. NO. 2016-27020
(DRDCT)

FLOOD ZONE AE
PER LOMR DATED JUNE 26, 2018
CASE NO. 18-06-0546P
FIRM PANEL 48121C0210G

LEGEND

	PROP. STORM S
	PROP. STORM SEWER
	PROP. INLET
	EX. CONTOURS
	PROP. AREA DESIGNATION AREA IN ACRES
	FLOW ARROW
	DRAINAGE BOUNDARY

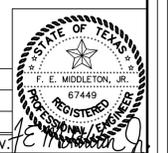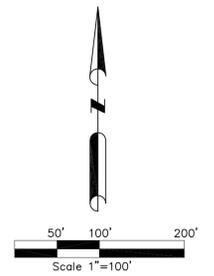

No.	DATE	REVISION	APPROV.
			5-15-24



**Middleton PROJECT ENGINEER:
& Associates, LLC.**
CONSULTING CIVIL ENGINEERS & LAND PLANNERS
TBP# 10900 © Copyright 2024
2785 ROCKBROOK DRIVE, SUITE 105
LEWISVILLE, TEXAS 75067 (972) 393-9800

PRELIMINARY DRAINAGE PLAN
LANE RANCH ADDITION
813 RESIDENTIAL LOTS - 27 HOA LOTS
3 GENERAL BUSINESS LOTS
RUBEN BEBEE SURVEY, ABST. NO. 29
303.412 ACRES - 41.02 ACRES ROW
CITY OF SANGER DENTON COUNTY TEXAS

Drawing File: 0001032PPT-STM.DWG	DATE: 5-15-24	SCALE: 1"=100'	SHEET NO.: 3
Project No. 0001032			6

LEGEND

- PROP. STORM ☉
- PROP. STORM SEWER
- PROP. INLET
- EX. CONTOURS
- AREA # ACRES
- PROP. AREA DESIGNATION AREA IN ACRES
- FLOW ARROW
- DRAINAGE BOUNDARY

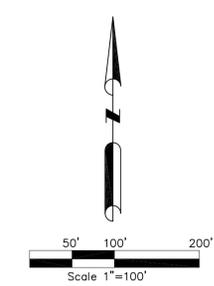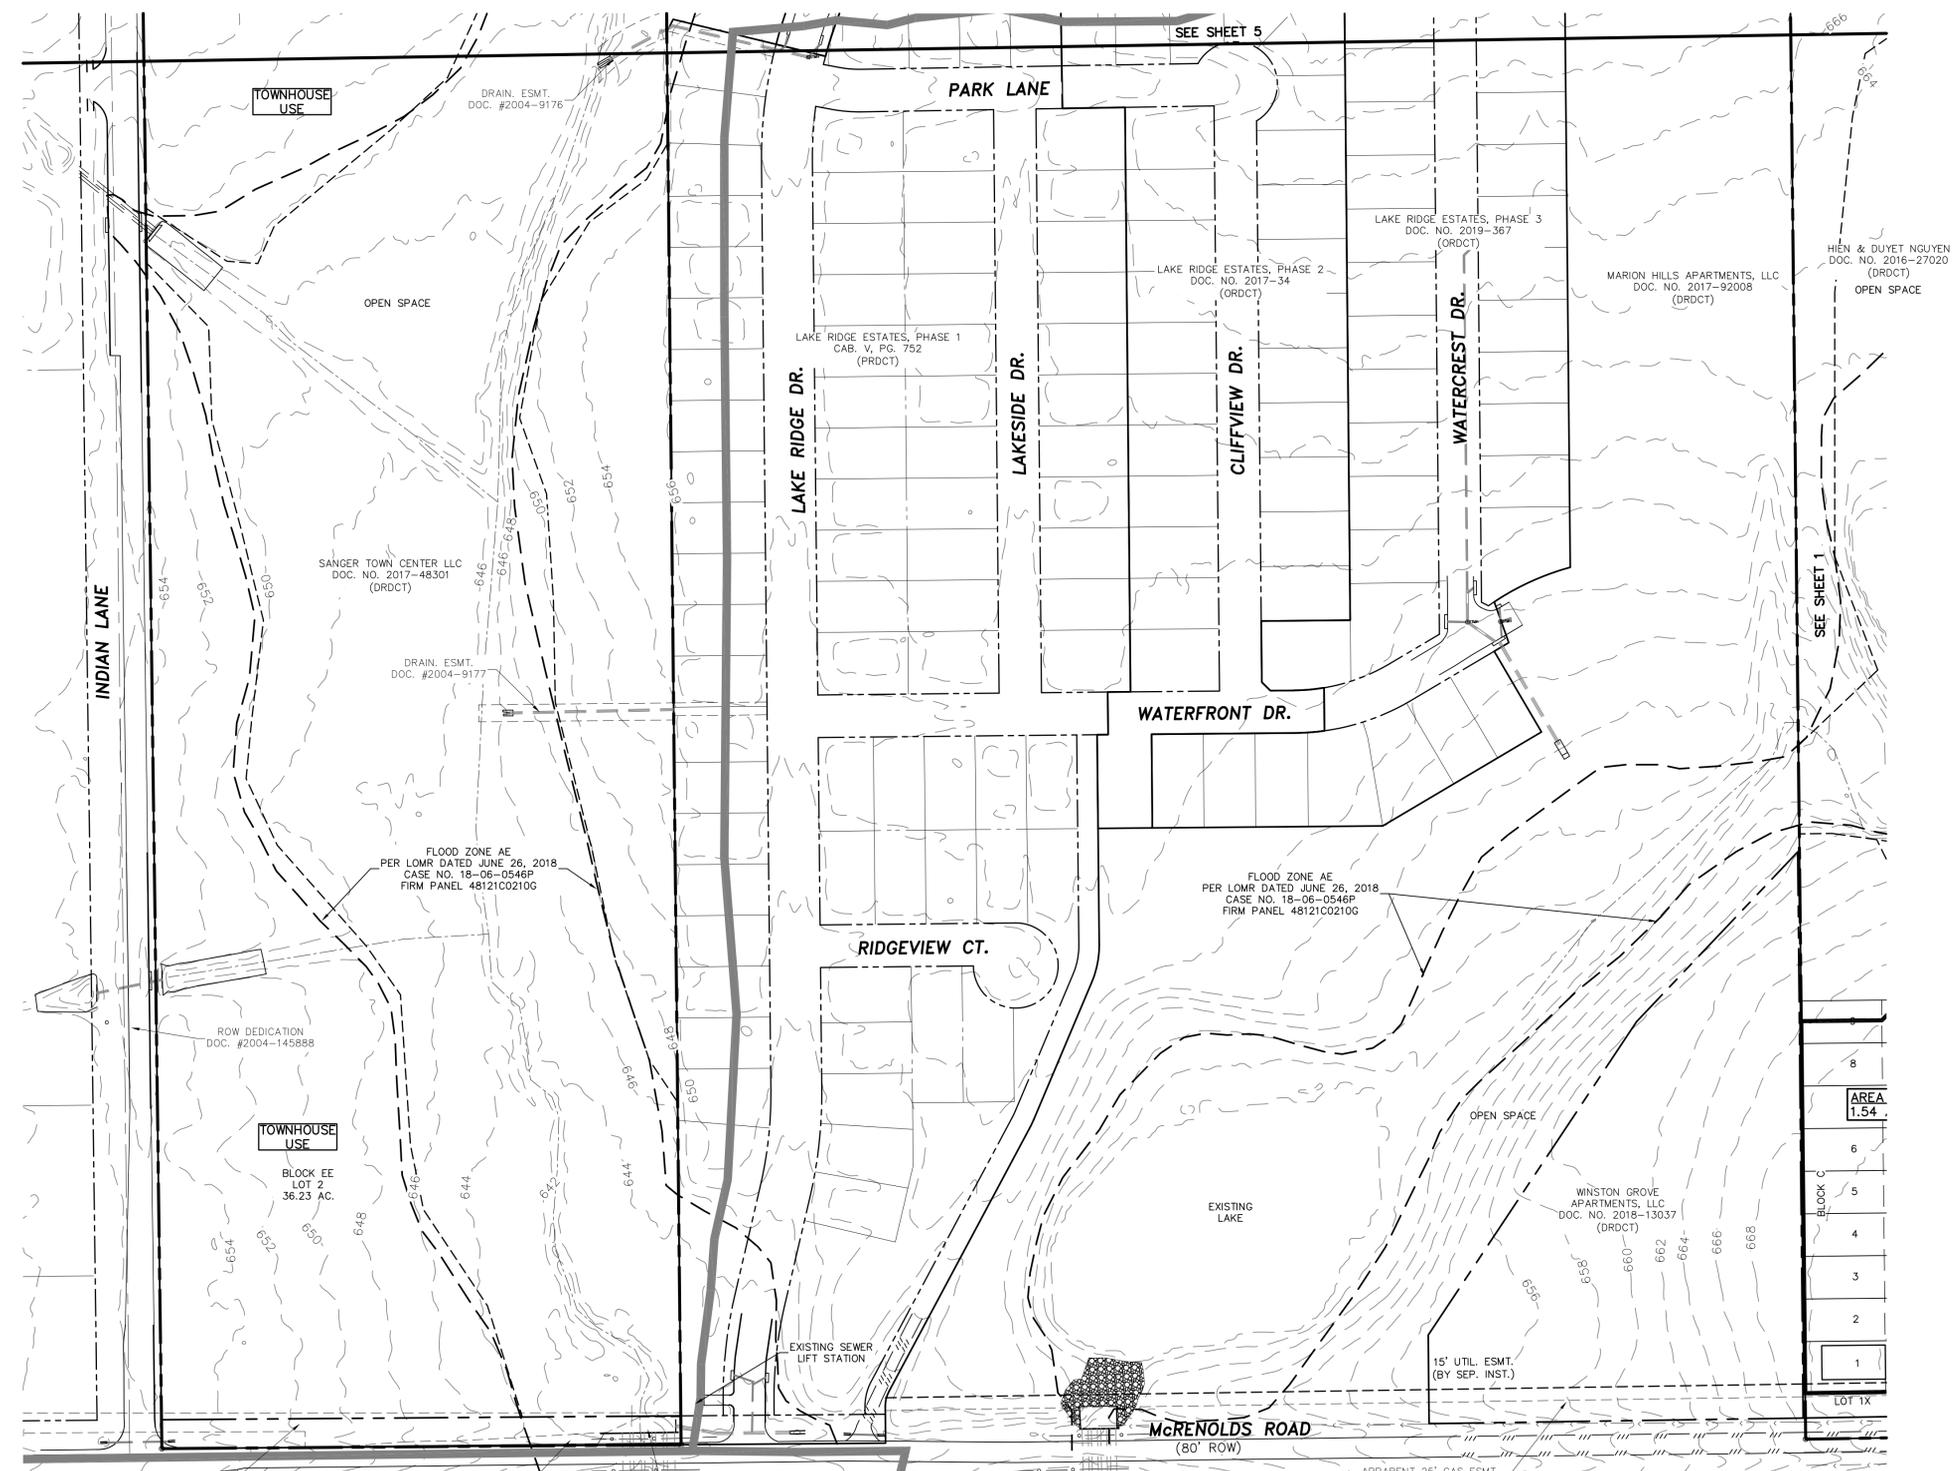

No.	DATE	REVISION	APPROV.

5-15-24

**Middleton PROJECT ENGINEER:
& Associates, LLC.**

CONSULTING CIVIL ENGINEERS & LAND PLANNERS
 TYPE #F-10900 © Copyright 2024
 2785 ROCKBROOK DRIVE, SUITE 105
 LEWISVILLE, TEXAS 75067 (972) 393-9800


PRELIMINARY DRAINAGE PLAN
 LANE RANCH ADDITION
 813 RESIDENTIAL LOTS - 27 HOA LOTS
 3 GENERAL BUSINESS LOTS
 RUEBEN BEBEE SURVEY, ABST. NO. 29
 303.412 ACRES - 41.02 ACRES ROW
 CITY OF SANGER DENTON COUNTY TEXAS

Drawing File: 0001032PPT-STM.DWG	DATE: 5-15-24	SCALE: 1"=100'	SHEET NO.: 4
Project No. 0001032			6



AREA	1.54
BLOCK C	8
	6
	5
	4
	3
	2
	1
LOT 1X	

UTIL. ESMT. DOC. #2004-9175 SLOPE ESMT. DOC. #2015-140349 DRAIN. ESMT. DOC. #2015-140349 APPARENT 25' GAS ESMT. NO RECORDING INFO.

- LEGEND
- PROP. STORM ☉
 - PROP. STORM SEWER
 - PROP. INLET
 - EX. CONTOURS
 - AREA # ACRES
 - PROP. AREA DESIGNATION AREA IN ACRES
 - FLOW ARROW
 - DRAINAGE BOUNDARY

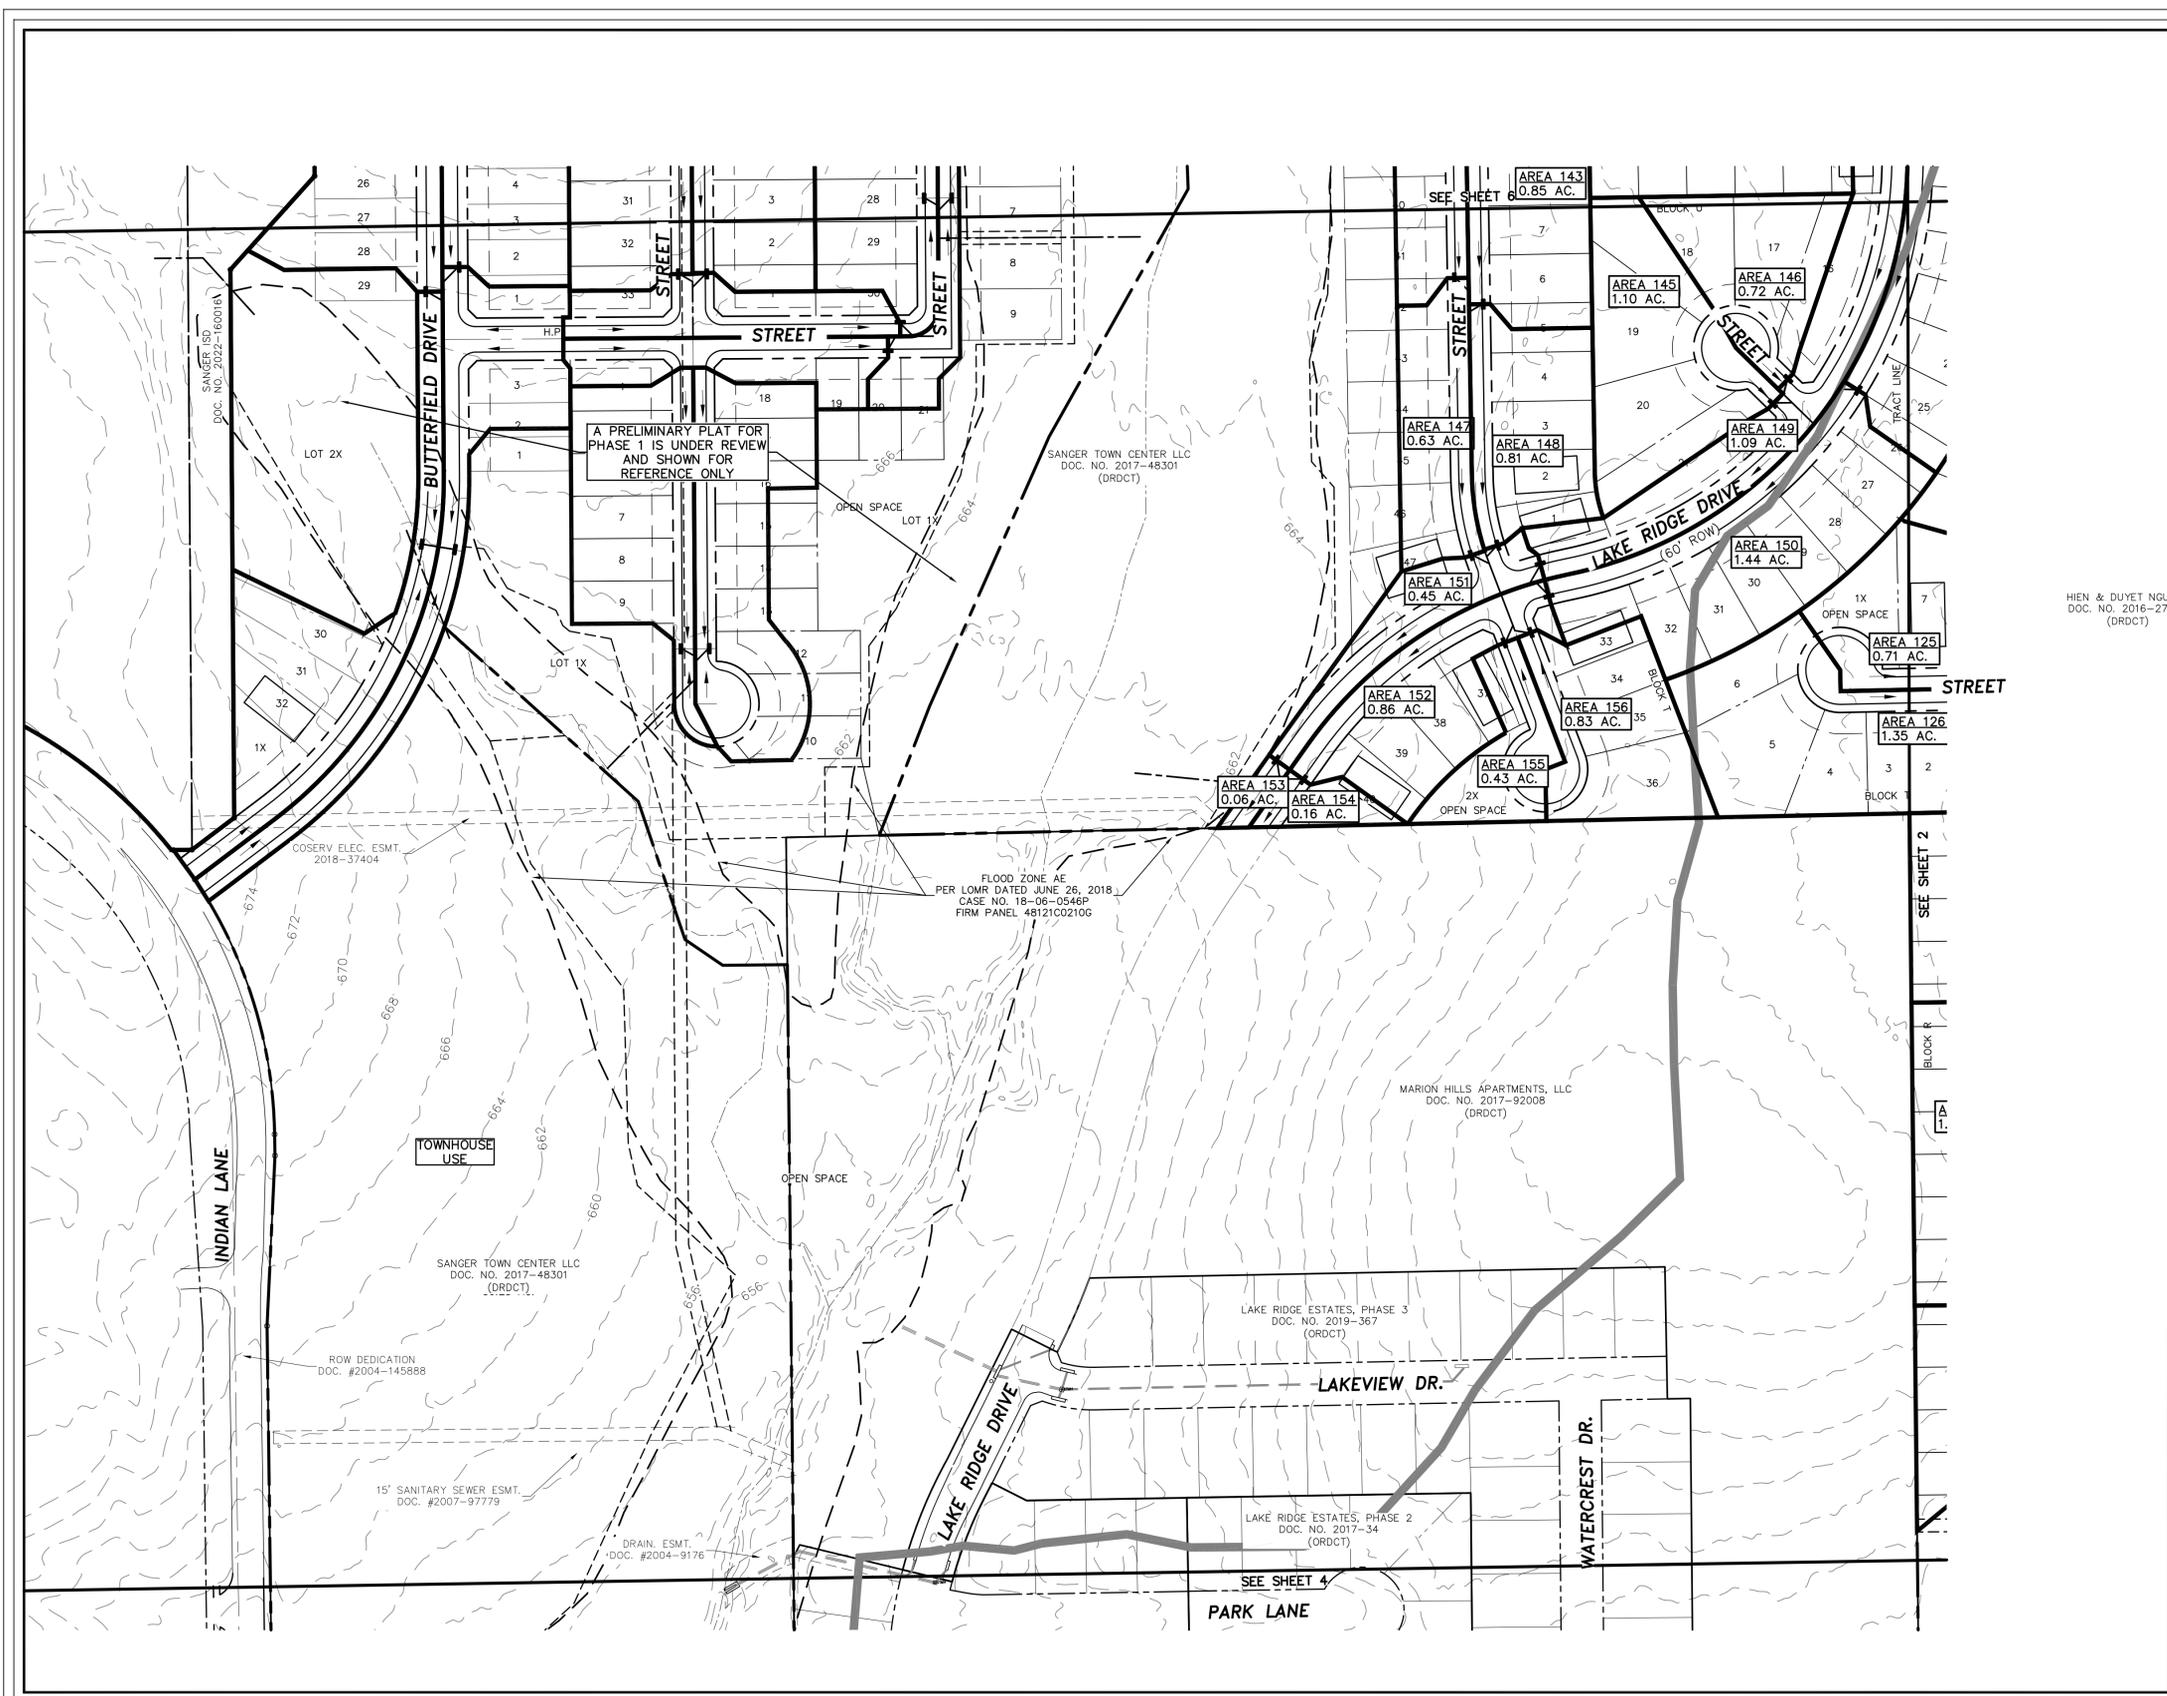

HIEN & DUyet NGUYEN
DOC. NO. 2016-27020
(DRDCT)

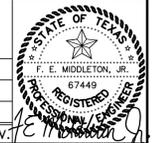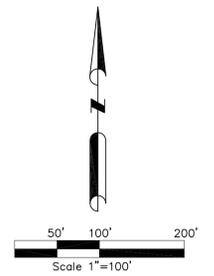


No.	DATE	REVISION	APPROV.
			5-15-24

**Middleton PROJECT ENGINEER:
& Associates, LLC.**

CONSULTING CIVIL ENGINEERS & LAND PLANNERS
 TEP# 10900 © Copyright 2024
 2785 ROCKBROOK DRIVE, SUITE 105
 LEWISVILLE, TEXAS 75067 (972) 393-9800



PRELIMINARY DRAINAGE PLAN
 LANE RANCH ADDITION
 813 RESIDENTIAL LOTS - 27 HOA LOTS
 3 GENERAL BUSINESS LOTS
 RUEBEN BEBEE SURVEY, ABST. NO. 29
 303.412 ACRES - 41.02 ACRES ROW
 CITY OF SANGER DENTON COUNTY TEXAS

Drawing File: 0001032PPT-STM.DWG	DATE: 5-15-24	SCALE: 1"=100'	SHEET NO.: 5
Project No. 0001032			6

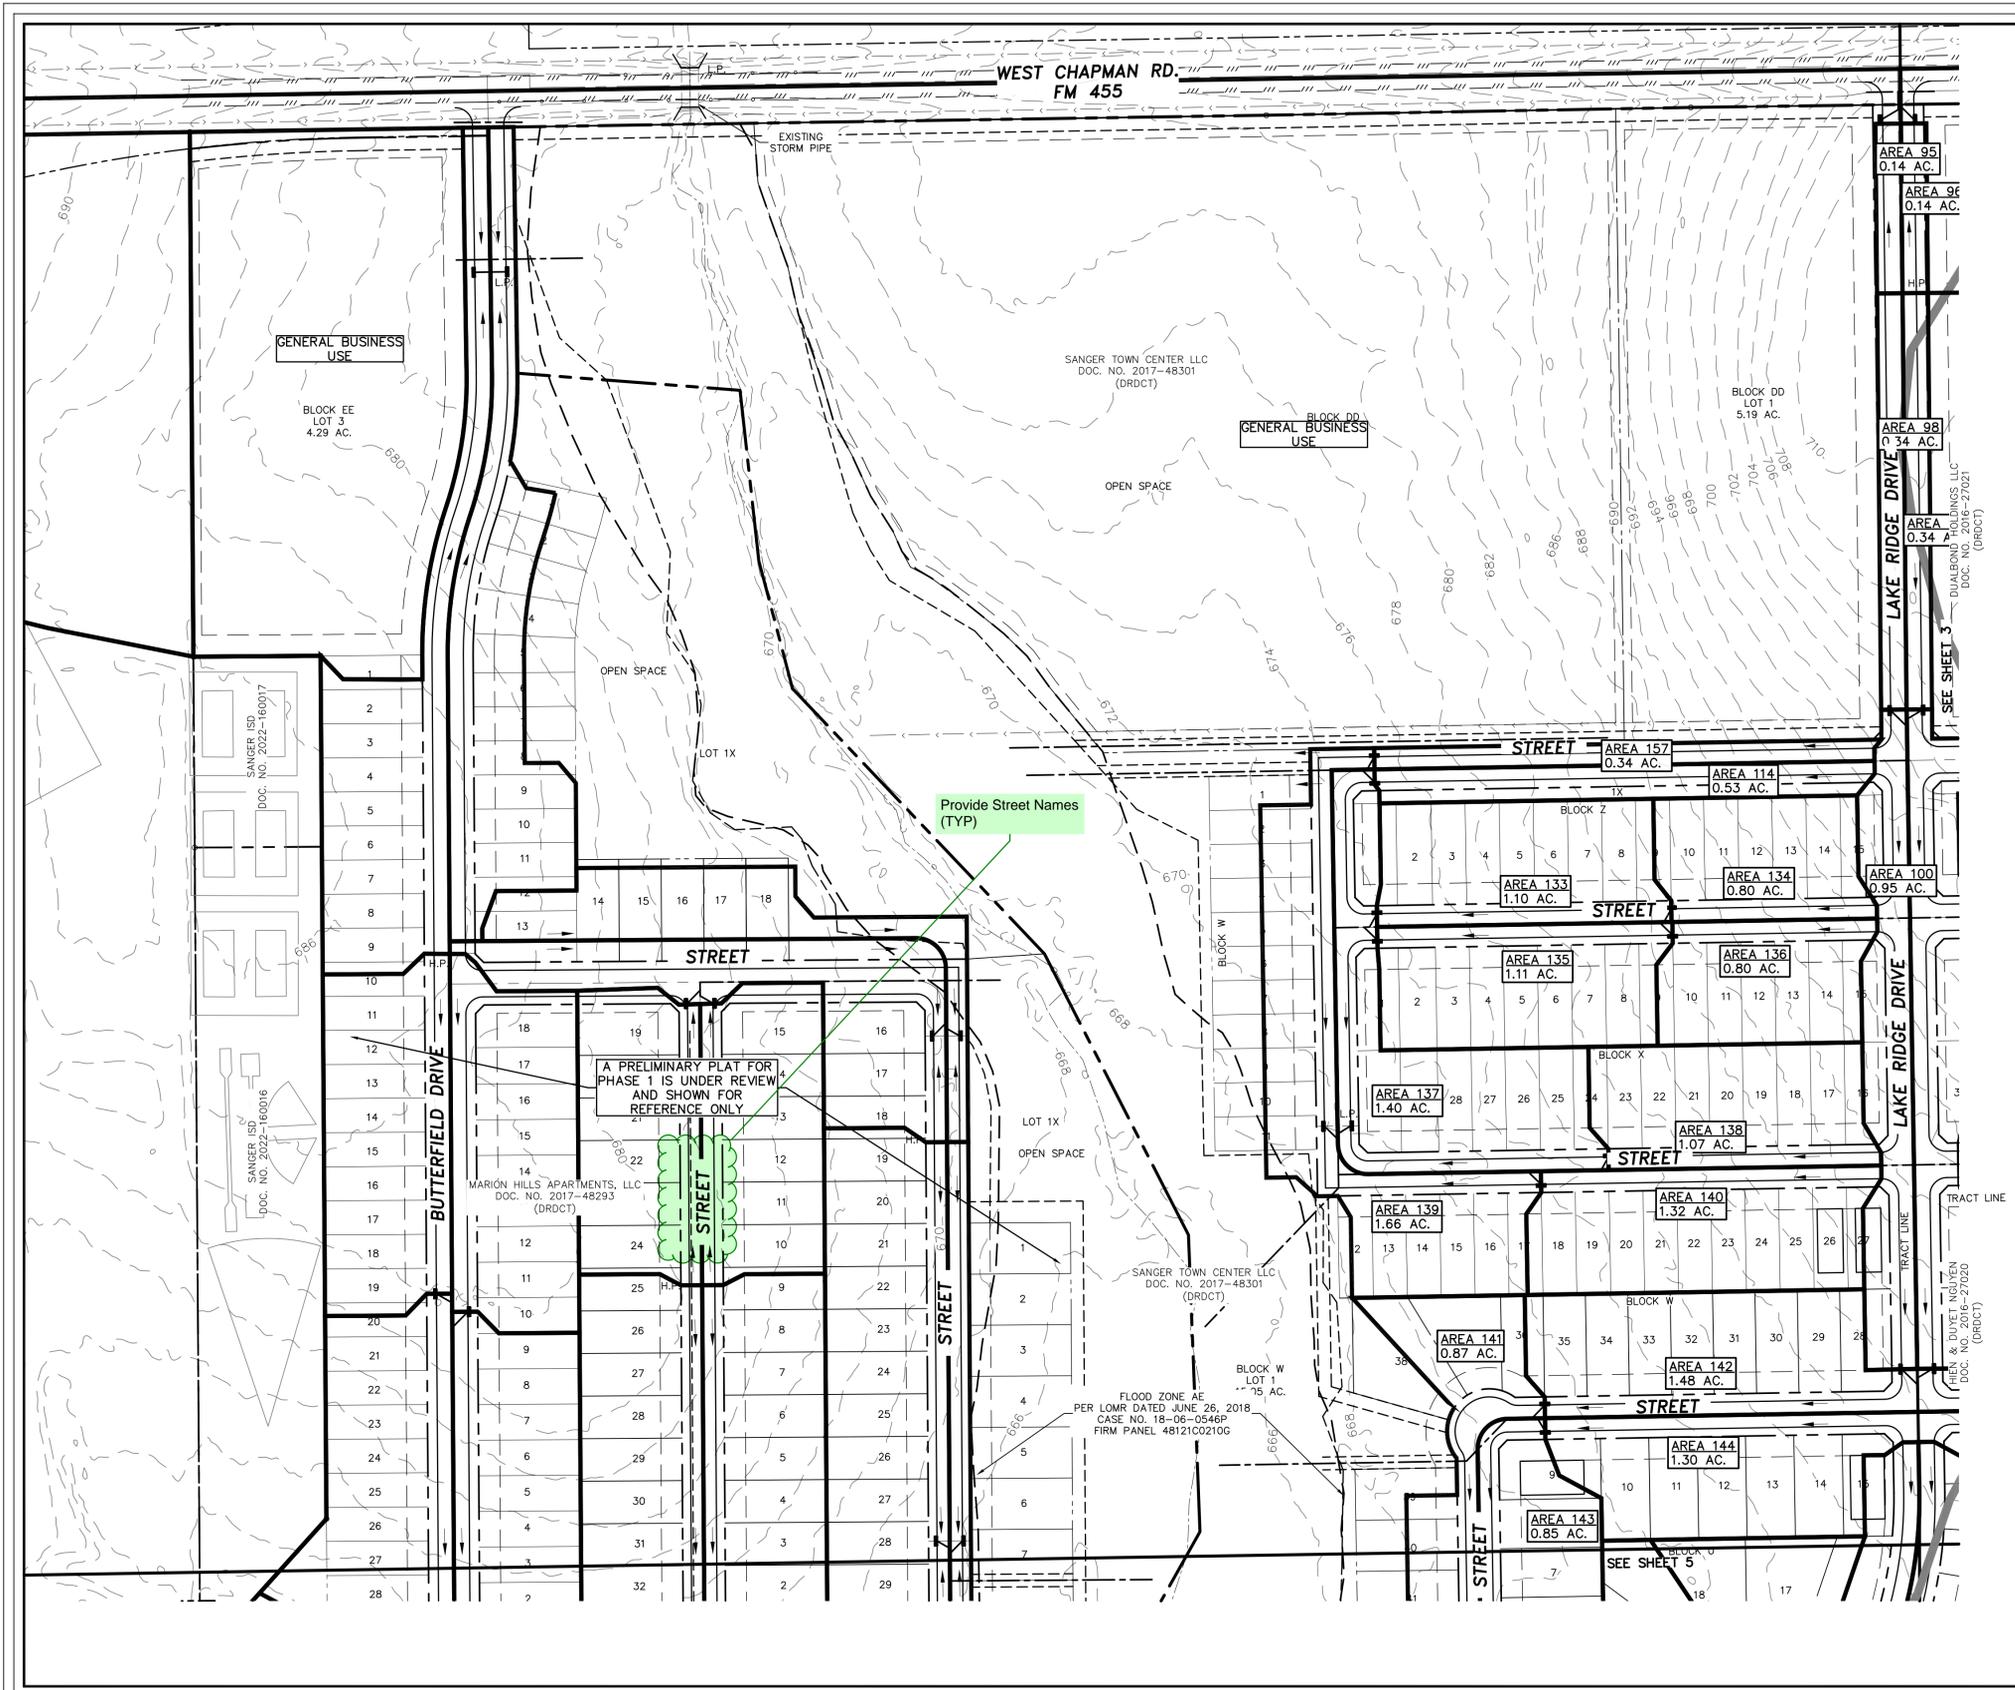

LEGEND

	PROP. STORM & PROP. STORM SEWER
	PROP. INLET
	EX. CONTOURS
	PROP. AREA DESIGNATION AREA IN ACRES
	FLOW ARROW
	DRAINAGE BOUNDARY

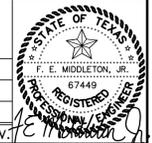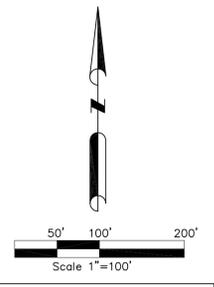

No.	DATE	REVISION	APPROV.
			<i>[Signature]</i>

5-15-24

**Middleton PROJECT ENGINEER:
& Associates, LLC.**


CONSULTING CIVIL ENGINEERS & LAND PLANNERS
 TP&E #F-10900 © Copyright 2024
 2785 ROCKBROOK DRIVE, SUITE 105
 LEWISVILLE, TEXAS 75067 (972) 393-9800

PRELIMINARY DRAINAGE PLAN
 LANE RANCH ADDITION
 813 RESIDENTIAL LOTS - 27 HOA LOTS
 3 GENERAL BUSINESS LOTS
 RUEBEN BEBEE SURVEY, ABST. NO. 29
 303.412 ACRES - 41.02 ACRES ROW
 CITY OF SANGER DENTON COUNTY TEXAS

Drawing File: 0001032PPT-STM.DWG	DATE: 5-15-24	SCALE: 1"=100'	SHEET NO.: 6
Project No. 0001032			6

MARION HILLS APARTMENTS, LLC
 DOC. NO. 2017-92008
 (DRDCT)


WINSTON GROVE
 APARTMENTS, LLC
 DOC. NO. 2018-13037
 (DRDCT)

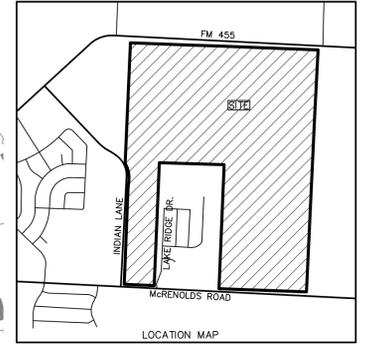

LEGEND

	Ex. Water
	Ex. Sanitary Sewer
	Prop. Sanitary Sewer
	Prop. Sewer Manhole

No.	DATE	REVISION	APPROV.

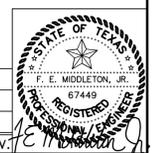

**Middleton PROJECT ENGINEER:
 & Associates, LLC.**
 CONSULTING CIVIL ENGINEERS & LAND PLANNERS
 TBP# #F-10900 © Copyright 2024
 2785 ROCKBROOK DRIVE, SUITE 105
 LEWISVILLE, TEXAS 75067 (972) 393-9800




PRELIMINARY DRAINAGE PLAN
 LANE RANCH ADDITION
 813 RESIDENTIAL LOTS - 27 HOA LOTS
 3 GENERAL BUSINESS LOTS
 RUEBEN BEBEE SURVEY, ABST. NO. 29
 303.412 ACRES - 41.02 ACRES ROW
 CITY OF SANGER DENTON COUNTY TEXAS

Drawing File: 0001032PPT-STM.DWG	DATE: 5-15-24	SCALE: 1"=100'	SHEET NO: 1
Project No. 0001032			6

What happens to street drainage? are cross culverts required. Clarify

SANGER TOWN CENTER LLC
DOC. NO. 2017-48301
(DRDCT)

MARION HILLS APARTMENTS, LLC
DOC. NO. 2017-92008
(DRDCT)

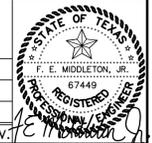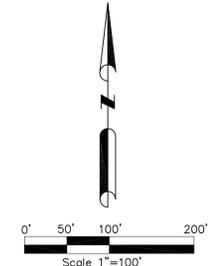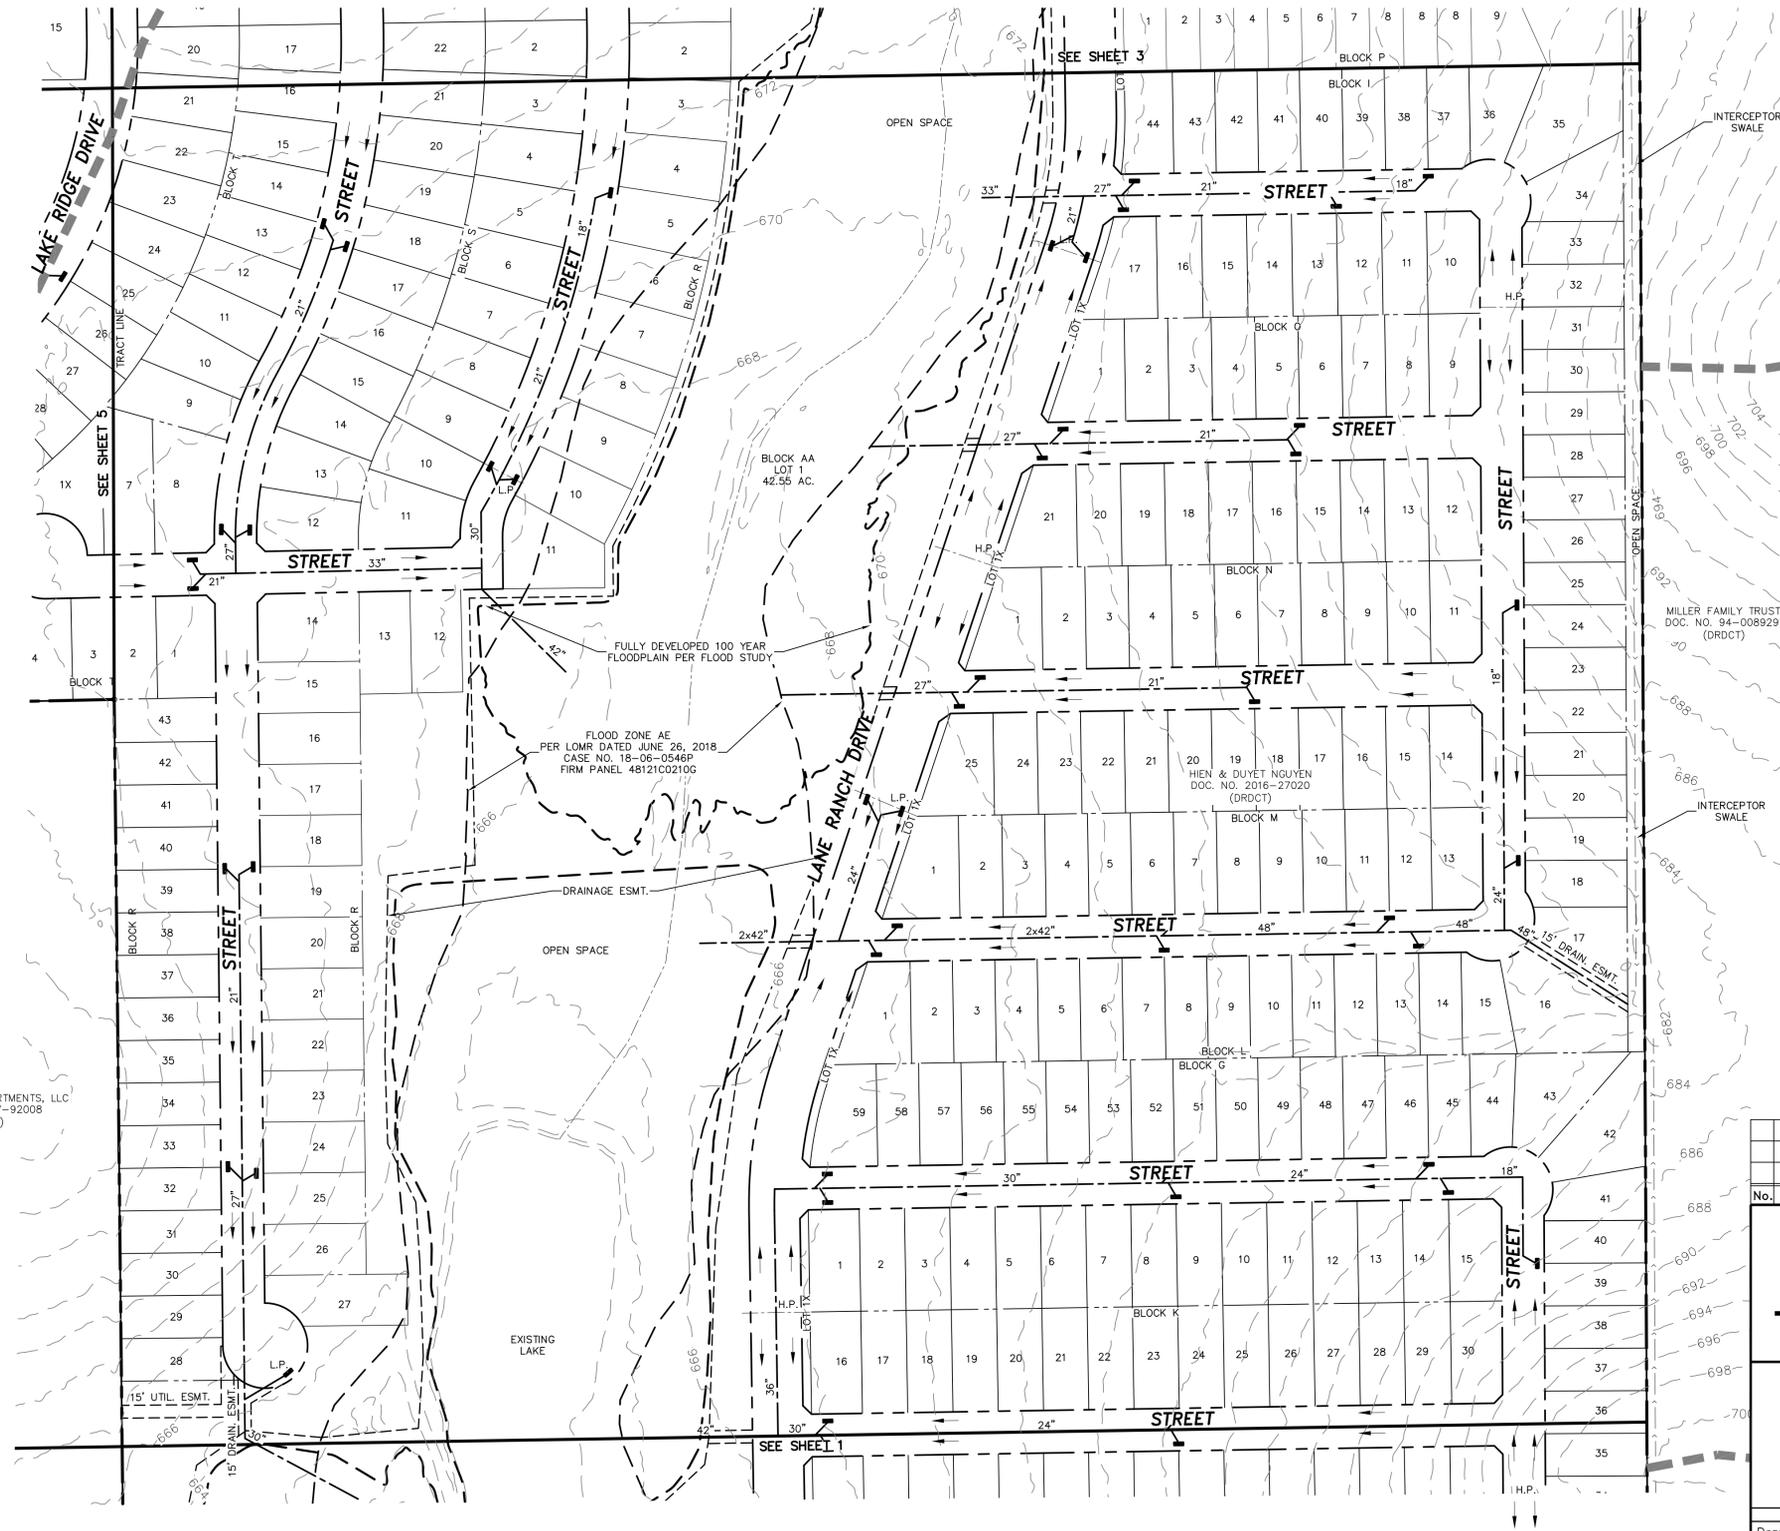


No.	DATE	REVISION	APPROV.

**Middleton PROJECT ENGINEER:
& Associates, LLC.**
CONSULTING CIVIL ENGINEERS & LAND PLANNERS
TBP# #F-10900 © Copyright 2024
2785 ROCKBROOK DRIVE, SUITE 105
LEWISVILLE, TEXAS 75067 (972) 393-9800

PRELIMINARY DRAINAGE PLAN
LANE RANCH ADDITION
813 RESIDENTIAL LOTS - 27 HOA LOTS
3 GENERAL BUSINESS LOTS
RUBEN BEBEE SURVEY, ABST. NO. 29
303.412 ACRES - 41.02 ACRES ROW
CITY OF SANGER DENTON COUNTY TEXAS

Drawing File: 0001032PPT-STM.DWG	DATE: 5-15-24	SCALE: 1"=100'	SHEET NO.: 2
Project No. 0001032			6

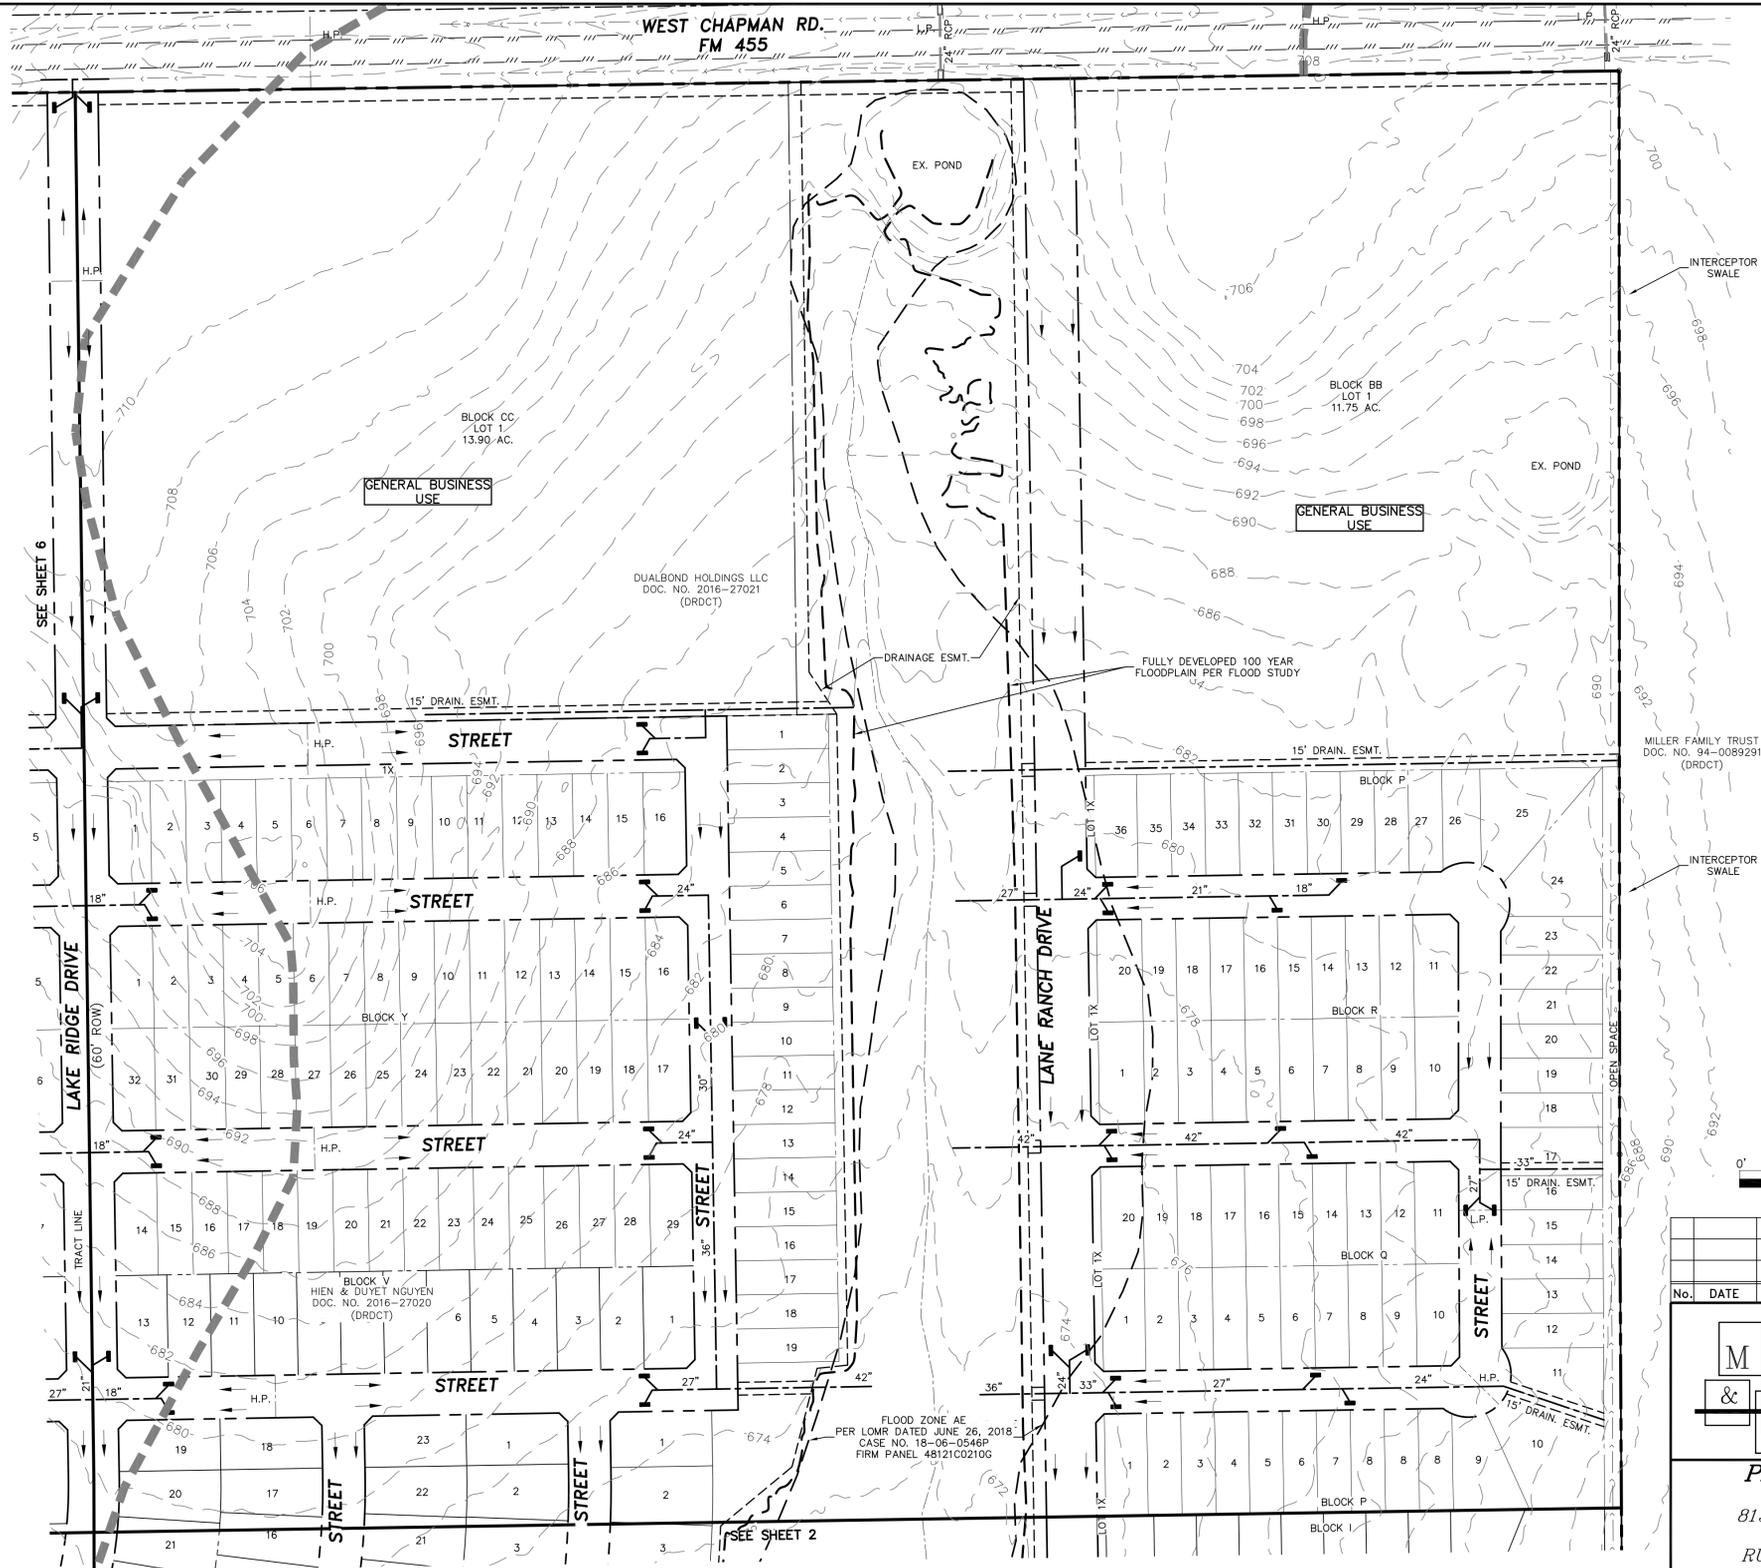

SANGER TOWN CENTER LLC
 DOC. NO. 2017-48301
 (DRDCT)

WEST CHAPMAN RD.
 FM 455

BLOCK CC
 LOT 1
 13.90 AC.


BLOCK BB
 LOT 1
 11.75 AC.

DUALBOND HOLDINGS LLC
 DOC. NO. 2016-27021
 (DRDCT)


MILLER FAMILY TRUST
 DOC. NO. 94-0089291
 (DRDCT)

BLOCK V
 HIEN & DUYET NGUYEN
 DOC. NO. 2016-27020
 (DRDCT)

FLOOD ZONE AE
 PER LOMR DATED JUNE 26, 2018
 CASE NO. 18-06-0546P
 FIRM PANEL 48121C0210G

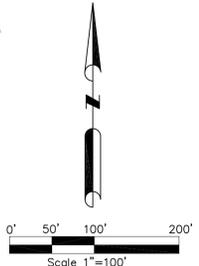

No.	DATE	REVISION	APPROV.


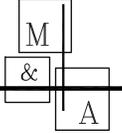


**Middleton PROJECT ENGINEER:
 & Associates, LLC.**

CONSULTING CIVIL ENGINEERS & LAND PLANNERS
 TBP# 10900 © Copyright 2024
 2785 ROCKBROOK DRIVE, SUITE 105
 LEWISVILLE, TEXAS 75067 (972) 393-9800

PRELIMINARY DRAINAGE PLAN
 LANE RANCH ADDITION
 813 RESIDENTIAL LOTS - 27 HOA LOTS
 3 GENERAL BUSINESS LOTS
 RUEBEN BEBEE SURVEY, ABST. NO. 29
 303.412 ACRES - 41.02 ACRES ROW
 CITY OF SANGER DENTON COUNTY TEXAS

Drawing File: 0001032PPT-STM.DWG	DATE: 5-15-24	SCALE: 1"=100'	SHEET NO.: 3
Project No. 0001032	5-15-24	1"=100'	6

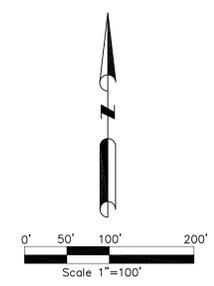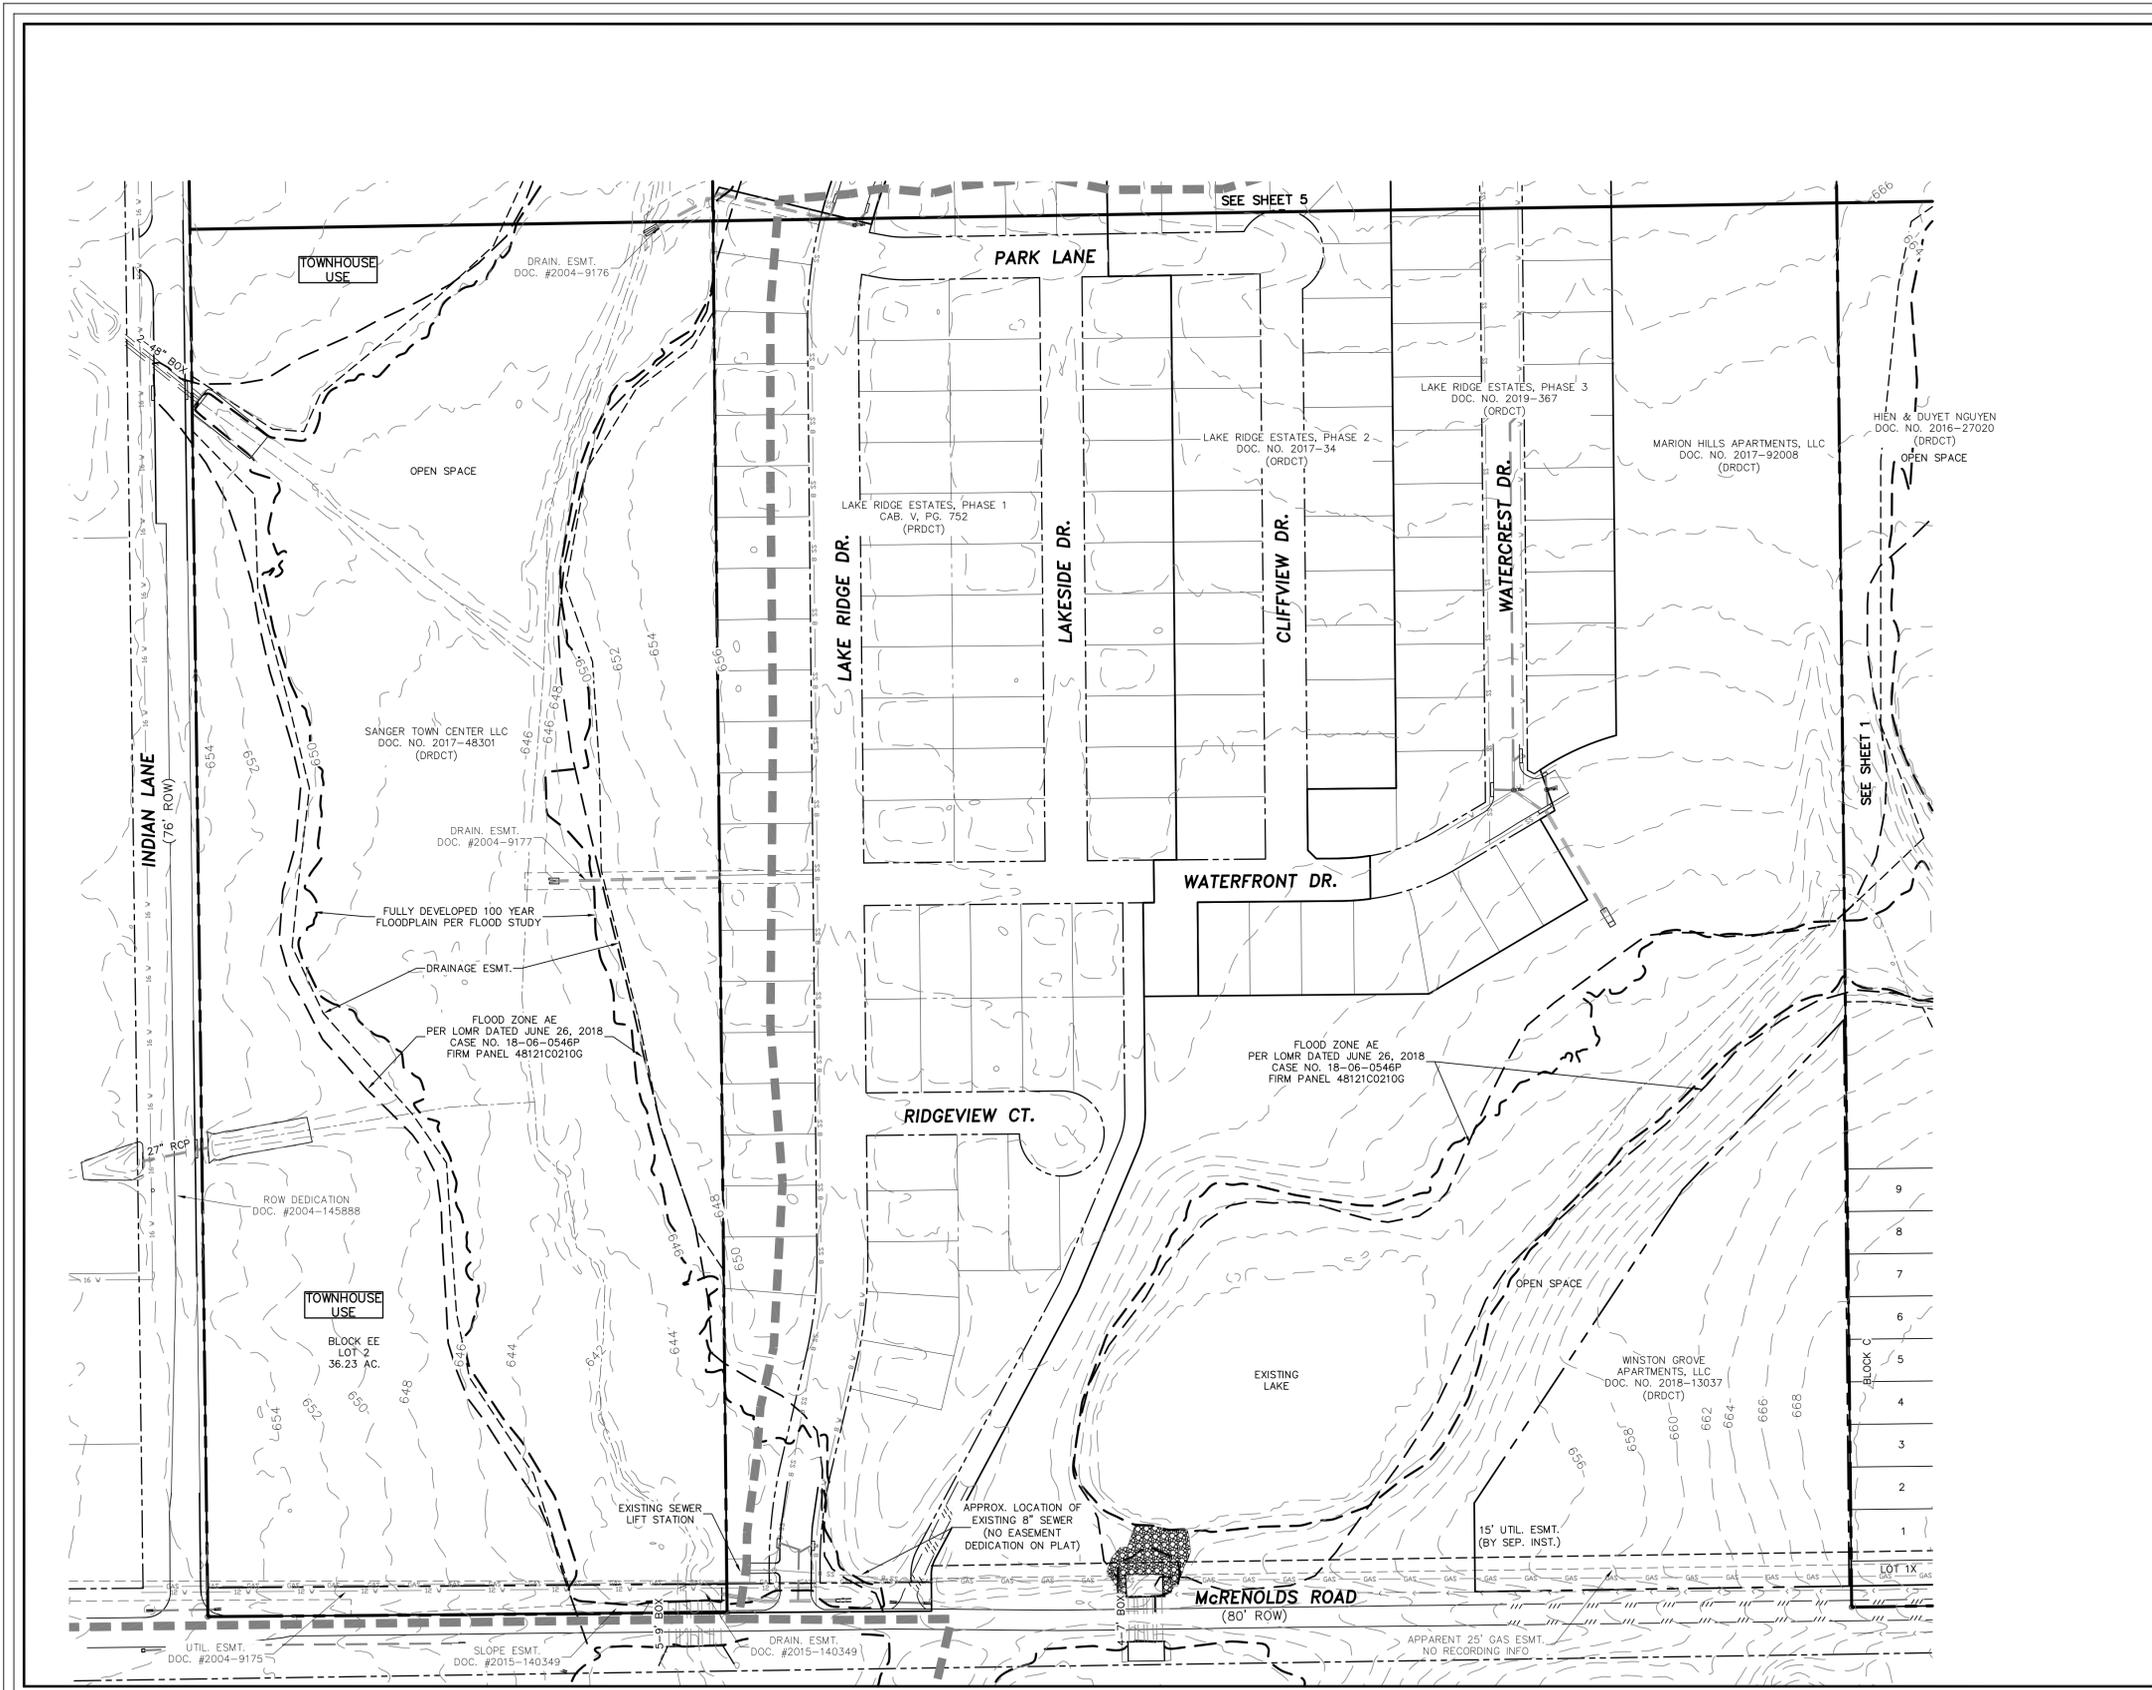


No.	DATE	REVISION	APPROV.



**Middleton PROJECT ENGINEER:
& Associates, LLC.**
 CONSULTING CIVIL ENGINEERS & LAND PLANNERS
 TEP# 10900 © Copyright 2024
 2785 ROCKBROOK DRIVE, SUITE 105
 LEWISVILLE, TEXAS 75067 (972) 393-9800

PRELIMINARY DRAINAGE PLAN
 LANE RANCH ADDITION
 813 RESIDENTIAL LOTS - 27 HOA LOTS
 3 GENERAL BUSINESS LOTS
 RUEBEN BEBEE SURVEY, ABST. NO. 29
 303.412 ACRES - 41.02 ACRES ROW
 CITY OF SANGER DENTON COUNTY TEXAS

Drawing File: 0001032PPT-STM.DWG	DATE: 5-15-24	SCALE: 1"=100'	SHEET NO: 4
Project No. 0001032			6

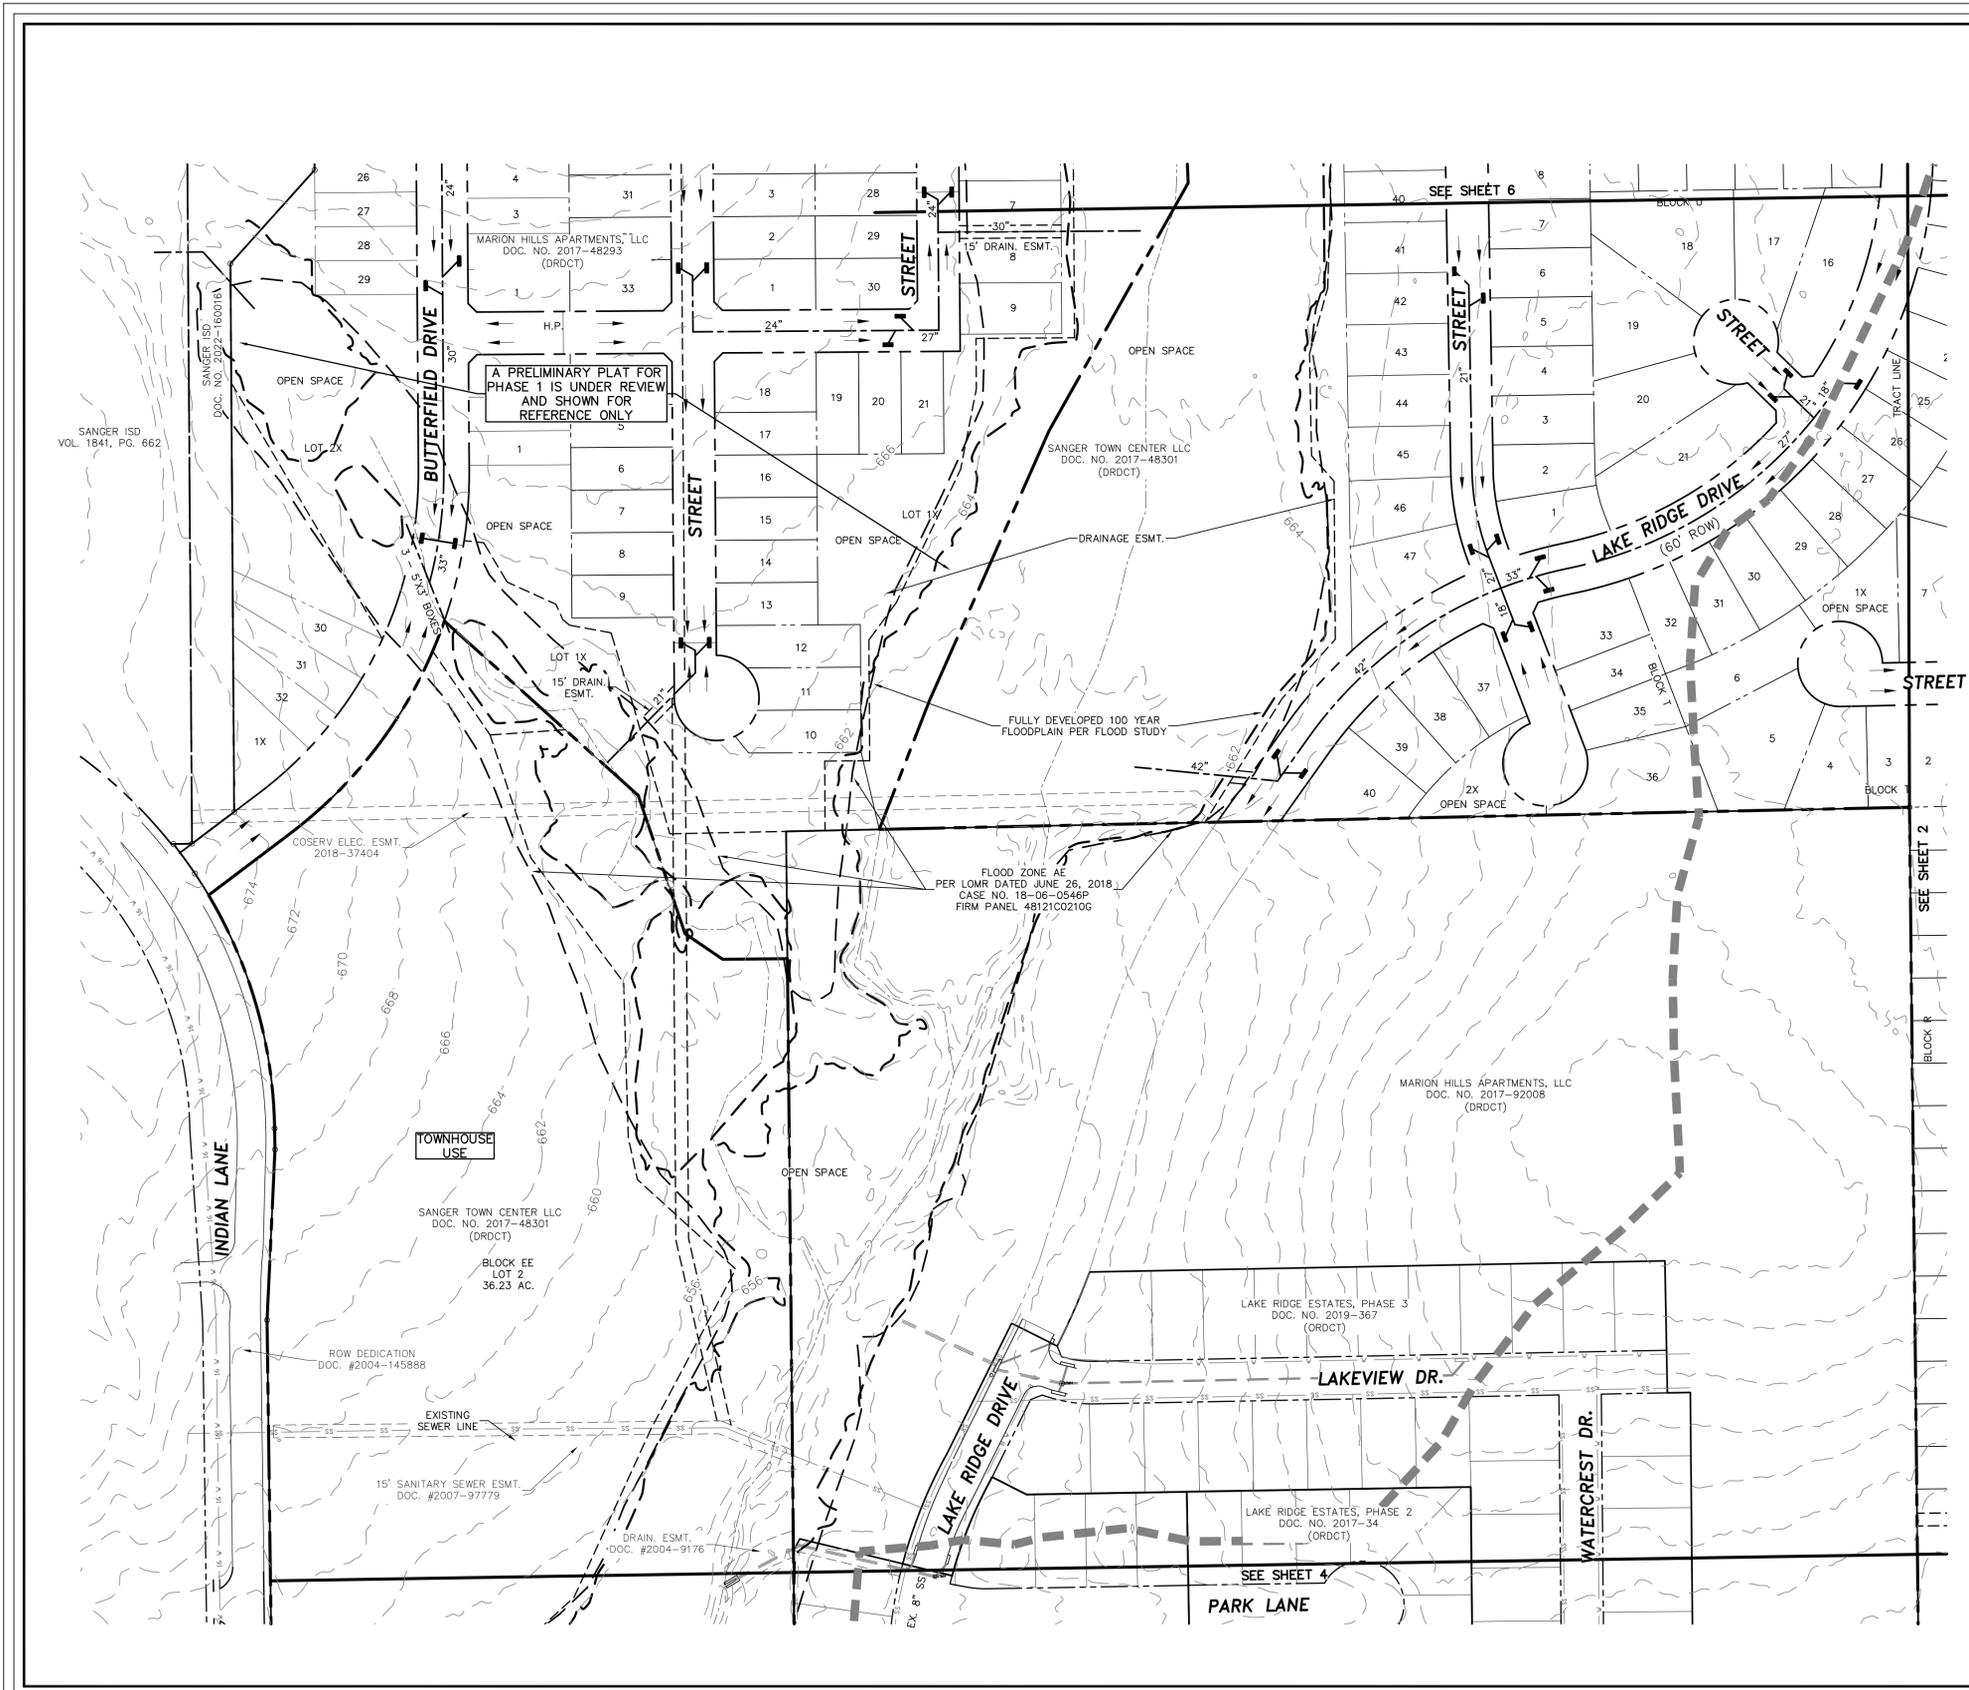

HIEN & DUYET NGUYEN
 DOC. NO. 2016-27020
 (DRDCT)

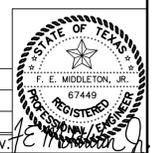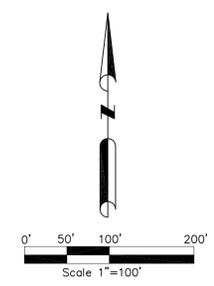


No.	DATE	REVISION	APPROV.

**Middleton PROJECT ENGINEER:
 & Associates, LLC.**
 CONSULTING CIVIL ENGINEERS & LAND PLANNERS
 TBP# #10900 © Copyright 2024
 2785 ROCKBROOK DRIVE, SUITE 105
 LEWISVILLE, TEXAS 75067 (972) 393-9800

PRELIMINARY DRAINAGE PLAN
 LANE RANCH ADDITION
 813 RESIDENTIAL LOTS - 27 HOA LOTS
 3 GENERAL BUSINESS LOTS
 RUEBEN BEBEE SURVEY, ABST. NO. 29
 303.412 ACRES - 41.02 ACRES ROW
 CITY OF SANGER DENTON COUNTY TEXAS

Drawing File: 0001032PPT-STM.DWG	DATE: 5-15-24	SCALE: 1"=100'	SHEET NO.: 5
Project No. 0001032			6

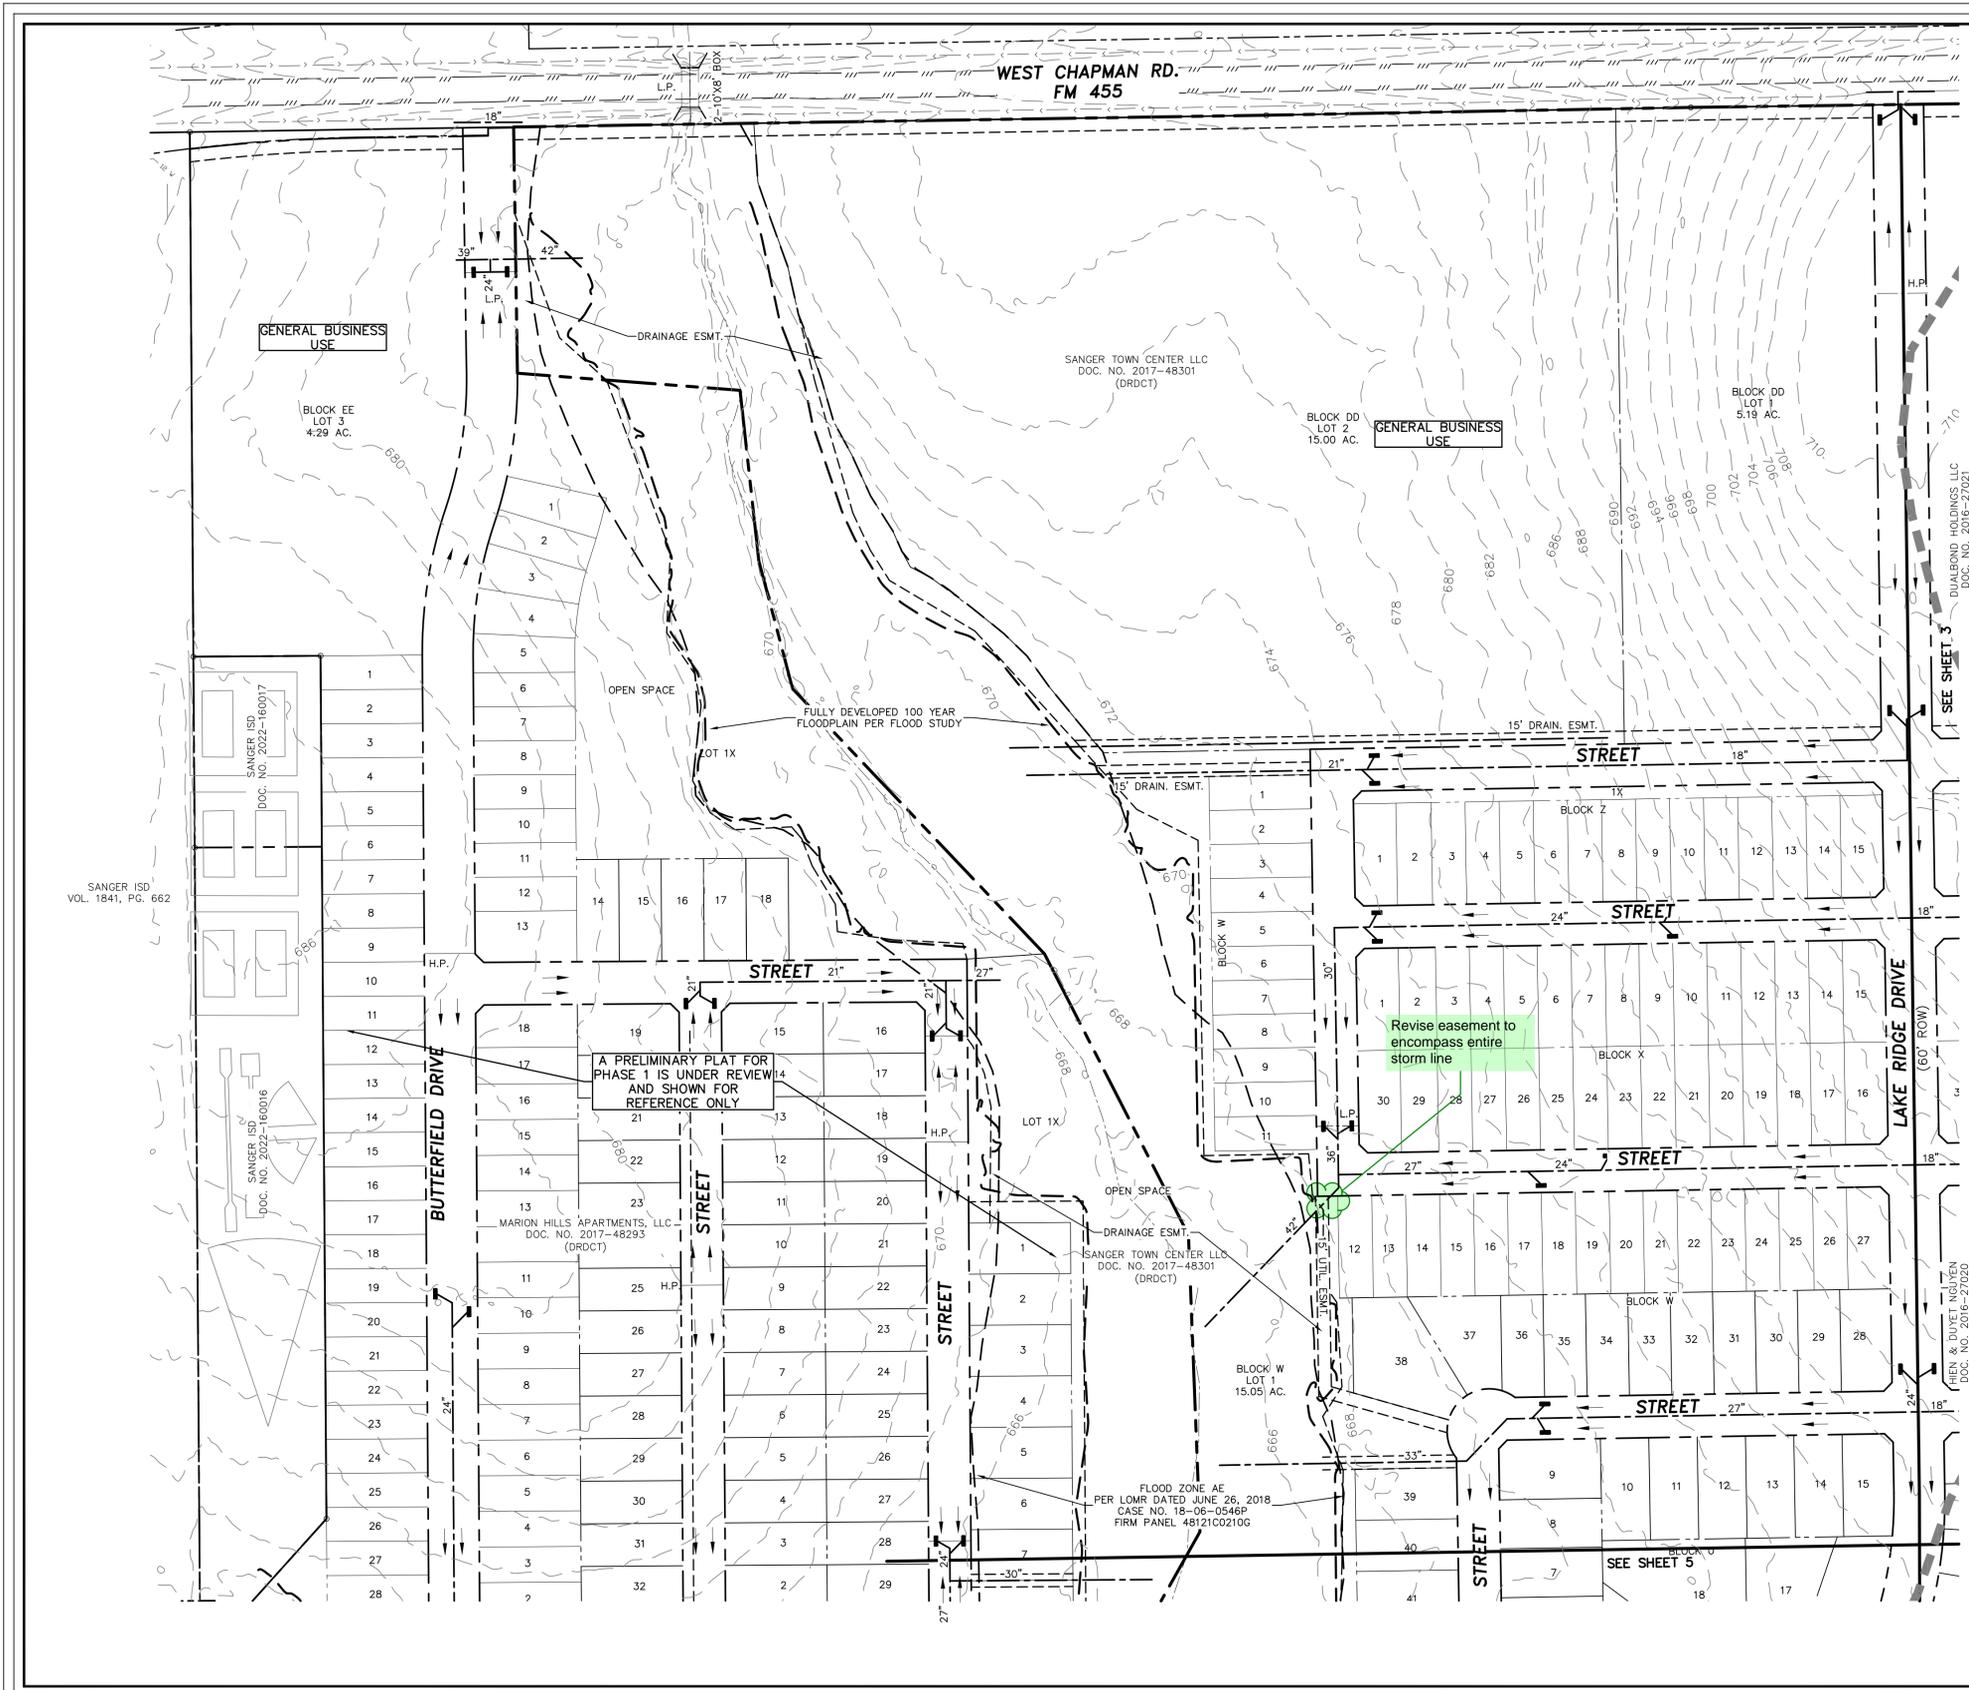

SANGER ISD
VOL. 1841, PG. 662

GENERAL BUSINESS
USE

BLOCK EE
LOT 3
4.29 AC.

WEST CHAPMAN RD.
FM 455

SANGER TOWN CENTER LLC
DOC. NO. 2017-48301
(DRDCT)

BLOCK DD
LOT 2
15.00 AC.

GENERAL BUSINESS
USE

BLOCK DD
LOT 1
5.18 AC.

DUALBOND HOLDINGS, LLC
DOC. NO. 2016-27021
(DRDCT)

SEE SHEET 3



A PRELIMINARY PLAT FOR
PHASE 1 IS UNDER REVIEW
AND SHOWN FOR
REFERENCE ONLY

Revise easement to
encompass entire
storm line


SANGER TOWN CENTER LLC
DOC. NO. 2017-48301
(DRDCT)

FLOOD ZONE AE
PER LOMR DATED JUNE 26, 2018
CASE NO. 18-06-0546P
FIRM PANEL 48121C0210G

DOC. NO. 2016-27020
(DRDCT)

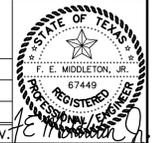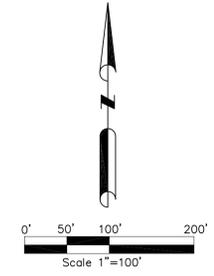

No.	DATE	REVISION	APPROV.
			5-15-24

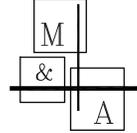

**Middleton PROJECT ENGINEER:
& Associates, LLC.**

CONSULTING CIVIL ENGINEERS & LAND PLANNERS
TBP# #F-10900 © Copyright 2024
2785 ROCKBROOK DRIVE, SUITE 105
LEWISVILLE, TEXAS 75067 (972) 393-9800

PRELIMINARY DRAINAGE PLAN
LANE RANCH ADDITION
813 RESIDENTIAL LOTS - 27 HOA LOTS
3 GENERAL BUSINESS LOTS
RUBEN BEBEE SURVEY, ABST. NO. 29
303.412 ACRES - 41.02 ACRES ROW
CITY OF SANGER DENTON COUNTY TEXAS

Drawing File: 0001032PPT-STM.DWG	DATE: 5-15-24	SCALE: 1"=100'	SHEET NO.: 6
Project No. 0001032			6