

City of Stevenson

Carolyn Sourek, Public Work Director

Phone (509)427-5970 FAX (509) 427-8202 7121 E Loop Road, PO Box 371 Stevenson, Washington 98648

To: City Council

From: Carolyn Sourek, Public Work Director

RE: 725 NW Angel Heights Road Meeting Date: March 16, 2023

Executive Summary:

The owners of parcel 03073633011900, Derek and Glenna Girtle, have requested a Type D Right Of Way permit to allow them to retain a rock wall construction within the City of Stevenson Right of Way (ROW) at 725 Angel Heights Road.

Overview of Items:

Figure 1 is a cross section of Angel Heights Road, near at the subject parcel, looking south. Angel Heights Road is currently classified as a Local Street, defined in Stevenson Engineering Standards (SES) under Volume 1, Chapter 2.00(D) as "designed specifically to have high accessibility and to connect collector and arterial roads, and are typically not used for through traffic."

Figure 1 – Angel Heights Road Looking South

Per Table 2.03A of the SES Volume 1, local streets should have a total ROW width of 50 ft, with 28 ft of pavement, including (2) 10 ft drive lanes, and (1) 8 ft parking lane. Additionally, within the ROW should be (1) 6 ft minimum sidewalk, and (1) 3 ft wide planter strip.

The subject parcel is located at the end of Angel Heights Road, the wall being within the cul-de-sac bulb section of the roadway. The ROW designated at the cul-de-sac bulb is circular, with a 50 ft radius, while

the street (with sidewalk) is constructed as a 47 ft radius, leaving an additional 3 ft of ROW from the back of sidewalk.

The straight section of Angel Heights Road at the subject parcel ROW is 60 ft, with (2) drive lanes and parking available on one of the street. Additionally, sidewalks are provided on both sides of the street. The straight segment of street (with sidewalk) is constructed as 44 ft wide, leaving an additional 8 ft of ROW from the back of sidewalk.

Figure 2 – 725 Angel Heights Rock Wall Looking East




Figure 3 – 725 Angel Heights Rock Wall Looking South



Figures 2 and 3 are photos taken of the rock wall along the subject parcel. Note the rock wall was built to the edge of sidewalk.

The parcel's sewer cleanout was installed within the ROW in the cul-de-sac section of the parcel frontage. Given the nature of the wall, the City would like to have the owner install a concrete collar as provided in City of Stevenson Standard Detail S-3.1 in Figure 4.

Figure 4 - Sewer Cleanout Concrete Collar Detail

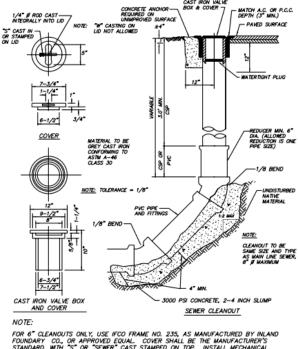

The wall drain was installed under the existing sidewalk, as shown in Figure 5 below. This item of work would typically have required a ROW permit as well. Per 12.02.060(B)(2), street restoration share require the permittee to return the public right-of-way to its original or better condition immediately upon completion of the project. The City would like to have the owner replace the concrete sidewalk panel as required per code and to City of Stevenson Engineering Standards.

Attachment 1 is a copy of Utility Plans for the Subdivision. Attachment 2 is a copy of Subdivision Survey Plans. Attachment 3 is a copy of the submitted permit application.

FOR 6" CLEANOUTS ONLY, USE IFCO FRAME NO. 235, AS MANUFACTURED BY INLAND FOUNDARY CO., OR APPROVED EQUAL. COVER SHALL BE THE MANUFACTURER'S STANDARD, WITH "S" OR "SEWER" CAST STAMPED ON TOP. INSTALL MECHANICAL PLUGS ON ALL CLEANOUTS.

STANDARD SEWER CLEANOUT


Figure 5 - Sidewalk Cut for Wall Drain



Chapter 12.02.060 of the Stevenson City Code establishes this type of ROW use permit as a Type D -Long-Term and Permanent Uses by Agreement and Approval by Council, as the rock wall is a "structure" that will likely have a useful life exceeding five years [12.02.060(D)(2)(a)], as well as would likely cost over one hundred dollars to remove [12.02.060(D)(2)(b)].

Action Needed:


Approve City of Stevenson Type D Right of Way Permit for 725 Angel Heights rock wall to remain within City ROW, conditional upon the installation of a protective concrete collar around the sewer cleanout and replacement of sidewalk panel with wall drain, and removable at parcel owner's expense if issues with any city infrastructure is observed.

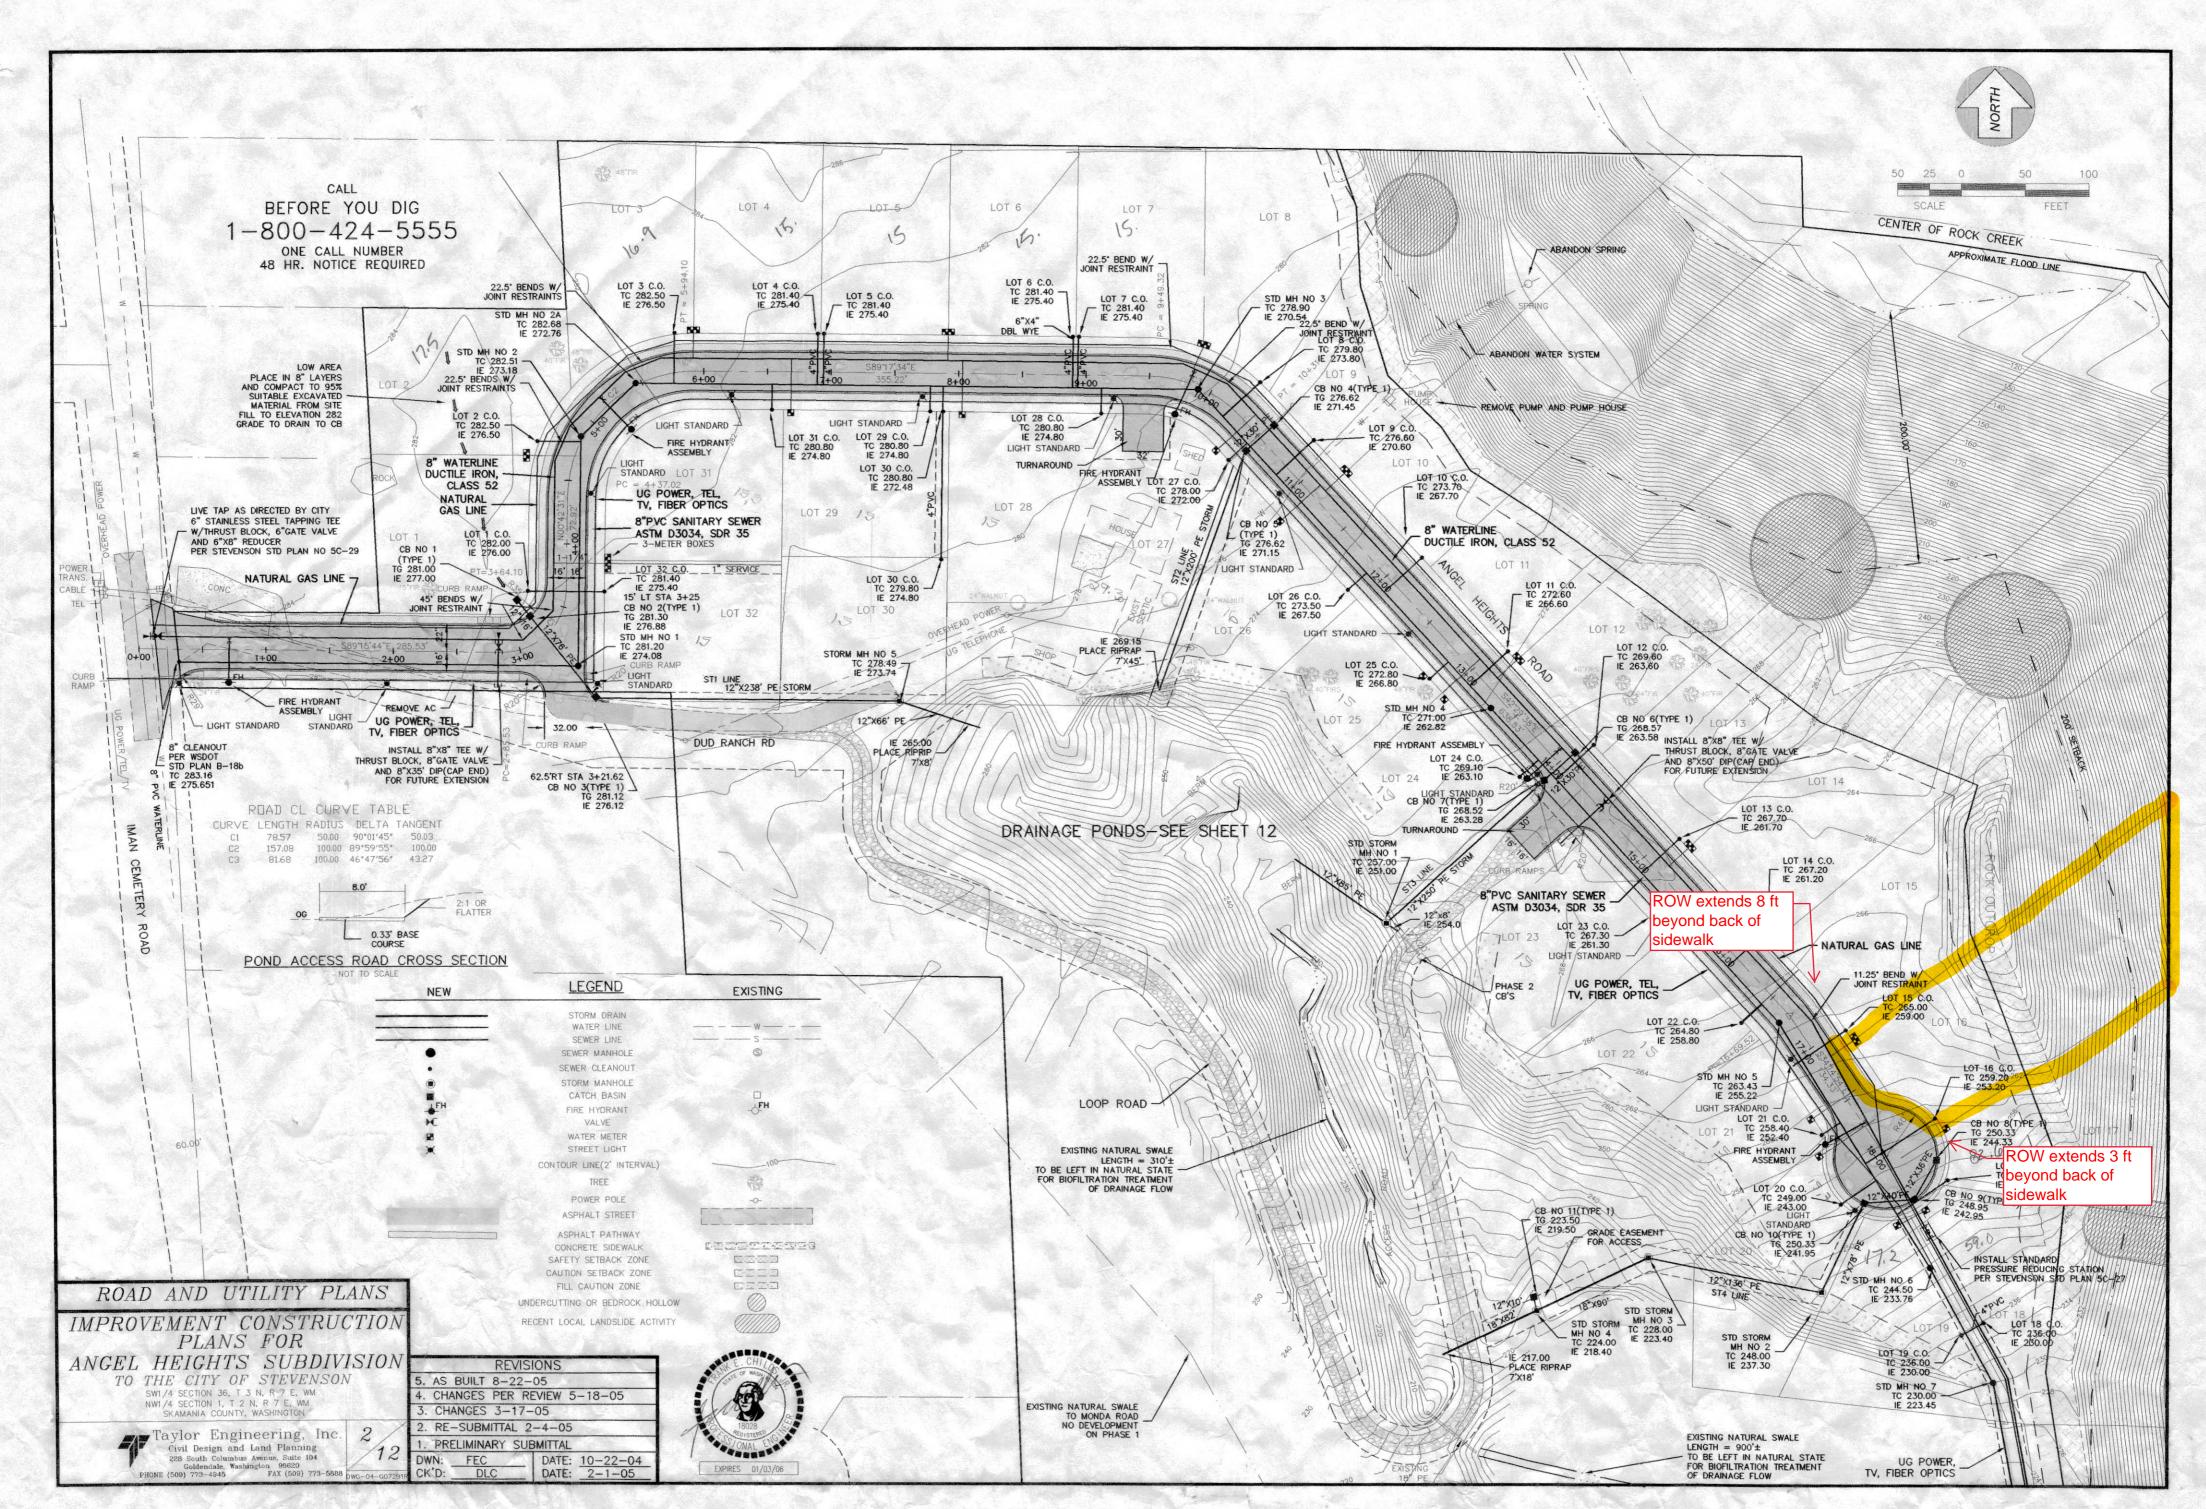

5-321

ANGEL HEIGHTS SUBDIVISION-PHASE 1

SW1/4 OF SECTION 36, T 3 N, R 7 E, WM CITY OF STEVENSON, SKAMANIA CO, WA

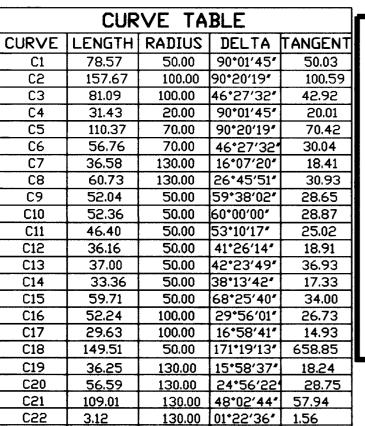

LINE TABLE

LENGTH

17.98

33.62

15.74

9.60

20.47

43.55

17.00

59.21

68.28

54.45

185.96

269.29

294.16

46.50

147.48

148.87

152.66

C23

LINE

L1

L2

L3

14

L5

L6

L7

L8

L9

L10

L11

L12

L13

L14

L15

L16

L17

8.11

130.00 | 03°34′21″ | 4.05

BEARING

S00°47′19″W

N88°57′10°W

S42°29'38"E

S42°29'38'E

S42°29'38'E

S89°16′56°E

\$42°29'38"E

S41°29'33"E

N79°43′16″W

N67°43'09"W

N20°48'26"W

S12°07'40"E

N34°14′54"W

\$28*52'11'E S10°36′58″E

S16°38'08"E

N00°42'31"E

٦,	
	MATCH LINE (SEE SHEET 2) 15' DRAINAGE EASEMENT TO FOLLOW NATURAL AND PATHWAY SWALE SWALE
	EASEMENT (SEE NOTE 8)
	CATHOLIC CHURCH OF CHILD NO A ST. OF CREEK DRIVE S. ROCK CREEK DRIVE
	DETAIL A 1" = 100'



NOTES

- 1. CONSTRUCTION OF BUILDINGS OR SITE DISTURBING ACTIVITIES WITHIN THE SAFETY SETBACK ZONE, CAUTION SETBACK ZONE AND FILL CAUTION ZONE AS SHOWN ON LOTS 8 THROUGH 27 ARE SUBJECT TO CERTAIN GEOTECHNICAL REQUIREMENTS. FOR SAID REQUIREMENTS SEE THE REPORT BY BELL DESIGN. COMPANY AS RECORDED IN BOOK ____ PAGE ____ AFN 2005/58976 RECORDS OF SKAMANIA COUNTY, WASHINGTON
- 2. ALL EASEMENTS ARE PUBLIC UNLESS OTHERWISE NOTED, EXCEPT DRAINAGE EASEMENTS WHICH ARE CITY ONLY.
- 3. ALL EASEMENTS ARE FOR INGRESS, EGRESS AND UTILITIES
- 4. PHASE 1 INCLUDES THE FOLLOWING:
- A. LOTS 1 THROUGH 32 B. ALL DRAINAGE EASEMENTS AND ROAD EASEMENTS IN THE FUTURE TRACT
- D. THE 20' UTILITY AND PATHWAY EASEMENT THROUGH THE
- FUTURE TRACT, THE PARK AND THE PARCEL SOUTH OF THE PARK TO ROCK CREEK DRIVE.
- 5. IMAN ROCK CREEK TRACTS WAS BASED ON AN OLD FENCE LINE AND ENCROACHS INTO PARCEL 1 OF THE DUDLEY SHORT PLAT. THE OLD FENCE LINE HAS BEEN HELD FOR THIS SUBDIVISION.
- 6. ACCESS FOR LOT 30 IS VIA THE PRIVATE EASEMENT AS SHOWN ON SHEET 2.

TRACT IS GRANTED TO THE CITY OF STEVENSON OVER THE PRIVATE ROAD RIGHT OF WAY TO LOT 30 AND THE 30' PRIVATE EASEMENT.

7. ACCESS TO THE DRAINAGE AND OPEN SPACE EASEMENT ON THE FUTURE

- 8. THE UTILITY AND PATHWAY EASEMENT FROM ROCK CREEK DRIVE TO THE CUL-DE-SAC IS A PUBLIC EASEMENT TO BE MAINTAINED BY THE ANGEL HEIGHTS HOME OWNERS ASSOCIATION. ANY DISTURBANCE OR DAMAGE TO THE 10' PATHWAY DONE BY THE CITY OR UTILITY COMPANIES SHALL BE REPAIRED BY SAME.
- 9. LOT OWNERS ARE SUBJECT TO A LATECOMERS AGREEMENT FOR CONSTRUCTION OF A WATERLINE AS RECORDED UNDER NO. 2005-158705
- 10. HOMEOWNERS ASSOCIATION SHALL BE RESPONSIBLE FOR ALL REPAIRS AND MAINTENANCE OF THE STORMWATER SYSTEM(THE SYSTEM). IF THE CITY PERFORMS ANY REPAIR OR MAINTENANCE ON THE SYSTEM, THE OWNER. ASSOCIATION, AND SUCCESSION AGREE IT SHALL BE PERMITTED TO FIX A SYSTEM MAINTENANCE CHARGE TO THE HOMEOWNERS CONTRIBUTING STORM WATER TO THE SYSTEM AS PROVIDED IN RCW 35.67.190.

PHASE 1-23.53 ACRES (LOTS 1-32 AND STREET) **FUTURE TRACT-10.03 ACRES**

PARK -3.05 ACRES

<u>LEGEND</u>

ACREAGES

SET 5/8"X24" CAPPED REBAR EXISTING REBAR-FOUND AS NOTED FD EXISTING MONUMENT

RECORD BEARING AND DISTANCE

SAFETY SETBACK ZONE CAUTION SETBACK ZONE

FILL CAUTION ZONE UNDERCUTTING OR BEDROCK HOLLOW

RECENT LOCAL LANDSLIDE ACTIVITY

Skamania County Auditor's Records

CONSERVATION EASEMENT

0

(N89°19'21"W 2531.18')

REFERENCES

SURVEY 137523 SURVEY 79974 SURVEY 104740 SURVEY 107593 NICKLAUS SUBDIVISION 128569 REHAL SHORT PLAT 109019 **DUDLEY SHORT PLAT 133529** HAZEL SHORT PLAT 137578 IMAN ROCK CREEK TRACTS

BASIS OF BEARINGS

MONUMENTS VISITED OCTOBER, 2004

SURVEY 137523

LEGAL DESCRIPTION TOTAL PARCEL

PARCEL 1. DUDLEY SHORT PLAT NO 133529 REMAINDER OF REHAL SHORT PLAT NO 109019 LESS HAZEL SHORT PLAT AND LESS CATHOLIC CHURCH IN THE NW1/4 OF SECTION 1, T 2 N, R 7 E, WM AND IN THE SWI/4 OF SECTION 36, T 3 N, R 7 E, WM

Skamania County Auditor's Records

Declaration of Conditions, Covenants, Conservation Easement Recorded in Book ______, Page ______, AFN 2005/58874 Book ______, Page ______, AFN 2005/58875 SHEET 1 OF 2

DEDICATION

We, Owners of the described tract of land, hereby declare and certify this Plat to be true and correct to the best of our abilities, and that this subdivision has been made with our free consent and in accordance with our desires. Further, we hereby dedicate Angel Heights Road to the use of the public forever and waive all claims for damages against any governmental agency arising from the construction and maintenance of said road.

ANSEL HEIGHTS LLC, 64BETT ER WORLD
Owner ACRUSITIONS LLC 84 Mini Morissette

This is to certify that on the ______ day of _______ Before me personally appeared: MIMI MOVISSETIC To me known to be the individuals described in and who executed the foregoing instrument and acknowledged to me that they signed the same as their free and voluntary act for the use and purpose set forth herein

Notary Public in and for the State of Washington Residing at

This is to certify that on the ___

Before me personally appeared: To me known to be the individuals described in and who executed the foregoing instrument and acknowledged to me that they signed the same as their free and voluntary act for the use and purpose set forth herein

Notary Public in and for the State of Washington Residing at

hereby certify that the city road abutting the proposed subdivision is of sufficient width to meet current city standards without requiring additional right of way and that road right of ways upon or abutting the proposed subdivision are of sufficient width to assure maintenance and to permit future utility installations. I further certify that the proposed roads meet current city standards and that city water and sewer services are

available to the proposed subdivision 9-27-05 Public Works Directo

I hereby certify that the taxes and assessments have been duly paid discharged or satisfied in regard to the lan proposed subdivision

638010000 638010000 9.28.05

This subdivision conforms with City requirements and is approved subject to day special conditions inscribed hereon and to recording in the Stamania County Auditor's office.

9-27-05

Frank E. Childs, Jr. registered as a land surveyor by the State of Washington, certify that this plat is based on an actual survey of the land described herein, conducted by me or under my supervision during the period of October, 2004 through September, 2005; that the distances, courses, and angles are shown thereon correctly; and that monuments other than those approved for setting at a later date, have been set and lot corners staked on the ground as depicted on the plat.

Dated this 15th day of September ,2005

Licensed Land Surveyor

PLS NO.18028

STATE OF WASHINGTON) COUNTY OF SKAMANIA


EXPIRES 01/03/06

l_hei	reby certify t	hat the within	instrument of	writing filed	pà.
BeH	er, World	Acquistion	L	at 1:00	∠ M on
(:J	9/28 10: DI als	hat the within 2005, w at Page	as recorded in	200k	2872
	Sea fu	nania County,	u l		
Reco	order of Skor	nania County,	Wishington		
1:	Michae	l Sarvis	ion by	PLOU	m
Cour	ity Auditor				


ANGEL HEIGHTS SUBDIVISION-PHASE 1

TO THE CITY OF STEVENSON


SW1/4 SECTION 36, T 3 N, R 7 E, WM SKAMANIA COUNTY, WASHINGTON

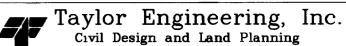


228 South Columbus Avenue, Suite 104 Goldendale, Washington 98620 PHONE (509) 773-4945 FAX (509) 773-5888 JOB NO 04-G072P2

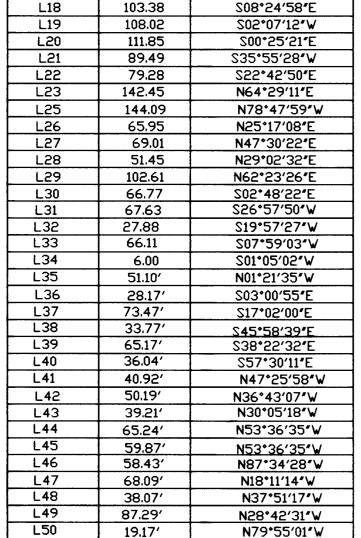

2005/58873

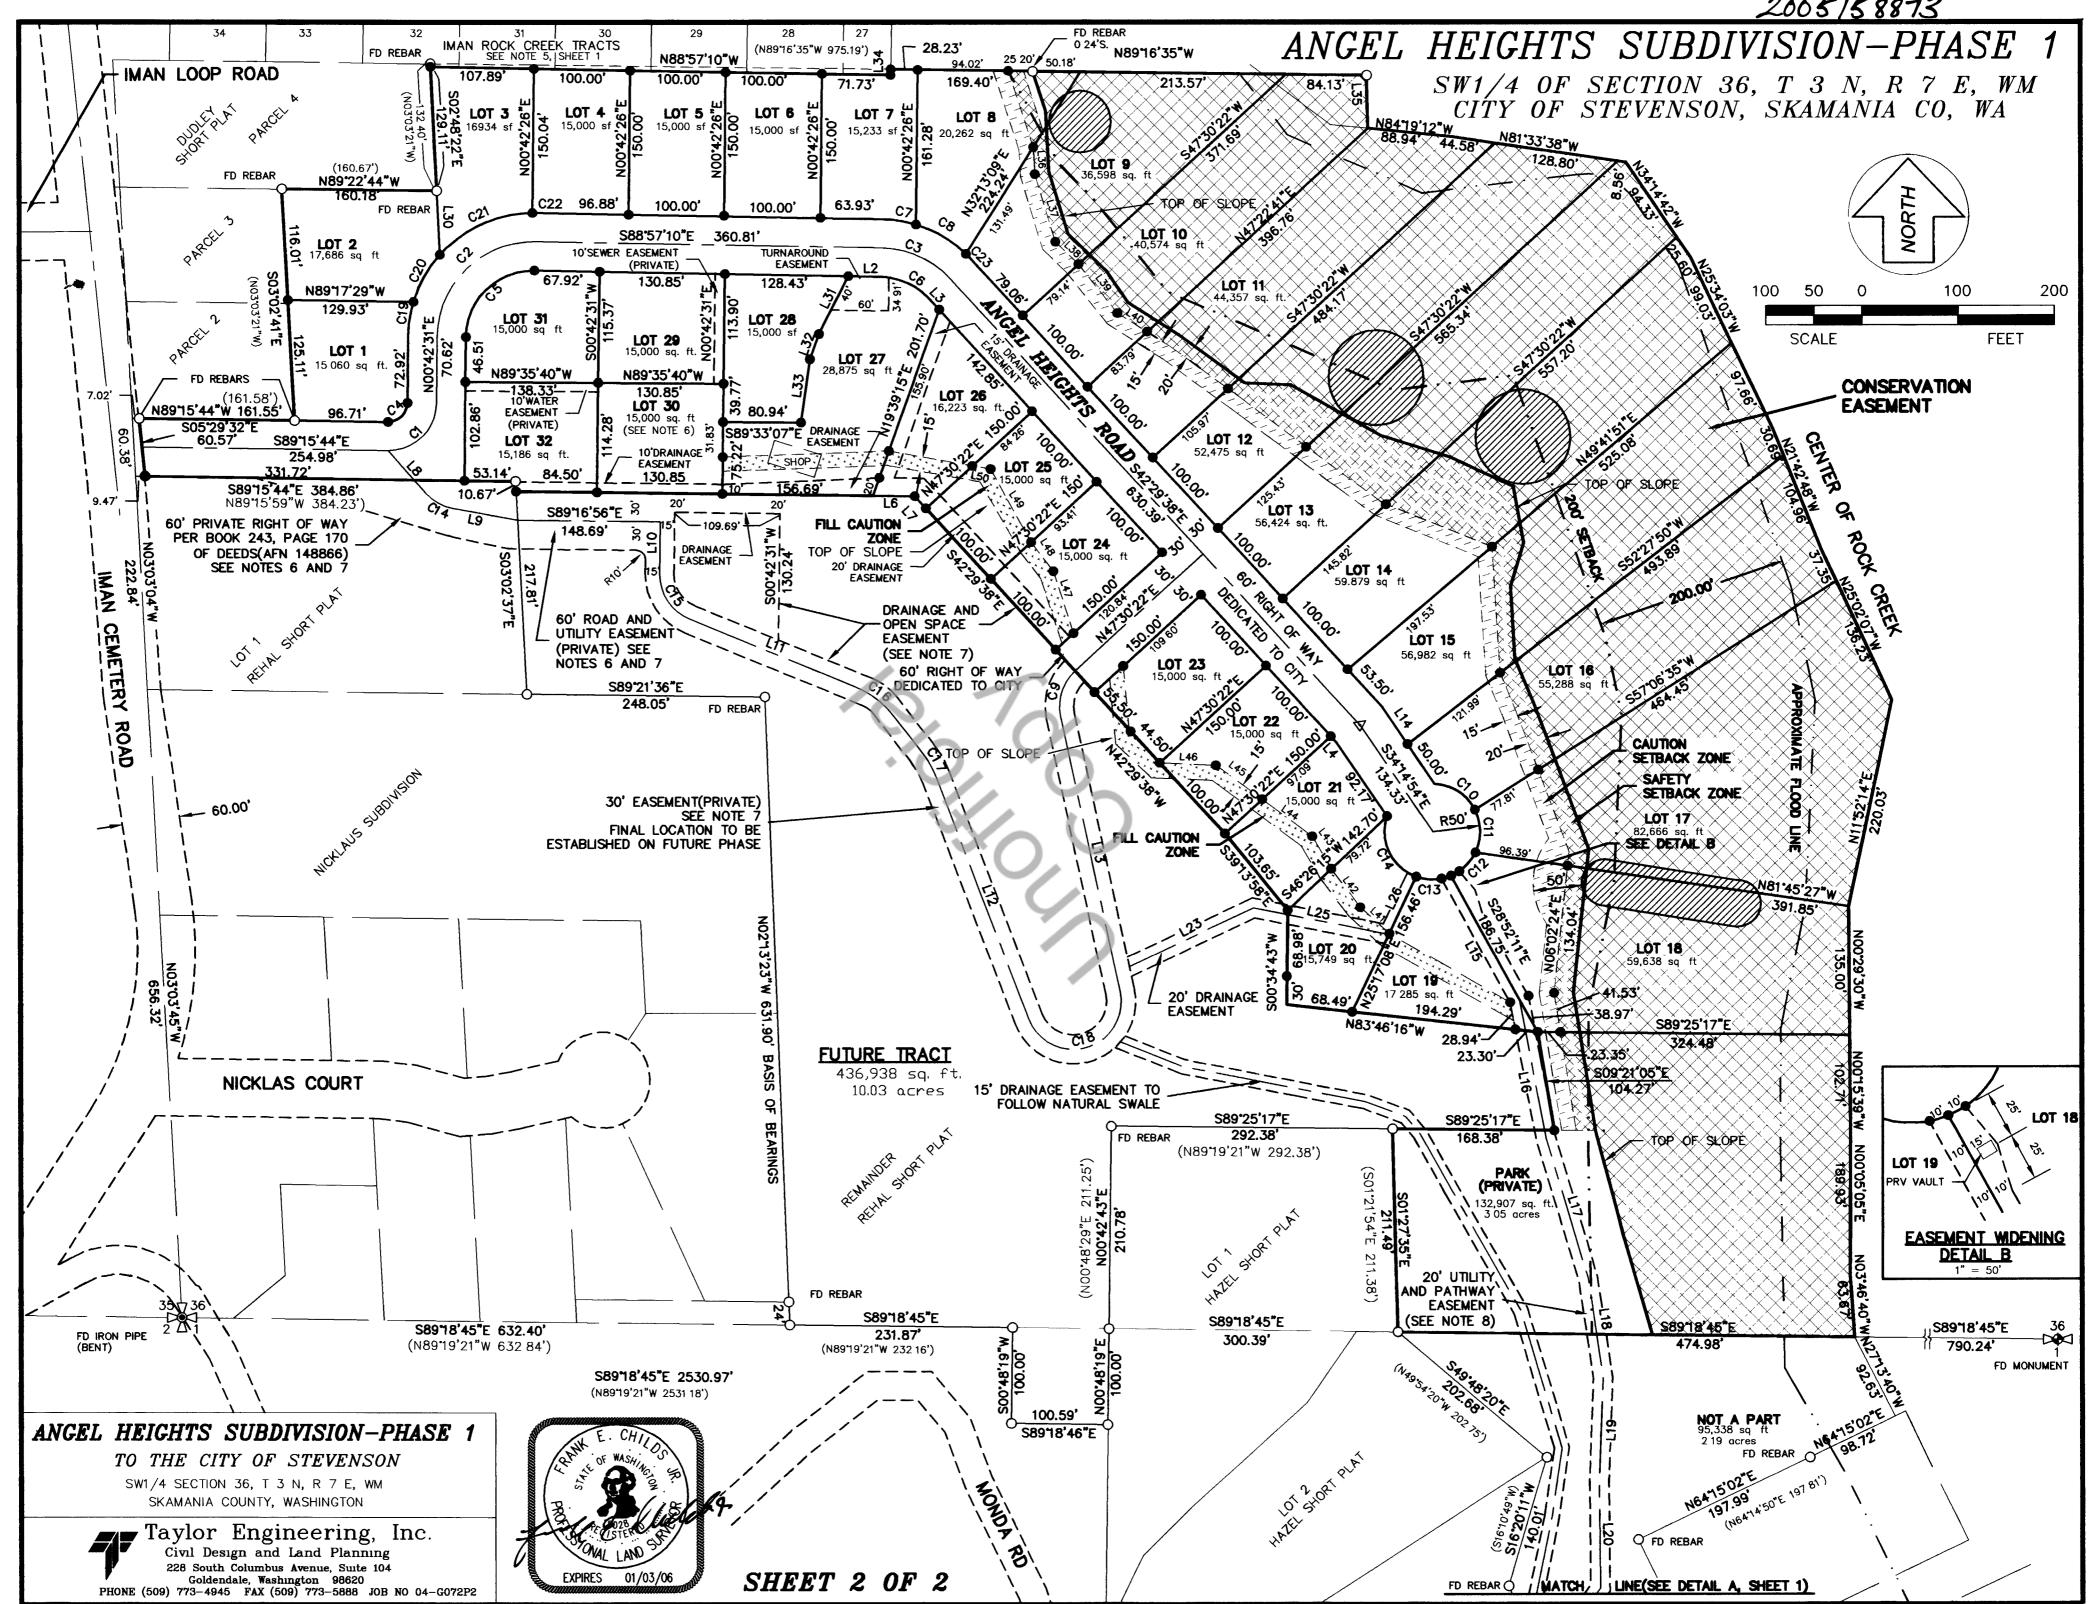

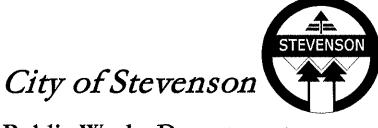

Public Works Department

PERMIT NUM	IBER: ROWA3-0
Date Received:	1/5/23

USE OF RIGHT OF WAY


APPLICATION					
PERMITTEE / PROPERTY OWNER INFORMATION					
Name: Derek& Glenna	Girtle Email: der	ekgirtile@gmail.com			
Address: City: Portland State: Oregon Zip: 97225 Phone:na Cell Phone 503-718 1574					
CONTRACTOR INFORMATION (NA)					
CONTRACTOR: By C	Owner Contact I	Person Email: tomo@gorgo	e.net		
DESIGN Consultant /	Contact Person: Tom Ov	wens Contact Phone: 503	-740-0840		
Address: PO Box 221	City: Cascade Locks Sta	te: OR Zip: 97014			
WA Contractor's Regis	tration No : (NA)	Stevenson Busi	ness License : NO		
PROJECT ADDRESS	PROJECT NAME Girtle; Retaining Wall PROJECT ADDRESS 725 Angel Heights Nearest cross streets if address is not assigned) TAX PARCEL #: 03073633011900				
PROJECT DESCRIPTION	ON; NATURAL STONE RI	ETAINING WALL			
Type of Application	☐ Utility Installation	☐ Utility Connection	☐ Utility Maintenance		
(Check Box)	X Use of right-of-way	□ Emergency	Street Closure		
	_ Landscaping	☐ Frontage Improveme	nts Drainage Improvement		
	☐ Special Event	Oversize/Weight			
	Other				
			АТЕ ИІТ ТҮРЕ: АBC		

INDEMNIFY AND HOLD HARMLESS: The Permittee agrees to indemnify and hold harmless the City of Stevenson as provided herein to the maximum extent possible under law. Accordingly, the Permittee agrees for itself, its successors, and assigns, to defend and indemnify the City of Stevenson its appointed and elected officials and employees from and against liability for all claims, demands, suits, and judgments, including cost of defense thereof, for injury to persons, death, or property damage which is caused by, arises out of, or is incidental to Permittee's exercise of rights and privileges granted by this permit. The Permittee's obligations under this permit shall include, without limitation, indemnification of claims made by the Permittee's own employees or agents and waiver of the Permittee's immunity under the industrial insurance provisions of Title 51 RCW, which waiver has been mutually negotiated by the parties. In the event it is necessary for the City of Stevenson to incur attorney's fees, legal expenses, or other costs to enforce the provisions of this section, all such fees, expenses, and costs shall be recoverable from the Permittee. In the event it is determined that RCW 4.24.115 applies to this permit, the Permittee agrees to defend, hold harmless, and indemnify the City of Stevenson to the maximum extent permitted thereunder, and specifically for its negligence concurrent with that of City of Stevenson to the full extent of Permittee's negligence.

LEGAL COMPLIANCE: Permittee agrees to prosecute work under the permit with all diligence and speed. At the expiration of the permit the rights herein conferred shall cease and terminate, unless specific written provisions are made for a renewal or extension. The undersigned, its successors and assigns, agrees if granted the above permit, to comply with the provisions, conditions, and requirements of the permit, and regulations adopted in the City of Stevenson Municipal Code and administrative rules authorized by the Code. Inspections or final approval by the City do not relieve the Permittee from its obligation to fully comply with state and city laws and regulations.

AUTHORITY: The undersigned acknowledges that the information submitted in support of this permit is true and correct and he/she is the Permittee or authorized by the Permittee to execute this permit.

Permitee/Agent Signature Date 1/04/202	3
Public Works Review and Comments:	
	1

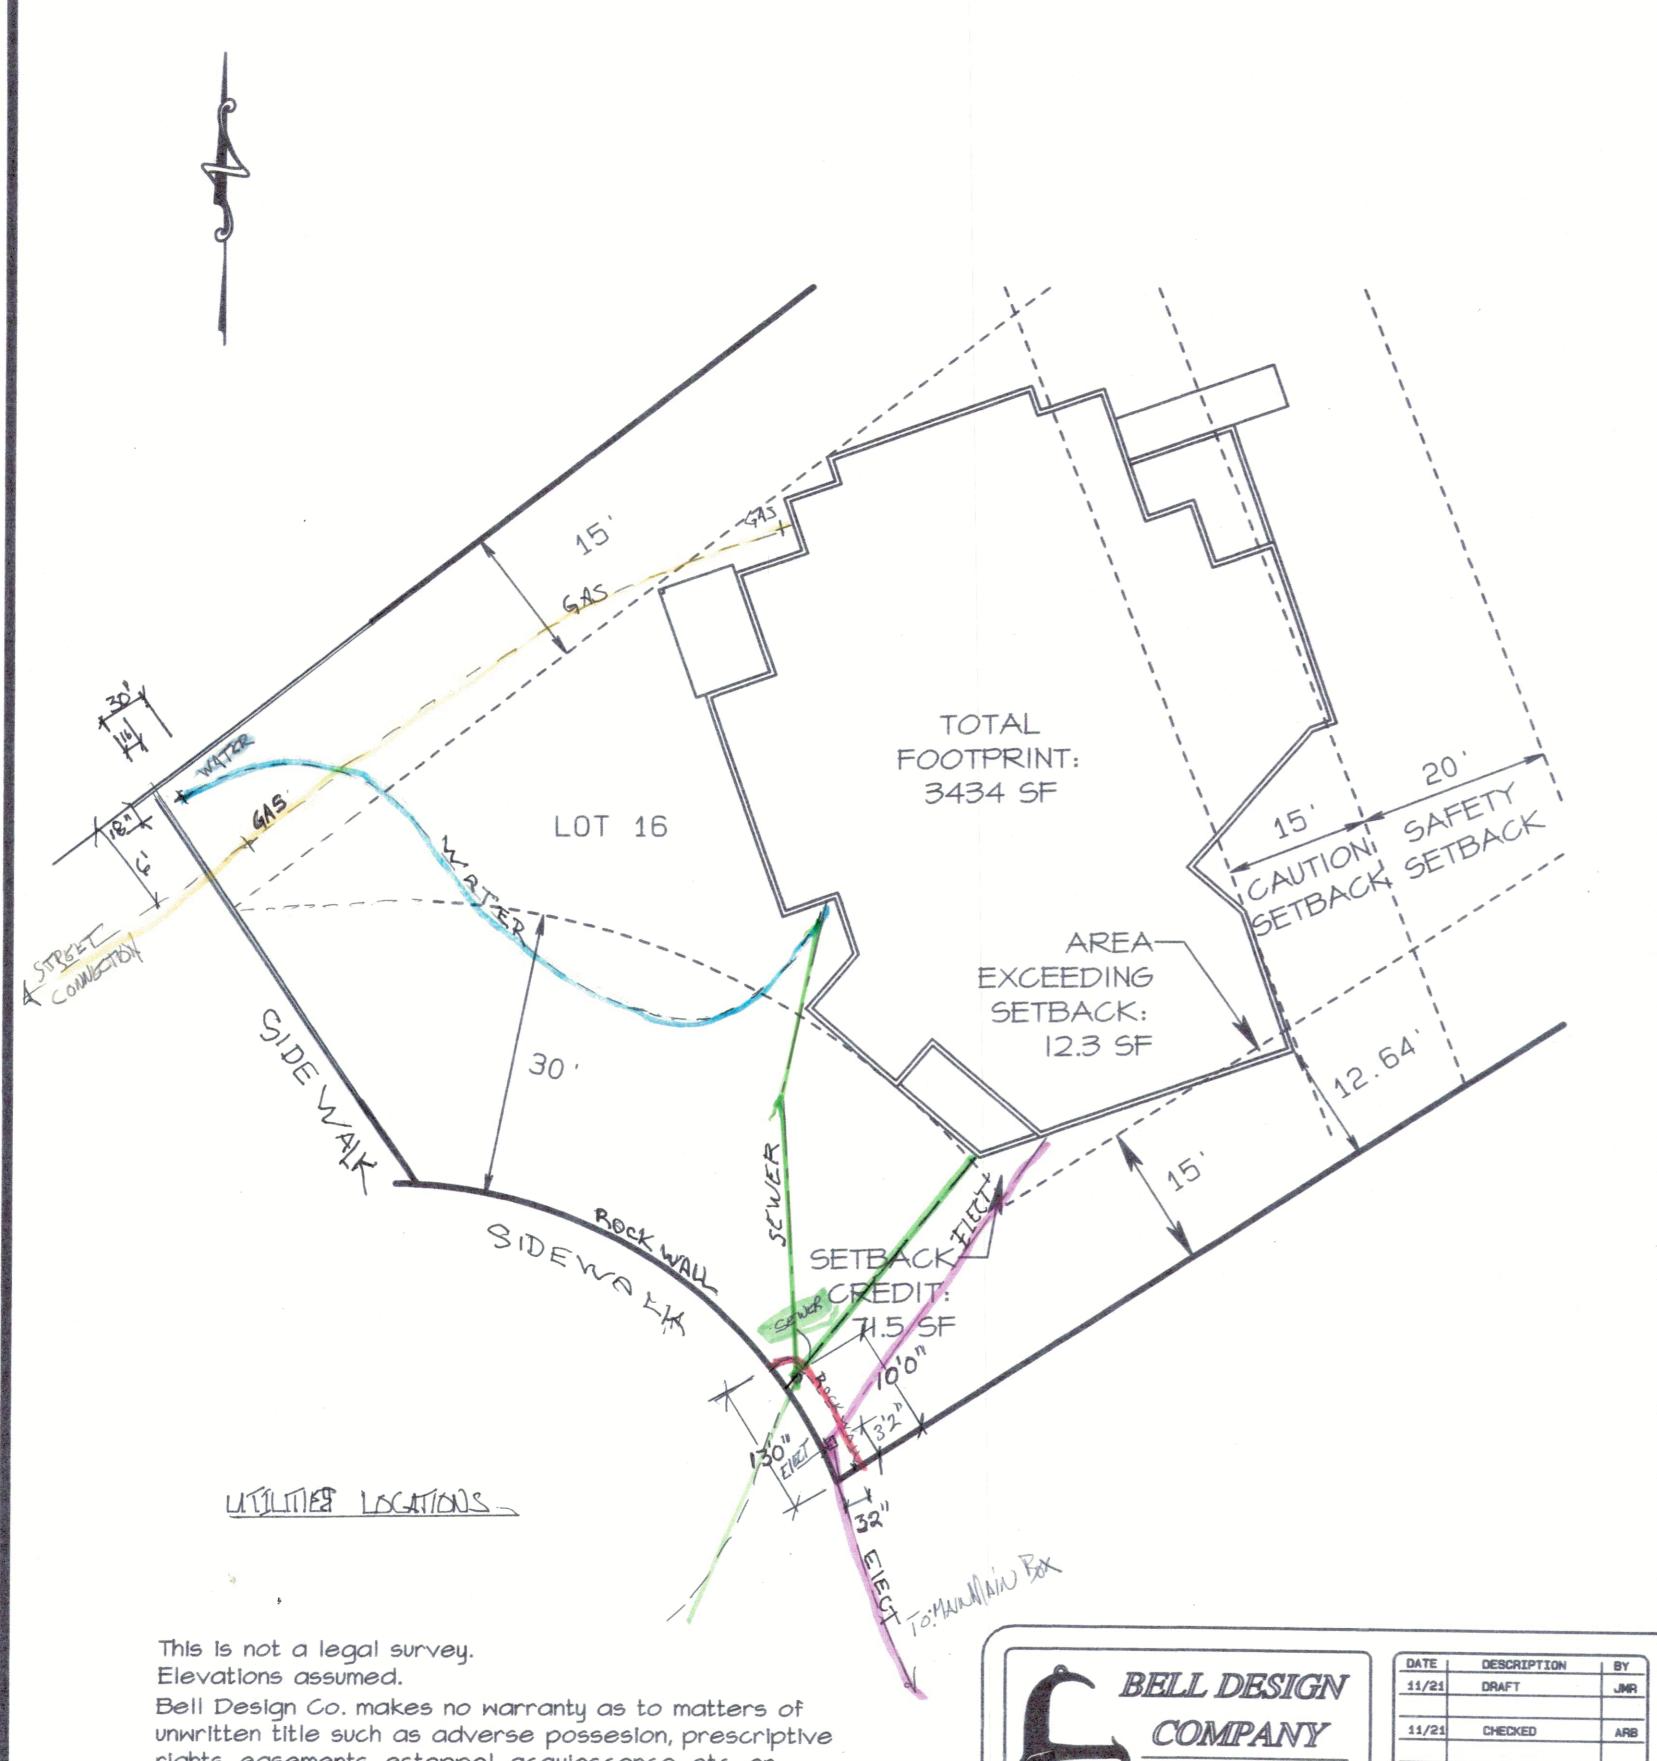

SETBACK EXHIBIT LOT 16 OF ANGEL HEIGHTS SUBDIVISION PHASE 1 SW 1/4 OF SEC 36, T3N, R7E, W.M. CITY OF STEVENSON, SKAMANIA, WA



INV. # 14758

For those who needed it done - yesterday!

PRIVATE WORK REQUEST

Customer: 10M Owens	Date: <u>/-/8-2023</u>			
	P.O. #:			
	Job #:			
Billing/Email Address:				
Date Requested: 1-17-2023 Requested By: 70m				
Locate/Site Address: 725 Flogel Heights Rd. Stephenson				
Description of Locating Private Utilities: <u>On Known</u> & this Lime				
Off. Tel.: Cell #: 503 ~ 740-0840 Fax #:				
Date Completed: 1-18-23 Site Contact: Call Tom	w/ EtA			
Activity, Summary: Localed to Verify Sanitary Sewer, water,				
as undated Set back exhibit. No public Utities in				
Said walk				
Please Note: This locate is being performed on private property at the customer's request. All County Locating Services, LLC has no knowledge of, and customer has not furnished as-installed plans, drawings or information of other utilities and the area of the requested locate. All County Locating Services, LLC, shall not be liable for damage to any type of utility, or any loss or injury caused by such damage.	THIS IS YOUR INVOICE, TOTAL AMOUNT DUE ON COMPLETION OF SERVICES			
*Charges outstanding over 30 days from the date of service are subject to a 1½% FINANCE CHARGE PER MONTH or annual percentage rate of 18%. Customer agrees to pay accrued expenses in the event of collection.	Travel <u> </u>			
Method of-Payment: □ C/C □ Visa □ Master Card □ Other	Total = 270.00			
□ To be Billed □ Cash □ Check - #	Note: Minimum 2-hour labor charges apply. Travel is computed from our home office or from the last job site. If travel is greater than one hour round trip will be charged.			
Customer Signature:	Thank You For Your Rusiness!			

rights, easements, estoppel, acquiescence, etc. or to environmental concerns such as hazardous waste, pollution, wet land delineation, riparian changes, flood zones, etc.



SETBACK EXHIBIT

FOR DEREK & GLENNA GIRTLE

STEVENSON, WASHINGTON

SHEET: 2 OF 2 PROJECT: 21B296 DATE: Nov 2021

0:\2021\B296\T02 - SURVEY STAKING\21