






DRAWING NO: **C-110**

DATE: 10/6/2022	SCALE: 1"=8'-0" SHOWN
SHEET	DESIGNED BY: SMC
OF	DRAWN BY: JL
SHEETS	CHECKED BY: SMC
	APPROVED BY: SMC

	7/11/2022	1	Address Review comments
	10/4/2022	2	Address Review comments

ISSUED FOR PRELIMINARY PLAT

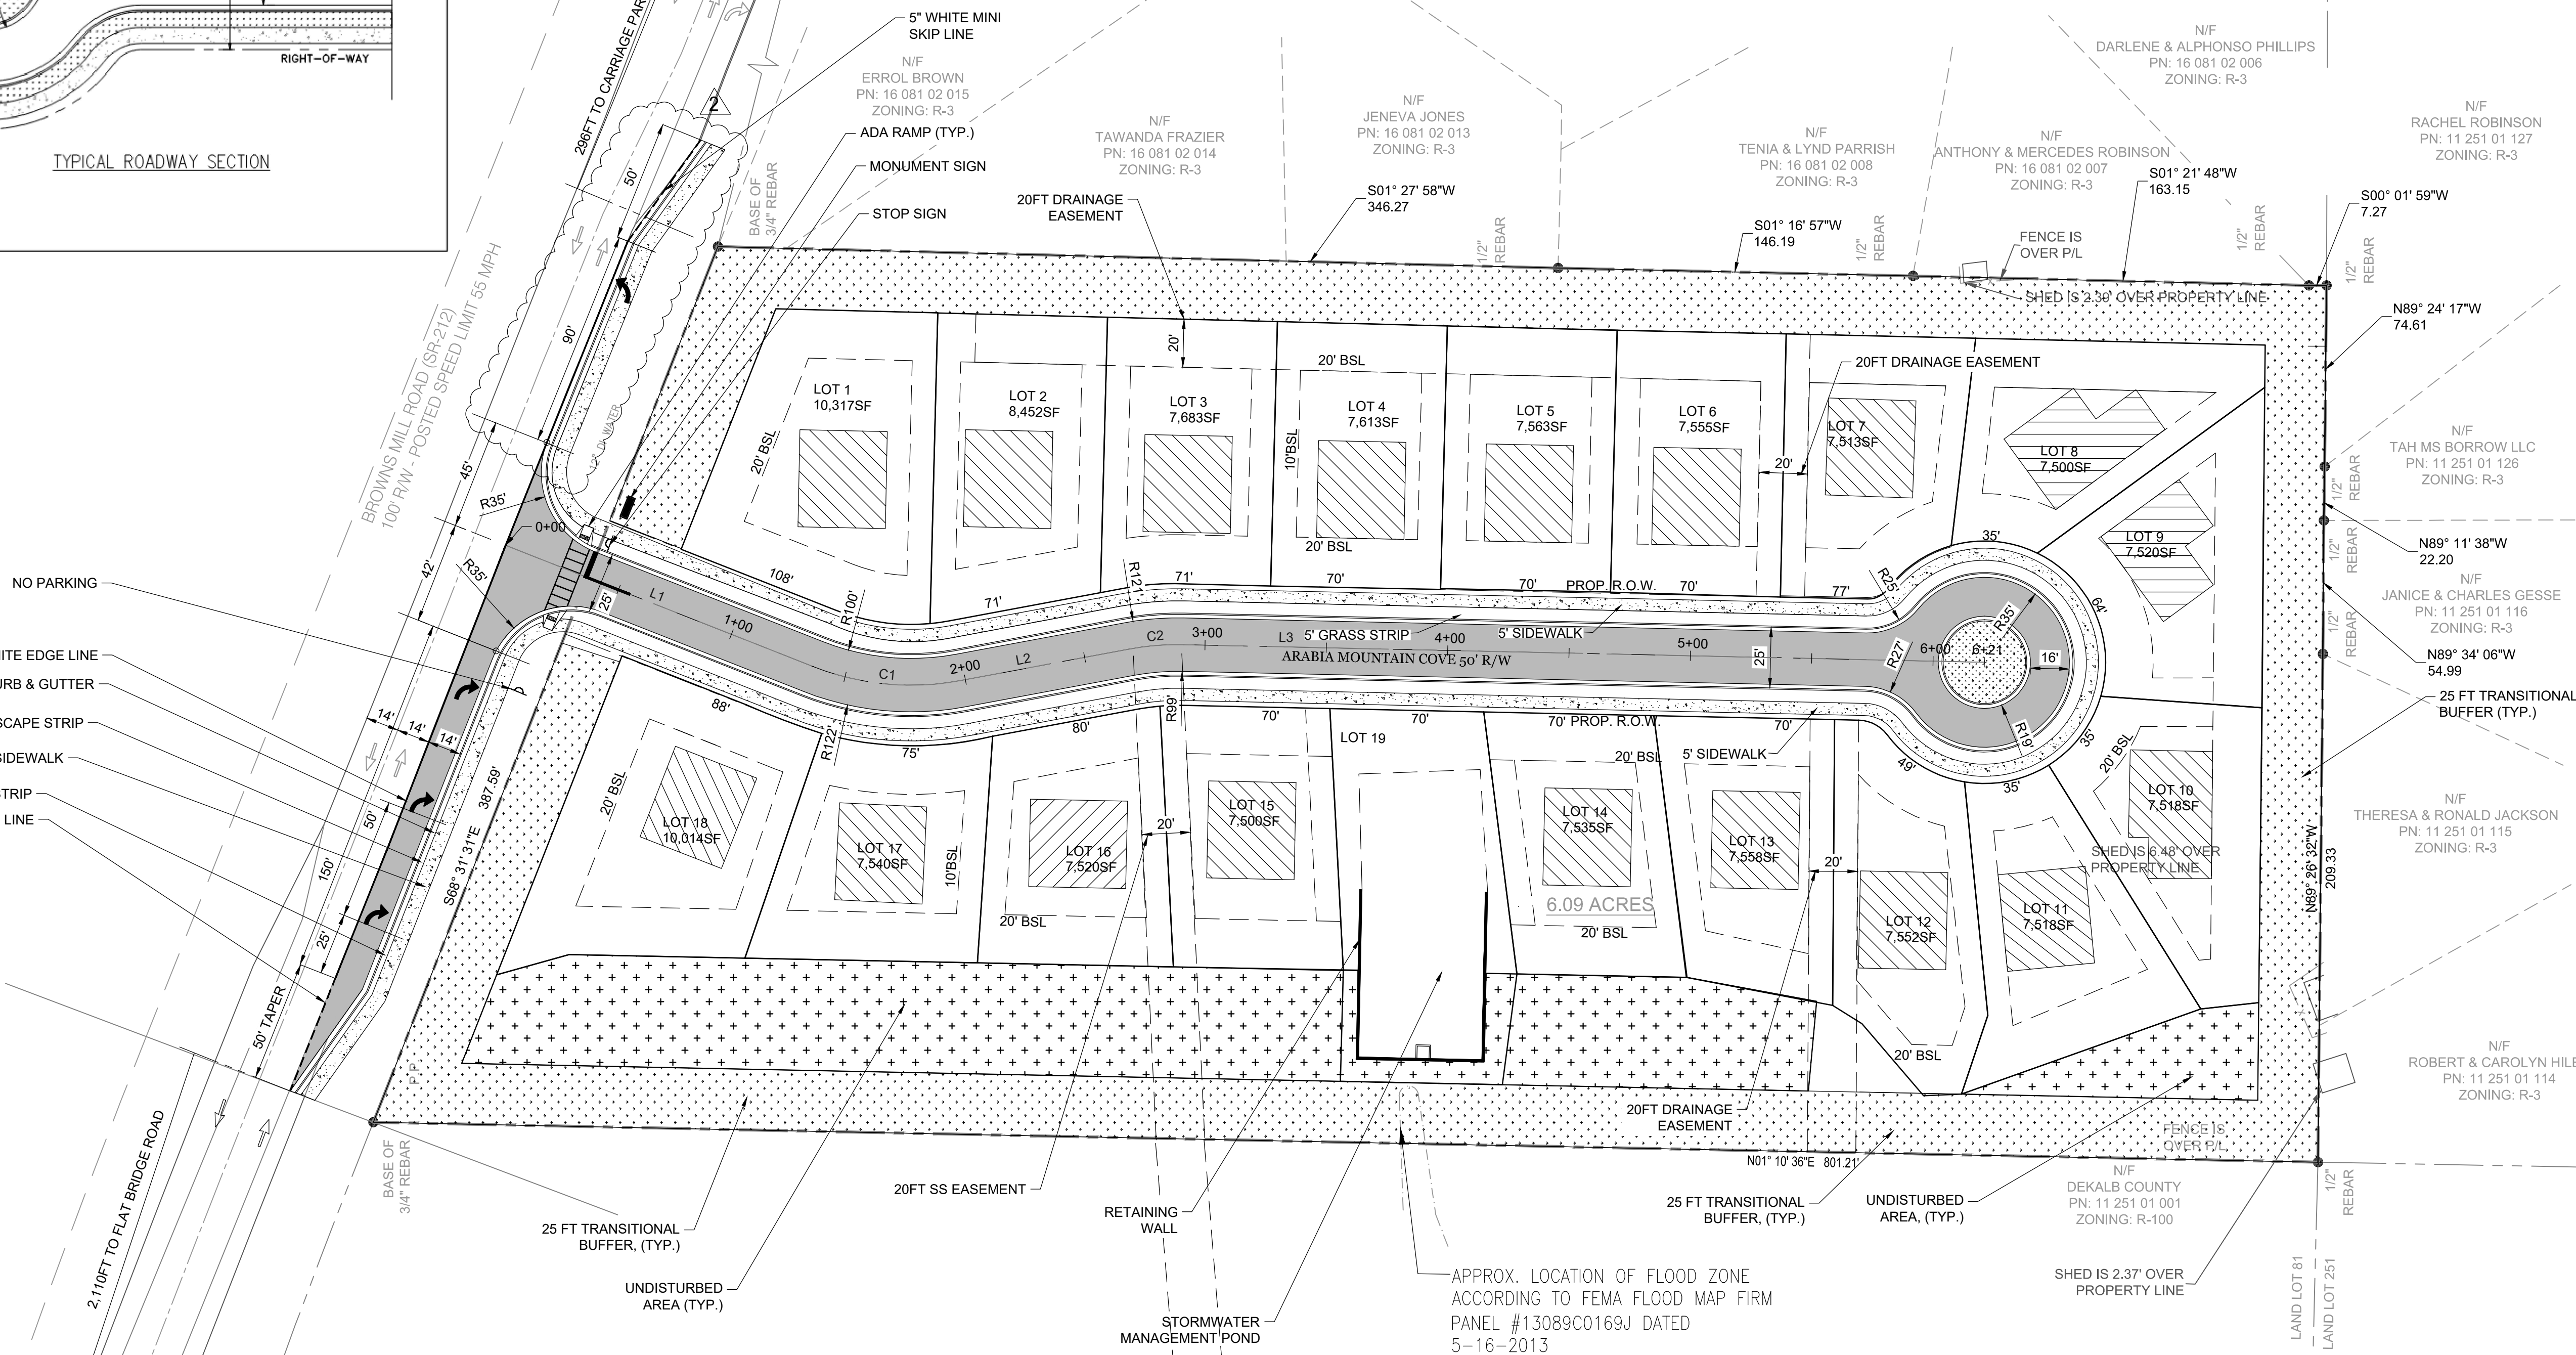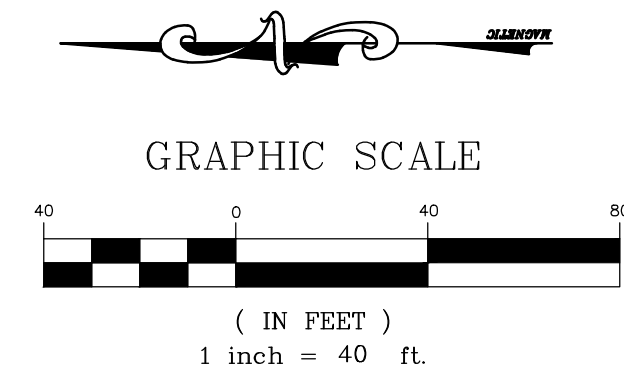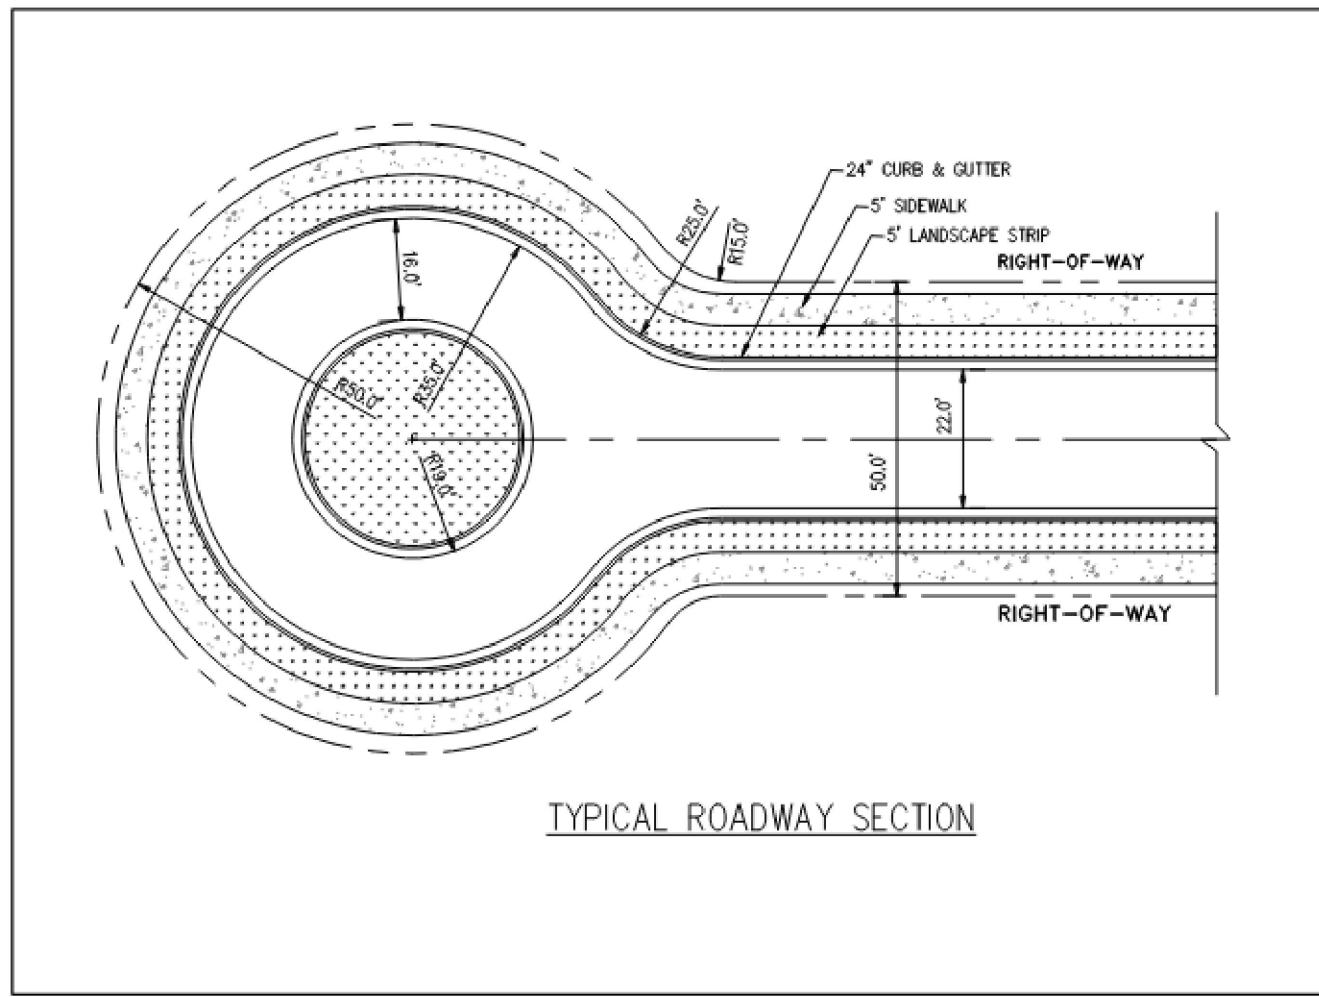

CURVE TABLE: ALIGNMENTS					
CURVE #	RADIUS	LENGTH	CHORD DIRECTION	START POINT	END POINT
C1	110.00'	61.62'	S05° 28' 10.68"W	N: 1326767.16 E: 2303239.32	N: 1326706.62 E: 2303233.52
C2	110.00'	22.68'	S04° 41' 52.41"E	N: 1326637.16 E: 2303246.49	N: 1326614.59 E: 2303248.35

LINE TABLE: ALIGNMENTS				
LINE #	LENGTH	DIRECTION	START POINT	END POINT
L1	136.20'	S21° 31' 02.97"W	N: 1326893.87 E: 2303289.28	N: 1326767.16 E: 2303239.32
L2	70.66'	S10° 34' 41.60"E	N: 1326706.62 E: 2303233.52	N: 1326637.16 E: 2303246.49
L3	329.98'	S01° 15' 39.60"W	N: 1326614.59 E: 2303248.35	N: 1326284.69 E: 2303241.09

SITE LAYOUT PLAN



72 HRS NOTICE IS REQUIRED TO GEORGIA 811 UTILITY PROTECTION CENTER BEFORE ANY PLANNED DIGGING
<http://www.georgia811.com>

DEVELOPER
WSM ASSOCIATES, LLC
CONTACT: WAYNE S. MOREHEAD
3112 MAIN STREET, SUITE 200
DULUTH, GA 30096
TEL: 678-641-2284
EMAIL: wmorehead@seedcapitalinvestment.com


24 HOUR CONTACT
WAYNE S. MOREHEAD
TEL: 678-641-2284

ENGINEER
CIVTECH CONSULTING, LLC
CONTACT: SAMUEL MCINTOSH, P.E.
2302 Parklake Dr. N.E., Suite 625
Atlanta, GA 30345
TEL: 770-756-4699
EMAIL: smcintosh@civtechconsulting.com

DATE	REV. NO.	REVISION
10/24/22	1	Address City Comments
11/14/22	2	Address City Comments


CivTech Consulting, LLC
2302 PARKLAKE DR., N.E., SUITE 625
ATLANTA, GA 30345
TEL: 770-756-1270

THE ENCLAVE AT ARABIA MOUNTAIN
6301 BROWNS MILL RD
LITHONIA, GA 30038

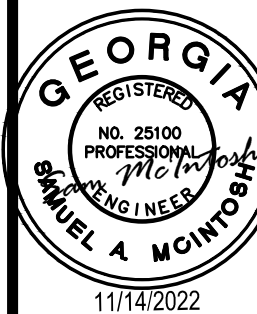

DATE: 11/14/2022	SCALE: AS SHOWN	DESIGNED BY: SMG	DRAWN BY: J.L.	CHECKED BY: SMG	APPROVED BY: SMG
SHEET	OF	SHEETS			
DRAWING NO: C-200					

ISSUED FOR PRELIMINARY PLAT

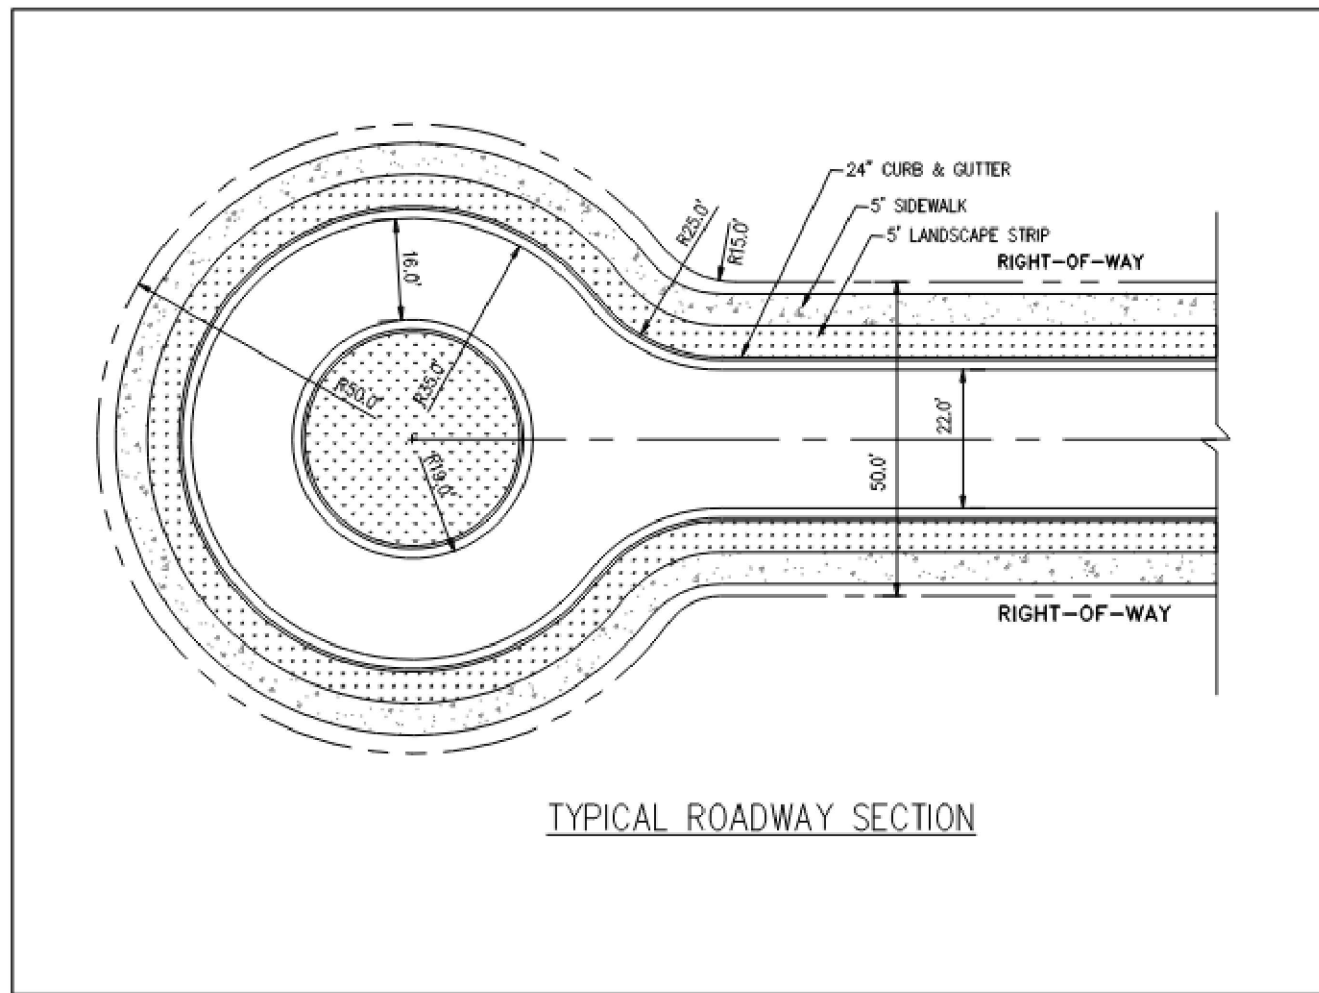


This plat has been submitted to and accepted by the Planning & Zoning Department for the City of Stonecrest, Georgia and has been approved as required by state law and city codes as meeting all conditions precedent to recording in the superior court of this circuit.

Director, Department of Planning & Zoning Date

CURVE TABLE: ALIGNMENTS				
CURVE #	RADIUS	LENGTH	CHORD DIRECTION	START POINT
C1	110.00'	61.62'	S05° 28' 10.68"W	N: 1326767.16 E: 2303239.32
C2	110.00'	22.68'	S04° 41' 52.41"E	N: 1326637.16 E: 2303246.49

LINE TABLE: ALIGNMENTS				
LINE #	LENGTH	DIRECTION	START POINT	END POINT
L1	136.20'	S21° 31' 02.97"W	N: 1326893.87 E: 2303289.28	N: 1326767.16 E: 2303239.32
L2	70.66'	S10° 34' 41.60"E	N: 1326706.62 E: 2303233.52	N: 1326637.16 E: 2303246.49
L3	329.98'	S01° 15' 39.60"W	N: 1326614.59 E: 2303248.35	N: 1326284.69 E: 2303241.09

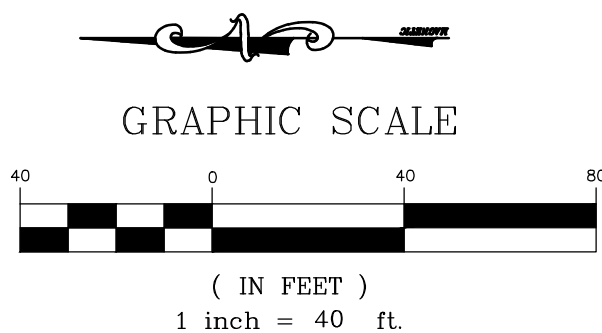

PROPERTY INFORMATION
SUBDIVISION NAME: THE ENCLAVE AT ARABIA MOUNTAIN
ADDRESS: 6301 BROWNS MILL RD, STONECREST, GA
ZONING: R-100
AREA: 6.09AC
PARCEL ID: 16 081 02 004
NUMBER OF LOTS: 18

APPLICANT CERTIFICATION
APPLICANT HEREBY CERTIFIES THAT NO LOTS PLATTED
ARE NONCONFORMING OR WILL RESULT IN ANY
NONCONFORMING LOTS

WAYNE MOREHEAD
APPLICANT NAME SIGNATURE

SOIL TYPES ON SITE
GeC - Gwinnett Sandy Loam, Group B, 0.57 to 1.98 in./hr, 6 to 10 percent slopes
GeD - Gwinnett Sandy Loam, Group B, 0.57 to 1.98 in./hr, 6 to 10 percent slopes
HsB - Halwassee Sandy Loam, Group B, 0.57 to 1.98 in./hr, 2 to 6 percent slopes
Tf - Toccoa Sandy Loam, Group A, 1.98 to 5.95 in./hr, 0 to 2 percent slopes

- NOTES:
1. THERE ARE NO HISTORIC RESOURCES ON THE SITE
 2. THERE ARE NO WETLAND OR STREAM BUFFERS ON SITE
 3. THERE IS ONE SINGLE-STORY WOODEN STRUCTURE ON SITE TO BE DEMOLISHED
 4. THERE IS NO PRIOR SUBDIVISION ON THE PROPERTY
 5. THERE IS NO CONDITION OF ZONING ASSOCIATED WITH THIS PROPERTY
 6. THERE ARE NO SPECIAL ADMINISTRATIVE PERMIT NUMBER, SPECIAL LAND USE PERMIT OR BOARD OF APPEALS PERMIT ASSOCIATED WITH THIS PROPERTY
 7. THERE ARE NO VARIANCES ISSUED FOR THIS PROPERTY
 8. THERE ARE NO EXISTING SEWER MAINS OR SEWER EASEMENTS ON THIS PROPERTY
 9. THERE ARE NO WATER EASEMENTS ON SITE
 10. THERE ARE NO BURY PITS ON THE PROPERTY
 11. ALL UTILITIES, INCLUDING ELECTRICAL SERVICE, WILL BE INSTALLED UNDERGROUND
 12. THE SUBDIVISION WILL BE GOVERNED BY A MANDATORY HOMEOWNERS ASSOCIATION.
 13. ONLY STREET RIGHTS-OF-WAY IS TO BE DEDICATED TO THE CITY OF STONECREST.
 14. 25FT TRANSITIONAL AREA, UNDISTURBED AREA AND DETENTION POND AREA (LOT 19) SHALL BE OWNED AND MAINTAINED BY THE HOMEOWNERS ASSOCIATION.

Engineer's Acknowledgment.
In my opinion, this plat, drawn by me or under my supervision, was made from an actual survey, and is a correct representation of the land platted and has been prepared in conformity with the minimum standards and requirements of law.

Sam McIntosh PE NO.: 25100

Owner's Acknowledgment.
I, Wayne Morehead, the owner of the land shown on this plat and whose name is subscribed hereto, acknowledges that this plat was made from an actual survey, and for value received the sufficiency of which is hereby acknowledged, do hereby convey all rights-of-way abutting the roads to the City of Stonecrest, and further dedicate to the use of the public forever all streets and rights-of-way, alleys, parks, easements and public places hereon shown for the purposes and considerations herein expressed. In consideration of the approval of this development plan and other valuable considerations, the owner further releases and holds harmless City of Stonecrest from any and all claims, damages or demands arising on account of the design, construction and maintenance of the property shown hereon; on account of the roads, fills, embankments, ditches, cross-drains, culverts, water mains, sewer lines, and bridges within the proposed rights-of-way and easements shown; and on account of backwater, the collection and discharge of surface water, or the changing of courses of streams.

And further the owner warrants that he owns fee simple title to the property shown hereon and agrees that City of Stonecrest shall not be liable to him, his heirs, successors or assigns for any claims or damages resulting from the construction or maintenance of cross-drain extensions, drives, structures, streets, culverts, curbs or sidewalks, the changing of courses of streams and rivers, flooding from natural creeks and rivers, surface waters and any other matter whatsoever. I further warrant that I have the right to sell and convey the land according to this plat and do hereby bind myself and owners subsequent in title to defend by virtue of these presents.

All roads have been properly designed and dedicated to accommodate any required parking in the right-of-way.
In witness whereof, I have hereunto set my hand this 18 day of August, 2022

OWNER: Wayne Morehead
WITNESS: [Signature]
NOTARY PUBLIC: [Signature]



PRELIMINARY PLAT

DATE	REV. NO.	REVISION
10/24/22	1	Address City Comments
11/14/22	2	Address City Comments


CivTech Consulting, LLC
2302 PARKLAKE DR., N.E., SUITE 625
ATLANTA, GA 30345
TEL. 770-756-1270

THE ENCLAVE AT ARABIA MOUNTAIN
6301 BROWNS MILL RD
LITHONIA, GA 30038



DATE:	SCALE:	AS SHOWN	DESIGNED BY:	SMG	DRAWN BY:	JL	CHECKED BY:	SMG	APPROVED BY:	SMG
11/14/2022										
SHEET										
OF										
DRAWING NO:										
C-203										

ISSUED FOR CONSTRUCTION

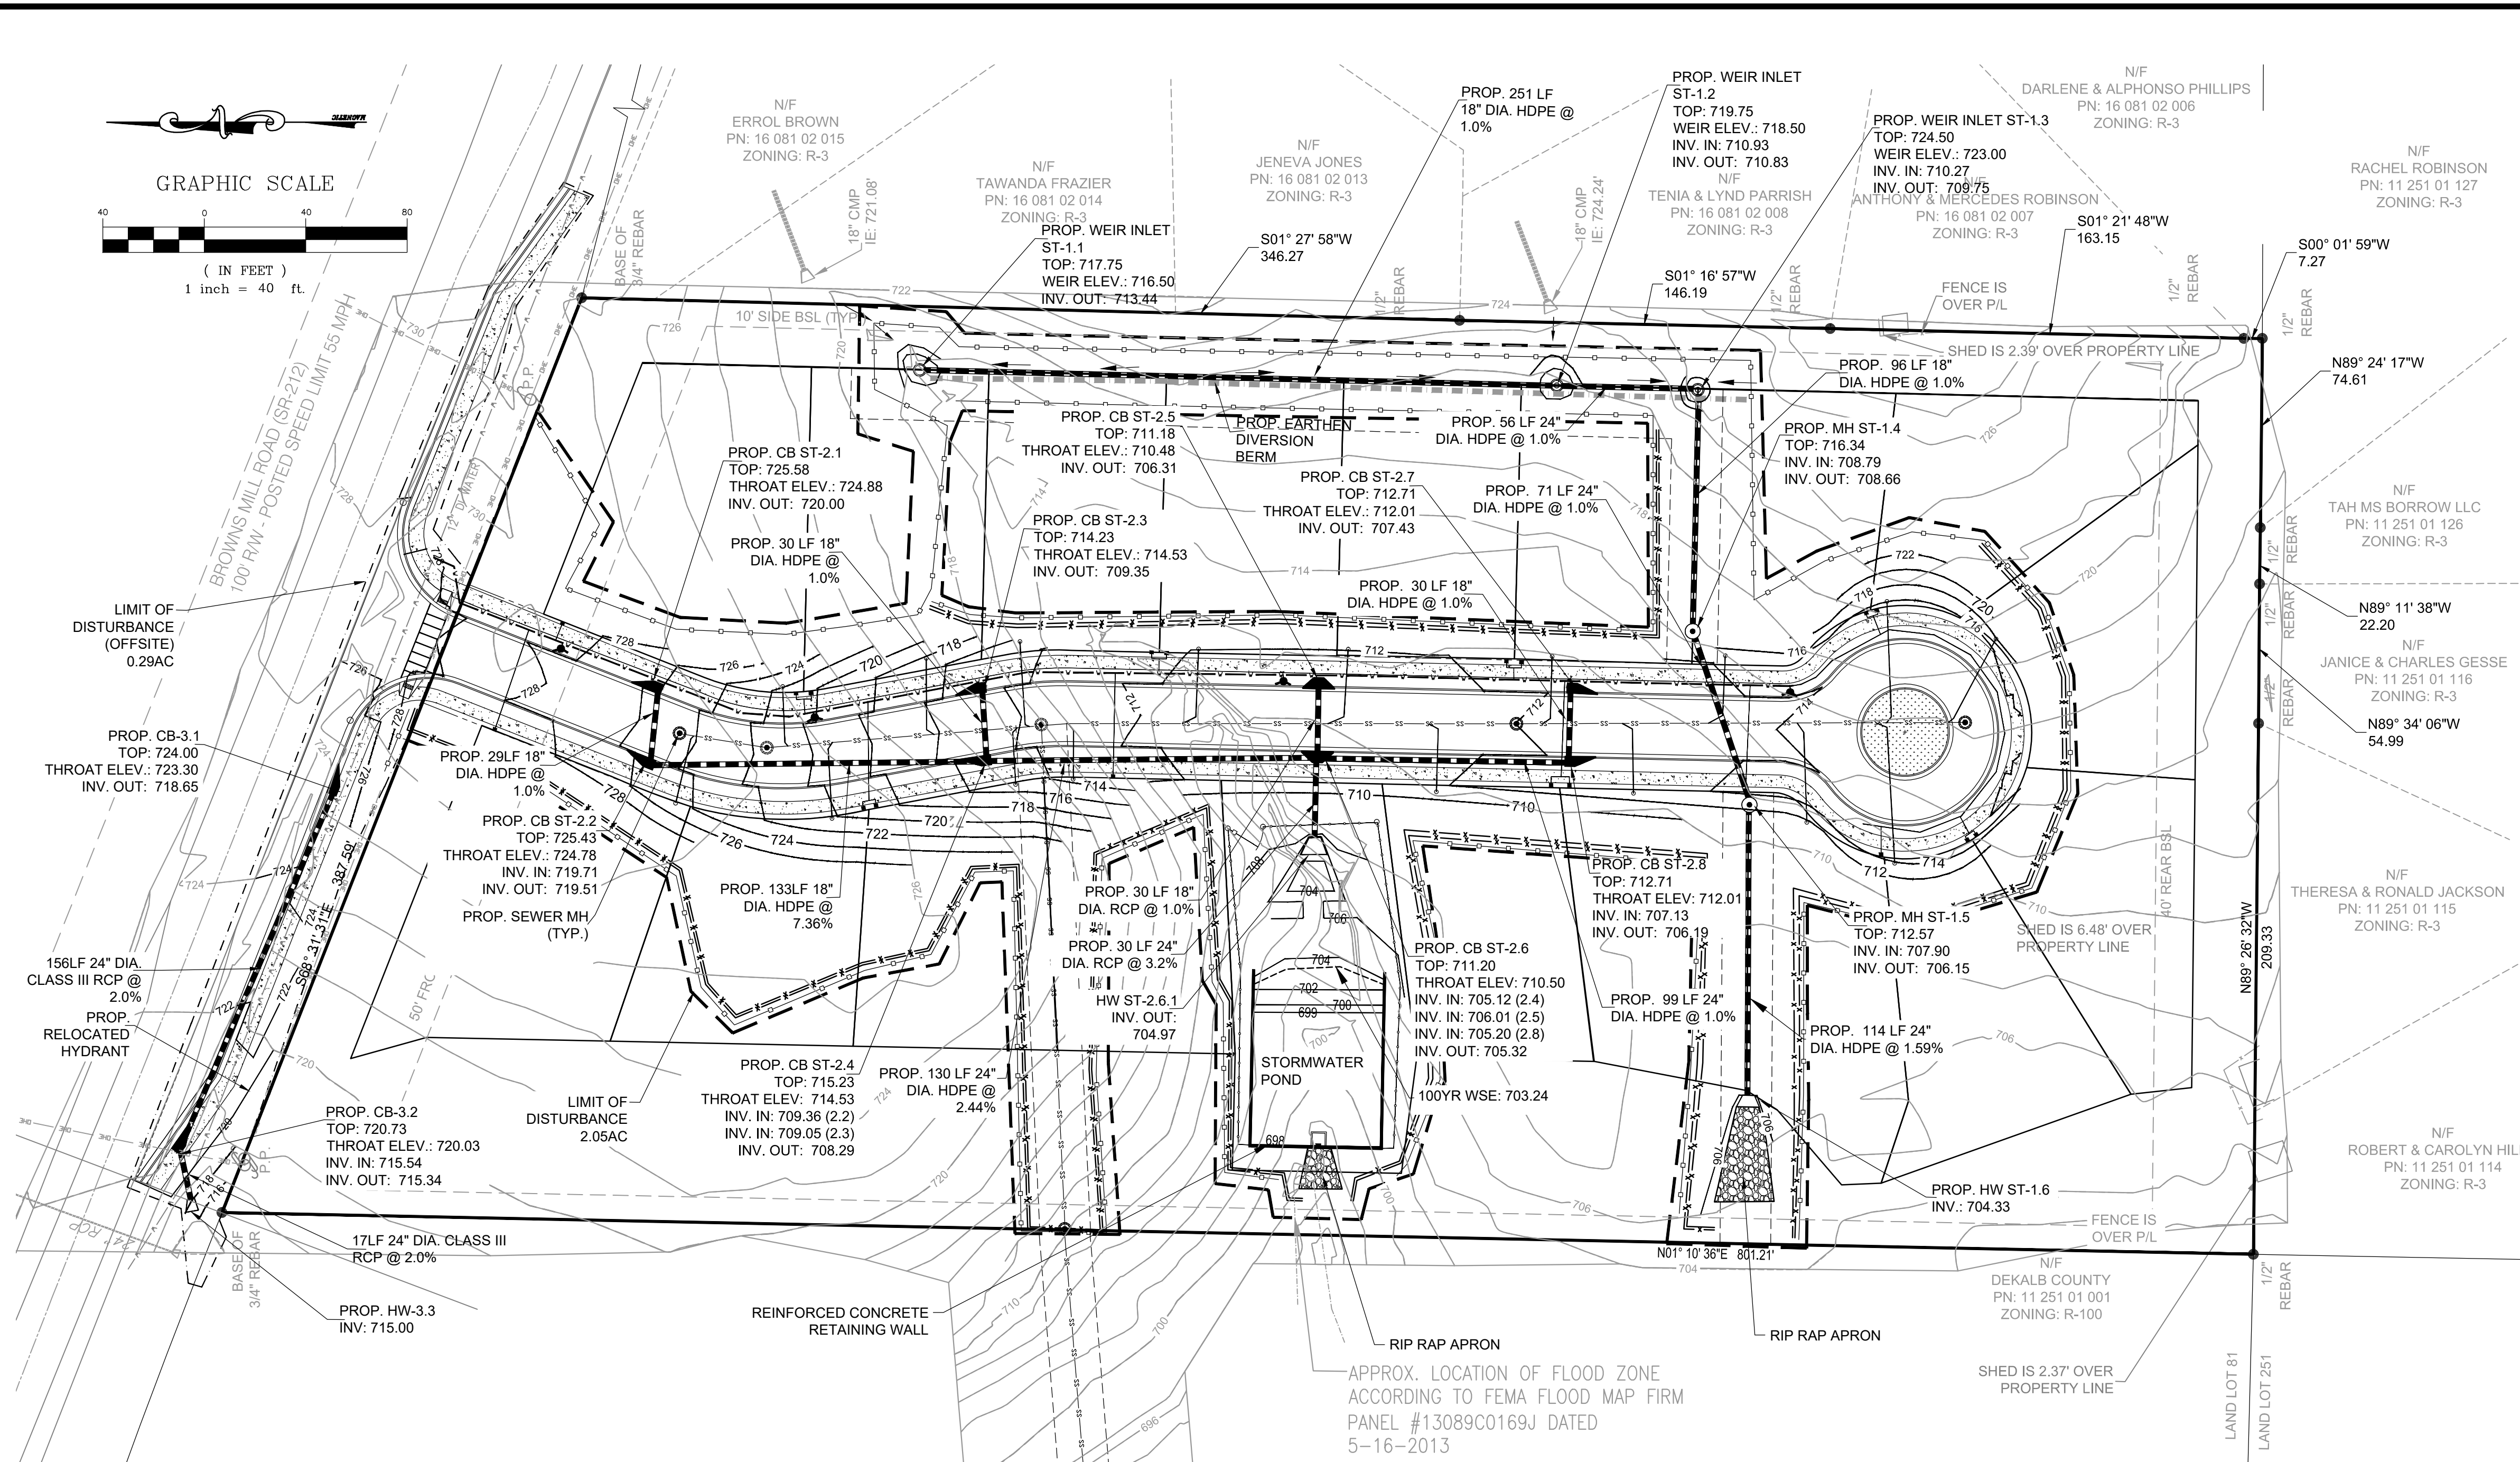

- GRADING & DRAINAGE NOTES:**
- GROUND SURFACE PREPARATION: REMOVE VEGETATION INCLUDING GRASS, ROOTS, AND SURFICIAL ORGANICS. DEBRIS UNSATISFACTORY SOIL MATERIALS, OBSTRUCTIONS, AND DELETERIOUS MATERIALS FROM GROUND SURFACE PRIOR TO PLACEMENT OF FILLS. PLOW STRIP, OR BREAK UP SLOPED SURFACES STEEPER THAN 1 VERT. TO 2 HORIZ. SO THAT FILL MATERIAL WILL BOND WITH EXISTING SURFACE. WHEN EXISTING GROUND SURFACE HAS A DENSITY LESS THAN THAT SPECIFIED UNDER COMPACTION FOR PARTICULAR AREA CLASSIFICATION, BREAK UP GROUND SURFACE, PULVERIZE, MOISTURE CONDITION TO OPTIMUM MOISTURE CONTENT, AND COMPACT TO REQUIRED DEPTH AND PERCENTAGE OF MAXIMUM DENSITY.
 - PLACE BACKFILL AND FILL MATERIALS IN LAYERS NOT MORE THAN 12 INCHES IN LOOSE DEPTH FOR MATERIAL COMPACTED BY HEAVY COMPACTION EQUIPMENT AND NOT MORE THAN 6 INCHES IN LOOSE DEPTH FOR MATERIAL COMPACTED BY HAND-OPERATED TAMPERS.
 - BEFORE COMPACTION, MOISTEN AND AERATE EACH LAYER AS NECESSARY TO PROVIDE OPTIMUM MOISTURE CONTENT. COMPACT EACH LAYER TO REQUIRED PERCENTAGE OF MAXIMUM DRY DENSITY OR RELATIVE DRY DENSITY FOR EACH AREA CLASSIFICATION. DO NOT PLACE BACKFILL OR FILL MATERIAL ON SURFACES THAT ARE MUDDY, FROZEN OR CONTAIN FROST OR ICE.
 - COMPACT SUBGRADE AND EACH LAYER OF BACKFILL OF FILL MATL. TO AT LEAST 95% OF THE STANDARD PROCTOR. MAXIMUM DRY DENSITY TO A DEPTH OF 6" BELOW BOTTOM OF FINAL GRADE.
 - MOISTURE CONTROL: WHERE SUBGRADE OR LAYER OF SOIL MATERIAL MUST BE MOISTURE CONDITIONED BEFORE COMPACTION, UNIFORMLY APPLY WATER TO SURFACE OF SUBGRADE OR LAYER OF SOIL MATL. APPLY WATER IN MINIMUM QUANTITY AS NECESSARY TO PREVENT FREE WATER FROM APPEARING ON SURFACE DURING OR SUBSEQUENT TO COMPACTION OPERATIONS.
 - REMOVE AND REPLACE, OR SCARIFY AND AIR DRY, SOIL MATERIAL THAT IS TOO WET TO PERMIT COMPACTION TO SPECIFIED DENSITY.
 - SPREAD SOIL MATERIAL THAT HAS BEEN REMOVED BECAUSE IT IS TOO WET TO PERMIT COMPACTION. ASSIST DRYING BY DISCING, HARROWING, OR PULVERIZING UNTIL MOISTURE CONTENT IS REDUCED TO A SATISFACTORY VALUE.
 - QUALITY CONTROL TESTING DURING CONSTRUCTION: ALLOW GEOTECHNICAL TESTING SERVICE TO INSPECT AND APPROVE EACH SUB-GRADE AND BACKFILL OR FILL LAYER BEFORE FURTHER BACKFILL OR CONSTRUCTION WORK IS PERFORMED. TEST SHALL BE PERFORMED EVERY 10,000 SQ. FT. OF AREA PER ONE FOOT LIFT (OR AS DIRECTED BY A REGISTERED GEOTECHNICAL ENGINEER.
 - GEOTECHNICAL SPEC'S DEPICTED HEREON ARE GUIDELINES ONLY AND SHOULD BE VERIFIED BY A REGISTERED GEOTECHNICAL ENGINEER PRIOR TO THE COMMENCEMENT OF CONSTRUCTION. RECOMMENDATIONS FROM A REGISTERED GEOTECHNICAL ENGINEER (IF ANY) SHALL SUPERSEDE THE ABOVE REFERENCED SPEC'S.
 - THE CONTRACTOR SHALL IMMEDIATELY NOTIFY THE OWNER OF THE DISCOVERY OF ANY GROUNDWATER, SUBSURFACE SEEPAGE OR SPRINGS DURING THE COURSE OF CONSTRUCTION. IT SHALL BE THE RESPONSIBILITY OF THE OWNER TO CONSULT WITH A REGISTERED GEOTECHNICAL ENGINEER TO INSPECT THE SITE, AND TO MAKE ANY RECOMMENDATIONS REGARDING EVIDENCE AND REMEDIATION (IF ANY) OF SAID SUBSURFACE WATERS.
 - THE SPOT ELEVATIONS AND CONTOUR LINES SHOWN REPRESENT THE FINISHED GRADE ELEVATION. THE GRADING CONTRACTOR SHALL ESTABLISH THE ROUGH GRADE ELEVATION BASED ON THE BUILDING FOUNDATION SECTION, PAVING SECTIONS, TOPSOIL CONDITION, AND OTHER SITE RELATED CONDITION WHICH ARE REPRESENTED ON THESE PLANS.
 - ALL TREE SAFE FENCES AND EROSION CONTROL BMP'S ARE TO BE INSTALLED PRIOR TO ANY LAND DISTURBANCE ACTIVITIES.
 - CONTRACTOR TO LOCATE ALL UNDERGROUND UTILITIES PRIOR TO COMMENCEMENT OF CONSTRUCTION. ANY DISCREPANCIES IDENTIFIED ARE TO BE BROUGHT TO THE ATTENTION OF THE ENGINEER FOR RESOLUTION.

GSWCC Georgia Soil and Water Conservation Commission

Samuel McIntosh
Level III Certified Design Professional

CERTIFICATION NUMBER: 0000024059

ISSUED: 11/21/2018 EXPIRES: 11/21/2021

GEORGIA811
www.Georgia811.com

Know what's below.
Call before you dig.

72 HRS NOTICE IS REQUIRED TO GEORGIA 811 UTILITY PROTECTION CENTER BEFORE ANY PLANNED DIGGING
http://www.georgia811.com

DEVELOPER
WSM ASSOCIATES, LLC
CONTACT: WAYNE S. MOREHEAD
3112 MAIN STREET, SUITE 200
DULUTH, GA 30096
TEL: 678-641-2284
EMAIL: wmorehead@seedcapitalinvestment.com

24 HOUR CONTACT
WAYNE S. MOREHEAD
TEL: 678-641-2284

ENGINEER
CIVTECH CONSULTING, LLC
CONTACT: SAMUEL MCINTOSH, P.E.
2302 Parklake Dr, N.E., Suite 625
Atlanta, GA 30345
TEL: 770-756-4699
EMAIL: smcintosh@civtechconsulting.com

GRADING AND DRAINAGE PLAN



CivTech consulting, LLC 2302 PARKLAKE DR., N.E., SUITE 625 ATLANTA, GA 30345 TEL: 770-756-1270	
DATE	REV. NO.
7/11/2022	1
Address Review comments	

THE ENCLAVE AT ARABIA MOUNTAIN
6301 BROWNS MILL RD
STONECREST, GA 30038

REGISTERED PROFESSIONAL ENGINEER
NO. 25100
Samuel A. McIntosh
7/11/2022

DATE: 7/11/22	SCALE: 1"=40'	DESIGNED BY: SMG
SHEET	OF	DRAWN BY: J.L.
DRAWING NO: C-210		CHECKED BY: SMG
		APPROVED BY: SMG

ISSUED FOR PRELIMINARY PLAT

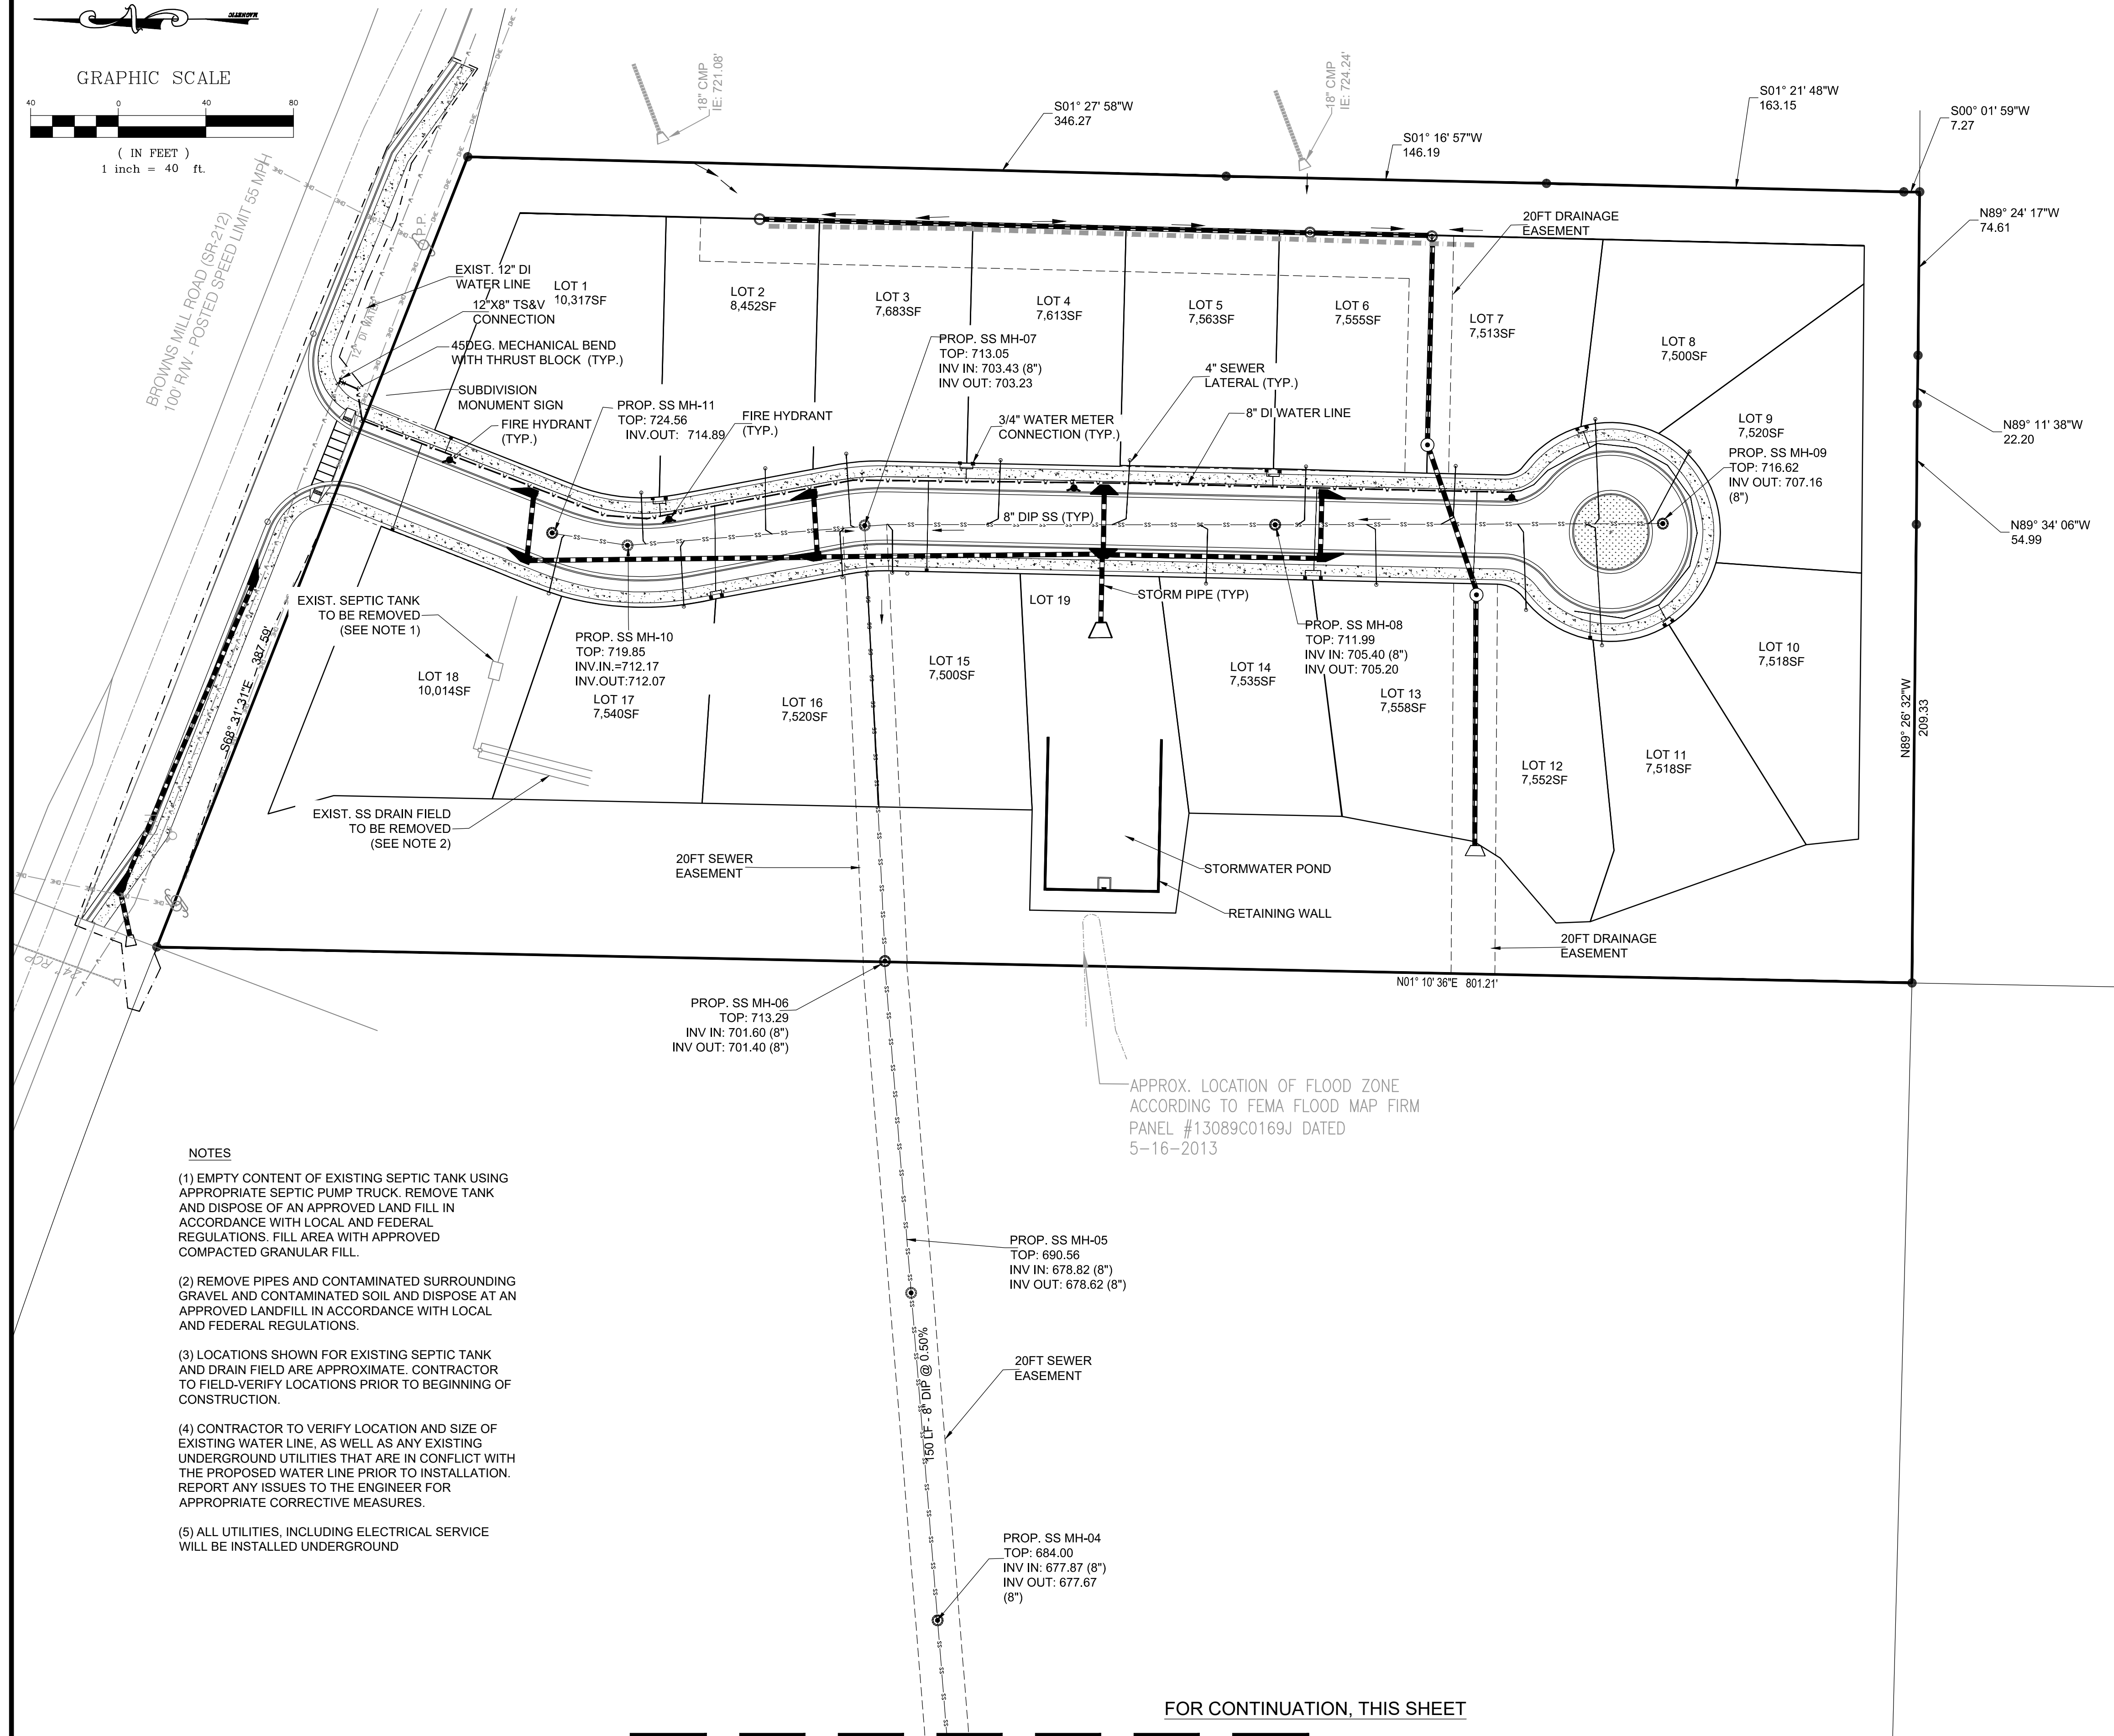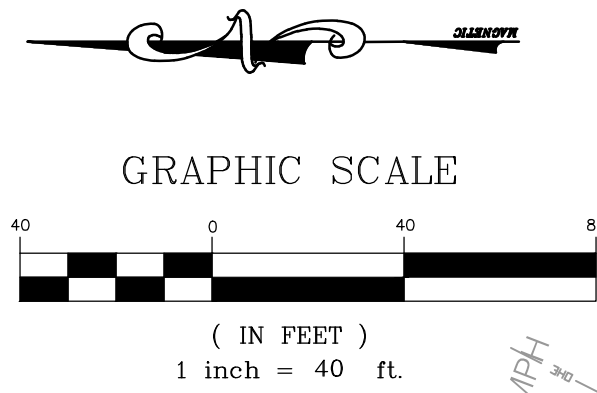

NOTES

- (1) EMPTY CONTENT OF EXISTING SEPTIC TANK USING APPROPRIATE SEPTIC PUMP TRUCK. REMOVE TANK AND DISPOSE OF AN APPROVED LAND FILL IN ACCORDANCE WITH LOCAL AND FEDERAL REGULATIONS. FILL AREA WITH APPROVED COMPACTED GRANULAR FILL.
- (2) REMOVE PIPES AND CONTAMINATED SURROUNDING GRAVEL AND CONTAMINATED SOIL AND DISPOSE AT AN APPROVED LANDFILL IN ACCORDANCE WITH LOCAL AND FEDERAL REGULATIONS.
- (3) LOCATIONS SHOWN FOR EXISTING SEPTIC TANK AND DRAIN FIELD ARE APPROXIMATE. CONTRACTOR TO FIELD-VERIFY LOCATIONS PRIOR TO BEGINNING OF CONSTRUCTION.
- (4) CONTRACTOR TO VERIFY LOCATION AND SIZE OF EXISTING WATER LINE, AS WELL AS ANY EXISTING UNDERGROUND UTILITIES THAT ARE IN CONFLICT WITH THE PROPOSED WATER LINE PRIOR TO INSTALLATION. REPORT ANY ISSUES TO THE ENGINEER FOR APPROPRIATE CORRECTIVE MEASURES.
- (5) ALL UTILITIES, INCLUDING ELECTRICAL SERVICE WILL BE INSTALLED UNDERGROUND


FOR CONTINUATION, THIS SHEET

DEVELOPER
WSM ASSOCIATES, LLC
CONTACT: WAYNE S. MOREHEAD
3112 MAIN STREET, SUITE 200
DULUTH, GA 30096
TEL: 678-641-2284
EMAIL: wmorehead@seedcapitalinvestment.com

24 HOUR CONTACT
WAYNE S. MOREHEAD
TEL: 678-641-2284

ENGINEER
CIVTECH CONSULTING, LLC
CONTACT: SAMUEL MCINTOSH, P.E.
2302 Parklake Dr, N.E., Suite 625
Atlanta, GA 30345
TEL: 770-756-4699
EMAIL: smcintosh@civtechconsulting.com

FOR CONTINUATION, THIS SHEET

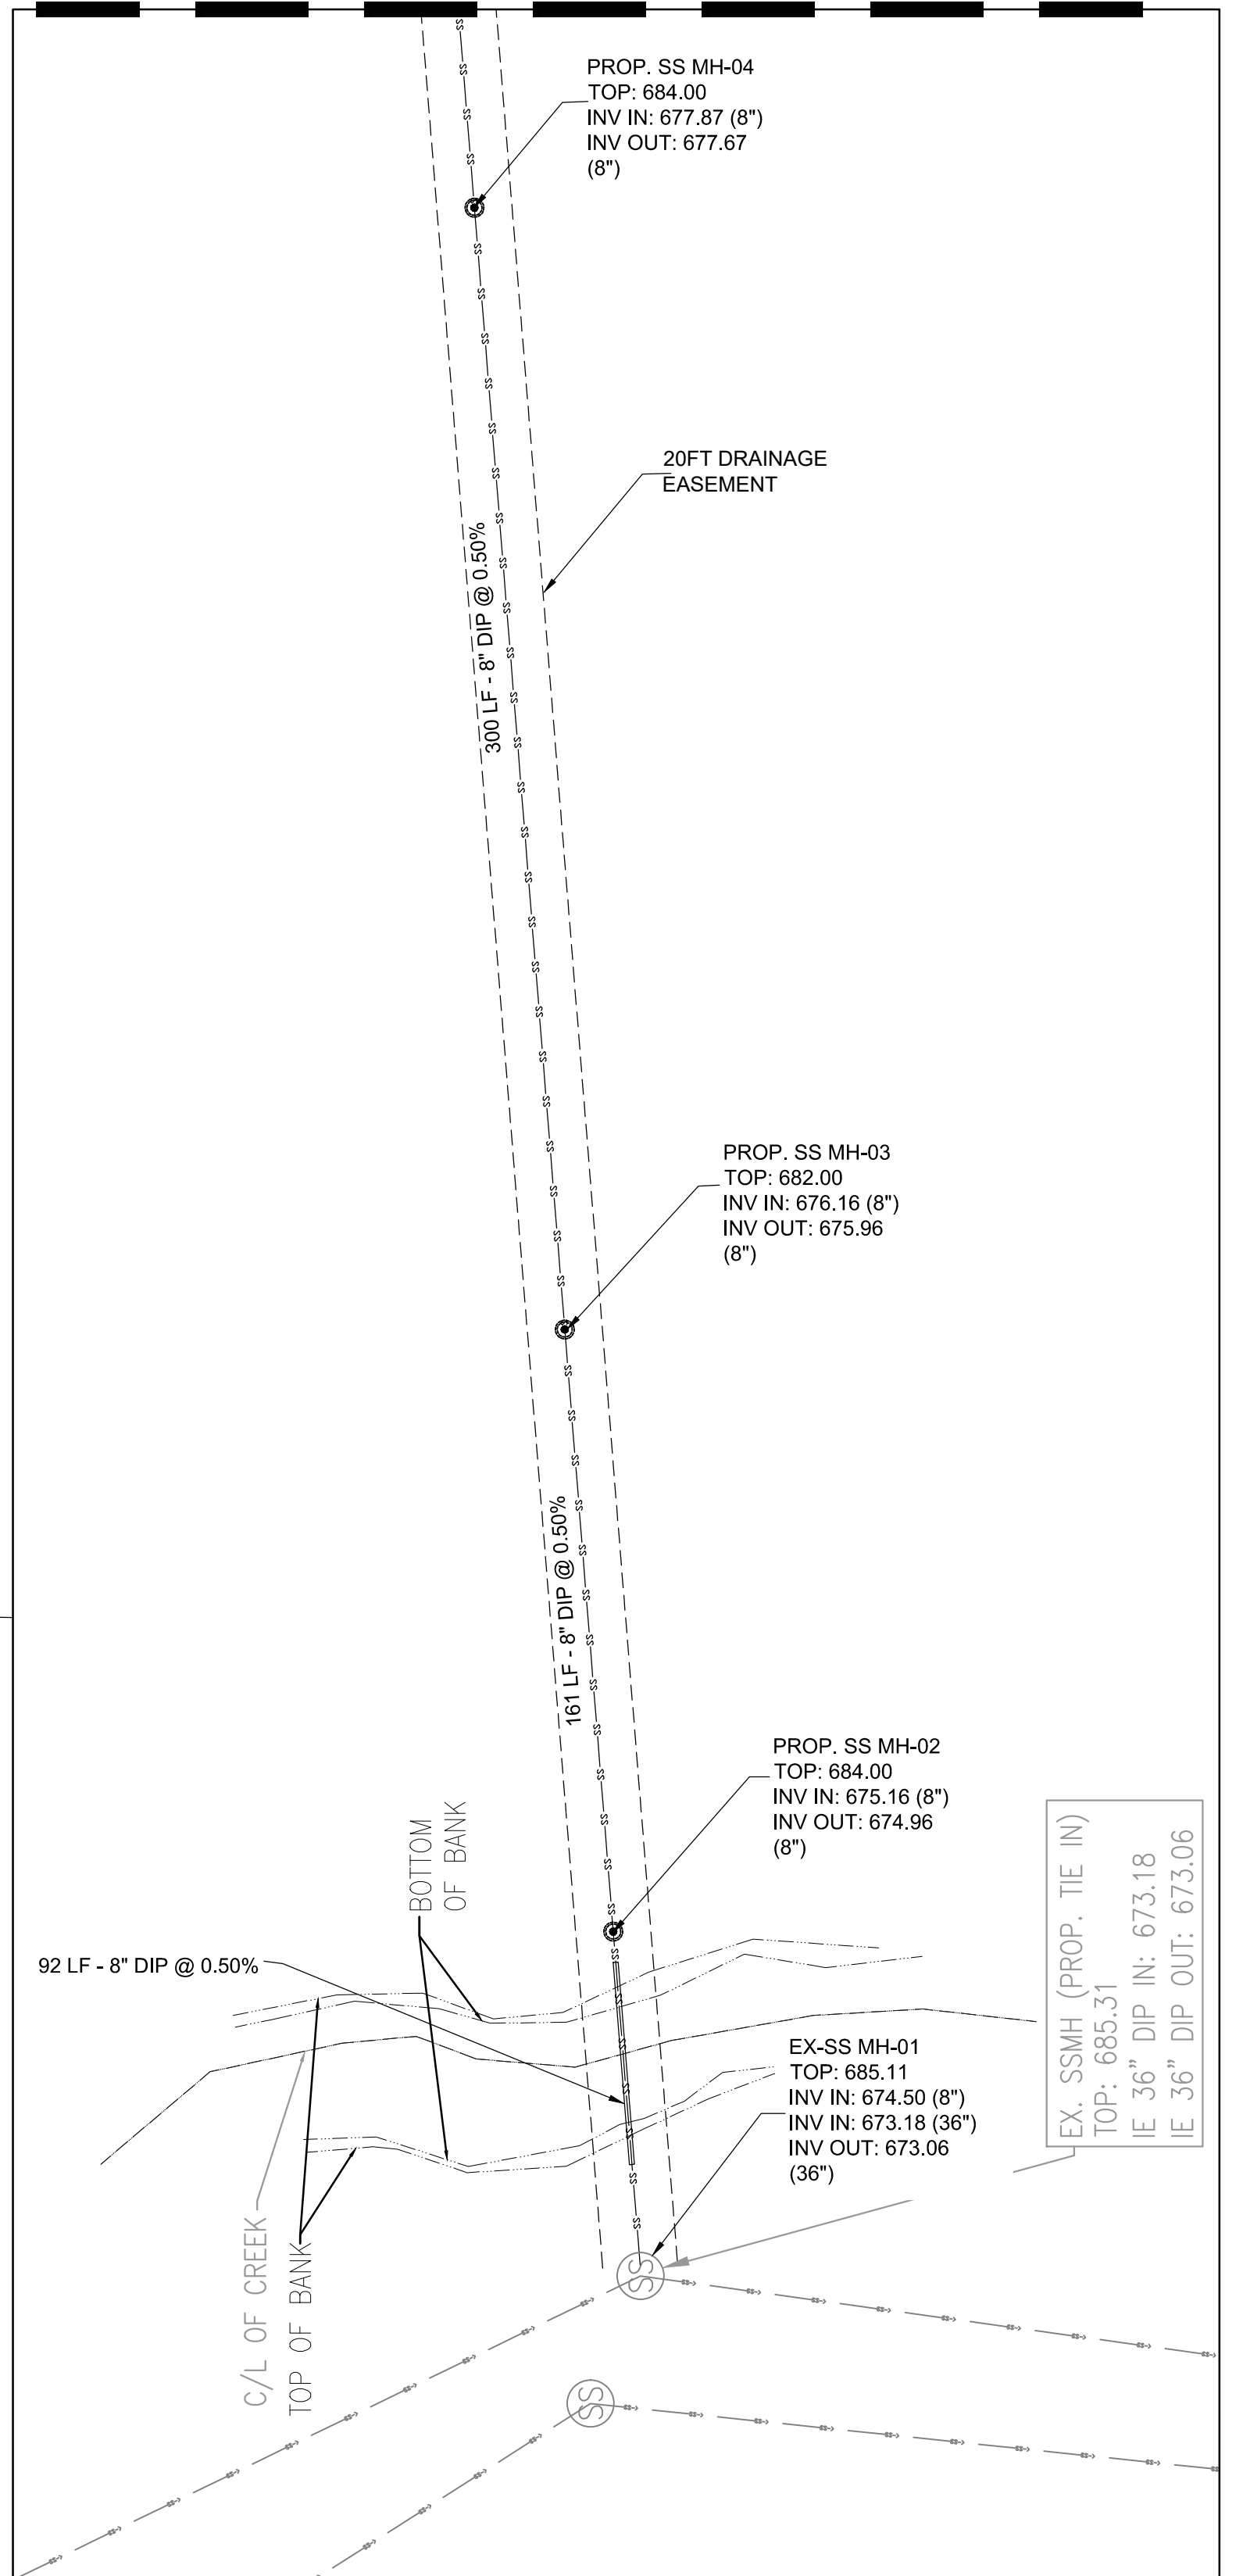


UTILITY PLAN

DATE	REV. NO.	REVISION
10/24/22	1	Address City Comments
11/14/22	2	Address City Comments

CivTech Consulting, LLC
2302 PARKLAKE DR, N.E., SUITE 625
ATLANTA, GA 30345
TEL: 770-756-1270

THE ENCLAVE AT ARABIA MOUNTAIN
6301 BROWNS MILL RD
LITHONIA, GA 30038

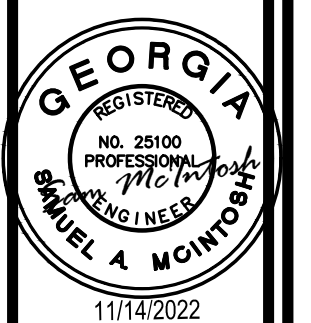

DATE	SCALE	AS SHOWN	DESIGNED BY	SMG	DRAWN BY	JL	CHECKED BY	SMG	APPROVED BY	SMG	SHEETS	OF
11/14/2022												

DRAWING NO: C-230

ISSUED FOR PRELIMINARY PLAT

SEAL



THESE DRAWINGS PREPARED BY SEARS SMITH AND ASSOCIATES, INC. FOR THIS PROJECT ARE FOR USE SOLELY WITH RESPECT TO THIS PROJECT AND UNLESS OTHERWISE PROVIDED, SEARS SMITH AND ASSOCIATES, INC. SHALL BE DEEMED THE AUTHOR OF THESE DOCUMENTS AND SHALL RETAIN ALL RIGHTS, INCLUDING THE COPYRIGHT. THESE DRAWINGS SHALL NOT BE USED BY OTHERS ON OTHER PROJECTS, FOR ADDITIONS TO THIS PROJECT OR FOR COMPLETION OF THIS PROJECT BY OTHERS, EXCEPT BY AGREEMENT IN WRITING BY SEARS SMITH AND ASSOCIATES, INC.

REVISIONS

#	DATE	REMARKS

PROJECT TITLE

BROWNS MILL ROAD

6301 BROWNS MILL ROAD

CITY OF STONECREST

81ST LAND LOT

DEKALB COUNTY, GEORGIA

PREPARED FOR:



3112 MAIN ST
SUITE 200
DULUTH, GA
678.641.2284

SHEET TITLE

EXISTING TREE
LOCATION AND
ASSESSMENT

DRAWN: RJC

CHECKED: CCS

DATE

JULY 7, 2022

- ☐ CLIENT REVIEW
☐ FOR PERMIT / REVIEW
☐ BID SET
☐ CONSTRUCTION

SHEET NUMBER

T.01

SPECIMEN TREE ASSESSMENT

Tag Number	DBH	Species	Common Name	Condition	Notes
587	31	Carya illinoensis	Pecan	Poor	Large wound at base with internal decay
588	31	Quercus alba	White oak	Good	
589	37	Quercus alba	White oak	Poor	Large wound at base with internal decay, actively falling trunk
590	34	Quercus alba	White oak	Good	
591	43	Quercus falcata	Southern red oak	Fair	Low split into two codominant trunks with included bark
592	38	Quercus nigra	Water oak	Fair	Low split into two codominant trunks with included bark
593	37	Quercus alba	White oak	Poor	Low split into four codominant trunks with included bark and one trunk dead

TREE ASSESSMENT

Survey Number	DBH	Species	Common Name	Notes
1	24	Carya illinoensis	Pecan	
2	27	Carya illinoensis	Pecan	
3	21	Carya illinoensis	Pecan	
4	19	Pinus taeda	Loblolly pine	
5	24	Pinus taeda	Loblolly pine	
6	20	Pinus taeda	Loblolly pine	
7	18	Pinus taeda	Loblolly pine	
8	20	Pinus taeda	Loblolly pine	
9	28	Quercus falcata	Southern red oak	
10	21	Quercus falcata	Southern red oak	
11	20	Liriodendron tulipifera	Tulip poplar	
12	28	Quercus falcata	Southern red oak	
13	23	Pinus taeda	Loblolly pine	
14	20	Quercus nigra	Water oak	
15	18	Liriodendron tulipifera	Tulip poplar	
16	19	Quercus falcata	Southern red oak	
17	19	Quercus alba	White oak	
18	23	Quercus alba	White oak	
19	24	Quercus alba	White oak	
20	23	Quercus alba	White oak	
21	27	Liriodendron tulipifera	Tulip poplar	
22	21	Quercus alba	White oak	
23	23	Quercus alba	Southern red oak	
24	21	Liriodendron tulipifera	Tulip poplar	
25	22	Quercus falcata	Southern red oak	
26	20	Quercus alba	White oak	
27	22	Quercus alba	White oak	
28	19	Quercus falcata	Southern red oak	
29	18	Quercus alba	White oak	
30	28	Quercus alba	White oak	
31	18	Quercus alba	White oak	
32	25	Liriodendron tulipifera	Tulip poplar	
33	19	Acer negundo	Broadleaf	
34	20	Liriodendron tulipifera	Tulip poplar	
35	27	Liquidambar styraciflua	Sweetgum	
36	21	Liquidambar styraciflua	Sweetgum	
37	20	Liriodendron tulipifera	Tulip poplar	
38	19	Liquidambar styraciflua	Sweetgum	
39	22	Liriodendron tulipifera	Tulip poplar	
40	19	Quercus alba	White oak	
41	21	Quercus alba	White oak	
42	22	Quercus alba	White oak	
43	21	Quercus alba	White oak	
44	21	Quercus alba	White oak	
45	25	Quercus alba	White oak	
46	26	Quercus alba	White oak	
47	28	Liriodendron tulipifera	Tulip poplar	
48	29	Liquidambar styraciflua	Sweetgum	
49	27	Quercus alba	White oak	
50	23	Quercus falcata	Southern red oak	
51	27	Quercus falcata	Southern red oak	
52	21	Quercus falcata	Southern red oak	
53	21	Quercus rubra	Northern red oak	
54	26	Quercus falcata	Southern red oak	
55	22	Liriodendron tulipifera	Tulip poplar	
56	28	Liriodendron tulipifera	Tulip poplar	
57	20	Pinus taeda	Loblolly pine	
58	20	Pinus taeda	Loblolly pine	
59	21	Pinus taeda	Loblolly pine	
60	19	Pinus taeda	Loblolly pine	
61	22	Pinus taeda	Loblolly pine	
62	22	Pinus taeda	Loblolly pine	
63	18	Pinus taeda	Loblolly pine	
64	21	Pinus taeda	Loblolly pine	
65	21	Pinus taeda	Loblolly pine	
66	18	Pinus taeda	Loblolly pine	
67	20	Pinus taeda	Loblolly pine	
68	20	Pinus taeda	Loblolly pine	
69	22	Pinus taeda	Loblolly pine	
70	20	Pinus taeda	Loblolly pine	
71	20	Liriodendron tulipifera	Tulip poplar	
72	18	Liquidambar styraciflua	Sweetgum	
73	24	Quercus stellata	Post oak	
74	19	Quercus falcata	Southern red oak	
75	19	Pinus taeda	Loblolly pine	
76	23	Pinus taeda	Loblolly pine	
77	19	Pinus taeda	Loblolly pine	
78	22	Pinus taeda	Loblolly pine	
79	25	Pinus taeda	Loblolly pine	
80	20	Pinus taeda	Loblolly pine	
81	19	Quercus nigra	Water oak	
82	19	Quercus nigra	Water oak	
83	18	Quercus nigra	Water oak	
84	20	Quercus nigra	Water oak	
85	19	Pinus taeda	Loblolly pine	
86	18	Pinus taeda	Loblolly pine	
87	20	Pinus taeda	Loblolly pine	
88	20	Pinus taeda	Loblolly pine	
89	20	Pinus taeda	Loblolly pine	
90	19	Pinus taeda	Loblolly pine	
91	19	Pinus taeda	Loblolly pine	
92	22	Pinus taeda	Loblolly pine	
93	19	Pinus taeda	Loblolly pine	
94	18	Pinus taeda	Loblolly pine	
95	19	Pinus taeda	Loblolly pine	
96	18	Pinus taeda	Loblolly pine	
97	18	Pinus taeda	Loblolly pine	
98	18	Pinus taeda	Loblolly pine	
99	21	Pinus taeda	Loblolly pine	
100	20	Pinus taeda	Loblolly pine	
101	22	Pinus taeda	Loblolly pine	
102	25	Liquidambar styraciflua	Sweetgum	Low split
103	21	Pinus taeda	Loblolly pine	
104	19	Pinus taeda	Loblolly pine	
105	21	Pinus taeda	Loblolly pine	
106	20	Pinus taeda	Loblolly pine	
107	24	Pinus taeda	Loblolly pine	
108	22	Pinus taeda	Loblolly pine	
109	19	Pinus taeda	Loblolly pine	
110	18	Pinus taeda	Loblolly pine	
111	18	Pinus taeda	Loblolly pine	
112	19	Pinus taeda	Loblolly pine	
113	18	Pinus taeda	Loblolly pine	
114	18	Pinus taeda	Loblolly pine	
115	22	Pinus taeda	Loblolly pine	
116	19	Pinus taeda	Loblolly pine	
117	22	Pinus taeda	Loblolly pine	
118	18	Pinus taeda	Loblolly pine	
119	27	Liquidambar styraciflua	Sweetgum	Low split
120	21	Pinus taeda	Loblolly pine	
121	18	Pinus taeda	Loblolly pine	
122	19	Liriodendron tulipifera	Tulip poplar	
123	18	Pinus taeda	Loblolly pine	
124	28	Pinus taeda	Loblolly pine	
125	19	Pinus taeda	Loblolly pine	
126	20	Pinus taeda	Loblolly pine	
127	21	Liriodendron tulipifera	Tulip poplar	
128	20	Pinus taeda	Loblolly pine	
129	22	Liriodendron tulipifera	Tulip poplar	
130	29	Quercus falcata	Southern red oak	
131	25	Pinus taeda	Loblolly pine	
132	24	Pinus taeda	Loblolly pine	
133	18	Pinus taeda	Loblolly pine	
134	19	Quercus falcata	Southern red oak	
135	20	Quercus falcata	Southern red oak	
136	22	Quercus falcata	Southern red oak	
137	19	Liquidambar styraciflua	Sweetgum	
138	24	Pinus taeda	Loblolly pine	
139	20	Quercus alba	White oak	
140	21	Carya glabra	Pignut hickory	Low split
141	19	Quercus alba	White oak	
142	25	Liriodendron tulipifera	Tulip poplar	
143	22	Liriodendron tulipifera	Tulip poplar	
144	26	Liriodendron tulipifera	Tulip poplar	
145	23	Quercus alba	White oak	
146	18	Pinus taeda	Loblolly pine	
147	23	Pinus taeda	Loblolly pine	
148	21	Pinus taeda	Loblolly pine	
149	22	Pinus taeda	Loblolly pine	

NOTES

- EXISTING BOUNDARY AND TOPOGRAPHIC SURVEY PROVIDED BY DUSOUTH SURVEYING & ENGINEERING, INC.
- EXISTING TREE LOCATION DATA AND ASSESSMENT PROVIDED BY CHRIS HUGHES (ASCA RCA #493, ISA SO-5374) AT BROOKWOOD TREE CONSULTING, INC.

